

# **APPENDIX DR-2018**

## **RECORD DRAWINGS**

RM TA BRIDGES 4, 36, 46, 47, 48, 49, 50, 51, 54, 55, 56, 57, 58, 60 & 62





# **RMTA System Map**






# RICHMOND EXPRESSWAY SYSTEM

Scale:  
0 1000 2000 3000ft.

48 - Bridge Number  
RMTA Facilities Shown in Red

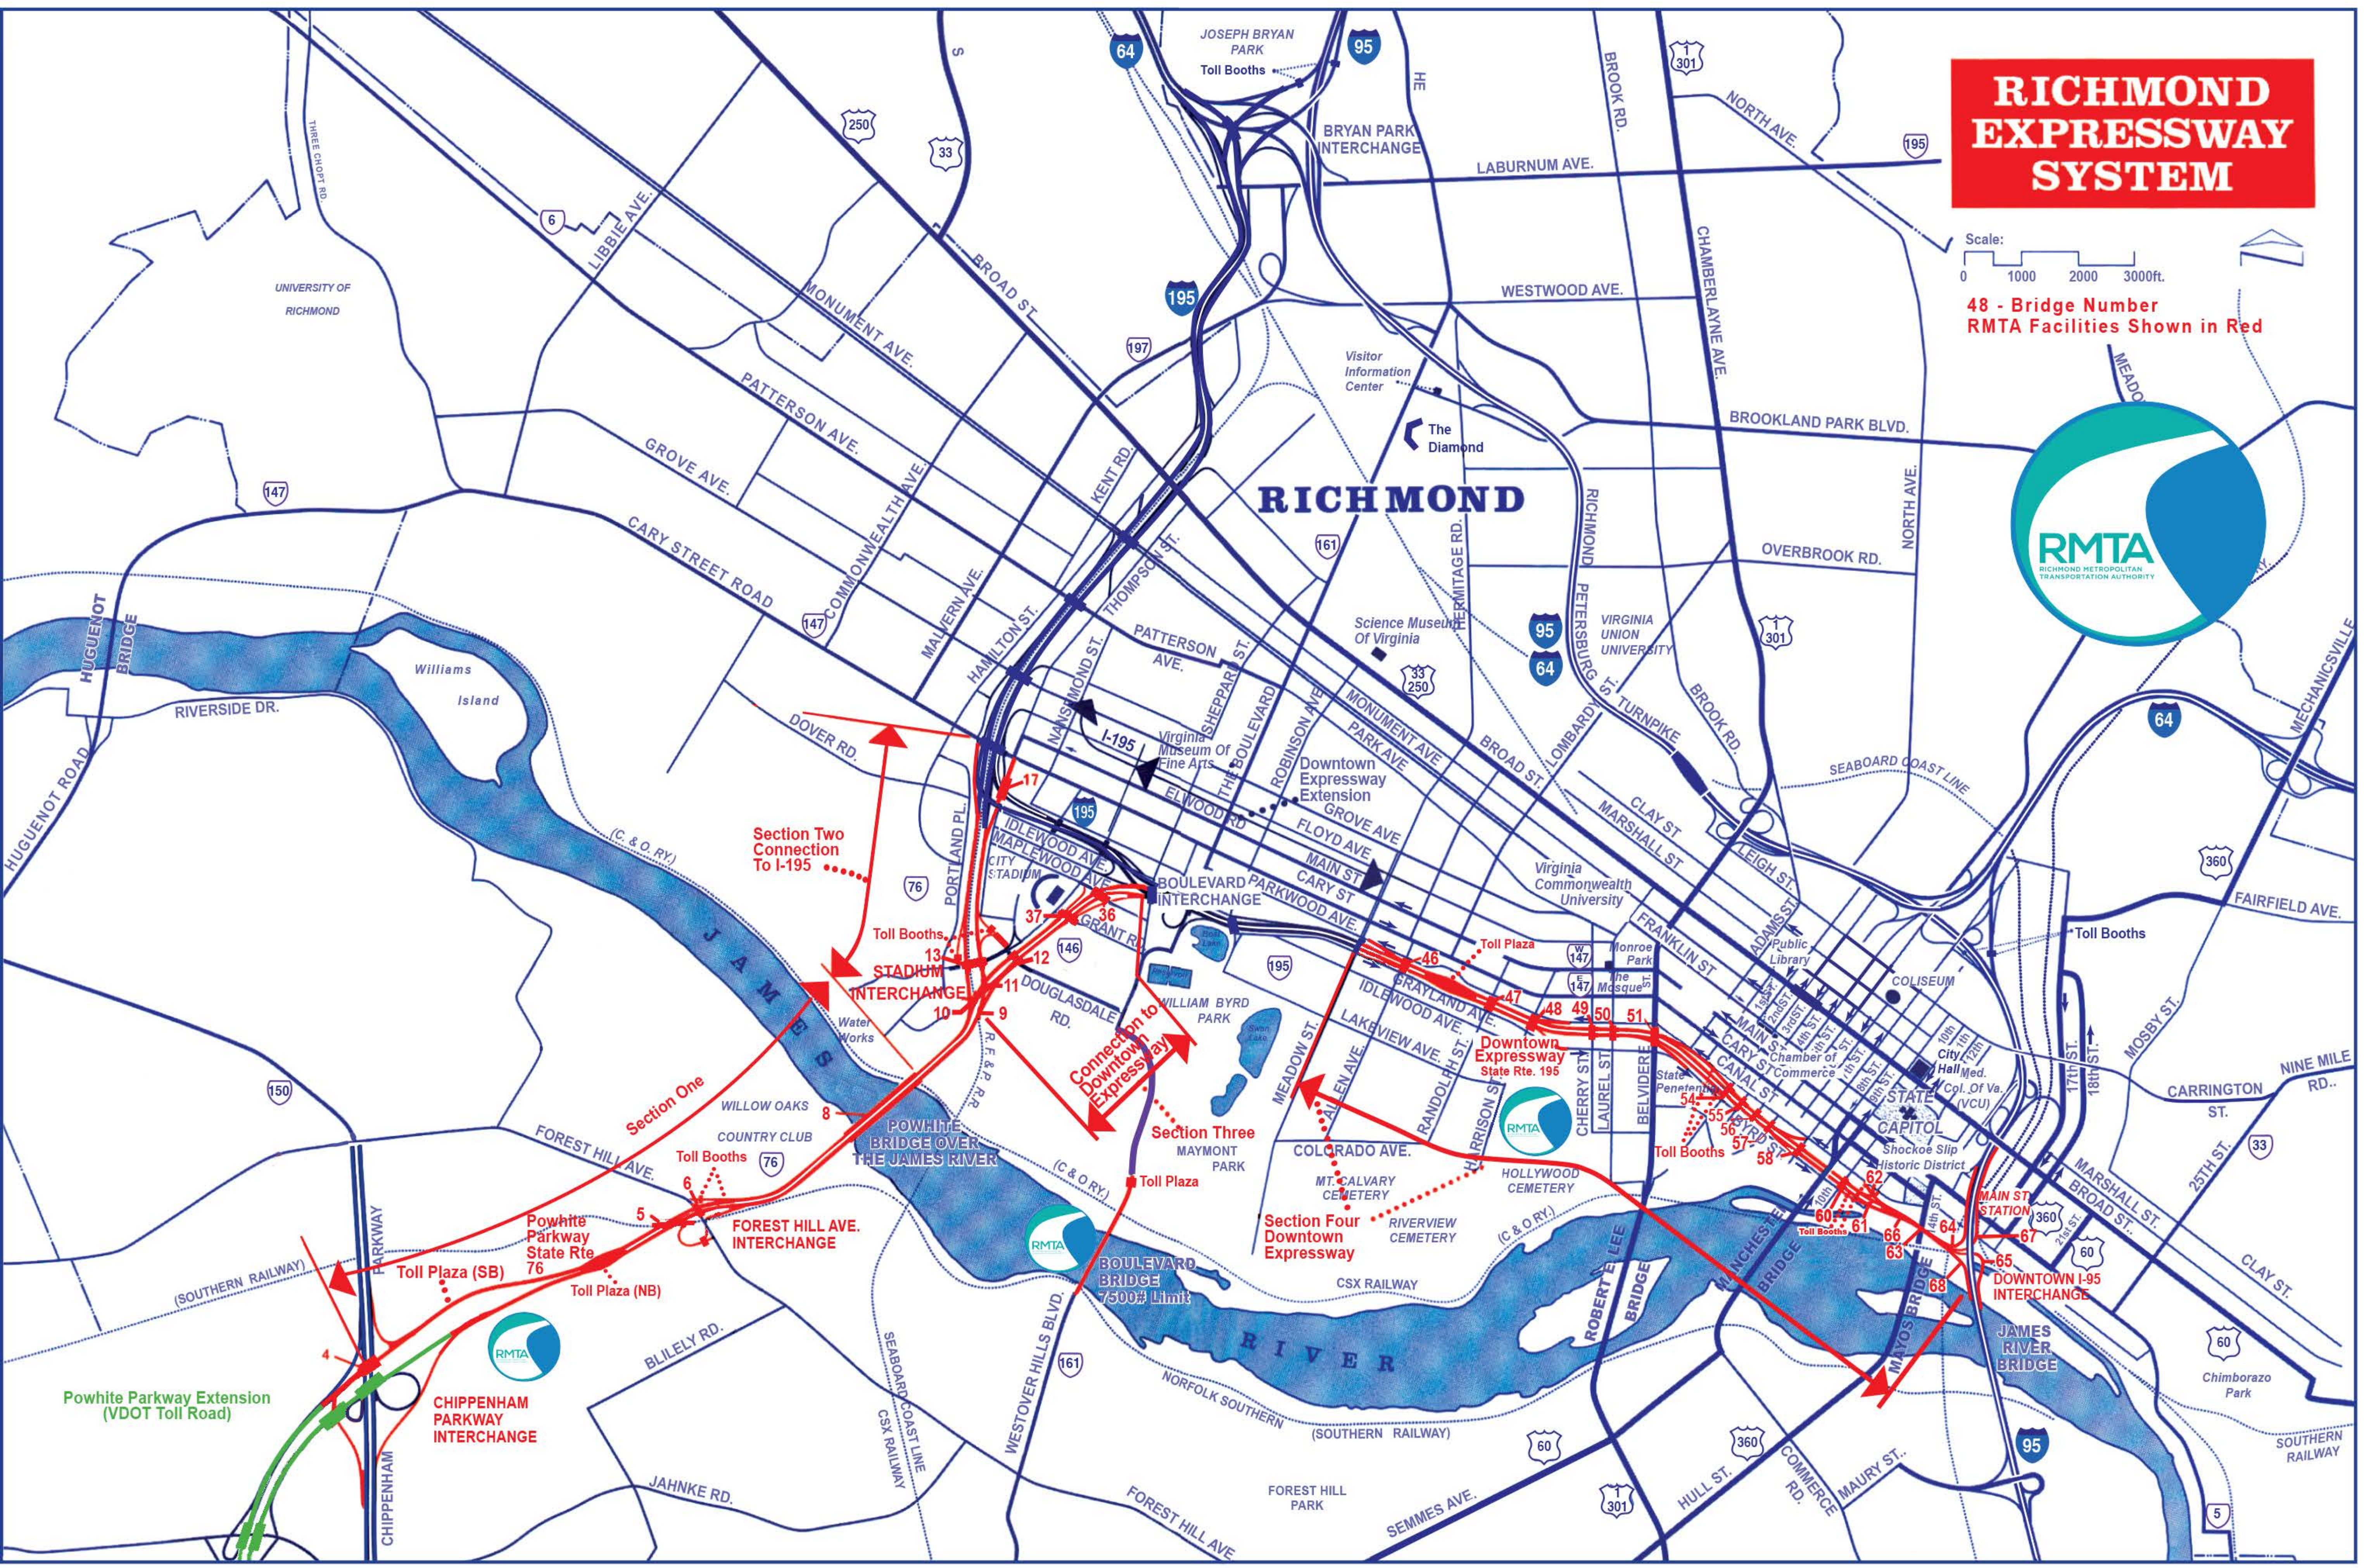







## **Bridge 4**




**(Southbound Powhite Parkway {Rte. 76}  
Over Chippenham Parkway {Rte. 150})**

**Record Set Plans**

RICHMOND EXPRESSWAY SYSTEM			
SECTION	PROJECT	SHEET NO.	TOTAL SHEETS
2	POWHITE PARKWAY	118	188

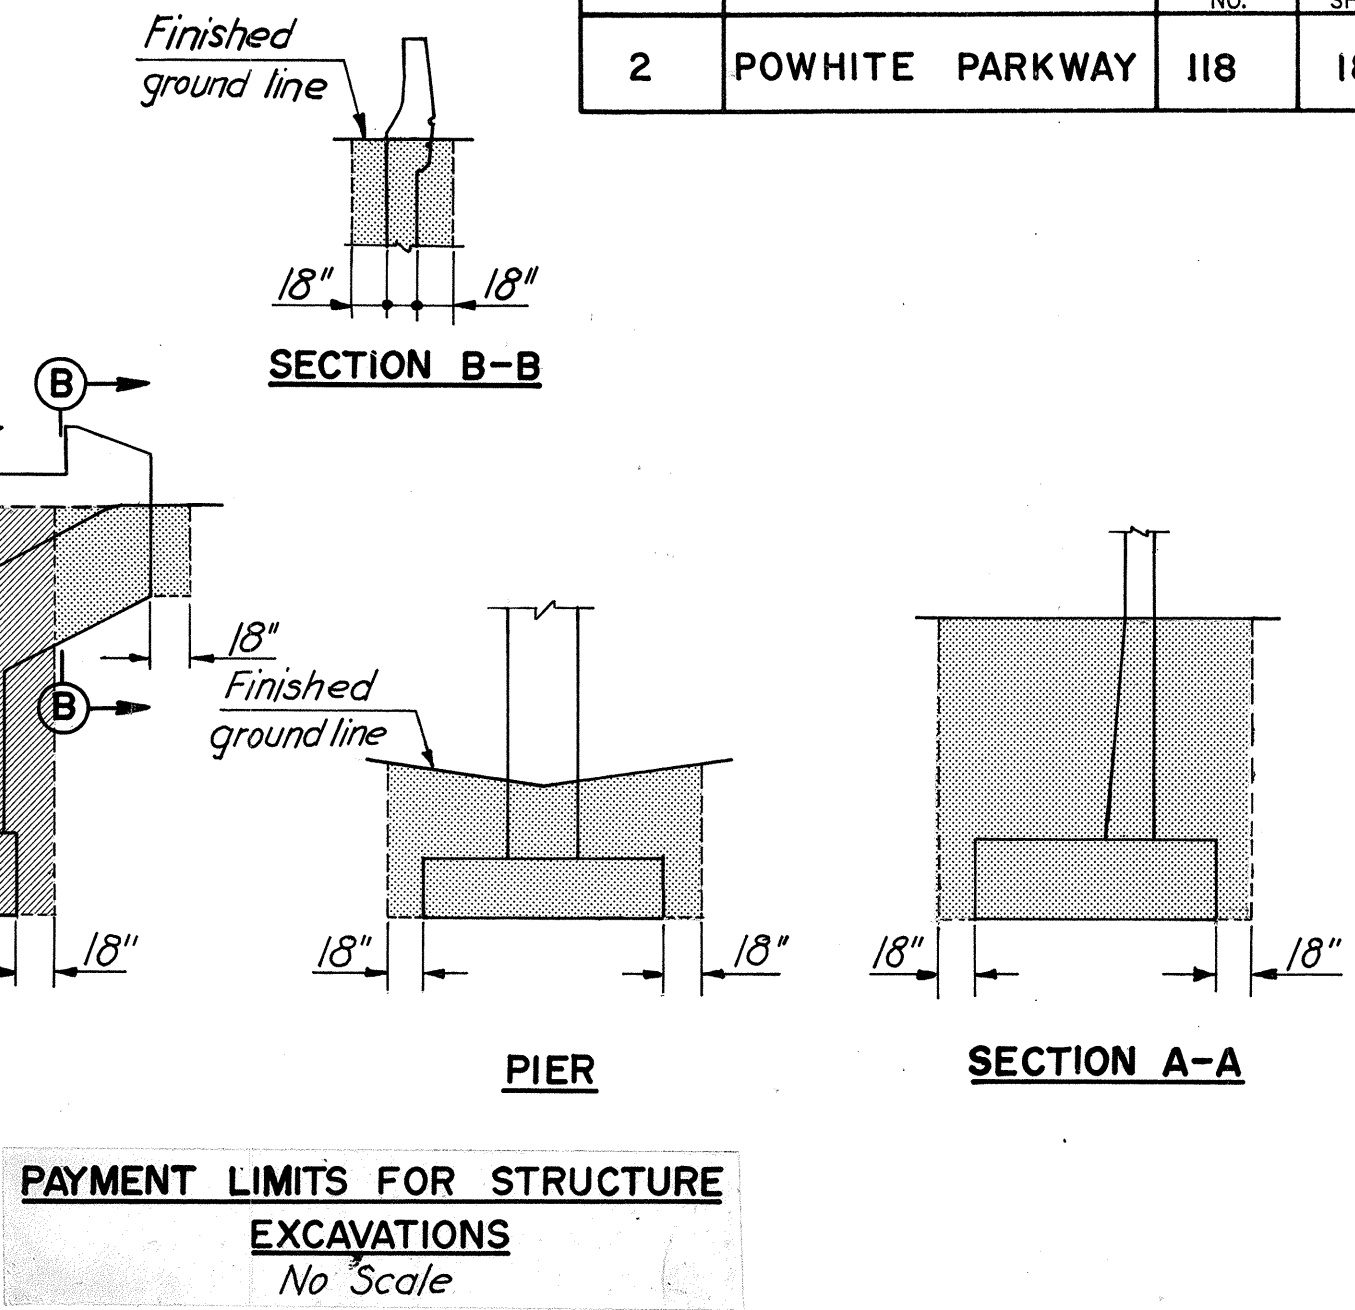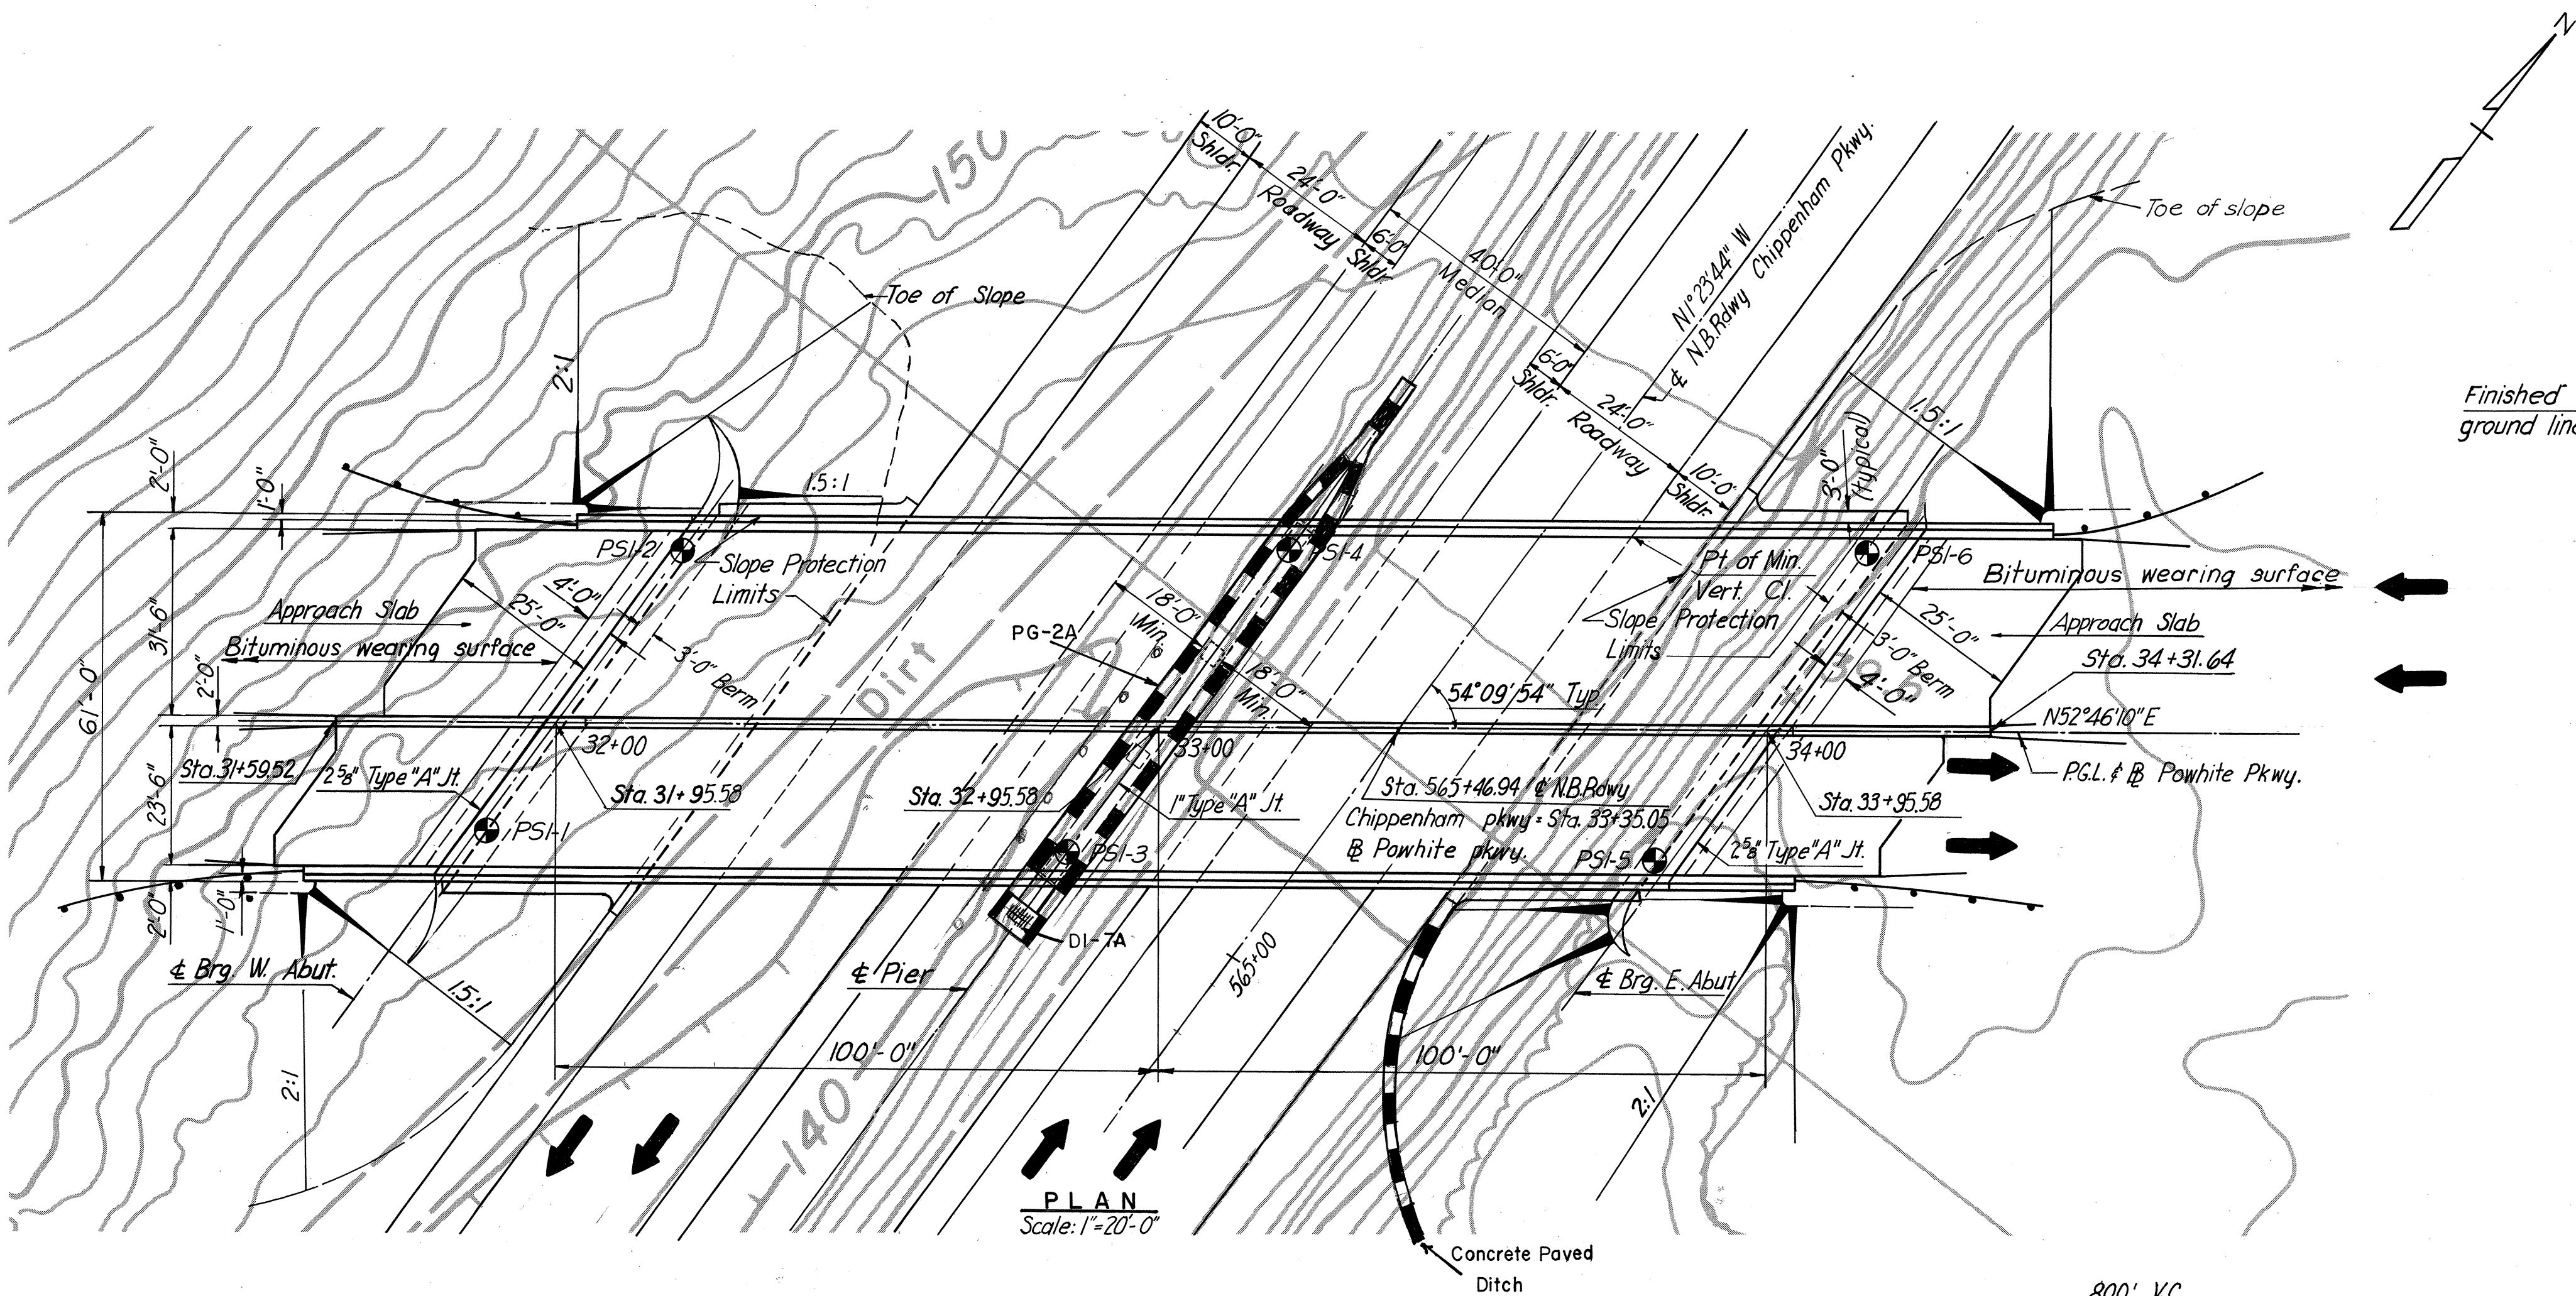

INDEX	
NO.	DESCRIPTION
1.	General Plan and Elevation
2.	General Notes and Quantities
3.	West Abutment
4.	East Abutment
5.	Abutment Details (1)
6.	Abutment Details (2)
7.	Pier Details
8.	Framing Plan
9.	Cross Section
10.	Deck Plans
11.	Joint Details
12.	Approach Slab and Slope Protection
13.	Boring Logs
14.	Boring Logs
S1.	Standard Shoe Details
S2.	Standard Aluminum Rolling Details
S7.	Standard Architectural Details

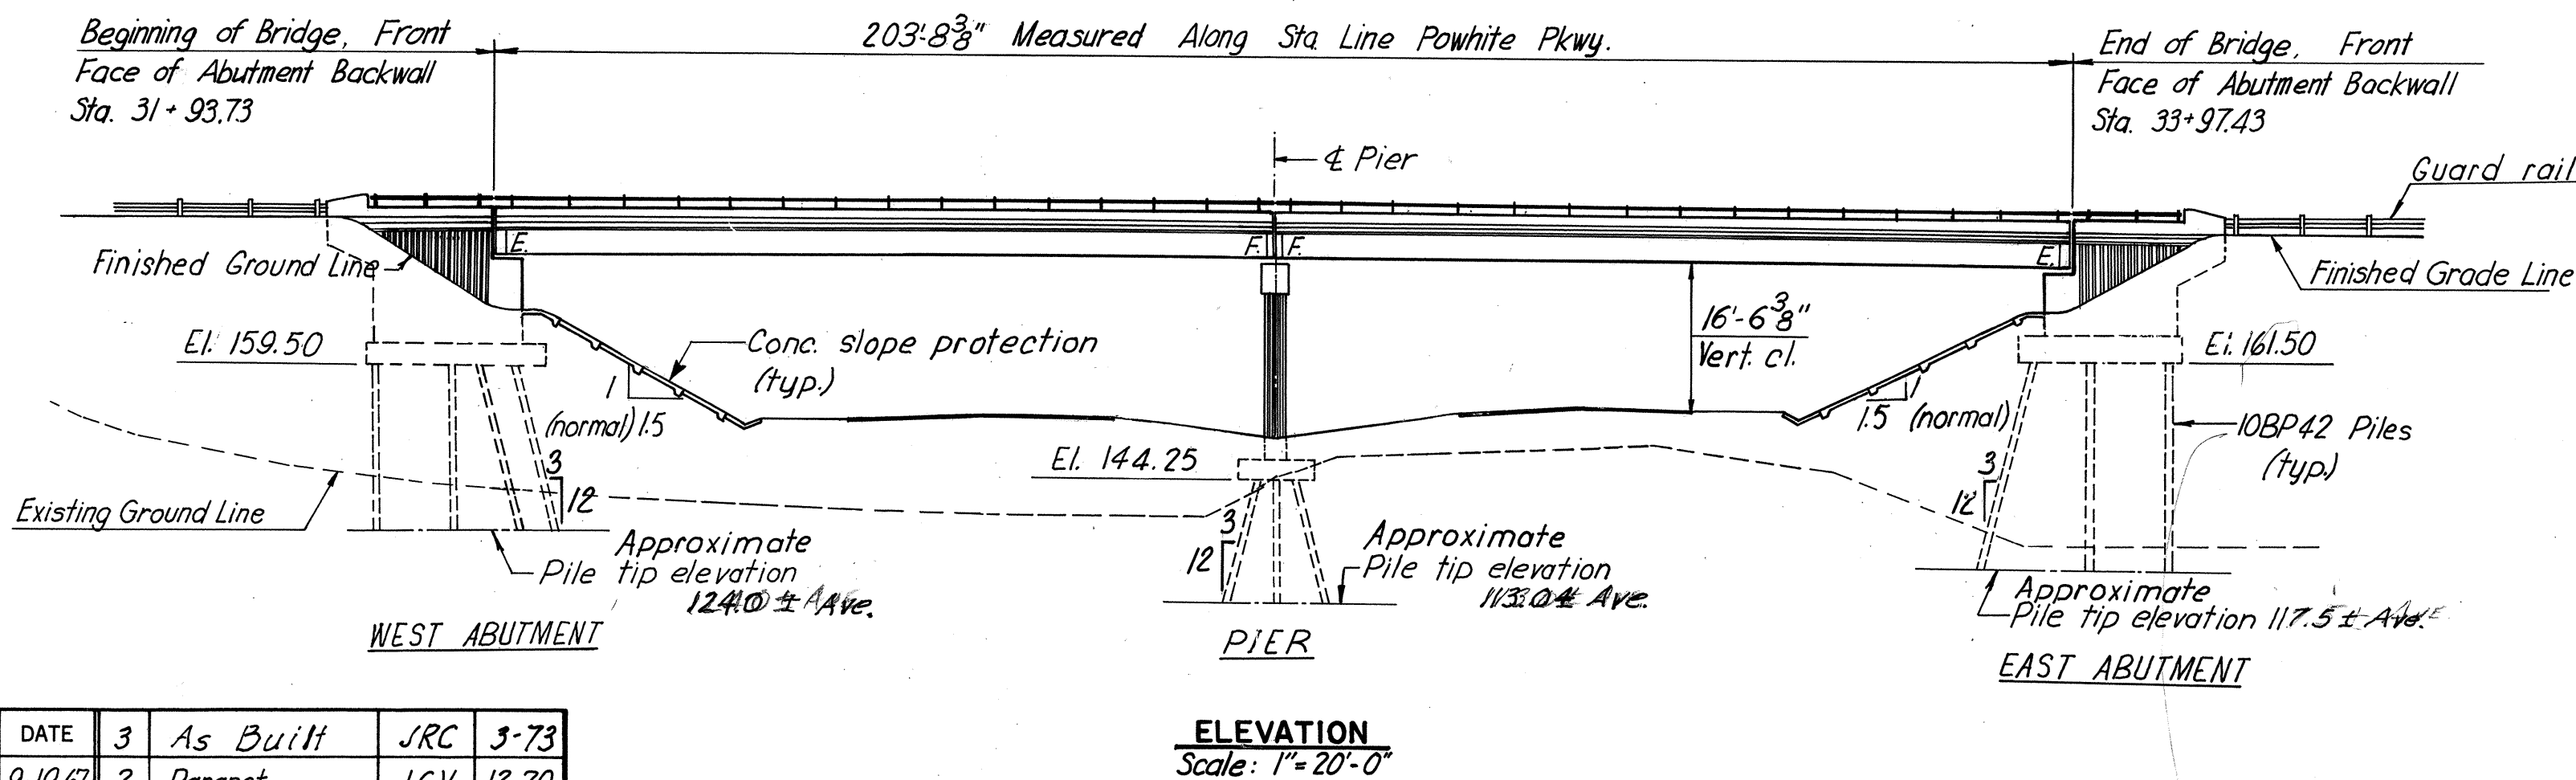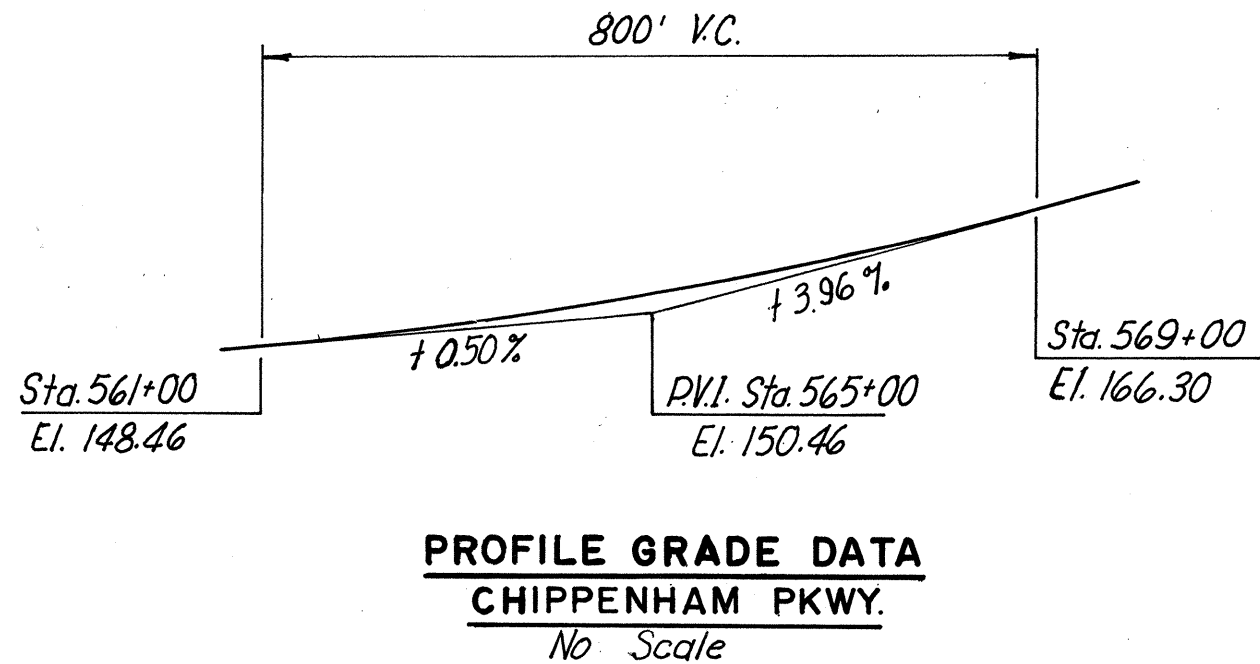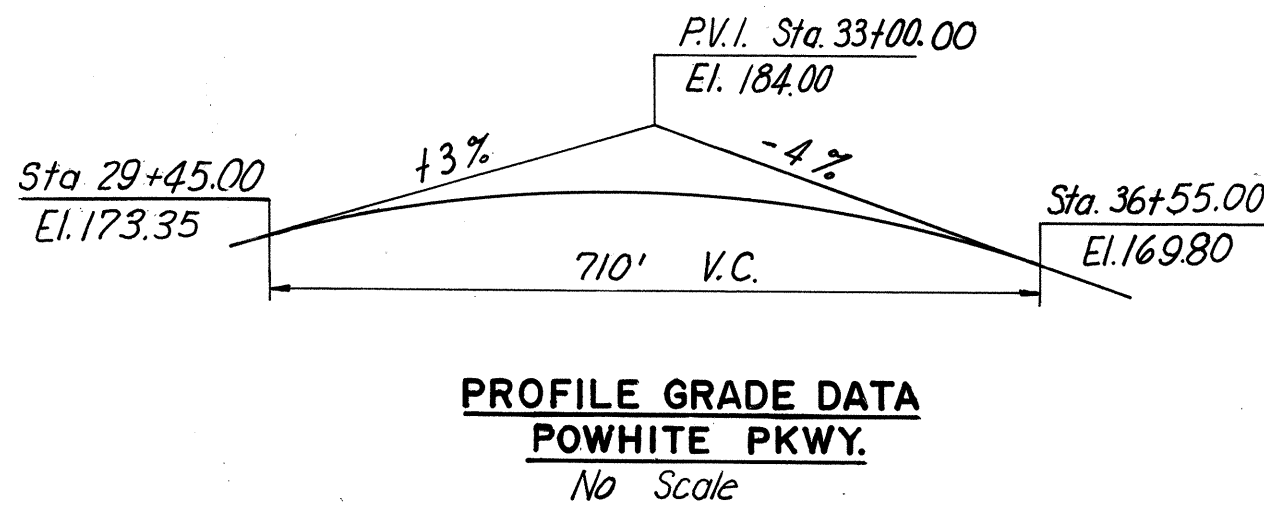

**BORINGS:** Indicates location of 2 1/2" cased hole boring.

**BENCH MARKS:** See Reference Ties and Field Control Data sheet in highway plans.  
 F-30 (Copper Weld Rod) Elevation 218.82  
 G-11 (Copper Weld Rod) Elevation 150.10

**AS BUILT**

**RICHMOND METROPOLITAN AUTHORITY  
RICHMOND EXPRESSWAY SYSTEM  
POWHITE PARKWAY**

**POWHITE PARKWAY OVER  
CHIPPENHAM PARKWAY  
BRIDGE B - 04**

**GENERAL PLAN & ELEVATION**





HOWARD, NEEDLES, TAMMEN & BERGENDOFF  
consulting engineers  
NEW YORK ALEXANDRIA KANSAS CITY

SCALE: AS SHOWN  
CONTRACT NO. C-2  
SHEET NO. 1 OF 14


BY	DATE	3	As Built	SRC	5-73
MADE	T.E.M.	9-19-67	2	Parapet	J.G.V. 12-70
CHECKED	DSB	5-27-68	1	Dimension	T.E.M. 5-68
IN CHARGE	PRY	NO.	REVISION	BY	DATE



RICHMOND EXPRESSWAY SYSTEM			
SECTION	PROJECT	SHEET NO.	TOTAL SHEETS
2	POWHITE PARKWAY	126	188

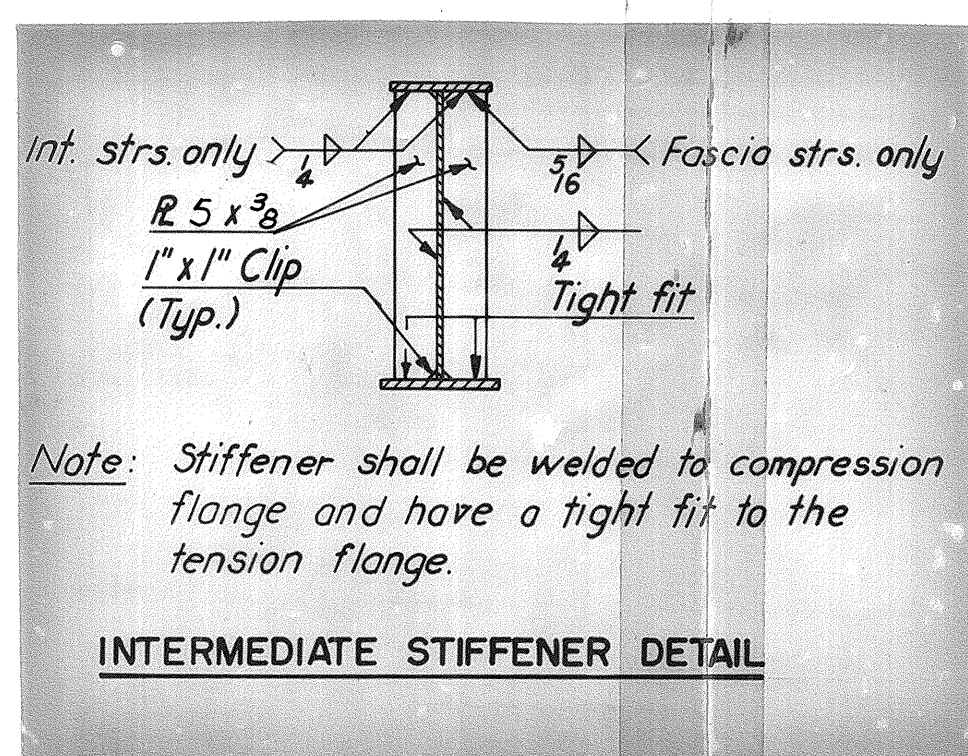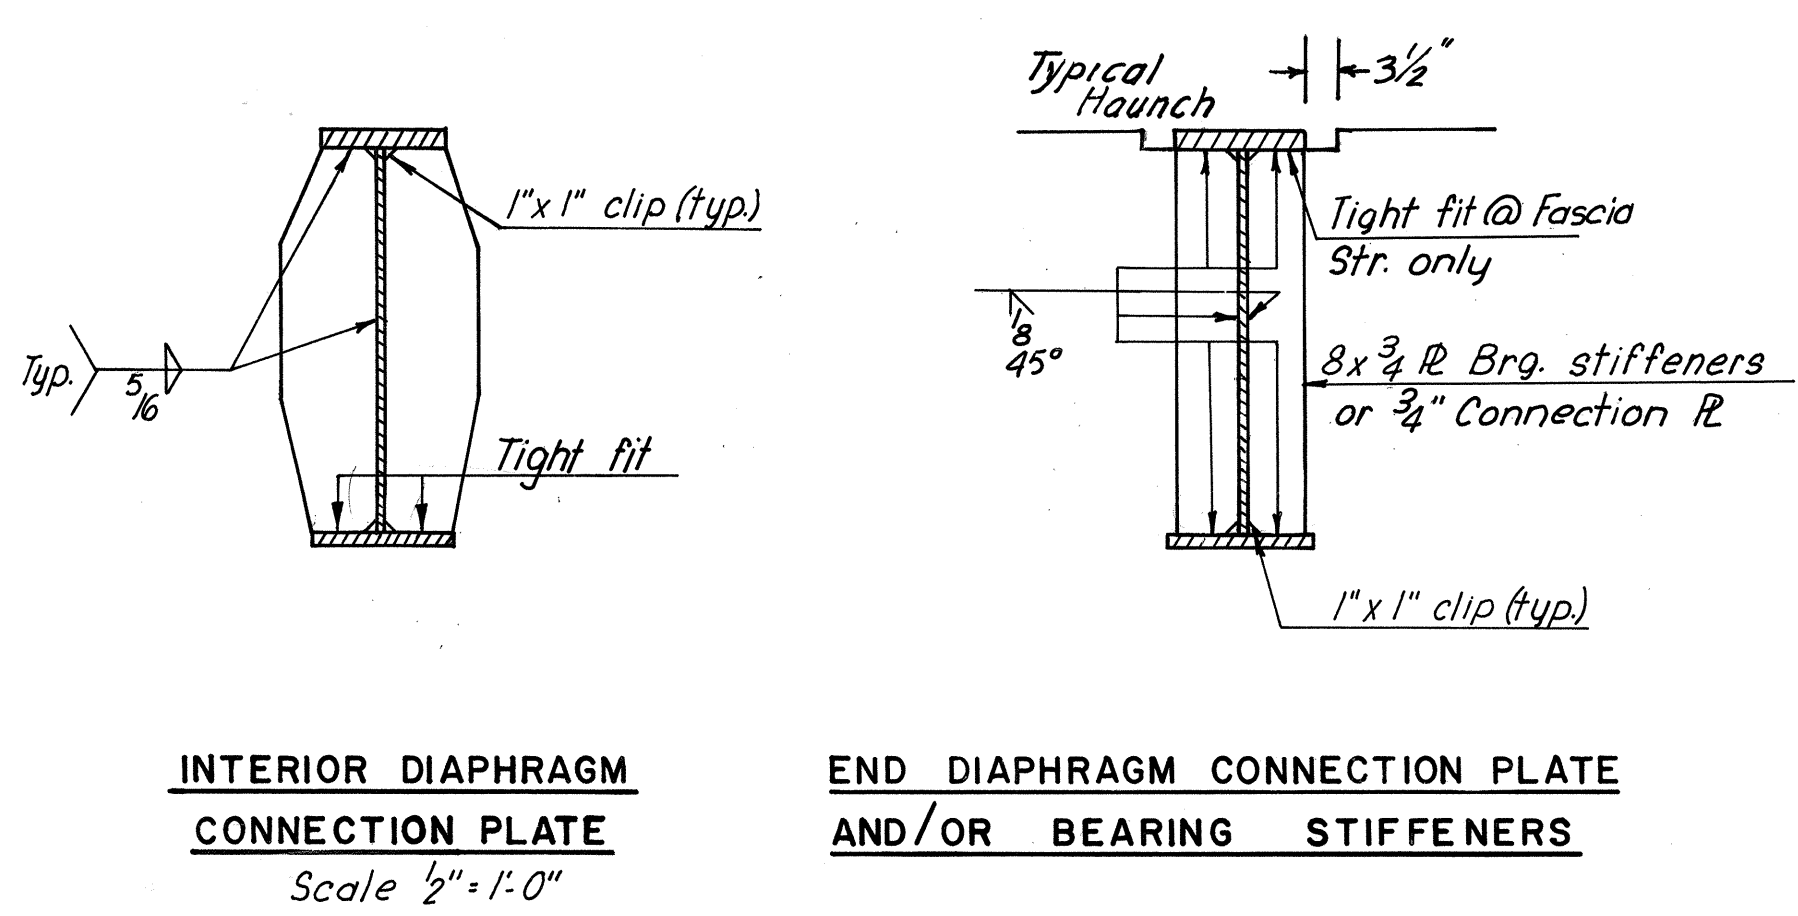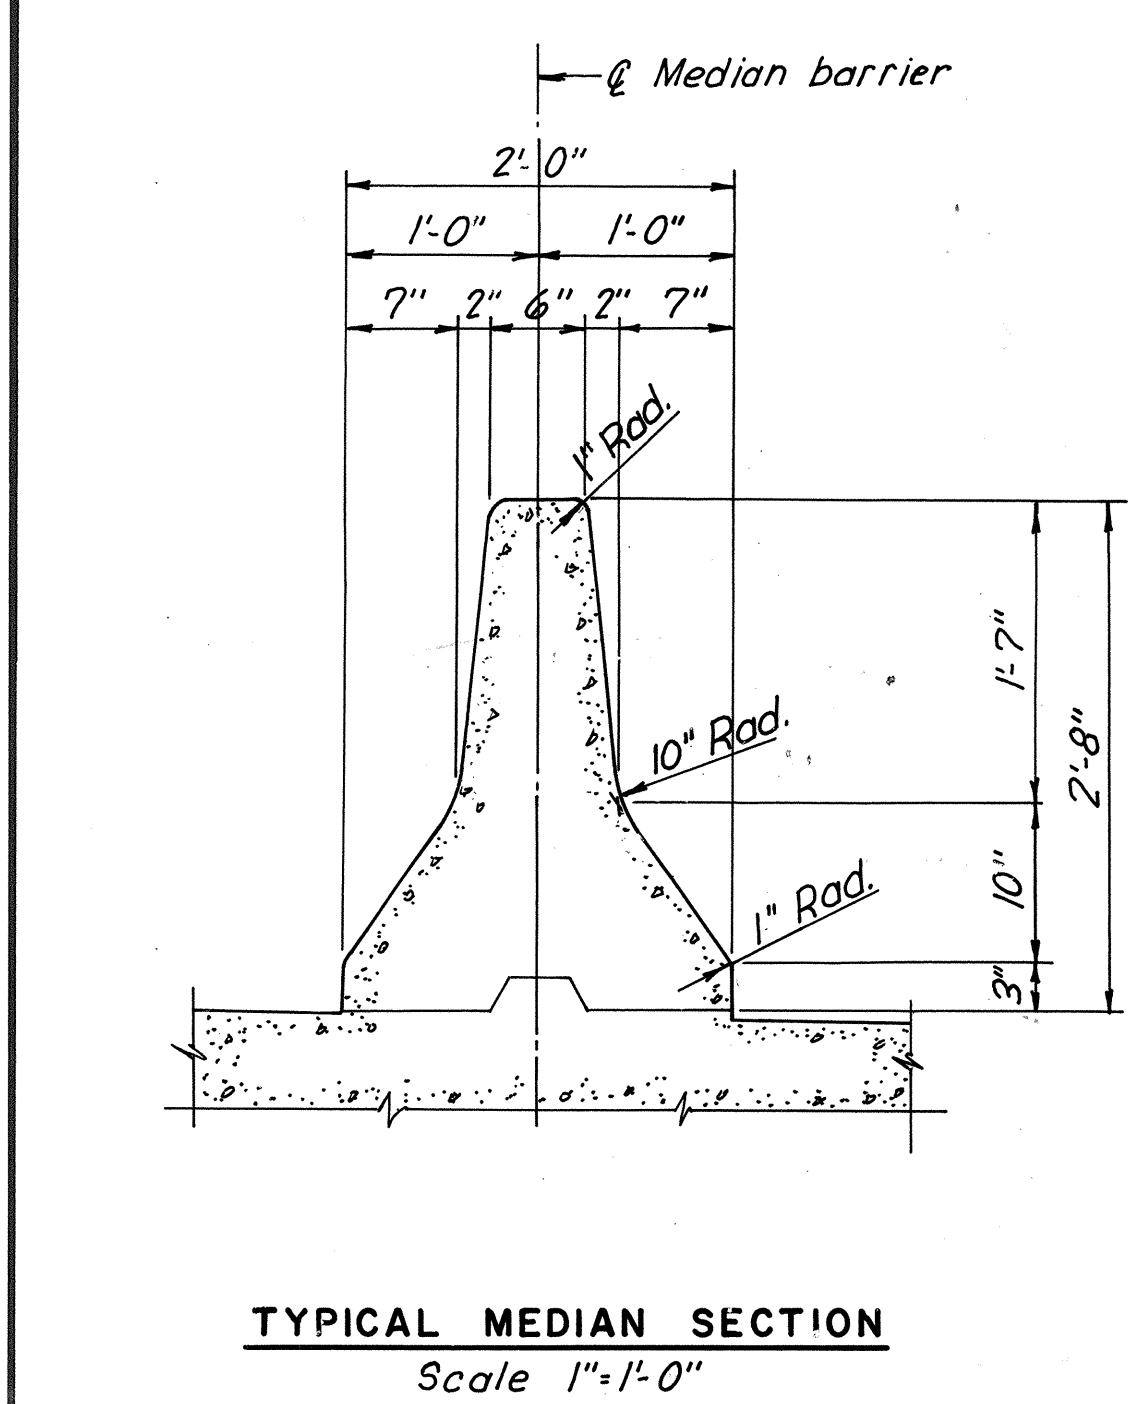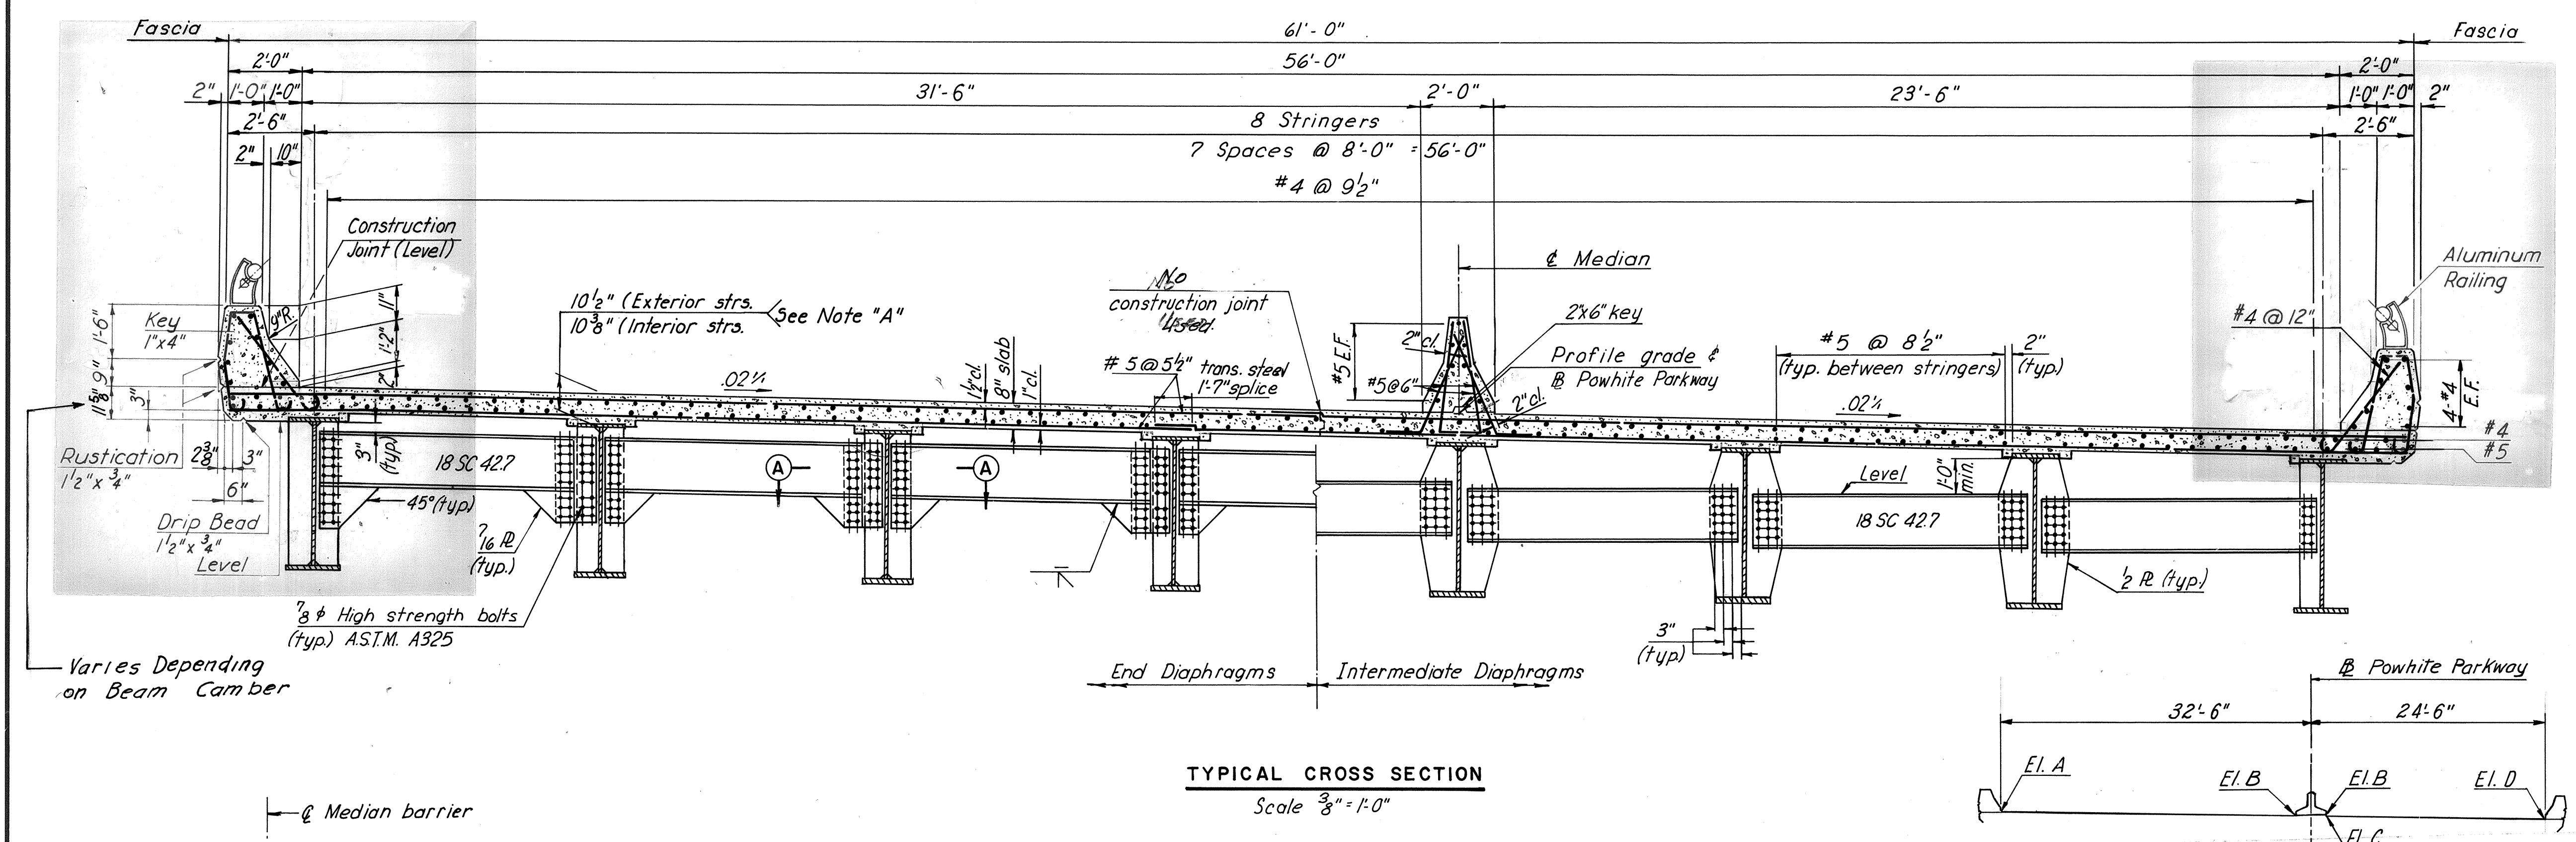

GUTTER LINE ELEVATION				
STATION	EL. A	EL. B	EL. C	EL. D
31+60.00	178.17	177.54	177.50	177.03
70.00	178.25	177.62	177.58	177.11
76.04				177.16
80.00	178.33	177.70	177.66	177.19
90.00	178.39	177.76	177.72	177.25
93.01			177.73	
94.45		177.78		
32+00.00	178.44	177.81	177.77	177.30
10.00	178.49	177.86	177.82	177.35
17.20	178.51			
20.00	178.52	177.89	177.85	177.38
30.00	178.55	177.92	177.88	177.41
40.00	178.56	177.93	177.89	177.42
50.00	178.56	177.93	177.89	177.42
60.00	178.56	177.93	177.89	177.42
70.00	178.54	177.91	177.87	177.40
77.89				177.39
80.00	178.52	177.89	177.85	177.38
90.00	178.48	177.85	177.81	177.34
94.86			177.79	
96.30		177.83		
33+00.00	178.44	177.81	177.77	177.30
10.00	178.38	177.75	177.71	177.24
19.05	178.33			
20.00	178.32	177.69	177.65	177.18
30.00	178.24	177.61	177.57	177.10
40.00	178.16	177.53	177.49	177.02
50.00	178.06	177.43	177.39	176.92
60.00	177.96	177.33	177.29	176.82
70.00	177.85	177.22	177.18	176.71
79.74				176.58
80.00	177.72	177.09	177.05	176.58
90.00	177.59	176.96	176.92	176.45
96.71			176.83	
98.51		176.85		
34+00.00	177.45	176.82	176.78	176.31
10.00	177.29	176.66	176.62	176.15
20.00	177.13	176.50	176.46	175.99
20.90	177.12			
30.00	176.95	176.32	176.28	175.81

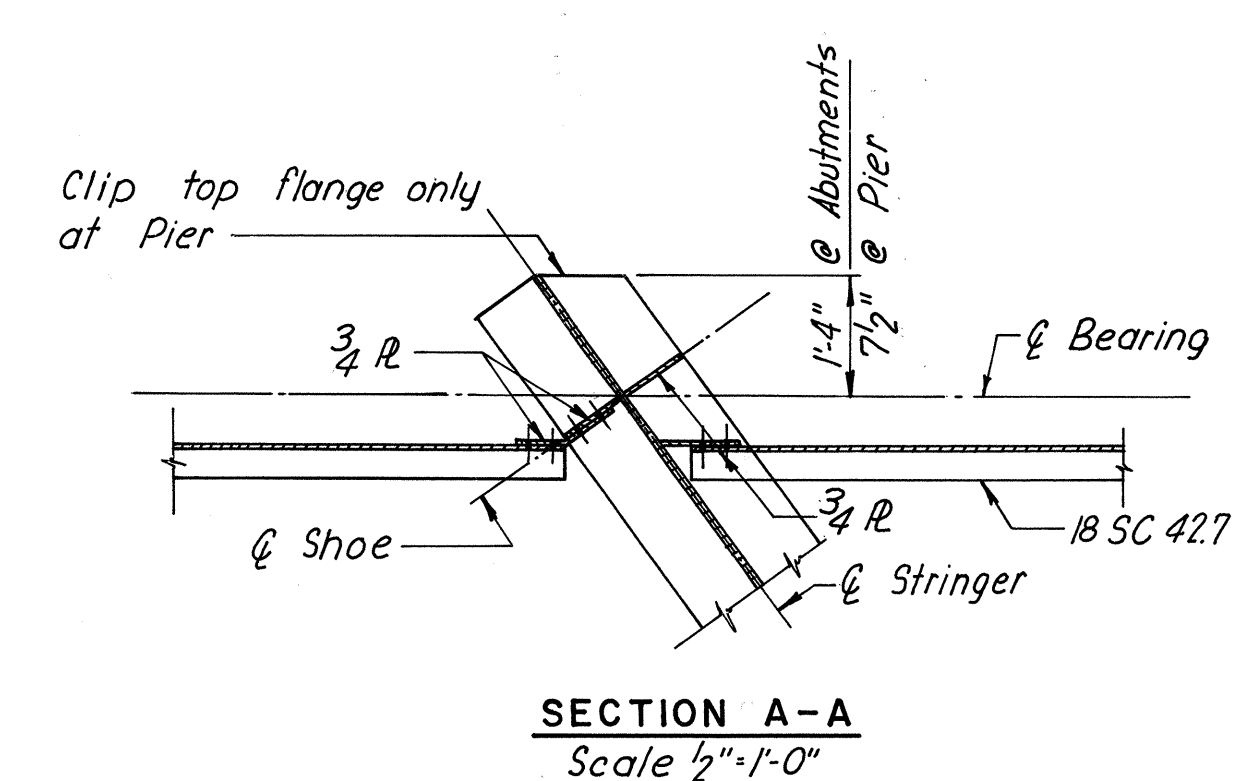

MADE	BY	DATE	NO.	REVISION	BY	DATE
DEK. 10-67	1	Parapet	EVR	12-70		

# AS BUILT

**RICHMOND METROPOLITAN AUTHORITY**  
**RICHMOND EXPRESSWAY SYSTEM**  
 POWHITE PARKWAY

**POWHITE PARKWAY OVER**  
**CHIPPENHAM PARKWAY**  
 BRIDGE B-04

**CROSS SECTION**

HOWARD, NEEDLES, TAMMEN & BERGENDOFF  
 consulting engineers  
 NEW YORK ALEXANDRIA KANSAS CITY

SCALE: **AS SHOWN**  
 CONTRACT NO.: **2**  
 SHEET NO. **9** OF **14**






# **Bridge 36**

**(Maplewood Avenue  
Over Downtown Expressway Connector {Rte. 146})**

**Record Set Plans**

RICHMOND EXPRESSWAY SYSTEM			
SECTION	PROJECT	SHEET NO.	TOTAL SHEETS
7	DOWNTOWN EXPRESSWAY	96	

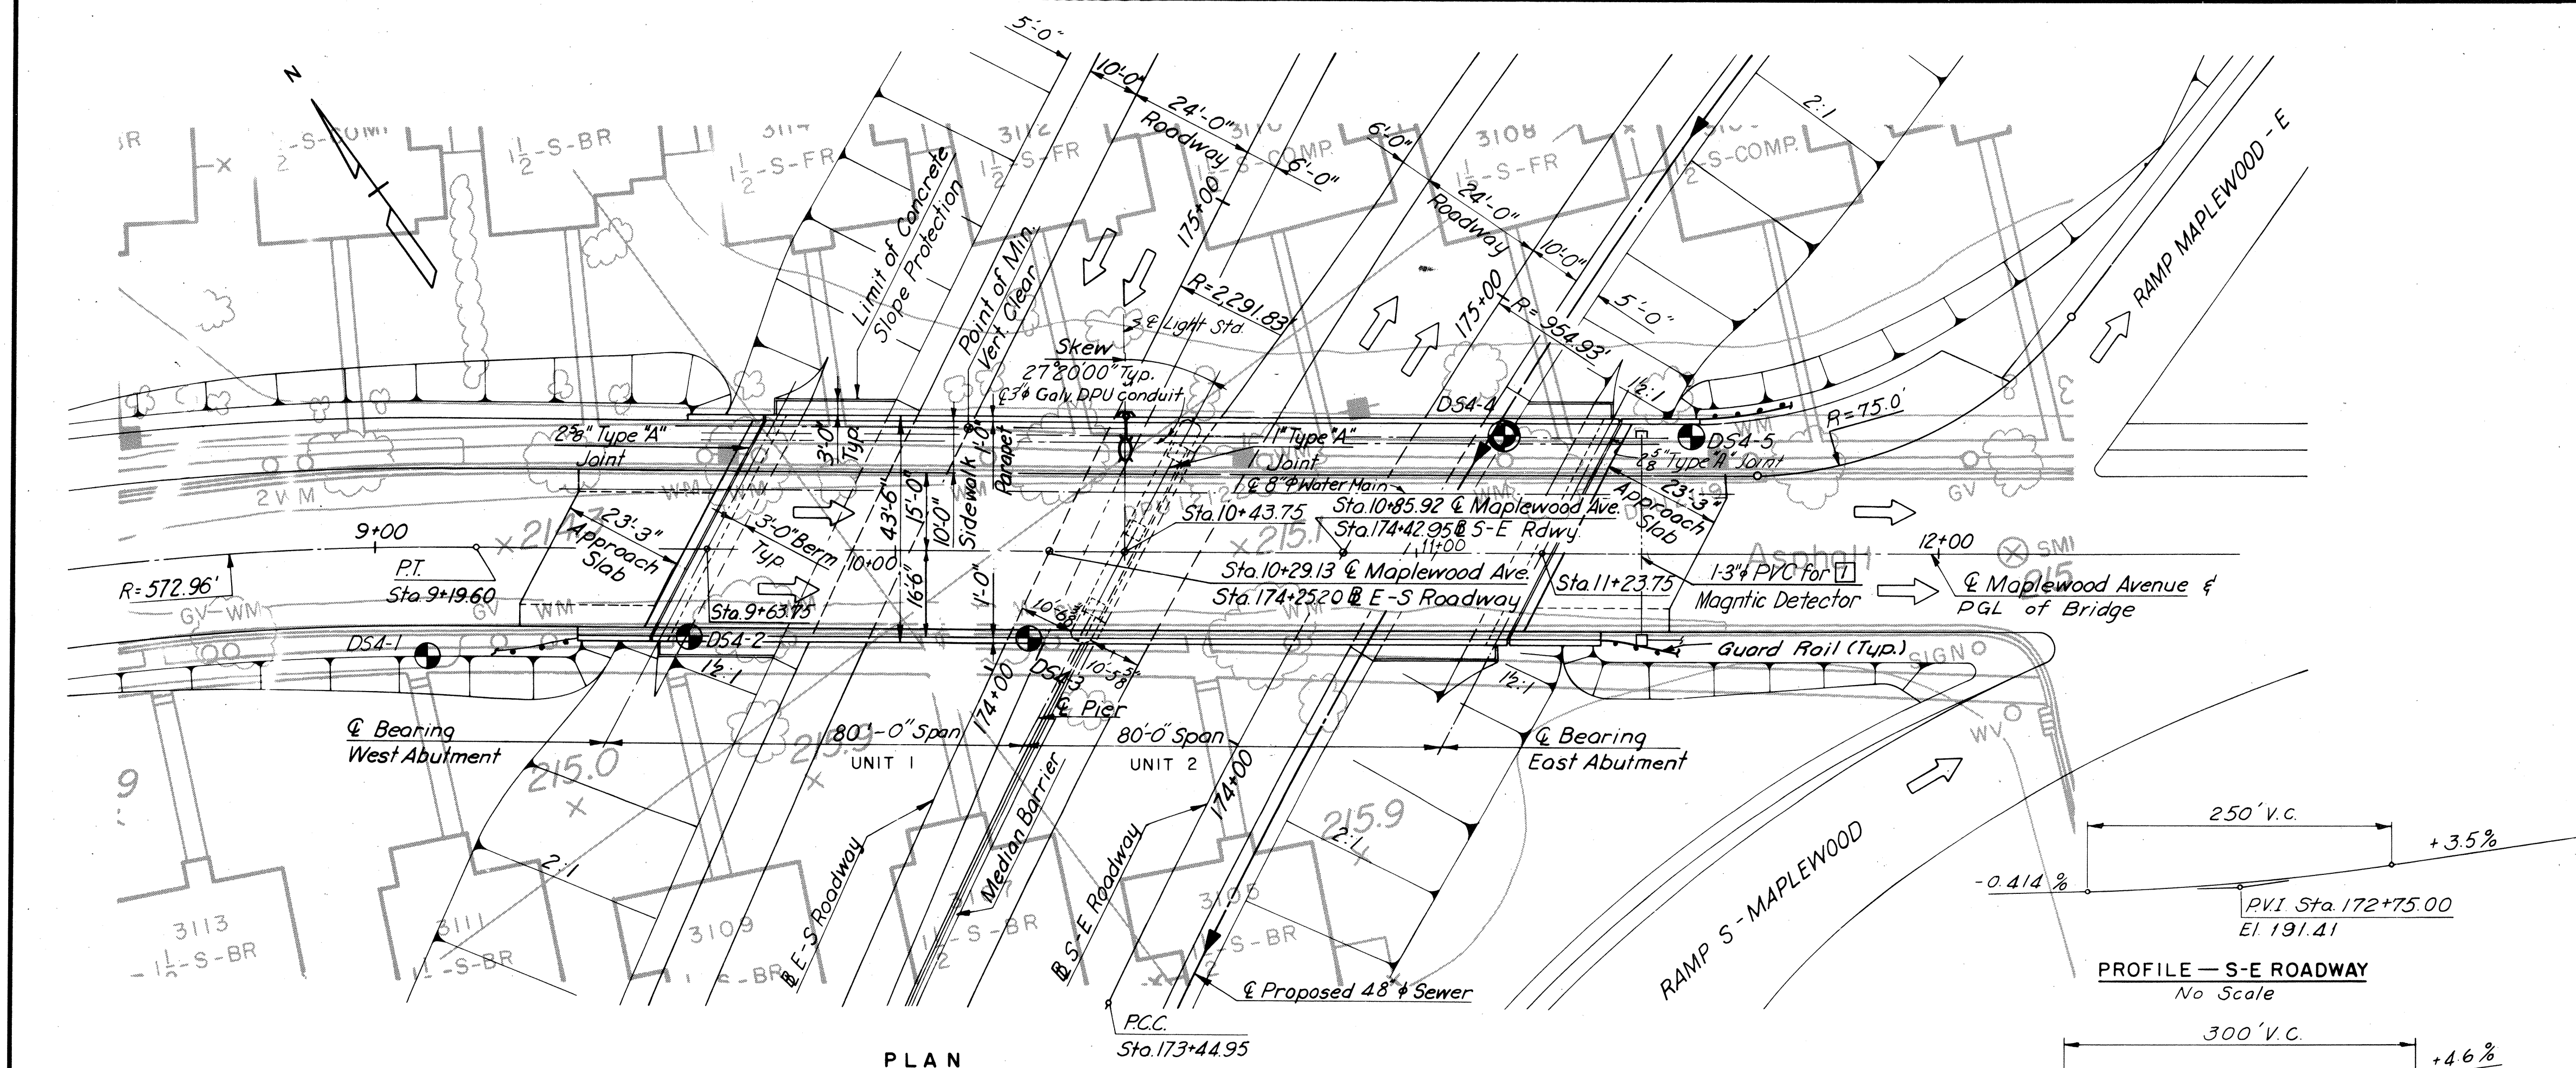

GENERAL NOTES

ROADWAY: 36'-1" Face of rail to edge of sidewalk.

CAPACITY: Dead Load-Includes 15 lbs. per sq. ft. for future wearing surface. Live Loads-HS20-44 loading and B.P.R. modified for military vehicles.

SPECIFICATIONS: GENERAL-Virginia Department of Highway Road and Bridge Specifications, 1970. DESIGN-A.A.S.H.O. Standard Specifications for Highway Bridges, 1969 and 1970-72 Interim Specifications, modified by Special Design Provisions. WELDING-1972 Structural Welding Code of the American Welding Society.

CONTRACT SPECIAL PROVISIONS

Specifications and Contract Special Provisions referred to above are necessary to make these plans complete.

DATUM: CITY OF RICHMOND

TEMPERATURE: The normal temperature referred to on the plan is 60° F. The temperature range for movement is 0° F. to 120° F.

DIMENSIONS: All dimensions are measured horizontally and vertically unless otherwise noted.

EXCAVATION: Excavation below subgrade and cut slope template shall be classified as Structure Excavation. All excavation above these limits shall be classified as Regular Excavation and is not included in the Structural Quantities.

FOUNDATIONS: Footings shall rest on firm material. Found. mat'l. shall be kept dry & special attn. is called to Sec. 401.05 of the Gen. Specs. & to the Contract Special Prov. concerning preparation of found. for ftgs.

CONCRETE NOTES:

Concrete in superstructure shall be Class A4. All other concrete shall be Class A3. All exposed edges and corners shall have a 3/4" chamfer or fillet unless otherwise noted. Care in the method of vibration, the use of low-slump concrete, and/or other means shall be employed to prevent downgrade movement of newly placed slab concrete. (When gradient is over 2%).

Finishing concrete surfaces: See the Standard Architectural Detail Sheets and the Contract Special Provisions for types and details.

All reinforcing steel shall be intermediate grade. All reinforcing bar dimensions on the detailed drawings are to centers of bars unless otherwise noted. Clear distance between reinforcing steel and face of concrete shall be as noted on the plans. All bar laps shall be 30 diameters of the smaller diameter bar unless otherwise noted.

STEEL NOTES: Structural steel shall conform to A.S.T.M. Specification A36 except as noted.


All field connections shall be made with high strength bolts. High strength bolts shall be 3/4" diameter unless otherwise noted and shall conform to A.S.T.M. Specification A-325.

BENCH MARK: C-11. Copper Weld Rod, South side of Maplewood Ave. at Belmont Ave. Elev. 215.37.

Indicates 2 1/2" φ cased hole boring.

Indicates 4" φ cased hole boring.

INDEX	
NO.	DESCRIPTION
1	GENERAL PLAN AND ELEVATION
2	WEST ABUTMENT
3	EAST ABUTMENT
4	ABUTMENT DETAILS
5	PIER
6	FRAMING PLAN
7	DECK PLAN AND CROSS SECTION
8	JOINT DETAILS
9	APPROACH SLAB & SLOPE PROTECTION DETAILS
10	BORING LOGS
S1	STANDARD SHOE DETAILS
S3	STANDARD ALUMINUM RAILING DETAILS (2 RAILS)
S4	STANDARD ELECTRICAL DETAILS
S7 TO S9	STANDARD ARCHITECTURAL DETAILS
S11	STANDARD GAS AND WATER MAIN SUPPORT DETAILS
S13	LIMITS OF EXCAVATION AND BACKFILL

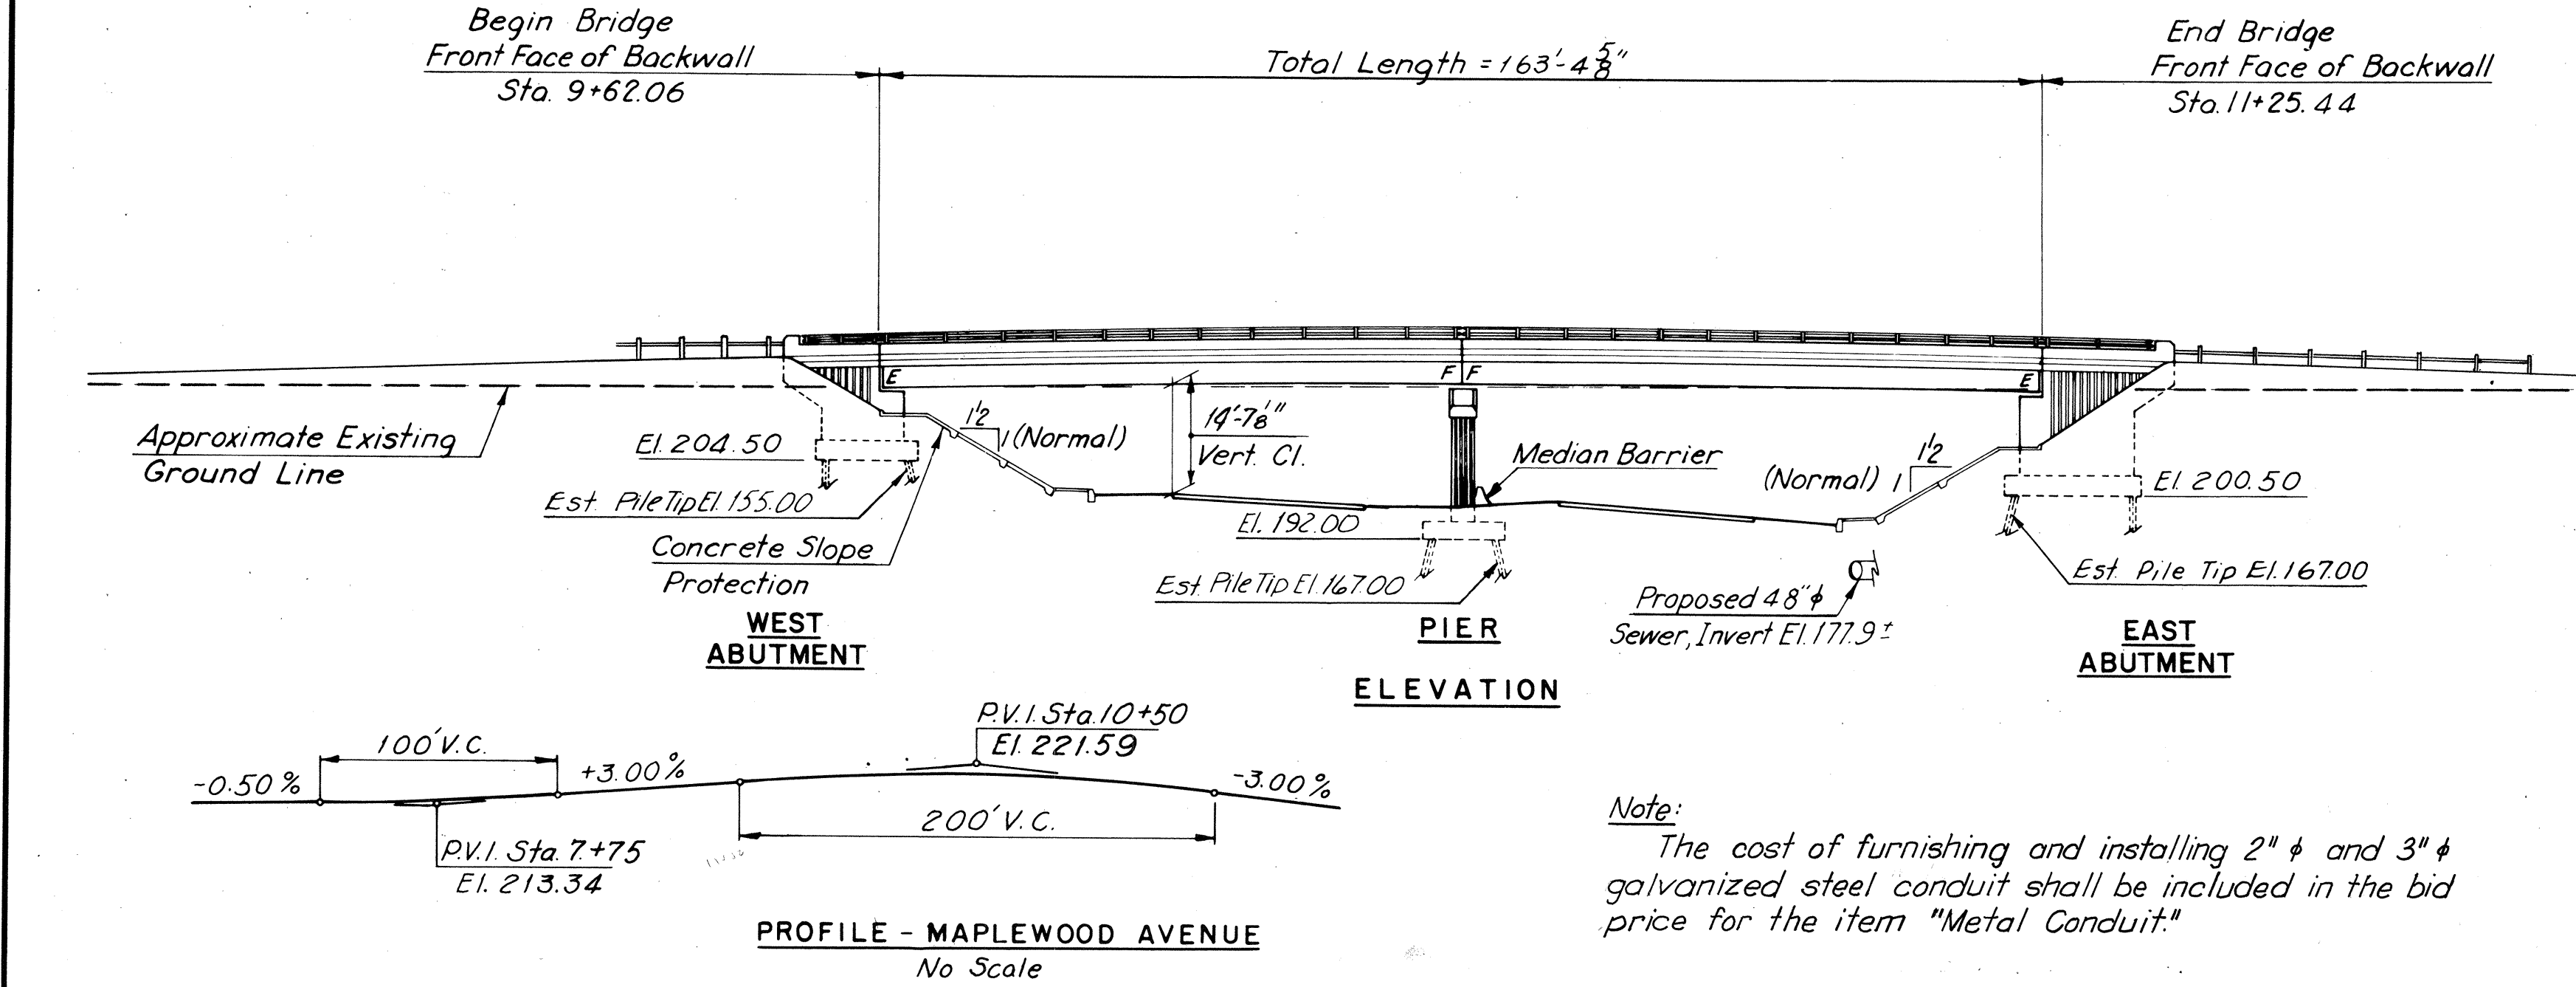

Note:

The cost of furnishing and installing 2" φ and 3" φ galvanized steel conduit shall be included in the bid price for the item "Metal Conduit."

ESTIMATE OF QUANTITIES													
	STRUCTURE EXCAVATION	CONCRETE			STRUCTURAL STEEL	ALUMINUM BR. RAILING (2 RAIL)	POROUS BACKFILL	REINFORCING STEEL	STEEL PILES IOB P 42	CONC. SLAB SLOPE PROT.	ASPHALT DAMPROOFING	UNDERDRAIN 6" φ PIPE	WATER MAIN 8" φ
	C.Y.	CLASS A4 C.Y.	CLASS A3 C.Y.	CLASS A3 APPR. SLABS C.Y.	LBS.	L.F.	C.Y.	LBS.	L.F.	S.Y.	S.Y.	L.F.	L.F.
SUPERSTRUCTURE		276.2			270,749	32.7		53,067					213
WEST ABUTMENT	218.6		143.0			23	12.3	7,081	864.2	150.2	57	57	
EAST ABUTMENT	454.0		215.0			31.4	43	13,320	1,291.4	133.1	107	60	
PIER	131.4		82.7					12,264	480.2				
APPROACH SLABS				86				22,420					
TOTAL	804.0	276.2	440.7	86	270,749	381.4	55.3	108,152	2,635.8	283.3	164	117	1,176

BY	DATE				
MADE	LCC	1-3-68	2	As Built	T.E.M. 9-75
CHECKED	TCY	3-12-68	1	Add PVC Cond.	TEM 1-31-74
IN CHARGE	AGC				

RICHMOND METROPOLITAN AUTHORITY

RICHMOND EXPRESSWAY SYSTEM

DOWNTOWN EXPRESSWAY

BRIDGE NO. 36

MAPLEWOOD AVENUE OVER

DOWNTOWN EXPRESSWAY

GENERAL PLAN AND ELEVATION

HOWARD, NEEDLES, TAMMEN & BERGENDOFF  
consulting engineers  
NEW YORK ALEXANDRIA KANSAS CITY

SCALE: 1"=20' UNLESS NOTED


CONTRACT NO. 7

SHEET NO. 1 OF 10

AS BUILT




RICHMOND EXPRESSWAY SYSTEM			
SECTION	PROJECT	SHEET NO.	TOTAL SHEETS
7	DOWNTOWN EXPRESSWAY	102	

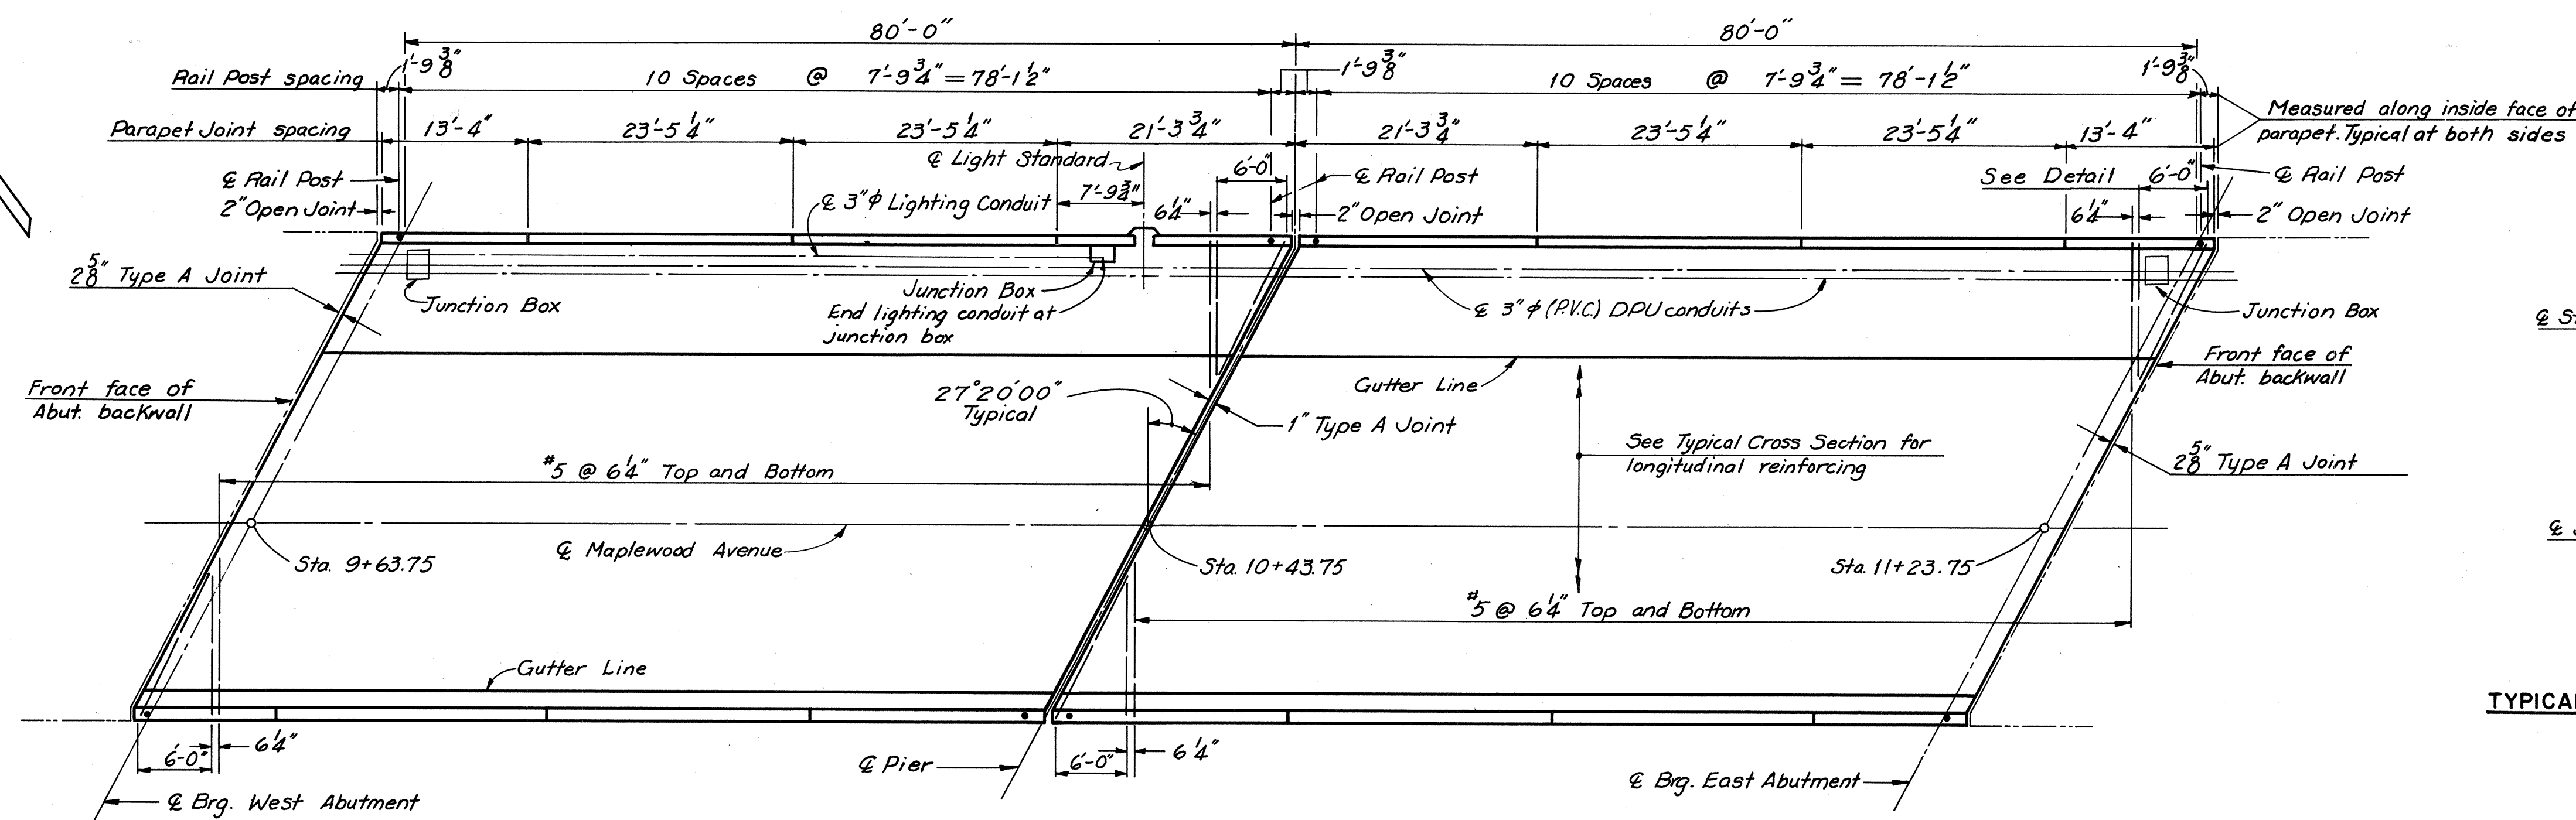


DECK PLAN  
1" = 10'


3 Junction Boxes  
2 each 2'-0" x 1'-11"  
1 each 2'-0" x 1'-1 1/2"

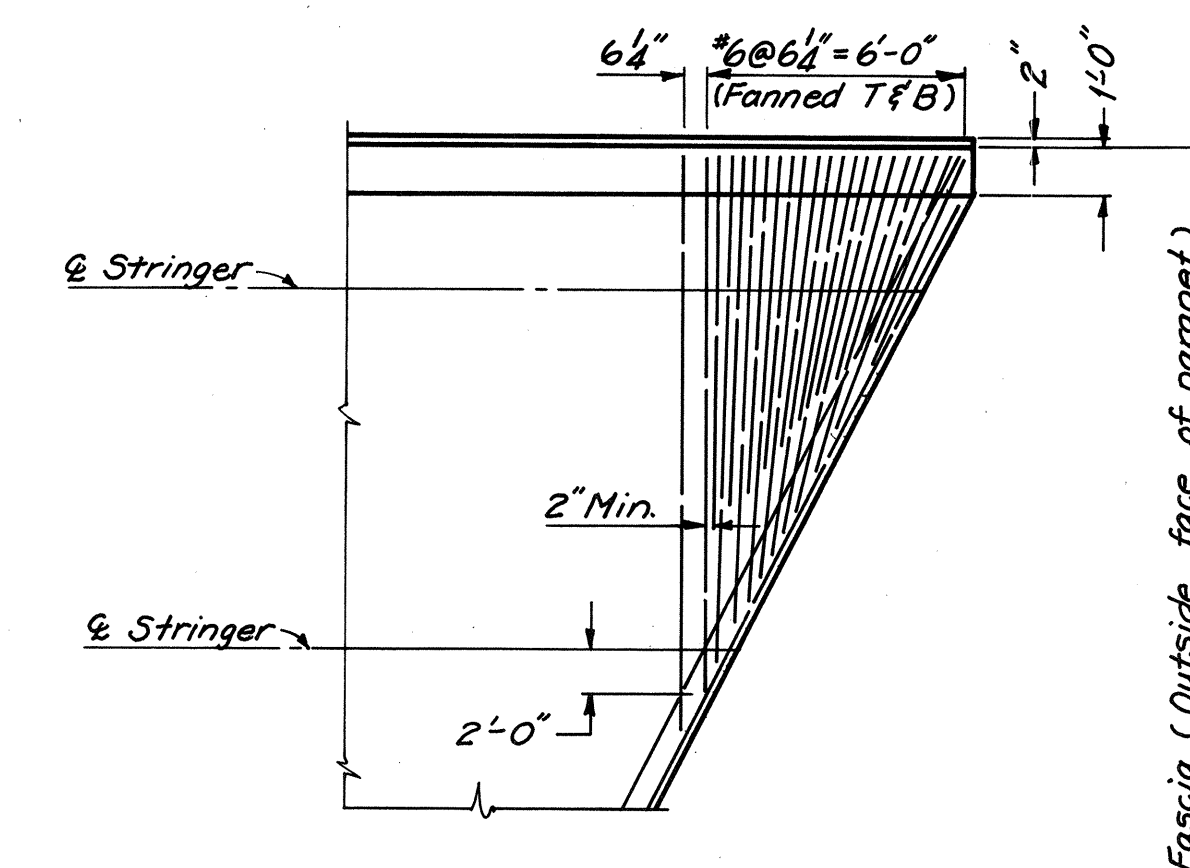

TYPICAL ACUTE CORNER REINFORCING DETAIL  
No Scale

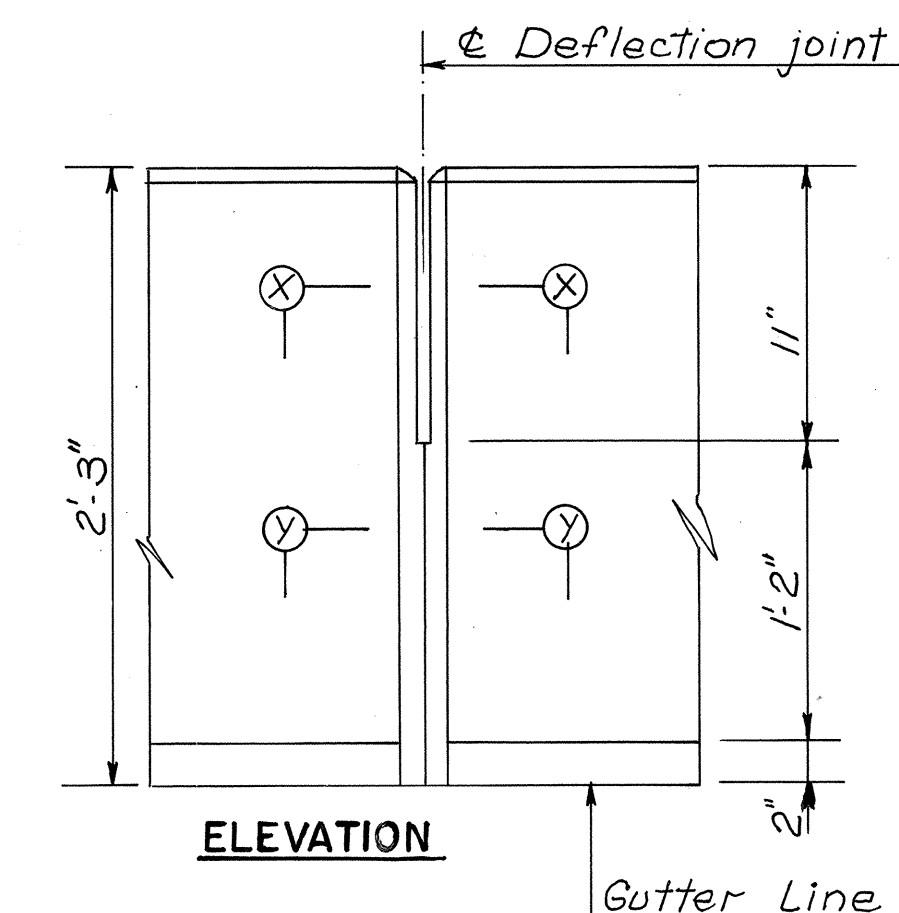


ELEVATION

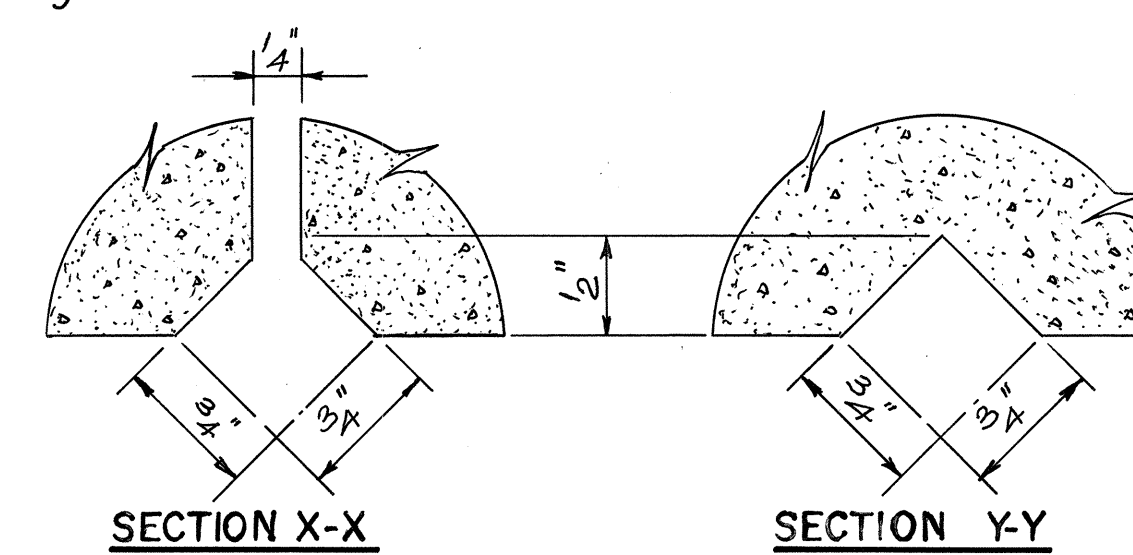

PARAPET DEFLECTION JOINT DETAILS

ROADWAY ELEVATIONS			
LOCATION	ELEV. A	ELEV. B	ELEV. C
Front Face W. Abut. BKwall	218.89	218.93	218.47
1/4 Point	219.32	219.41	219.00
1/2 Point	219.62	219.76	219.40
3/4 Point	219.80	219.98	219.67
Center Line Pier	219.86	220.08	219.82
1/4 Point	219.78	220.06	219.84
1/2 Point	219.59	219.91	219.74
3/4 Point	219.27	219.64	219.51
Front Face E. Abut. BKwall	218.82	219.24	219.16

Notes:  
Minimum splice length for #4 bar is 1'-3" and #5 bar is 1'-7"  
For details of water main support, see Standard Gas and Water Main Support Details Sheet S11.  
For Lighting details and DPU conduit details, see Standard Electrical Details (Bridge Carrying City Street) Sheet S4.

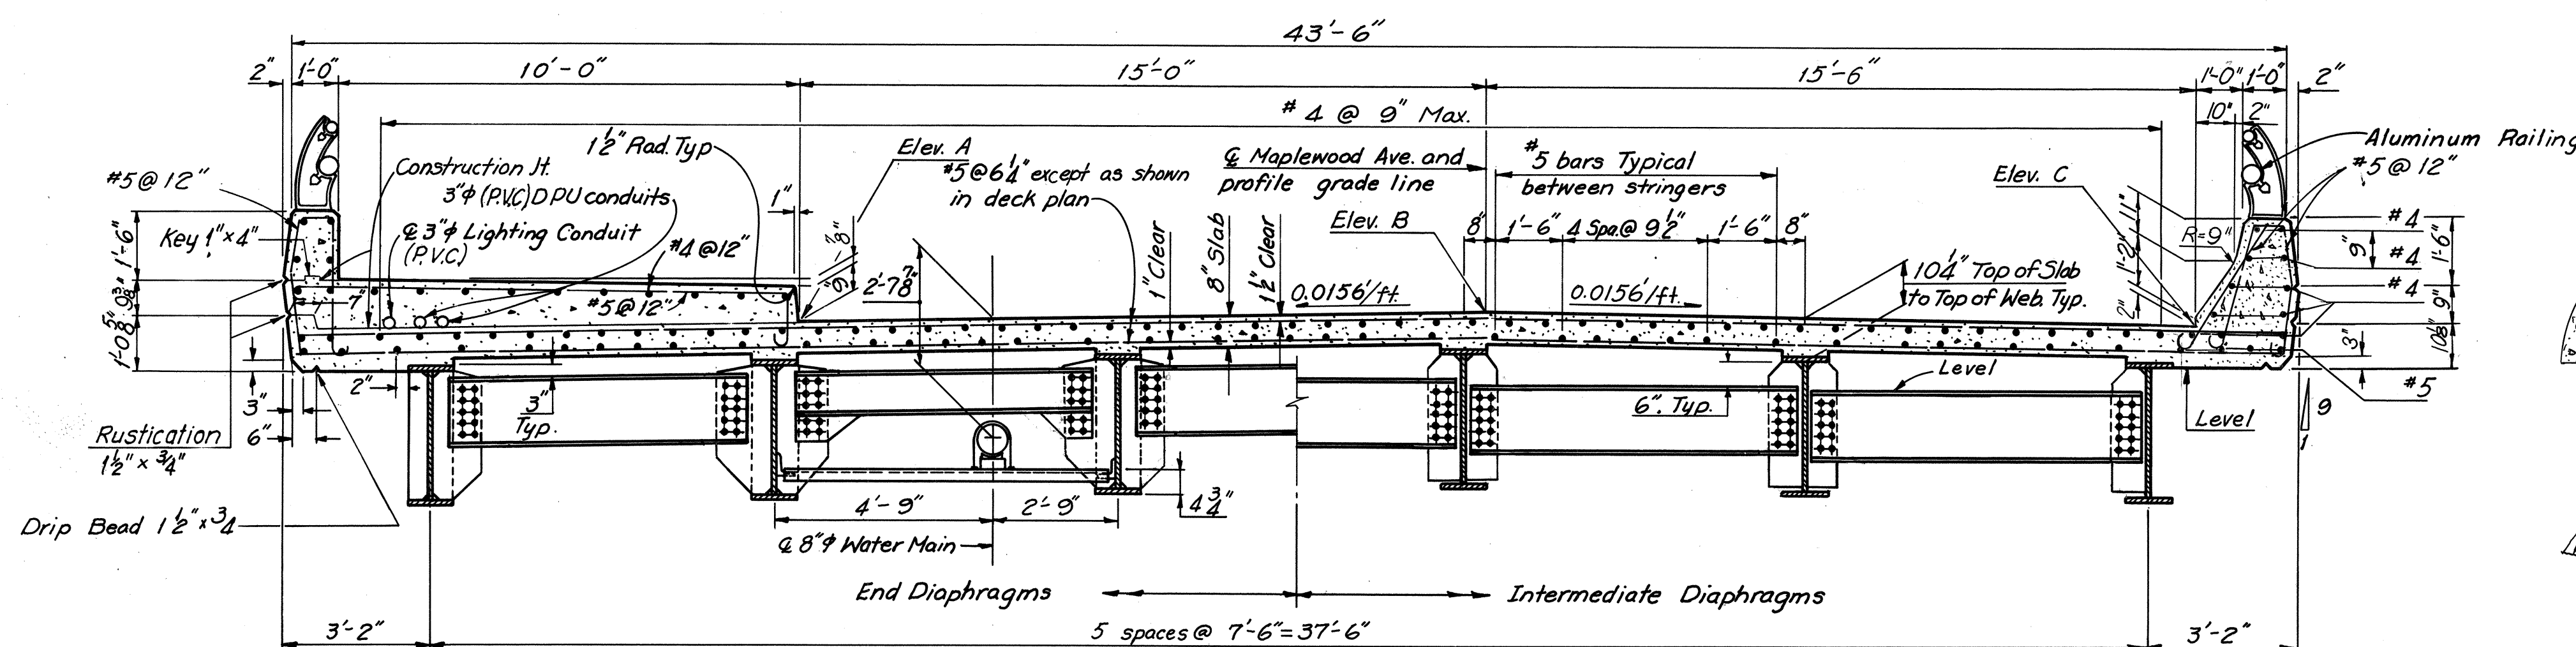

TYPICAL CROSS SECTION  
3/8" = 1'-0"

BY	DATE	NO.	REVISION	BY	DATE
MADE	LCC 11-14-67	2	As Built	TEM	9-75
CHECKED	Q.M. 2-9-68	1	PARAPET JOINT ADDED	TEM	7-74
IN CHARGE	R. G. C.				

RICHMOND METROPOLITAN AUTHORITY  
RICHMOND EXPRESSWAY SYSTEM  
DOWNTOWN EXPRESSWAY

BRIDGE NO. 36  
MAPLEWOOD AVENUE OVER  
DOWNTOWN EXPRESSWAY

DECK PLAN AND CROSS SECTION

HOWARD, NEEDLES, TAMMEN & BERGENDOFF  
consulting engineers  
NEW YORK ALEXANDRIA KANSAS CITY  
SCALE: As Noted  
CONTRACT NO.: 7  
SHEET NO. 7 OF 10

AS BUILT



# **Bridge 46**

**(South Allen Street  
Over Downtown Expressway {Rte. 195})**

**Record Set Plans**














# **Bridge 47**


**(South Randolph Street  
Over Downtown Expressway {Rte. 195})**

**Record Set Plans**

RICHMOND EXPRESSWAY SYSTEM			
SECTION	PROJECT	SHEET NO.	TOTAL SHEETS
8	DOWNTOWN EXPRESSWAY	184	

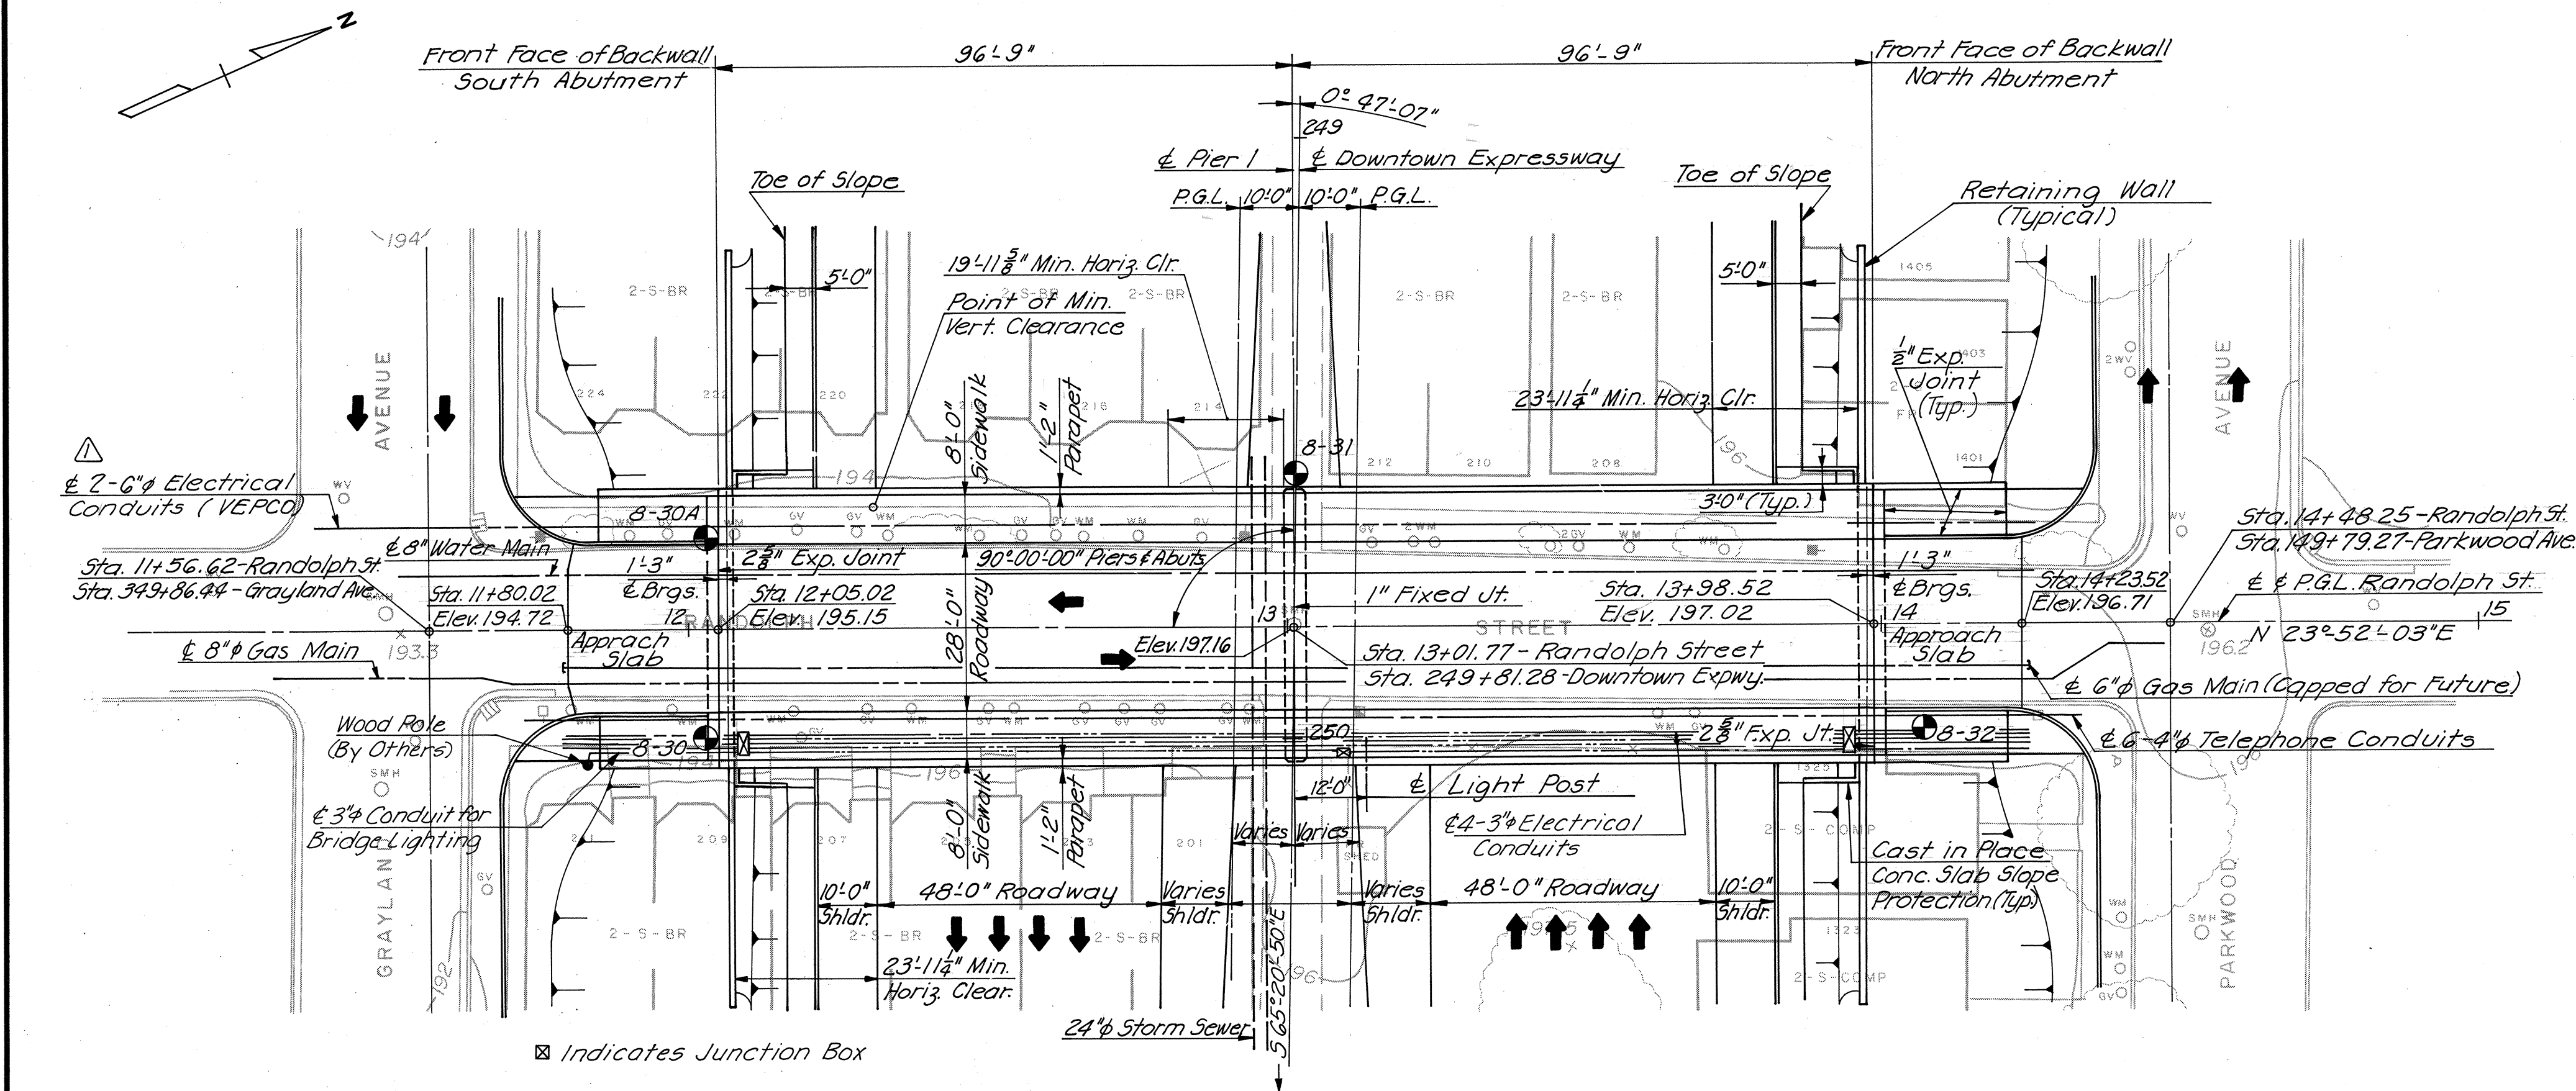

PLAN

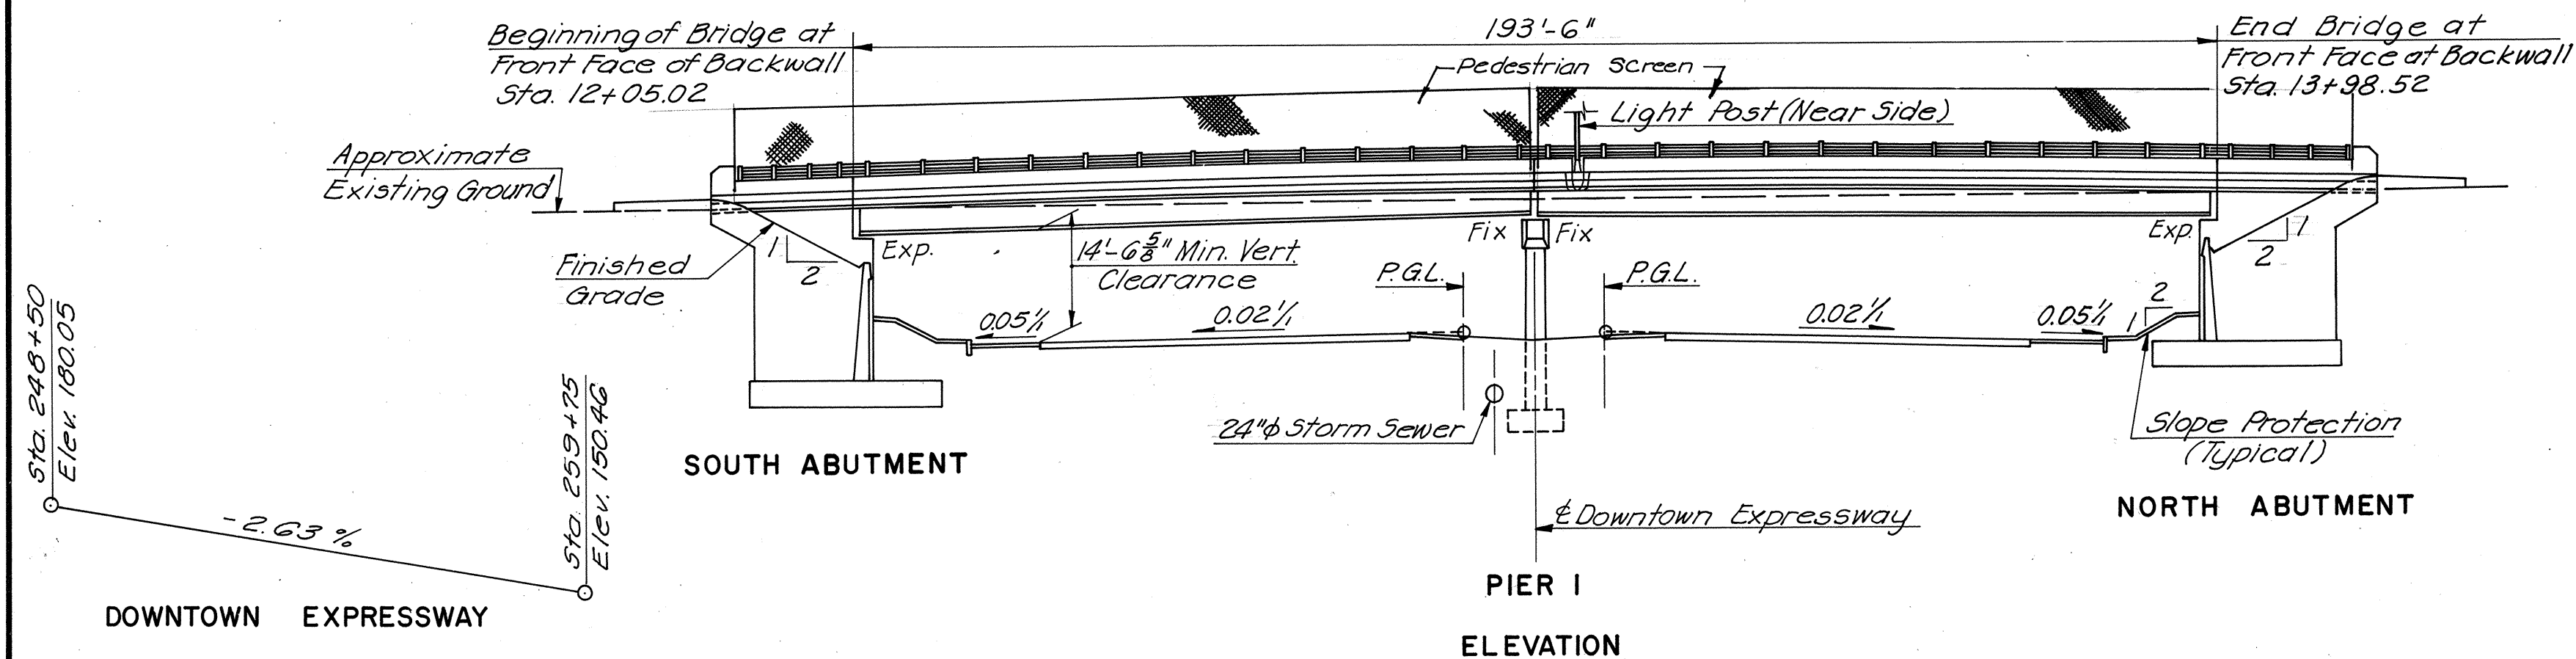

ELEVATION

NOTES:  
Top of Pavement Elevations at ends of deck along P.G.L. are given on plan; Remaining pavement elevations are given on Sheet 10.  
⊙ Indicates 2 1/2" Cased Hole Boring.

INDEX	
No.	DESCRIPTION
1	General Plan and Elevation
2	South Abutment
3	North Abutment
4	Retaining Wall Details-North & South Abut's
5	Pier Details
6	Framing Plan
7	Cross Section and Utility Details
8	Deck Plan and Joint Details
9	Approach Slab & Slope Protection Details
10	Boring Logs
11	Standard Shoe Details
12	Standard Aluminum Railing Details
13	Standard Electrical Details
14	Standard Architectural Details
15	Standard Elect. and Tele. Cond. Details
16	Standard Utility Support details @ Abutment

ESTIMATED QUANTITIES																			
	STRUCTURE EXCAVATION	CONCRETE CLASS A4	CONCRETE CLASS A3	REINFORCING STEEL	STRUCTURAL STEEL	ALUMINUM BRIDGE RAILING	CONC. SLAB SLOPE PROTECTION	ASPHALT DAMP- PROOFING	6-INCH PIPE UNDERDRAIN	POROUS BACKFILL	STONE BEDDING	GAS MAIN 8"Ø	GAS MAIN 6"Ø	WATER MAIN 8"Ø	CONDUIT 6"Ø VEPCO	CONDUIT 4"Ø TELE.	PVC CONDUIT 3"Ø	METAL CONDUIT 2"Ø	PEDESTRIAN SCREEN
	C.Y.	C.Y.	C.Y.	LBS.	LBS.	L.F.	S.Y.	S.Y.	L.F.	C.Y.	TON	L.F.	L.F.	L.F.	L.F.	L.F.	L.F.	L.F.	L.F.
Superstructure		365.56		70,753	334,842.8	462						245.5	245.5	247	483.1	1170	1225	4	462
South Abutment	1304.9		516.27	34,863			82	225	123	87.5	52.47								6
Pier 1	315.4		90.36	18,495							23.06								
North Abutment	950.7		389.44	28,117			82	216	124	67.5	38.57								6
Approach Slabs			78.3	16,951															
Total	2571	365.56	1074.37	171,179	334,842.8	462	164	441	247	155	114.10	245.5	245.5	247	483.1	1170	1225	4	474

RANDOLPH STREET PROFILE DATA									
MADE	W.D.U.	8-67	AS BUILT	H.M.W.					
CHECKED	W.E.O.	11-67	REV. NO. & QUANTITY	DGT	11/27/74				
IN CHARGE	W.E.O.		REVISION	BY	DATE				

**GENERAL NOTES:**  
ROADWAY: One 28'-0" Clear roadway. Two 8'-0" sidewalks.  
CAPACITY: Dead Load-Includes 15lbs. per sq. ft. for future wearing surface.  
Live Loads - HS20-44 loading and B.P.R. modified for military vehicles.

**SPECIFICATIONS:**  
GENERAL - Virginia Department of Highway Road and Bridge Specifications 1970  
DESIGN - AASHTO Standard Specifications for Highway Bridges, 1961 modified by Special Design Provisions.  
WELDING - 1969 Standard Specifications for welded Highway and Railway Bridges of the American Welding Society.

**CONTRACT SPECIAL PROVISIONS:**  
Specifications and Contract Special Provisions referred to above are necessary to make these plans complete.

**DATUM:** CITY OF RICHMOND

**TEMPERATURE:** The normal temperature referred to on the plan is 60°F. The temperature range for movement is 0°F to 120°F.

**DIMENSIONS:** All dimensions are measured horizontally and vertically unless otherwise noted.

**EXCAVATION:** Excavation below subgrade and cut slope template shall be classified as Structure Excavation. All excavation above these limits shall be classified as Regular Excavation and is not included in the Structural Quantities.

**FOUNDATIONS:** Footings shall rest on firm material. Foundation material shall be kept dry and special attention is called to section 401.05 of the General Specifications, and to the Contract Special Provisions, concerning preparation of foundations for footings.

**CONCRETE NOTES:**  
Concrete in superstructure shall be Class A4. All other concrete shall be Class A3. All exposed edges and corners shall have a 3/8" chamfer or fillet unless otherwise noted. Care in the method of vibration, the use of low slump concrete and/or other means shall be employed to prevent downgrade movement of newly placed slab concrete. (When gradient is over 2%)  
Finishing concrete surfaces: See the Standard Architectural Detail Sheets and the Contract Special Provisions for types and details.

All reinforcing steel shall conform to ASTM A615 Grade 40. All reinforcing bar dimensions on the detailed drawings are to centers of bars unless otherwise noted. Clear distance between reinforcing steel and face of concrete shall be as noted on the plans. All bar laps shall be 30 diameters of the smaller diameter bar unless otherwise noted.

**STEEL NOTES:** Structural steel shall conform to A.S.T.M. Specification A36 except as noted.  
All field connections shall be made with high strength bolts. High strength bolts shall be 3/4" diameter unless otherwise noted and shall conform to A.S.T.M. Specification A-325.

**BENCH MARK:** C-32. Monument located in walk S.W. corner Idlewood and S. Randolph Sts. Elev. 192.25.

**AS BUILT**


**RICHMOND METROPOLITAN AUTHORITY  
RICHMOND EXPRESSWAY SYSTEM  
DOWNTOWN EXPRESSWAY**

**STRUCTURE B 47  
RANDOLPH STREET OVER  
DOWNTOWN EXPRESSWAY  
GENERAL PLAN AND ELEVATION**

AMERICAN ENGINEERS  
Richmond, Virginia  
HOWARD, NEEDLES, TAMMEN & BERGENDOFF  
General Consultants

SCALE: 1" = 20'  
CONTRACT NO.: 8  
SHEET NO. 1 OF 12



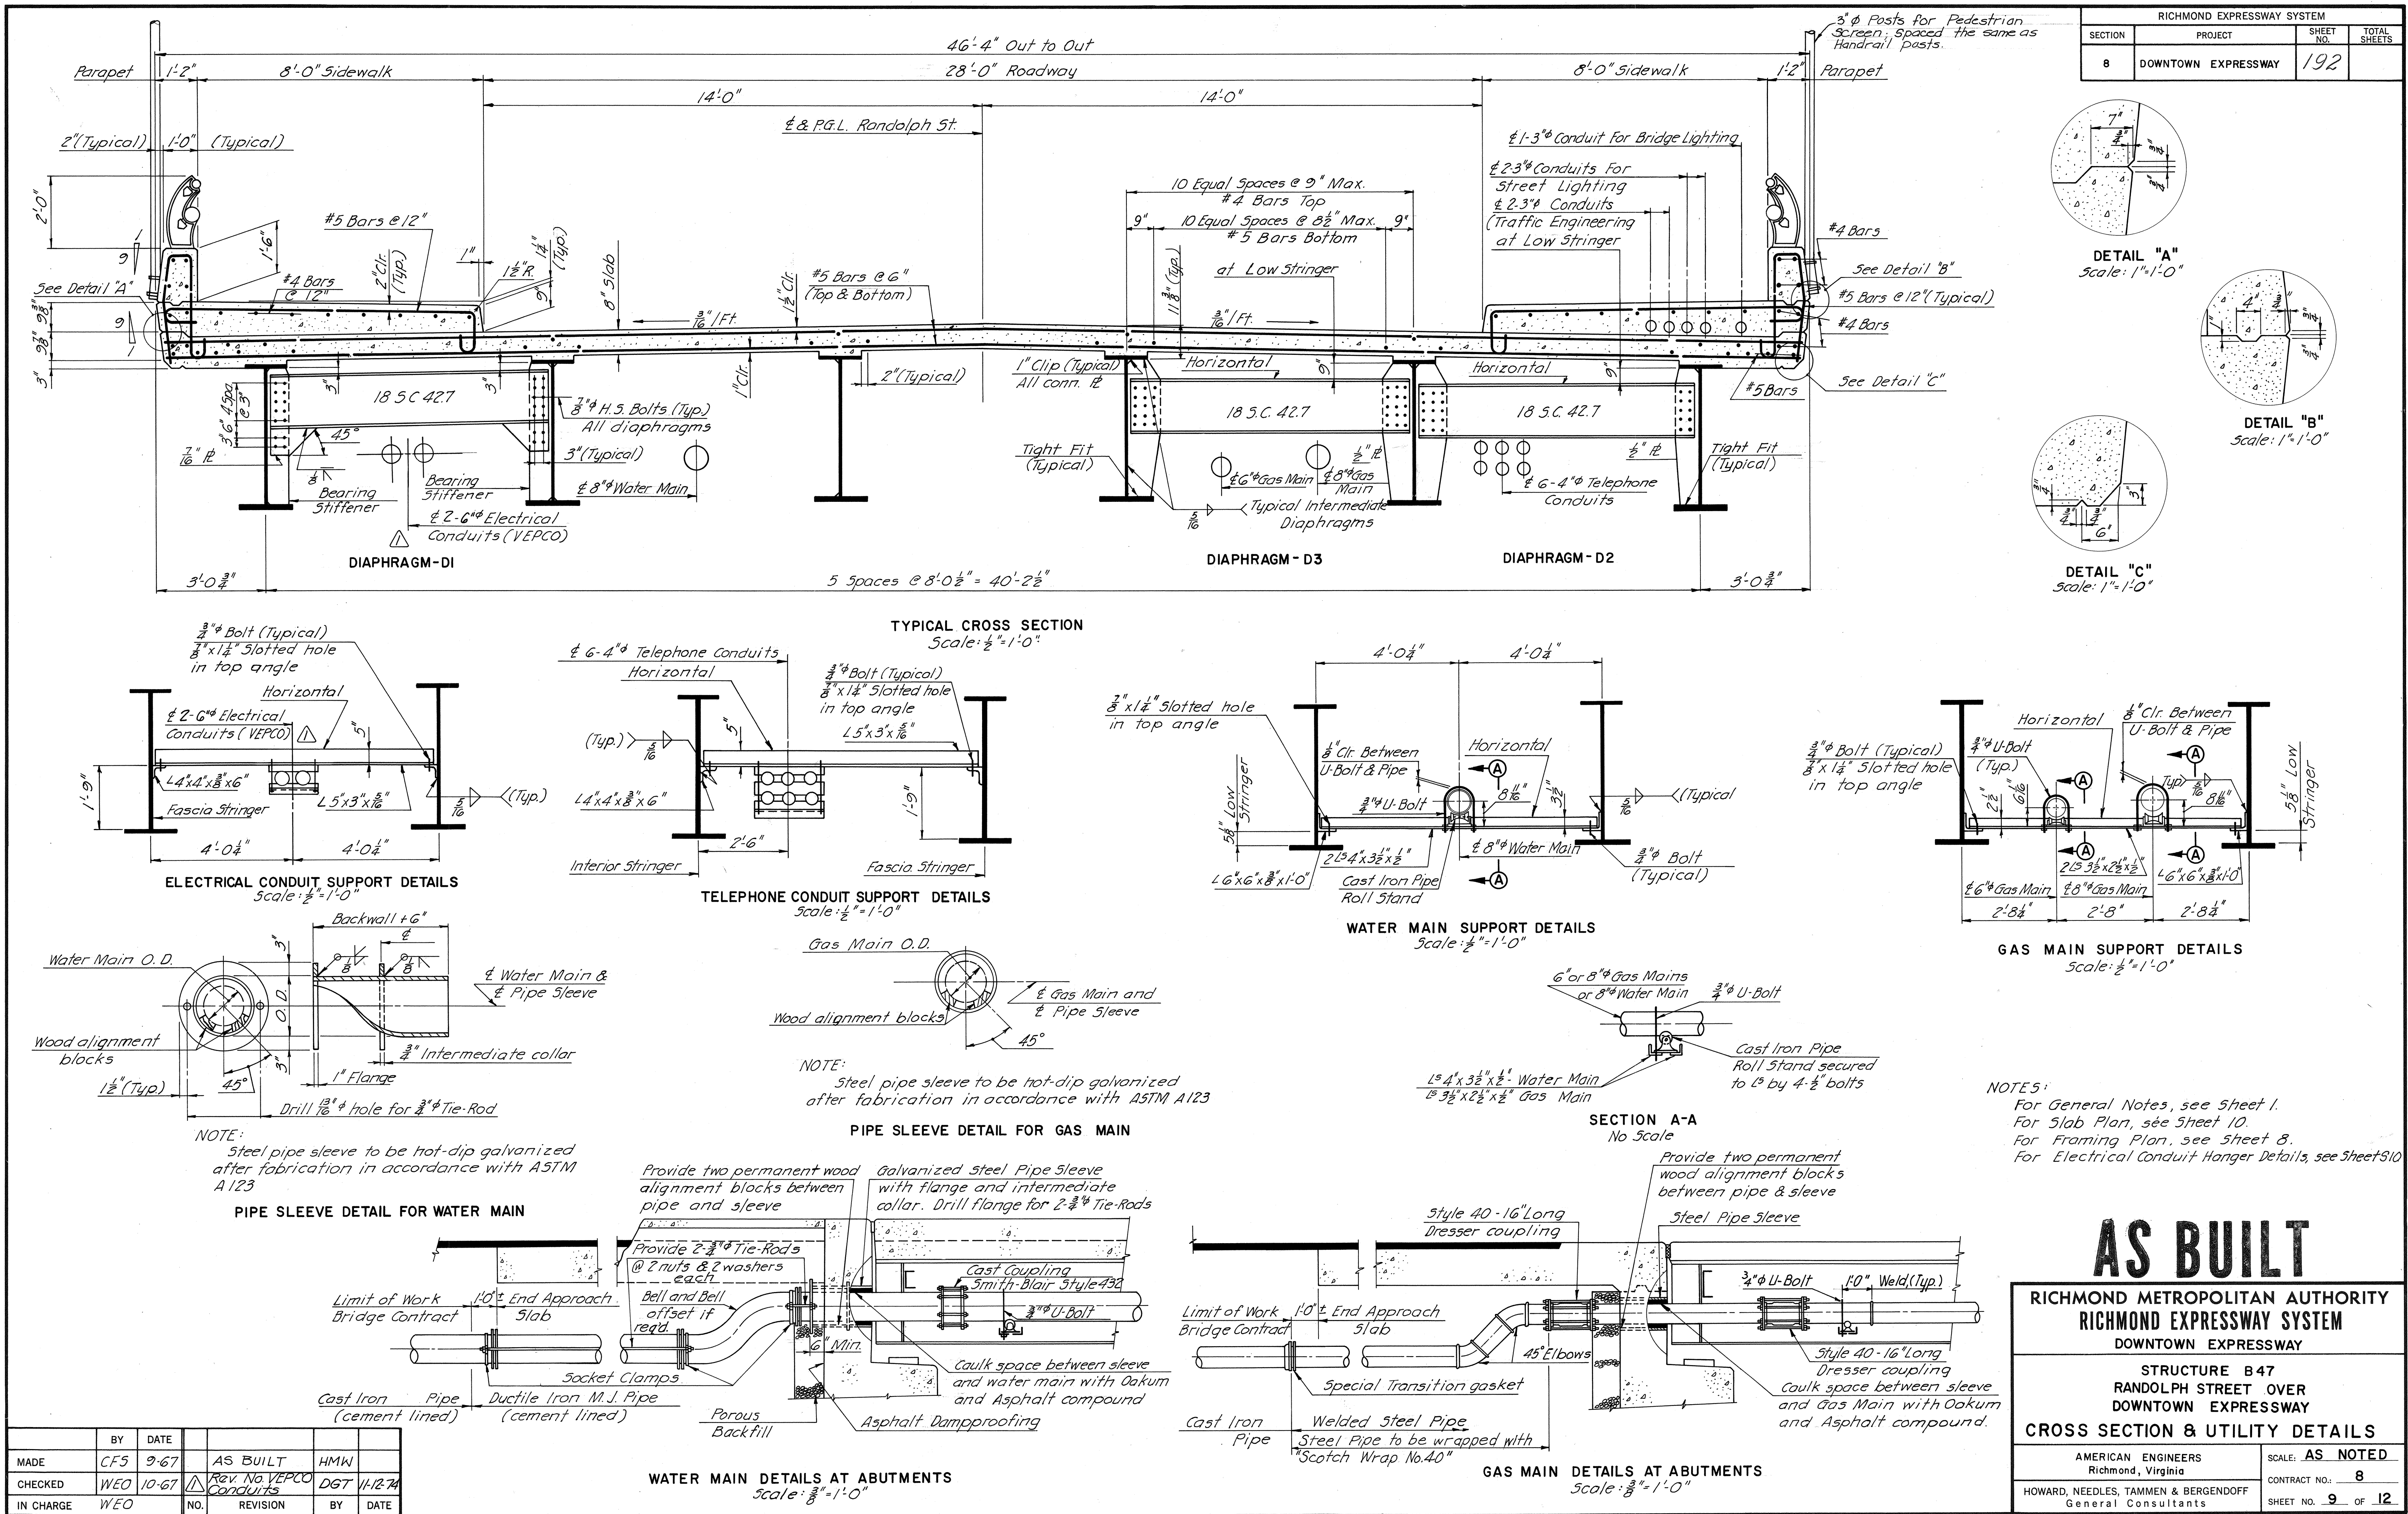




# **Bridge 48**

**(South Harrison Street  
Over Downtown Expressway {Rte. 195})**

**Record Set Plans**



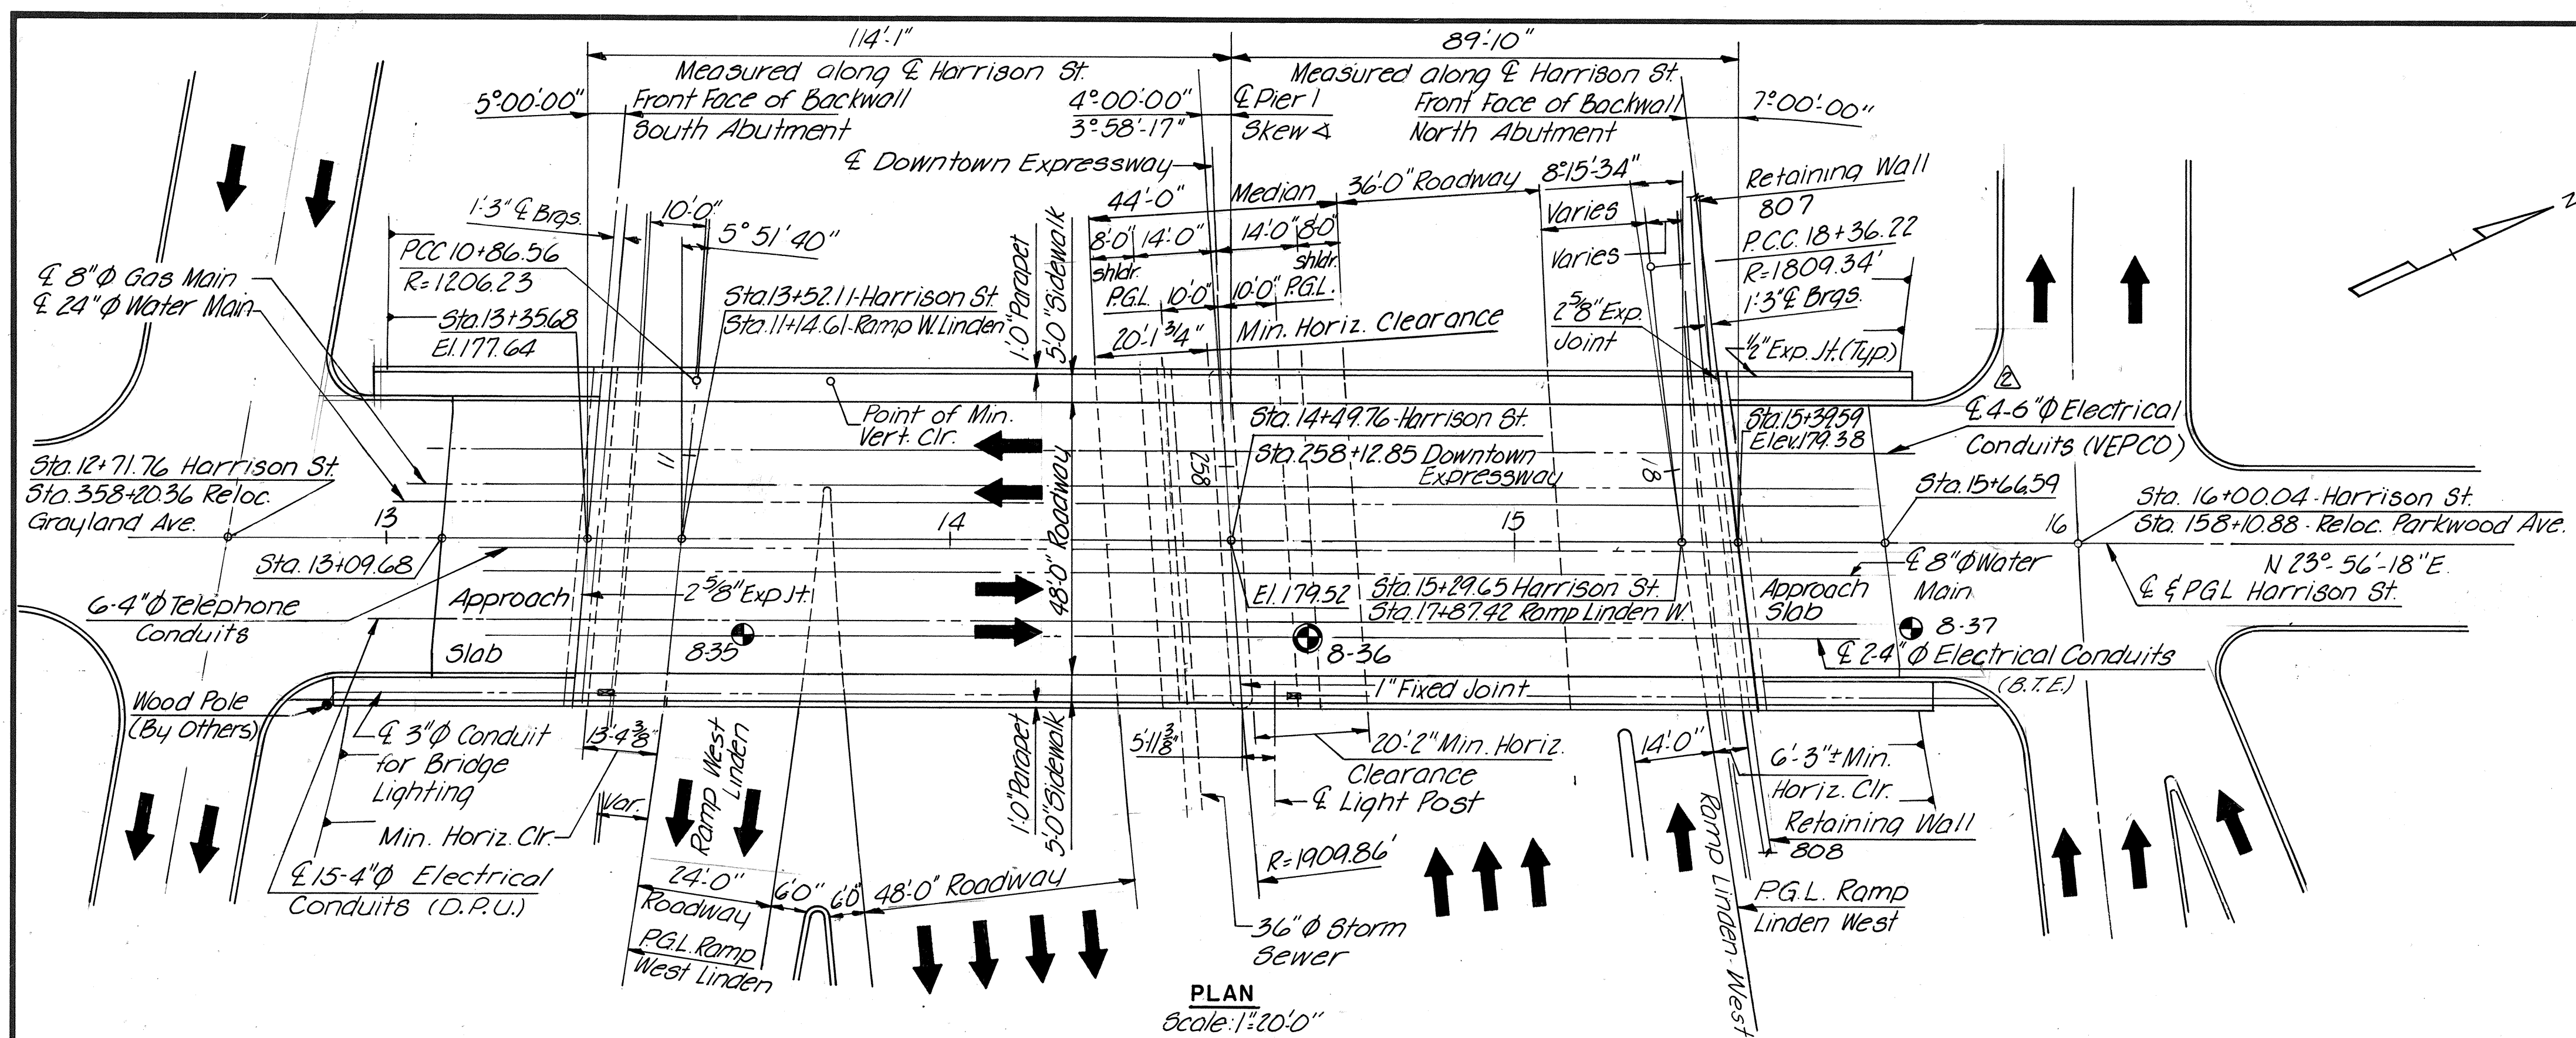

### GENERAL NOTES

**ROADWAY:** One 48'-0" clear roadway. Two 5'-0" sidewalks.

**CAPACITY:** Dead Load - Includes 15 lbs. per sq. foot for future wearing surface.  
Live Load - HS20-44 and B.P.R. modified for military vehicles.

**SPECIFICATIONS:** GENERAL - Virginia Department of Highways Road and Bridge Specifications, 1970.  
DESIGN - A.A.S.H.O. Standard Specifications for Highway Bridges, 1973  
WELDING - 1972 Structural Welding Code of the American Welding Society.

**CONTRACT SPECIAL PROVISIONS**  
Specifications and Contract Special Provisions referred to above are necessary to make these plans complete.

**DATUM:** U.S.C. and G.S. (Sea level, 1929 General Adjustment).

**TEMPERATURE:** The normal temperature referred to on the plans is 60°F. The temperature range for movement is 0°F to 120°F.

**DIMENSIONS:** All dimensions are measured horizontally and vertically unless otherwise noted.

**EXCAVATION:** Excavation below subgrade and cut slope template shall be classified as Structure Excavation. All excavation above these limits shall be classified as Regular Excavation and is not included in the Structural Quantities.

**FOUNDATIONS:** Footings shall rest on firm material. Foundation material shall be kept dry and special attention is called to section 401.05 of the General Specifications, and to the Contract Special Provisions, concerning preparation of foundations for footings.

### CONCRETE NOTES:

Concrete in the superstructure shall be Class A4. All other concrete shall be Class A3. All exposed edges and corners shall have a 3" chamfer or fillet unless otherwise noted. Care in the method of vibration, the use of low slump concrete and/or other means shall be employed to prevent downgrade movement of newly placed slab concrete (when gradient is over 2%).  
Finishing concrete surfaces. See the Standard Architectural Detail Sheets and the Contract Special Provisions for types and details.

All reinforcing steel shall conform to ASTM Specification A615 Grade 40. All reinforcing bar dimensions on the detailed plans are to centers of bars unless otherwise noted. Clear distance between reinforcing steel and face of concrete shall be as noted on the plans. All bar laps shall be 30 diameters of the smaller diameter bar unless otherwise noted.

### STEEL NOTES:

Structural Steel shall conform to ASTM Specification A36 except as noted. All field connections shall be made with high strength bolts. High strength bolts shall be 3" diameter unless otherwise noted and shall conform to ASTM Specification A325.

All shop welded web splices, flange splices and web to flange welds shall be made by the submerged arc process.

### BENCH MARK:

C-34 Monument in walk on the East side of Harrison Street between Parkwood Avenue and Cary Street. Elev. 179.381.

### NOTES:

Top of Pavement Elevations at ends of deck along P.G.L. are given on the plan. Remaining pavement elevations are given on Sheet 11. The cost of furnishing and installing 2" and 3" galvanized steel conduit shall be included in the bid price for the item "Metal Conduit".

Indicates 2 1/2" cased hole boring.

INDEX	SHEET
GENERAL PLAN AND ELEVATION	1
SOUTH ABUTMENT DETAILS	2-4a
NORTH ABUTMENT DETAILS	5-7a
PIER DETAILS	8
FRAMING PLAN	9
STRINGER DETAILS	10
DECK PLAN AND CROSS SECTION	11
JOINT DETAILS	12
UTILITY DETAILS	13
APPROACH SLAB DETAILS	14
BORING LOGS	15
STANDARD SHOE DETAILS	S1
STANDARD ALUMINUM RAILING DETAILS	S3
STANDARD ELECTRICAL DETAILS	S4
STANDARD ARCHITECTURAL DETAILS	S7-S8
STANDARD CONDUIT INSTALLATION DETAILS	S10
STANDARD UTILITY DETAILS	S11
LIMITS OF EXCAVATION AND BACKFILL	S13

**AS BUILT**

DESIGNED	PRM	10/73	3	AS BUILT	HMW	129-74
DRAWN	RPC	11/73	2	Revised	DGT	11/73
CHECKED	DER	11/73	1	No. Abut. 1 Re. St. Qty.	PRM	12-73
IN CHARGE	L.J.H.	NO.	REVISION	BY	DATE	

ESTIMATE OF QUANTITIES														
STRUCTURE EXCAVATION	CONCRETE			STRUCTURAL STEEL	REINFORCING STEEL	POROUS BACKFILL	ALUMINUM BR. RAILING (2 RAIL) L.F.	ASPHALT DAMPROOFING S.Y.	UNDERDRAIN 6" Ø PIPE L.F.	WATERMAIN 24" Ø PIPE L.F.	WATERMAIN 8" Ø PIPE L.F.	GAS MAIN 8" Ø PIPE L.F.	CONDUITS (VEPCO) 6" Ø L.F.	CONDUIT 4" Ø TELEPHONE L.F.
	CLASS A4 C.Y.	CLASS A3 C.Y.	CLASS A3 APPR. SLABS C.Y.											
SUPERSTRUCTURE	437.12			470,378	92,871		408			249	259.5	255	1,024	1556
SOUTH ABUTMENT	1250	512.94			51,897	127.1	75	280	144					
NORTH ABUTMENT	2100	626.94			91,112	132	58	300	63					
PIER I	606	282.20			31,883									
APPROACH SLABS			116.12		40,377									
TOTAL	3956	1422.08	116.12	470,378	308,140	259.1	541	580	207	249	259.5	255	1,024	1556

**RICHMOND METROPOLITAN AUTHORITY**  
**RICHMOND EXPRESSWAY SYSTEM**  
DOWNTOWN EXPRESSWAY

STRUCTURE B 48  
HARRISON STREET OVER  
DOWNTOWN EXPRESSWAY  
GENERAL PLAN AND ELEVATION


SCALE *AS SHOWN*  
DATE *Nov. 29, 1973*

SHEET *1* OF *15*

HOWARD, NEEDLES, TAMMEN & BERGENDOFF  
CONSULTING ENGINEERS  
Alexandria, Virginia

**HNTB**



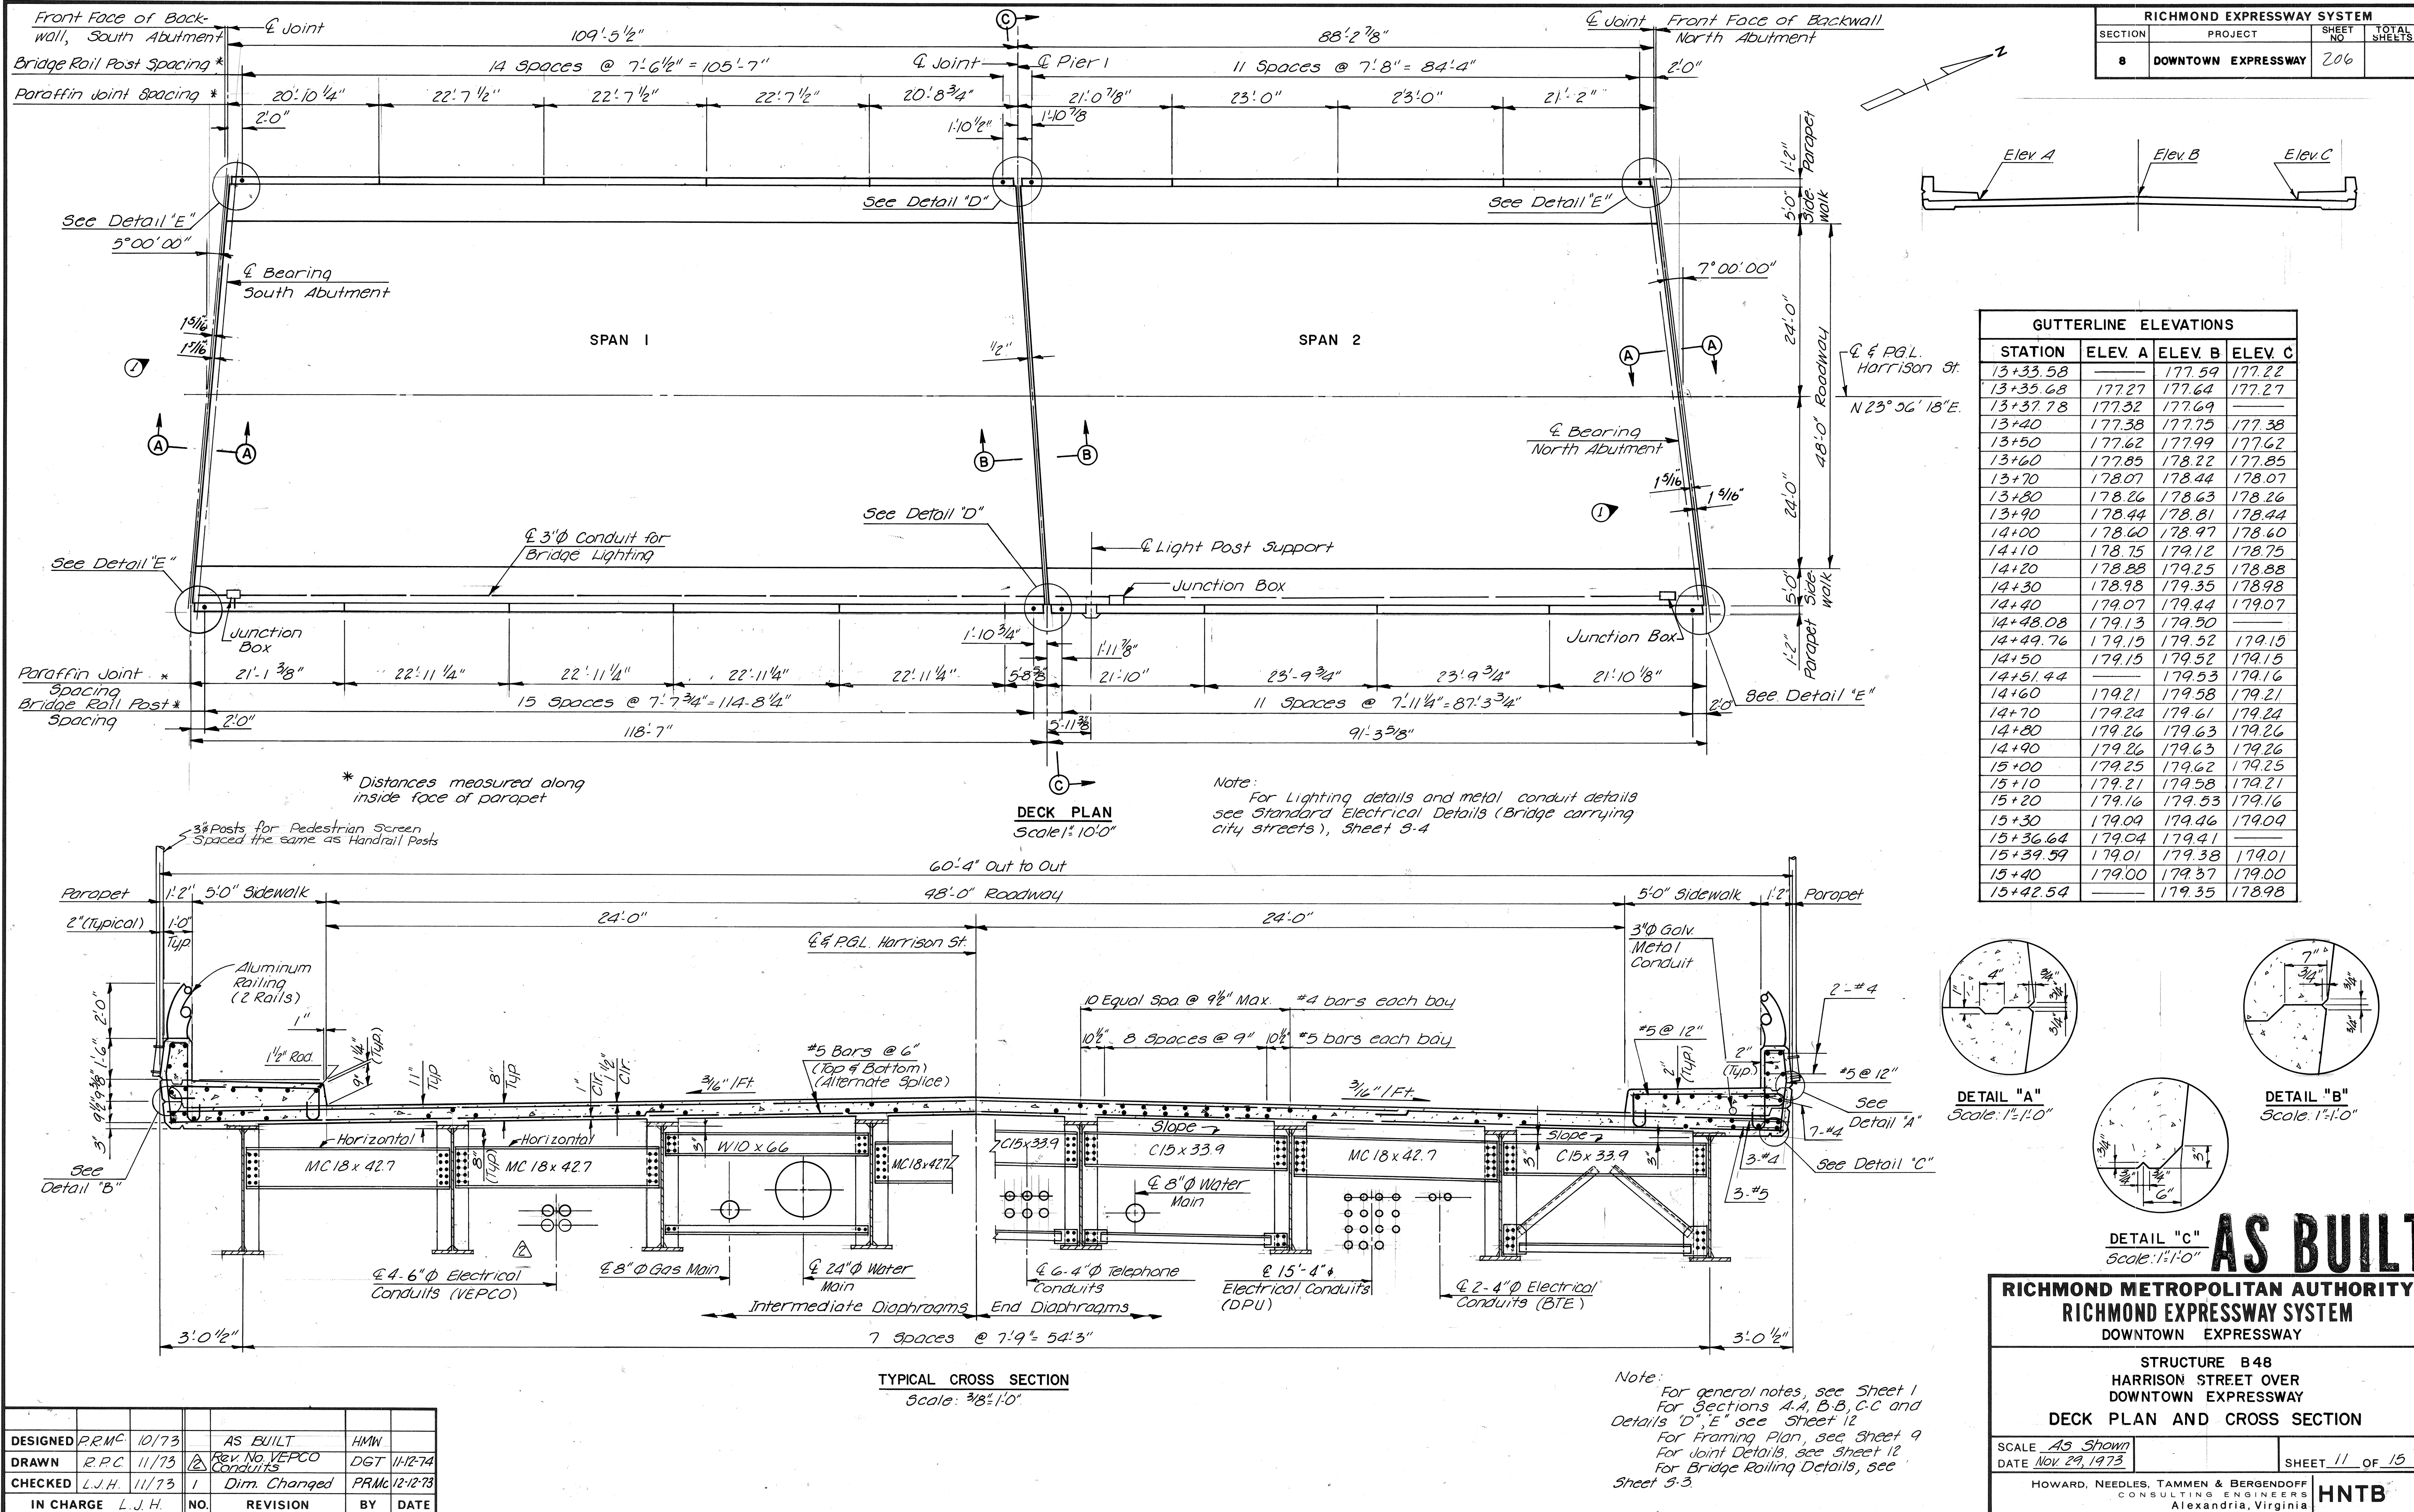





# **Bridge 49**

**(South Cherry Street  
Over Downtown Expressway {Rte. 195})**

**Record Set Plans**

RICHMOND EXPRESSWAY SYSTEM			
SECTION	PROJECT	SHEET NO.	TOTAL SHEETS
8	DOWNTOWN EXPRESSWAY	211	

**GENERAL NOTES:**  
**ROADWAY:** One 30'-0" Clear roadway. Two 8'-0" sidewalks.  
**CAPACITY:** Dead Load - Includes 15 lbs. per sq. foot for future wearing surface.  
 Live Load - HS 20-44 loading and B.P.R. modified for military vehicles.

**SPECIFICATIONS:**  
**GENERAL** - Virginia Department of Highway Road and Bridge Specifications 1970  
**DESIGN** - A.A.S.H.O. Standard Specifications for Highway Bridges, 1961 modified by Special Design Provisions.  
**WELDING** - 1963 Standard Specifications for welded Highway and Railway Bridge of the American Welding Society.

**CONTRACT SPECIAL PROVISIONS:**  
 Specifications and Contract Special Provisions referred to above are necessary to make these plans complete.

**DATUM:** CITY OF RICHMOND  
**TEMPERATURE:** The normal temperature referred to on the plan is 60°F. The temperature range for movement is 0°F. to 120°F.

**DIMENSIONS:** All dimensions are measured horizontally and vertically unless otherwise noted.

**EXCAVATION:** Excavation below subgrade and cut slope template shall be classified as Structure Excavation. All excavation above these limits shall be classified as Regular Excavation and is not included in the Structural Quantities.

**FOUNDATIONS:** Footings shall rest on firm material. Foundation material shall be kept dry and special attention is called to section 40105 of the General Specifications, and to the Contract Special Provisions, concerning preparation of foundations for footings.

**CONCRETE NOTES:**  
 Concrete in superstructure shall be Class A4. All other concrete shall be Class A3. All exposed edges and corners shall have a 3/4" chamfer or fillet unless otherwise noted. Care in the method of vibration, the use of low slump concrete and/or other means shall be employed to prevent downgrade movement of newly placed slab concrete. (When gradient is over 2%)  
 Finishing concrete surfaces: See the Standard Architectural Detail Sheets and the Contract Special Provisions for types and details.

All reinforcing steel shall conform to ASTM. A615 Grade 40. All reinforcing bar dimensions on the detailed drawings are to centers of bars unless otherwise noted. Clear distance between reinforcing steel and face of concrete shall be as noted on the plans. All bar laps shall be 30 diameters of the smaller diameter bar unless otherwise noted.


**STEEL NOTES:** Structural steel shall conform to ASTM. Specification A36 except as noted.  
 All field connections shall be made with high strength bolts. High strength bolts shall be 3/4" diameter unless otherwise noted and shall conform to ASTM. Specifications A325.

**BENCH MARK:** C-36 Monument in sidewalk, N.W. Corner Idlewood and South Cherry. Elev. 173.57.


INDEX	
No.	DESCRIPTION
1	General Plan and Elevation
2/3	South Abutment
4	North Abutment
5	Typical Sections and Details - No. 1 So. Abuts.
6	Pier Details
7	Framing Plan
8	Cross Section and Utility Details
9	Deck Plan and Joint Details.
10	Approach Slabs
11	Boring Logs
51	Standard Shoe Details
53	Standard Aluminum Railing Details (2-Rail)
54	Standard Electrical Details
55a	Standard Architectural Details
510	Standard Elect. and Tele. Cond. Details
511	Standard Utility Support details @ Abutment

**NOTES:**  
 Top of Pavement Elevations at ends of deck along P.G.L. are given on plan; Remaining pavement elevations are given on Sheet 9.


⊙ Indicates 2 1/2" φ Cased Hole Boring.

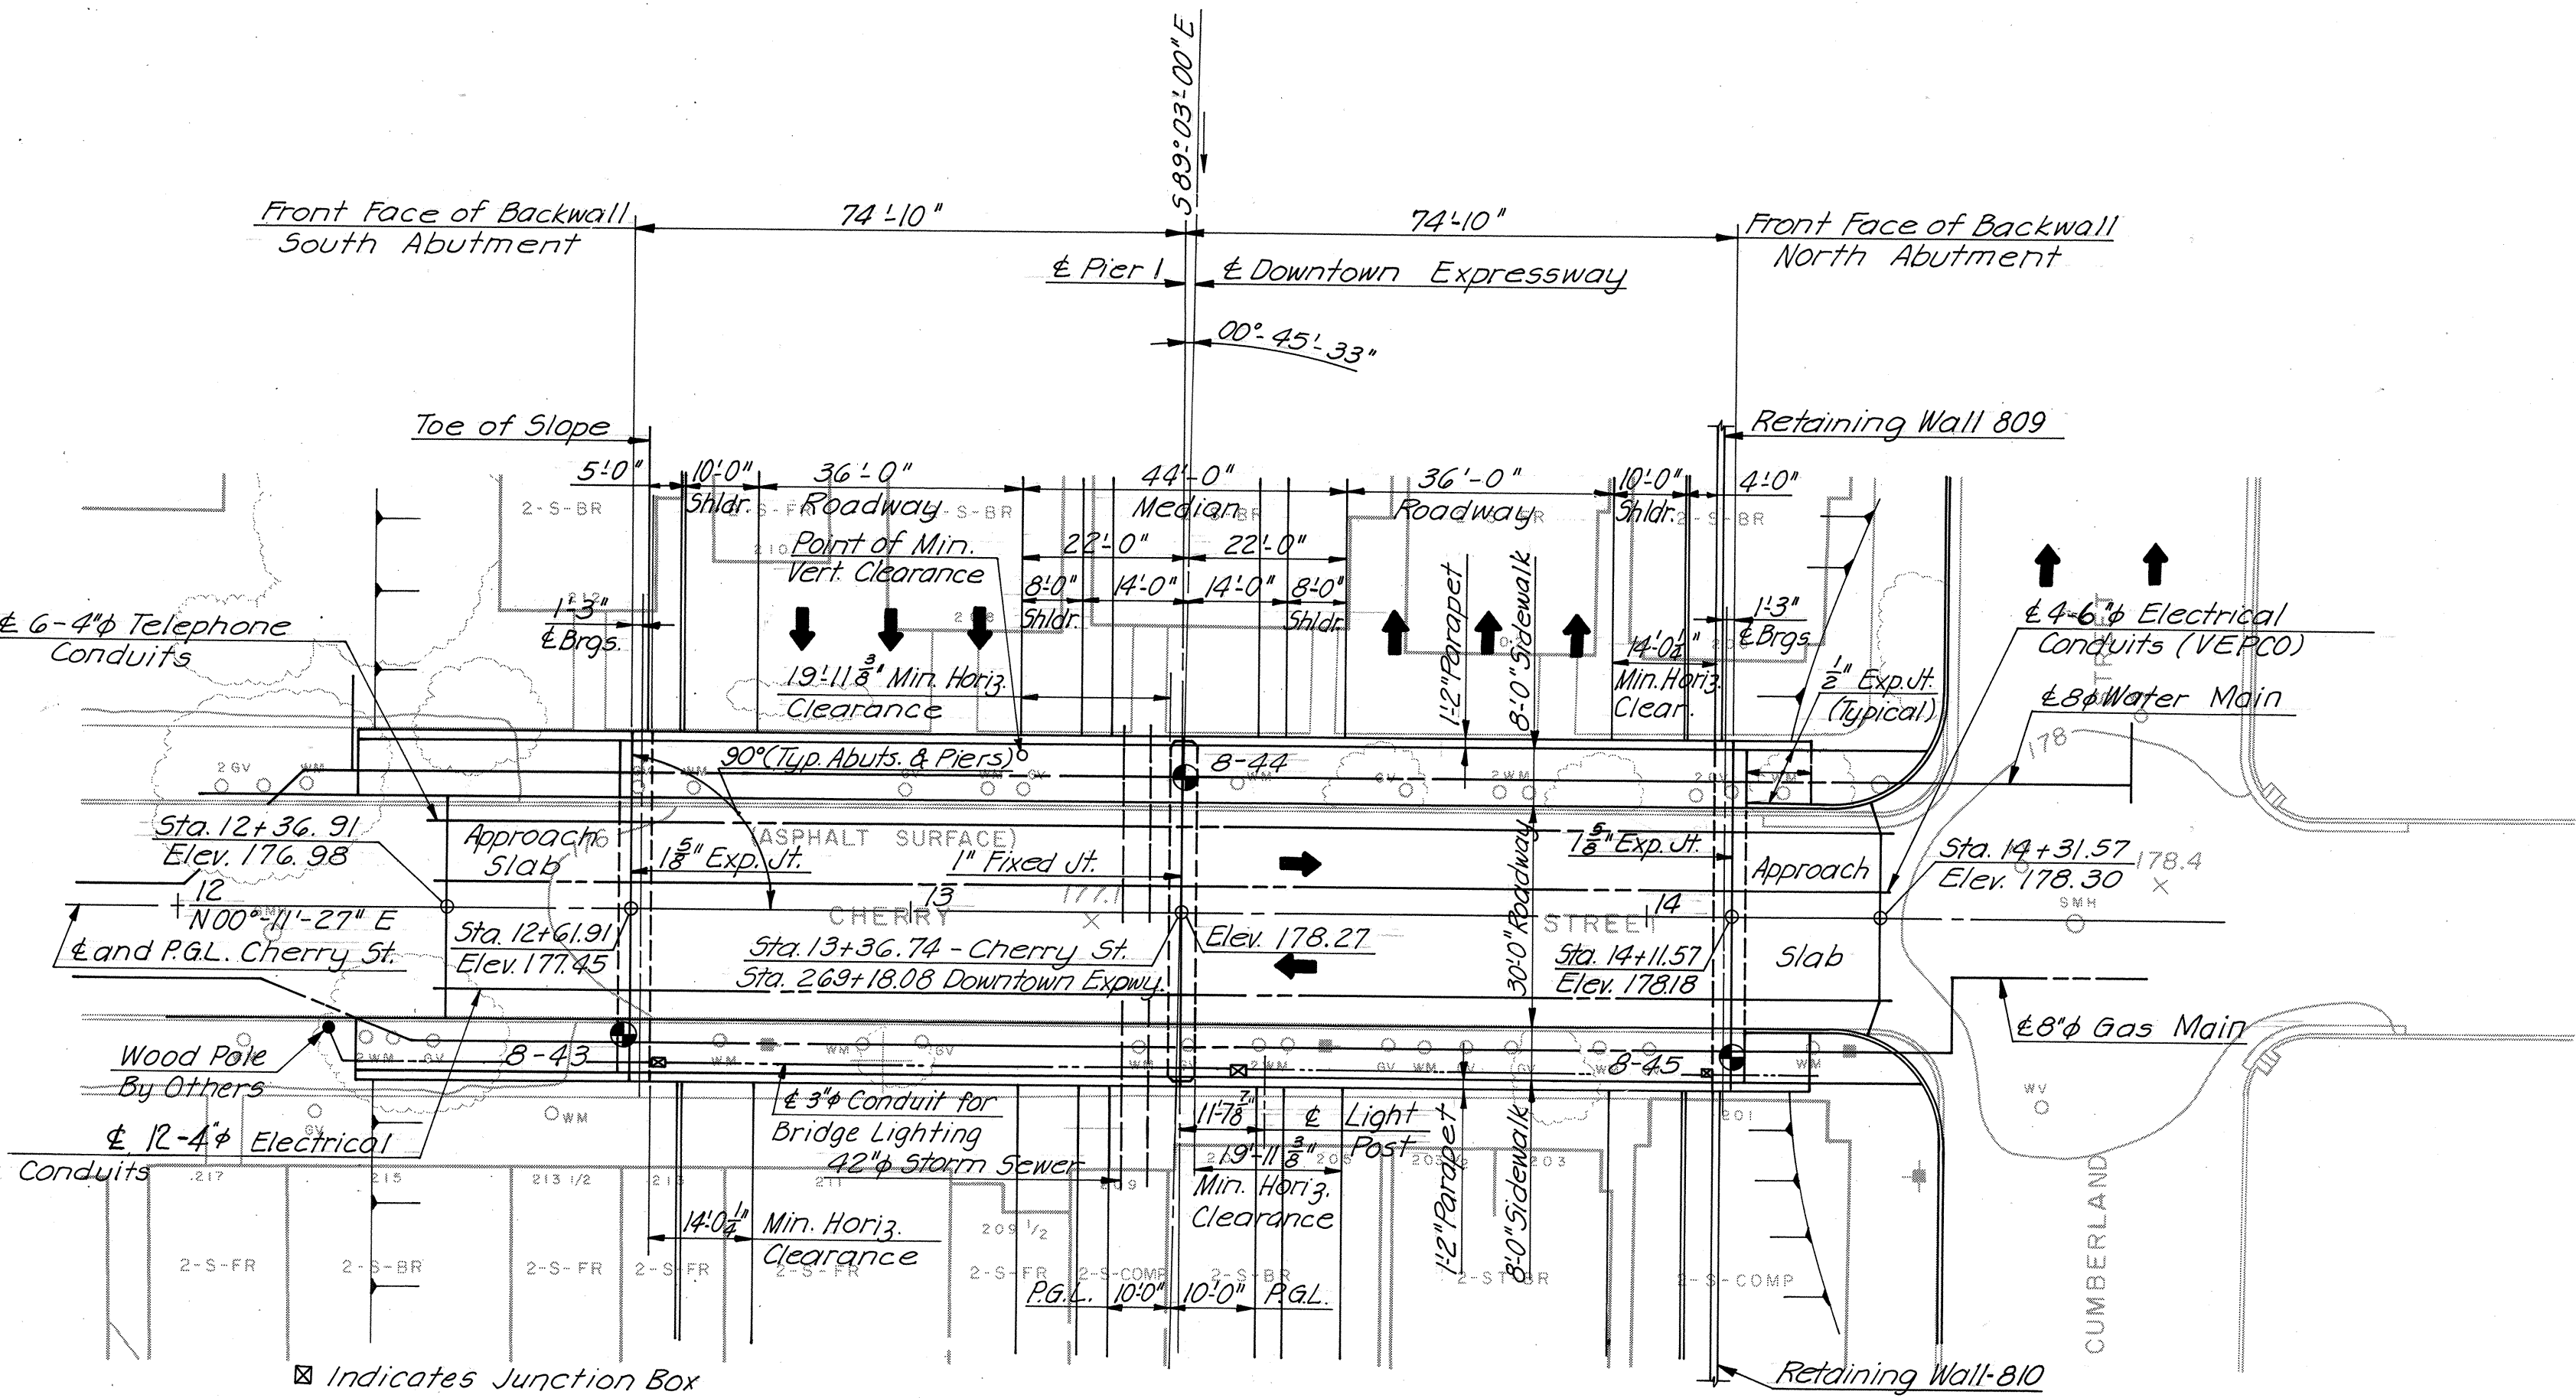

PLAN

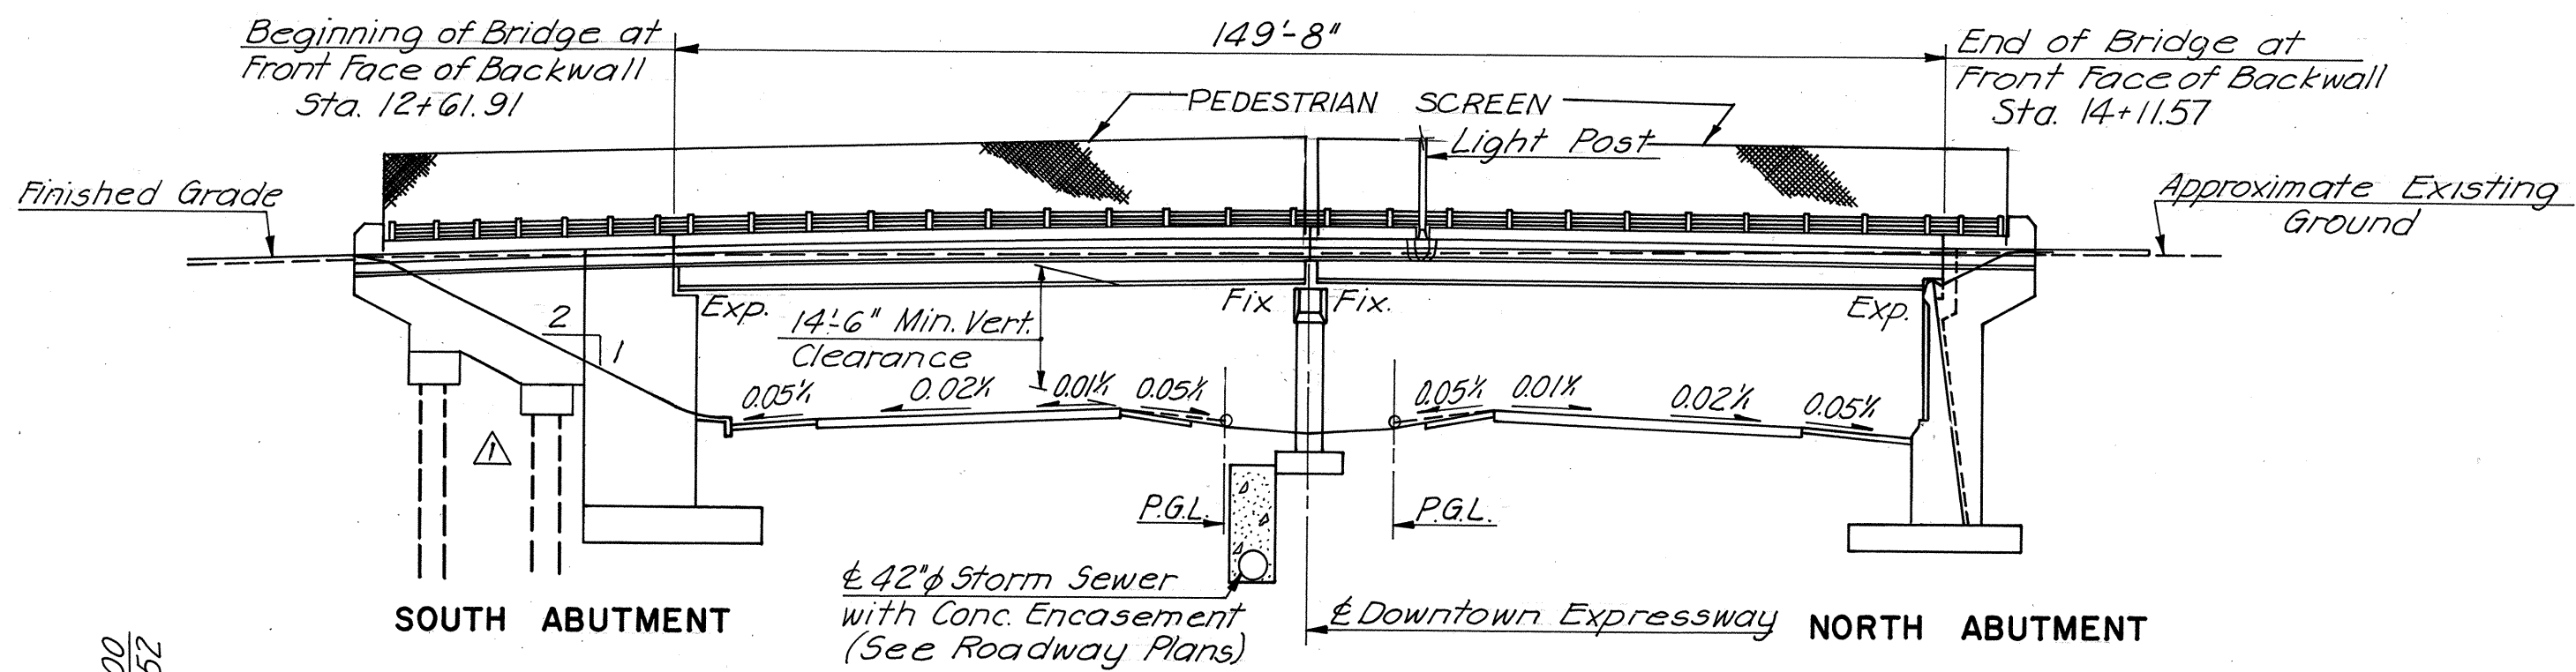

ELEVATION

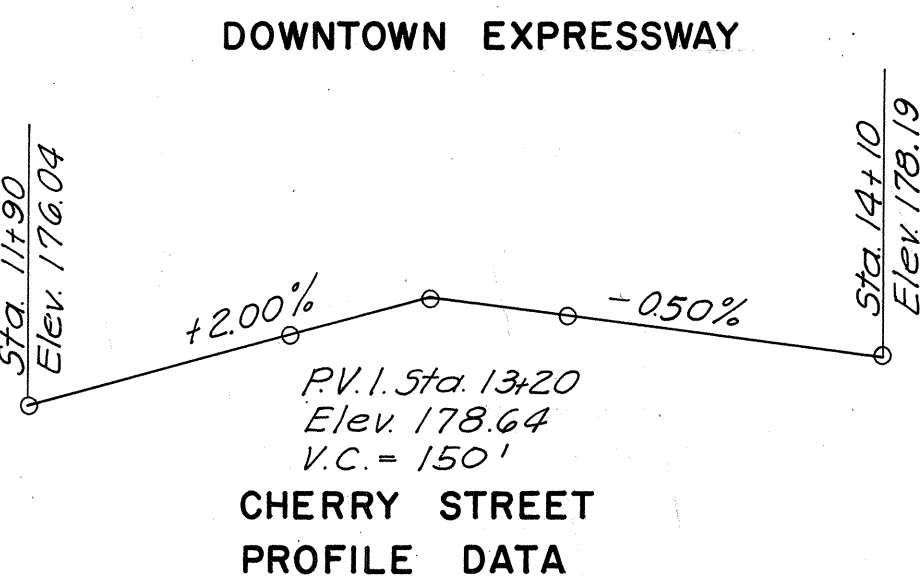

CHERRY STREET PROFILE DATA




BY	DATE	AS BUILT	HMW
MADE	W.D.U. 8-67	AS BUILT	HMW
CHECKED	W.E.O. 12-67	AS BUILT	T.E.M. 3-75
IN CHARGE	W.E.O.	NO. REVISION	BY DATE

ESTIMATED QUANTITIES															
	STRUCTURE EXCAVATION C.Y.	CONCRETE CLASS A4 C.Y.	CONCRETE CLASS A3 C.Y.	REINFORCING STEEL LBS.	STRUCTURAL STEEL A36 LBS.	ALUMINUM BRIDGE RAILING L.F.	ASPHALT DAMP-PROOFING S.Y.	6 INCH PIPE UNDERDRAIN L.F.	POROLIS BACK FILL C.Y.	GAS MAIN 8" φ L.F.	WATER MAIN 8" φ L.F.	CONDUIT 6" φ VEPCO L.F.	CONDUIT 4" φ TELE. L.F.	CONDUIT 4" φ CITY L.F.	10BP42 STEEL PILES L.F.
Superstructure		286.45		52,924	275,080.3	381				195	197.8	788	918.	2142	
South Abutment	885		457.64	49,884			188	47	107						963
Pier 1	90		79.86	16,123											
North Abutment	638		371.58	26,943			157	57	83						
Approach Slabs			74.53	16,762											7
Total	1613	286.45	983.61	162,636	275,080.3	381	345	104	190	195	197.8	788	918.	2142	963


RICHMOND METROPOLITAN AUTHORITY		RICHMOND EXPRESSWAY SYSTEM	
DOWNTOWN EXPRESSWAY		STRUCTURE B 49	
		CHERRY STREET OVER DOWNTOWN EXPRESSWAY	
GENERAL PLAN AND ELEVATION		SCALE: 1" = 20'	
AMERICAN ENGINEERS Richmond, Virginia		CONTRACT NO.: 8	
HOWARD, NEEDLES, TAMMEN & BERGENDOFF General Consultants		SHEET NO. 1 OF 11	






RICHMOND EXPRESSWAY SYSTEM			
SECTION	PROJECT	SHEET NO.	TOTAL SHEETS
8	DOWNTOWN EXPRESSWAY	217	

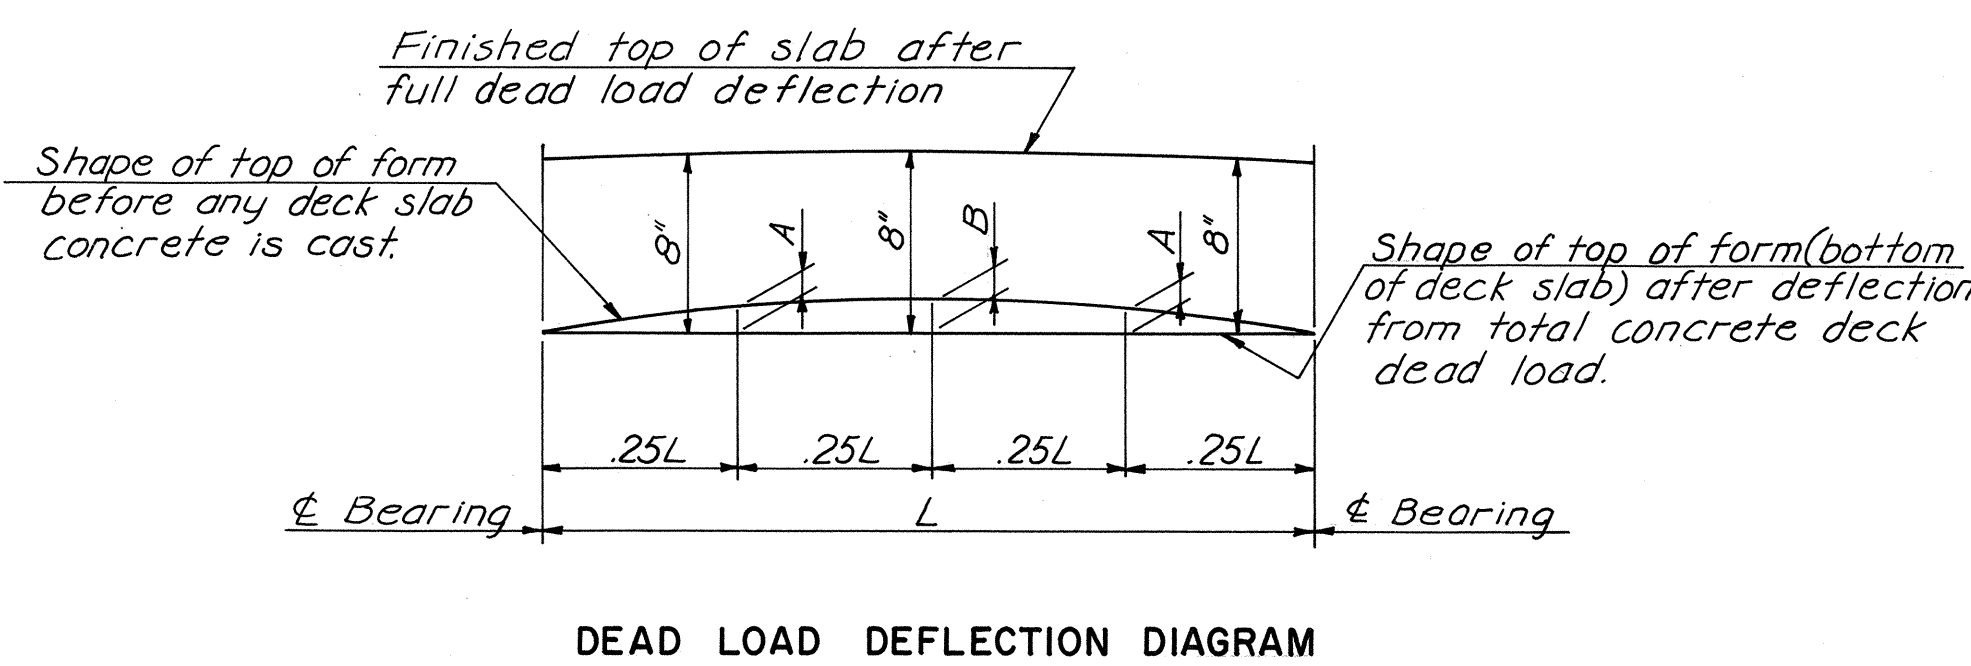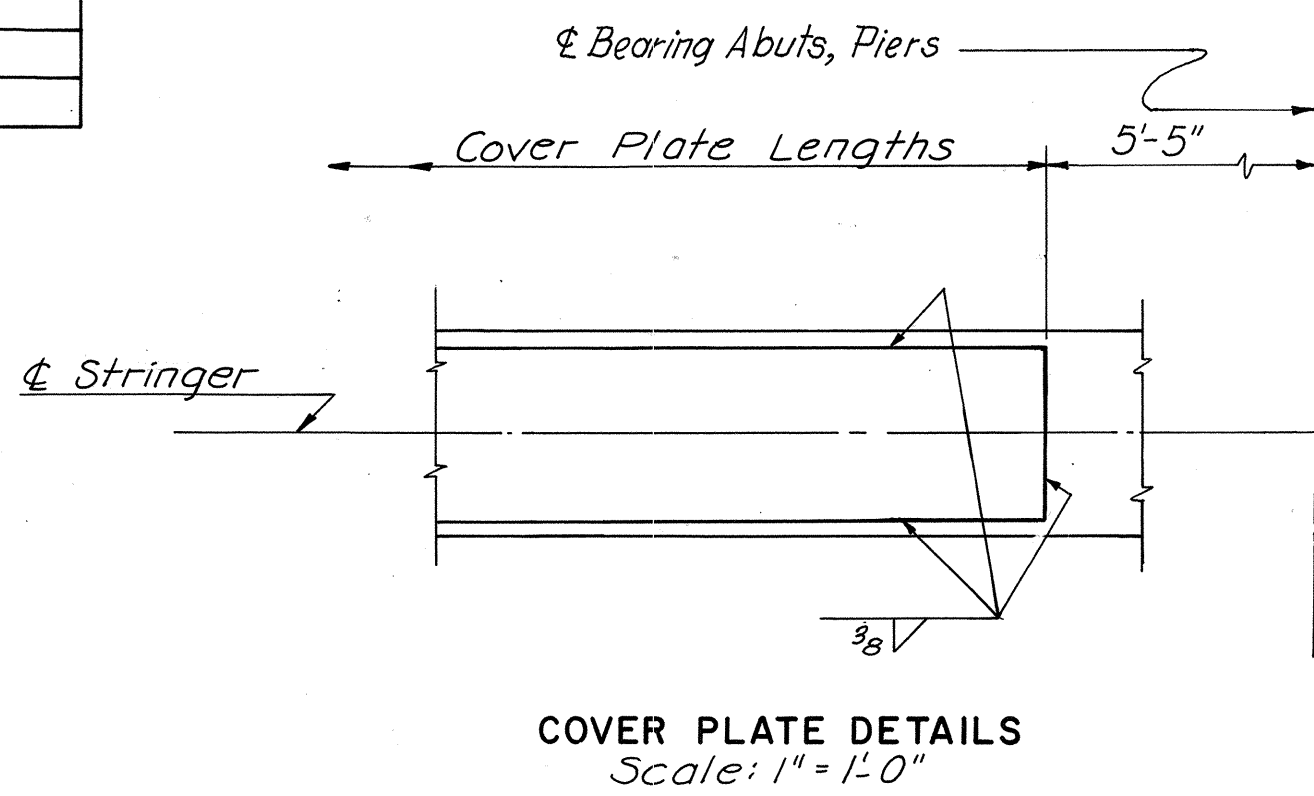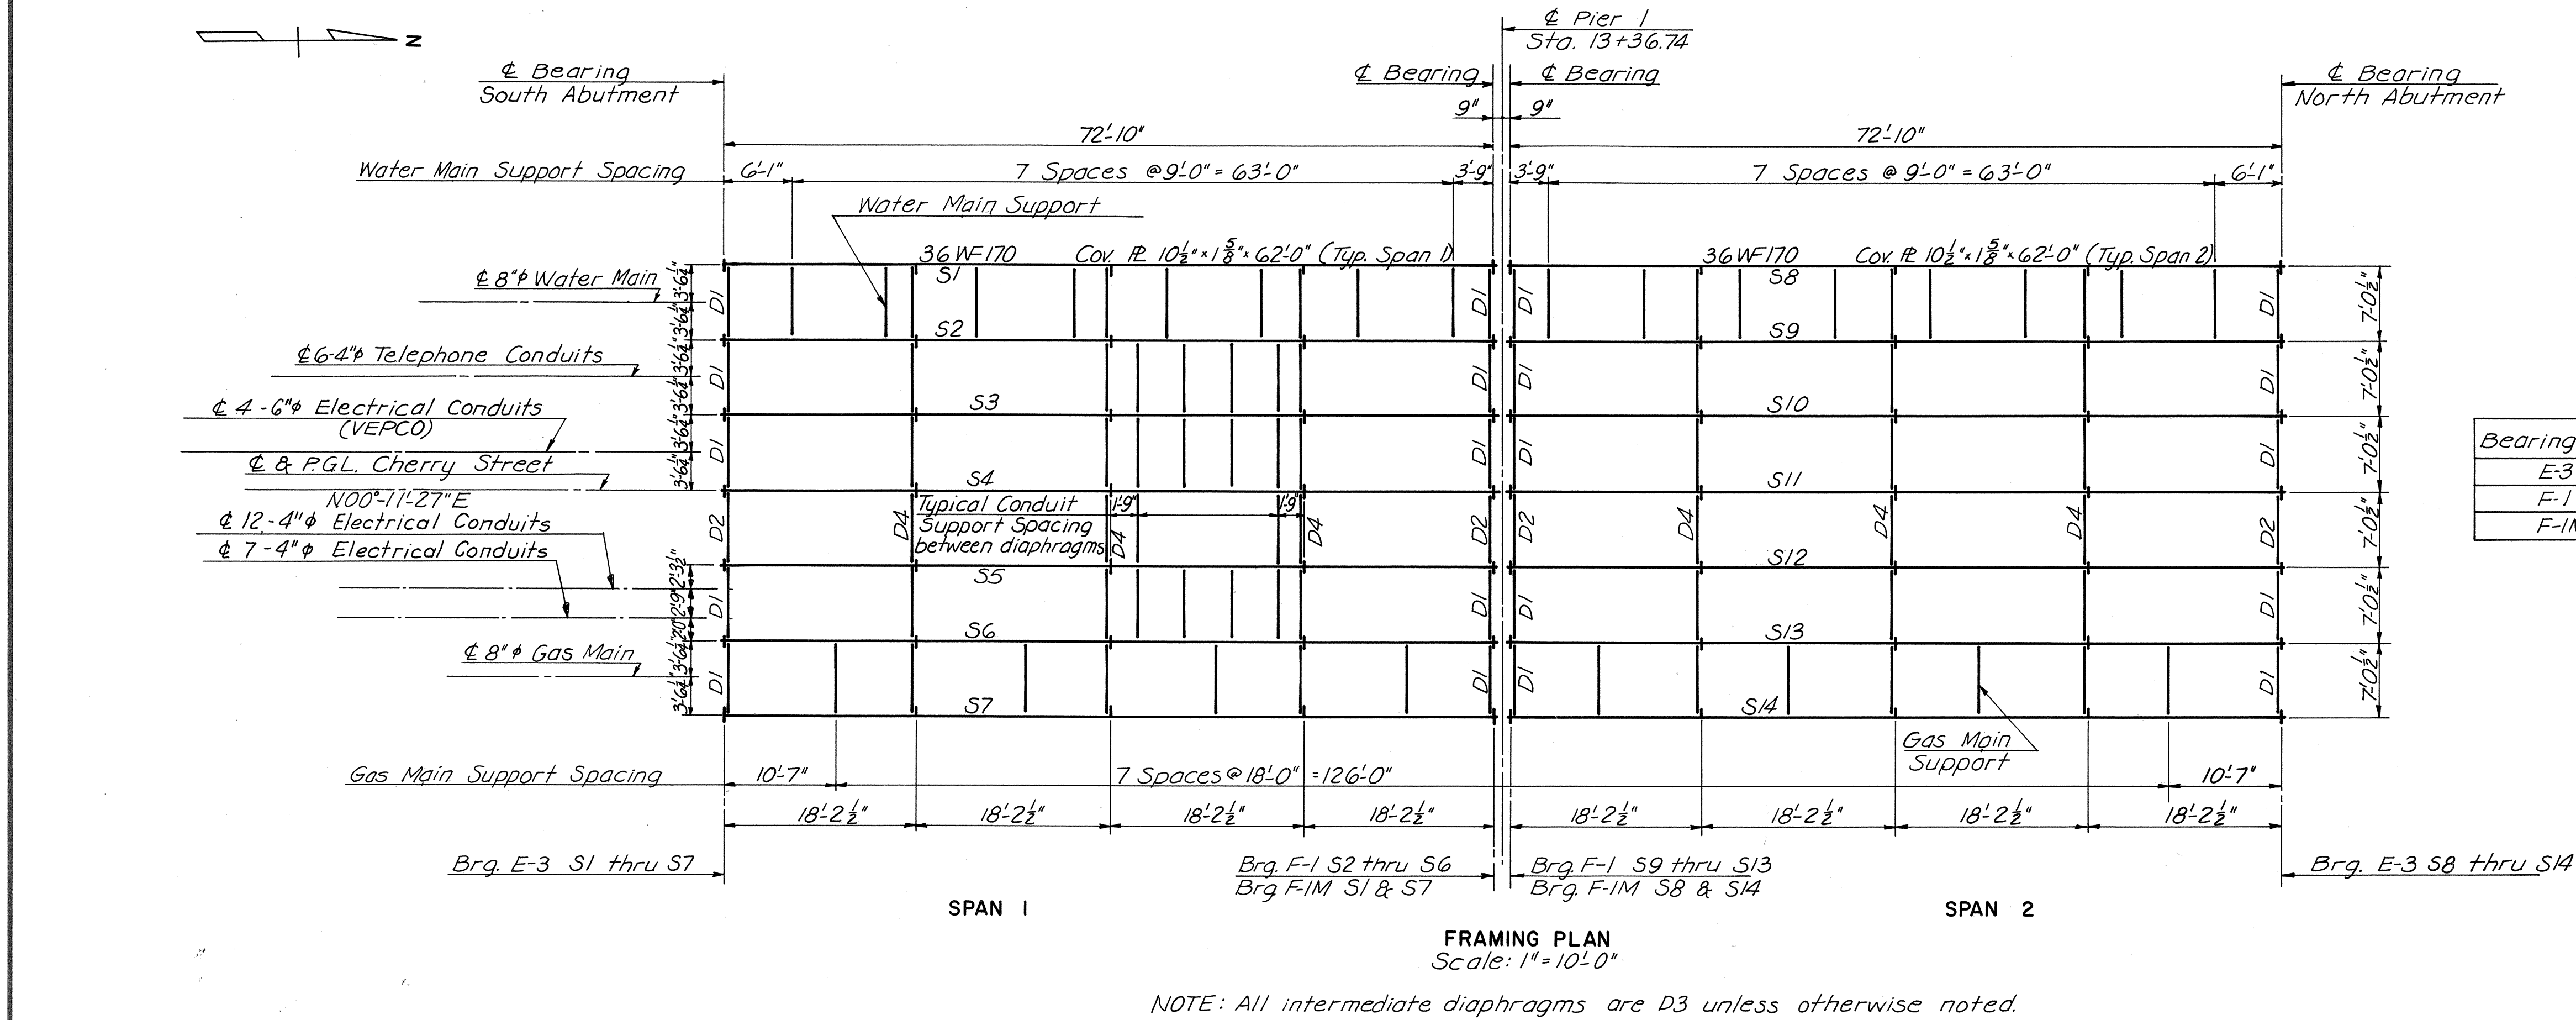

Stringers	A	B
S1, S7, S8, S14	1 1/16"	1 1/2"
S2 thru S6, S9 thru S13	1 3/16"	1 1/4"

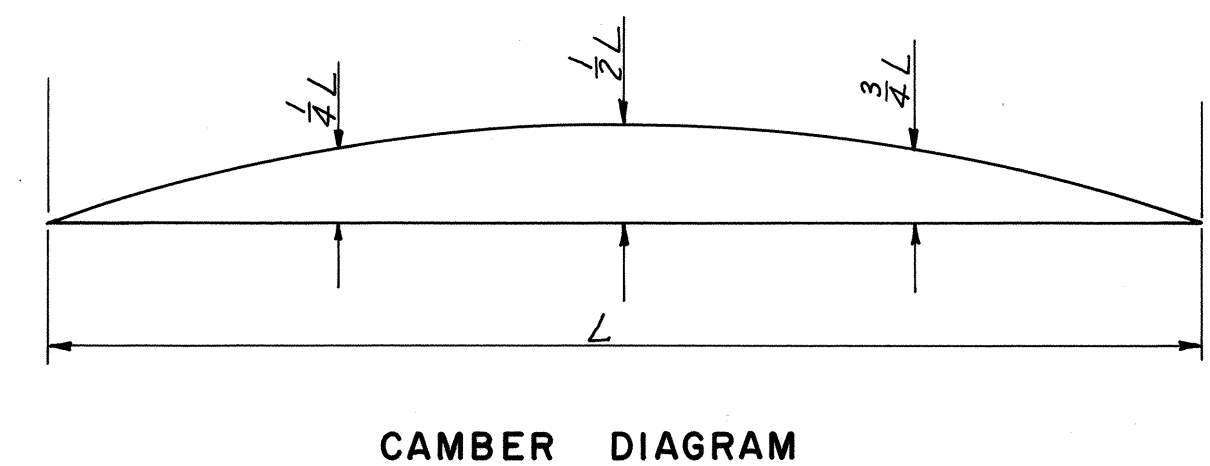

Stringers	1/4 L, 3/4 L	1/2 L
S1, S6, S7	2 1/4"	3 3/16"
S3 thru S5	2 1/2"	3 1/2"
S8, S13, S14	2 1/4"	3 3/16"
S10 thru S12	2 1/4"	3 1/2"
S2 & S9	2 3/16"	3 1/6"

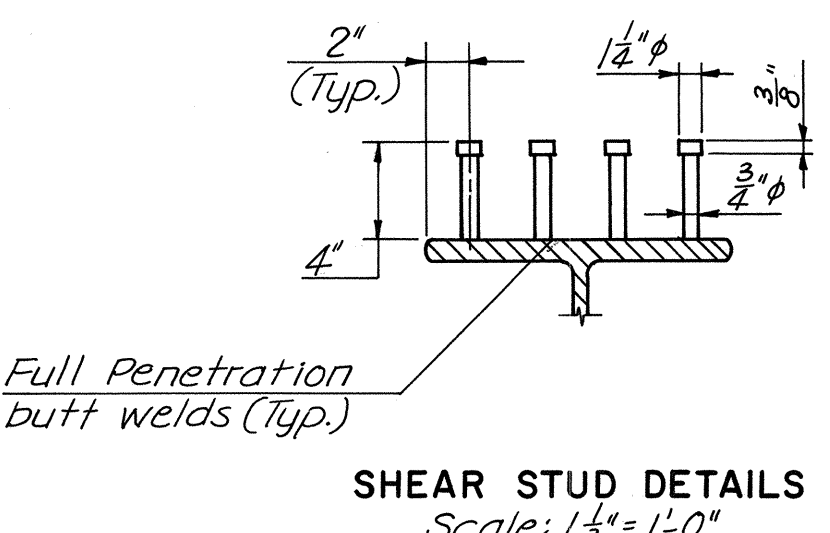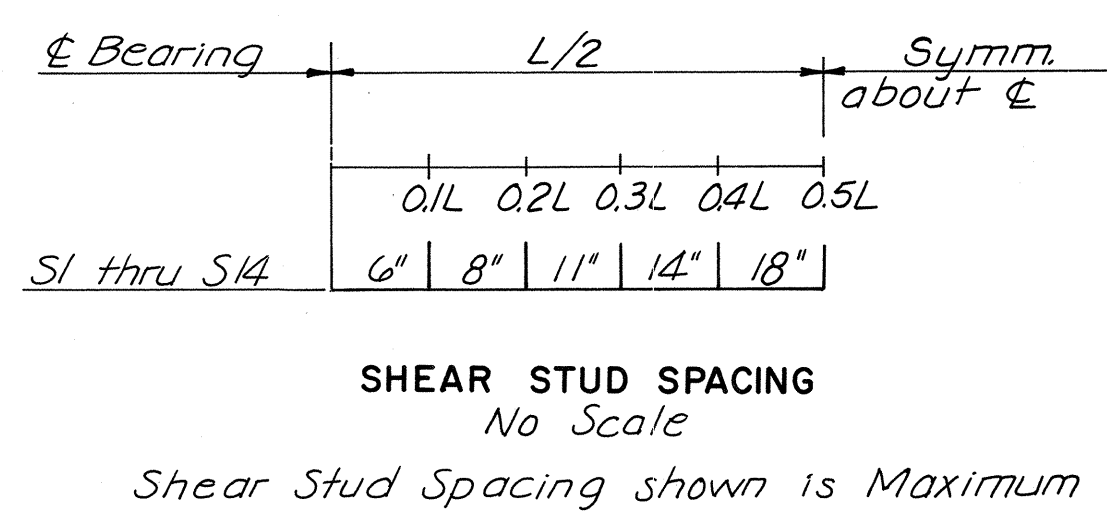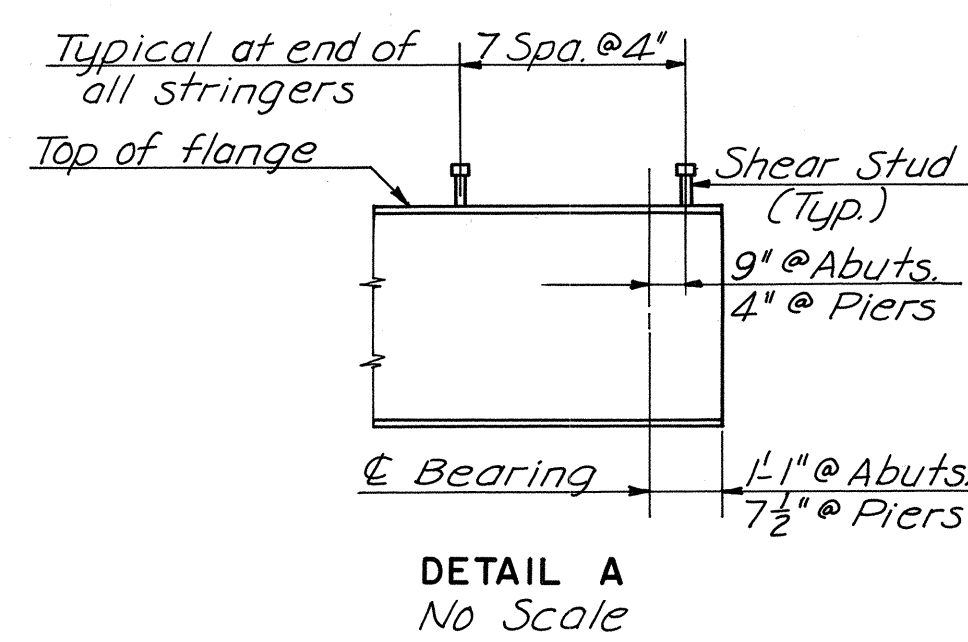

**SHEAR STUD NOTES:**  
Capacity = 3400 lbs. per stud  
Three 3/4" diameter studs may be substituted at the same longitudinal spacing as shown for four 3/4" diameter studs.  
Stud rows to be placed perpendicular to stringer.  
For end condition see Detail "A".

**NOTES:**  
Structural steel shall conform to ASTM Specifications A36 (latest revision).  
For General Notes see Sheet 1.  
For Superstructure Cross Section see Sheet 8.  
For Bearing Shoe Dimensions see Standard Sheet S1.  
For Diaphragm Details see Sheet 8.  
For Utility Support Details see Sheet 8.

**NOTE TO CONTRACTOR:**  
The above deflections are those anticipated to occur in the stringer upon placement of the total concrete deck dead load. In practice the stringers in place are not likely to have the exact camber to compensate for these deflections during construction. The residual amounts shall be provided for by adjusting forms to vary the thickness of the concrete bolster between the bottom of the slab and the top of the stringer, without alteration of the slab thickness.

**NOTE TO FABRICATOR:**  
The above stringers shall be fabricated with an upward camber amounting to (see table). This will provide approximate compensation for deflection under full dead load and for conformity with finished grade. Stringers which are not required to be shop cambered shall be turned so that any mill tolerance deviation from straightness will be in the direction shown by the camber diagram above.

MADE	BY	DATE	NO.	REVISION	BY	DATE
	T.D.U.	8-67				
CHECKED	W.E.O.	9-67				
IN CHARGE	W.E.O.					

# AS BUILT

**RICHMOND METROPOLITAN AUTHORITY**  
**RICHMOND EXPRESSWAY SYSTEM**  
DOWNTOWN EXPRESSWAY

**STRUCTURE B 49**  
**CHERRY STREET OVER**  
**DOWNTOWN EXPRESSWAY**

**FRAMING PLAN**

AMERICAN ENGINEERS Richmond, Virginia	SCALE: <b>AS NOTED</b>
HOWARD, NEEDLES, TAMMEN & BERGENDOFF General Consultants	CONTRACT NO. <b>8</b> SHEET NO. <b>7</b> OF <b>11</b>













RICHMOND EXPRESSWAY SYSTEM			
SECTION	PROJECT	SHEET NO.	TOTAL SHEETS
B	DOWNTOWN EXPRESSWAY	220	

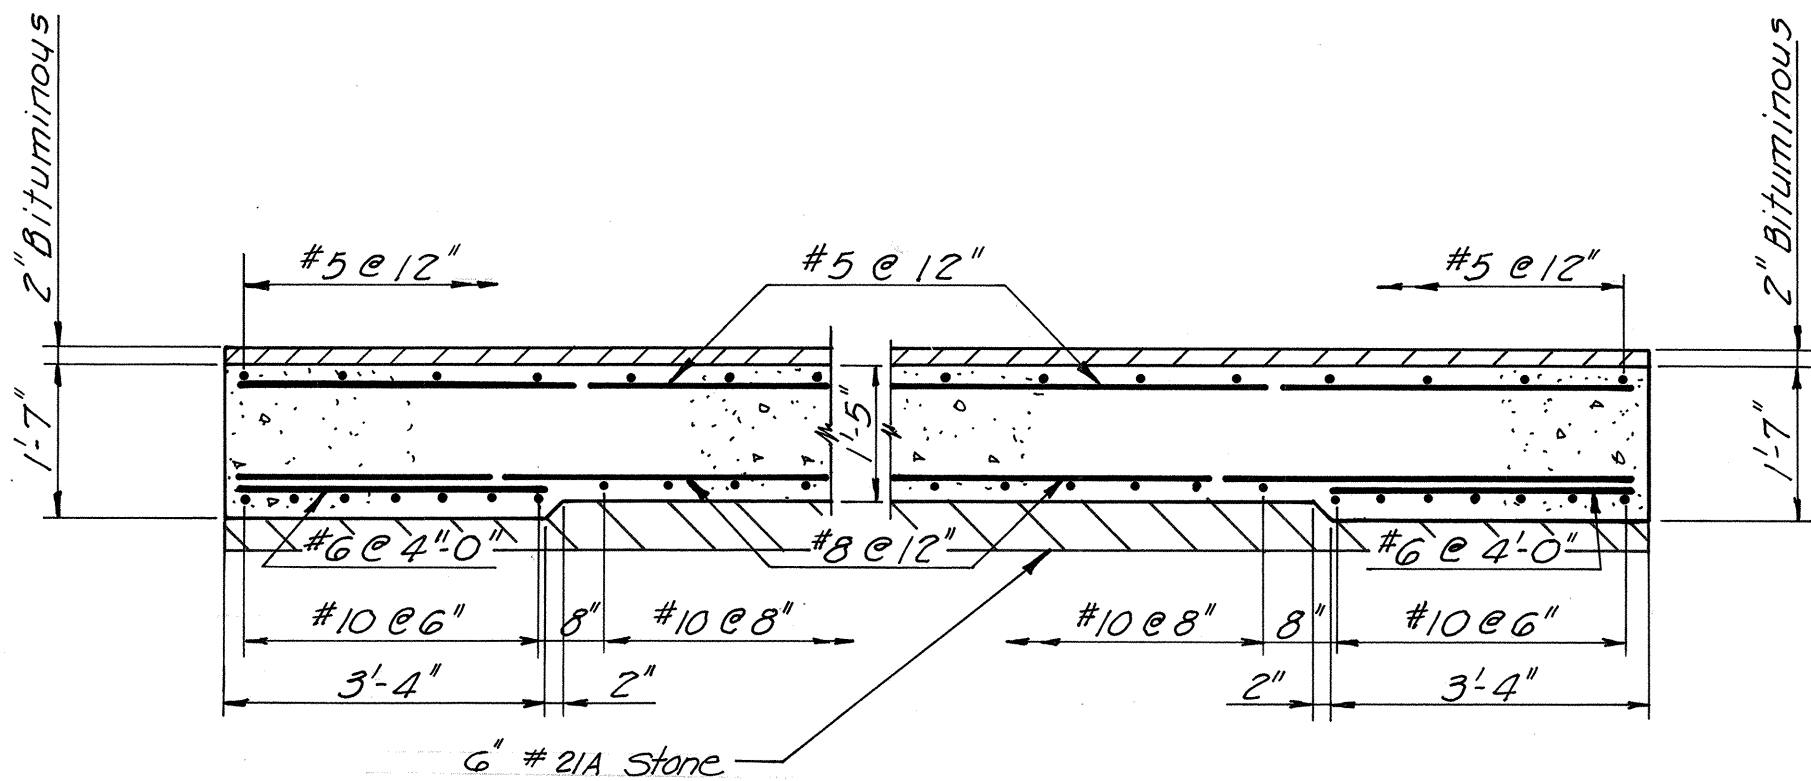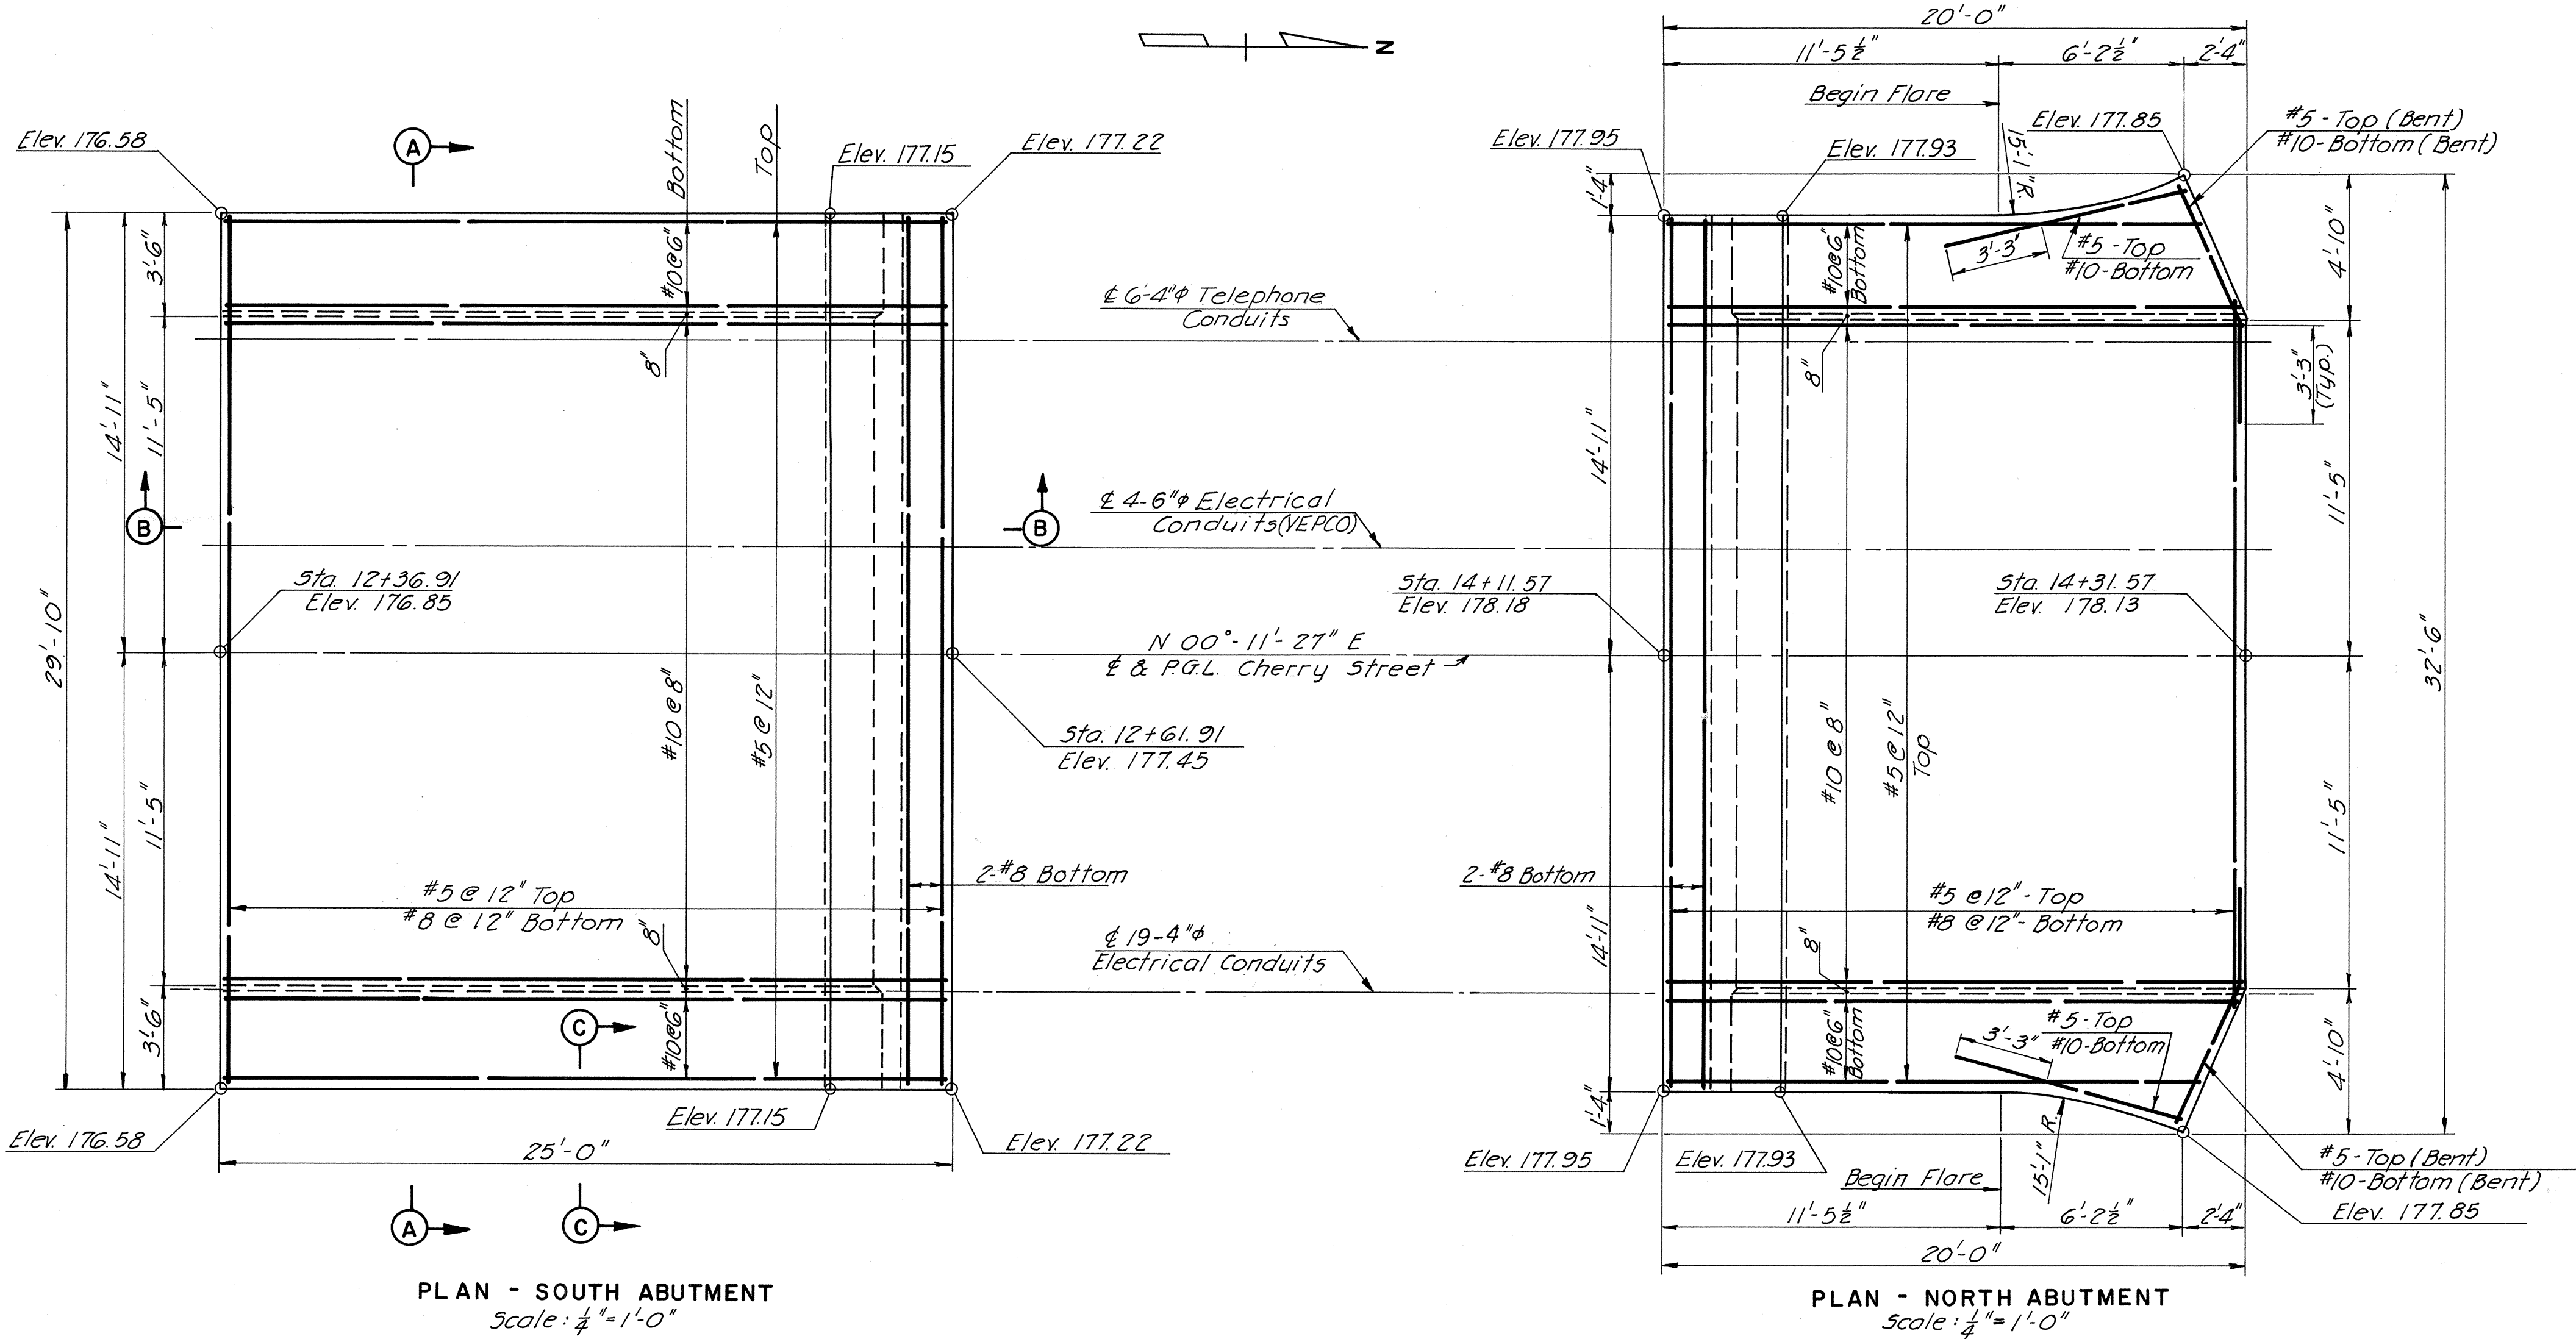

SECTION A-A  
Scale: 1/2" = 1'-0"

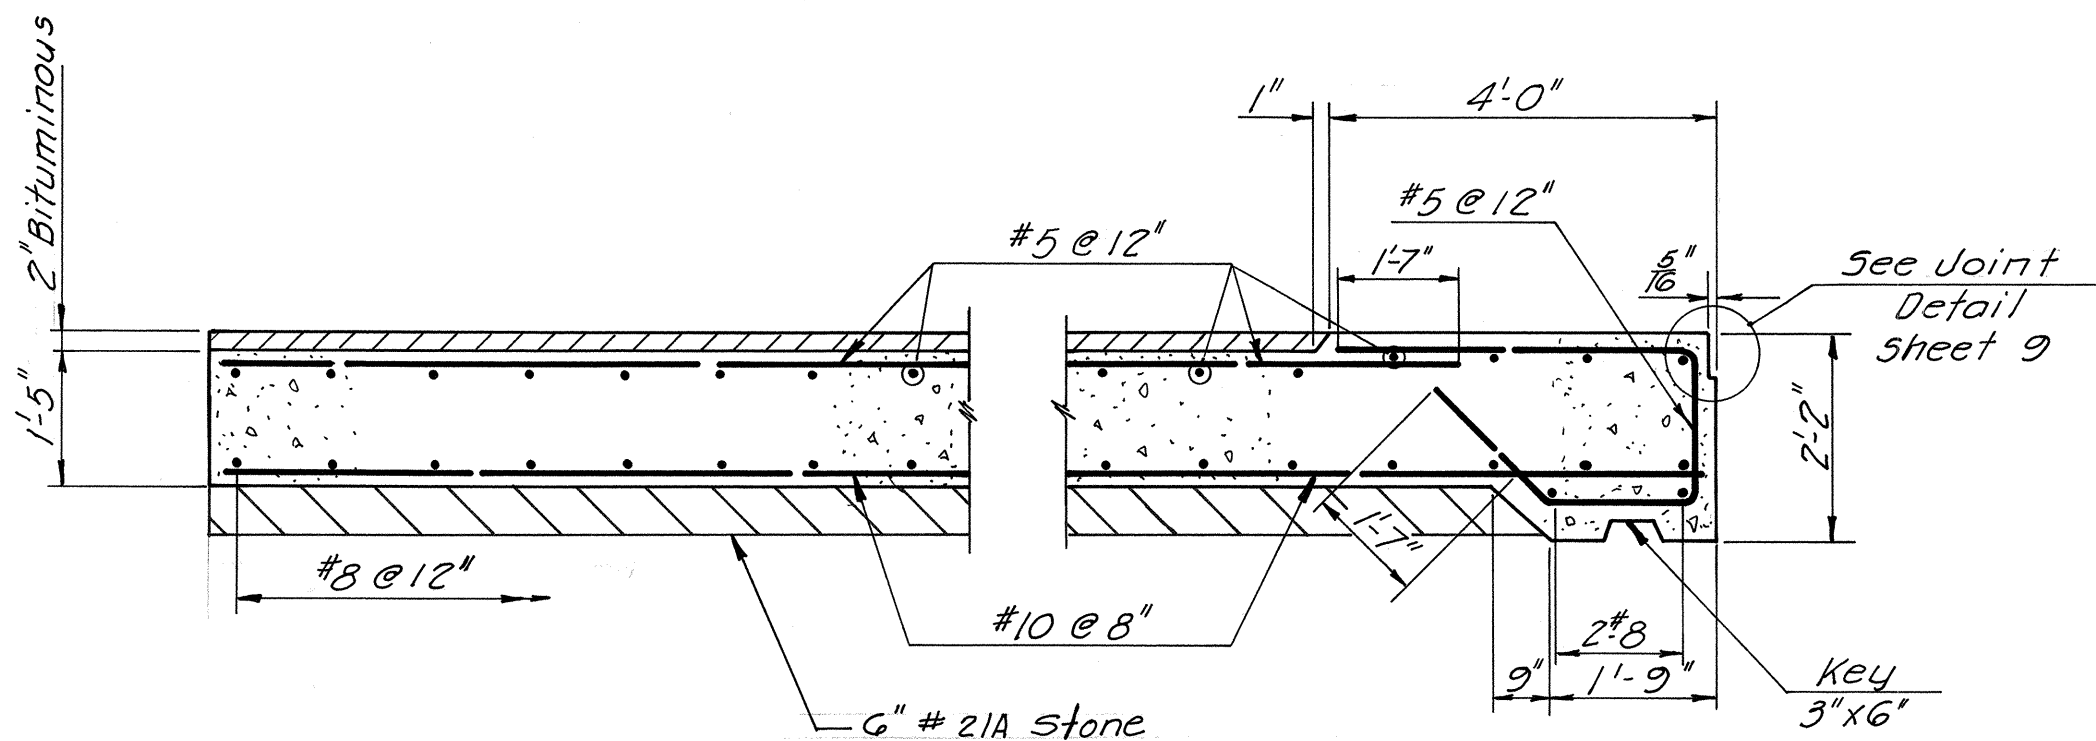

SECTION B-B  
Scale: 1/2" = 1'-0"

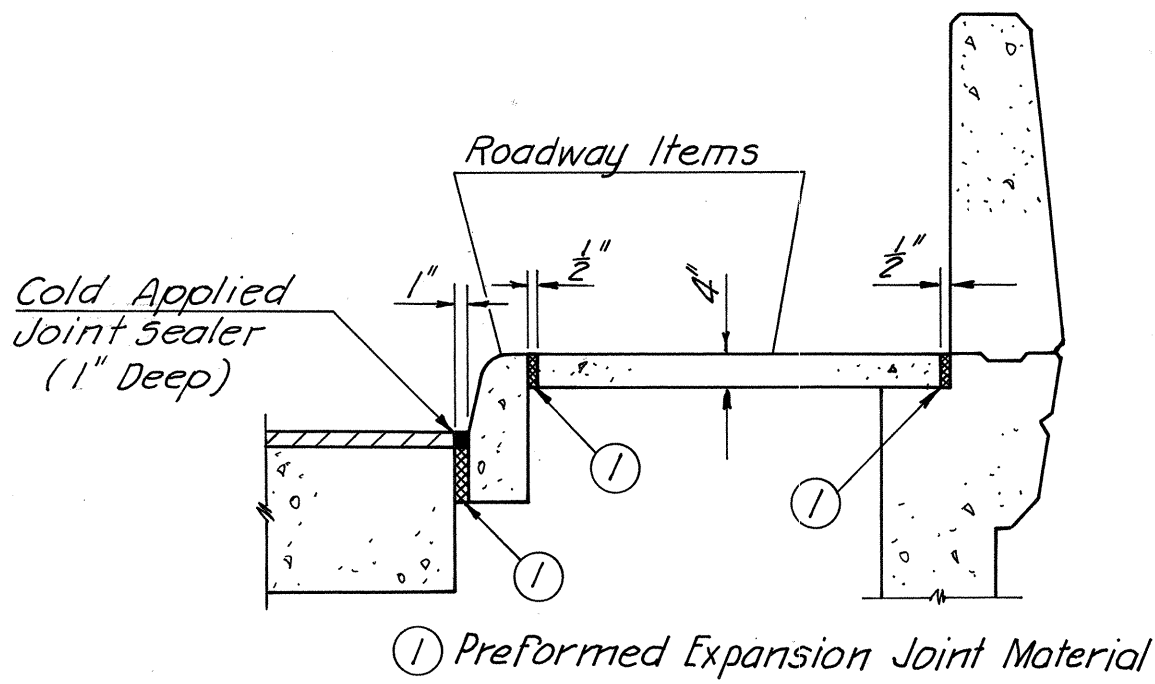

SECTION C-C  
Scale: 1/2" = 1'-0"

**AS BUILT**

NOTE:  
All reinforcing steel shall be 2" Clear.  
ELEVATIONS SHOWN ARE TO TOP OF CONCRETE.

MADE	CHECKED	IN CHARGE	BY	DATE	NO.	REVISION	BY	DATE
RPR	WEO	WEO		8-67				
				9-67				

RICHMOND METROPOLITAN AUTHORITY		SCALE: AS NOTED	
RICHMOND EXPRESSWAY SYSTEM		CONTRACT NO. 8	
DOWNTOWN EXPRESSWAY		SHEET NO. 10 OF 11	
STRUCTURE B 49			
CHERRY STREET OVER			
DOWNTOWN EXPRESSWAY			
APPROACH SLABS			
AMERICAN ENGINEERS			
Richmond, Virginia			
HOWARD, NEEDLES, TAMMEN & BERGENDOFF			
General Consultants			

# **Bridge 50**

**(South Laurel Street  
Over Downtown Expressway {Rte. 195})**



**Record Set Plans**








RICHMOND EXPRESSWAY SYSTEM			
SECTION	PROJECT	SHEET NO.	TOTAL SHEETS
8	DOWNTOWN EXPRESSWAY	226	

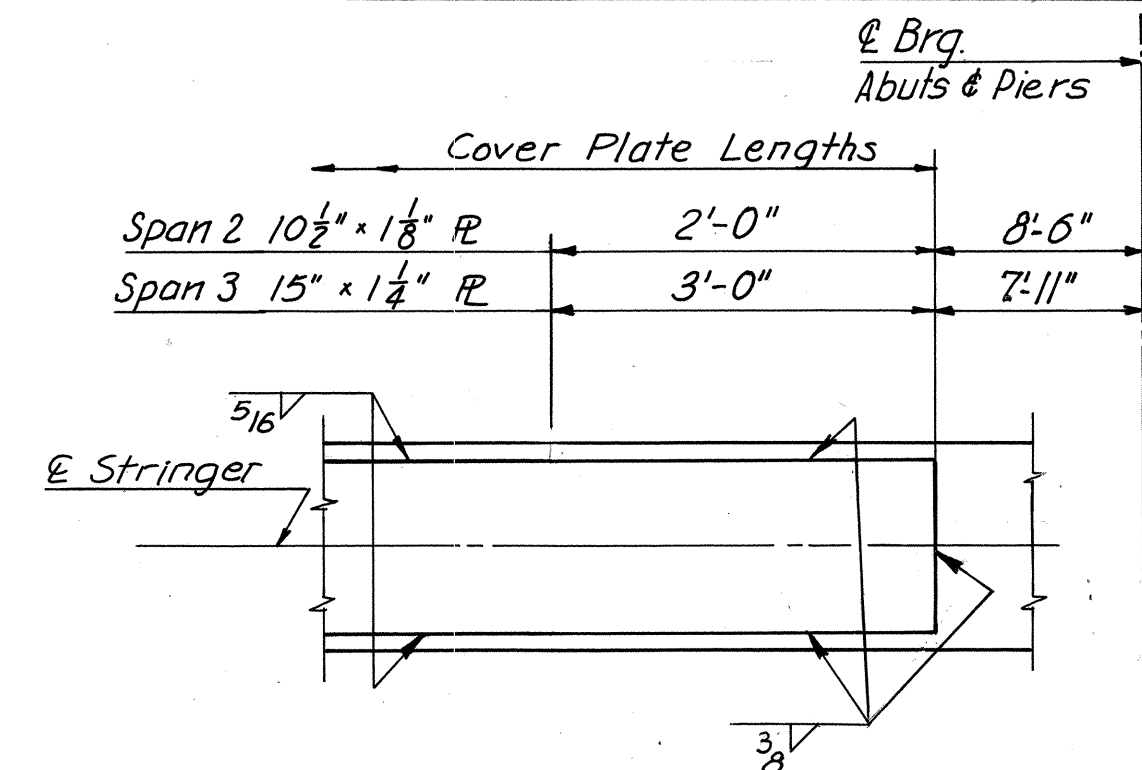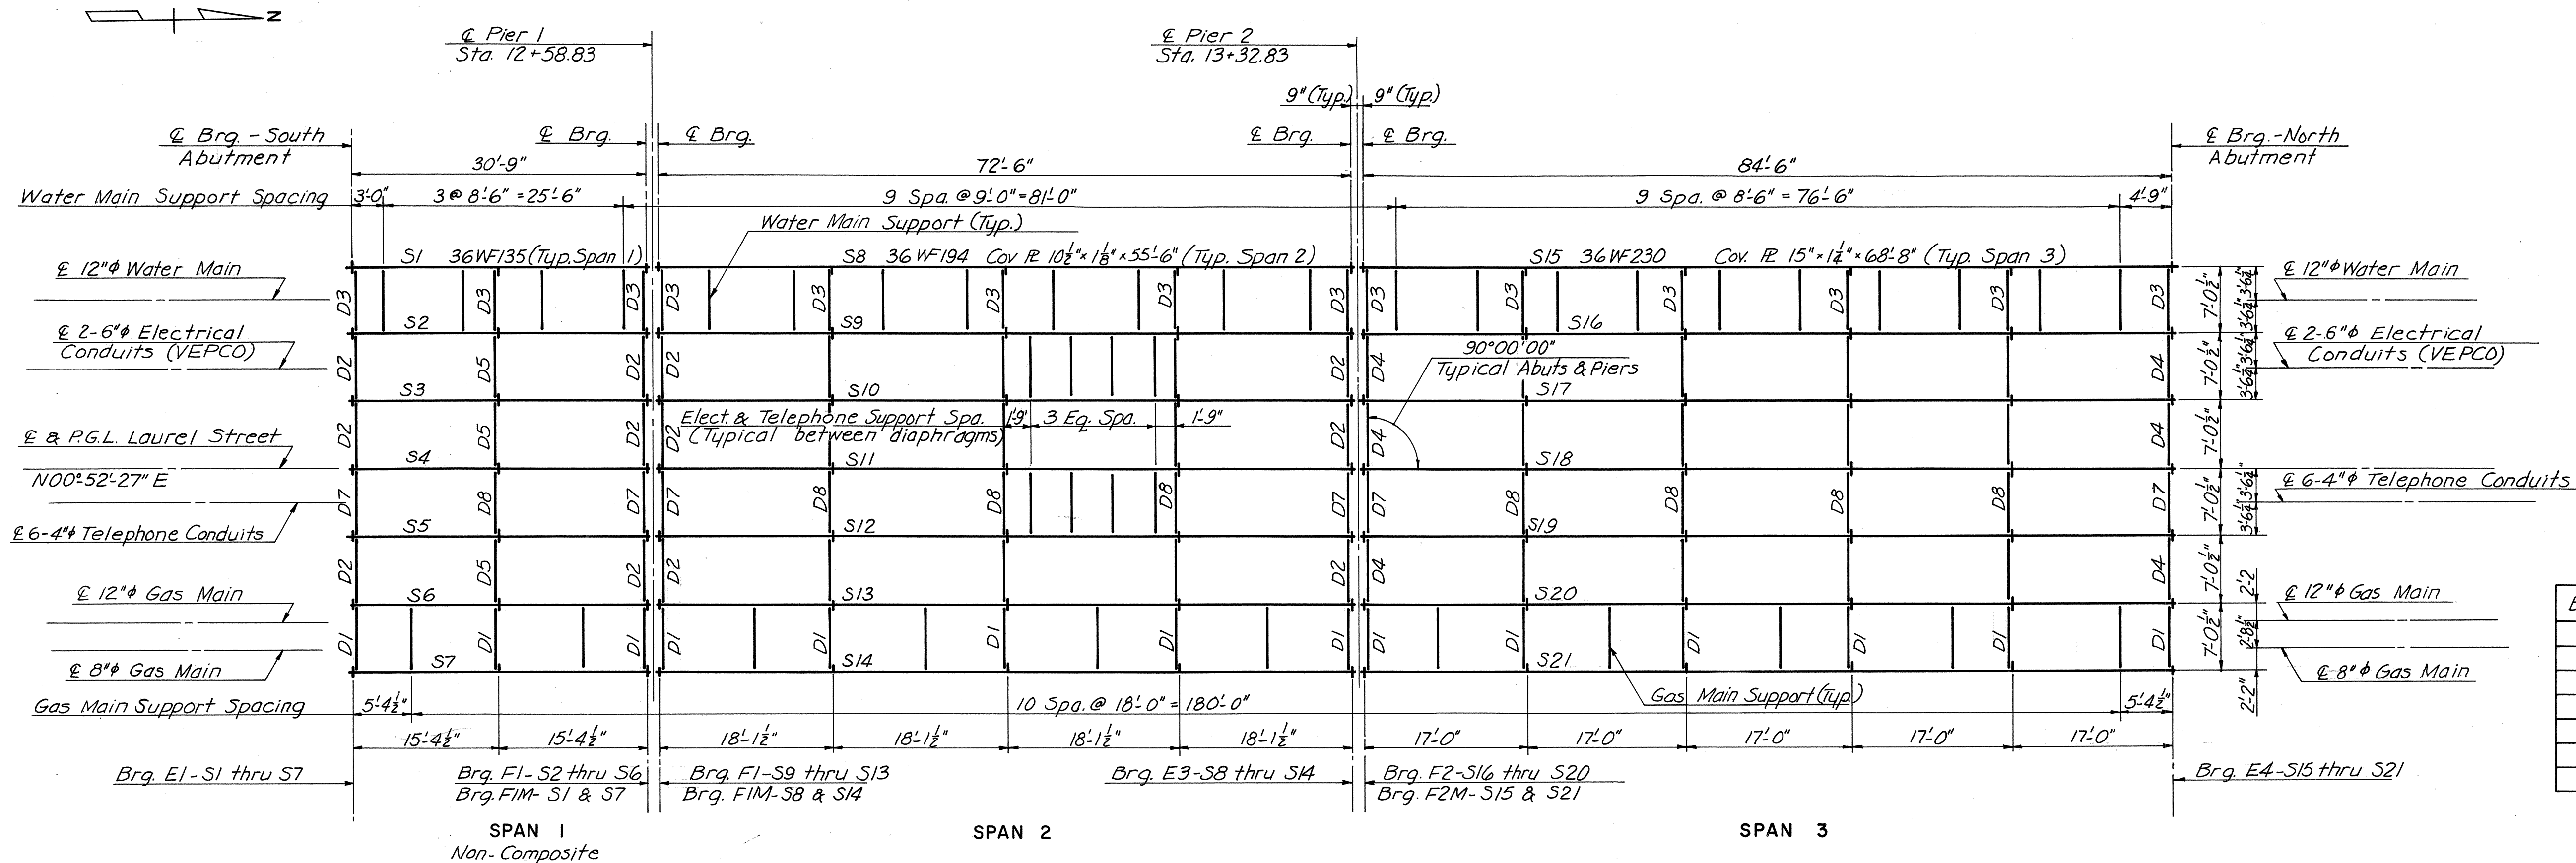

Bearing Type	No. Required
E1	7
F1	10
F1M	4
E3	7
F2	5
F2M	2
E4	7

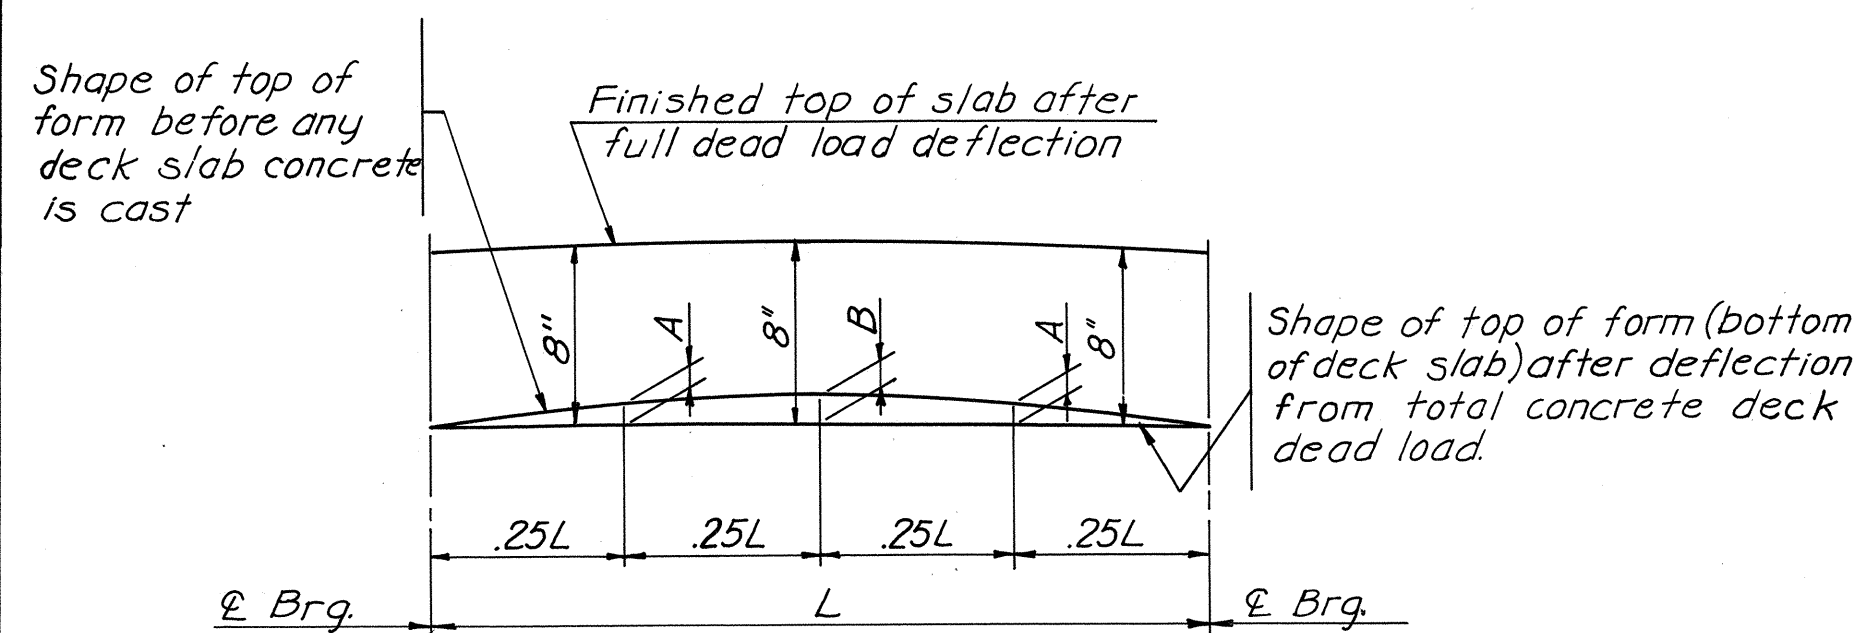


DEAD LOAD DEFLECTION DIAGRAM

Stringers	A	B
S1 thru S7	1/2"	3/4"
S8, S14	1"	1 1/4"
S9 thru S13	3/4"	1 1/8"
S15, S21	1 1/2"	2 1/8"
S16 thru S20	1 1/4"	1 3/4"

**NOTE TO CONTRACTOR:**

The above deflections are those anticipated to occur in the stringer upon placement of the total concrete deck dead load. In practice the stringers in place are not likely to have the exact camber to compensate for these deflections during construction. The residual amounts shall be provided for by adjusting forms to vary the thickness of the concrete bolster between the bottom of the slab and the top of the stringer, without alteration of the slab thickness.

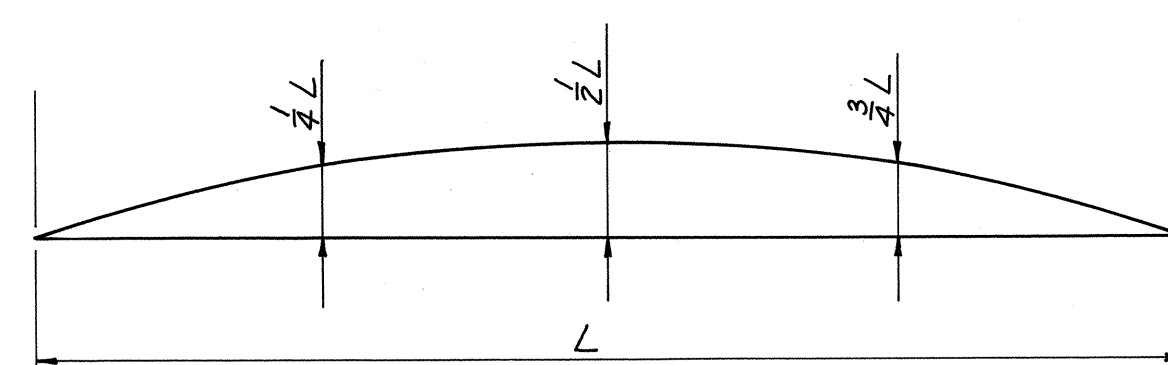


CAMBER DIAGRAM

Stringers	1/4 L	3/4 L	1/2 L
S8, S14	1 1/2"	1 3/4"	1 3/8"
S9 thru S13	1 1/2"	1 3/4"	1 1/8"
S15, S21	2"	2 1/8"	2 1/2"
S16 thru S20	1 1/2"	1 3/4"	2 1/8"

**NOTE TO FABRICATOR:**

The above stringers shall be fabricated with an upward camber amounting to (see table). This will provide approximate compensation for deflection under full dead load and for conformity with finished grade. Stringers which are not required to be shop cambered shall be turned so that any mill tolerance deviation from straightness will be in the direction shown by the camber diagram above.

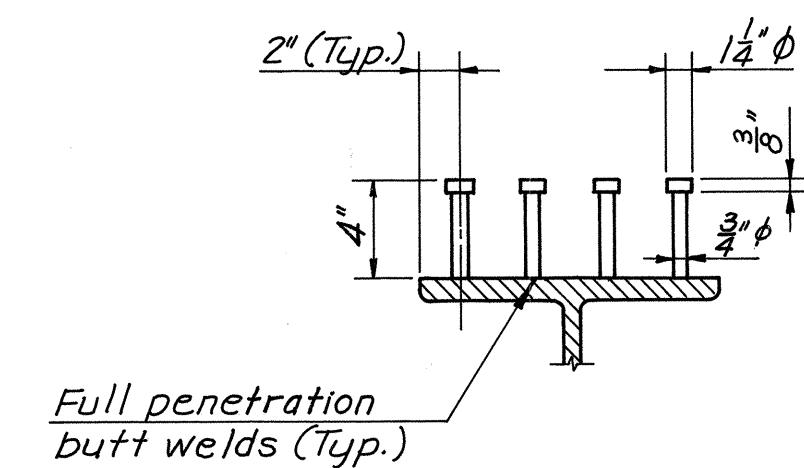

SHEAR STUD DETAIL  
Scale: 1 1/2"=1'-0"

Stringers	1/4 L	3/4 L	1/2 L
S8, S14	1 1/2"	1 3/4"	1 3/8"
S9 thru S13	1 1/2"	1 3/4"	1 1/8"
S15, S21	2"	2 1/8"	2 1/2"
S16 thru S20	1 1/2"	1 3/4"	2 1/8"


**SHEAR STUD SPACING**

No Scale

Shear Stud spacing shown is maximum

**Shear Stud Notes:**

Capacity = 3400 lbs. per stud.  
Three 3/8" diameter studs may be substituted at the same longitudinal spacing as shown for four 3/4" diameter studs.  
Stud rows to be placed perpendicular to E stringer.  
For end condition see Detail "A".

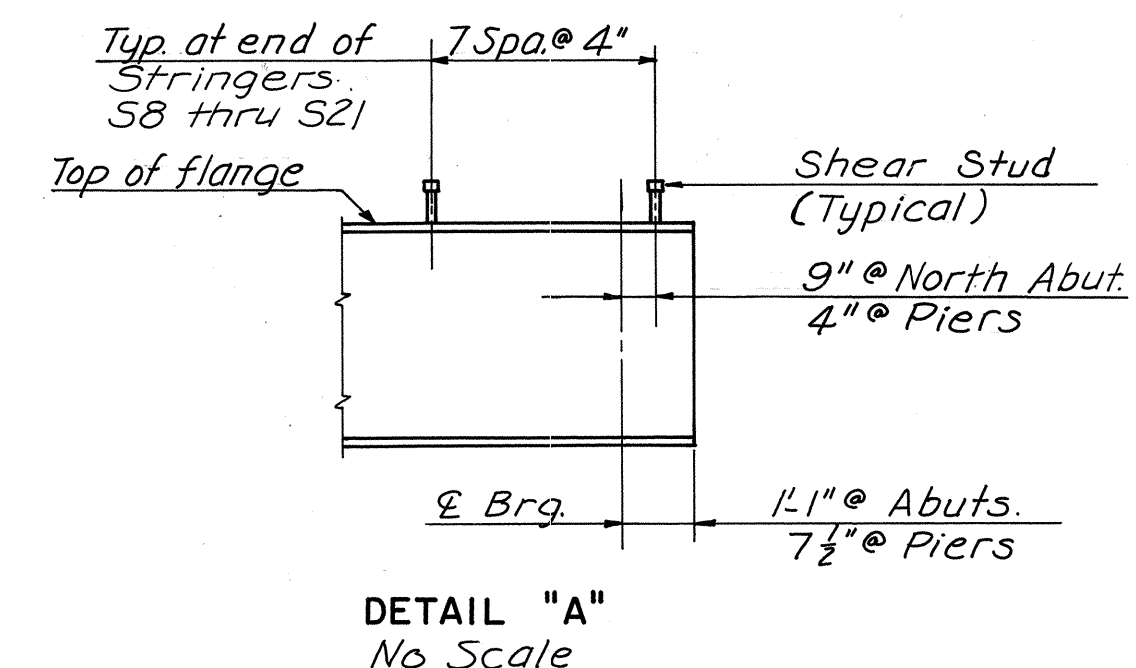

**Notes:**

Structural steel shall conform to ASTM Specifications A36 (latest revision).  
For General Notes see Sheet 1.  
For Superstructure Cross Section see Sheet 6.  
For Diaphragm Details see Sheet 6.  
For Utility Support Details see Sheet 6.  
For Bearing Shoe Dimensions see Standard Sheet S1.

**AS BUILT**

RICHMOND METROPOLITAN AUTHORITY	
RICHMOND EXPRESSWAY SYSTEM	
DOWNTOWN EXPRESSWAY	
STRUCTURE B 50	
LAUREL STREET OVER	
DOWNTOWN EXPRESSWAY	
FRAMING PLAN	
AMERICAN ENGINEERS Richmond, Virginia	SCALE: AS NOTED
HOWARD, NEEDLES, TAMMEN & BERGENOFF General Consultants	CONTRACT NO.: 8
	SHEET NO. 5 OF 9



BY	DATE				
MADE	FBC	7-67			
CHECKED	W.E.O.	9-67			
IN CHARGE	W.E.O.		NO.	REVISION	BY DATE









RICHMOND EXPRESSWAY SYSTEM			
SECTION	PROJECT	SHEET NO.	TOTAL SHEETS
8	DOWNTOWN EXPRESSWAY	228	

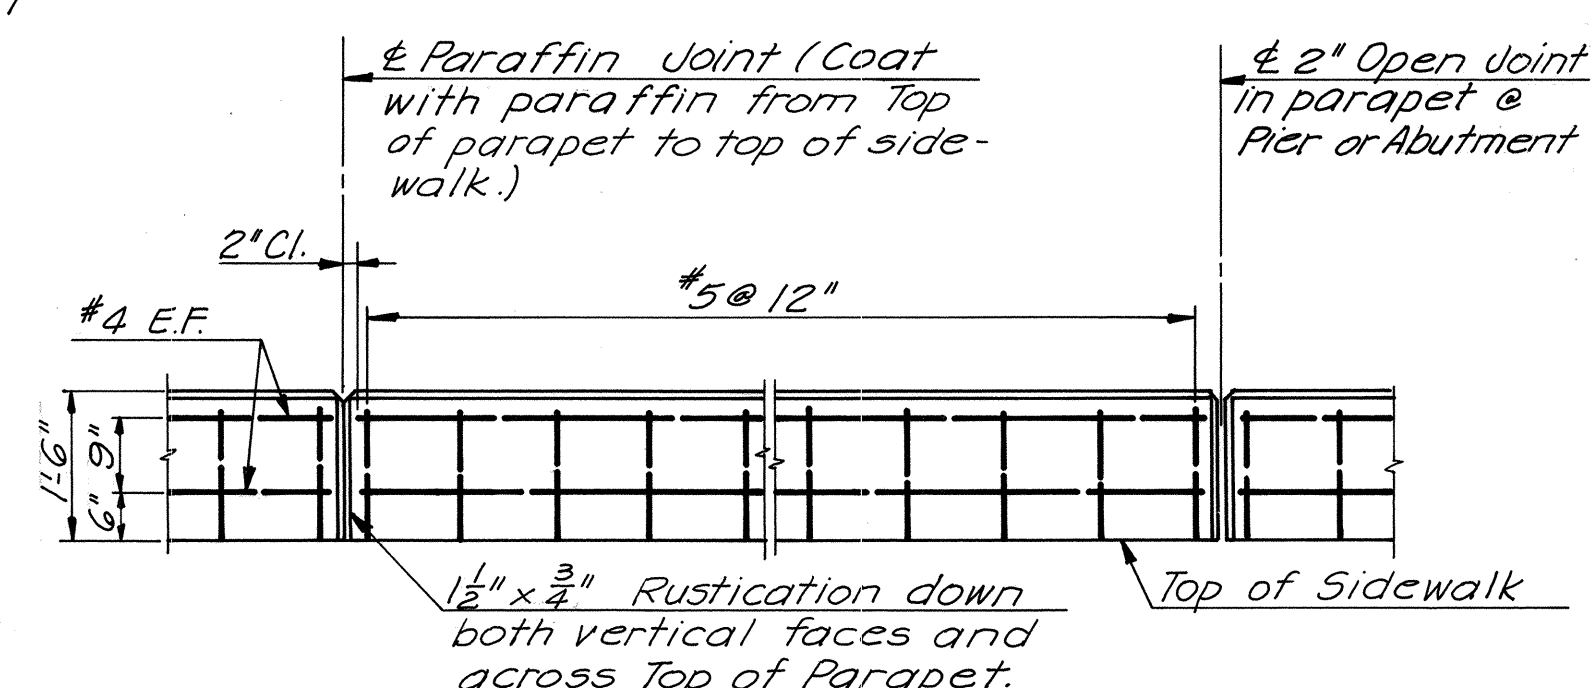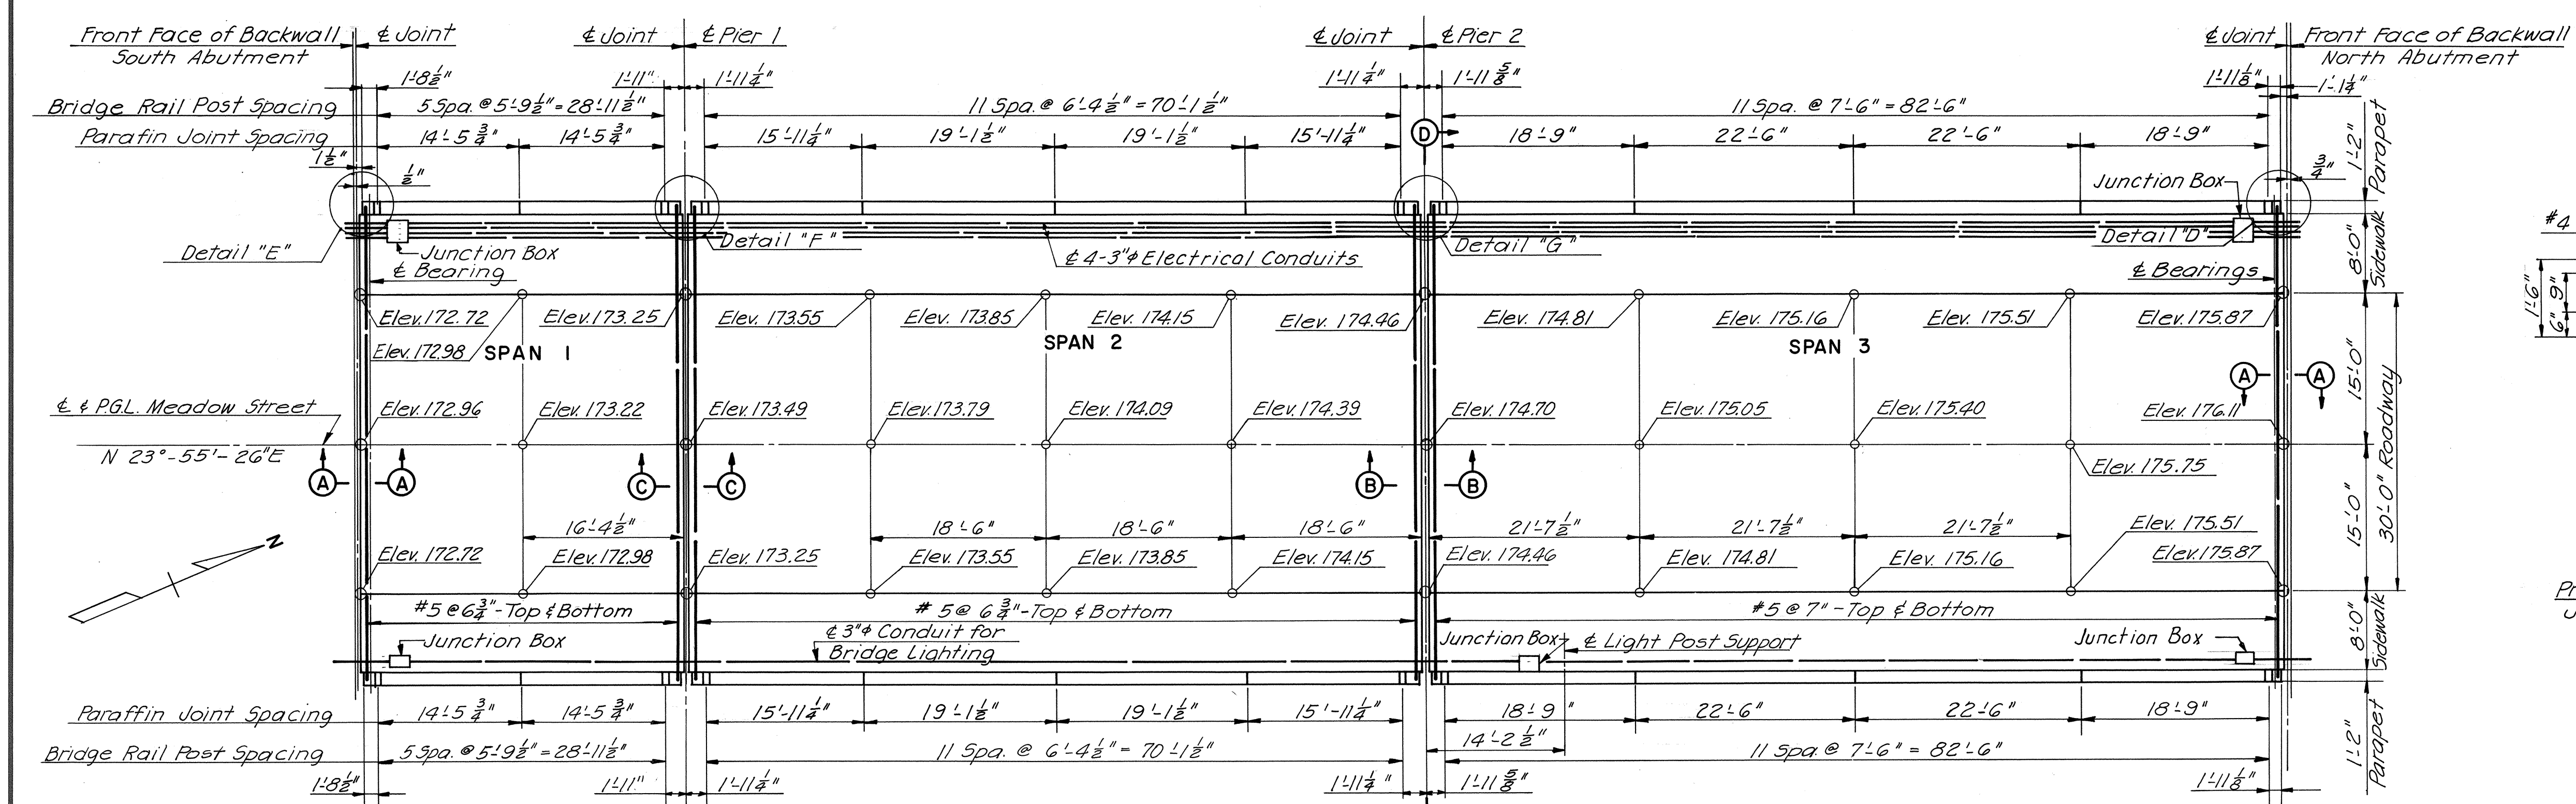


TYPICAL PARAPET ELEVATION  
Scale: 1/2" = 1'-0"

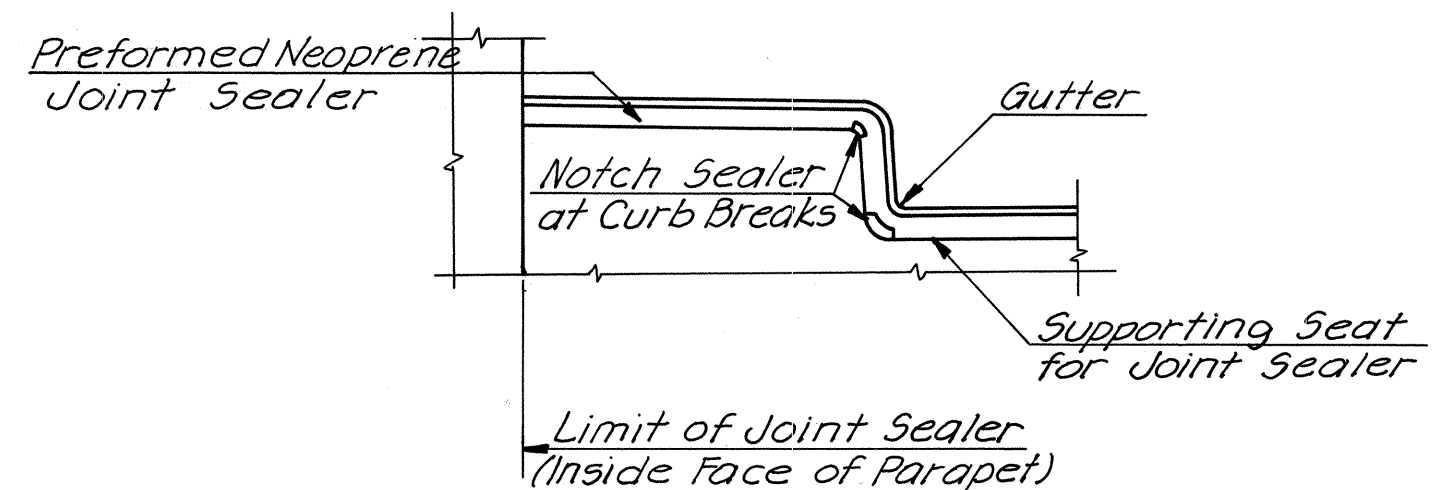


TREATMENT OF JOINT AT CURB  
No Scale

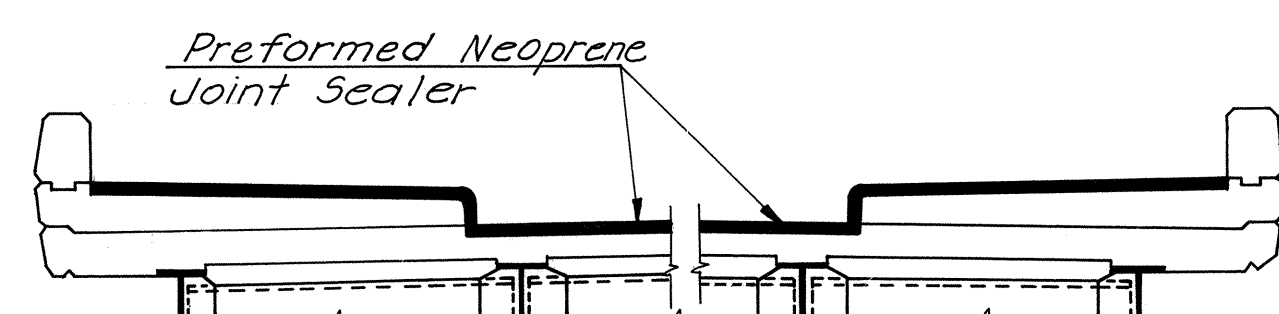


SECTION D-D  
Scale: 1/4" = 1'-0"

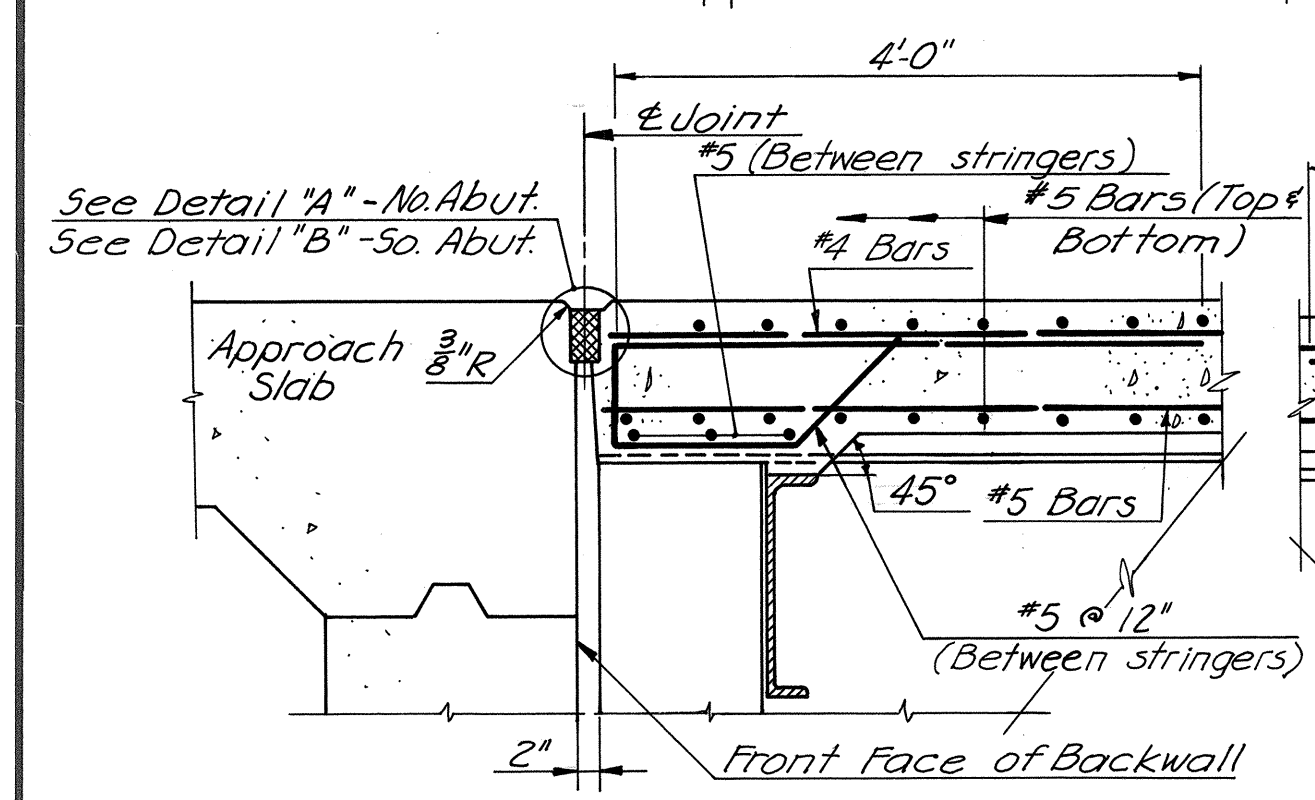


SECTION A-A  
Scale: 3/4" = 1'-0"

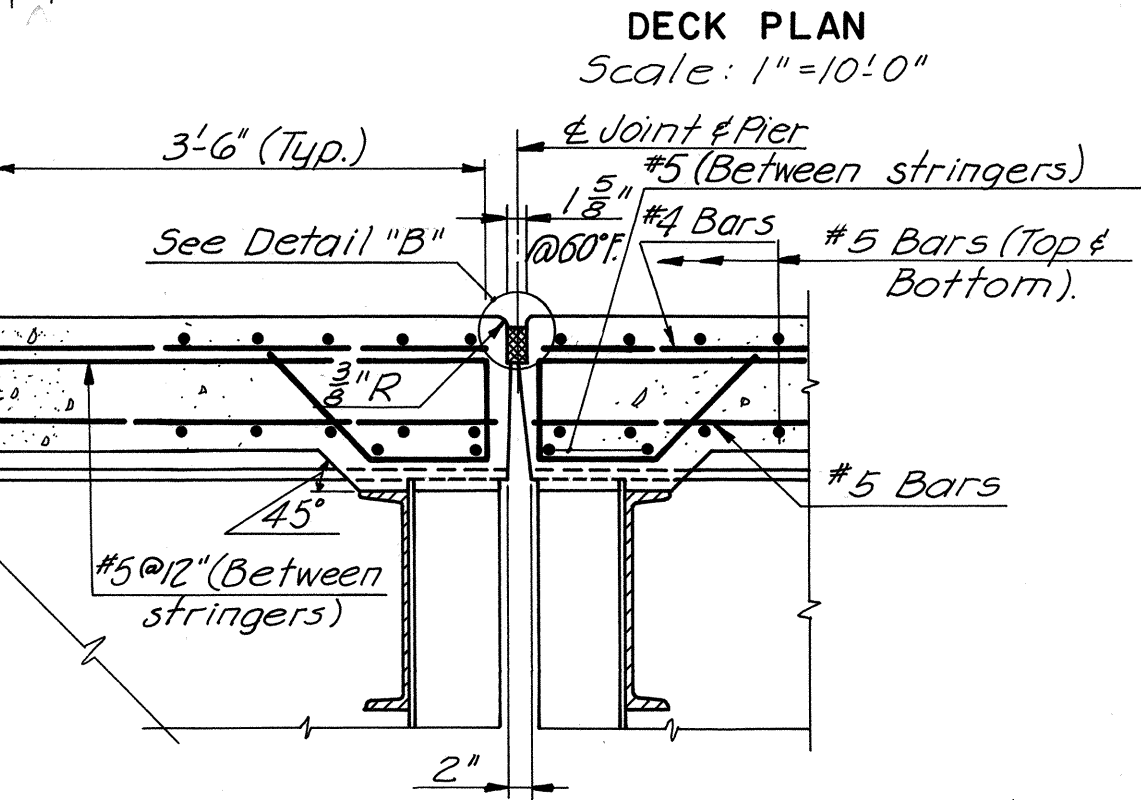


SECTION B-B  
Scale: 3/4" = 1'-0"

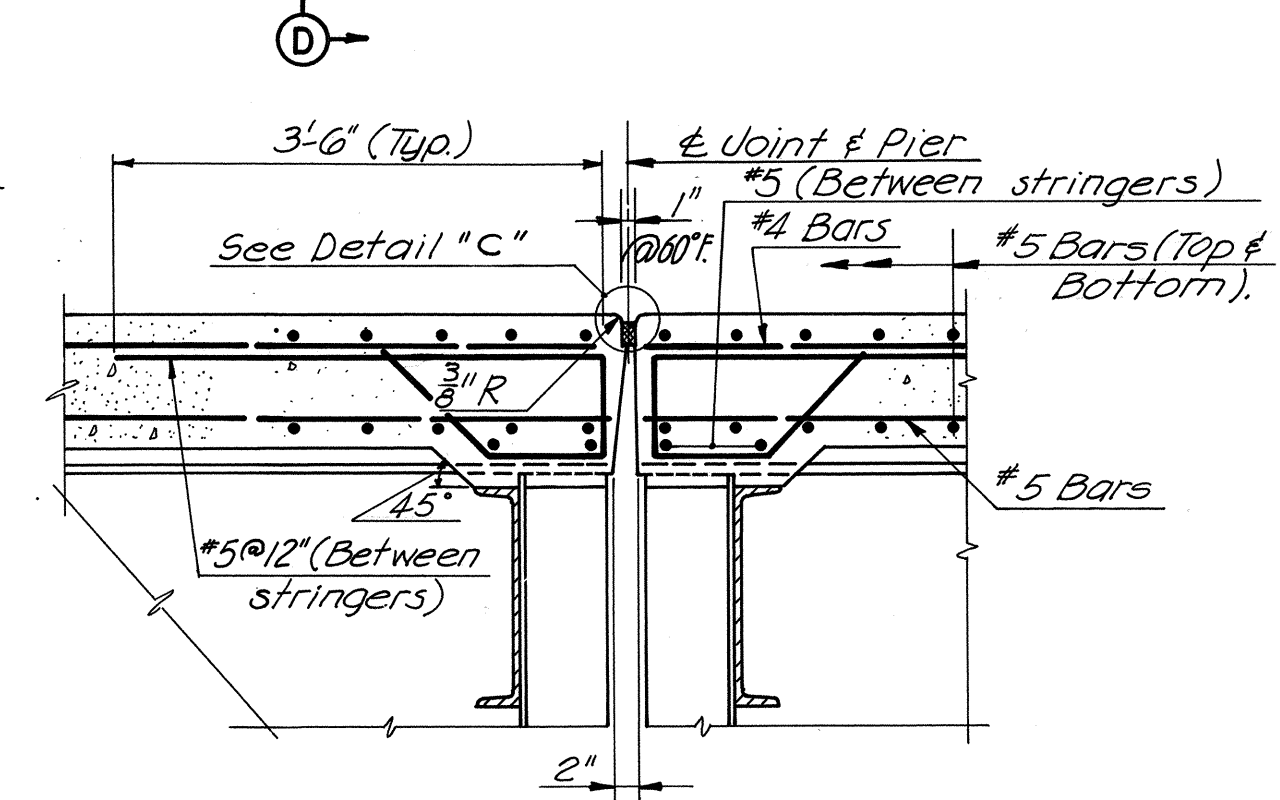


SECTION C-C  
Scale: 3/4" = 1'-0"

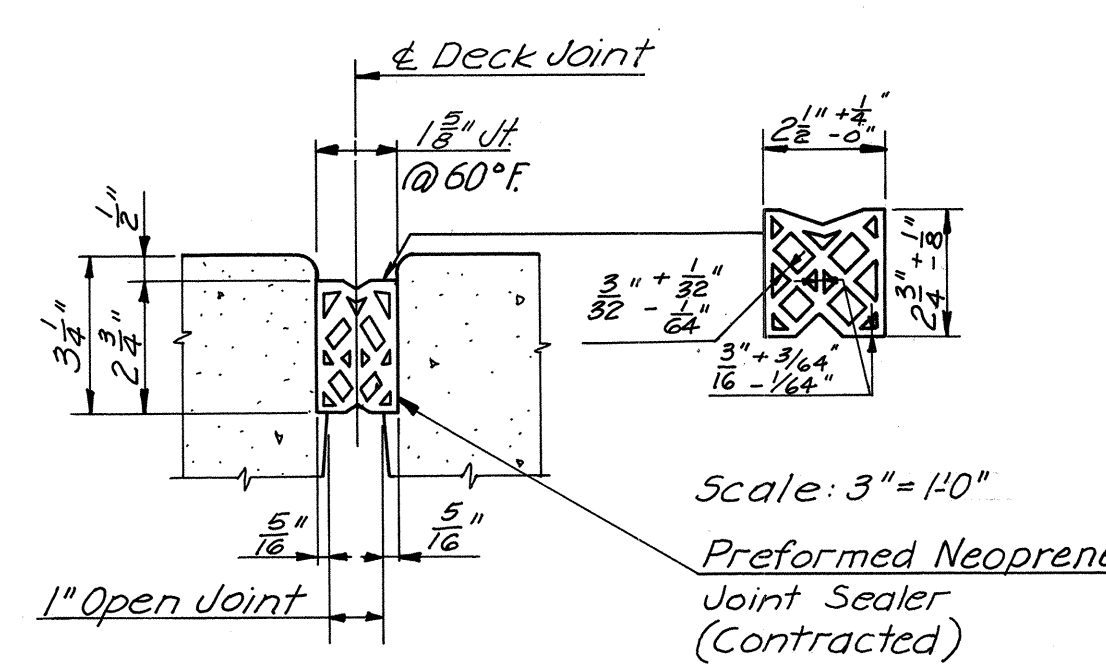


DETAIL "B"  
Scale: 3" = 1'-0"

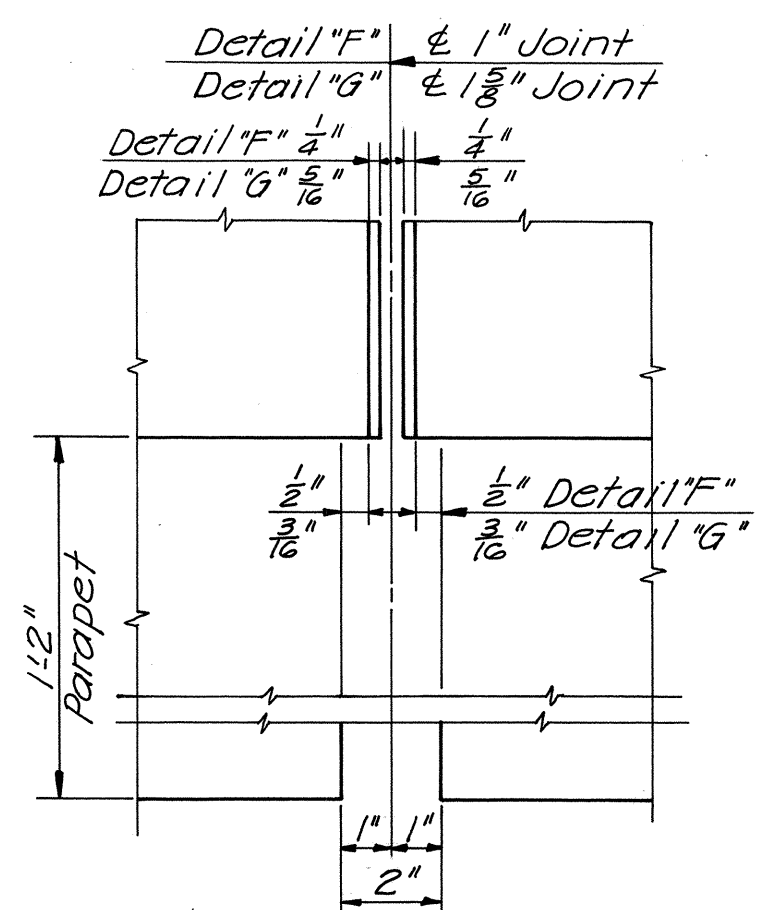


DETAIL "F" 8" 6"  
Scale: 3" = 1'-0"

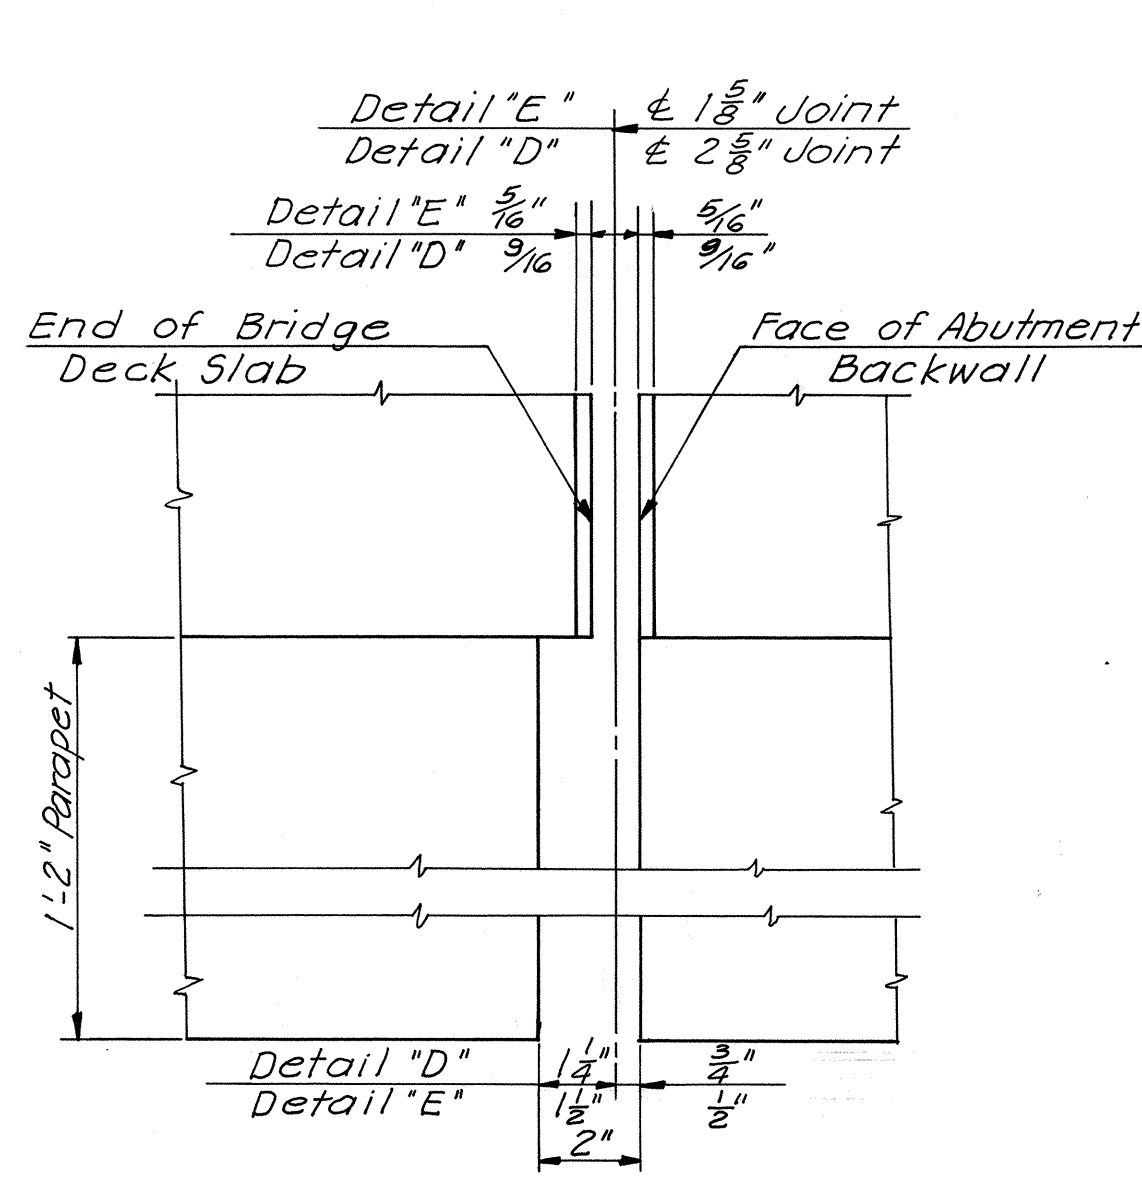

DETAIL "D" 8" 6"  
Scale: 3" = 1'-0"

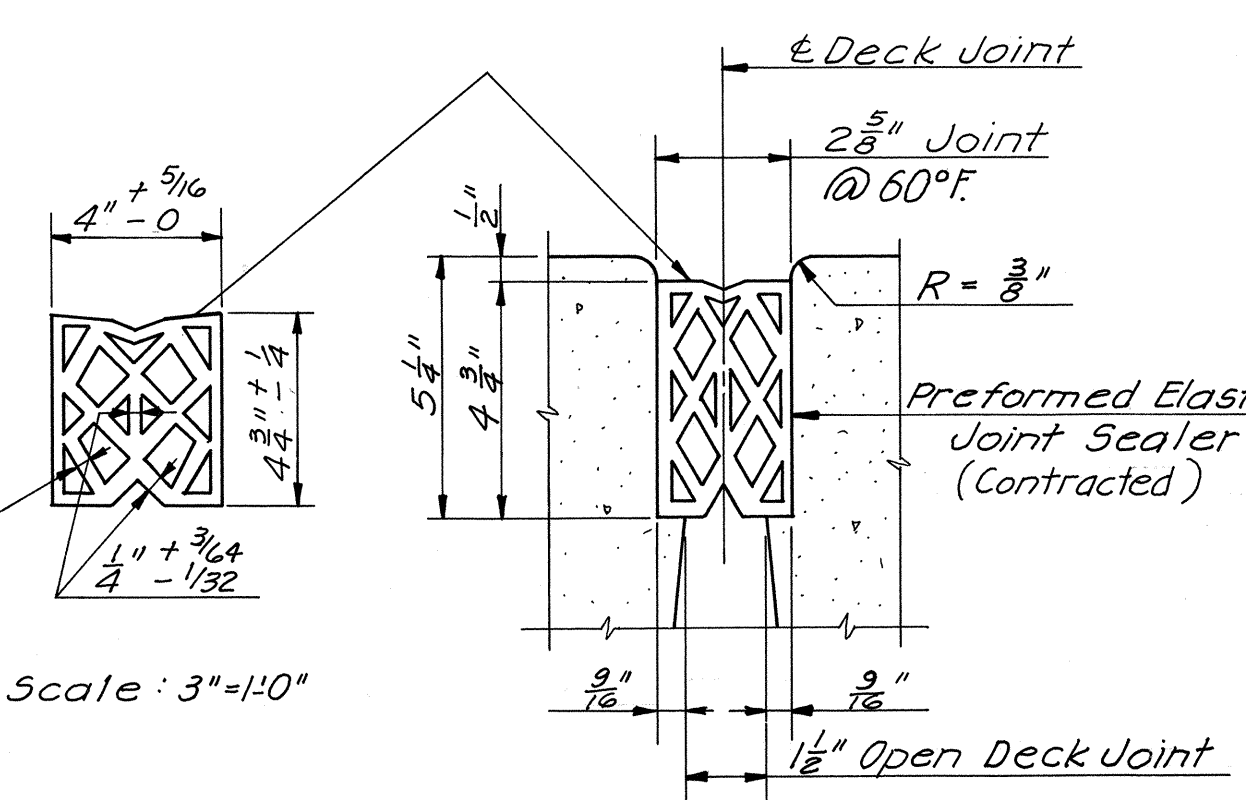

DETAIL "A"  
Scale: 3" = 1'-0"

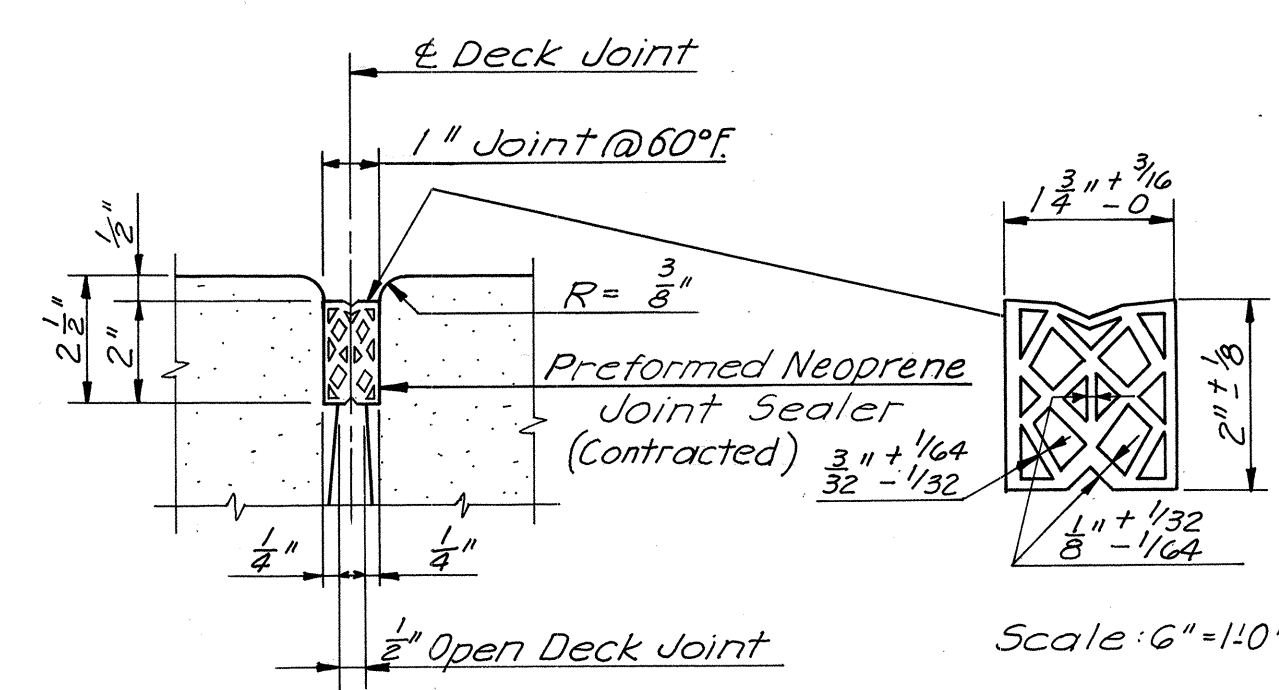

DETAIL "C"  
Scale: 3" = 1'-0"

Note to Contractor:  
It is absolutely essential that the openings for the preformed neoprene joint sealers be accurately formed and constructed to smooth, straight lines. The size of the opening shall be adjusted to allow for anticipated dead load rotation of the ends of the slab and for the temperature at the time of construction.

NOTES:  
For Typical Deck Cross Section, see Sheet 6.  
For General Notes, see Sheet 1.  
For Framing Plan, see Sheet 5.  
For Railing Details, see Sheet 53.  
For Light Post Support Details, see Sheet 54.


AS BUILT

RICHMOND METROPOLITAN AUTHORITY RICHMOND EXPRESSWAY SYSTEM DOWNTOWN EXPRESSWAY	
STRUCTURE B50 LAUREL STREET OVER DOWNTOWN EXPRESSWAY DECK PLAN AND JOINT DETAILS	
AMERICAN ENGINEERS Richmond, Virginia	SCALE: AS NOTED
HOWARD, NEEDLES, TAMMEN & BERGENDOFF General Consultants	CONTRACT NO.: 8
	SHEET NO. 7 OF 9

BY	DATE				
MADE	RPR	8-67			
CHECKED	WEO	9-67			
IN CHARGE	WEO		NO.	REVISION	BY DATE




RICHMOND EXPRESSWAY SYSTEM			
SECTION	PROJECT	SHEET NO.	TOTAL SHEETS
8	DOWNTOWN EXPRESSWAY	229	

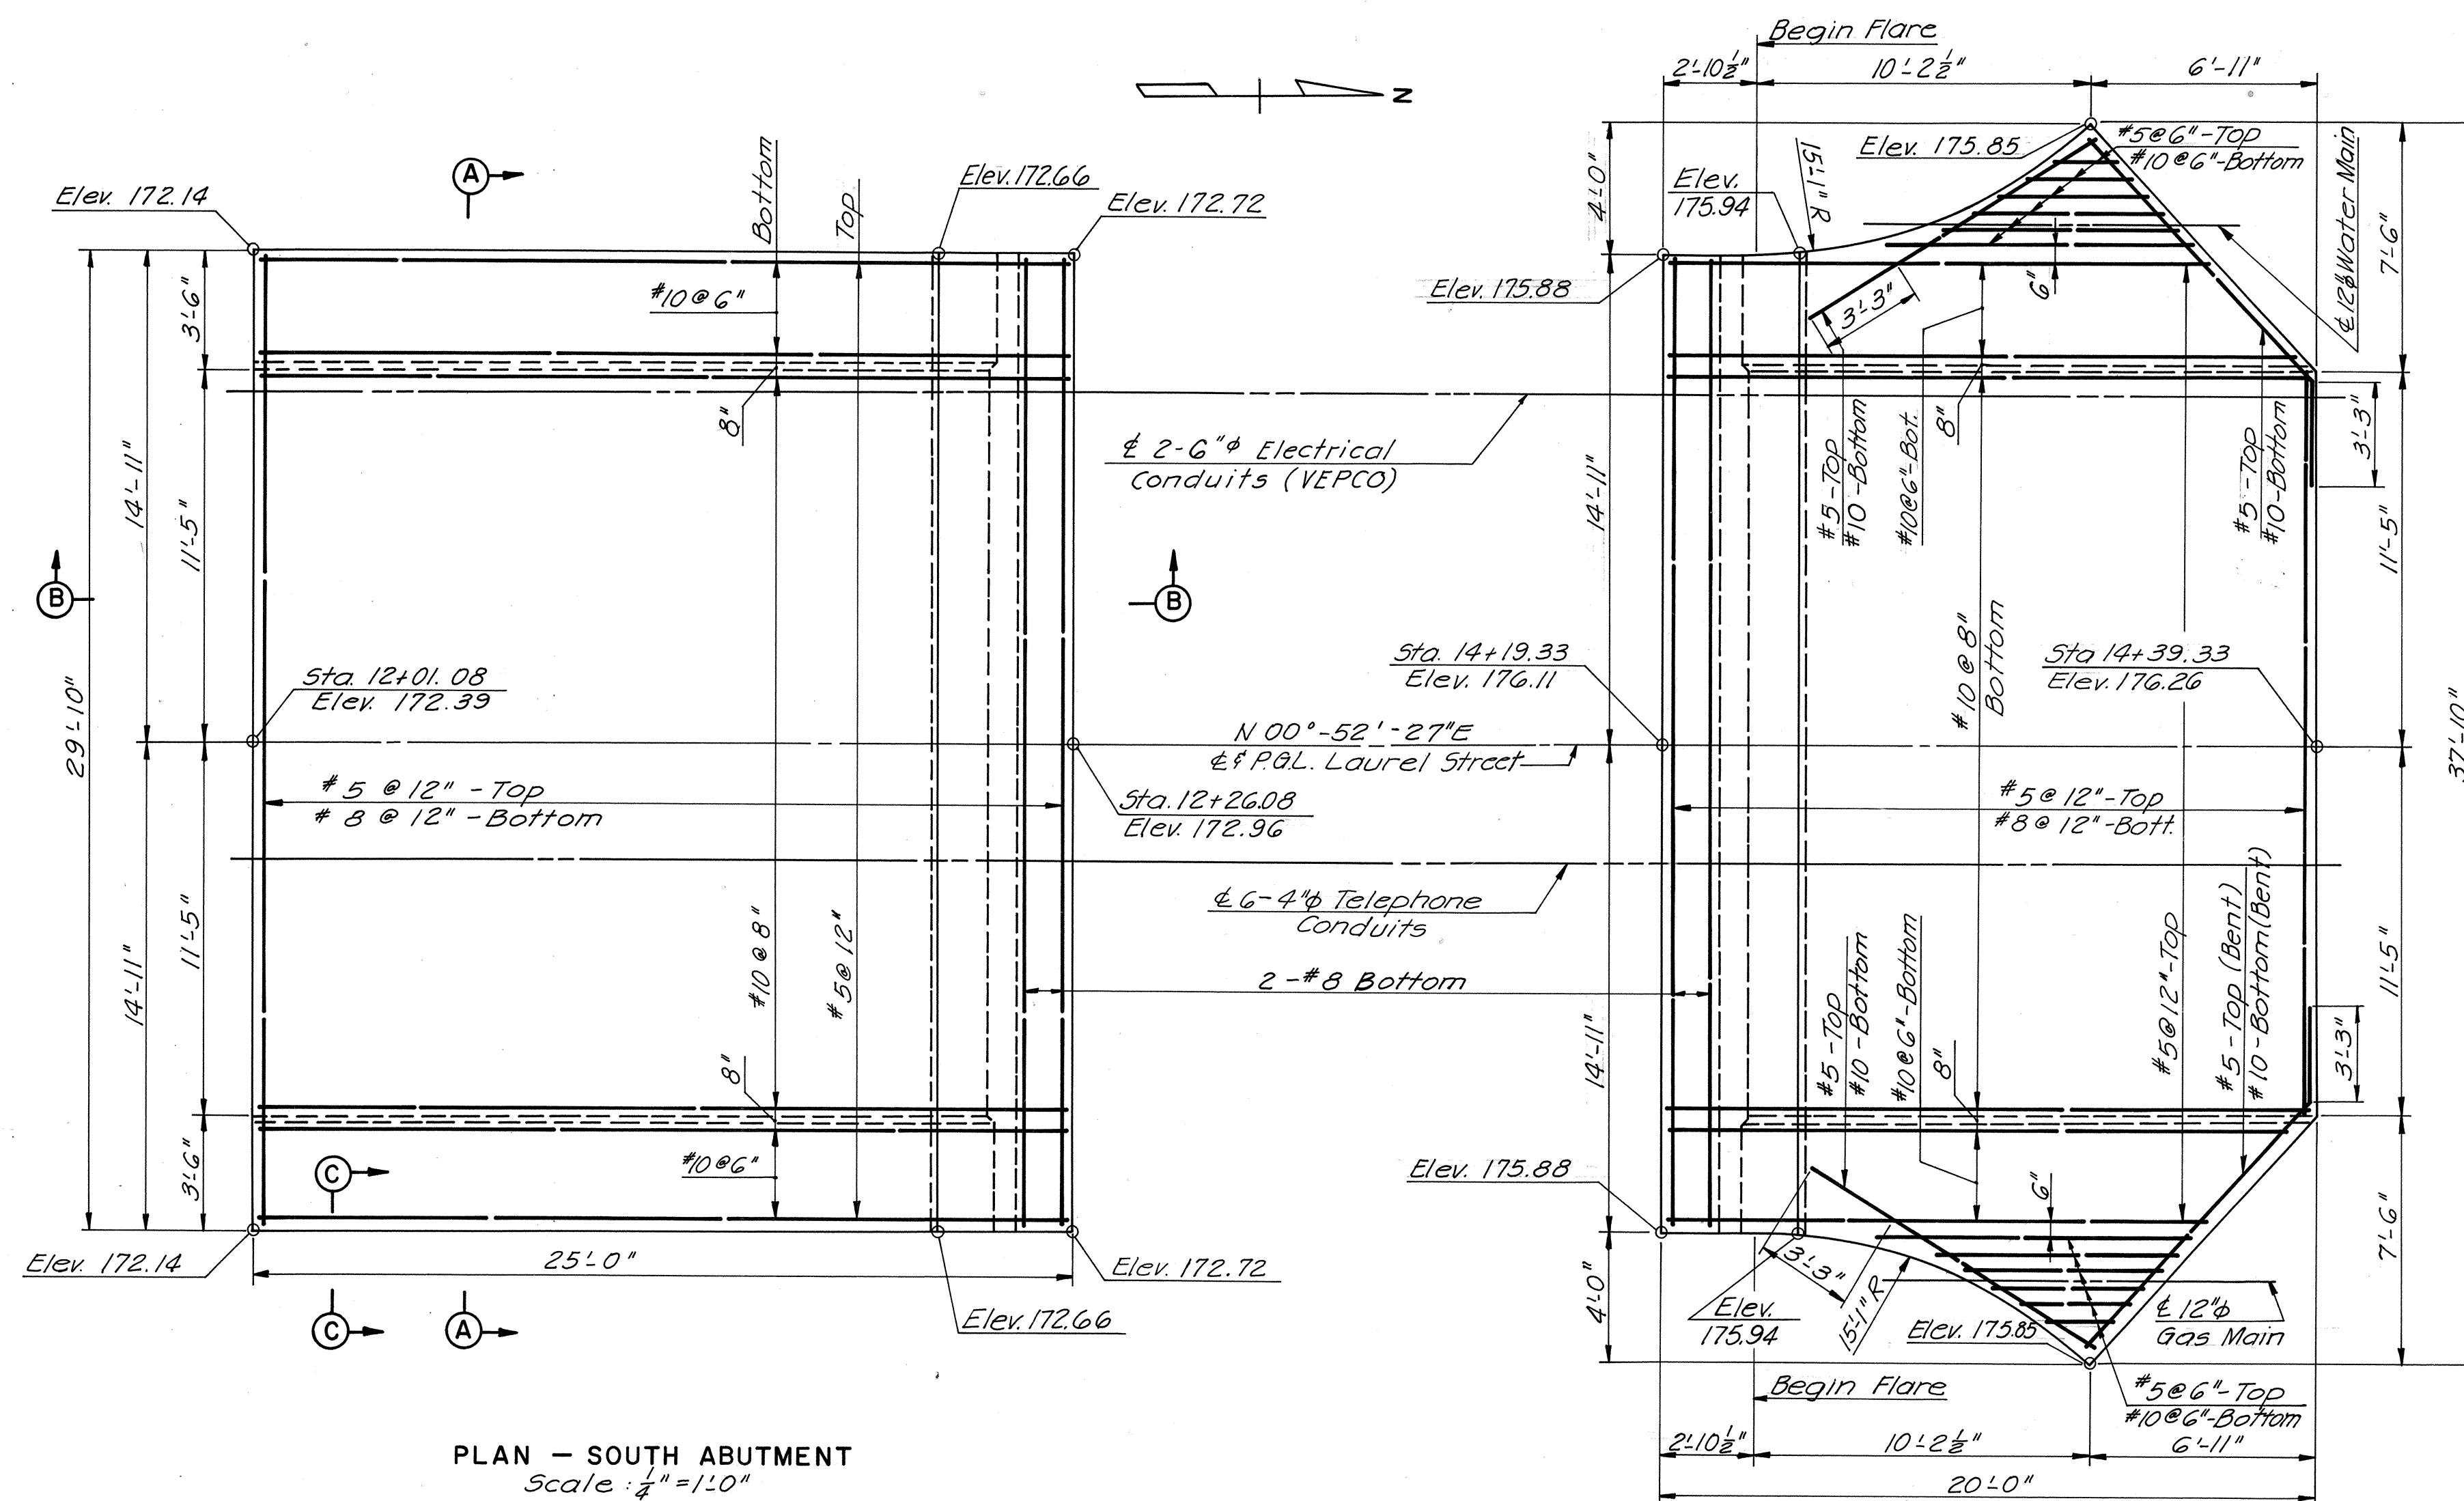


PLAN - SOUTH ABUTMENT  
Scale:  $\frac{1}{4}$ " = 1'-0"

PLAN - NORTH ABUTMENT  
Scale:  $\frac{1}{4}$ " = 1'-0"

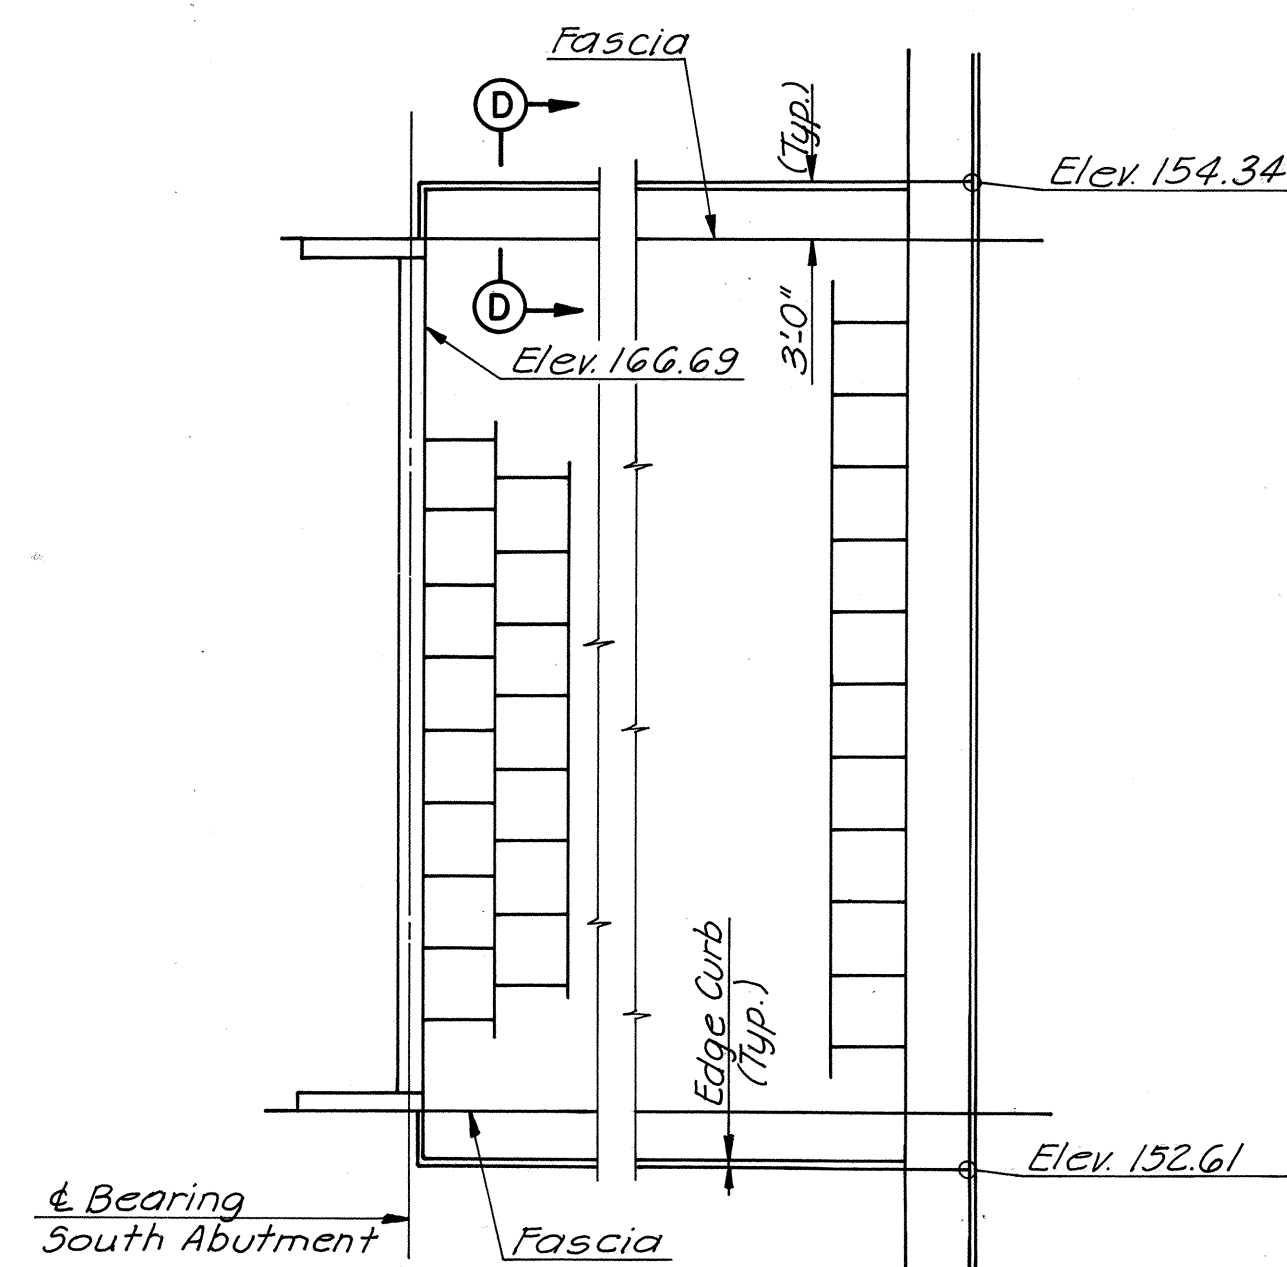

PLAN - SLOPE PROTECTION  
Scale:  $\frac{3}{32}$ " = 1'-0"

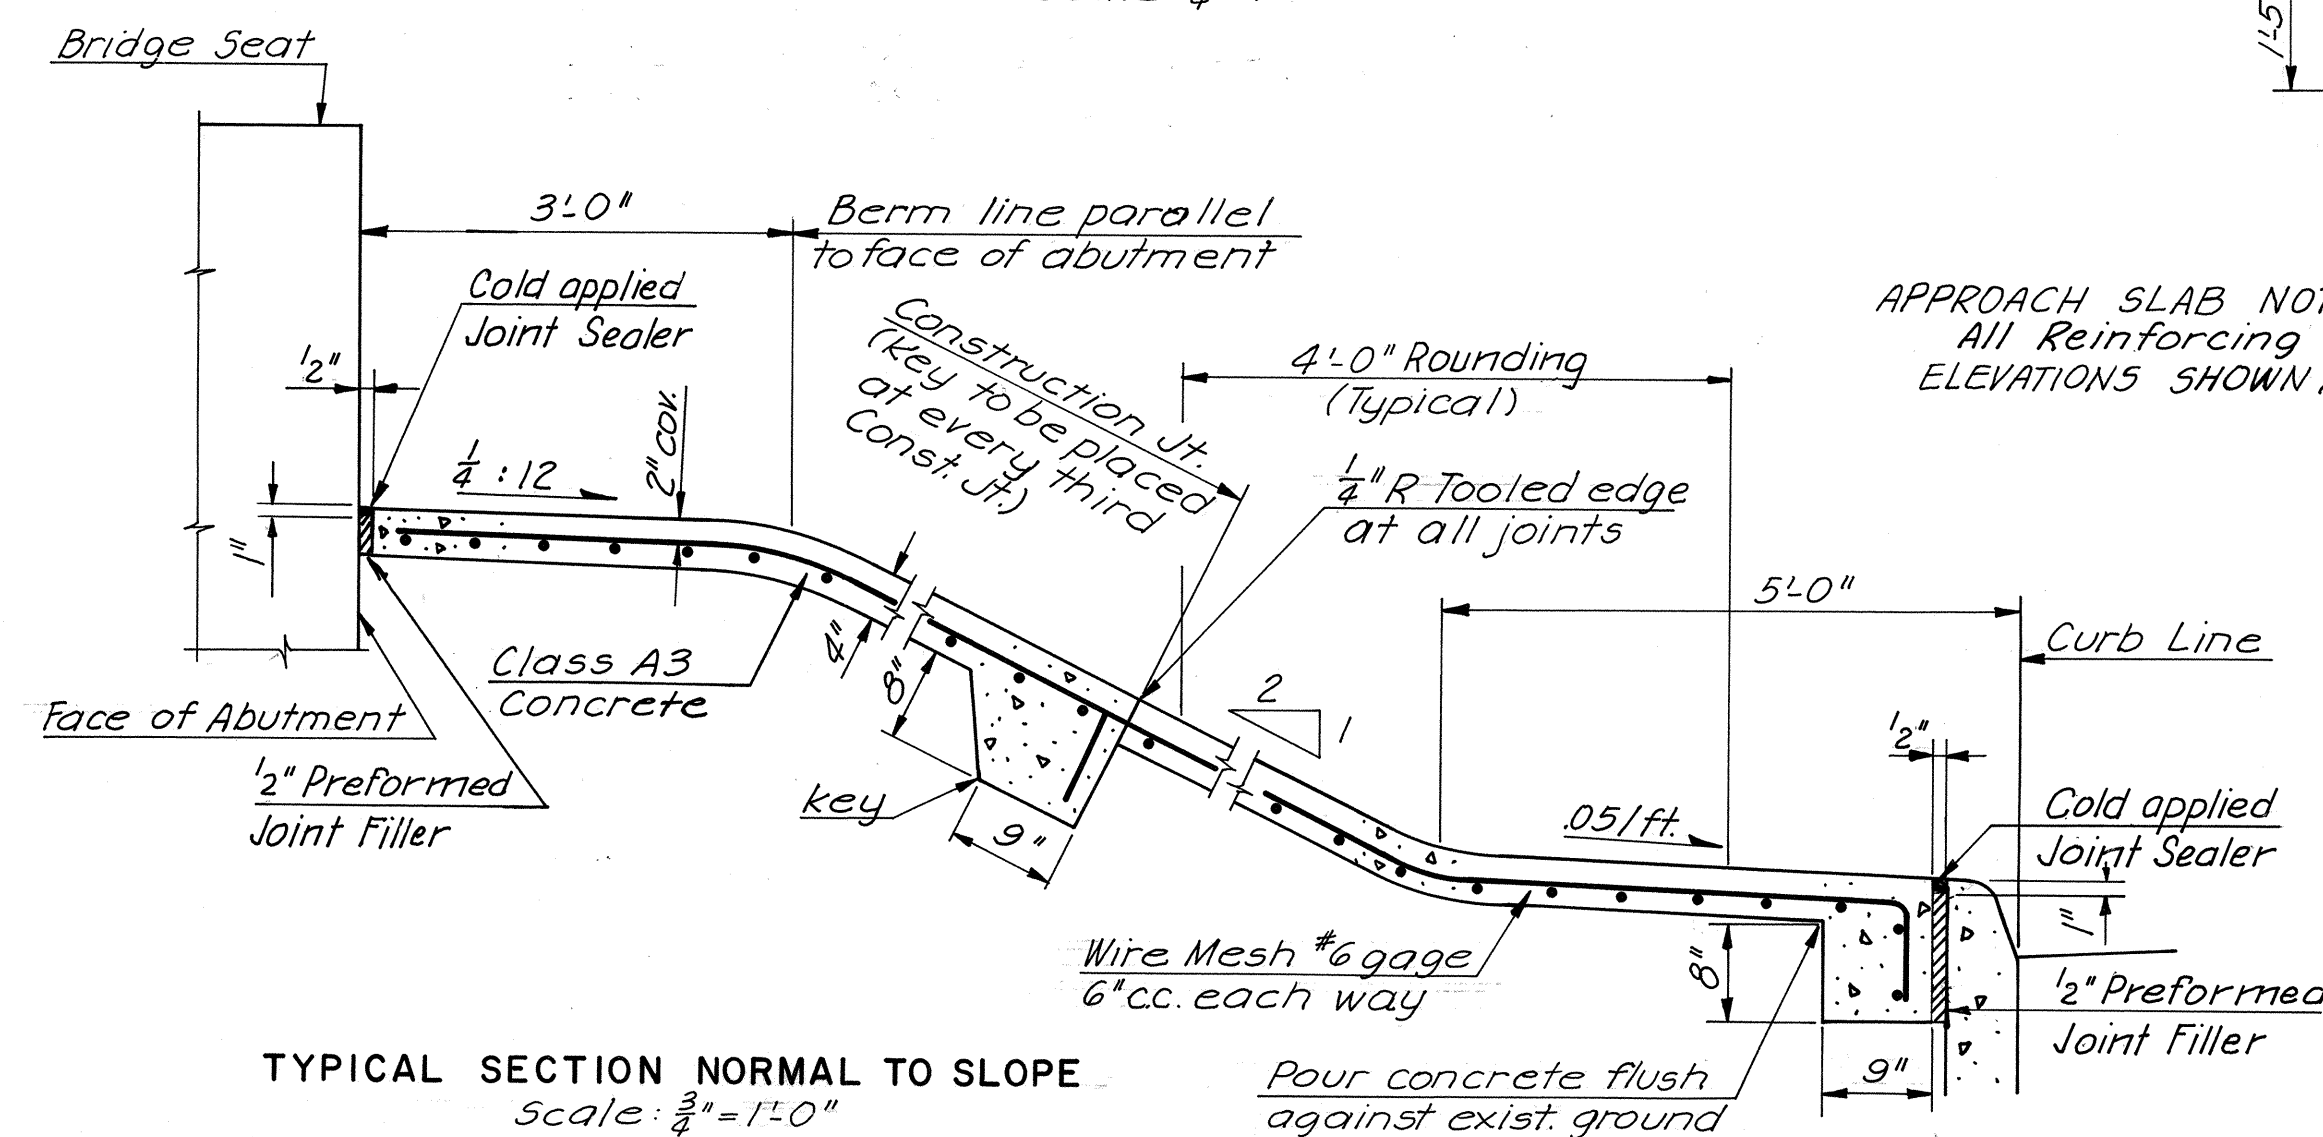


TYPICAL SECTION NORMAL TO SLOPE  
Scale:  $\frac{3}{4}$ " = 1'-0"

#### SLOPE PROTECTION NOTES:


The Item "Concrete Slope Protection" shall include the excavation of or the placing and compaction of any embankment material necessary to bring the surface of the paved slopes of the finished elevations shown on the plans. "Concrete Slope Protection" shall be paid for at the contract unit price per square yard, which price shall include the concrete slab including wire mesh and joint filler.

The slab shall be constructed in 4'-0" x 4'-0" panels, placed in horizontal courses, alternate panels poured in a staggered pattern with adjacent panels poured later. The slab shall be Class A3 concrete of such consistency that it can be placed without the use of top forms, the surface shall be finished with a wood float.


Reinforcement shall consist of wire mesh #6 gage, 6" cc. each way, placed at the center of the slab, and continuous through construction joints.

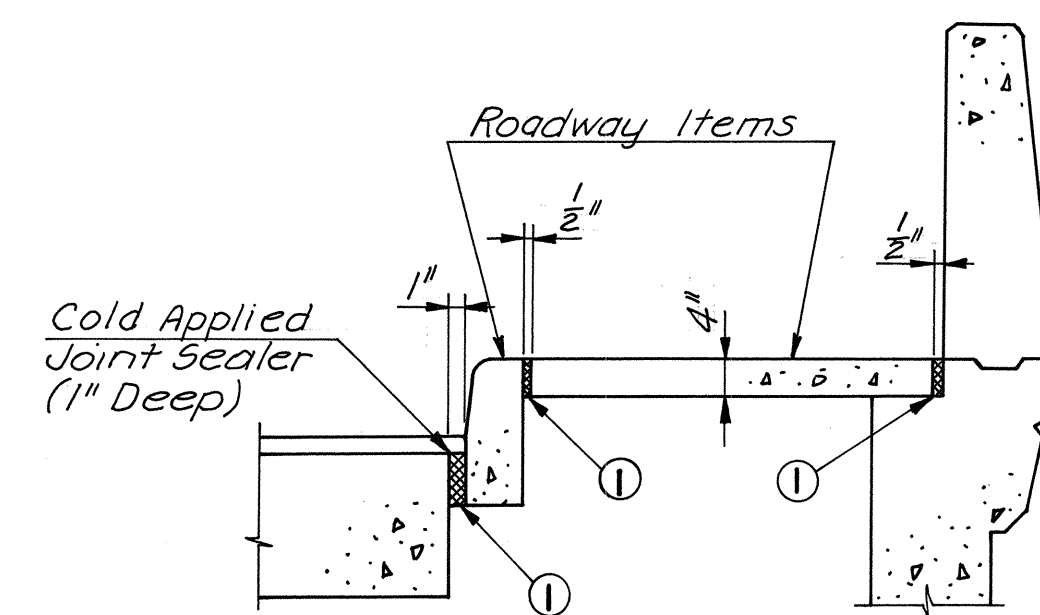

① Preformed Expansion Joint Material  
SECTION C-C  
Scale:  $\frac{1}{4}$ " = 1'-0"

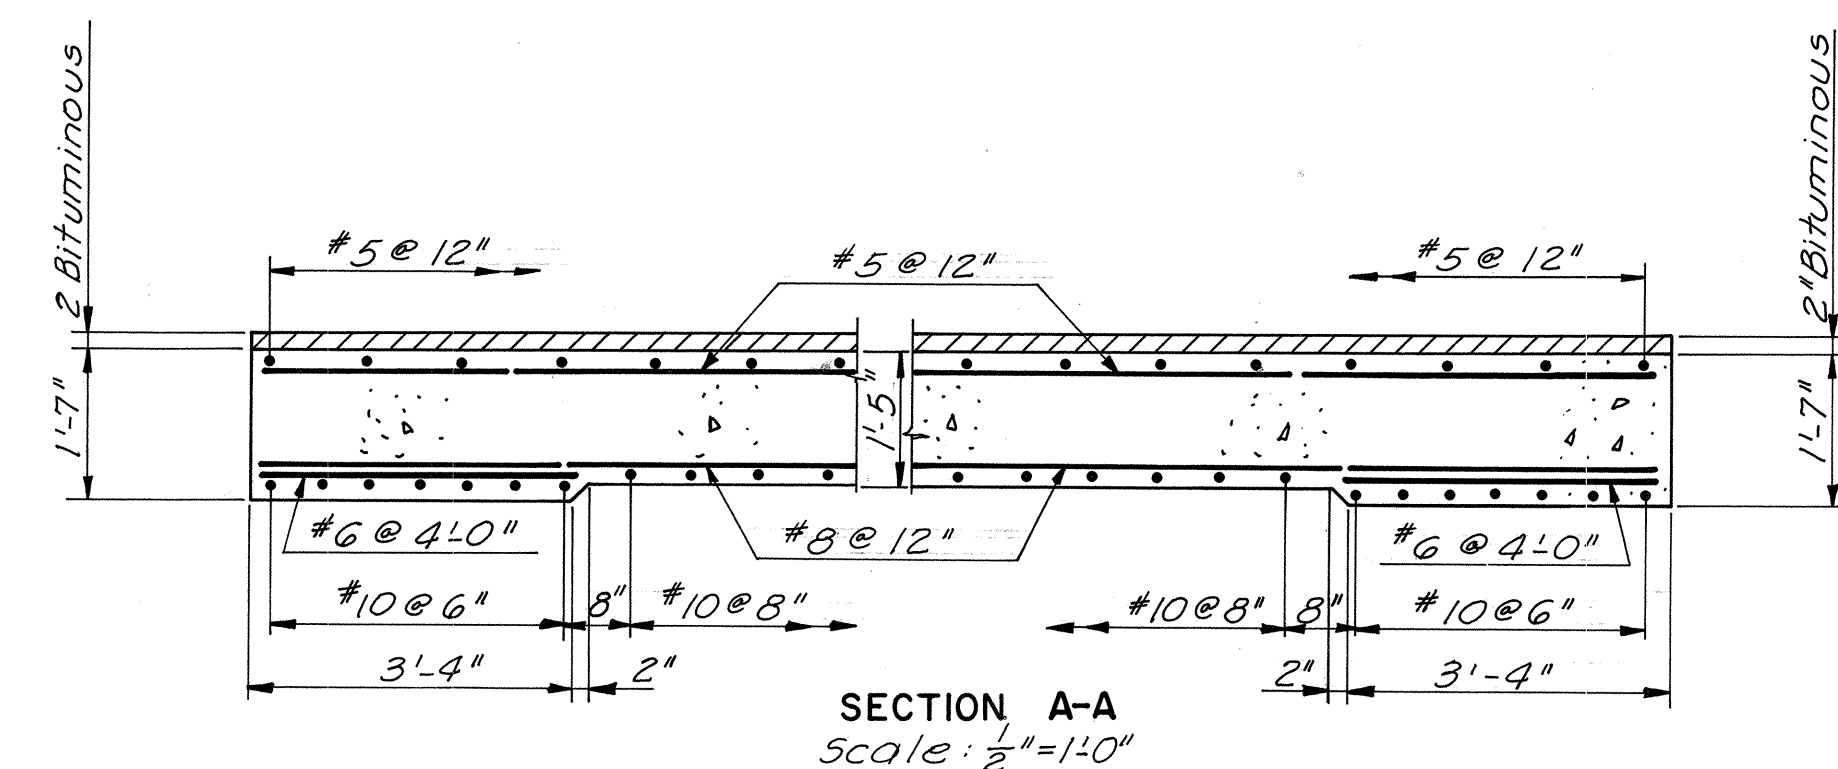


SECTION A-A  
Scale:  $\frac{1}{2}$ " = 1'-0"

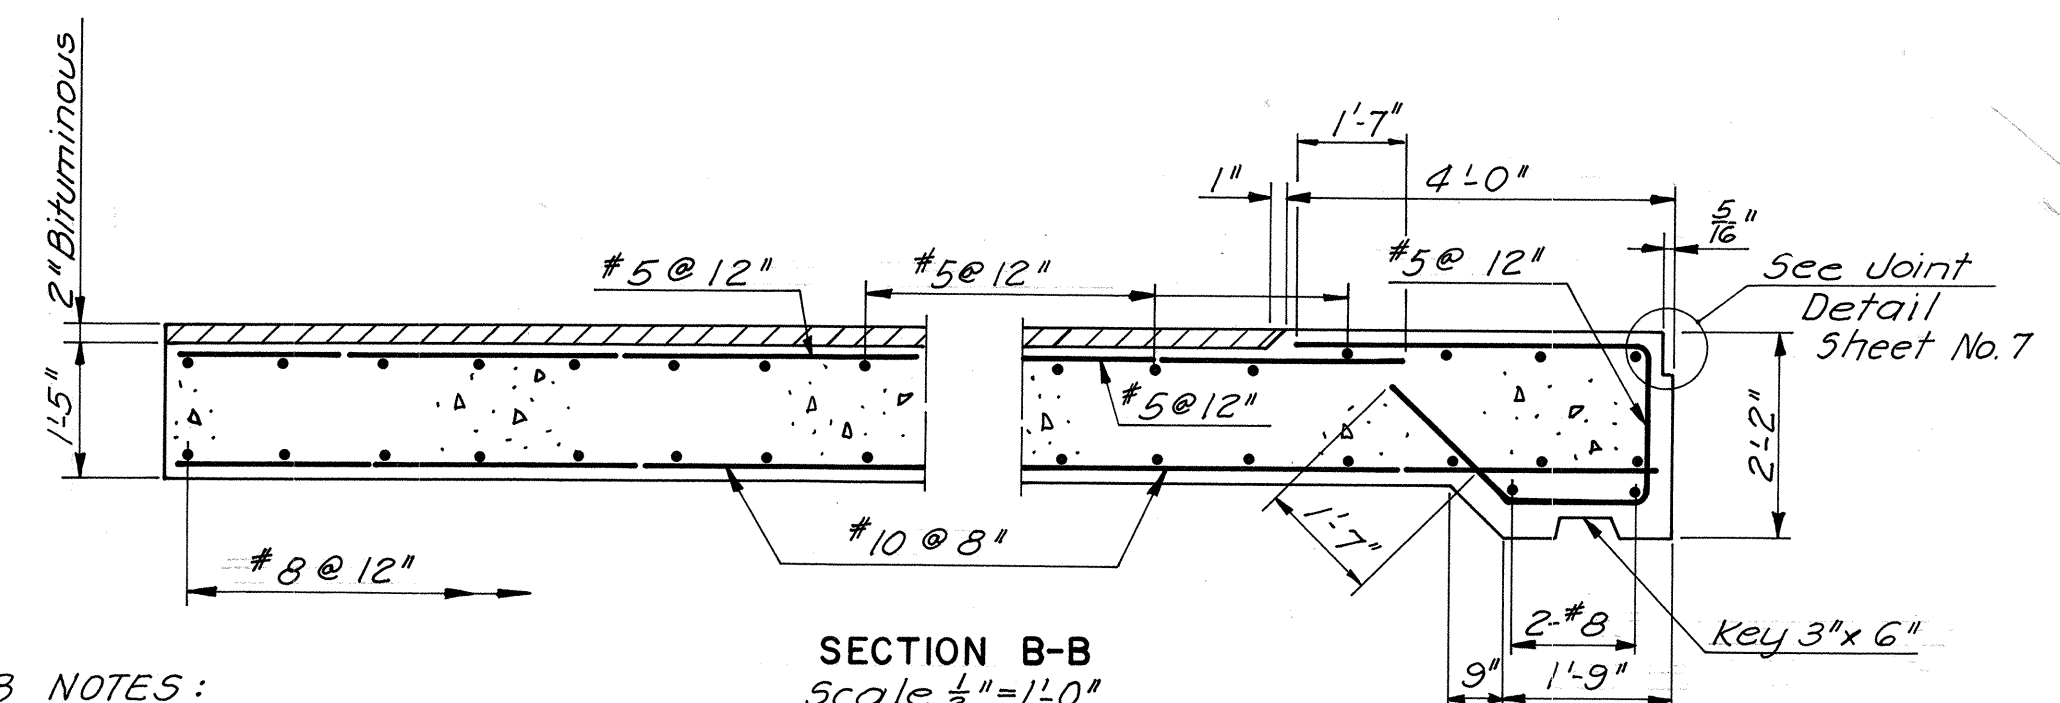

SECTION B-B  
Scale:  $\frac{1}{2}$ " = 1'-0"

APPROACH SLAB NOTES:  
All Reinforcing steel shall be 2" clear.  
ELEVATIONS SHOWN ARE TO TOP OF CONCRETE.

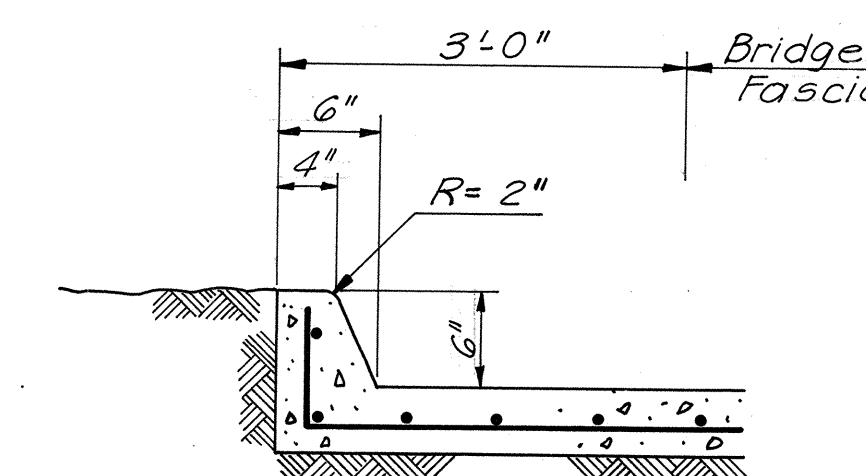

SECTION D-D  
No Scale

# AS BUILT

RICHMOND METROPOLITAN AUTHORITY RICHMOND EXPRESSWAY SYSTEM DOWNTOWN EXPRESSWAY	
STRUCTURE B 50 LAUREL STREET OVER DOWNTOWN EXPRESSWAY APPROACH SLAB & SLOPE PROTECTION DETAILS	
AMERICAN ENGINEERS Richmond, Virginia	SCALE: AS NOTED
HOWARD, NEEDLES, TAMMEN & BERGENOFF General Consultants	CONTRACT NO.: 8
	SHEET NO. 8 OF 9

BY	DATE			
MADE	R.P.R. 8-67			
CHECKED	W.E.O. 9-67			
IN CHARGE	W.E.O.	NO.	REVISION	BY DATE



# **Bridge 51**

**(South Belvidere Street  
Over Downtown Expressway {Rte. 195})**

**Record Set Plans**



RICHMOND EXPRESSWAY SYSTEM			
SECTION	PROJECT	SHEET NO.	TOTAL SHEETS
8	DOWNTOWN EXPRESSWAY	231	

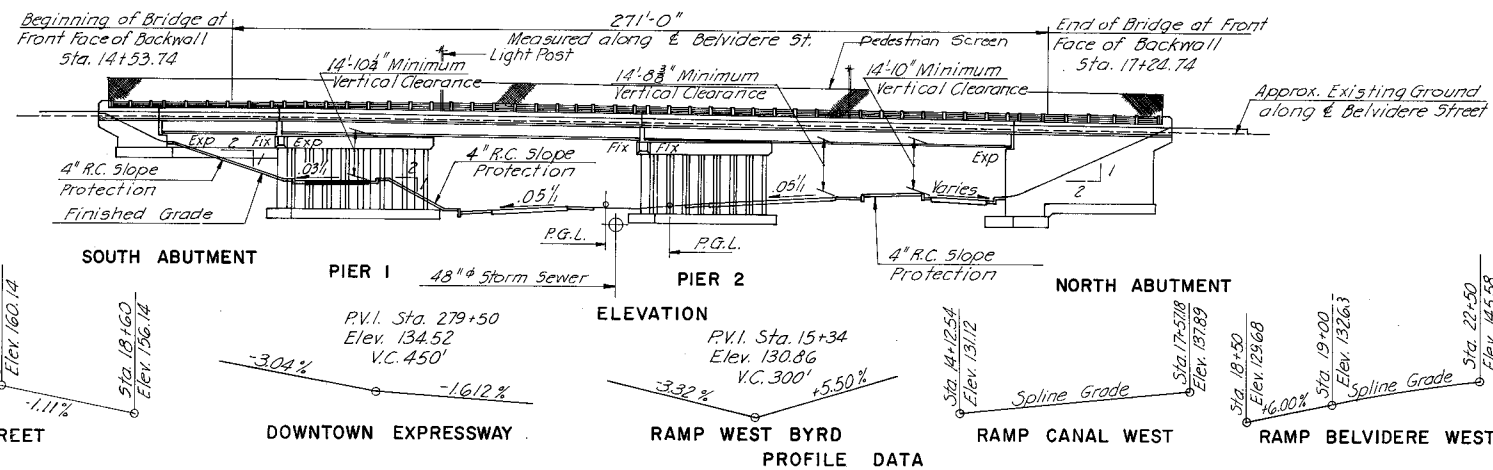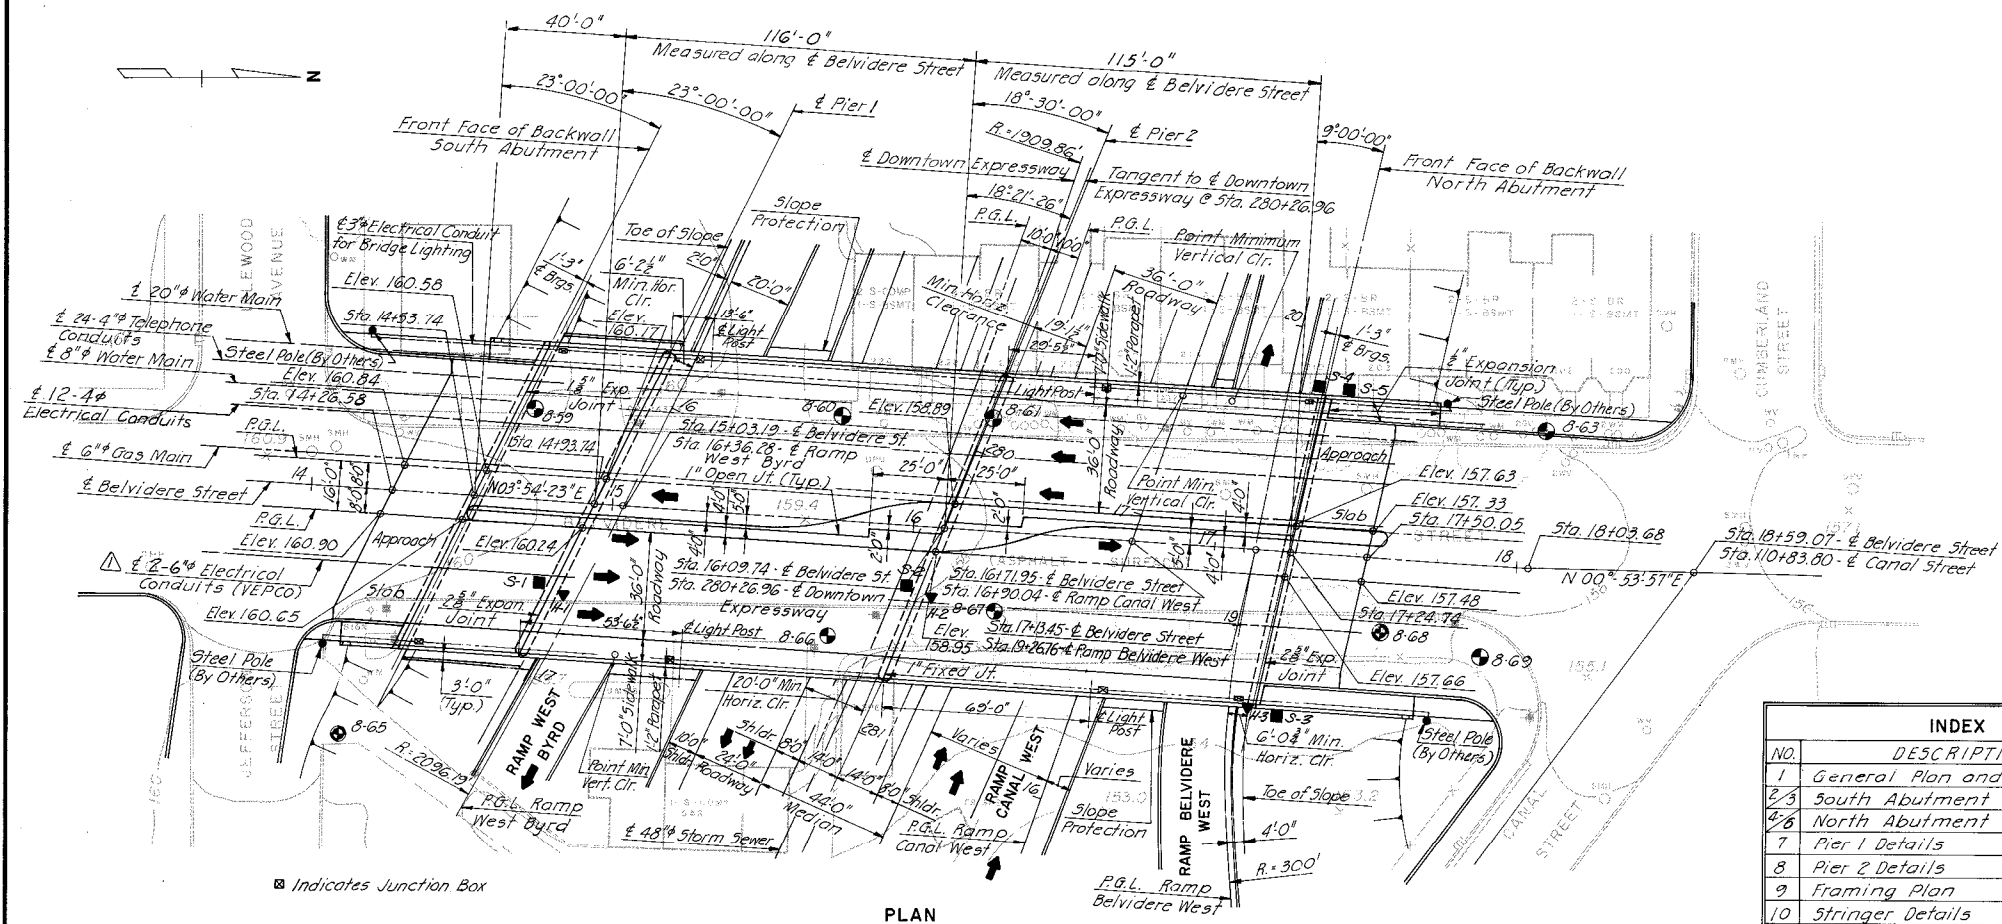

INDEX	
NO.	DESCRIPTION
1	General Plan and Elevation
2/3	South Abutment
4/6	North Abutment
7	Pier 1 Details
8	Pier 2 Details
9	Framing Plan
10	Stringer Details
11	Cross Section
12	Diaphragm Details
13	Utility Details
14	Deck Plan
15	Joint Details
16	Approach Slab - South Abutment
17	Approach Slab - North Abutment
18	Slope Protection Details
19/21	Boring Logs
51	Standard Shoe Details
53	Standard Aluminum Railing Details
54	Standard Electrical Details
57/58	Standard Architectural Details
510	Standard Elect and Tele Cond Details
511	Standard Utility Support details @ Abut.

#### GENERAL NOTES:

- ROADWAY:** Two 36'-0" Clear roadways. Two 7'-0" Sidewalks. One variable median.
- CAPACITY:** Dead Load - includes 15 lbs. per sq. ft. for future wearing surface.  
Live Loads - HS20-44 loading and B.P.R. modified for military vehicles.
- SPECIFICATIONS:** GENERAL - Virginia Department of Highway Road and Bridge Specifications 1970  
DESIGN - A.A.S.H.O. Standard Specifications for Highway Bridges, 1961 modified by Special Design Provisions.  
WELDING - 1969 Standard Specifications for welded Highway and Railway Bridges of the American Welding Society.
- CONTRACT SPECIAL PROVISIONS:**  
Specifications and Contract Special Provisions referred to above are necessary to make these Plans complete.
- DATUM:** CITY OF RICHMOND
- TEMPERATURE:** The normal temperature referred to on the plan is 60°F. The temperature range for movement is 0°F to 120°F.
- DIMENSIONS:** All dimensions are measured horizontally and vertically unless otherwise noted.
- EXCAVATION:** Excavation below subgrade and cut slope template shall be classified as Structure Excavation. All excavation above these limits shall be classified as Regular Excavation and is not included in the Structural Quantities.
- FOUNDATIONS:** Footings shall rest on firm material. Foundation material shall be kept dry and special attention is called to Section 401.05 of the General Specifications, and to the Contract Special Provisions, concerning preparation of foundations for footings.

#### CONCRETE NOTES:

Concrete in superstructure shall be Class A4. All other concrete shall be Class A3. All exposed edges and corners shall have a 3/4" chamfer or fillet unless otherwise noted. Care in the method of vibration, the use of low-slump concrete and/or other means shall be employed to prevent downgrade movement of newly placed slab concrete. (When gradient is over 2%).  
Finishing concrete surfaces: See the Standard Architectural Detail Sheets and the Contract Special Provisions for types and details.

All reinforcing steel shall conform to ASTM A615 Grade 40. All reinforcing bar dimensions on the detailed drawings are to centers of bars unless otherwise noted. Clear distance between reinforcing steel and face of concrete shall be as noted on the plans. All bar laps shall be 30 diameters of the smaller diameter bar unless otherwise noted.

#### STEEL NOTES:

Structural steel shall conform to A.S.T.M. Specification A36 except as noted.  
All field connections shall be made with high strength bolts. High strength bolts shall be 3/4" unless otherwise noted and shall conform to A.S.T.M. Specification A-325.

#### BENCH MARK:

C-40 Monument located at S.E. corner Idlewood Avenue and Belvidere Street. Elev. 160.76.

#### ESTIMATED QUANTITIES

	STRUCTURE EXCAVATION	CONCRETE CLASS A4	CONCRETE CLASS A3	REINFORCING STEEL	STRUCTURAL STEEL	ALUMINUM BRIDGE RAILING	CONCRETE SLOPE PROTECTION	ASPHALT DAMP-PROOFING	6" INCH PIPE UNDERDRAIN	POROUS BACKFILL	GAS MAIN	WATER MAIN	WATER MAIN	CONDUIT	CONDUIT	Pedestrian Screen	CONDUIT	3" PVC CONDUIT	2" METAL CONDUIT
	C.Y.	C.Y.	C.Y.	LBS.	LBS.	L.F.	S.Y.	S.Y.	L.F.	C.Y.	L.F.	L.F.	L.F.	L.F.	L.F.	L.F.	L.F.	L.F.	L.F.
Superstructure		962.16		224,141	1,324,511.8	658													
South Abutment	475		234.47	11,589			564.9	228	126	76									
Pier 1	598		258.89	80,865			295.1												
Pier 2	318		258.71	48,366															
North Abutment	1,194		891.55	15,607			131.2	468	170	289									
Approach Slabs			258.08	58,162															
Total	2,505	962.16	1,901.70	468,730	1,324,511.8	658	991.2	696	296	365	323	247	313	664	6,504	665	3,252	570	16

BY	DATE	AS BUILT	HMM	4-76
MADE	WDO 10-67	Rev. VEPCO	DGT	11-12-74
CHECKED	WEO 12-67	REVISION	BY	DATE
IN CHARGE	WEO			

NOTES: Top of Pavement Elevations at ends of Deck along P.G.L.'s are given on Plan; Remaining Pavement Elevations are given on Sheet 14.  
● Indicates 2 1/2" Cased Hole Boring.  
○ Indicates 4" Cased Hole Boring  
▼ Indicates Geonor Heave Points  
■ Indicates Settlement Points


# AS BUILT

RICHMOND METROPOLITAN AUTHORITY  
RICHMOND EXPRESSWAY SYSTEM  
DOWNTOWN EXPRESSWAY

STRUCTURE B 51  
BELVIDERE STREET OVER  
DOWNTOWN EXPRESSWAY  
GENERAL PLAN AND ELEVATION

AMERICAN ENGINEERS Richmond, Virginia	SCALE: 1"=30'-0"
HOWARD, NEEDLES, TAMMEN & BERGENDOFF General Consultants	CONTRACT NO. 8
	SHEET NO. 1 OF 21

RICHMOND EXPRESSWAY SYSTEM			
SECTION	PROJECT	SHEET NO.	TOTAL SHEETS
8	DOWNTOWN EXPRESSWAY	239	

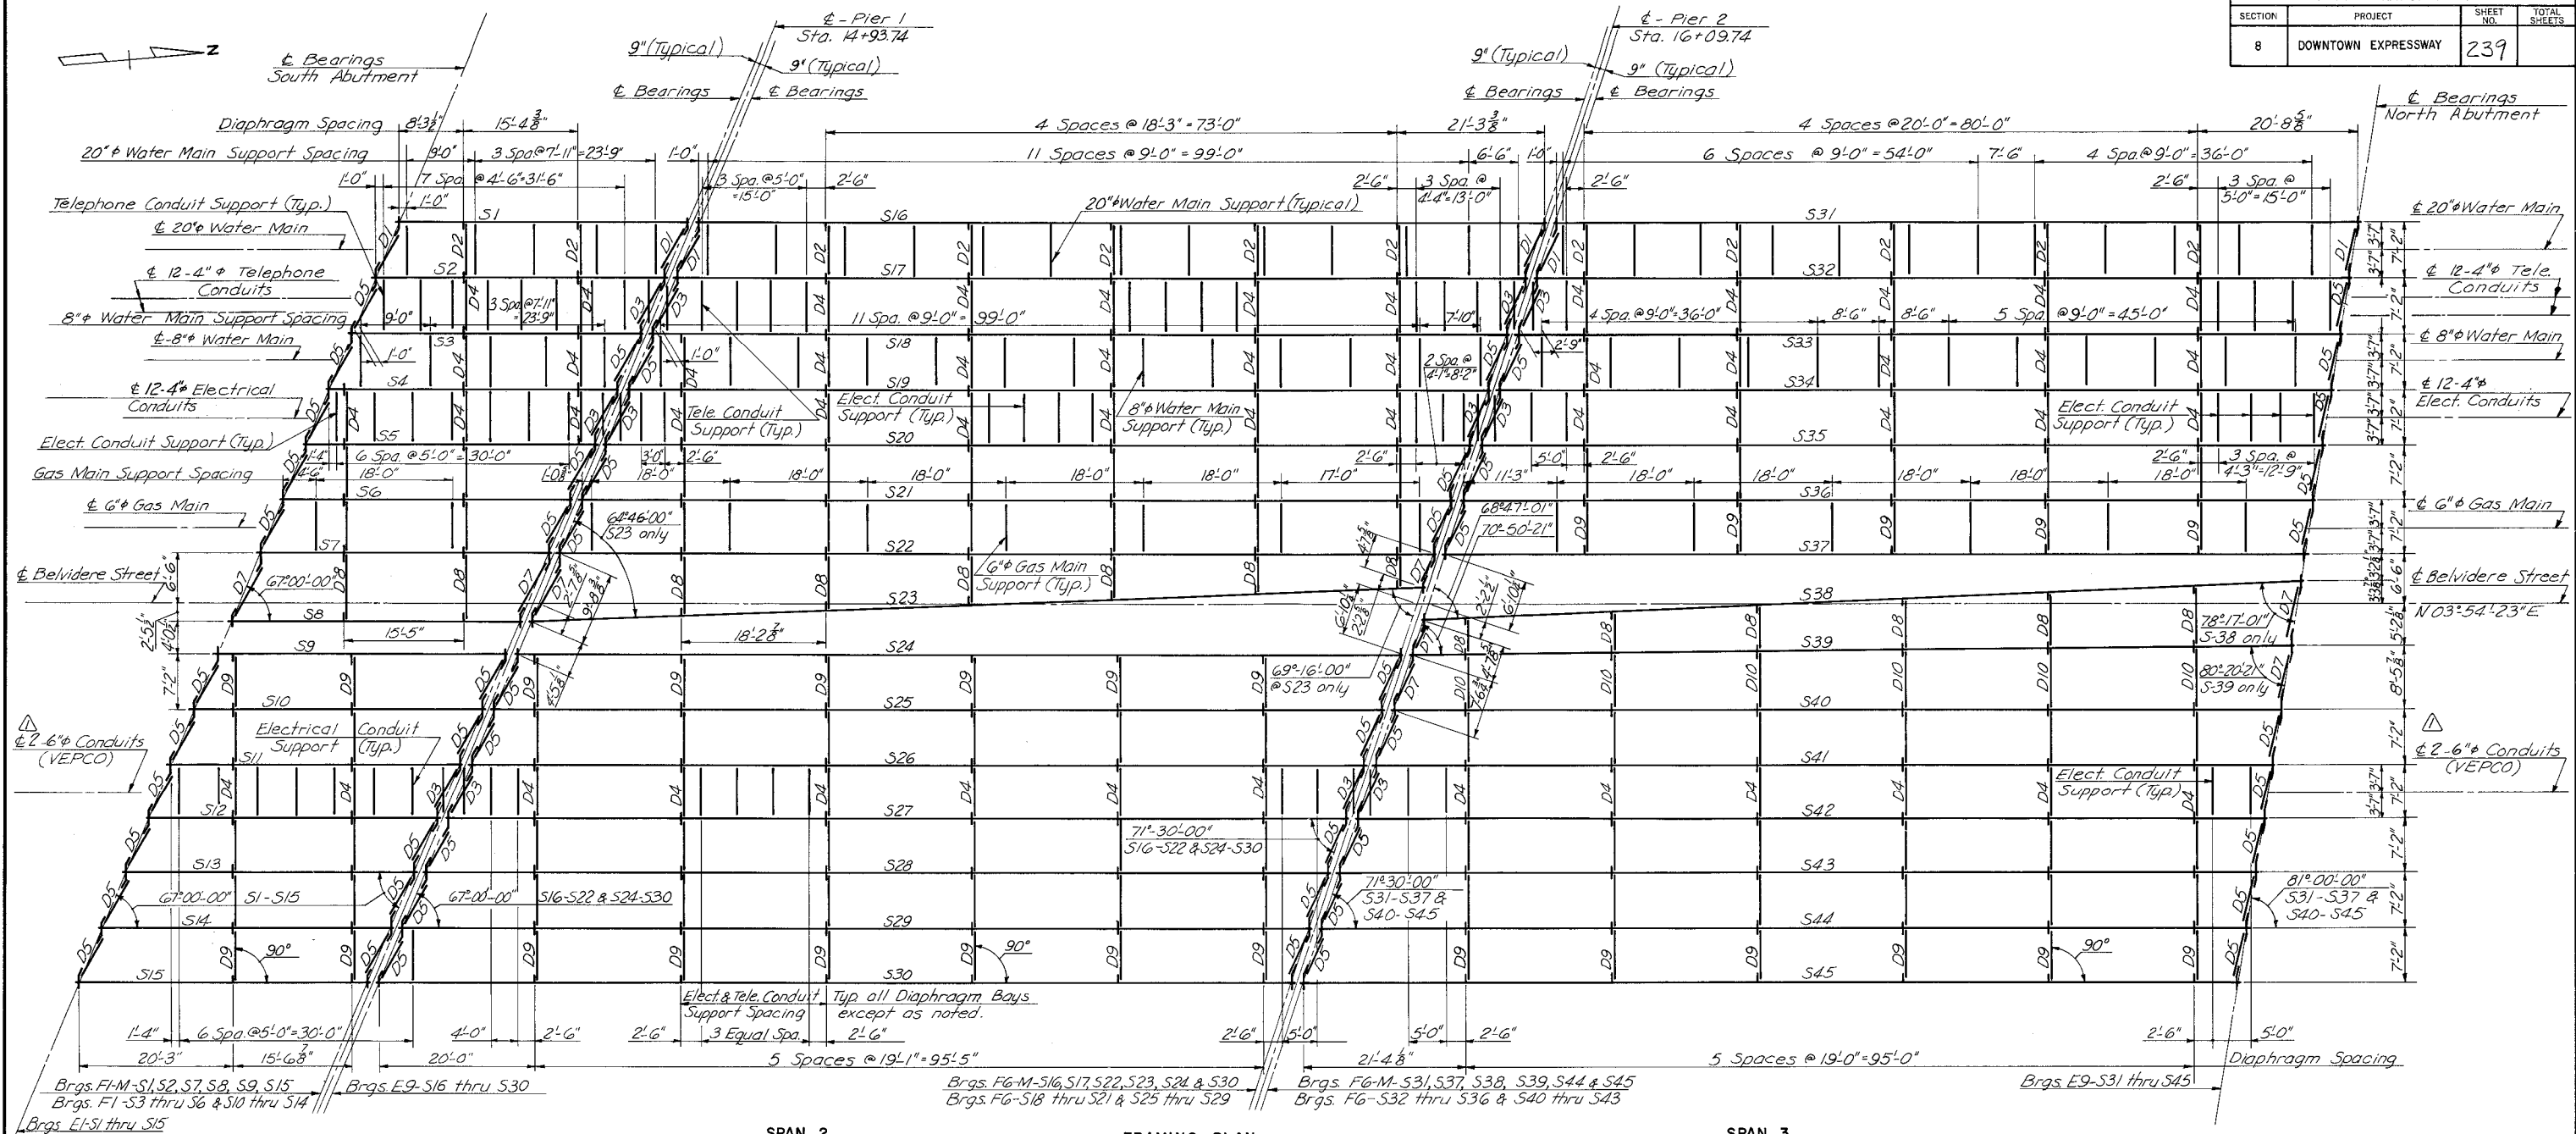

SPAN 1  
Non-Composite

SPAN 2

FRAMING PLAN  
Scale: 1"=10'-0"

SPAN 3

NOTE:  
All Intermediate Diaphragms are D6 unless otherwise noted.  
Intermediate Stiffeners shall be located on inside face of stringers S1, S15, S16, S30, S31 & S45. They shall be located on alternate sides along the remaining stringers.

NOTES:  
Structural Steel Shall Conform to ASTM Specifications A-36 (Latest Revision).  
For General Notes see Sheet 1.  
For Superstructure Cross Section see Sheet 11.  
For Diaphragm Details see Sheet 12.  
For Utility Support Details see Sheet 13.  
For Bearing Shoe Dimensions see Sheet 51.  
For Stringer Details see Sheet 10.  
For Stiffener Details see Sheet 10.

Bearing Type	No. Required
FI	9
FI-M	6
F6	18
F6-M	12
E1	15
E9	30

Stringer Lengths & Brg. to & Brg.							
S1 thru S15	37'-9 3/8"	S22	113'-9 3/8"	S30	118'-10 1/8"	S38	114'-3 3/8"
S16	109'-11 3/8"	S23	116'-2 3/8"	S31	104'-2 3/8"	S39	114'-3 3/8"
S17	110'-7 3/8"	S24	114'-11 3/8"	S32	105'-5 3/8"	S40	115'-4 3/8"
S18	111'-2 3/8"	S25	115'-7 3/8"	S33	106'-9"	S41	116'-7 3/8"
S19	111'-10 3/8"	S26	116'-3 3/8"	S34	108'-0 3/8"	S42	117'-10 3/8"
S20	112'-6 3/8"	S27	116'-10 3/8"	S35	109'-3 3/8"	S43	119'-1 3/8"
S21	113'-2"	S28	117'-6 3/8"	S36	110'-6 3/8"	S44	120'-4 3/8"
		S29	118'-2 3/8"	S37	111'-9 3/8"	S45	121'-8"

#### INTERMEDIATE STIFFENER SPACING (MAXIMUM)

Stringer	1st 2 Spaces	.1L	.2L	.3L	.4L	.5L
S1 thru S15	2'-0"	4'-0"	4'-0"	4'-0"	4'-0"	4'-0"
S16 thru S45	1'-9"	3'-6"	3'-10"	4'-0"	4'-0"	4'-0"

RICHMOND METROPOLITAN AUTHORITY  
RICHMOND EXPRESSWAY SYSTEM  
DOWNTOWN EXPRESSWAY

STRUCTURE B51  
BELVIDERE STREET OVER  
DOWNTOWN EXPRESSWAY  
FRAMING PLAN

AMERICAN ENGINEERS  
Richmond, Virginia  
HOWARD, NEEDLES, TAMMEN & BERGENOFF  
General Consultants


SCALE: AS NOTED  
CONTRACT NO.: 8  
SHEET NO. 9 OF 21

AS BUILT

BY	DATE				
MADE	D.L.A.	9-67			
CHECKED	W.E.O.	12-67	Rev. No. VEP CO Conduits	DGT	11/2/74
IN CHARGE	W.E.O.		NO.	REVISION	BY DATE




RICHMOND EXPRESSWAY SYSTEM			
SECTION	PROJECT	SHEET NO.	TOTAL SHEETS
8	DOWNTOWN EXPRESSWAY	241	

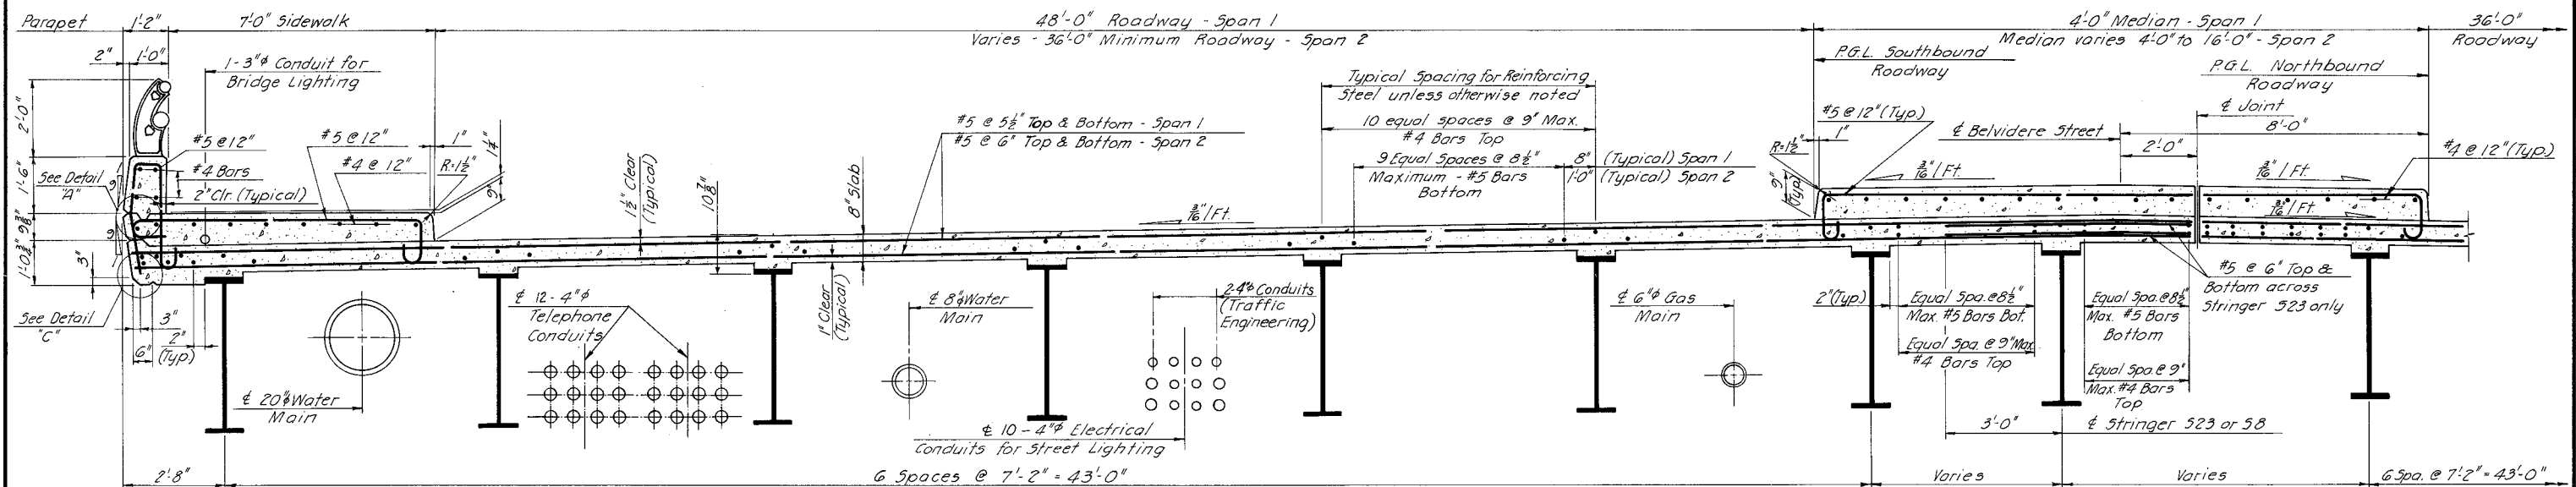


**TYPICAL CROSS SECTION**  
Southbound Roadway (Spans 1 & 2 shown)  
Scale:  $\frac{1}{2}$ " = 1'-0"

**4' MEDIAN - SPAN 3**  
Scale:  $\frac{1}{2}$ " = 1'-0"


**4' MEDIAN - SPANS 1 & 2**  
Scale:  $\frac{1}{2}$ " = 1'-0"

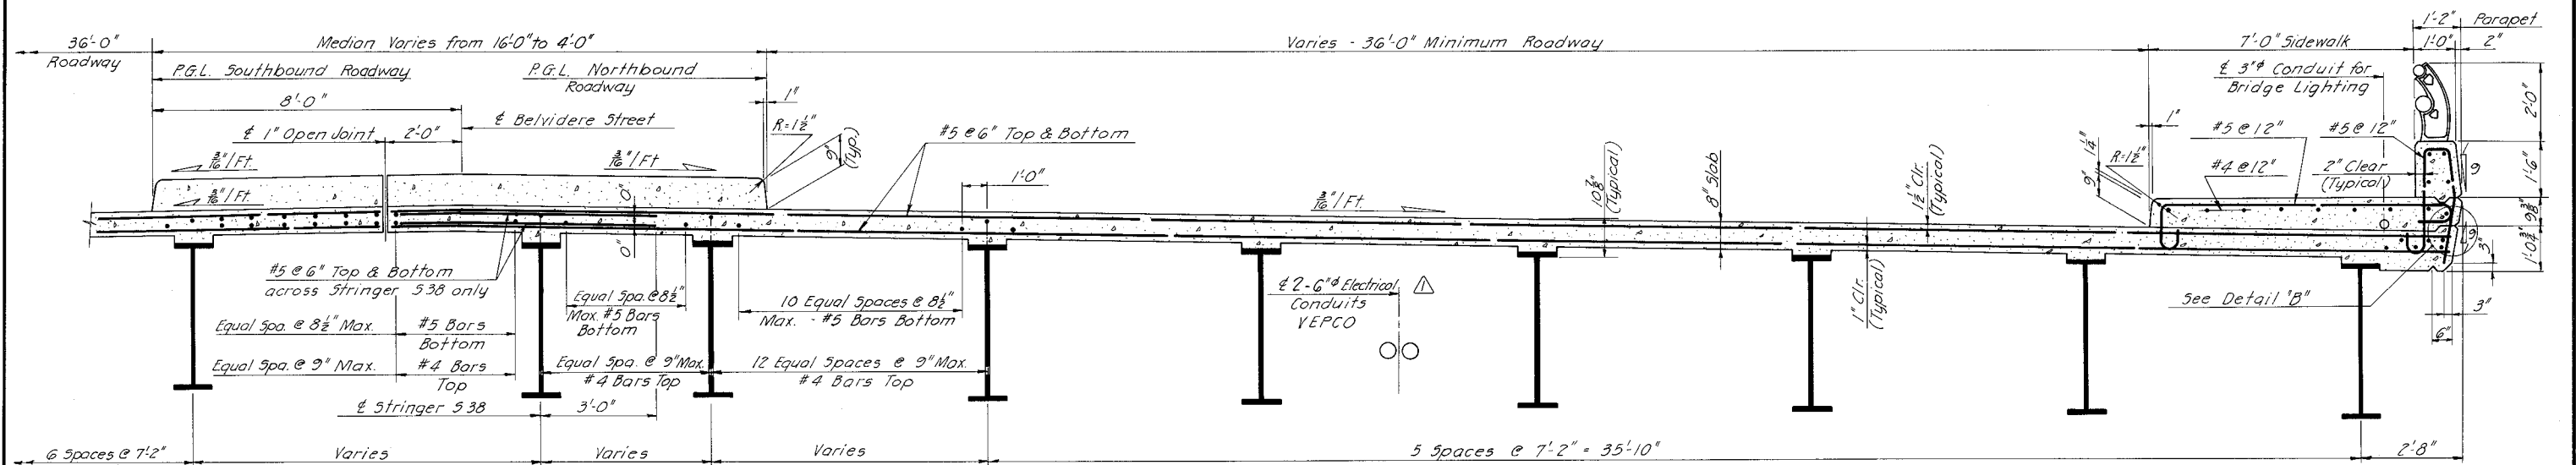


**TYPICAL CROSS SECTION**  
Northbound Roadway (Span 3 shown)  
Scale:  $\frac{1}{2}$ " = 1'-0"

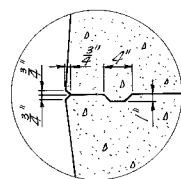

**DETAIL "A"**  
Scale:  $\frac{1}{2}$ " = 1'-0"

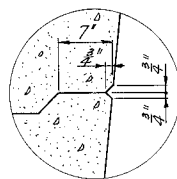

**DETAIL "B"**  
Scale:  $\frac{1}{2}$ " = 1'-0"

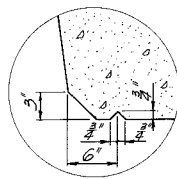

**DETAIL "C"**  
Scale:  $\frac{1}{2}$ " = 1'-0"

**NOTES:**  
For General Notes, see Sheet 1.  
For Framing Plan, see Sheet 2.  
For Slab Plan, see Sheet 14.  
For Diaphragm Details, see Sheet 12.  
For Joint Details, see Sheet 15.  
For Railing Details, see Sheet 53.

**AS BUILT**




**RICHMOND METROPOLITAN AUTHORITY**  
**RICHMOND EXPRESSWAY SYSTEM**  
DOWNTOWN EXPRESSWAY

**STRUCTURE B51**  
**BELVIDERE STREET OVER**  
**DOWNTOWN EXPRESSWAY**  
**CROSS SECTION**

AMERICAN ENGINEERS  
Richmond, Virginia  
HOWARD, NEEDLES, TAMMEN & BERGENOFF  
General Consultants

SCALE: **AS NOTED**  
CONTRACT NO.: **8**  
SHEET NO. **11** OF **21**

BY	DATE				
MADE	DLA	9-67			
CHECKED	WEO	12-67	Rev No VEP Conduits	DGT	11-12-74
IN CHARGE	WEO		NO.	REVISION	BY DATE

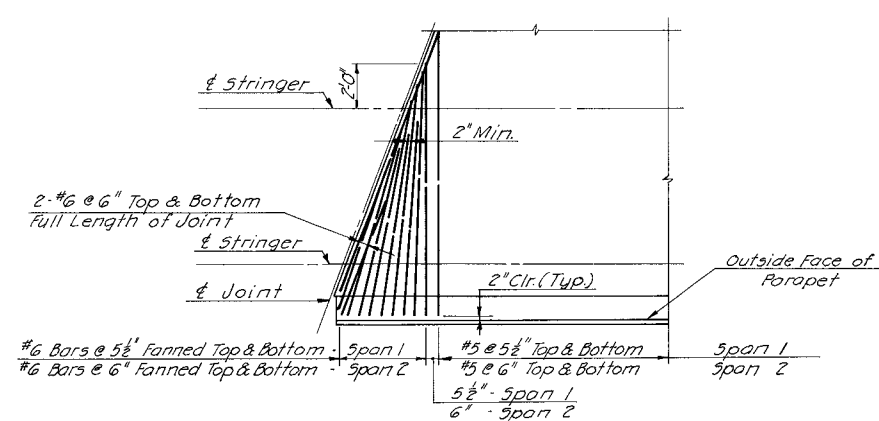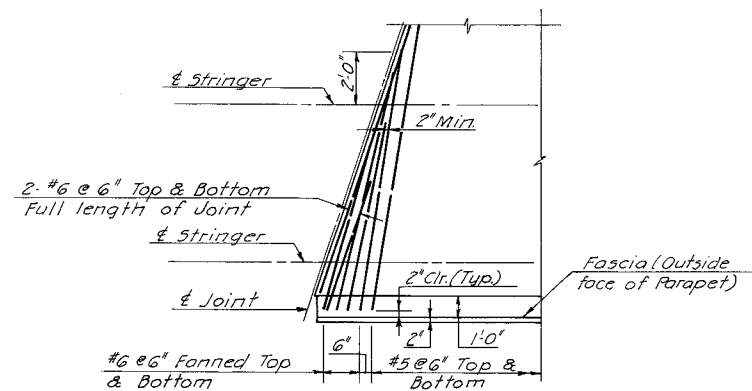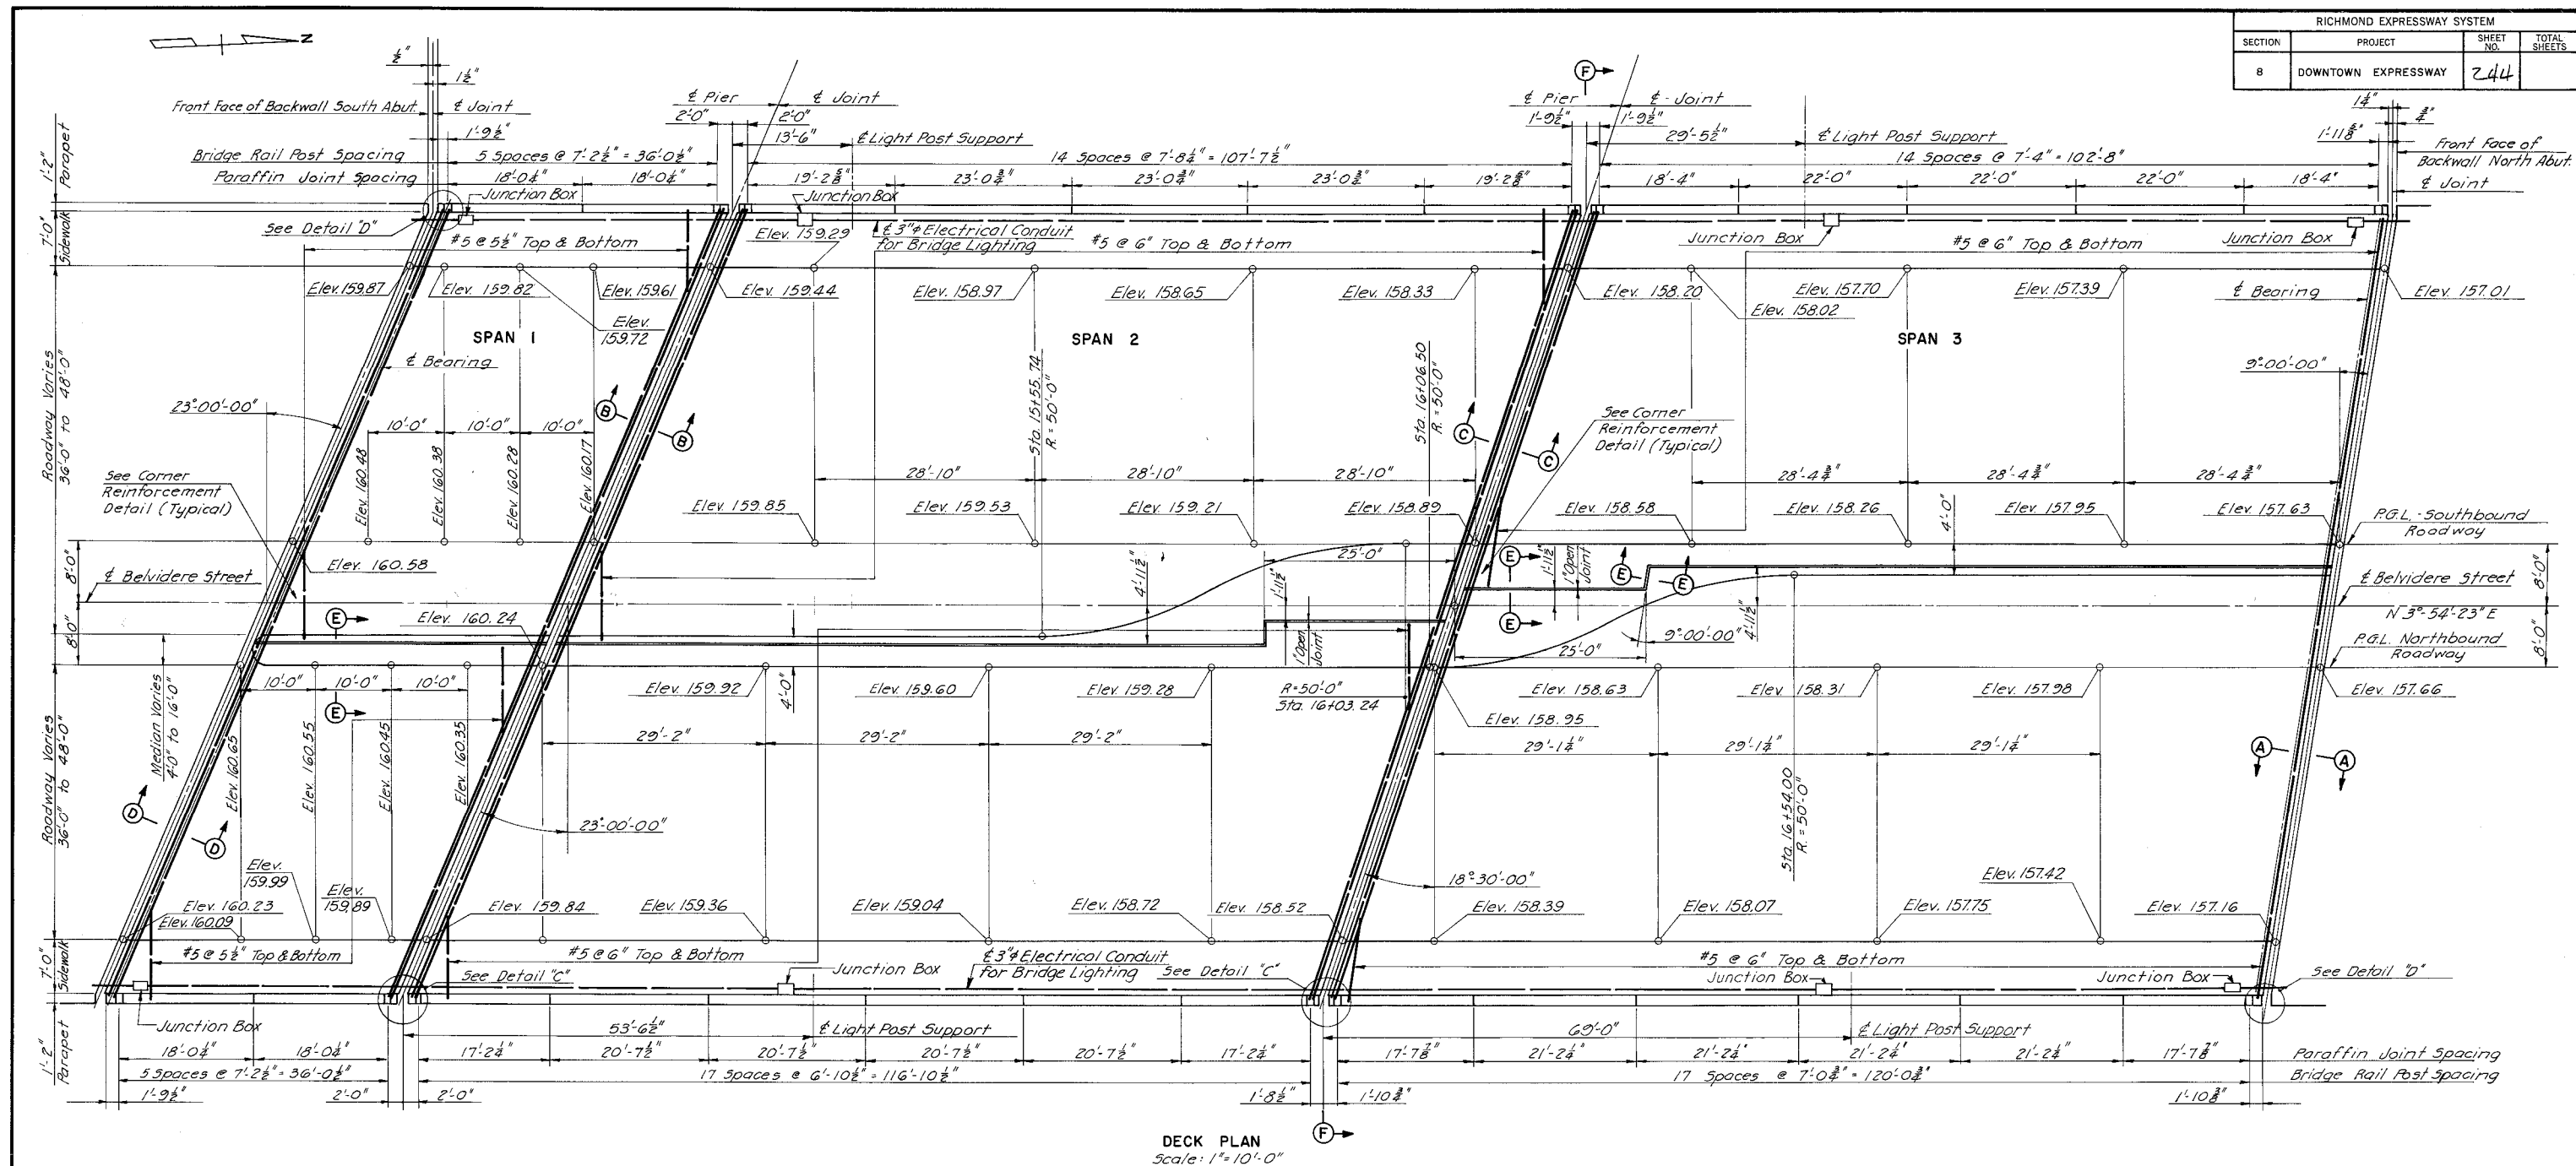

**NOTES:**  
For General Notes, see Sheet 11.  
For Typical Deck Cross Section, see Sheet 11.  
For Joint Details, see Sheet 15.  
For Sections and Details, see Sheet 15.  
For Typical Parapet Elevation, see Sheet 15.

**AS BUILT**

**RICHMOND METROPOLITAN AUTHORITY  
RICHMOND EXPRESSWAY SYSTEM  
DOWNTOWN EXPRESSWAY**

**STRUCTURE B51  
BELVIDERE STREET OVER  
DOWNTOWN EXPRESSWAY  
DECK PLAN**

AMERICAN ENGINEERS  
Richmond, Virginia  
HOWARD, NEEDLES, TAMMEN & BERGENDOFF  
General Consultants


SCALE: AS NOTED  
CONTRACT NO. 8  
SHEET NO. 14 OF 21

BY	DATE				
MADE	DLA	9-67			
CHECKED	WEO	12-67			
IN CHARGE	WEO		NO.	REVISION	BY
					DATE






RICHMOND EXPRESSWAY SYSTEM			
SECTION	PROJECT	SHEET NO.	TOTAL SHEETS
8	DOWNTOWN EXPRESSWAY	246	

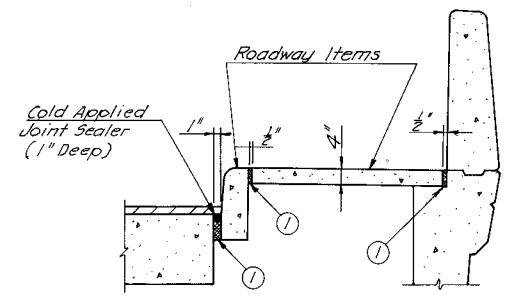


① = Preformed Expansion Joint Material


SECTION C-C  
Scale: 1"=1'-0"

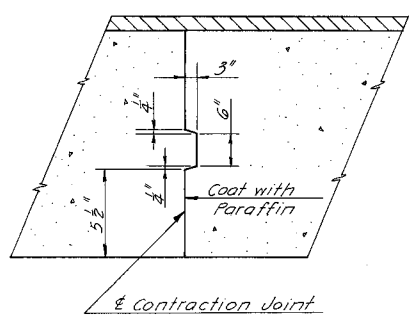


SECTION D-D  
(CONTRACTION JOINT DETAIL)  
No Scale

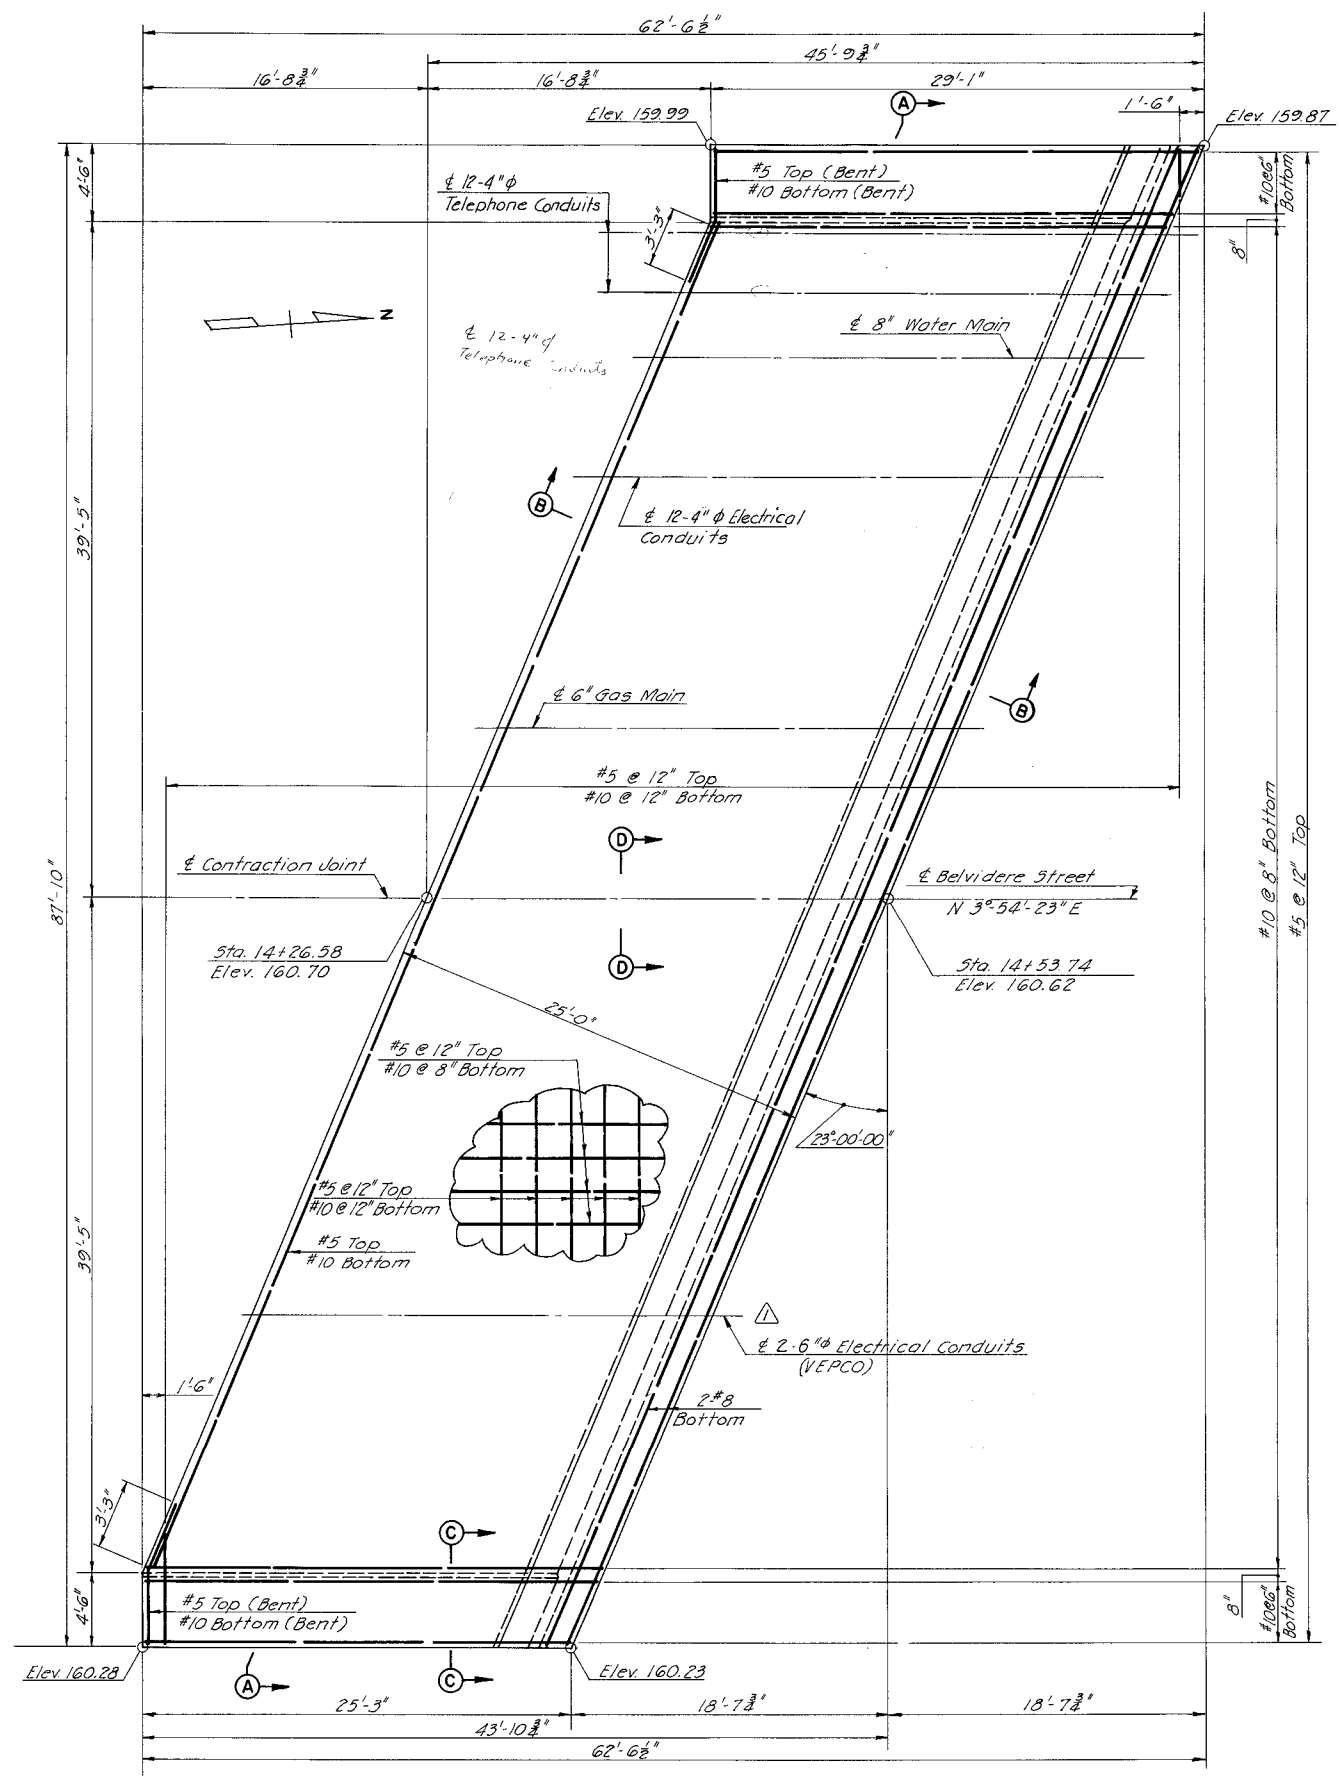

PLAN - SOUTH ABUTMENT  
Scale: 1/8"=1'-0"

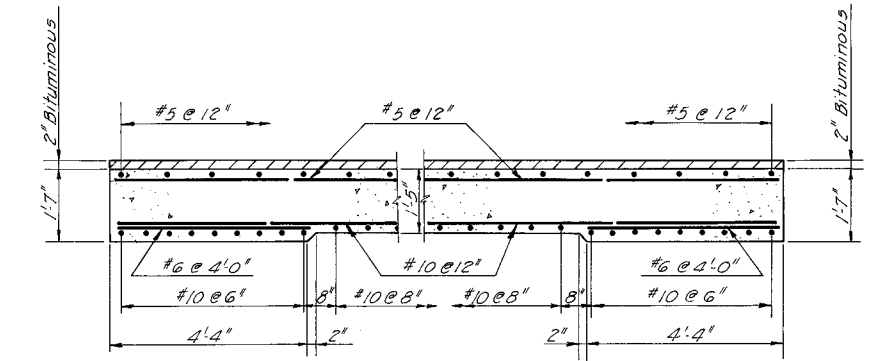

SECTION A-A  
Scale: 1/2"=1'-0"

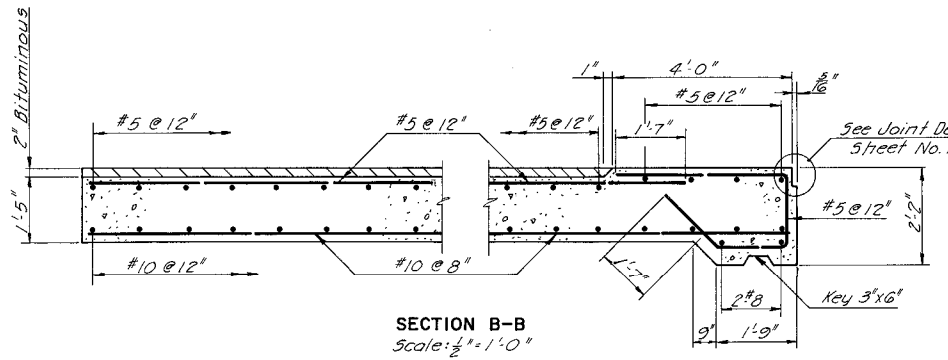

SECTION B-B  
Scale: 1/2"=1'-0"

NOTE 5:  
All reinforcing steel shall be 2" Clear.  
ELEVATIONS SHOWN ARE TO TOP OF CONCRETE.


**AS BUILT**

RICHMOND METROPOLITAN AUTHORITY RICHMOND EXPRESSWAY SYSTEM DOWNTOWN EXPRESSWAY	
STRUCTURE B51 BELVIDERE STREET OVER DOWNTOWN EXPRESSWAY APPROACH SLAB SOUTH ABUTMENT	
AMERICAN ENGINEERS Richmond, Virginia	SCALE: AS NOTED
HOWARD, NEEDLES, TAMMEN & BERGENDOFF General Consultants	CONTRACT NO.: 8
	SHEET NO. 16 OF 21


BY	DATE				
MADE	TDJ	10-67			
CHECKED	WEO	12-67	Rev No Vepco Conduits	DGT	11-12-74
IN CHARGE	WEO		NO. REVISION	BY	DATE





RICHMOND EXPRESSWAY SYSTEM				
SECTION	PROJECT	SHEET NO.	TOTAL SHEETS	
8	DOWNTOWN EXPRESSWAY	247		

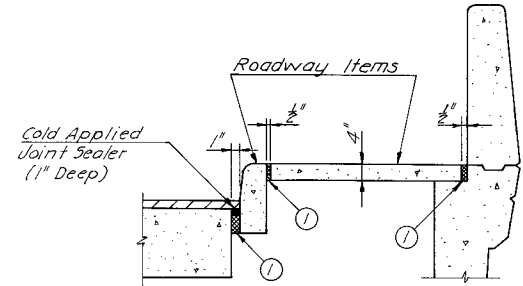


SECTION C-C  
Scale: 1"=1'-0"

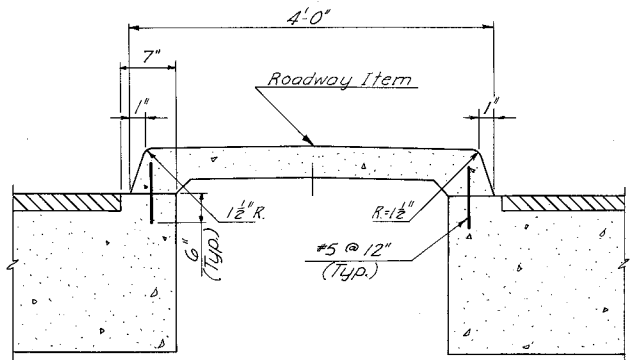

SECTION D-D  
Scale: 1"=1'-0"

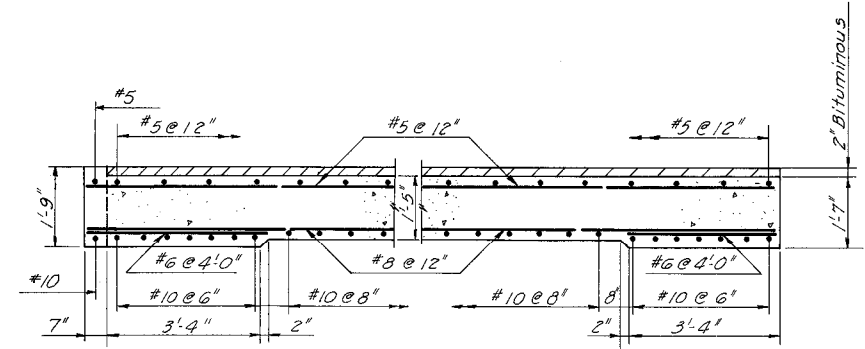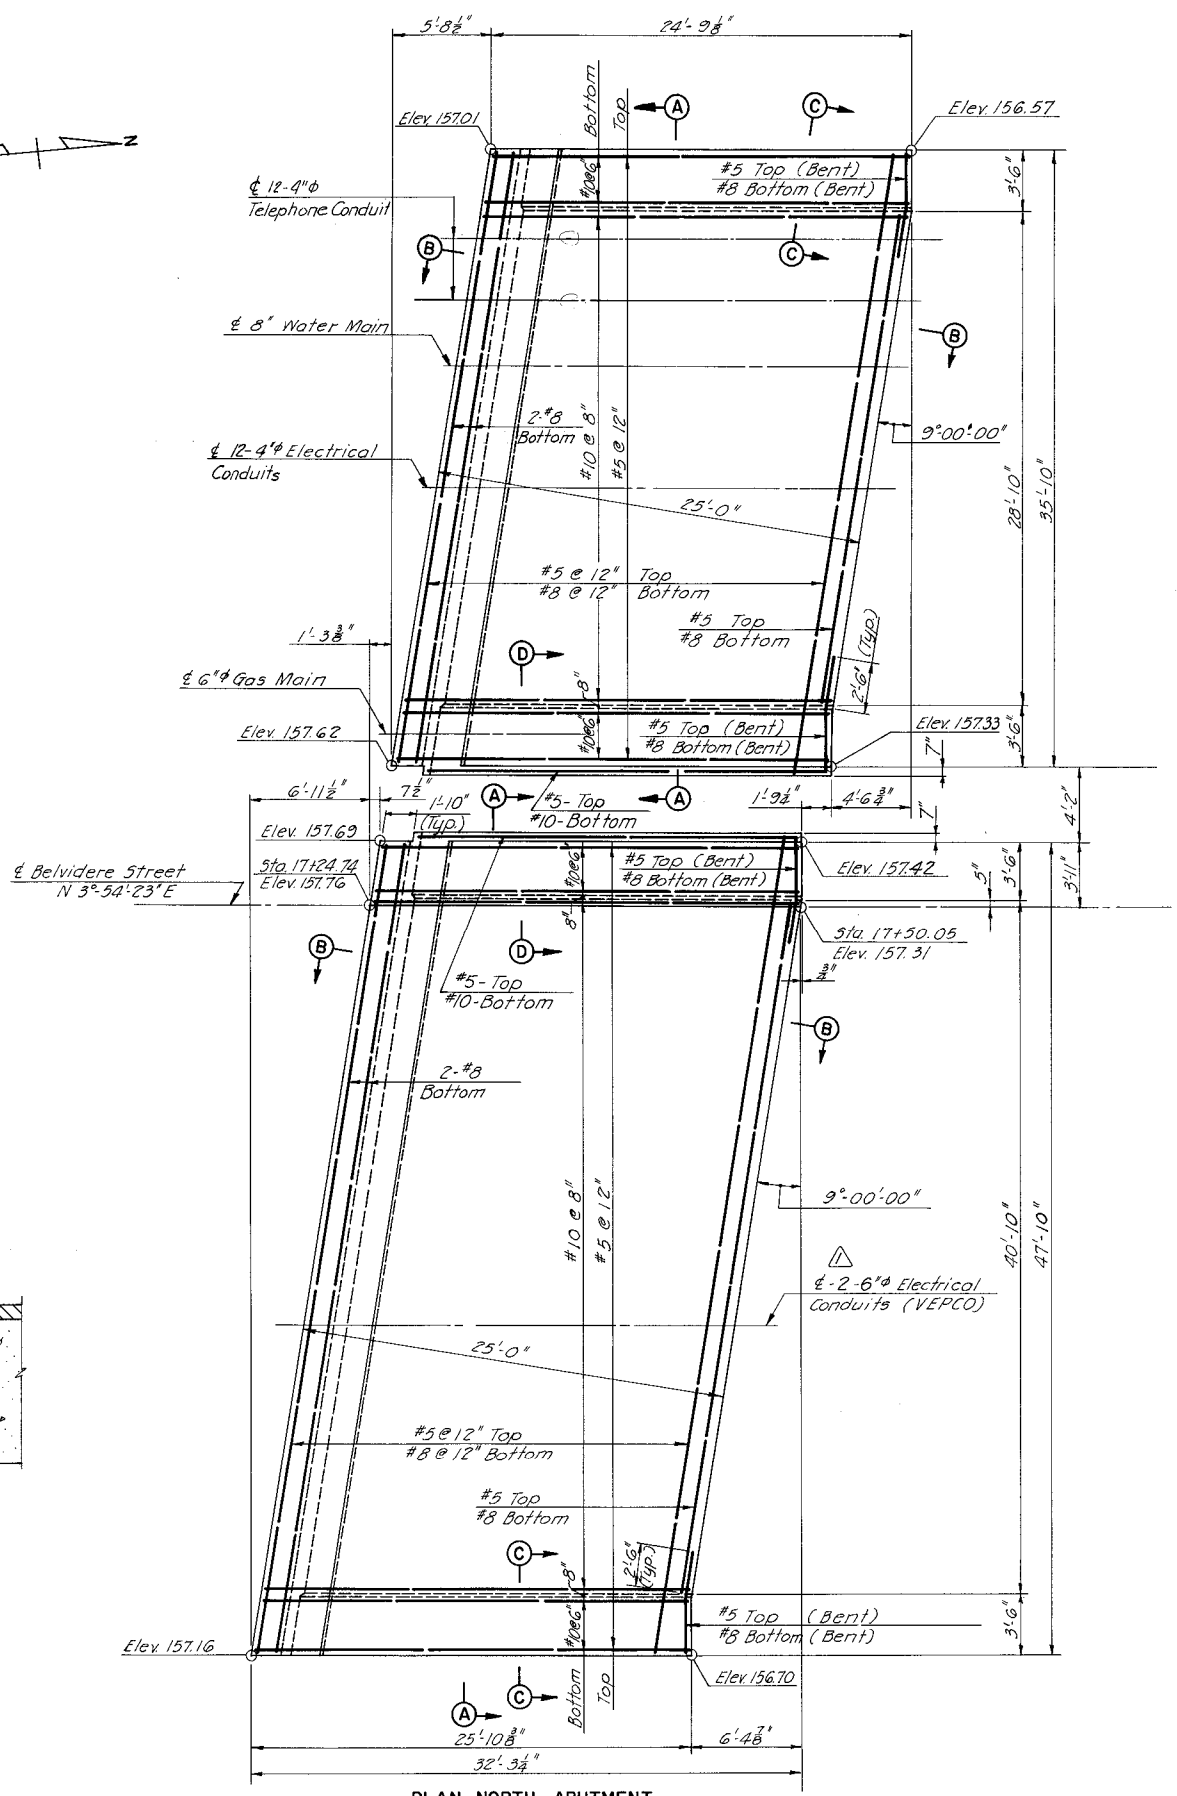

SECTION A-A  
Scale: 1/2"=1'-0"

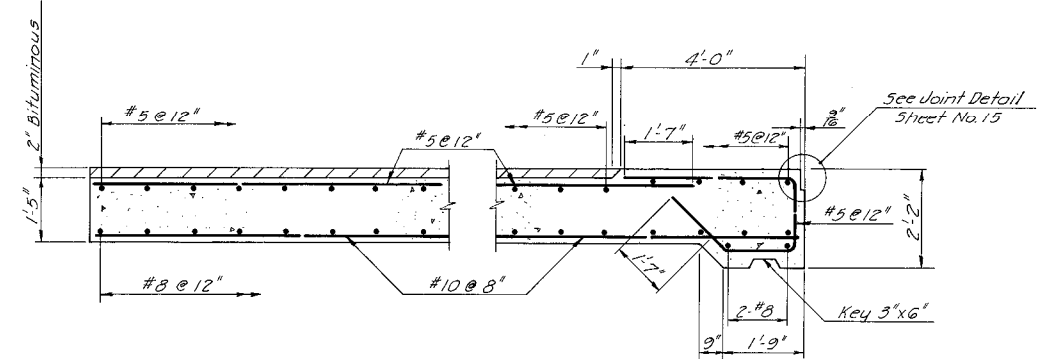

SECTION B-B  
Scale: 1/2"=1'-0"

NOTES:  
All reinforcing steel shall be 2" Clear.  
ELEVATIONS SHOWN ARE TO TOP OF CONCRETE.

AS BUILT

BY	DATE				
MADE	TDJ	10-67			
CHECKED	WFO	12-67	Rev. No. VEPCC Conduits	DGT	11-12-74
IN CHARGE	WFO		NO. REVISION	BY	DATE

RICHMOND METROPOLITAN AUTHORITY	
RICHMOND EXPRESSWAY SYSTEM	
DOWNTOWN EXPRESSWAY	
STRUCTURE B51	
BELVIDERE STREET OVER	
DOWNTOWN EXPRESSWAY	
APPROACH SLAB	
NORTH ABUTMENT	
AMERICAN ENGINEERS Richmond, Virginia	SCALE: AS NOTED
HOWARD, NEEDLES, TAMMEN & BERGENDOFF General Consultants	CONTRACT NO.: 8
	SHEET NO. 17 OF 21

# **Bridge 54**



**(South 2nd Street  
Over Downtown Expressway {Rte. 195})**

**Record Set Plans**



RICHMOND EXPRESSWAY SYSTEM			
SECTION	PROJECT	SHEET NO.	TOTAL SHEETS
9	DOWNTOWN EXPRESSWAY	119	


INDEX	
NO.	DESCRIPTION
1	General Plan and Elevation
2	General Notes and Quantities
3	Support For Exist. Tel. Ducts
4	North Abutment
5	North Abutment Details
6	South Abutment
7	South Abutment Details (1)
8	South Abutment Details (2)
9	Pier 1
10	Pier 2
11	Framing Plan (1)
12	Framing Plan (2)
13	Cross Section (1)
14	Cross Section (2)
15	Deck Plan 1
16	Deck Plan 2
17	Joint Details
18	Approach Slabs and Slope Protection
19	Boring Logs
20	Boring Logs
5A	Retaining Wall North Abutment
S1	Standard Shoe Details
S3	Standard Aluminum Railing Details (2 Rails)
S4	Standard Electrical Details (Bridges Carrying City Streets)
S7	Standard Architectural Details
S8	Standard Architectural Details
S9	Standard Architectural Details
S10	Standard Conduit Installation Details
S11	Standard Utility Support Details at Bridge Abutments

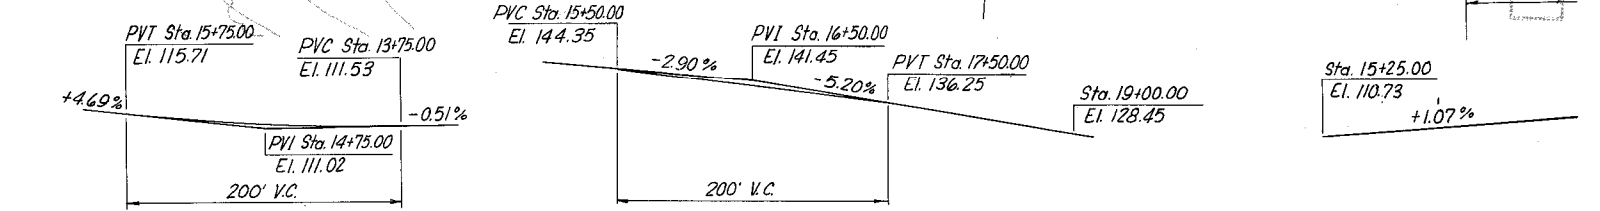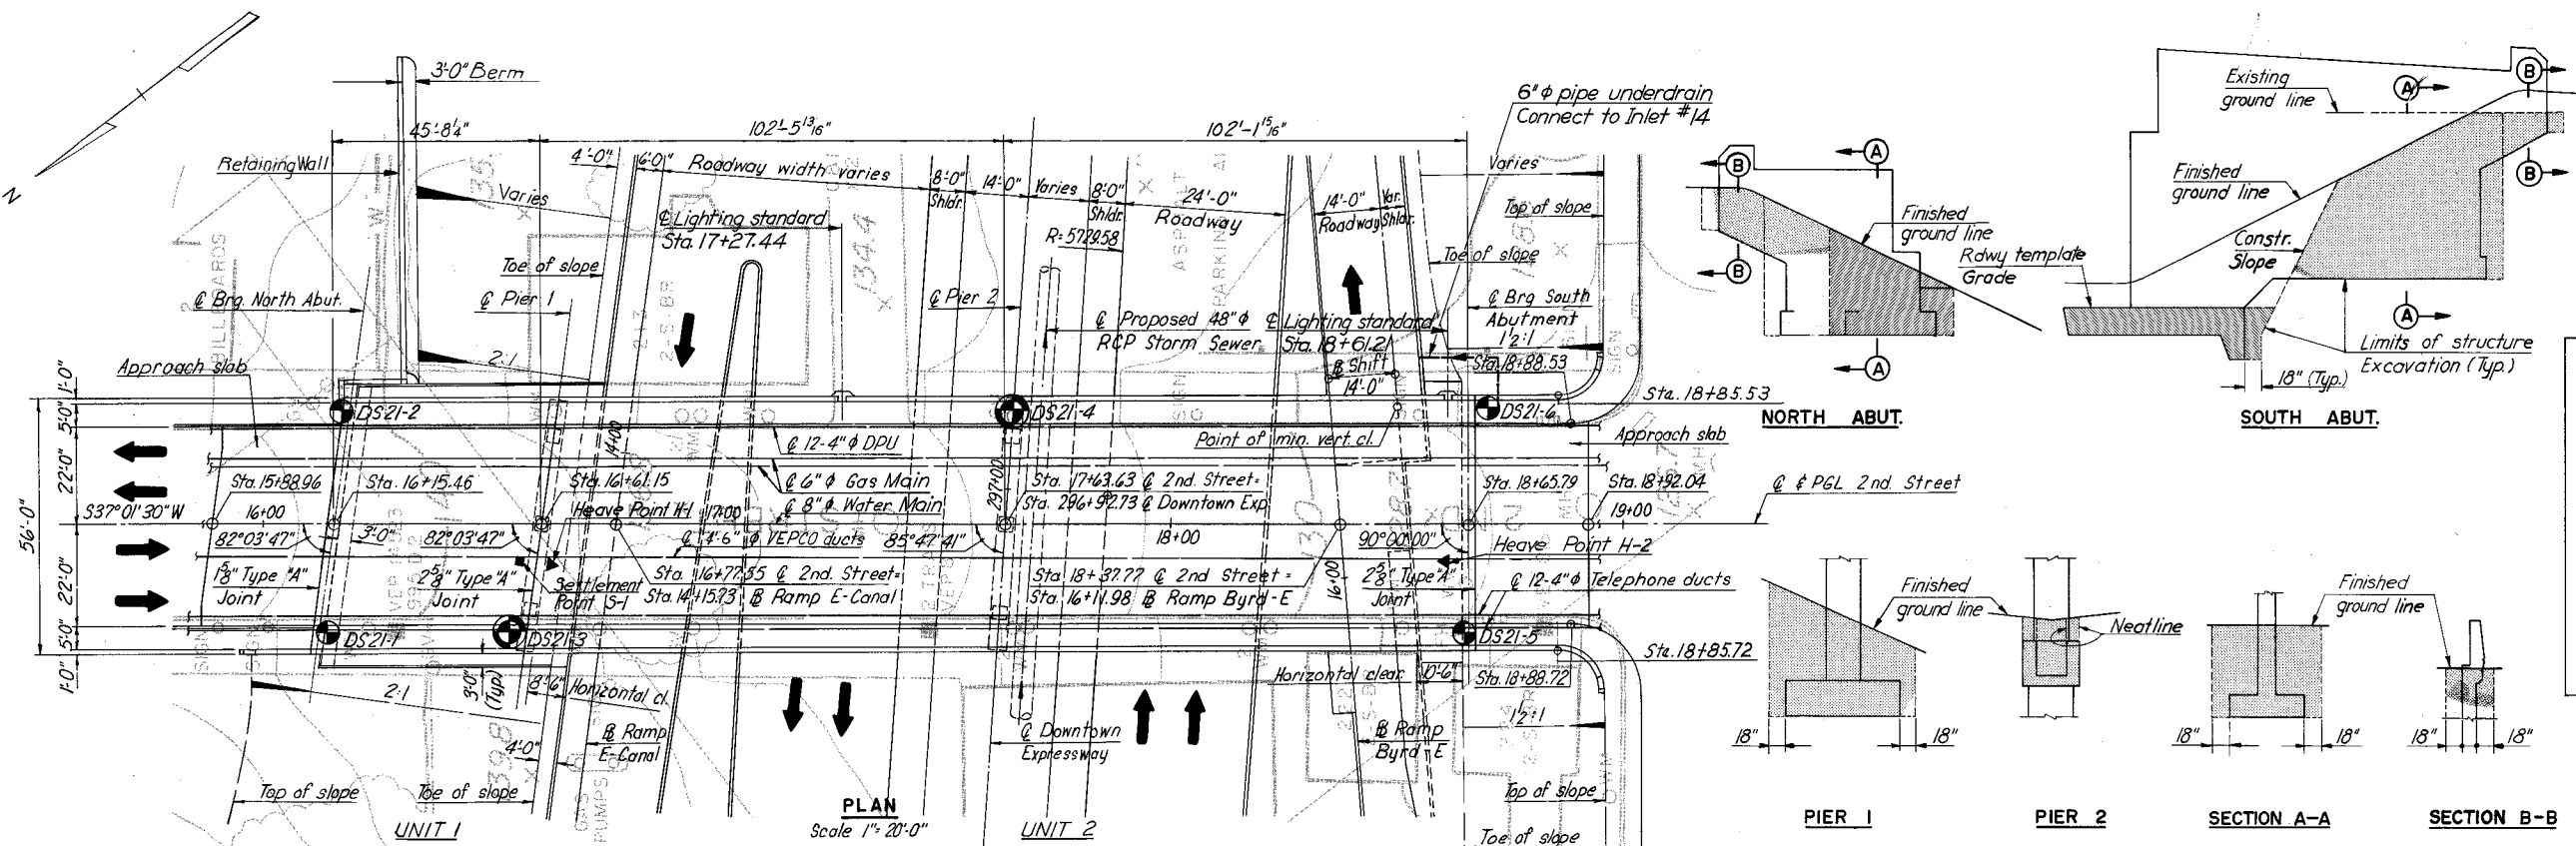


PROFILE GRADE  
RAMP E-CANAL  
Not to Scale

PROFILE GRADE  
SOUTH SECOND STREET BRIDGE  
Not to Scale

PROFILE GRADE  
RAMP BYRD-E  
Not to Scale

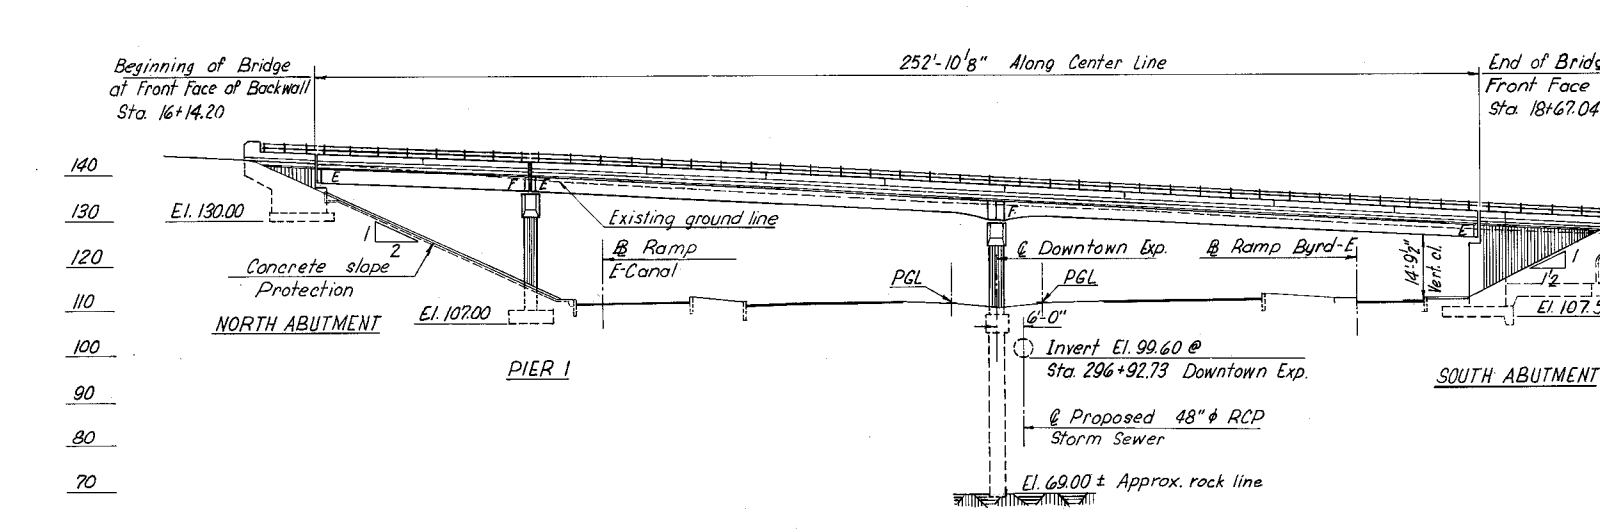


ELEVATION  
Scale 1" = 20'-0"

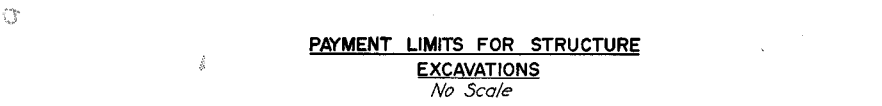

SECTION A-A  
SECTION B-B



RETAINING WALL  
AT NORTH ABUTMENT

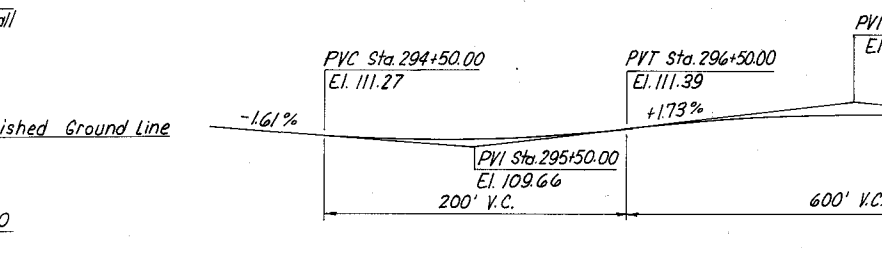

PROFILE GRADE  
DOWNTOWN EXPRESSWAY  
Not to Scale



**INSTRUMENTATION:**  
 ■ Indicates location of Heave Point.  
 ■ Indicates location of Settlement Point.  
**BORINGS:**  
 ⊕ Indicates location of 2 1/2" cased hole boring.  
 ⊙ Indicates location of 4" cased hole boring.  
 For boring data, see Boring Logs sheet.  
**NOTE:**  
 For General Notes and Quantities, see next sheet.

MADE	BY	DATE	NO.	REVISION	BY	DATE
EF	6-67	2	As Built	TEM	6-77	
DSB	5-68	1	Retaining Wall Added			



RICHMOND METROPOLITAN AUTHORITY	
RICHMOND EXPRESSWAY SYSTEM	
DOWNTOWN EXPRESSWAY	
BRIDGE B-54	
2ND STREET OVER	
DOWNTOWN EXPRESSWAY	
GENERAL PLAN AND ELEVATION	
HOWARD, NEEDLES, TAMMEN & BERGENDOFF consulting engineers NEW YORK ALEXANDRIA KANSAS CITY	SCALE: AS SHOWN CONTRACT NO. 9 SHEET NO. 119 OF 20

AS BUILT

RICHMOND EXPRESSWAY SYSTEM			
SECTION	PROJECT	SHEET NO.	TOTAL SHEETS
9	DOWNTOWN EXPRESSWAY	129	

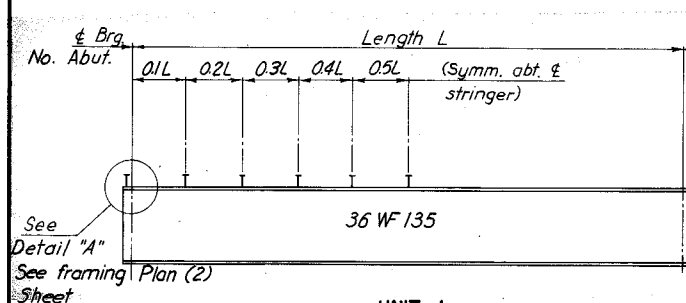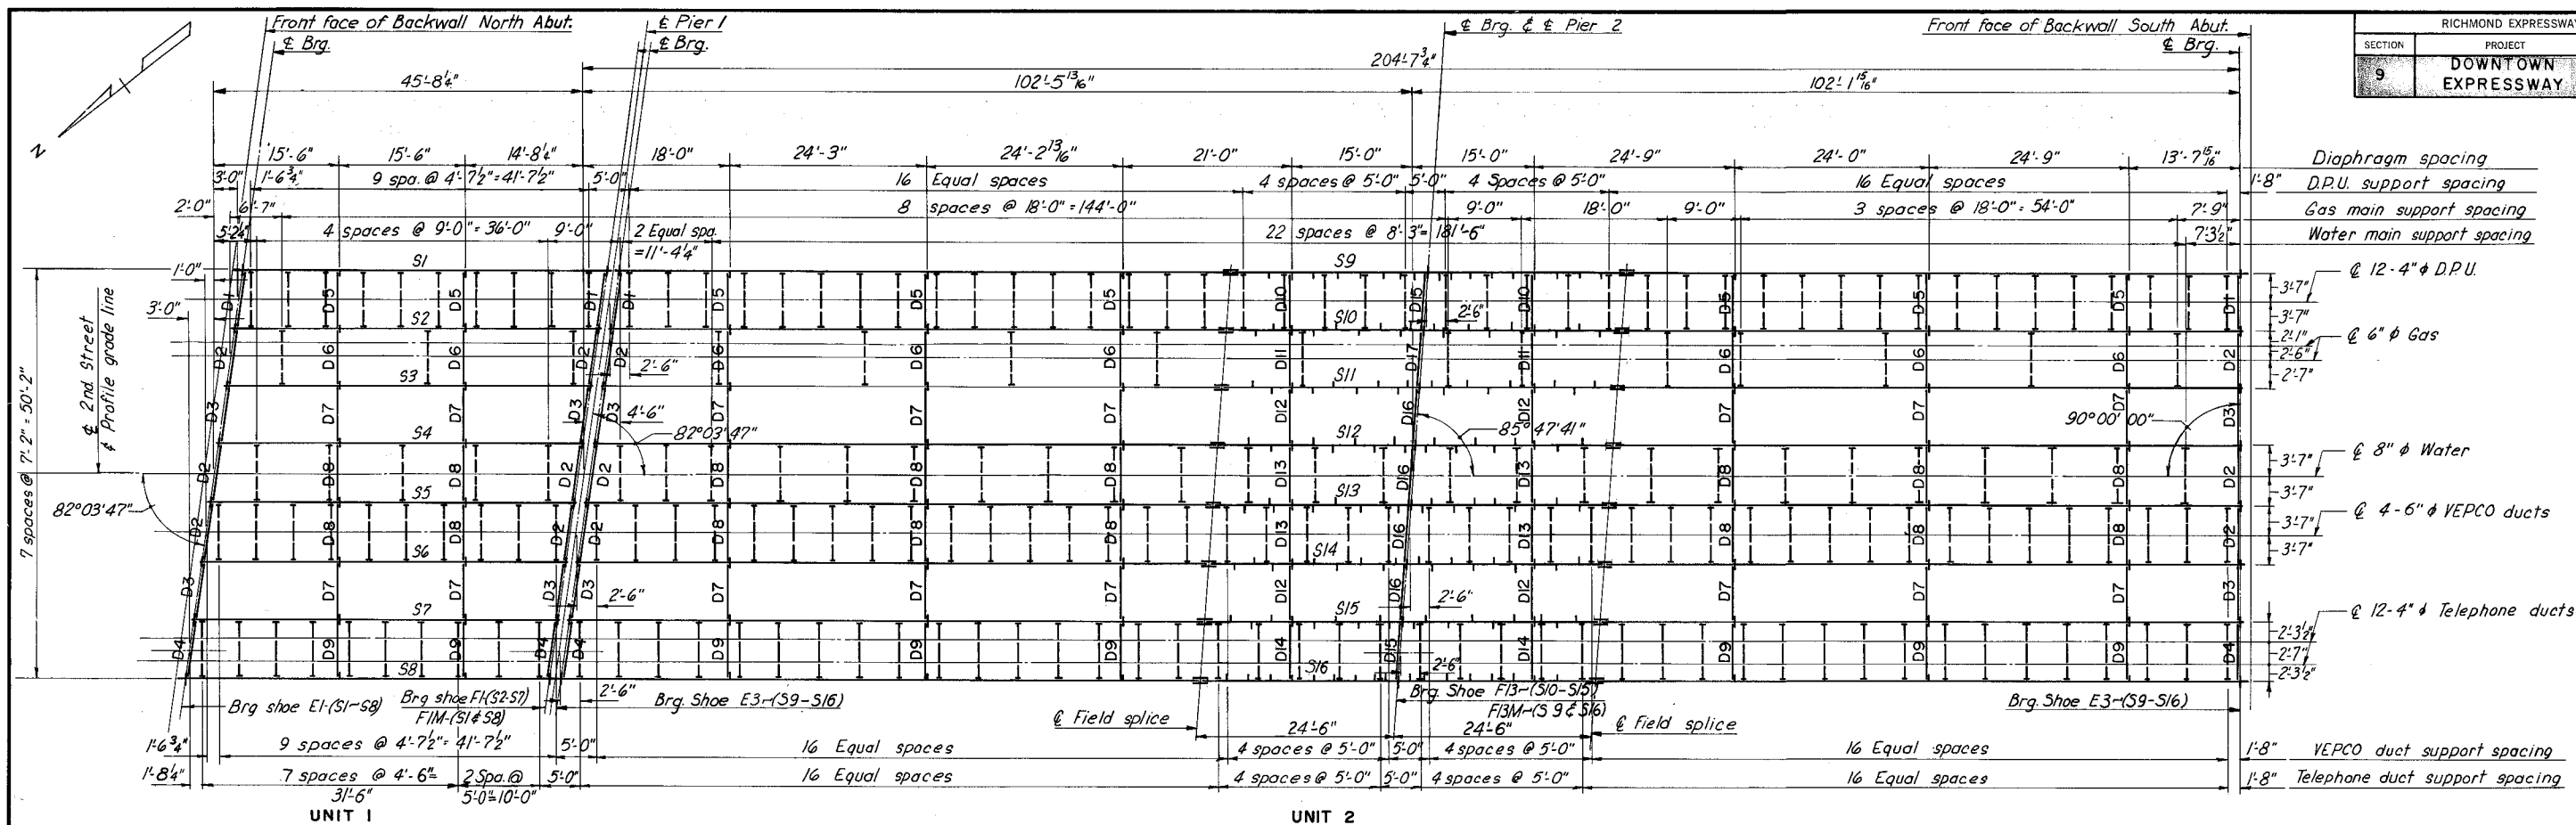


UNIT 1 STRINGER SCHEDULE					
STRINGER	LENGTH & BRG. TO & BRG.	SHEAR STUD SPACING**			
		0.1L	0.2L	0.3L	0.4L 0.5L
S1-S8	44'-11 3/16"	8 1/2	9 1/2	11 1/2	14 1/2 16

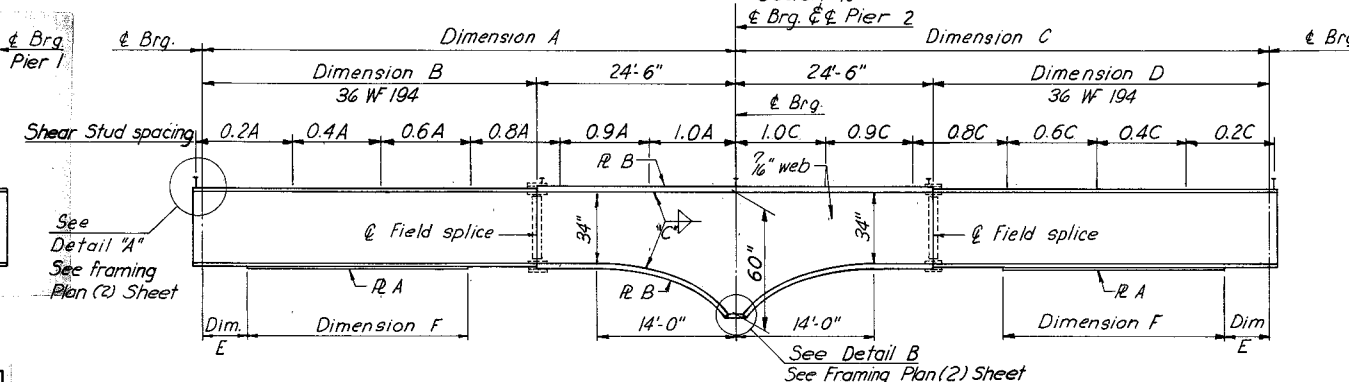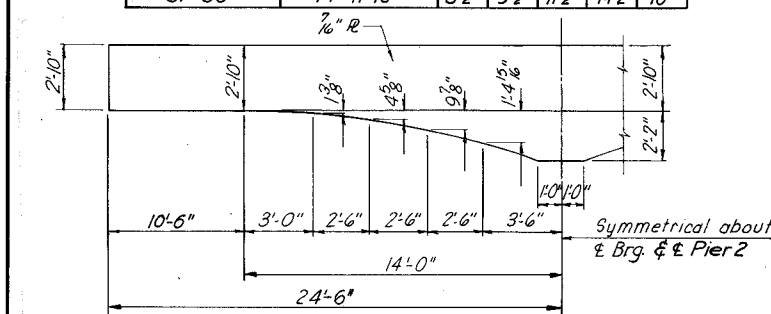


UNIT 2 STRINGER SCHEDULE																		
STRINGER	DIM. A	DIM. B	DIM. C	DIM. D	DIM. E	R. A					R. B		SHEAR STUD SPACING *					
						DIM. F	SIZE	"L"	"a"	"b"	SIZE	"c"	0.2"	0.4"	0.6"	0.8"	0.9"	1.0"
S9	100'-0" <sup>5</sup> / <sub>8</sub>	75'-6" <sup>5</sup> / <sub>16</sub>	100'-3" <sup>3</sup> / <sub>4</sub>	75'-9" <sup>3</sup> / <sub>4</sub>	9'-3"	61'-0"	10 1/2 x 1 <sup>5</sup> / <sub>8</sub>	2'-3"	5" <sup>5</sup> / <sub>8</sub>	3" <sup>5</sup> / <sub>8</sub>	18 x 1 <sup>3</sup> / <sub>8</sub>	5 <sup>1</sup> / <sub>8</sub> "	7"	10"	11"	7"	18"	24"
S10	100'-6" <sup>3</sup> / <sub>16</sub>	76'-0" <sup>3</sup> / <sub>16</sub>	100'-10" <sup>1</sup> / <sub>8</sub>	76'-4" <sup>1</sup> / <sub>16</sub>	10'-3"	59'-6"	10 1/2 x 1 <sup>5</sup> / <sub>8</sub>	↑	↑	↑	18 x 1 1/2	↑	8"	11"	12"	8"	↑	↑
S11	101'-0" <sup>4</sup> / <sub>8</sub>	76'-6" <sup>4</sup> / <sub>8</sub>	101'-4" <sup>1</sup> / <sub>8</sub>	76'-10" <sup>1</sup> / <sub>8</sub>	11'-6"	57'-6"	10 1/2 x 1/4				18 x 1/4		↑	↑	↑	↑	↑	↑
S12	101'-5" <sup>5</sup> / <sub>16</sub>	76'-11" <sup>5</sup> / <sub>16</sub>	101'-10" <sup>3</sup> / <sub>4</sub>	77'-4" <sup>3</sup> / <sub>4</sub>	10'-3"	60'-6"	10 1/2 x 1 <sup>5</sup> / <sub>8</sub>				18 x 1 1/2		↑	↑	↑	↑	↑	↑
S13	101'-11" <sup>9</sup> / <sub>16</sub>	77'-5" <sup>9</sup> / <sub>16</sub>	102'-5" <sup>1</sup> / <sub>8</sub>	77'-11" <sup>1</sup> / <sub>8</sub>	↑	61'-0"	10 1/2 x 1 <sup>5</sup> / <sub>8</sub>				18 x 1 1/2		↓	↓	↓	↓	↓	↓
S14	102'-5" <sup>4</sup> / <sub>8</sub>	77'-11" <sup>4</sup> / <sub>8</sub>	102'-11" <sup>3</sup> / <sub>8</sub>	78'-5" <sup>3</sup> / <sub>8</sub>	↑	61'-6"	10 1/2 x 1 <sup>5</sup> / <sub>8</sub>				18 x 1 1/2		↓	↓	↓	↓	↓	↓
S15	102'-10" <sup>3</sup> / <sub>8</sub>	78'-4" <sup>3</sup> / <sub>8</sub>	103'-5" <sup>1</sup> / <sub>8</sub>	78'-11" <sup>1</sup> / <sub>8</sub>	10'-3"	62'-0"	10 1/2 x 1 <sup>5</sup> / <sub>8</sub>		↓	↓	↓	18 x 1 1/2	5 <sup>1</sup> / <sub>8</sub> "	8"	11"	12"	8"	↓
S16	103'-4" <sup>1</sup> / <sub>8</sub>	78'-10" <sup>3</sup> / <sub>8</sub>	104'-0"	79'-6"	9'-0"	64'-0"	10 1/2 x 1 <sup>3</sup> / <sub>8</sub>	2'-3"	5" <sup>5</sup> / <sub>8</sub>	3" <sup>5</sup> / <sub>8</sub>	18 x 1 <sup>5</sup> / <sub>8</sub>	3 <sup>5</sup> / <sub>8</sub> "	7"	10"	11"	7"	18"	24"

\* To be applied to either A or C dimension.  
\*\* Shear stud spacing shown is maximum spacing.

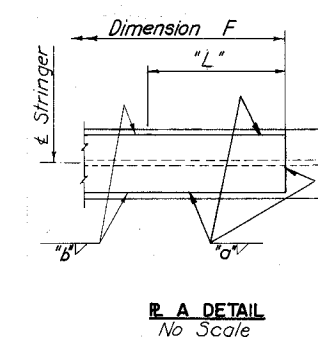

SHOE SCHEDULE			
EXPANSION SHOES		FIXED SHOES	
TYPE	NO. REQD.	TYPE	NO. REQD.
E1	8	F1	6
E3	16	F1M	2
		F13	6
		F13M	2

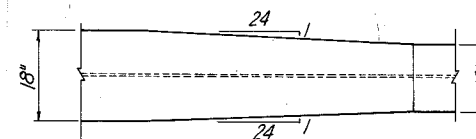

Note:  
For additional details see Framing Plan (2) Sheet.

MADE	BY	DATE	CHECKED	DATE	IN CHARGE	NO.	REVISION	BY	DATE
EV	3-68	DSB	5-68	1	As Built	TEM	6-77		

AS BUILT

RICHMOND METROPOLITAN AUTHORITY	
RICHMOND EXPRESSWAY SYSTEM	
DOWNTOWN EXPRESSWAY	
BRIDGE B-54	
2ND STREET OVER	
DOWNTOWN EXPRESSWAY	
FRAMING PLAN (1)	
HOWARD, NEEDLES, TAMMEN & BERGENDOFF consulting engineers NEW YORK ALEXANDRIA KANSAS CITY	SCALE: AS SHOWN CONTRACT NO.: 9 SHEET NO. 11 OF 20






RICHMOND EXPRESSWAY SYSTEM			
SECTION	PROJECT	SHEET NO.	TOTAL SHEETS
9	DOWNTOWN EXPRESSWAY	131	

TABLE A	
STRINGER	DIM "A"
S1-S8	10 3/8"
S9-S16	10 1/2"


# NOTE "A"

Dimension shown is measured from top of stringer to top of slab at the intersection of the centerline of stringer and the centerline of bearing. At exterior stringers this is measured to the cross slope extended. This dimension may be varied between bearings as required to care for variation in camber, except that no portion of the stringer flange may fall within the 8" slab.

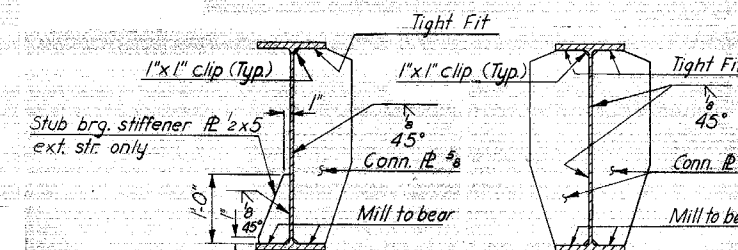

END DIAPHRAGM CONNECTOR PLATE AT EXTERIOR STRINGER  
No Scale

END DIAPHRAGM CONNECTOR PLATE AT INTERIOR STRINGER  
No Scale

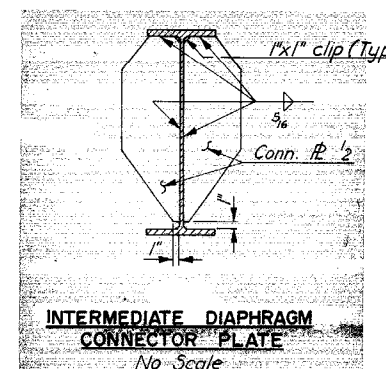


INTERMEDIATE DIAPHRAGM CONNECTOR PLATE FOR 36W STRINGERS  
No Scale


# NOTES:

For spacing and location of utility supports and diaphragms, see Framing Plan (1) sheet.  
For Basic Attachment Details for cement asbestos conduit, see Standard Conduit Installation Details sheet.  
For details showing gas and water mains thru abutments, see Standard Utility Support Details At Bridge Abutments sheet.


⊗ Indicates existing telephone ducts which are to be maintained in service. See Sheet 3.

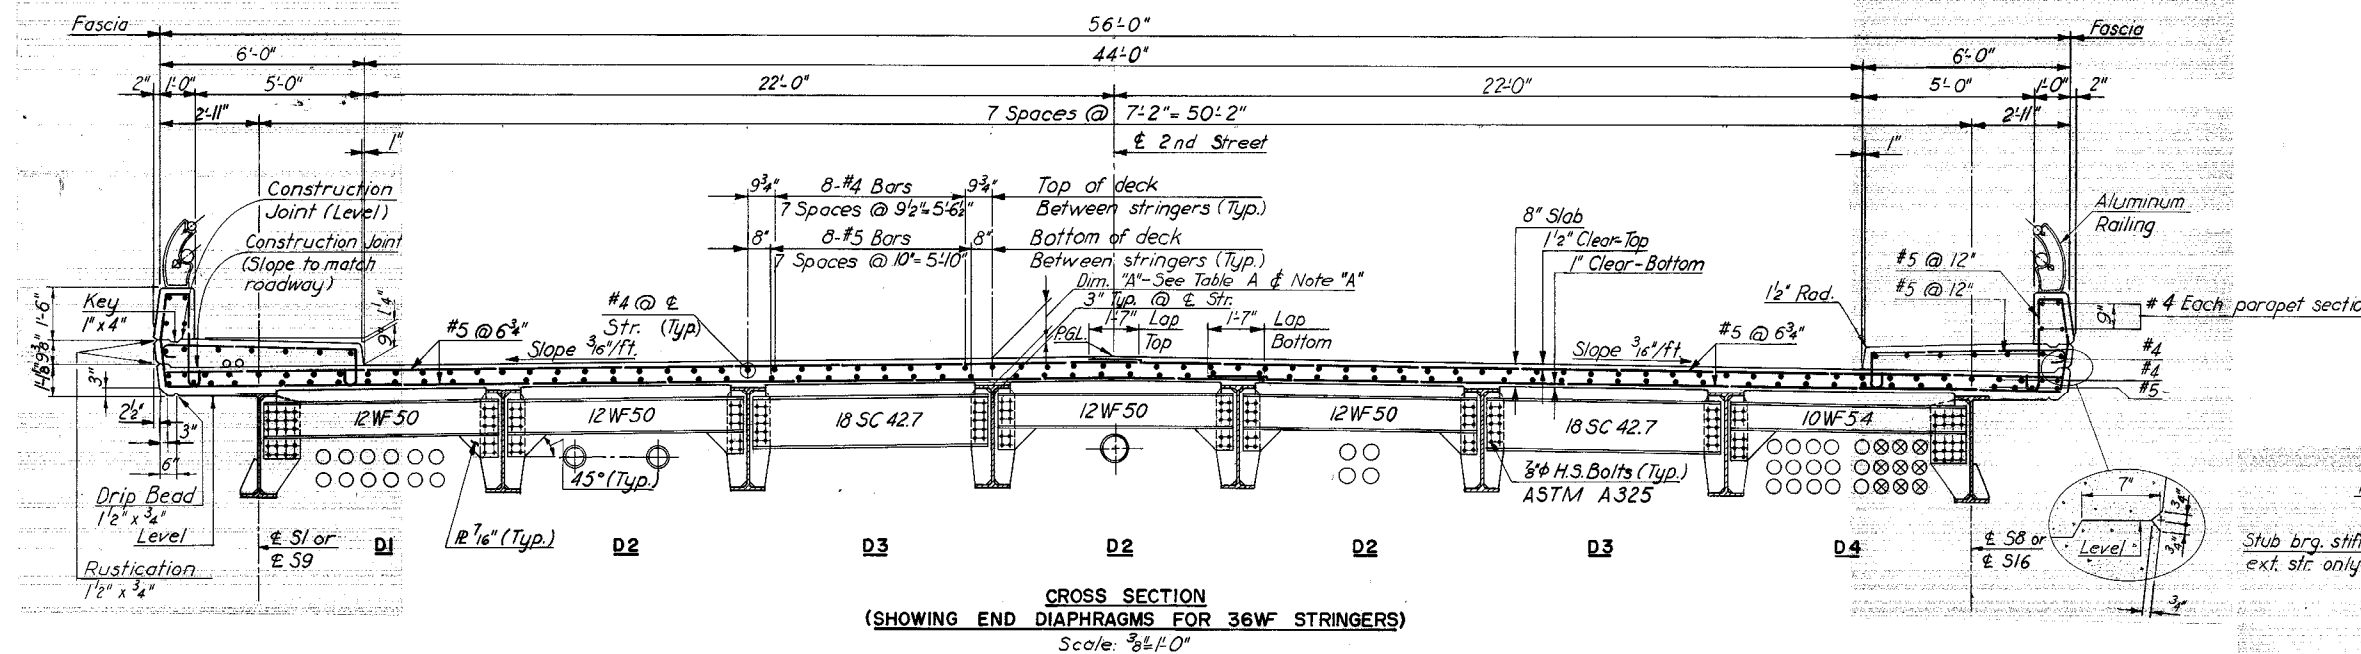


CROSS SECTION (SHOWING END DIAPHRAGMS FOR 36W STRINGERS)  
Scale: 3/8"=1'-0"

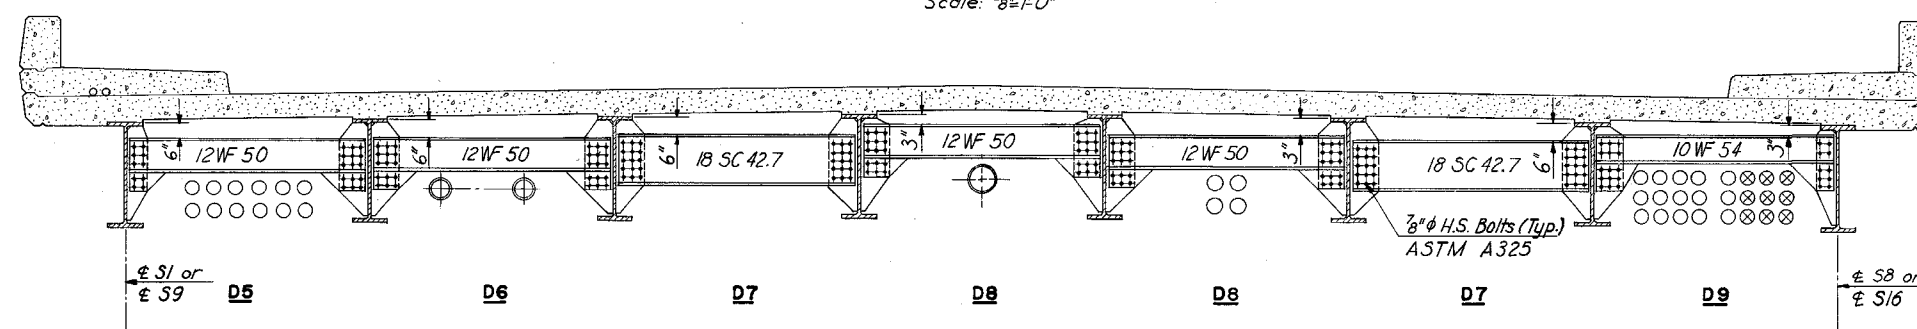


CROSS SECTION (SHOWING INTERMEDIATE DIAPHRAGMS FOR 36W STRINGERS)  
Scale: 3/8"=1'-0"

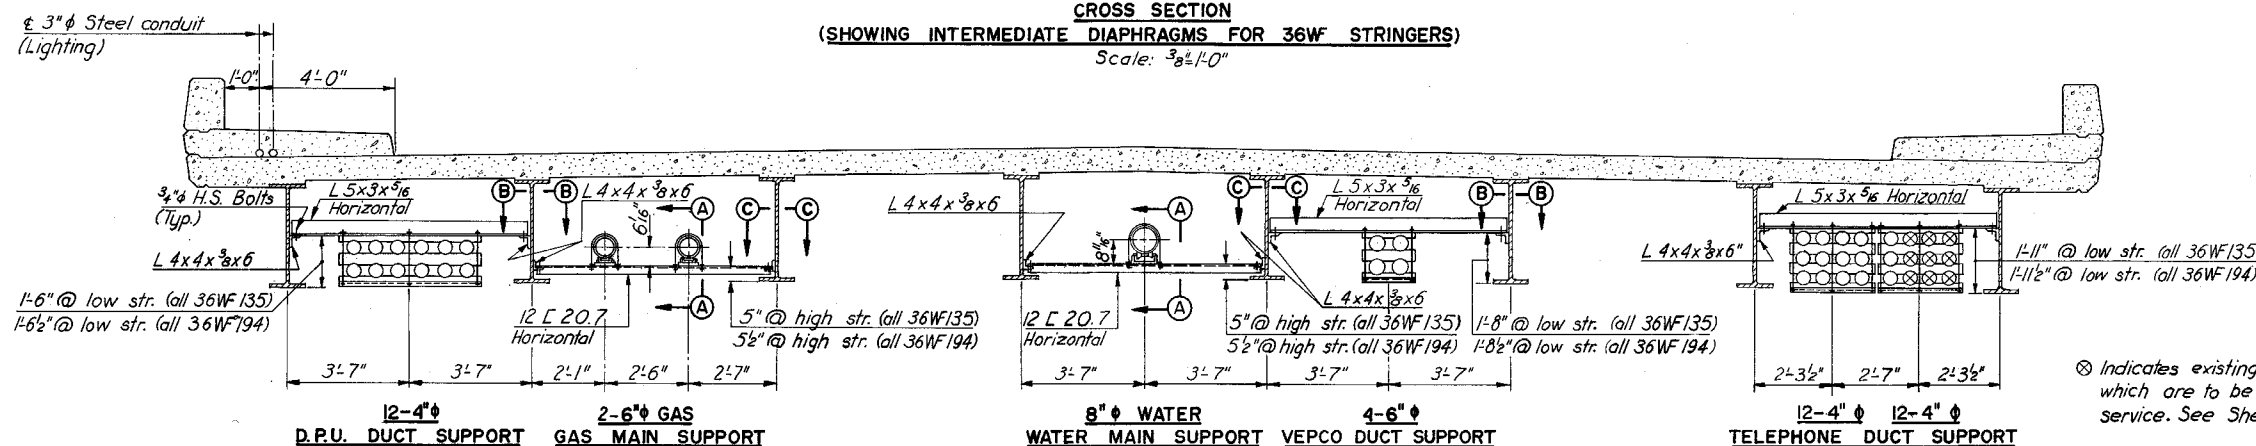


CROSS SECTION (SHOWING UTILITY SUPPORTS FOR 36W STRINGERS)  
Scale: 3/8"=1'-0"

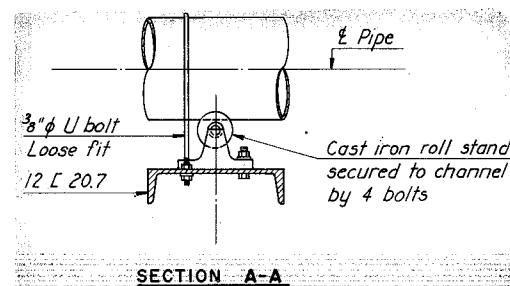


SECTION A-A

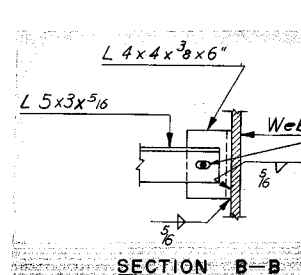

SECTION B-B

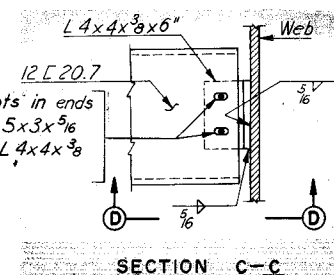

SECTION C-C

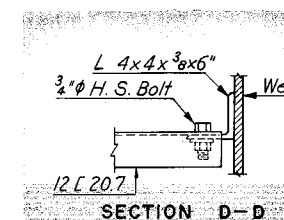

SECTION D-D


AS BUILT

RICHMOND METROPOLITAN AUTHORITY	
RICHMOND EXPRESSWAY SYSTEM	
DOWNTOWN EXPRESSWAY	
BRIDGE B-54	
2ND STREET OVER DOWNTOWN EXPRESSWAY	
CROSS SECTION (1)	
HOWARD, NEEDLES, TAMMEN & BERGENDOFF consulting engineers NEW YORK ALEXANDRIA KANSAS CITY	SCALE: AS SHOWN CONTRACT NO. 9 SHEET NO. 131 OF 20

MADE	BY	DATE			
DSB	EVR	10-67			
CHECKED	DSB	5-68	1	As Built	TEM 6-77
IN CHARGE	PRY		NO.	REVISION	BY DATE




RICHMOND EXPRESSWAY SYSTEM			
SECTION	PROJECT	SHEET NO.	TOTAL SHEETS
9	DOWNTOWN EXPRESSWAY	132	

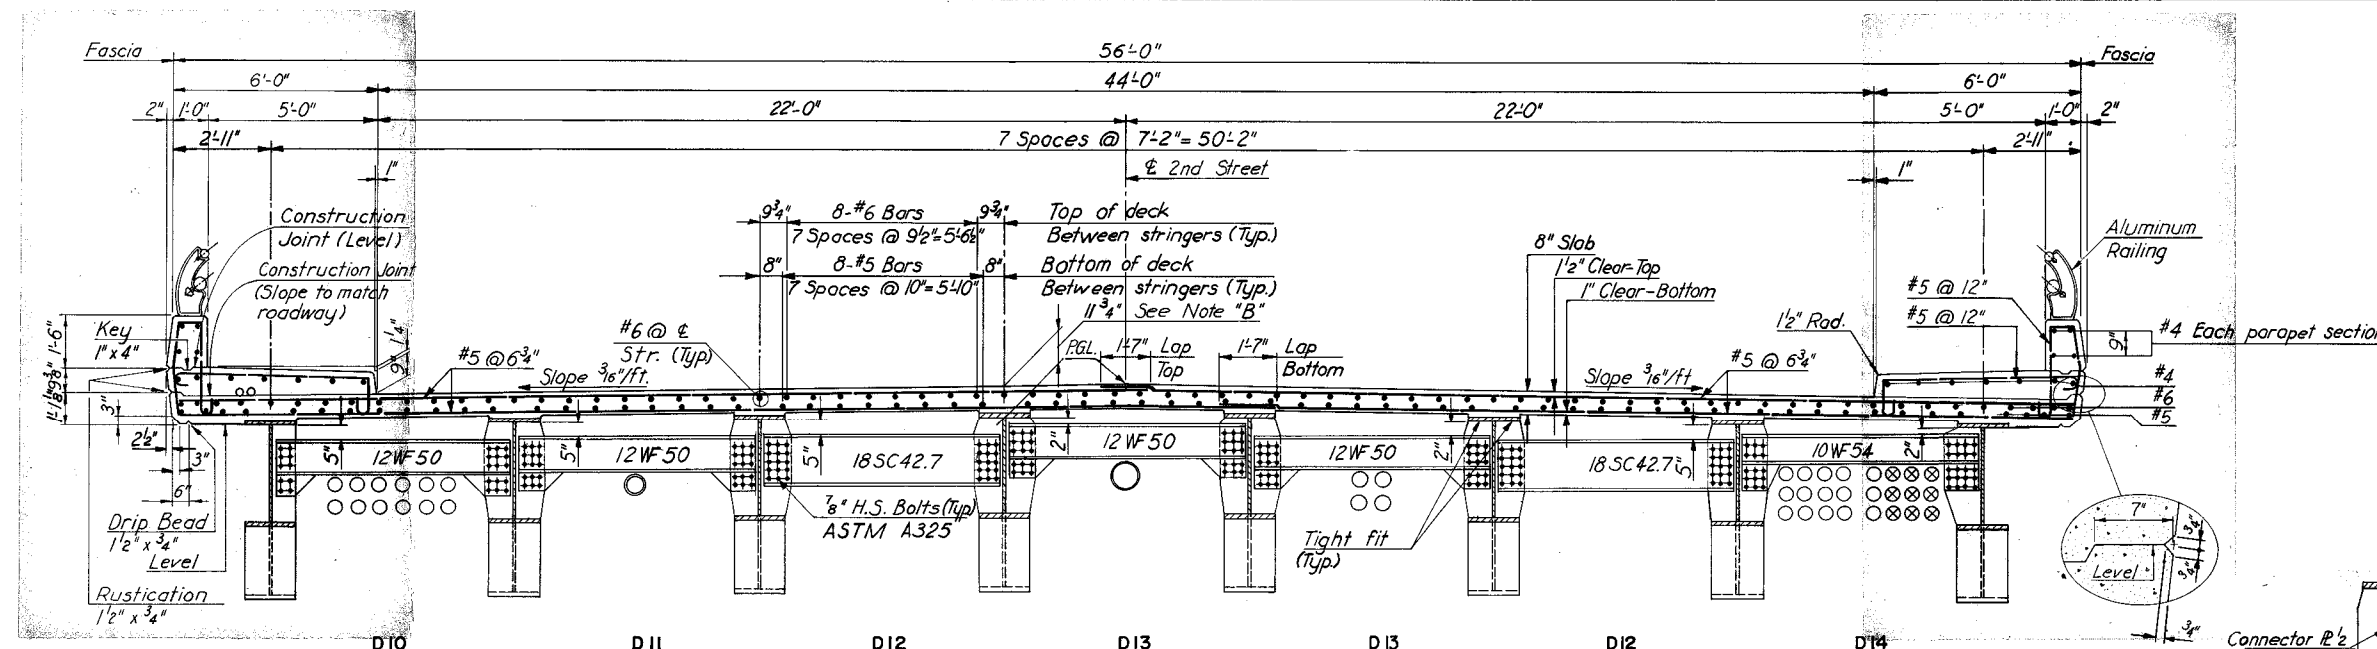


**NOTE "B"**  
Dimension shown is measured from top of web to top of slab at the intersection of the centerline of stringer and the centerline of bearing. At exterior stringers this is measured to the cross slope extended. This dimension may be varied between bearings as required to care for variation in camber, except that no portion of the stringer flange may fall within the 8" slab.

**CROSS SECTION**  
(SHOWING INTERMEDIATE DIAPHRAGMS FOR WELDED PLATE STRINGERS)  
Scale:  $\frac{3}{8}" = 1'-0"$

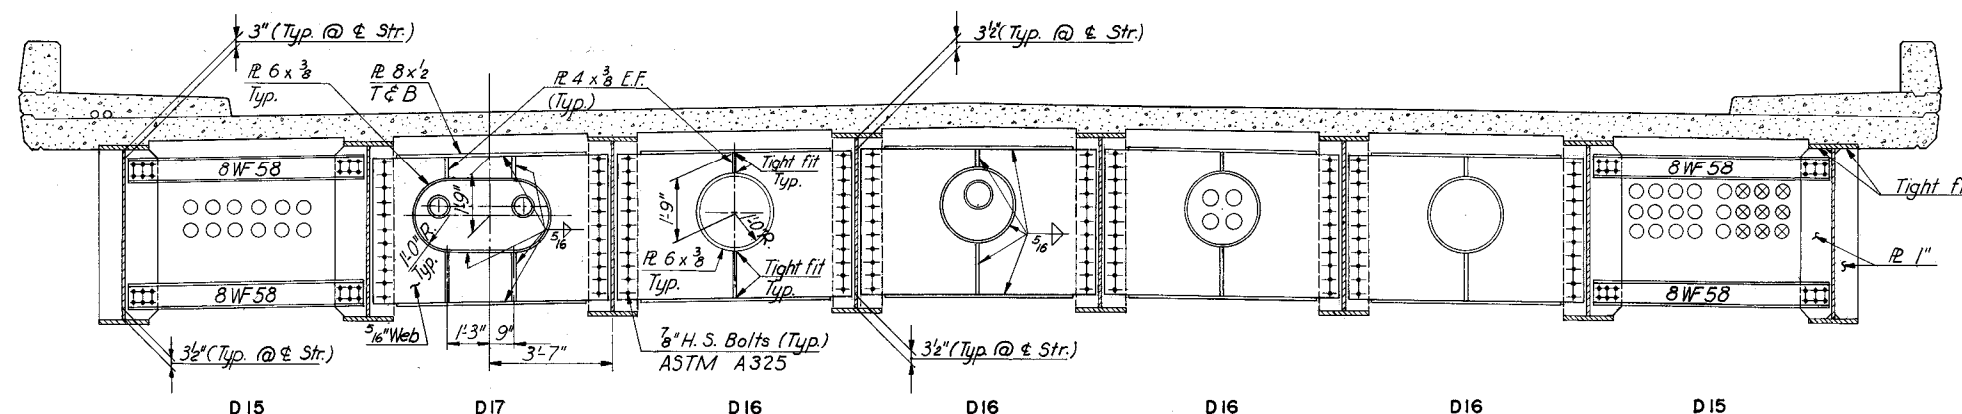

**INTERMEDIATE DIAPHRAGM CONNECTOR PLATE**  
D10 THRU D14

**INTERMEDIATE STIFFENER AT DIAPHRAGM D5 THRU D9**

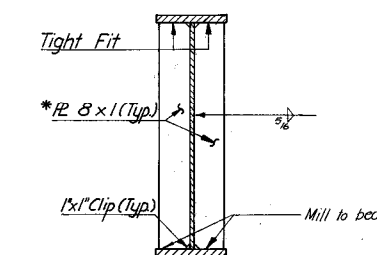


**BEARING STIFFENER AT PIER 2**  
D15 & D16

\* Bearing stiffener width is minimum and may be increased to accommodate diaphragm.

**FOR WELDED PLATE STRINGERS**  
No Scale

**CROSS SECTION**  
(SHOWING DIAPHRAGMS FOR WELDED PLATE STRINGERS AT PIER 2)  
Scale:  $\frac{3}{8}" = 1'-0"$

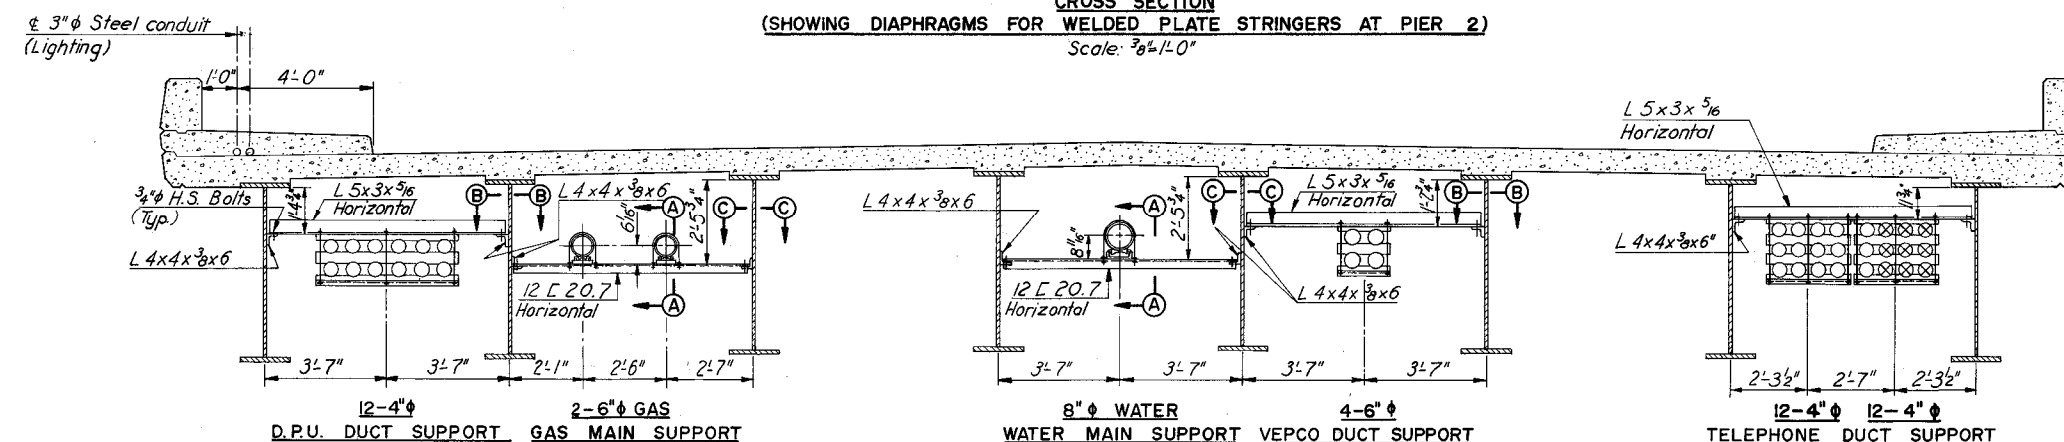

**CROSS SECTION**  
(SHOWING UTILITY SUPPORTS FOR WELDED PLATE STRINGERS)  
Scale:  $\frac{3}{8}" = 1'-0"$

**NOTES:**  
For spacing and location of utility supports and diaphragms, see Framing Plan (1) sheet.  
For Basic Attachment Details for cement asbestos conduit, see Standard Conduit Installation Details sheet.  
For details showing gas and water mains thru abutments, see Standard Utility Support Details At Bridge Abutments sheet.  
For Sections A-A, B-B, C-C, see Cross Section (1) Sheet.


⊗ Indicates existing telephone ducts which are to be maintained in service. See Sheet 3.

MADE	CHECKED	IN CHARGE	BY	DATE	NO.	REVISION	BY	DATE
EVR	DSB	P.R.Y.		1-68	1	As Built	TEM	6-77

AS BUILT


RICHMOND METROPOLITAN AUTHORITY	
RICHMOND EXPRESSWAY SYSTEM	
DOWNTOWN EXPRESSWAY	
BRIDGE B-54	
2ND STREET OVER DOWNTOWN EXPRESSWAY	
CROSS SECTION (2)	
HOWARD, NEEDLES, TAMMEN & BERGENDOFF consulting engineers NEW YORK ALEXANDRIA KANSAS CITY	SCALE: AS SHOWN CONTRACT NO. 9 SHEET NO. 14 OF 20

RICHMOND EXPRESSWAY SYSTEM			
SECTION	PROJECT	SHEET NO.	TOTAL SHEETS
9	DOWNTOWN EXPRESSWAY	133	

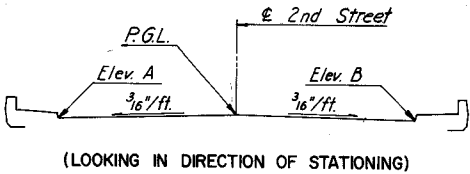


PAVEMENT ELEVATIONS							
STATION	ELEV. A	C & B P.G.L.	ELEV. B	STATION	ELEV. A	C & B P.G.L.	ELEV. B
15+90.00	*142.76	*143.10	*142.76	+40.00	136.42	136.76	136.42
16+00.00	*142.42	*142.76	*142.42	17+50.00	135.91	136.25	135.91
+10.00	*142.06	*142.40	142.06	+60.00	135.39	135.73	135.39
+11.13	—	—	142.02	+62.01	—	—	135.28
+14.20	—	142.25	—	+63.63	—	135.54	—
+17.26	141.80	—	—	+65.25	135.11	—	—
+20.00	141.70	142.04	141.70	+70.00	134.87	135.21	134.87
+30.00	141.32	141.66	141.32	+80.00	134.35	134.69	134.35
+40.00	140.93	141.27	140.93	+90.00	133.83	134.17	133.83
16+50.00	140.53	140.87	140.53	18+00.00	133.31	133.65	133.31
+58.08	—	—	140.20	+10.00	132.79	133.13	132.79
+60.00	140.12	140.46	140.12	+20.00	132.27	132.61	132.27
+61.15	—	140.42	—	+30.00	131.75	132.09	131.75
+64.21	139.94	—	—	+40.00	131.23	131.57	131.23
+70.00	139.70	140.04	139.70	18+50.00	130.71	131.05	130.71
+80.00	139.27	139.61	139.27	+60.00	130.19	130.53	130.19
+90.00	138.82	139.16	138.82	+67.04	129.82	130.16	129.82
17+00.00	138.37	138.71	138.37	+70.00	129.67	130.01	129.67
+10.00	137.90	138.24	137.90	+80.00	*129.15	*129.49	*129.15
+20.00	137.42	137.76	137.42	+90.00	—	*128.97	—
+30.00	136.93	137.27	136.93	19+00.00	—	*128.45	—

\* Elevations shown are given to top of bituminous surfacing.

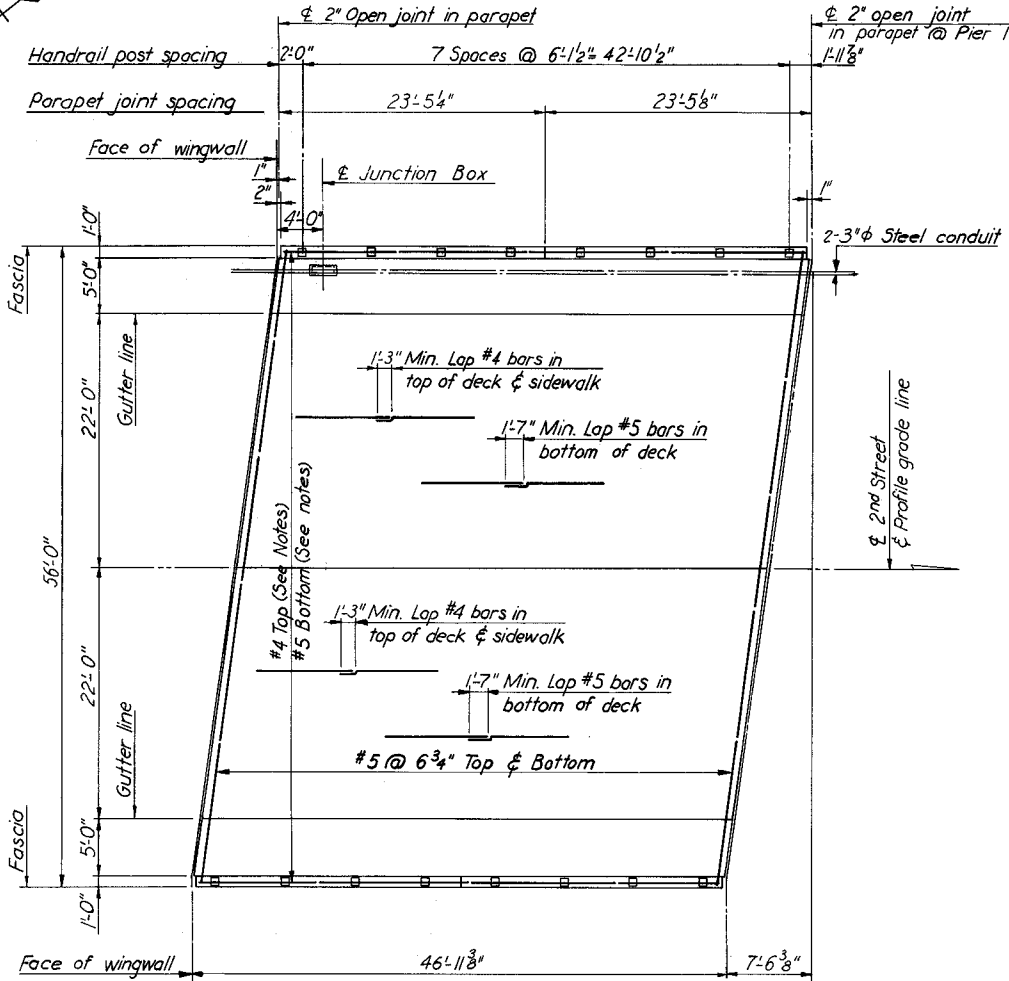

PLAN-UNIT I  
Scale: 1/8"=1'-0"

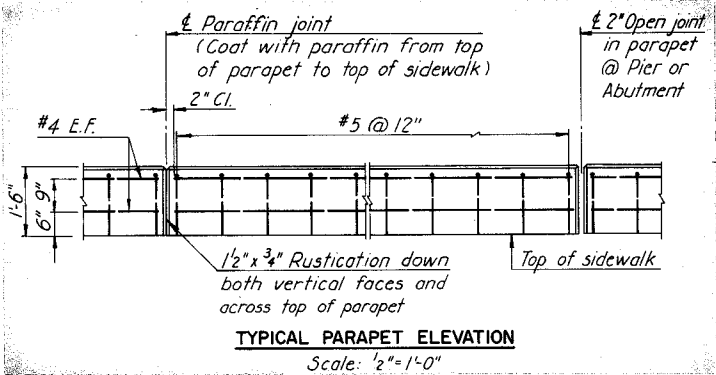

**NOTES:**

For location and spacing of deck, parapet and sidewalk reinforcing, see Cross Section (1) sheet.

For location and spacing of reinforcing in haunch over end diaphragms, see Joint Details sheet.

For lighting standard base, junction box details and additional reinforcing, see Standard Electrical Details sheet S4.


MADE	BY	DATE	NO.	REVISION	BY	DATE
EVR	3-68					
DSB	5-68		1	As Built	TEM	6-77
PRY						

AS BUILT


RICHMOND METROPOLITAN AUTHORITY	
RICHMOND EXPRESSWAY SYSTEM	
DOWNTOWN EXPRESSWAY	
BRIDGE B-54	
2ND STREET OVER DOWNTOWN EXPRESSWAY	
DECK PLAN I	
HOWARD, NEEDLES, TAMMEN & BERGENDOFF consulting engineers NEW YORK ALEXANDRIA KANSAS CITY	SCALE: AS SHOWN CONTRACT NO.: 9 SHEET NO. 15 OF 20



RICHMOND EXPRESSWAY SYSTEM			
SECTION	PROJECT	SHEET NO.	TOTAL SHEETS
9	DOWNTOWN EXPRESSWAY	134	

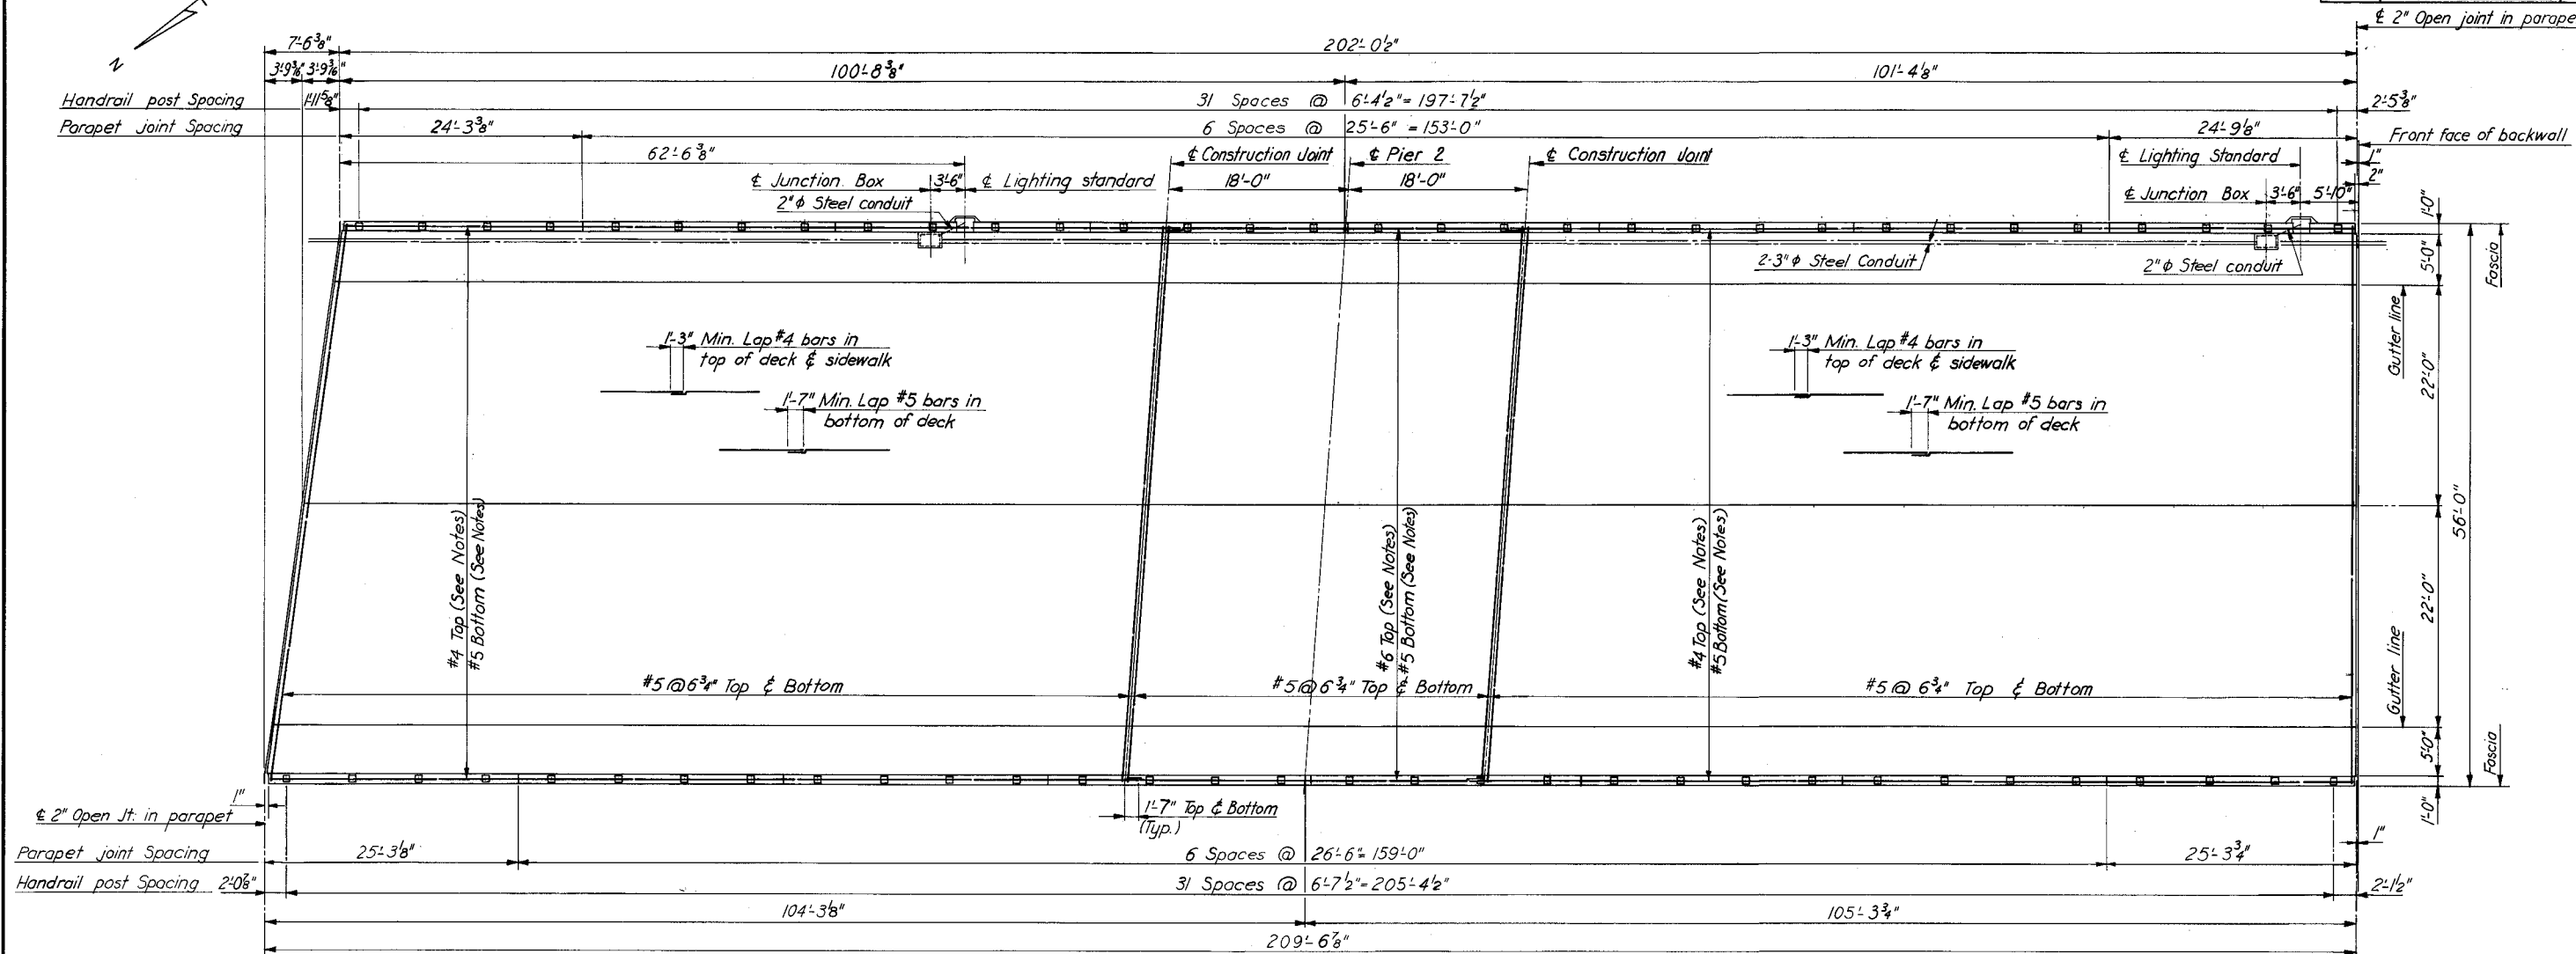


PLAN - UNIT 2  
Scale: 1/8" = 1'-0"

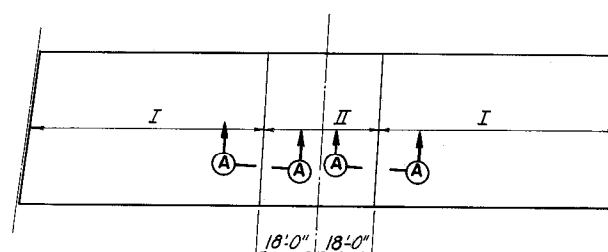

OPTIONAL  
DECK POURING SEQUENCE  
No Scale

Area marked I indicates first pour.  
Area marked II indicates second pour.

Note:  
Unit 2 was poured  
in one pour.

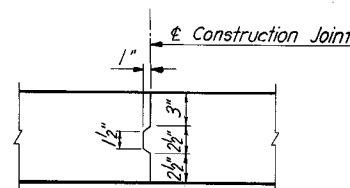

SECTION A-A  
No Scale

#### NOTES

For location and spacing of deck parapet and sidewalk reinforcement see Cross Section (1) Sheet for end portion and Cross Section (2) Sheet for Pier 2.

For location and spacing of reinforcing in haunch over end diaphragms, see Joint Details sheet.


For lighting standard base, junction box details and additional reinforcing, see Standard Electrical Details sheet S4.

BY	DATE				
MADE	EVR	3-68			
CHECKED	DSB	5-68	1	As Built	TEM 6-77
IN CHARGE	PRY		NO.	REVISION	BY DATE



AS BUILT

RICHMOND METROPOLITAN AUTHORITY RICHMOND EXPRESSWAY SYSTEM DOWNTOWN EXPRESSWAY	
BRIDGE B-54 2ND STREET OVER DOWNTOWN EXPRESSWAY DECK PLAN 2	
HOWARD, NEEDLES, TAMMEN & BERGENDOFF consulting engineers NEW YORK ALEXANDRIA KANSAS CITY	SCALE: AS SHOWN CONTRACT NO. 9 SHEET NO. 16 OF 20


RICHMOND EXPRESSWAY SYSTEM			
SECTION	PROJECT	SHEET NO.	TOTAL SHEETS
9	DOWNTOWN EXPRESSWAY	135	

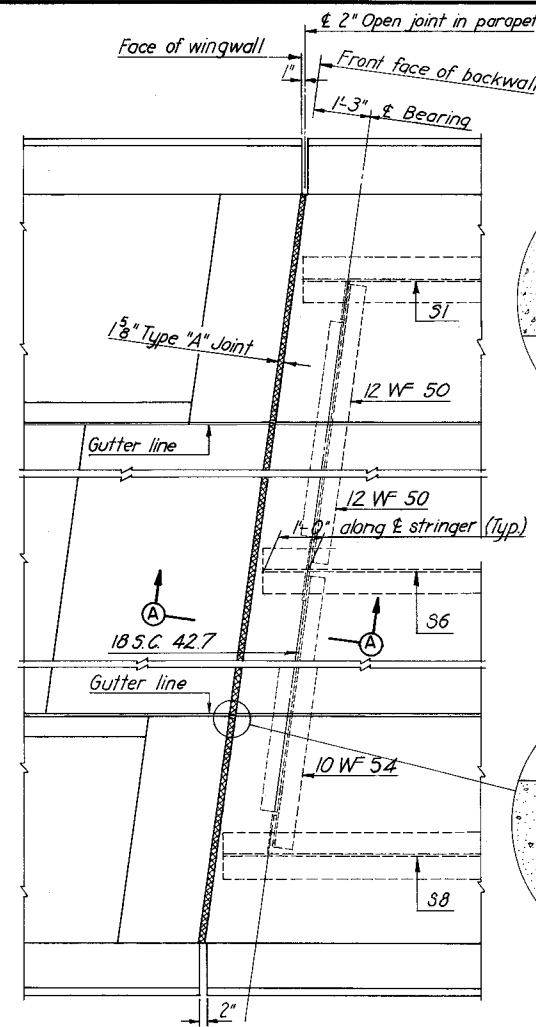


PLAN - JOINT AT NORTH ABUTMENT  
Scale: 1/2" = 1'-0"

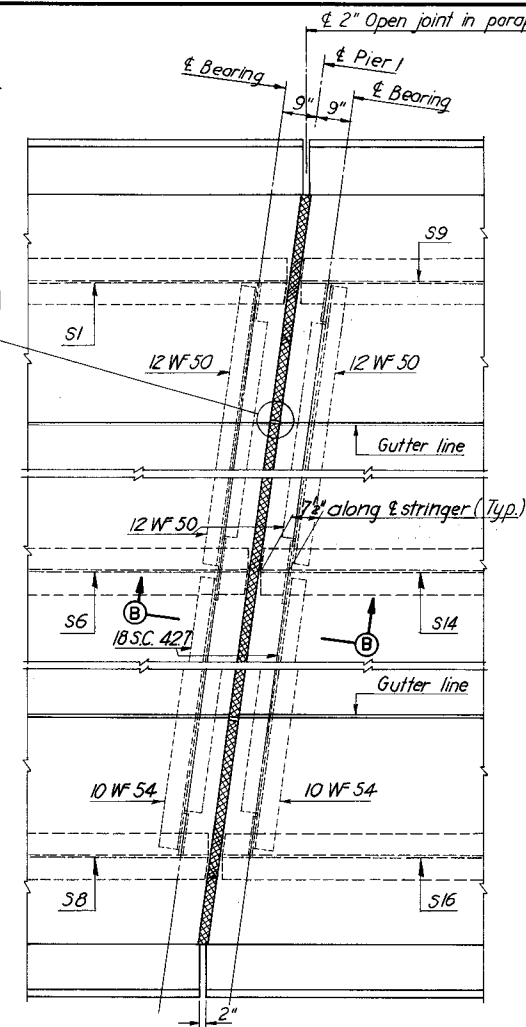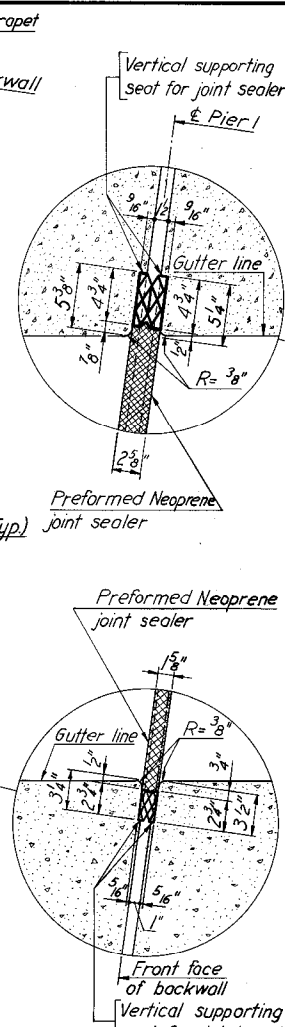


PLAN - JOINT AT PIER 1  
Scale: 1/2" = 1'-0"

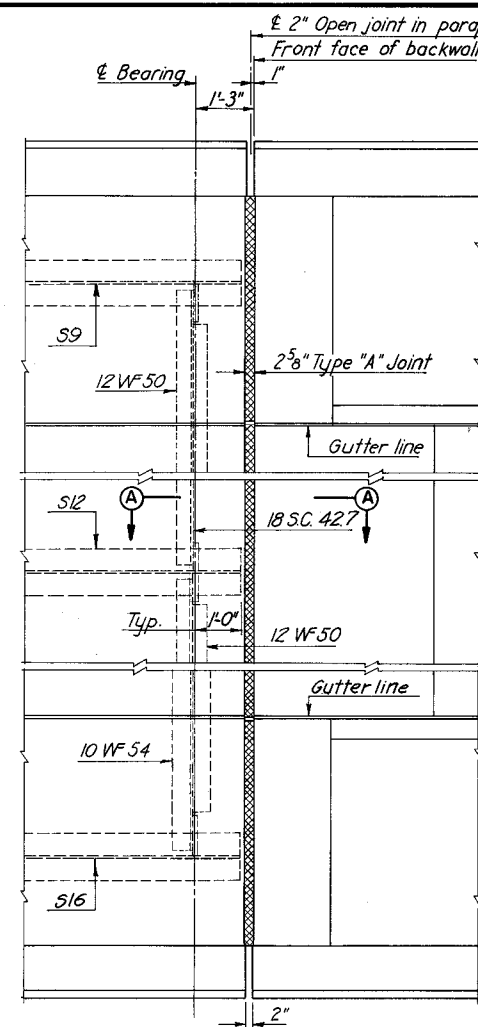


PLAN - JOINT AT SOUTH ABUTMENT  
Scale: 1/2" = 1'-0"

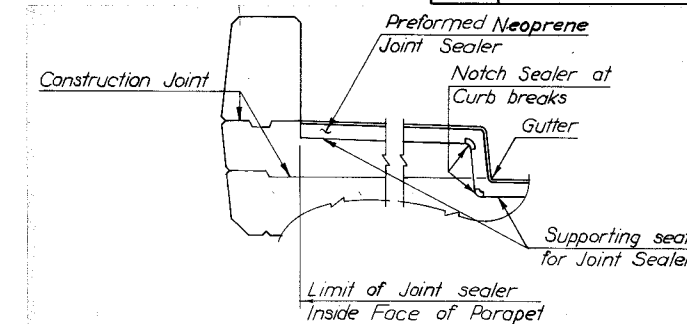


TREATMENT OF TYPE "A" JOINT AT CURB  
No Scale

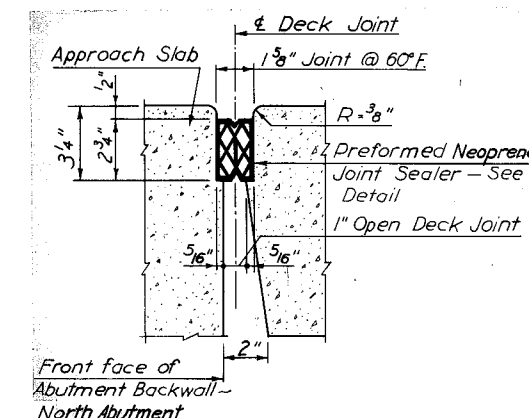


1 1/2" TYPE "A" JOINT  
Scale: 3/4" = 1'-0"

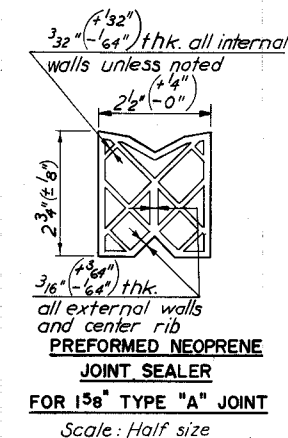


FOR 1 1/2" TYPE "A" JOINT  
Scale: Half size

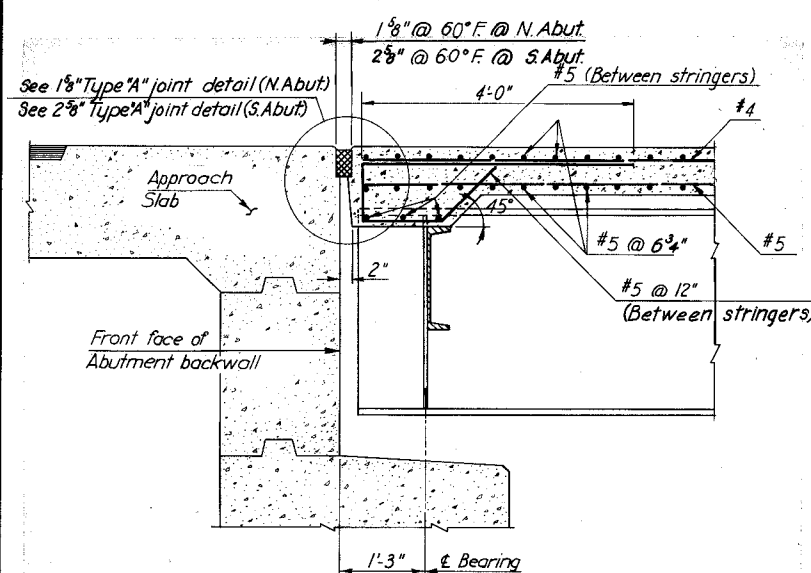


SECTION A-A  
Scale: 3/4" = 1'-0"

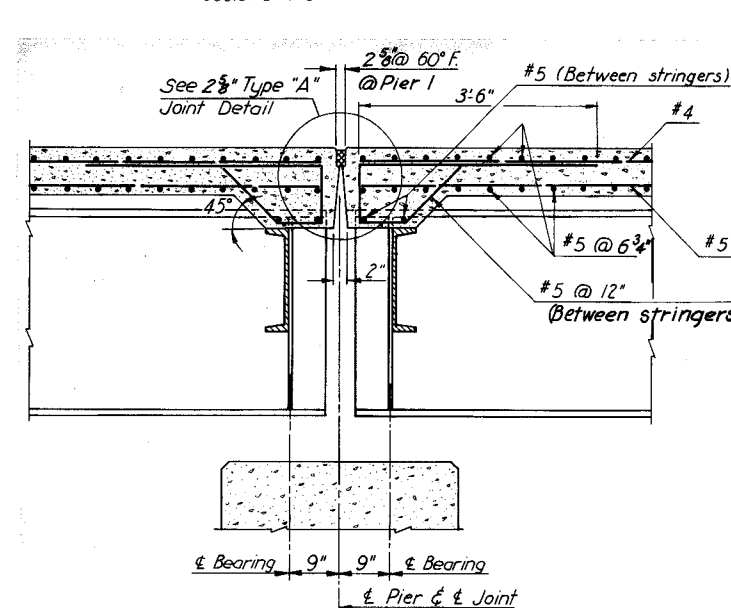


SECTION B-B  
Scale: 3/4" = 1'-0"

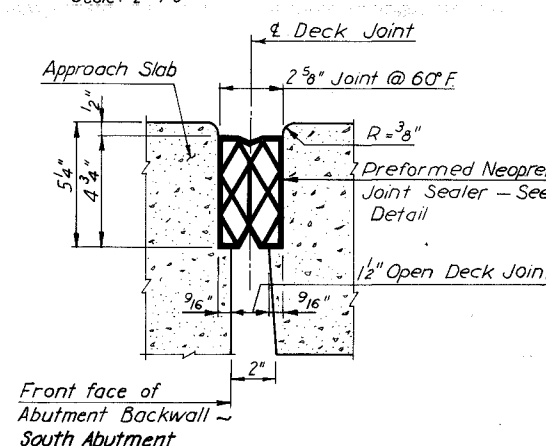

2 1/2" TYPE "A" JOINT  
Scale: 3/4" = 1'-0"

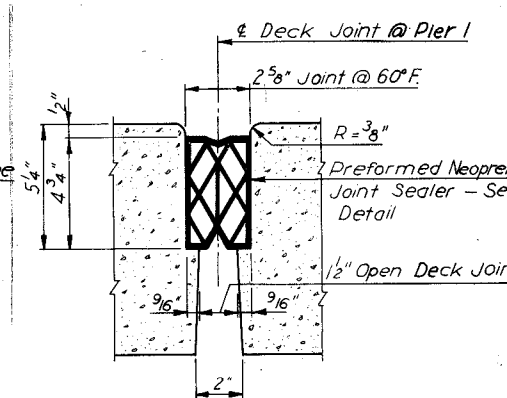

2 1/2" TYPE "A" JOINT  
Scale: 3/4" = 1'-0"

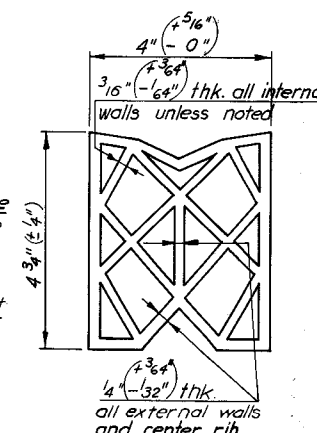

FOR 2 1/2" TYPE "A" JOINT  
Scale: Half size


**NOTE TO CONTRACTOR:**  
It is absolutely essential that the openings for the preformed Neoprene joint sealers be accurately formed and constructed to smooth, straight lines. The size of the opening shall be adjusted to allow for anticipated dead load rotation of the ends of the slab and for the temperature of the time of construction.

RICHMOND METROPOLITAN AUTHORITY	
RICHMOND EXPRESSWAY SYSTEM	
DOWNTOWN EXPRESSWAY	
BRIDGE B-54	
2ND STREET OVER	
DOWNTOWN EXPRESSWAY	
JOINT DETAILS	
HOWARD, NEEDLES, TAMMEN & BERGENDOFF consulting engineers NEW YORK ALEXANDRIA KANSAS CITY	SCALE: AS SHOWN CONTRACT NO.: 9 SHEET NO. 17 OF 20

AS BUILT







RICHMOND EXPRESSWAY SYSTEM			
SECTION	PROJECT	SHEET NO.	TOTAL SHEETS
9	DOWNTOWN EXPRESSWAY	136	

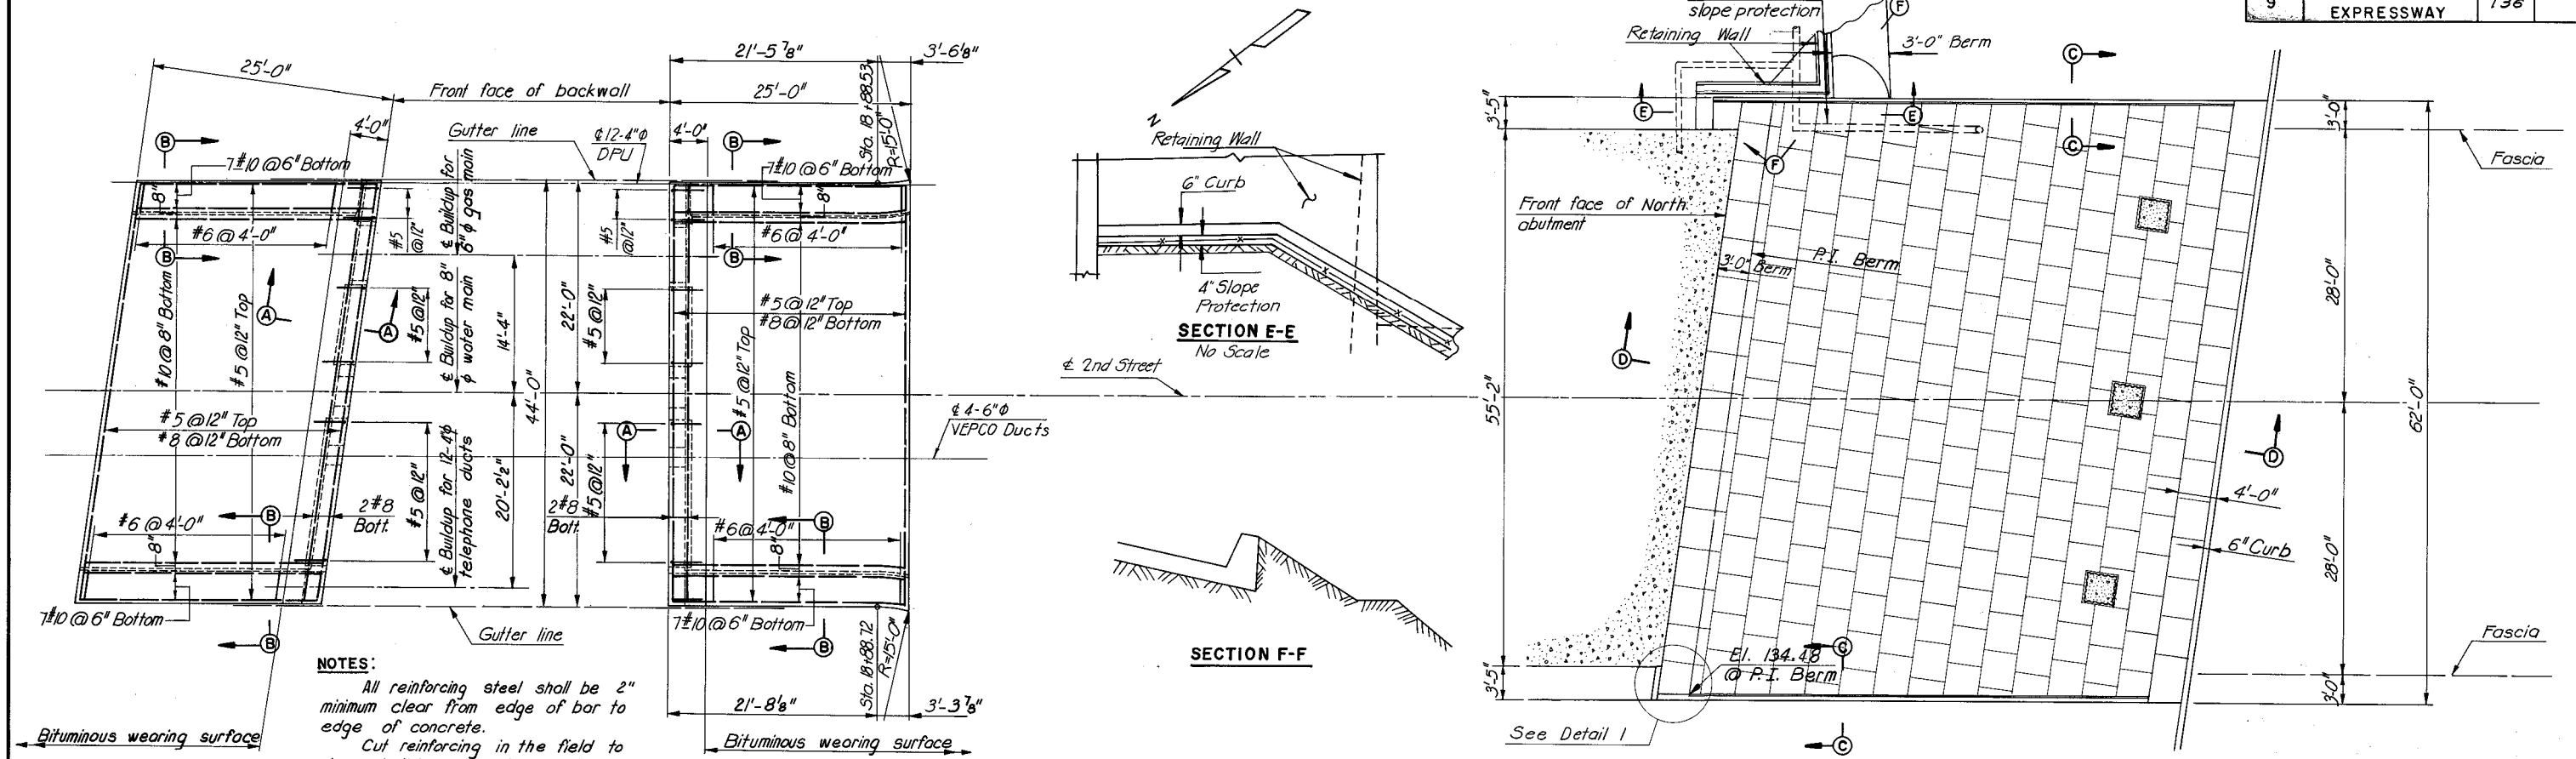

**NORTH APPROACH SLAB**  
Scale: 1/8" = 1'-0"

**SOUTH APPROACH SLAB**  
Scale: 1/8" = 1'-0"

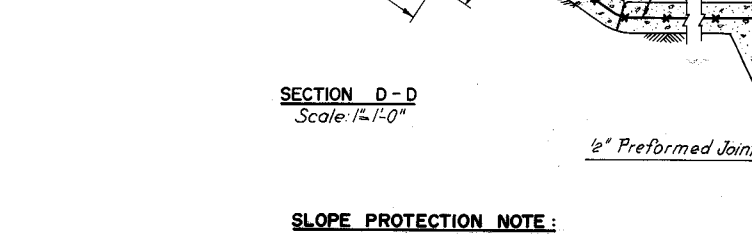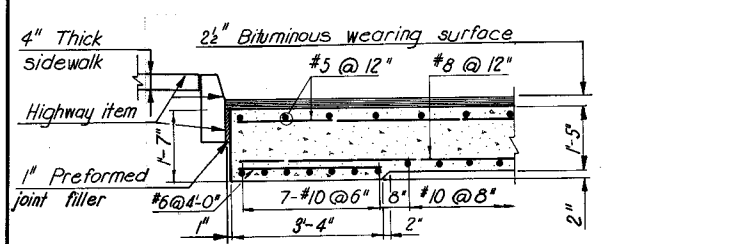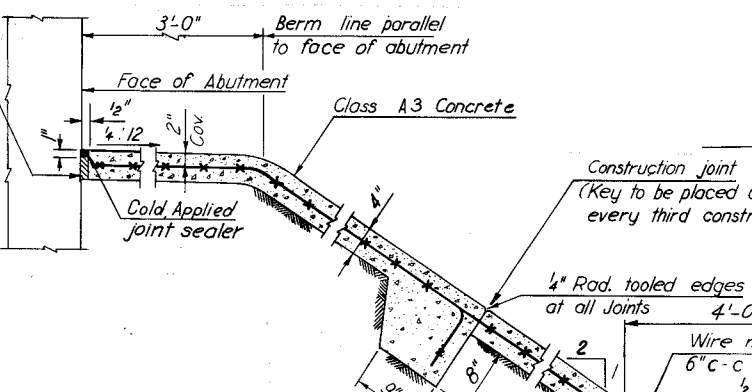
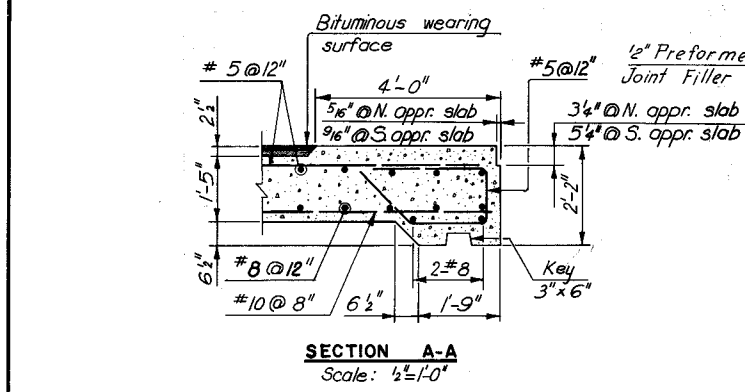


MADE	BY	DATE	REVISION	BY	DATE
DSB	DSB	12-67	As Built	TEM	6-77
CHECKED	DSB	5-68	Slope Protection NE Corner		
IN CHARGE	PRV				

**SLOPE PROTECTION NOTE:**

The item "Cast-in-Place Concrete Slab Slope Protection" shall include the excavation of, or the placing and compaction of any embankment material necessary to bring the surface of the paved slopes to the finished elevations shown on the plans. "Cast-in-Place Concrete Slab Slope Protection" shall be paid for at the contract unit price per square yard, which price shall include the concrete slab including wire mesh and joint filler.

The slab shall be constructed in 4'-0" x 4'-0" panels, placed in horizontal courses, alternate panels being poured in a staggered pattern with adjacent panels poured later. The slab shall be Class A3 concrete of such consistency that it can be placed without the use of top forms. The surface shall be finished with a wood float. Reinforcing shall consist of wire mesh No. 6 gage, 6" c.c. each way, placed at the center of the slab, and continuous through construction joints.

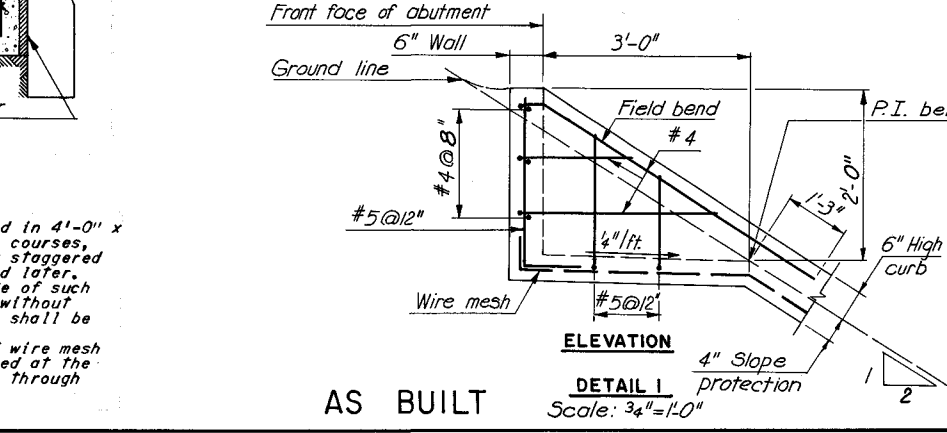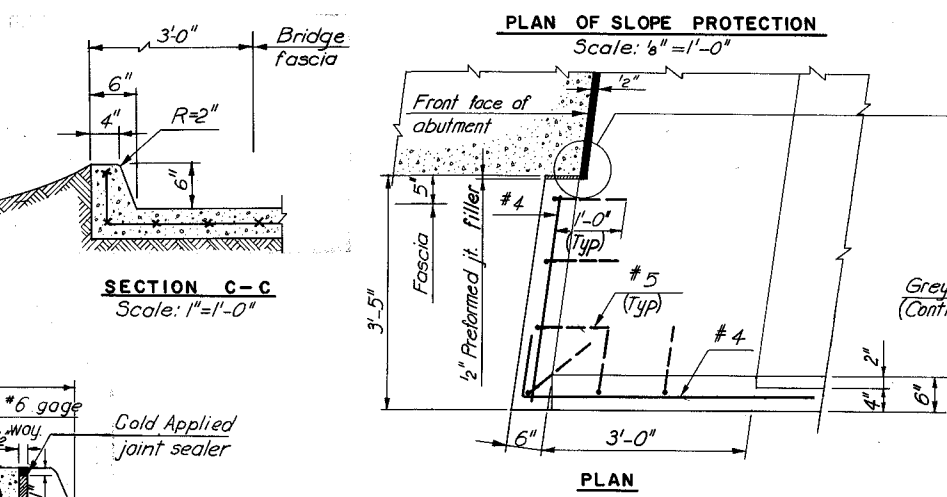

**RICHMOND METROPOLITAN AUTHORITY**  
**RICHMOND EXPRESSWAY SYSTEM**  
DOWNTOWN EXPRESSWAY

BRIDGE B-54  
2ND STREET OVER  
DOWNTOWN EXPRESSWAY

**APPROACH SLABS AND SLOPE PROTECTION**

HOWARD, NEEDLES, TAMMEN & BERGENDOFF  
consulting engineers  
NEW YORK ALEXANDRIA KANSAS CITY

SCALE: AS SHOWN  
CONTRACT NO.: 9  
SHEET NO. 18 OF 20

AS BUILT

# **Bridge 55**






**(South 3rd Street  
Over Downtown Expressway {Rte. 195})**


**Record Set Plans**



RICHMOND EXPRESSWAY SYSTEM			
SECTION	PROJECT	SHEET NO.	TOTAL SHEETS
9	DOWNTOWN EXPRESSWAY	139	

INDEX	
NO.	DESCRIPTION
1	General Plan and Elevation
2	General Notes and Quantities
3	North Abutment
4	North Abutment Details (1)
5	North Abutment Details (2)
6	North Abutment Details (3)
7	South Abutment
8	South Abutment Details (1)
9	South Abutment Details (2)
10	Pier
11	Framing Plan
12	Cross Section and Utility Details
13	Deck Plans
14	Joint Details
15	Approach Slabs and Slope Protection
16	Boring Logs
S1	Standard Shoe Details
S3	Standard Aluminum Railing Details (2 Rails)
S4	Standard Electrical Details (Bridges Carrying City Streets)
S7	Standard Architectural Details
S8	Standard Architectural Details
S9	Standard Architectural Details
S10	Standard Conduit Installation Details
S11	Standard Utility Support Details at Bridge Abutments

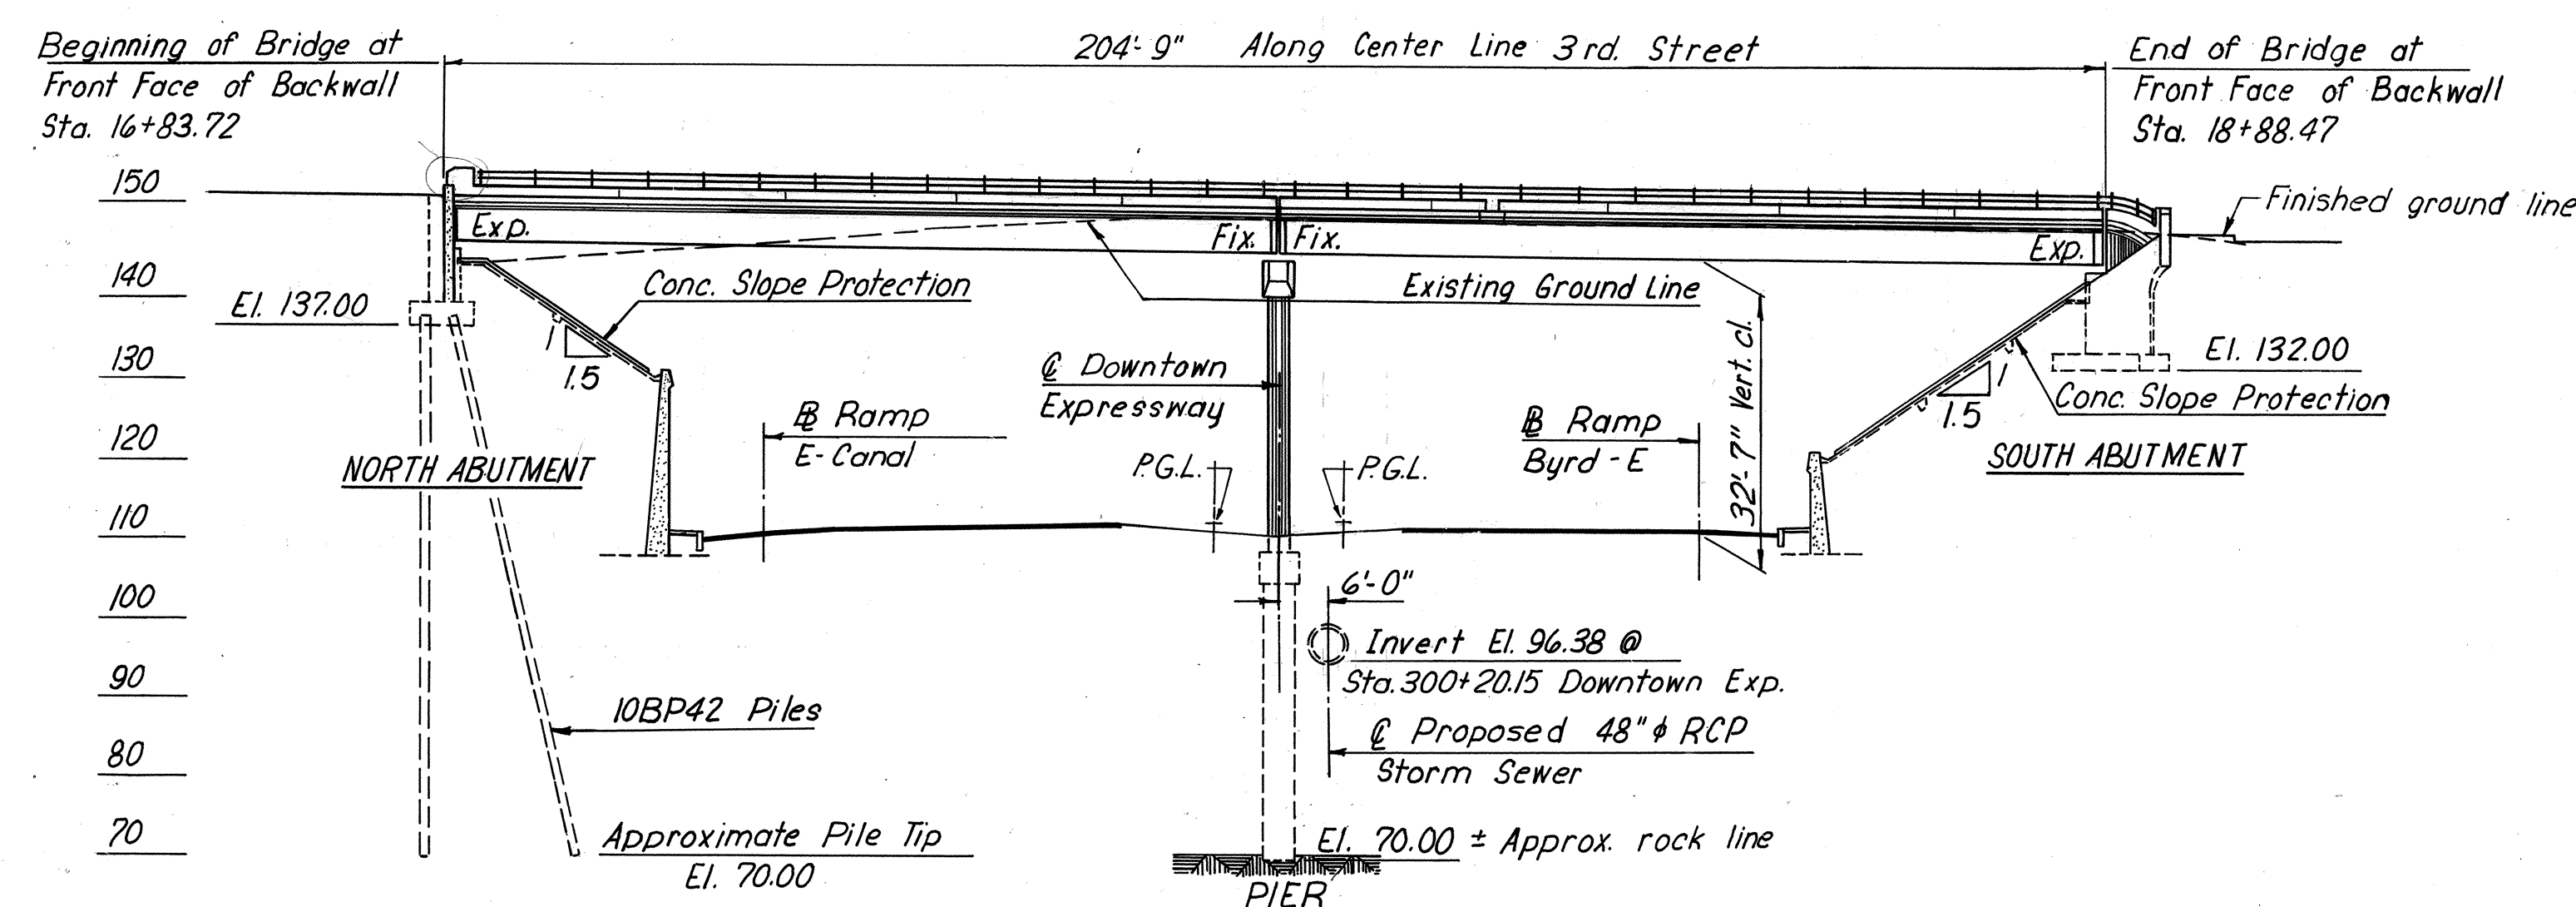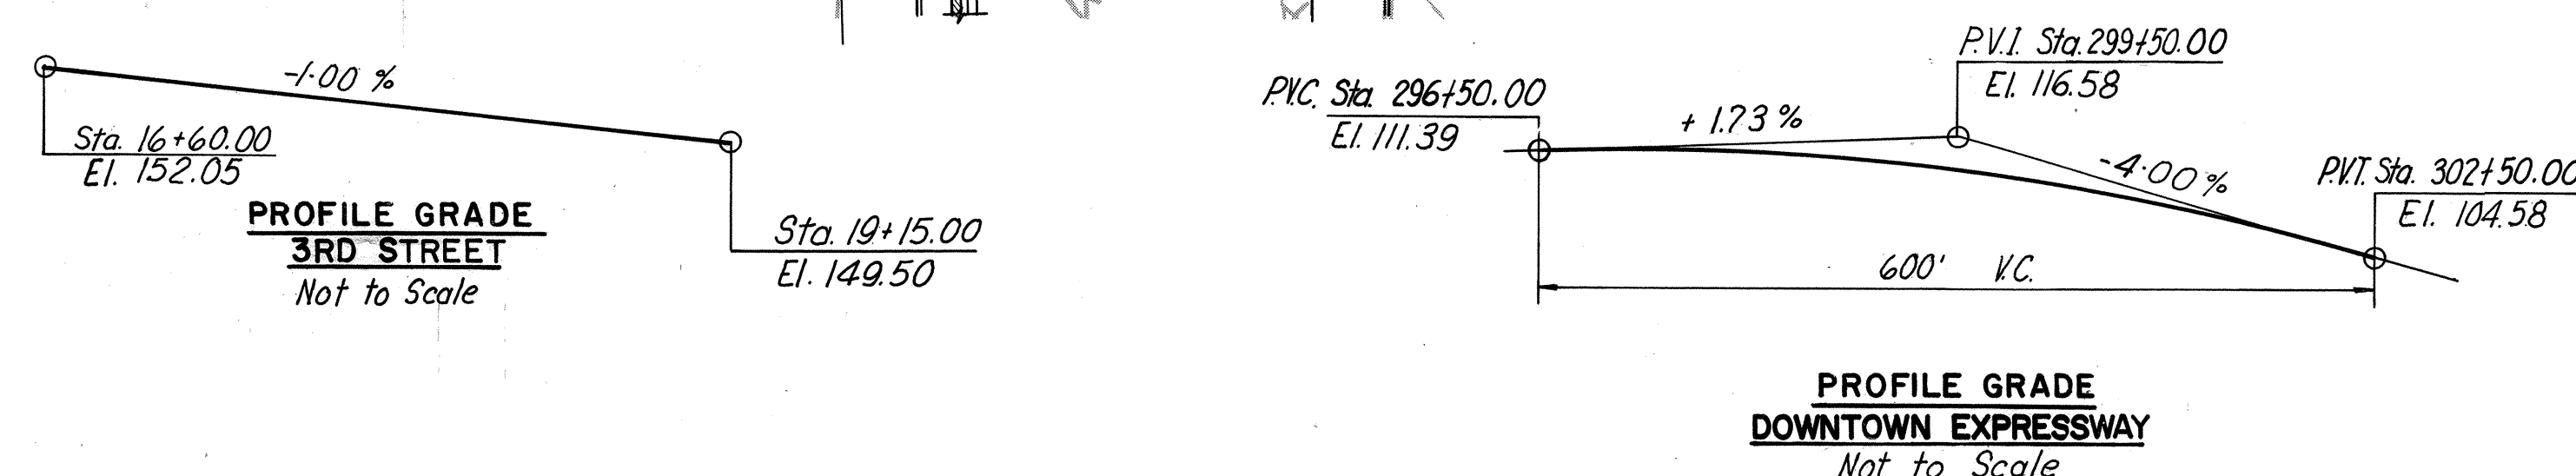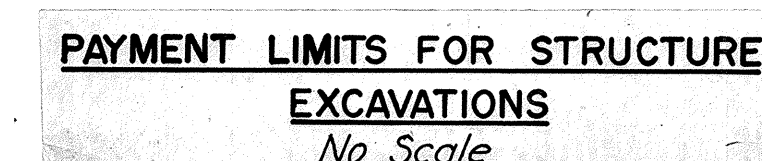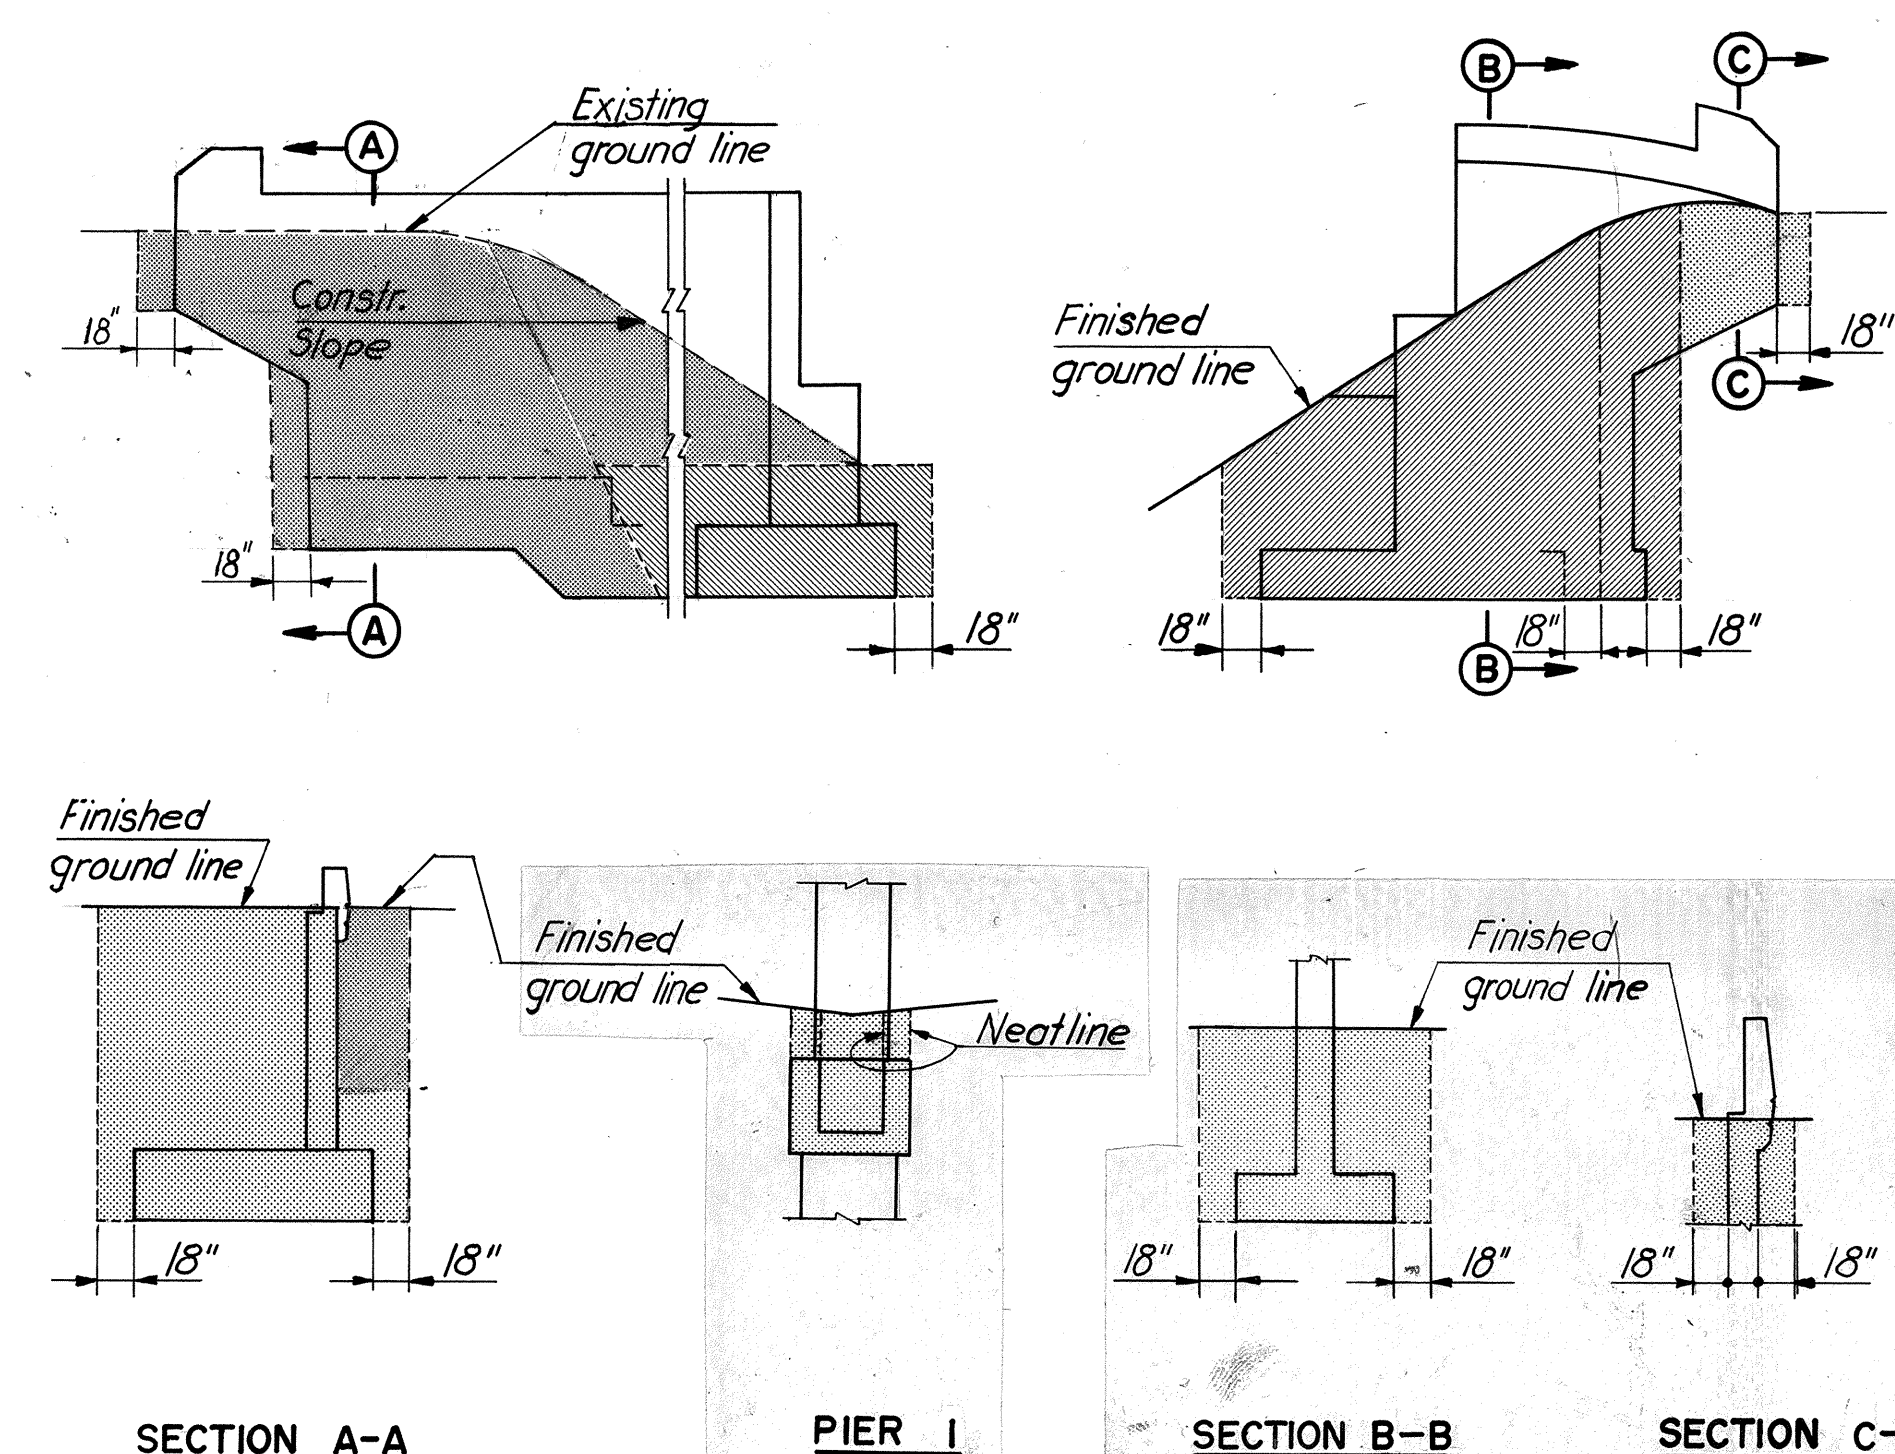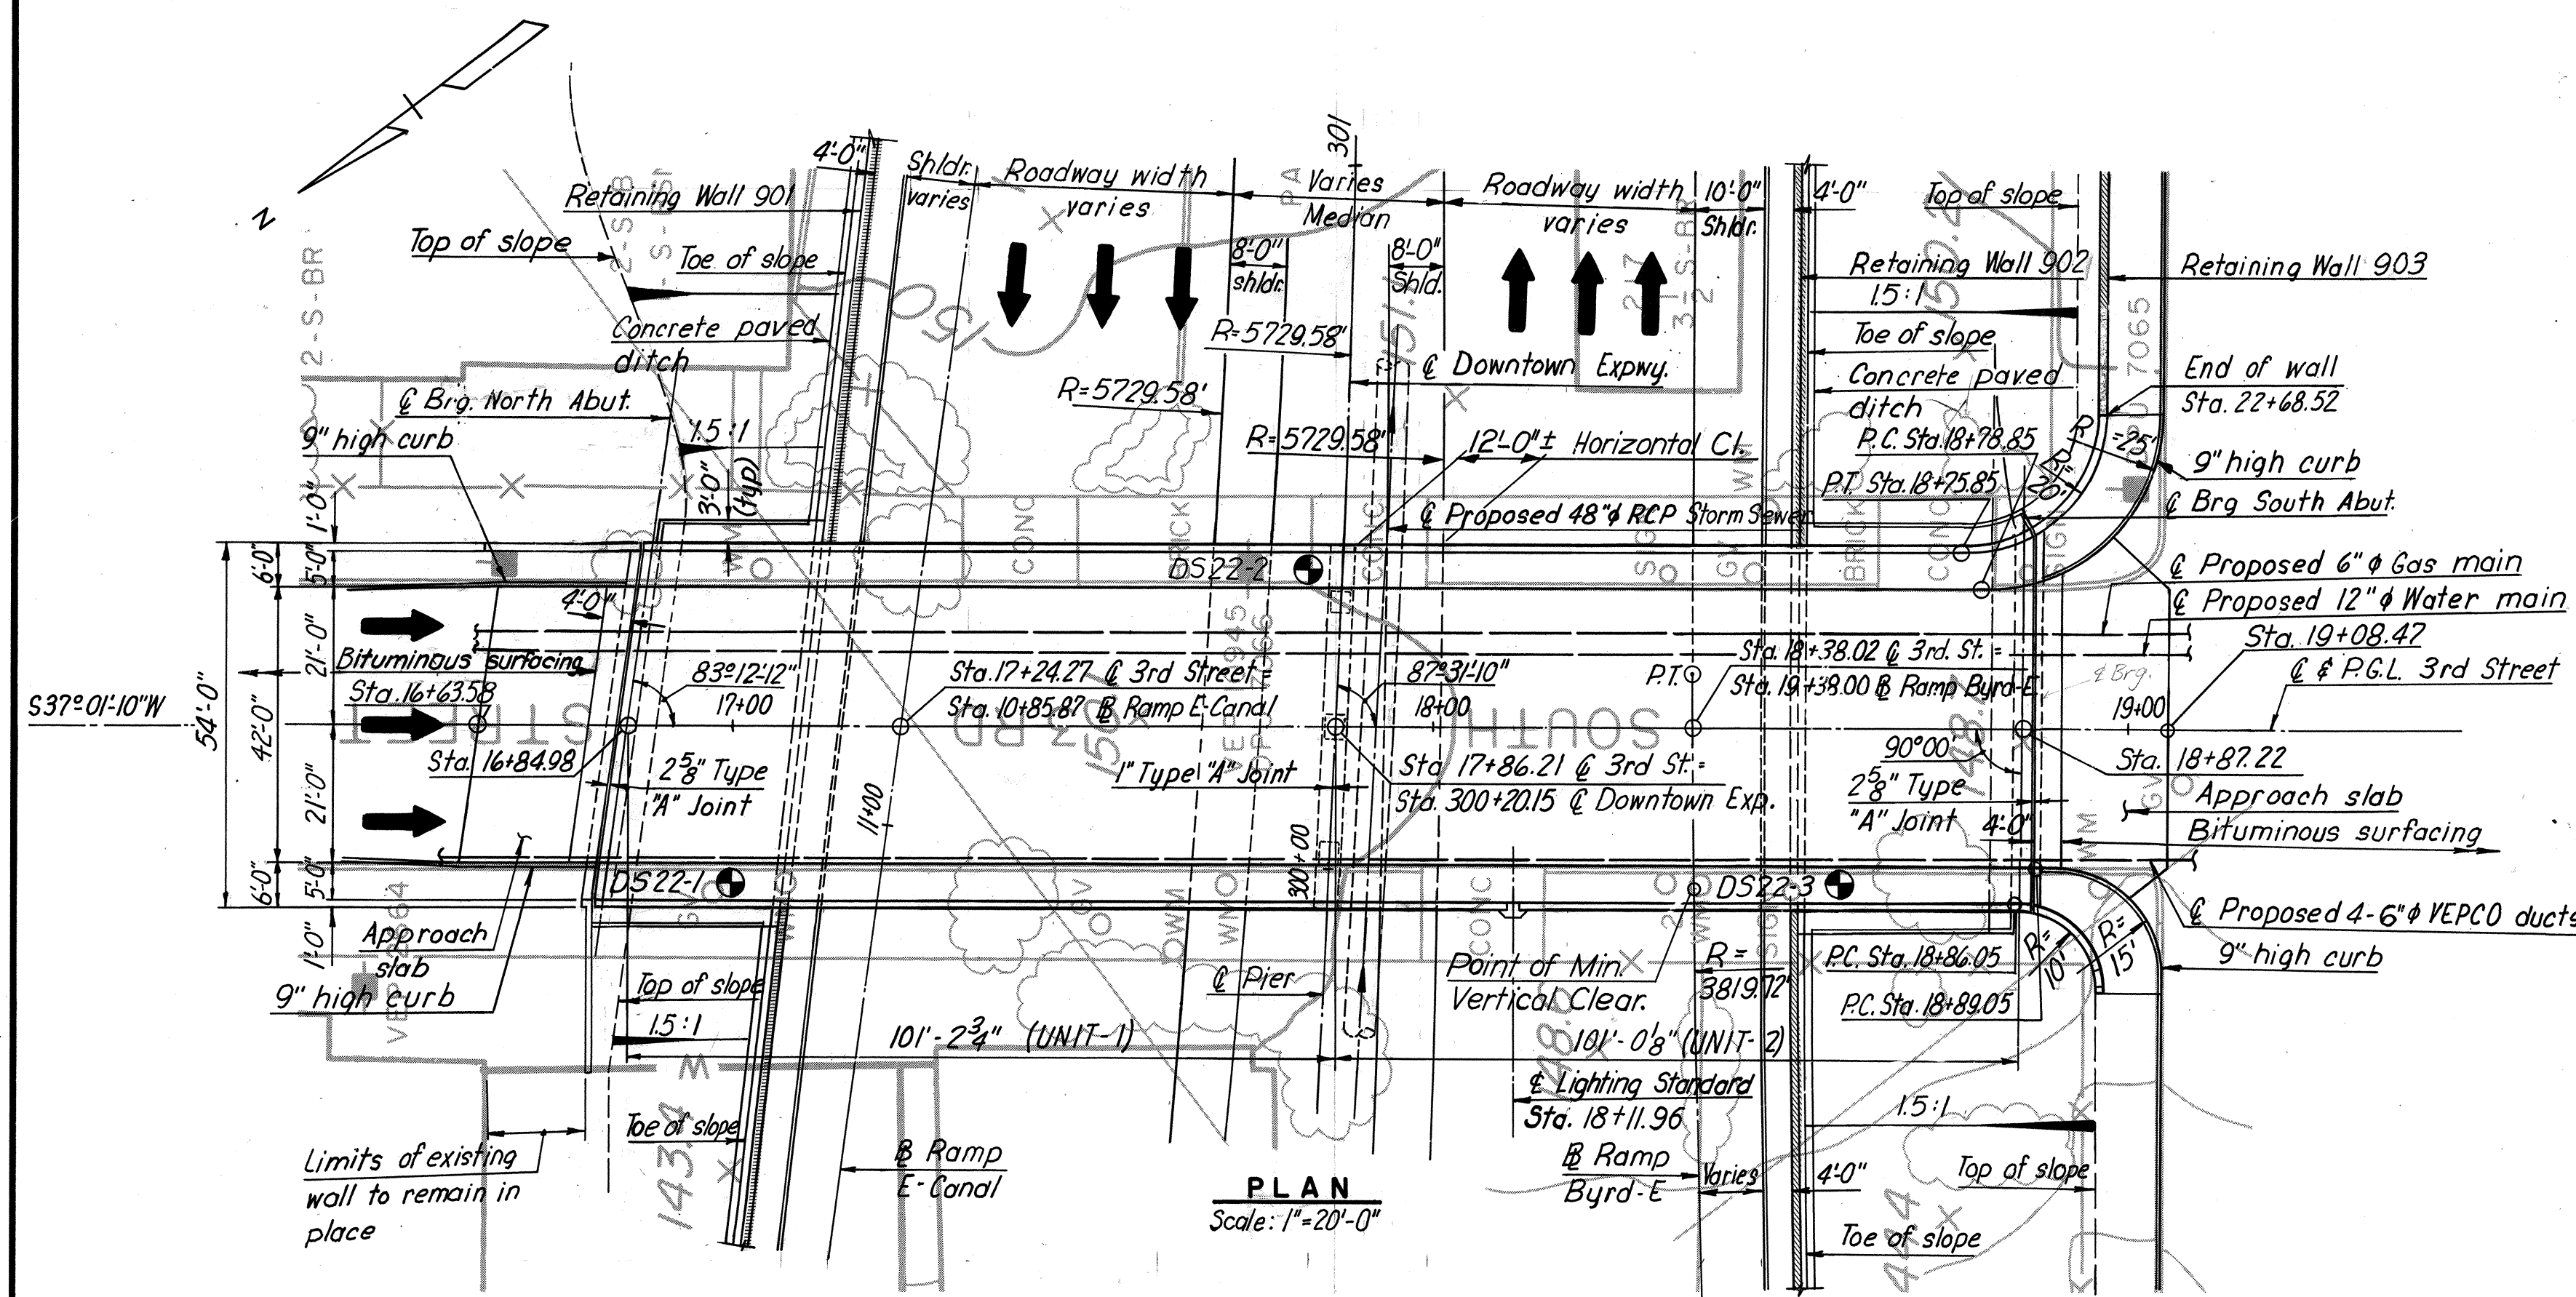


BORINGS:       Indicates location of 2 1/2" φ cased hole boring.  
For boring data, see Boring Logs sheet.

NOTE:              For General Notes and Quantities, see next sheet.


	BY	DATE					
MADE	TEM.	1-68	2	As Built	TEM	6-77	
CHECKED	A.B.P.	3-68	△	Ret. Wall Deleted	H.M.W.	4-15-77	
IN CHARGE	DRY		NO.	REVISION	BY	DATE	

AS BUILT



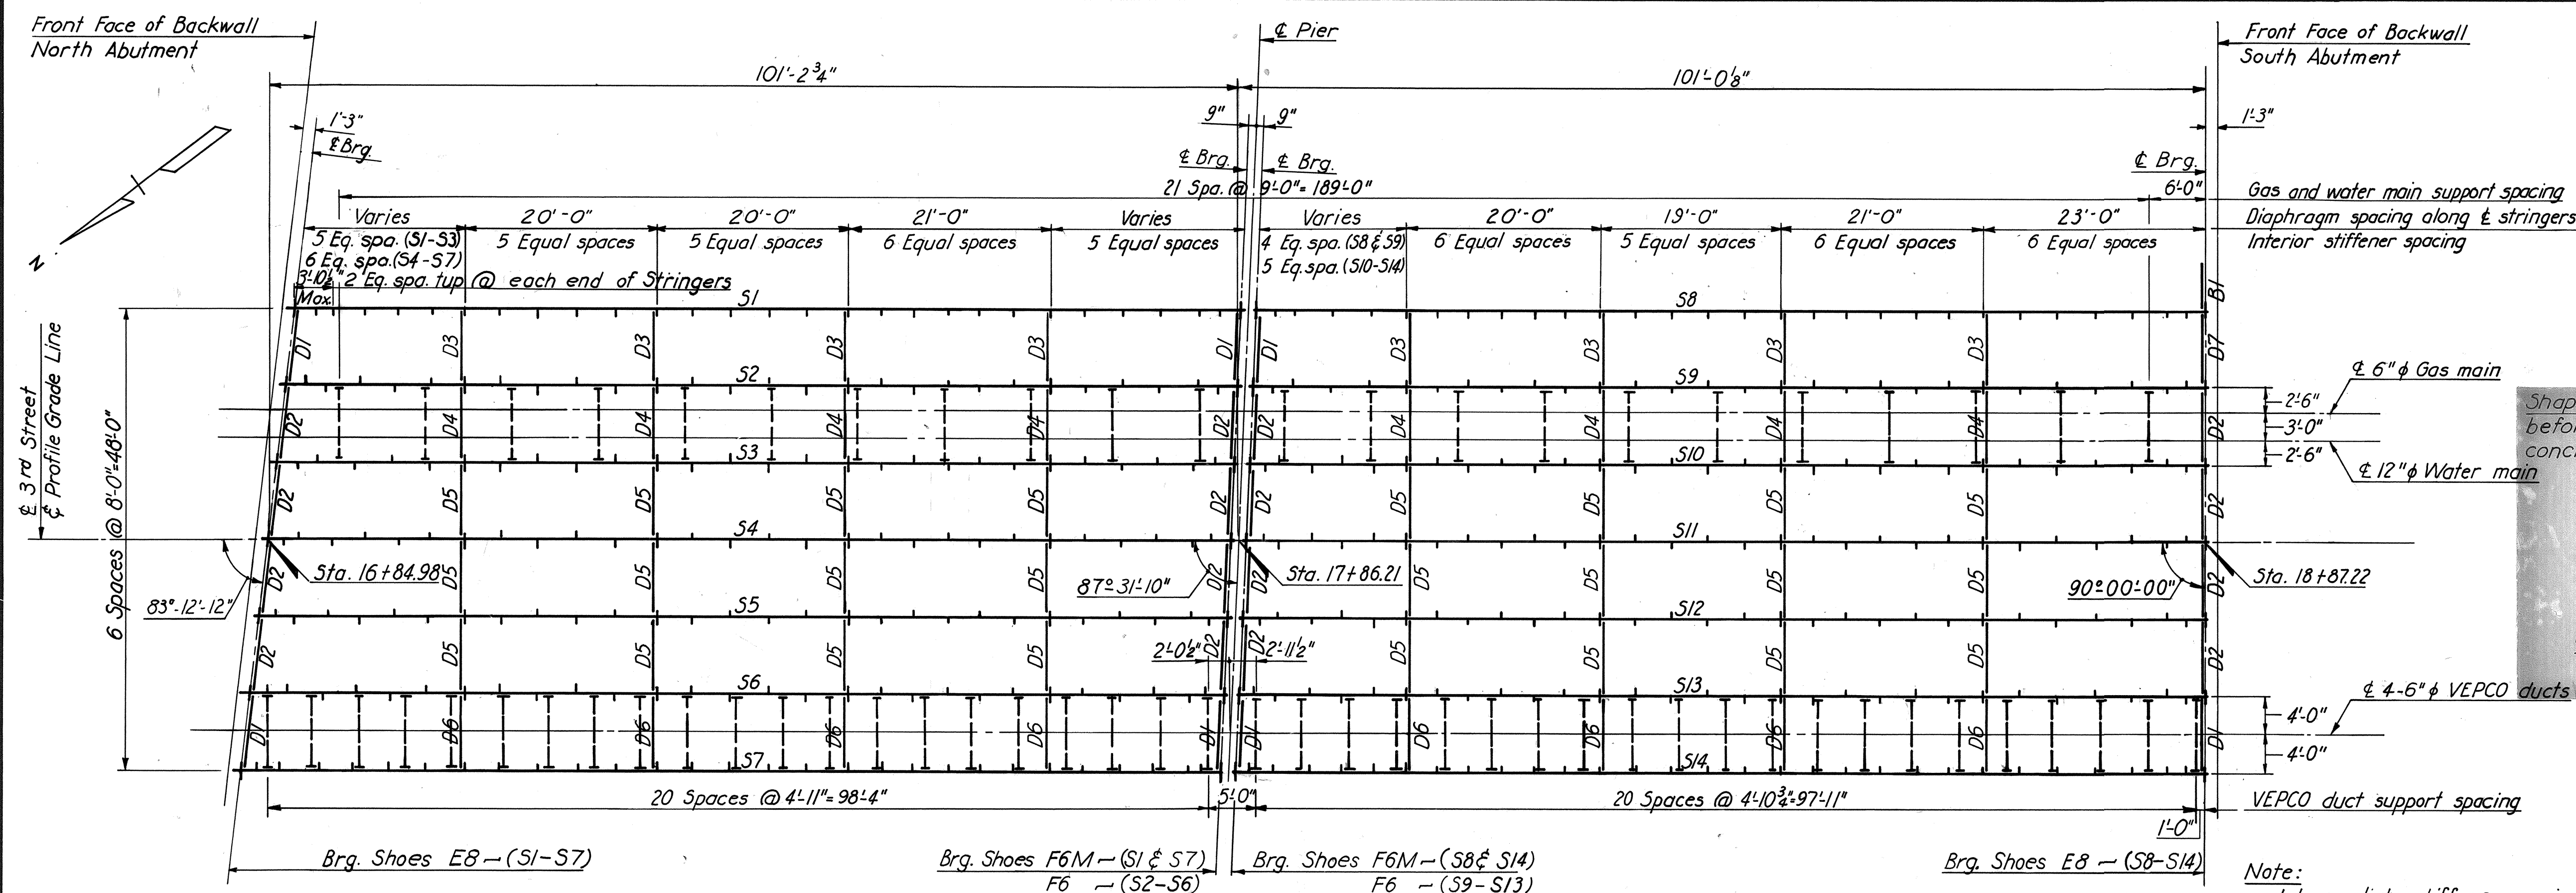

SHOE SCHEDULE			
EXPANSION SHOES		FIXED SHOES	
TYPE	NO. REQD.	TYPE	NO. REQ.
<i>E8</i>	<i>14</i>	<i>F6M</i>	<i>4</i>
		<i>F6</i>	<i>10</i>

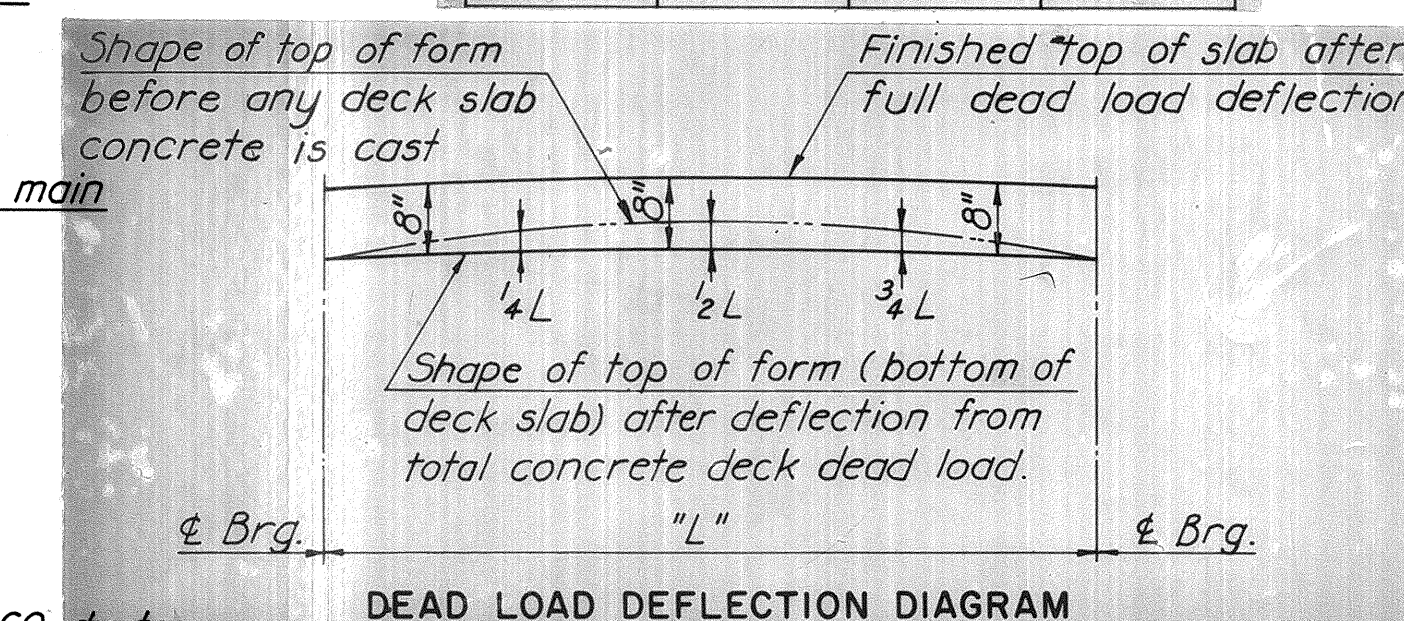


DEFLECTION SCHEDULE					
STR.	$\frac{1}{4}L$ & $\frac{3}{4}L$	$\frac{1}{2}L$	STR.	$\frac{1}{4}L$ & $\frac{3}{4}L$	$\frac{1}{2}L$
S/6, S6, S8			S2, S3, S9		
S/8, S12	1/2"	2 1/8"	S10, S13	1/2"	2
S14			S4, S5, S7	1/2"	2 1/2"

Note:  
Intermediate stiffener spacing  
along stringers may be varied to  
clear utility supports.

**NOTE TO CONTRACTOR:**

The above deflections are those anticipated to occur in the stringer upon placement of the total concrete deck dead load.

In practice, the stringers in place are not likely to have the exact camber to compensate for these deflections during construction. The residual amounts shall be provided for by adjusting forms to vary the thickness of the concrete bolts between the bottom of the slab and the top of stringer, without alteration of the slab thickness.

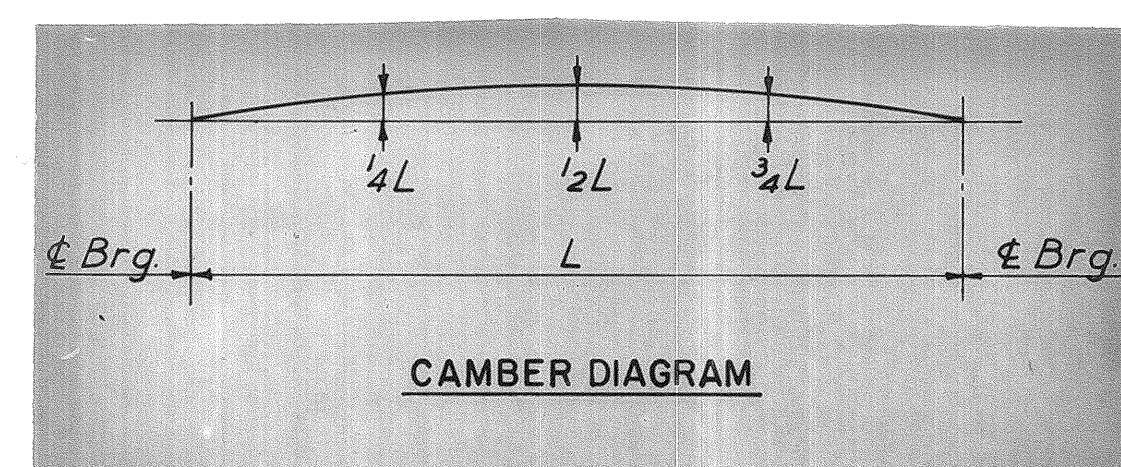


CAMBER SCHEDULE							
STR.	1/4 L	1/2 L	3/4 L	STR.	1/4 L	1/2 L	3/4 L
51-53				54, 55	2"	2 1/2"	2"
56	2"	2 1/2"	2"	57			
58-54							

NOTE TO FABRICATOR:



*The above stringers shall be fabricated with an upward camber amounting to the tabulated value.*

*This will provide approximate compensation for deflection under full dead load and for conformity with finished grade.*


*Dimensions are in inches.*

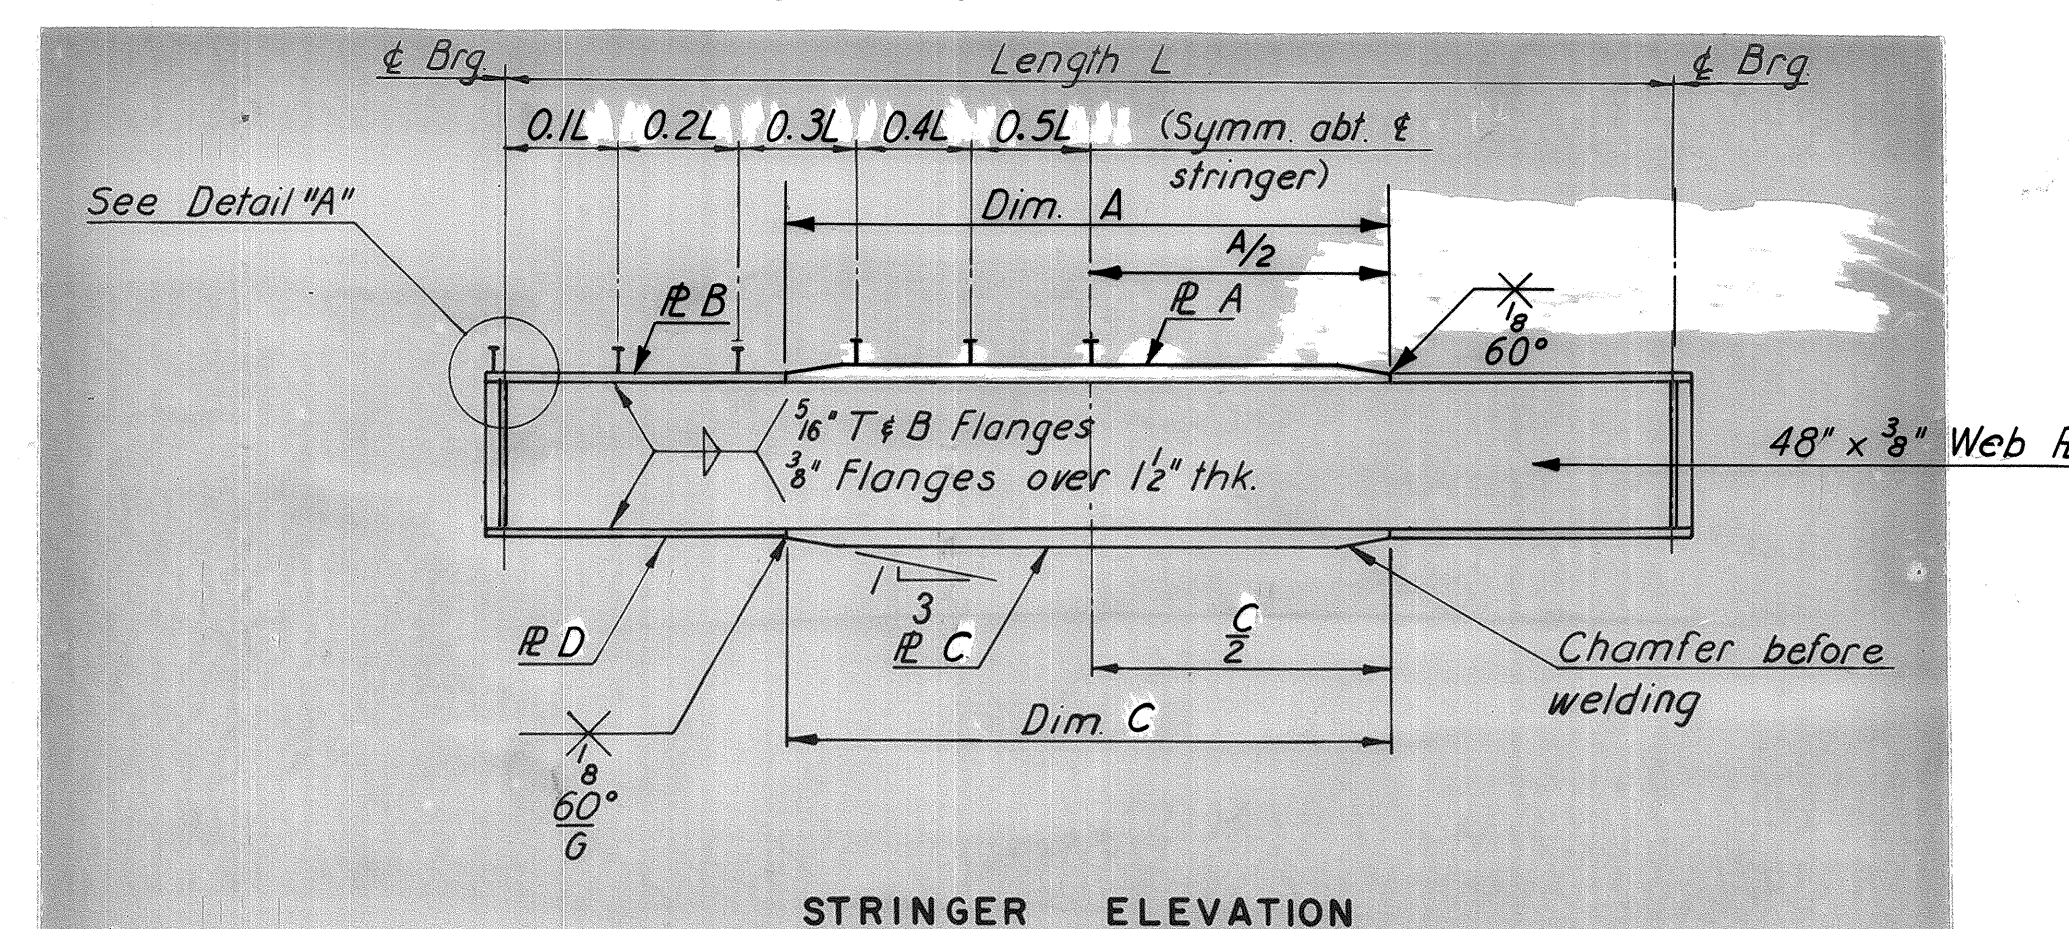

STRINGER SCHEDULE												
STR.	LENGTH £ BRG. TO £ BRG.	R A	DIM A	R B	R C	DIM C	R D	SHEAR STUD SPACING				
								0.1L	0.2L	0.3L	0.4L	0.5
S1	98'-7 $\frac{1}{2}$ "	16 x 1/4	53'-0"	16 x 7/8	20 x 1/8	63'-0"	20 x 1/4	9"	10 $\frac{1}{2}$ "	13 $\frac{1}{2}$ "	18"	21"
S2	99'-3 $\frac{3}{8}$ "	16 x 1/8	57'-0"	↑	↑	64'-0"	↑	10"	11 $\frac{1}{2}$ "	14"	18"	20"
S3	99'-10 $\frac{1}{2}$ "	16 x 1/8	57'-0"	↓	↓	↑	↓	↑	↑	↑	18"	20"
S4	100'-5 $\frac{3}{8}$ "	16 x 1/4	53'-0"	↓	↓	↓	↓	↓	↓	↓	17 $\frac{1}{2}$ "	19"
S5	101'-1 $\frac{1}{16}$ "	16 x 1/4	53'-0"	↓	20 x 1/8	64'-0"	20 x 1/4	↓	↓	↓	17 $\frac{1}{2}$ "	19"
S6	101'-8 $\frac{5}{8}$ "	16 x 1/8	59'-0"	16 x 7/8	20 x 2	62'-0"	20 x 1/8	10"	11 $\frac{1}{2}$ "	14"	17 $\frac{1}{2}$ "	20"
S7	102'-3 $\frac{5}{8}$ "	16 x 1/2	57'-0"	16 x 1	20 x 2 $\frac{1}{8}$	66'-0"	20 x 1/8	9"	10 $\frac{1}{2}$ "	13 $\frac{1}{2}$ "	18 $\frac{1}{2}$ "	22"
S8	99'-2 $\frac{5}{8}$ "	16 x 1/4	53'-0"	16 x 7/8	20 x 1/8	63'-0"	20 x 1/4	9"	10 $\frac{1}{2}$ "	13 $\frac{1}{2}$ "	18"	21"
S9	99'-6 $\frac{1}{8}$ "	16 x 1/8	57'-0"	↑	↑	64'-0"	↑	10"	11 $\frac{1}{2}$ "	14"	18"	20"
S10	99'-10 $\frac{1}{16}$ "	16 x 1/8	57'-0"	↓	↓	64'-0"	↓	↑	↑	↑	18"	20"
S11	100'-3 $\frac{1}{8}$ "	16 x 1/4	52'-0"	↓	↓	63'-0"	↓	↓	↓	↓	17 $\frac{1}{2}$ "	19"
S12	100'-7 $\frac{1}{4}$ "	16 x 1/4	52'-0"	↓	20 x 1/8	63'-0"	20 x 1/4	↓	↓	14"	17 $\frac{1}{2}$ "	19"
S13	100'-11 $\frac{1}{16}$ "	16 x 1/8	58'-0"	16 x 7/8	20 x 2	61'-0"	20 x 1/8	10"	11 $\frac{1}{2}$ "	13 $\frac{1}{2}$ "	18"	20"
S14	101'-3 $\frac{3}{8}$ "	16 x 1/2	55'-0"	16 x 1	20 x 2 $\frac{1}{8}$	65'-0"	20 x 1/8	9"	11"	13 $\frac{1}{2}$ "	18 $\frac{1}{2}$ "	22"

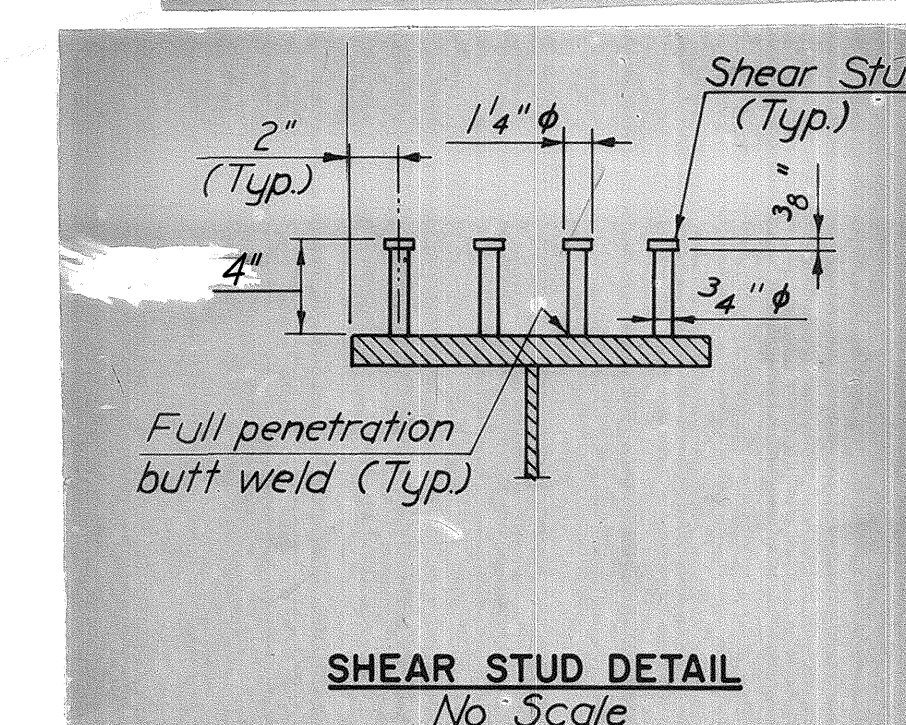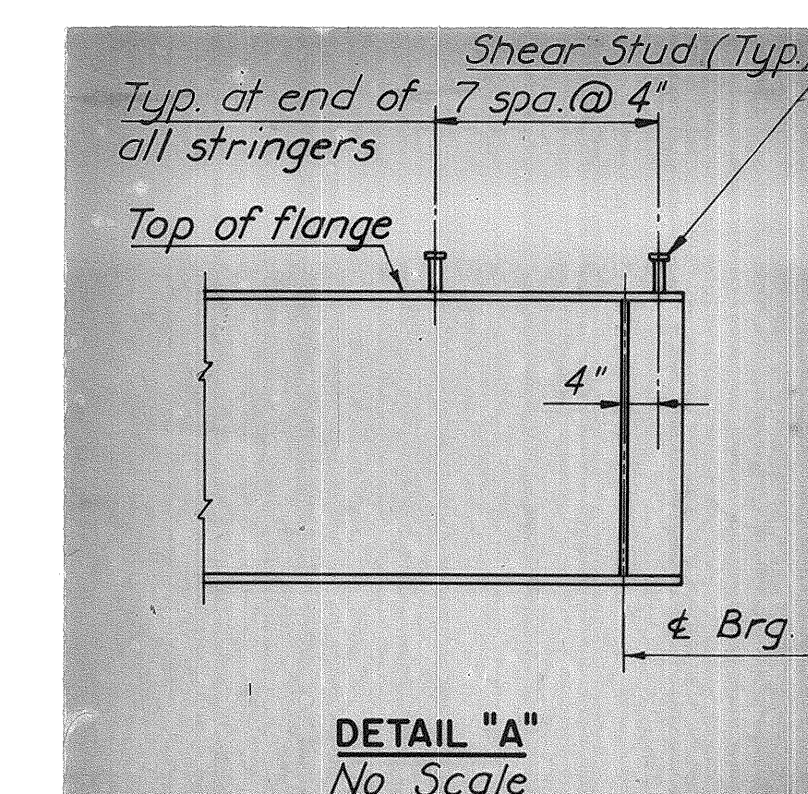

**SHEAR STUD NOTE:**  
Capacity = 3,400 lbs. per stud.  
The contractor may, if he elects, use three  $\frac{3}{4}$ " diameter studs at the same longitudinal spacing in lieu of the four  $\frac{3}{4}$ " diameter studs shown.  
Stud rows shall be placed parallel to the main reinforcement.  
Shear stud spacing shown is maximum spacing.

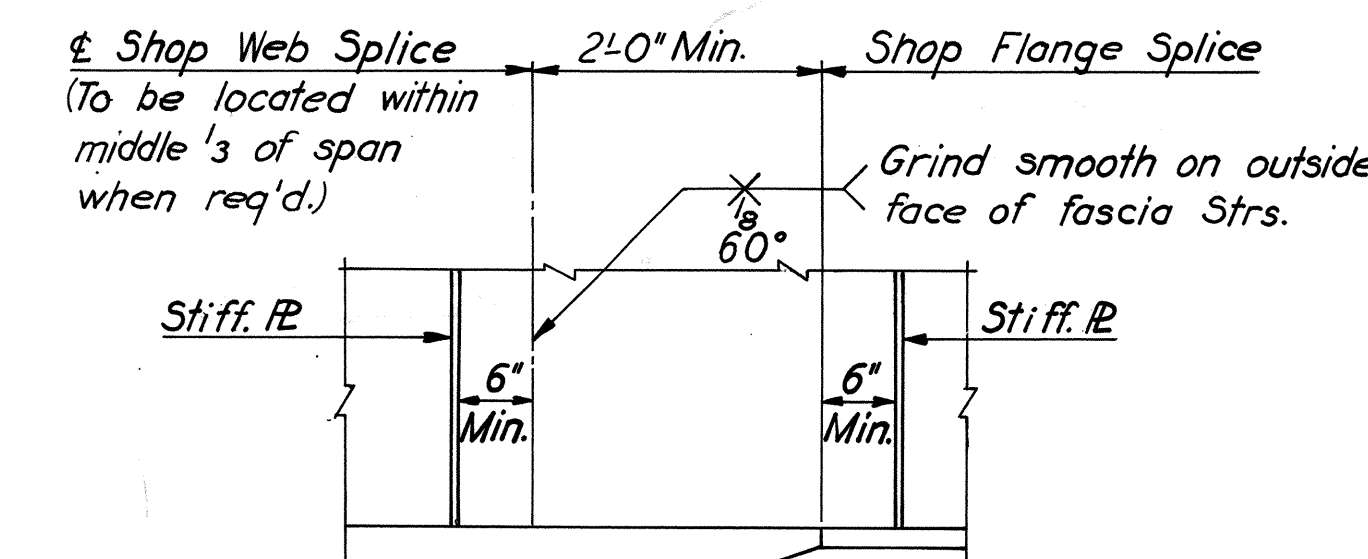

**SHOP SPLICE DETAILS**  
Scale: 3/4" = 1'-0"

	BY	DATE					
MADE	EVR	12-14					
CHECKED	T.E.M.	2-68	1	As Built	TEM	6-77	
IN CHARGE	PRV		NO.	REVISION	BY	DATE	

**RICHMOND METROPOLITAN AUTHORITY**  
**RICHMOND EXPRESSWAY SYSTEM**  
**DOWNTOWN EXPRESSWAY**

**BRIDGE B-55**  
**3<sup>RD</sup> STREET OVER**  
**DOWNTOWN EXPRESSWAY**

**FRAMING PLAN**

HOWARD, NEEDLES, TAMMEN & BERGENDOFF consulting engineers NEW YORK      ALEXANDRIA      KANSAS CITY	SCALE: AS SHOWN CONTRACT NO.: 9 SHEET NO. 11 OF 16
---	--



## AS BUILT








RICHMOND EXPRESSWAY SYSTEM			
SECTION	PROJECT	SHEET NO.	TOTAL SHEETS
9	DOWNTOWN EXPRESSWAY	151	

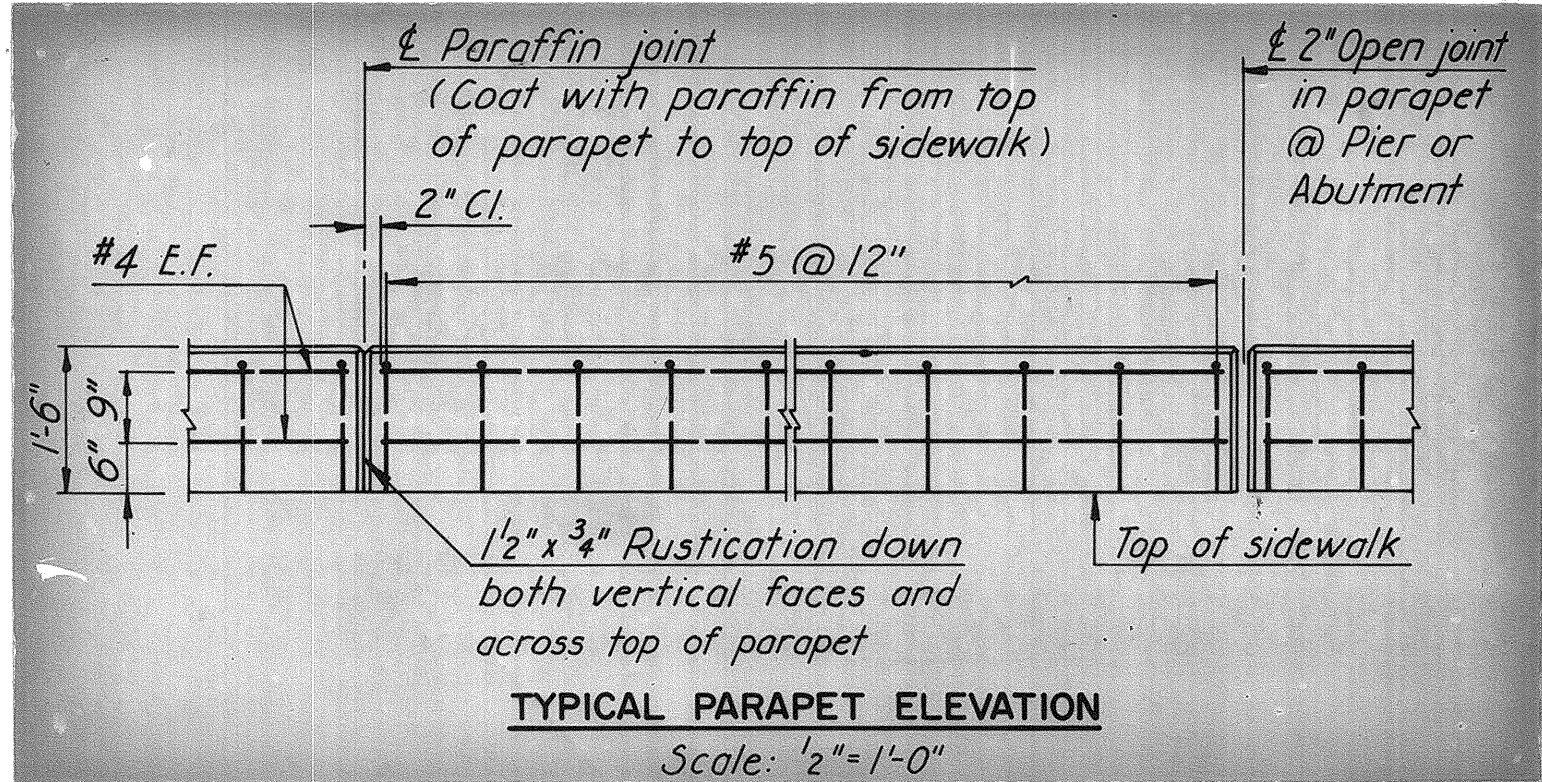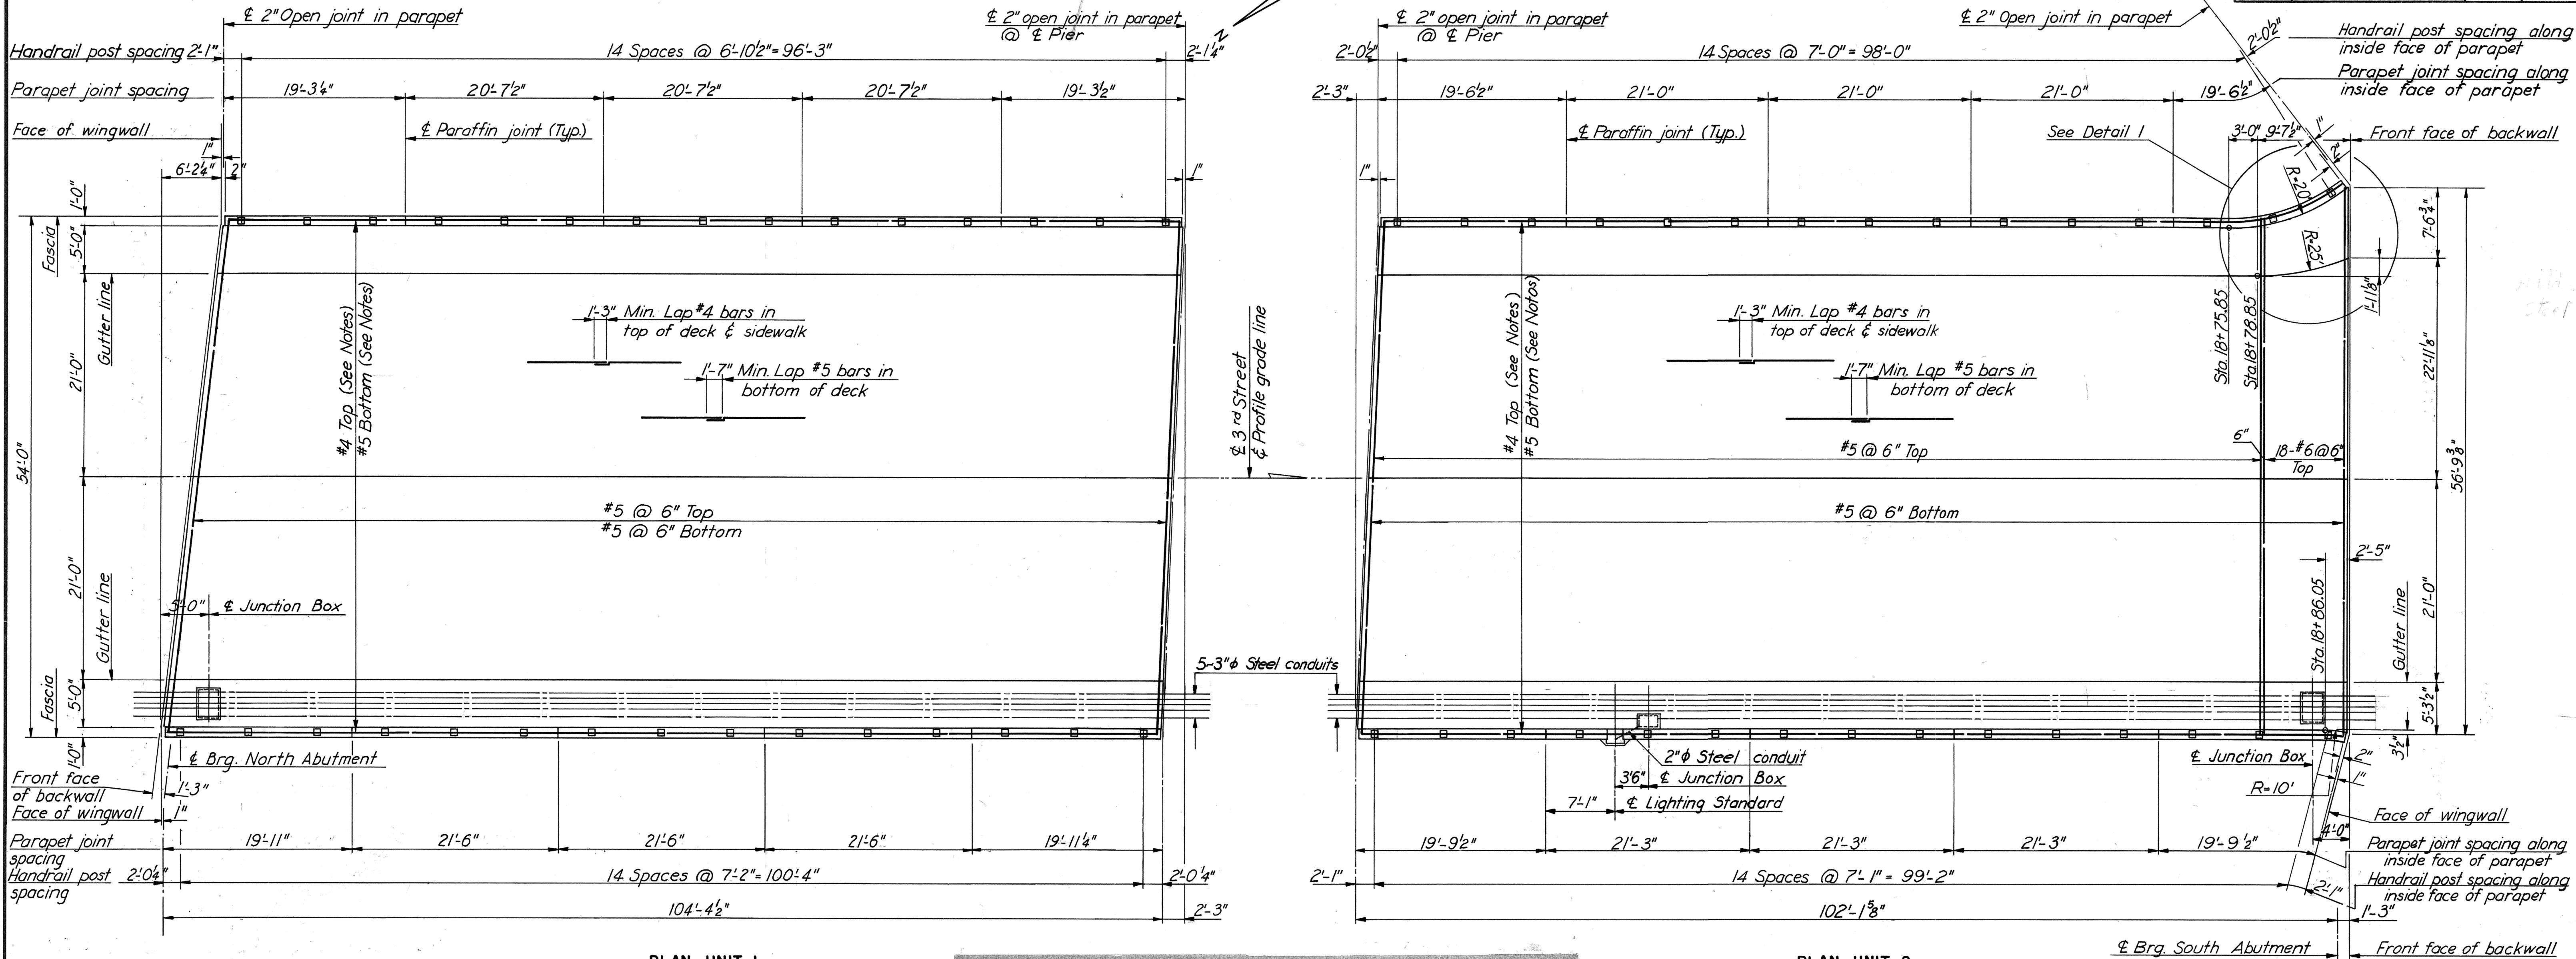

PAVEMENT ELEVATIONS						
STATION	ELEV. A	E. B P.G.L.	ELEV. B	STATION	ELEV. A	E. B P.G.L.
16+60	—	152.05*	151.72*	+85.30	—	150.47
+70	151.62*	151.95*	151.62*	+86.21	—	150.79
+80	151.52*	151.85	151.52	+87.12	150.45	—
+81.23	—	—	151.51	+90	150.42	150.75
+83.72	—	151.81	—	+90.00	150.32	150.65
+86.23	151.46	—	—	+10	150.22	150.55
+90	151.42	151.75	151.42	+20	150.12	150.45
+10	151.32	151.65	151.32	+30	150.02	150.35
+20	151.22	151.55	151.22	+40	149.92	150.25
+30	151.12	151.45	151.12	+50	149.82	150.15
+40	151.02	151.35	151.02	+60	149.72	150.05
+50	150.92	151.25	150.92	+70	149.62	149.95
+60	150.82	151.15	150.82	+80	149.51	149.85
+70	150.72	151.05	150.72	+88.47	149.42	149.77
+80	150.62	150.95	150.62	+90	149.40	149.75
+80	150.52	150.85	150.52	+108.47	149.27*	149.65*
					149.57*	—

\* Elevations shown are given at top of bituminous surfacing.

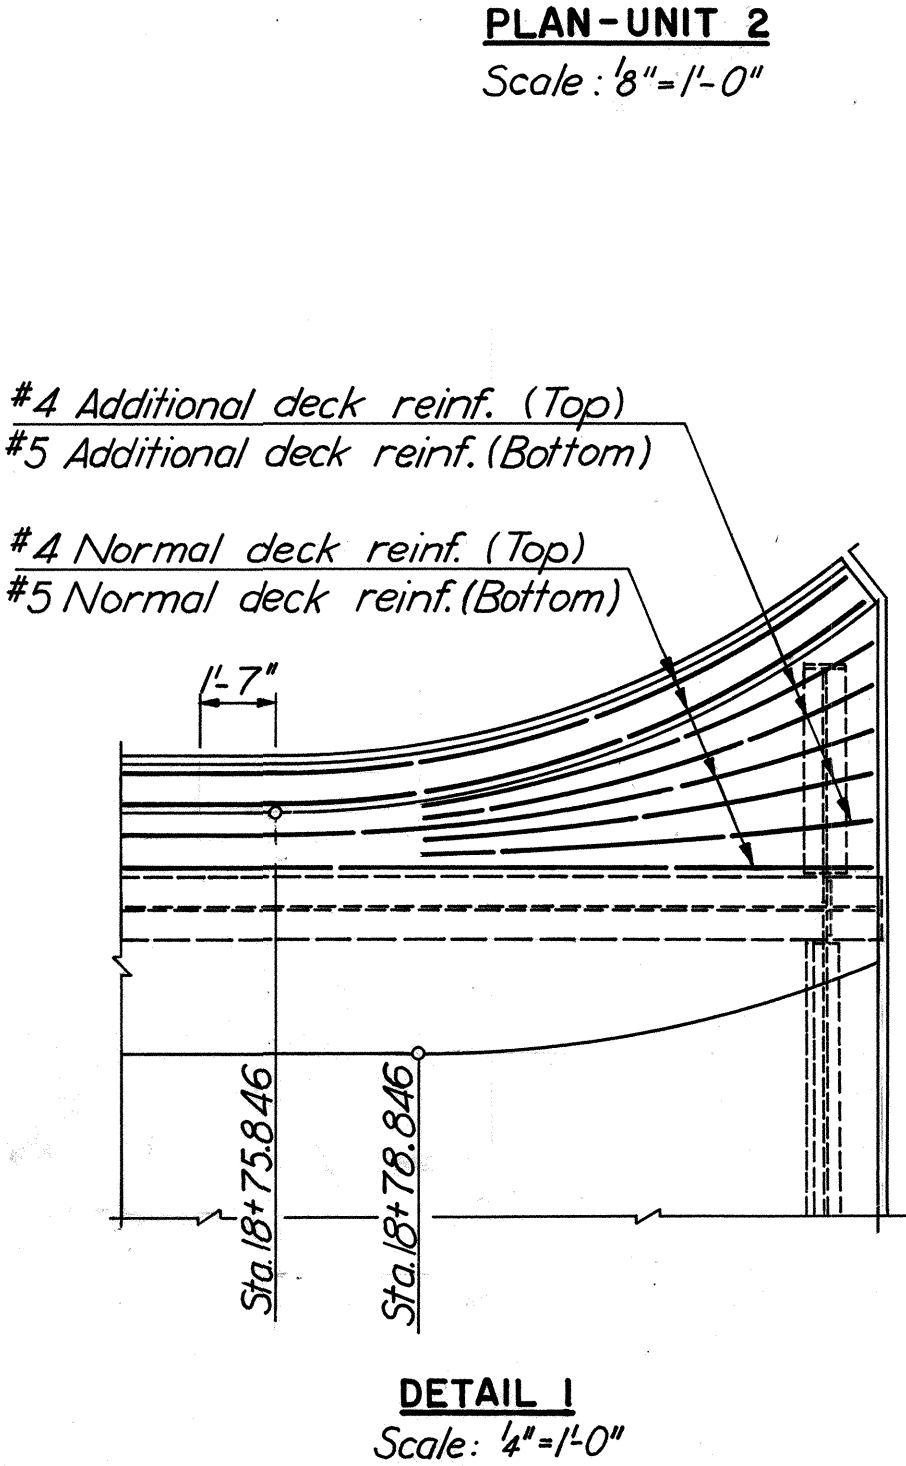

**NOTES:**

- For location and spacing of deck, parapet and sidewalk reinforcing, see Cross Section and Utility Details sheet.
- For location and spacing of reinforcing in haunch over end diaphragms, see Joint Details sheet.
- For lighting standard base, junction box details and additional reinforcing, see Standard Electrical Details sheet 34.

BY	DATE				
MADE	J.B.M.	9-67			
CHECKED	T.E.M.	2-68	1	As Built	TEM 6-77
IN CHARGE	P.R.Y.		NO.	REVISION	BY

RICHMOND METROPOLITAN AUTHORITY			
RICHMOND EXPRESSWAY SYSTEM			
DOWNTOWN EXPRESSWAY			
BRIDGE B-55			
3RD STREET OVER			
DOWNTOWN EXPRESSWAY			
DECK PLANS			
HOWARD, NEEDLES, TAMMEN & BERGENDOFF		SCALE: AS SHOWN	
consulting engineers		CONTRACT NO. 9	
NEW YORK ALEXANDRIA KANSAS CITY		SHEET NO. 13 OF 16	


AS BUILT












RICHMOND EXPRESSWAY SYSTEM			
SECTION	PROJECT	SHEET NO.	TOTAL SHEETS
9	DOWNTOWN EXPRESSWAY	153	

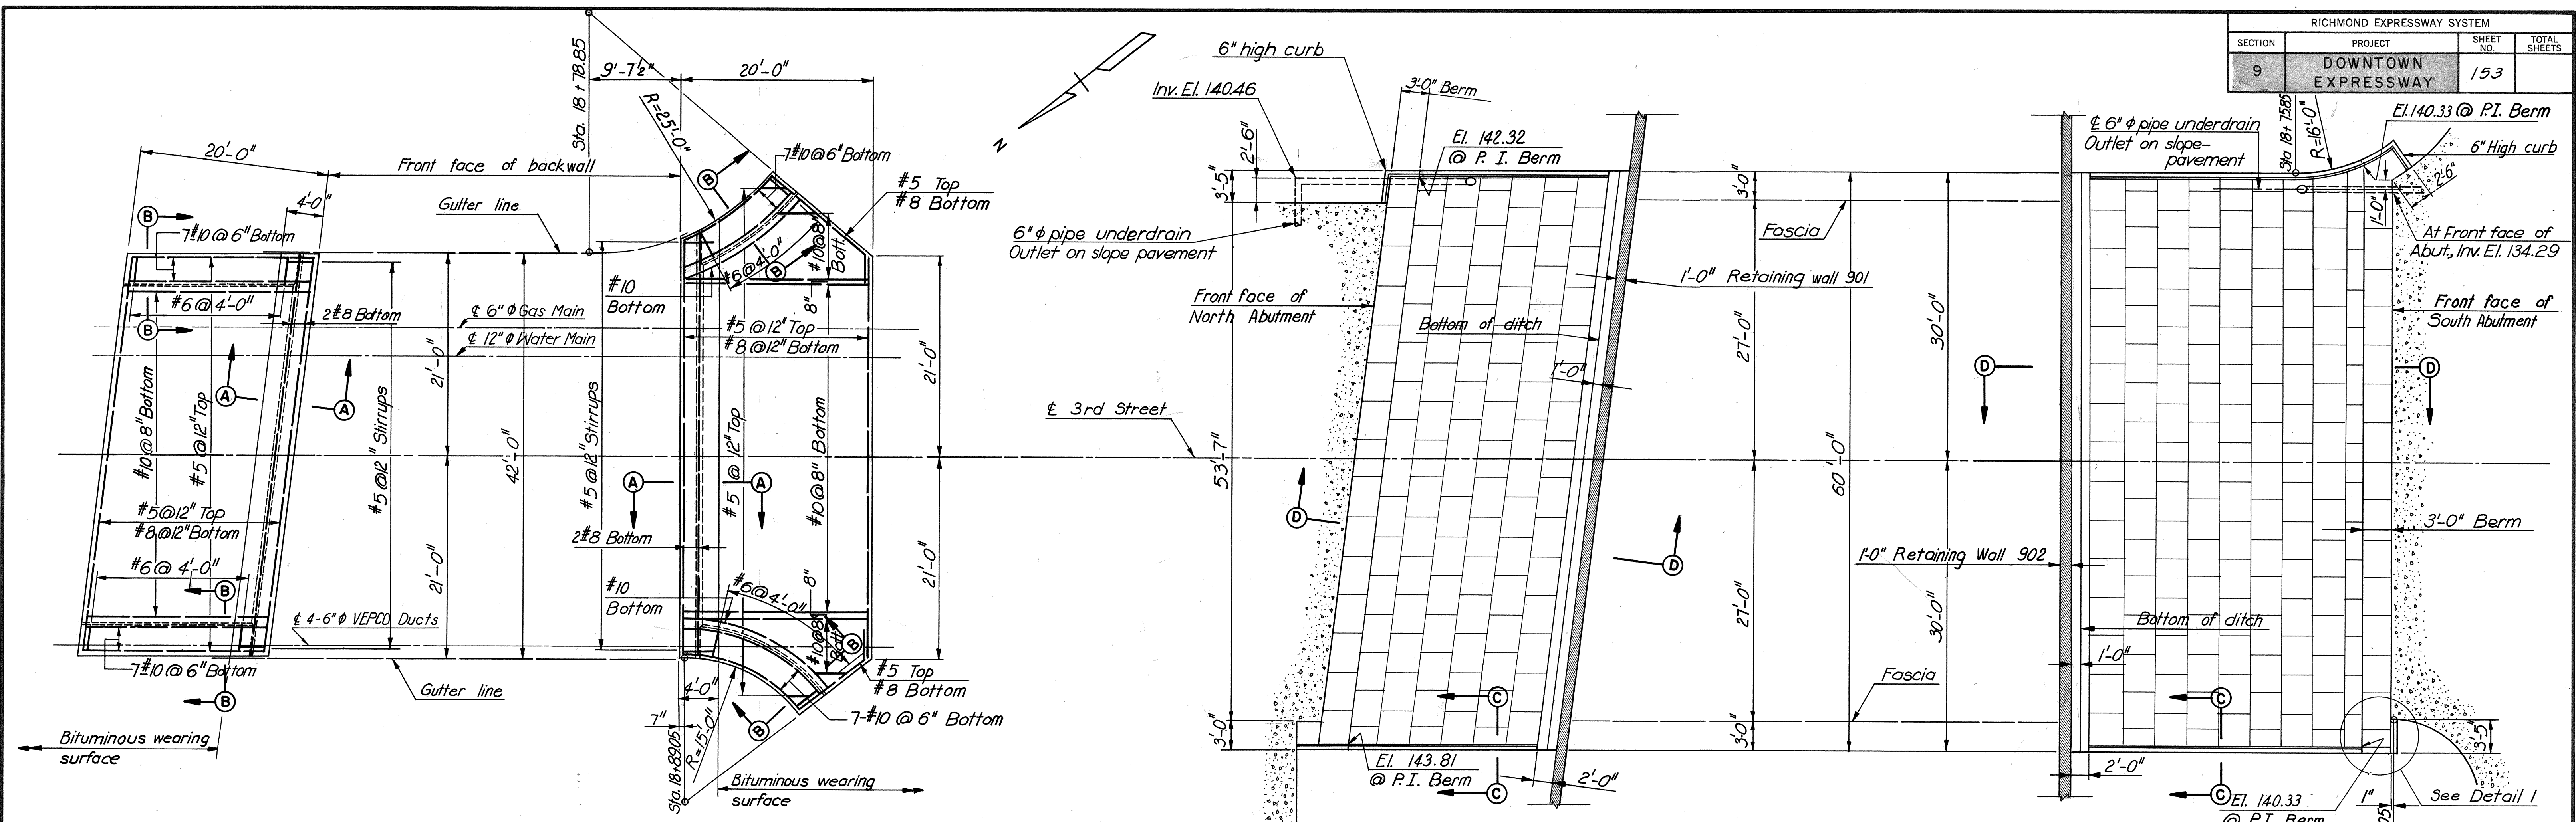

**NORTH APPROACH SLAB**  
Scale: 1/8" = 1'-0"

**SOUTH APPROACH SLAB**  
Scale: 1/8" = 1'-0"


**PLAN OF SLOPE PROTECTION**  
Scale: 1/8" = 1'-0"

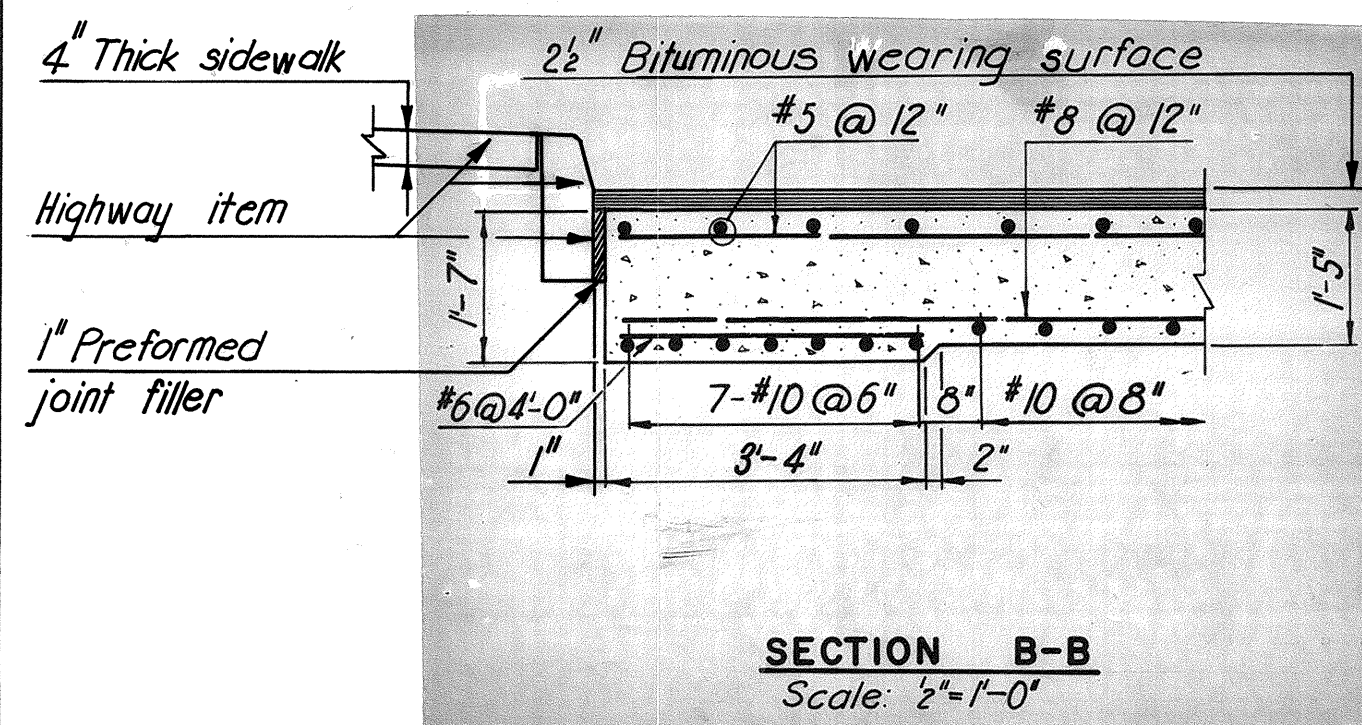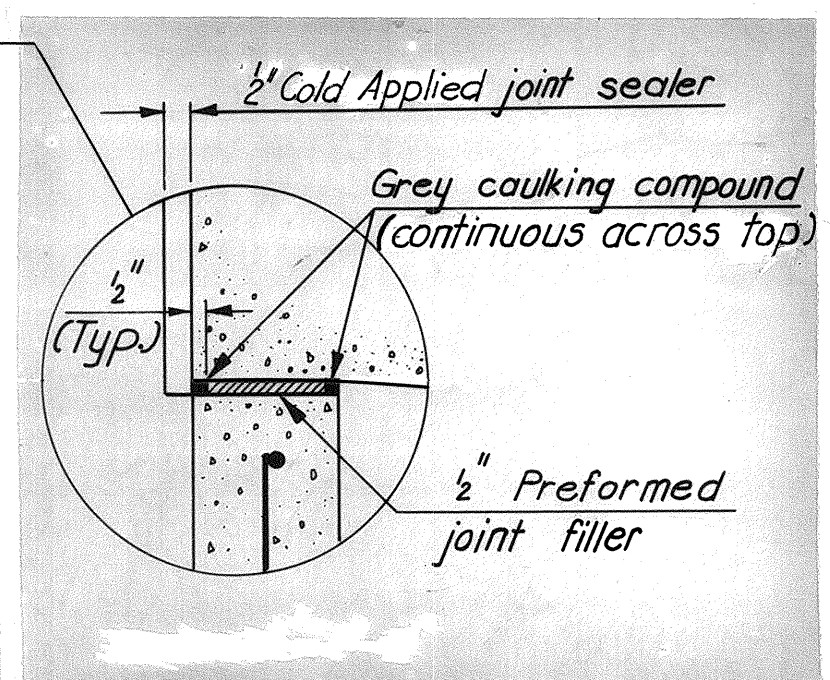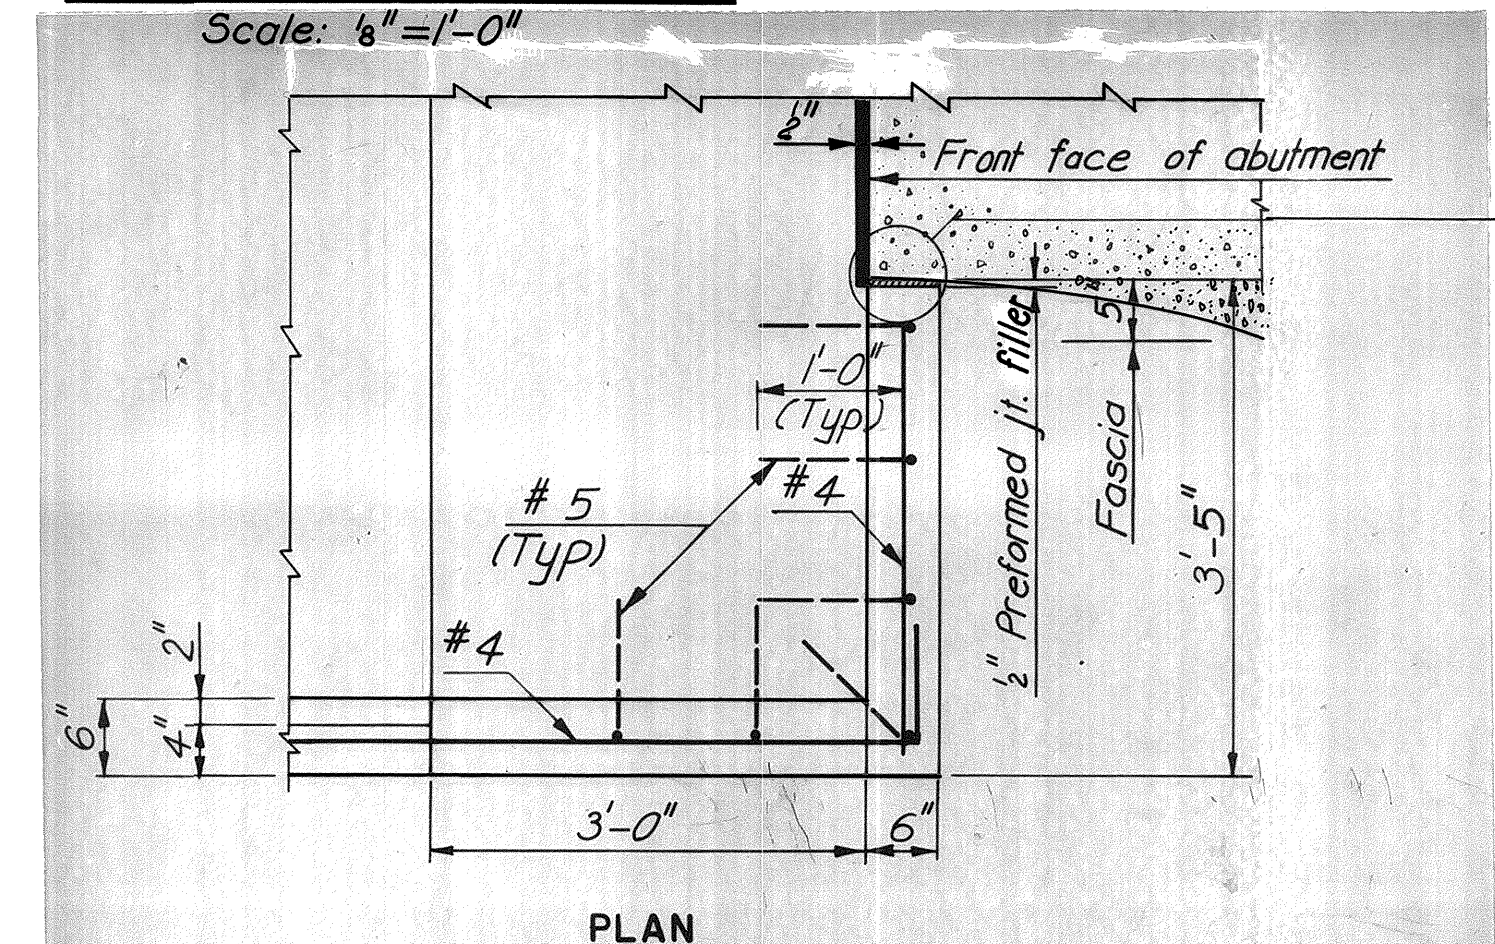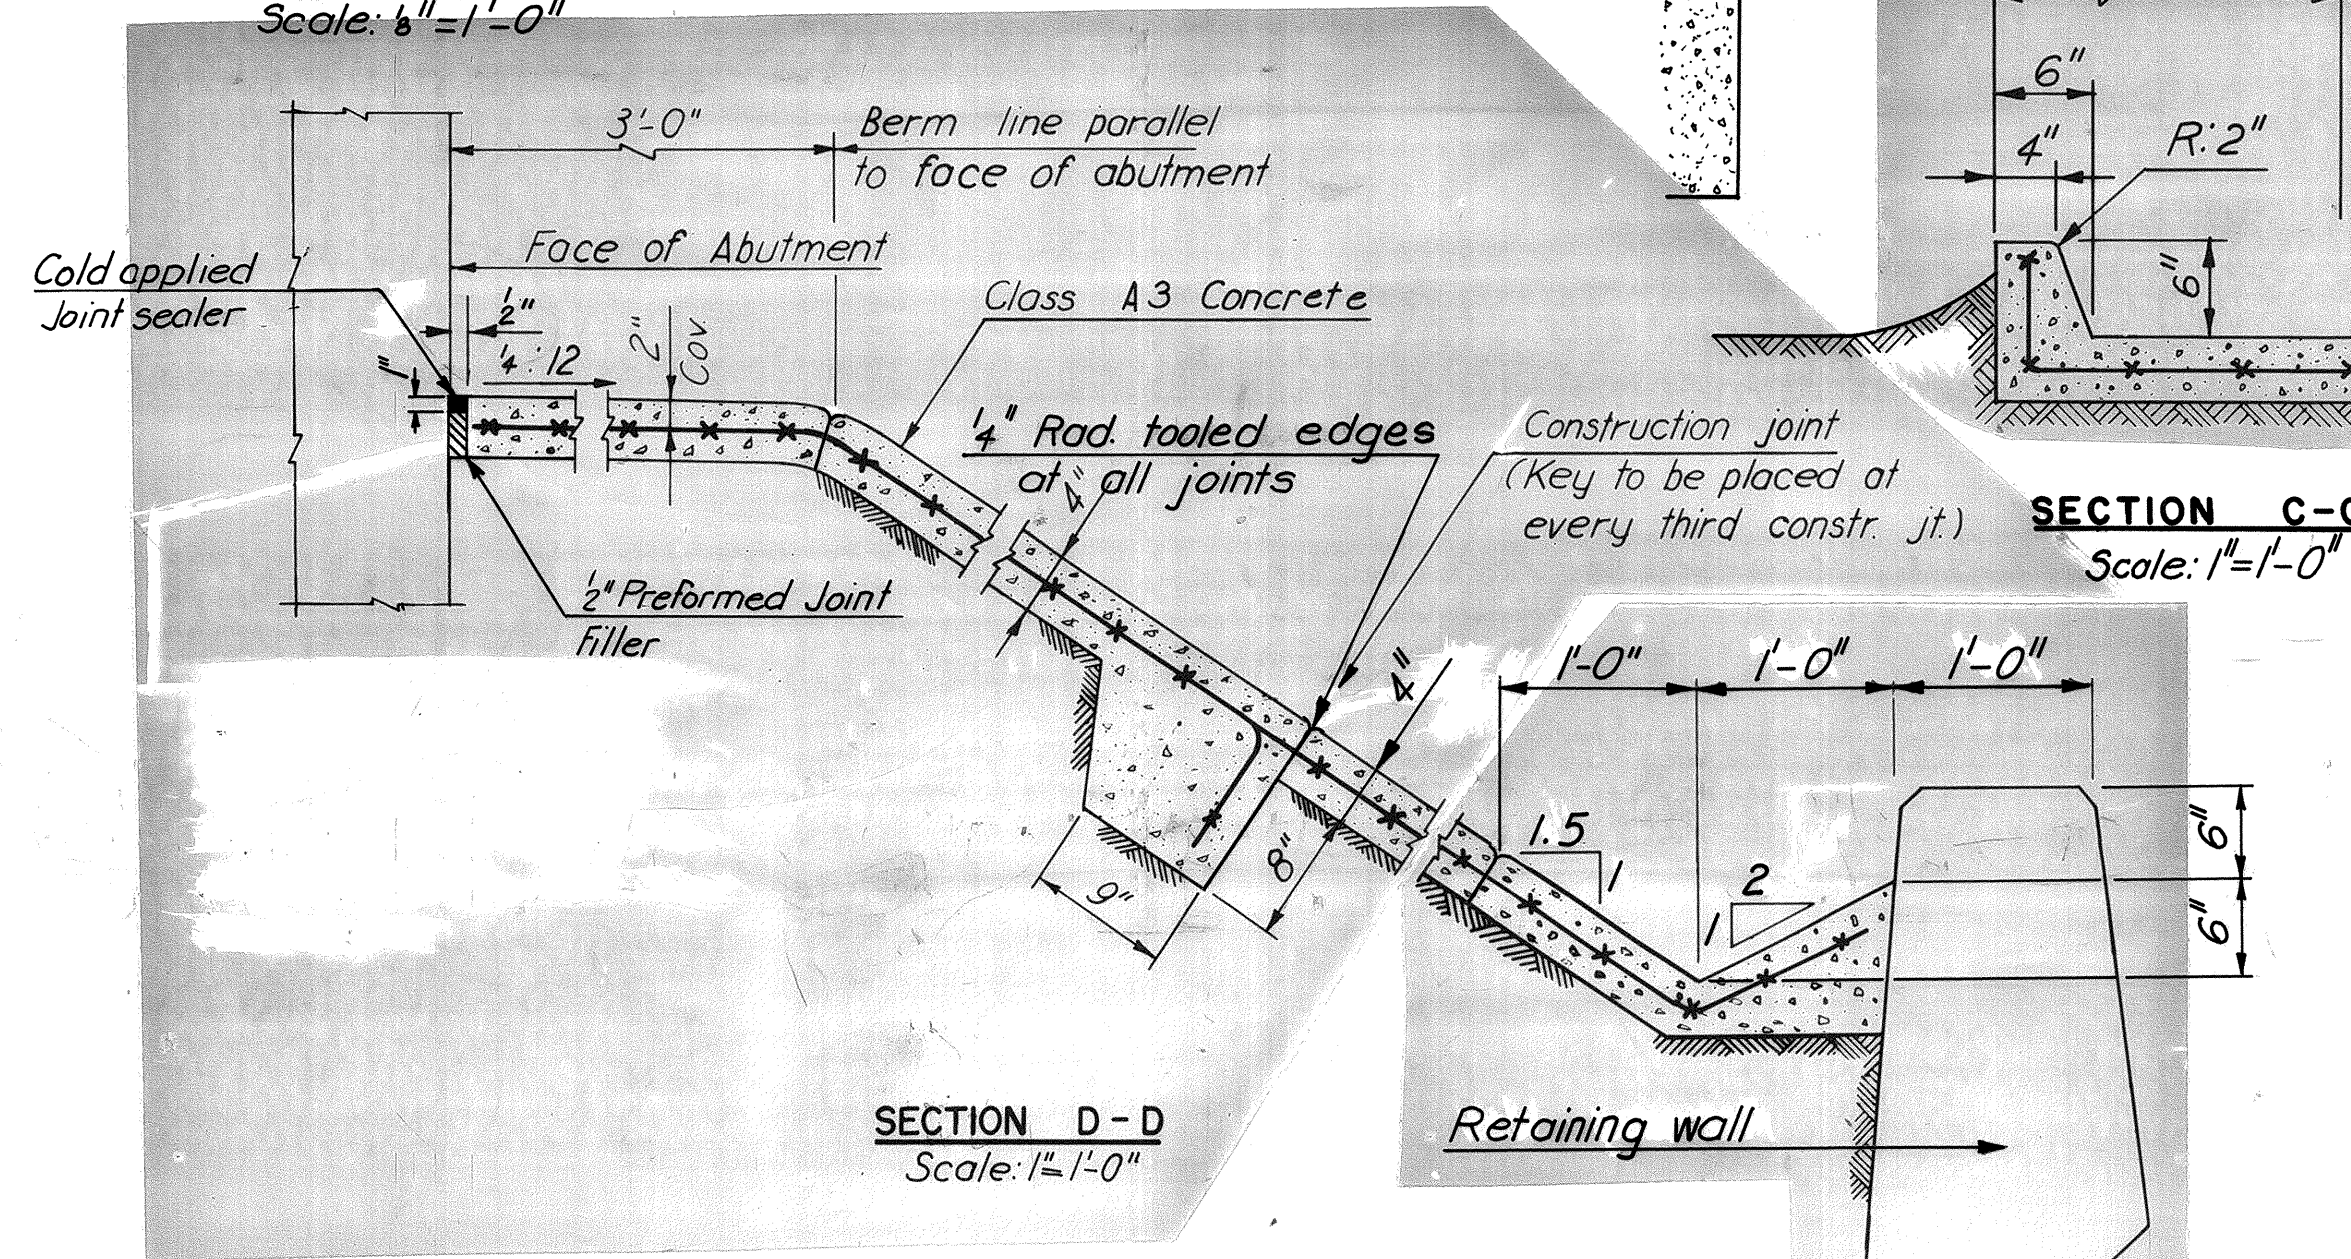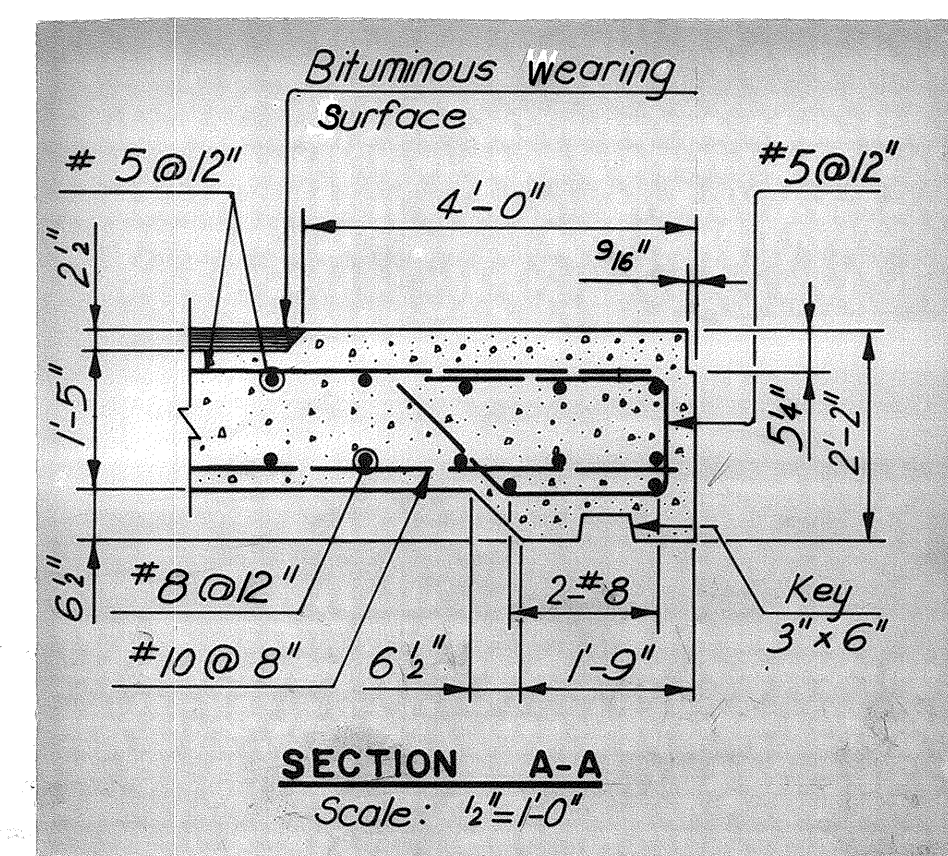

**SLOPE PROTECTION NOTE:**

The item "Cast-in-Place Concrete Slab Slope Protection" shall include the excavation of, or the placing and compaction of any embankment material necessary to bring the surface of the paved slopes to the finished elevations shown on the plans. "Cast-in-Place Concrete Slab Slope Protection" shall be paid for at the contract unit price per square yard, which price shall include the concrete slab including wire mesh and joint filler.

The slab shall be constructed in 4'-0" x 4'-0" panels, placed in horizontal courses, alternate panels being poured in a staggered pattern with adjacent panels poured later. The slab shall be Class A3 concrete of such consistency that it can be placed without the use of top forms. The surface shall be finished with a wood float. Reinforcing shall consist of wire mesh No. 6 gage, 6" c.c., each way, placed at the center of the slab, and continuous through construction joints.

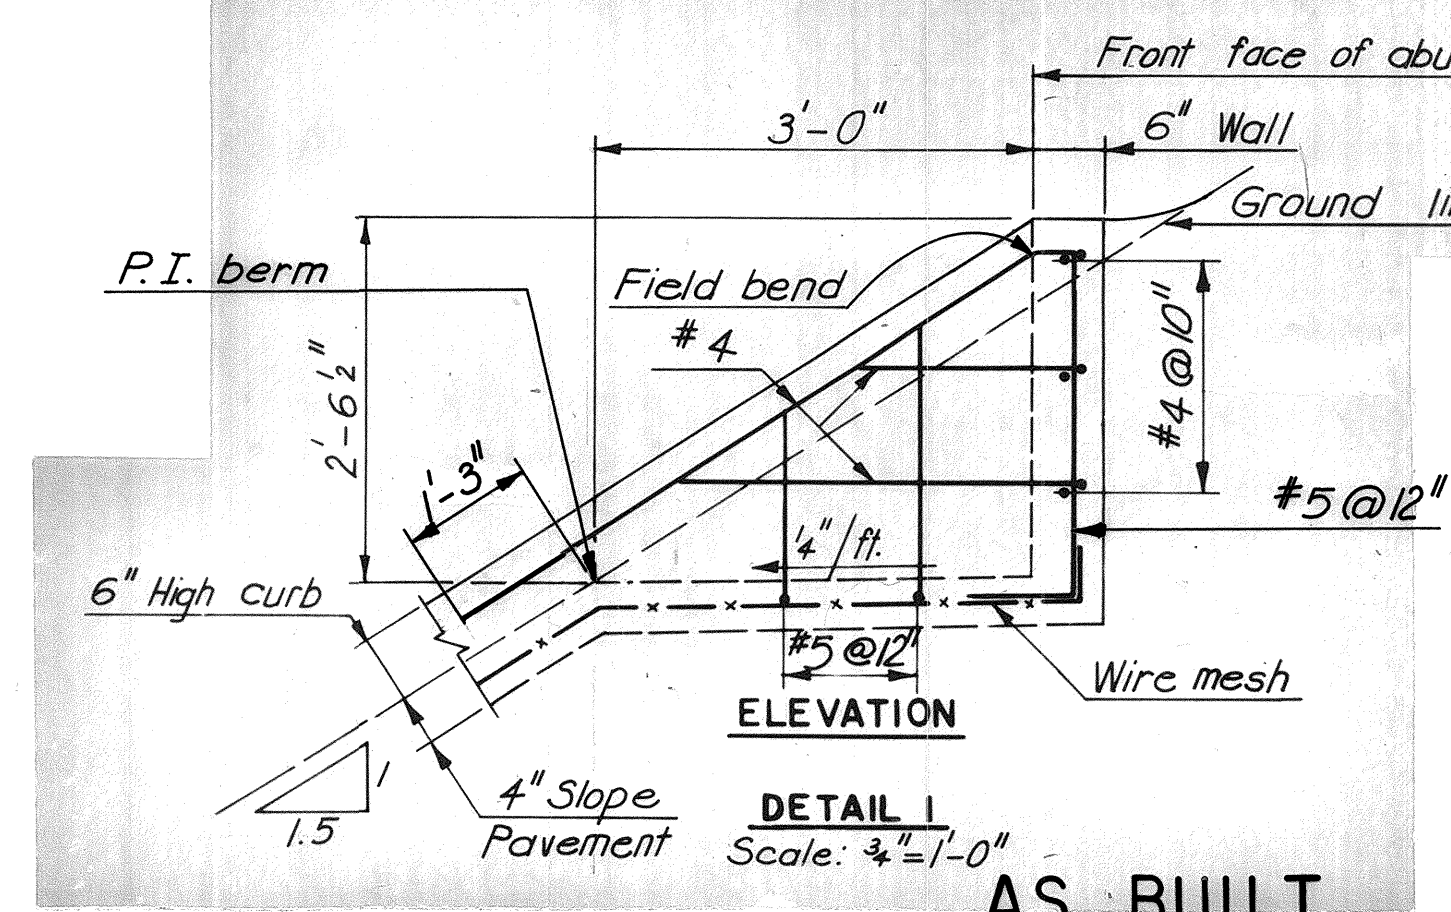

**RICHMOND METROPOLITAN AUTHORITY**  
**RICHMOND EXPRESSWAY SYSTEM**  
DOWNTOWN EXPRESSWAY

**BRIDGE B-55**  
**3RD STREET OVER**  
**DOWNTOWN EXPRESSWAY**

**APPROACH SLABS AND SLOPE PROTECTION**

HOWARD, NEEDLES, TAMMEN & BERGENDOFF  
consulting engineers  
NEW YORK ALEXANDRIA KANSAS CITY

SCALE: AS SHOWN  
CONTRACT NO. 9  
SHEET NO. 15 OF 16

BY	DATE	REVISION	BY	DATE
MADE	elm 12-67			
CHECKED	TEM 2-68	1 As Built	TEM	6-77
IN CHARGE	PRY			





# **Bridge 56**




**(South 4th Street  
Over Downtown Expressway {Rte. 195})**

**Record Set Plans**





RICHMOND EXPRESSWAY SYSTEM			
SECTION	PROJECT	SHEET NO.	TOTAL SHEETS
9	DOWNTOWN EXPRESSWAY	155	

INDEX	
NO.	DESCRIPTION
1	General Plan and Elevation
2	General Notes and Quantities
3	North Abutment
4	North Abutment Details
5	South Abutment
6	South Abutment Details (1)
7	South Abutment Details (2)
8	South Abutment Details (3)
9	Pier
10	Framing Plan
11	Cross Section and Utility Details
12	Deck Plans
13	Joint Details
14	Approach Slabs and Slope Protection
15	Boring Logs
S1	Standard Shoe Details
S3	Standard Aluminum Railing Details (2 Rails)
S4	Standard Electrical Details (Bridges Carrying City Streets)
S7	Standard Architectural Details
S8	Standard Architectural Details
S9	Standard Architectural Details
S10	Standard Conduit Installation Details
S11	Standard Utility Support Details at Bridge Abutments

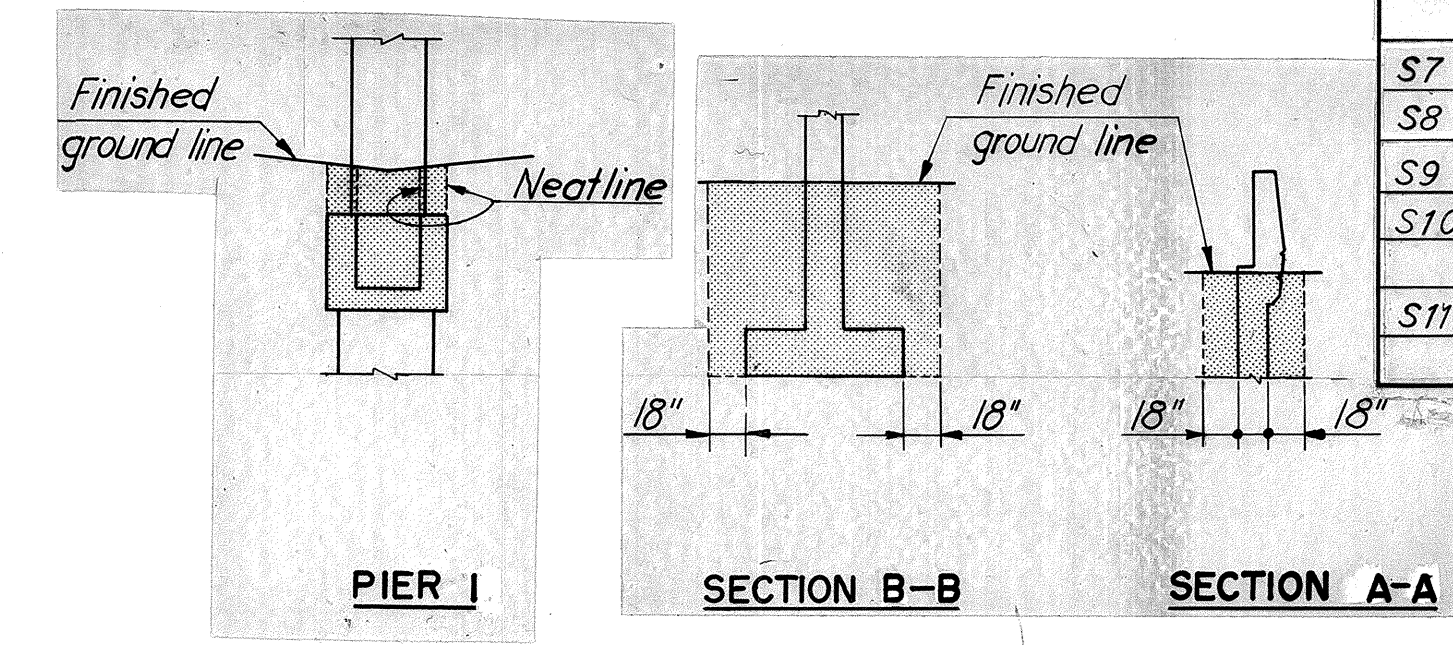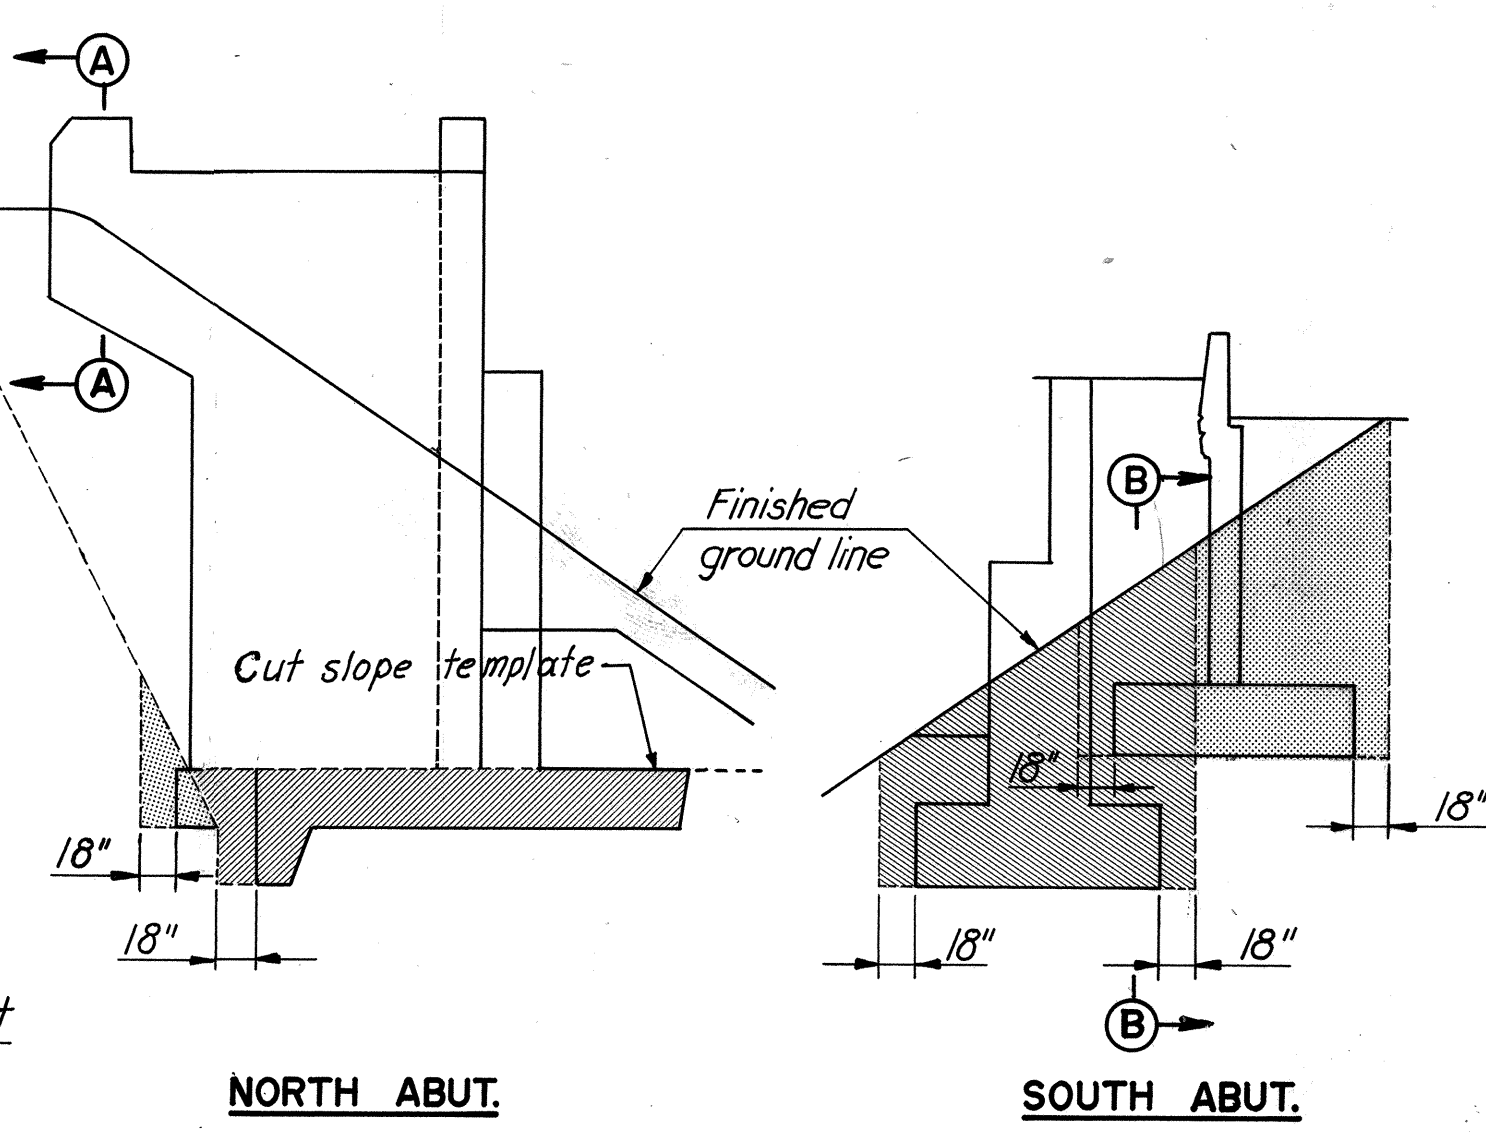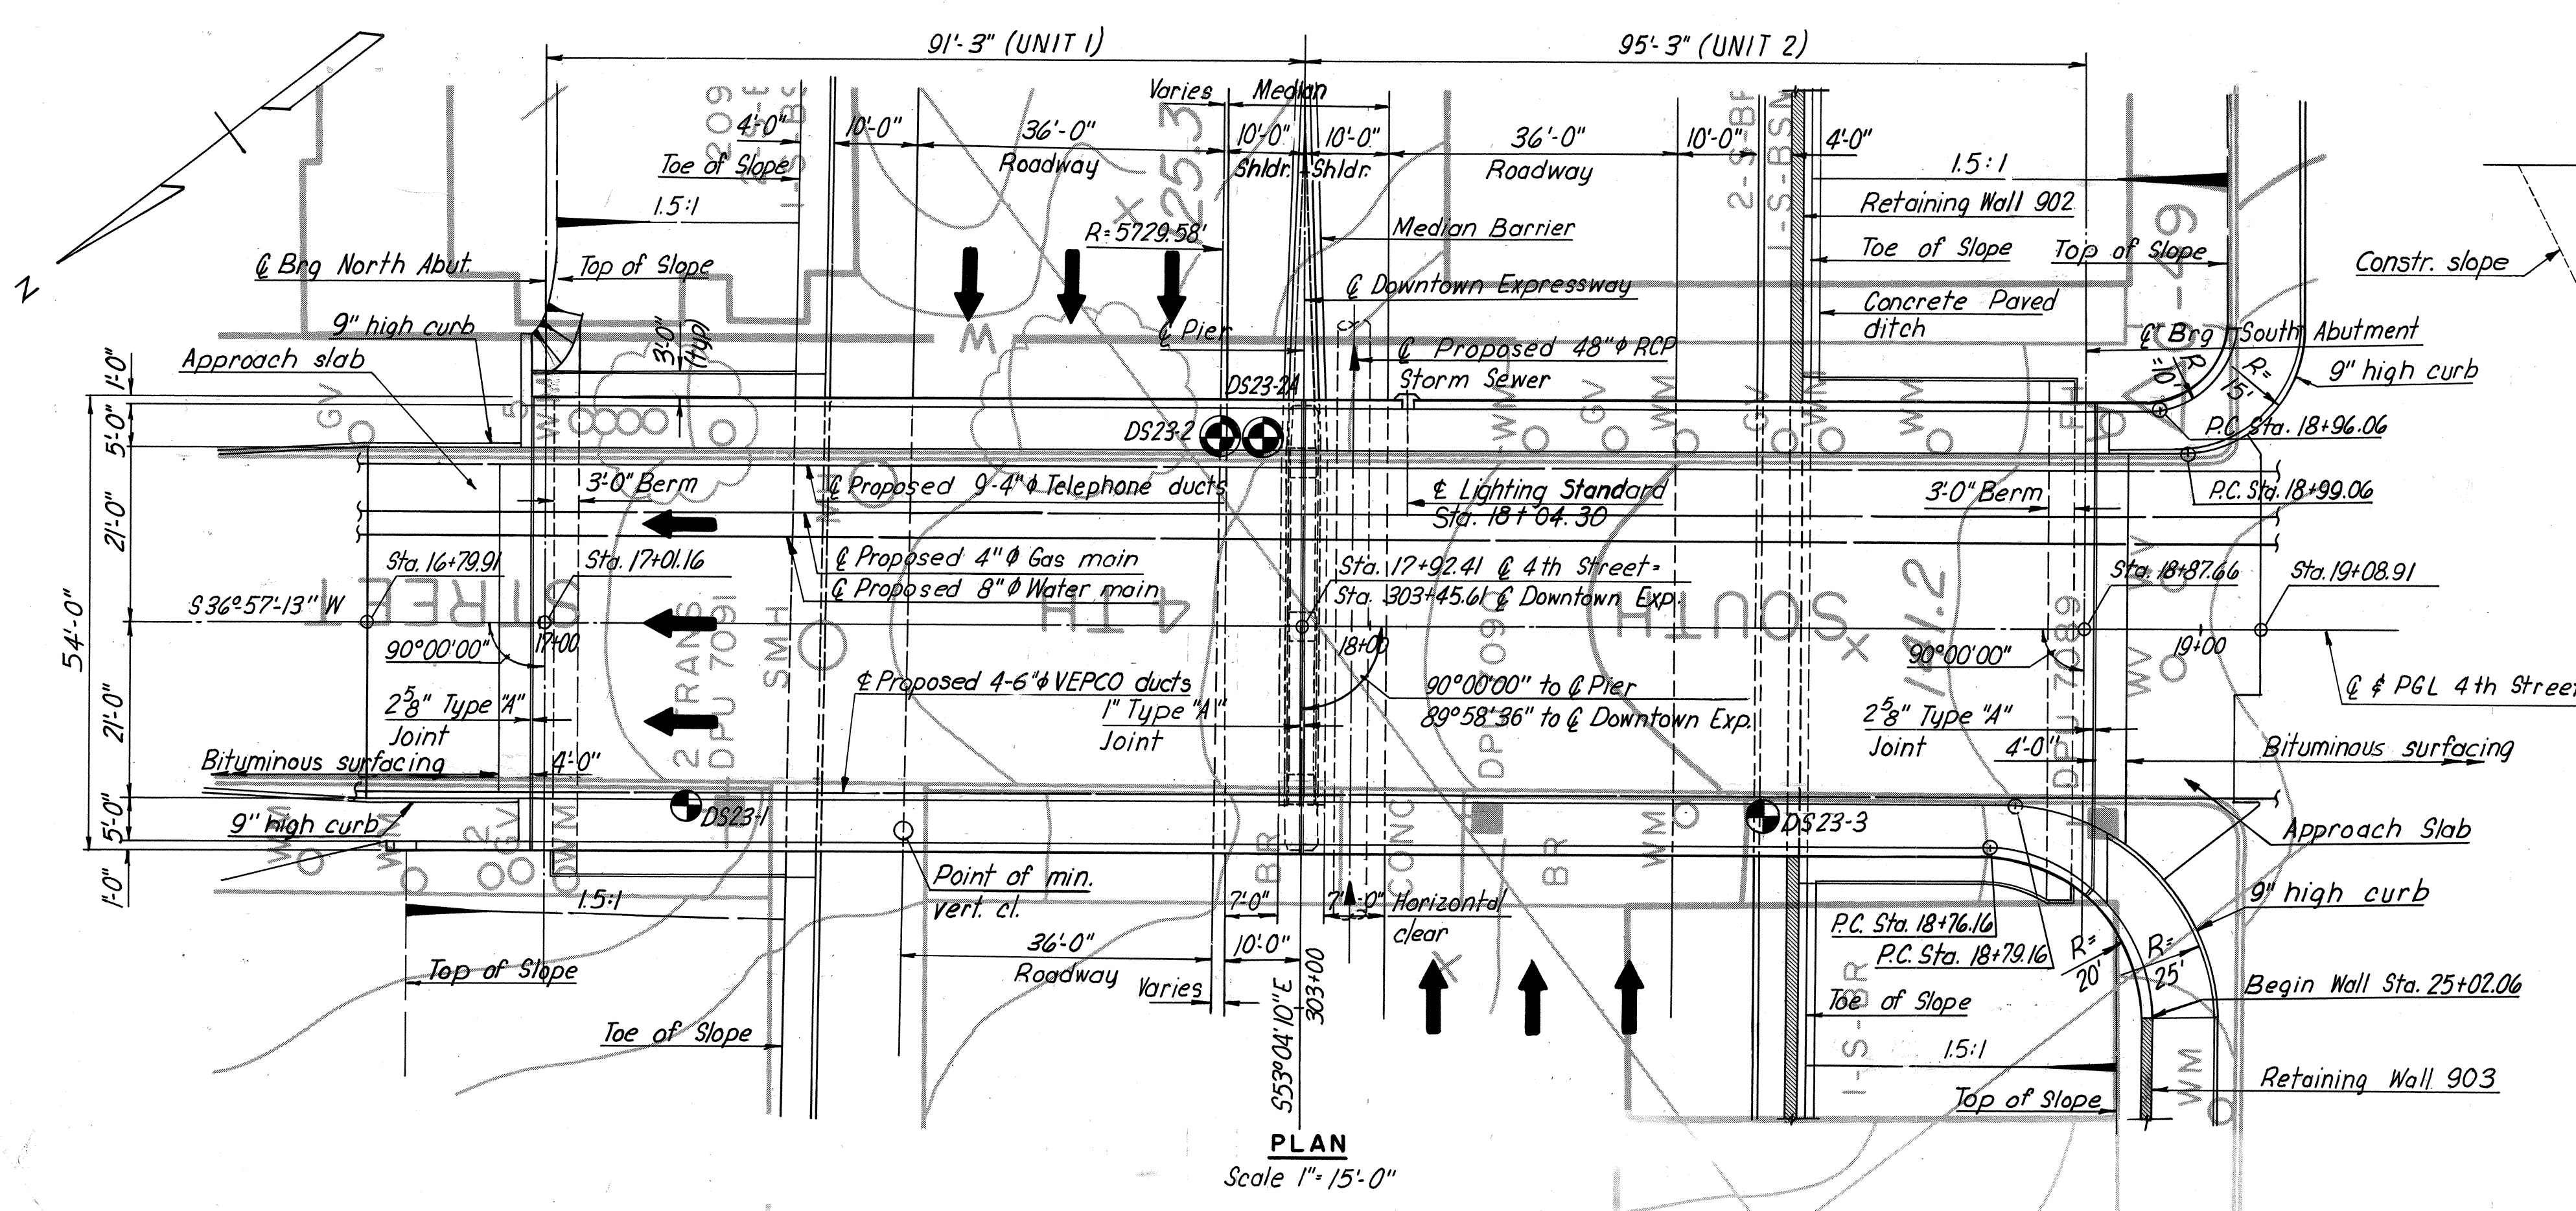

**PAYMENT LIMITS FOR STRUCTURE EXCAVATIONS**  
No Scale

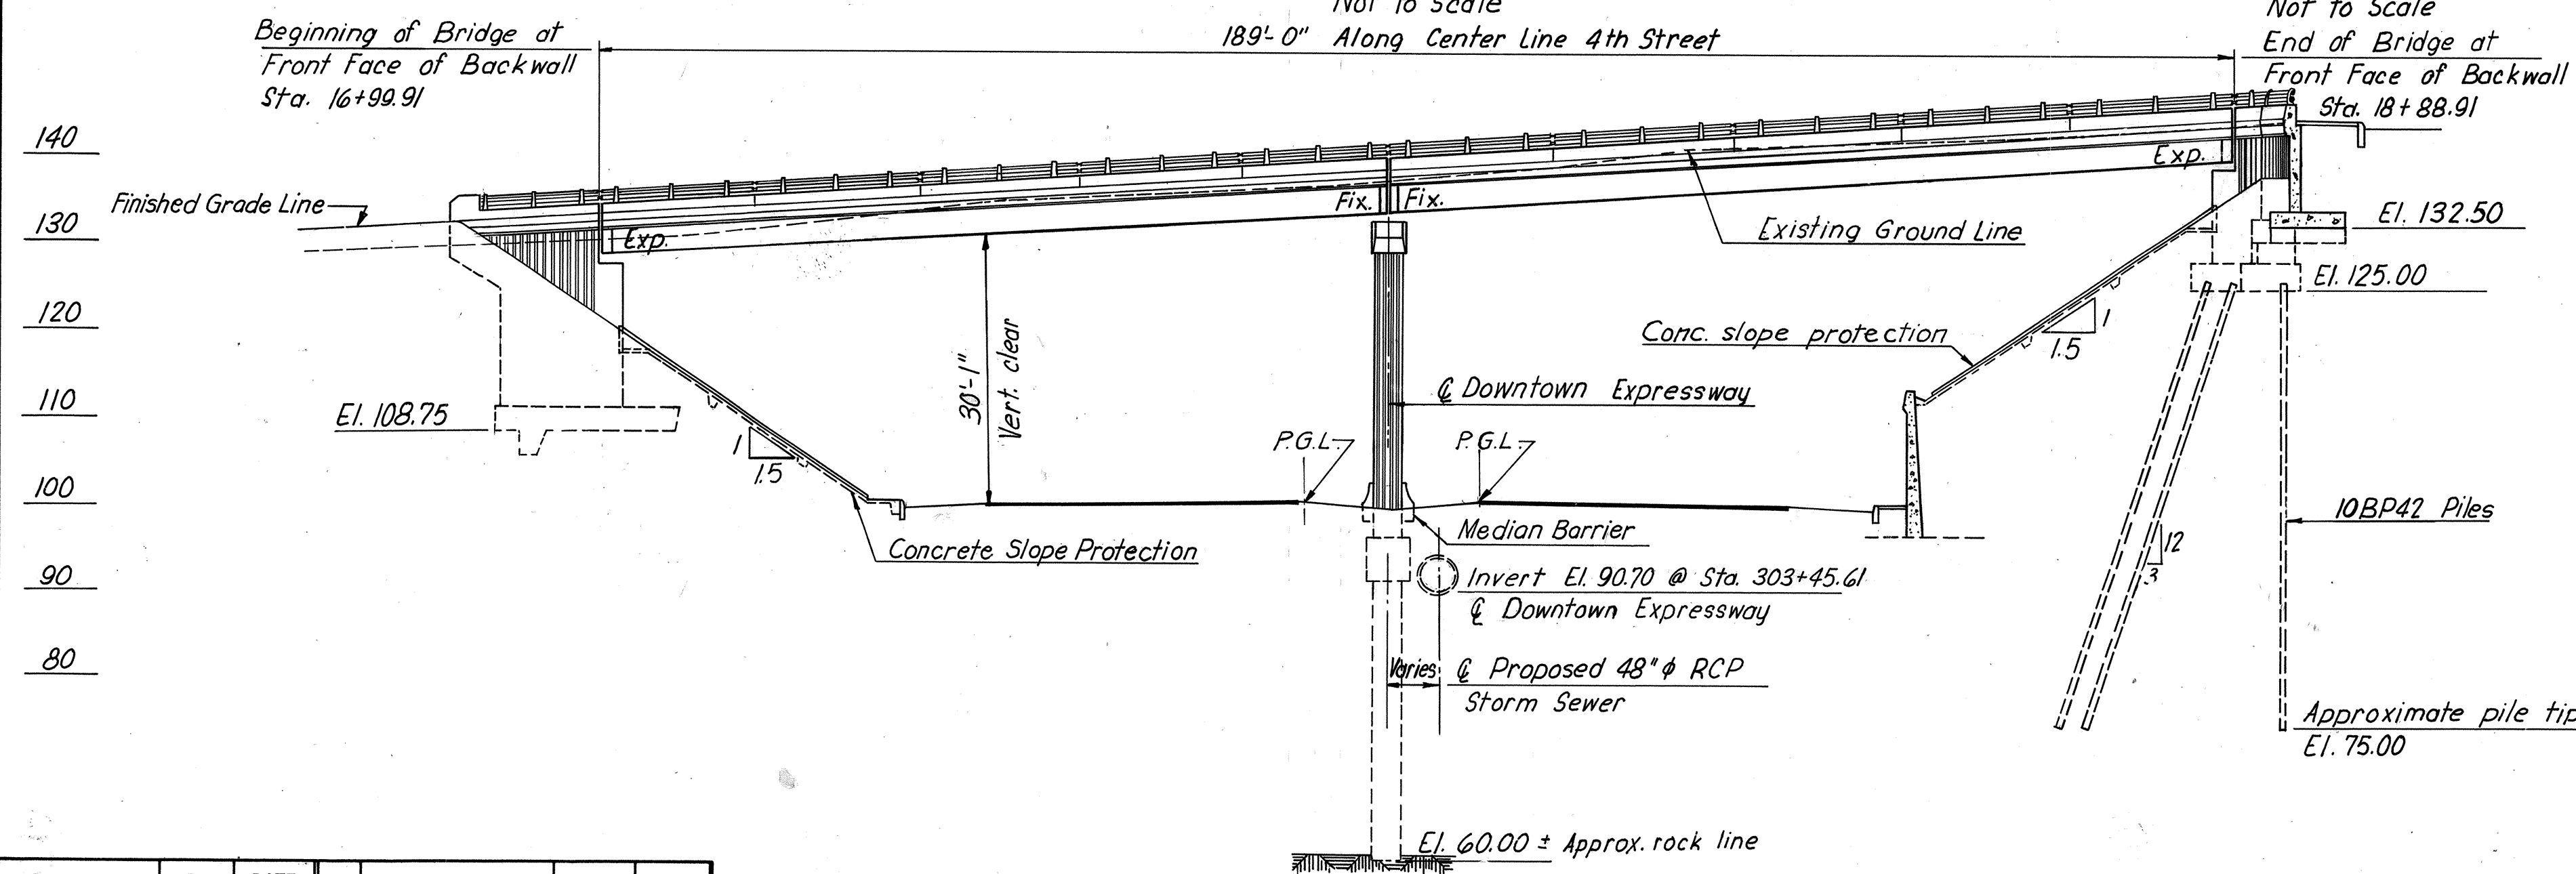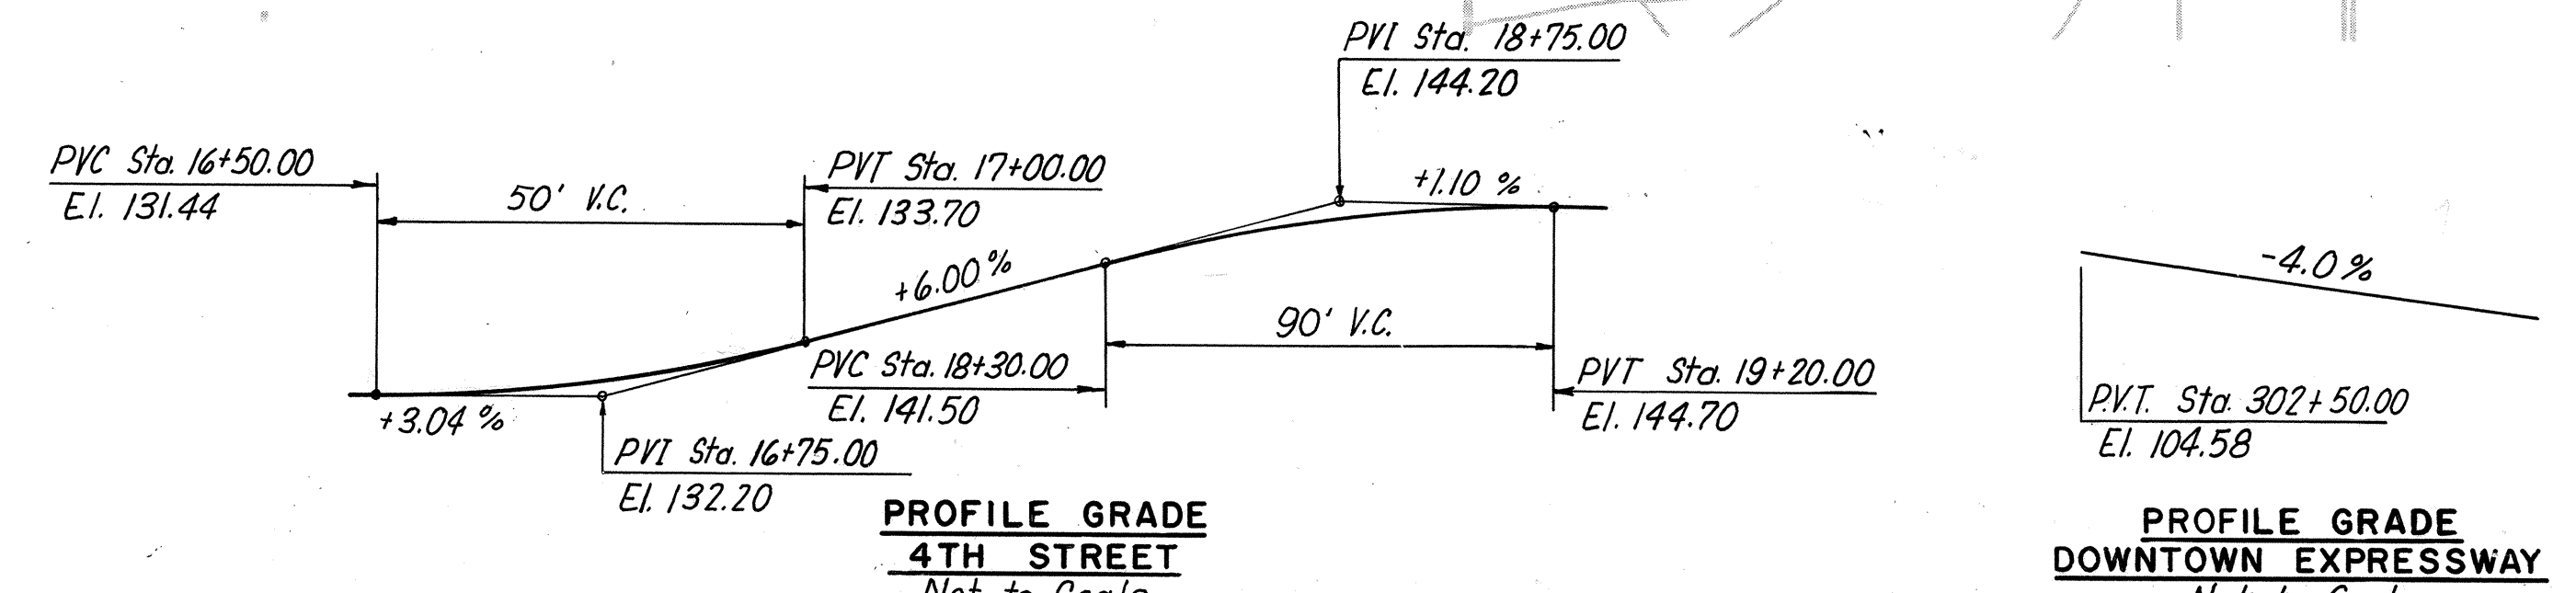

**BORINGS:**  
 Indicates location of 2 1/2" cased hole boring.  
 Indicates location of 4" cased hole boring.  
 For boring data, see Boring Logs sheet.  
**NOTE:** For General Notes and Quantities, see next sheet.

BY	DATE			
MADE	TEM	2-68		
CHECKED	L.B.P.	3-68	1 As Built	TEM 7-77
IN CHARGE	PRY		NO.	REVISION

**RICHMOND METROPOLITAN AUTHORITY**  
**RICHMOND EXPRESSWAY SYSTEM**  
DOWNTOWN EXPRESSWAY

**BRIDGE B-56**  
**4TH STREET OVER**  
**DOWNTOWN EXPRESSWAY**  
**GENERAL PLAN AND ELEVATION**


HOWARD, NEEDLES, TAMMEN & BERGENDOFF  
consulting engineers  
NEW YORK ALEXANDRIA KANSAS CITY

SCALE: AS SHOWN  
CONTRACT NO.: 9  
SHEET NO. 1 OF 15




AS BUILT



RICHMOND EXPRESSWAY SYSTEM			
SECTION	PROJECT	SHEET NO.	TOTAL SHEETS
9	DOWNTOWN EXPRESSWAY	164	

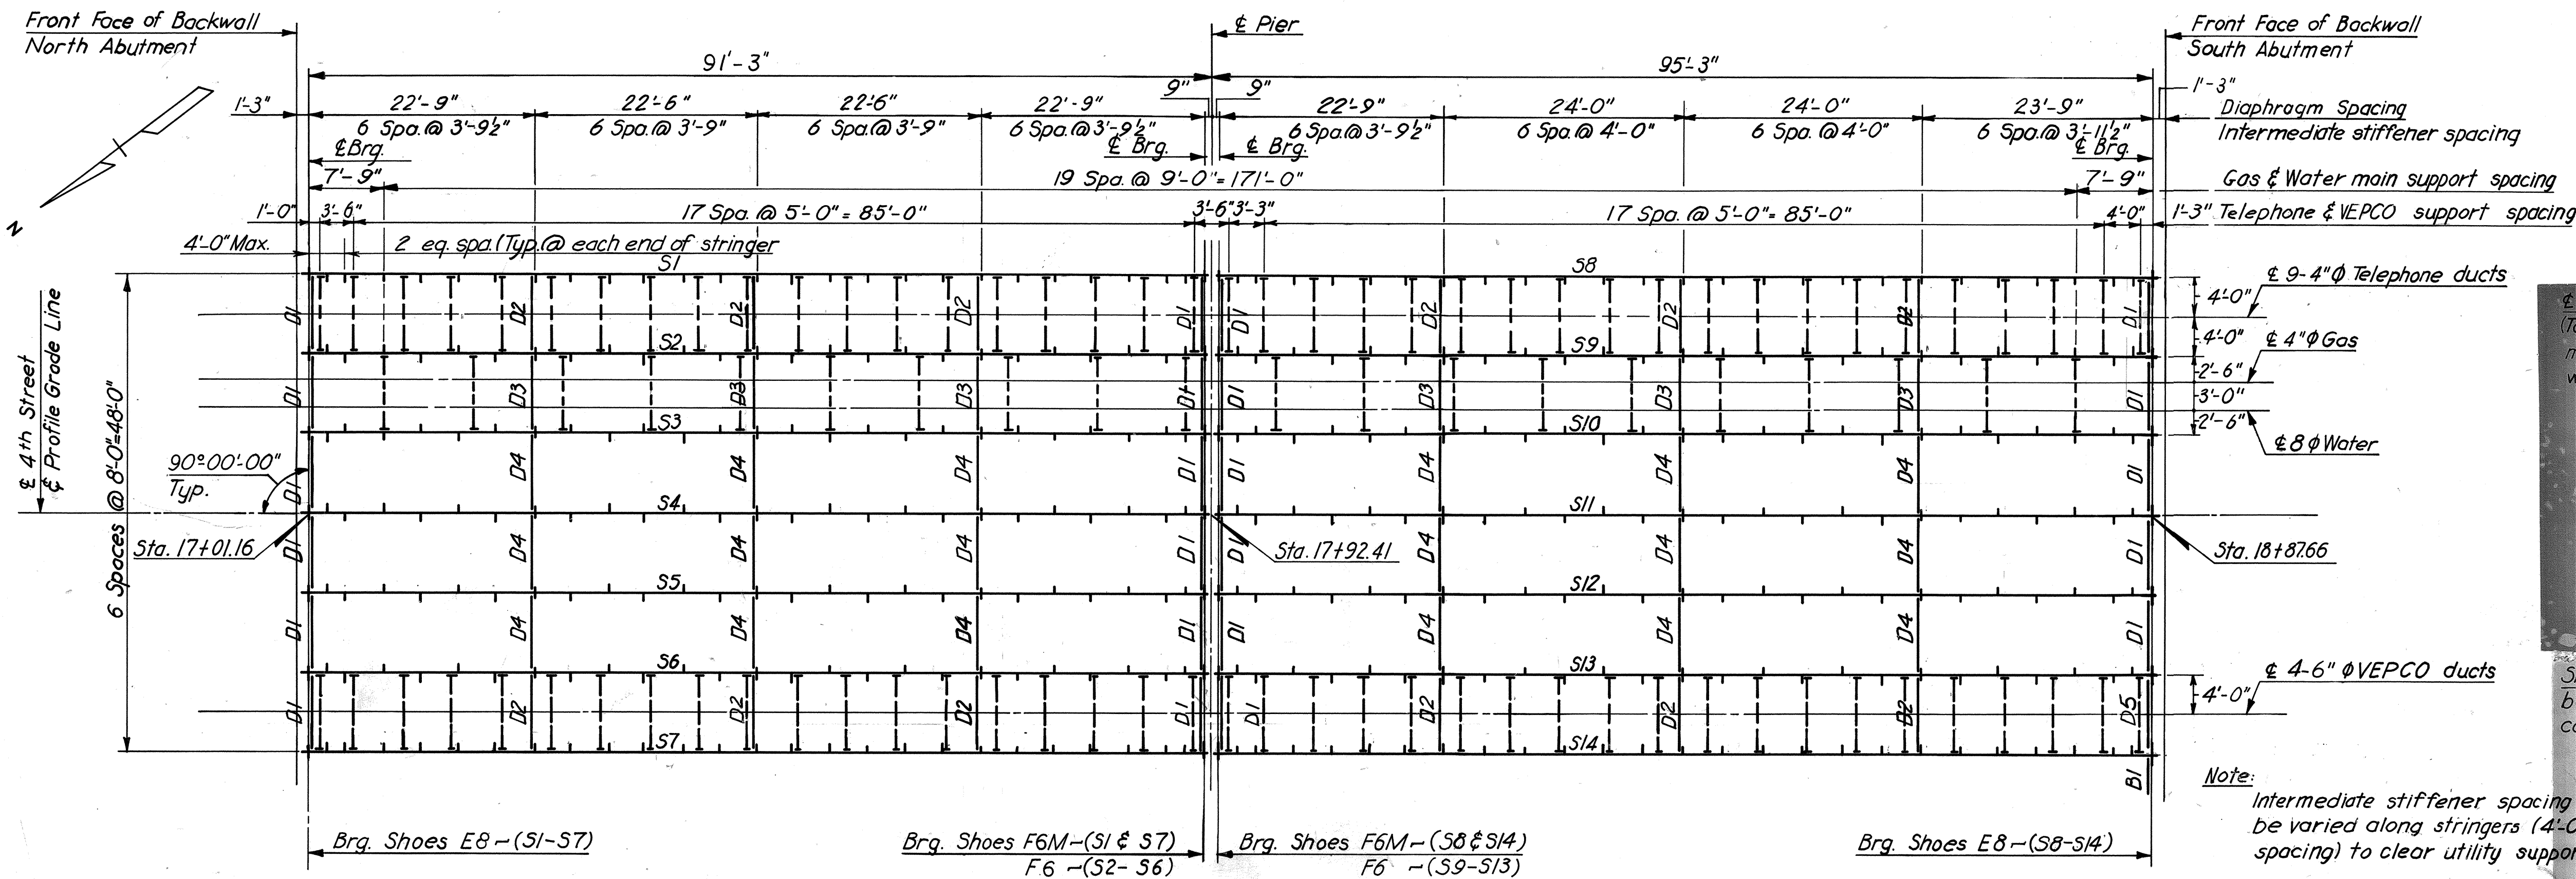

SHOE SCHEDULE			
EXPANSION SHOES		FIXED SHOES	
TYPE	NO. REQD.	TYPE	NO. REQD.
E8	14	F6	10
		F6M	4

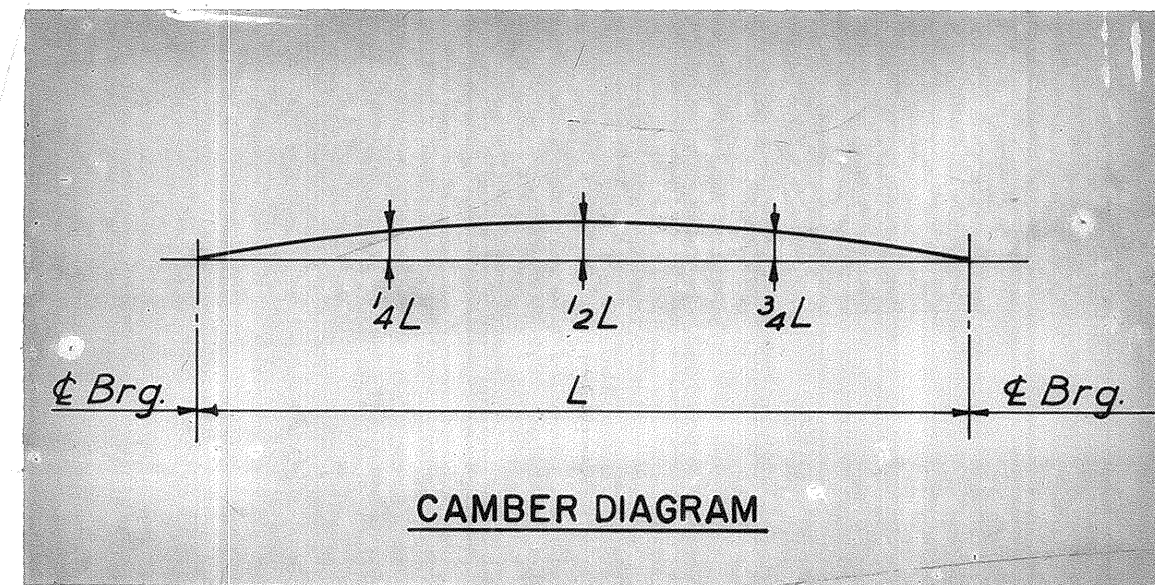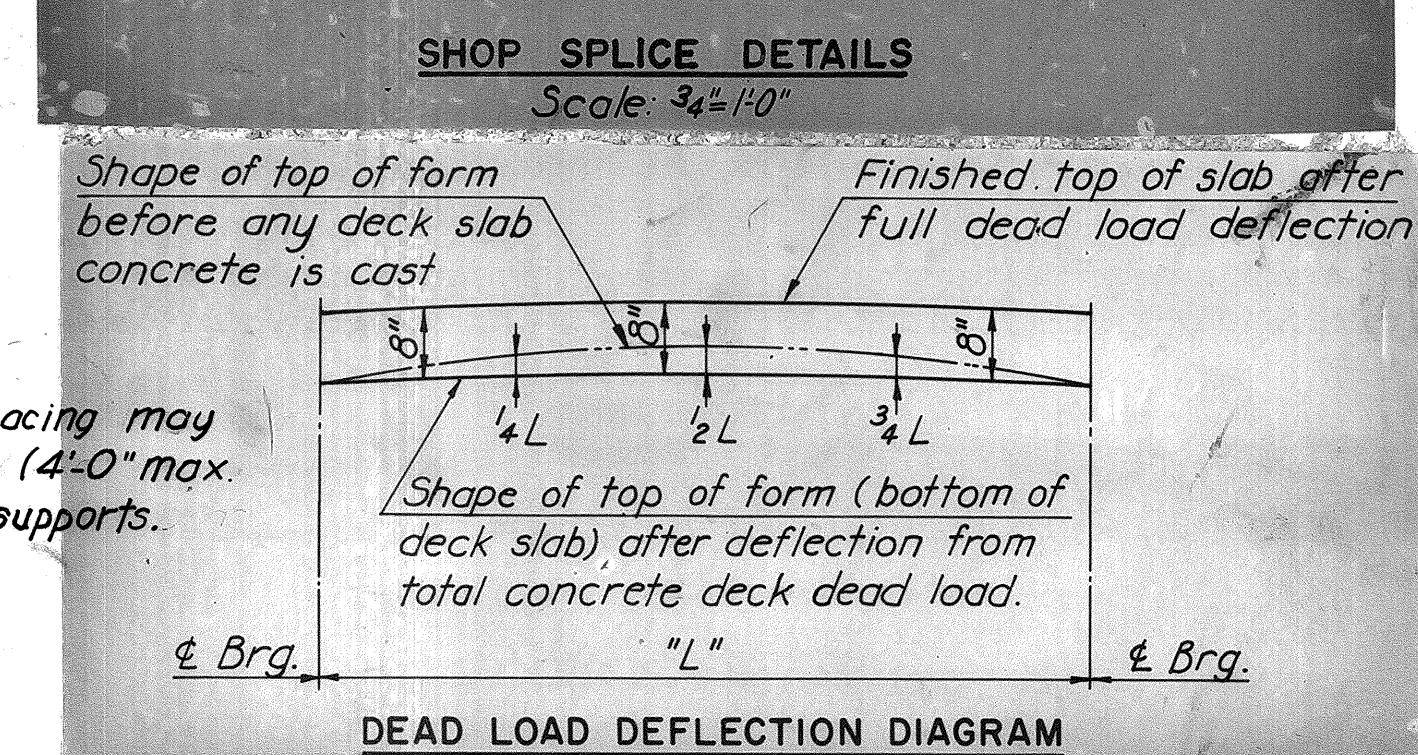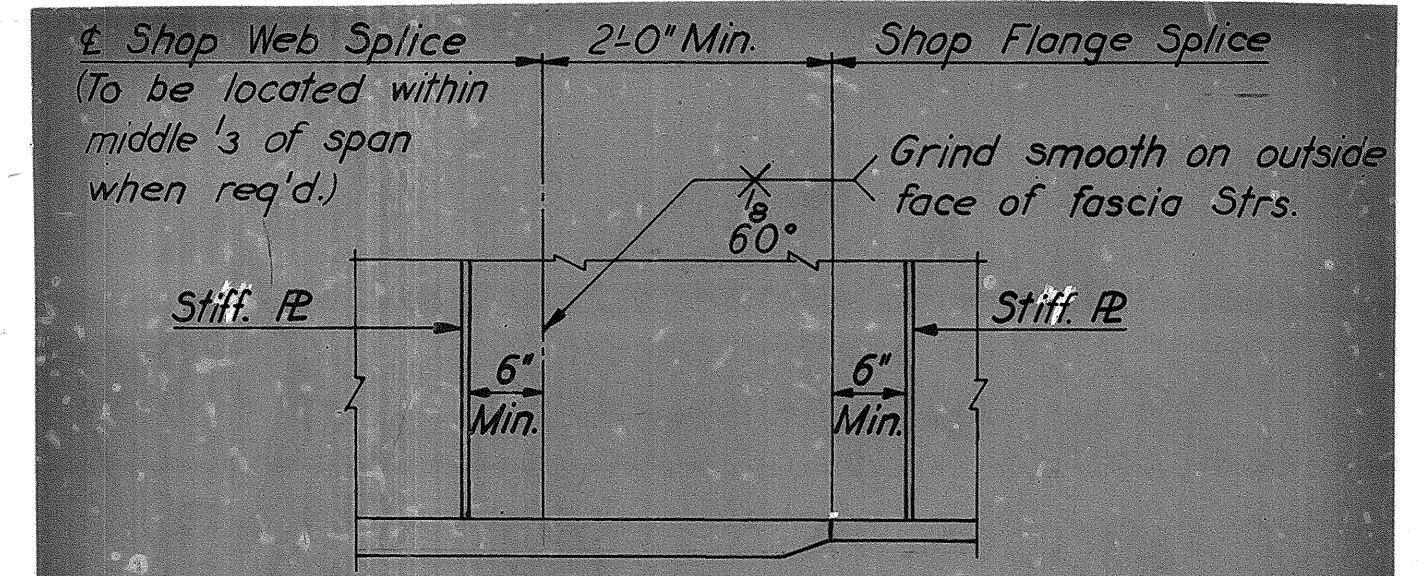


CAMBER SCHEDULE							
STR.	1/4L	1/2L	3/4L	STR.	1/4L	1/2L	3/4L
S1, S2	1 5/8"	2 1/4"	1 5/8"	S8	4 1/2"	7 3/8"	6 1/8"
S4, S5	1 5/8"	2 3/8"	1 5/8"	S11, S12	4 1/2"	7 3/8"	6 1/8"
S3	1 5/8"	2 3/8"	1 5/8"	S9, S10, S13, S14	4 1/2"	7 3/8"	6 1/8"

**NOTE TO FABRICATOR:**

The above stringers shall be fabricated with an upward camber amounting to the tabulated value.



This will provide approximate compensation for deflection under full dead load and for conformity with finished grade.

Dimensions are in inches.

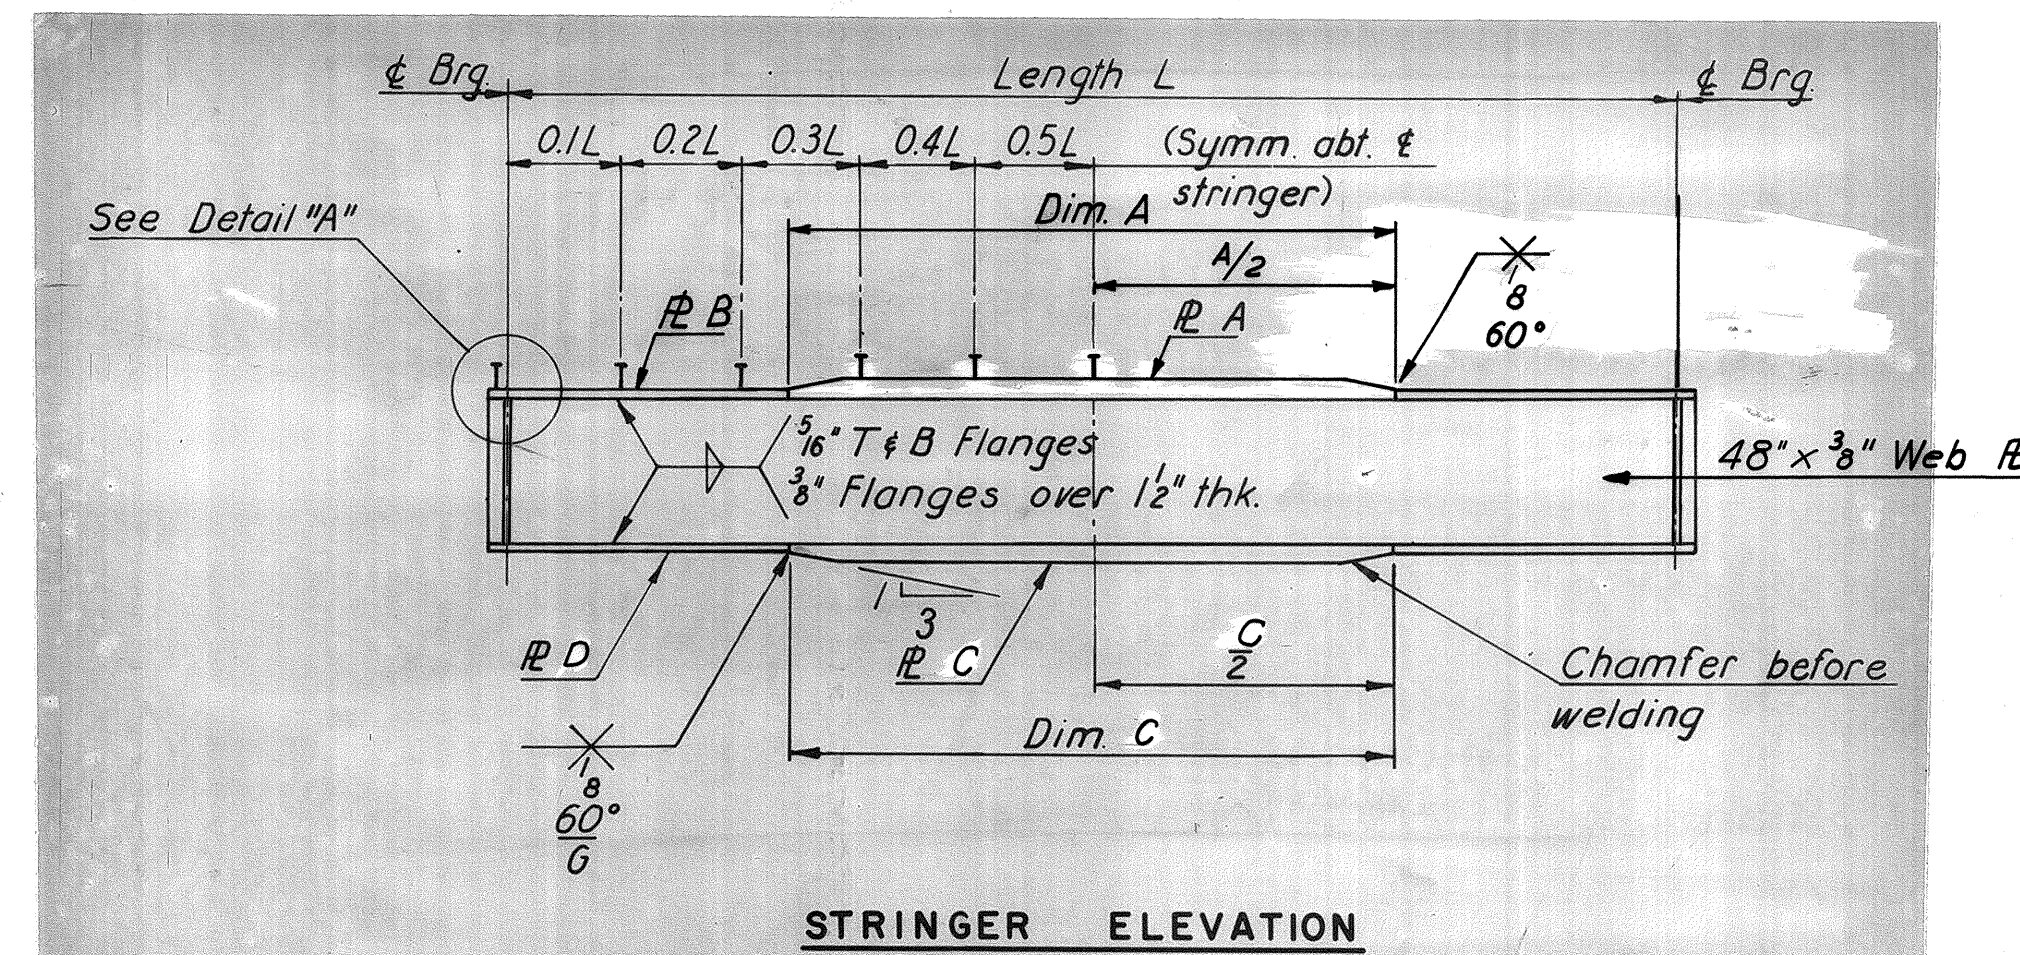

STRINGER - SCHEDULE																	
STR.	LENGTH ℓ BRG. TO ℓ BRG.	R A	DIM A	R B	R C	DIM C	R D	SHEAR STUD SPACING									
								0.1L	0.2L	0.3L	0.4L	0.5L					
S1	90'-6"	16 x 1	42'-0"	16 x 3/4	20 x 1 1/2	55'-0"	20 x 1 1/8	9"	10 1/2"	13 1/2"	17 1/2"	20 1/2"					
S2	↑	16 x 1	40'-0"	↑	20 x 1 1/2	53'-0"	20 x 1 1/8	10"	11 1/2"	13 1/2"	17"	19"					
S3		16 x 3/8	34'-0"		20 x 1 1/2	53'-0"	20 x 1 1/8	10"	13 1/2"	16 1/2"	18 1/2"						
S4		29'-0"	20 x 1 1/2		57'-0"	20 x 1	9 1/2"	14"	↑	↑							
S5		29'-0"	20 x 1 1/2		57'-0"	20 x 1	9 1/2"	11 1/2"			14"						
S6	↓	16 x 3/8	34'-0"		20 x 1 1/2	53'-0"	20 x 1 1/8	9 1/2"	11"	13 1/2"	16 1/2"	18 1/2"					
S7	90'-6"	16 x 1	42'-0"		20 x 1 1/2	55'-0"	↑	9"	10 1/2"	13 1/2"	17 1/2"	20 1/2"					
S8	94'-6"	16 x 1 1/8	53'-0"		20 x 1 3/4	62'-0"		9"	10 1/2"	13 1/2"	↑	21"					
S9	↑	16 x 1 1/8	52'-0"		20 x 1 3/4	61'-0"		9 1/2"	11"	14"			19 1/2"				
S10		16 x 1 1/8	50'-0"		20 x 1 3/4	60'-0"		10"	11 1/2"	↑	17 1/2"	19 1/2"					
S11		16 x 1	44'-0"		20 x 1 1/2	58'-0"	10"	11 1/2"	17"				19"				
S12		↓	16 x 1	44'-0"		20 x 1 1/2	58'-0"	↓	10"	11 1/2"	↓	17"	19"				
S13	16 x 1 1/8		50'-0"	20 x 1 3/4	61'-0"	20 x 1 1/8	9 1/2"		11"	14"				17"	19 1/2"		
S14	94'-6"		16 x 1 1/8	53'-0"	16 x 3/4	20 x 1 1/8	58'-0"		20 x 1 1/4	9"				10 1/2"	13 1/2"	17 1/2"	21"

Note: Lengths shown are horizontal distances measured along centerlines of stringers.

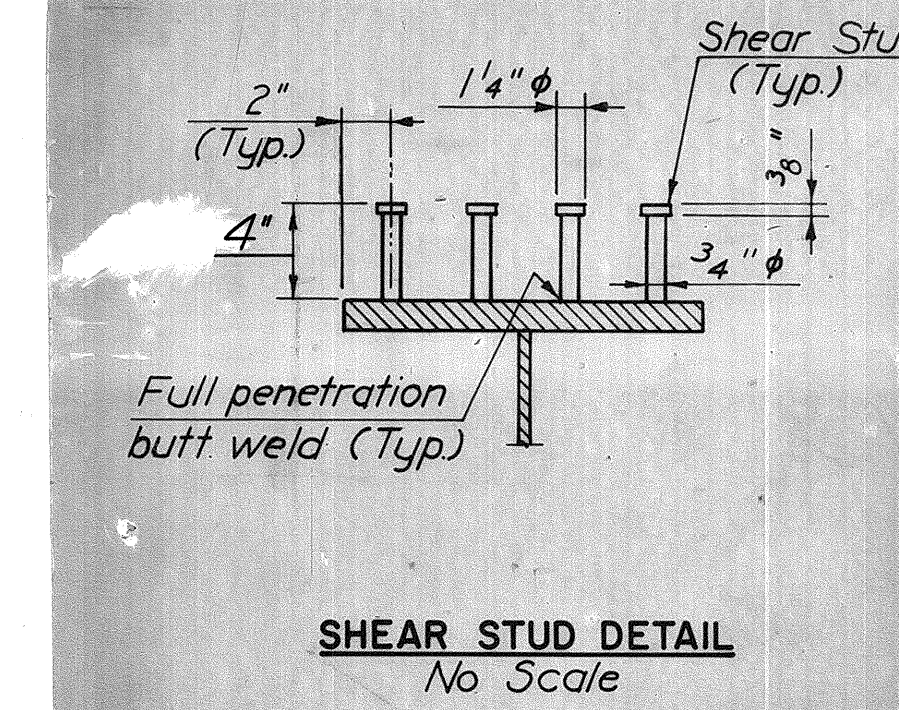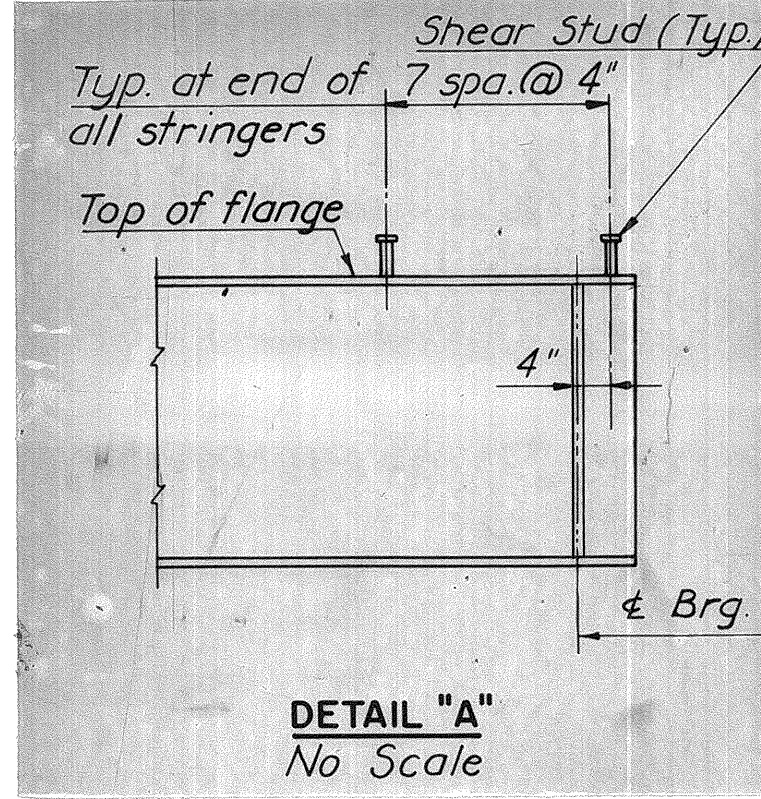

**SHEAR STUD NOTE:**

Capacity = 3,400 lbs. per stud.

The contractor may, if he elects, use three 1/2" diameter studs at the same longitudinal spacing in lieu of the four 3/4" diameter studs shown.

Stud rows shall be placed parallel to the main deck reinforcing.

Shear stud spacing shown is maximum spacing.

DEFLECTION SCHEDULE		
STR.	1/4L	1/2L
S1-S7	1 1/4"	1 3/4"
S8, S11, S12	1 1/8"	2"
S9, S10, S13, S14	1 1/8"	1 3/8"

**NOTE TO CONTRACTOR:**

The above deflections are those anticipated to occur in the stringer upon placement of the total concrete deck dead load.

In practice, the stringers in place are not likely to have the exact camber to compensate for these deflections during construction. The residual amounts shall be provided for by adjusting forms to vary the thickness of the concrete bolster between the bottom of the slab and the top of stringer, without alteration of the slab thickness.

**RICHMOND METROPOLITAN AUTHORITY**

**RICHMOND EXPRESSWAY SYSTEM**

**DOWNTOWN EXPRESSWAY**

**BRIDGE B-56**

**4TH STREET OVER**

**DOWNTOWN EXPRESSWAY**

**FRAMING PLAN**

HOWARD, NEEDLES, TAMMEN & BERGENDOFF  
consulting engineers  
NEW YORK ALEXANDRIA KANSAS CITY

SCALE: AS SHOWN

CONTRACT NO. 9


SHEET NO. 10 OF 15

BY	DATE	REVISION	BY	DATE
MADE	EVR 10-20			
CHECKED	T.E.M. 2-68	1 As Built	TEM	7-77
IN CHARGE	P.R.Y.			

AS BUILT





RICHMOND EXPRESSWAY SYSTEM			
SECTION	PROJECT	SHEET NO.	TOTAL SHEETS
9	DOWNTOWN EXPRESSWAY	165	

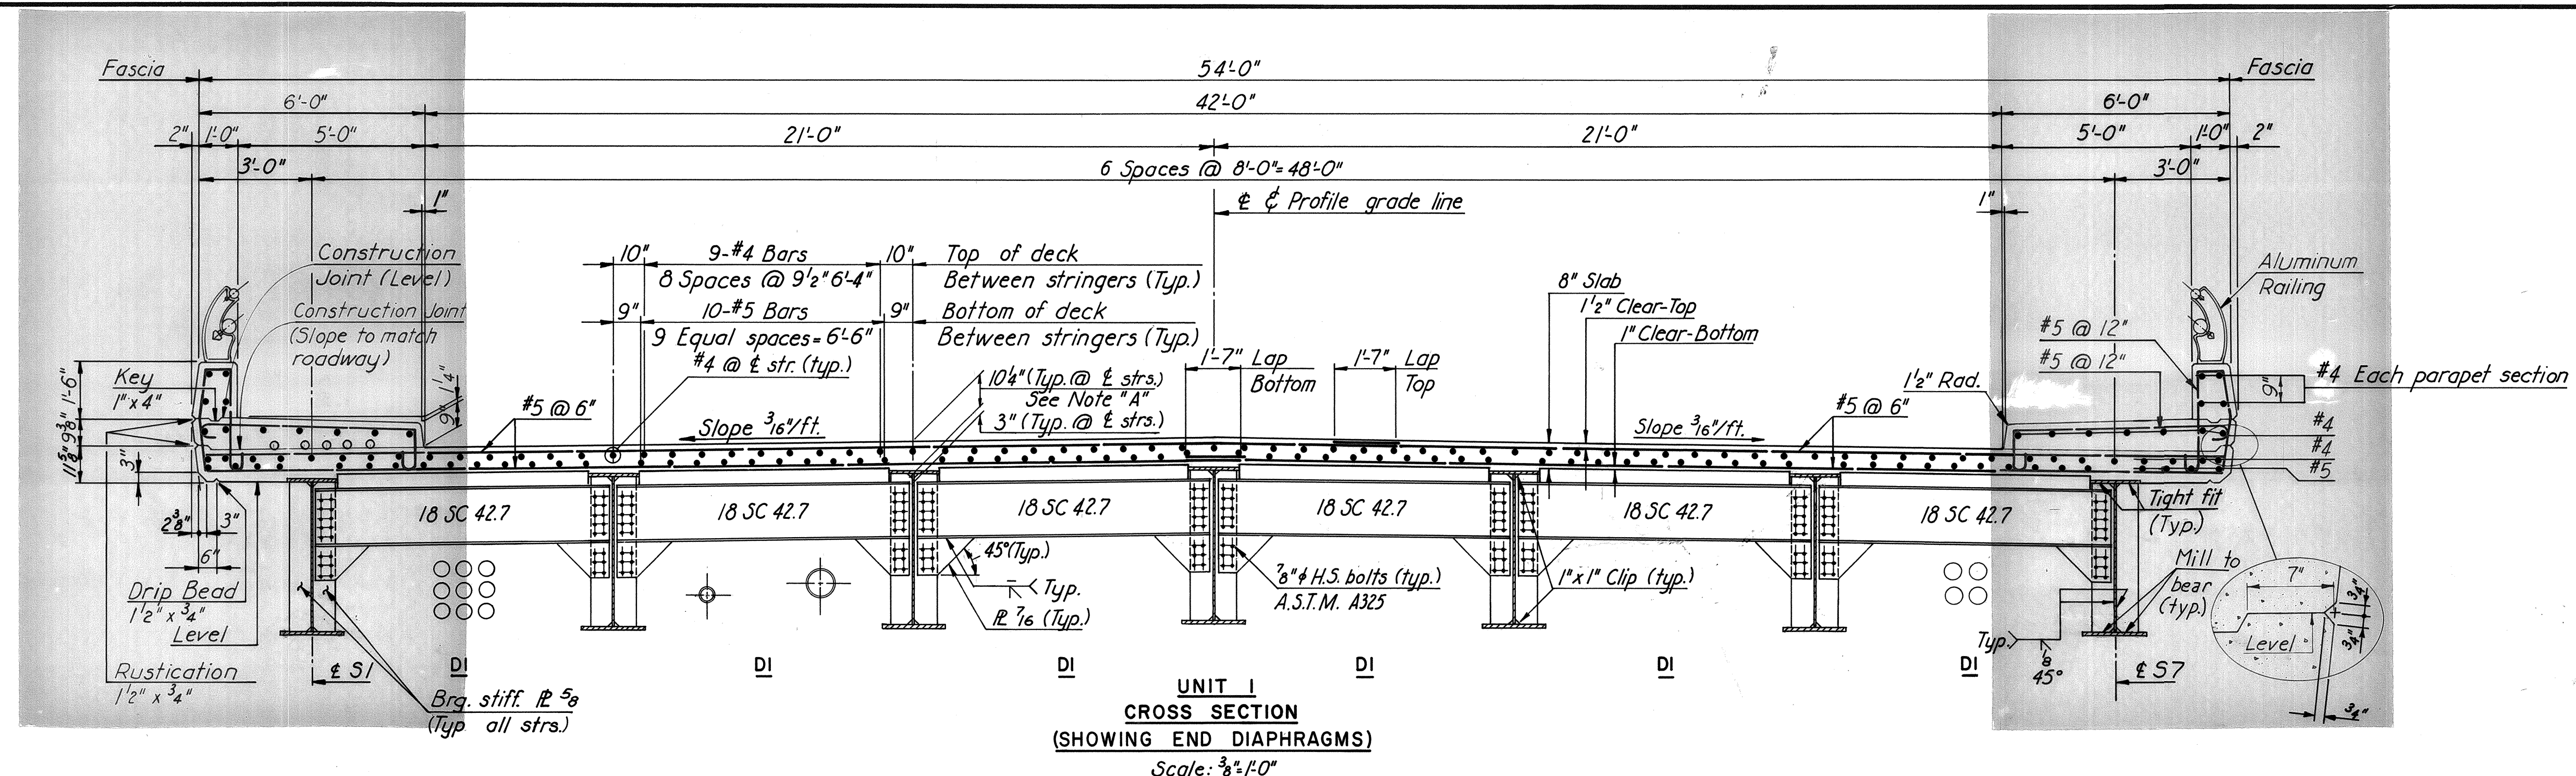



**NOTE "A":**  
 Dimension shown is measured from top of web to top of slab at the intersection of the centerline of stringer and the centerline of bearing. At exterior stringers this is measured to the cross slope extended. This dimension may be varied between bearings as required to care for variation in camber, except that no portion of the stringer flange may fall within the 8" slab.

**NOTES:**  
 For spacing and location of utility supports and diaphragms, see Framing Plan sheet.  
 For Basic Attachment Details for cement asbestos conduit, see Standard Conduit Installation Details sheet.  
 For details showing gas and water mains thru abutments, see Standard Utility Support Details At Bridge Abutments sheet.

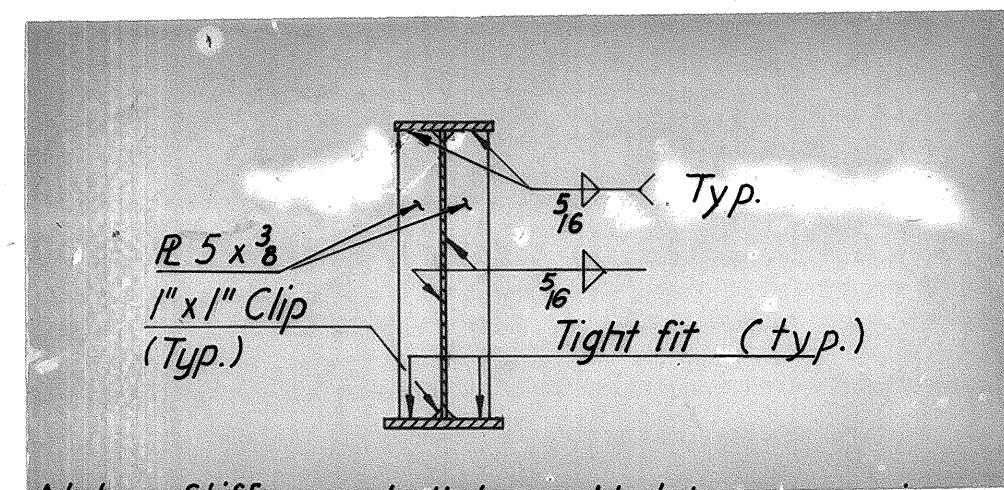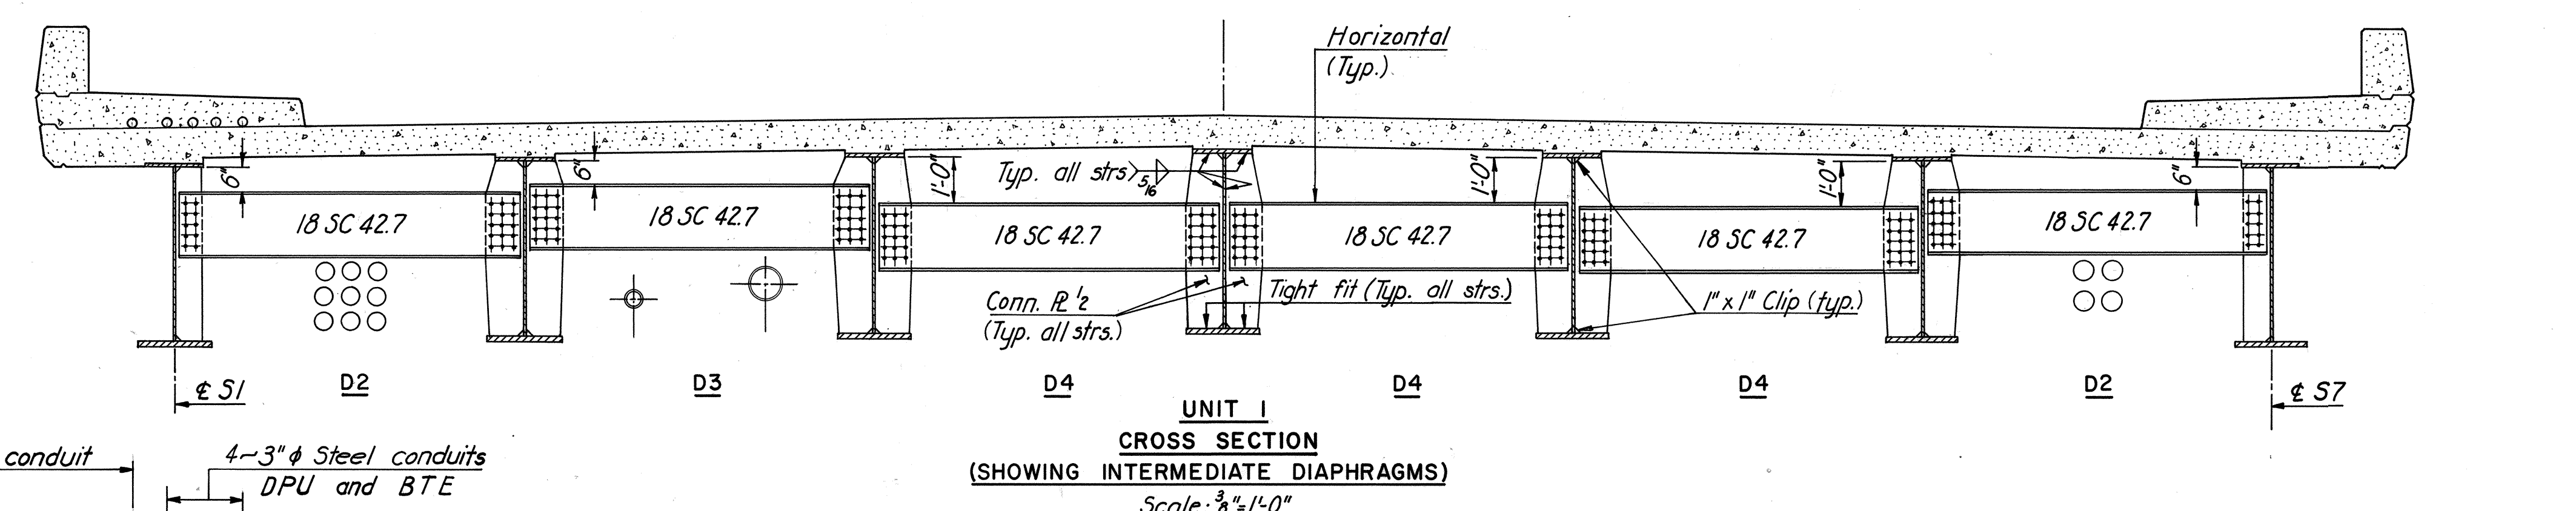


Note: Stiffener shall be welded to compression flange and have a tight fit to the tension flange.

INTERMEDIATE STIFFENER DETAIL


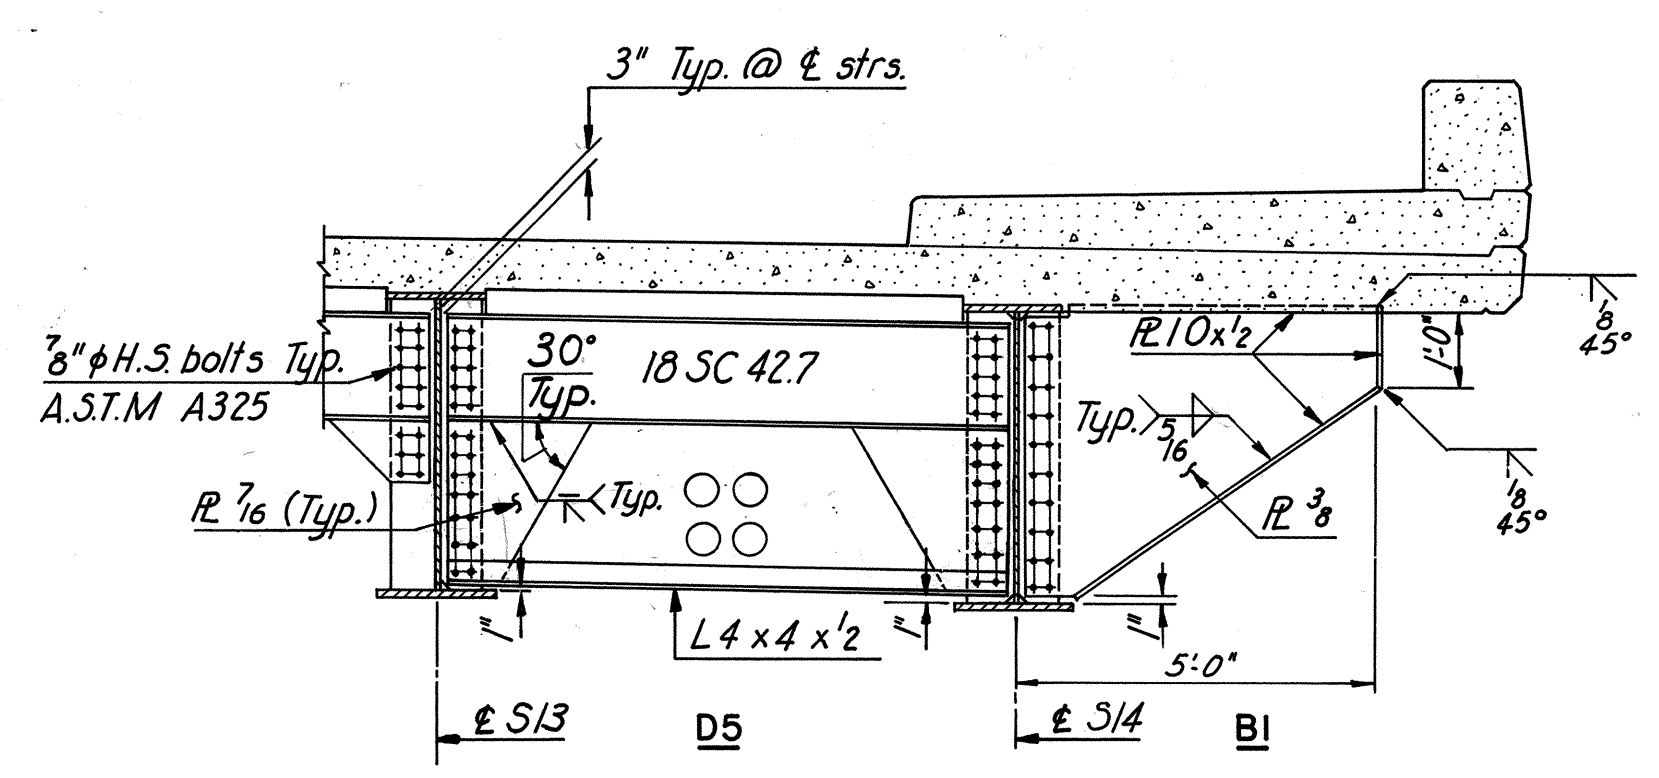
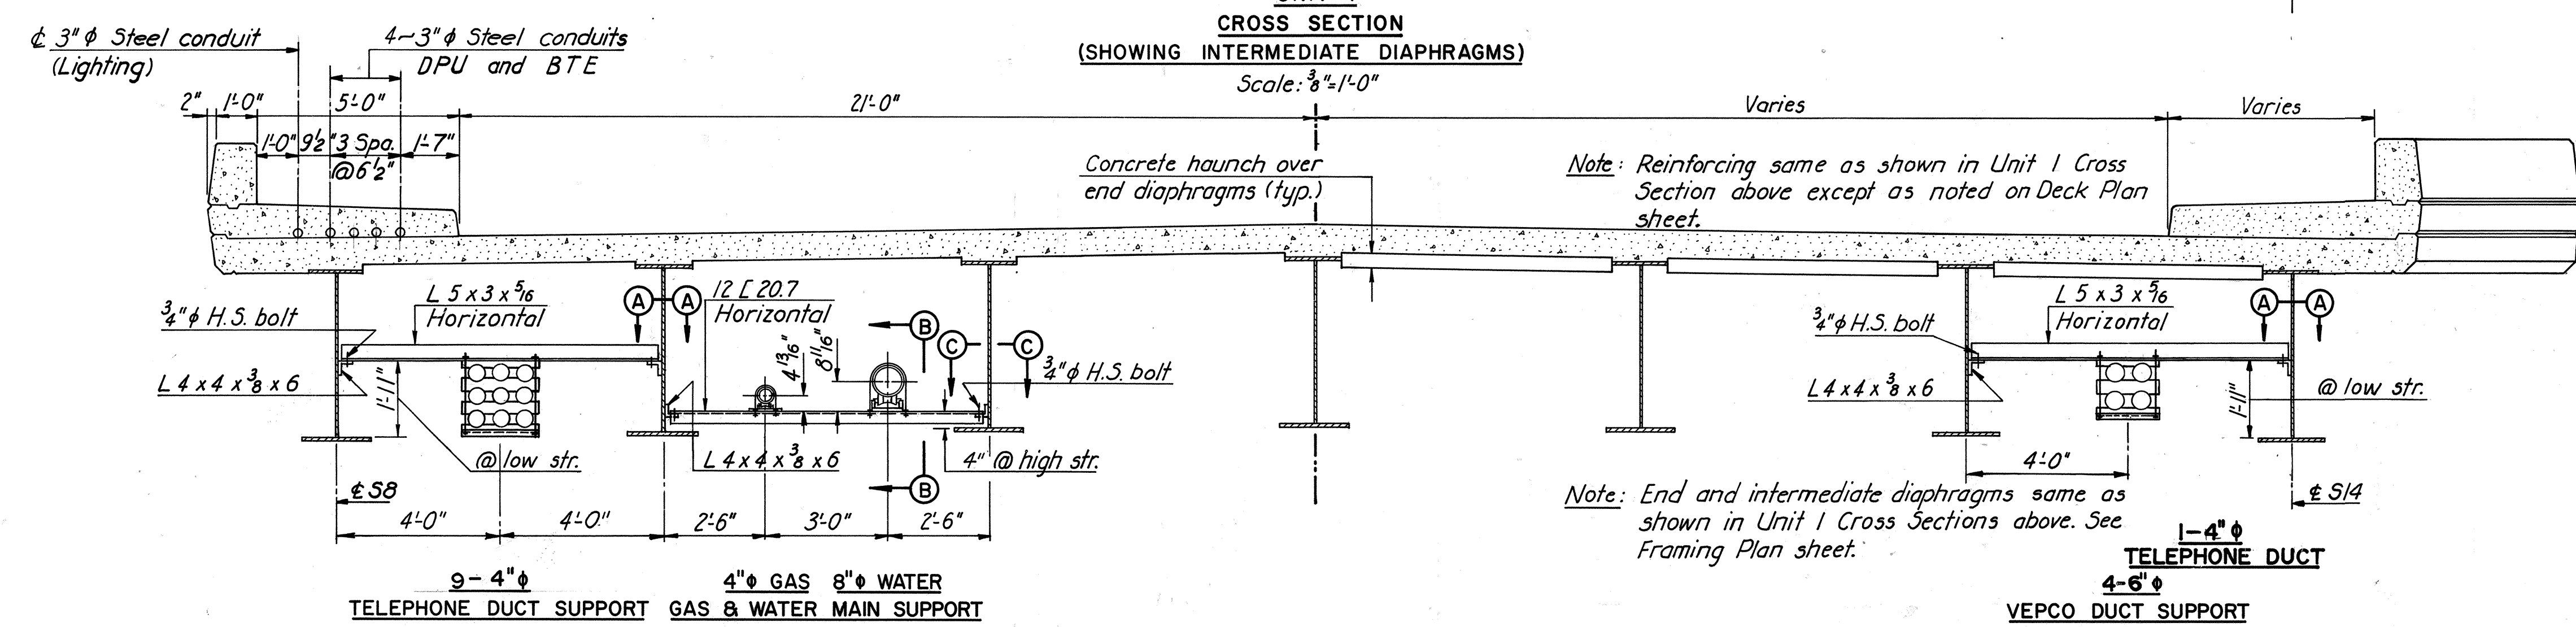


UNIT 2 PARTIAL CROSS SECTION (SHOWING END DIAPHRAGM AT SOUTH ABUTMENT) Scale: 3/8"=1'-0"

BY	DATE			
MADE	6.8.67	11-67		
CHECKED	T.E.M.	2-68	1 As Built	T.E.M. 7-77
IN CHARGE	P.R.Y.			

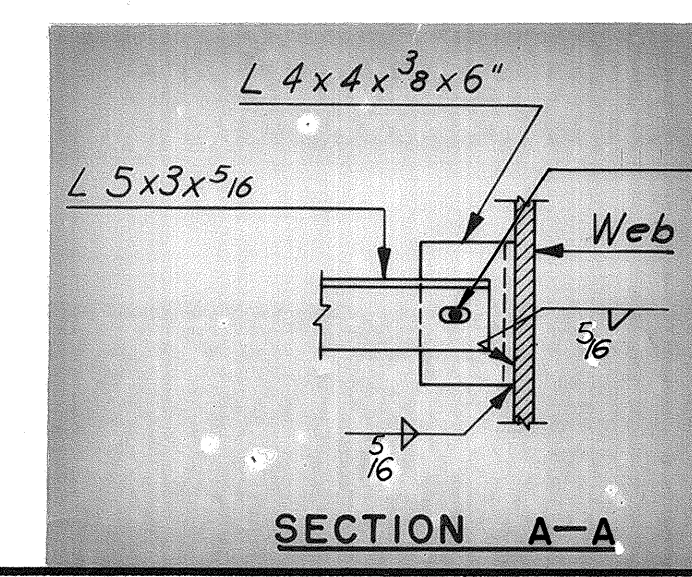

Provide 13/16" x 1/4" slots in ends of L 5 x 3 x 7/16 and 13/16" hole in L 4 x 4 x 3/8 x 6 for 3/4" H.S. bolt.

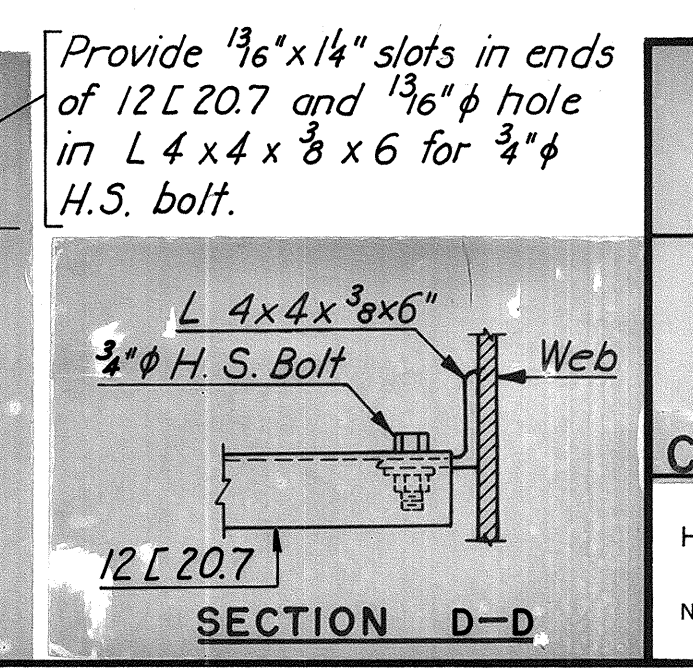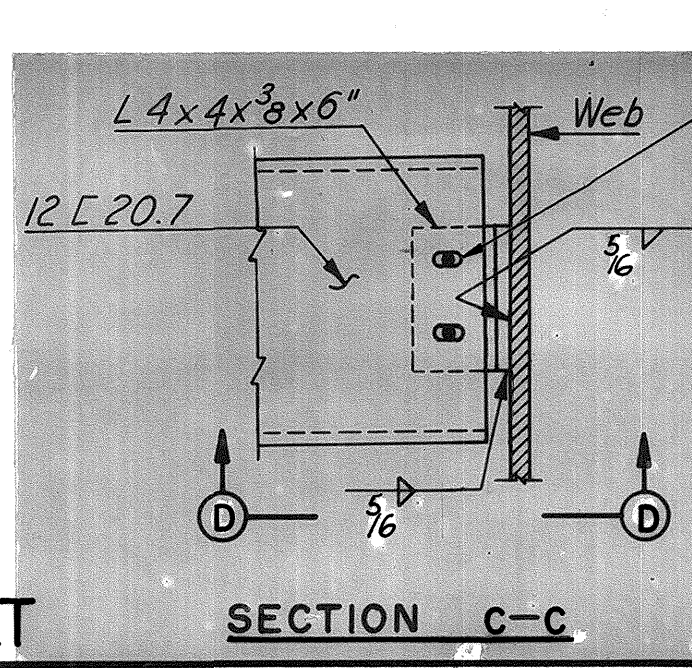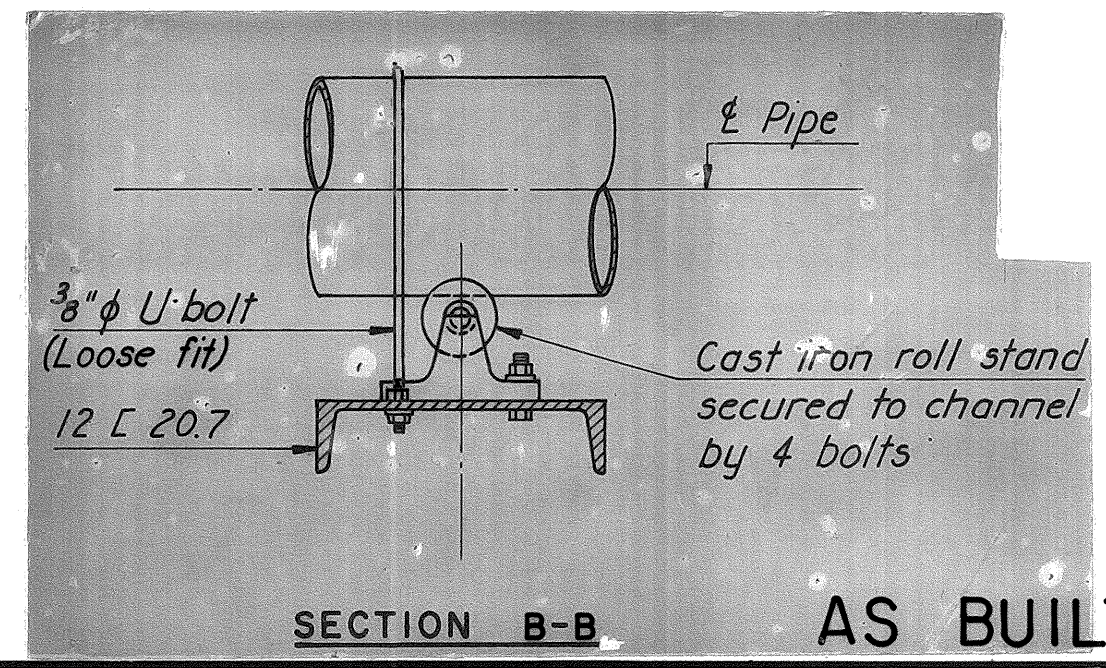

**RICHMOND METROPOLITAN AUTHORITY**  
**RICHMOND EXPRESSWAY SYSTEM**  
 DOWNTOWN EXPRESSWAY

BRIDGE B-56  
 4TH STREET OVER  
 DOWNTOWN EXPRESSWAY

**CROSS SECTION AND UTILITY DETAILS**





HOWARD, NEEDLES, TAMMEN & BERGENDOFF  
 consulting engineers  
 NEW YORK ALEXANDRIA KANSAS CITY

SCALE: AS SHOWN

CONTRACT NO.: 9

SHEET NO. 11 OF 15



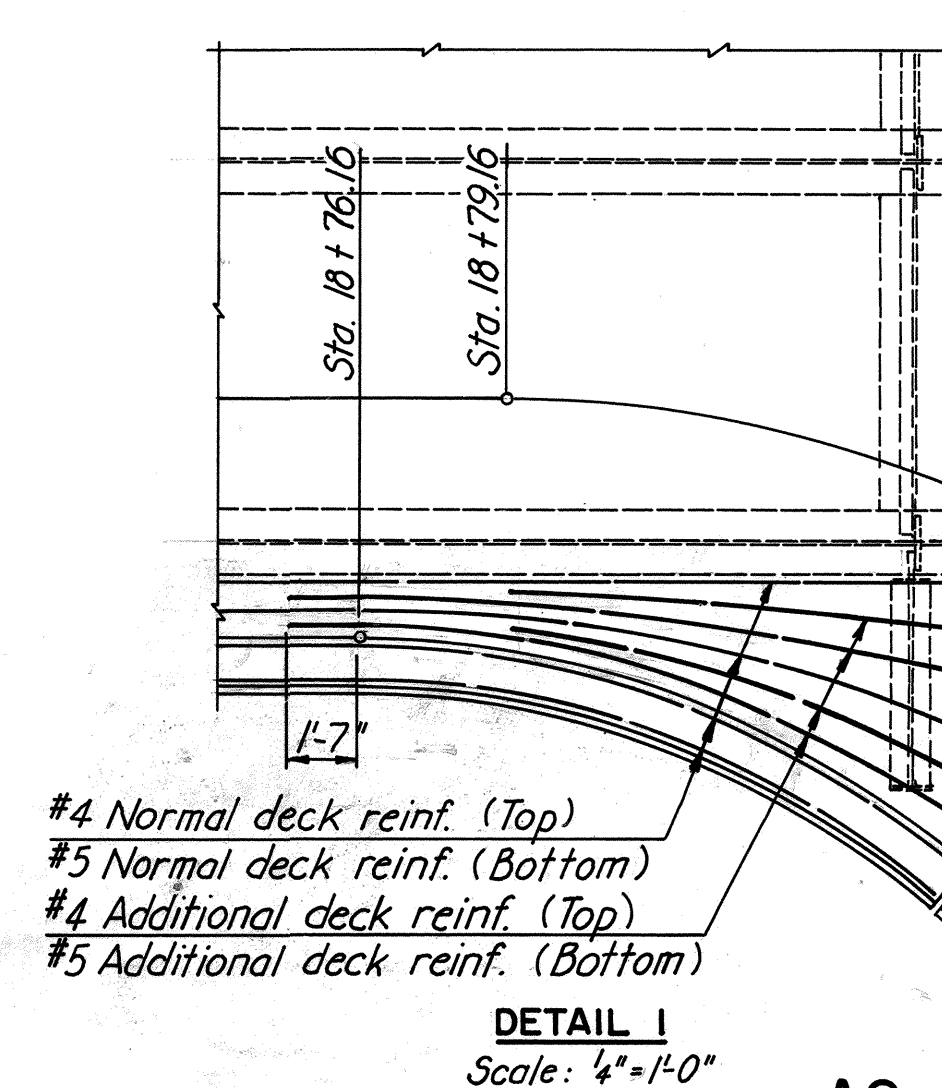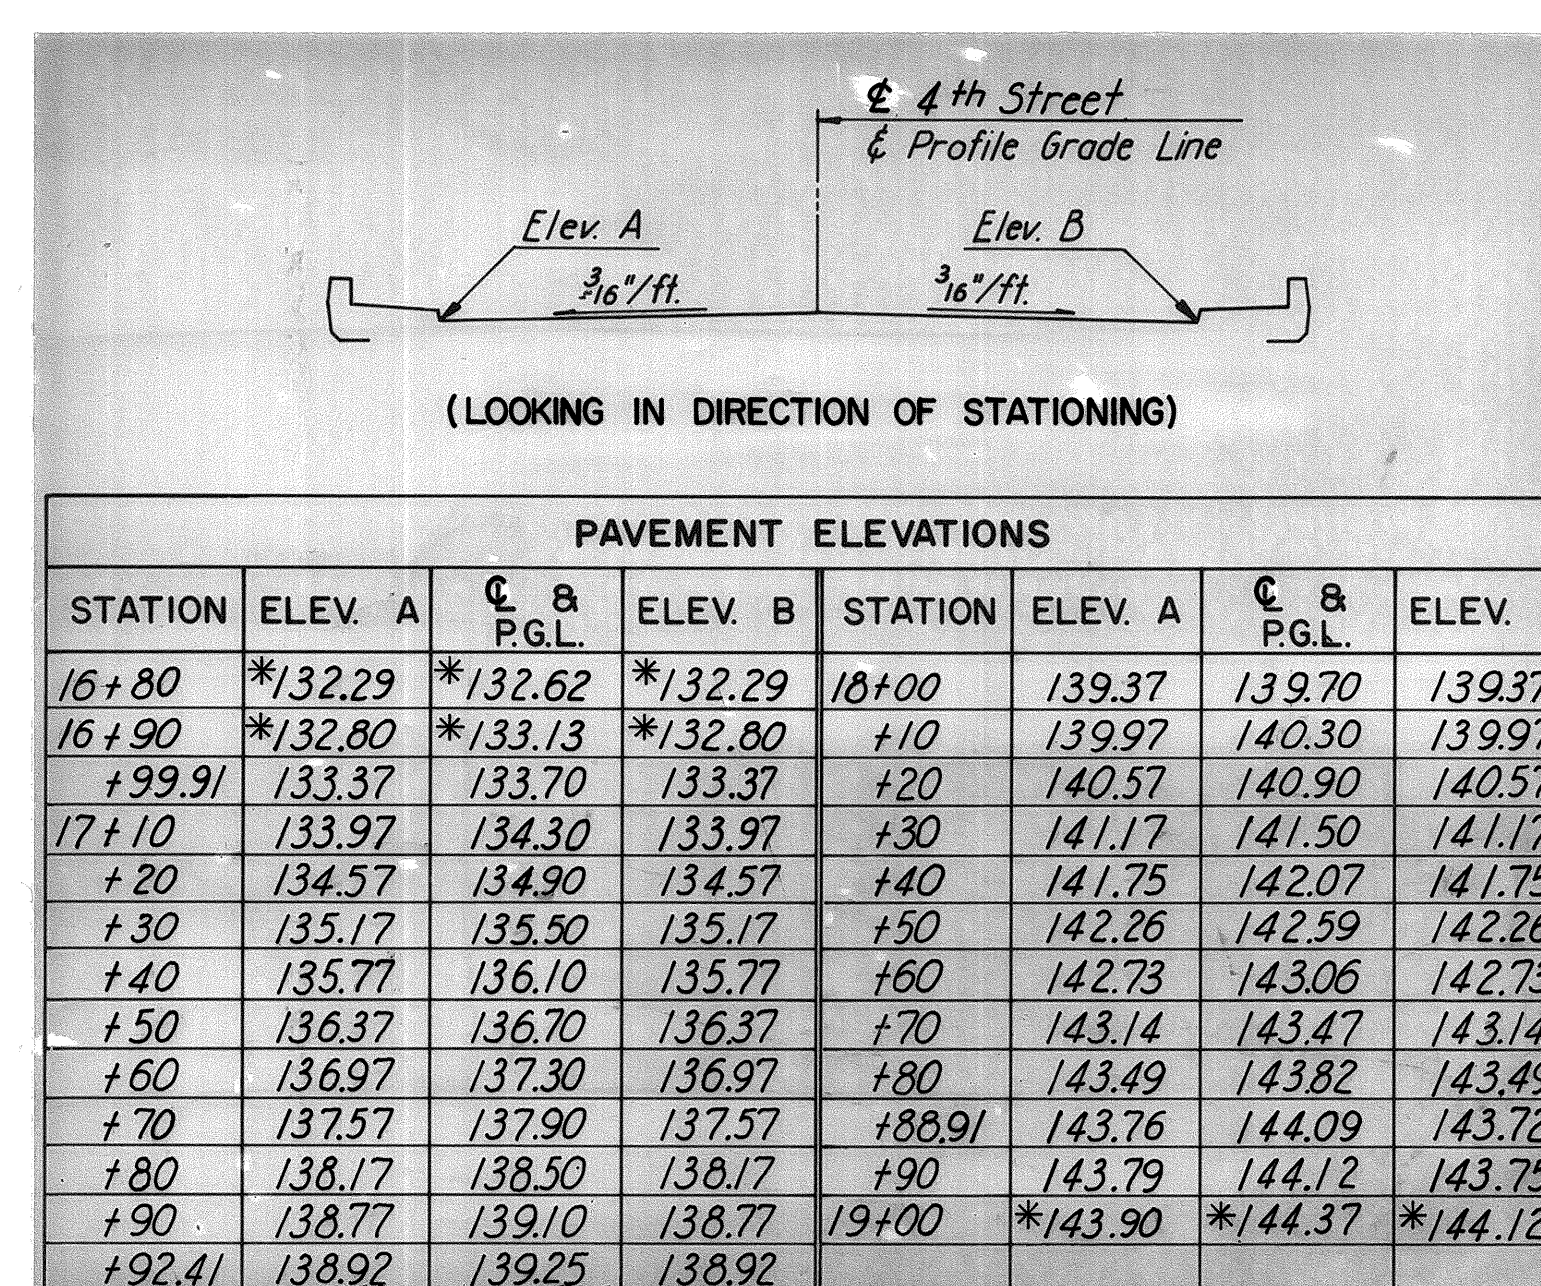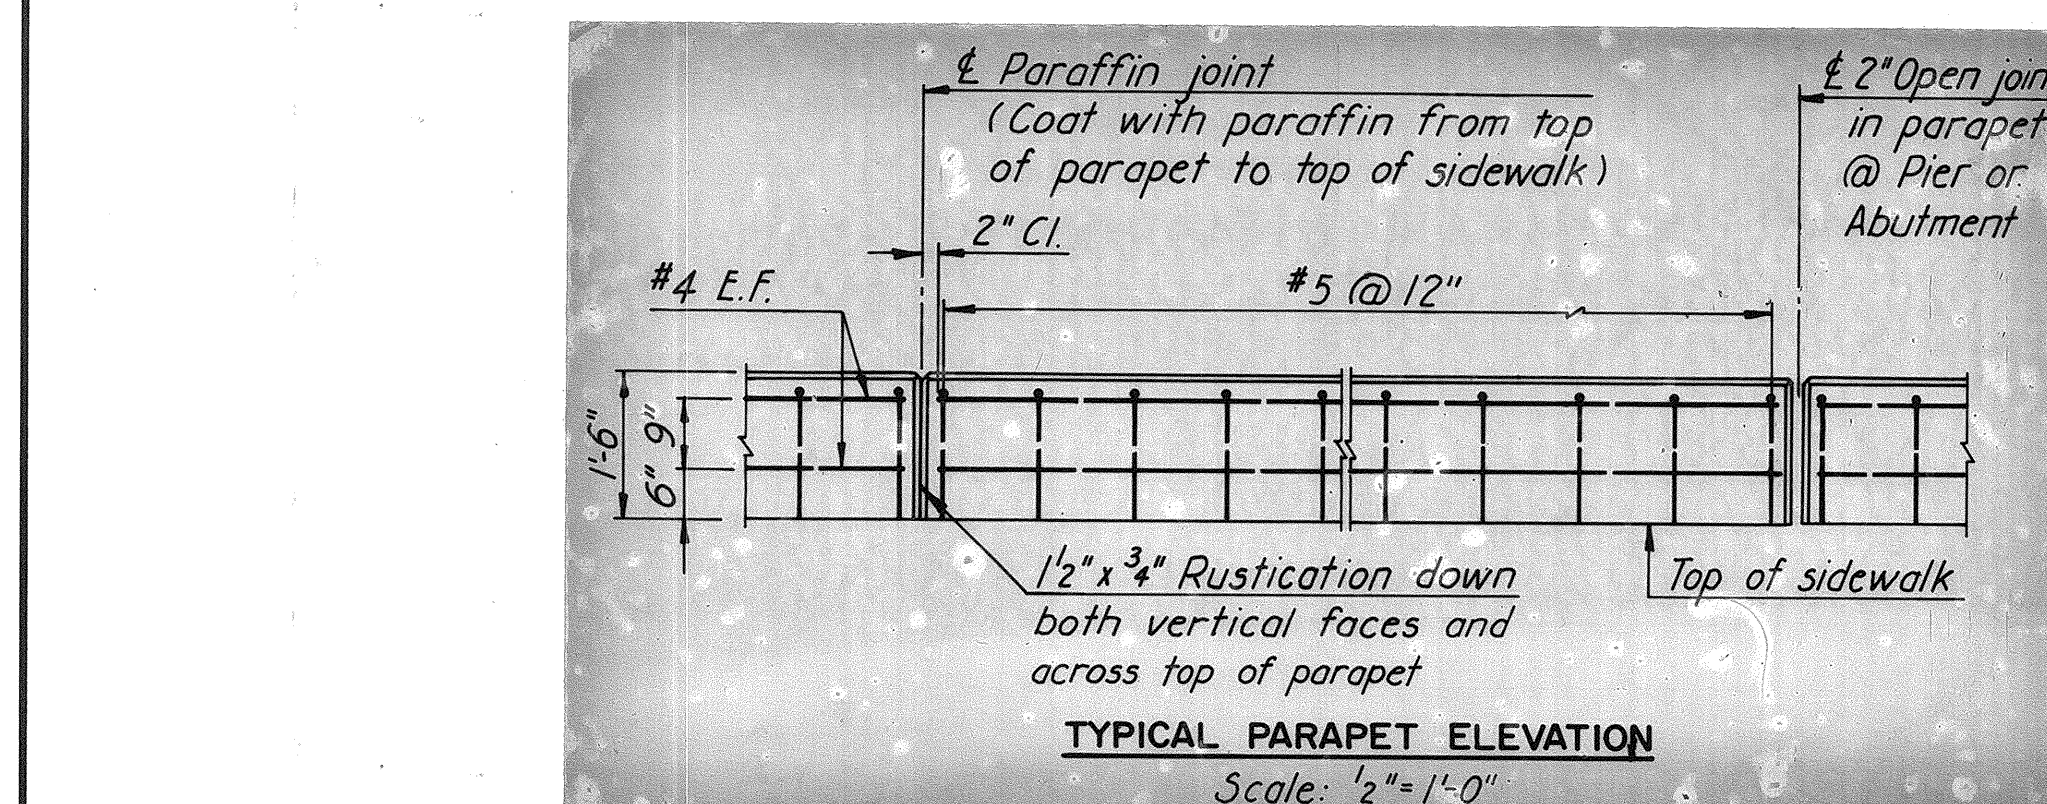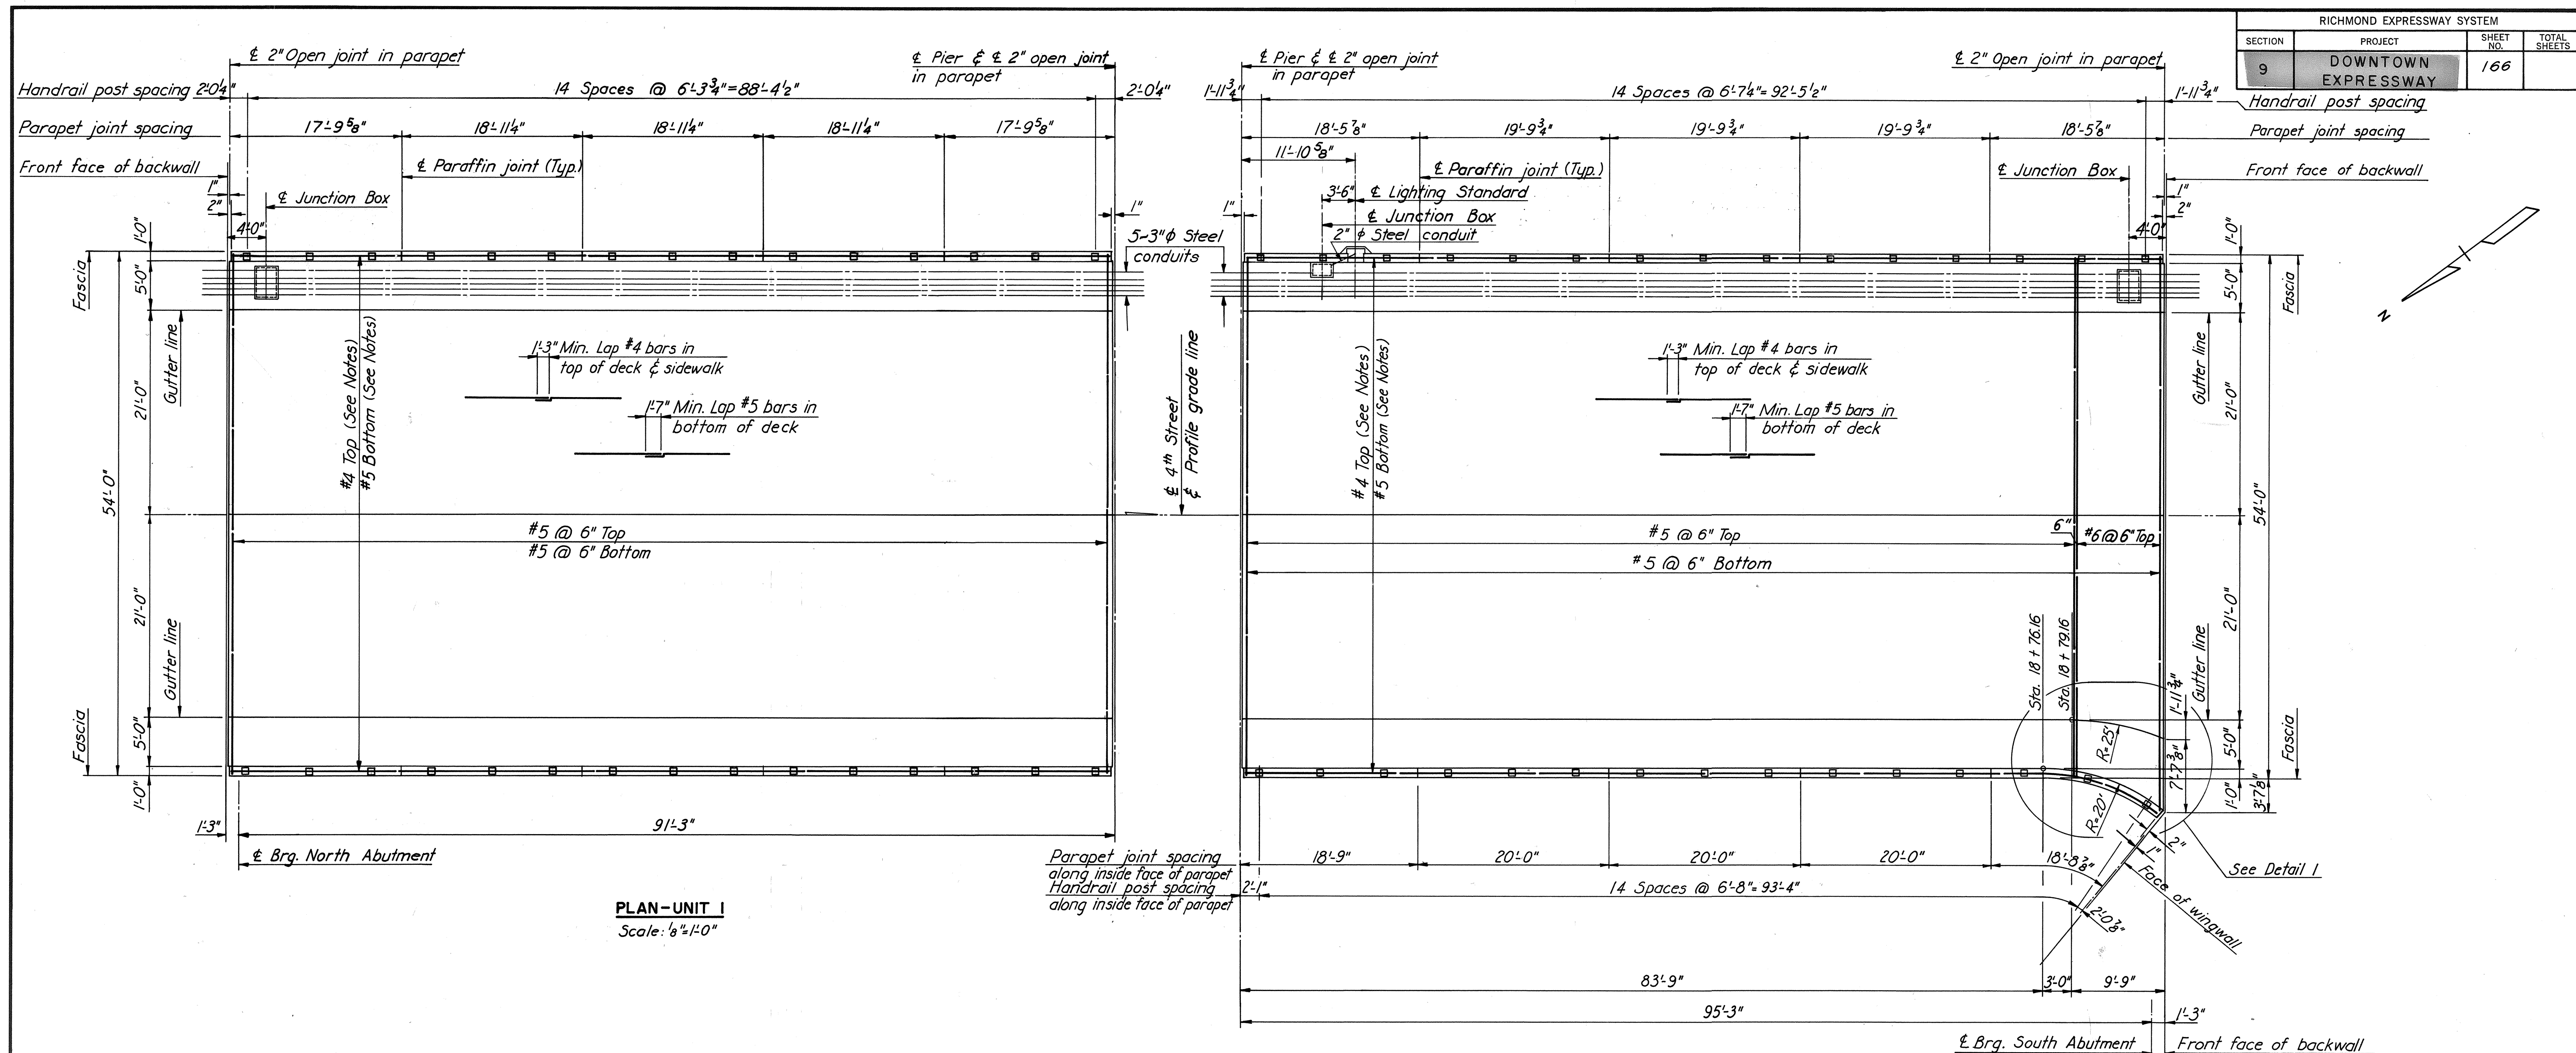

**NOTES:**

*For location and spacing of deck, parapet and sidewalk reinforcing, see Cross Section and Utility Details sheet.*

*For location and spacing of reinforcing in haunch over end diaphragms, see Joint Details sheet.*

*For lighting standard base, junction box details and additional reinforcing, see Standard Electrical Details sheet S4.*

	BY	DATE				
MADE	<i>L.B.P.</i>	<i>9-67</i>				
CHECKED	<i>TEM</i>	<i>2-68</i>	<i>1</i>	<i>As Built</i>	<i>TEM</i>	<i>7-77</i>
IN CHARGE	<i>PRY</i>		NO.	REVISION	BY	DATE

**RICHMOND METROPOLITAN AUTHORITY**  
**RICHMOND EXPRESSWAY SYSTEM**  
**DOWNTOWN EXPRESSWAY**

**BRIDGE B-56**

**4TH STREET OVER**  
**DOWNTOWN EXPRESSWAY**

**DECK PLANS**


HOWARD, NEEDLES, TAMMEN & BERGENDOFF consulting engineers NEW YORK      ALEXANDRIA      KANSAS CITY	SCALE: <u>AS SHOWN</u> CONTRACT NO.: <u>9</u> SHEET NO. <u>12</u> OF <u>15</u>
---	--







RICHMOND EXPRESSWAY SYSTEM			
SECTION	PROJECT	SHEET NO.	TOTAL SHEETS
9	DOWNTOWN EXPRESSWAY	168	

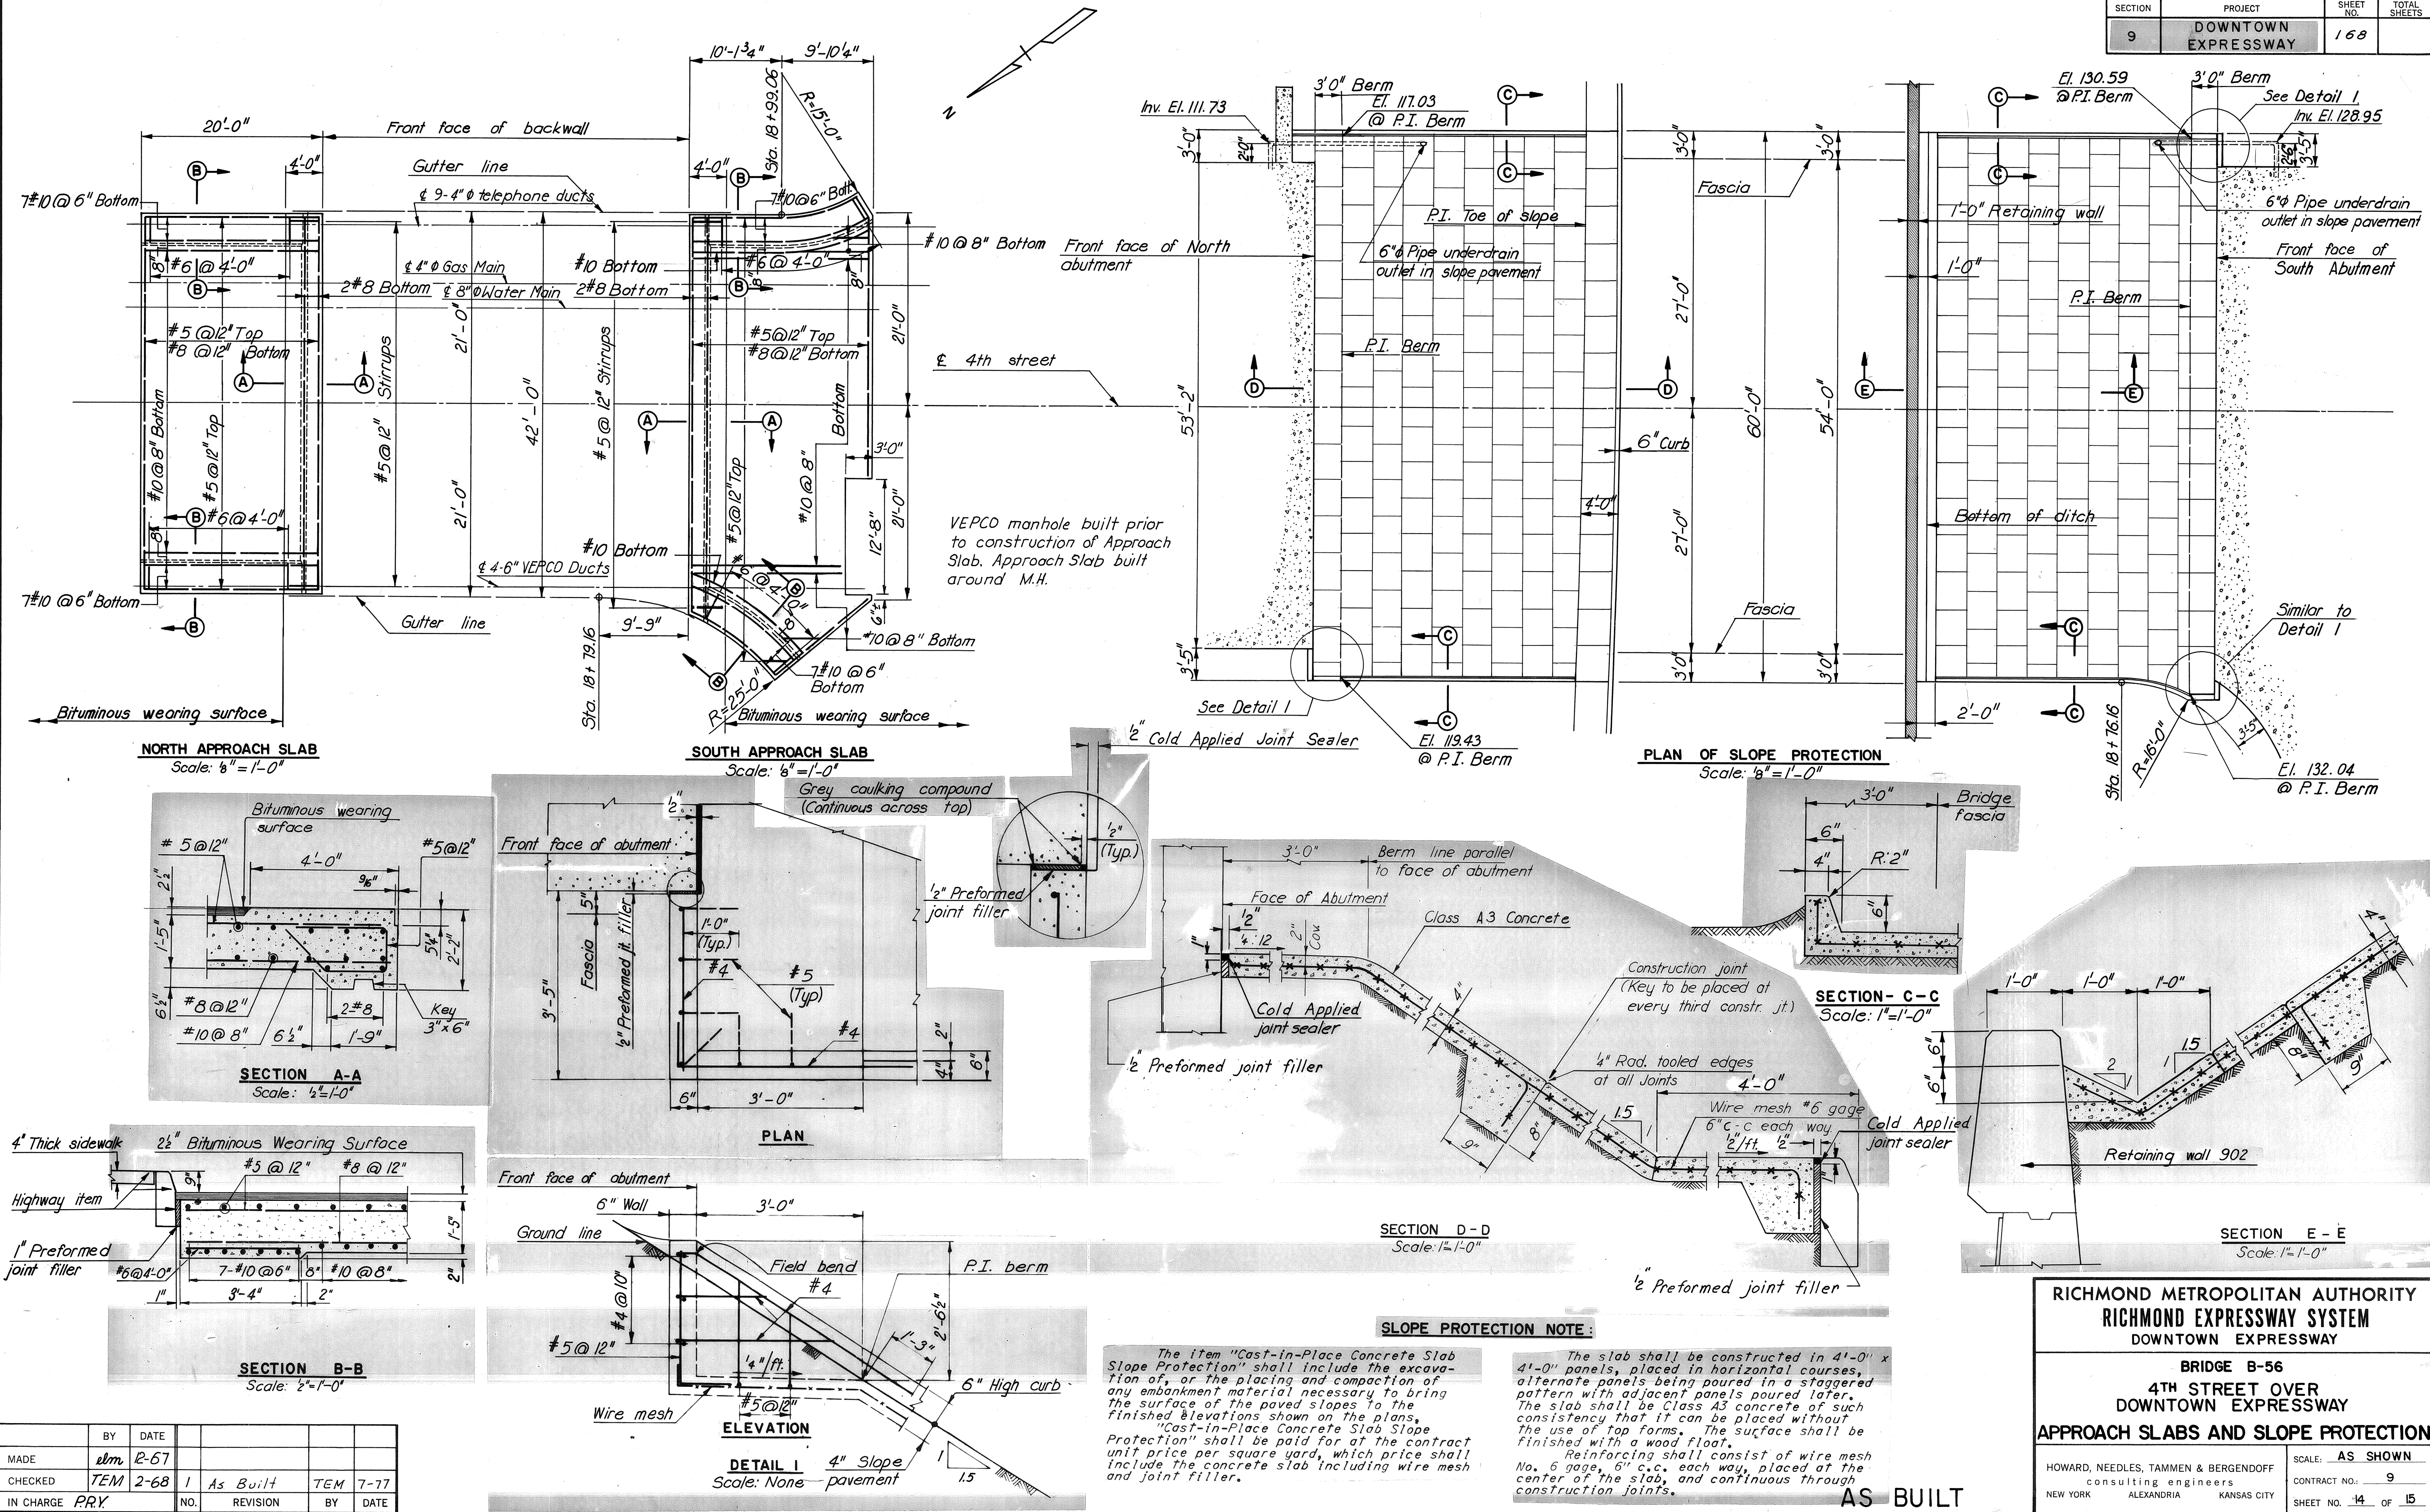

BY	DATE				
MADE	elm	2-67			
CHECKED	TEM	2-68	1	As Built	TEM 7-77
IN CHARGE	PRY		NO.	REVISION	BY DATE

RICHMOND METROPOLITAN AUTHORITY			
RICHMOND EXPRESSWAY SYSTEM			
DOWNTOWN EXPRESSWAY			
BRIDGE B-56			
4TH STREET OVER			
DOWNTOWN EXPRESSWAY			
APPROACH SLABS AND SLOPE PROTECTION			
HOWARD, NEEDLES, TAMMEN & BERGENDOFF consulting engineers NEW YORK ALEXANDRIA KANSAS CITY		SCALE: AS SHOWN CONTRACT NO. 9 SHEET NO. 14 OF 15	







# **Bridge 57**




**(South 5th Street  
Over Downtown Expressway {Rte. 195})**

**Record Set Plans**



RICHMOND EXPRESSWAY SYSTEM			
SECTION	PROJECT	SHEET NO.	TOTAL SHEETS
9	DOWNTOWN EXPRESSWAY	170	

INDEX	
NO.	DESCRIPTION
1	General Plan and Elevation
2	General Notes and Quantities
3	North Abutment
4	North Abutment Details (1)
5	North Abutment Details (2)
6	South Abutment
7	South Abutment Details (1)
8	South Abutment Details (2)
9	Pier
10	Framing Plan
11	Cross Section and Utility Details
12	Deck Plans
13	Joint Details
14	Approach Slabs and Slope Protection
15	Boring Logs
S1	Standard Shoe Details
S3	Standard Aluminum Railing Details (2 Rails)
S4	Standard Electrical Details (Bridges Carrying City Streets)
S7	Standard Architectural Details
S8	Standard Architectural Details
S9	Standard Architectural Details
S10	Standard Conduit Installation Details
S11	Standard Utility Support Details at Bridge Abutments

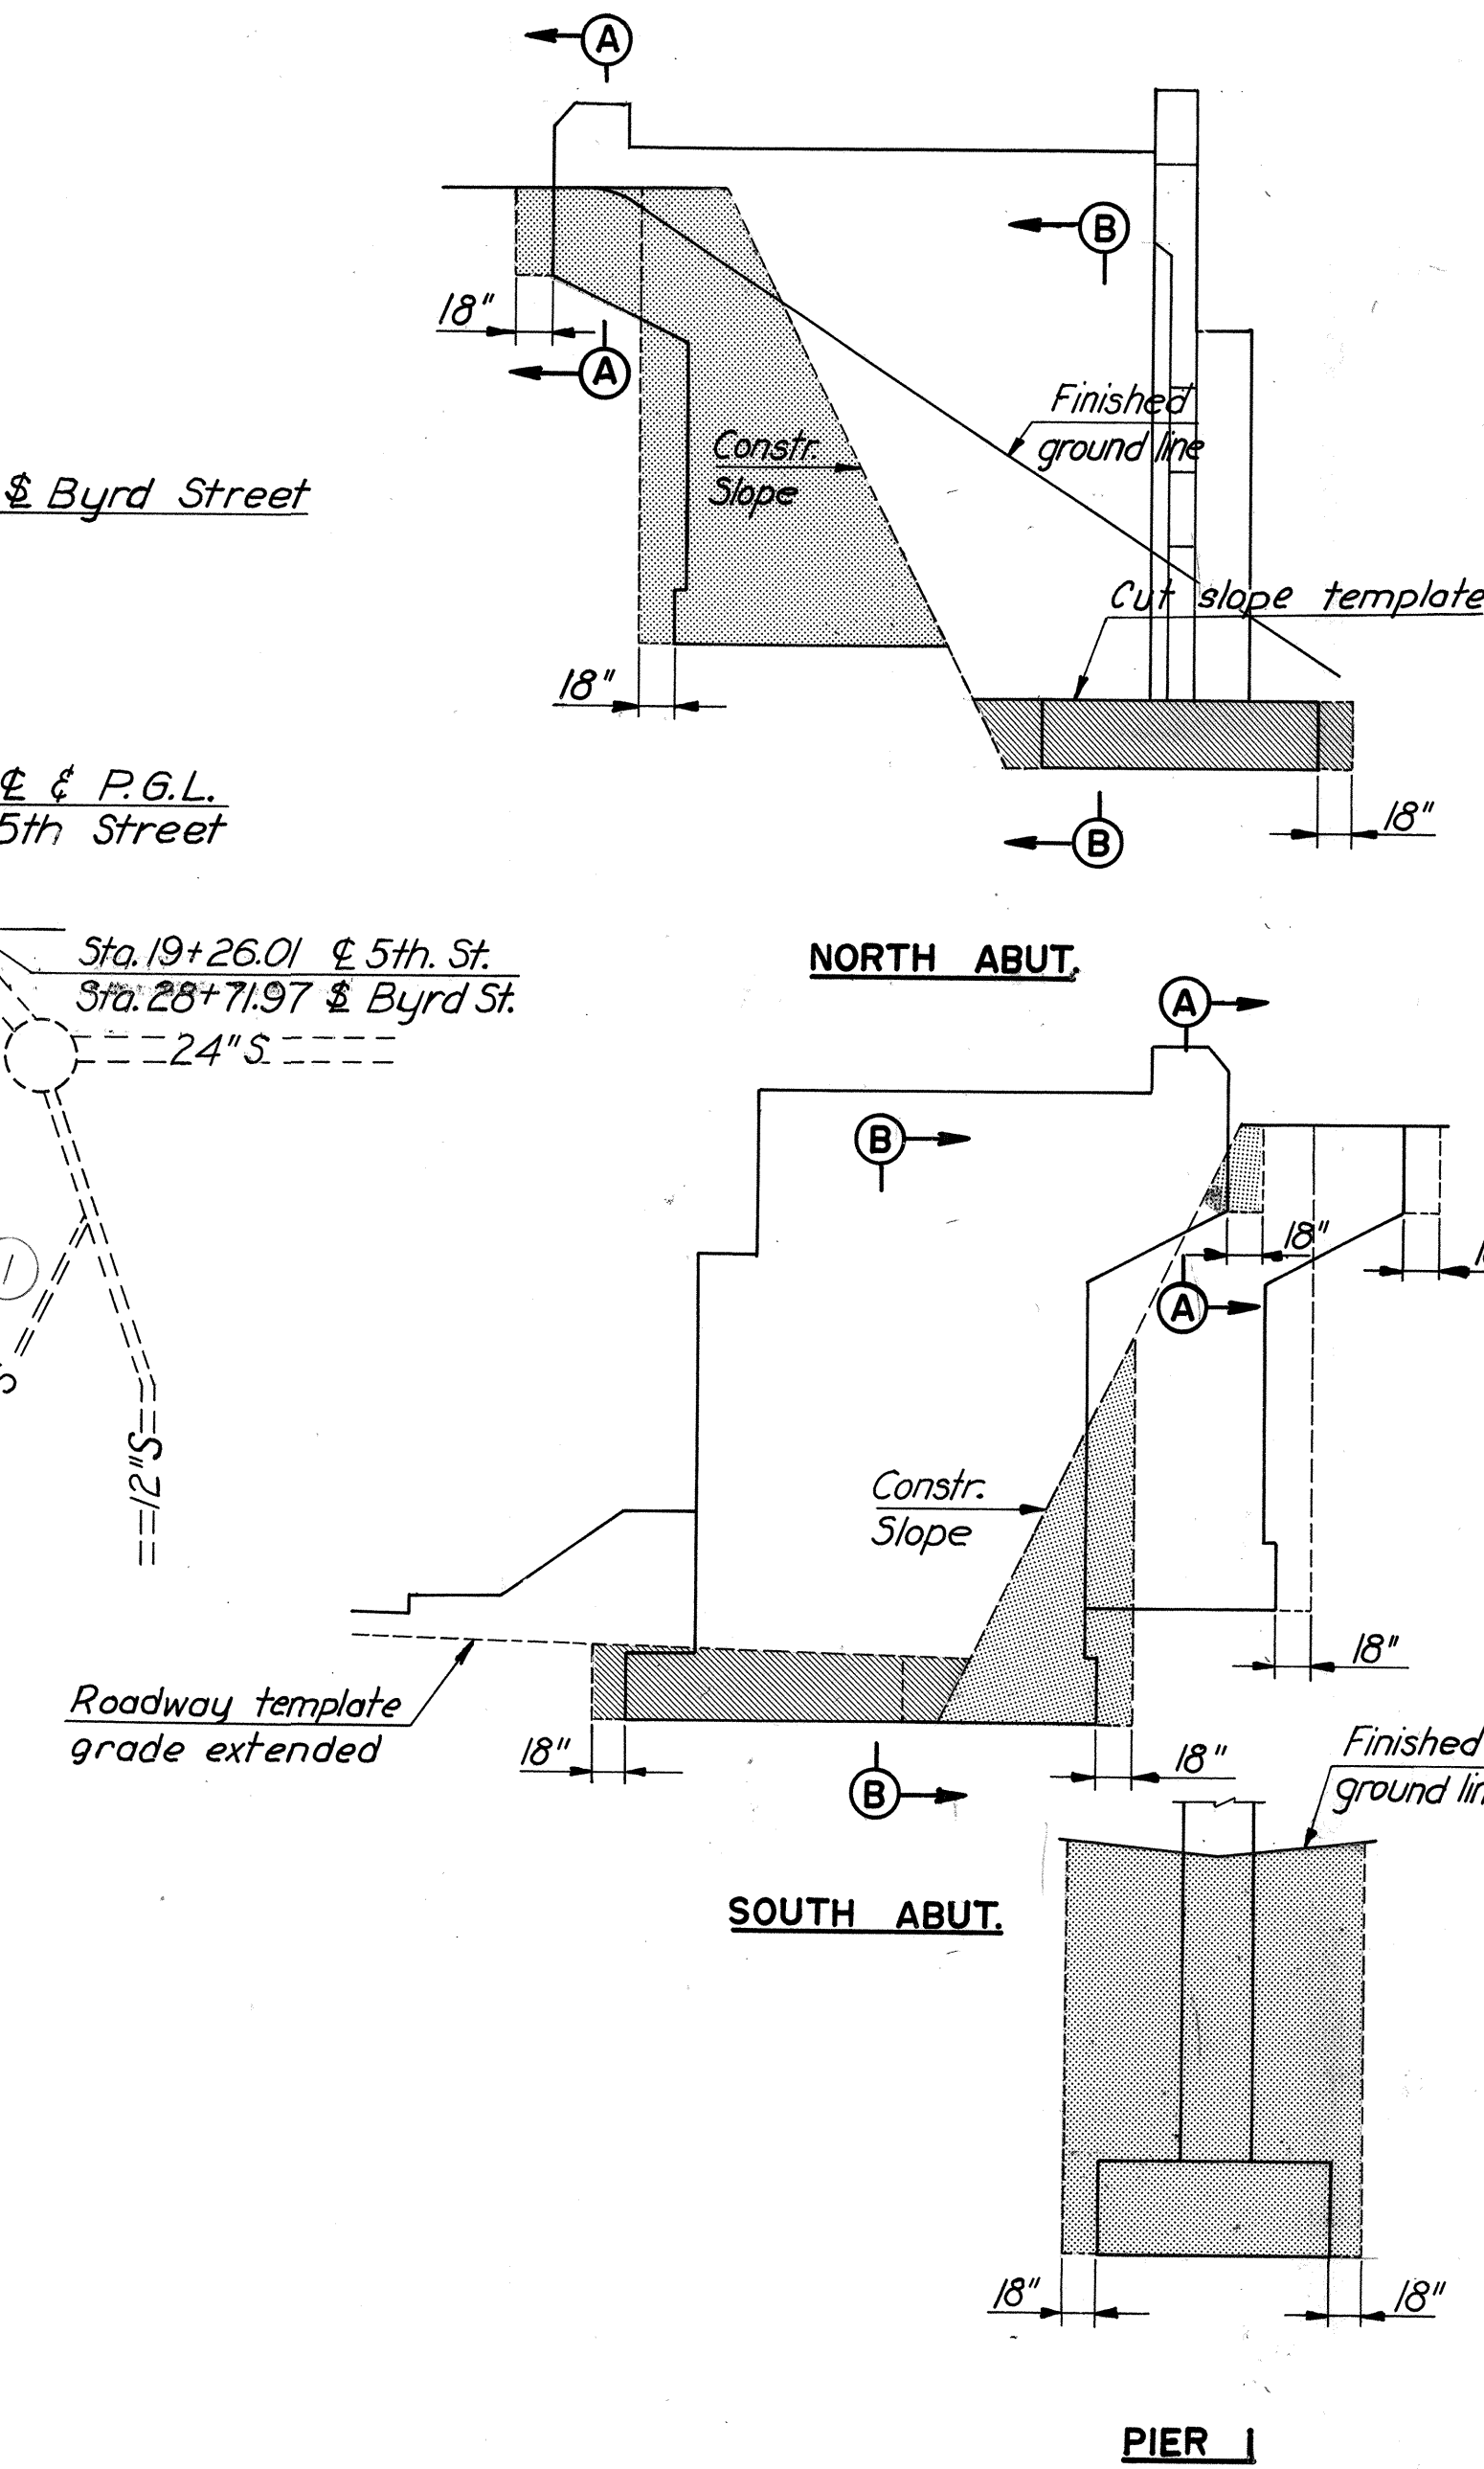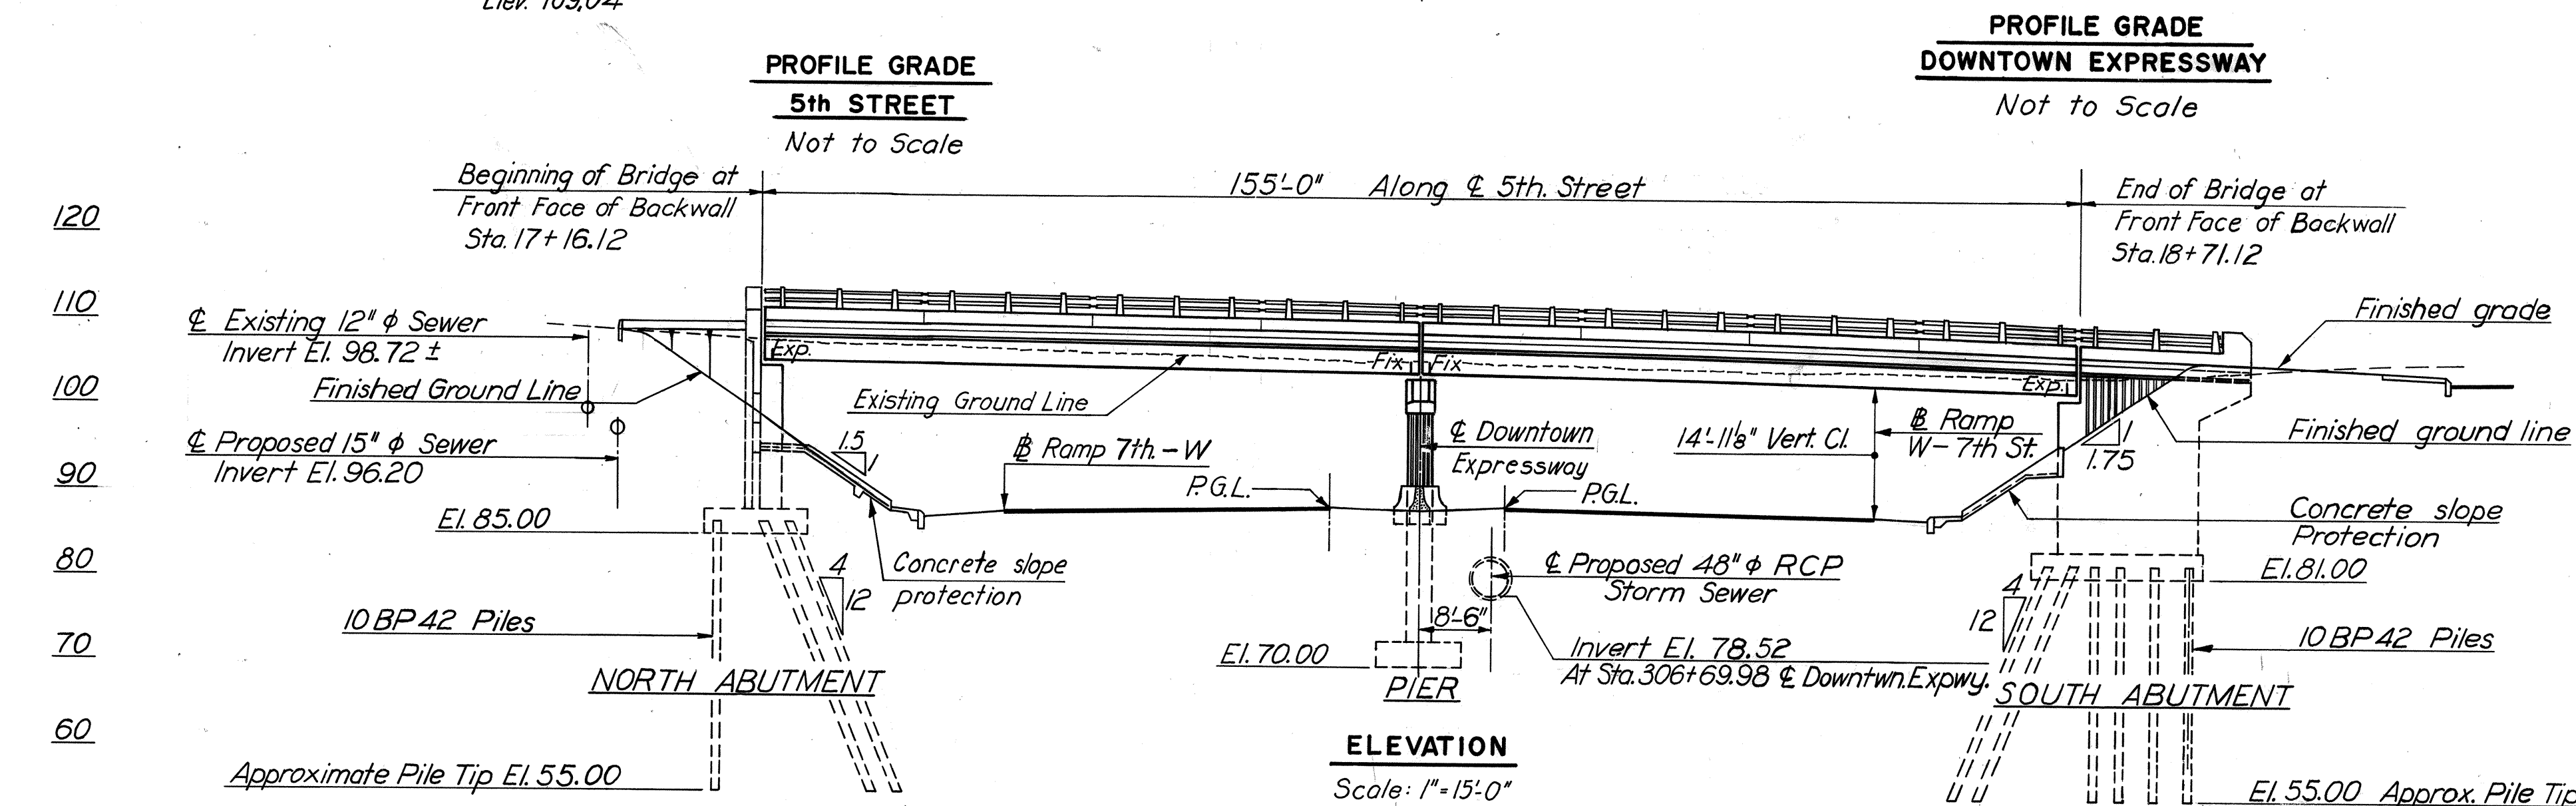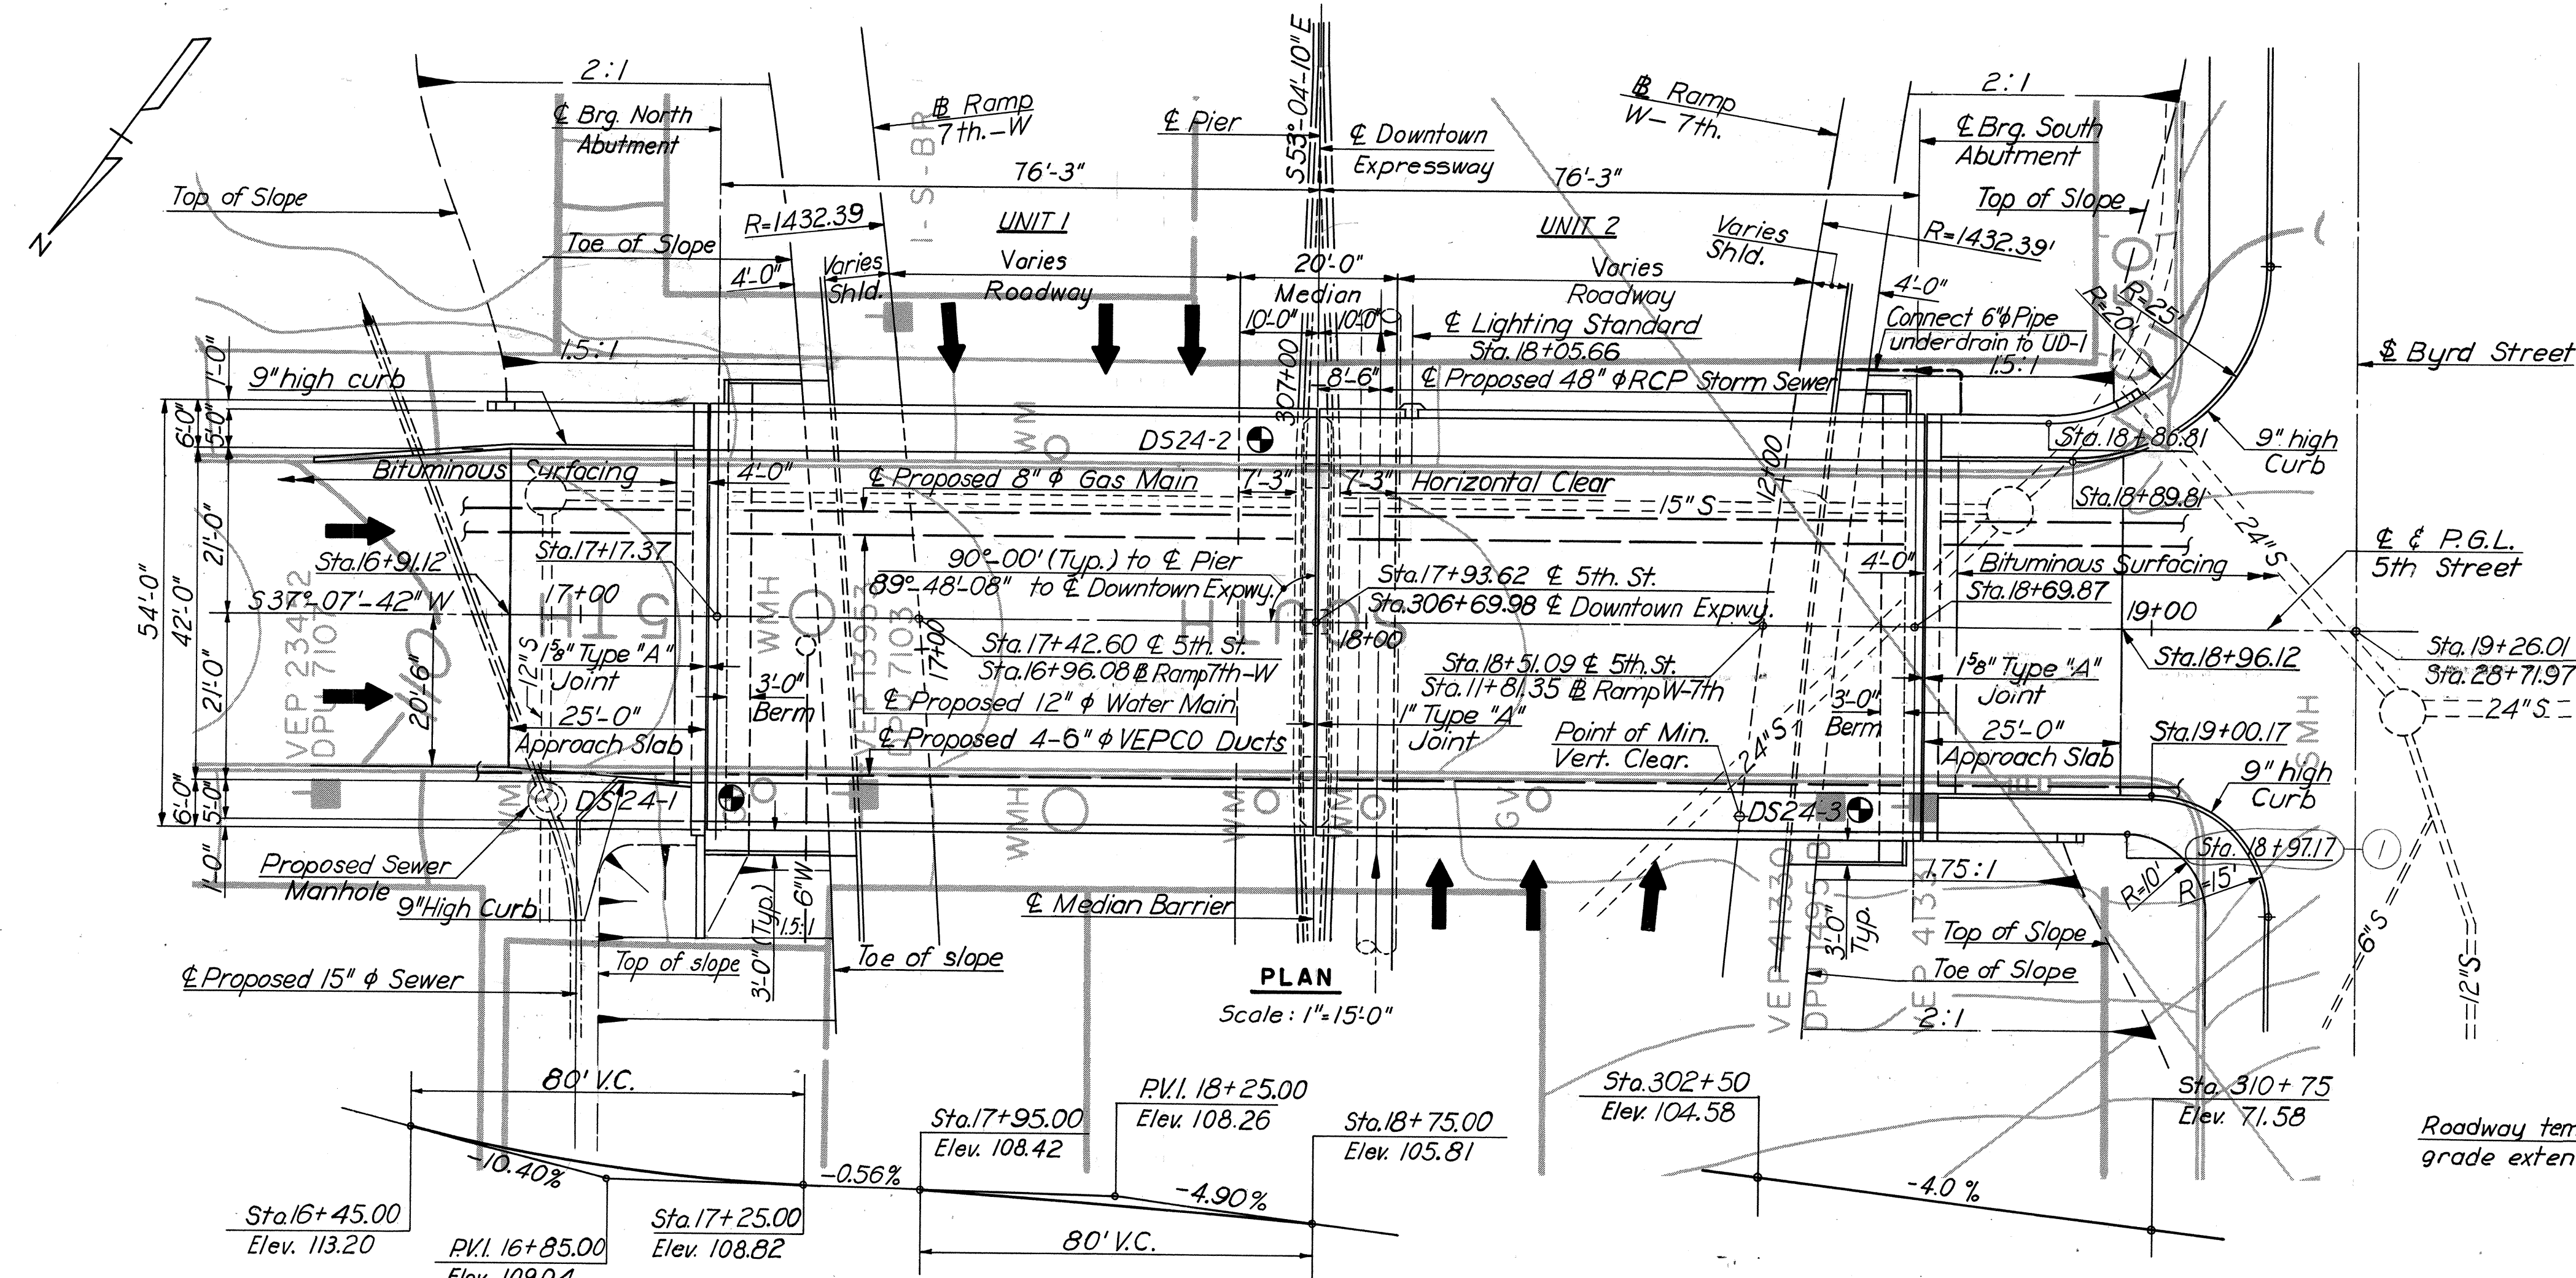

**PAYMENT LIMITS FOR STRUCTURE EXCAVATIONS**  
No Scale

**BORINGS:** Indicates location of 2 1/2" cased hole boring. For boring data, see Boring Logs sheet.  
**NOTE:** For General Notes and Quantities, see next sheet.

**RICHMOND METROPOLITAN AUTHORITY**  
**RICHMOND EXPRESSWAY SYSTEM**  
**DOWNTOWN EXPRESSWAY**  
**BRIDGE B-57**  
**5TH STREET OVER**  
**DOWNTOWN EXPRESSWAY**  
**GENERAL PLAN AND ELEVATION**

HOWARD, NEEDLES, TAMMEN & BERGENDOFF  
consulting engineers  
NEW YORK ALEXANDRIA KANSAS CITY

SCALE: AS SHOWN  
CONTRACT NO.: 9  
SHEET NO. 1 OF 15

BY	DATE				
MADE	JBM	1-68			
CHECKED	TEM	2-68	1	As Built	TEM 7-77
IN CHARGE	PRK				

AS BUILT















RICHMOND EXPRESSWAY SYSTEM			
SECTION	PROJECT	SHEET NO.	TOTAL SHEETS
9	DOWNTOWN EXPRESSWAY	181	

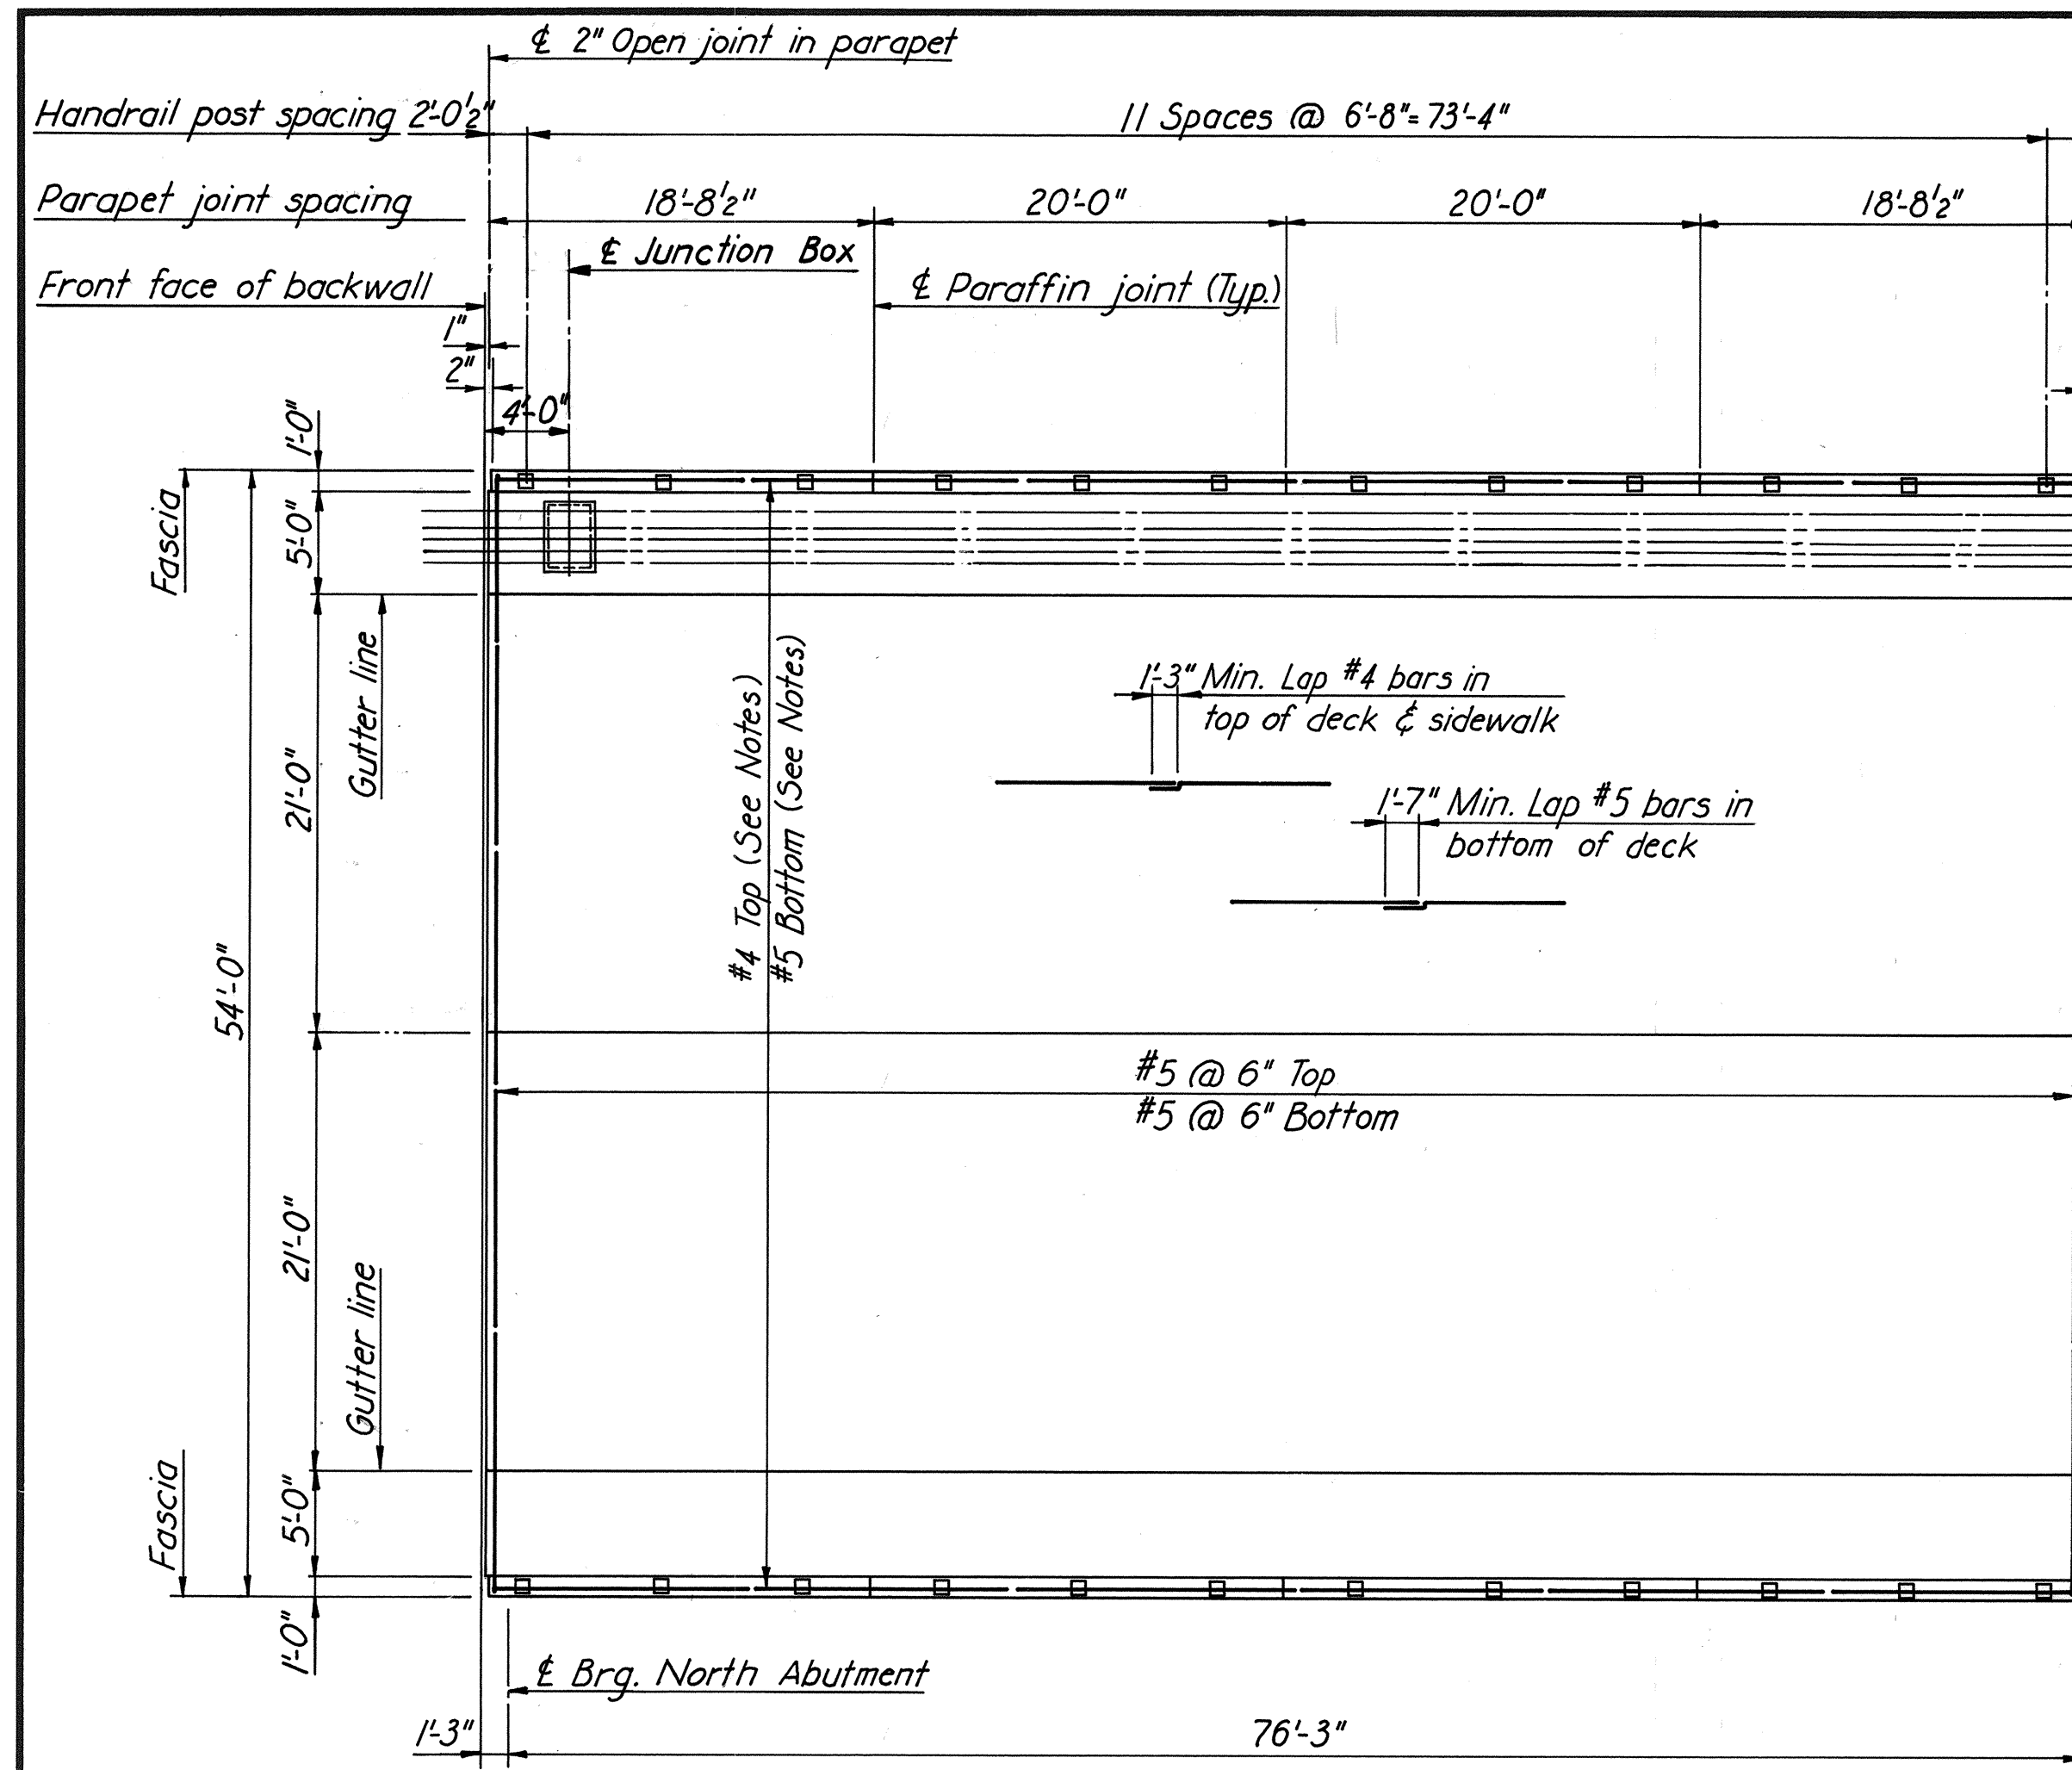

**PLAN-UNIT 1**  
Scale: 1/8"=1'-0"

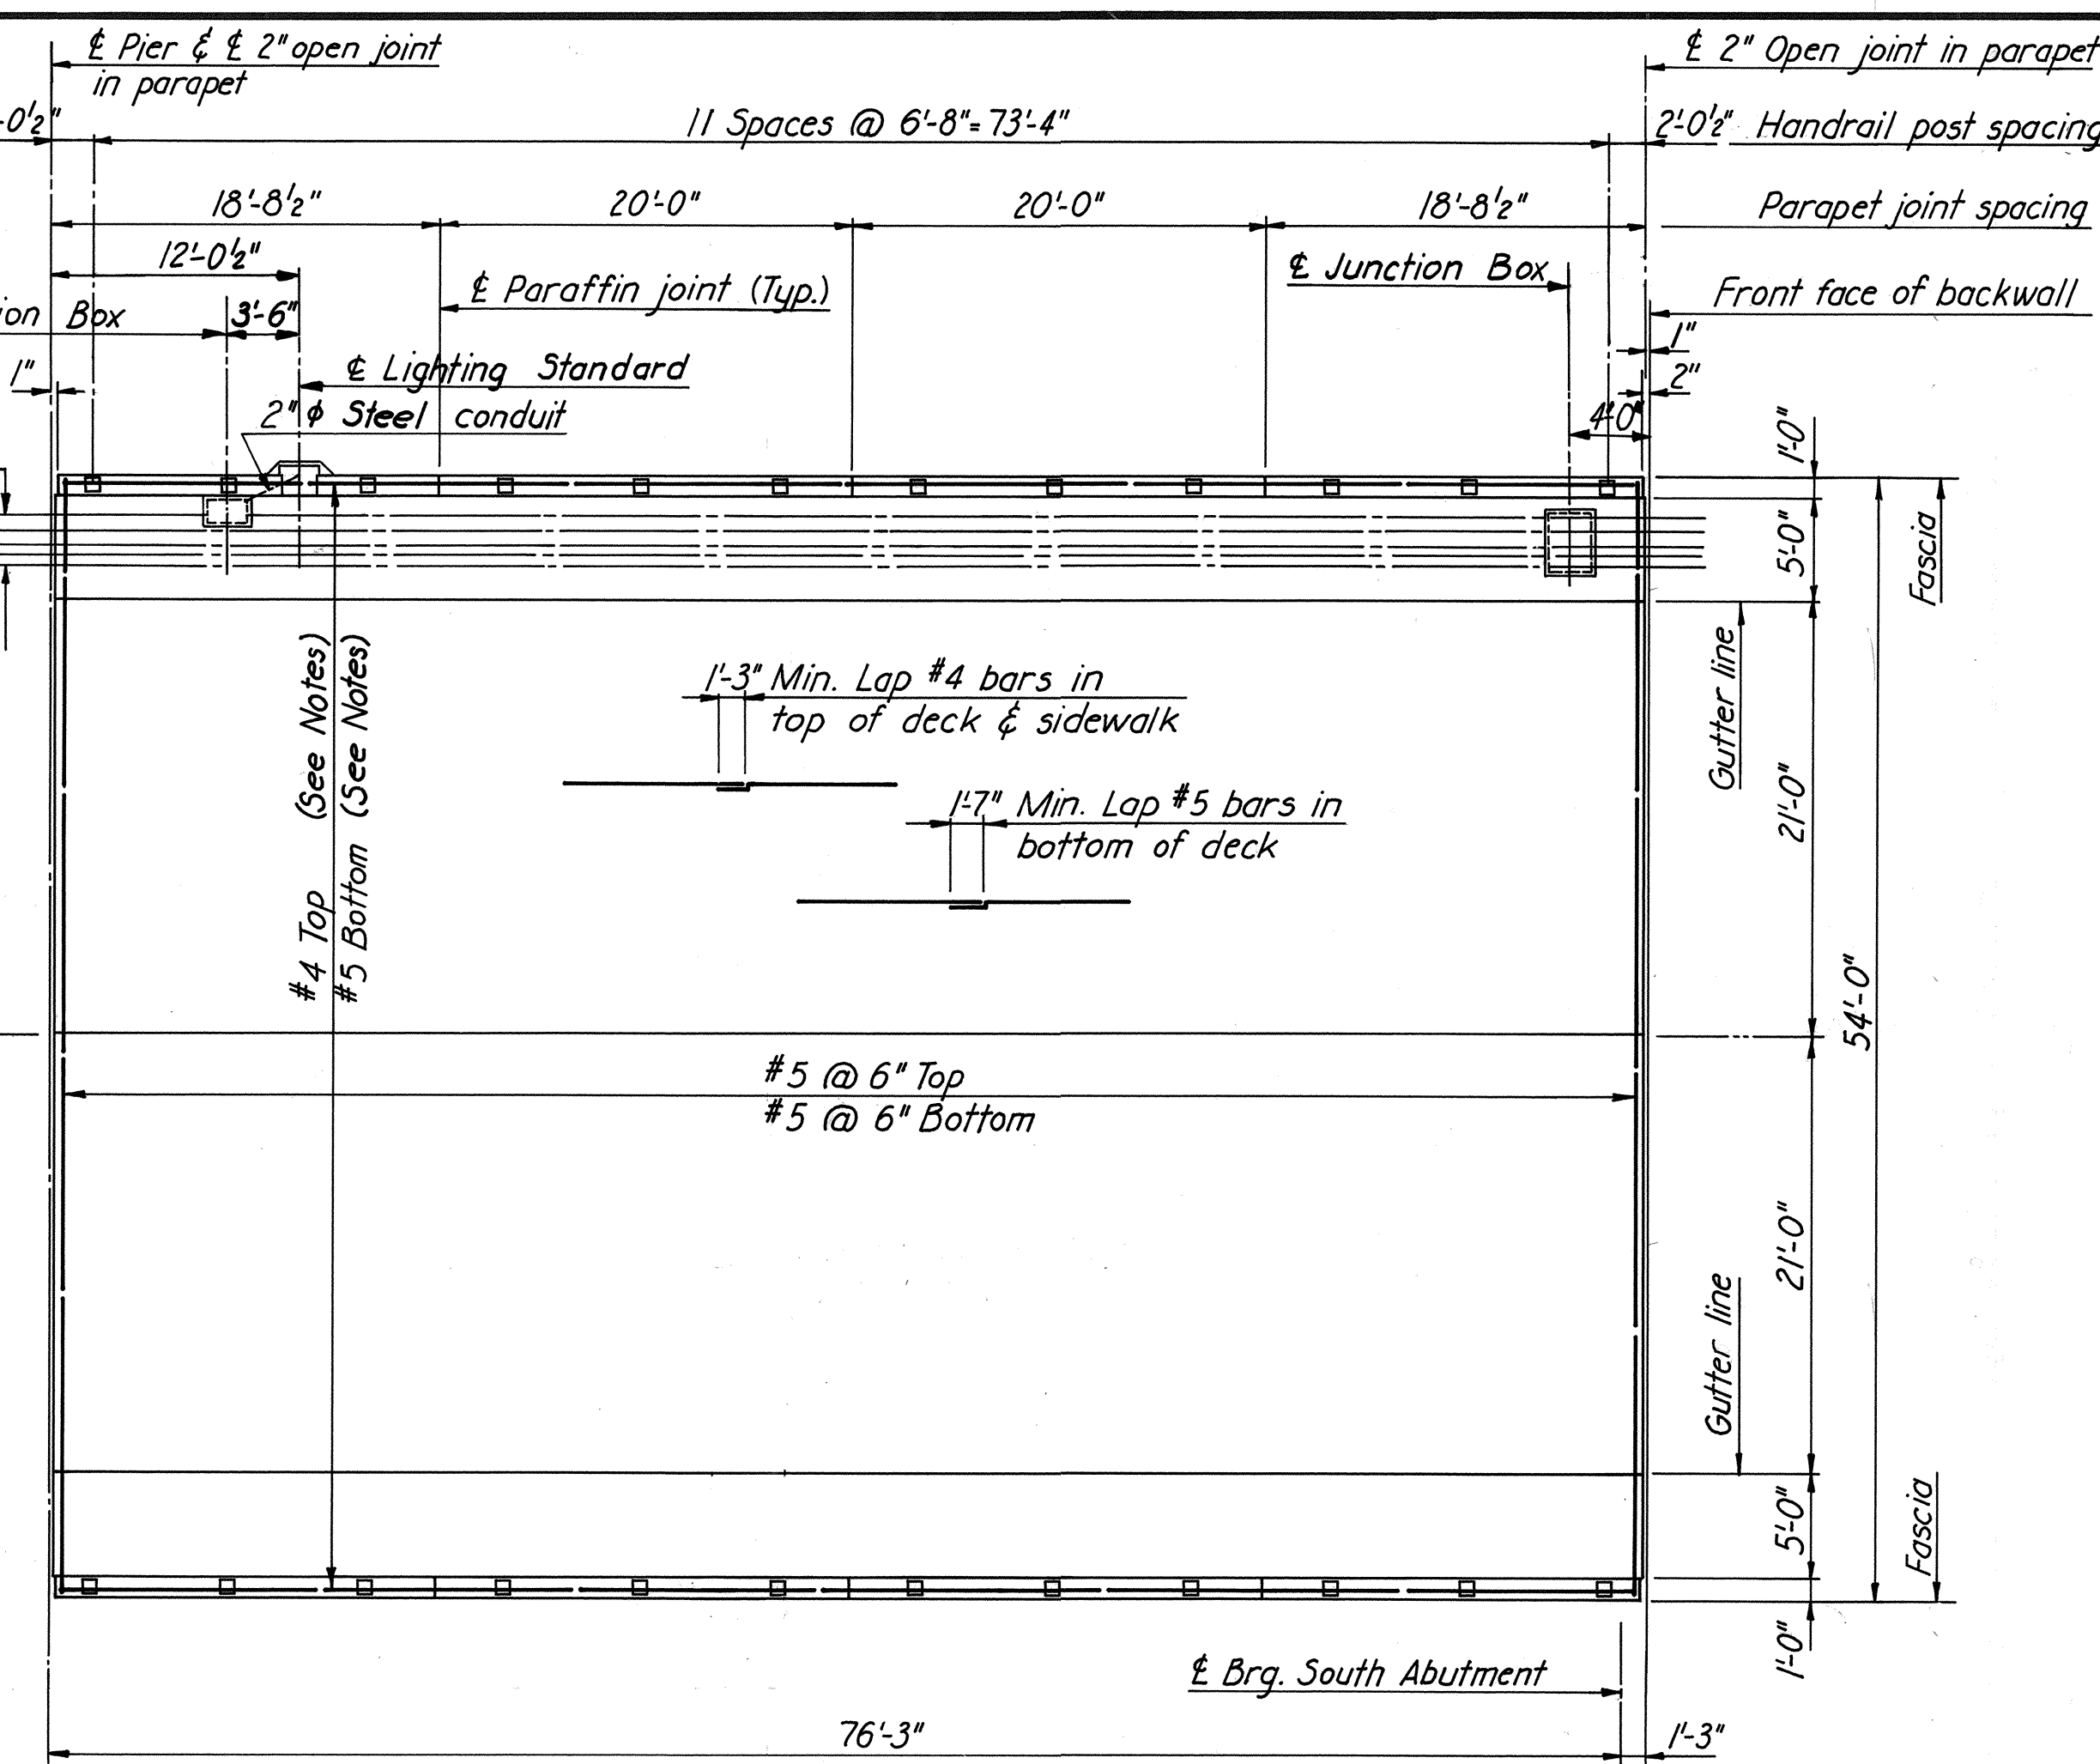

**PLAN-UNIT 2**  
Scale: 1/8"=1'-0"

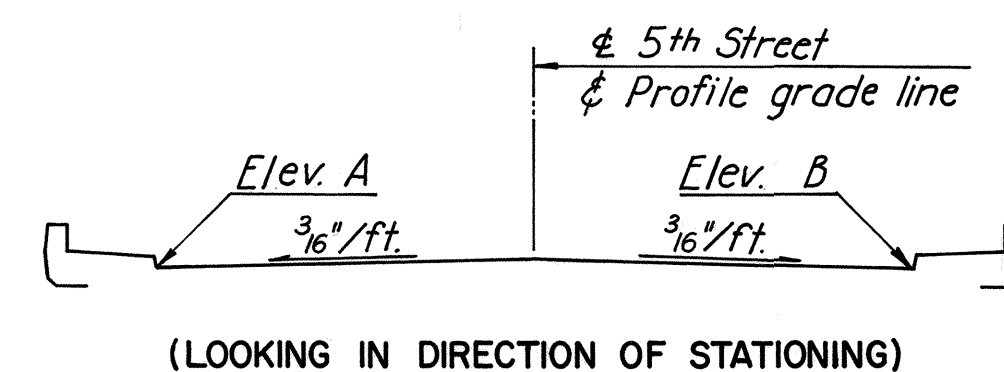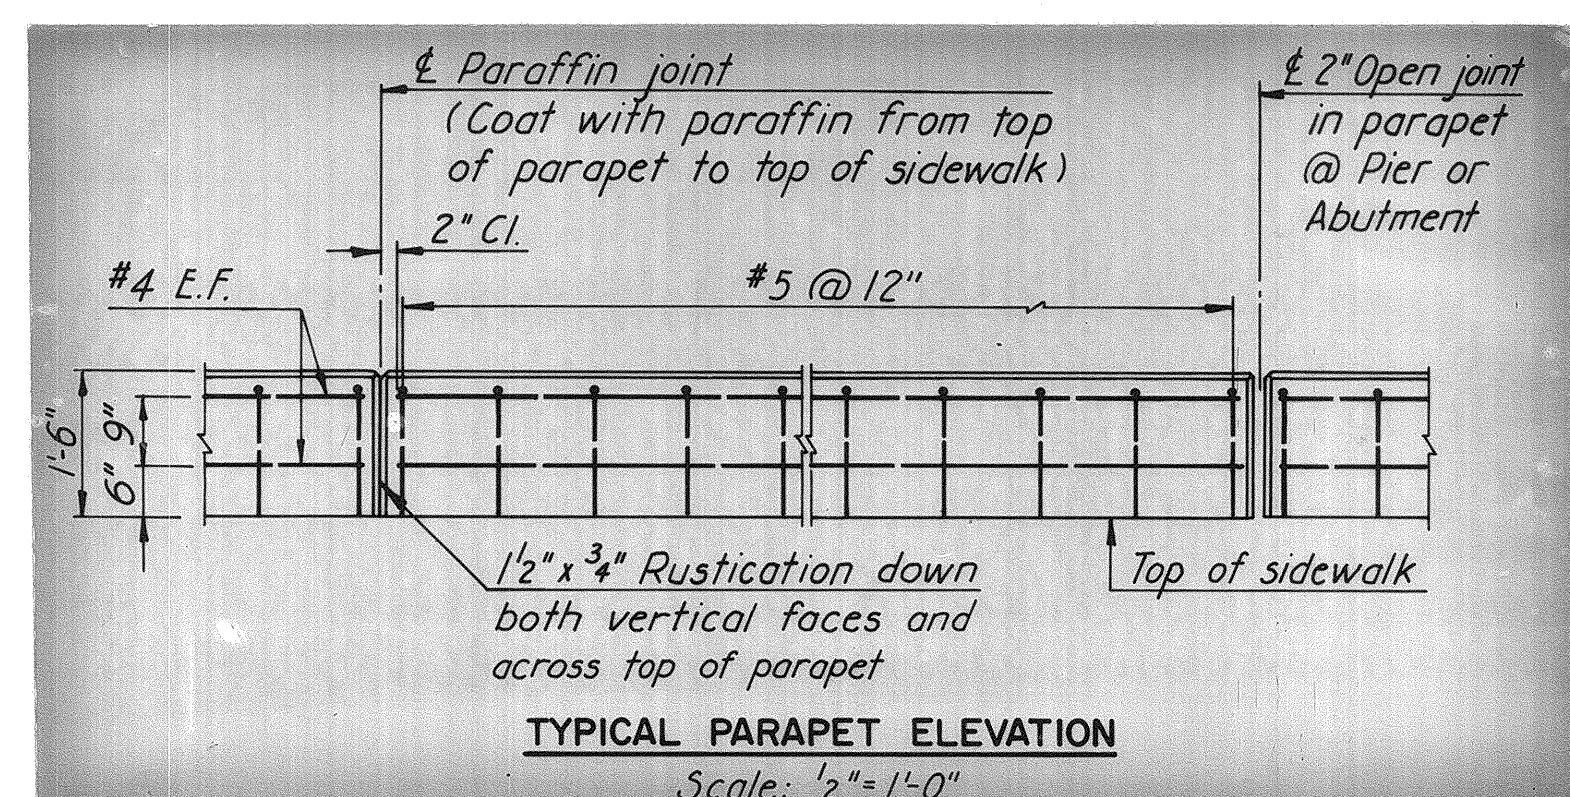

PAVEMENT ELEVATIONS							
STATION	ELEV. A	ELEV. B	STATION	ELEV. A	ELEV. B	STATION	ELEV. A
16+90	—	*109.77	18+00	108.06	108.39	108.06	
17+00	*109.01	*109.34	+10	107.92	108.25	107.92	
+10	*108.71	*109.04	+20	107.69	108.02	107.69	
+16.12	108.59	108.92	+30	107.38	107.71	107.38	
+20	108.53	108.86	+40	107.01	107.34	107.01	
+30	108.46	108.79	+50	106.61	106.94	106.61	
+40	108.40	108.73	+60	106.18	106.51	106.18	
+50	108.35	108.68	+70	105.72	106.05	105.72	
+60	108.29	108.62	+71.12	105.67	105.99	105.67	
+70	108.23	108.56	+80	*105.23	*105.56	*105.25	
+80	108.18	108.51	+90	*104.64	*105.07	*104.72	
+90	108.12	108.45	+90	—	*104.58	—	
+93.62	108.10	108.43	108.10				

\* Elevations shown are given to top of bituminous surfacing.

**NOTES:**

For location and spacing of deck, parapet and sidewalk reinforcing, see Cross Section and Utility Details sheet.

For location and spacing of reinforcing in haunch over end diaphragms, see Joint Details sheet.


For lighting standard base, junction box details and additional reinforcing, see Standard Electrical Details sheet S4.

BY	DATE				
MADE	A.B.P.	9-67			
CHECKED	TEM	2-68	1	As Built	TEM 1-77
IN CHARGE	PRY		NO.	REVISION	BY DATE


RICHMOND METROPOLITAN AUTHORITY	
RICHMOND EXPRESSWAY SYSTEM	
DOWNTOWN EXPRESSWAY	
BRIDGE B-57	
5TH STREET OVER	
DOWNTOWN EXPRESSWAY	
DECK PLANS	
HOWARD, NEEDLES, TAMMEN & BERGENDOFF consulting engineers NEW YORK ALEXANDRIA KANSAS CITY	SCALE: AS SHOWN CONTRACT NO.: 9 SHEET NO. 12 OF 15

AS BUILT




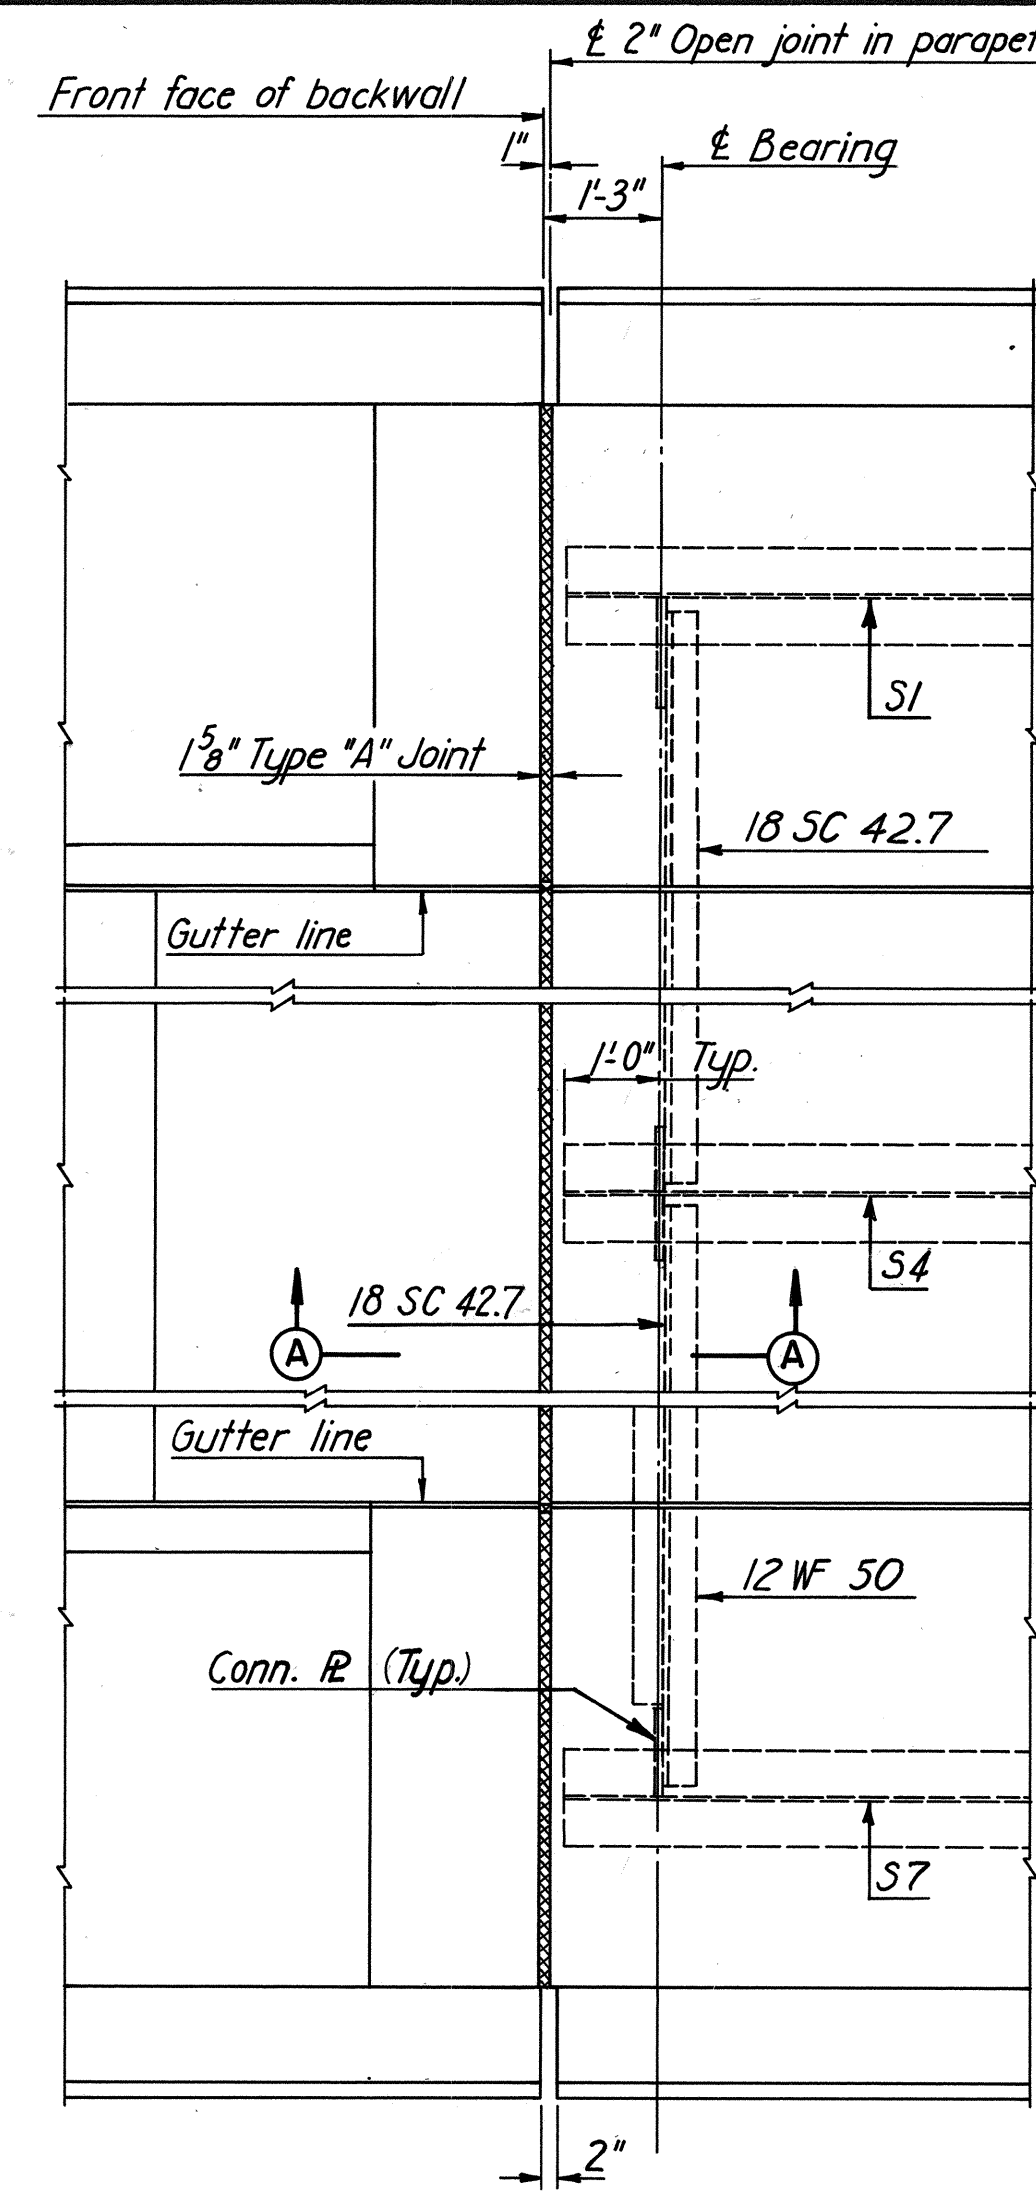


PLAN - JOINT AT NORTH ABUTMENT  
Scale: 1/2" = 1'-0"

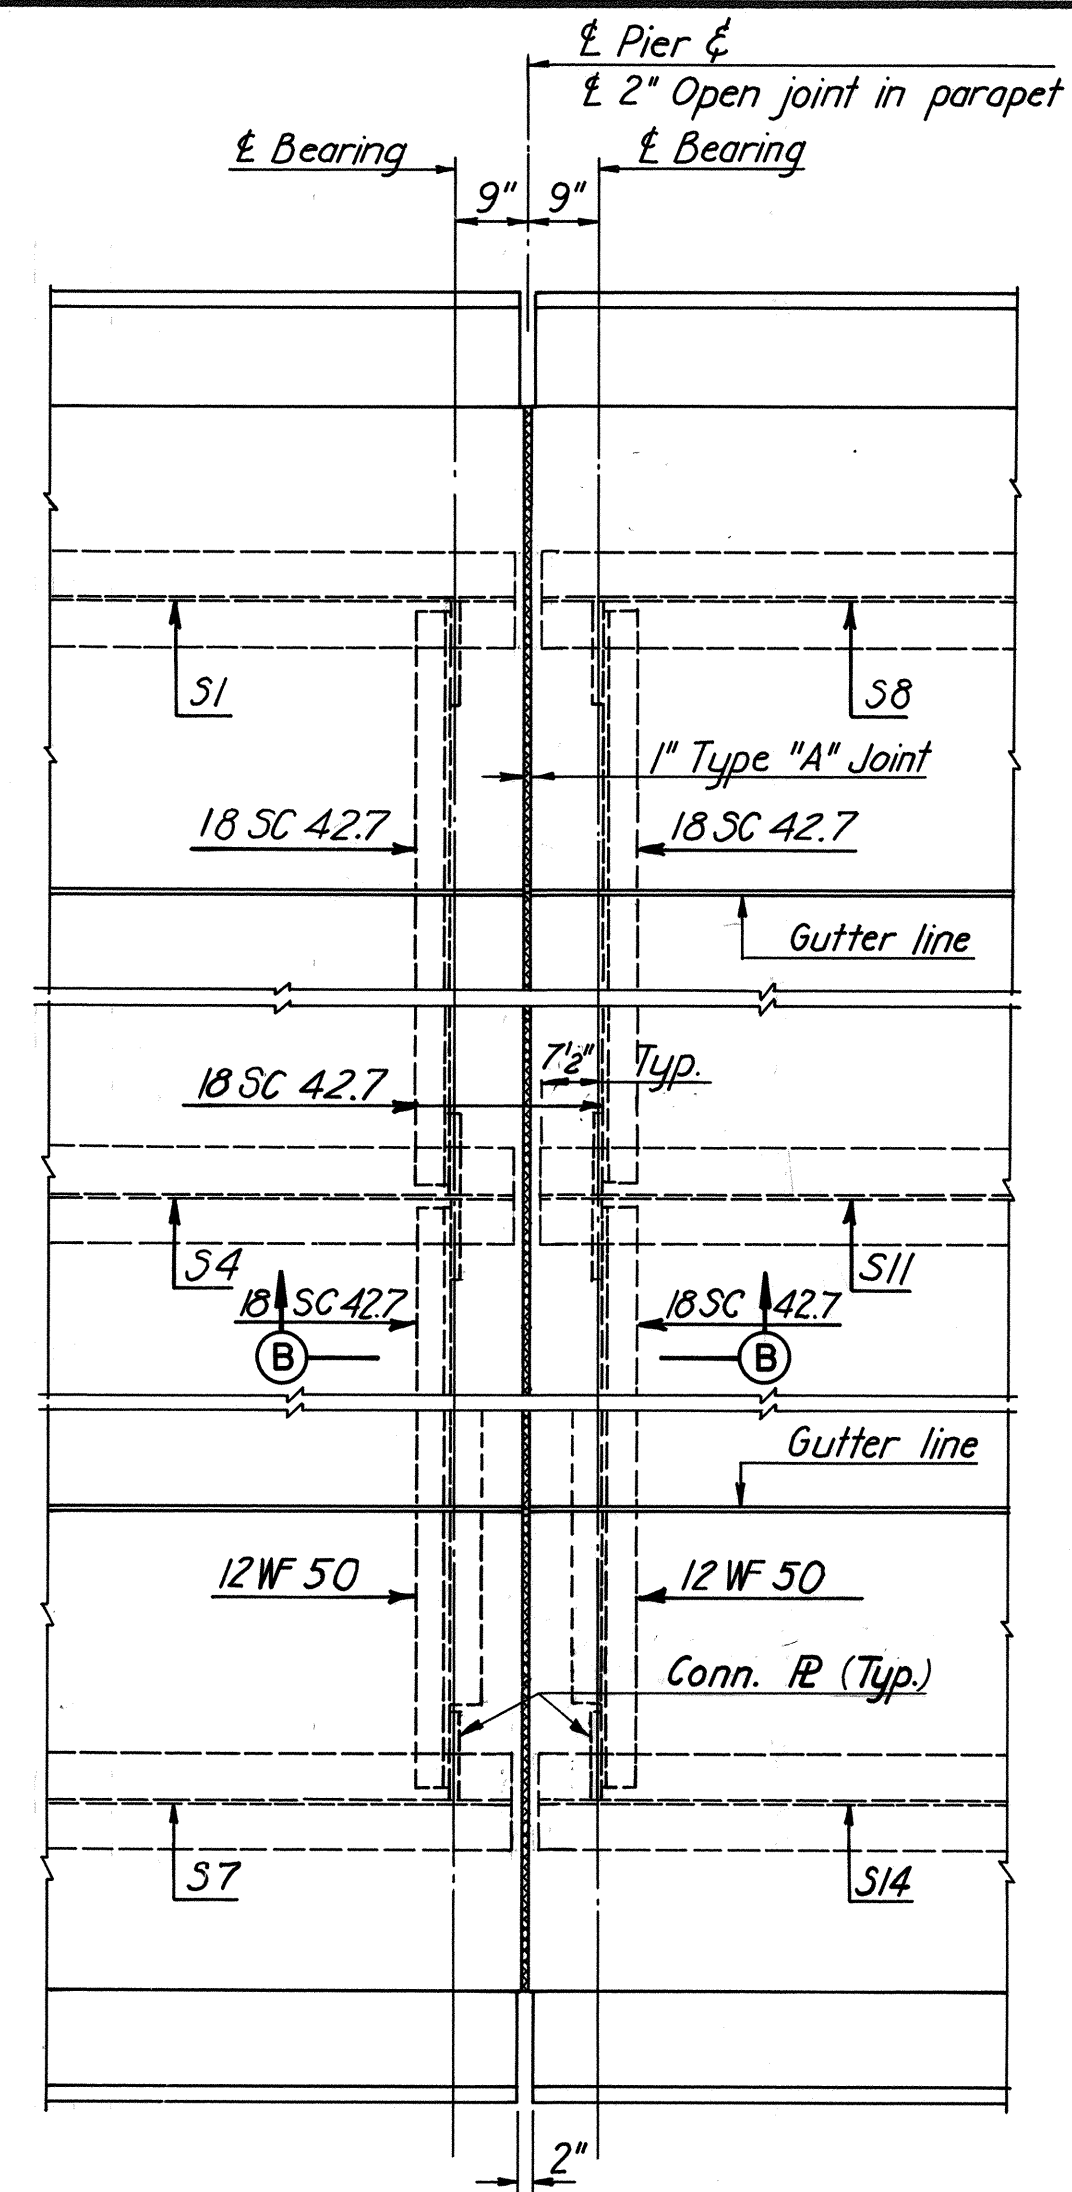


PLAN - JOINT AT PIER  
Scale: 1/2" = 1'-0"

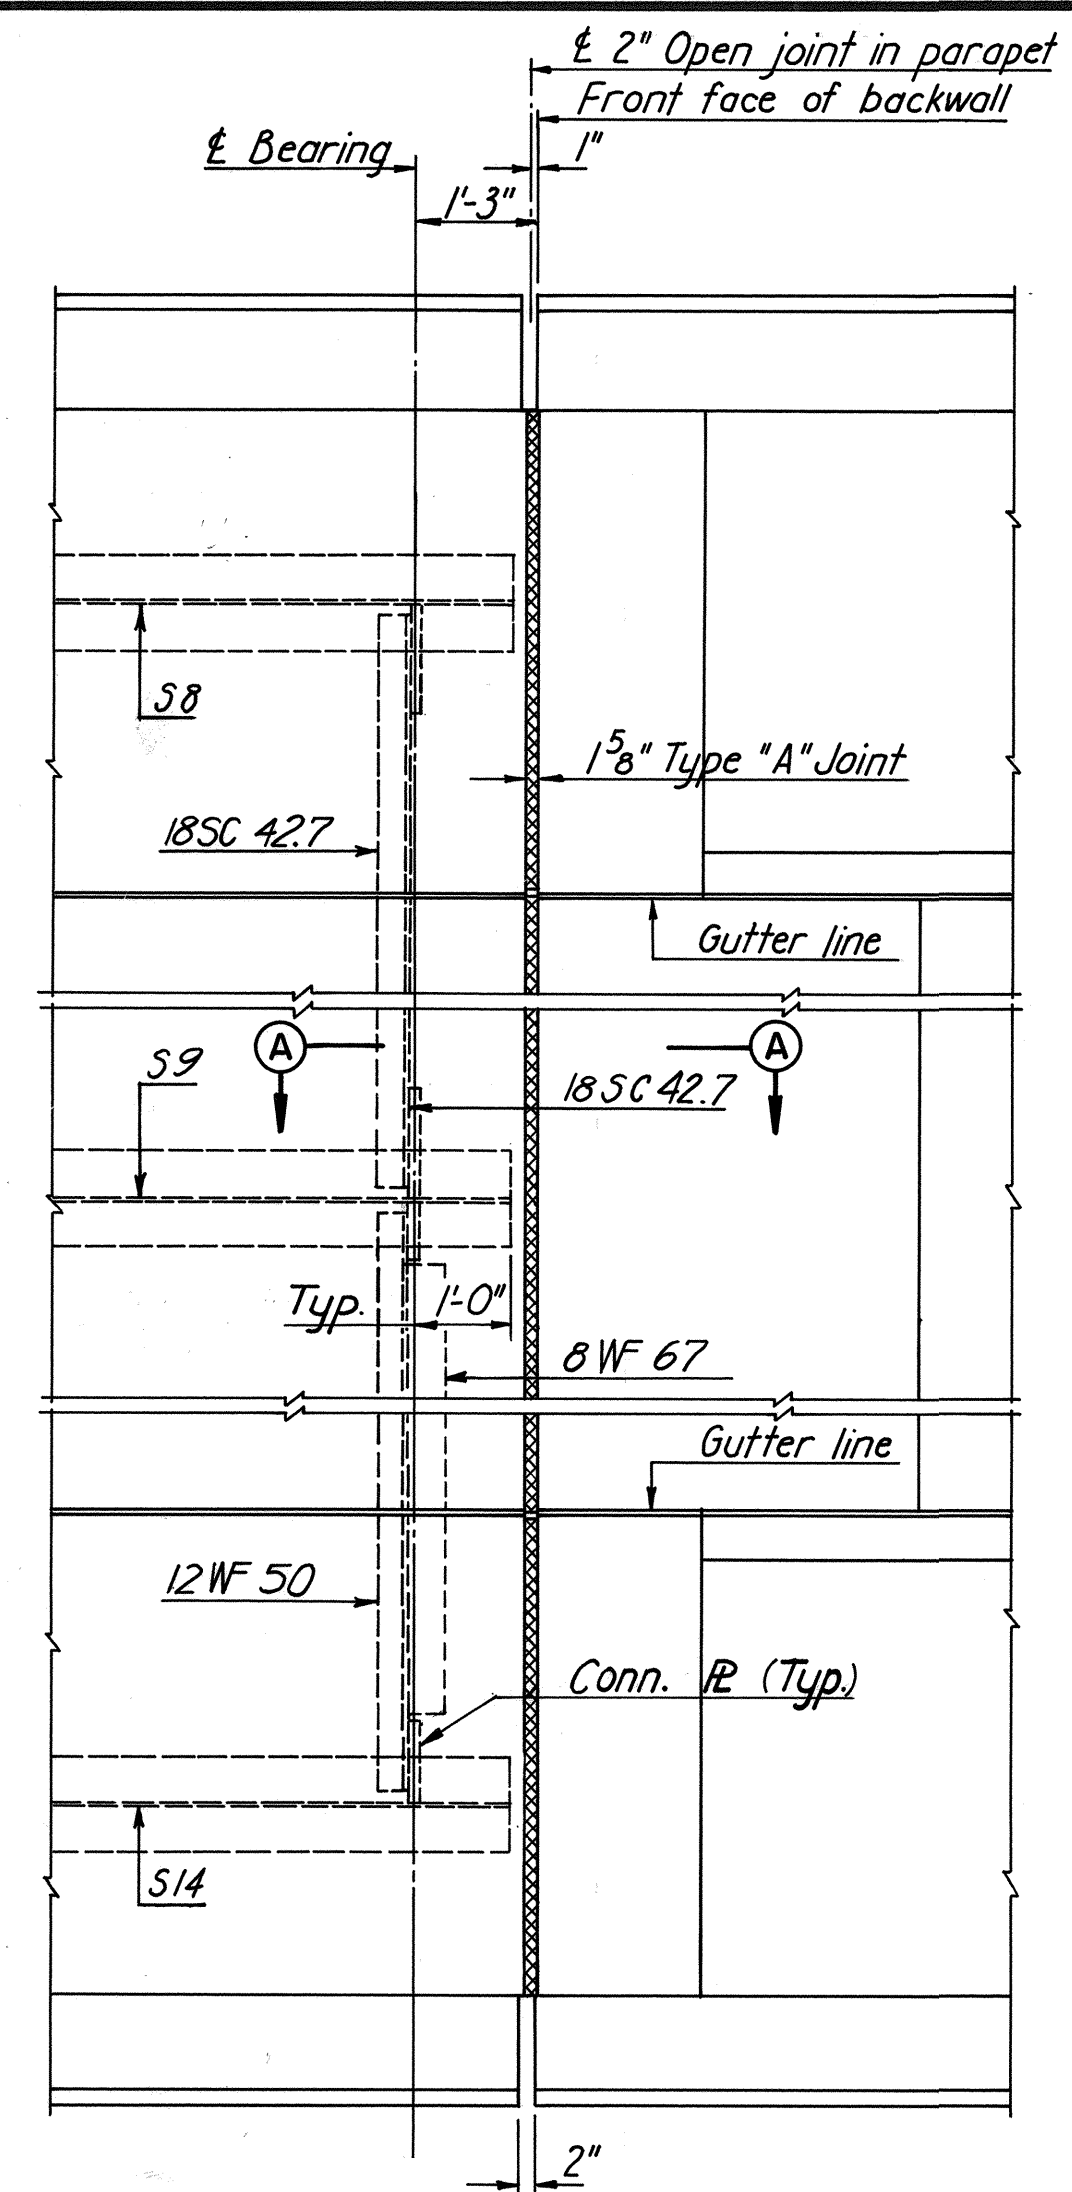






PLAN - JOINT AT SOUTH ABUTMENT  
Scale: 1/2" = 1'-0"

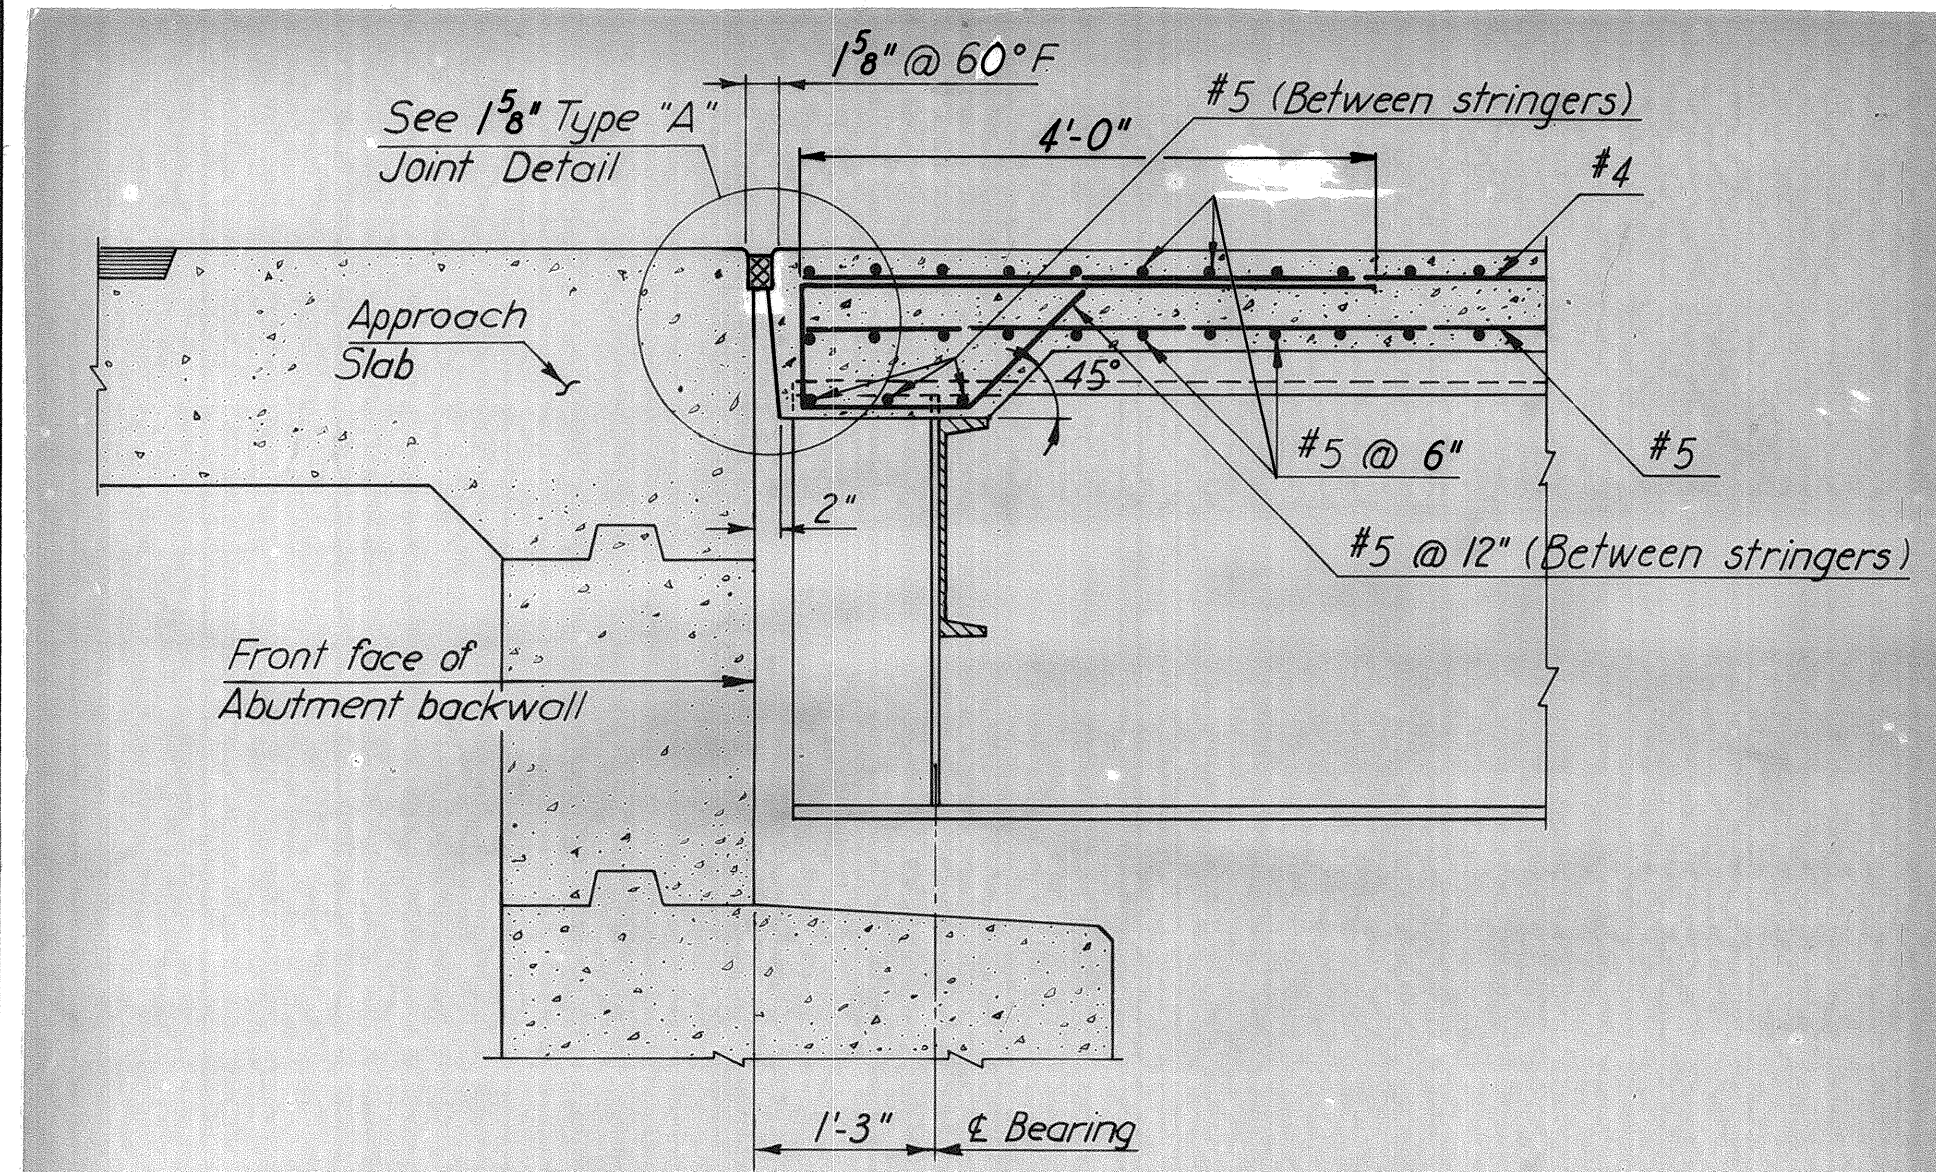

SECTION A-A  
Scale: 3/4" = 1'-0"

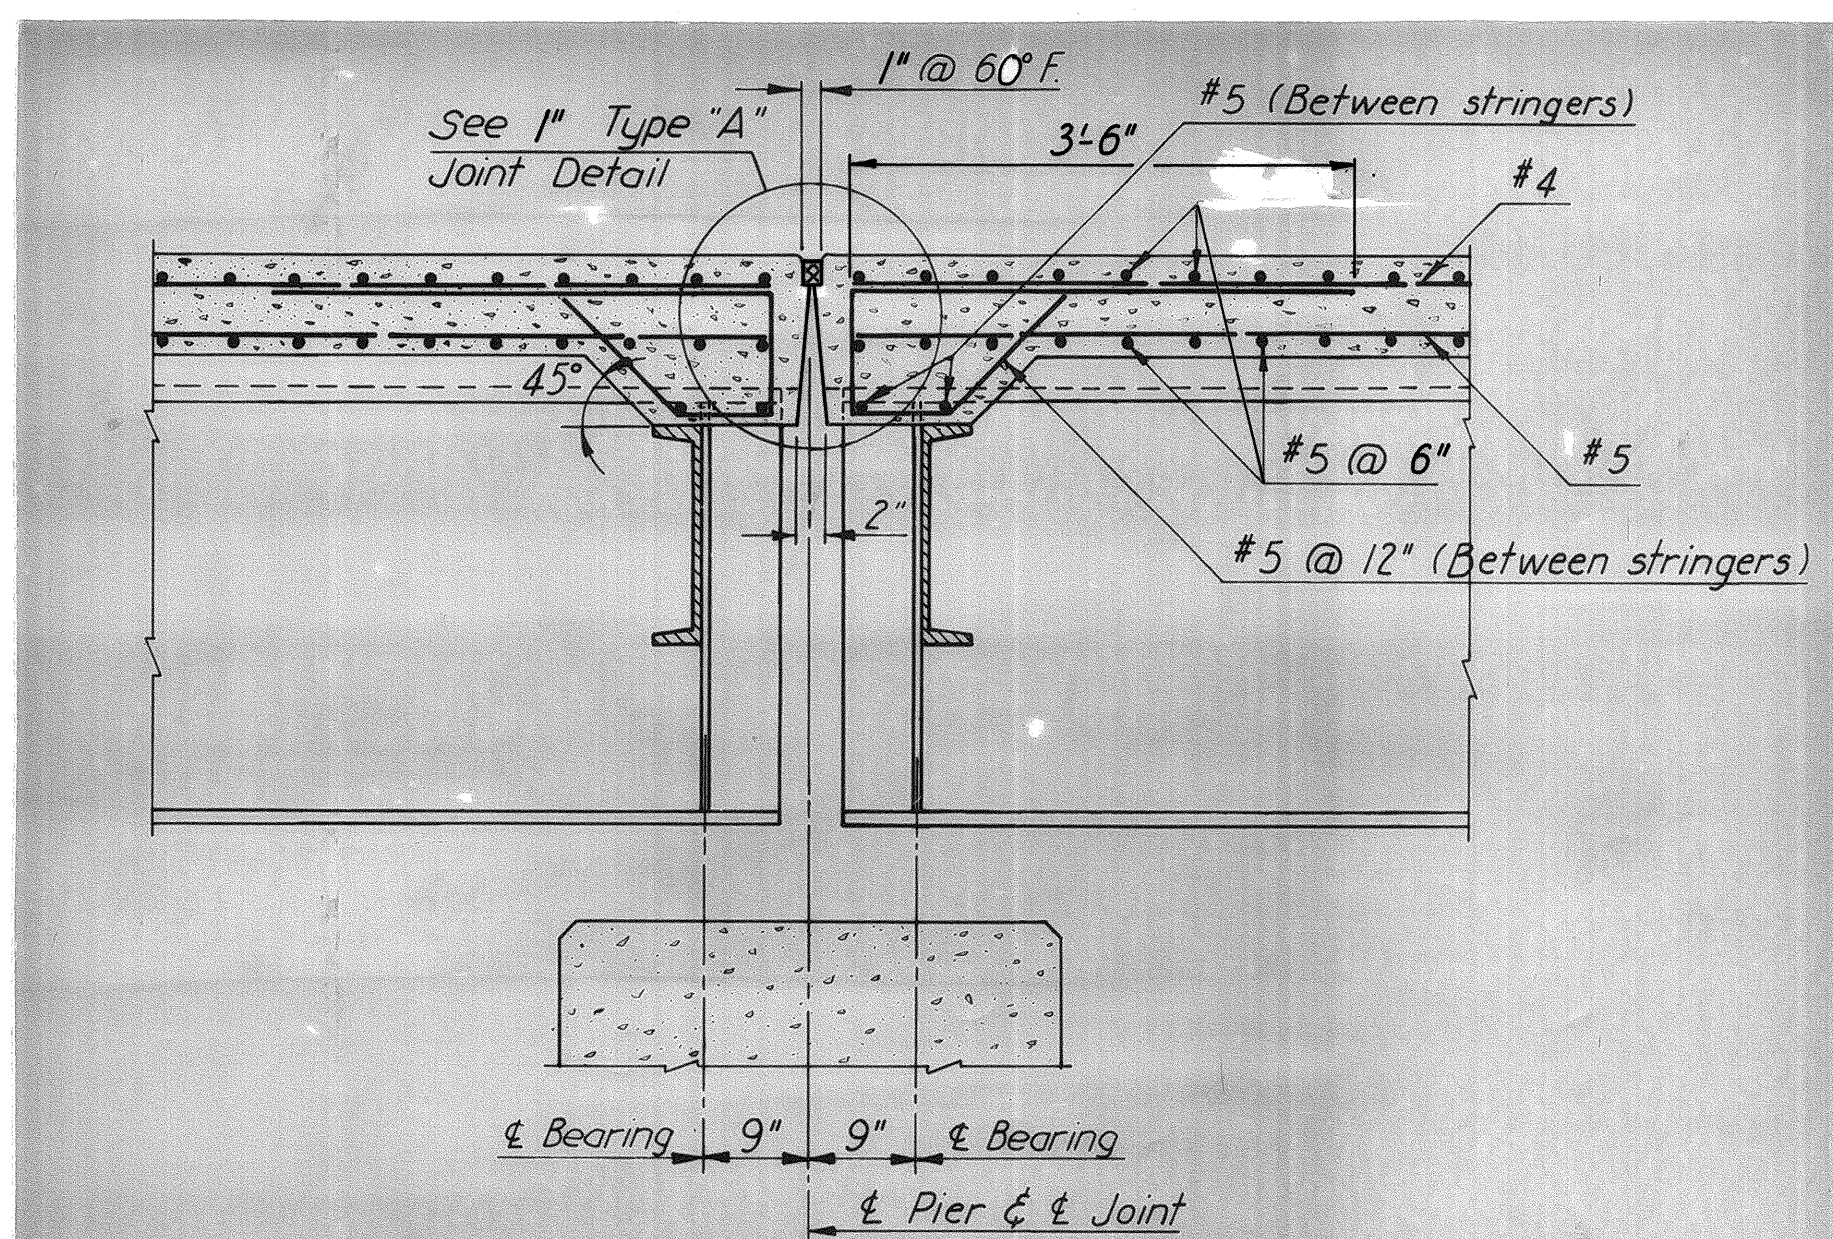

SECTION B-B  
Scale: 3/4" = 1'-0"

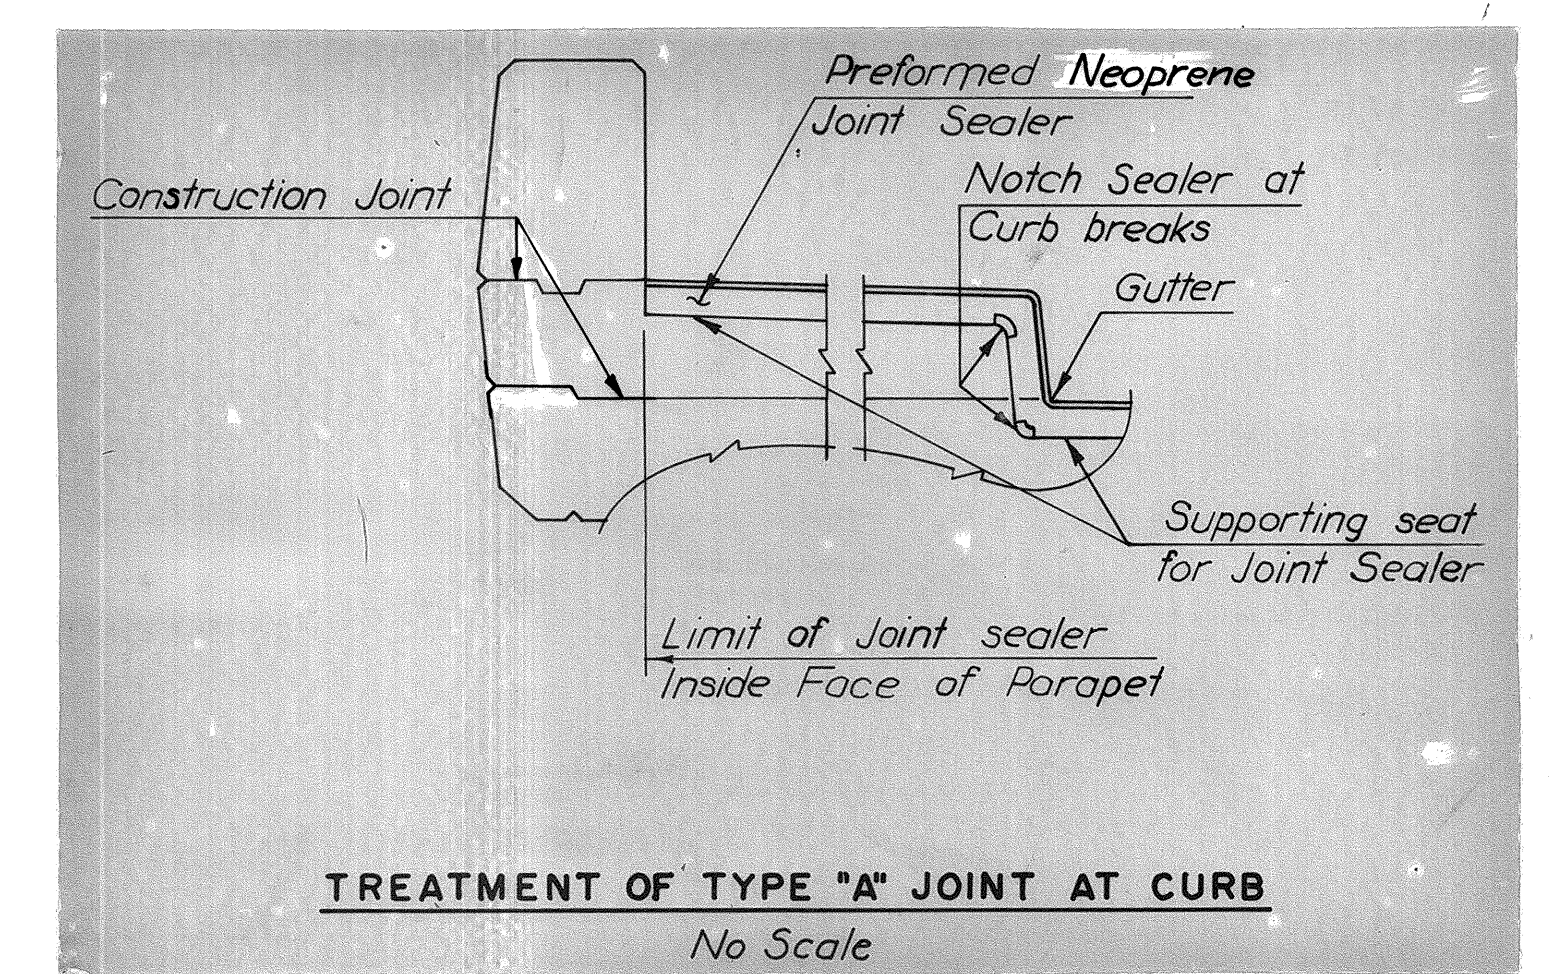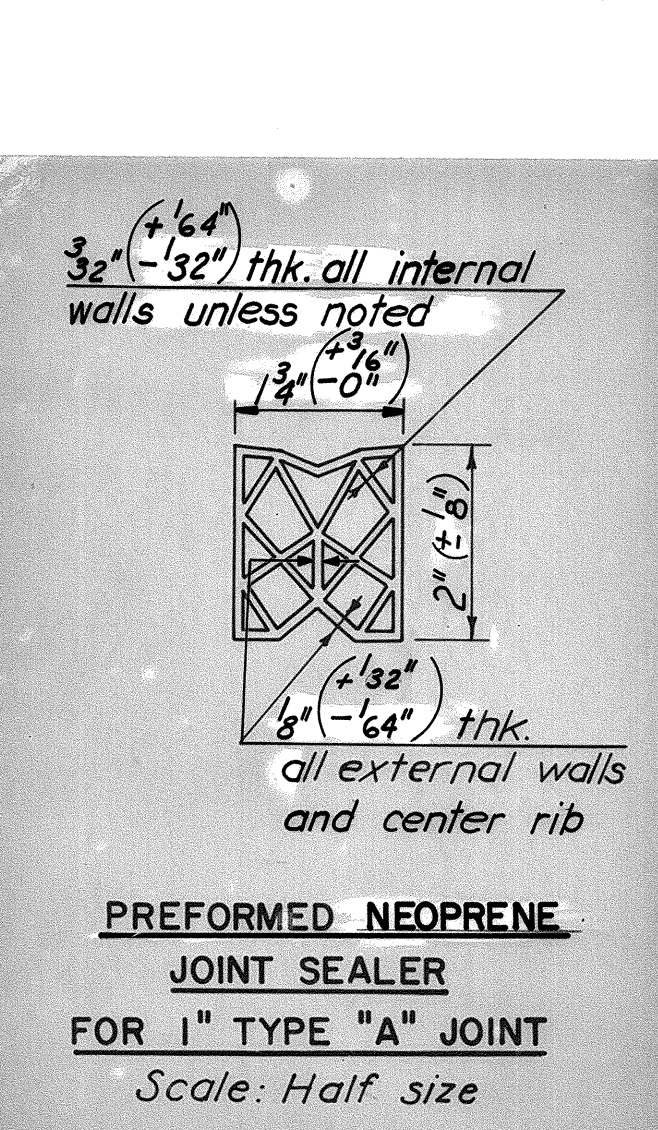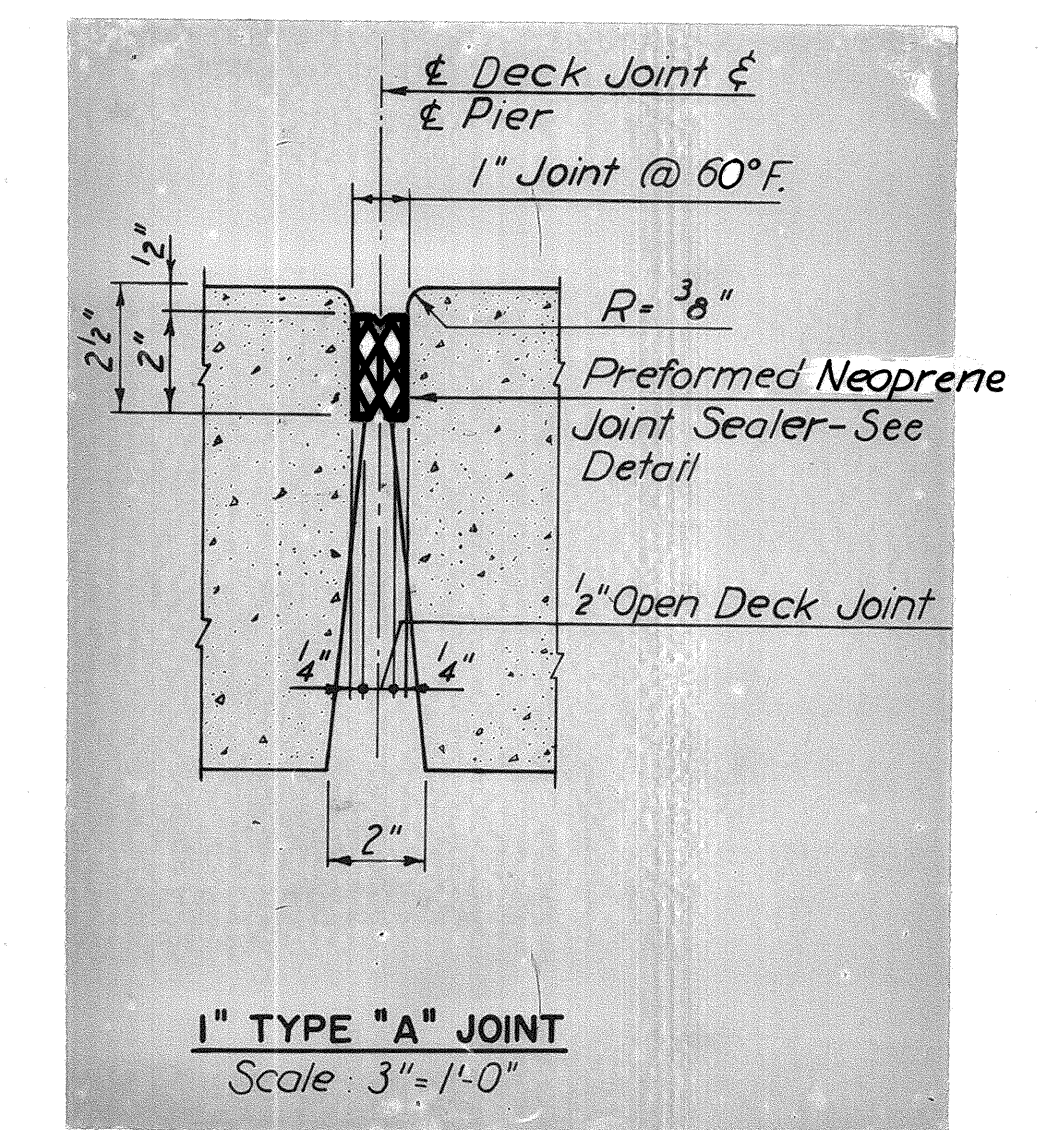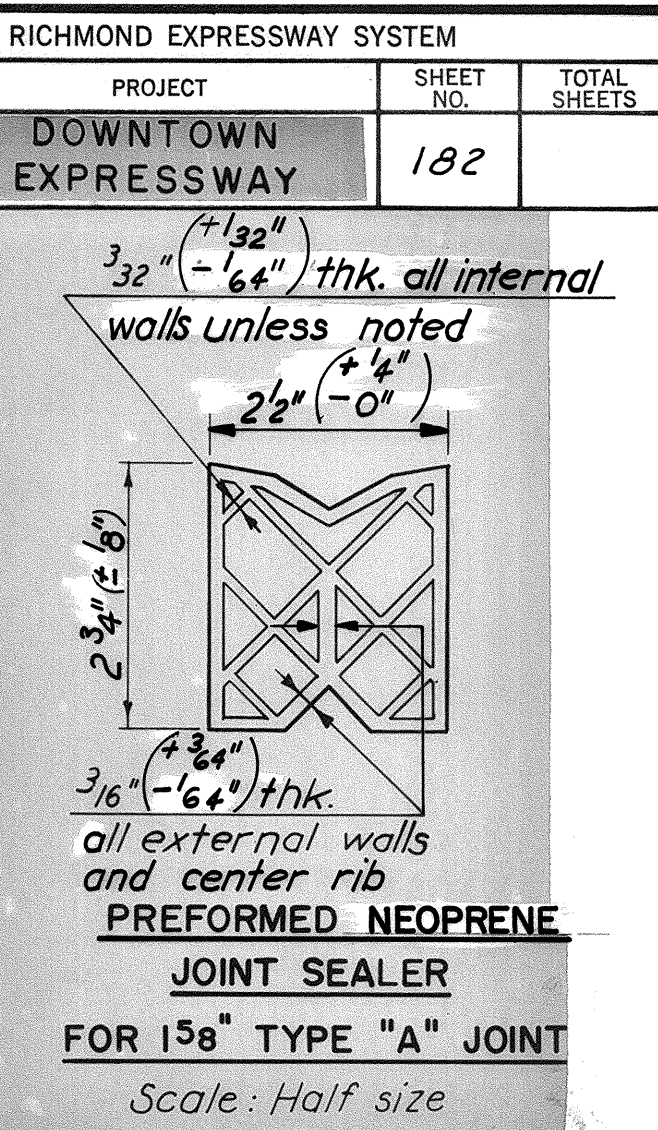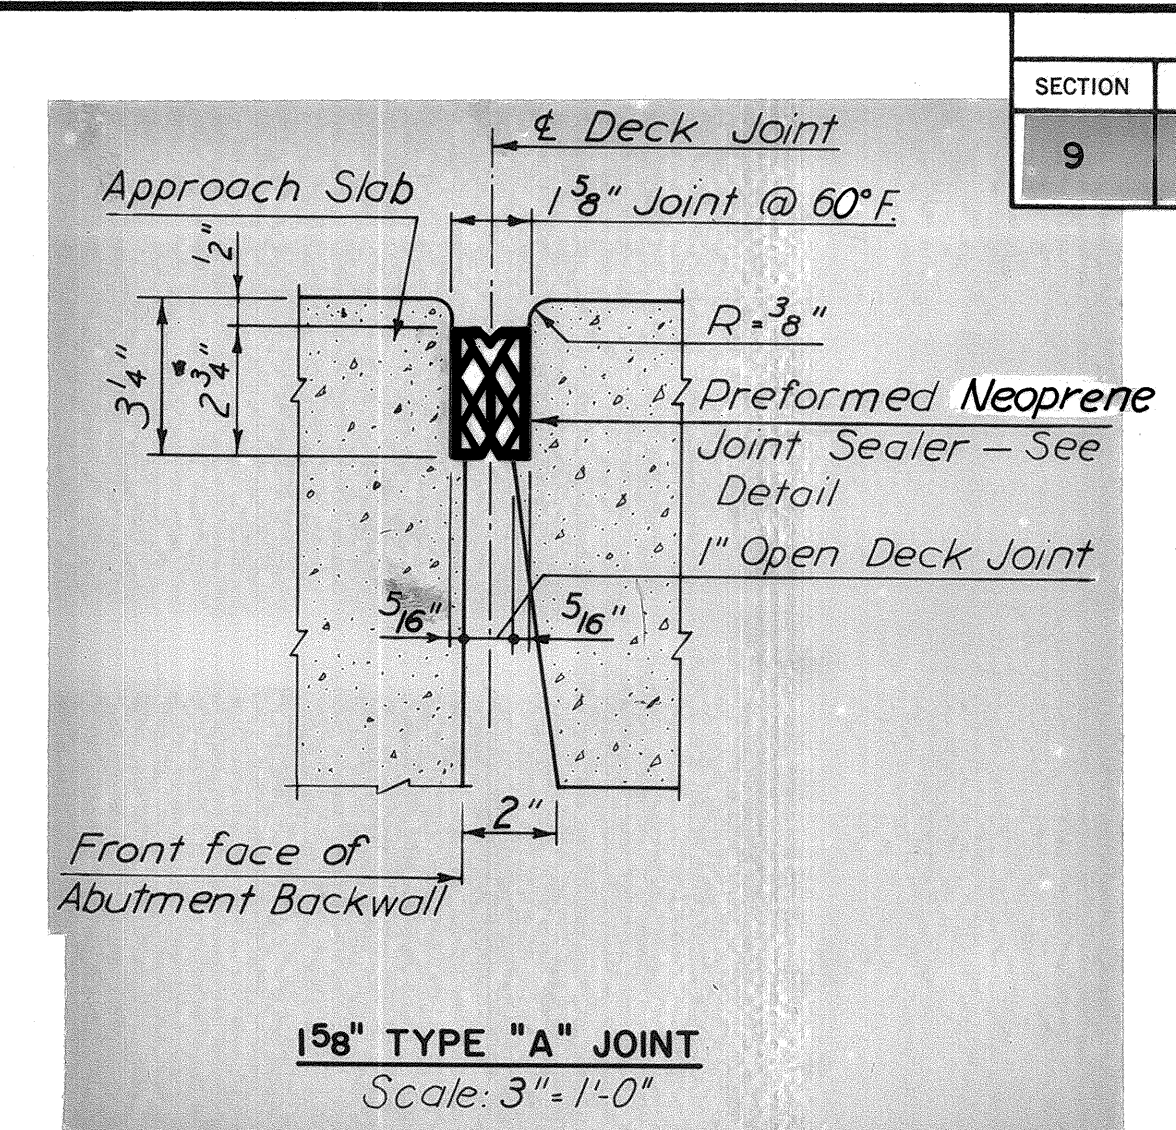

**NOTE TO CONTRACTOR:**  
It is absolutely essential that the openings for the preformed Neoprene joint sealers be accurately formed and constructed to smooth, straight lines. The size of the opening shall be adjusted to allow for anticipated dead load rotation of the ends of the slab and for the temperature at the time of construction.

<b>RICHMOND METROPOLITAN AUTHORITY</b> <b>RICHMOND EXPRESSWAY SYSTEM</b> <b>DOWNTOWN EXPRESSWAY</b>			
<b>BRIDGE B-57</b> <b>5TH STREET OVER</b> <b>DOWNTOWN EXPRESSWAY</b> <b>JOINT DETAILS</b>			
HOWARD, NEEDLES, TAMMEN & BERGENDOFF consulting engineers NEW YORK ALEXANDRIA KANSAS CITY		SCALE: AS SHOWN CONTRACT NO.: 9 SHEET NO. 13 OF 15	

AS BUILT

BY	DATE			
MADE	A.B.P. 9-67			
CHECKED	TEM 2-68	1	As Built	TEM 7-77
IN CHARGE	RAK	NO.	REVISION	BY DATE











# **Bridge 58**




**(South 7th Street  
Over Downtown Expressway {Rte. 195})**

**Record Set Plans**




RICHMOND EXPRESSWAY SYSTEM			
SECTION	PROJECT	SHEET NO.	TOTAL SHEETS
9	DOWNTOWN EXPRESSWAY	185	

INDEX	
NO.	DESCRIPTION
1	General Plan and Elevation
2	General Notes and Quantities
3	North Abutment
4	North Abutment Details
5	South Abutment
6	South Abutment Details (1)
7	South Abutment Details (2)
8	South Abutment Details (3)
9	Pier
10	Framing Plan
11	Cross Section and Utility Details
12	Deck Plans
13	Joint Details
14	Approach Slabs
15	Slope Protection
16	Boring Logs
17	Boring Logs
S1	Standard Shoe Details
S3	Standard Aluminum Railing Details (2 Rails)
S4	Standard Electrical Details (Bridges Carrying City Streets)
S7	Standard Architectural Details
S8	Standard Architectural Details
S9	Standard Architectural Details
S10	Standard Conduit Installation Details
S11	Standard Utility Support Details at Bridge Abutments

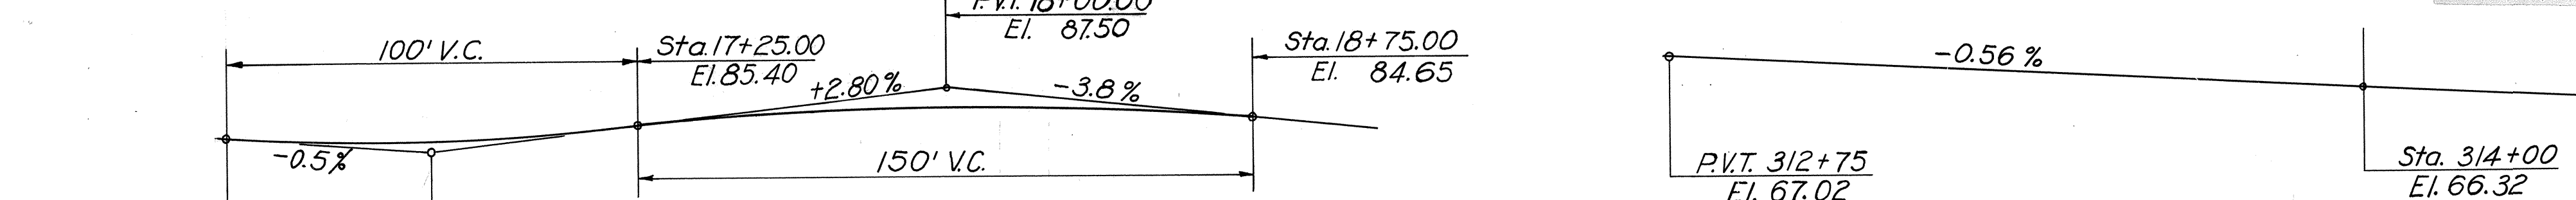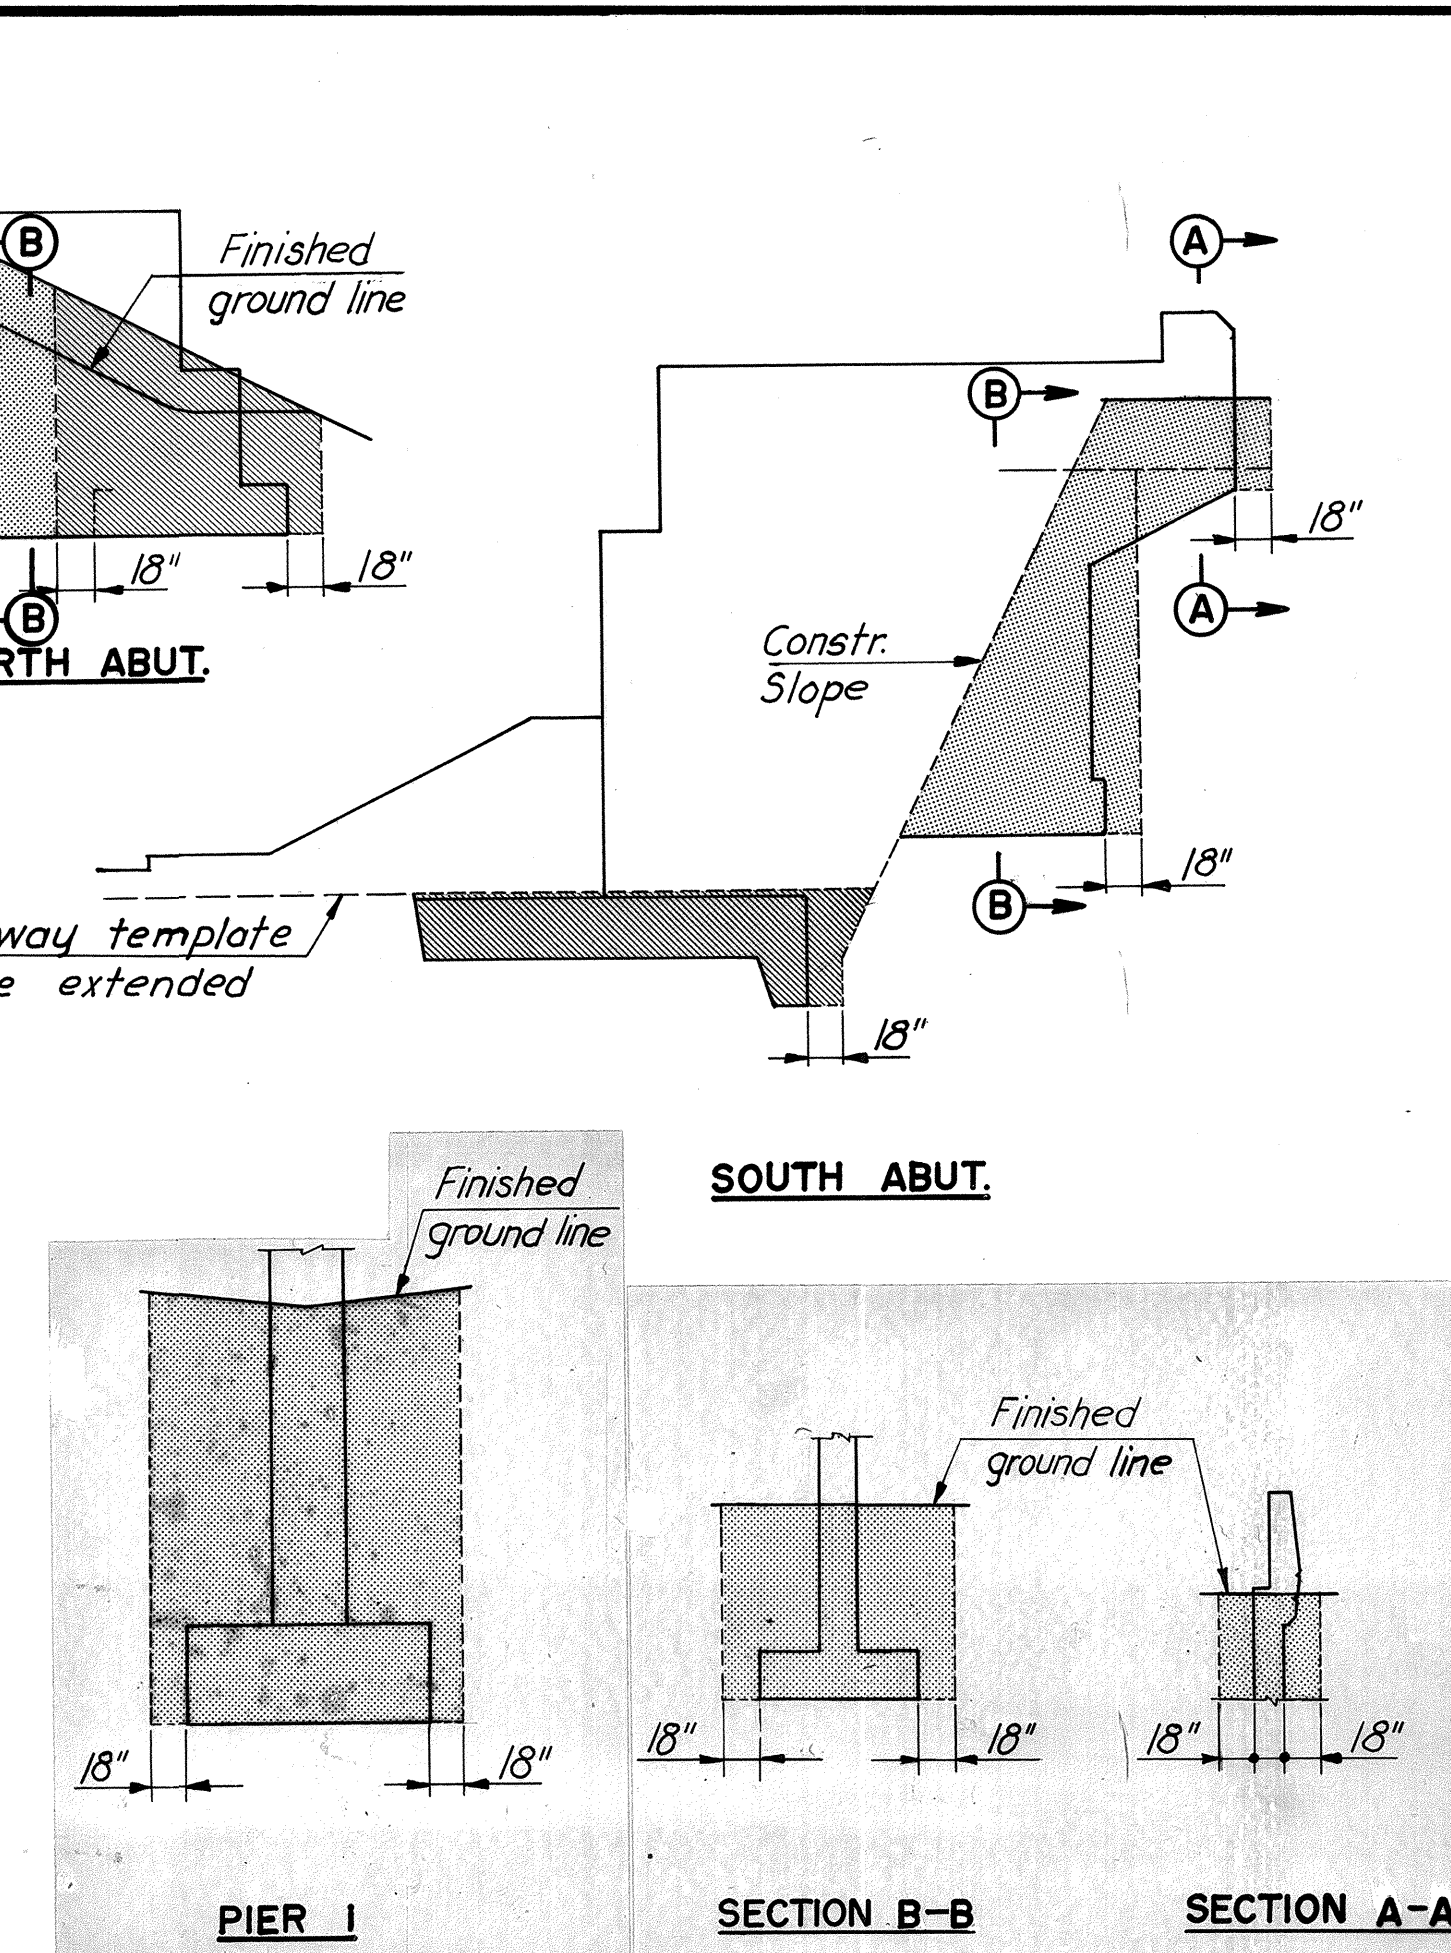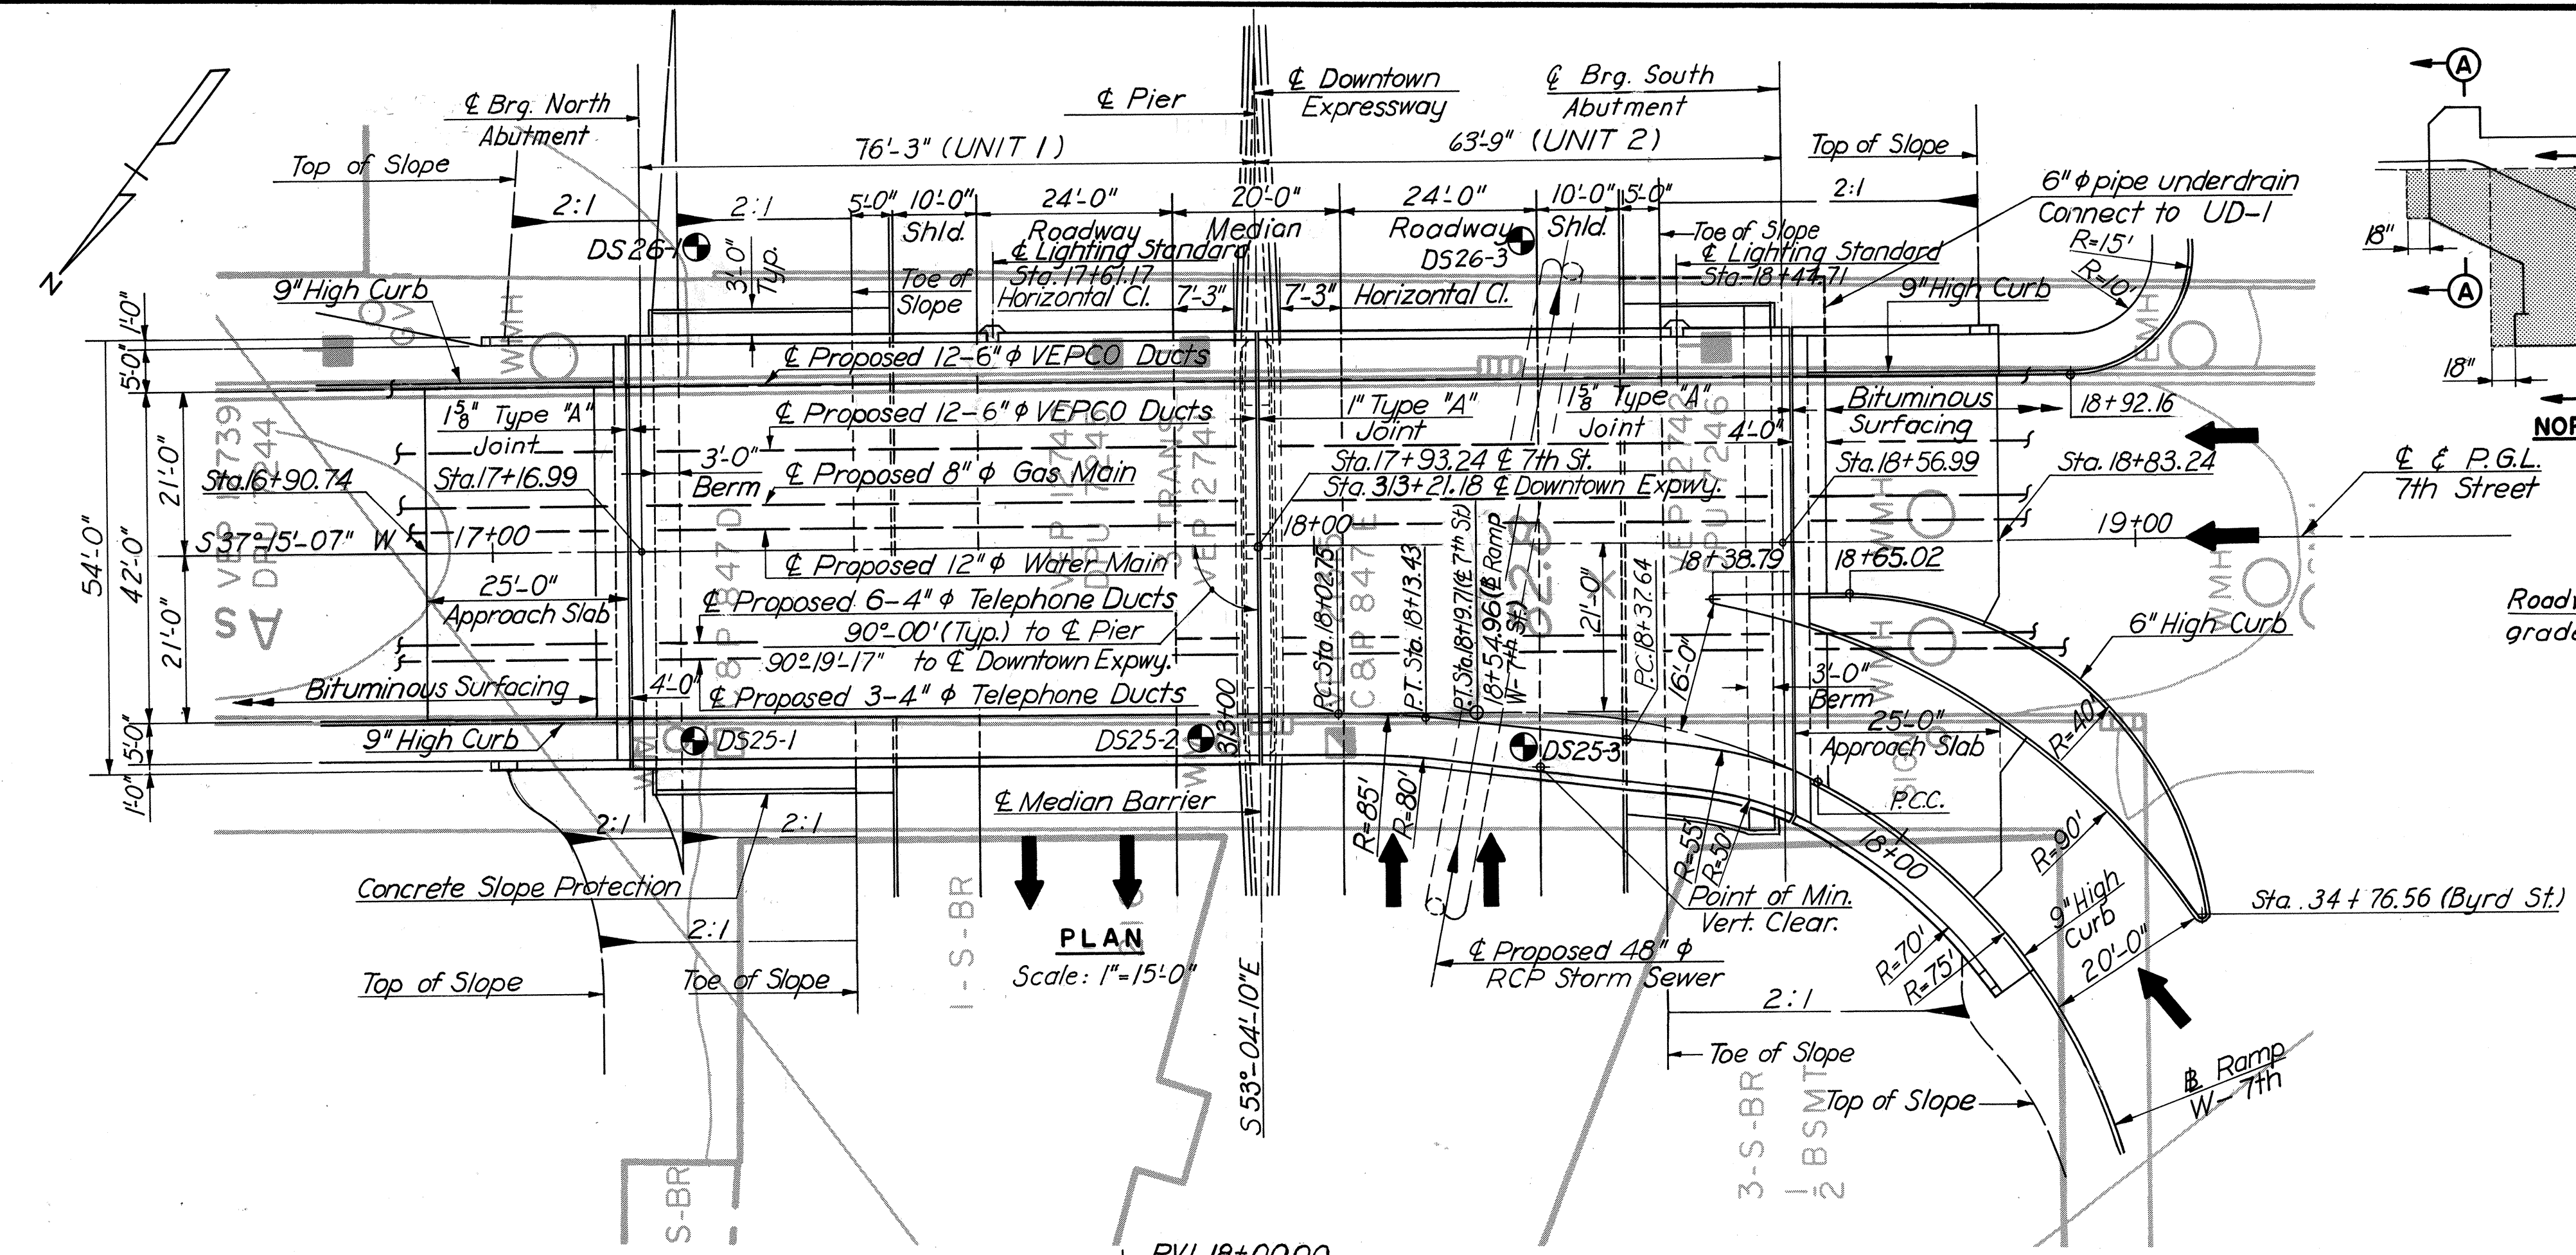

**PAYMENT LIMITS FOR STRUCTURE EXCAVATIONS**  
No Scale

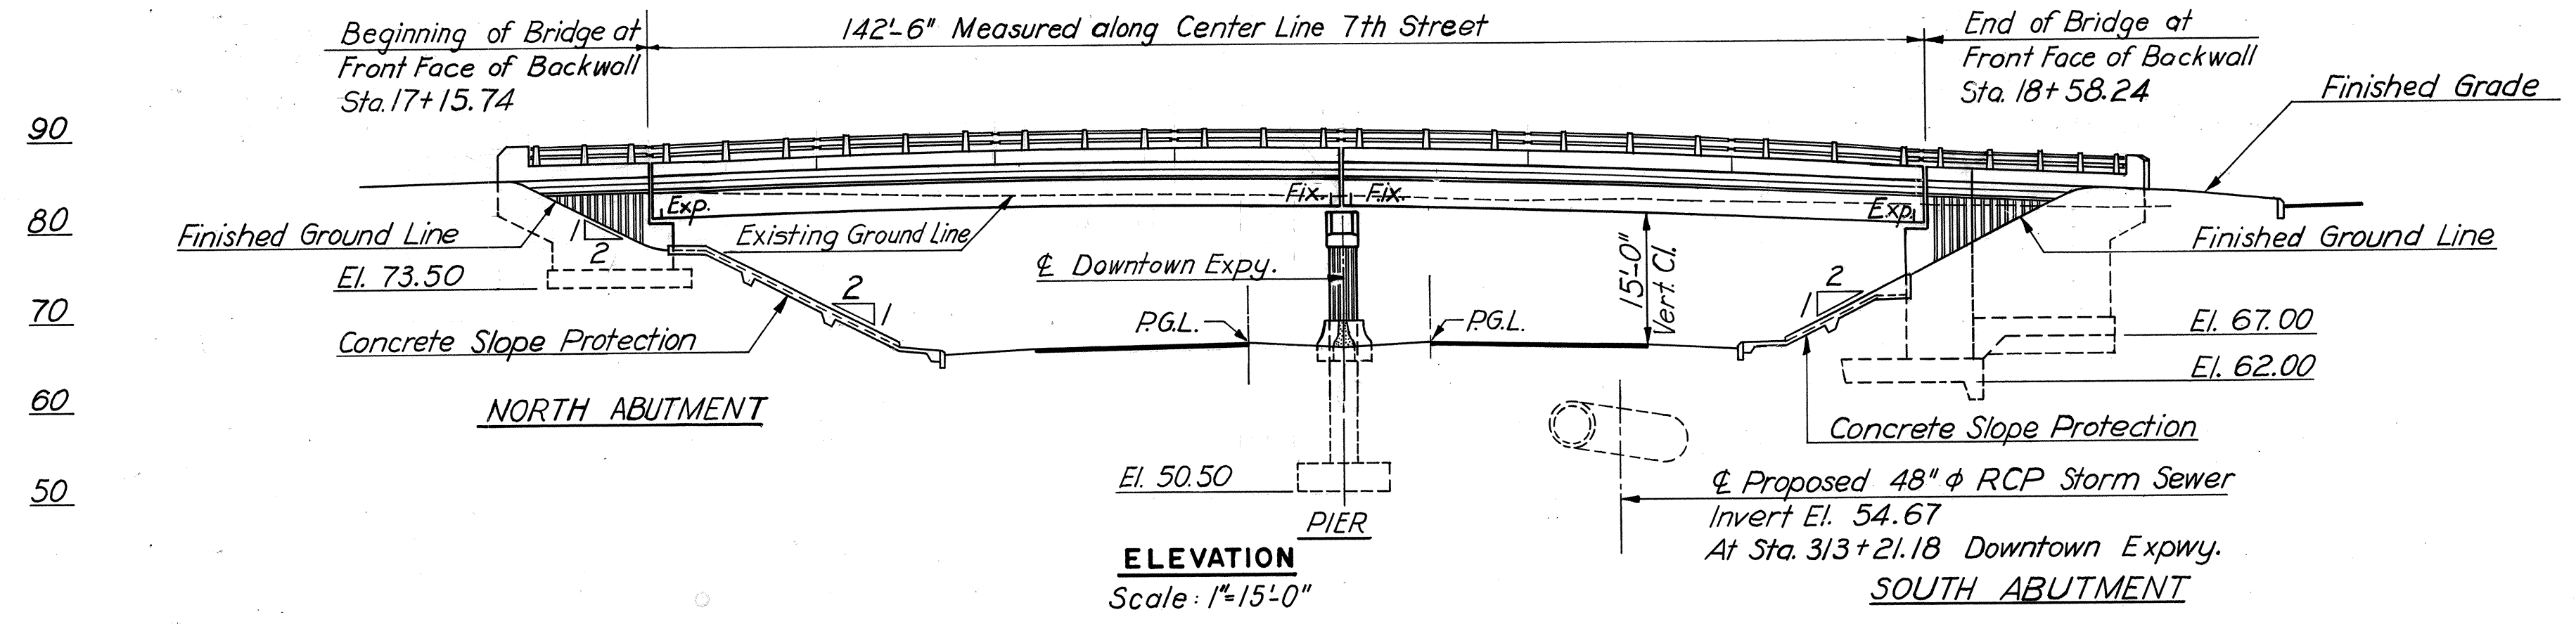

**BORINGS:** Indicates location of 2 1/2" cased hole boring. For boring data, see Boring Logs sheet.  
**NOTE:** For General Notes and Quantities, see next sheet.

MADE	BY	DATE	CHECKED	DATE	IN CHARGE	NO.	REVISION	BY	DATE
JBM	1-68		TEM	2-68	PRV	1	As Built	TEM	7-77

**RICHMOND METROPOLITAN AUTHORITY**  
**RICHMOND EXPRESSWAY SYSTEM**  
**DOWNTOWN EXPRESSWAY**


**BRIDGE B-58**  
**7TH STREET OVER**  
**DOWNTOWN EXPRESSWAY**  
**GENERAL PLAN AND ELEVATION**

HOWARD, NEEDLES, TAMMEN & BERGENDOFF  
consulting engineers  
NEW YORK ALEXANDRIA KANSAS CITY

SCALE: AS SHOWN  
CONTRACT NO. 9  
SHEET NO. 1 OF 17

AS BUILT



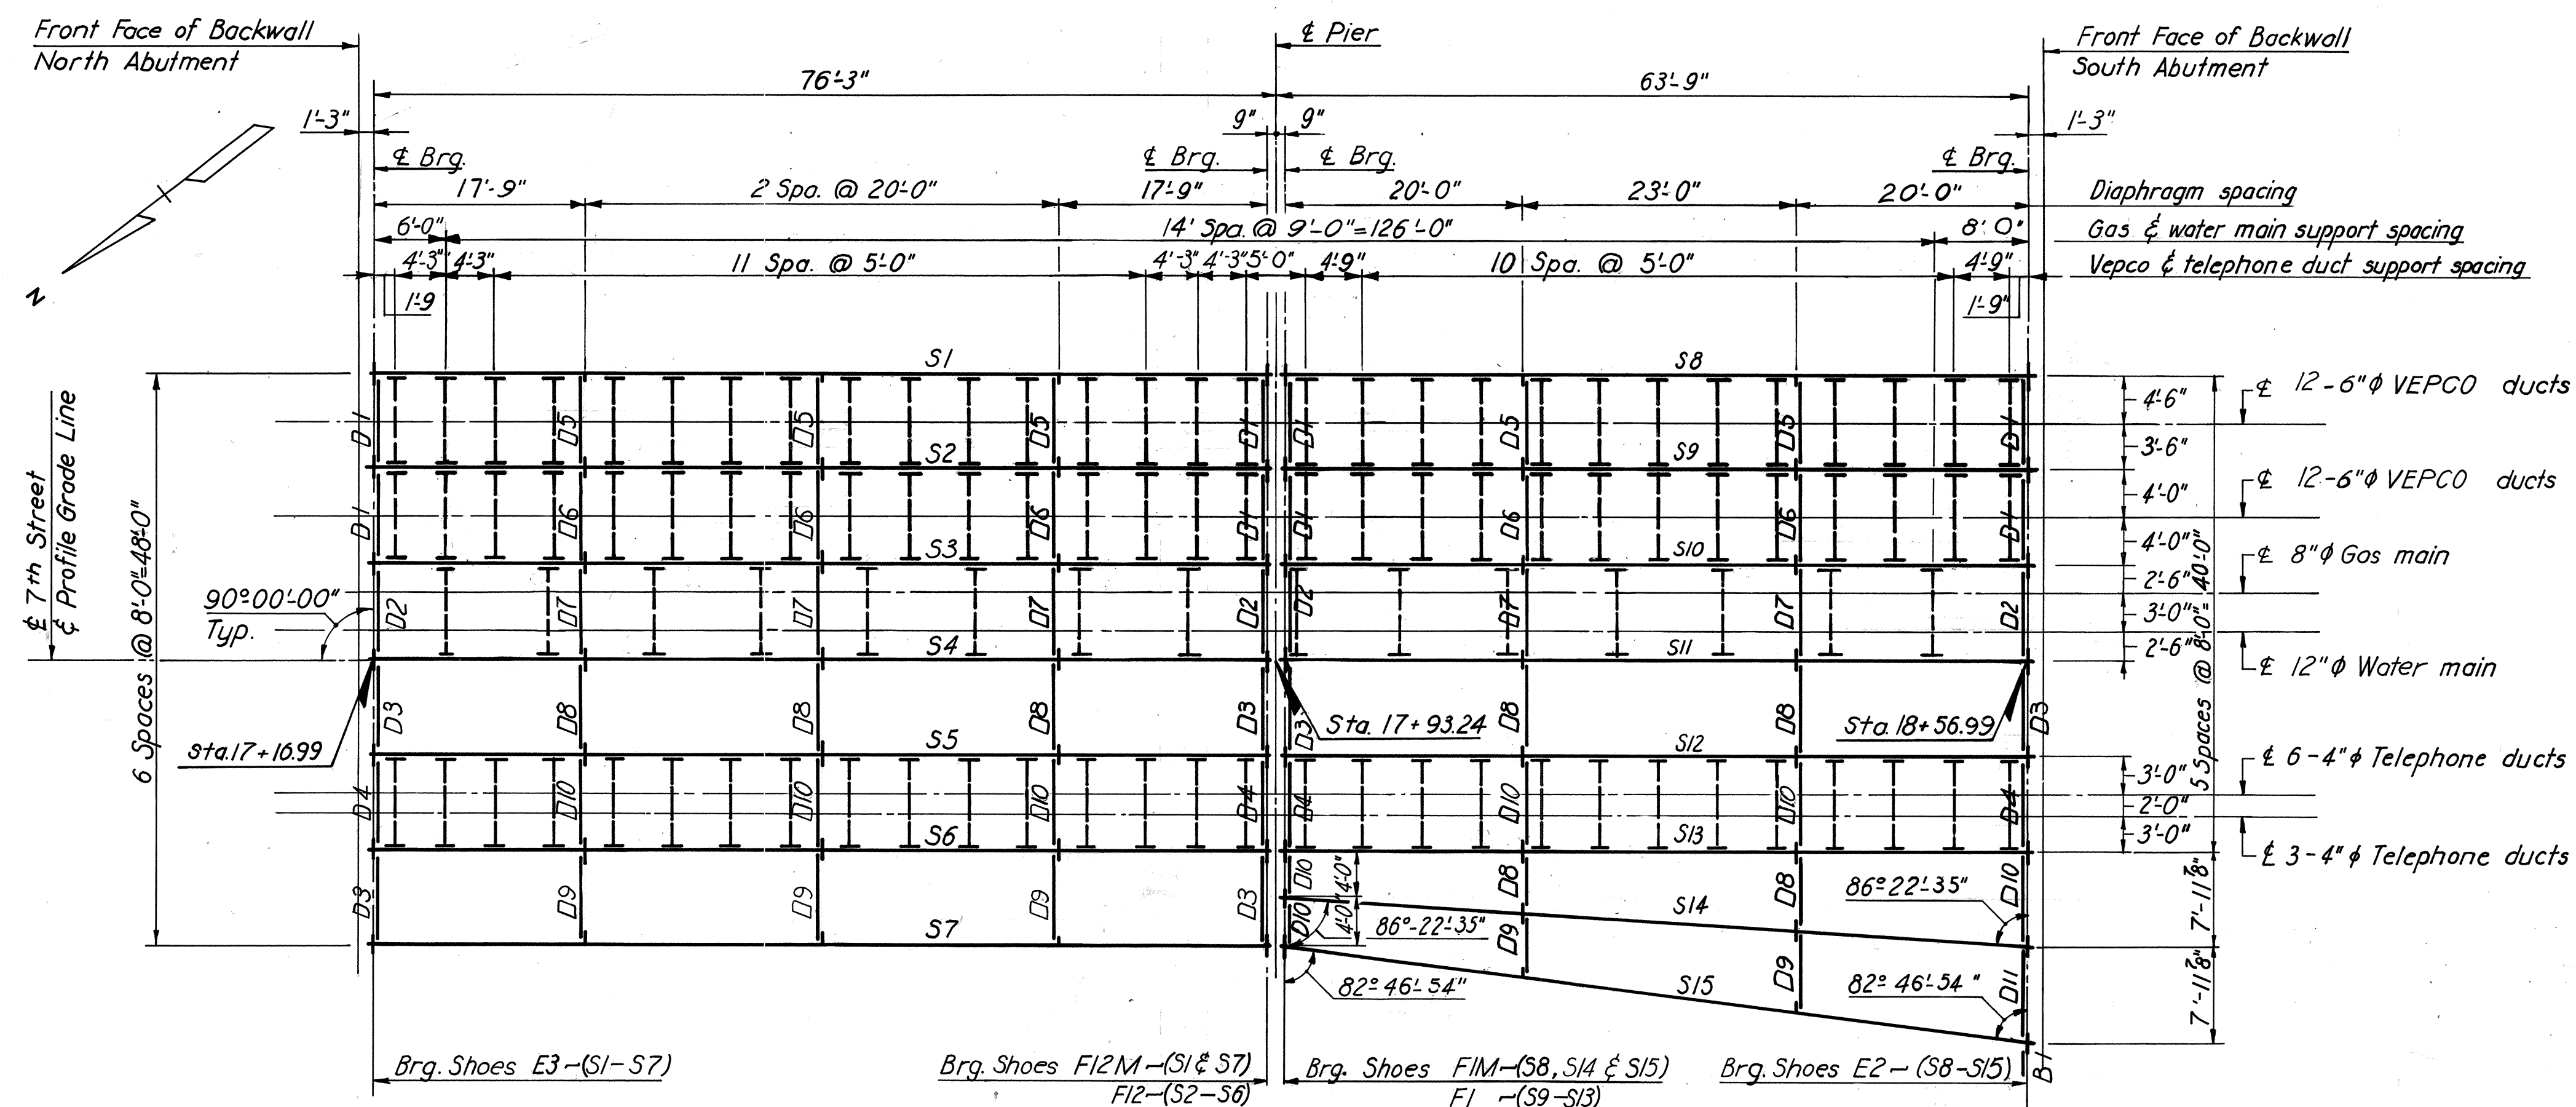


## UNIT 1


## UNIT 2

## FRAMING PLAN


Scale: 1" = 10'

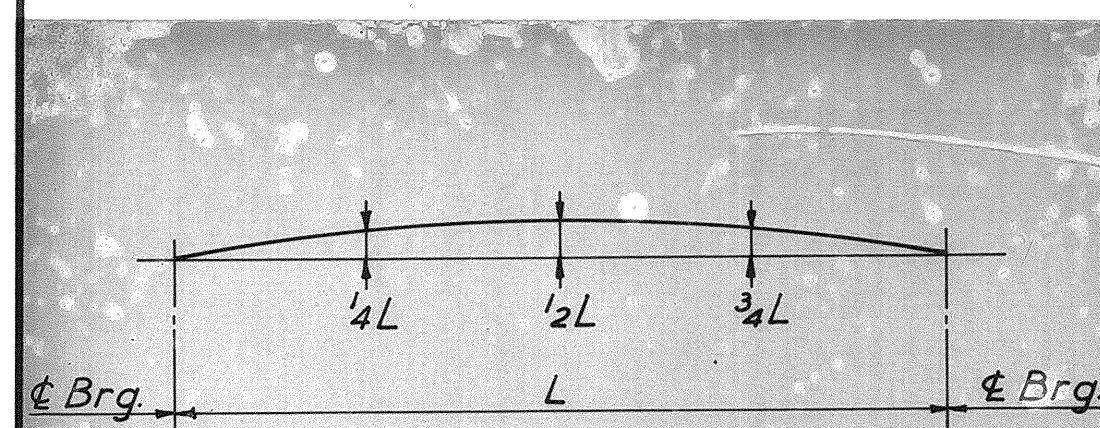

### CAMBER DIAGRAM

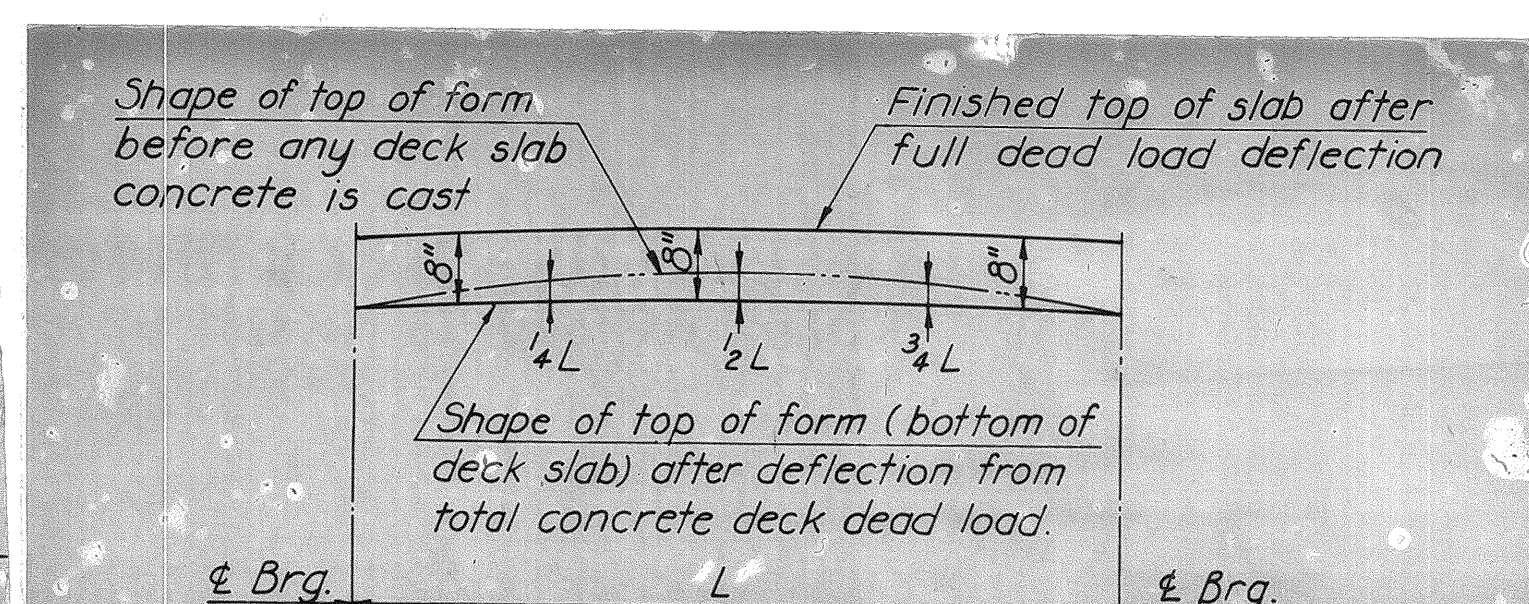


DEAD LOAD DEFLECTION DIAGRAM

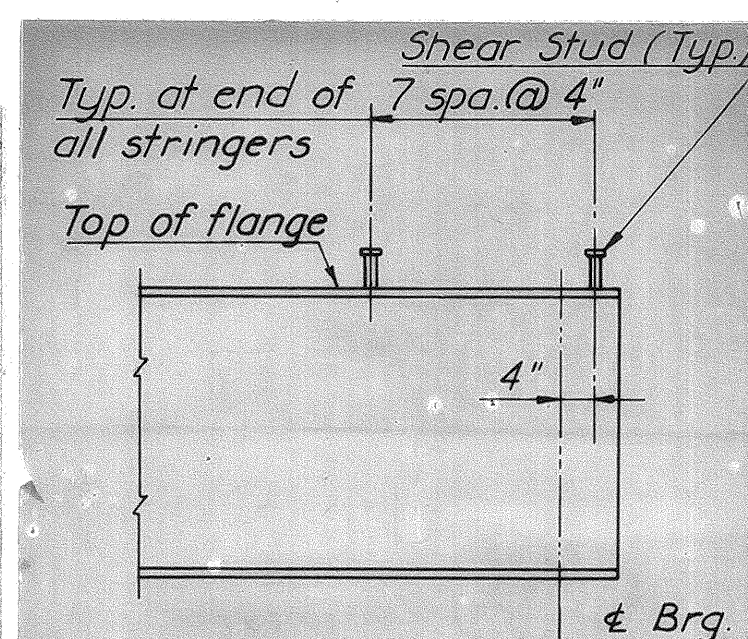


DETAIL "A"

No Scale

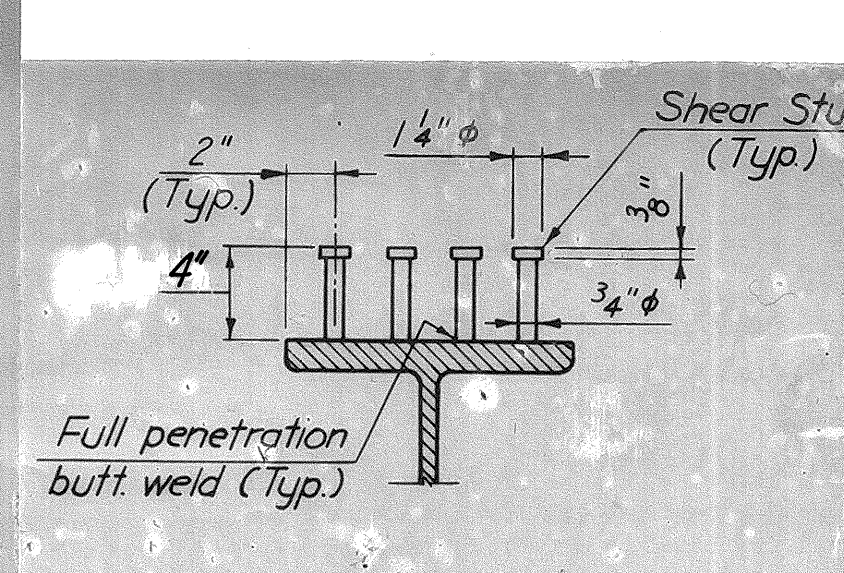

SHEAR STUD DETAIL

No Scale

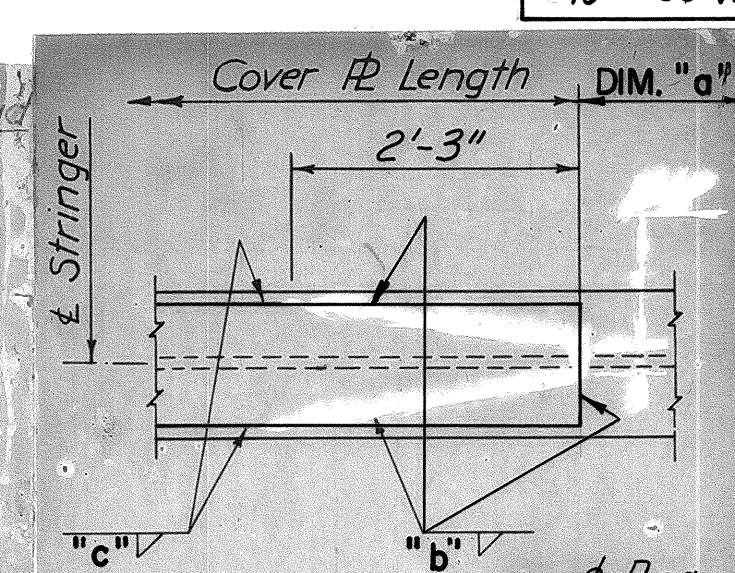

COVER PLATE DETAIL

OVER PLATE  
No Scale

STRINGER SCHEDULE							
STRINGER	LENGTH £ BRG. TO £ BRG.	COVER PLATE	SHEAR STUD SPACING				
			0.1L	0.2L	0.3L	0.4L	0.5L
S1 - 36 WF 194	75'-6"	10½ x 1¾ x 64'-0"	7"	8"	11"	13½"	15½"
S2 - 36 WF 194	↑	10½ x 1¾ x 64'-0"	↑	↑	10½"	13"	14½"
S3 - 36 WF 182		10½ x 1¾ x 65'-0"			11"	↑	↑
S4 - 36 WF 182		10½ x 1¾ x 64'-6"			↑		
S5 - 36 WF 182		10½ x 1⅝ x 63'-6"				↓	↓
S6 - 36 WF 182	↓	10½ x 1⅝ x 63'-6"	↓	↓	↓	13"	14½"
S7 - 36 WF 182	75'-6"	10½ x 1¾ x 64'-6"	7"	8"	11"	13½"	15½"
S8 - 36 WF 150	63'-0"	10½ x 1 x 51'-0"	7"	8"	10½"	13½"	15"
S9 - 36 WF 150	↑	10½ x 1 x 51'-0"	↑	↑	10½"	12½"	14"
S10 - 36 WF 150		10½ x 1 x 51'-0"			11"	↑	↑
S11 - 36 WF 135		10½ x 1⅛ x 53'-0"			11"		
S12 -	↑	10½ x 1⅛ x 53'-0"	↓	↓		10½"	14"
S13 -	63'-0"	10½ x ⅞ x 51'-6"	7½"	8"	11½"	12½"	15"
S14 -	↓	10½ x ⅞ x 48'-6"	9"	10"	13"	15½"	17"
S15 - 36 WF 135	63'-6½"	10½ x ¾ x 49'-6"	8½"	10"	12½"	16"	18½"

Note: Lengths shown are horizontal distances measured along centerlines of stringers.

CAMBER				SCHEDULE				
STR.	1/4 L	2 L	3/4 L	STR.	1/4 L	2 L	3/4 L	
5/6	4"	5 5/8"	4 1/2"	58-510	2 3/8"	3 3/8"	2 3/8"	
55-57				512-513				
52		4"		5 1/2"	511	2 3/8"	4"	2 3/8"
54		4 1/8"		5 5/8"	514	3"	4"	3"
53	4 1/8"	5 3/8"	44"	515	3 3/8"	4 1/8"	3 3/8"	

DEFLECTION SCHEDULE					
STR.	$\frac{1}{4}$ 8 3/4	1/2 L	STR.	$\frac{1}{4}$ 8 3/4	1/2 L
S1, S3, S7	1/8"	1/2"	S8 - S14	3/4"	1"
S2, S4 - S6	1"		S15	5/8"	7/8"

**SHEAR STUD NOTE:**

Capacity = 3,400 lbs. per stud.  
The contractor may, if he elects, use three  $\frac{3}{4}$ " diameter studs at the same longitudinal spacing in lieu of the four  $\frac{3}{4}$ " diameter studs shown.  
Stud rows shall be placed parallel to the main deck reinforcing.  
Shear stud spacing shown is maximum spacing.

COVER PLATE SCHEDULE				
STR.	DIM. "d"	Cover R	"b"	"c"
S/ES2	5'-9"		5'8"	3'8"
S3	5'-3"	10 1/2 x 1 3/4		
S4 ES7	5'-6"			
S5 ES6	6'-0"	10 1/2 x 1 5/8		
S8-S10	6'-0"	10 1/2 x 1		
S11 ES12	5'-0"	10 1/2 x 1/8		
S13	5'-9"	10 1/2 x 7/8		
S14	7'-3 3/4	10 1/2 x 5/8		
S15	7'-0 1/4	10 1/2 x 3/4		

SHOE SCHEDULE			
EXPANSION SHOES		FIXED SHOES	
TYPE	NO. REQD.	TYPE	NO. REQD.
E2	8	F1	5
E3	7	F1M	3
		F12	5
		F12M	2

**NOTE TO FABRICATOR:**

The above stringers shall be fabricated with an upward camber amounting to the tabulated value.

This will provide approximate compensation for deflection under full dead load and for conformity with finished grade.

Dimensions are in inches.

**NOTE TO CONTRACTOR:**

*The above deflections are those anticipated to occur in the stringer upon placement of the total concrete deck load.*

*In practice, the stringers in place are not likely to have the exact camber to compensate for these deflections during construction. The residual amounts shall be provided for by adjusting forms to vary the thickness of the concrete bolsters between the bottom of the slab and the stringer, without alteration of the slab thickness.*

	BY	DATE				
MADE	<i>D.L.A.</i>	<i>10-67</i>				
CHECKED	<i>TEM</i>	<i>2-68</i>	<i>1</i>	<i>As Built</i>	<i>TEM</i>	<i>7-77</i>
IN CHARGE	<i>PRY</i>		NO.	REVISION	BY	DATE

**RICHMOND METROPOLITAN AUTHORITY**  
**RICHMOND EXPRESSWAY SYSTEM**  
DOWNTOWN EXPRESSWAY

## RICHMOND EXPRESSWAY SYSTEM

DOWNTOWN EXPRESSWAY

BRIDGE R. 58

BRIDGE B-58  
3TH STREET OVER

7TH STREET OVER  
DOWNTOWN EXPRESS

HOWARD, NEEDLES, TAMMEN & BERGENDOFF  
consulting engineers  
NEW YORK ALEXANDRIA KANSAS CITY

NEW YORK      ALEXANDRIA      KANSAS CITY

[illegible]

SCALE: AS SHOWN

CONTRACT NO. 9

10

AS BUILT




194



RICHMOND EXPRESSWAY SYSTEM			
SECTION	PROJECT	SHEET NO.	TOTAL SHEETS
9	DOWNTOWN EXPRESSWAY	195	



TABLE A	
STRINGER	DIM "A"
S1, S2	9 1/2"
S3-S7	9 1/4"
S8-S15	9 1/2"

**NOTE "A":**  
Dimension shown is measured from top of stringer to top of slab at the intersection of the centerline of stringer and the centerline of bearing. At exterior stringers this is measured to the cross slope extended. This dimension may be varied between bearings as required to care for variation in camber, except that no portion of the stringer flange may fall within the 8" slab.

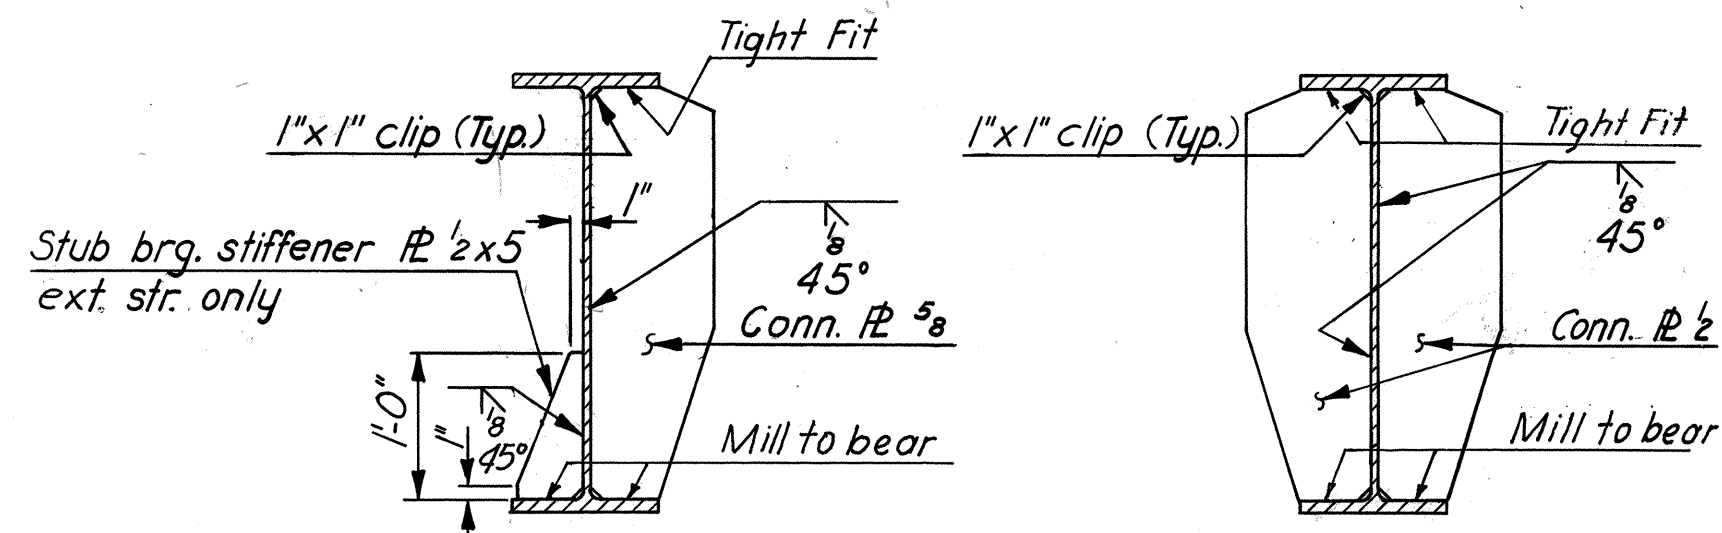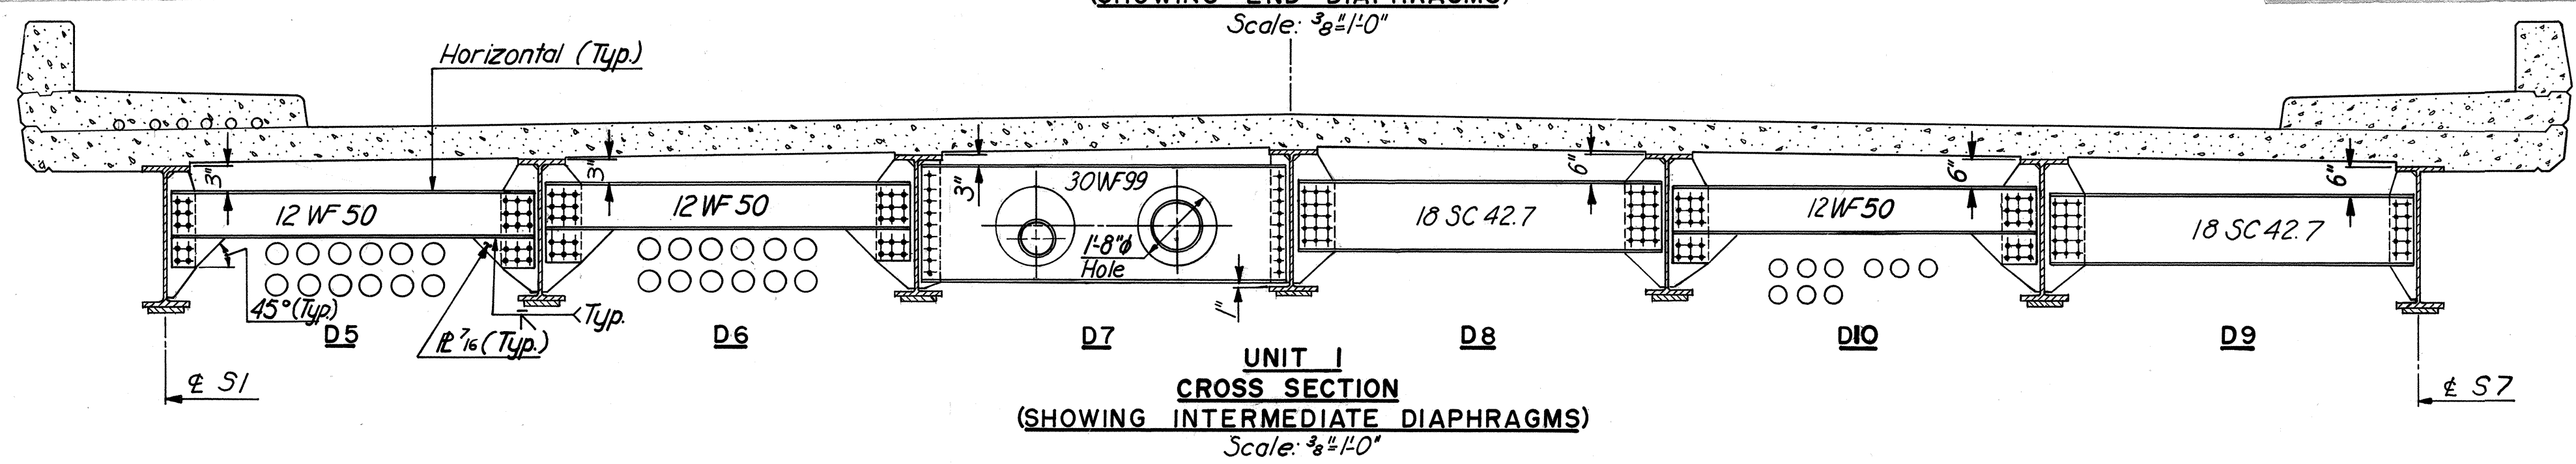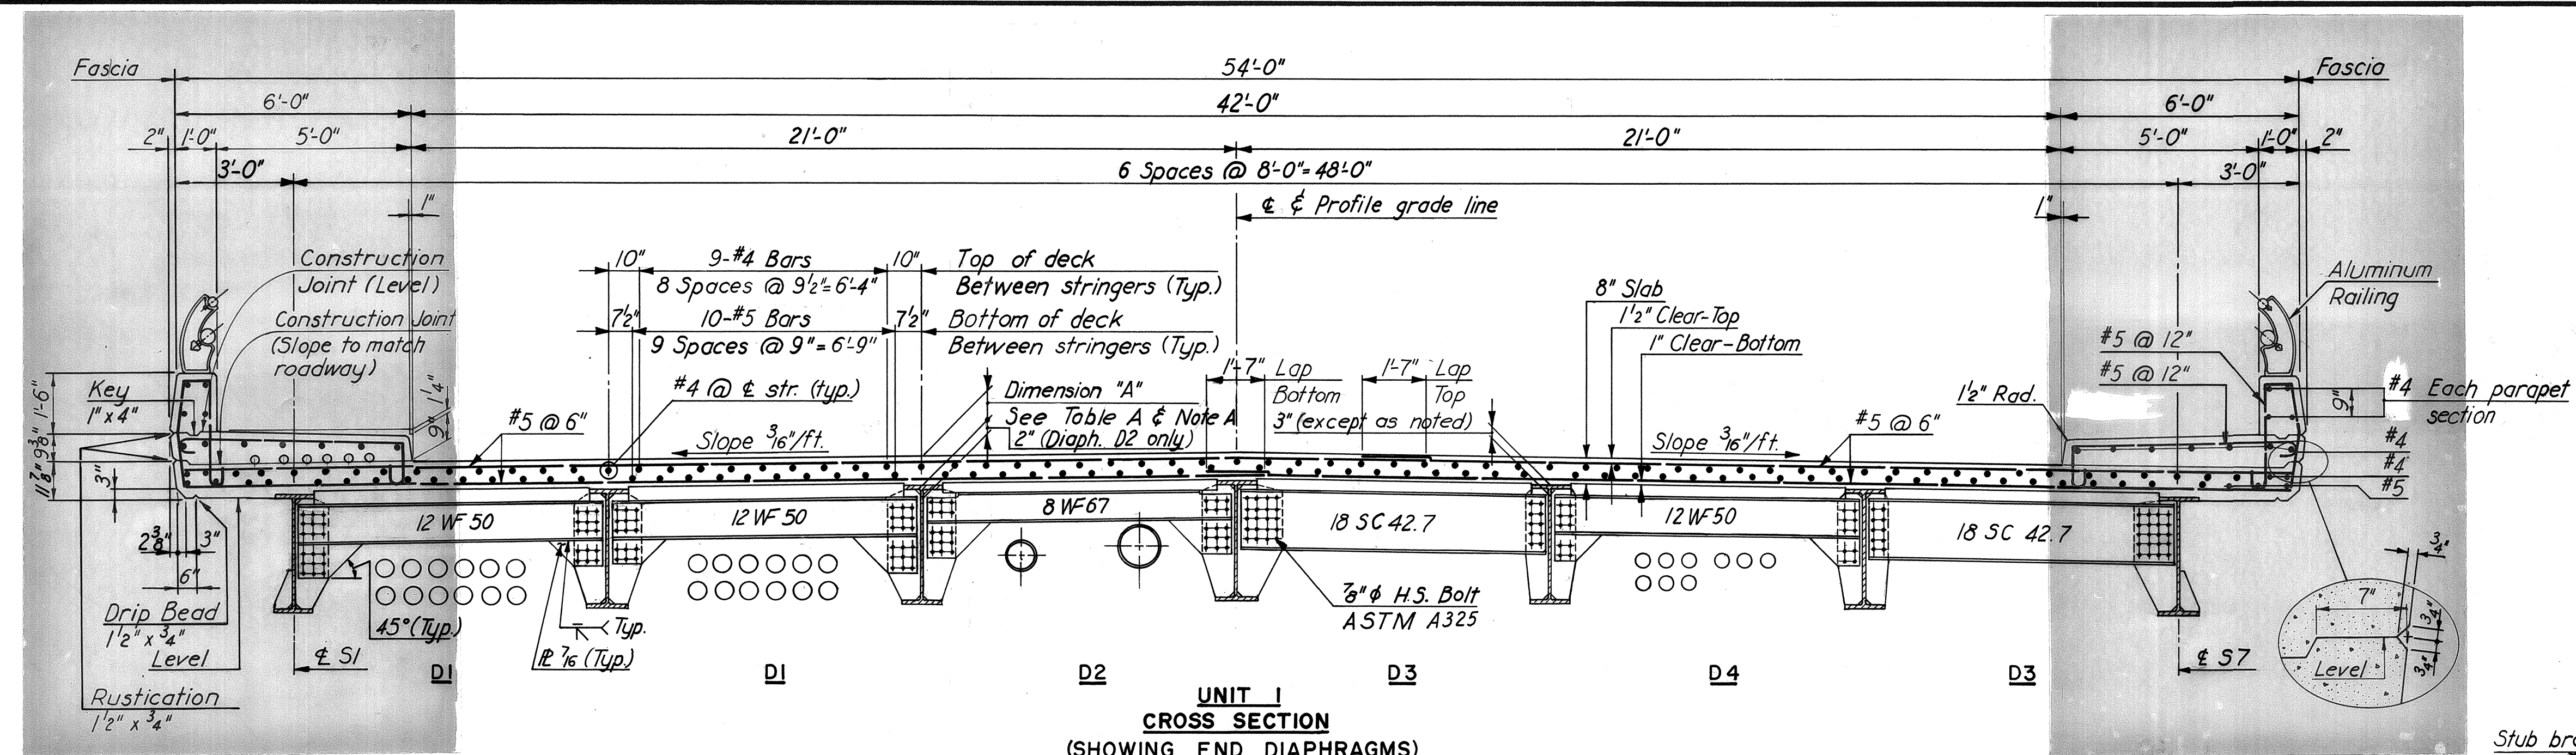


**TYP END DIAPHRAGM CONNECTOR PLATE AT EXTERIOR STRINGER**  
No Scale

**TYP END DIAPHRAGM CONNECTOR PLATE AT INTERIOR STRINGER**  
No Scale

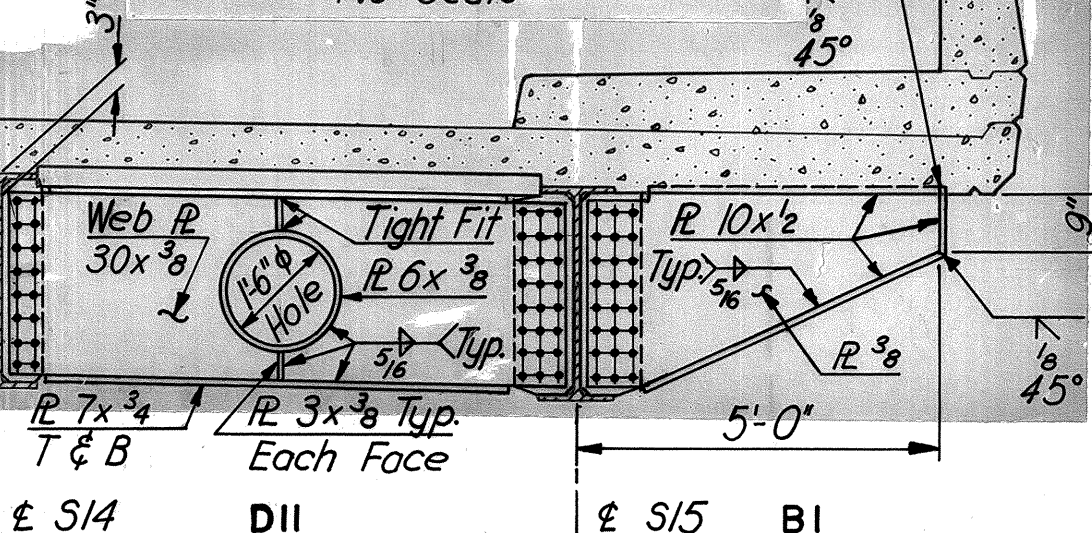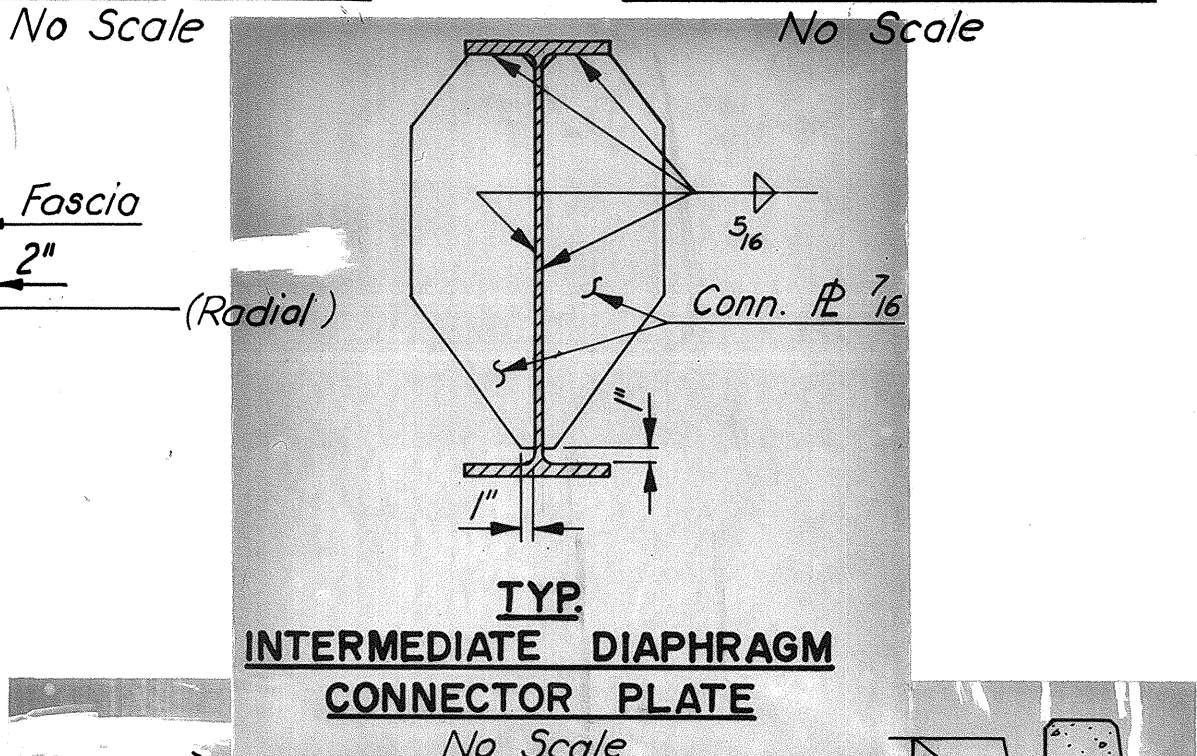


**UNIT 2 PARTIAL CROSS SECTION (SHOWING END DIAPHRAGM AT SOUTH ABUTMENT)**  
Scale: 3/8"=1'-0"




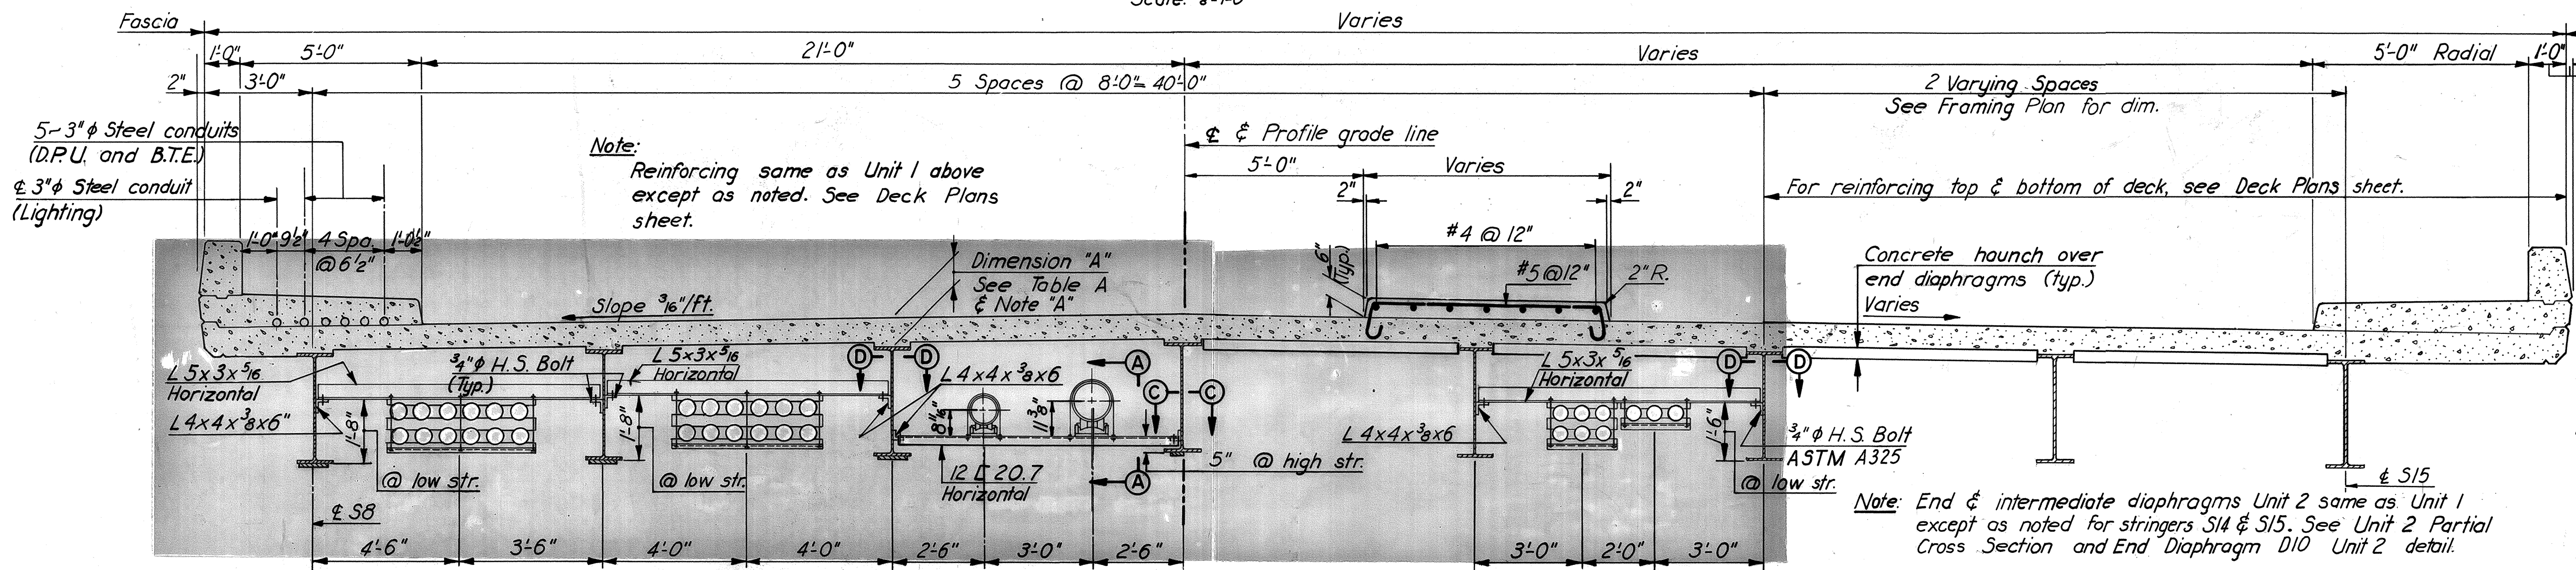


**NOTE:** End & intermediate diaphragms Unit 2 same as Unit 1 except as noted for stringers S14 & S15. See Unit 2 Partial Cross Section and End Diaphragm D10 Unit 2 detail.

**NOTES:**  
For spacing and location of utility supports and diaphragms, see Framing Plan sheet.  
For Basic Attachment Details for cement asbestos conduit, see Standard Conduit Installation Details sheet.  
For details showing gas and water mains thru abutments, see Standard Utility Support Details At Bridge Abutments sheet.

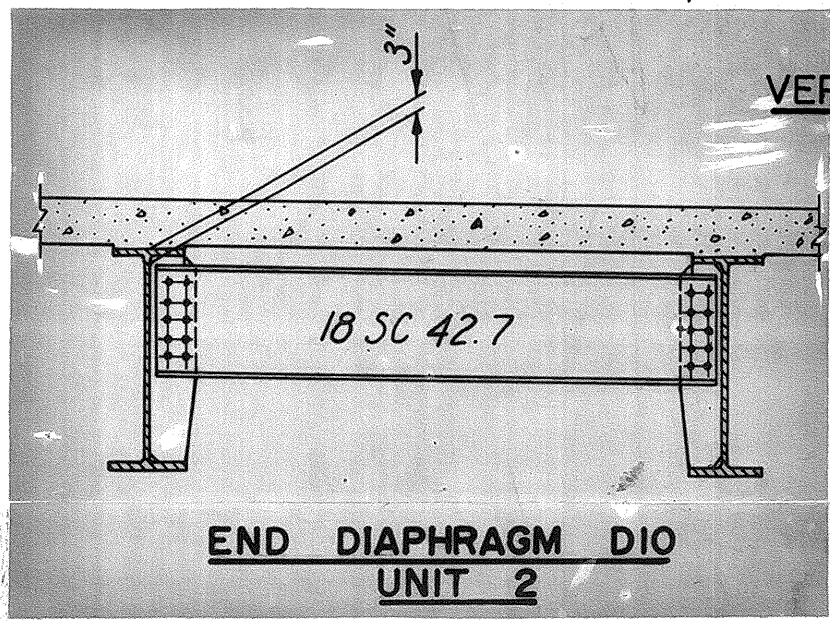

BY	DATE				
MADE	EVR	10-67			
CHECKED	TEM	2-68	1	As Built	TEM 7-77
IN CHARGE	PRY		NO.	REVISION	BY DATE

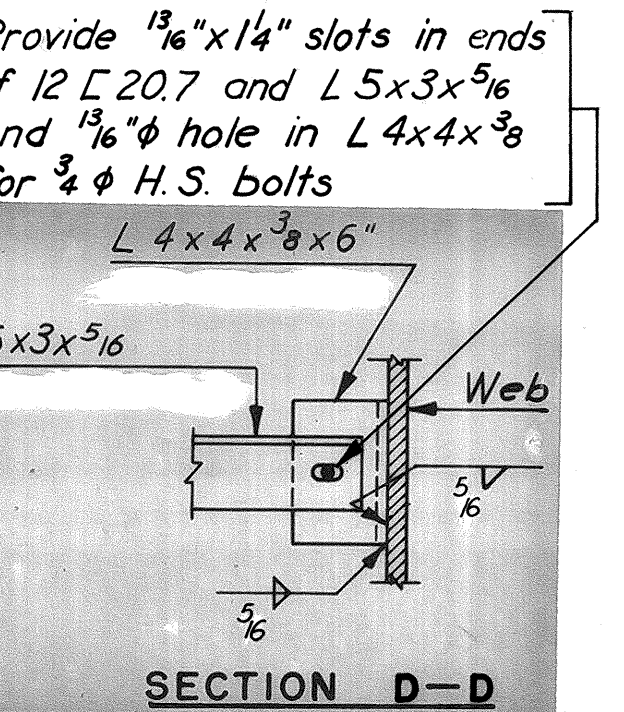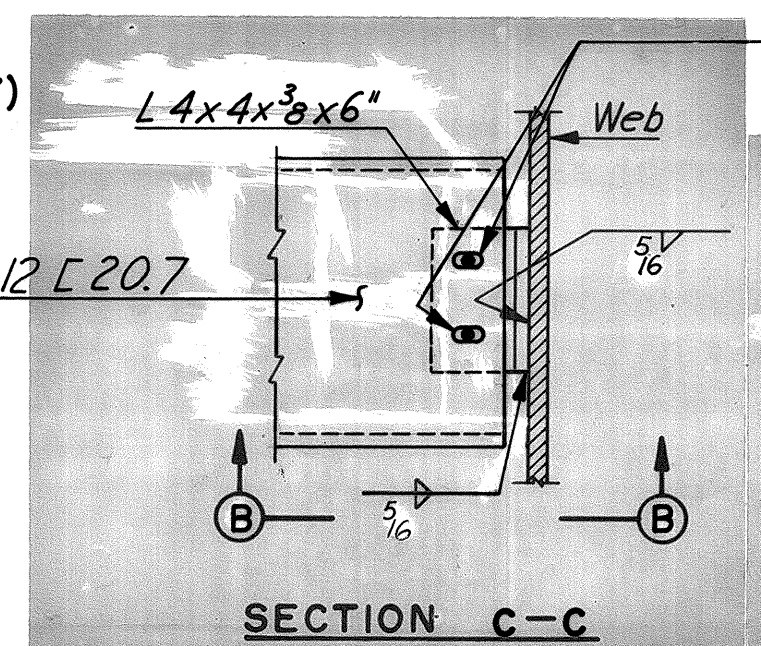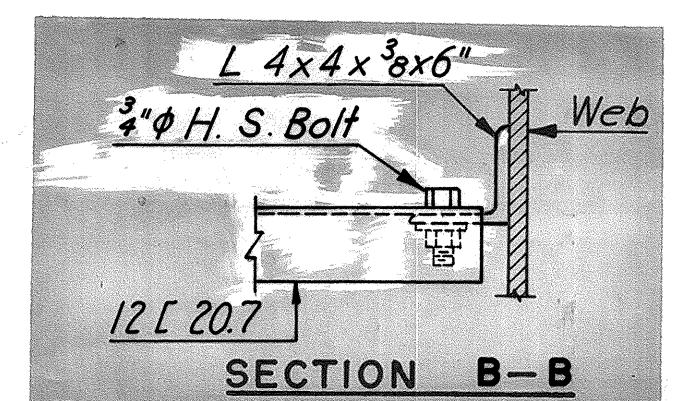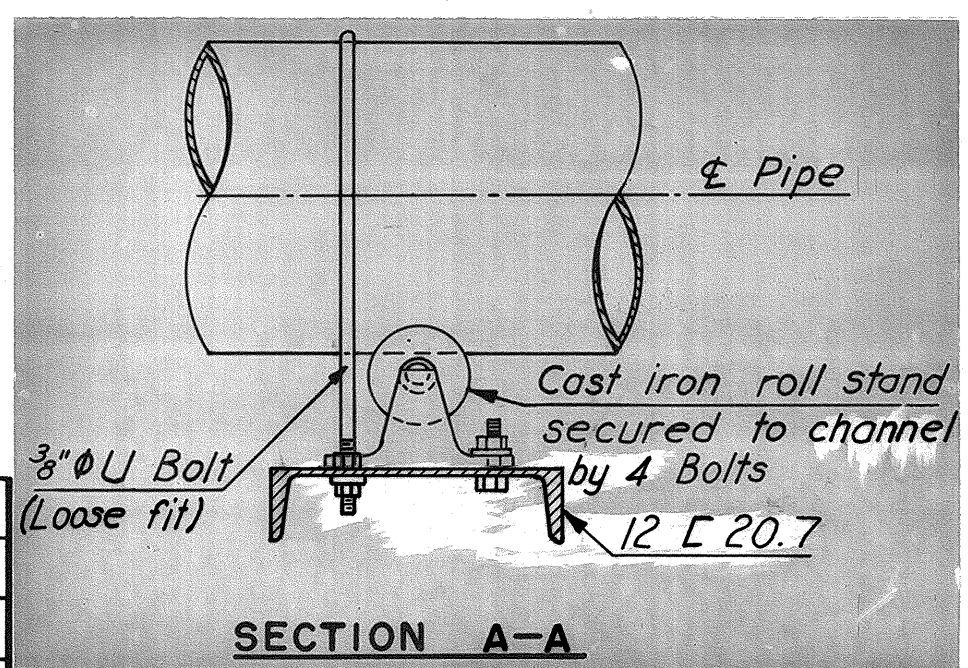

**RICHMOND METROPOLITAN AUTHORITY**  
**RICHMOND EXPRESSWAY SYSTEM**  
**DOWNTOWN EXPRESSWAY**  
**BRIDGE B-58**  
**7TH STREET OVER**  
**DOWNTOWN EXPRESSWAY**  
**CROSS SECTION AND UTILITY DETAILS**


HOWARD, NEEDLES, TAMMEN & BERGENDOFF  
consulting engineers  
NEW YORK ALEXANDRIA KANSAS CITY

SCALE: AS SHOWN  
CONTRACT NO.: 9  
SHEET NO. 11 OF 17

AS BUILT



RICHMOND EXPRESSWAY SYSTEM			
SECTION	PROJECT	SHEET NO.	TOTAL SHEETS
9	DOWNTOWN EXPRESSWAY	196	

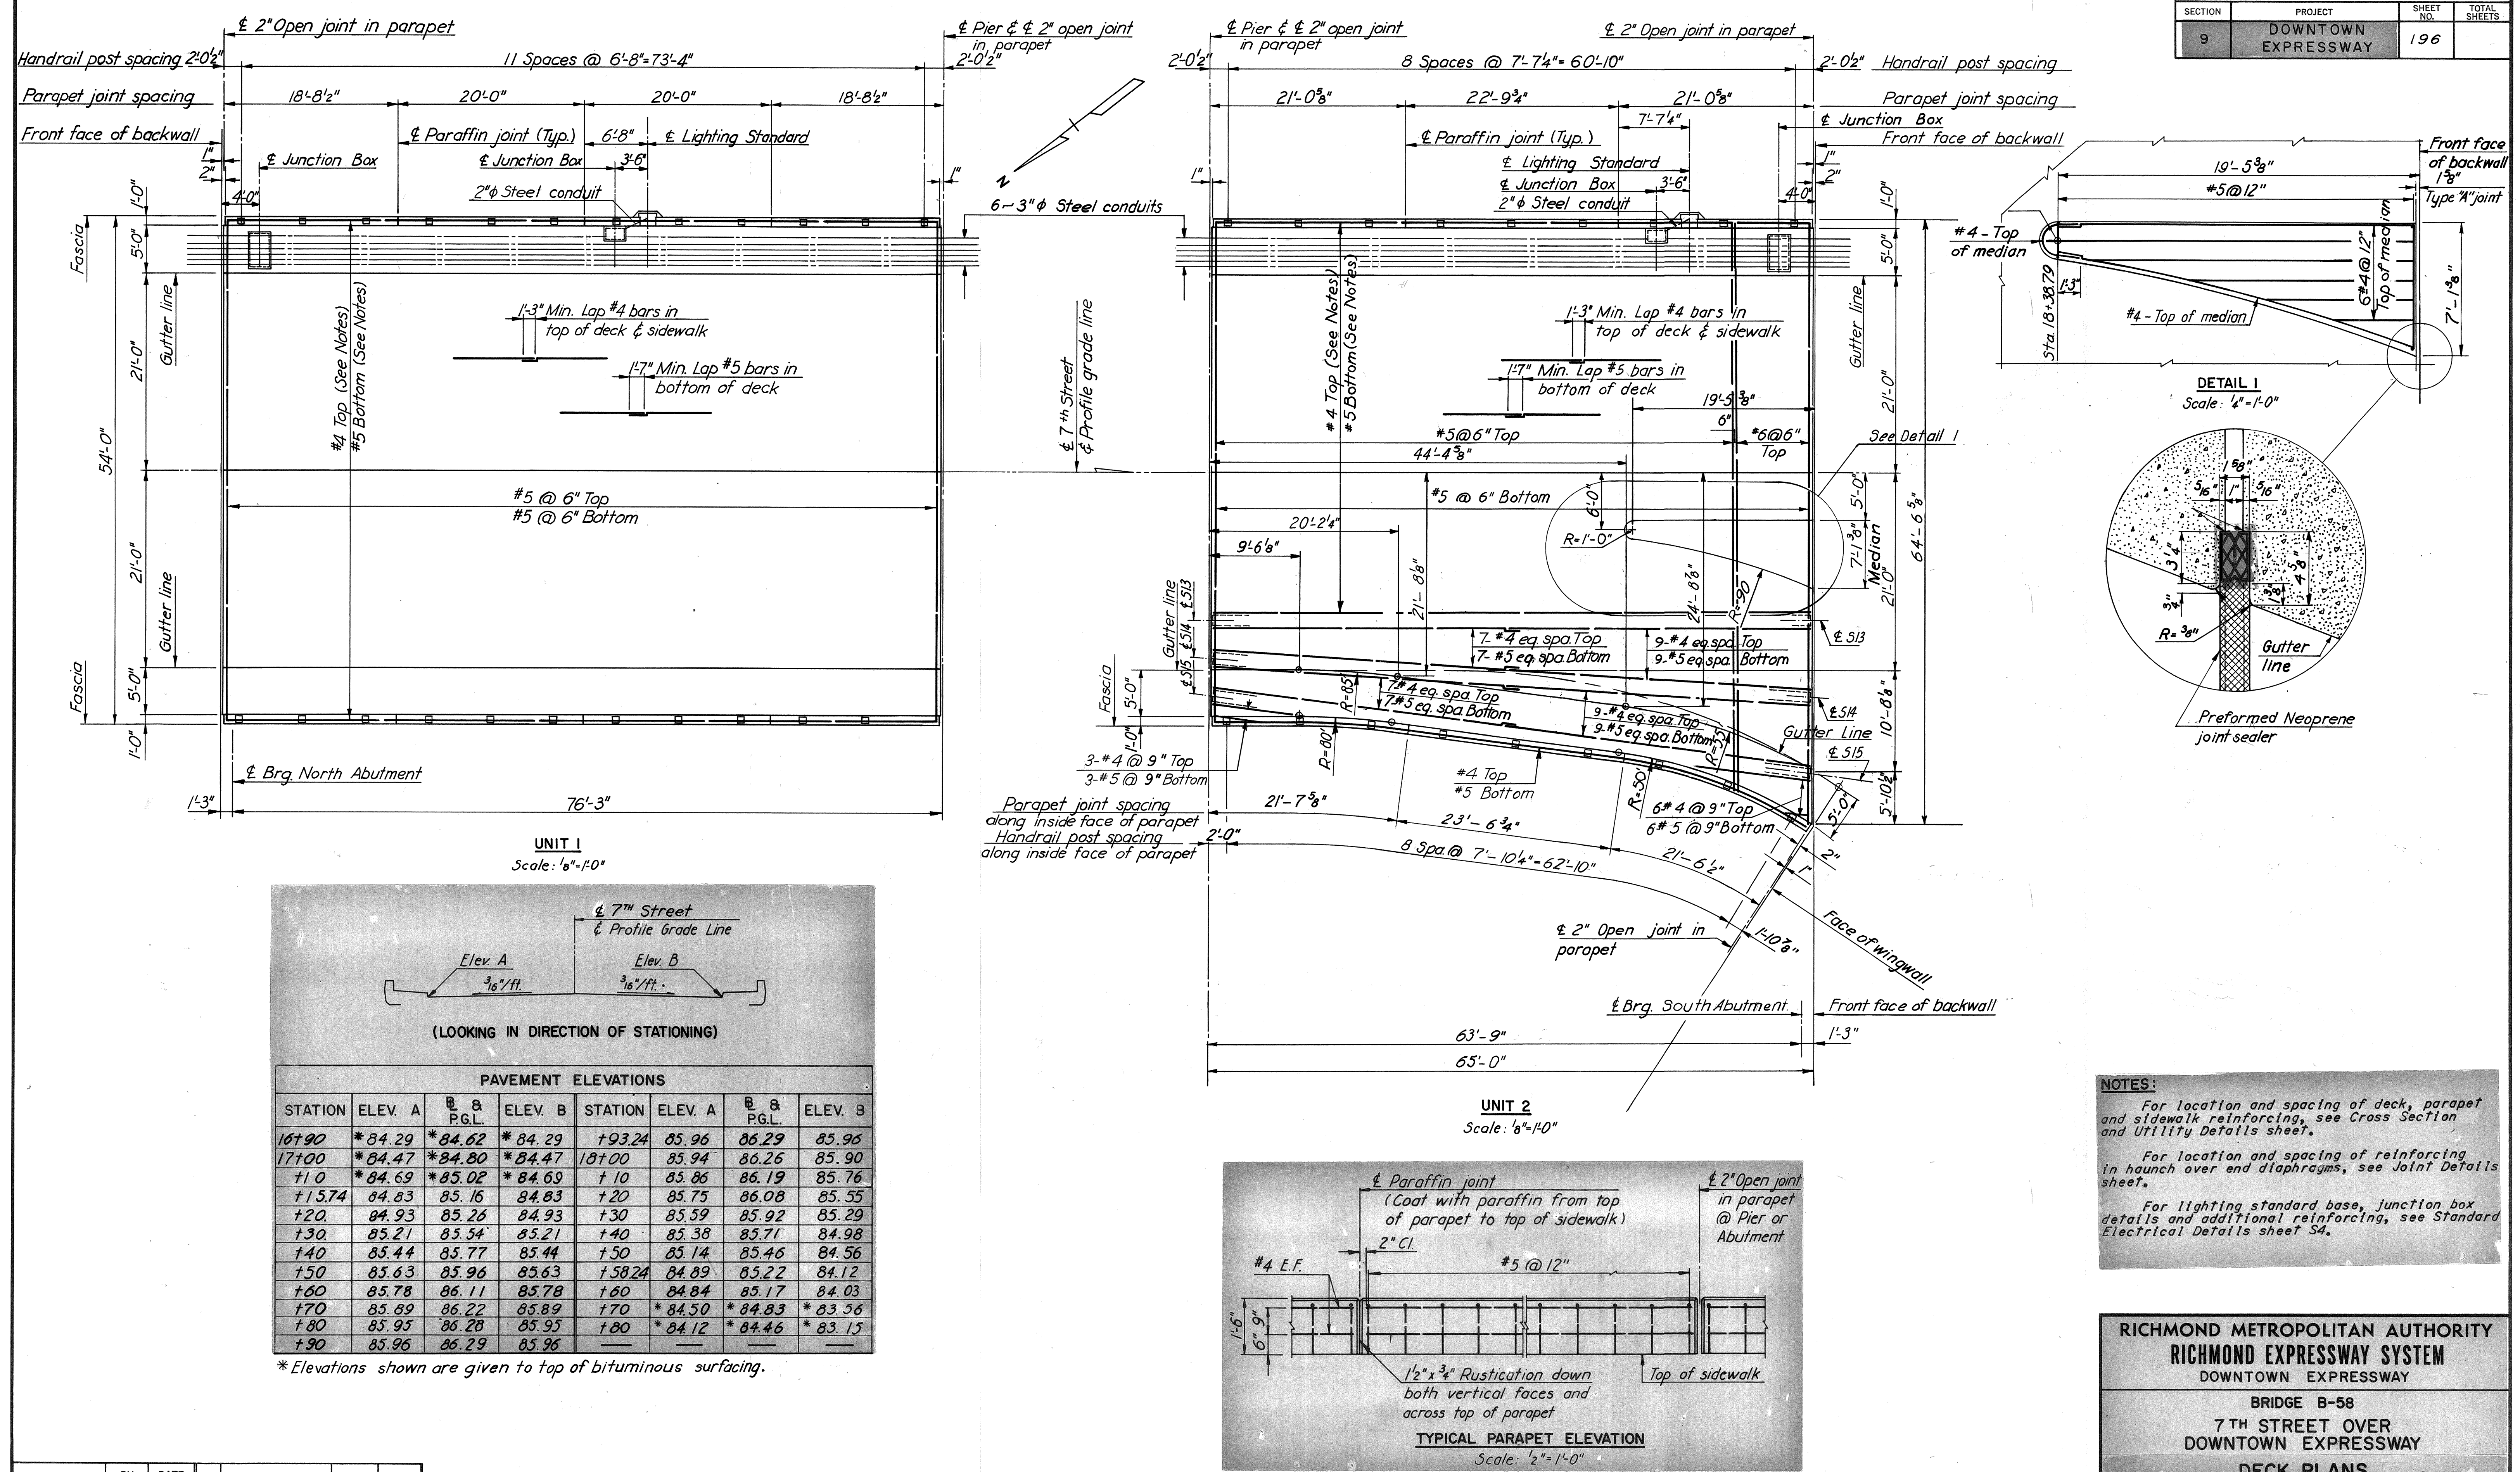

**NOTES:**

For location and spacing of deck, parapet and sidewalk reinforcing, see Cross Section and Utility Details sheet.

For location and spacing of reinforcing in haunch over end diaphragms, see Joint Details sheet.

For lighting standard base, junction box details and additional reinforcing, see Standard Electrical Details sheet S4.


RICHMOND METROPOLITAN AUTHORITY  
RICHMOND EXPRESSWAY SYSTEM  
DOWNTOWN EXPRESSWAY  
BRIDGE B-58  
7TH STREET OVER  
DOWNTOWN EXPRESSWAY  
DECK PLANS

SCALE: AS SHOWN  
HOWARD, NEEDLES, TAMMEN & BERGENDOFF  
consulting engineers  
NEW YORK ALEXANDRIA KANSAS CITY  
CONTRACT NO. 9  
SHEET NO. 12 OF 17


BY	DATE				
MADE	J.B.M. 1-68				
CHECKED	TEM 2-68	1	As Built	TEM	7-77
IN CHARGE	PRY	NO.	REVISION	BY	DATE

AS BUILT




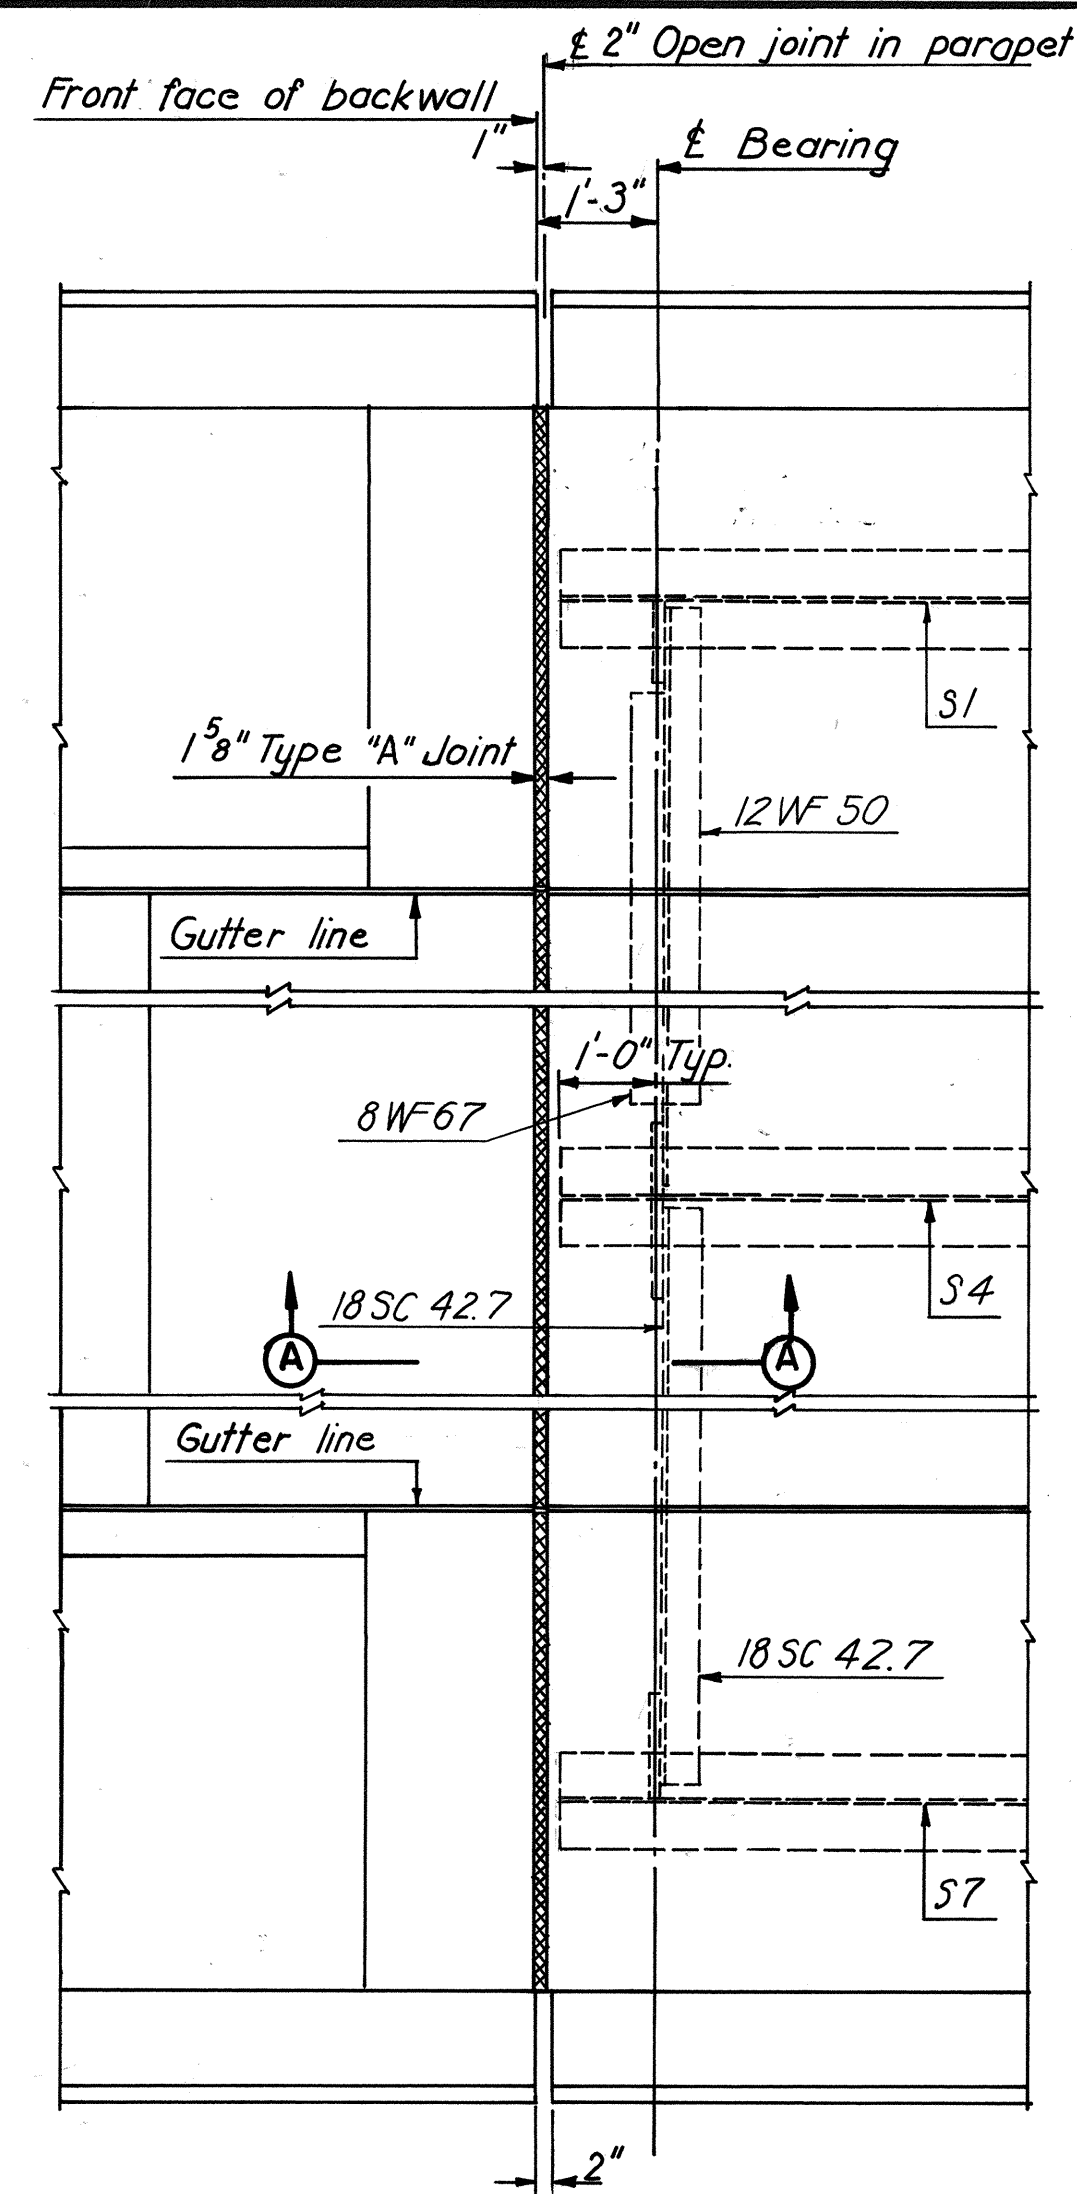


PLAN - JOINT AT NORTH ABUTMENT  
Scale: 1/2" = 1'-0"

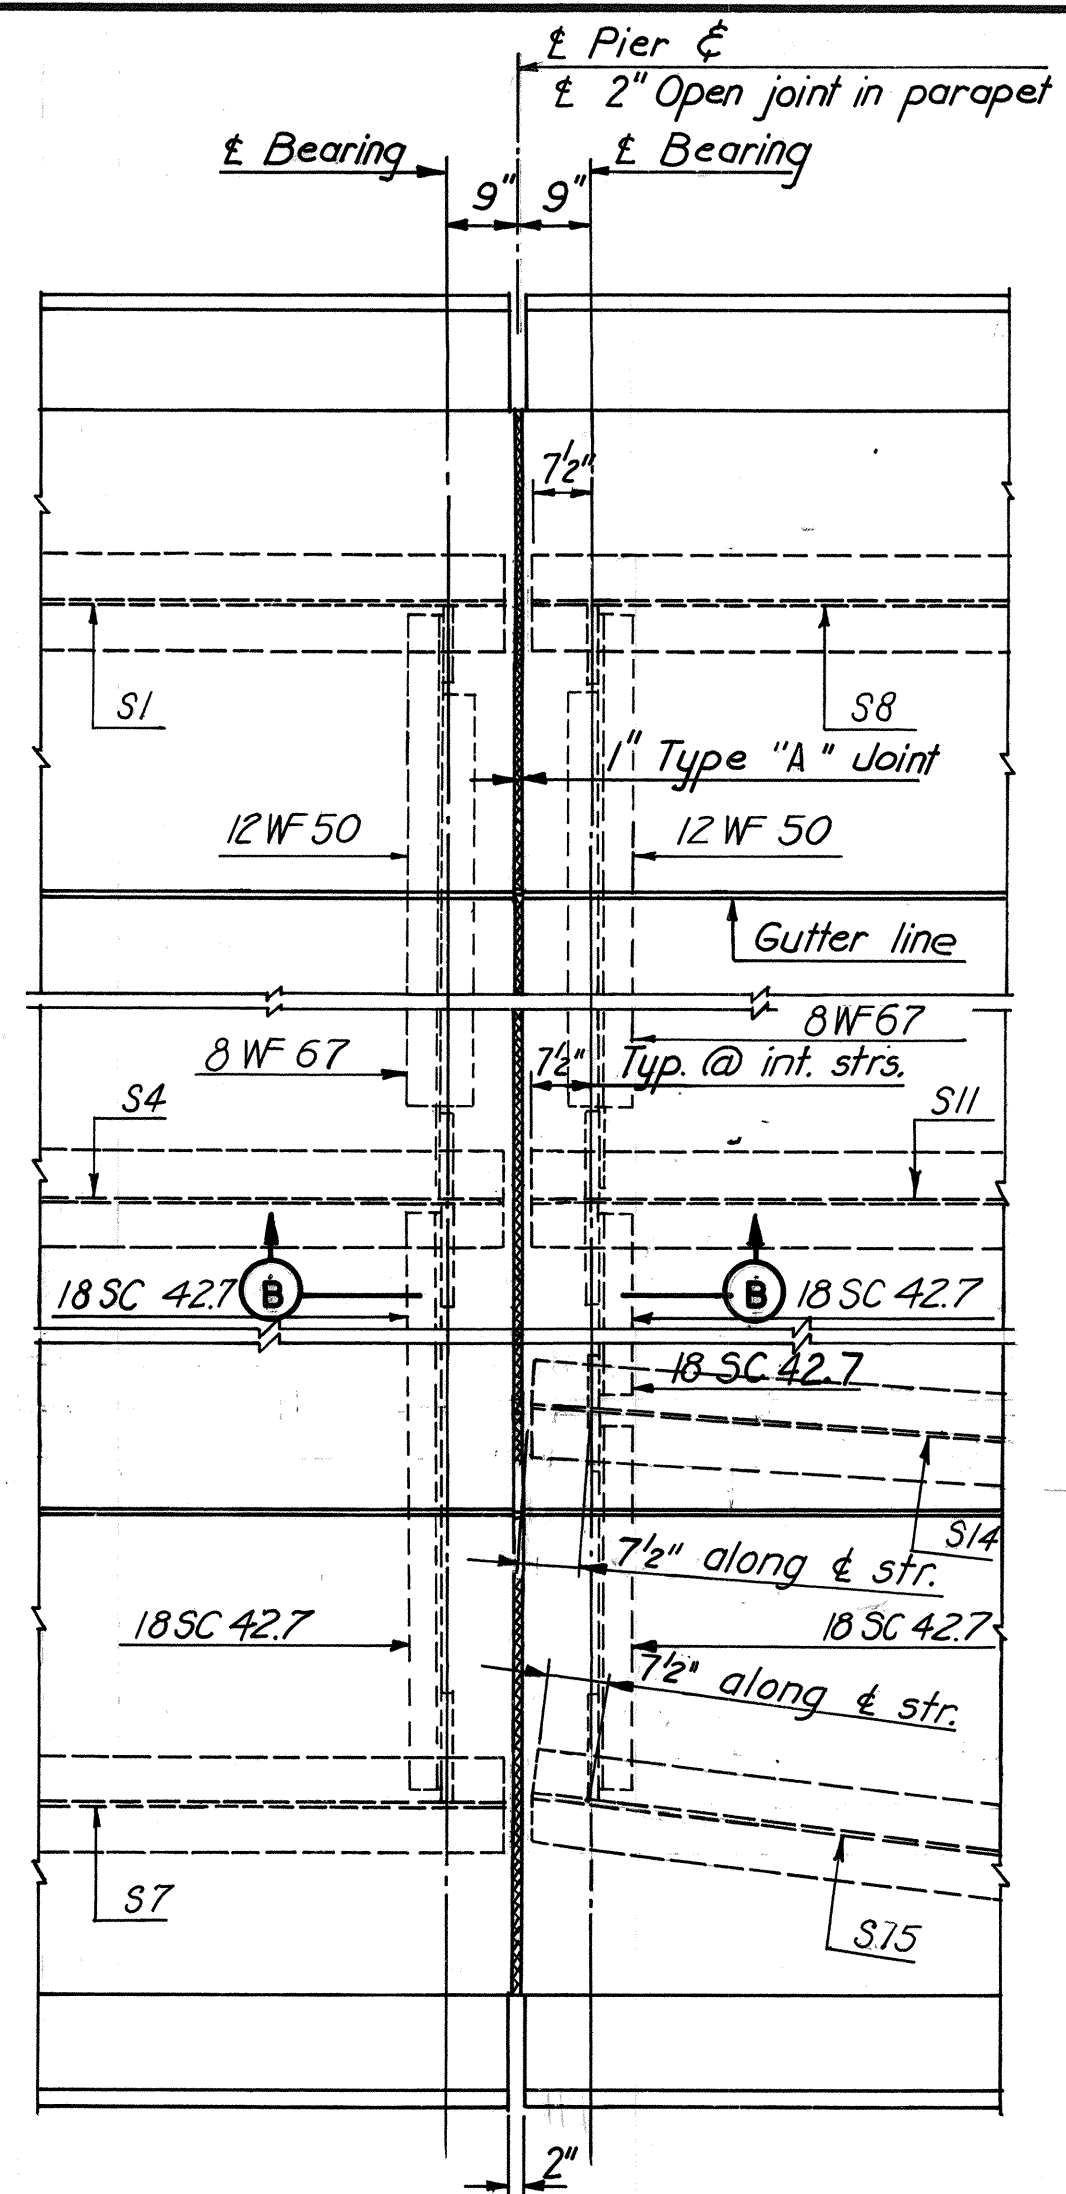


PLAN - JOINT AT PIER  
Scale: 1/2" = 1'-0"

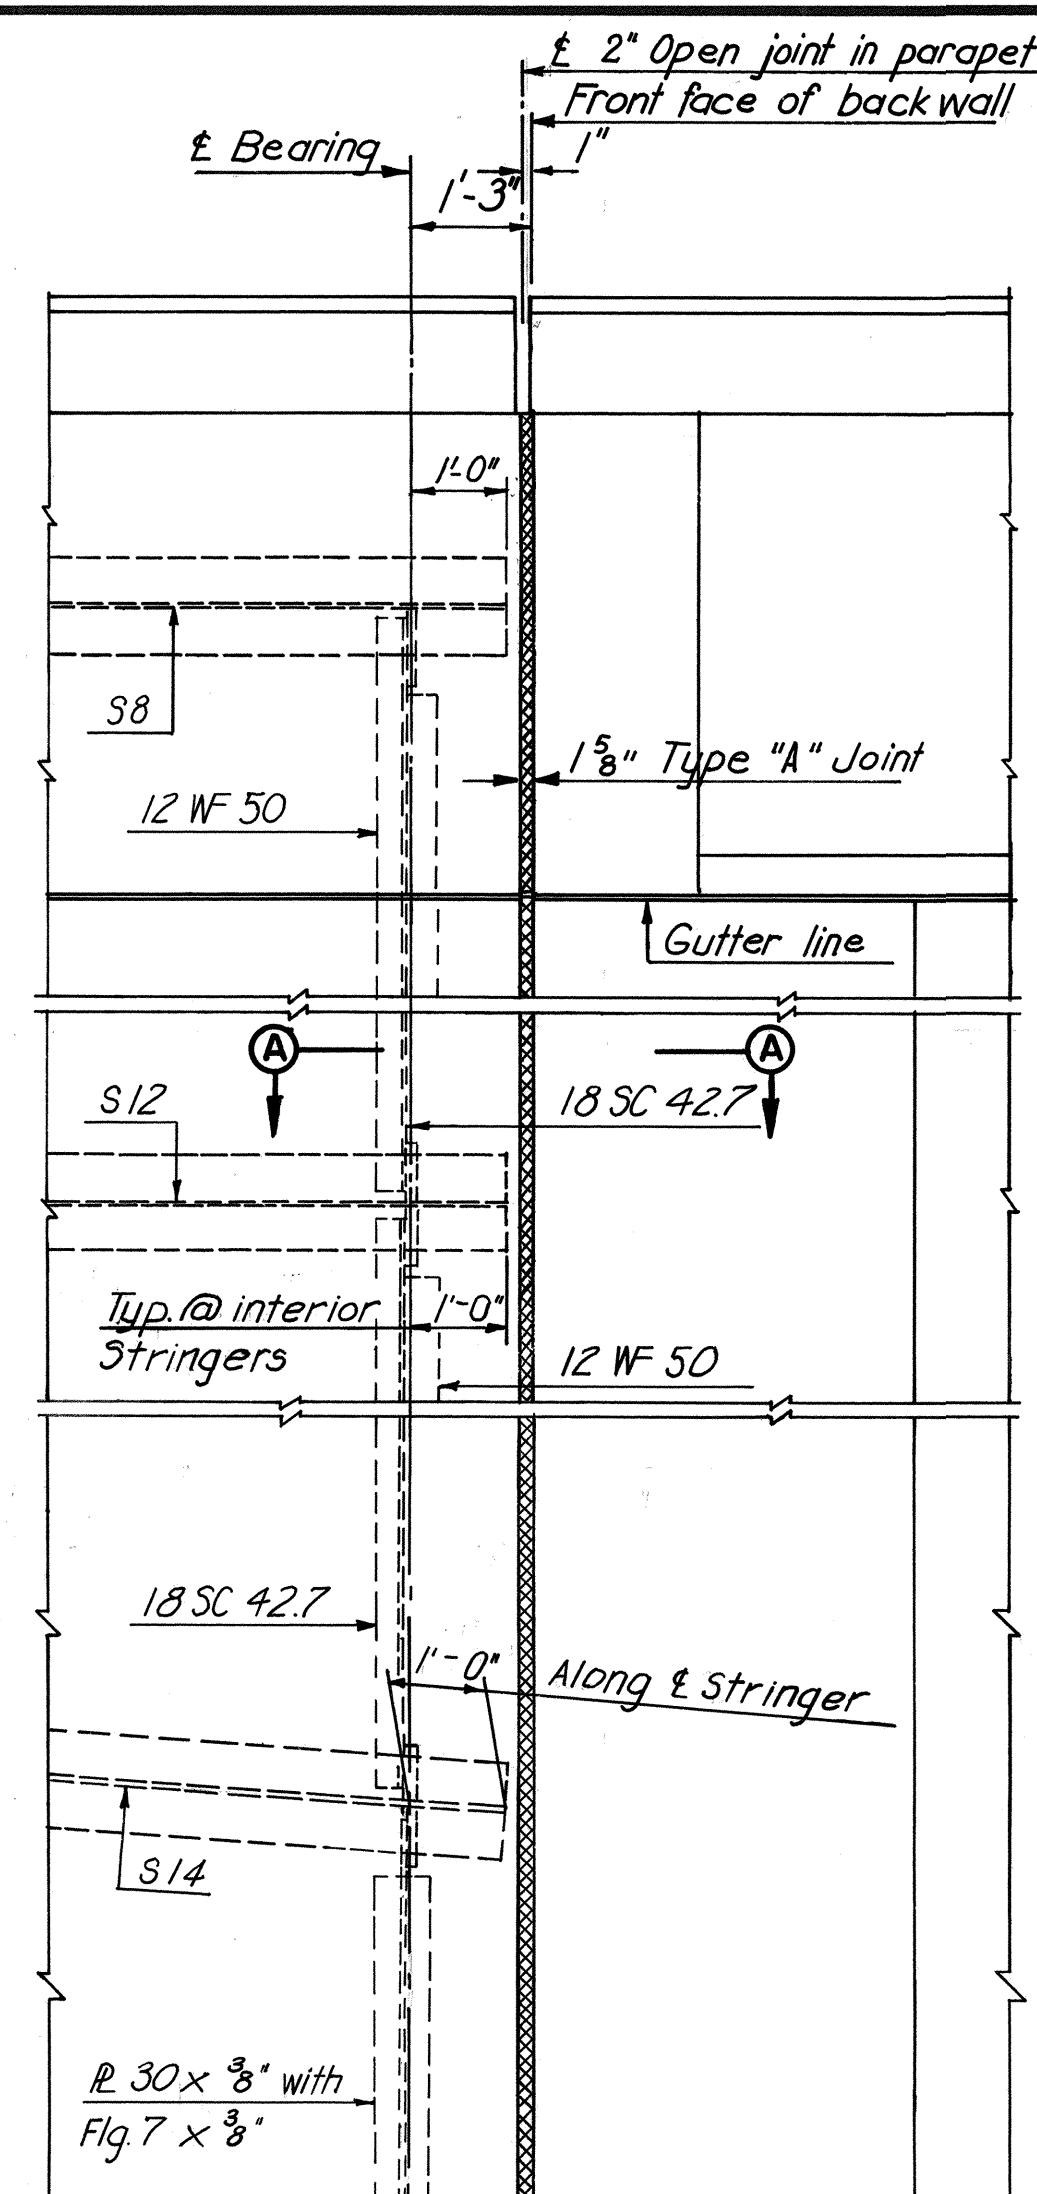

PLAN - JOINT AT SOUTH ABUTMENT  
Scale: 1/2" = 1'-0"

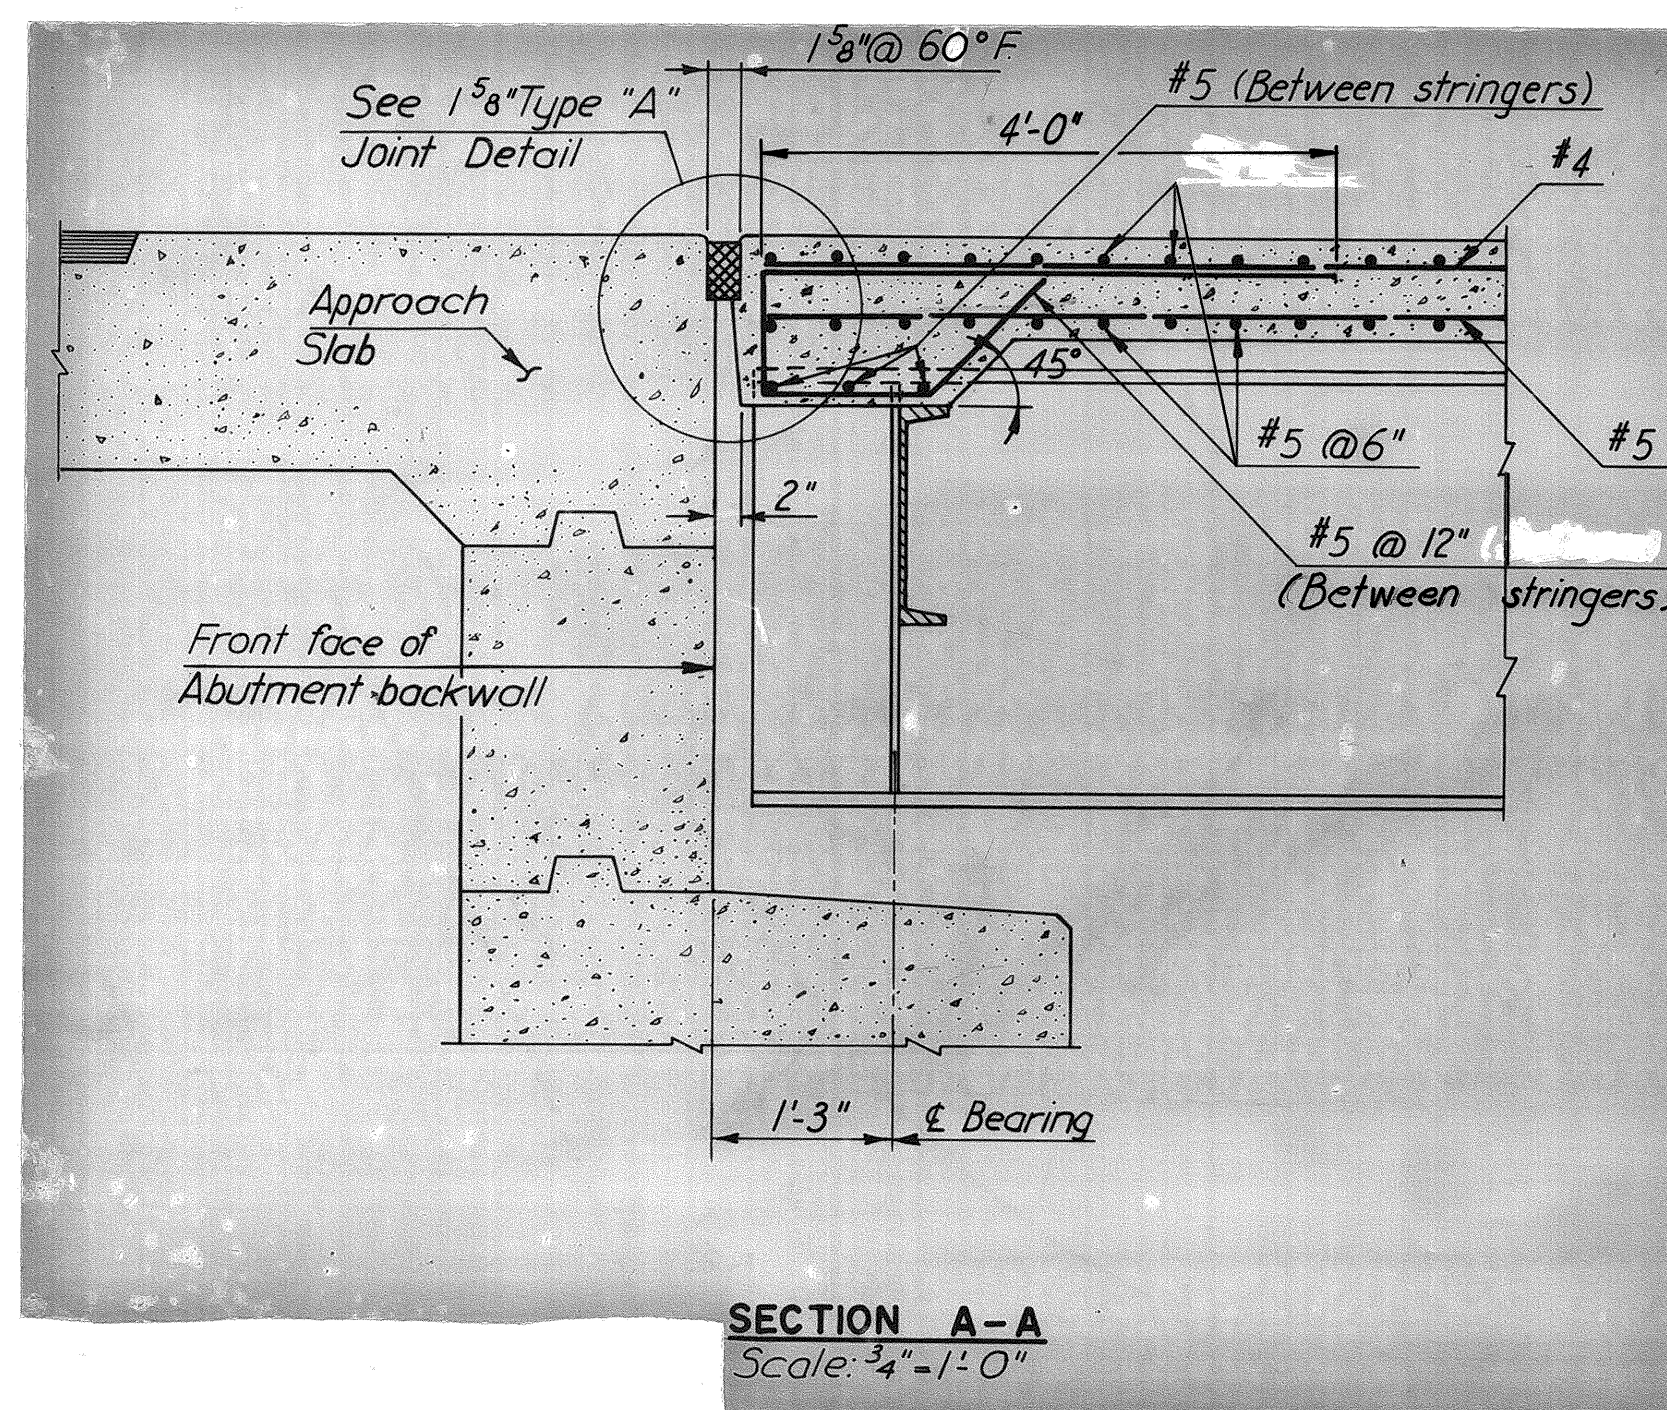


SECTION A-A  
Scale: 3/4" = 1'-0"

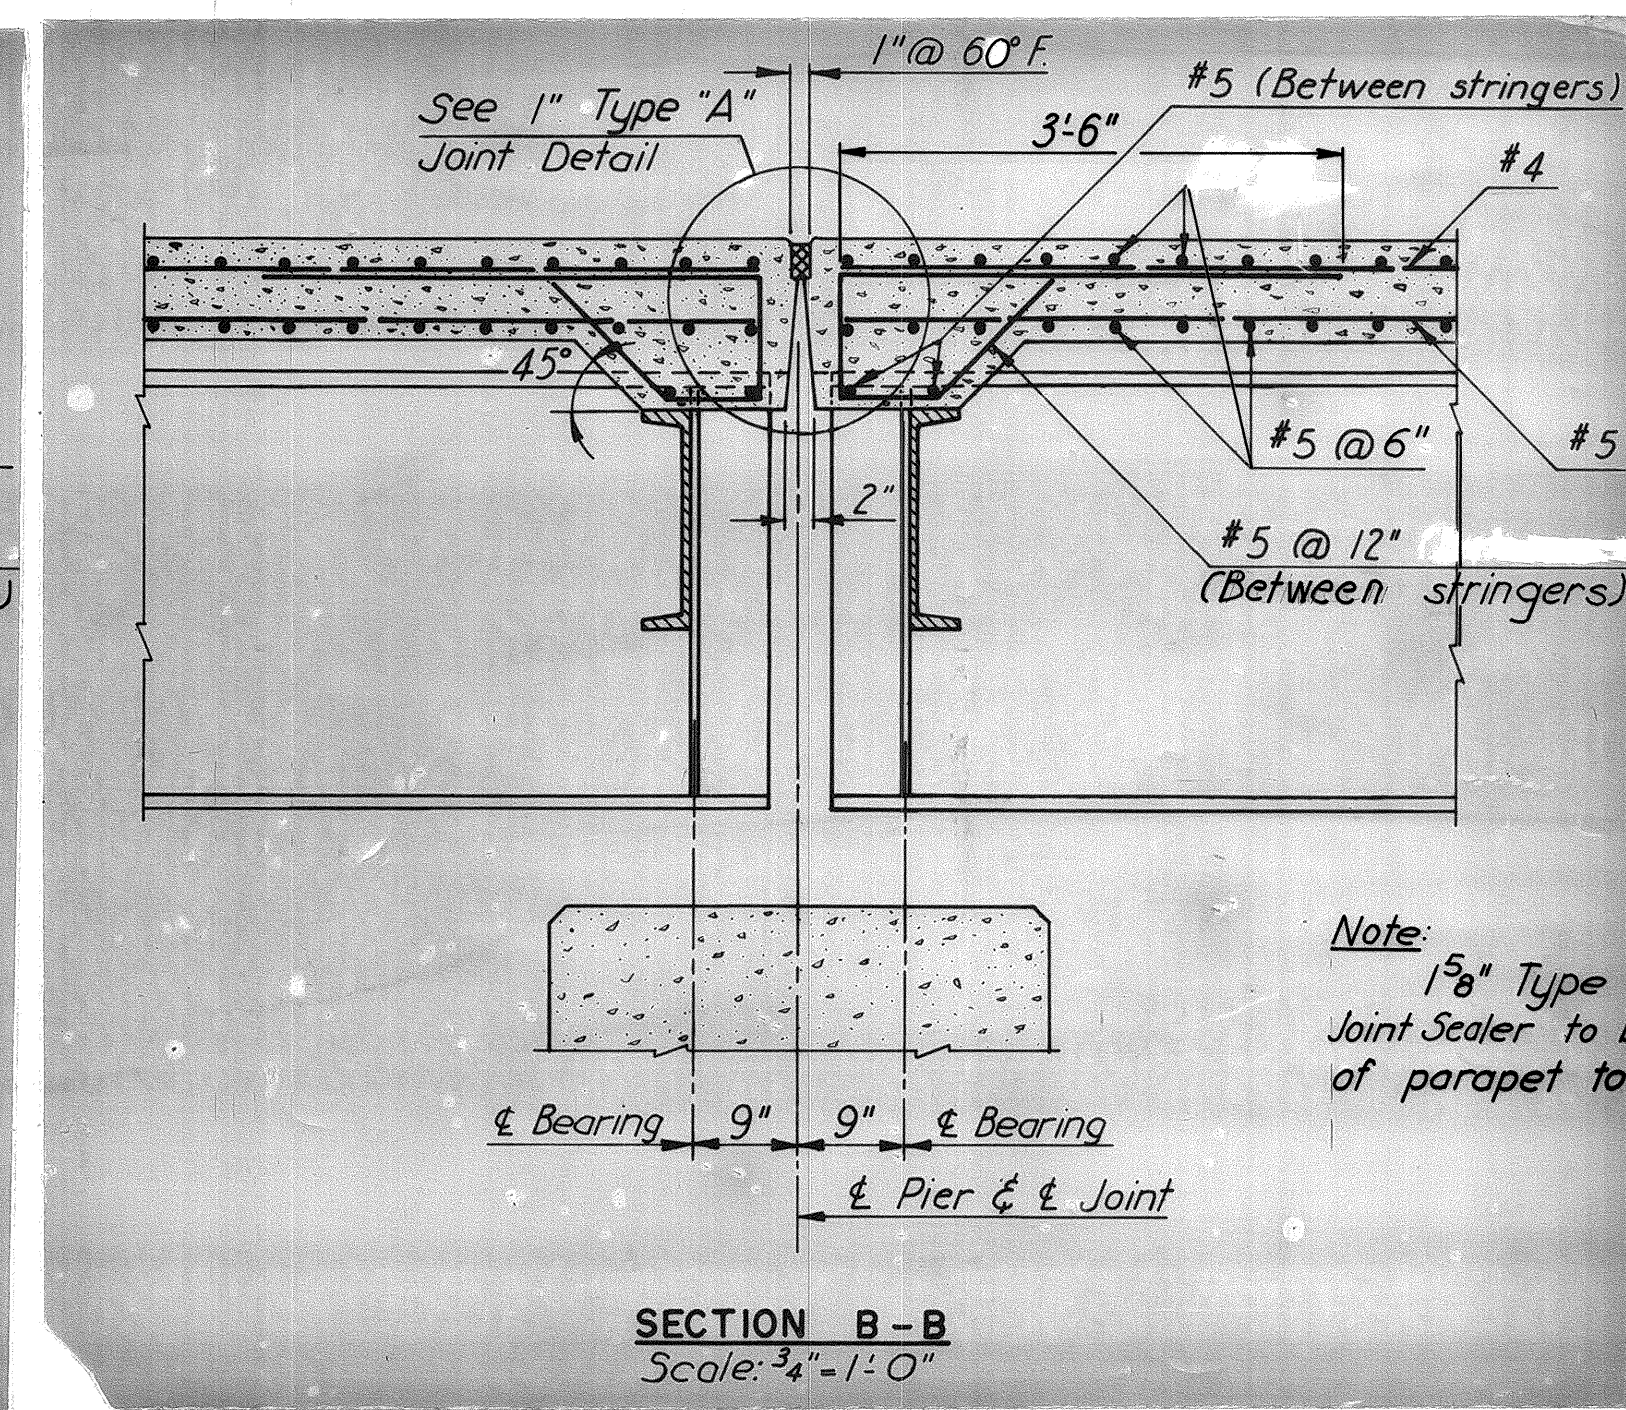


SECTION B-B  
Scale: 3/4" = 1'-0"

Note:  
1 1/2" Type "A" Preformed Neoprene Joint Sealer to be continuous from face of parapet to face of parapet.


Preformed Neoprene joint sealer

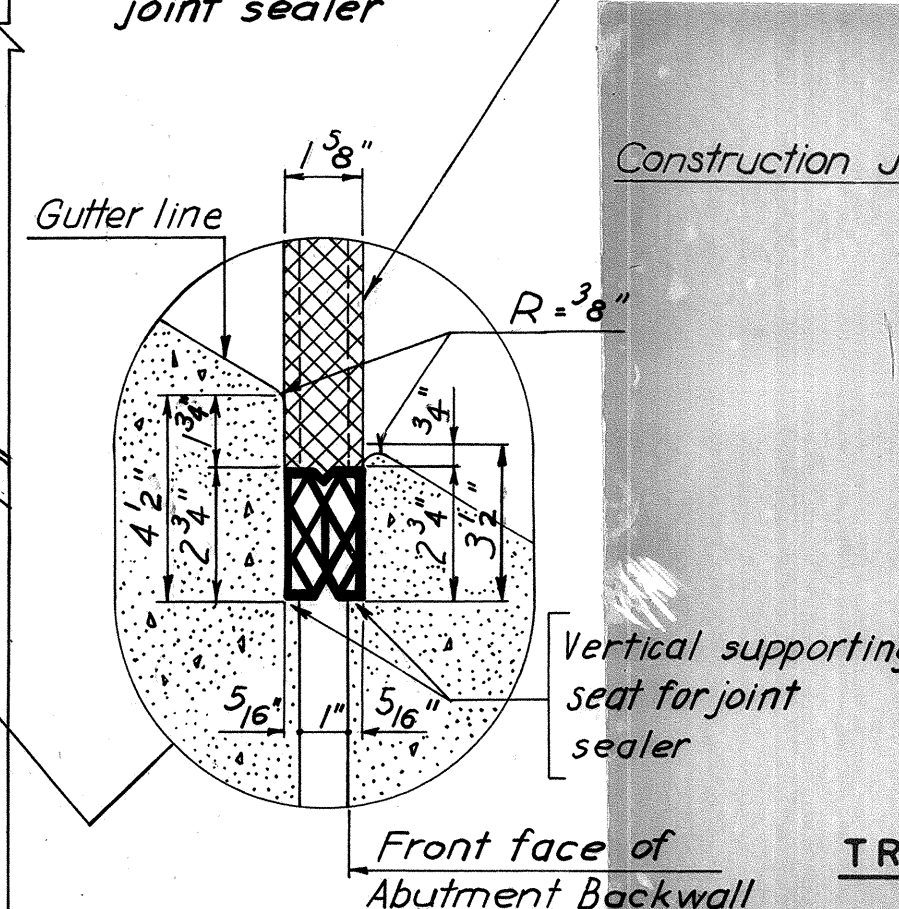


NOTE TO CONTRACTOR:  
It is absolutely essential that the openings for the preformed Neoprene joint sealers be accurately formed and constructed to smooth, straight lines. The size of the opening shall be adjusted to allow for anticipated dead load rotation of the ends of the slab and for the temperature at the time of construction.

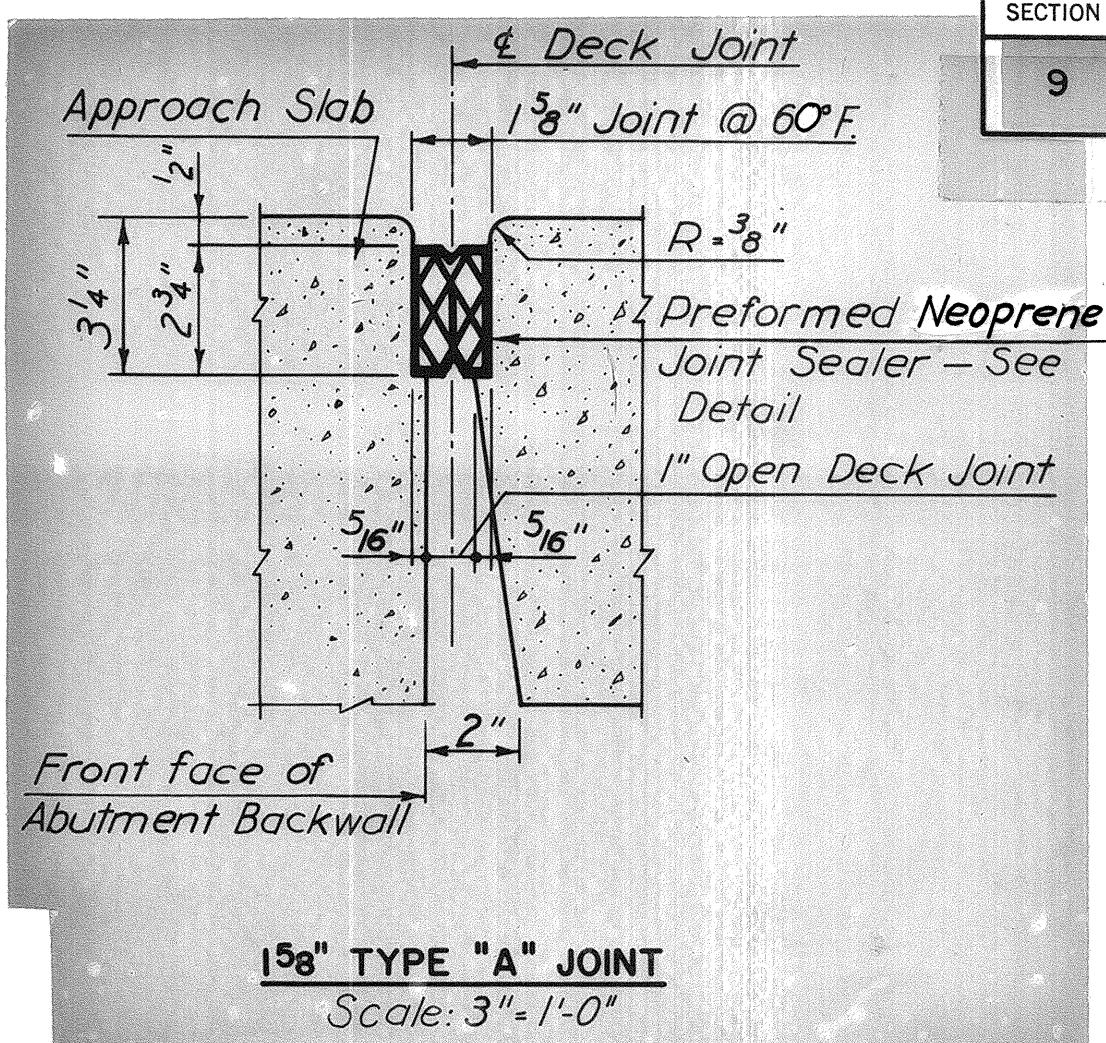


1 1/2" TYPE "A" JOINT  
Scale: 3/4" = 1'-0"

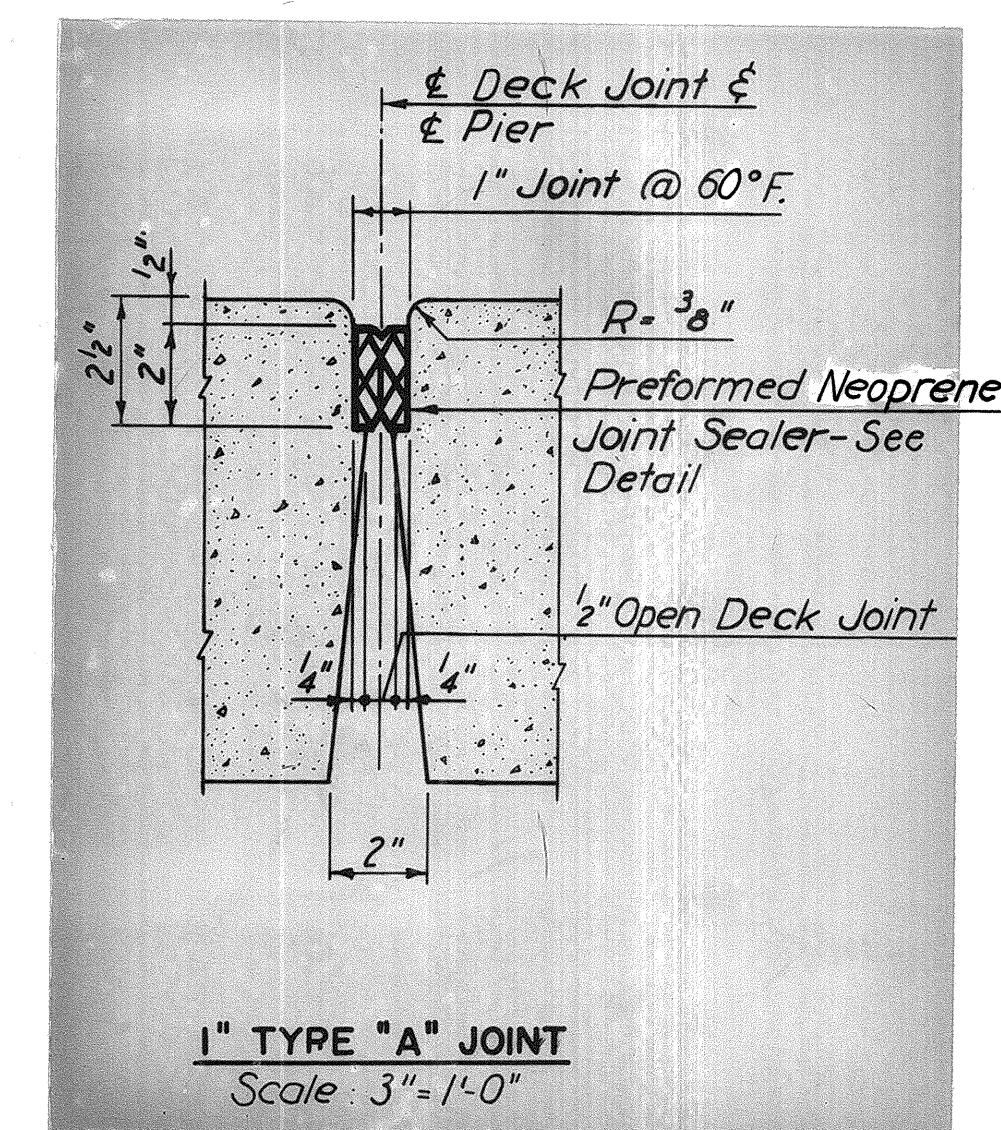

1" TYPE "A" JOINT  
Scale: 3/4" = 1'-0"

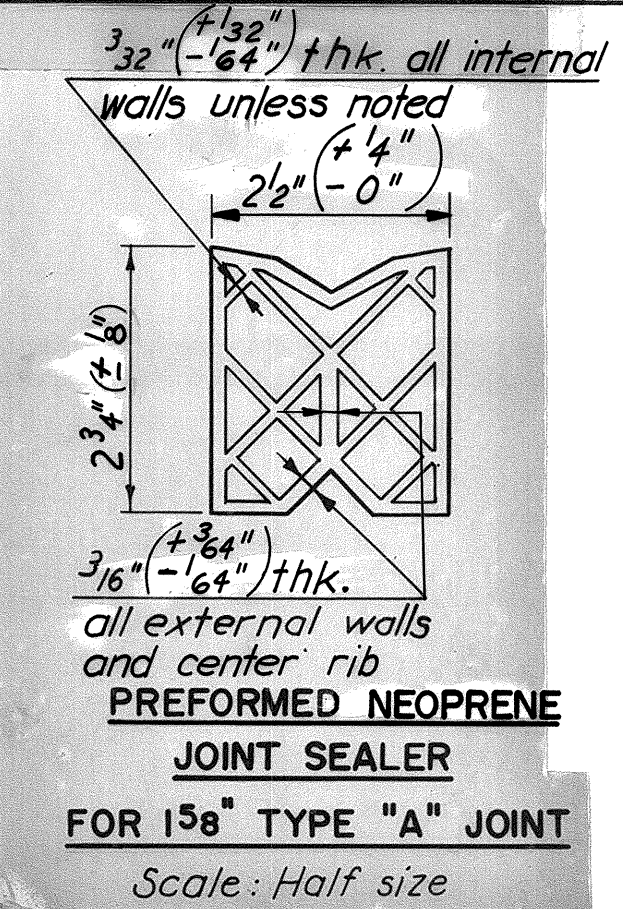

PREFORMED NEOPRENE JOINT SEALER  
FOR 1 1/2" TYPE "A" JOINT  
Scale: Half size

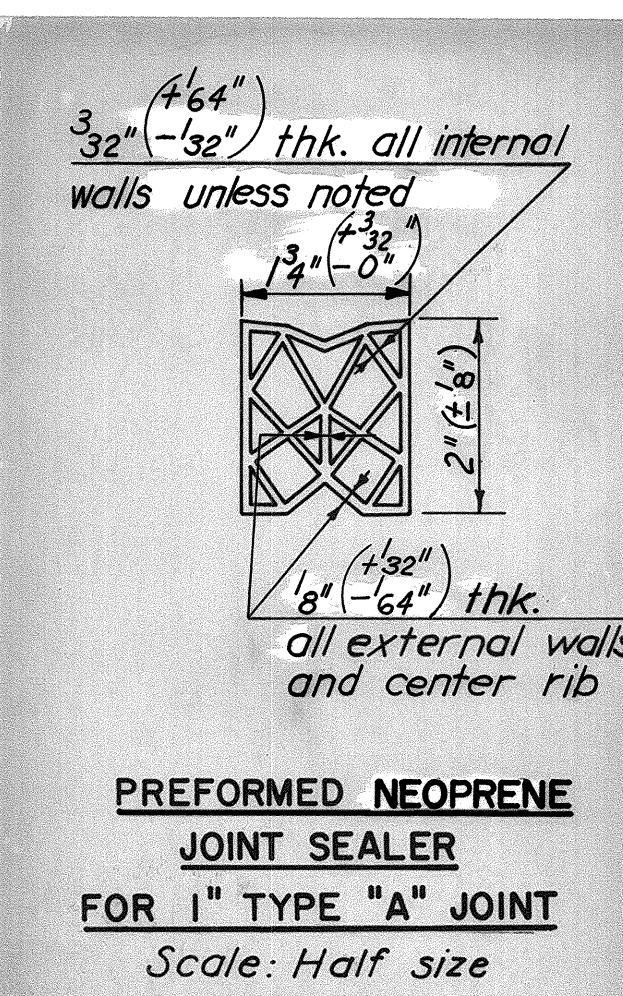

PREFORMED NEOPRENE JOINT SEALER  
FOR 1" TYPE "A" JOINT  
Scale: Half size

RICHMOND METROPOLITAN AUTHORITY  
RICHMOND EXPRESSWAY SYSTEM  
DOWNTOWN EXPRESSWAY  
BRIDGE B-58  
7TH STREET OVER  
DOWNTOWN EXPRESSWAY  
JOINT DETAILS



HOWARD, NEEDLES, TAMMEN & BERGENDOFF  
consulting engineers  
NEW YORK ALEXANDRIA KANSAS CITY  
SCALE: AS SHOWN  
CONTRACT NO. 9  
SHEET NO. 13 OF 17

AS BUILT


BY	DATE				
MADE	EVR	1-68			
CHECKED	TEM	2-68	1	As Built	TEM 7-77
IN CHARGE	PRY		NO.	REVISION	BY DATE




RICHMOND EXPRESSWAY SYSTEM			
SECTION	PROJECT	SHEET NO.	TOTAL SHEETS
9	DOWNTOWN EXPRESSWAY	198	

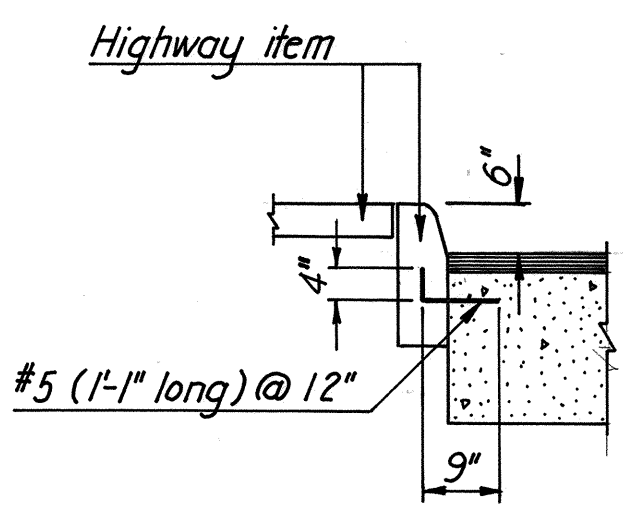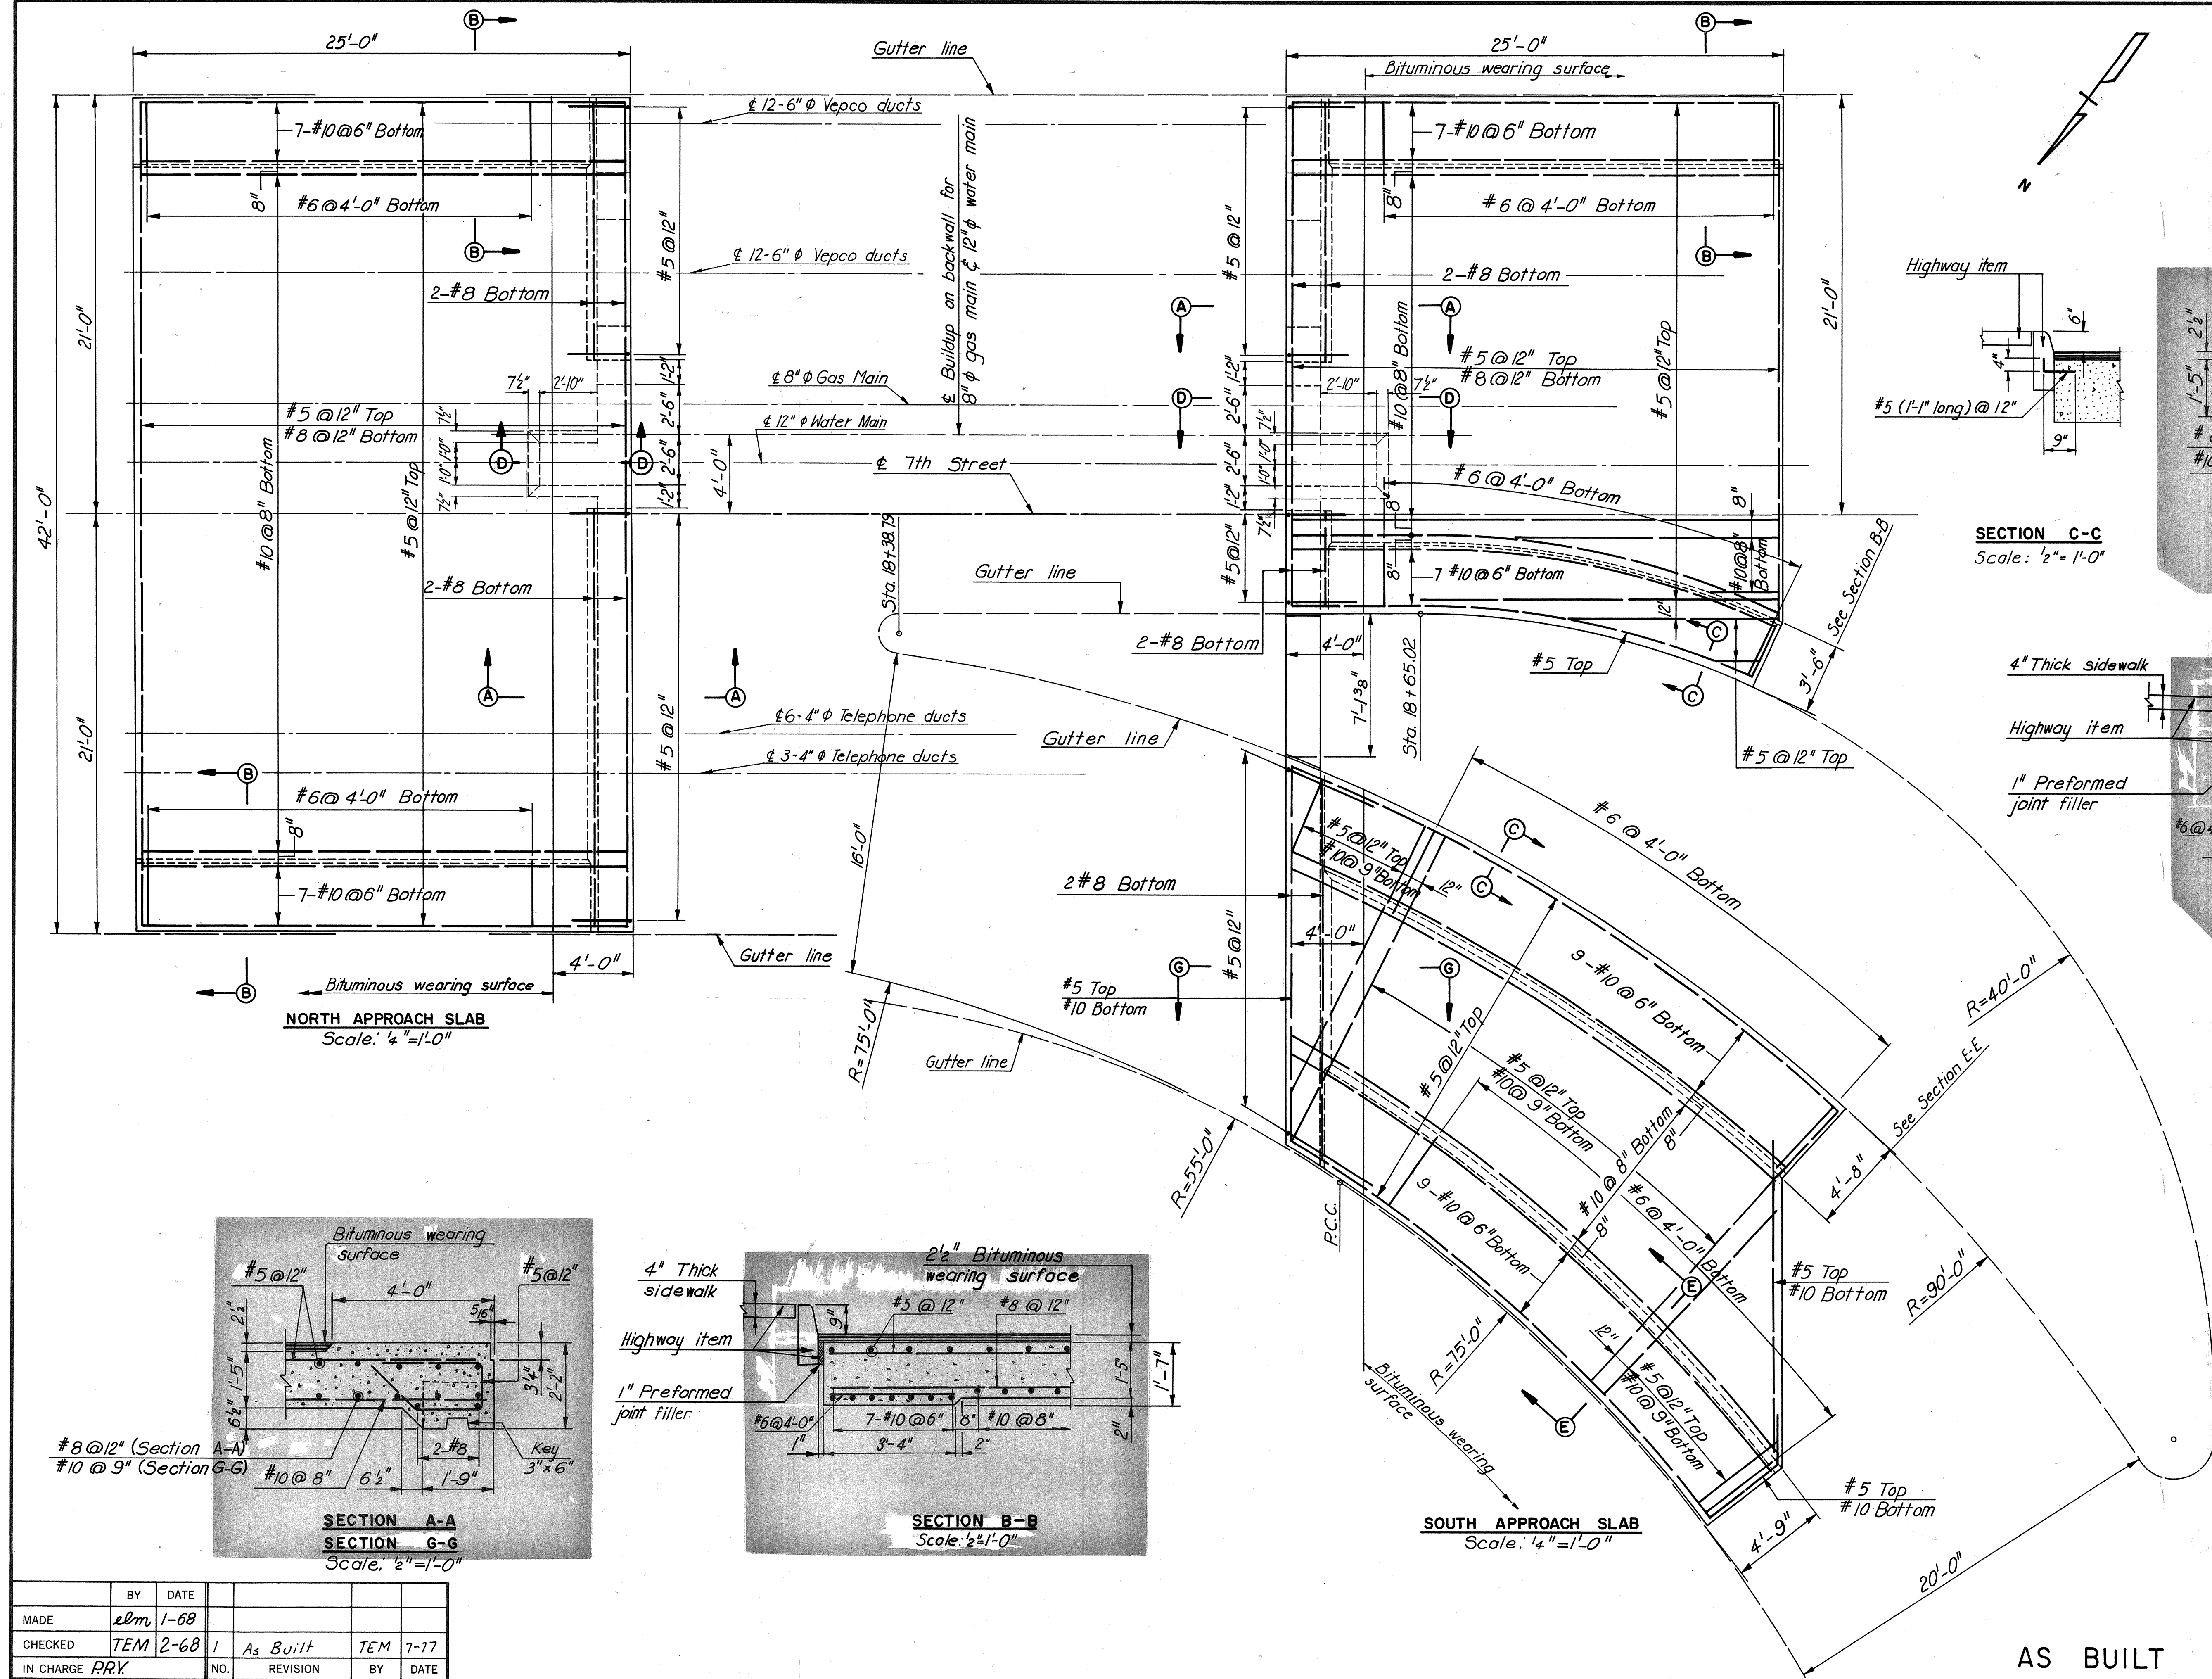

**SECTION C-C**  
Scale: 1/2" = 1'-0"

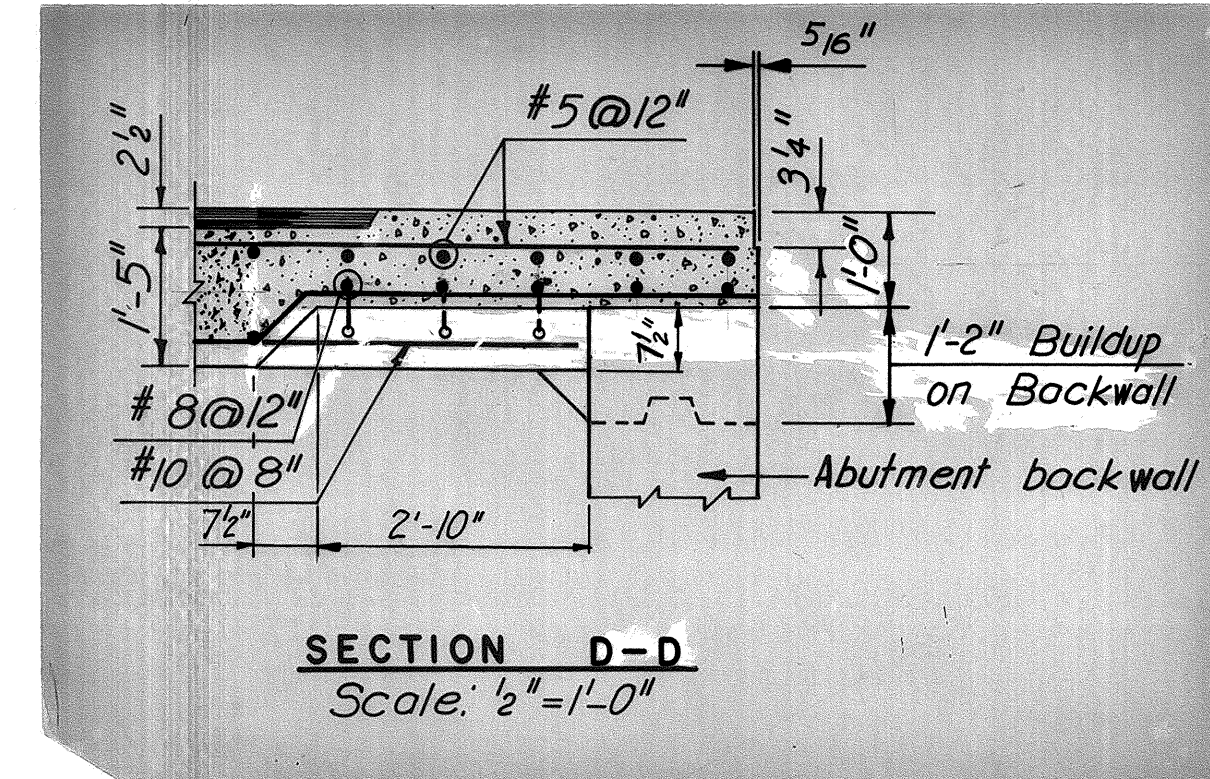


**SECTION D-D**  
Scale: 1/2" = 1'-0"

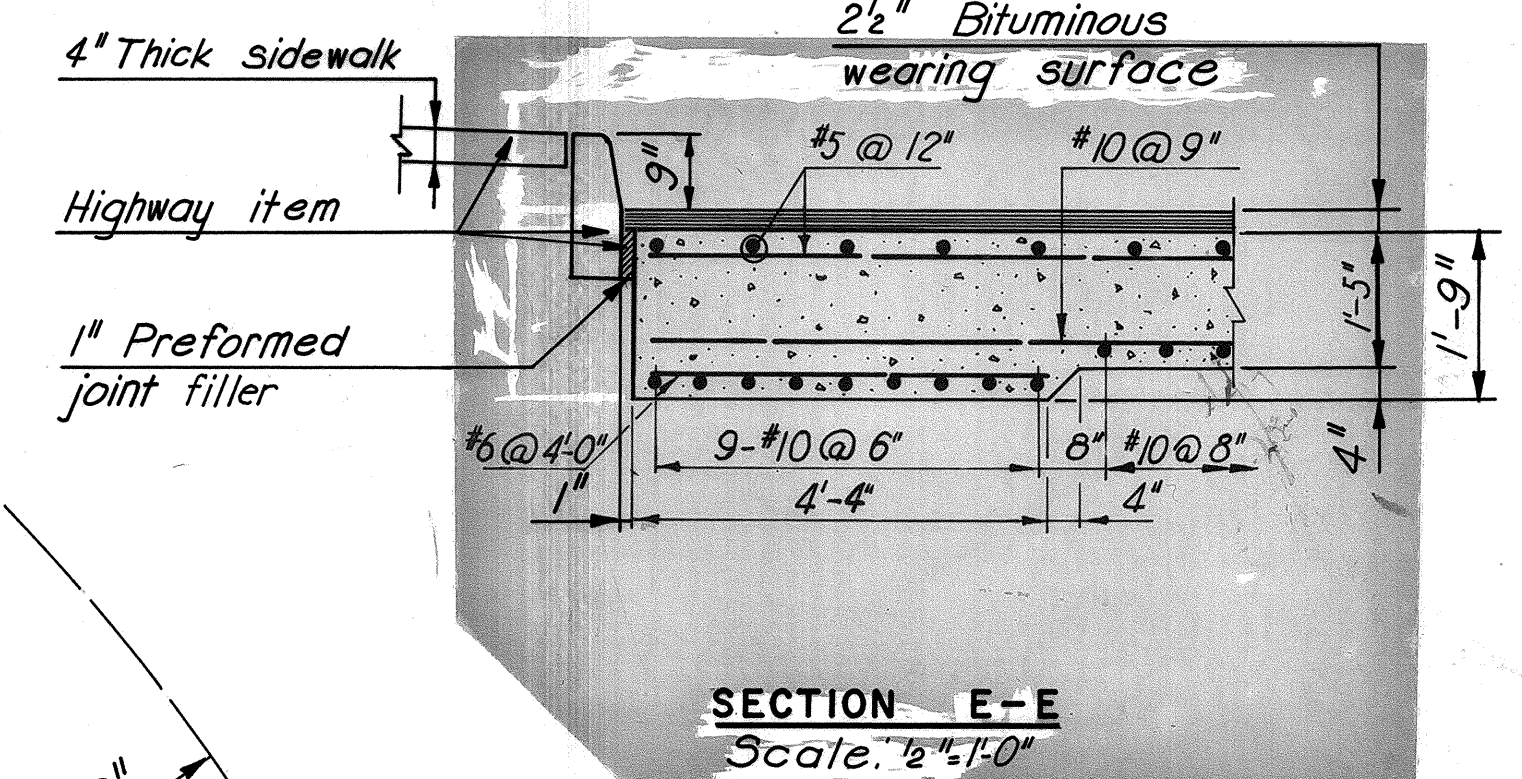


**SECTION E-E**  
Scale: 1/2" = 1'-0"

**NOTES:**  
All reinforcing steel shall be 2" minimum clear from edge of bar to edge of concrete.  
Cut reinforcing in the field to clear build-up on abutment backwall.

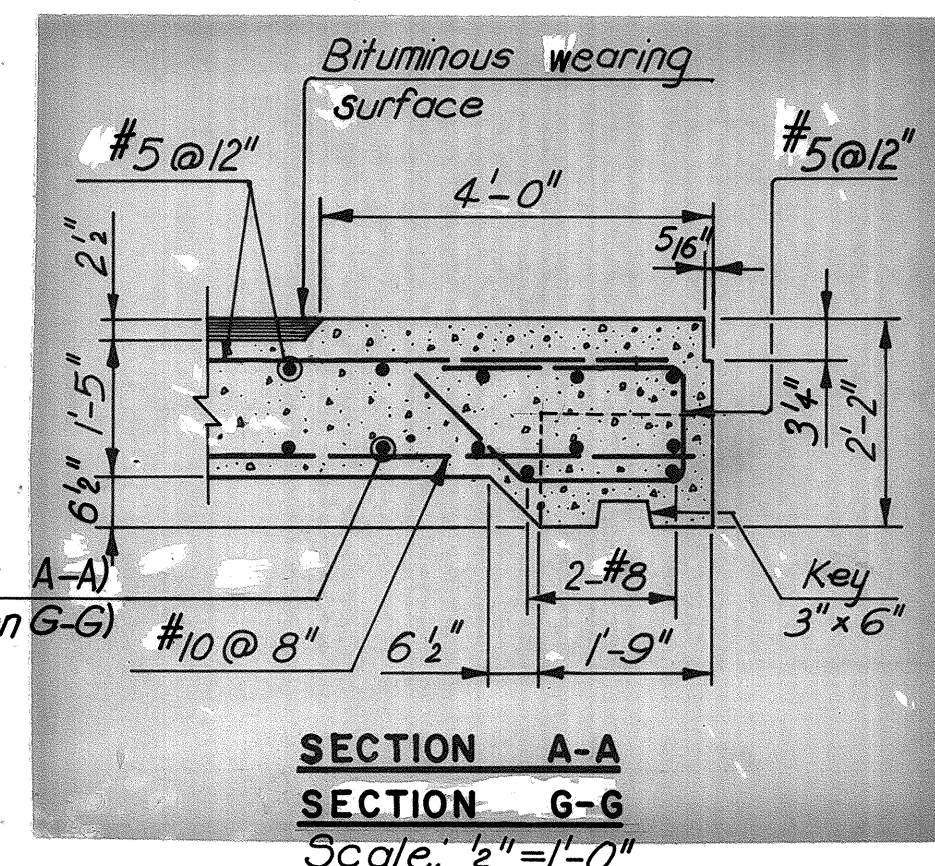

**SECTION A-A**  
**SECTION G-G**  
Scale: 1/2" = 1'-0"

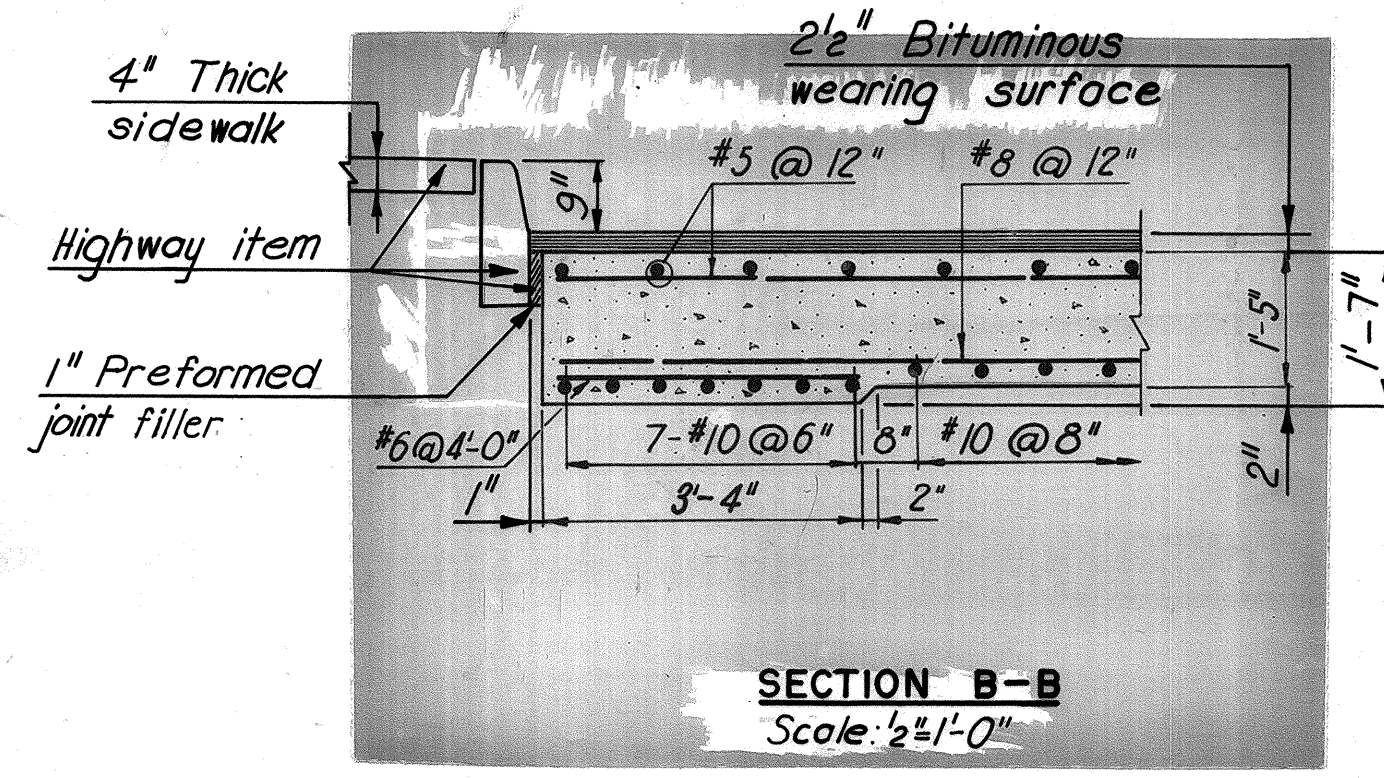

**SECTION B-B**  
Scale: 1/2" = 1'-0"

**SOUTH APPROACH SLAB**  
Scale: 1/4" = 1'-0"

MADE	CHECKED	IN CHARGE	BY	DATE
elm	TEM	PRK		1-68
				2-68
				7-77

RICHMOND METROPOLITAN AUTHORITY  
RICHMOND EXPRESSWAY SYSTEM  
DOWNTOWN EXPRESSWAY  
BRIDGE B-58  
7TH STREET OVER  
DOWNTOWN EXPRESSWAY  
APPROACH SLABS

SCALE: AS SHOWN  
CONTRACT NO. 9  
HOWARD, NEEDLES, TAMMEN & BERGENDOFF  
consulting engineers  
NEW YORK ALEXANDRIA KANSAS CITY  
SHEET NO. 14 OF 17







# **Bridge 60**


**(South 10th Street  
Over Downtown Expressway {Rte. 195})**

**Record Set Plans**




RICHMOND EXPRESSWAY SYSTEM			
SECTION	PROJECT	SHEET NO.	TOTAL SHEETS
9	DOWNTOWN EXPRESSWAY	204	

INDEX	
NO.	DESCRIPTION
1	General Plan and Elevation
2	General Notes and Quantities
3	North Abutment
4	North Abutment Details (1)
5	North Abutment Details (2)
6	North Abutment Details (3) - Void
7	South Abutment
8	South Abutment Details (1)
9	South Abutment Details (2)
10	South Abutment Details (3)
11	Pier
12	Framing Plan
13	Cross Section and Utility Details
14	Deck Plans
15	Joint Details
16	Approach Slabs
17	Boring Logs
S1	Standard Shoe Details
S3	Standard Aluminum Railing Details (2 Rails)
S4	Standard Electrical Details (Bridges Carrying City Streets)
S7	Standard Architectural Details
S8	Standard Architectural Details
S9	Standard Architectural Details
S10	Standard Conduit Installation Details
S11	Standard Utility Support Details at Bridge Abutments

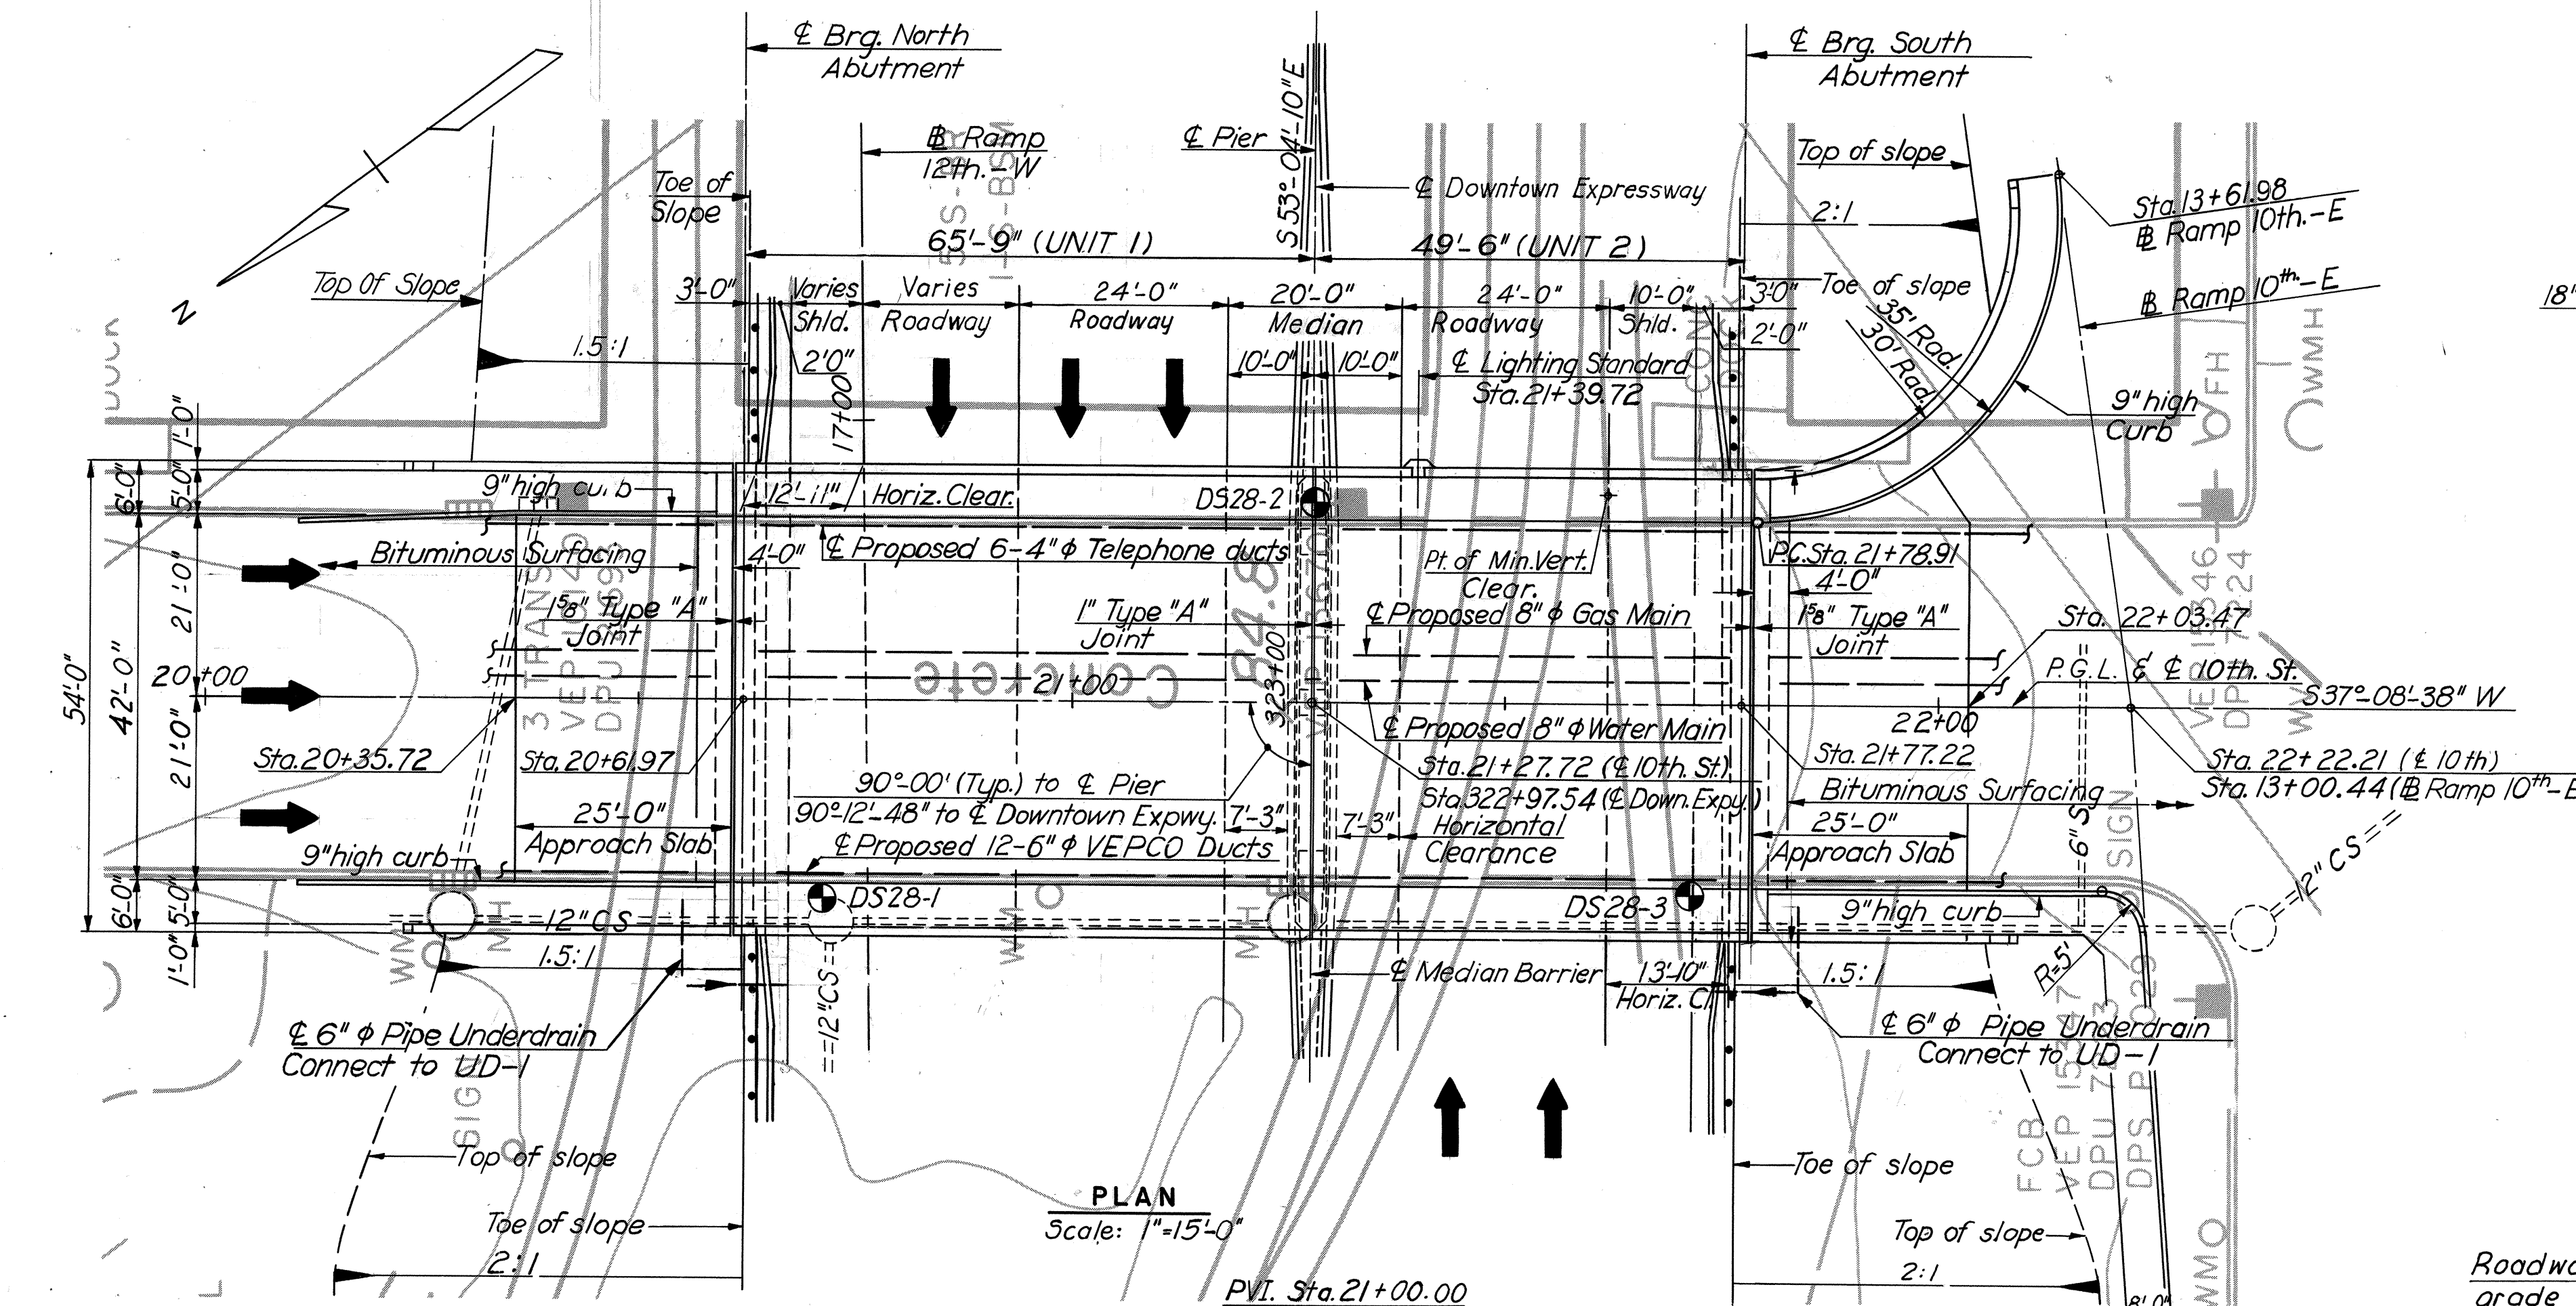


**PLAN**  
Scale: 1"=15'-0"

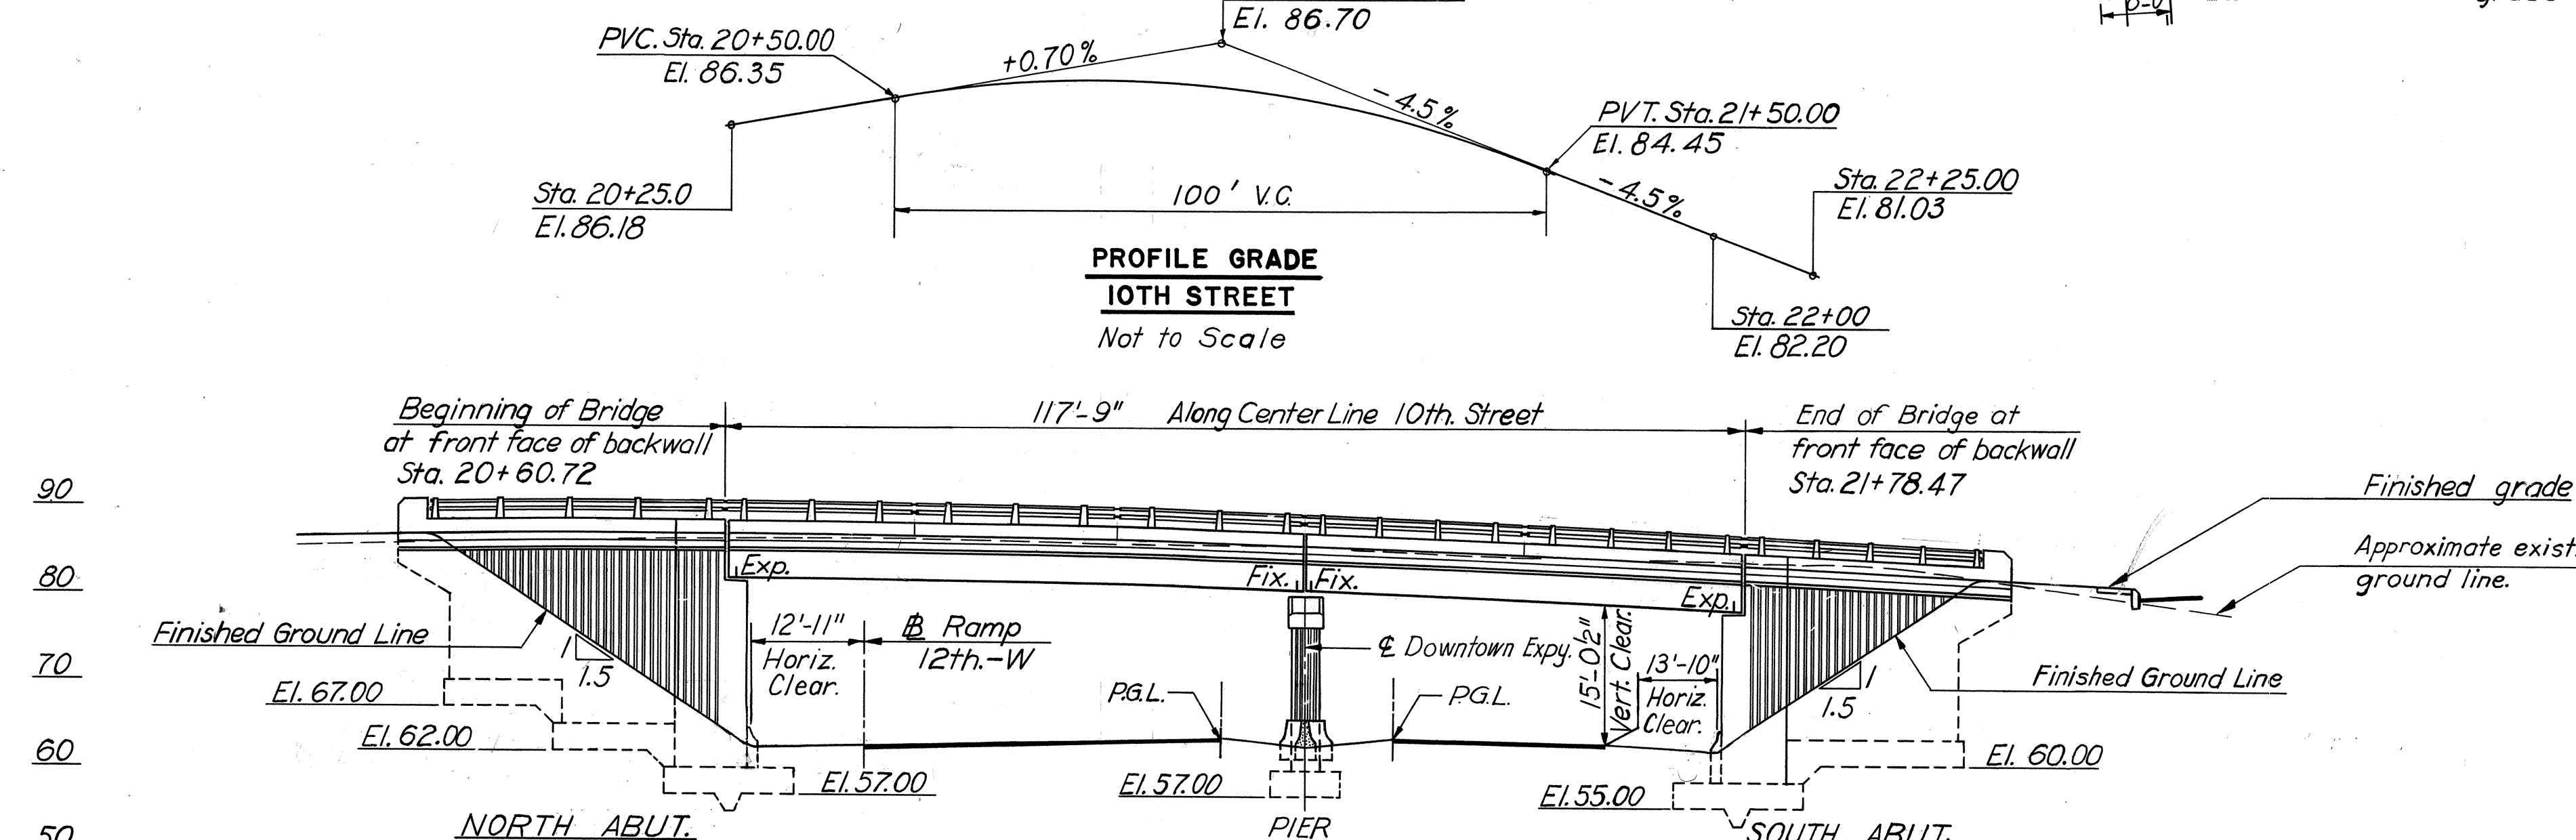


**PROFILE GRADE  
10TH STREET**  
Not to Scale


**ELEVATION**  
Scale 1"=15'

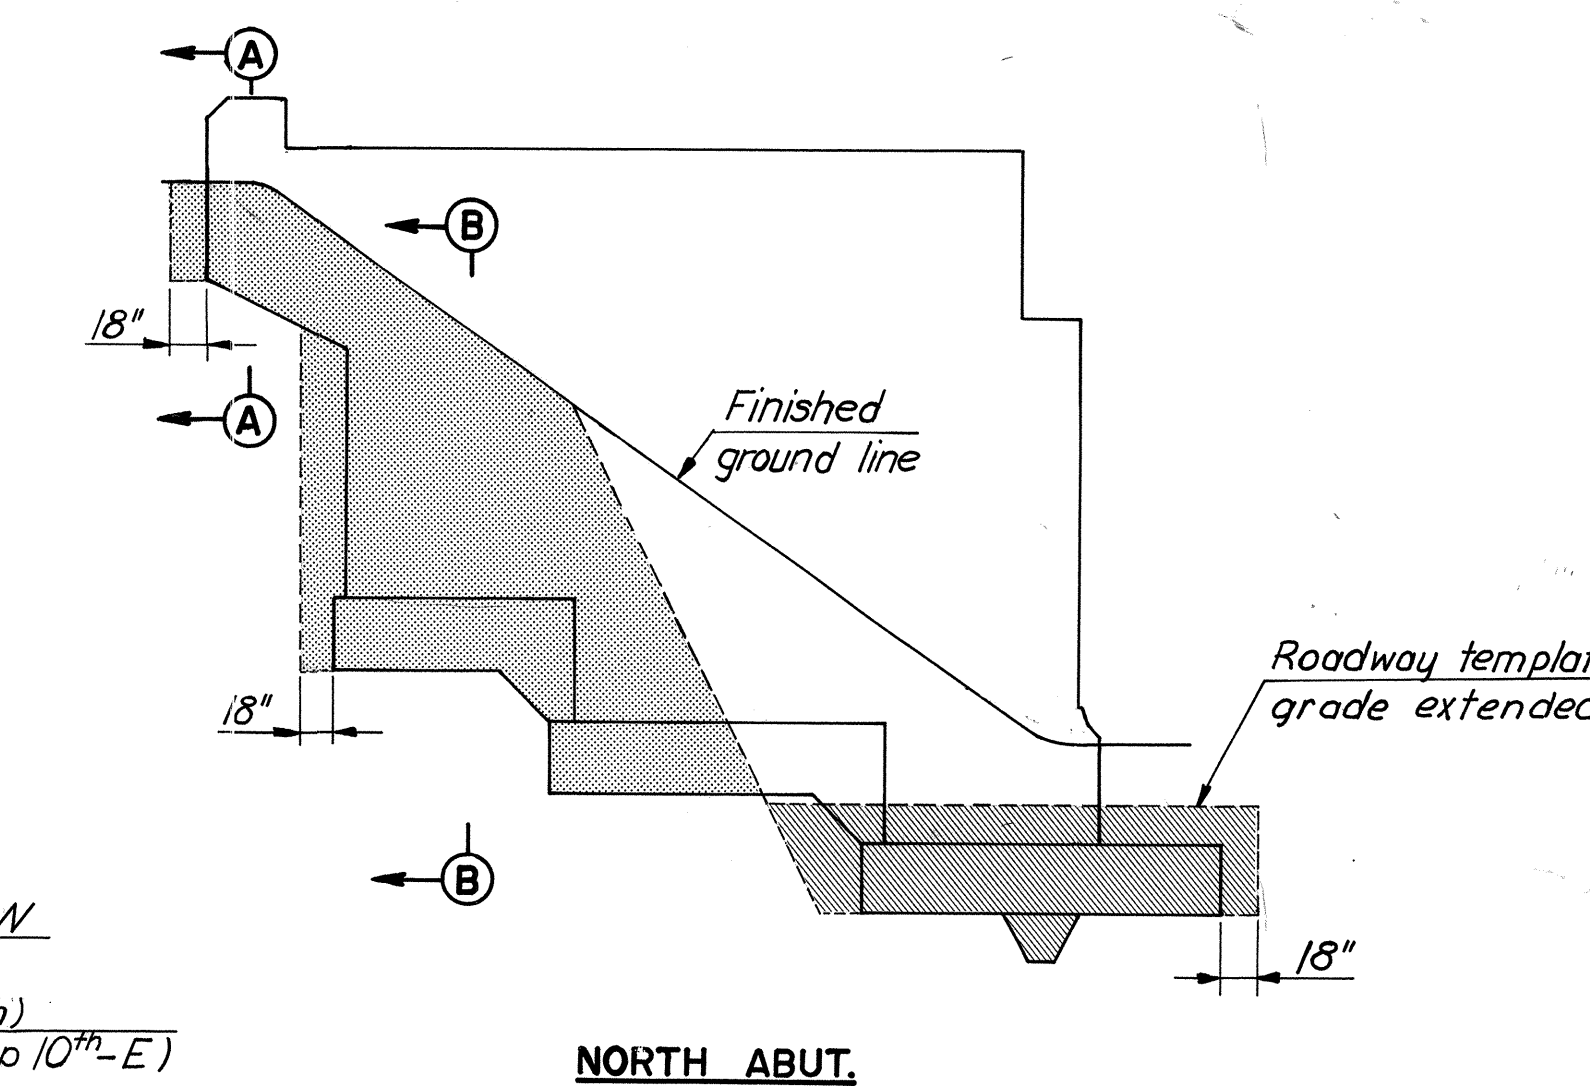


**NORTH ABUT.**

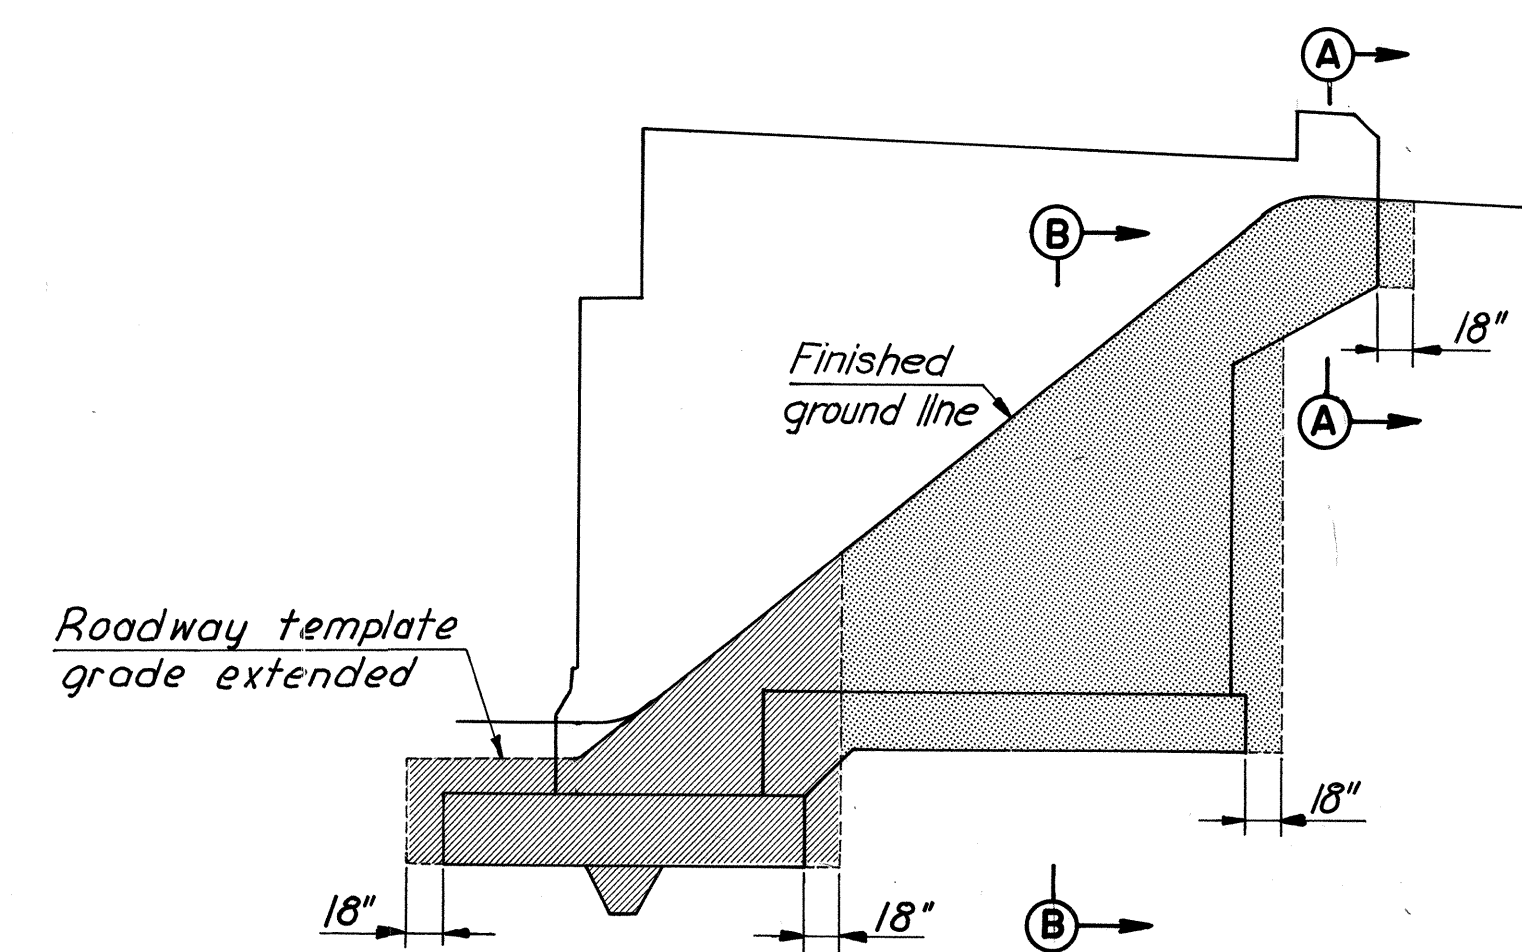

**SOUTH ABUT.**

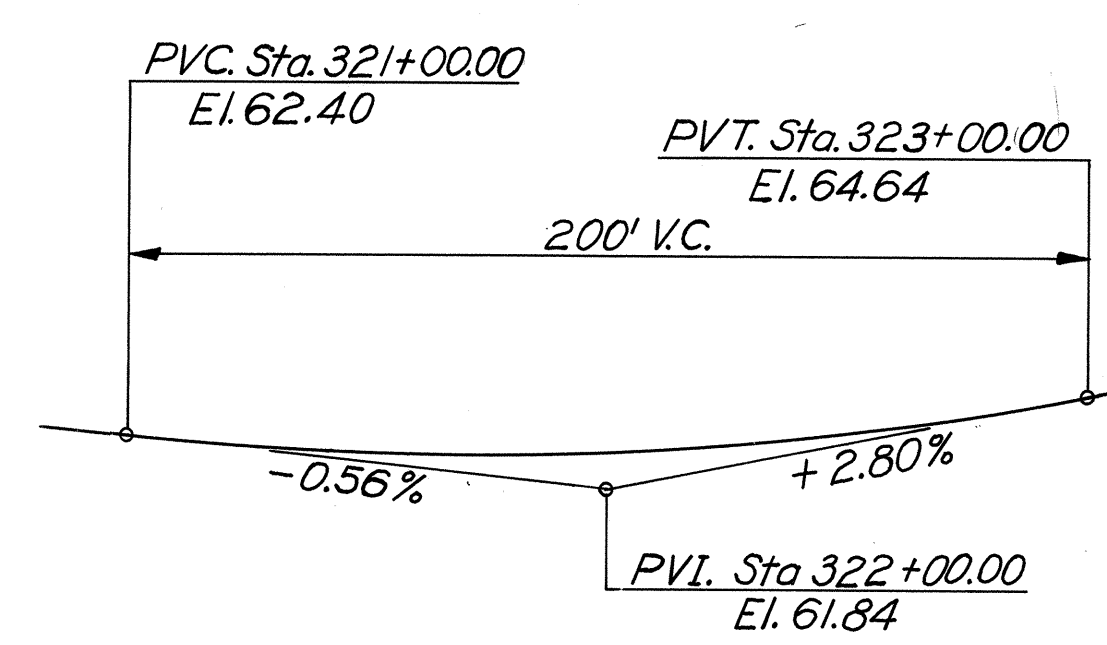

**PROFILE GRADE  
DOWNTOWN EXPRESSWAY**  
Not to Scale

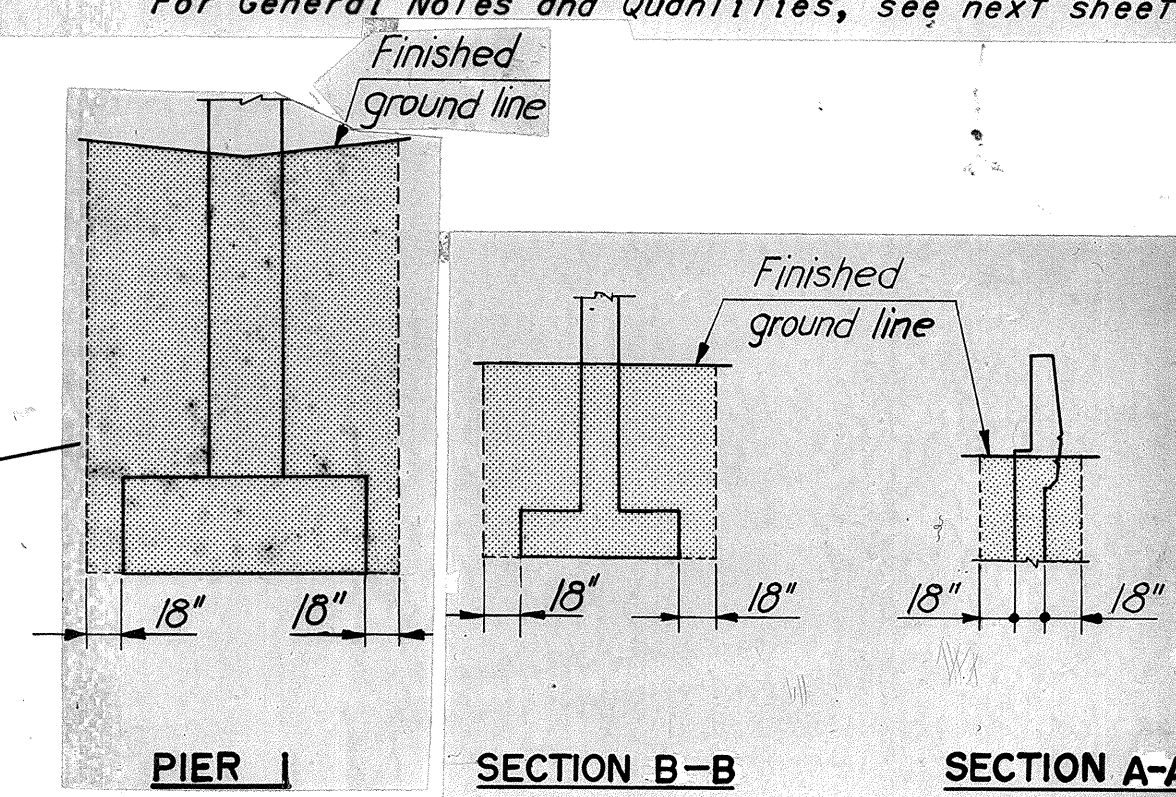

**PAYMENT LIMITS FOR STRUCTURE  
EXCAVATIONS**  
No Scale

BY	DATE	REVISION	BY	DATE
MADE	JBM/12-67	2	As Built	TEM 7-77
CHECKED	L.B.P. 3-68	1	North East	TEM 6-74
IN CHARGE	P.R.Y.			

**RICHMOND METROPOLITAN AUTHORITY**  
**RICHMOND EXPRESSWAY SYSTEM**  
DOWNTOWN EXPRESSWAY

**BRIDGE B-60**  
**10TH STREET OVER**  
**DOWNTOWN EXPRESSWAY**

**GENERAL PLAN AND ELEVATION**



HOWARD, NEEDLES, TAMMEN & BERGENDOFF  
consulting engineers  
NEW YORK ALEXANDRIA KANSAS CITY

SCALE: AS SHOWN  
CONTRACT NO.: 9  
SHEET NO. 1 OF 17


AS BUILT



RICHMOND EXPRESSWAY SYSTEM			
SECTION	PROJECT	SHEET NO.	TOTAL SHEETS
9	DOWNTOWN EXPRESSWAY	215	

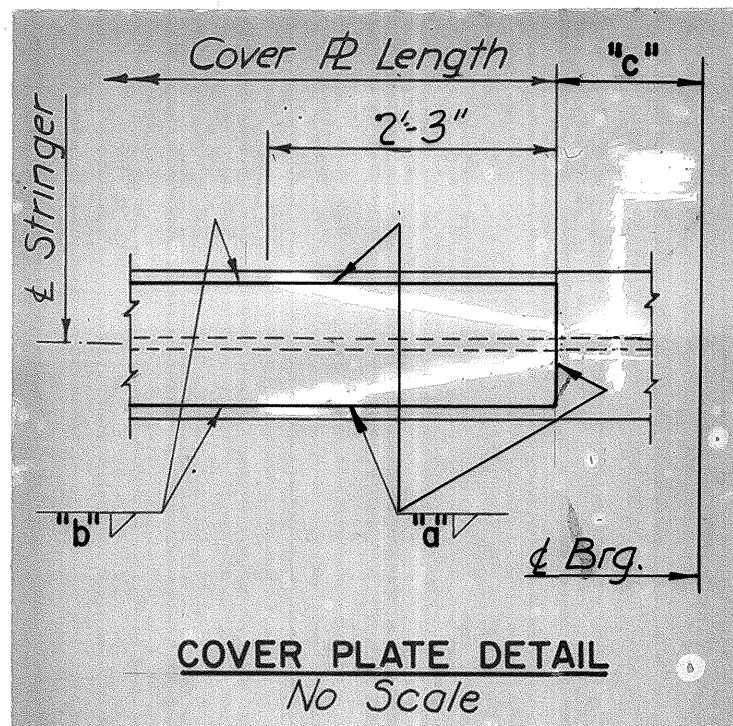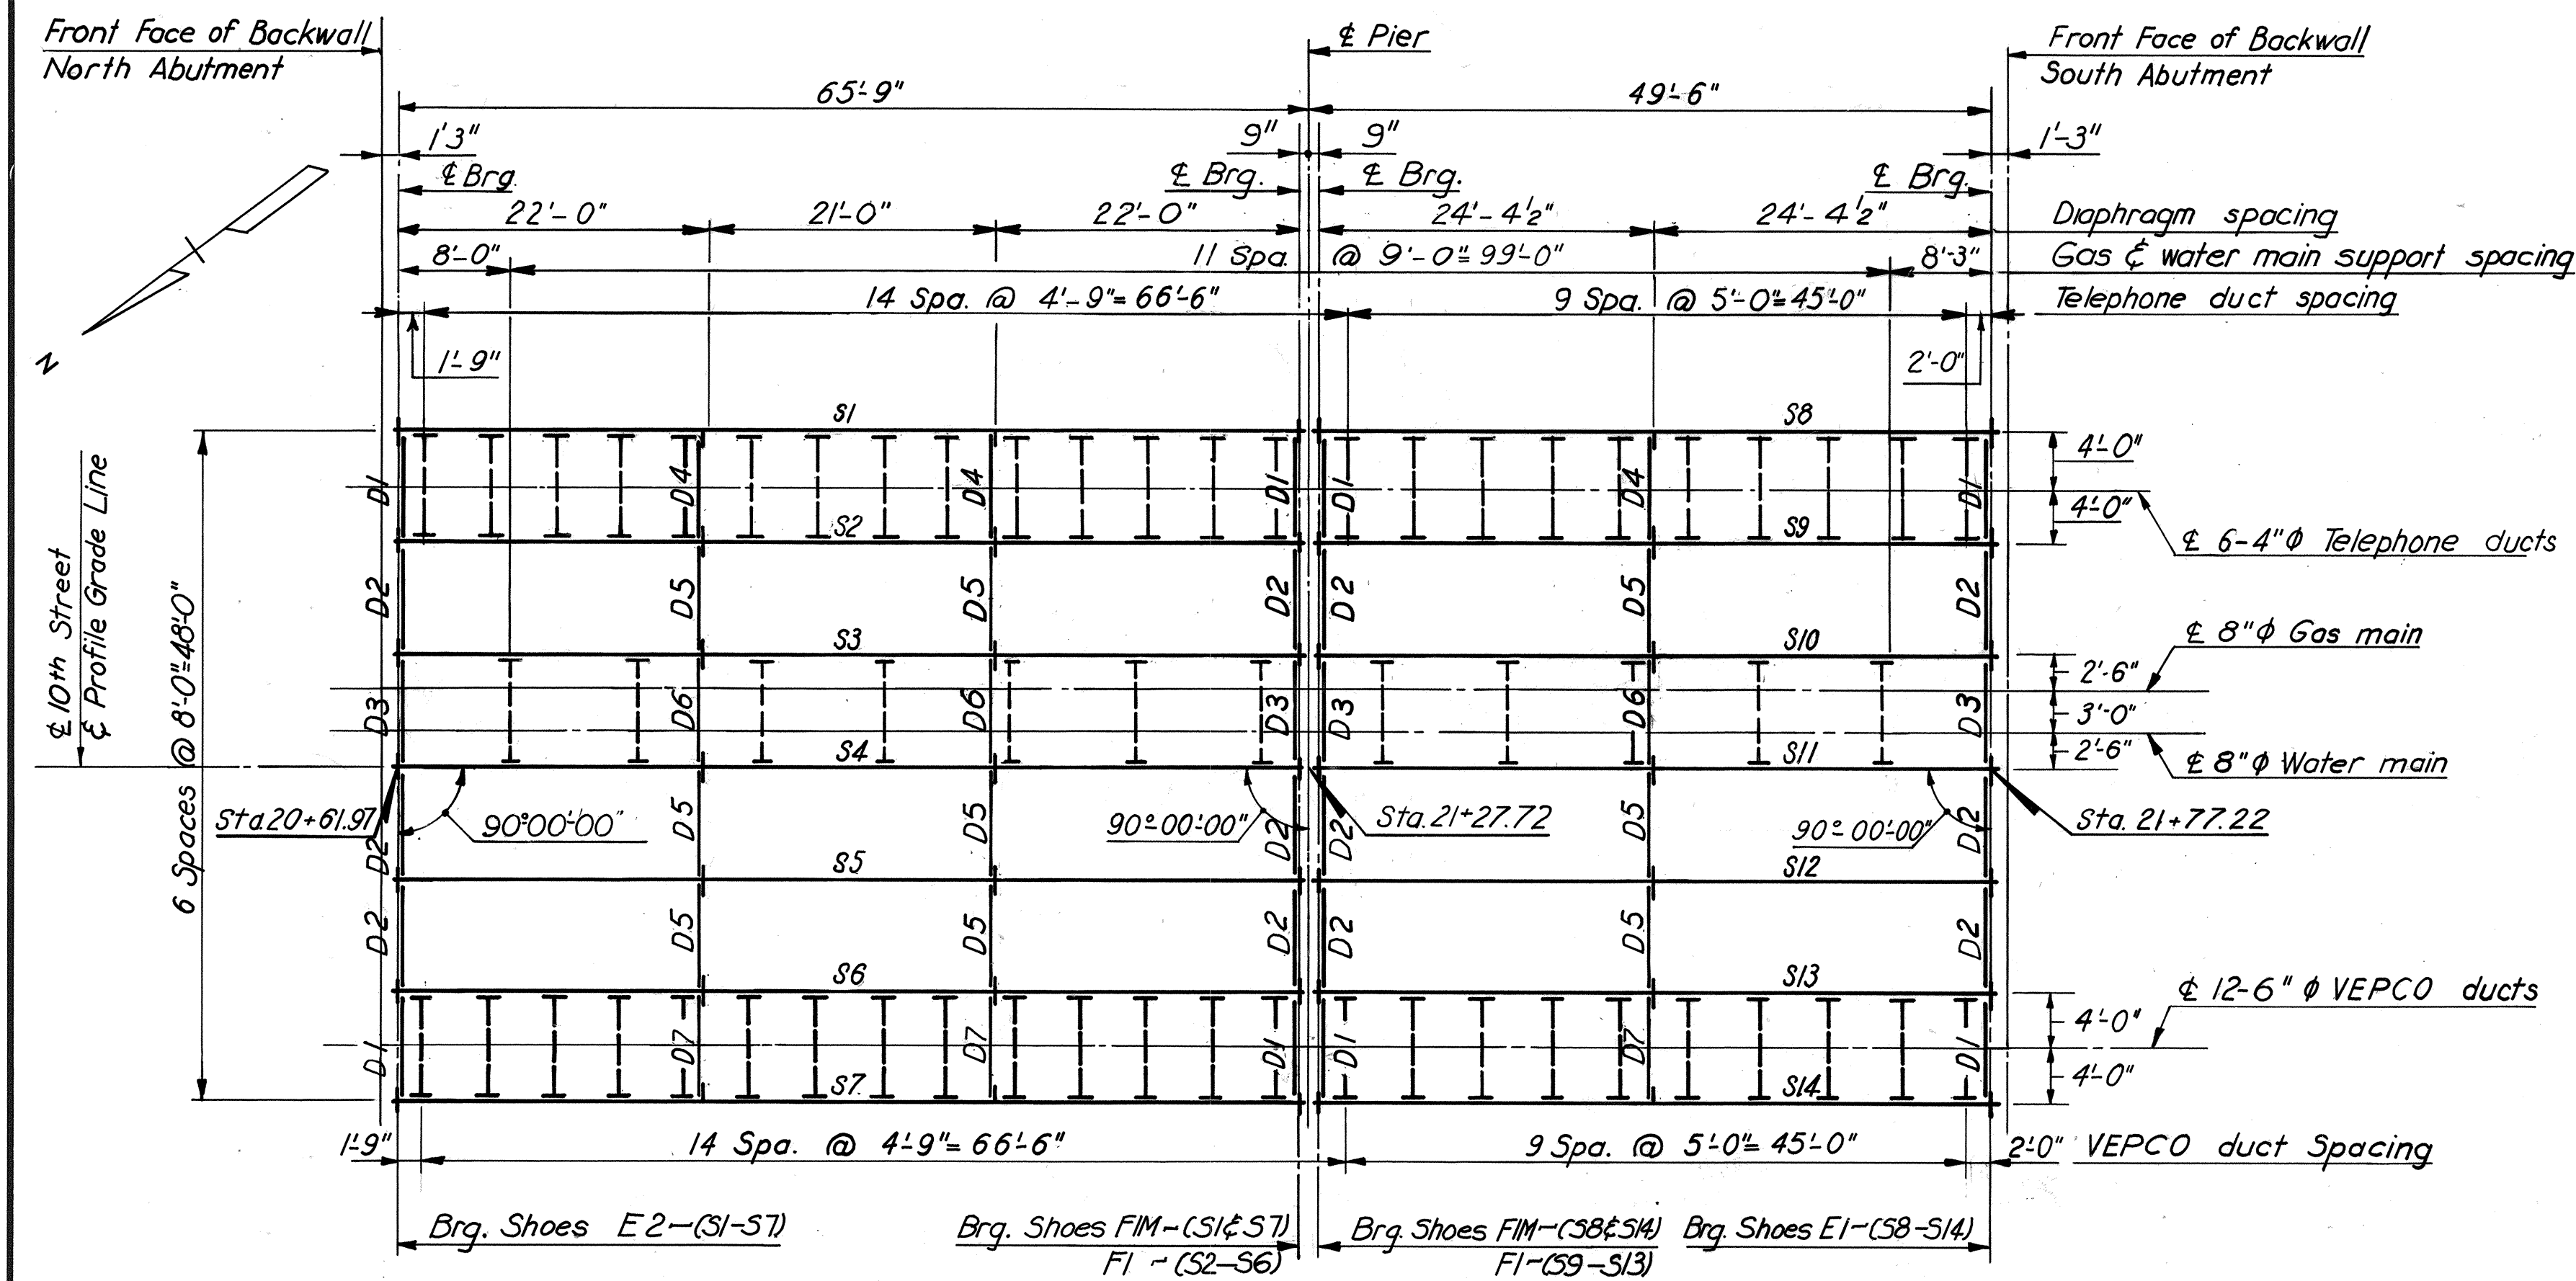


COVER PLATE SCHEDULE				
STR.	COVER PL. LENGTH	"a"	"b"	"c"
S1, S6, S7	10 1/2 x 1 1/4	1/2"	5/8"	5'-3"
S2-S5	10 1/2 x 1 1/8	1/2"	5/8"	5'-9"

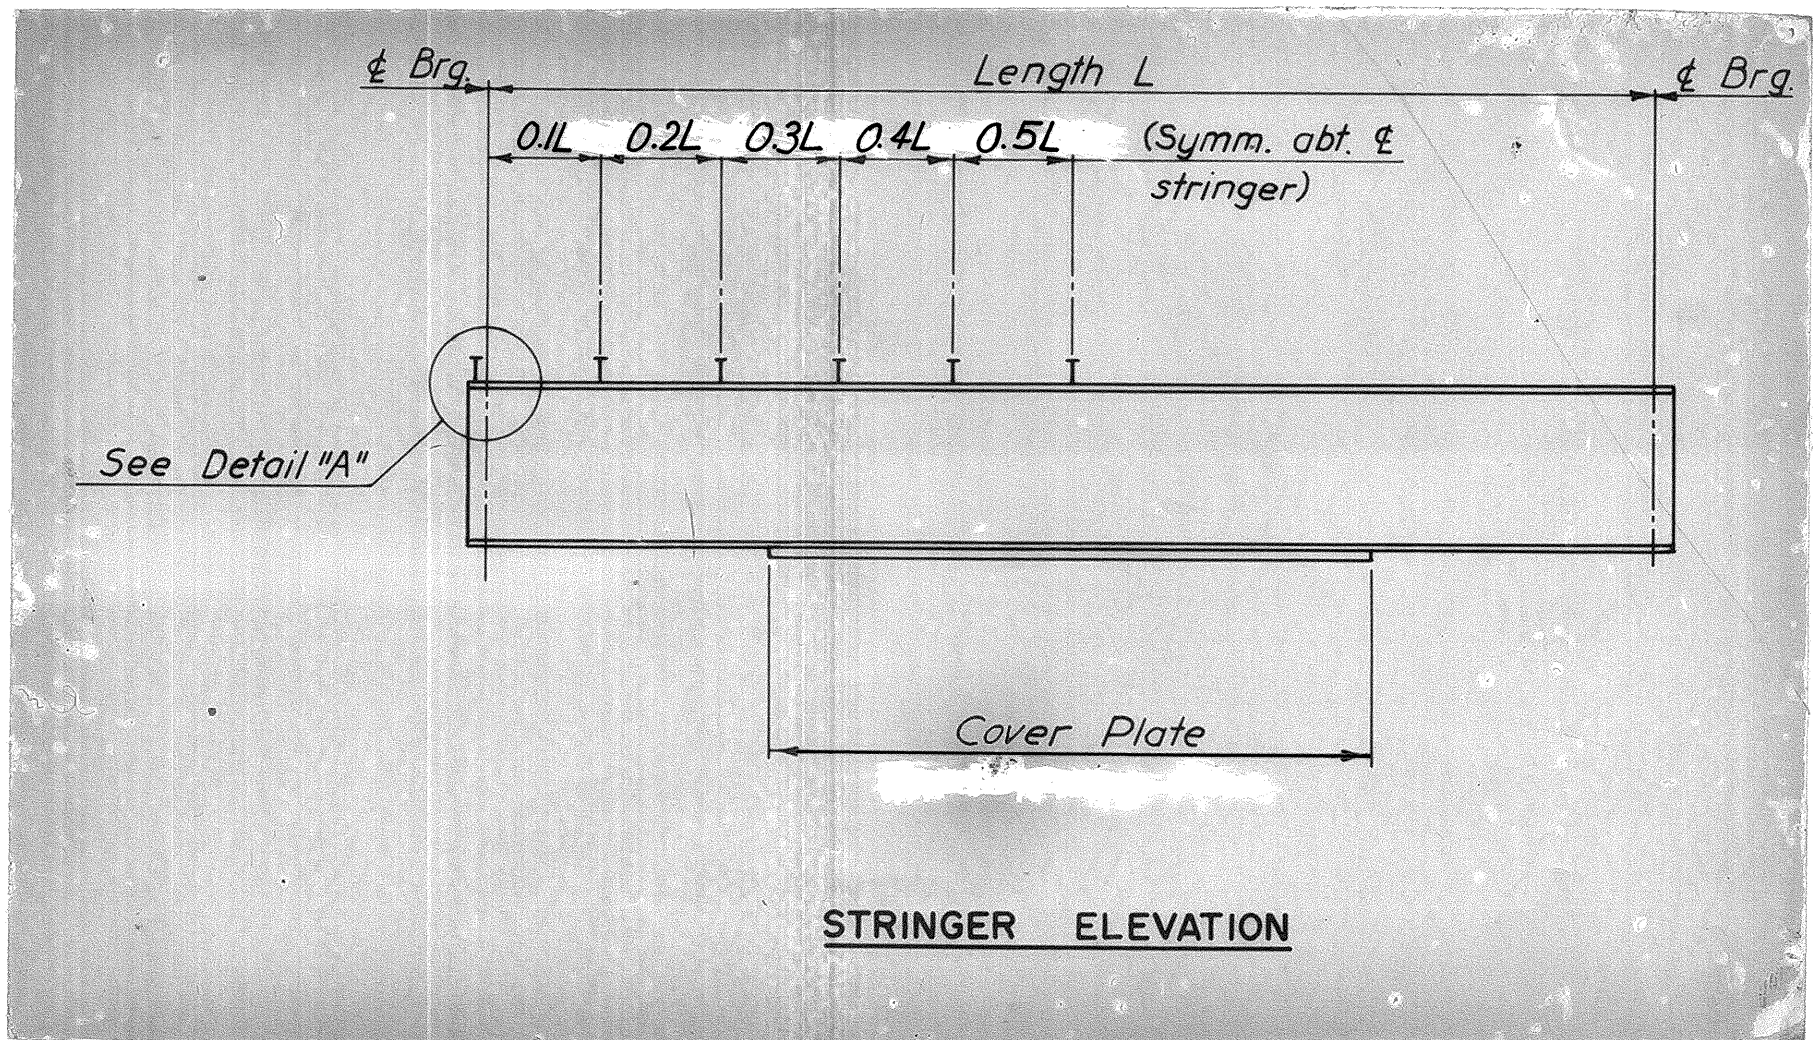

STRINGER SCHEDULE							
STRINGER	LENGTH £ BRG.TO £ BRG.	COVER PLATE	SHEAR STUD SPACING				
			O.1L	O.2L	O.3L	O.4L	O.5L
S1 — 36 WF150	65'-0"	10½ x 1¼ x 54'-6"	6½"	8"	10½"	13"	15"
S2 —	↑	10½ x 1⅝ x 53'-6"	7"	↑	↑	12½"	14"
S3 —	↑	10½ x 1⅝ x 53'-6"	↑	↑	↑	↑	↑
S4 —	↑	10½ x 1⅝ x 53'-6"	↑	↑	↑	↑	↑
S5 —	↑	10½ x 1⅝ x 53'-6"	↓	↑	↑	↑	↓
S6 —	↓	10½ x 1¼ x 54'-6"	7"	↓	↓	12½"	14"
S7 —	65'-0"	10½ x 1¼ x 54'-6"	6½"	8"	10½"	13"	15"
S8 —	48'-9"	No Cover Plates	7½"	9"	10½"	13½"	15½"
S9 —	↑	↑	↑	↑	↑	12½"	14"
S10 —	↑	↑	↑	↑	↑	↑	↑
S11 —	↑	↑	↑	↑	↑	↑	↑
S12 —	↑	↑	↑	↑	↑	↑	↑
S13 —	↓	↓	↓	↓	↓	12½"	14"
S14 — 36 WF150	48'-9"	No Cover Plates	7½"	9"	10½"	13½"	15½"


Note: Lengths shown are horizontal distances measured along centerlines of stringers.

SHOE SCHEDULE			
EXPANSION SHOES		FIXED SHOES	
TYPE	NO. REQD.	TYPE	NO. REQD.
E1	7	F1	10
E2	7	F1M	4

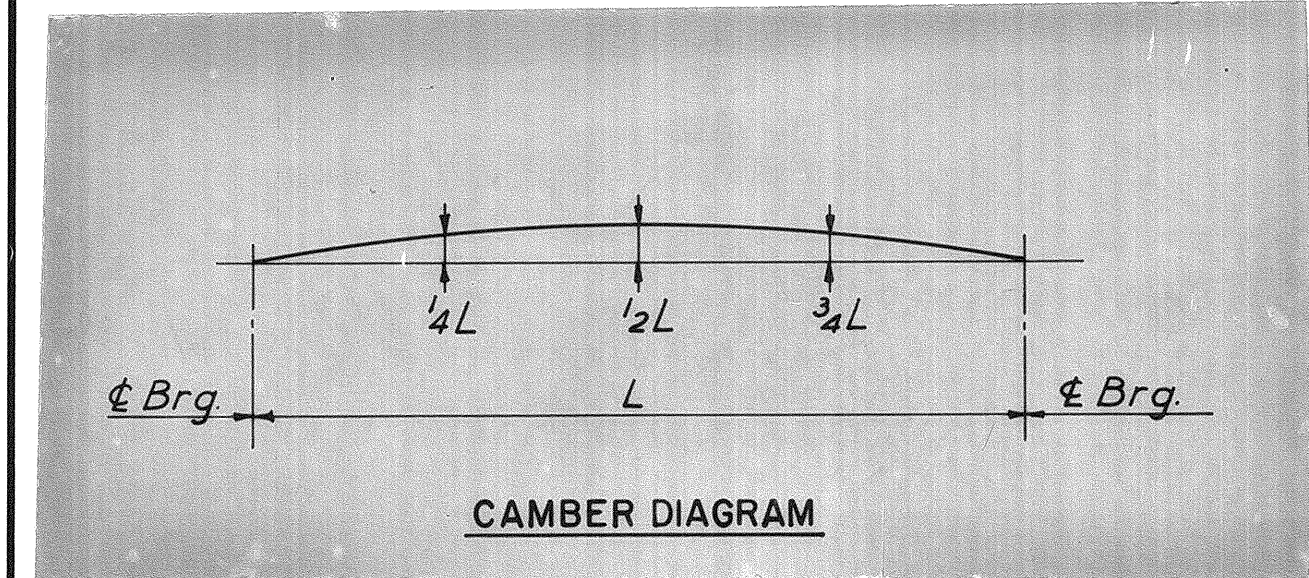



CAMBER SCHEDULE			
STR.	1/4L	1/2L	3/4L
S2	3 3/8"	4 5/8"	3 3/8"
S4-S6	3 1/2"	4 5/8"	3 1/2"
S6-S8	3 1/2"	4 5/8"	3 1/2"
S8-S14	1 1/4"	1 1/4"	3 1/4"

**NOTE TO FABRICATOR:**  
The above stringers shall be fabricated with an upward camber amounting to the tabulated value.  
This will provide approximate compensation for deflection under full dead load and for conformity with finished grade.  
Dimensions are in inches.

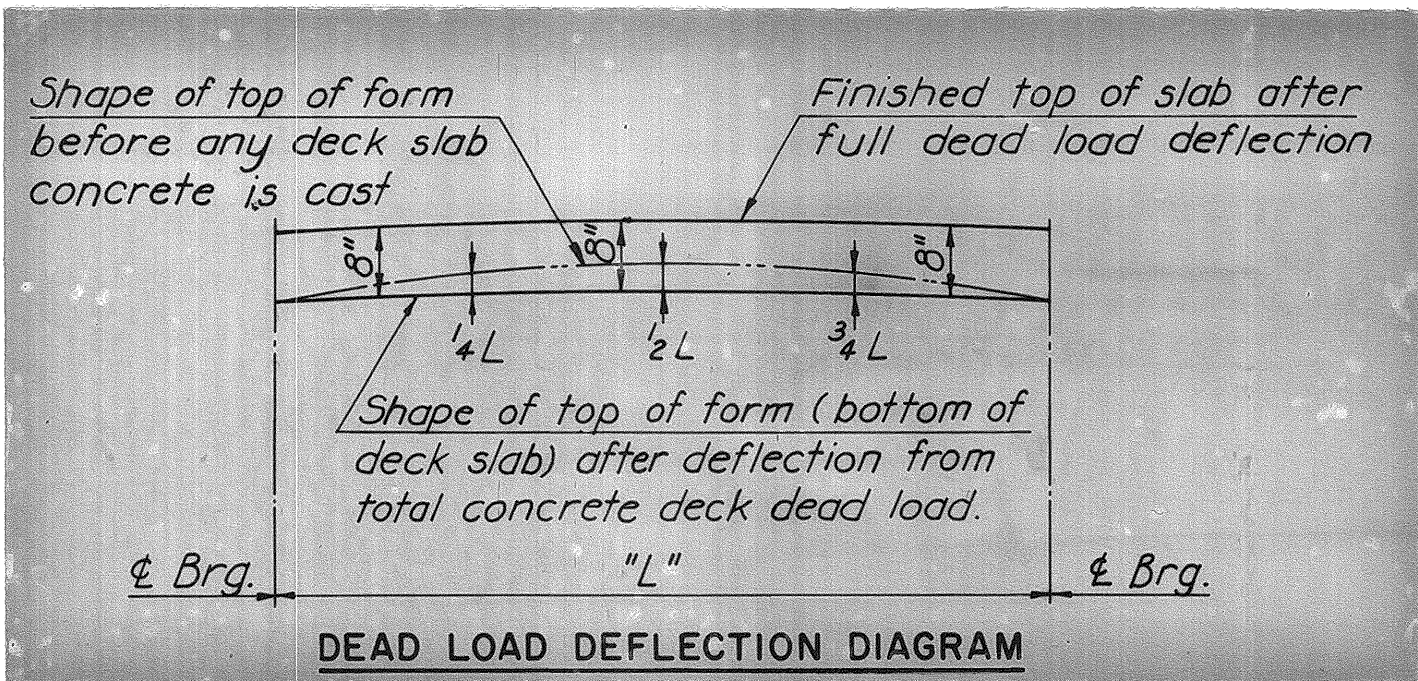

DEFLECTION SCHEDULE		
STR.	1/4L	1/2L
S1, S3, S5-S7	3 1/2"	1 1/8"
S2, S4	3 1/4"	1"
S8-S14	3 3/8"	1/2"

**NOTE TO CONTRACTOR:**  
The above deflections are those anticipated to occur in the stringer upon placement of the total concrete deck dead load.  
In practice, the stringers in place are not likely to have the exact camber to compensate for these deflections during construction. The residual amounts shall be provided for by adjusting forms to vary the thickness of the concrete bolster between the bottom of the slab and the top of stringer, without alteration of the slab thickness.

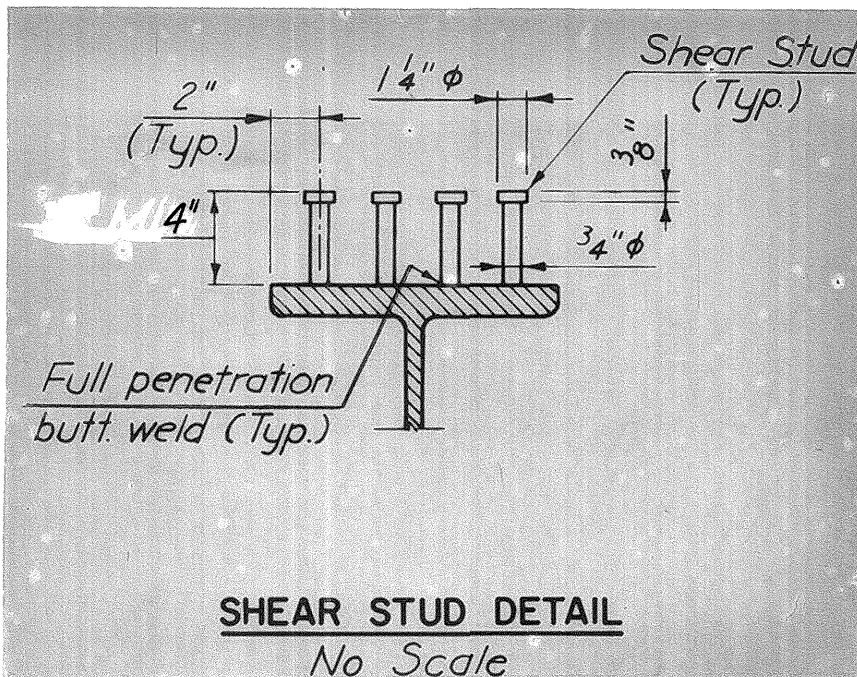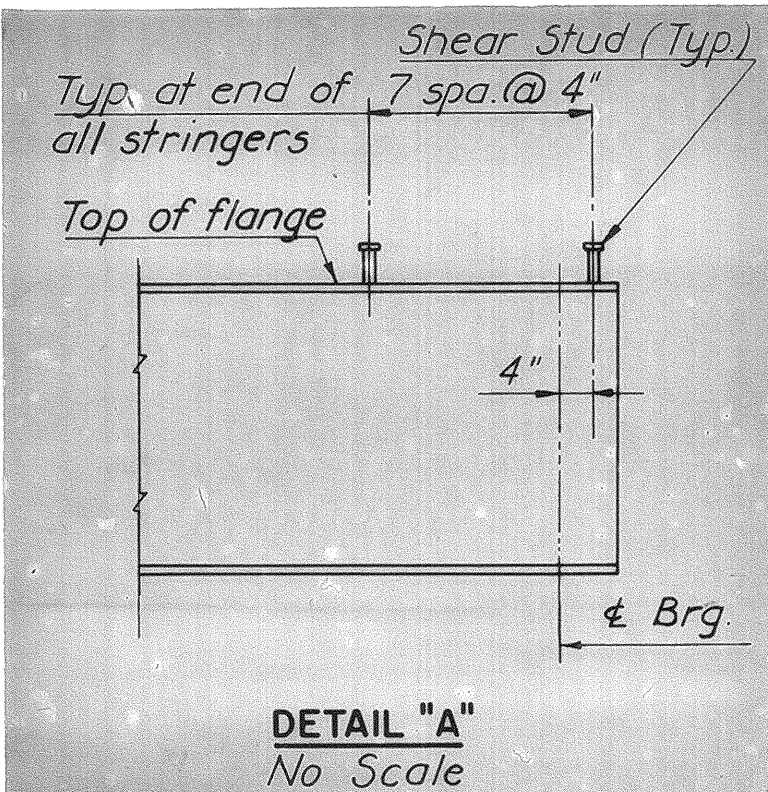

**SHEAR STUD NOTE:**  
Capacity = 3,400 lbs. per stud.  
The contractor may, if he elects, use three 3/4" diameter studs at the same longitudinal spacing in lieu of the four 3/4" diameter studs shown.  
Stud rows shall be placed parallel to the main deck reinforcing.  
Shear stud spacing shown is maximum spacing.

MADE	BY	DATE	CHECKED	DATE	IN CHARGE
EVR	11-67	1	As Built	TEM	7-77
PRY					

RICHMOND METROPOLITAN AUTHORITY  
RICHMOND EXPRESSWAY SYSTEM  
DOWNTOWN EXPRESSWAY  
BRIDGE B-60  
10TH STREET OVER  
DOWNTOWN EXPRESSWAY  
FRAMING PLAN

HOWARD, NEEDLES, TAMMEN & BERGENDOFF  
consulting engineers  
NEW YORK ALEXANDRIA KANSAS CITY

SCALE: AS SHOWN  
CONTRACT NO. 9  
SHEET NO. 12 OF 17




AS BUILT







RICHMOND EXPRESSWAY SYSTEM			
SECTION	PROJECT	SHEET NO.	TOTAL SHEETS
9	DOWNTOWN EXPRESSWAY	217	

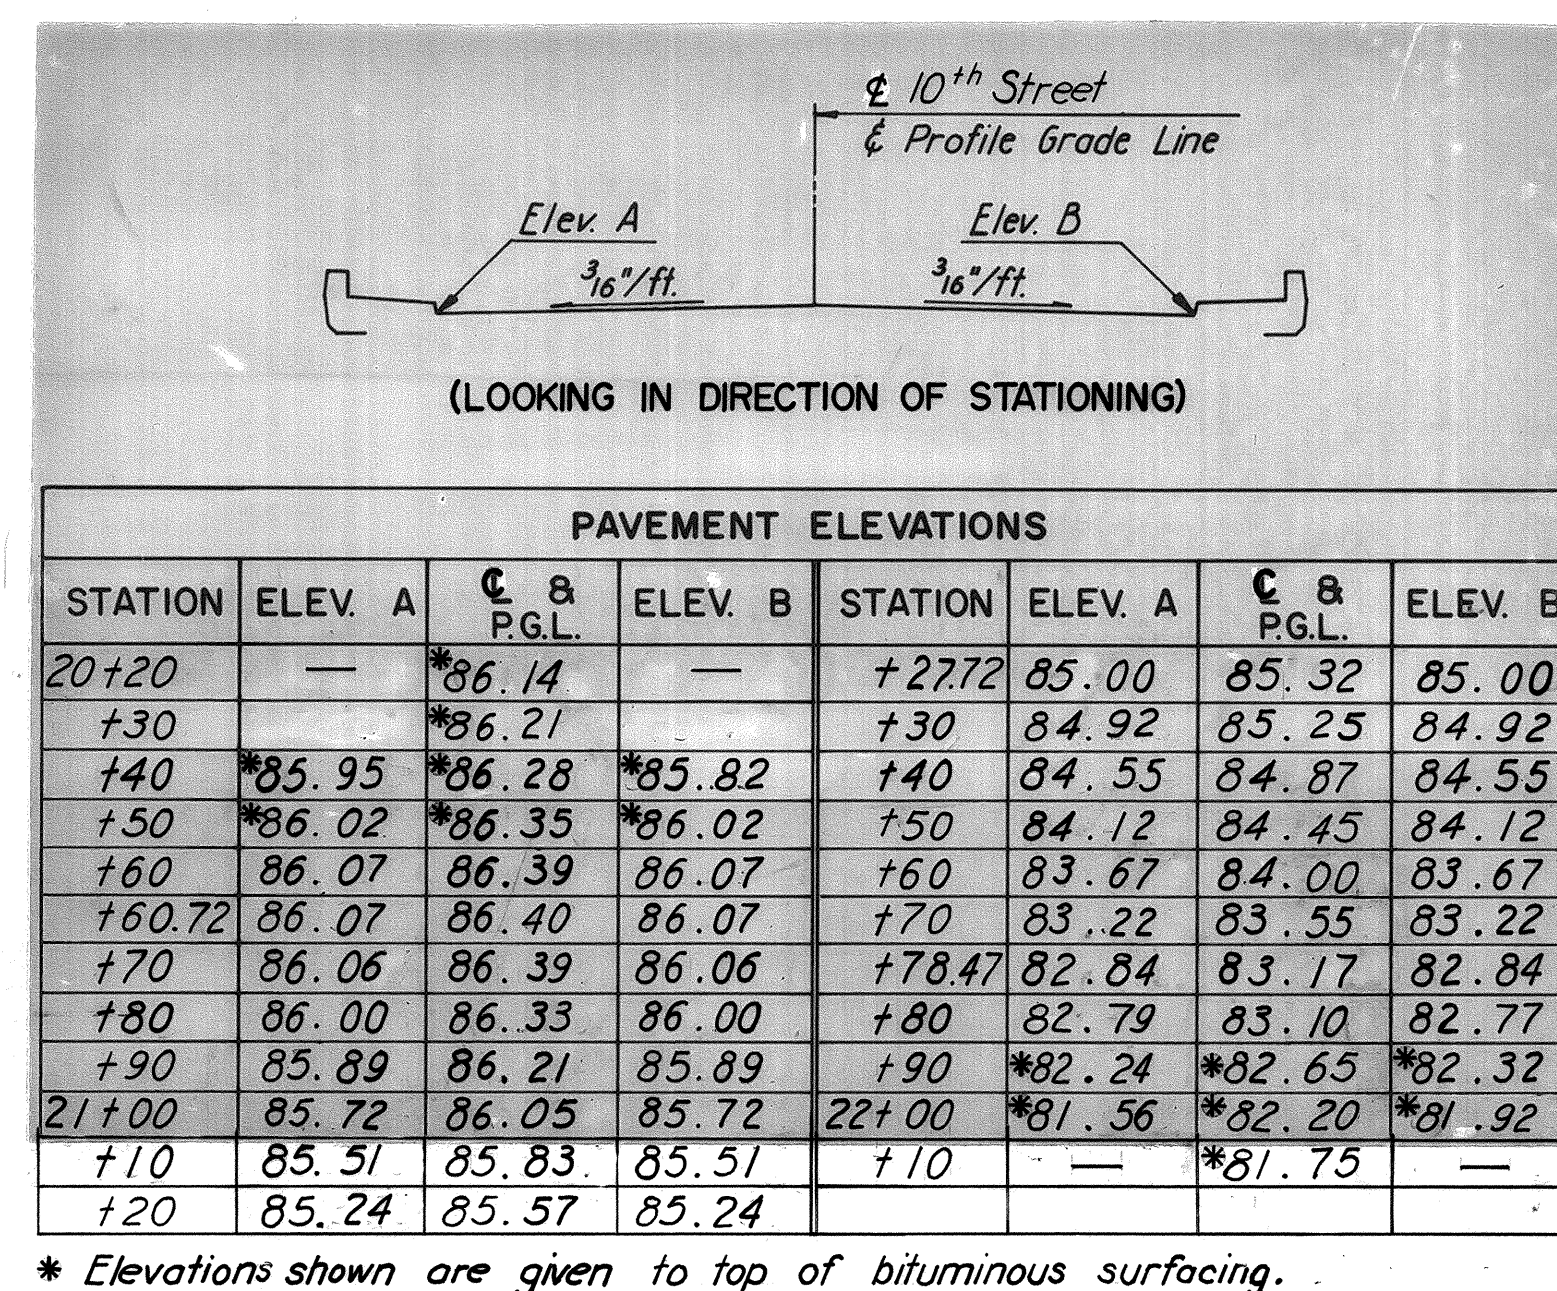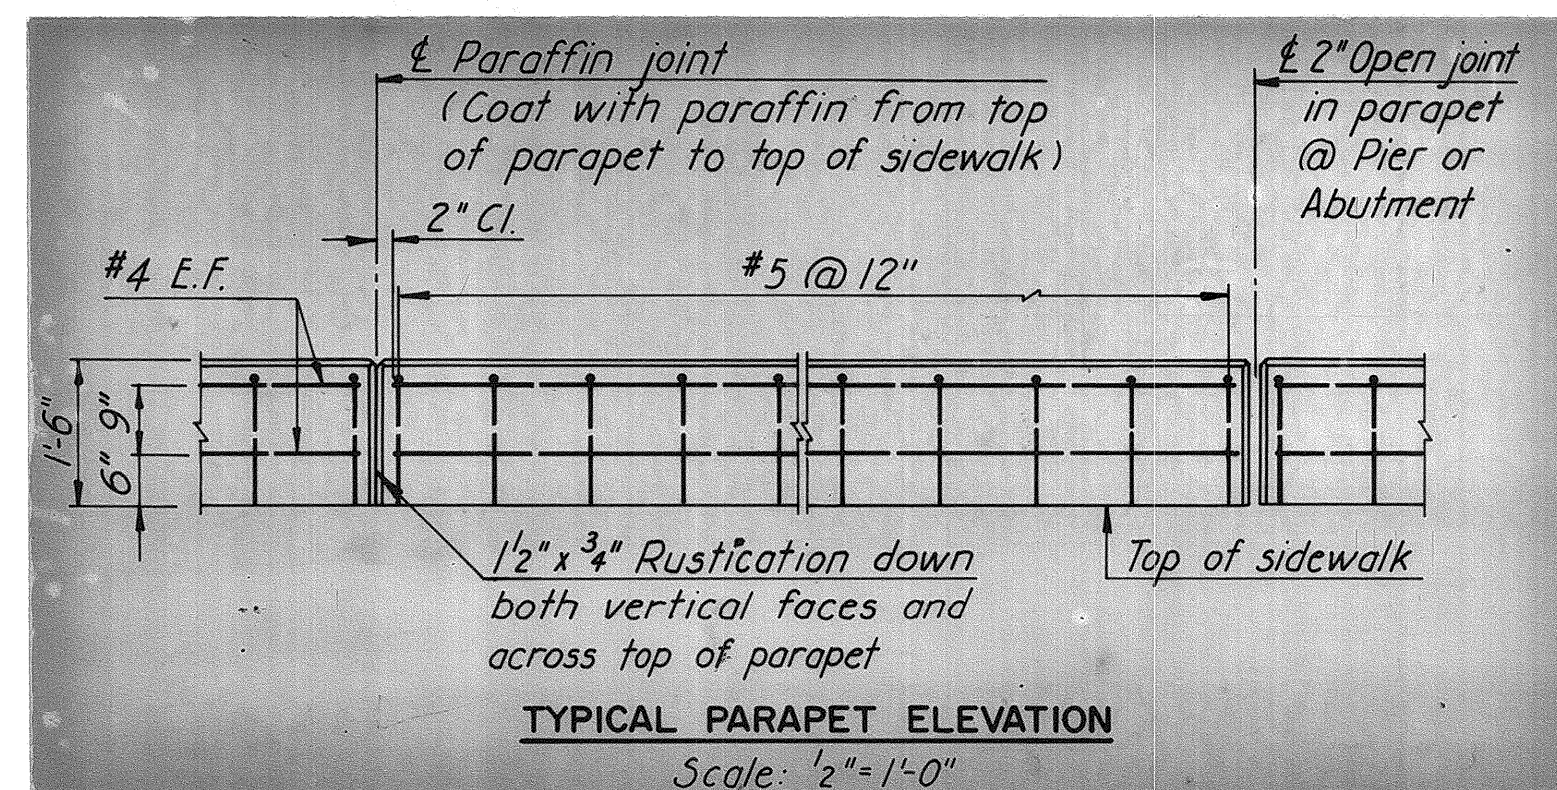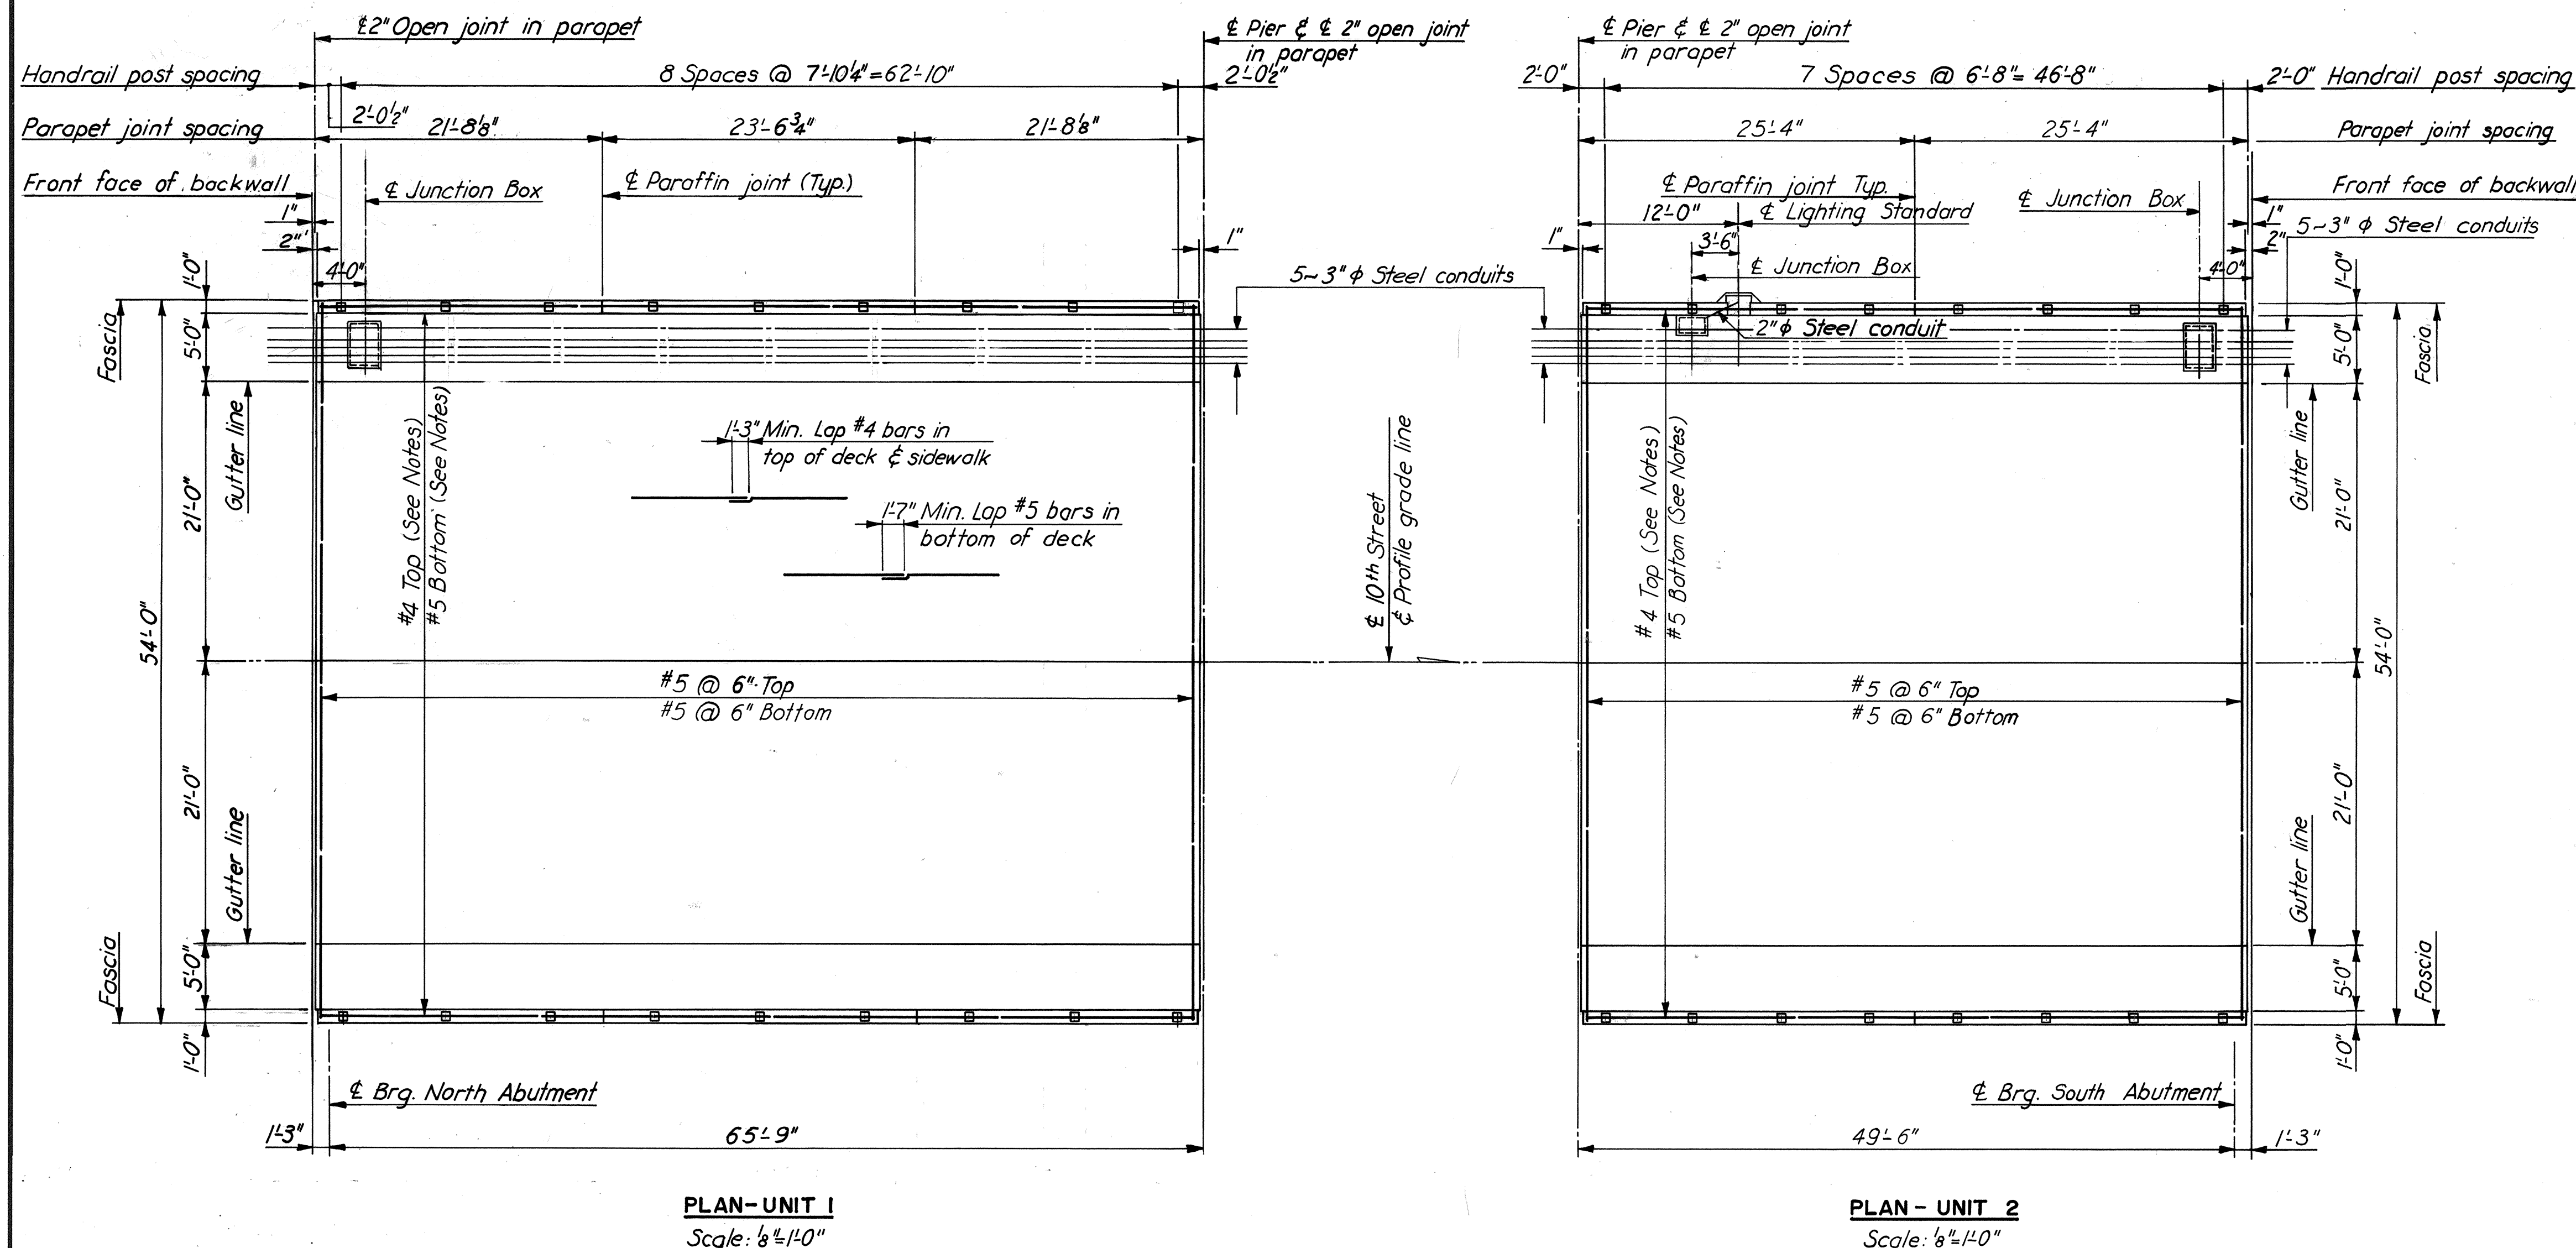

**NOTES:**

For location and spacing of deck, parapet and sidewalk reinforcing, see Cross Section and Utility Details sheet.

For location and spacing of reinforcing in haunch over end diaphragms, see Joint Details sheet.


For lighting standard base, junction box details and additional reinforcing, see Standard Electrical Details sheet S4.

MADE	BY	DATE			
CHECKED	DATE	REVISION	BY	DATE	
IN CHARGE	DATE	REVISION	BY	DATE	


AS BUILT

RICHMOND METROPOLITAN AUTHORITY RICHMOND EXPRESSWAY SYSTEM DOWNTOWN EXPRESSWAY			
BRIDGE B-60 10TH STREET OVER DOWNTOWN EXPRESSWAY			
DECK PLANS			
HOWARD, NEEDLES, TAMMEN & BERGENDOFF consulting engineers NEW YORK ALEXANDRIA KANSAS CITY			SCALE: AS SHOWN CONTRACT NO. 9 SHEET NO. 14 OF 17




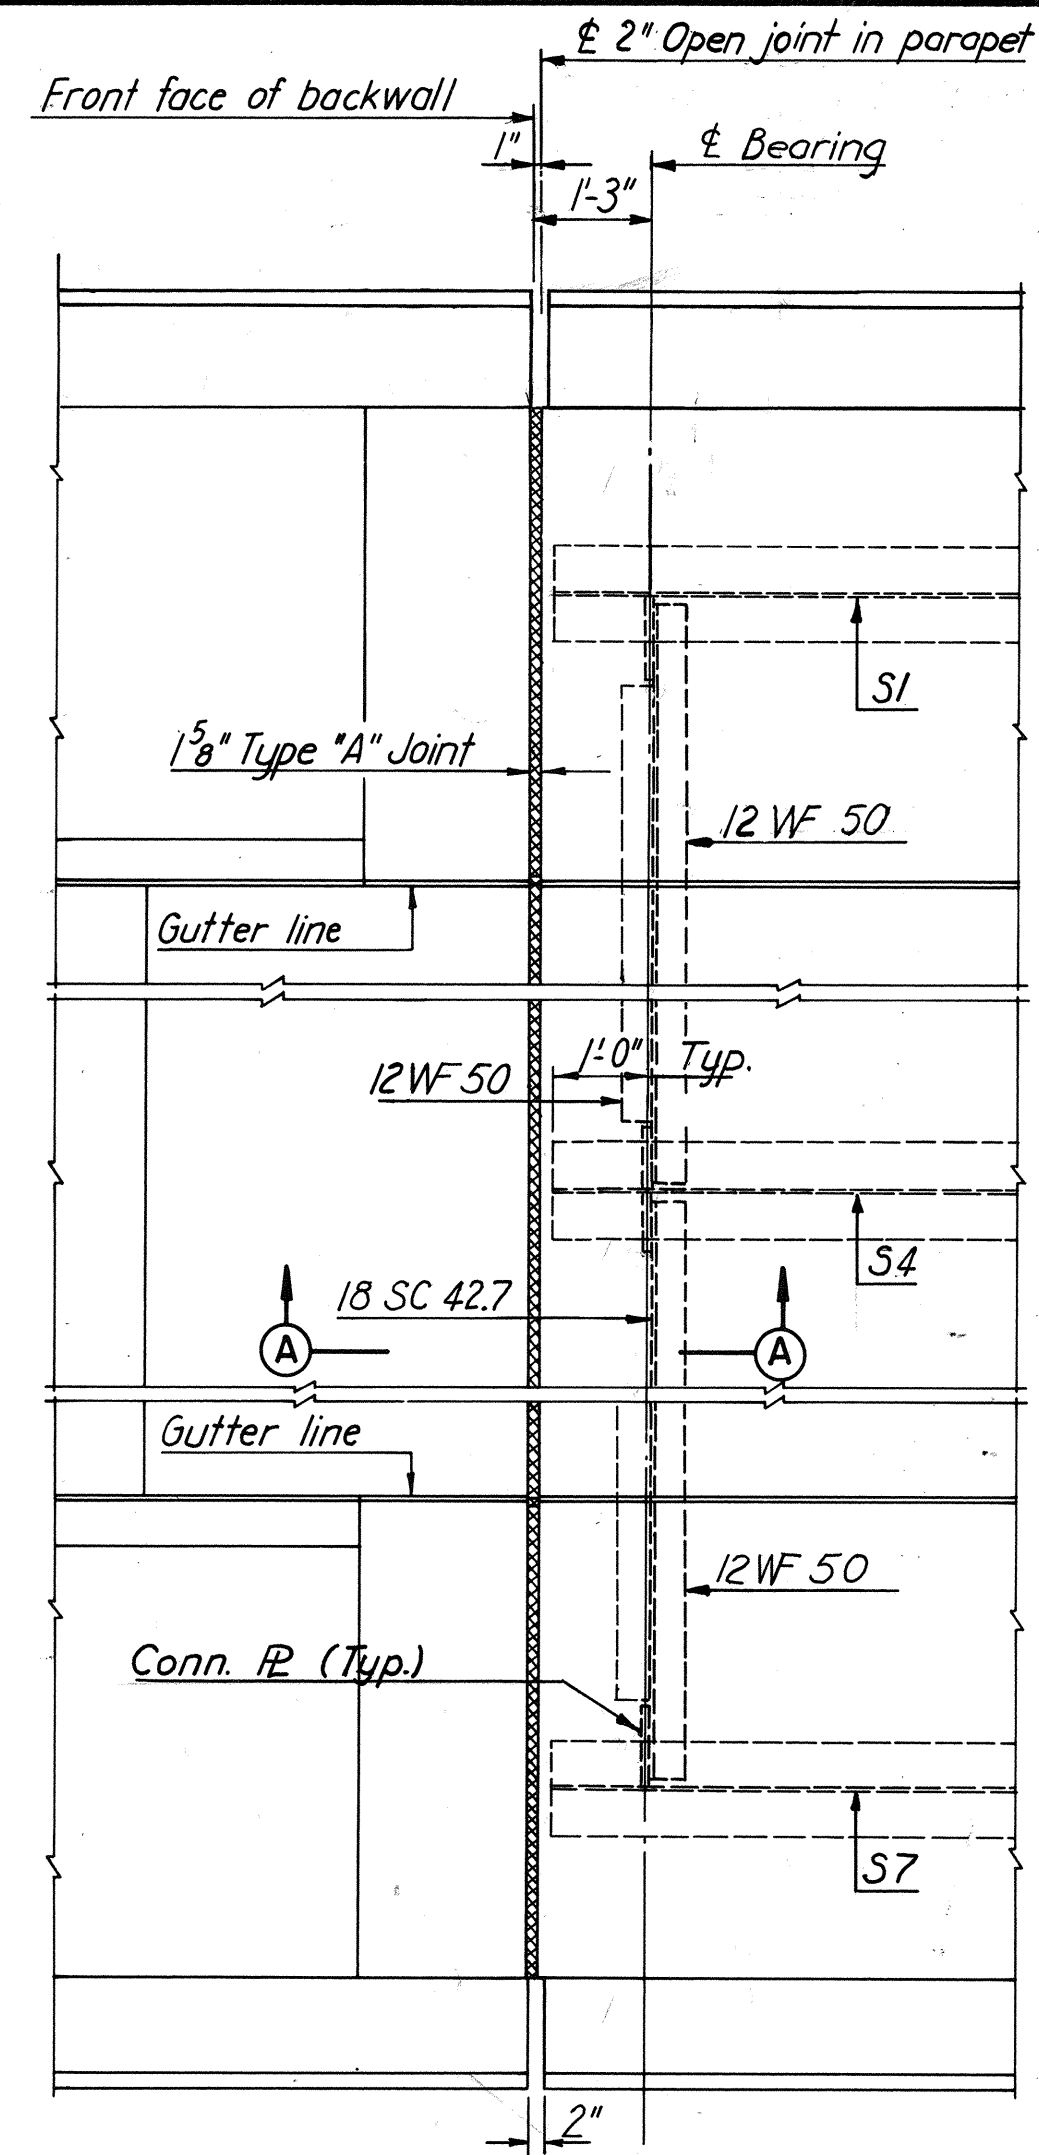


PLAN - JOINT AT NORTH ABUTMENT  
Scale: 1/2" = 1'-0"

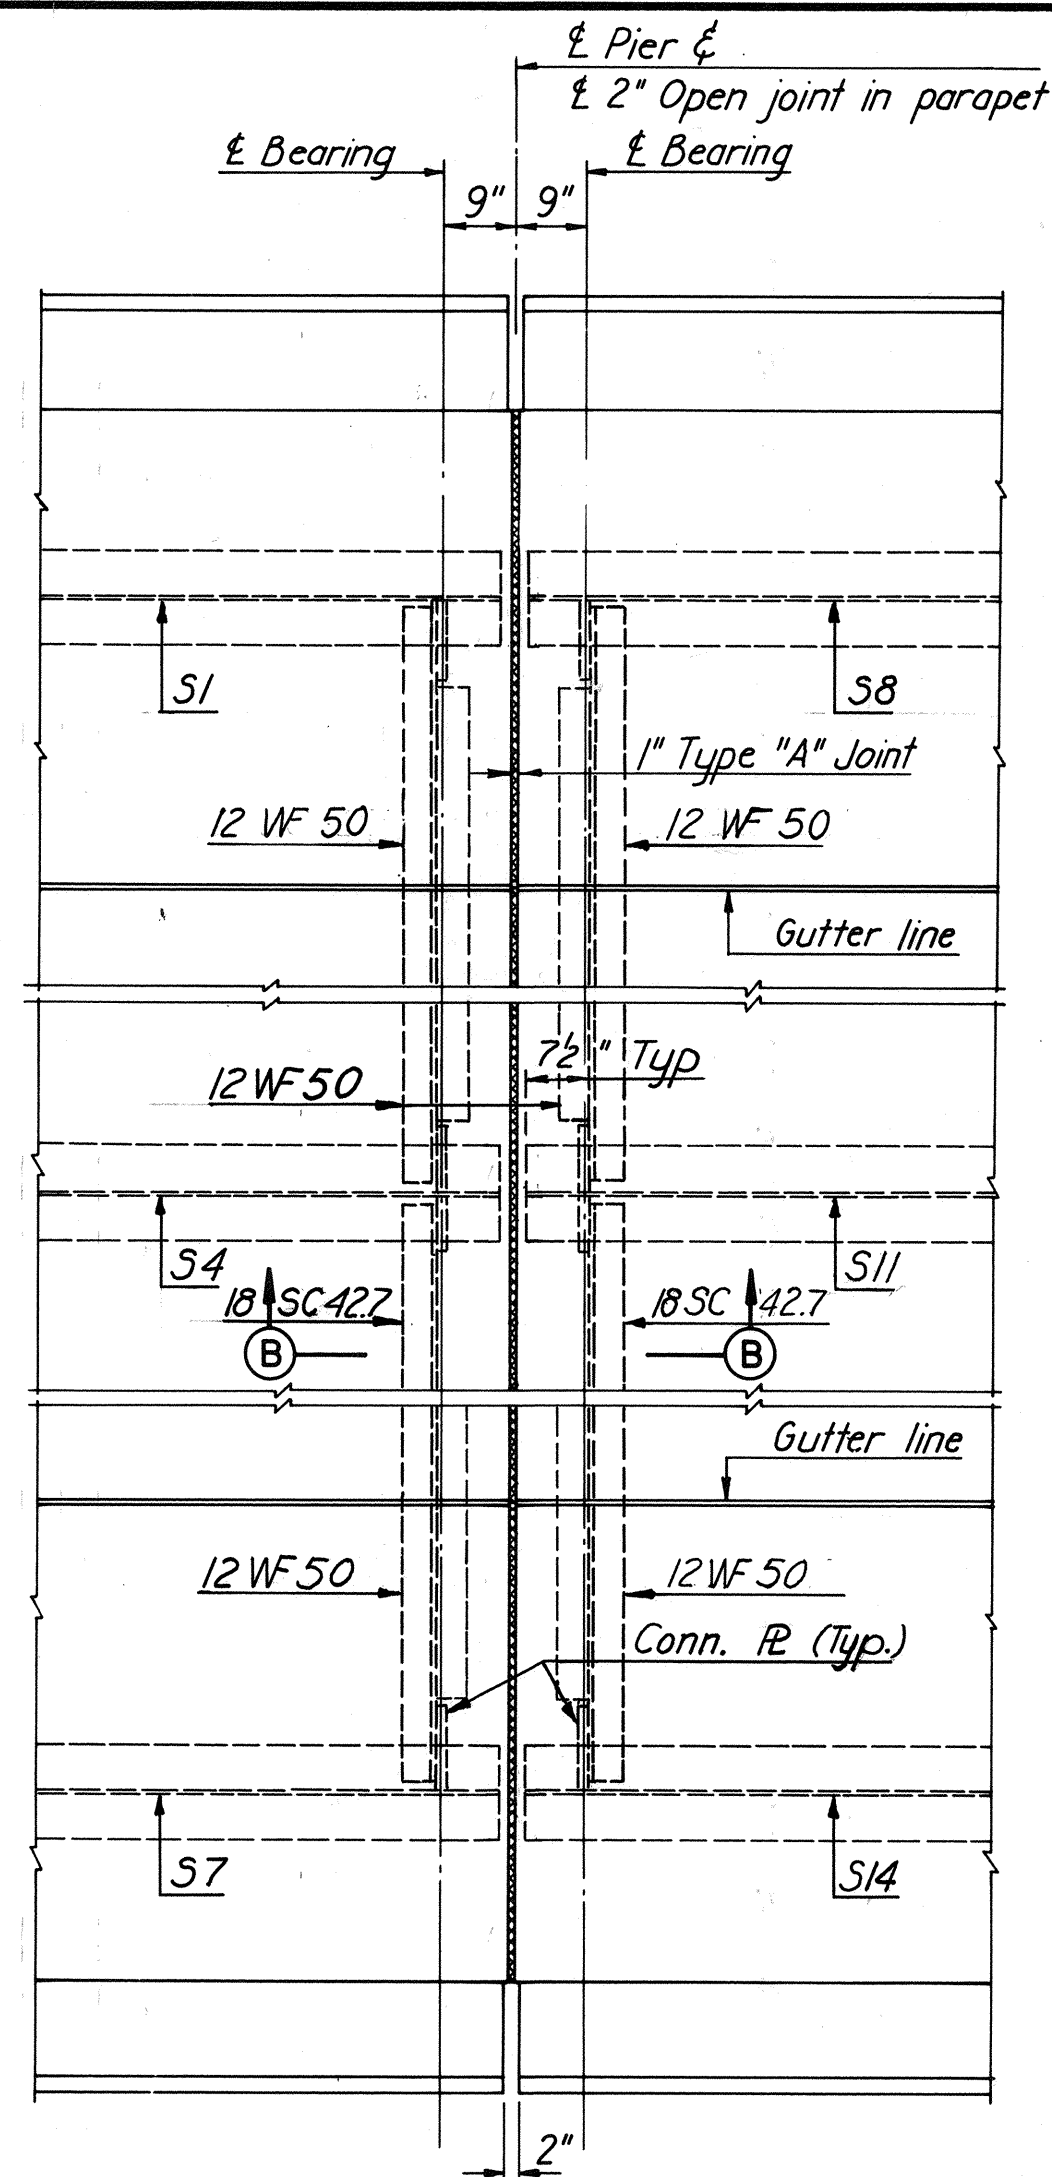


PLAN - JOINT AT PIER  
Scale: 1/2" = 1'-0"

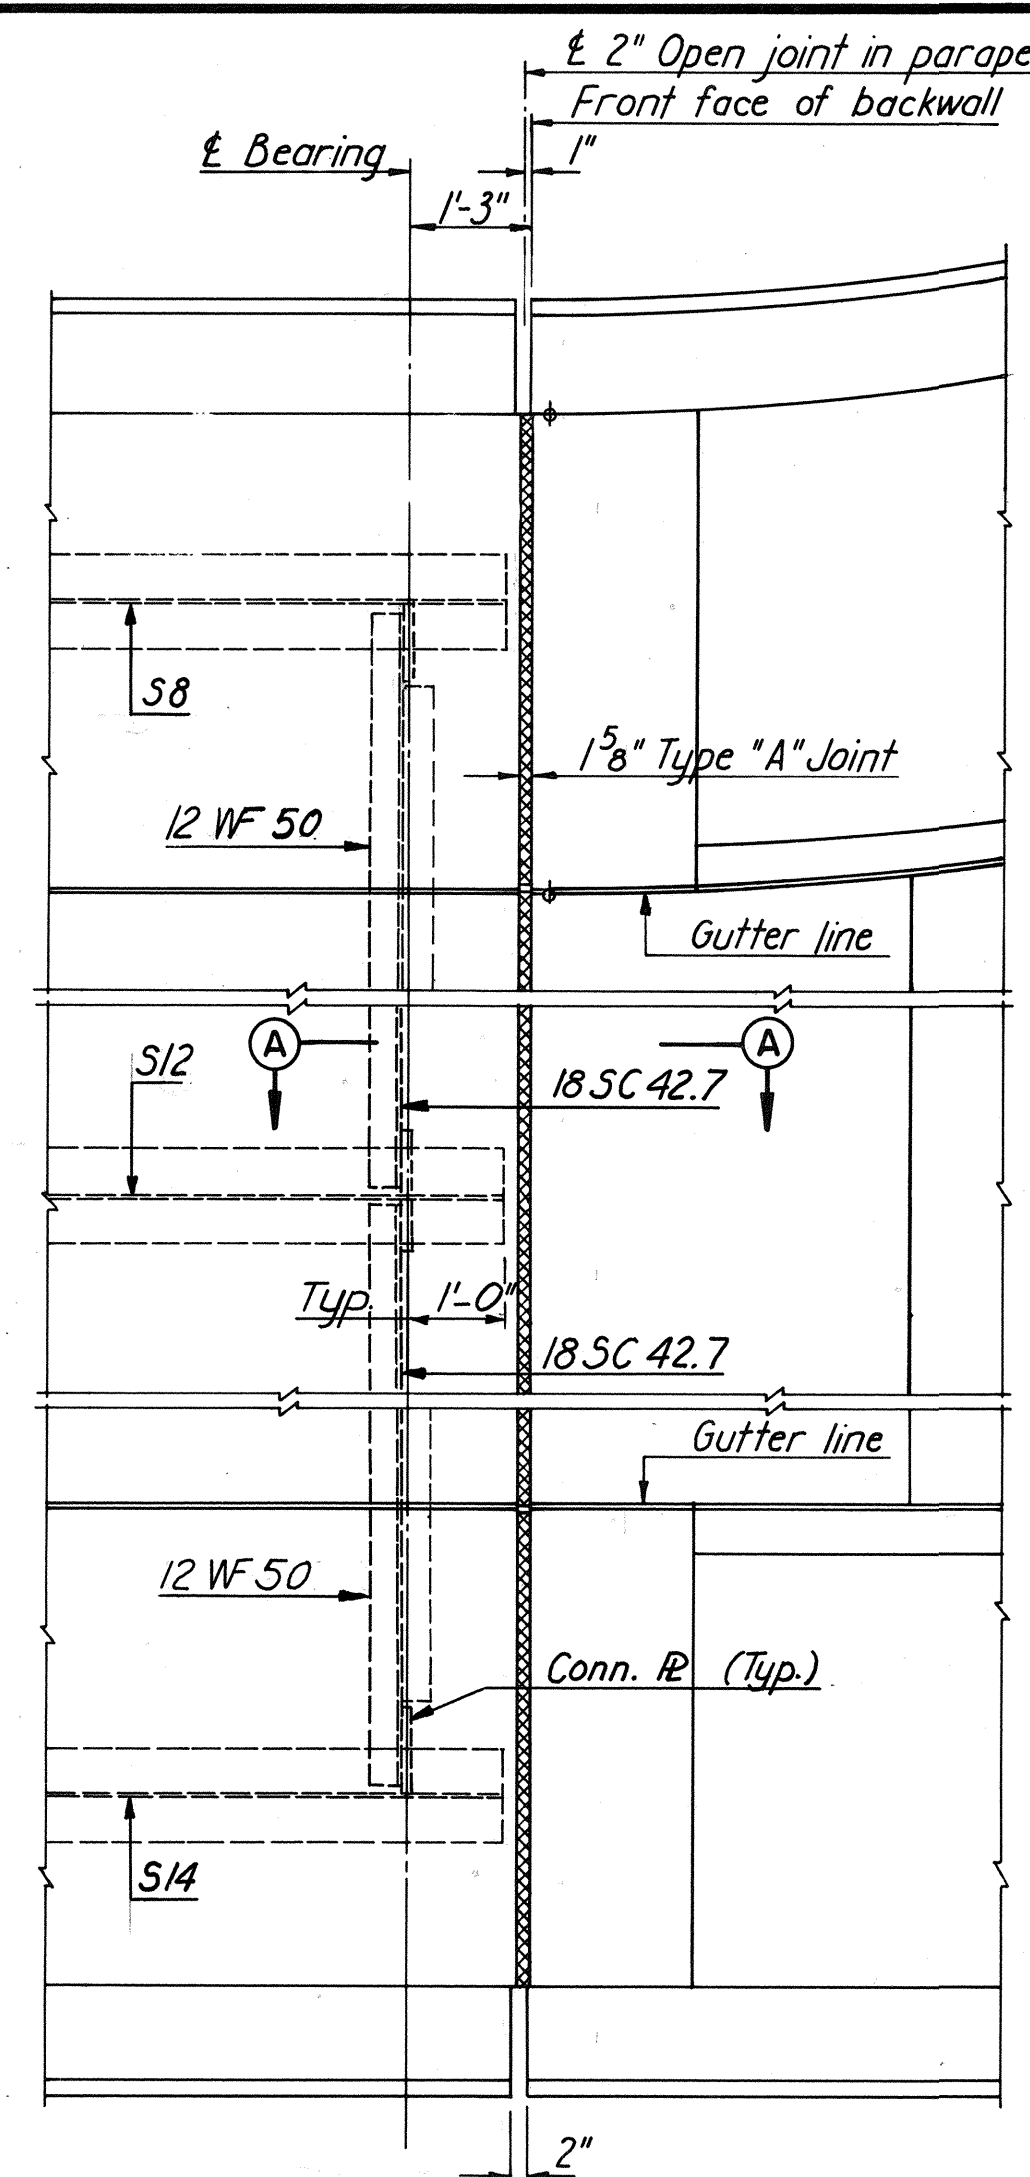


PLAN - JOINT AT SOUTH ABUTMENT  
Scale: 1/2" = 1'-0"

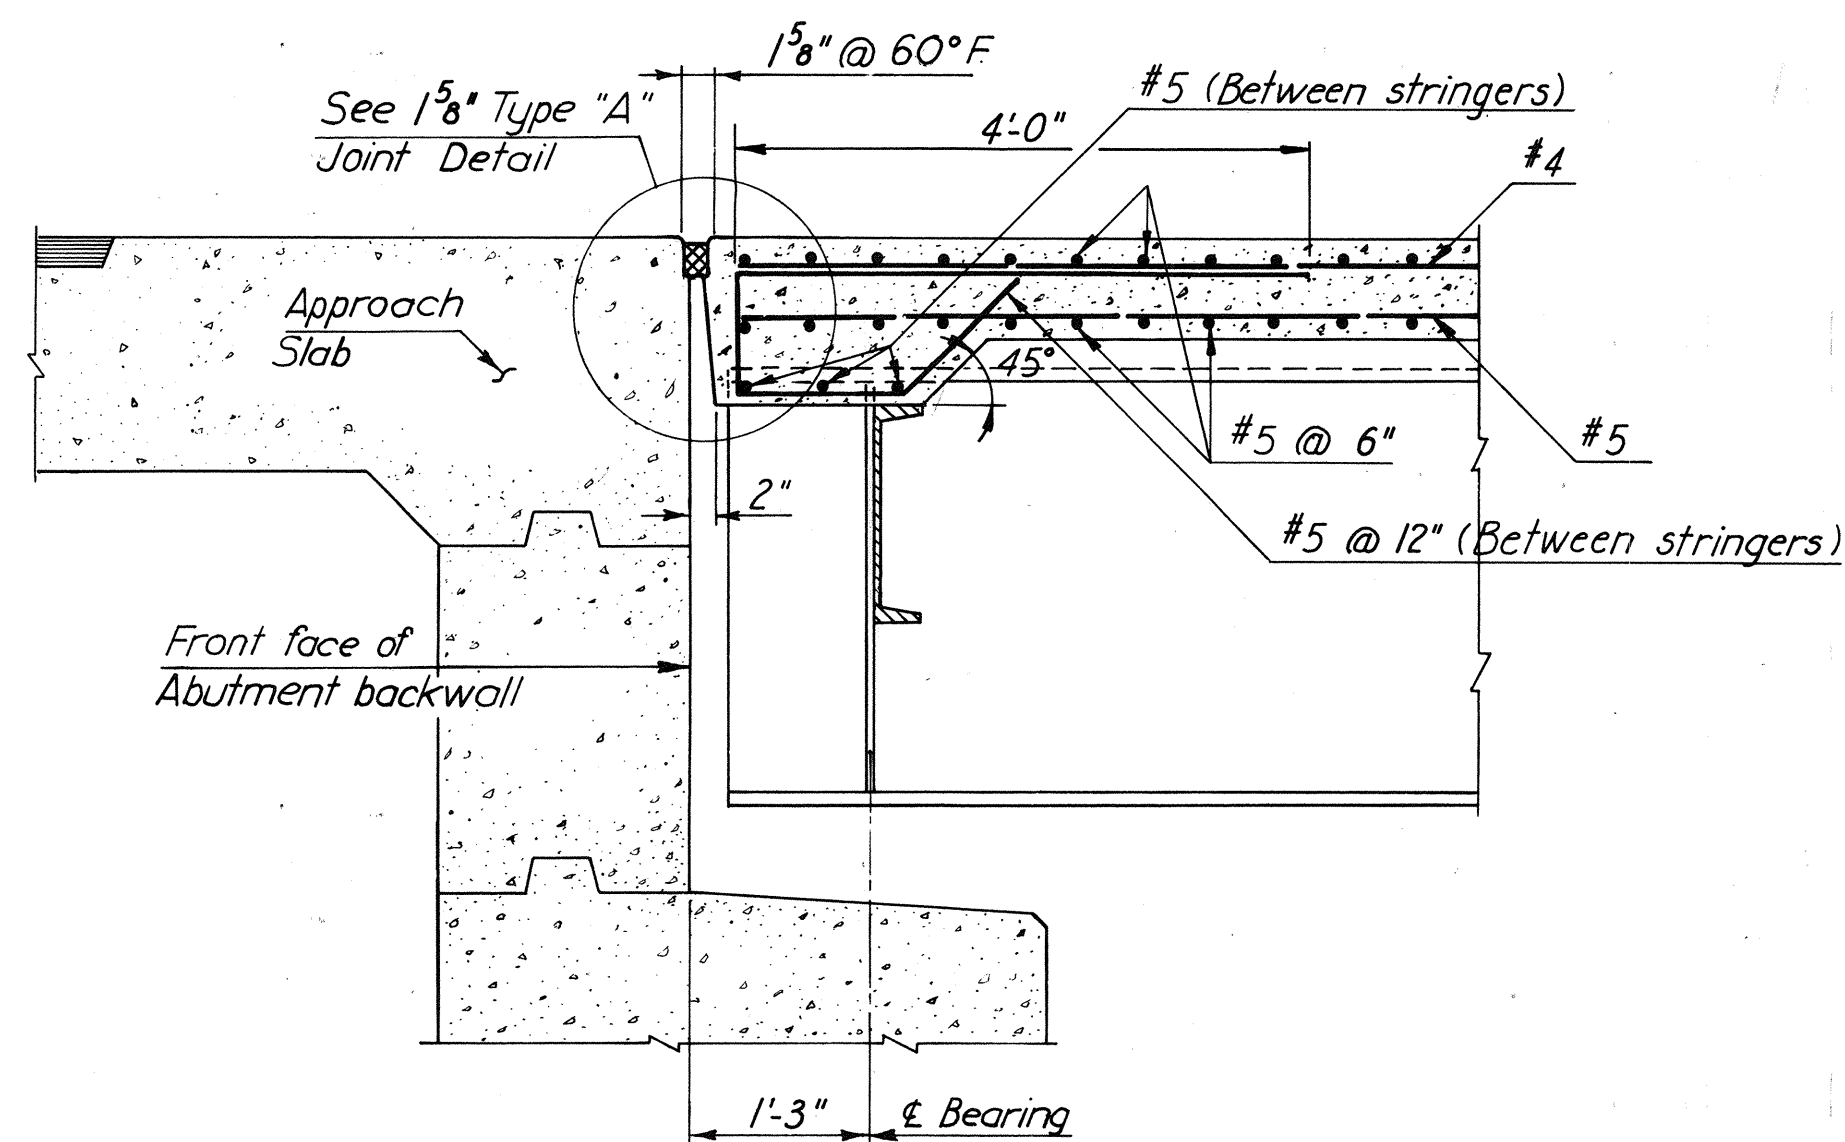


SECTION A-A  
Scale: 3/4" = 1'-0"

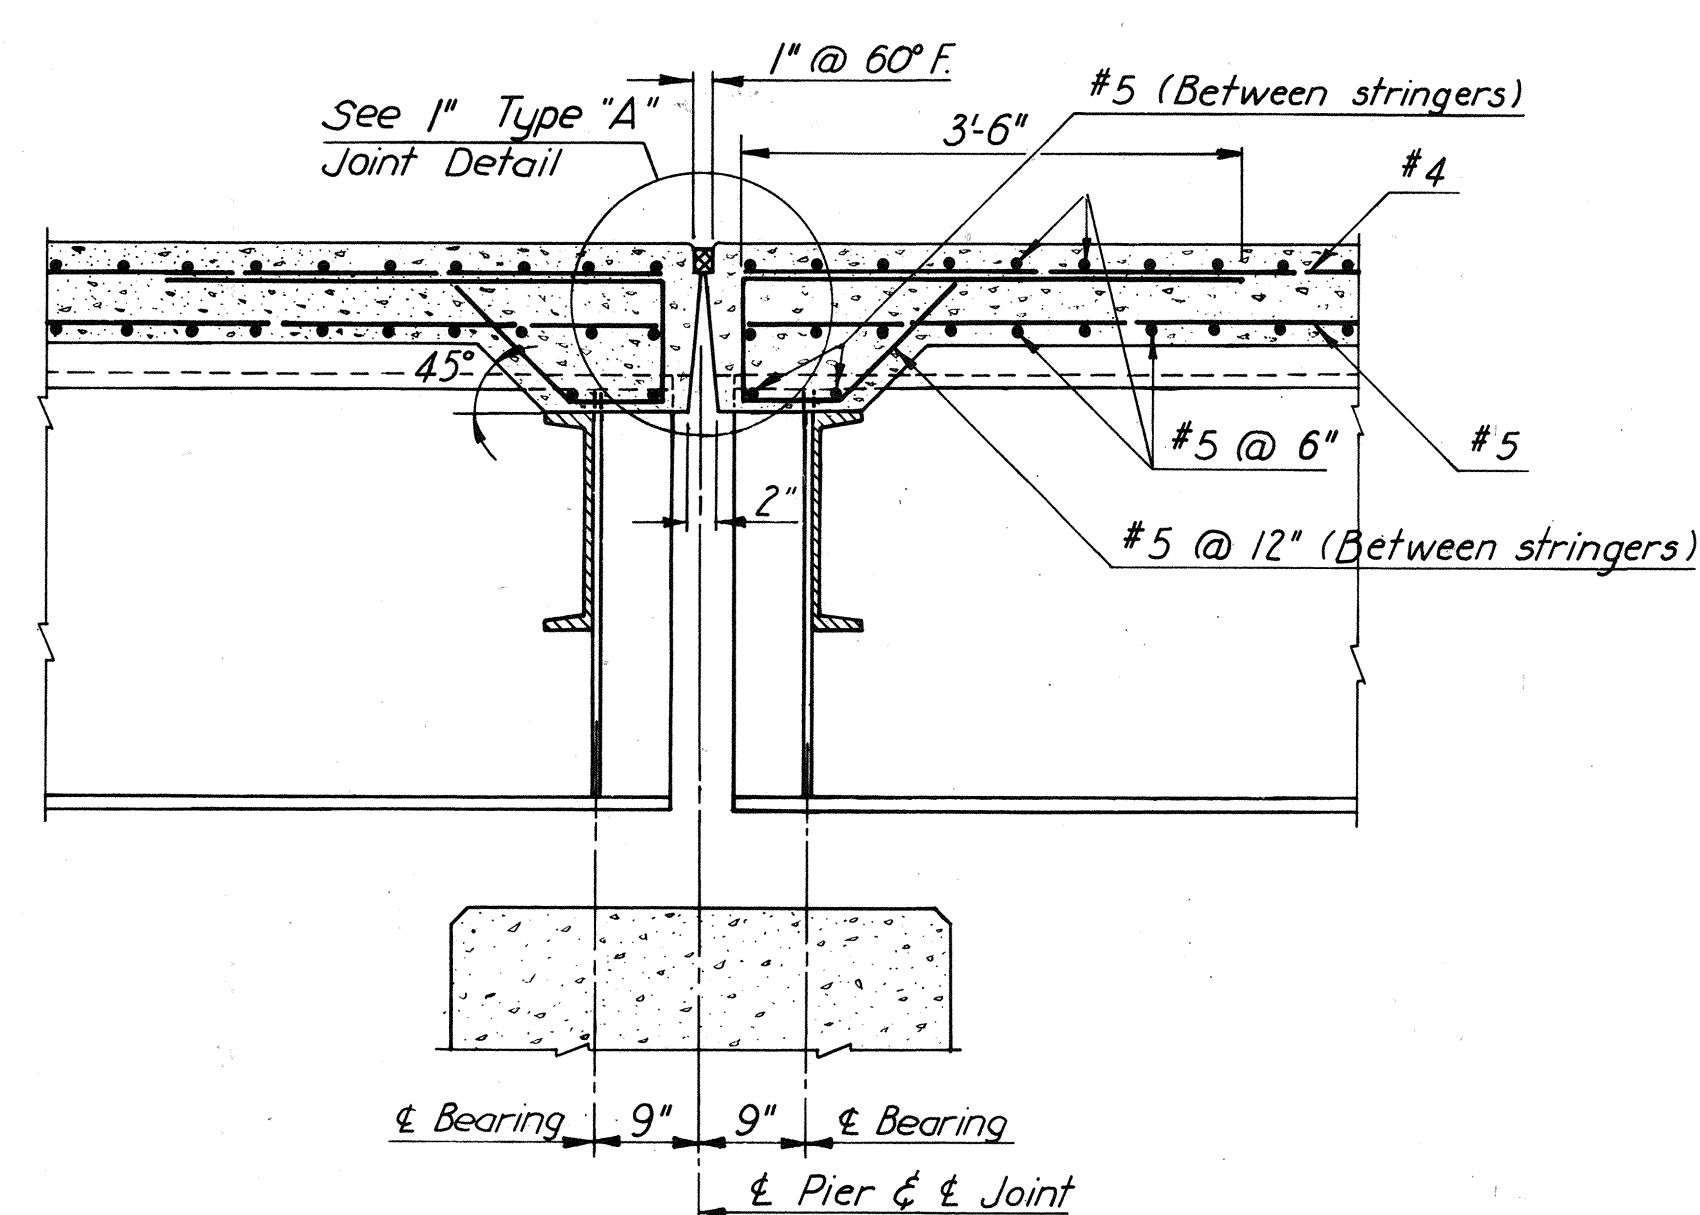




SECTION B-B  
Scale: 3/4" = 1'-0"

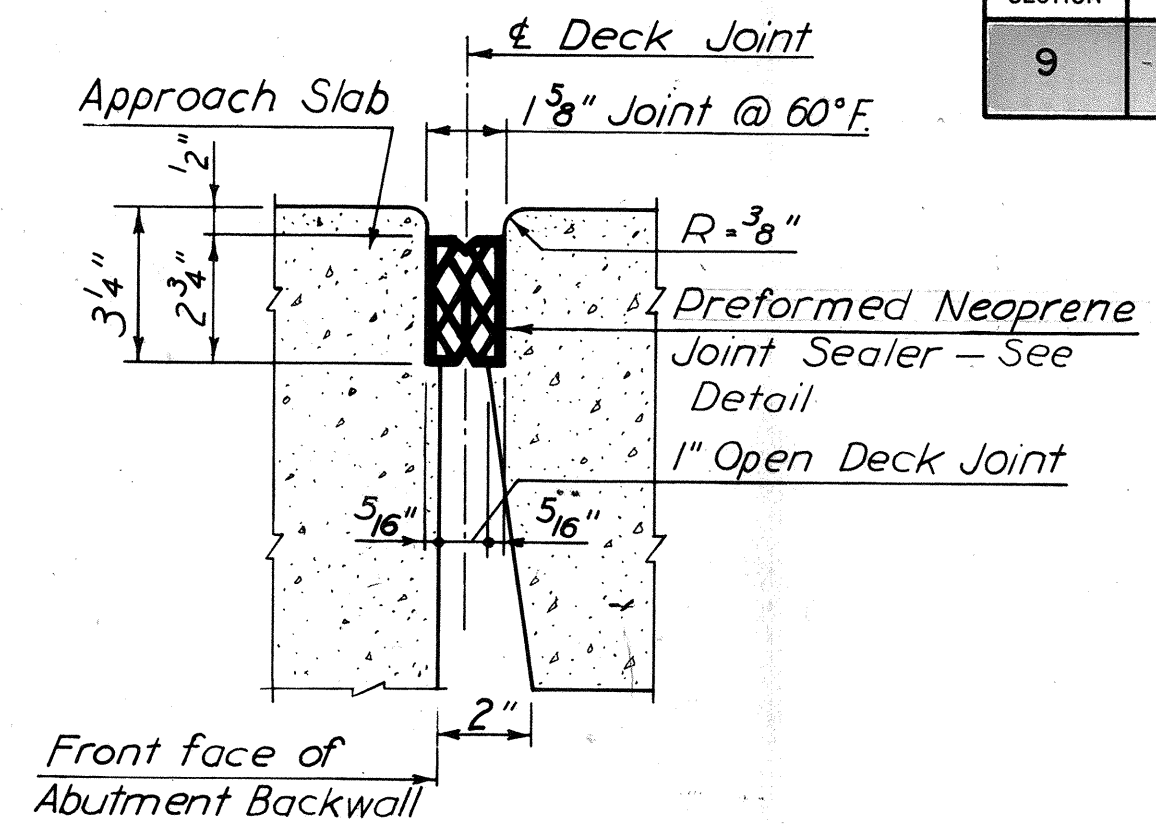

1 1/8" TYPE "A" JOINT  
Scale: 3/4" = 1'-0"

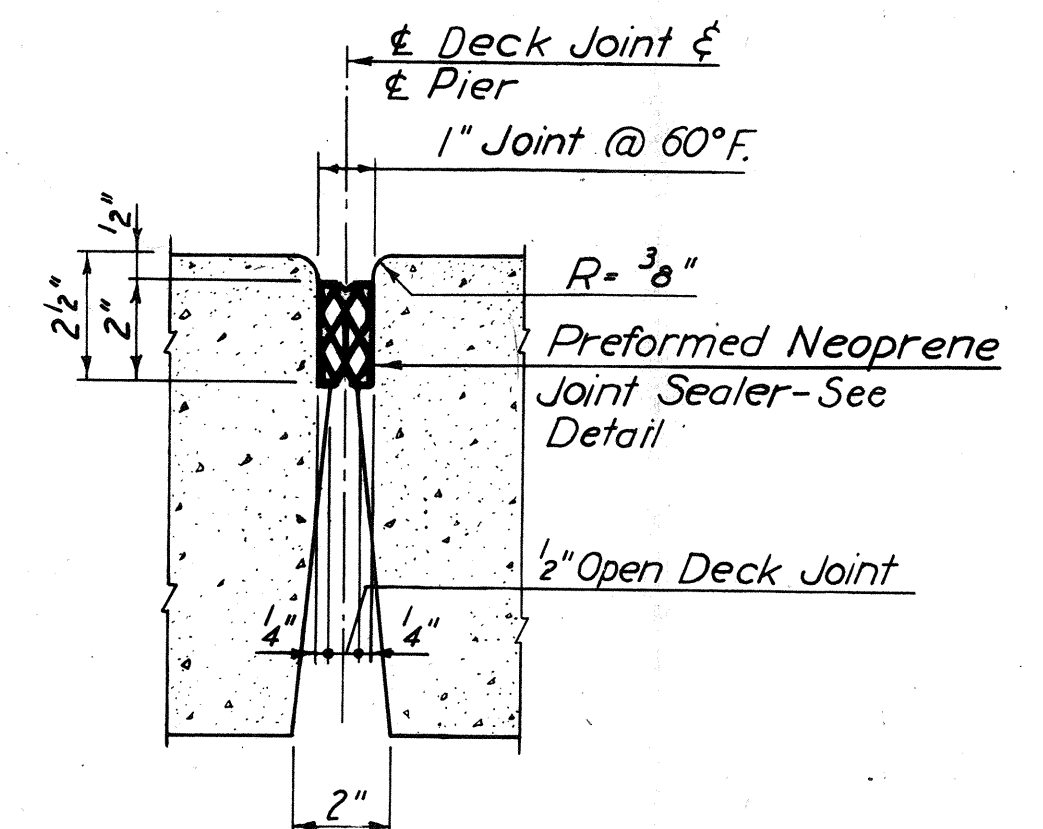

1" TYPE "A" JOINT  
Scale: 3/4" = 1'-0"

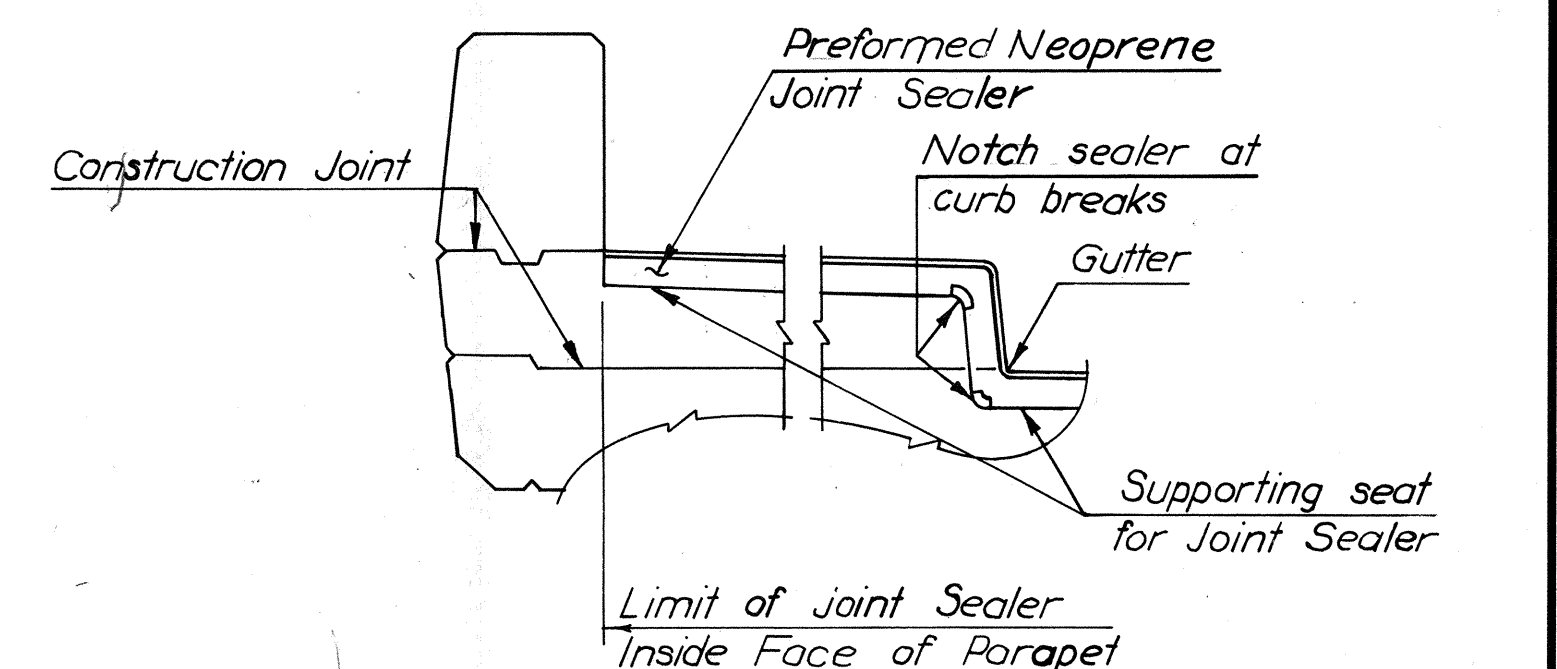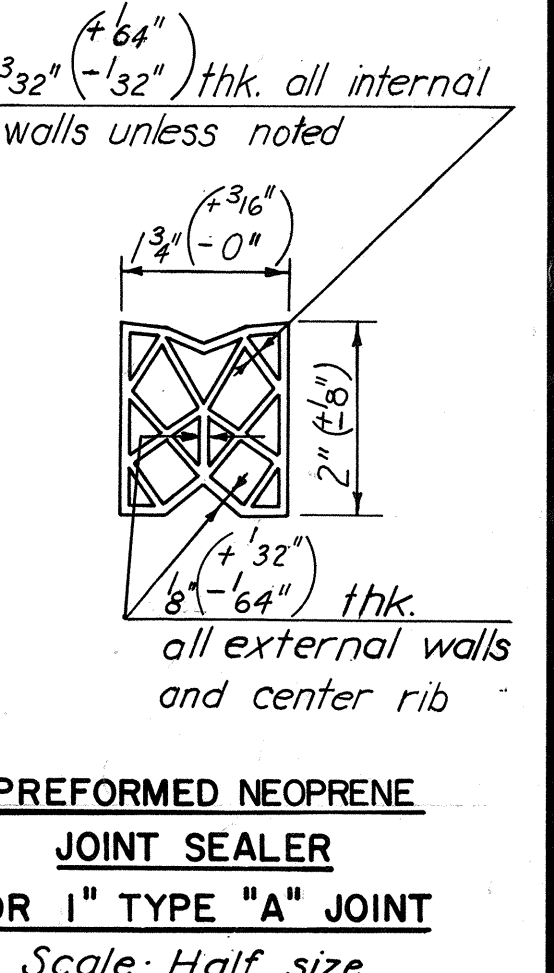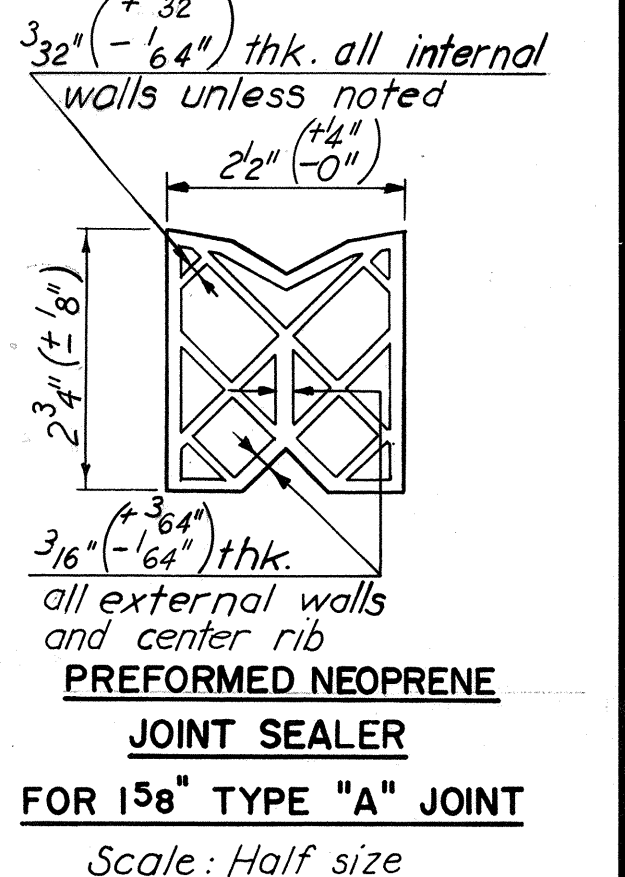

TREATMENT OF TYPE "A" JOINT AT CURB  
No Scale


**NOTE TO CONTRACTOR:**  
It is absolutely essential that the openings for the preformed Neoprene joint sealers be accurately formed and constructed to smooth, straight lines. The size of the opening shall be adjusted to allow for anticipated dead load rotation of the ends of the slab and for the temperature at the time of construction.

<b>RICHMOND METROPOLITAN AUTHORITY</b> <b>RICHMOND EXPRESSWAY SYSTEM</b> DOWNTOWN EXPRESSWAY BRIDGE B-60 10TH STREET OVER DOWNTOWN EXPRESSWAY <b>JOINT DETAILS</b>		SCALE: AS SHOWN CONTRACT NO. 9 SHEET NO. 15 OF 17
HOWARD, NEEDLES, TAMMEN & BERGENDOFF consulting engineers NEW YORK ALEXANDRIA KANSAS CITY		

AS BUILT




RICHMOND EXPRESSWAY SYSTEM			
SECTION	PROJECT	SHEET NO.	TOTAL SHEETS
9	DOWNTOWN EXPRESSWAY	219	

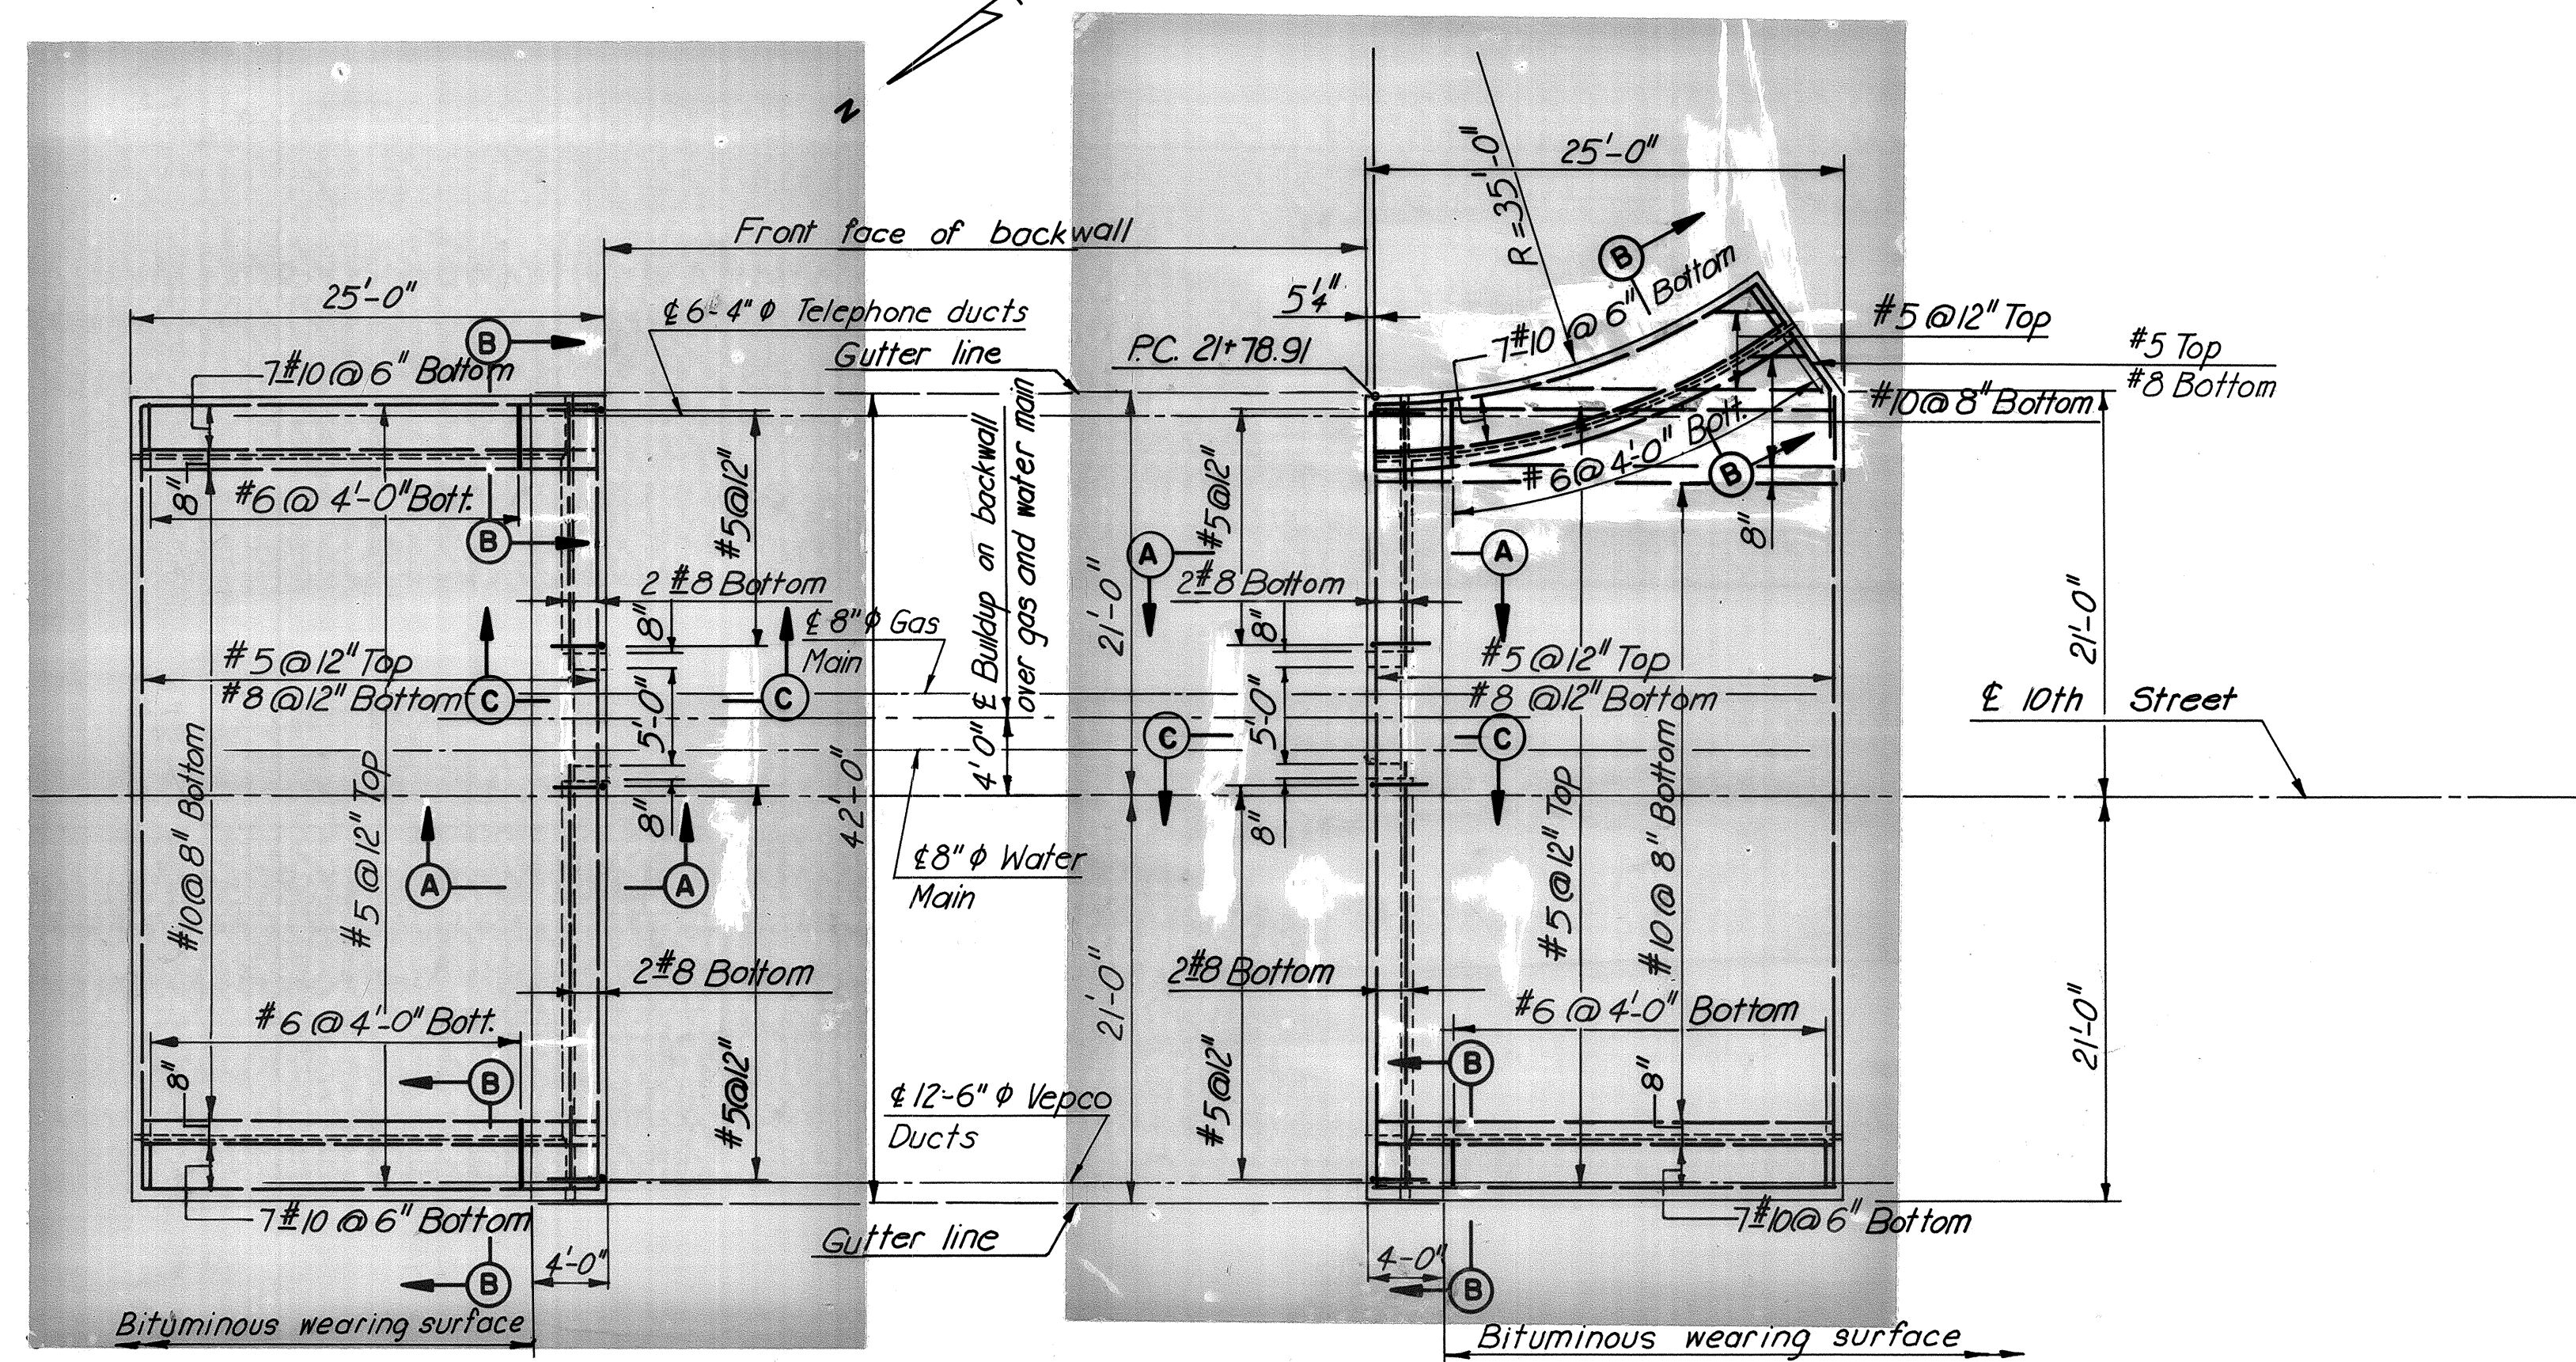


**NORTH APPROACH SLAB**  
Scale:  $\frac{1}{8}'' = 1'-0''$

**SOUTH APPROACH SLAB**  
Scale:  $\frac{1}{8}'' = 1'-0''$


**NOTE:**  
All reinforcing steel shall be 2" min.  
clear from edge of bar to edge of concrete.

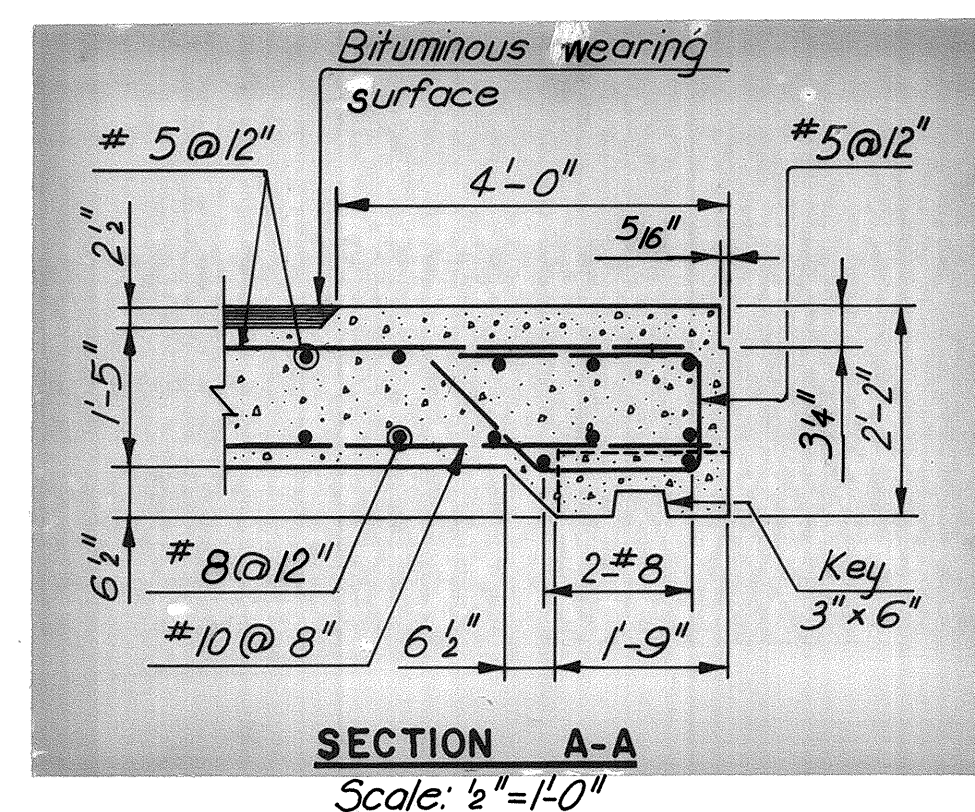

**SECTION A-A**  
Scale:  $\frac{1}{2}'' = 1'-0''$

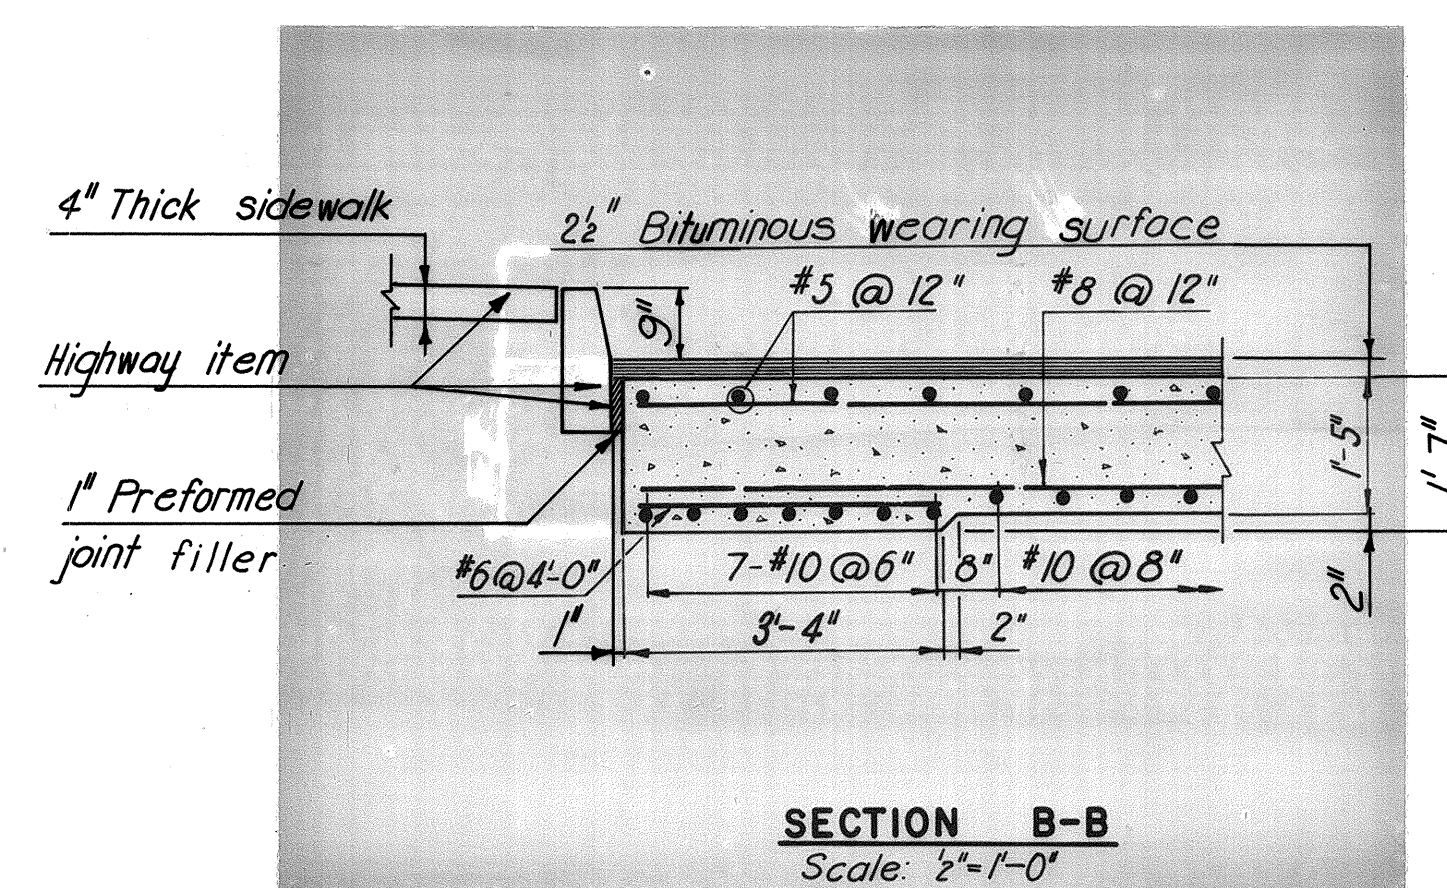

**SECTION B-B**  
Scale:  $\frac{1}{2}'' = 1'-0''$

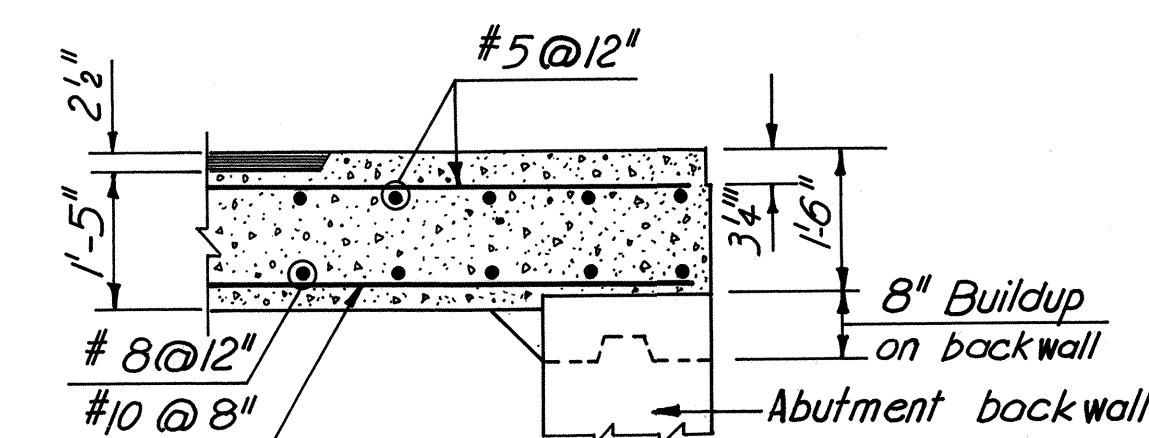

**SECTION C-C**  
Scale:  $\frac{1}{2}'' = 1'-0''$

BY	DATE				
MADE	elm	12-67			
CHECKED	TEM	2-68	1	As Built	TEM 7-77
IN CHARGE	PRY		NO.	REVISION	BY DATE

AS BUILT

RICHMOND METROPOLITAN AUTHORITY	
RICHMOND EXPRESSWAY SYSTEM	
DOWNTOWN EXPRESSWAY	
BRIDGE B-60	
10TH STREET OVER	
DOWNTOWN EXPRESSWAY	
APPROACH SLABS	
HOWARD, NEEDLES, TAMMEN & BERGENDOFF consulting engineers NEW YORK ALEXANDRIA KANSAS CITY	SCALE: AS SHOWN CONTRACT NO.: 9 SHEET NO. 16 OF 17








## **Bridge 62**

**(Westbound Downtown Expressway {Rte. 195} 11<sup>th</sup> Street Off-Ramp  
Over South 12<sup>th</sup> Street)**


**Record Set Plans**




RICHMOND EXPRESSWAY SYSTEM			
SECTION	PROJECT	SHEET NO.	TOTAL SHEETS
9	DOWNTOWN EXPRESSWAY	231	

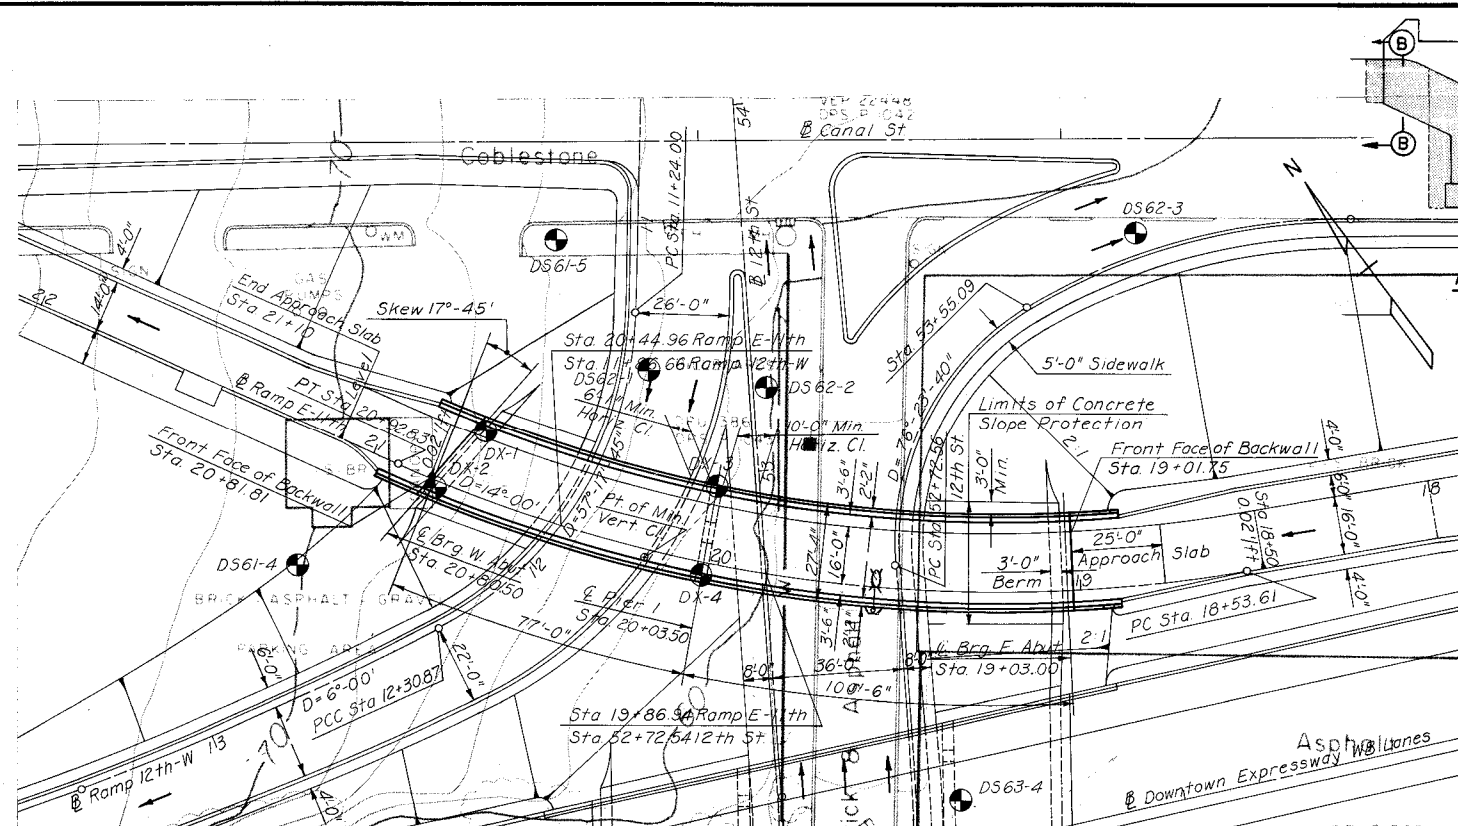


PLAN  
Scale: 1" = 25'

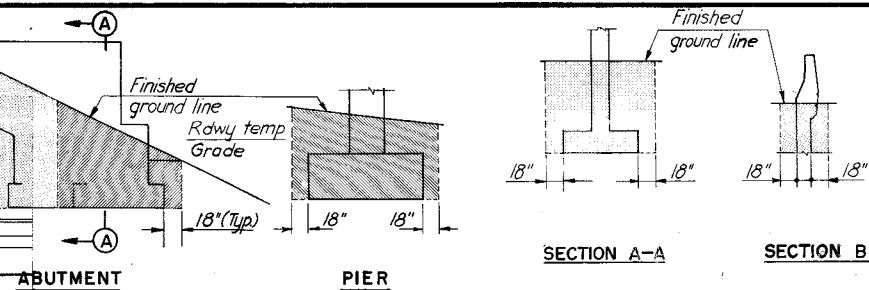

PAYMENT LIMITS FOR STRUCTURE  
EXCAVATIONS  
No Scale

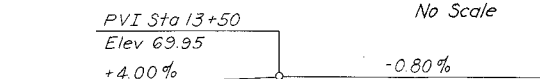


PROFILE GRADE RAMP 12TH-W  
No Scale

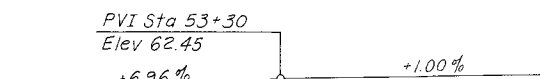


PROFILE GRADE 12TH ST  
No Scale

- GENERAL NOTES**
- ROADWAY: One 25'-0" face to face of rail.
- CAPACITY: Dead Load-Includes 15 lbs. per sq. ft. for future wearing surface. Live Loads-HS20-44 loading and B.P.R. modified for military vehicles.
- SPECIFICATIONS: GENERAL-Virginia Department of Highway Road and Bridge Specifications, 1970. DESIGN-A.A.S.H.O. Standard Specifications for Highway Bridges, 1961, modified by Special Design Provisions. WELDING-1969 Standard Specifications for welded Highway and Railway Bridges of the American Welding Society.
- CONTRACT SPECIAL PROVISIONS
- Specifications and Contract Special Provisions referred to above are necessary to make these plans complete.
- DATUM: CITY OF RICHMOND
- TEMPERATURE: The normal temperature referred to on the plan is 60°F. The temperature range for movement is 0°F, to 120°F.
- DIMENSIONS: All dimensions are measured horizontally and vertically unless otherwise noted.
- EXCAVATION: Excavation below subgrade and cut slope template shall be classified as Structure Excavation. All excavation above these limits shall be classified as Regular Excavation and is not included in the Structural Quantities.
- FOUNDATIONS: Footings shall rest on firm material. Foundation material shall be kept dry and special attention is called to Section 401.05 of the General Specifications and to the Contract Special Provisions concerning preparation of foundations for footings.
- CONCRETE NOTES:
- Concrete in superstructure shall be Class A4. All other concrete shall be Class A3. All exposed edges and corners shall have a 1/4" chamfer or fillet unless otherwise noted. Care in the method of vibration, the use of low-slump concrete, and or other means shall be employed to prevent downgrade movement of newly placed slab concrete. (When gradient is over 2%).
- Finishing concrete surfaces: See the Standard Architectural Detail Sheets and the Contract Special Provisions for types and details.
- All reinforcing steel shall conform to ASTM A615 grade 40. All reinforcing bar dimensions on the detailed drawings are to centers of bars unless otherwise noted. Clear distance between reinforcing steel and face of concrete shall be as noted on the plans. All bar laps shall be 30 diameters of the smaller diameter bar unless otherwise noted.
- STEEL NOTES: Structural steel shall conform to A.S.T.M. Specification A36 except as noted.
- All field connections shall be made with high strength bolts. High strength bolts shall be 3/4" diameter unless otherwise noted and shall conform to A.S.T.M. Specification A-325. All shop welded web splices, flange splices and web to flange welds shall be made by the submerged arc process.

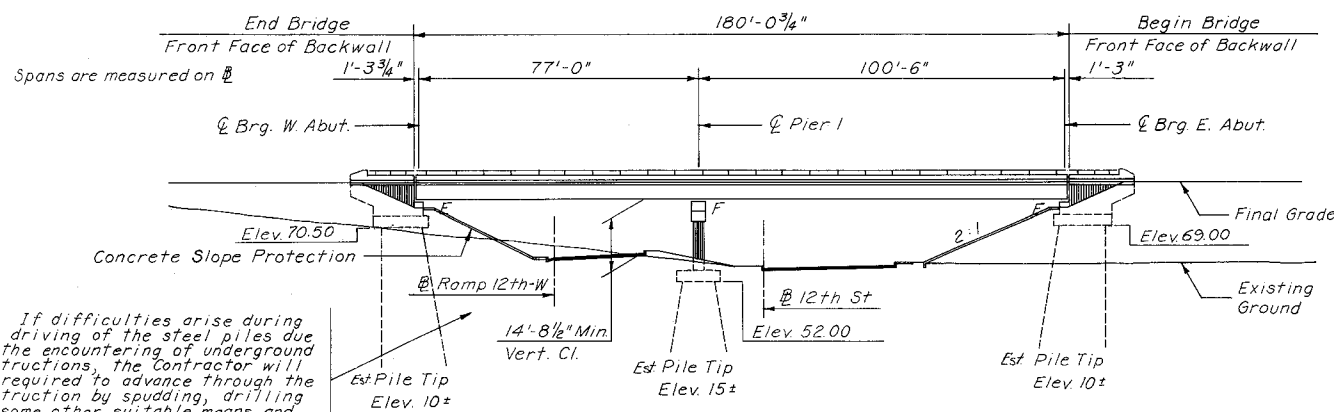

ELEVATION  
Scale: 1" = 25'

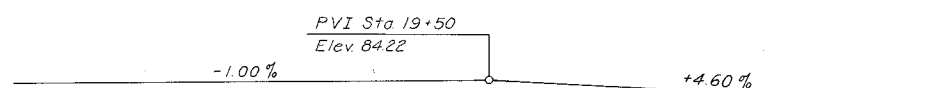

PROFILE RAMP E-11TH  
No Scale

INDEX OF SHEETS	
No	Title
1	General Plan and Elevation
2	West Abutment
3	East Abutment
4	Pier 1
5	Stringers
6	Stringer Details
7	Slab
8	Joint Details
9	Approach Slab and Slope Protection Details
10 & 11	Boring Logs
S1	Standard Shoe Details
S2	Standard Aluminum Railing Details (1 Rail)
S5	Standard Electrical Details (Exp Bridges)
S7	Standard Architectural Details

ESTIMATE OF QUANTITIES												
	Structure Excavation	Concrete Class A4	Concrete Class A3	Reinforcing Steel	Structural Steel A-36	Aluminum Br. Railing (1 Rail)	Porous Backfill	Steel Piles 10BP42	Conc. Slab Slope Prot	Asphalt Dampproof'g	Underdrain 6" Pipe	Metal Conduit 3" dia
	C.Y.	C.Y.	C.Y.	Lbs.	Lbs.	L.F.	C.Y.	L.F.	S.Y.	S.Y.	L.F.	L.F.
Superstructure		171.51		39,055	168,253	349						183
West Abutment	133		78.63	4,298		30	5	581.3	123.25	14	59	23.5
East Abutment	135		81.50	4,235		30	5	719.3	162.2	14	55	23.5
Pier 1	113		71.37	22,443				670.1				
Approach Slabs			49.82	11,682								
Total	381	171.51	231.50	81,713	168,253	409	10	1970.7	286.45	28	114	230


AS BUILT

MADE	BY	DATE	REVISION	BY	DATE
JLJ	11-67	2	As Built	TEM	7-77
LDL	1-68	1	Revised Light Location	TEM	9-74
IN CHARGE	PRY				

RICHMOND METROPOLITAN AUTHORITY	
RICHMOND EXPRESSWAY SYSTEM	
DOWNTOWN EXPRESSWAY	
BRIDGE NO. 62	
RAMP E-11TH OVER	
RAMP 12TH-W AND 12TH ST	
GENERAL PLAN AND ELEVATION	
HOWARD, NEEDLES, TAMMEN & BERGENDOFF consulting engineers NEW YORK ALEXANDRIA KANSAS CITY	SCALE: As Noted CONTRACT NO.: 9 SHEET NO. 1 OF 11



SHOE SCHEDULE			
EXPANSION SHOES		FIXED SHOES	
TYPE	NO. REQD.	TYPE	NO. REQD.
E 5	8	F 3	3
		F 14	1

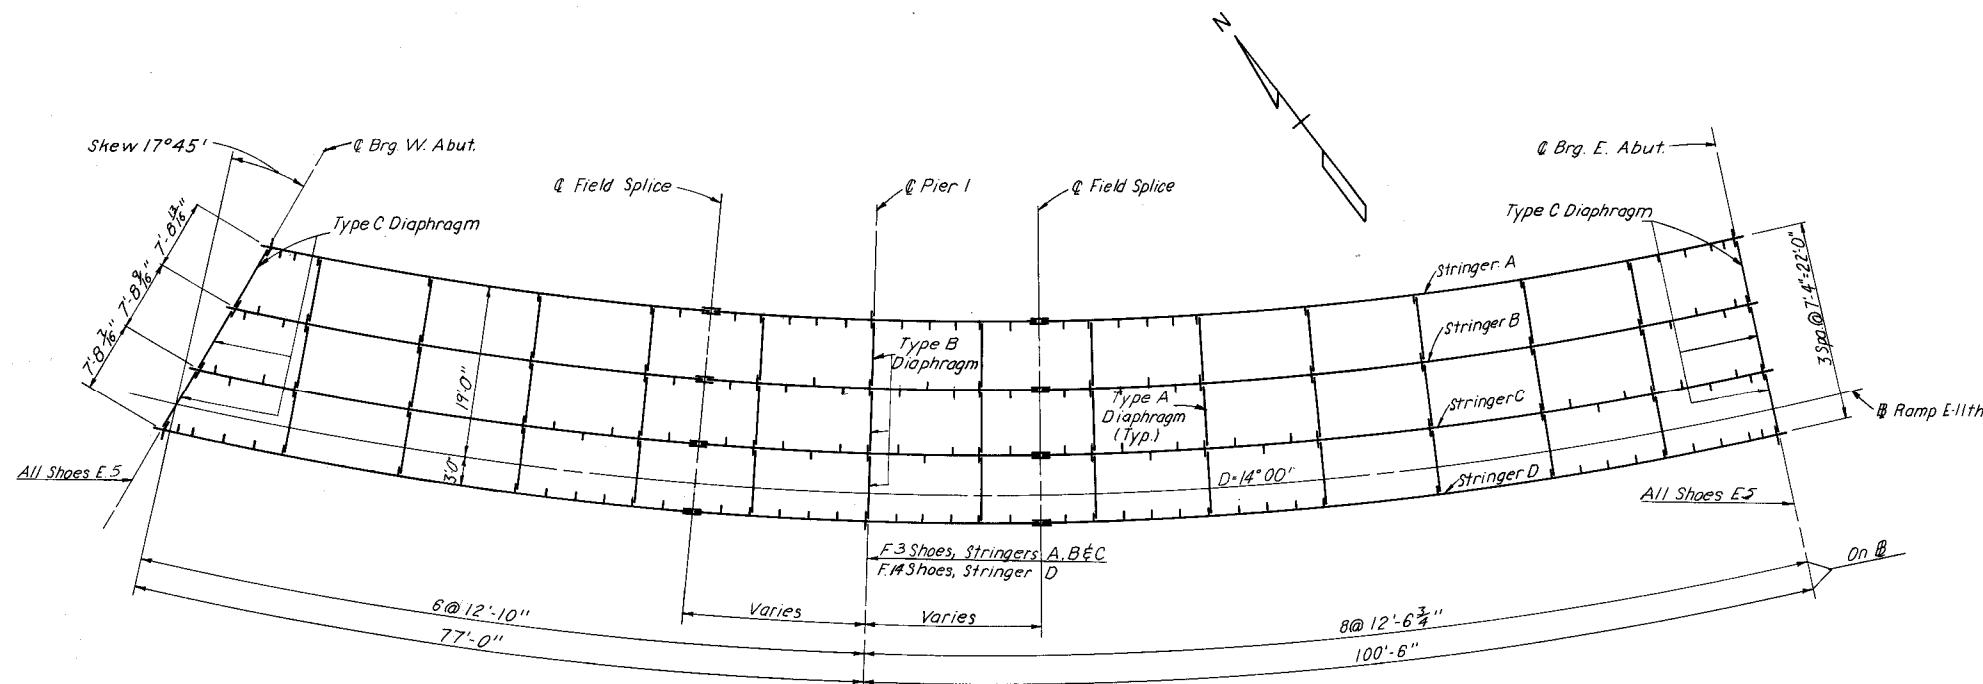

FRAMING PLAN


Scale 1"=10'

	Area A										Area B										Area A										
	0.0L-0.1L	0.1L-0.2L	0.2L-0.3L	0.3L-0.4L	0.4L-0.5L	0.5L-0.6L	0.6L-0.7L	0.7L-0.8L	0.8L-0.9L	0.9L-1.0L	0.0L-0.1L	0.1L-0.2L	0.2L-0.3L	0.3L-0.4L	0.4L-0.5L	0.5L-0.6L	0.6L-0.7L	0.7L-0.8L	0.8L-0.9L	0.9L-1.0L											
Shear Stud Spacing	10"	13"	17"	21"	24"	15"	12"	15"	13"	12"	12"	13"	10"	12"	17"	24"	24"	17"	12"	9"	Stringer A										
	10"	13"	17"	21"	24"	18"	14"	18"	16"	15"	15"	16"	12"	14"	18"	24"	24"	18"	14"	10"	Stringer B										
	10"	12"	16"	20"	21"	16"	12"	15"	13"	13"	13"	15"	11"	14"	18"	24"	22"	17"	12"	10"	Stringer C										
	8"	10"	14"	20"	18"	12"	10"	12"	10"	9"	9"	9"	7"	10"	14"	20"	20"	14"	9"	7"	Stringer D										
Top Flange	R 12x 1/2 x 41'-3 1/8"										R 16x 3/4 x 10'-0"										R 12x 1/2 x 79'-10"										Stringer A
	R 12x 1/2 x 45'-0 3/8"										R 16x 3/4 x 8'-0"										R 12x 1/2 x 40'-0"										Stringer B
	R 12x 1/2 x 46'-9 1/8"										R 16x 3/4 x 10'-0"										R 12x 1/2 x 45'-0"										Stringer C
	R 12x 1/2 x 48'-6 1/8"										R 16x 3/4 x 10'-0"										R 12x 1/2 x 44'-0"										Stringer D
	Taber Flg. width @ 1.24																														
	Web R 46x 3/8 (Typ.)																														
Bottom Flange	R 16x 3/4 x 51'-3 1/8"										R 16x 3/4 x 8'-0"										R 16x 1/2 x 45'-0"										Stringer A
	R 16x 3/4 x 55'-0 3/8"										R 16x 3/4 x 8'-0"										R 16x 1/2 x 45'-0"										Stringer B
	R 16x 3/4 x 56'-9 3/8"										R 16x 3/4 x 10'-0"										R 16x 1/2 x 47'-0"										Stringer C
	R 16x 1/2 x 58'-6 5/8"										R 16x 3/4 x 10'-0"										R 16x 1/2 x 55'-0"										Stringer D
Intermediate Stiffener Spacing Between Diaphragms	3 Spa. ①										4 Eq. Spa. ②										No Stiffeners										Stringer A
	4 Spa. ①										4 Eq. Spa. ②										No Stiffeners										Stringer B
	4 Spa. ①										4 Eq. Spa. ②										No Stiffeners										Stringer C
	5 Spa. ①										4 Eq. Spa. ②										No Stiffeners										Stringer D
Diaphragm Spacing	6'-1 1/8"										5 Spa. @ abt. 12'-2 3/8" = 61'-2 3/8"										8 Spa. @ abt. 11'-11 3/4" = 95'-10"										Stringer A
	8'-8 1/8"										5 Spa. @ abt. 12'-5 3/8" = 62'-4 1/8"										8 Spa. @ abt. 12'-2 1/8" = 97'-7 3/8"										Stringer B
	11'-3 1/8"										5 Spa. @ abt. 12'-8 3/8" = 63'-5 3/8"										8 Spa. @ abt. 12'-5 1/8" = 99'-5 1/8"										Stringer C
	13'-10 1/8"										5 Spa. @ abt. 12'-11 1/8" = 64'-7 3/8"										8 Spa. @ abt. 12'-7 3/8" = 101'-2 1/8"										Stringer D
Spans	67'-3 1/8"										71'-0 3/8"										95'-10"										Stringer A
	74'-9 3/8"										77'-7 3/8"										97'-7 3/8"										Stringer B
	78'-6 5/8"										99'-5 1/8"										101'-2 1/8"										Stringer C
																															Stringer D


GIRDER ELEVATION  
No Scale

DEFLECTION AND CAMBER										
STRINGER	ITEM	W. ABUT.	1/4	1/2	3/4	PIER 1	1/4	1/2	3/4	E. ABUT.
A	Steel	0	1/16	1/16	0	0	3/16	3/8	1/4	0
	Slab	0	3/16	1/8	0	0	5/8	1 1/16	2/8	0
	Curb and Parapet	0	1/16	1/16	-1/16	0	1/4	1/16	3/8	0
	Vertical Curve	0	15/16	15/16	13/16	0	33/16	4 1/4	33/16	0
B	Required Camber	0	1 1/4	1 3/8	1 3/16	0	4 3/8	6 1/8	4 1/16	0
	Steel	0	1/16	1/16	0	0	1/4	3/8	1/4	0
	Slab	0	3/16	1/8	0	0	3/4	1 1/16	1 1/16	0
	Curb and Parapet	0	0	0	0	0	0	1/16	0	0
C	Vertical Curve	0	15/16	15/16	13/16	0	33/16	4 1/4	33/16	0
	Required Camber	0	1 1/4	1 3/8	1 3/16	0	4 3/8	6 1/8	4 1/16	0
	Steel	0	1/16	1/16	0	0	1/4	3/8	1/4	0
	Slab	0	3/16	1/8	0	0	3/4	1 1/16	1 1/16	0
D	Curb and Parapet	0	0	0	0	0	1/16	1/16	1/16	0
	Vertical Curve	0	15/16	15/16	13/16	0	33/16	4 1/4	33/16	0
	Required Camber	0	1 1/4	1 3/8	1 3/16	0	4 3/8	6 1/8	4 1/16	0
	Steel	0	1/16	1/16	0	0	1/4	3/8	1/4	0
	Slab	0	3/16	1/8	0	0	3/4	1 1/16	1 1/16	0
	Curb and Parapet	0	0	0	0	0	1/16	1/16	1/16	0</




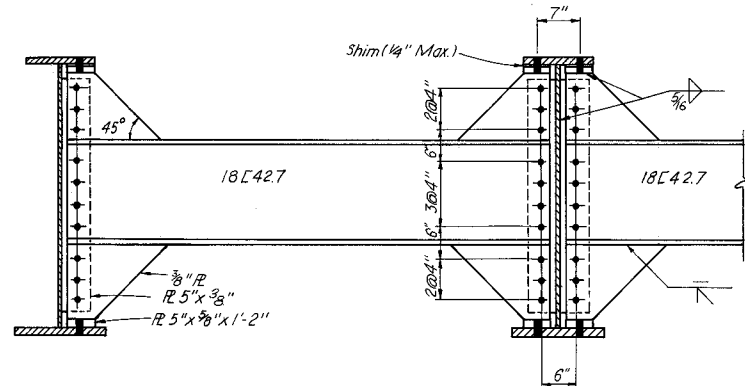



**TYPE A DIAPHRAGM**  
Scale  $\frac{3}{4}" = 1'-0"$

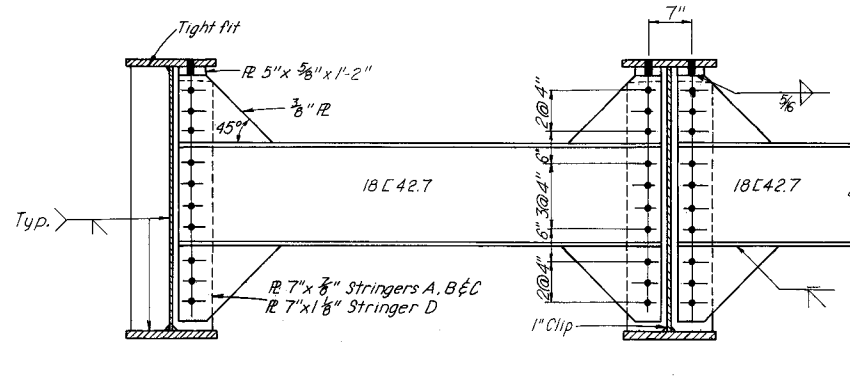


**TYPE B DIAPHRAGM**  
Scale  $\frac{3}{4}" = 1'-0"$

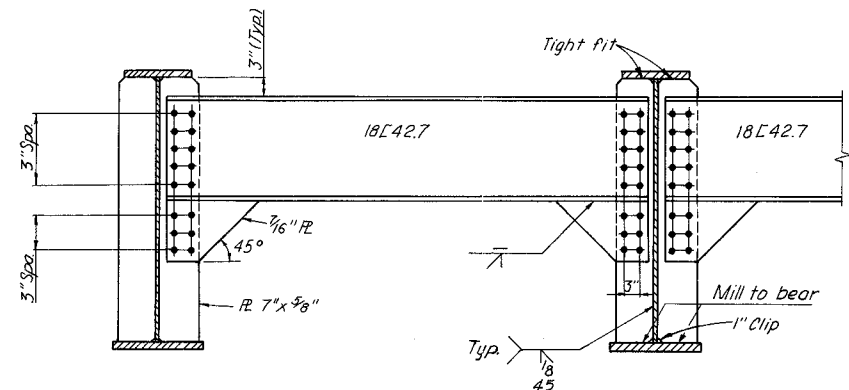


**TYPE C DIAPHRAGM**  
Scale  $\frac{3}{4}" = 1'-0"$

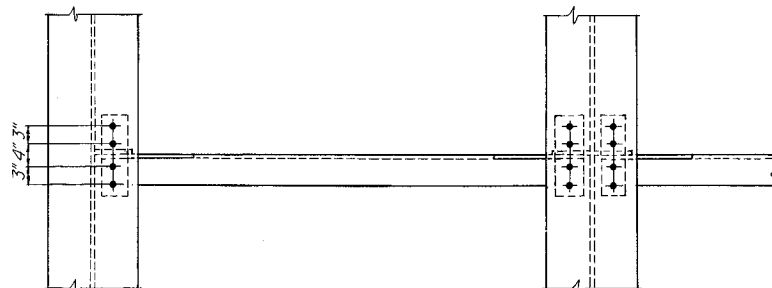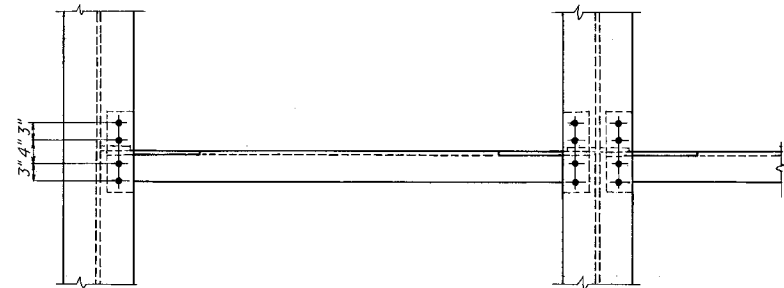

Note:  
Intermediate stiffeners shall be used on inside of Stringers A and D and alternate sides of Stringers B and C.

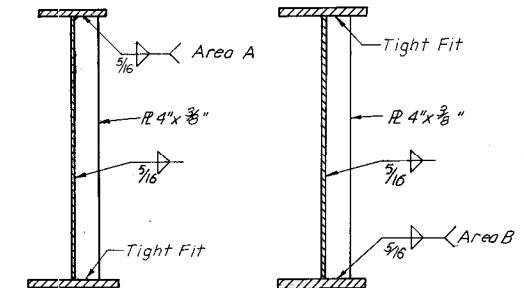


**INTERMEDIATE STIFFENER**  
Scale  $\frac{3}{4}" = 1'-0"$

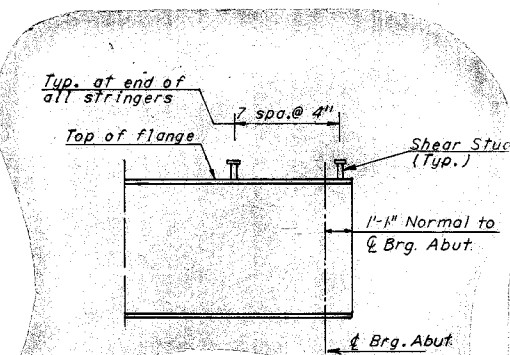


**SHEAR STUD DETAILS AT END BEARINGS**

**SHEAR STUD NOTE**


Capacity = 3,400 lbs. per stud.  
The contractor may, if he elects, use three 1/2 inch diameter studs at the same longitudinal spacing in lieu of the four 1/2 inch diameter studs shown.  
Stud rows shall be placed parallel to the main deck reinforcing.  
Shear stud spacing shown is maximum spacing.

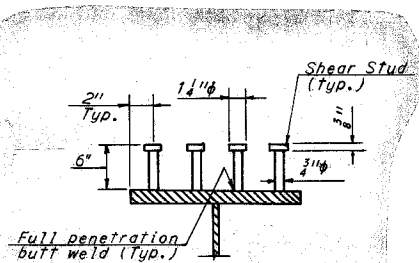

**SHEAR STUD DETAIL**

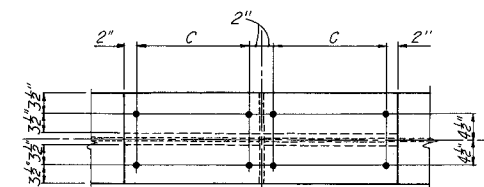


**16 INCH FLANGE TO 16 INCH FLANGE**  
Scale  $\frac{3}{4}" = 1'-0"$

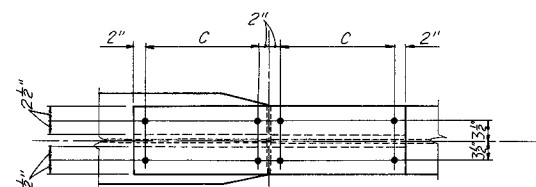

**16 INCH FLANGE TO 12 INCH FLANGE**  
Scale  $\frac{3}{4}" = 1'-0"$

SPICES			
FLANGE	R A	R B	C
R 12"x 1/2"	R 12"x 3/8"	R 5"x 3/8"	3 Spa @ 3"
R 12"x 3/4"	R 12"x 1/2"	R 5"x 1/2"	4 Spa @ 3"
R 12"x 1"	R 12"x 3/4"	R 5"x 3/4"	6 Spa @ 3"
R 16"x 3/4"	R 16"x 3/8"	R 7"x 1/2"	6 Spa @ 3"
R 16"x 1"	R 16"x 1/2"	R 7"x 3/8"	8 Spa @ 3"
R 16"x 1 1/4"	R 16"x 5/8"	R 7"x 1/2"	10 Spa @ 3"
R 16"x 1 1/2"	R 16"x 3/4"	R 7"x 3/8"	12 Spa @ 3"

Note:  
When splicing plates of unequal thickness, the splice for the smaller plate shall be used. Use fill plates as required at these locations.

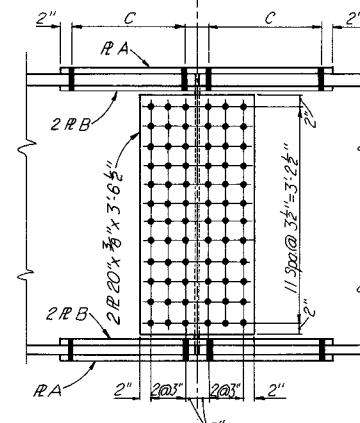


**WEB SPICE**  
Scale  $\frac{3}{4}" = 1'-0"$

**FIELD SPICE DETAILS**

THICKER PART JOINED (INCHES)	FILLET WELD (INCHES)
To 3/4 inclusive	5/16
Over 3/4 to 1 1/2	5/16
Over 1 1/2 to 2 1/4	3/8
Over 2 1/4 to 6	1/2

The above table shall be used where weld sizes are not indicated. The weld size need not exceed the thickness of the thinner part joined.

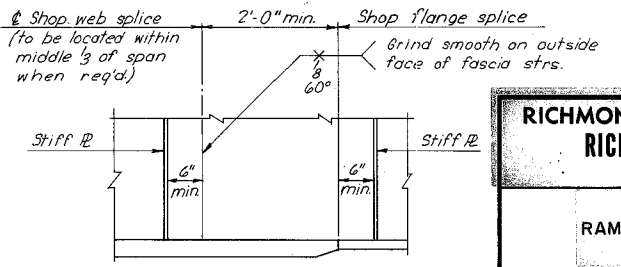

**SHOP SPICE DETAILS**

Scale  $\frac{3}{4}" = 1'-0"$

**AS BUILT**

**RICHMOND METROPOLITAN AUTHORITY**  
**RICHMOND EXPRESSWAY SYSTEM**  
**DOWNTOWN EXPRESSWAY**

**BRIDGE NO. 62**  
**RAMP E-11TH OVER RAMP 12TH-W**  
**OVER 12TH ST.**  
**STRINGER DETAILS**


HOWARD, NEEDLES, TAMMEN & BERGENDOFF  
consulting engineers  
NEW YORK ALEXANDRIA KANSAS CITY

SCALE: As Noted  
CONTRACT NO.: 9  
SHEET NO. 6 OF 11


BY	DATE				
MADE	RDR	1-2-68			
CHECKED	JLJ	1-68	1	As Built	TEM 7-77
IN CHARGE	PRY		NO.	REVISION	BY DATE




RICHMOND EXPRESSWAY SYSTEM			
SECTION	PROJECT	SHEET NO.	TOTAL SHEETS
9	DOWNTOWN EXPRESSWAY	237	

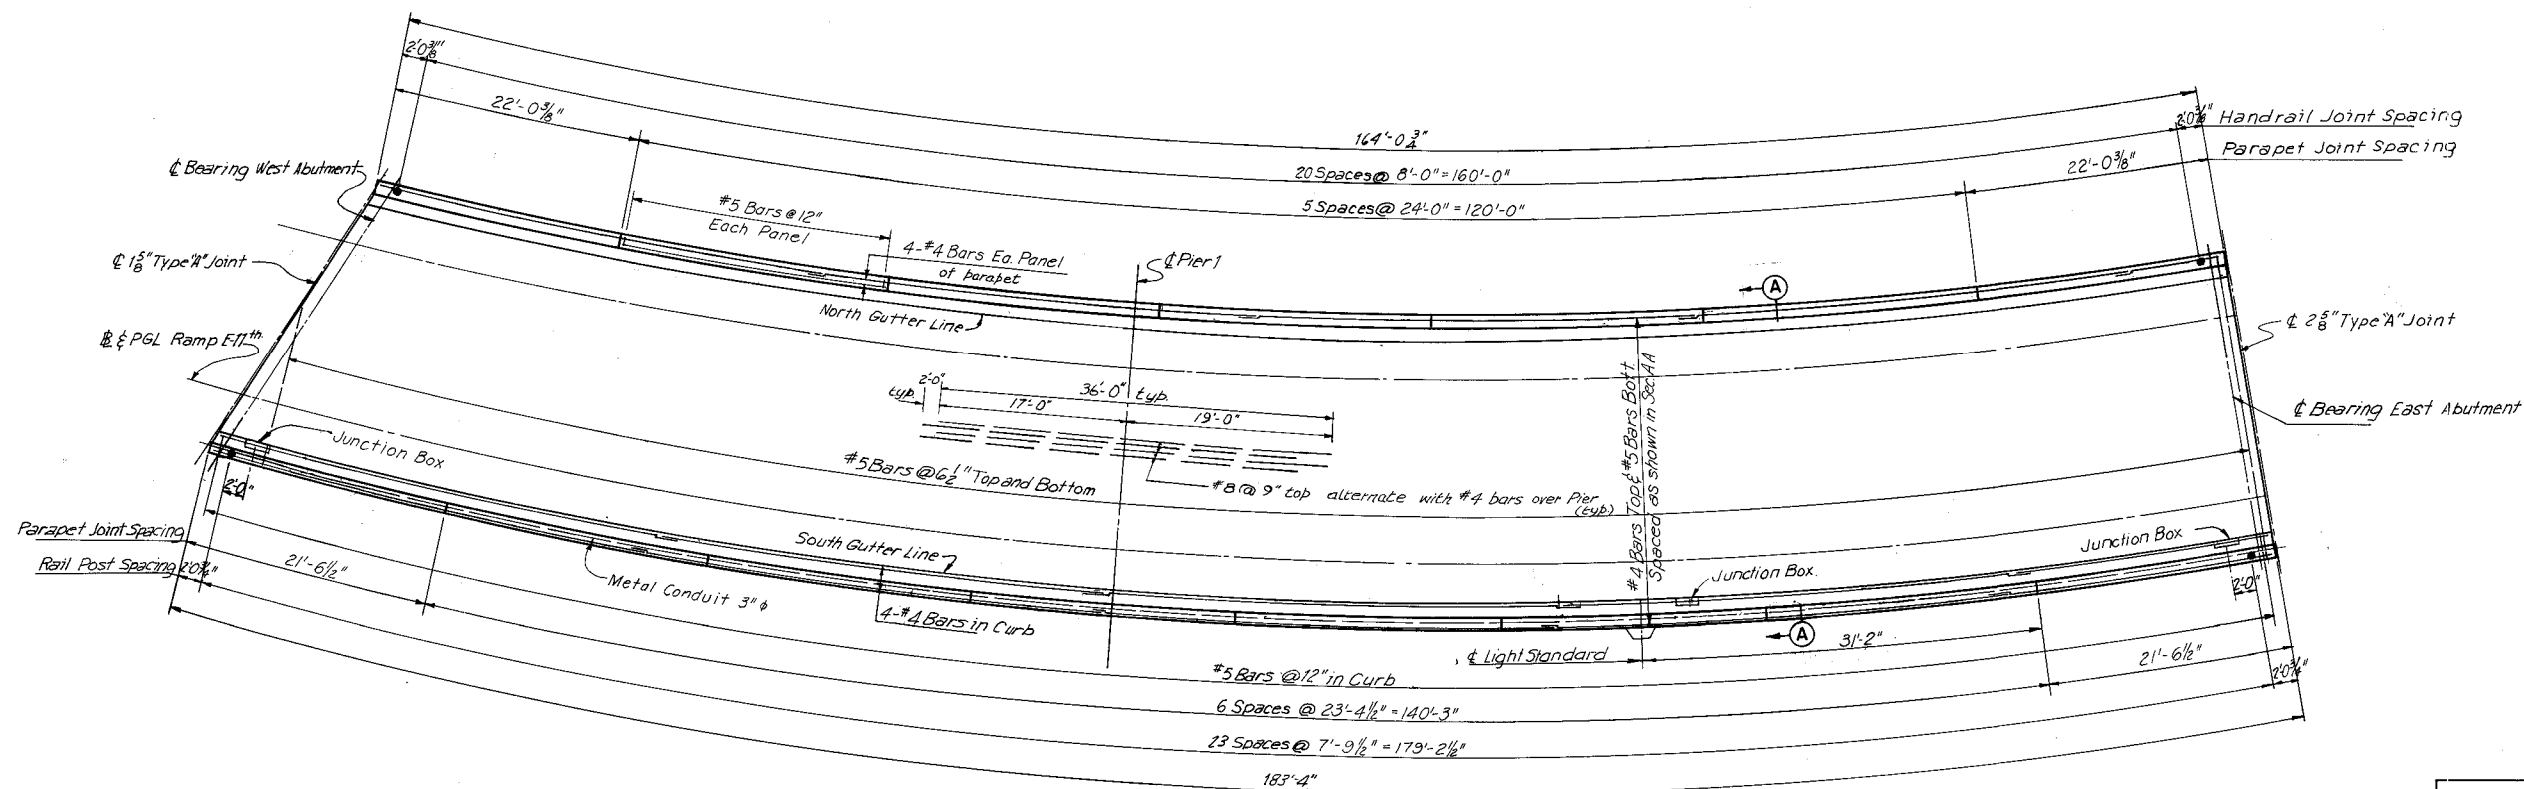


DECK PLAN  
Scale  $\frac{1}{8}'' = 1'-0''$

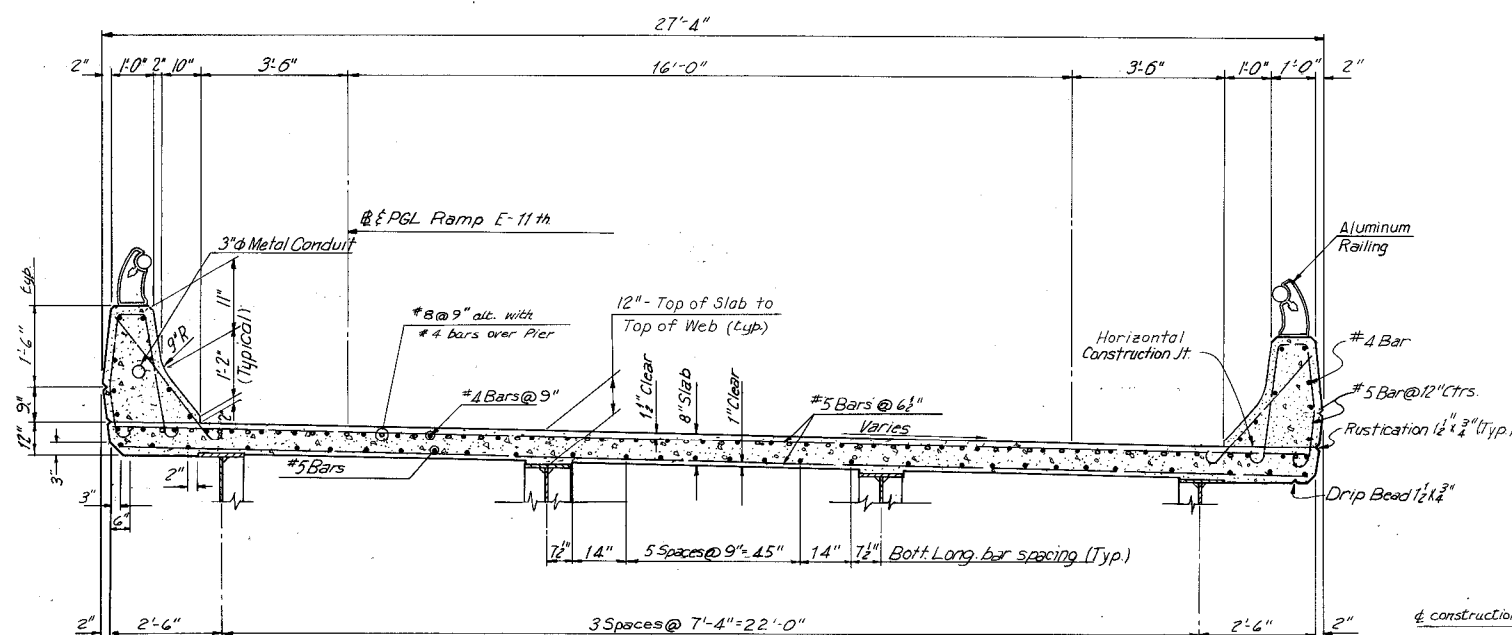

SECTION A-A  
Scale  $\frac{1}{8}'' = 1'-0''$

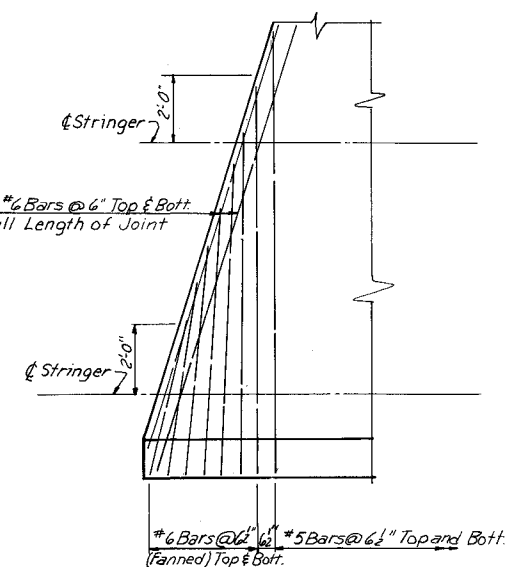


ACUTE CORNER REINFORCING FOR DECK SLAB  
Scale  $\frac{1}{8}'' = 1'-0''$

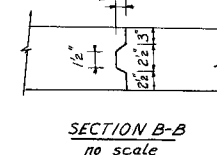

SECTION B-B  
no scale

TABLE OF ELEVATIONS			
LOCATION	N. GUTTER	BASE LINE	S. GUTTER
CL. J.T.W. ABUT	82.58	82.90	82.96
1/4 POINT	82.76	83.10	83.16
1/2 POINT	82.92	83.29	83.35
3/4 POINT	83.00	83.39	83.46
CL. PIER 1	82.99	83.38	83.45
1/4 POINT	82.83	83.22	83.29
1/2 POINT	82.48	82.87	82.94
3/4 POINT	81.95	82.34	82.41
CL. J.T.E. ABUT	81.23	81.63	81.70

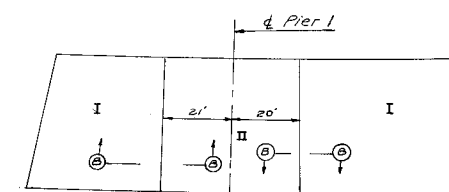

OPTIONAL DECK POURING SEQUENCE  
no scale  
I indicates first pour  
II indicates second pour  
Note:  
Deck poured in one pour.


MADE	BY	DATE	NO.	REVISION	BY	DATE
12-20-67	RP	2	As Built	TEM	7-77	
12-22-67	JLJ	1	Revised Light Sld. Locations	TEM	9-74	
	PRY					

RICHMOND METROPOLITAN AUTHORITY	
RICHMOND EXPRESSWAY SYSTEM	
DOWNTOWN EXPRESSWAY	
BRIDGE NO. 62	
RAMP E-11TH OVER RAMP 12TH-W	
OVER 12TH ST.	
SLAB	
HOWARD, NEEDLES, TAMMEN & BERGENDOFF consulting engineers NEW YORK ALEXANDRIA KANSAS CITY	SCALE: As Noted CONTRACT NO.: 9 SHEET NO. 7 OF 11


AS BUILT




RICHMOND EXPRESSWAY SYSTEM			
SECTION	PROJECT	SHEET NO.	TOTAL SHEETS
9	DOWNTOWN EXPRESSWAY	238	

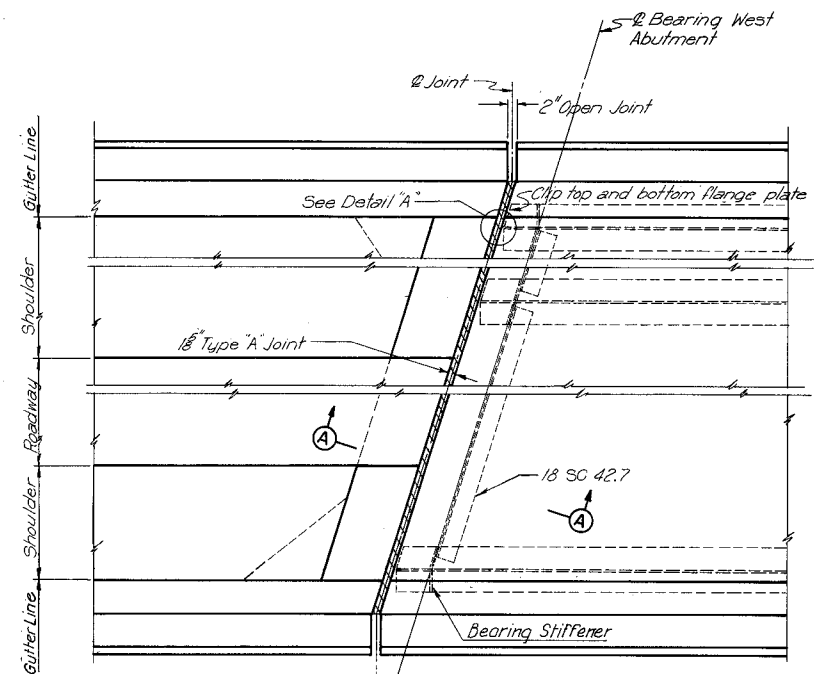


PLAN-JOINT AT WEST ABUTMENT  
No Scale

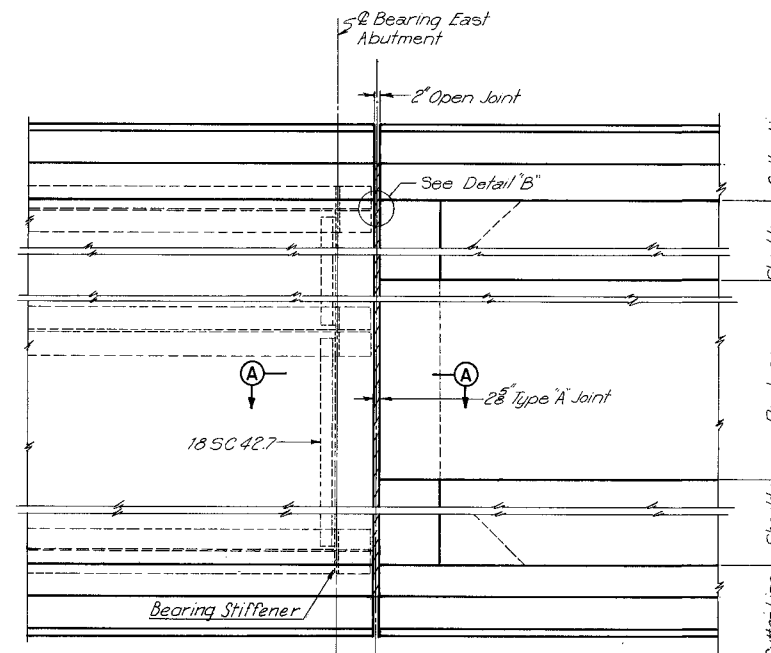

PLAN-JOINT AT EAST ABUTMENT  
No Scale

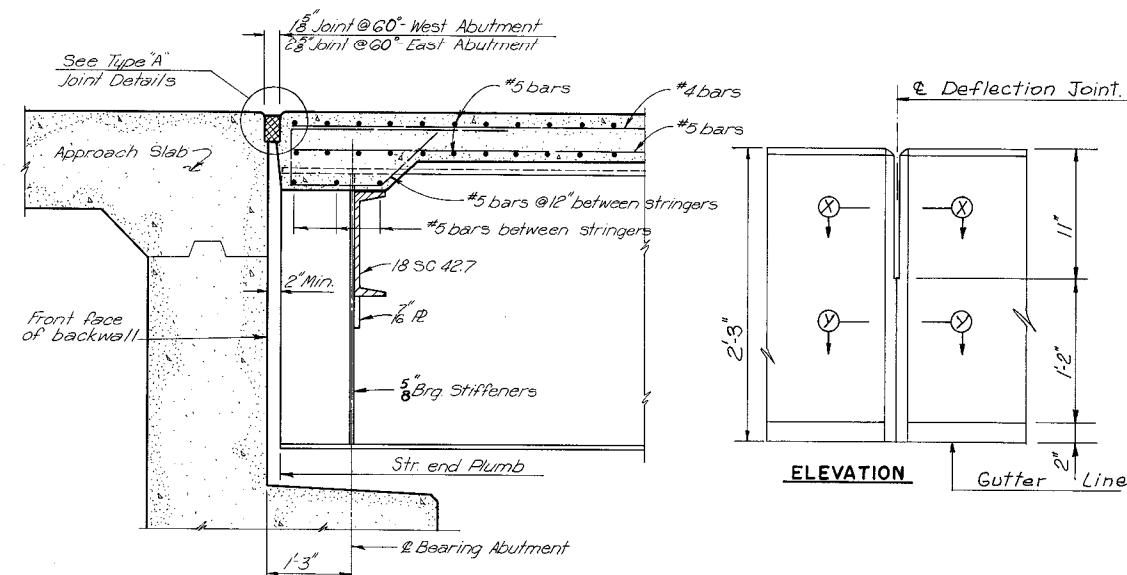


SECTION A-A  
Scale: 3/4\"/>

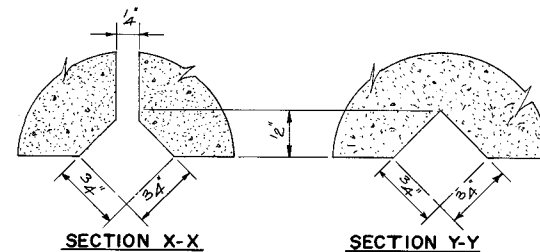


Note: Groove details are for both sides of parapet.

PARAPET DEFLECTION JOINT DETAILS

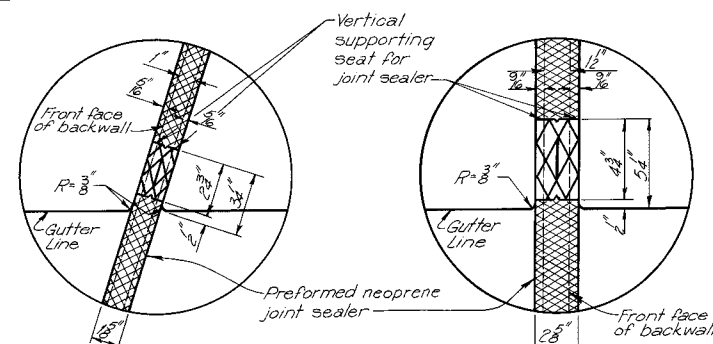


DETAIL "A"  
No Scale

DETAIL "B"  
No Scale

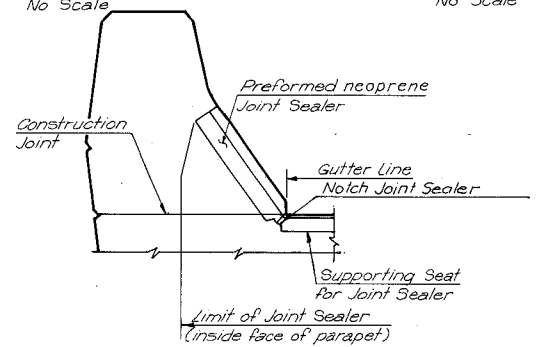

TREATMENT OF TYPE "A" JOINT AT GUTTER LINE  
No Scale

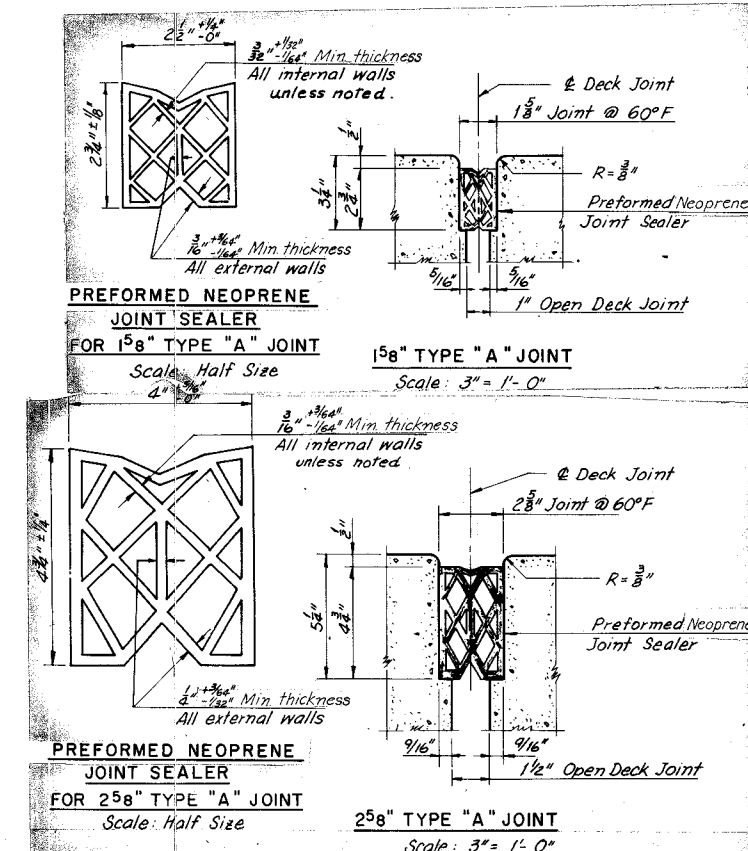

**NOTE TO CONTRACTOR:**  
It is absolutely essential that the openings for the preformed neoprene joint sealers be accurately formed and constructed to smooth, straight lines. The size of the opening shall be adjusted to allow for anticipated dead load rotation of the ends of the slab and for the temperature at the time of construction.


BY	DATE	NO.	REVISION	BY	DATE
MADE	LDL	1-68	2	As Built	TEM 7-77
CHECKED	JLJ	1-68	1	PARAPET JOINT ADDED.	T.E.M. 7-74
IN CHARGE	PRX				

RICHMOND METROPOLITAN AUTHORITY	
RICHMOND EXPRESSWAY SYSTEM	
DOWNTOWN EXPRESSWAY	
BRIDGE NO. 62	
RAMP E-11TH OVER RAMP I2TH-W	
OVER I2TH ST.	
JOINT DETAILS	
HOWARD, NEEDLES, TAMMEN & BERGENDOFF consulting engineers NEW YORK ALEXANDRIA KANSAS CITY	SCALE: As Shown CONTRACT NO.: 9 SHEET NO. B OF 11


AS BUILT





RICHMOND EXPRESSWAY SYSTEM			
SECTION	PROJECT	SHEET NO.	TOTAL SHEETS
9	DOWNTOWN EXPRESSWAY	239	

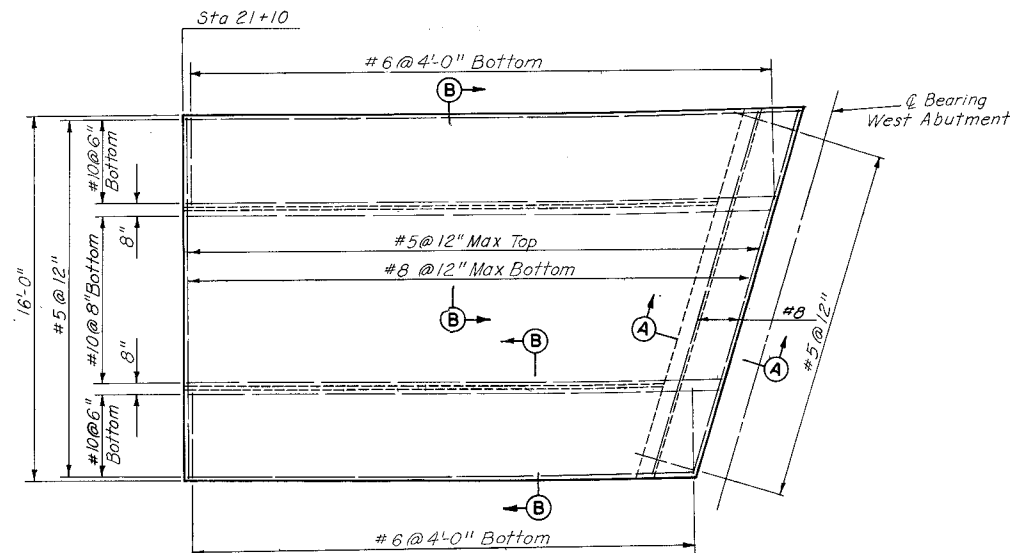


WEST APPROACH SLAB  
Scale 1/4"=1'-0"

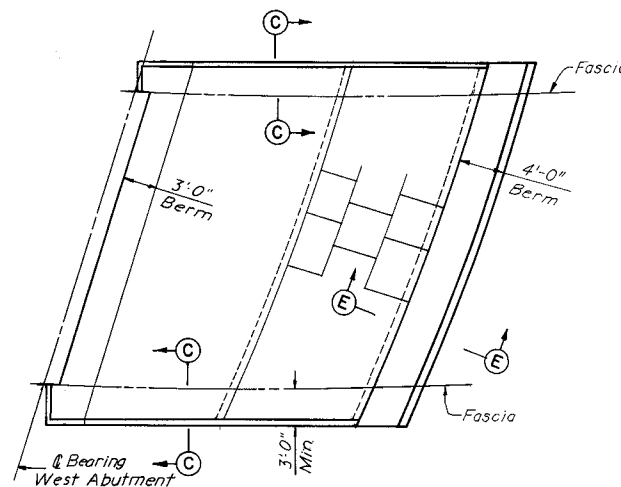


PLAN OF SLOPE PROTECTION  
Scale 1/8"=1'-0"

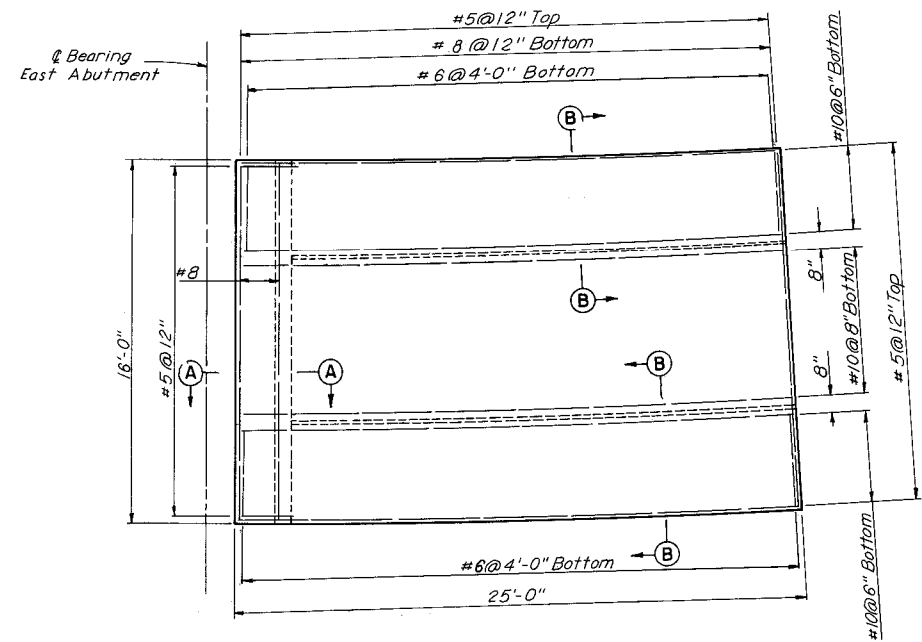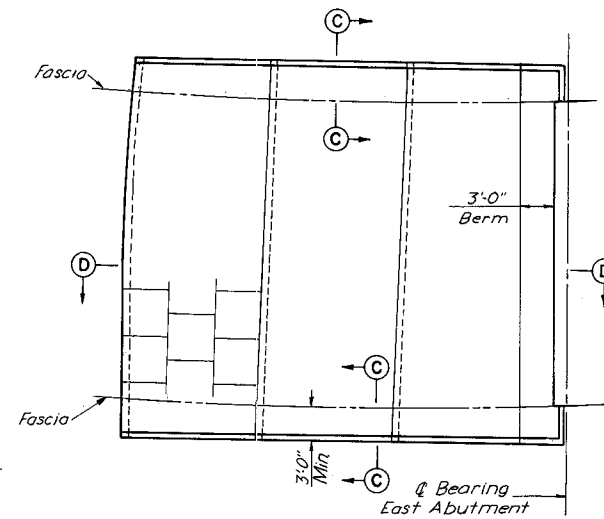


EAST APPROACH SLAB  
Scale 1/4"=1'-0"

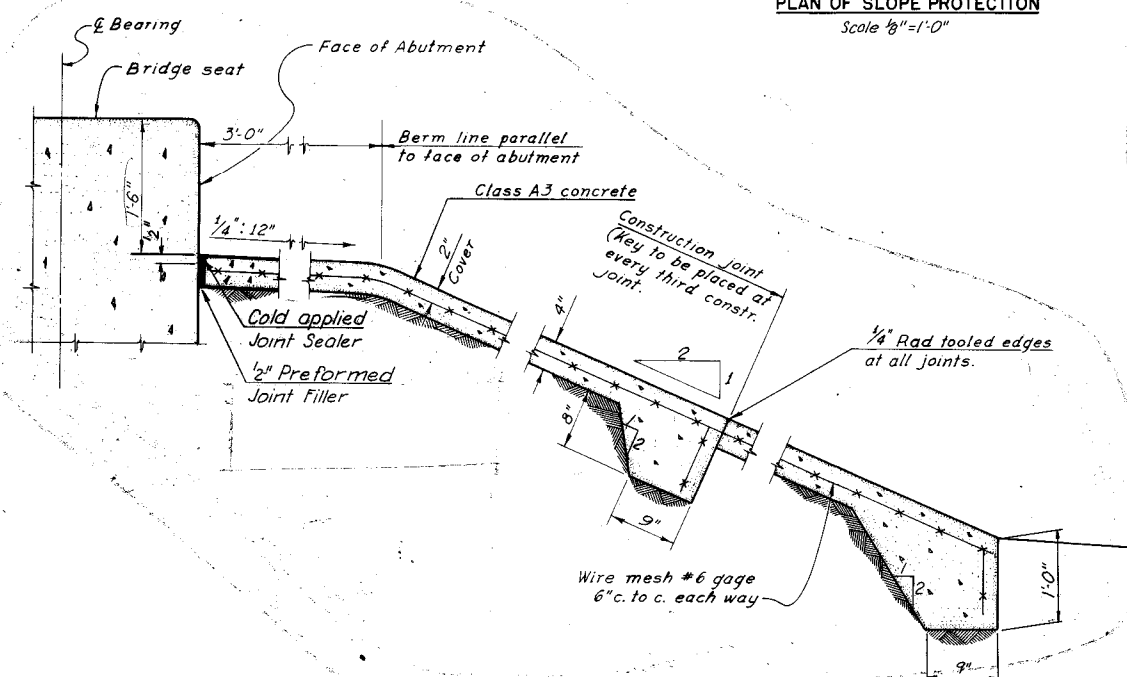


SECTION D-D  
Scale 1/4"=1'-0"

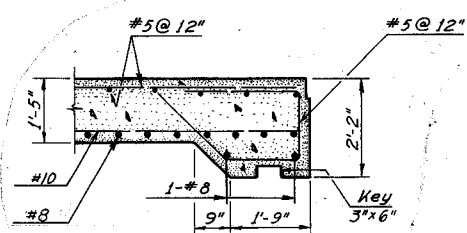


SECTION A-A  
Scale 1/2"=1'-0"

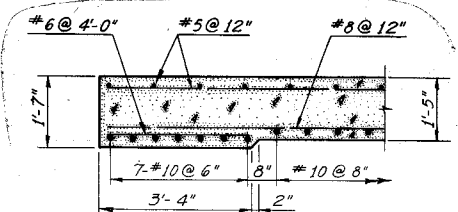

SECTION B-B  
Scale 1/2"=1'-0"

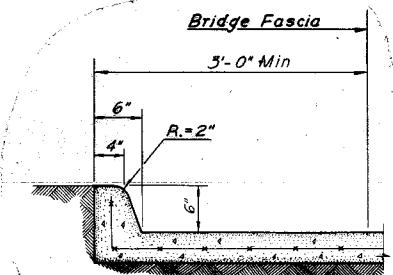

SECTION C-C  
Scale 1"=1'-0"

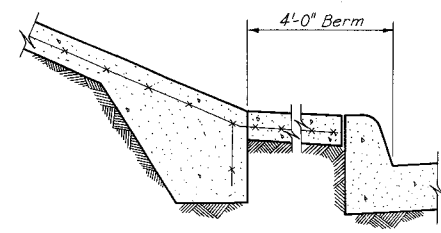

SECTION E-E  
Scale 1"=1'-0"

See Section D-D for details not shown

**SLOPE PROTECTION NOTE**  
The item "Cast-in-place Concrete Slab Slope Protection" shall include the excavation of, or the placing and compaction of any embankment material necessary to bring the surface of the paved slopes to the finished elevations shown on the plans.  
"Cast-in Place Concrete Slab Slope Protection" shall be paid for at the contract unit price per square yard, which price shall include the concrete slab including wire mesh and joint filler. The slab shall be constructed in 4'-0" x 4'-0" panels, placed in horizontal courses, alternate panels being poured in a staggered pattern with adjacent panels poured later. The slab shall be Class A3 Concrete of such consistency that it can be placed without the use of top forms, the surface shall be finished with a wood float.  
Reinforcing shall consist of wire mesh No. 6 gage, 6" C.C. each way, placed at the center of the slab, and continuous through construction joints.

AS BUILT

RICHMOND METROPOLITAN AUTHORITY RICHMOND EXPRESSWAY SYSTEM DOWNTOWN EXPRESSWAY BRIDGE NO. 62 RAMP E-11TH OVER RAMP 12TH-W OVER 12TH ST. APPROACH SLAB AND SLOPE PROTECTION DETAILS			
HOWARD, NEEDLES, TAMMEN & BERGENDOFF consulting engineers NEW YORK ALEXANDRIA KANSAS CITY	SCALE: As Noted CONTRACT NO.: 9 SHEET NO. 9 OF 11		

MADE	BY	DATE	NO.	REVISION	BY	DATE
ADR	JLJ	1-68	1	As Built	TEM	7-77
IN CHARGE	PRY					







# **Bridge 62 Widening**

**(Westbound Downtown Expressway {Rte. 195} 11<sup>th</sup> Street Off-Ramp  
Over South 12<sup>th</sup> Street)**

**Record Set Plans**



RICHMOND EXPRESSWAY SYSTEM			
SECTION	PROJECT	SHEET NO.	TOTAL SHEETS
C-15	1990-1991 IMPROVEMENTS	6(11)	

GENERAL NOTES:

- WIDTH: WIDENING OF 7'-0" TO THE SOUTH OF THE EXISTING STRUCTURE.
- SPAN LAYOUT: 100.5'-77" CONTINUOUS STEEL PLATE GIRDER SPANS.
- CAPACITY: HS20-44 LOADING AND ALTERNATE MILITARY LOADING. DESIGN LOADING INCLUDES 15 PSF FOR FUTURE WEARING SURFACE AND 20 PSF ALLOWANCE FOR CONSTRUCTION TOLERANCES AND CONSTRUCTION METHODS.
- SPECIFICATIONS:
- CONSTRUCTION VIRGINIA DEPARTMENT OF TRANSPORTATION ROAD AND BRIDGE SPECIFICATIONS, 1987.
- DESIGN AASHTO STANDARD SPECIFICATIONS FOR HIGHWAY BRIDGES, 1989, INCLUDING INTERIM SPECIFICATIONS, 1990 AND VDOT MODIFICATIONS.
- STANDARDS: VIRGINIA DEPARTMENT OF TRANSPORTATION ROAD AND BRIDGE STANDARDS, 1989.

ALL DIMENSIONS ARE MEASURED HORIZONTALLY AND VERTICALLY UNLESS OTHERWISE SPECIFIED.

THESE PLANS ARE INCOMPLETE UNLESS ACCOMPANIED BY THE SUPPLEMENTAL SPECIFICATIONS AND SPECIAL PROVISIONS INCLUDED IN THE CONTRACT DOCUMENTS.

THE USE OF STAY-IN-PLACE FORMS WILL NOT BE PERMITTED.

ALL STRUCTURAL STEEL SHALL BE ASTM A36, EXCEPT AS NOTED.

CONCRETE IN SUPERSTRUCTURE SHALL BE CLASS A4. ALL OTHER CONCRETE SHALL BE CLASS A3.

DEFORMED REINFORCING BARS SHALL CONFORM TO ASTM A615, GRADE 60. ALL REINFORCING BAR DIMENSIONS ON THE DETAILED DRAWINGS ARE TO CENTERS OF BARS EXCEPT WHERE OTHERWISE NOTED AND ARE SUBJECT TO FABRICATION AND CONSTRUCTION TOLERANCES.

H-PILES HAVE A DESIGN CAPACITY OF 45 TONS PER PILE, AND SHALL BE DRIVEN TO REFUSAL.

PRIOR TO THE COMMENCEMENT OF ANY WORK THE CONTRACTOR SHALL FIELD VERIFY ALL DIMENSIONS AND ELEVATIONS OF THE EXISTING STRUCTURE AND REPORT TO THE ENGINEER ANY DISCREPANCIES BETWEEN FIELD MEASUREMENTS AND MEASUREMENT SHOWN ON THE CONTRACT PLANS.


THE CONTRACTOR SHALL COORDINATE CONSTRUCTION OF RETAINING WALL NO. 2 WITH THE BRIDGE B62 CONTRACTOR.

CURVE DATA RAMP E-11TH.





- Δ = 33° 29' 25.7"
- D = 13° 59' 59.9"
- T = 123.14'
- L = 239.22'
- R = 409.26'
- PC = 18+53.61
- PT = 20+92.83

LEGEND:

⊕ Exist. Borings

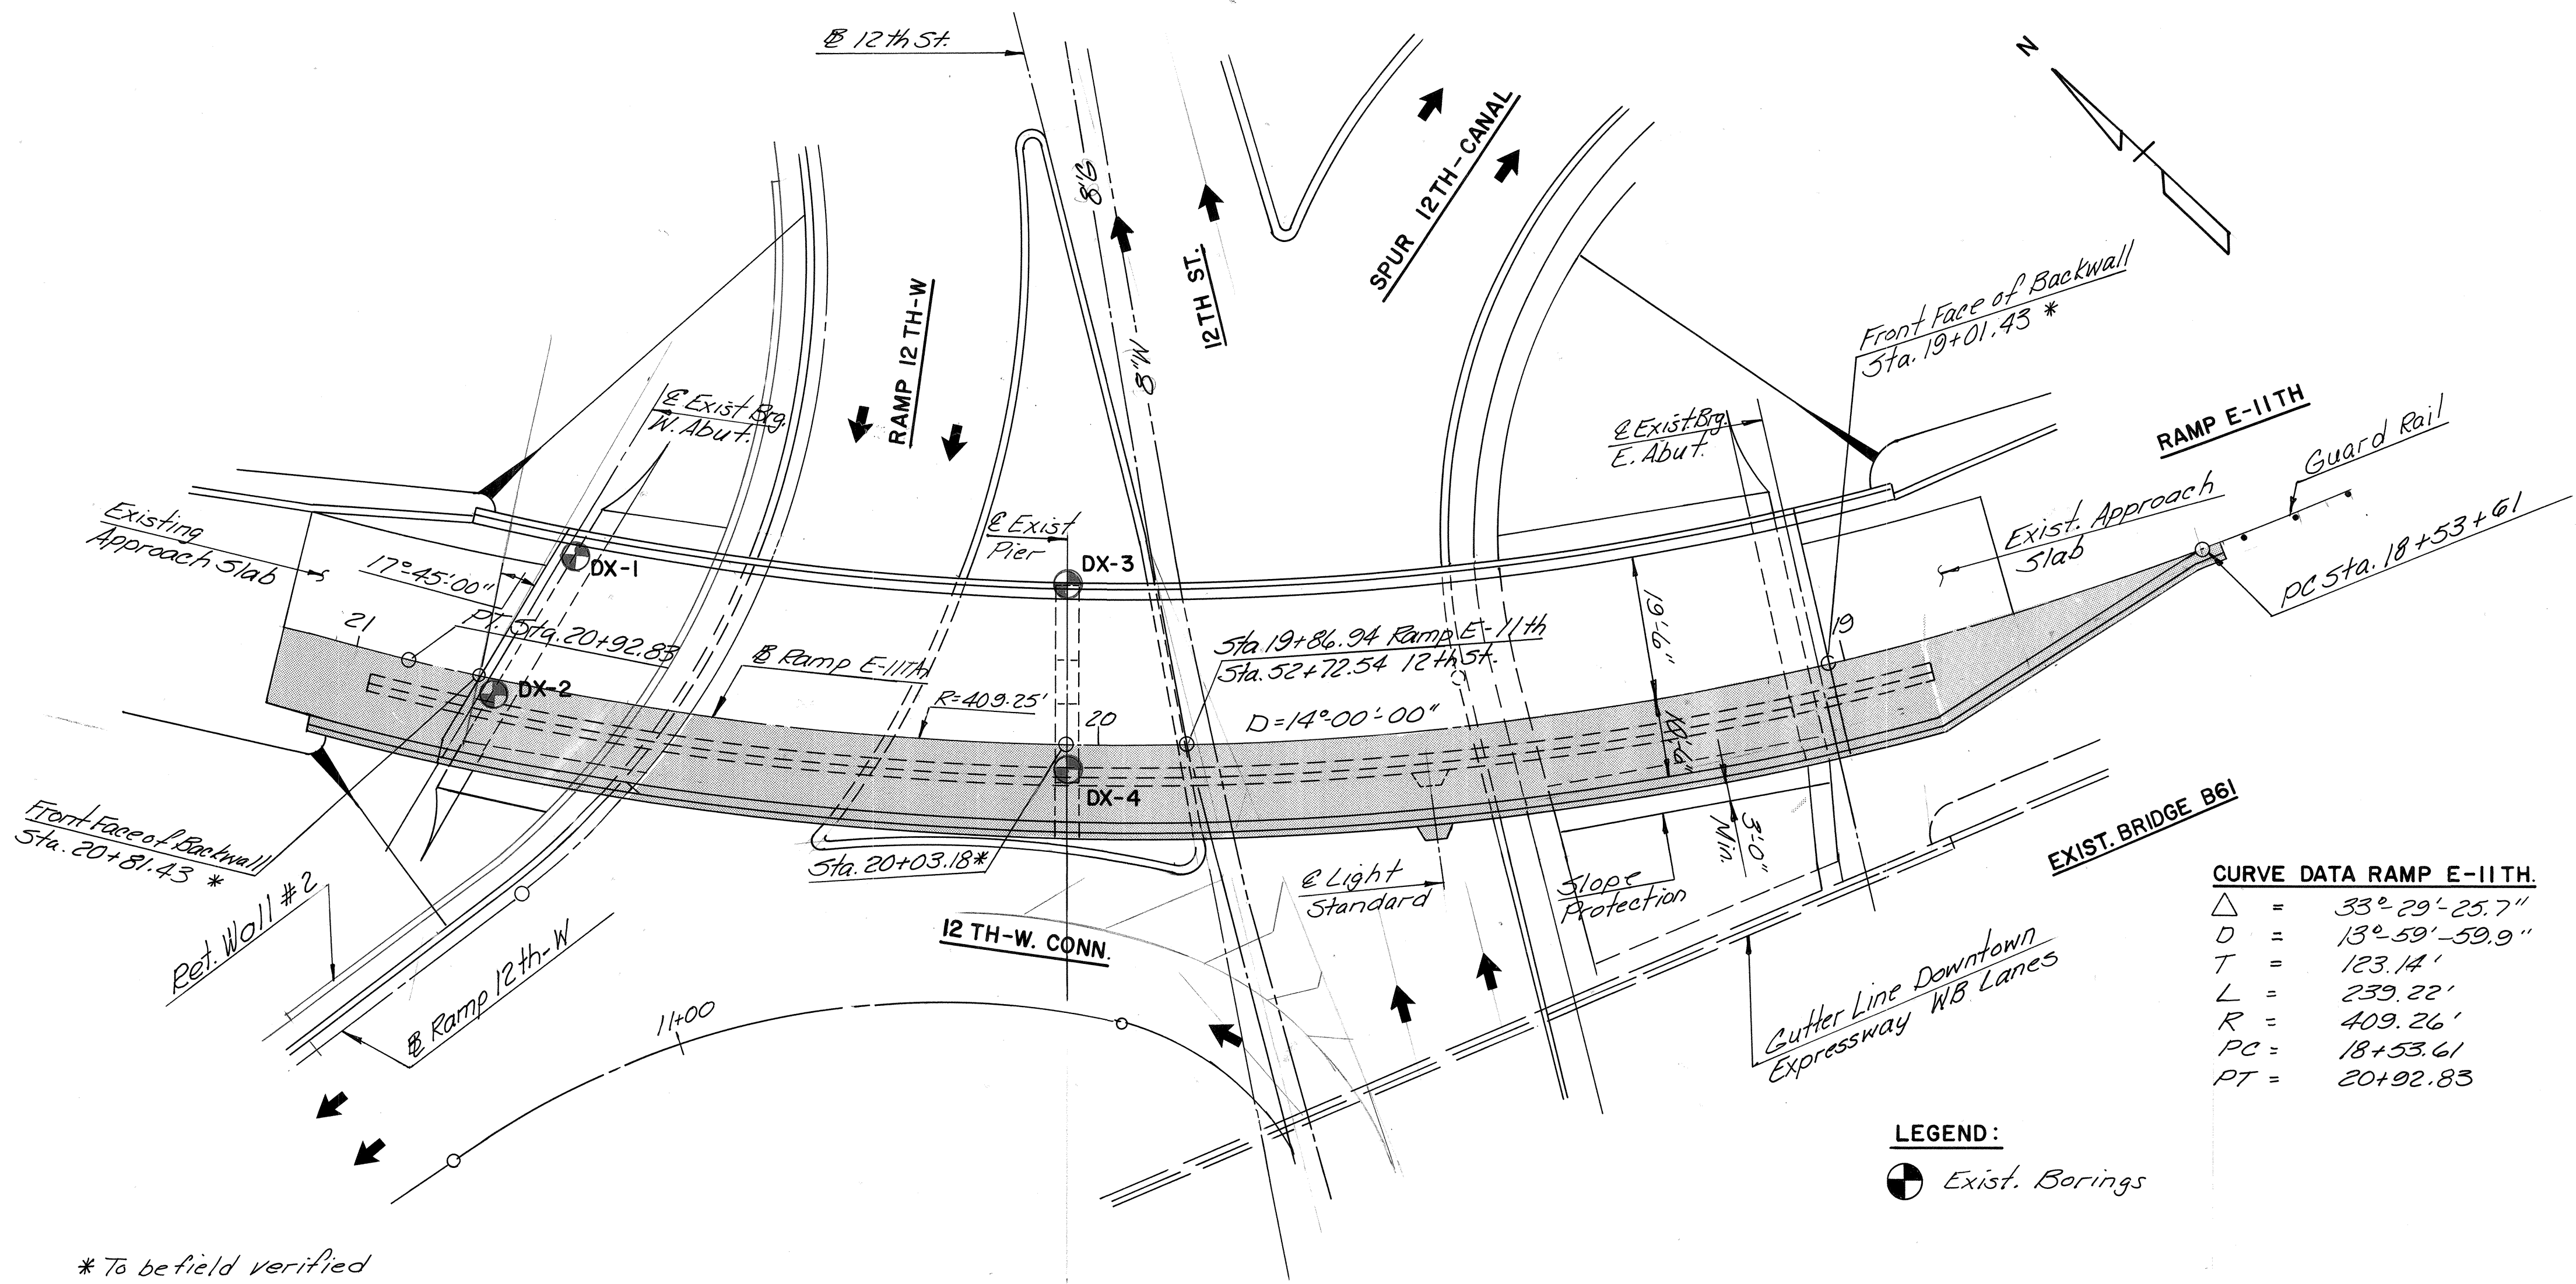

\* To be field verified

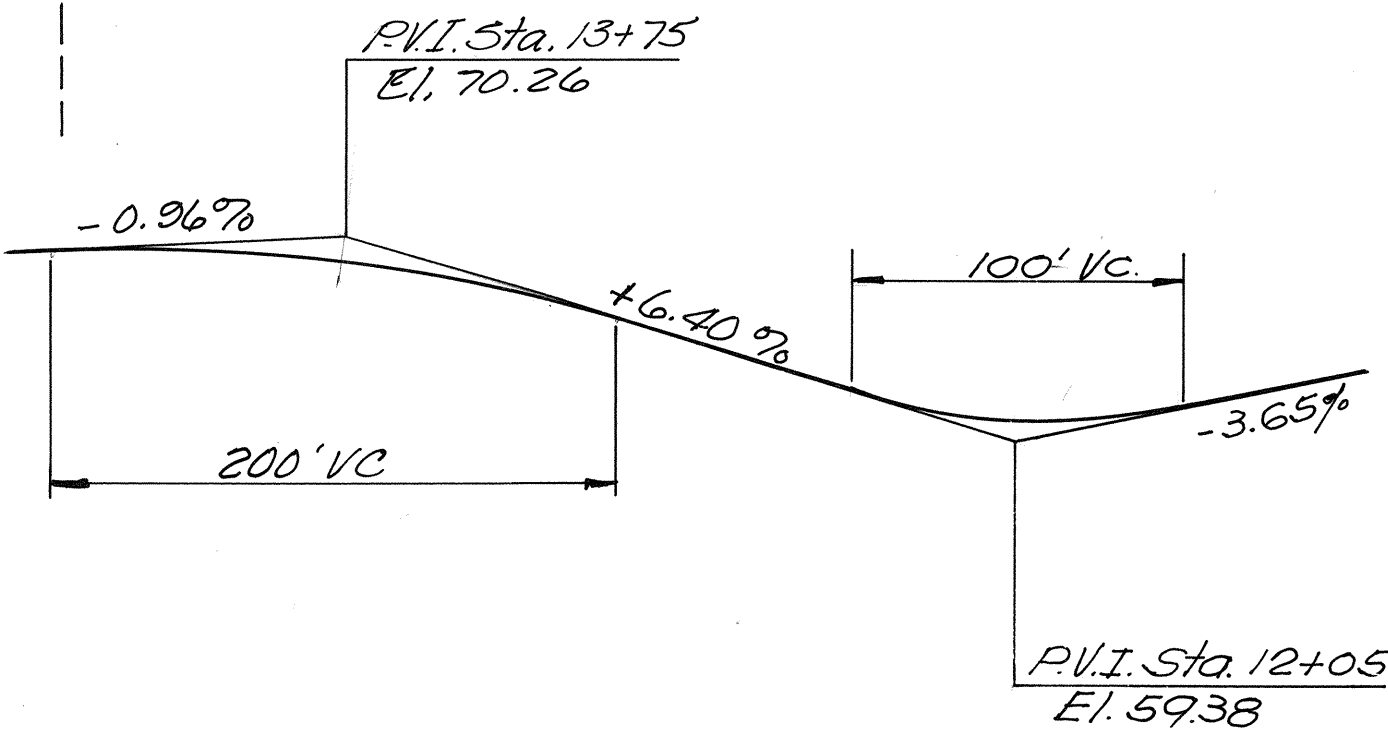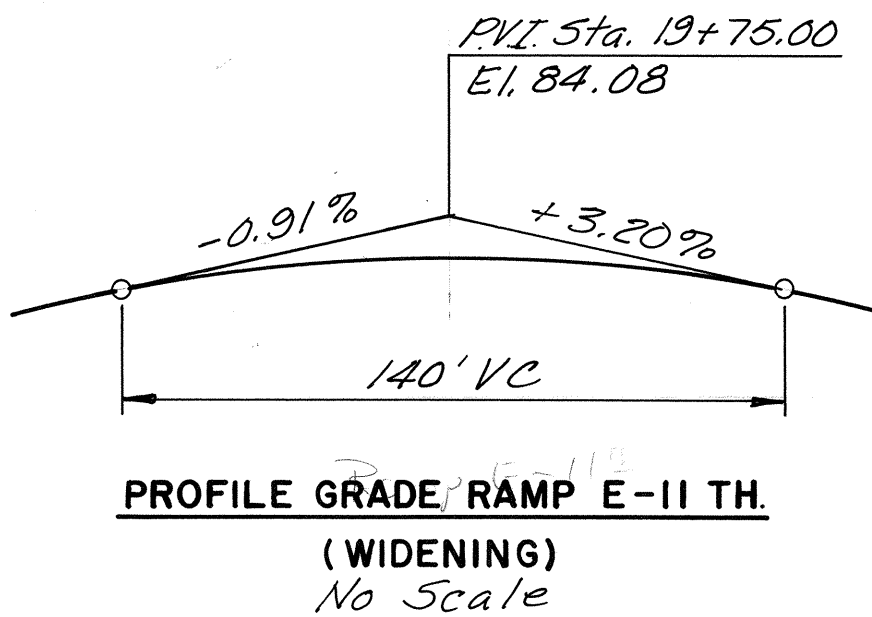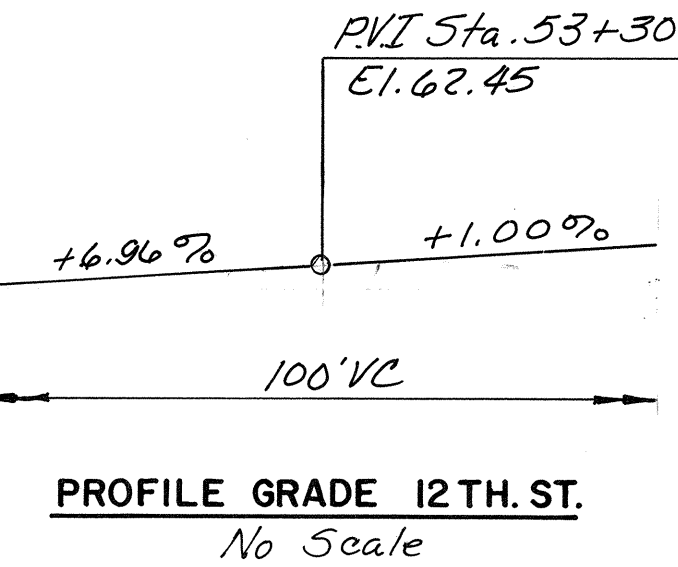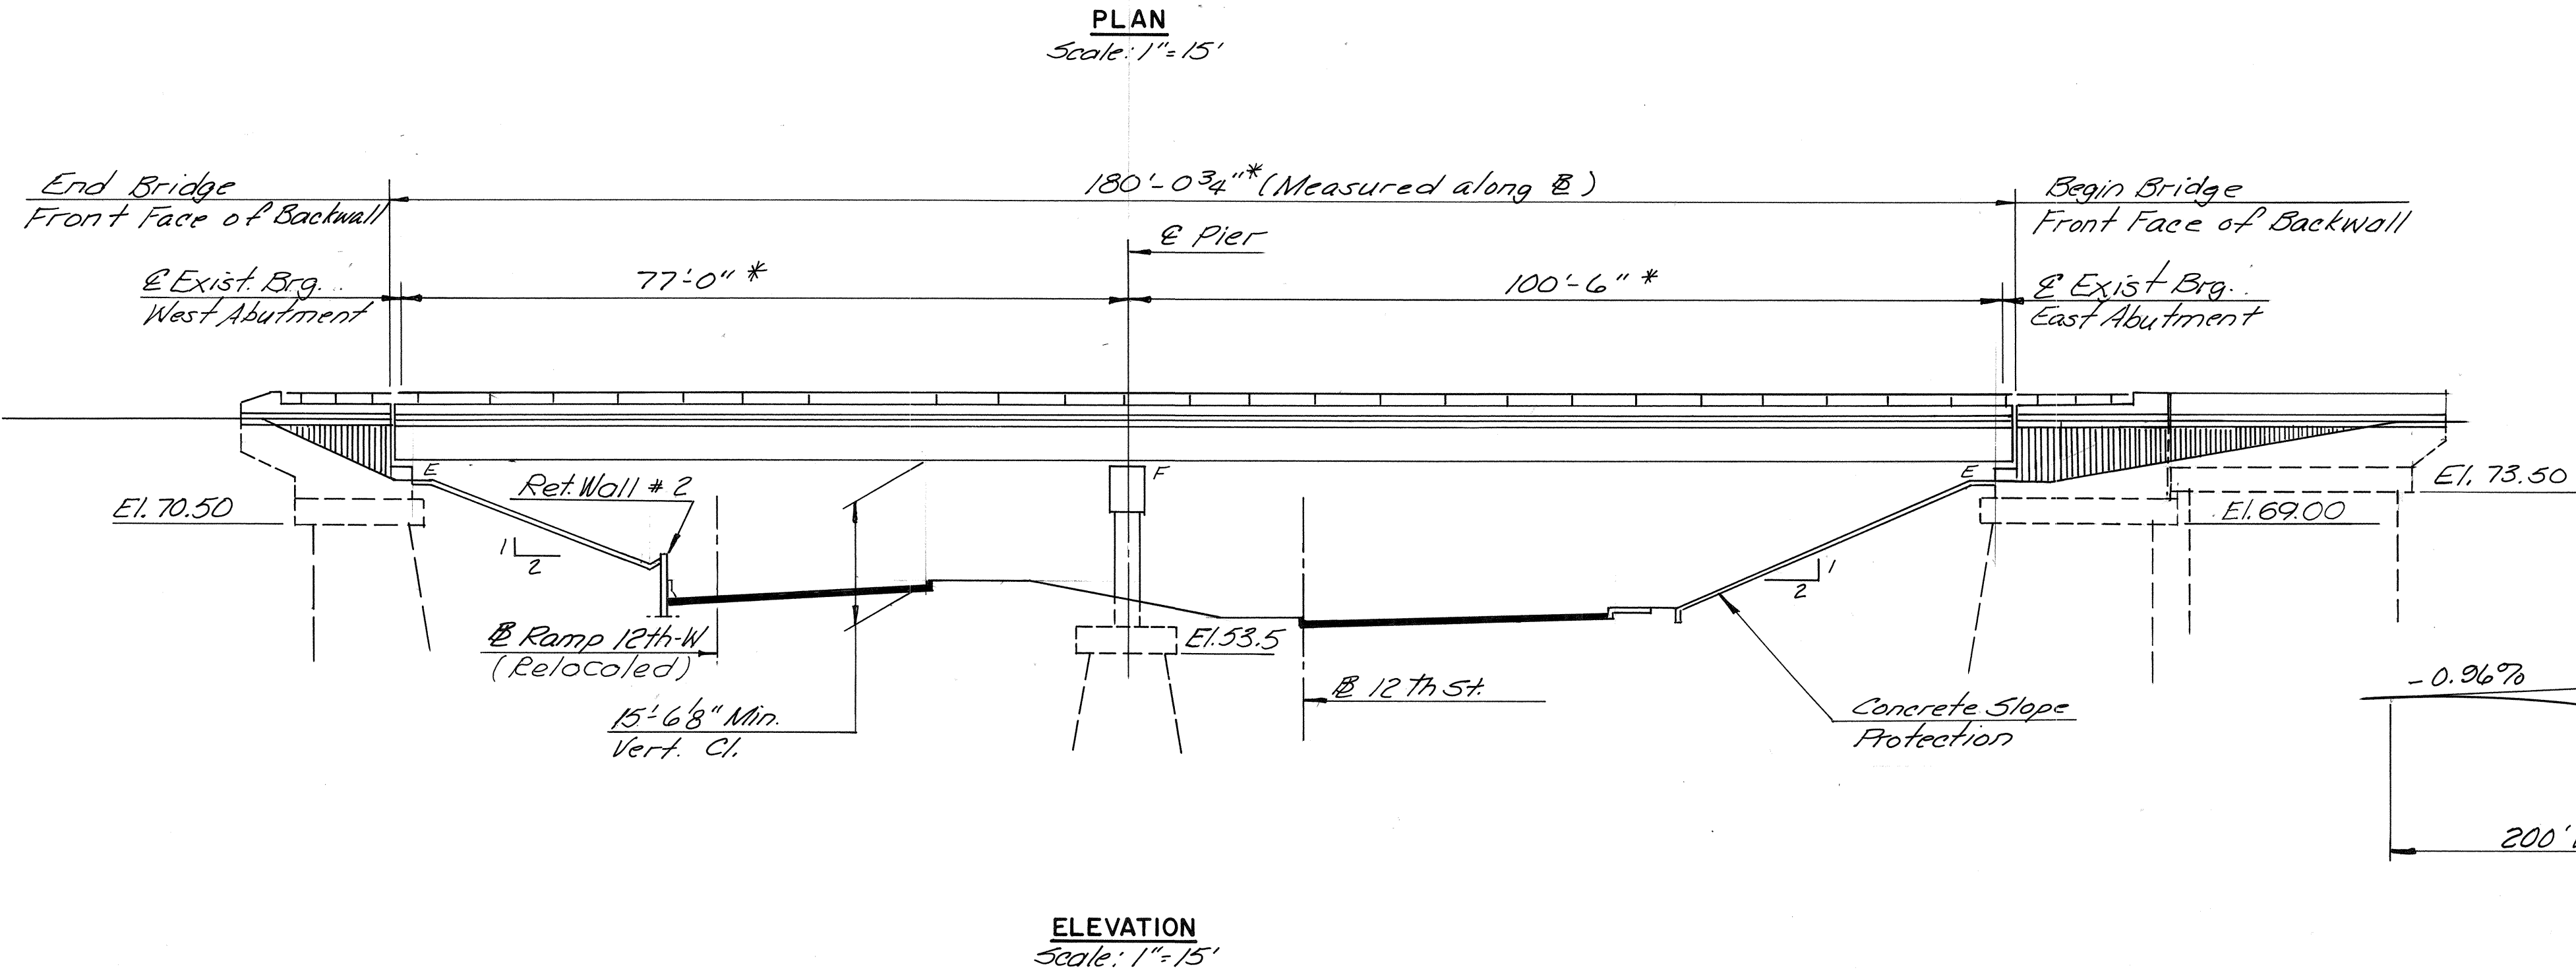

AS BUILT

MADE	BY	DATE	NO.	REVISION	BY	DATE
CHECKED	BS	12/90				
IN CHARGE	SR					

RICHMOND METROPOLITAN AUTHORITY  
RICHMOND EXPRESSWAY SYSTEM

BRIDGE NO. 62 WIDENING  
RAMP E-11TH OVER  
RAMP 12TH-W AND 12TH ST.  
PLAN AND ELEVATION

HOWARD, NEEDLES, TAMMEN & BERGENDOFF  
consulting engineers  
Alexandria, Virginia

SCALE: As Shown  
CONTRACT NO.: C-15  
SHEET NO. 1 OF 31













RICHMOND EXPRESSWAY SYSTEM			
SECTION	PROJECT	SHEET NO.	TOTAL SHEETS
C-15	1990-1991 IMPROVEMENTS	6(13)	

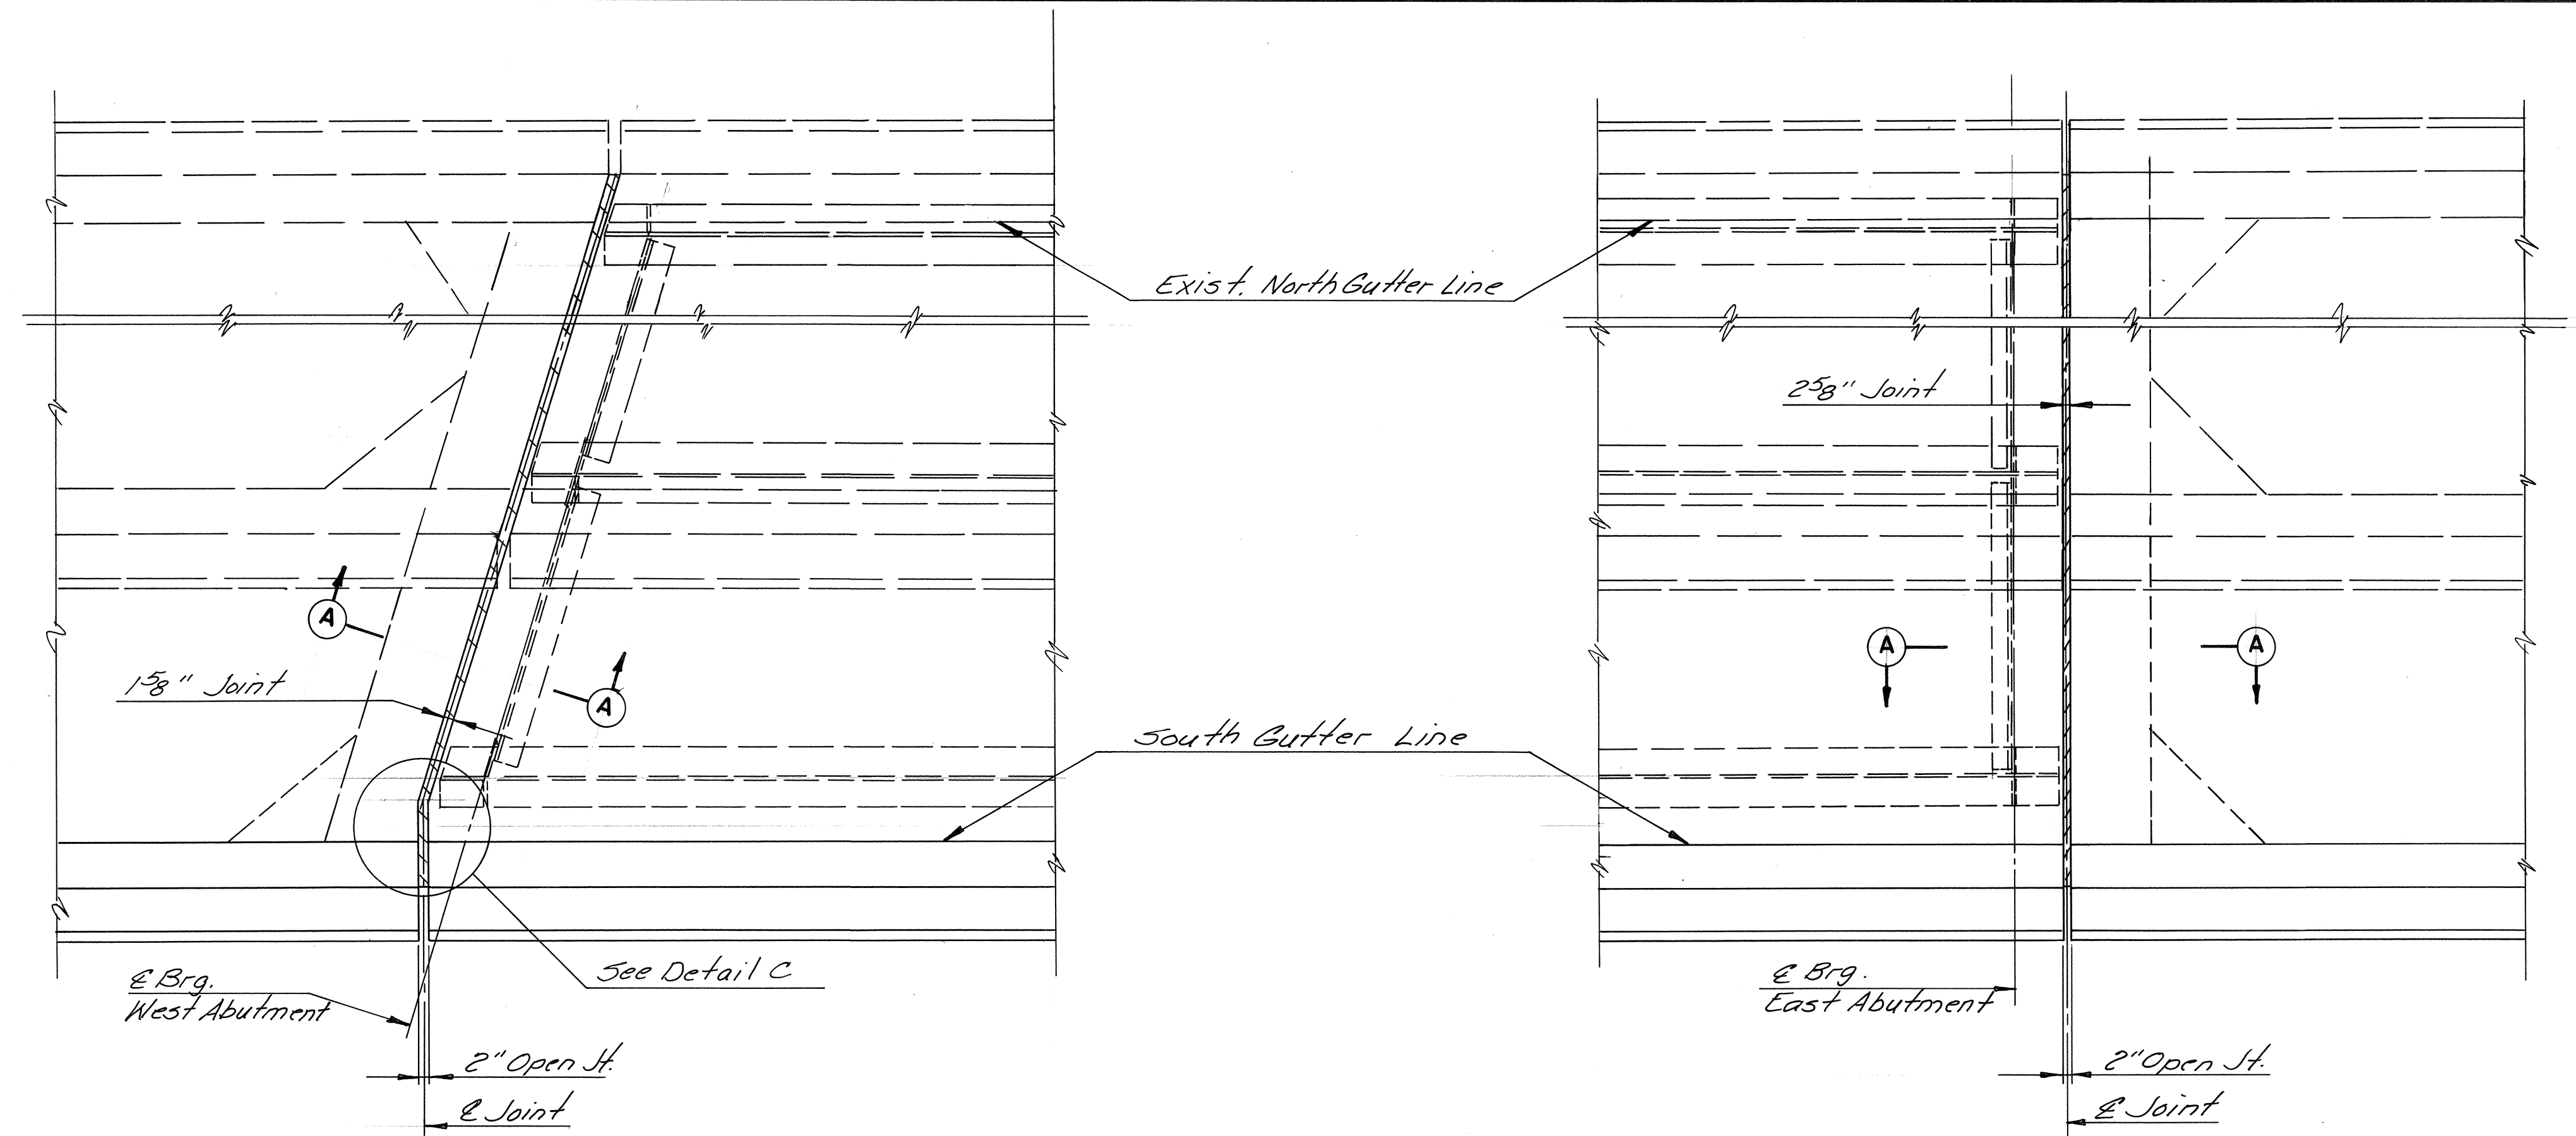


PLAN-JOINT AT WEST ABUTMENT  
No Scale

PLAN-JOINT AT EAST ABUTMENT  
No Scale

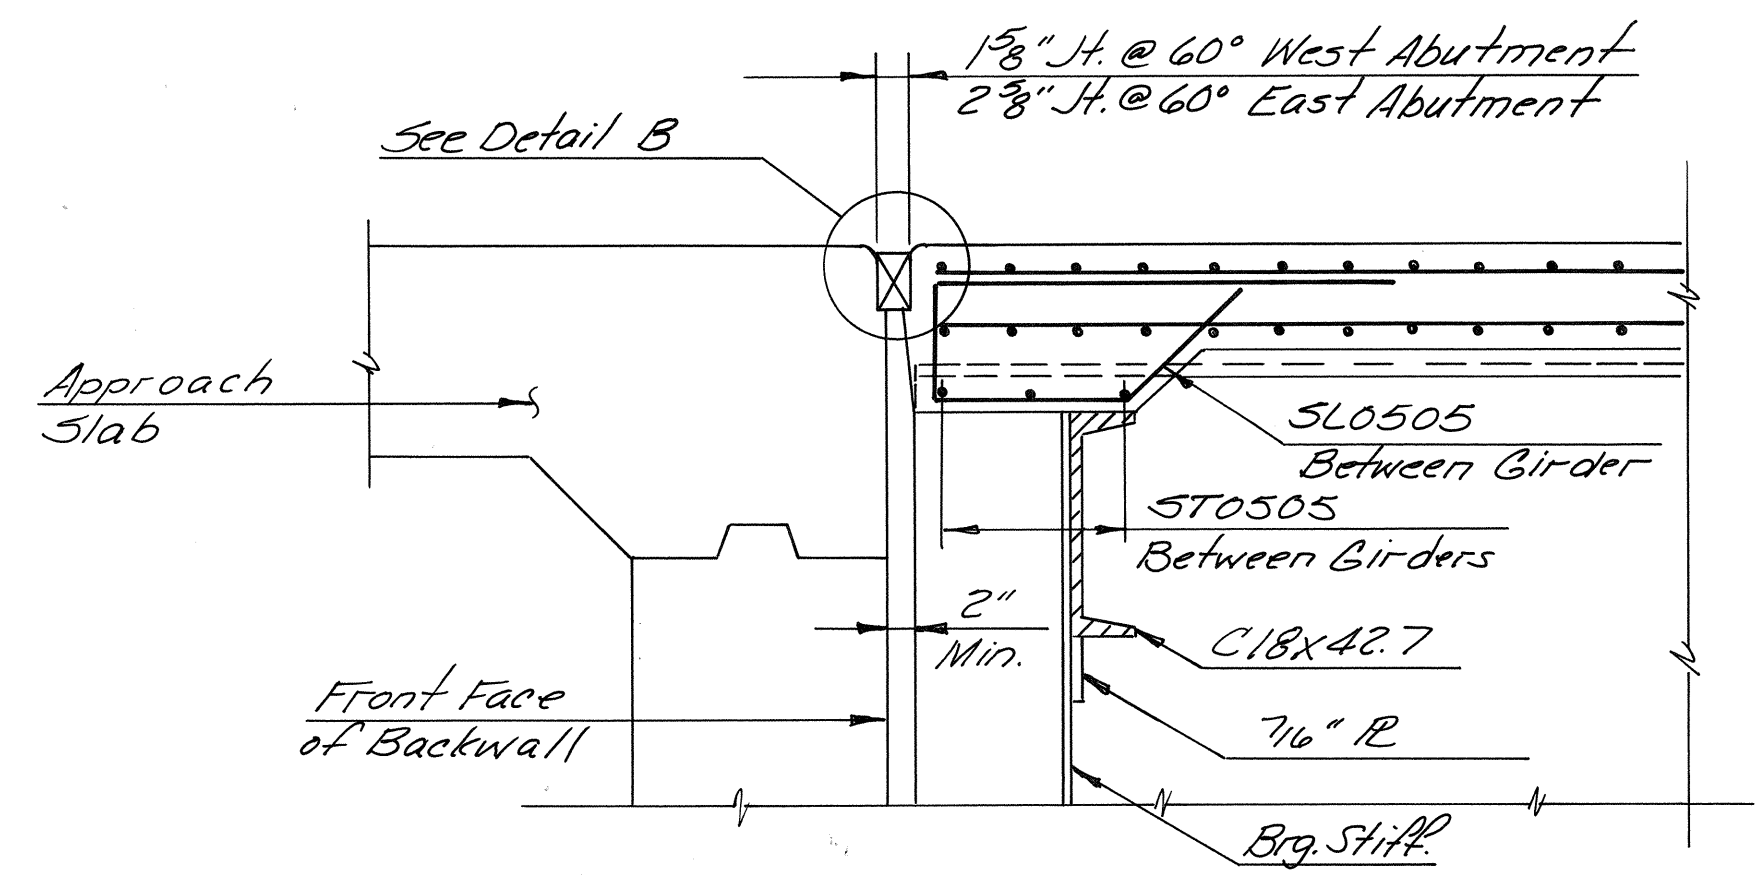


SECTION A-A  
Scale: 3/4"=1'-0"


**NOTE:**  
Existing preformed joint sealer at each Abutment to be completely removed. New continuous joint sealer shall be installed from gutter to gutter and up faces of parapet as shown. In damaged areas, joint edges on existing deck slab (R=3/8") shall be repaired.

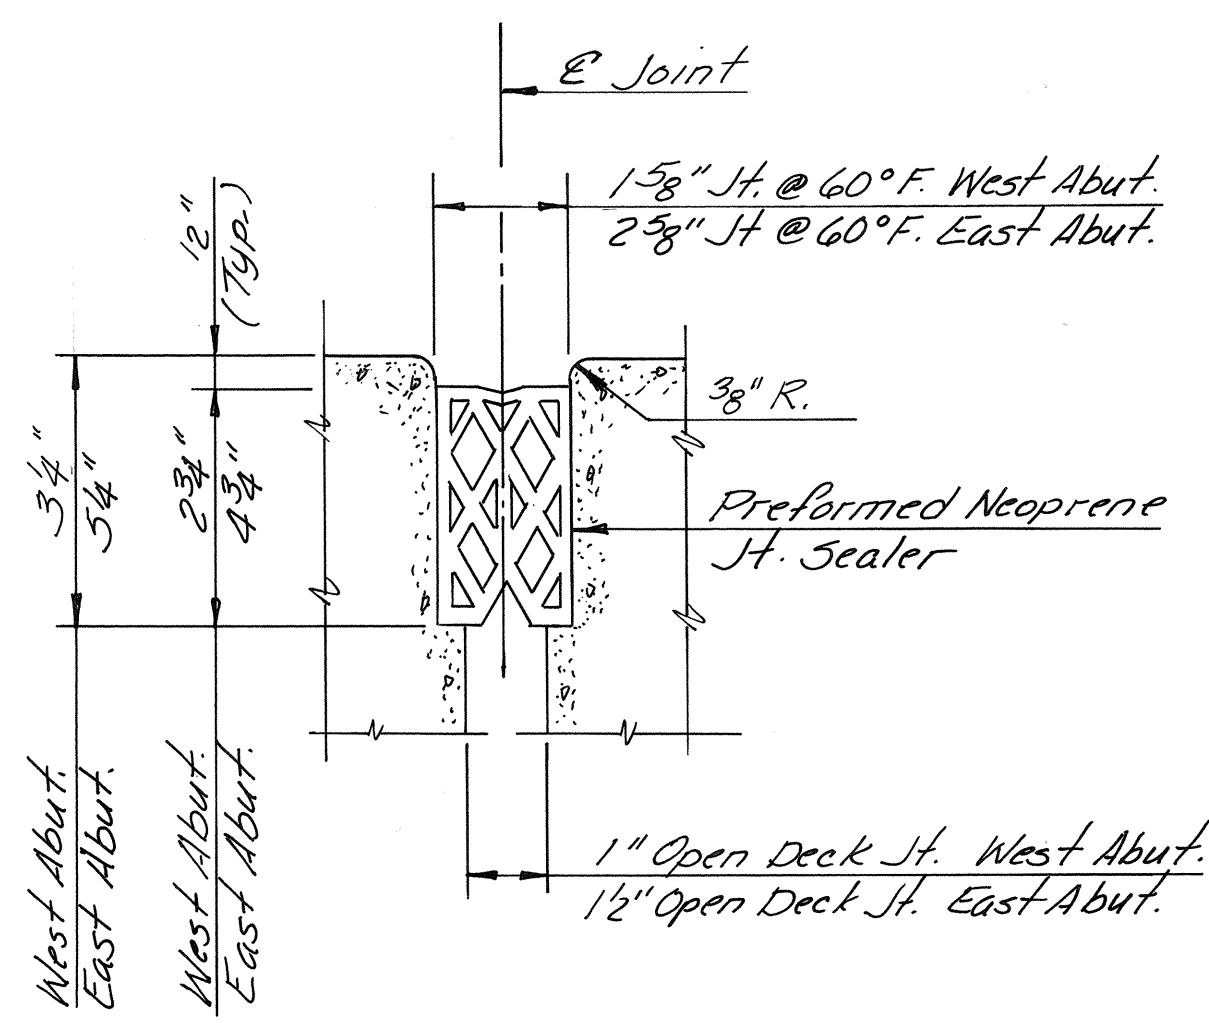


DETAIL B  
No Scale

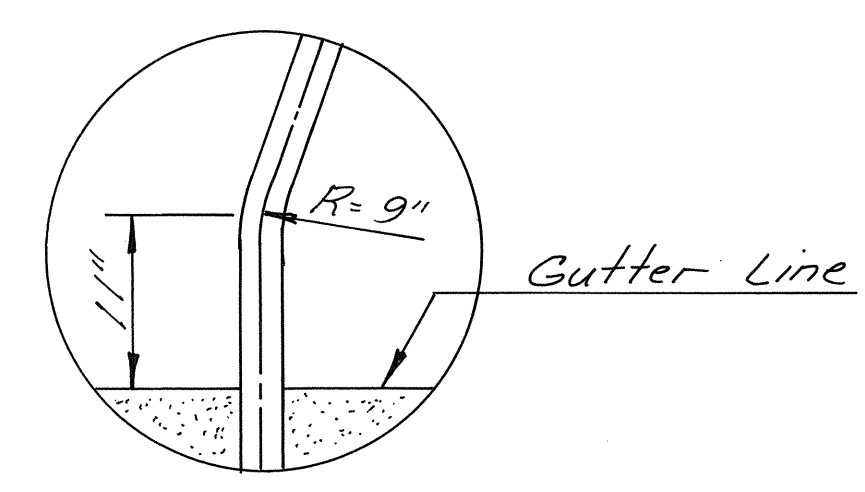

DETAIL C  
Scale: 1"=1'-0"

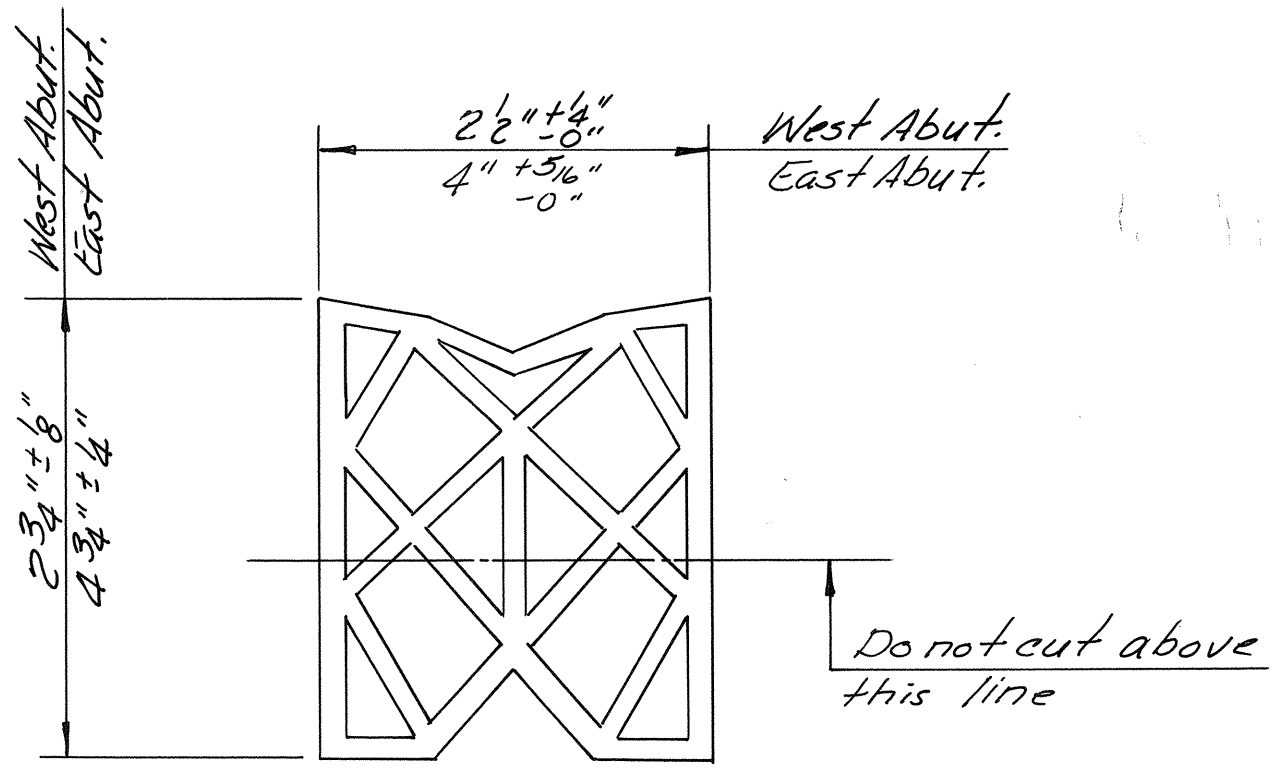

PREFORMED NEOPRENE JOINT SEALER  
No Scale

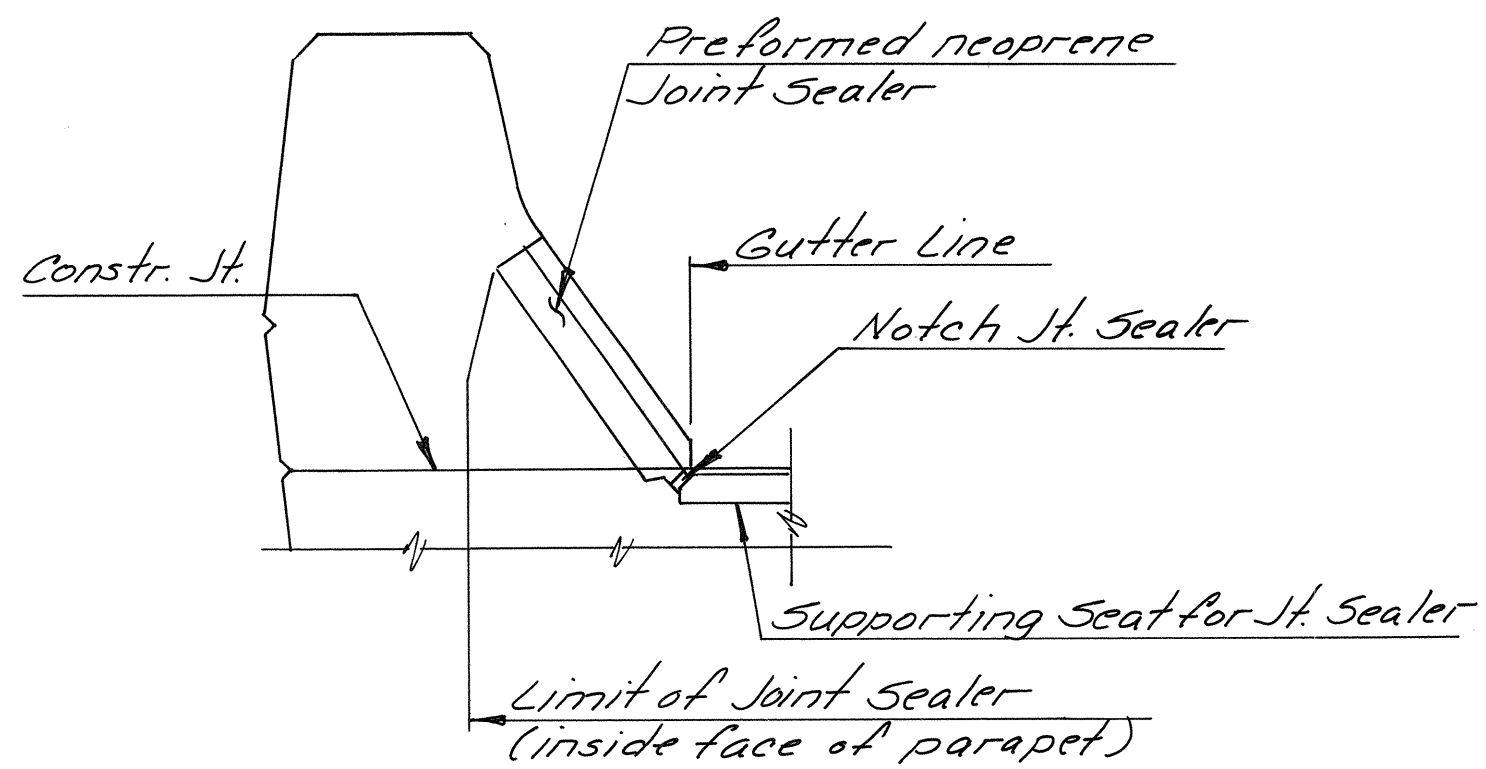

TREATMENT OF JOINT AT GUTTER LINE  
No Scale

AS BUILT

MADE	BY	DATE				
CHECKED	BS	12/90				
IN CHARGE	SR		NO.	REVISION	BY	DATE

RICHMOND METROPOLITAN AUTHORITY  
RICHMOND EXPRESSWAY SYSTEM


BRIDGE NO. 62 WIDENING  
RAMP E-11TH OVER  
RAMP 12TH-W AND 12TH ST.  
JOINT DETAILS

HOWARD, NEEDLES, TAMMEN & BERGENDOFF  
consulting engineers  
Alexandria, Virginia

SCALE: As Shown  
CONTRACT NO.: C-15  
SHEET NO. 13 OF 31





RICHMOND EXPRESSWAY SYSTEM			
SECTION	PROJECT	SHEET NO.	TOTAL SHEETS
C-15	1990-1991 IMPROVEMENTS	6(14)	

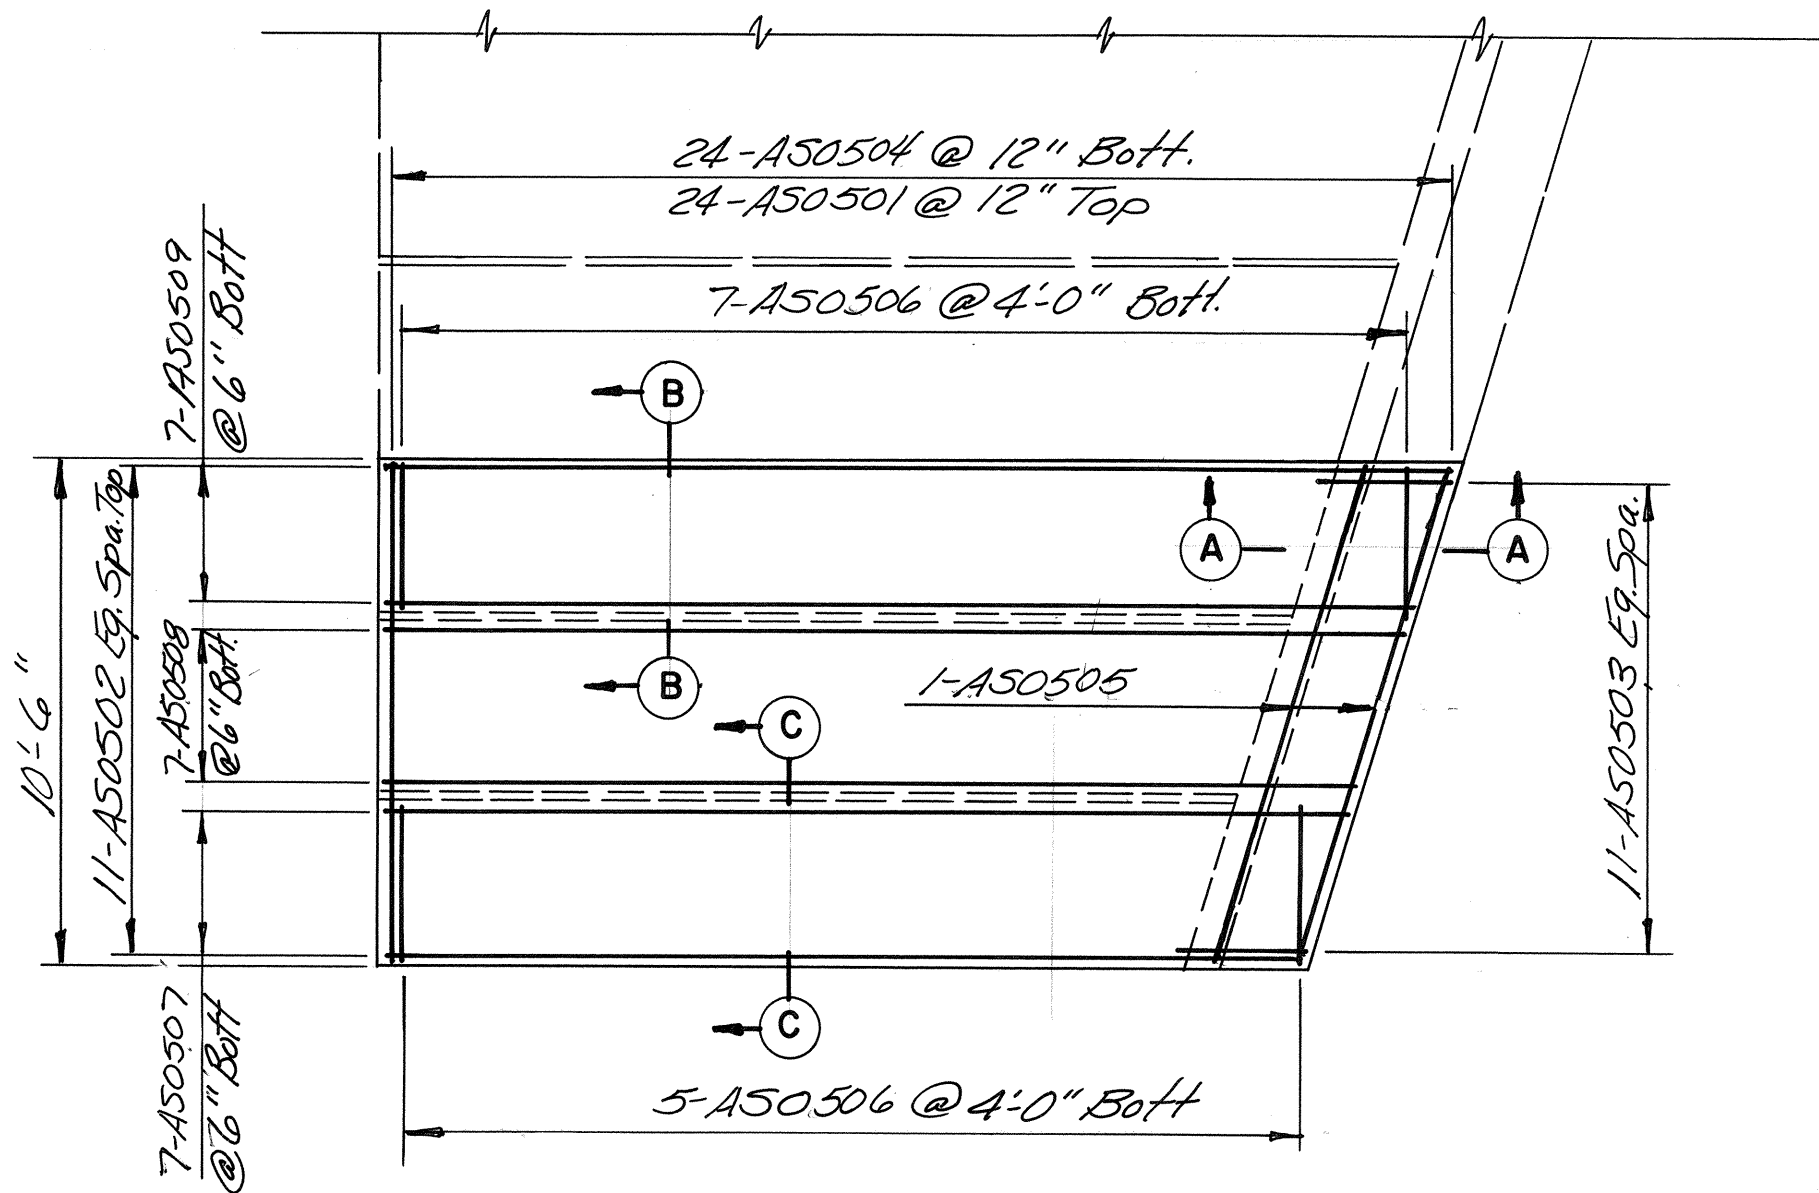


**WEST APPROACH SLAB**  
Scale: 4"=1'-0"


REINFORCING STEEL SCHEDULE			
MARK	NO	LENGTH	LOCATION
A50501	24	10'-0"	Top Transverse
A50502	11	19'-0"	Top Longitudinal
A to K		22'-0"	Top Longitudinal
A50503	11	8'-0"	End Longitudinal
A50504	24	10'-0"	Bottom Transverse
A50505	2	10'-6"	Bottom Transverse
A50506	12	3'-2"	Bottom Transverse
A50507	7	19'-0"	Bottom Longitudinal
A to G		20'-0"	Bottom Longitudinal
A50508	7	20'-0"	Bottom Longitudinal
A to G		21'-0"	Bottom Longitudinal
A50509	7	21'-0"	Bottom Longitudinal
A to G		22'-0"	Bottom Longitudinal

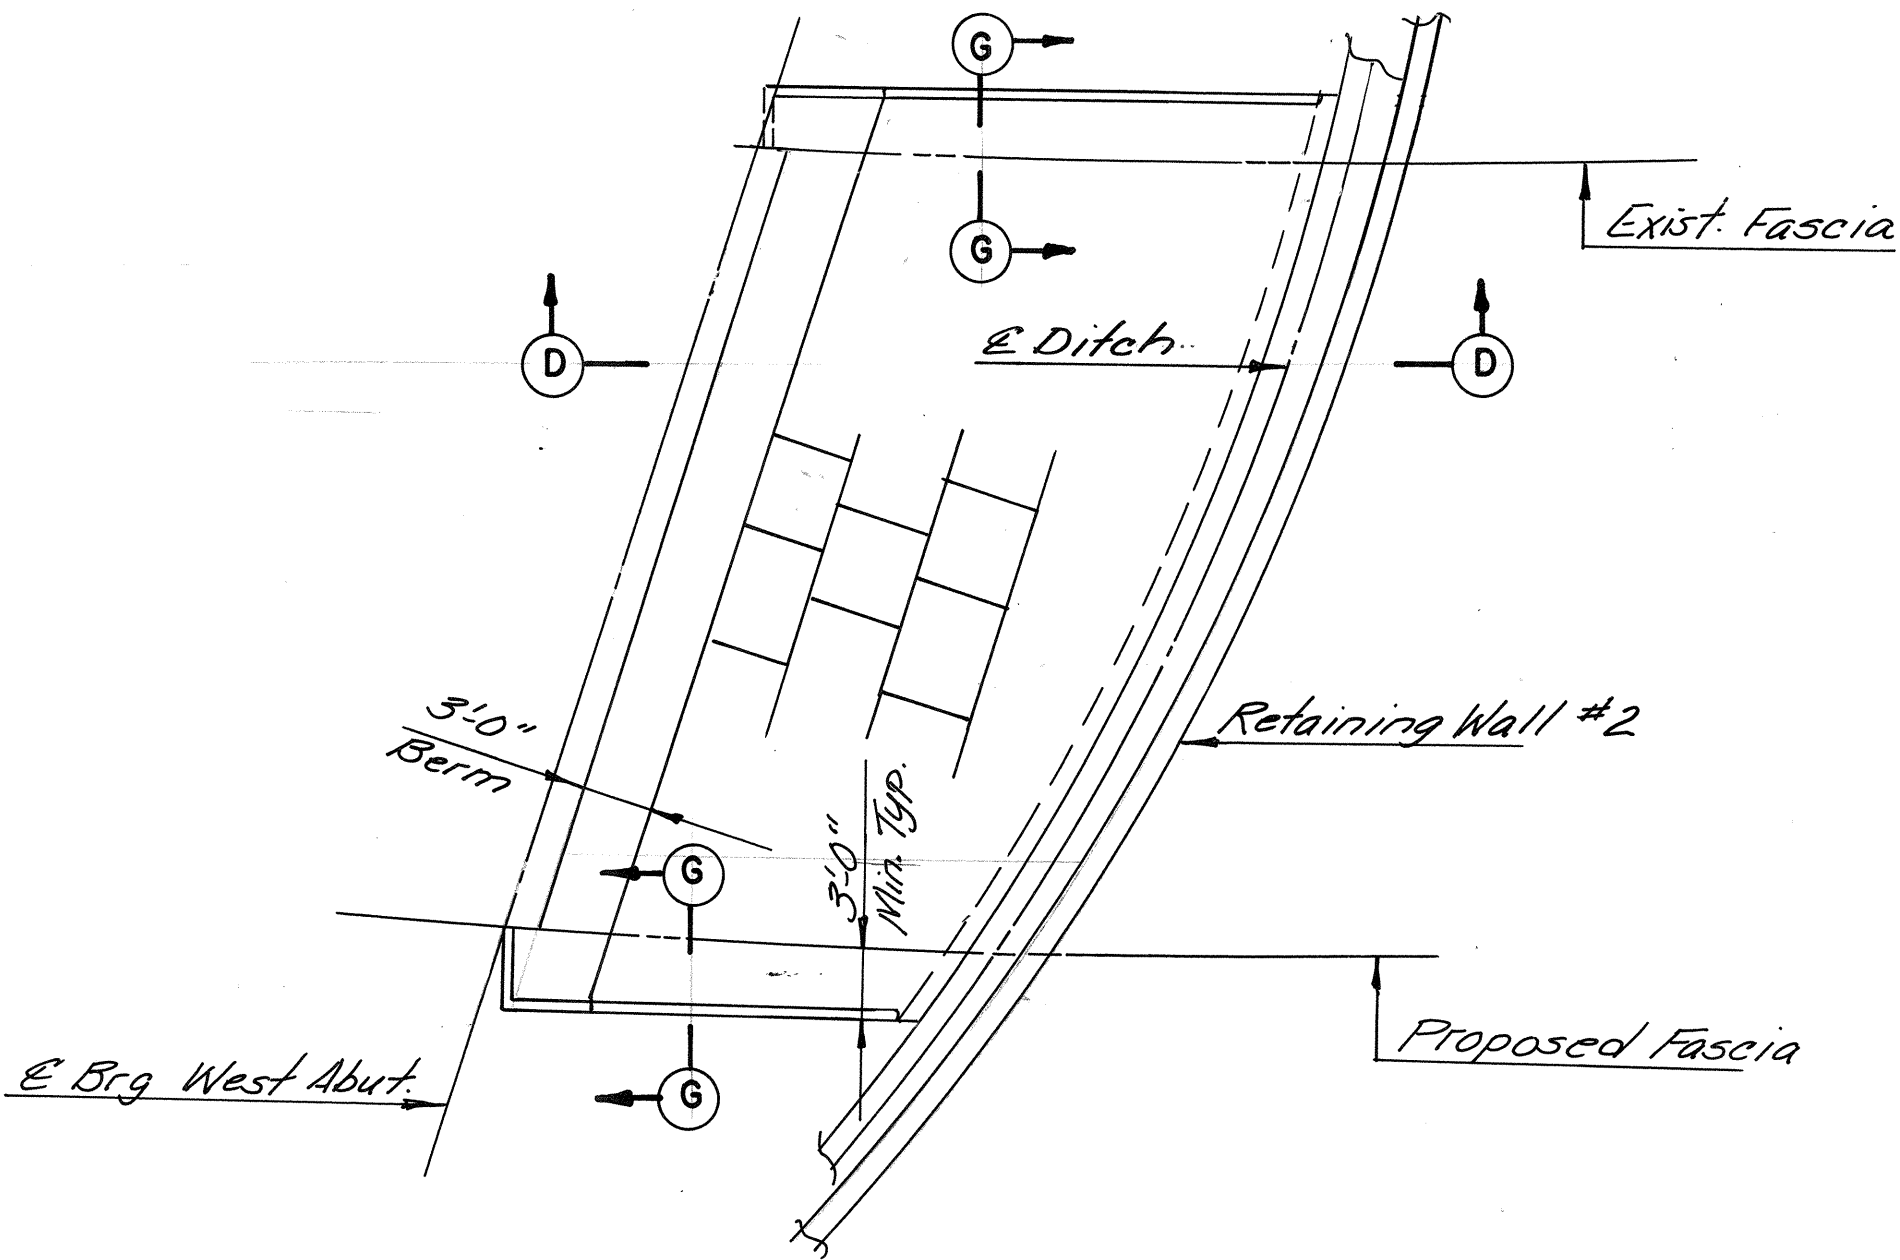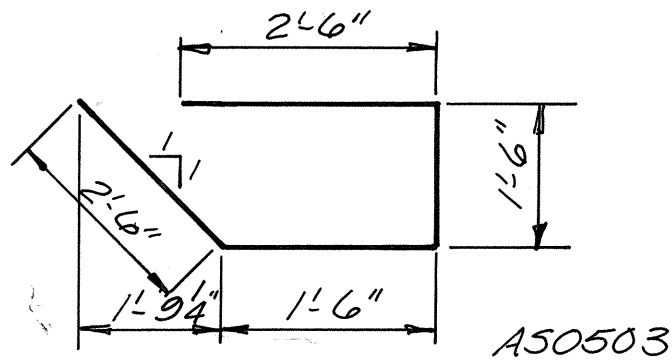


**WEST SLOPE PROTECTION**  
Scale: 8"=1'-0"

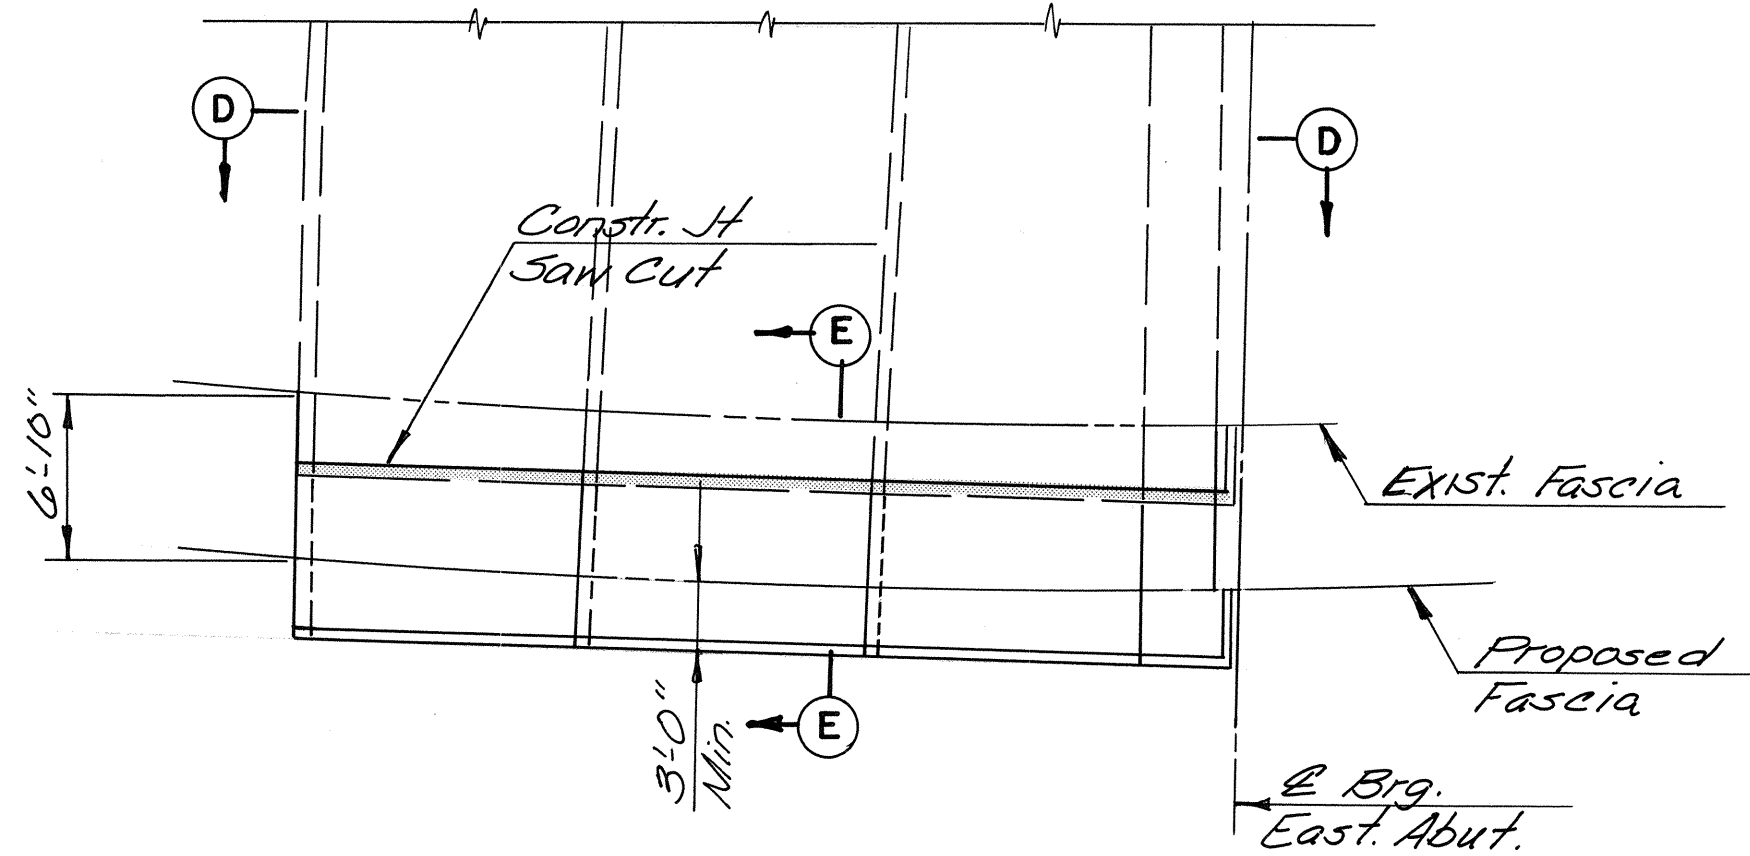


**EAST SLOPE PROTECTION**  
Scale: 8"=1'-0"

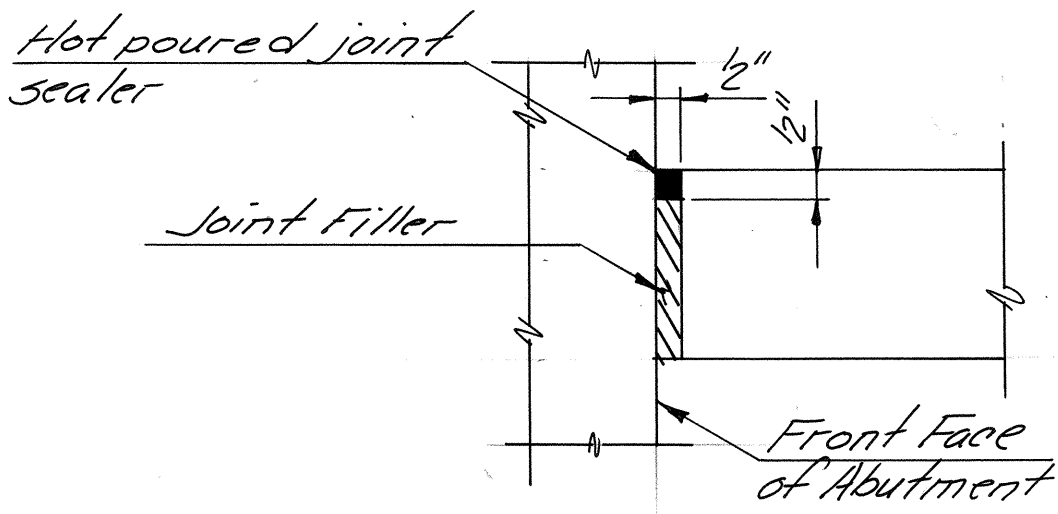


**DETAIL F**  
No Scale

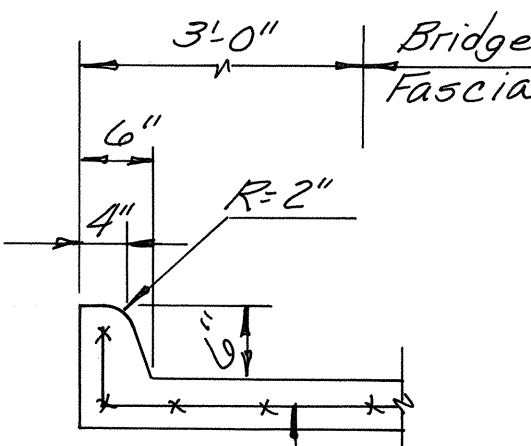


**SECTION G-G**  
Scale: 3/4"=1'-0"

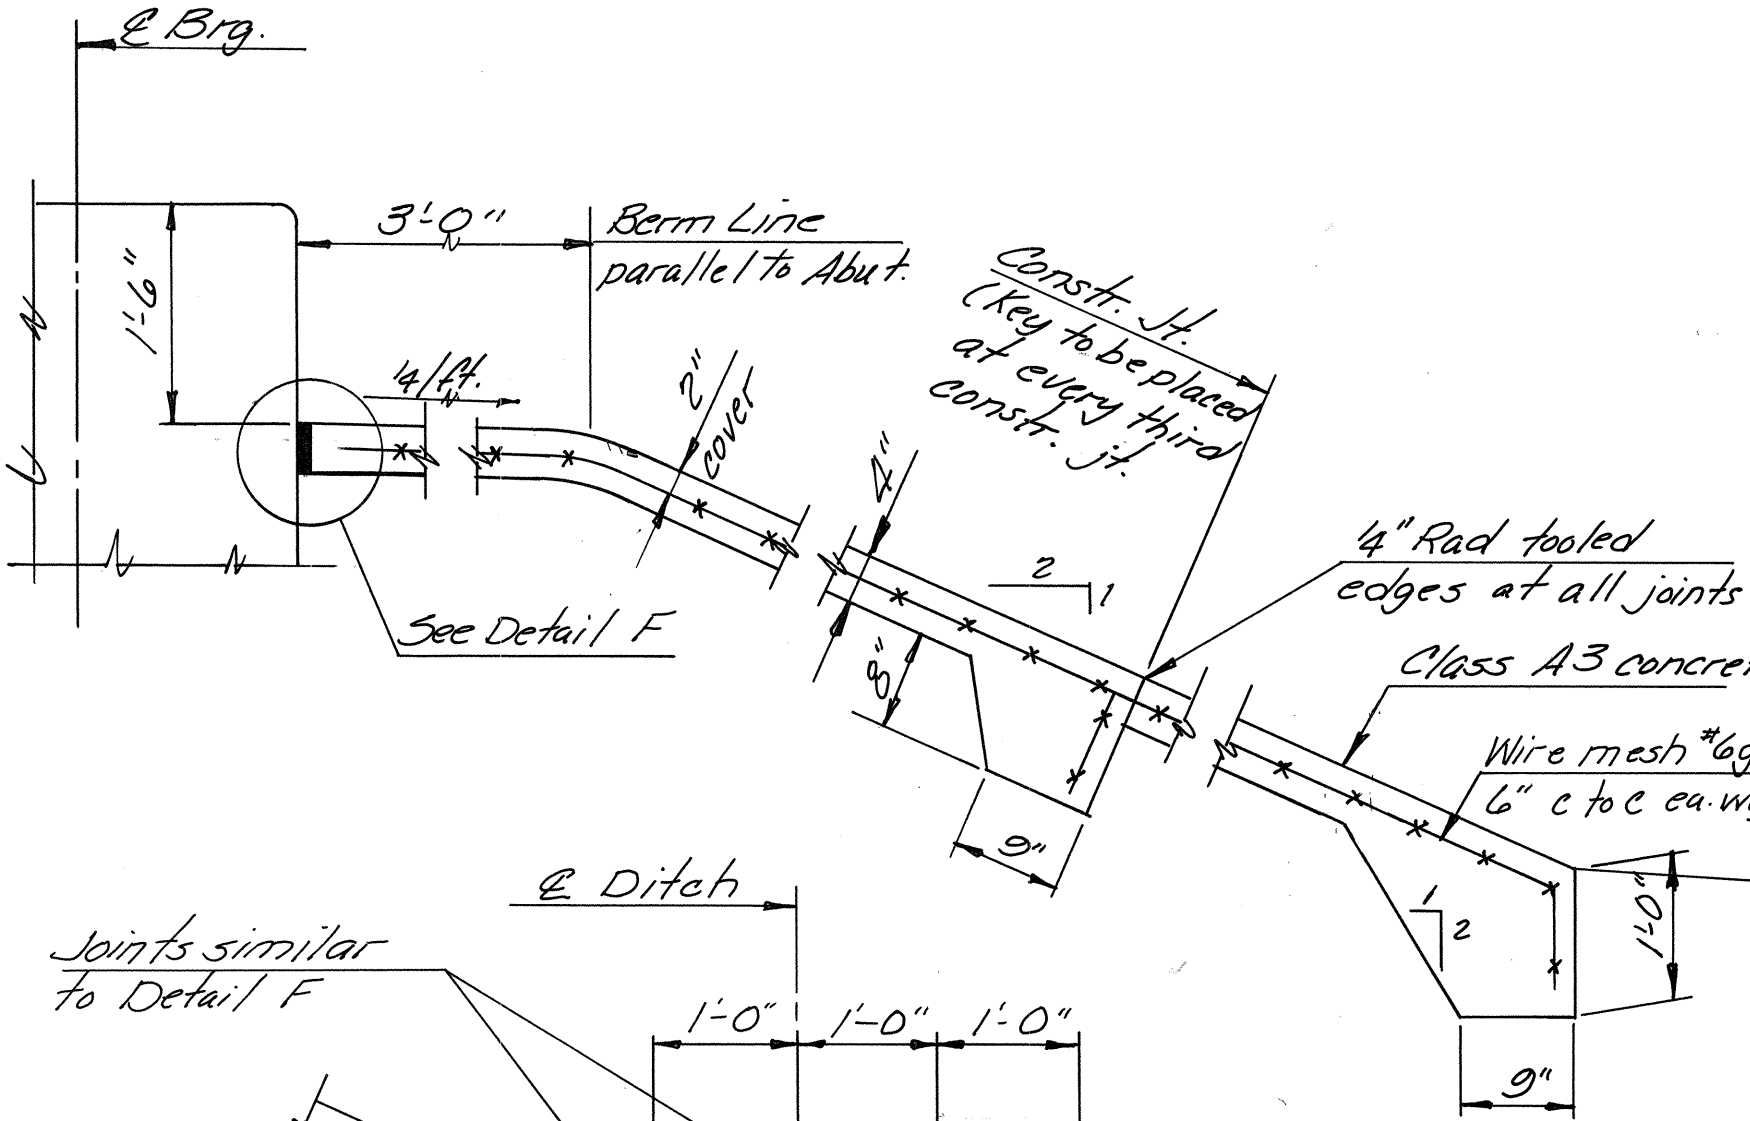


**SECTION D-D**  
Scale: 3/4"=1'-0"

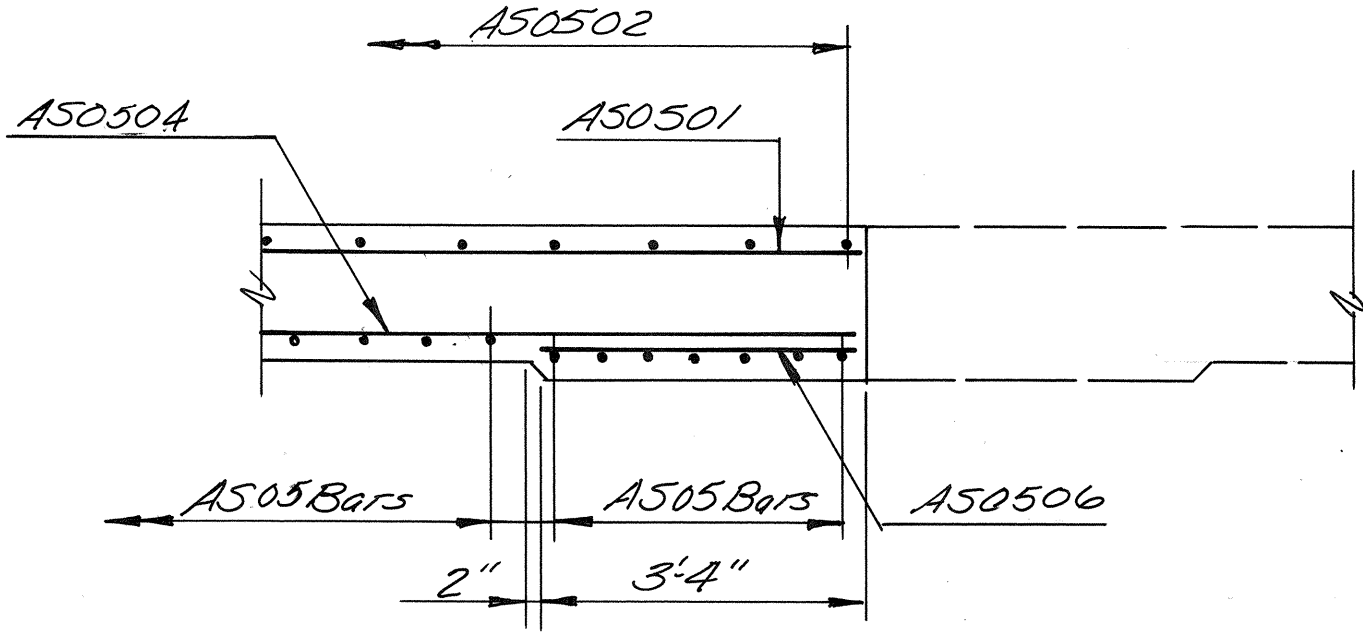


**SECTION B-B**  
Scale: 6"=1'-0"

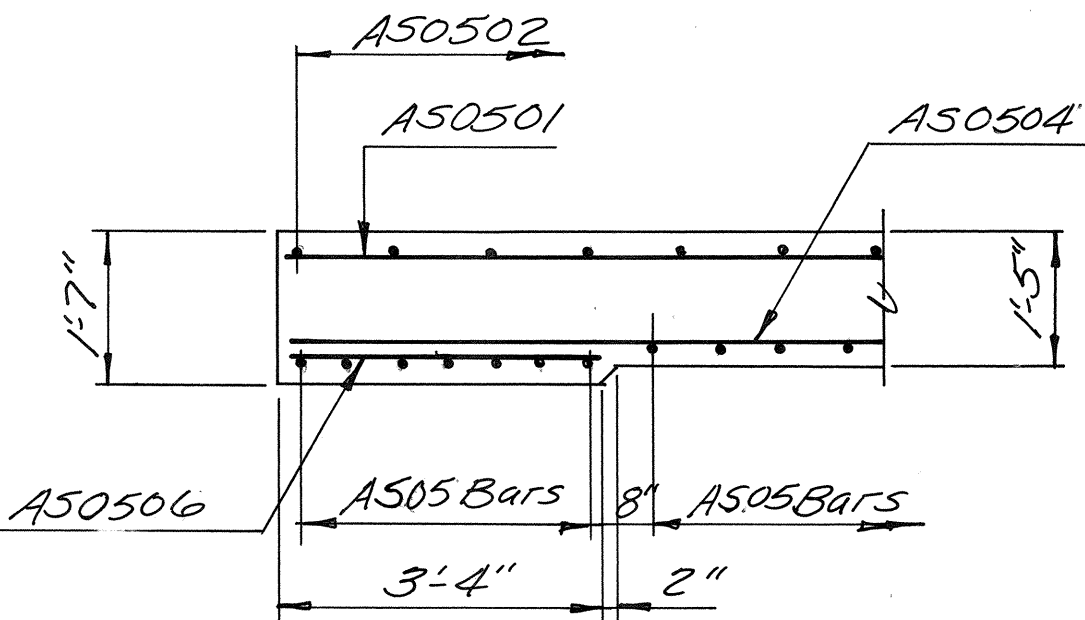

**SECTION C-C**  
Scale: 6"=1'-0"

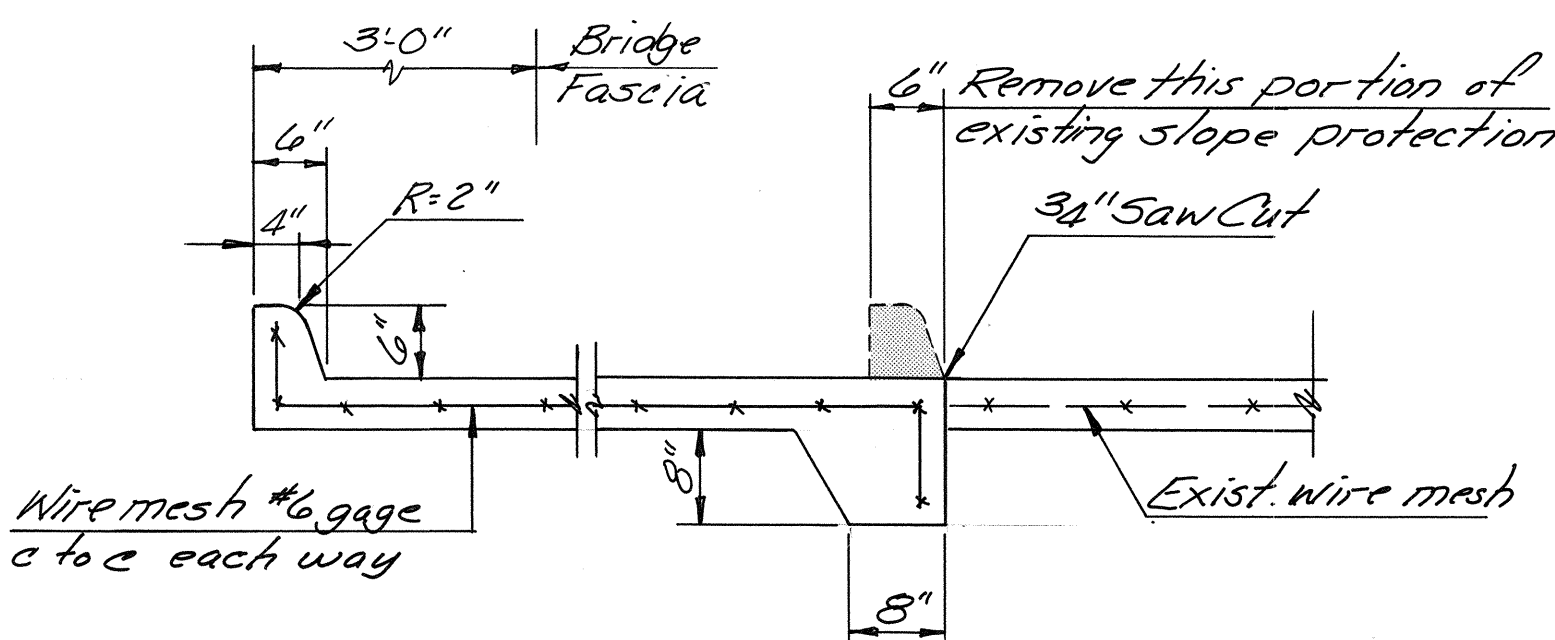

**SECTION E-E**  
Scale: 3/4"=1'-0"

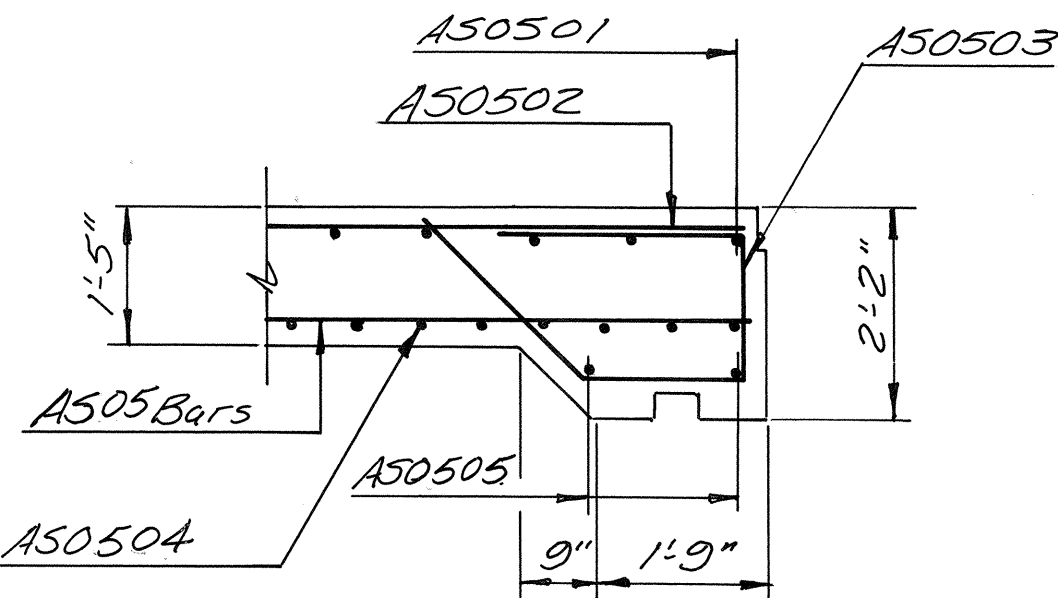

**SECTION A-A**  
Scale: 6"=1'-0"

BY	DATE				
MADE	TAL	12/90			
CHECKED	BS	12/90			
IN CHARGE	SR				

NO.	REVISION	BY	DATE
-----	----------	----	------

**RICHMOND METROPOLITAN AUTHORITY**  
**RICHMOND EXPRESSWAY SYSTEM**

**BRIDGE NO. 62 WIDENING**  
**RAMP E-11TH OVER**  
**RAMP 12TH-W AND 12TH ST.**  
**APPROACH SLAB AND**  
**SLOPE PROTECTION DETAILS**

HOWARD, NEEDLES, TAMMEN & BERGENDOFF  
consulting engineers  
Alexandria, Virginia

SCALE: As Shown

CONTRACT NO. C-15

SHEET NO. 14 OF 31

**AS BUILT**