

# **RICHMOND METROPOLITAN TRANSPORTATION AUTHORITY**

## **PC-2023 APPENDIX**

### **RECORD DRAWINGS**

RMTA BRIDGES 4, 5, (8 Original and 8 Widening), 12, 13, 17, 36, 37, 50, 51, 54, 55, 56, 57, 58, and 60

(NOTE: Additional As-built Plans are Available upon Request to the Engineer)



# **RMTA System Map**






# RICHMOND EXPRESSWAY SYSTEM

Scale:  
0 1000 2000 3000ft.

48 - Bridge Number  
RMTA Facilities Shown in Red

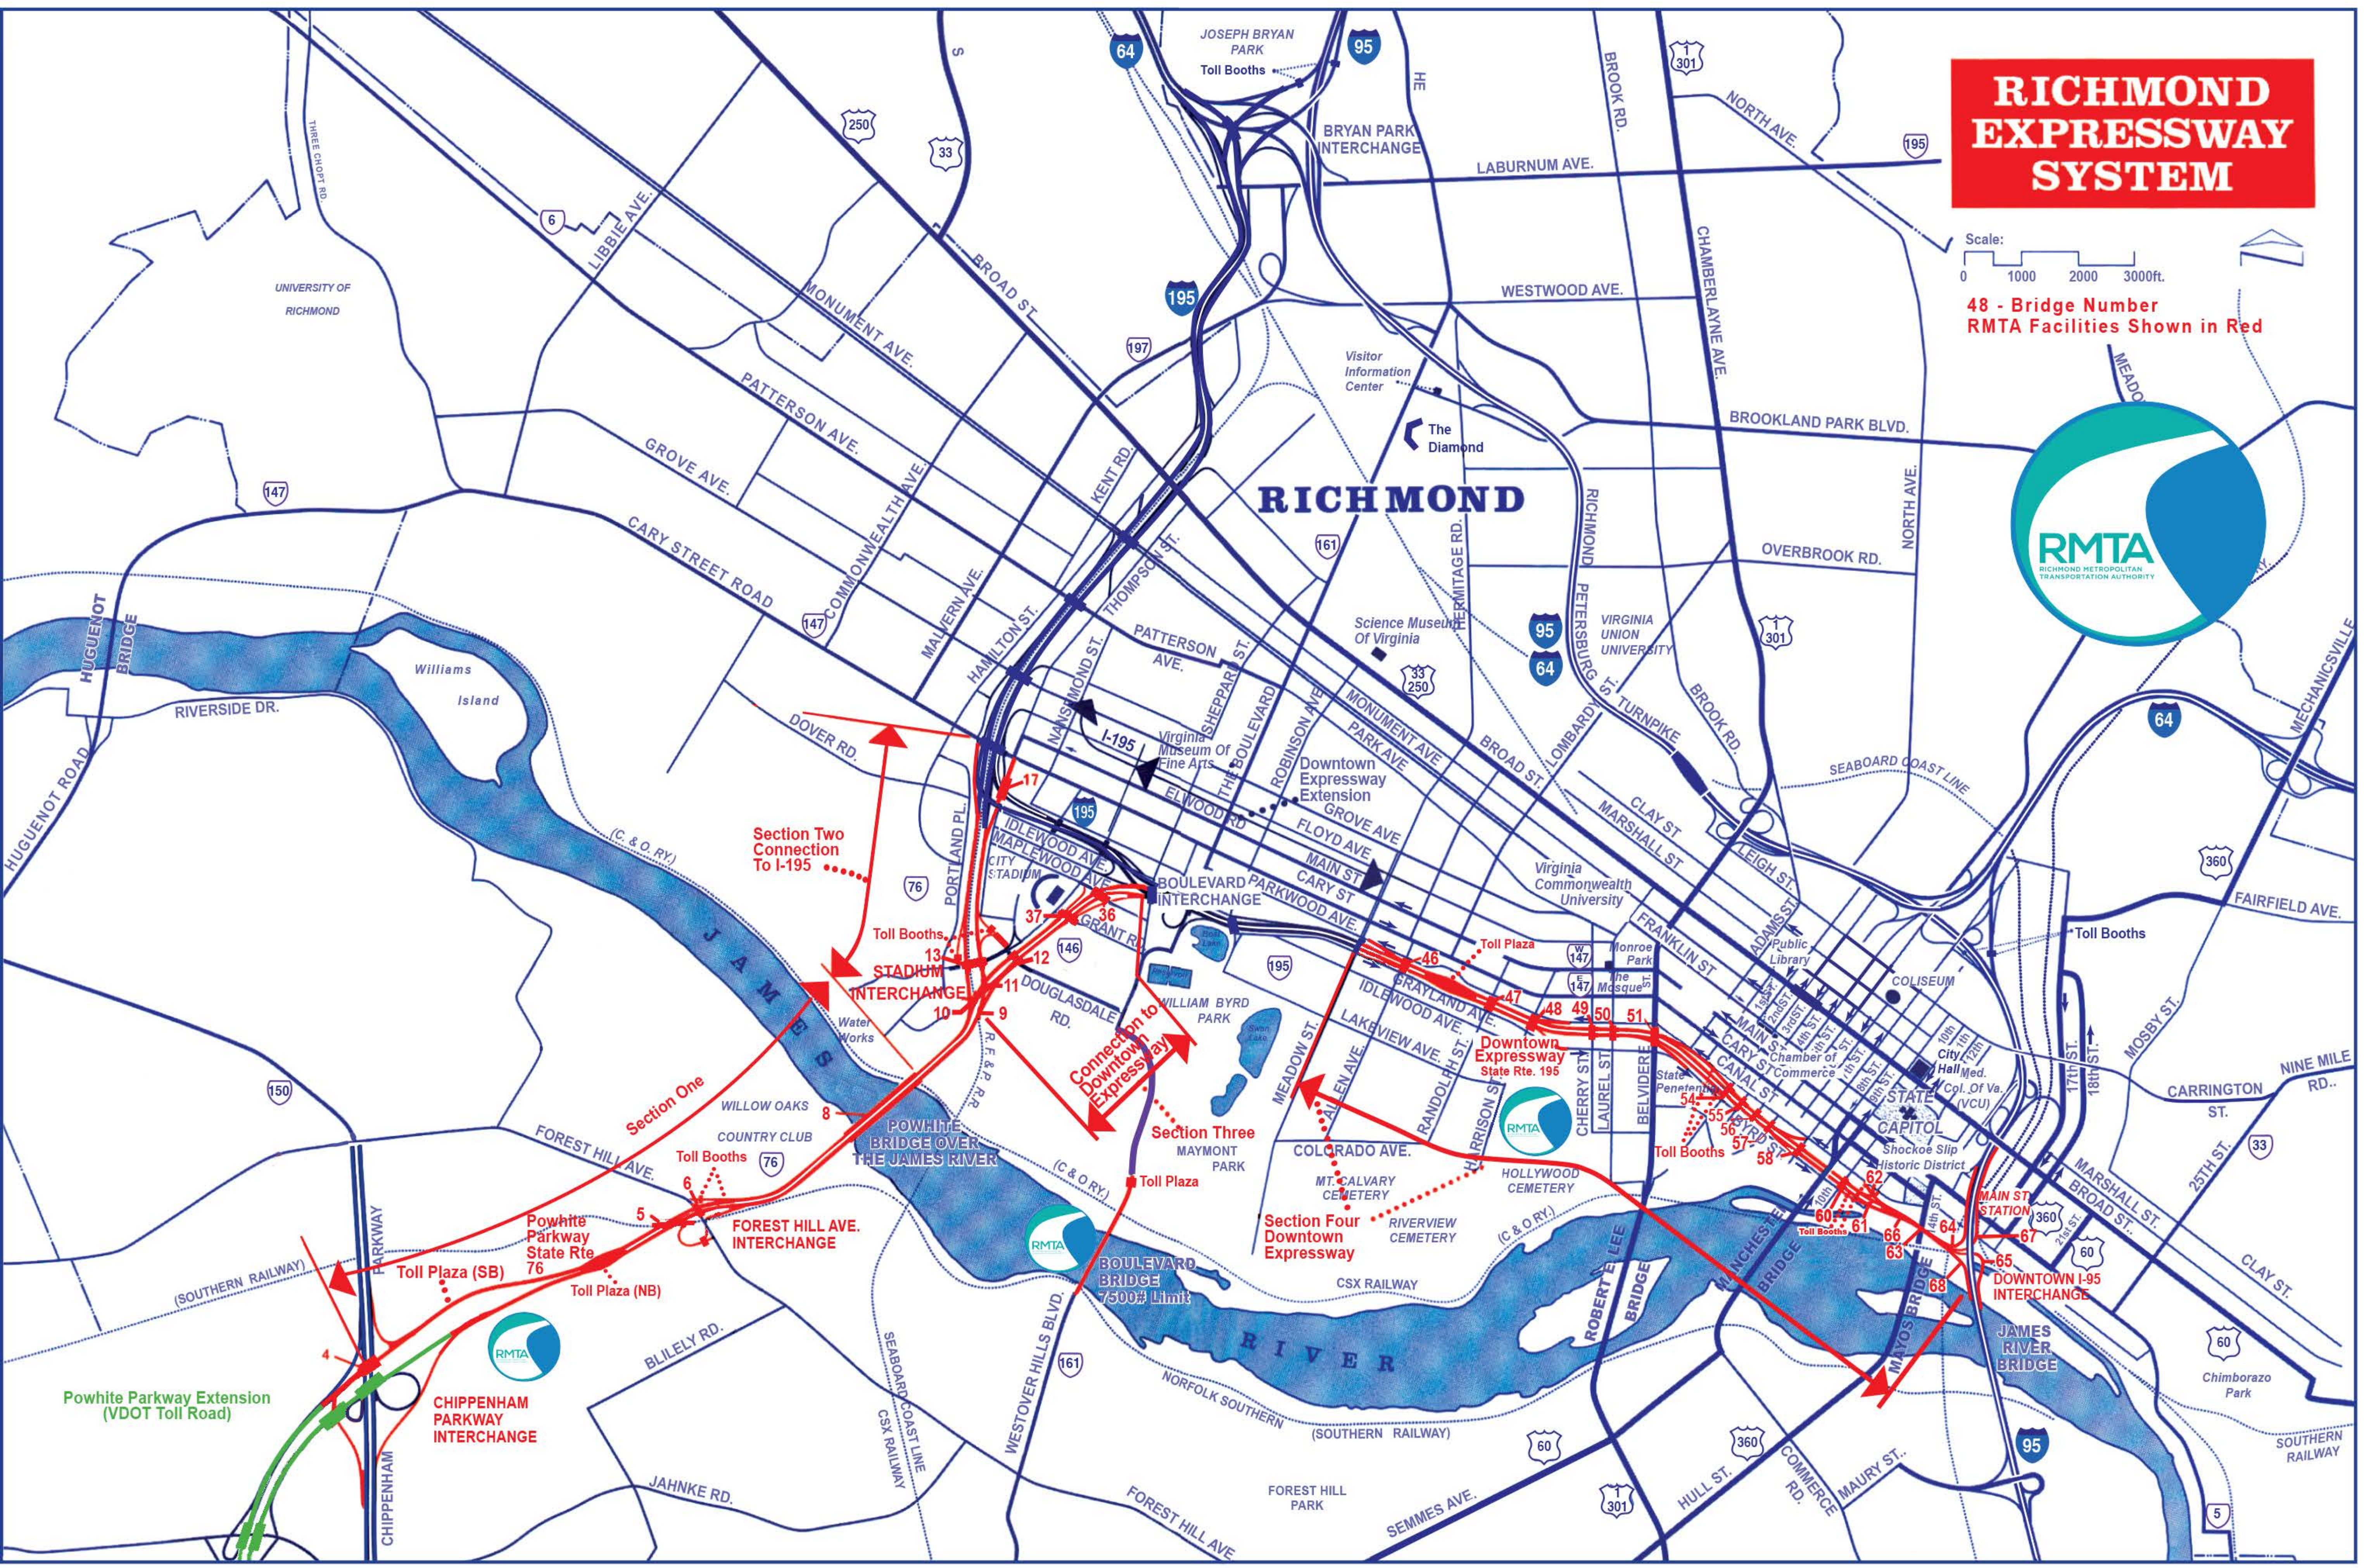





# **Bridge 4**

**Southbound Powhite Parkway (VA-76)**

**Over**

**Both directions of Chippenham Parkway (VA 150)**

**Partial Record Set of Plans**





GENERAL NOTES

**ROADWAY:** One 31'-6" and one 23'-6" clear roadway.  
**CAPACITY:** Dead Load-Includes 15 lbs. per sq.ft. for future wearing surface.  
Live Loads-HS20-44 loading and B.P.R. modified for military vehicles.

**SPECIFICATIONS:** GENERAL-Virginia Department of Highway Road and Bridge Specifications, 1970.  
DESIGN-A.A.S.H.O. Standard Specifications for Highway Bridges, 1961, modified by Special Design Provisions.  
WELDING-1969 Standard Specifications for Welded Highway and Railway Bridges of the American Welding Society.

**CONTRACT SPECIAL PROVISIONS**

Specifications and Contract Special Provisions referred to above are necessary to make these plans complete.

**DATUM:** CITY OF RICHMOND

**TEMPERATURE:** The normal temperature referred to on the plan is 68°F. The temperature range for movement is 0°F to 120°F.

**DIMENSIONS:** All dimensions are measured horizontally and vertically unless otherwise noted.

**EXCAVATION:** Excavation below subgrade and cut slope template shall be classified as Structure Excavation. All excavation above these limits shall be classified as Regular Excavation and is not included in the Structural Quantities.

**CONCRETE NOTES:** Concrete in superstructure shall be Class A4. All other concrete shall be Class A3. All exposed edges and corners shall have a 3/4" chamfer or fillet unless otherwise noted. Care in the method of vibration, the use of low-slump concrete, and/or other means shall be employed to prevent downgrade movement of newly placed slab concrete (when gradient is over 2%).

Finishing Concrete Surfaces: See the Standard Architectural Details sheets and the Contract Special Provisions for types and details.

All reinforcing steel shall conform to A.S.T.M. A615, Grade 40. All reinforcing bar dimensions on the detailed drawings are to centers of bars unless otherwise noted. Clear distance between reinforcing steel and face of concrete shall be as noted on the plans. All bar laps shall be 30 diameters of the smaller diameter bar unless otherwise noted.

**STEEL NOTES:** Structural steel shall conform to A.S.T.M. Specification A36 except as noted. All field connections shall be made with high strength bolts. High strength bolts shall be 7/8" diameter unless otherwise noted and shall conform to A.S.T.M. Specifications A325.

**BENCH MARKS:** See Reference Ties and Field Control Data sheet in highway plans.  
F30(Copper Weld Rod) Elevation 218.82  
G-11(Copper Weld Rod) Elevation 150.10

RICHMOND EXPRESSWAY SYSTEM			
SECTION	PROJECT	SHEET NO.	TOTAL SHEETS
2	POWHITE PARKWAY	119	188

ESTIMATED QUANTITIES

	STRUCTURE EXCAVATION C.Y.	CONCRETE CLASS A3 C.Y.	CONCRETE CLASS A3 BR. APPR. SLABS C.Y.	CONCRETE CLASS A4 C.Y.	REINFORCING STEEL LBS.	STRUCTURAL STEEL LBS.	ALUMINUM BR. RAILING (1 RAIL) L.F.	POROUS BACKFILL C.Y.	STEEL PILES 10BP42 L.F.	CONC. SLAB SLOPE PROTECTION S.Y.	DAMP-PROOFING S.Y.	UNDERDRAIN 6" Ø L.F.
SUPERSTRUCTURE				380.39	103,414	427,036	407					
WEST ABUTMENT	540	294.15			12,729		36	45	1934.8	228	140	111
PIER 1	175	136.91			24,625				1174.5			
EAST ABUTMENT	460	217.95			10,872		24	26	1634.6	228	91	94
APPROACH SLABS			204.77		57,934							
TOTAL	1,175	649.01	204.77	380.39	209,574	427,036	467	71	4743.9	456	231	205

AS BUILT

RICHMOND METROPOLITAN AUTHORITY  
RICHMOND EXPRESSWAY SYSTEM  
POWHITE PARKWAY

POWHITE PARKWAY OVER  
CHIPPENHAM PARKWAY  
BRIDGE B-04

GENERAL NOTES AND QUANTITIES

HOWARD, NEEDLES, TAMMEN & BERGENDOFF  
consulting engineers  
NEW YORK ALEXANDRIA KANSAS CITY

SCALE: AS SHOWN







CONTRACT NO. 2

SHEET NO. 2 OF 14

	BY	DATE	3	As Built	JRC	3-73
MADE	EVR	3-68	2	Parapet	HBW	12-70
CHECKED	PRY	3-68	1	General	J.G.V.	10-70
IN CHARGE	PRY		NO.	REVISION	BY	DATE



RICHMOND EXPRESSWAY SYSTEM			
SECTION	PROJECT	SHEET NO.	TOTAL SHEETS
2	POWHITE PARKWAY	124	188

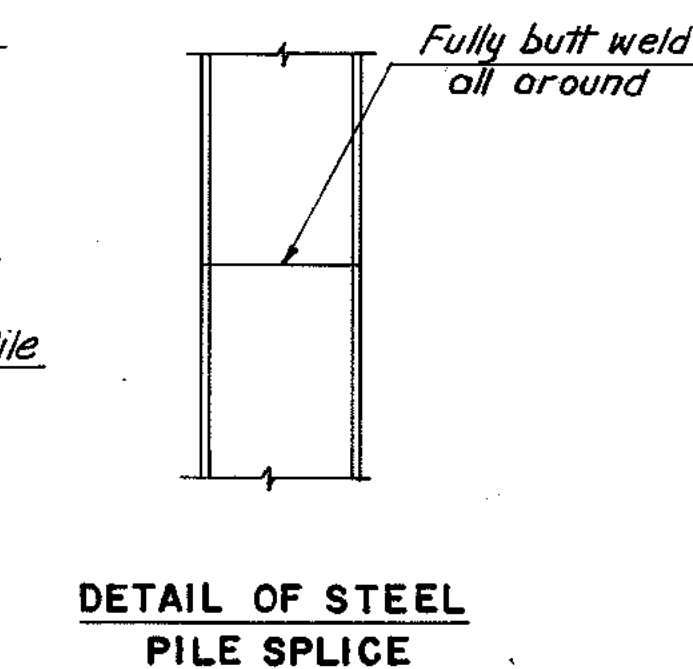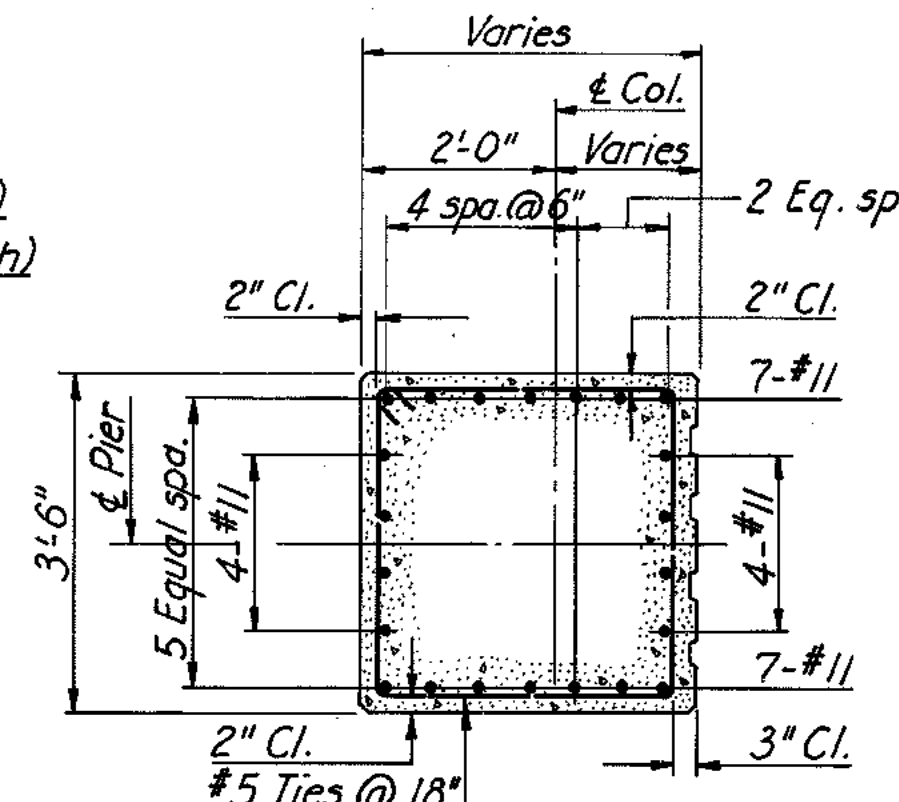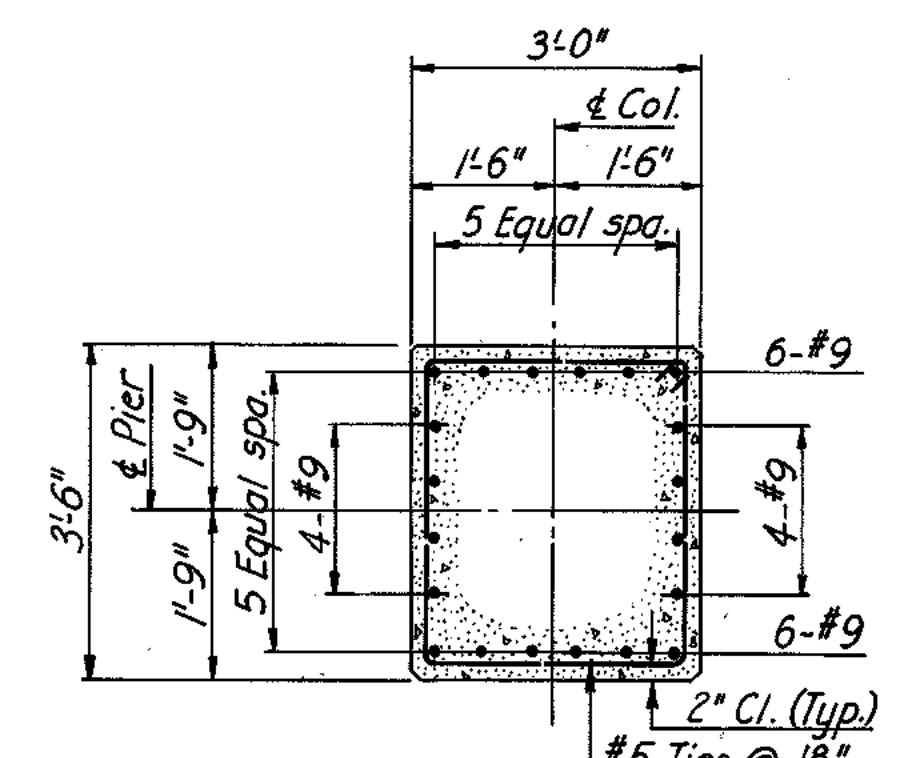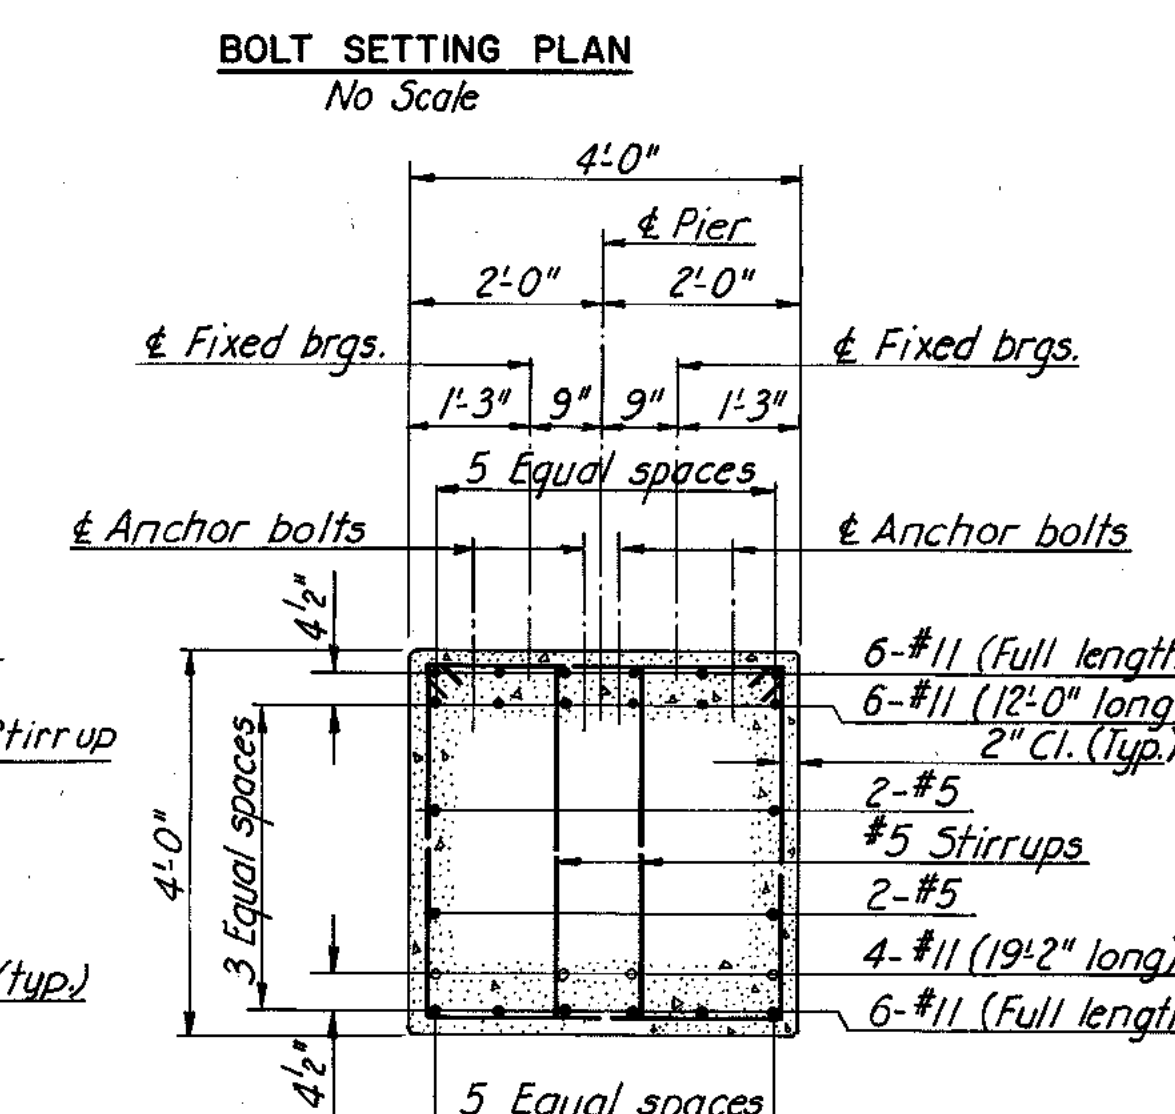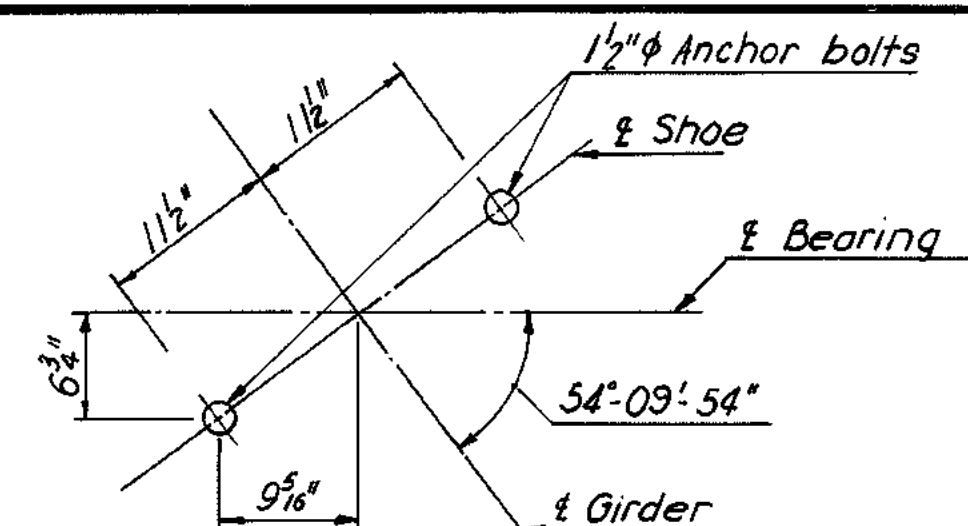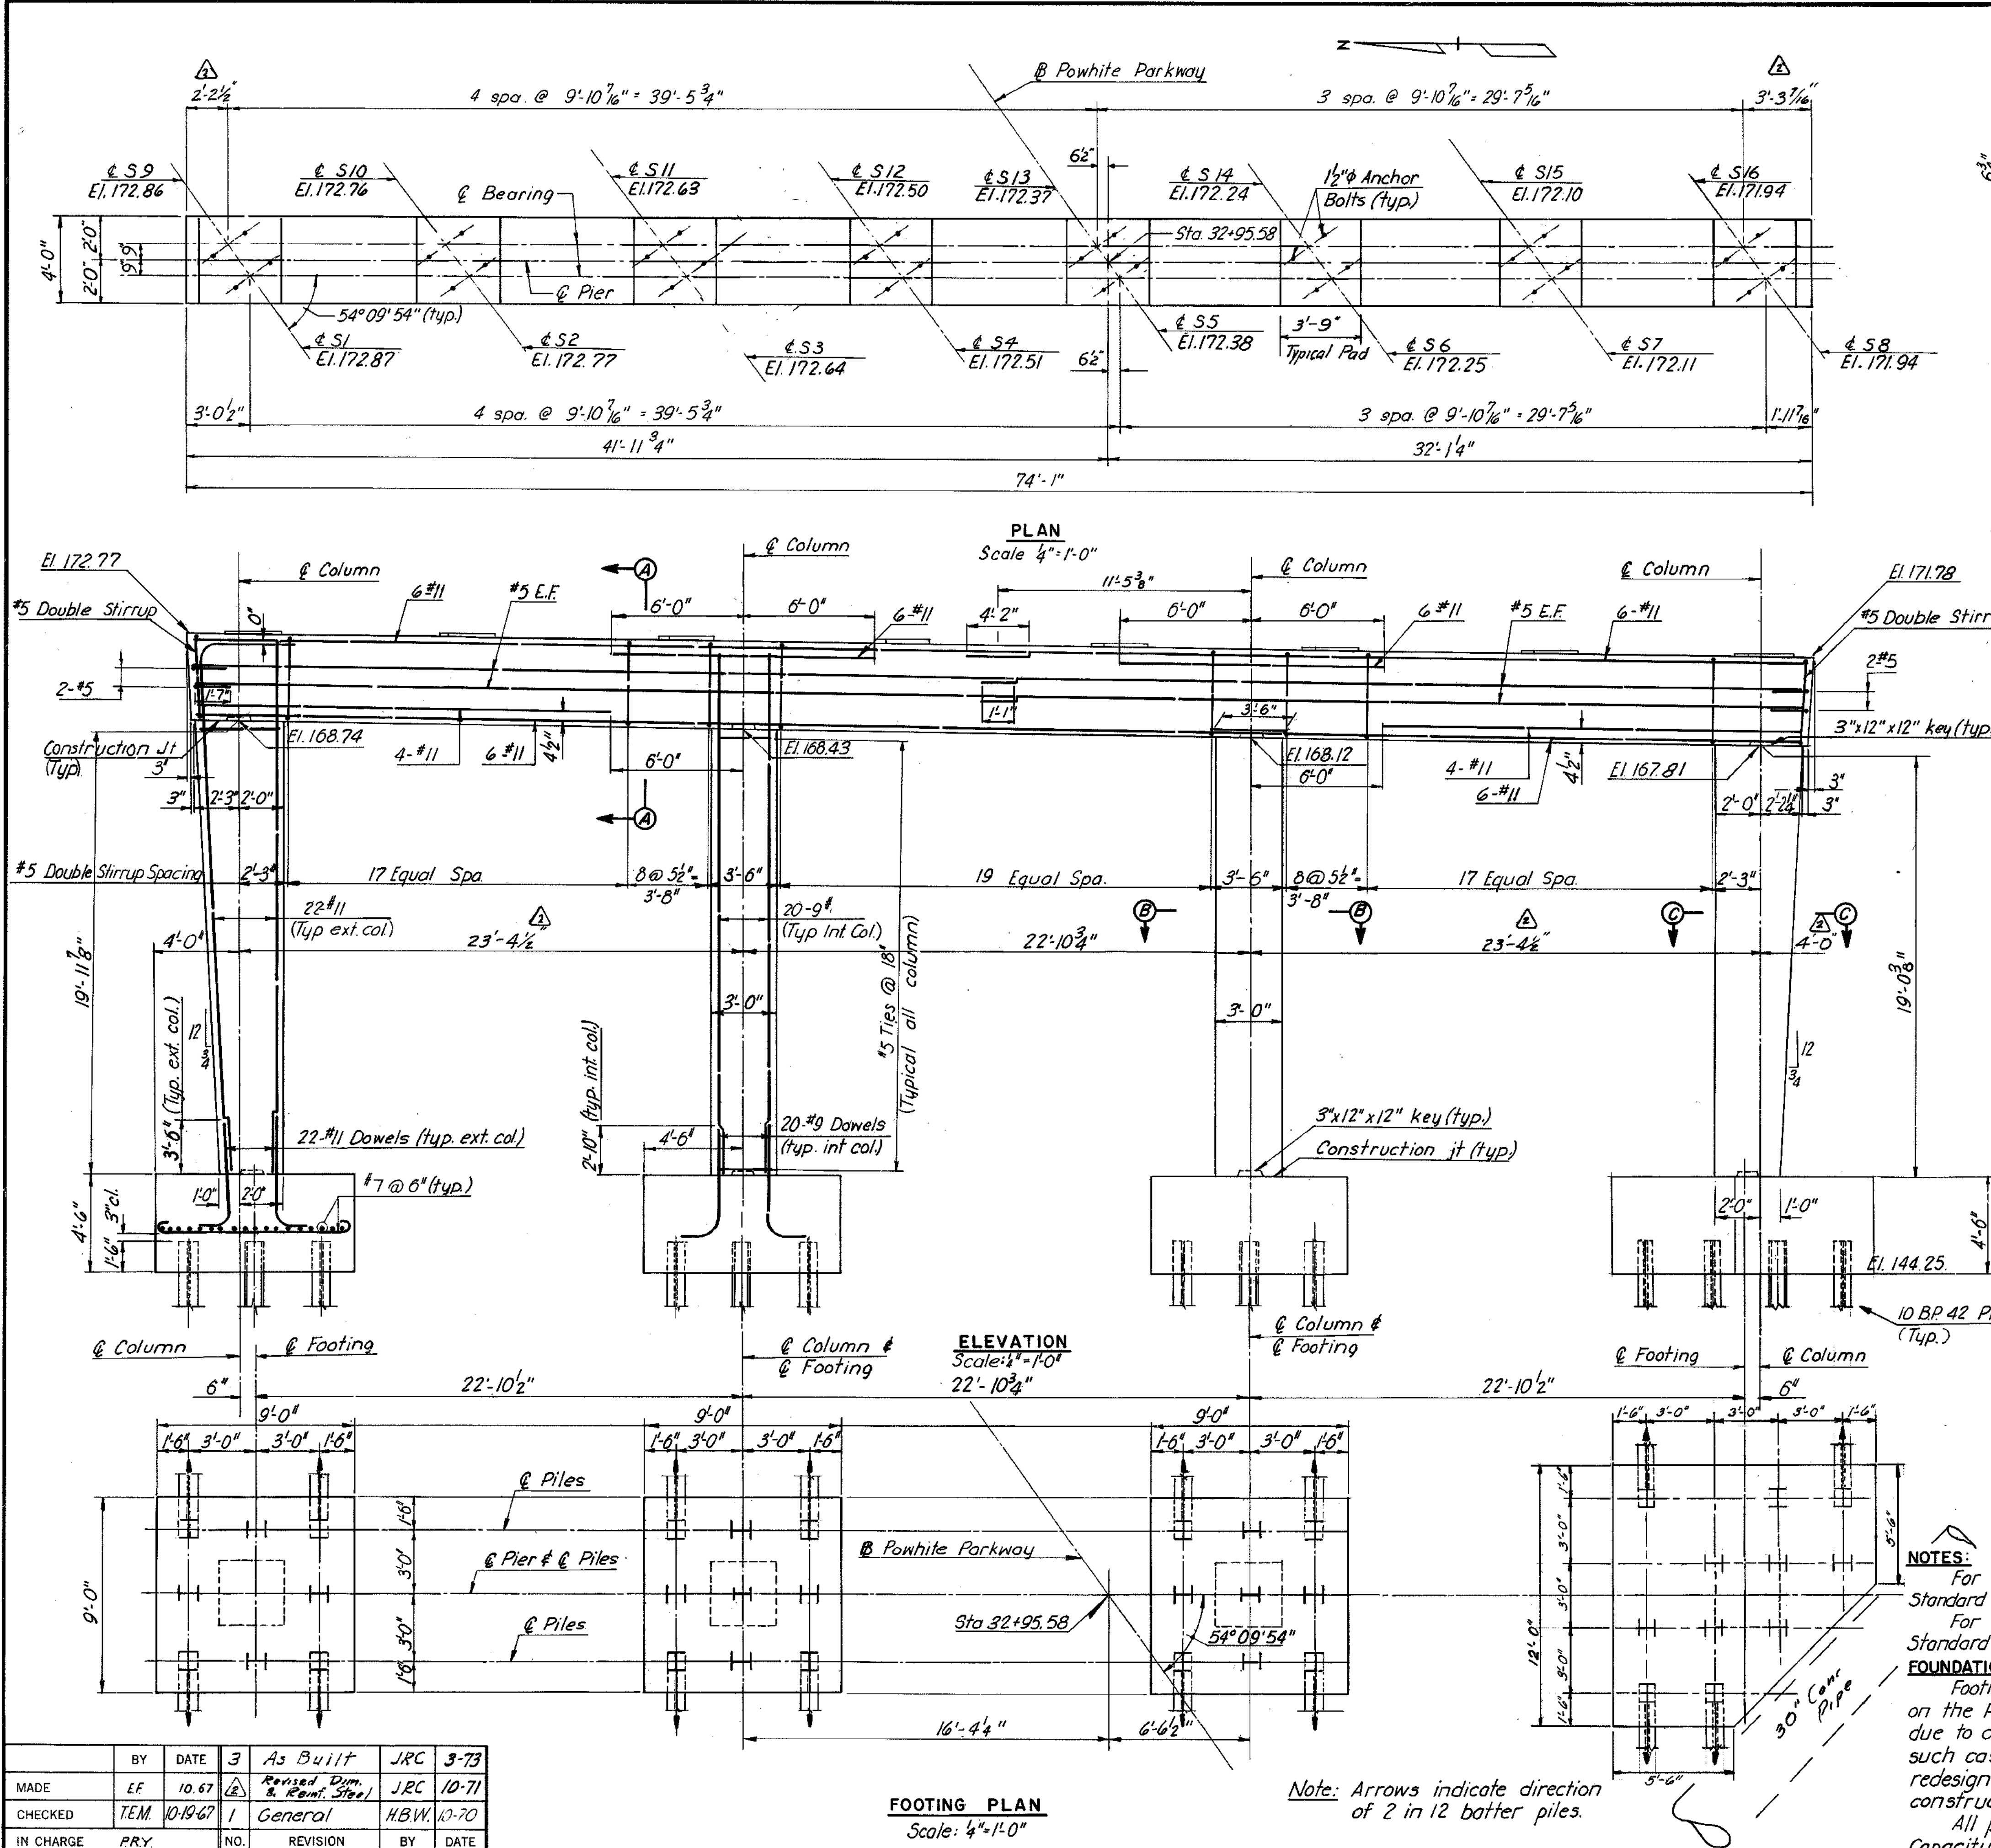

**NOTES:**  
For anchor bolt details and treatment of pads, see Standard Shoe Details sheet.  
For details of architectural treatment of piers, see Standard Architectural Details sheet.



**FOUNDATION NOTES:**  
Footings shall be founded at the elevation shown on the Plans unless otherwise directed by the Engineer due to conditions at the site during construction. In such cases, the Engineer will determine the extent of redesign necessary and will advise the Contractor before construction begins.  
All piles shall be 10BP42 Steel Piles (Design Capacity = 45 tons).

**AS BUILT**

RICHMOND METROPOLITAN AUTHORITY RICHMOND EXPRESSWAY SYSTEM POWHITE PARKWAY	
POWHITE PARKWAY OVER CHIPPENHAM PARKWAY BRIDGE B-04	
PIER DETAILS	
HOWARD, NEEDLES, TAMMEN & BERGENDOFF consulting engineers NEW YORK ALEXANDRIA KANSAS CITY	SCALE: AS SHOWN CONTRACT NO.: 2 SHEET NO. 7 OF 14

BY	DATE	3	As Built	JRC	3-73
MADE	EF	10-67	Revised Dim. & Reinf. Steel	JRC	10-71
CHECKED	TEM	10-19-67	General	HBW	10-70
IN CHARGE	PRY				


RICHMOND EXPRESSWAY SYSTEM			
SECTION	PROJECT	SHEET NO.	TOTAL SHEETS
2	POWHITE PARKWAY	125	188

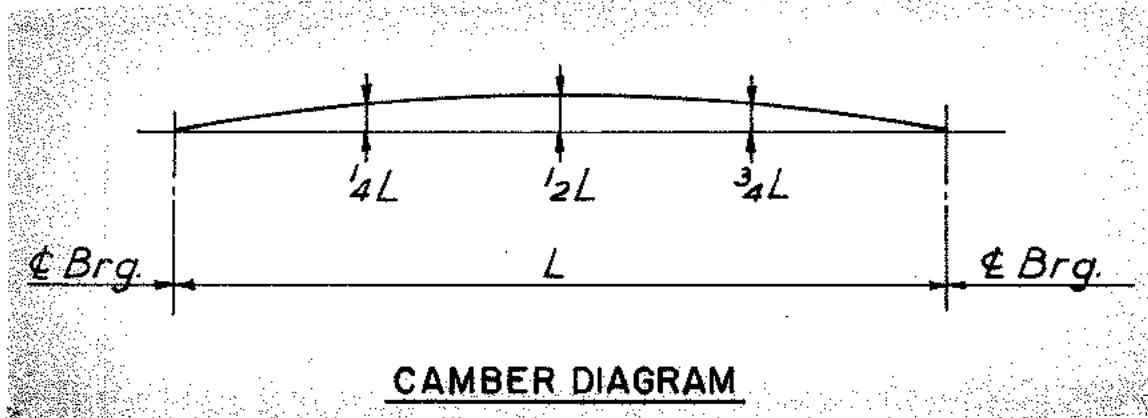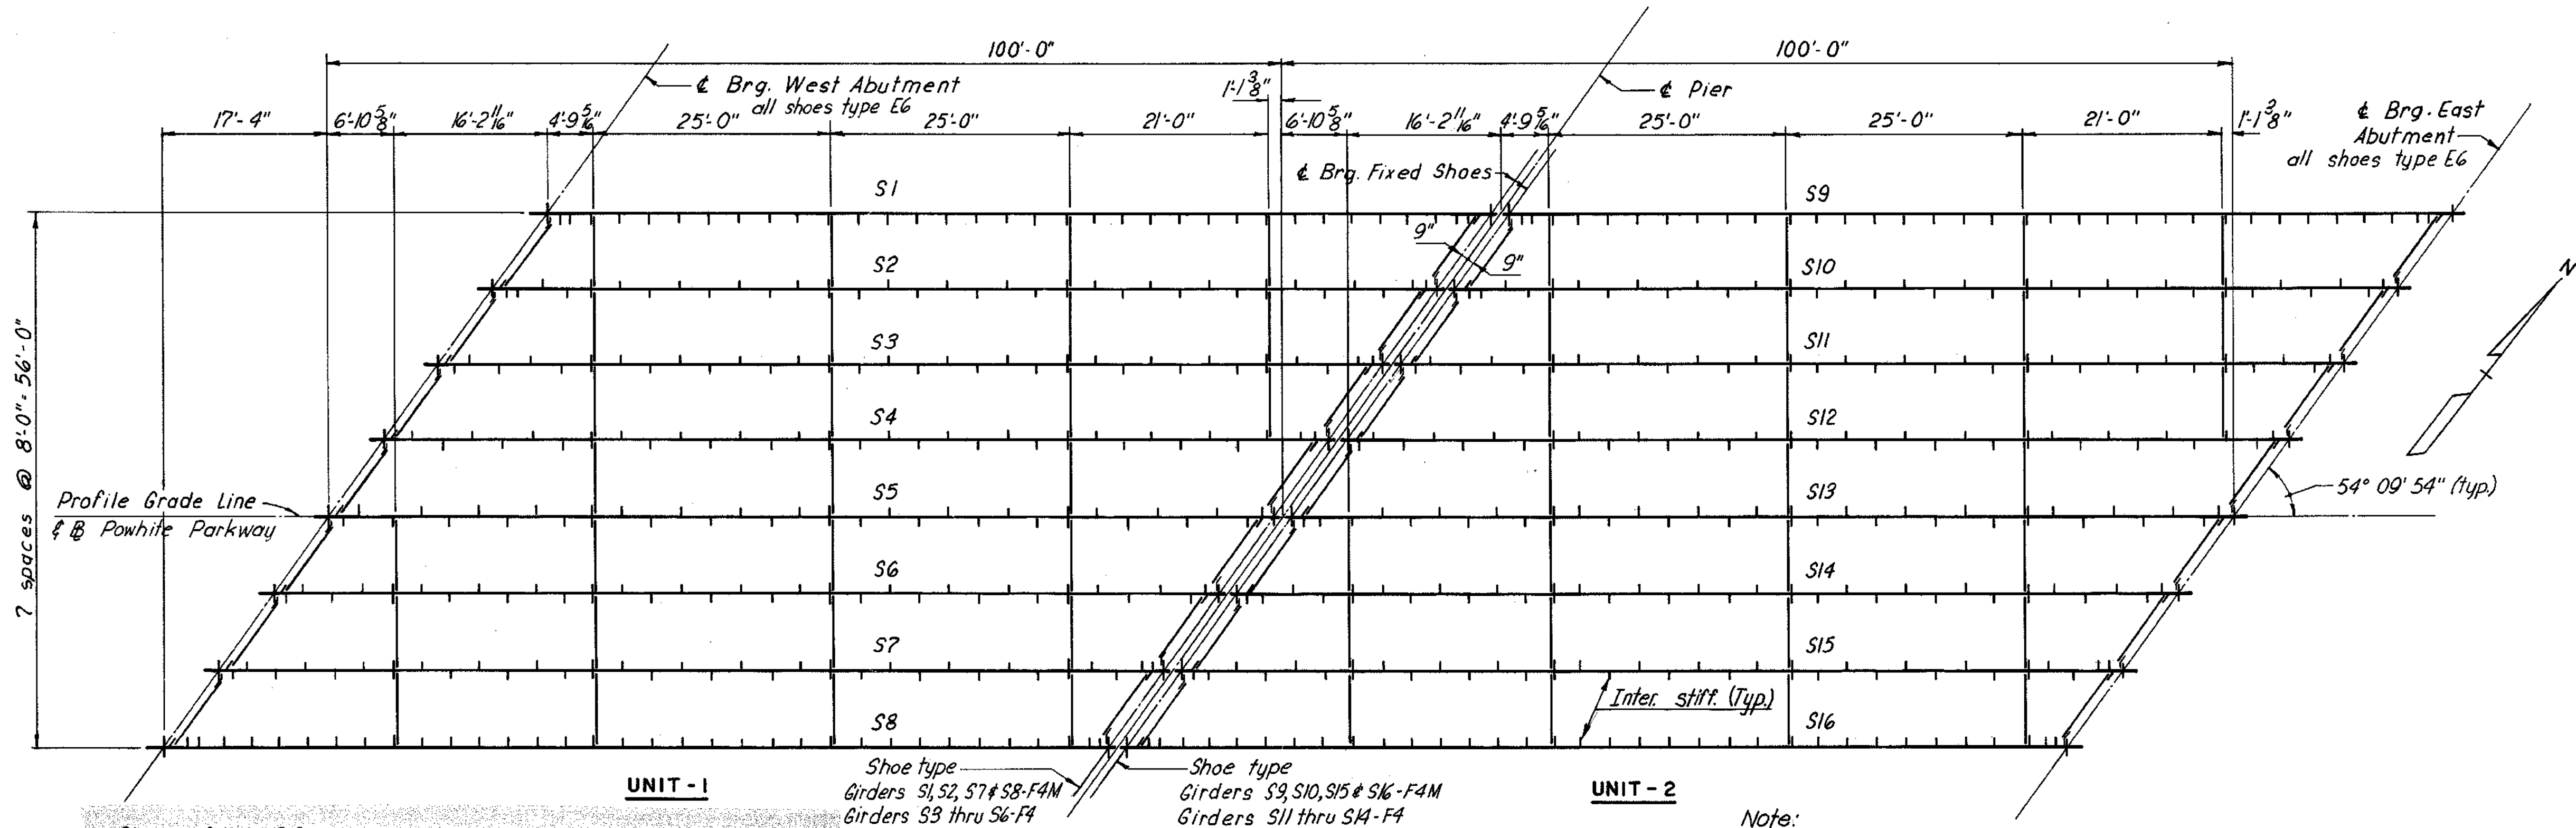

CAMBER SCHEDULE							
STR.	1/4 L	1/2 L	3/4 L	STR.	1/4 L	1/2 L	3/4 L
S1	2 5/8"	3 1/2"	2 5/8"	S9	2 5/8"	3 1/2"	2 5/8"
S2	2 5/8"	3 1/2"	2 5/8"	S10	2 5/8"	3 1/2"	2 5/8"
S3	2 5/8"	3 1/2"	2 5/8"	S11	2 5/8"	3 1/2"	2 5/8"
S4	2 5/8"	3 1/2"	2 5/8"	S12	2 5/8"	3 1/2"	2 5/8"
S5	2 5/8"	3 1/2"	2 5/8"	S13	2 5/8"	3 1/2"	2 5/8"
S6	2 5/8"	3 1/2"	2 5/8"	S14	2 5/8"	3 1/2"	2 5/8"
S7	2 5/8"	3 1/2"	2 5/8"	S15	2 5/8"	3 1/2"	2 5/8"
S8	2 5/8"	3 1/2"	2 5/8"	S16	2 5/8"	3 1/2"	2 5/8"

**NOTE TO FABRICATOR:**  
The above stringers shall be fabricated with an upward camber amounting to the tabulated value.  
This will provide approximate compensation for deflection under full dead load and for conformity with finished grade.  
Dimensions are in inches.


SHOE SCHEDULE			
EXPANSION SHOES		FIXED SHOES	
TYPE	NO. REQD.	TYPE	NO. REQD.
E6	16	F4	8
		F4M	8

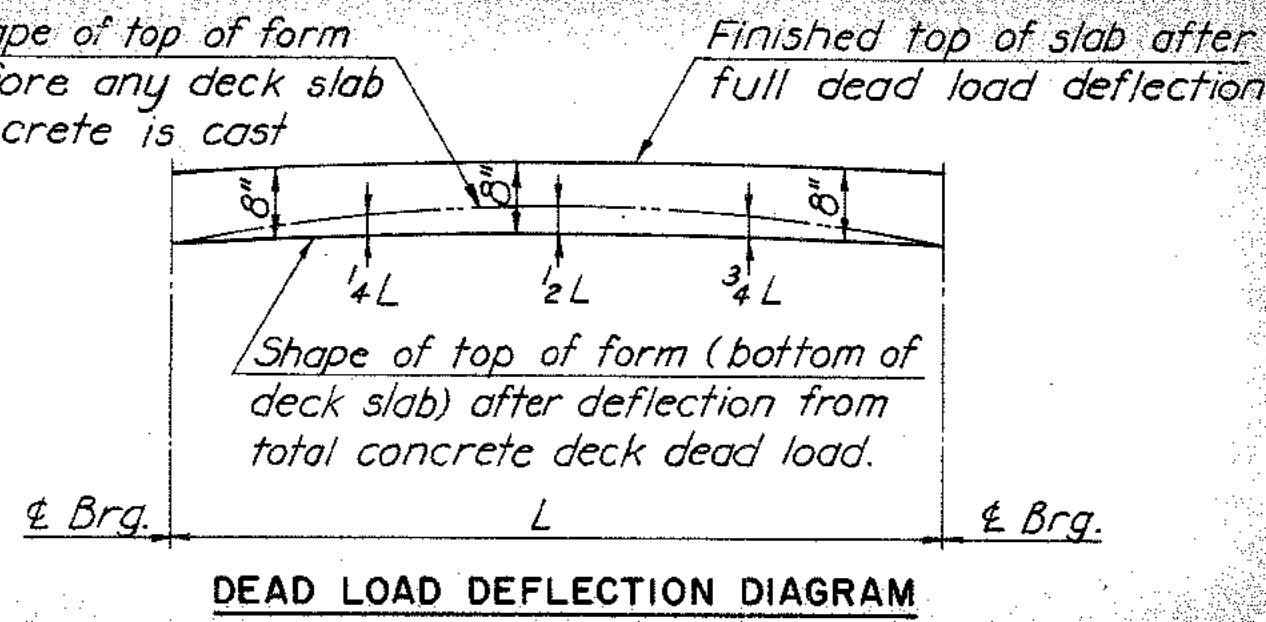



DEFLECTION SCHEDULE					
STR.	1/4 L	1/2 L	STR.	1/4 L	1/2 L
S1	1 1/2"	2 5/8"	S9	1 1/2"	2 5/8"
S2	1 1/2"	2 5/8"	S10	1 1/2"	2 5/8"
S3	1 1/2"	2 5/8"	S11	1 1/2"	2 5/8"
S4	1 1/2"	2 5/8"	S12	1 1/2"	2 5/8"
S5	1 1/2"	2 5/8"	S13	1 1/2"	2 5/8"
S6	1 1/2"	2 5/8"	S14	1 1/2"	2 5/8"
S7	1 1/2"	2 5/8"	S15	1 1/2"	2 5/8"
S8	1 1/2"	2 5/8"	S16	1 1/2"	2 5/8"

**NOTE TO CONTRACTOR:**  
The above deflections are those anticipated to occur in the stringer upon placement of the total concrete deck dead load.  
In practice, the stringers in place are not likely to have the exact camber to compensate for these deflections during construction. The residual amounts shall be provided for by adjusting forms to vary the thickness of the concrete bolster between the bottom of the slab and the top of stringer, without alteration of the slab thickness.

MADE	BY	DATE	NO.	REVISION	BY	DATE
	ILM	5-9-67				
CHECKED	DEK	10-24-67	1	As Built	JPC	3-73
IN CHARGE	PRY					

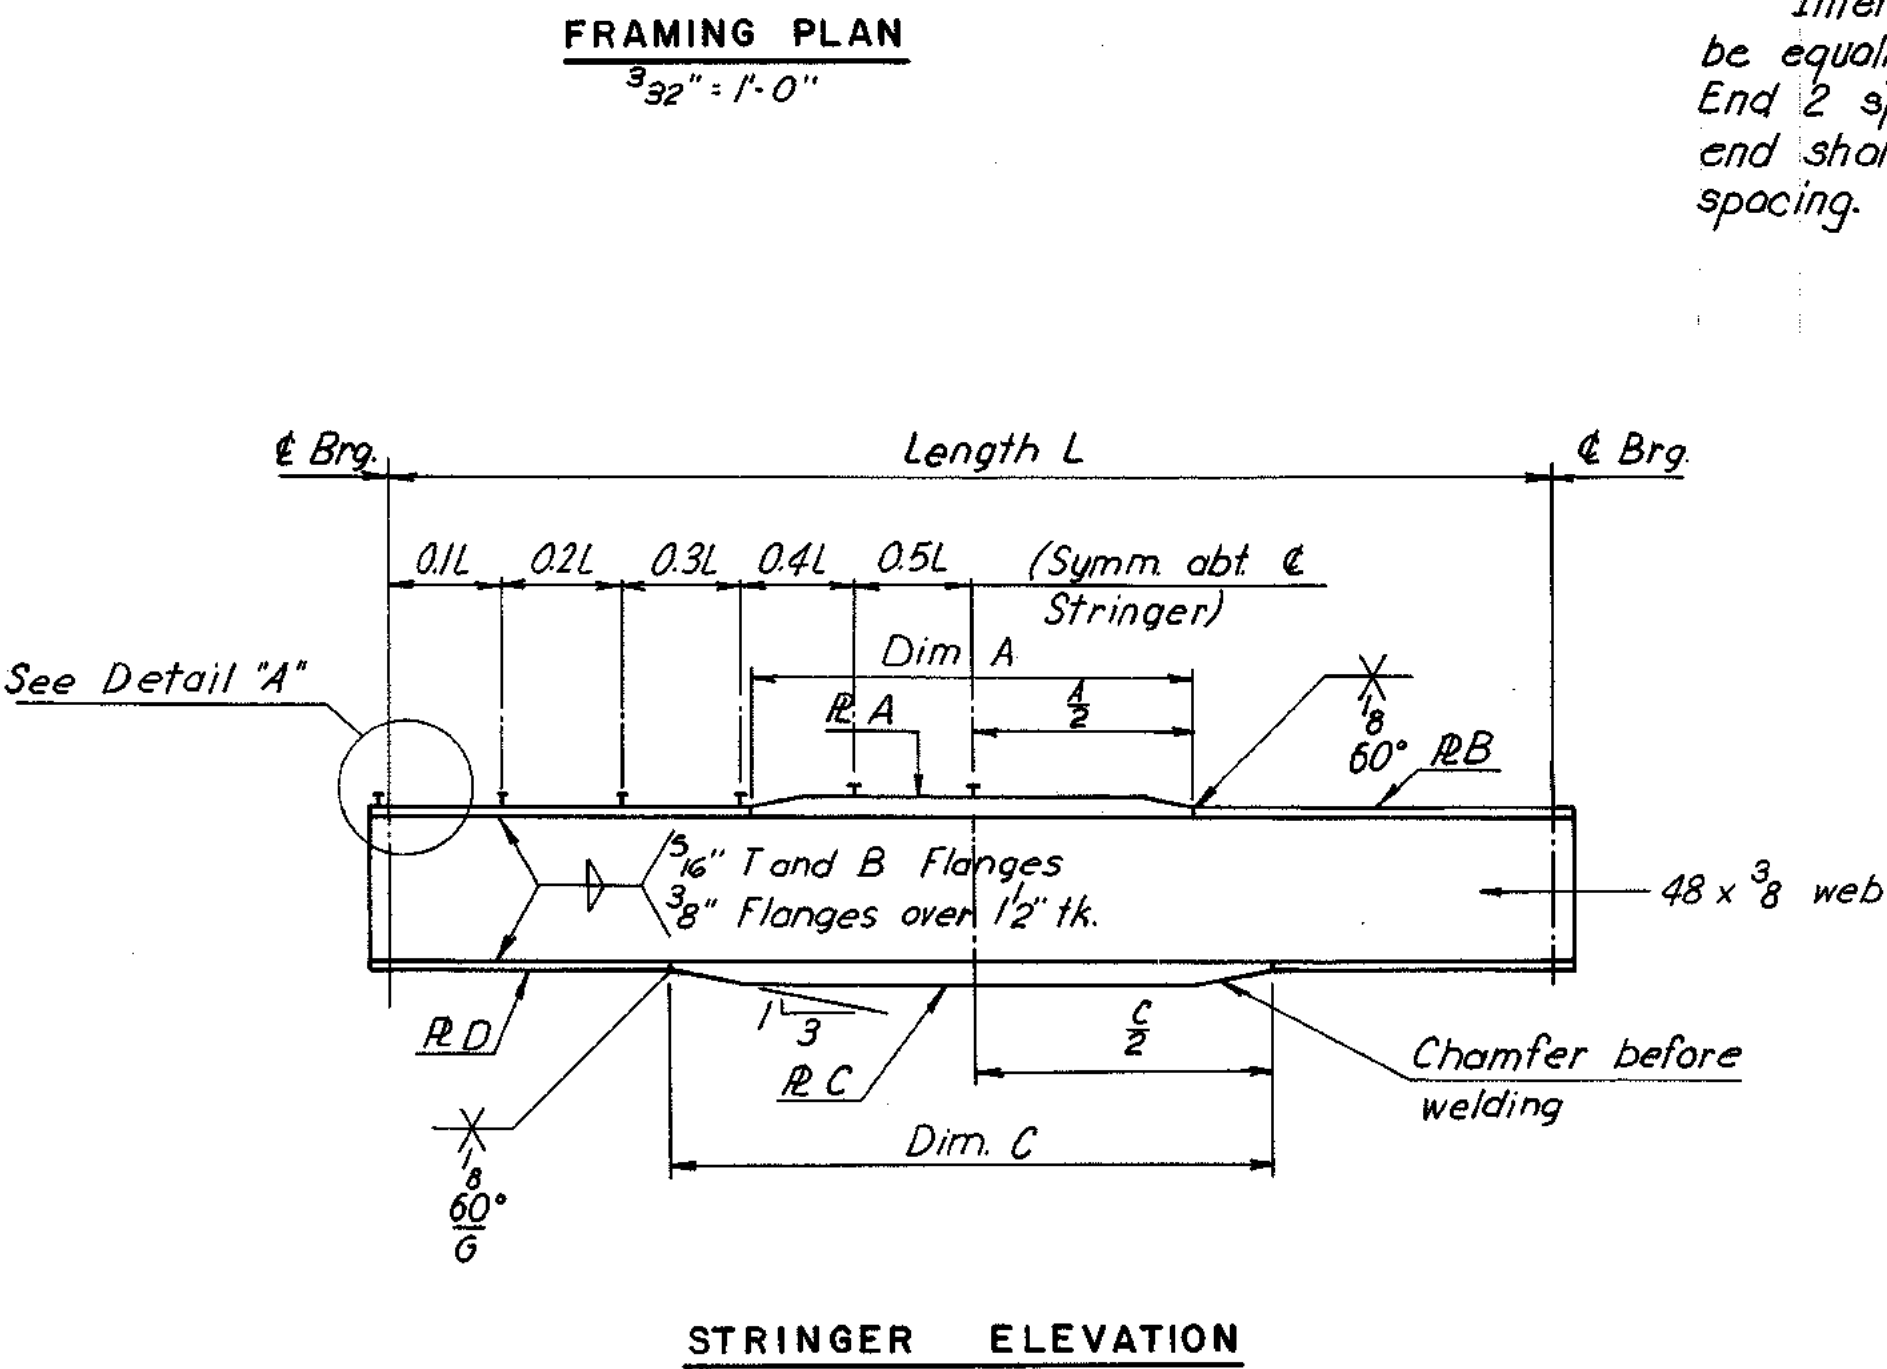


STRINGER SCHEDULE												
STR.	LENGTH ¢ BRG. TO ¢ BRG.	R A	DIM. A	R B	R C	DIM. C	R D	SHEAR STUD SPACING				
								0.1L	0.2L	0.3L	0.4L	0.5L
S1#S9	99'-0 3/8"	16 x 1 1/4	52'-0"	16 x 7/8	18 x 2	60'-0"	18 x 1 3/8	10 1/2"	12 1/2"	14 1/2"	20"	23"
S2#S10	99'-0 3/8"	16 x 1/8	54'-0"	16 x 3/4	18 x 1 3/8	62'-0"	18 x 1 1/4	11"	12 1/2"	15 1/2"	18 1/2"	23"
S3#S11	99'-0 3/8"	16 x 1/8	54'-0"	16 x 3/4	18 x 1 3/8	62'-0"	18 x 1 1/4	11"	12 1/2"	15 1/2"	18 1/2"	23"
S4#S12	99'-0 3/8"	16 x 1/8	54'-0"	16 x 3/4	18 x 1 3/8	62'-0"	18 x 1 1/4	11"	12 1/2"	15 1/2"	18 1/2"	23"
S5#S13	99'-0 3/8"	16 x 1/8	54'-0"	16 x 3/4	18 x 1 3/8	62'-0"	18 x 1 1/4	11"	12 1/2"	15 1/2"	18 1/2"	23"
S6#S14	99'-0 3/8"	16 x 1/8	54'-0"	16 x 3/4	18 x 1 3/8	62'-0"	18 x 1 1/4	11"	12 1/2"	15 1/2"	18 1/2"	23"
S7#S15	99'-0 3/8"	16 x 1/8	54'-0"	16 x 3/4	18 x 1 3/8	62'-0"	18 x 1 1/4	11"	12 1/2"	15 1/2"	18 1/2"	23"
S8#S16	99'-0 3/8"	16 x 1 1/4	52'-0"	16 x 7/8	18 x 2	60'-0"	18 x 1 3/8	10 1/2"	12 1/2"	14 1/2"	20"	23"

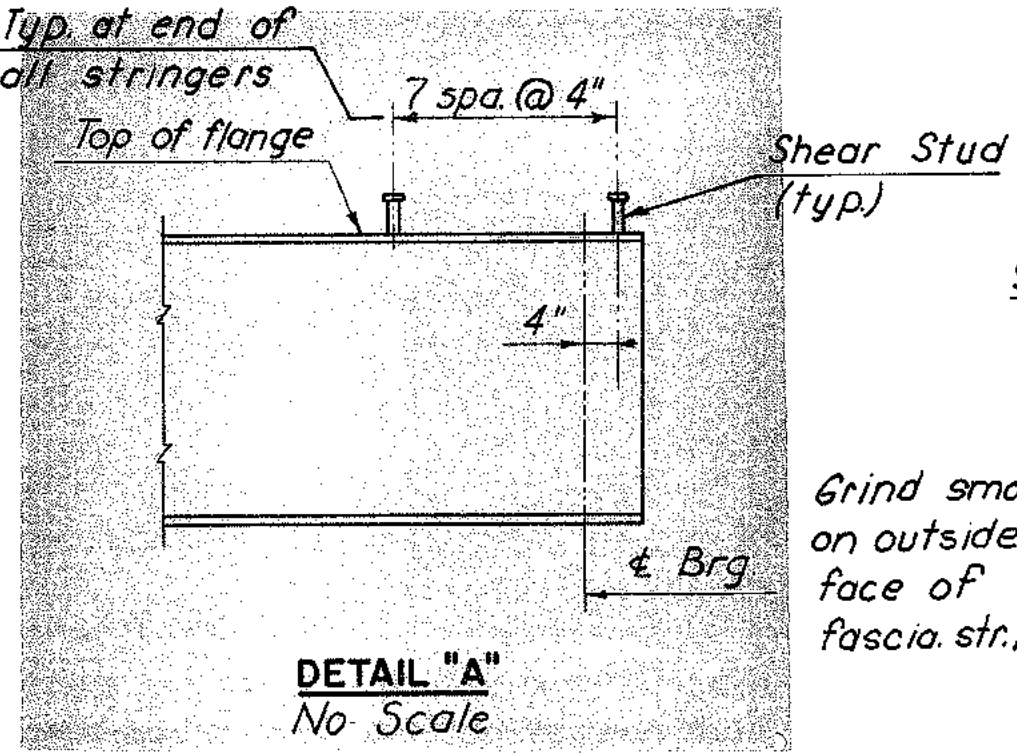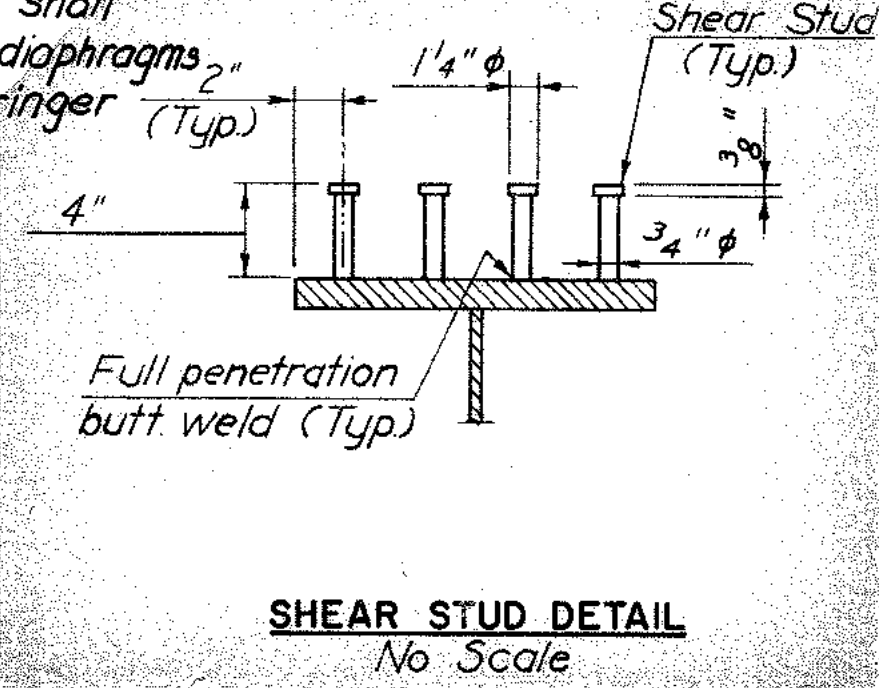

**SHEAR STUD NOTE:**  
Capacity = 3,400 lbs. per stud.  
The contractor may, if he elects, use three 1/2" diameter studs at the same longitudinal spacing in lieu of the four 1/2" diameter studs shown.  
Stud rows shall be placed parallel to the main deck reinforcing.  
Shear stud spacing shown is maximum spacing.

**AS BUILT**

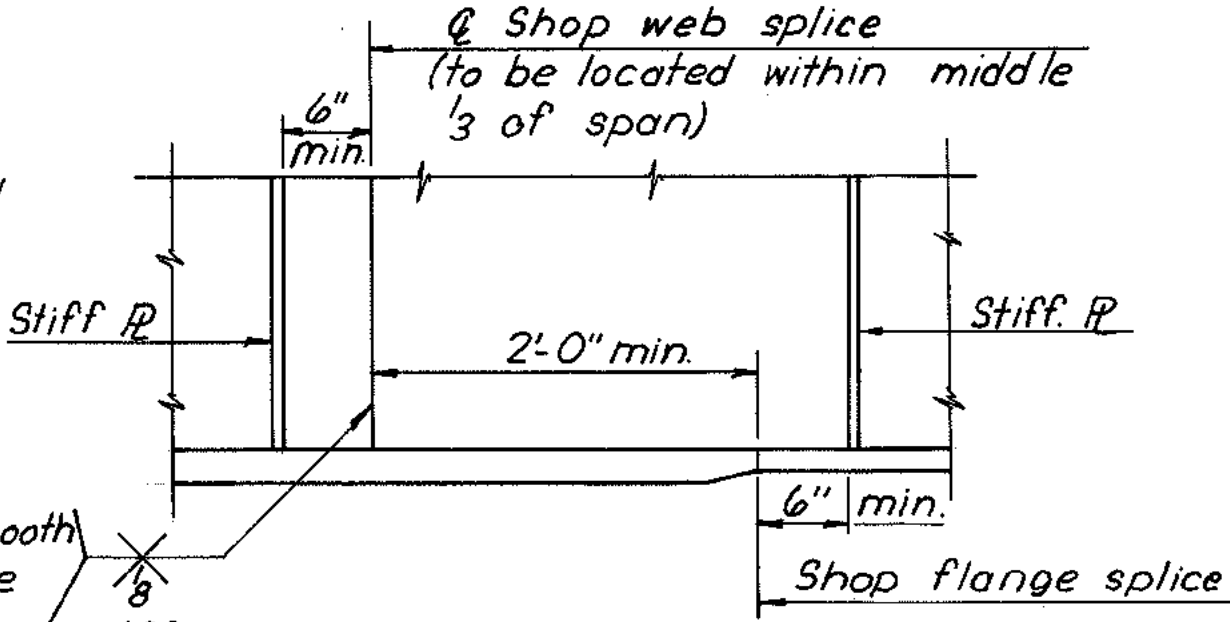


**RICHMOND METROPOLITAN AUTHORITY**  
**RICHMOND EXPRESSWAY SYSTEM**  
**POWHITE PARKWAY**  
**POWHITE PARKWAY OVER**  
**CHIPPENHAM PARKWAY**  
**BRIDGE B-04**  
**FRAMING PLAN**


HOWARD, NEEDLES, TAMMEN & BERGENDOFF consulting engineers NEW YORK ALEXANDRIA KANSAS CITY	SCALE: AS SHOWN CONTRACT NO.: 2 SHEET NO. 8 OF 14
---	---




RICHMOND EXPRESSWAY SYSTEM			
SECTION	PROJECT	SHEET NO.	TOTAL SHEETS
2	POWHITE PARKWAY	126	188

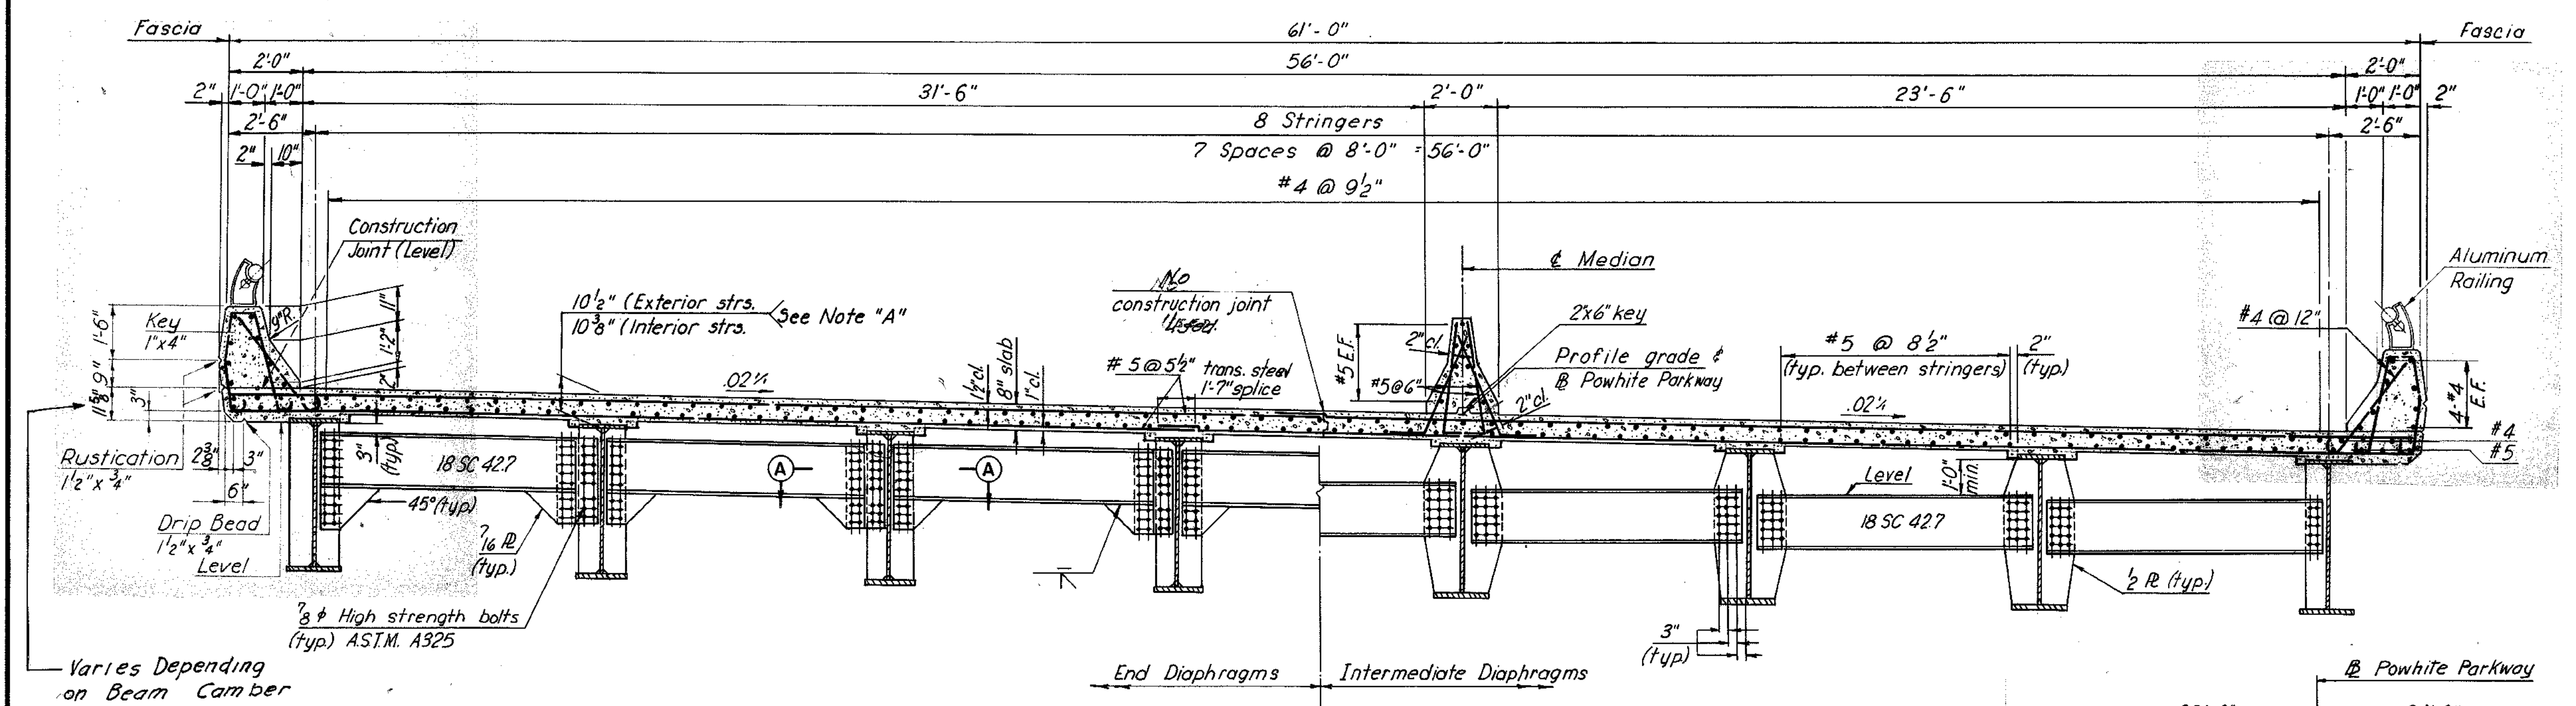


TYPICAL CROSS SECTION  
Scale 3/8" = 1'-0"

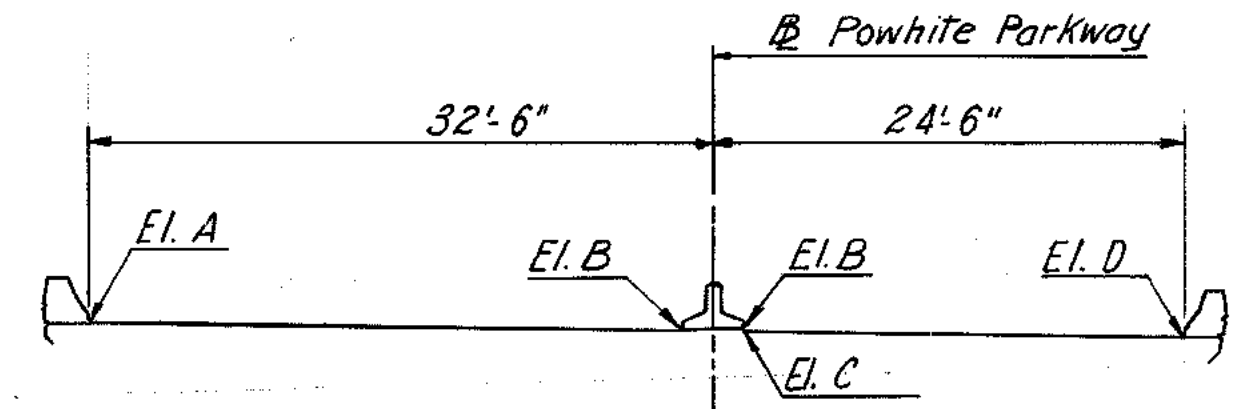


NOTE "A":  
Dimension shown is measured from top of web to top of slab at the intersection of the centerline of stringer and the centerline of bearing. This dimension may be varied between bearings as required to care for variation in camber, except that no portion of the stringer flange may fall within the 8" slab.

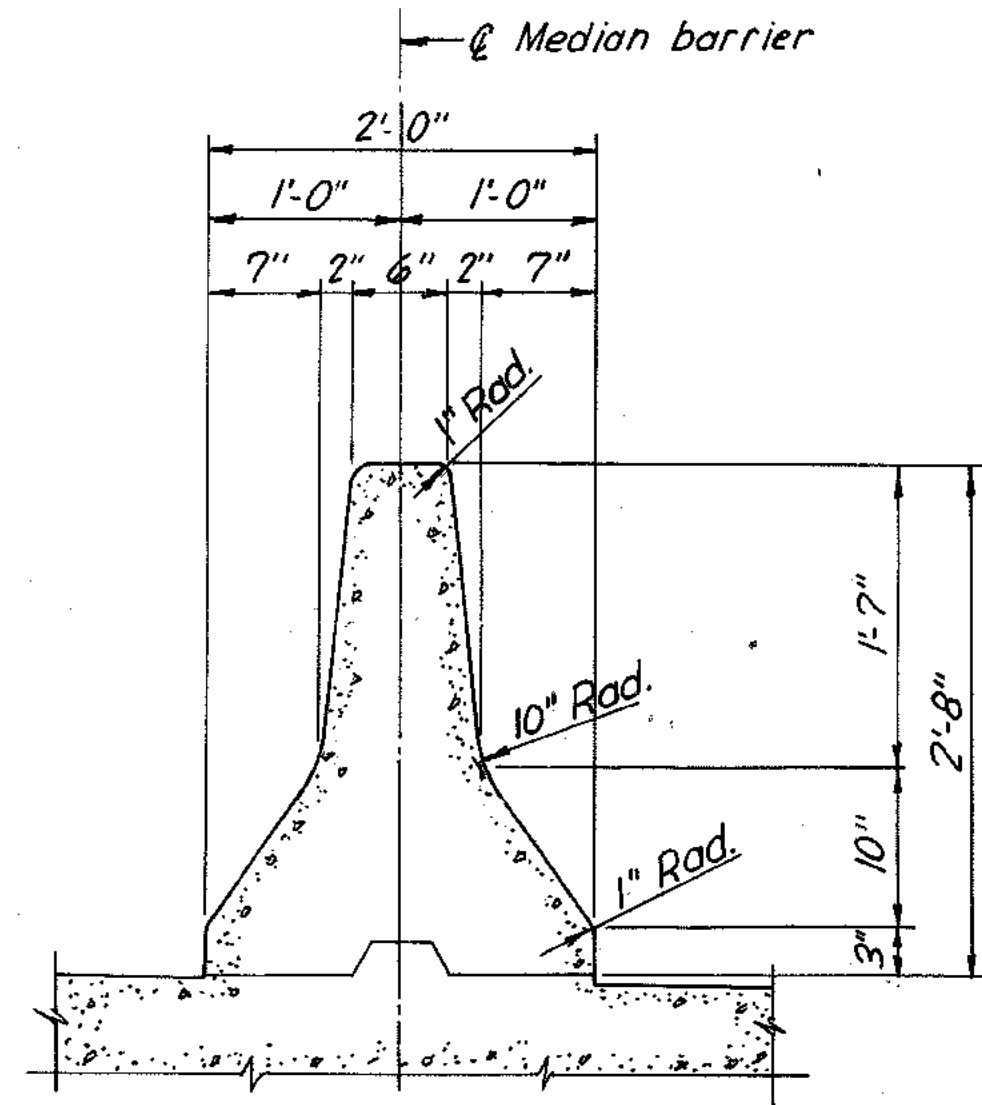


TYPICAL MEDIAN SECTION  
Scale 1" = 1'-0"

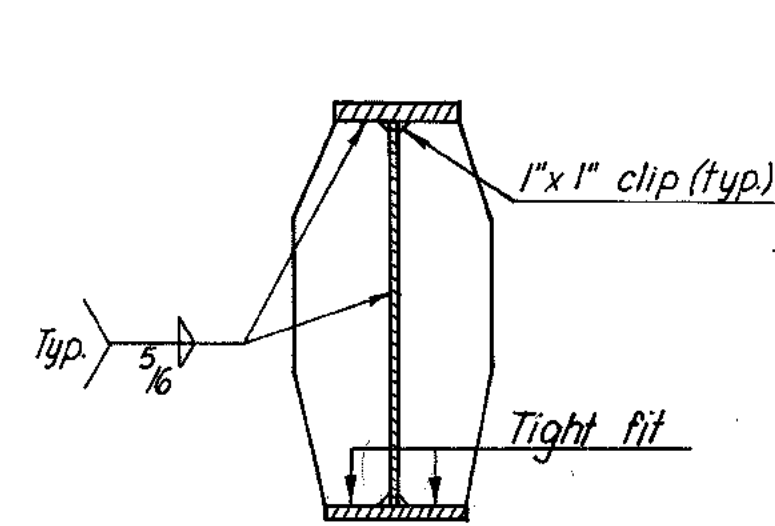

INTERIOR DIAPHRAGM  
CONNECTION PLATE  
Scale 1/2" = 1'-0"

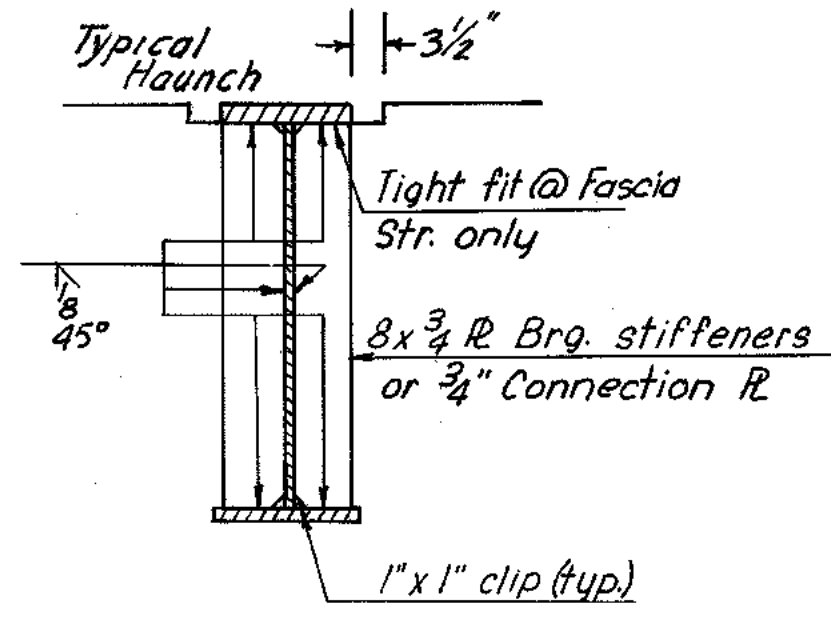


END DIAPHRAGM CONNECTION PLATE  
AND/OR BEARING STIFFENERS

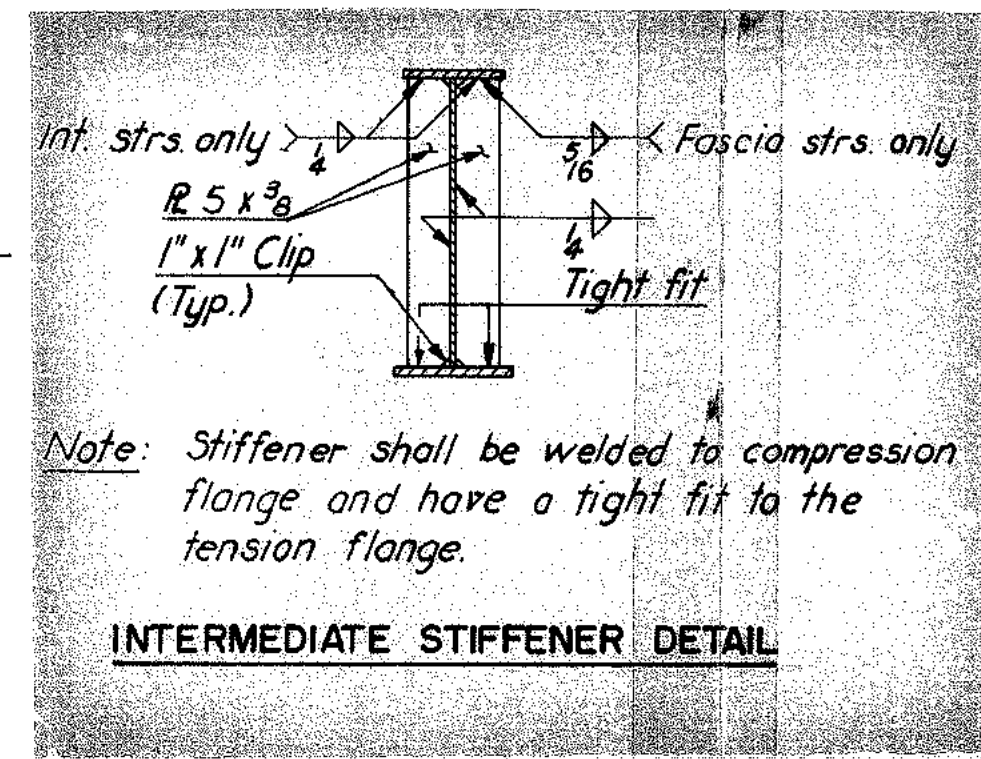

Note: Stiffener shall be welded to compression flange and have a tight fit to the tension flange.

INTERMEDIATE STIFFENER DETAIL

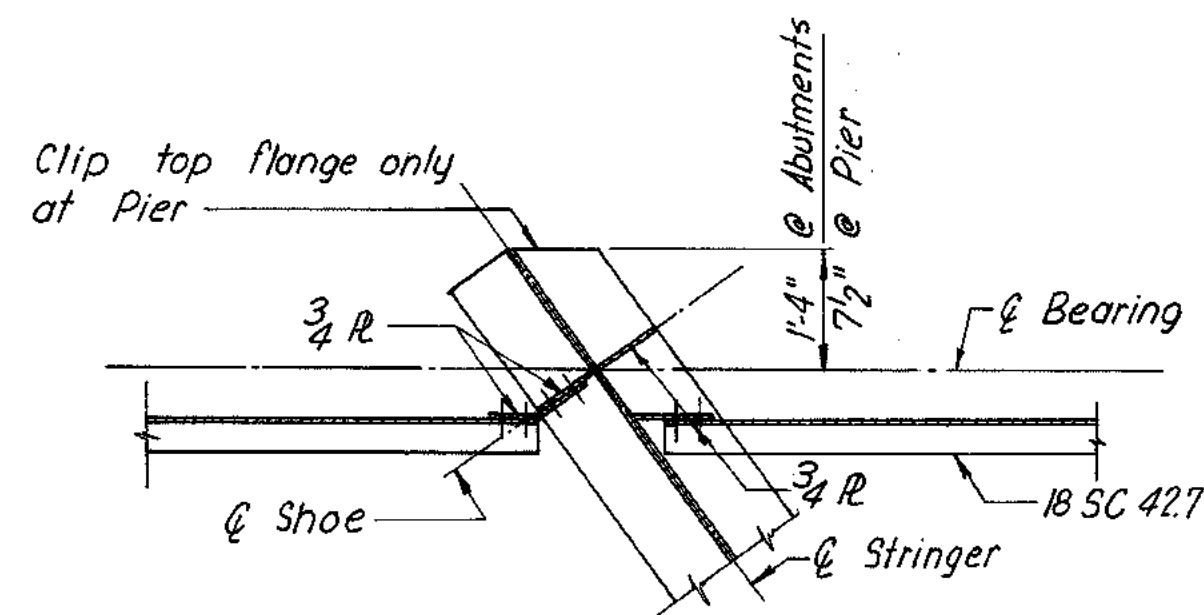

SECTION A-A  
Scale 1/2" = 1'-0"

GUTTER LINE ELEVATION				
STATION	EL. A	EL. B	EL. C	EL. D
31+60.00	178.17	177.54	177.50	177.03
70.00	178.25	177.62	177.58	177.11
76.04	—	—	—	177.16
80.00	178.33	177.70	177.66	177.19
90.00	178.39	177.76	177.72	177.25
93.01	—	—	177.73	—
94.45	—	177.78	—	—
32+00.00	178.44	177.81	177.77	177.30
10.00	178.49	177.86	177.82	177.35
17.20	178.51	—	—	—
20.00	178.52	177.89	177.85	177.38
30.00	178.55	177.92	177.88	177.41
40.00	178.56	177.93	177.89	177.42
50.00	178.56	177.93	177.89	177.42
60.00	178.56	177.93	177.89	177.42
70.00	178.54	177.91	177.87	177.40
77.89	—	—	—	177.39
80.00	178.52	177.89	177.85	177.38
90.00	178.48	177.85	177.81	177.34
94.86	—	—	177.79	—
96.30	—	177.83	—	—
33+00.00	178.44	177.81	177.77	177.30
10.00	178.38	177.75	177.71	177.24
19.05	178.33	—	—	—
20.00	178.32	177.69	177.65	177.18
30.00	178.24	177.61	177.57	177.10
40.00	178.16	177.53	177.49	177.02
50.00	178.06	177.43	177.39	176.92
60.00	177.96	177.33	177.29	176.82
70.00	177.85	177.22	177.18	176.71
79.74	—	—	—	176.58
80.00	177.72	177.09	177.05	176.58
90.00	177.59	176.96	176.92	176.45
96.71	—	—	176.83	—
98.51	—	176.85	—	—
34+00.00	177.45	176.82	176.78	176.31
10.00	177.29	176.66	176.62	176.15
20.00	177.13	176.50	176.46	175.99
20.90	177.12	—	—	—
30.00	176.95	176.32	176.28	175.81

AS BUILT

RICHMOND METROPOLITAN AUTHORITY  
RICHMOND EXPRESSWAY SYSTEM  
POWHITE PARKWAY  
POWHITE PARKWAY OVER  
CHIPPENHAM PARKWAY  
BRIDGE B-04  
CROSS SECTION

HOWARD, NEEDLES, TAMMEN & BERGENDOFF  
consulting engineers  
NEW YORK ALEXANDRIA KANSAS CITY  
SCALE: AS SHOWN  
CONTRACT NO.: 2  
SHEET NO. 9 OF 14

MADE	BY	DATE	NO.	REVISION	BY	DATE
DEK	10-67	1	Parapet	EVR	12-70	
IN CHARGE						







## **Bridge 5**

**Single Track of Railroad operated by Norfolk Southern Railroad  
Over**

**Southbound Powhite Parkway “Cash” Lanes, Southbound Powhite Parkway “Express” Lanes  
and a Single Lane Ramp from Westbound Forest Hill Ave. to Northbound Powhite Parkway**

**Record Set Plans**





RICHMOND EXPRESSWAY SYSTEM			
SECTION	PROJECT	SHEET NO.	TOTAL SHEETS
2	POWHITE PARKWAY	132	188

# GENERAL NOTES:

## SPECIFICATIONS:

A.R.E.A., current.  
WELDING - 1969 Standard Specifications for welded Highway and Railway Bridges of the American Welding Society.

## CONTRACT SPECIAL PROVISIONS

Specifications and Contract Special Provisions referred to above are necessary to make these plans complete.

## LIVE LOAD:

Cooper's E-80

## IMPACT:

Diesel impact plus rolling effect. Concrete Slab Derailment Impact:

$$LL \times \frac{LL}{DL + LL}$$

Structural Steel Derailment Impact:

$$0.9 \times LL$$

## DATUM:

CITY OF RICHMOND

## TEMPERATURE:

The normal temperature referred to on the plan is 68°F. The temperature range for movement is 0°F, to 120°F.

## DIMENSIONS:

All dimensions are measured horizontally and vertically unless otherwise noted.

## EXCAVATION:

Excavation below subgrade and cut slope template shall be classified as Structure Excavation. All excavation above these limits shall be classified as Regular Excavation and is not included in the Structural Quantities.

## FOUNDATIONS:

Footings shall rest on firm material. Foundation material shall be kept dry and special attention is called to Section 401.05 of the General Specifications, and to the Contract Special Provisions, concerning preparation of foundations for footings.

## CONCRETE NOTES:

Concrete in superstructure shall be Class A4 with a maximum slump of 2 1/2 inches. All other concrete shall be Class A3. All exposed edges and corners shall have a 3/4" chamfer or fillet unless otherwise noted. Care in the method of vibration, the use of low-slump concrete, and/or other means shall be employed to prevent downgrade movement of newly placed slab concrete. (When gradient is over 2%).

Finishing concrete surfaces: See the Standard Architectural Detail Sheets and the Contract Special Provisions for types and details.

All reinforcing steel shall conform to A.S.T.M. A615, Grade 40. All reinforcing bar dimensions on the detailed drawings are to centers of bars unless otherwise noted. Clear distance between reinforcing steel and face of concrete shall be as noted on the plans. All bar laps shall be 30 diameters of the smaller diameter bar unless otherwise noted.

## STEEL NOTES:

Structural steel shall conform to A.S.T.M. Specification A36 except as Noted.

All Field connections shall be made with high strength bolts. High strength bolts shall be 3/4" diameter unless otherwise noted and shall conform to A.S.T.M. Specification A-325.

## BENCH MARK:

See Reference Ties and Field Control Data sheet in highway plans.

F-17(Copper Weld Rod) Elevation 139.03

F-20(Copper Weld Rod) Elevation 145.80

INDEX	
NO.	DESCRIPTION
1	General Plan and Elevation
2	Quantities and Miscellaneous Det.
3	West Abutment Details
4	West Abutment and Drainage Details
5	East Abutment Details
6	East Abutment Details (I)
7	Pier Details (I)
8	Pier Details (2 & 3)
9	Framing Plan
10	Framing Plan
11	Girder Details
12	Superstructure Details
13	Deck Plans-Units 1 & 2
14	Deck Plans-Units 3 & 4
15	Deck Plans-Unit 5
16	Deck Plans-Unit 6
17	Shoe Details
18	Boring logs
19	Boring logs
20	Standard Aluminum Rail, Det.(Rail)
21	Standard Architectural Details.

Note: See sh. 2 for Slab Elevations and Estimated Quantities.

2 1/2" Cased Holes

**AS BUILT**

**RICHMOND METROPOLITAN AUTHORITY**  
**RICHMOND EXPRESSWAY SYSTEM**  
POWHITE PARKWAY

**SOUTHERN RAILWAY OVER**  
**POWHITE PARKWAY**  
BRIDGE B-05

## GENERAL PLAN & ELEVATION

HAYES, SEAY, MATTERN & MATTERN  
Associate Engineers


HOWARD, NEEDLES, TAMMEN & BERGENDOFF  
General Consultants

SCALE: AS SHOWN


CONTRACT NO.: C-2

SHEET NO. 1 OF 19


SOUTHERN RY. M.P. F-135

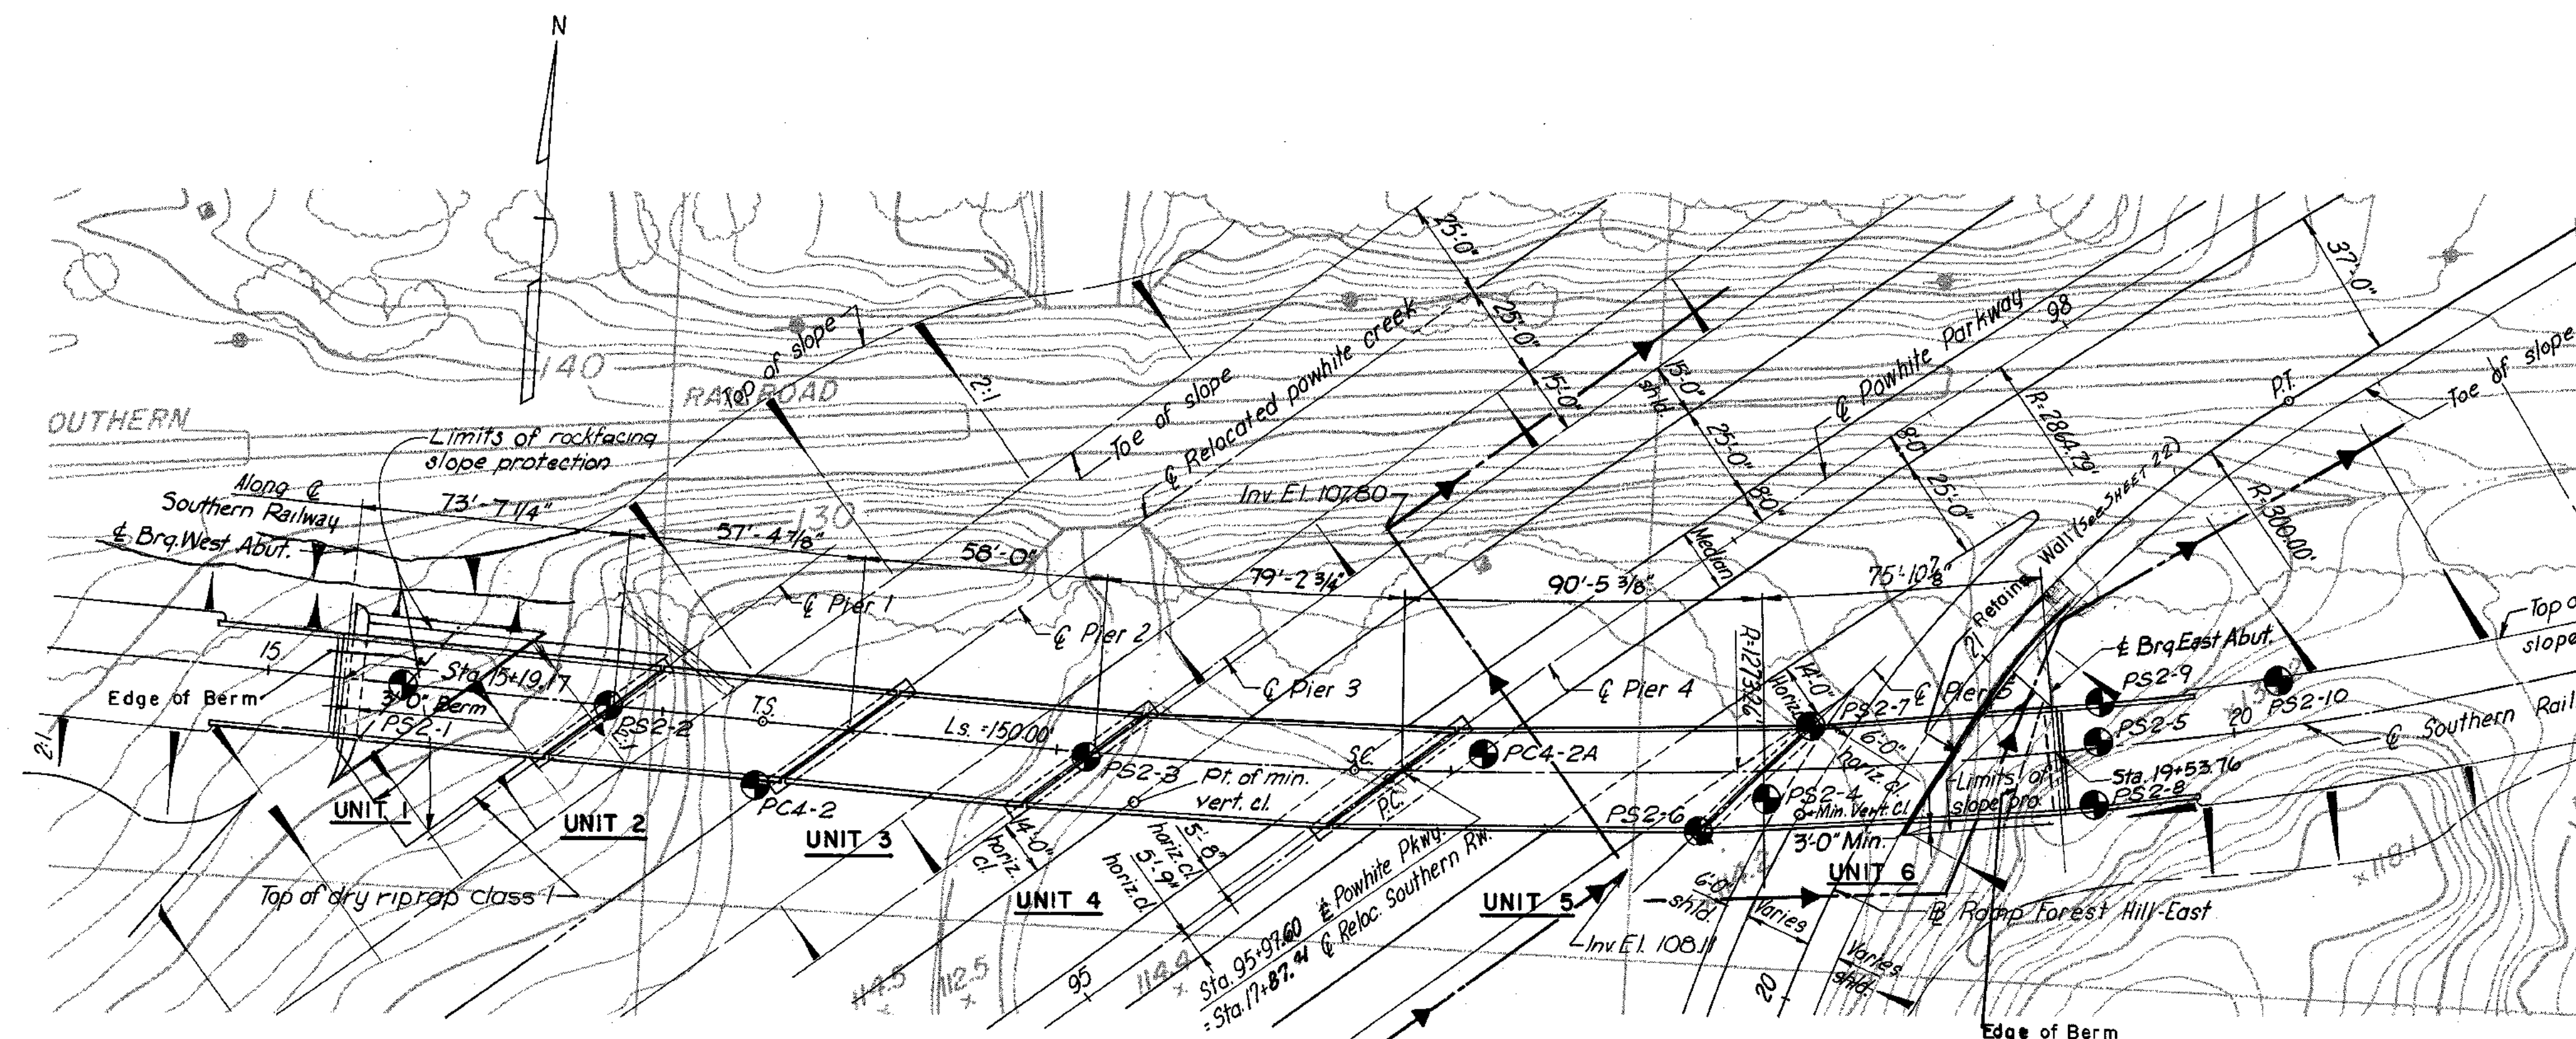


PLAN  
Scale 1"=30'-0"

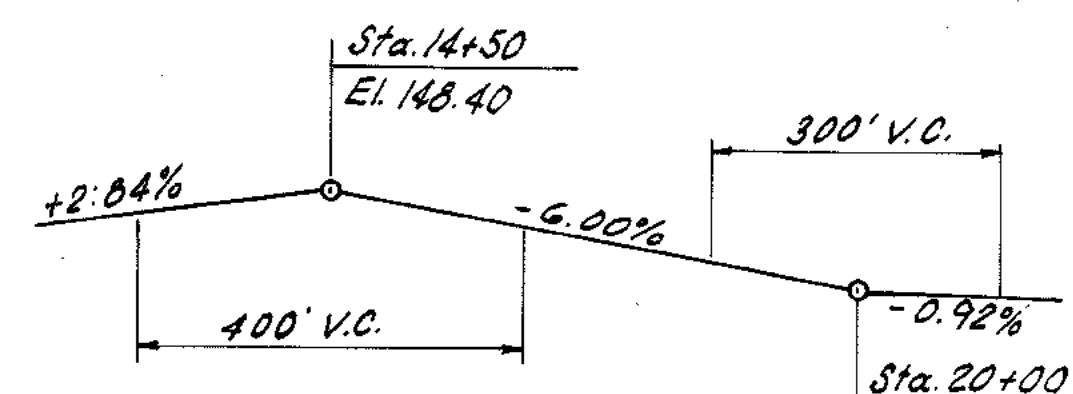


PROFILE GRADE  
RAMP F-E  
No Scale

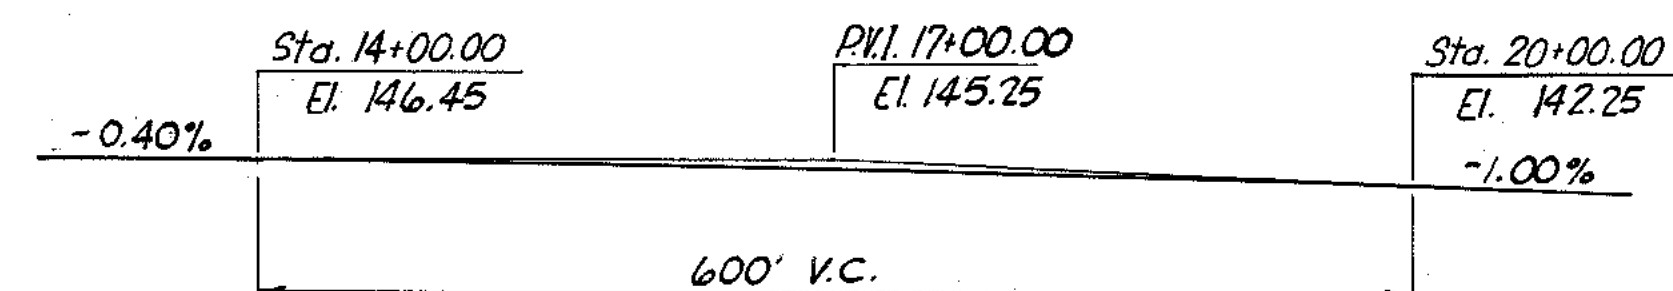


PROFILE GRADE  
SOUTHERN RAILWAY  
No Scale

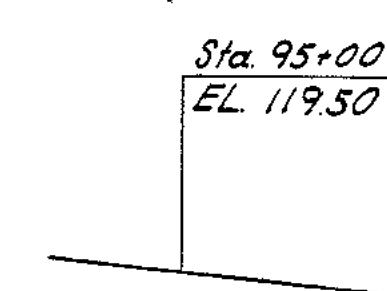

PROFILE GRADE  
POWHITE PARKWAY  
No Scale

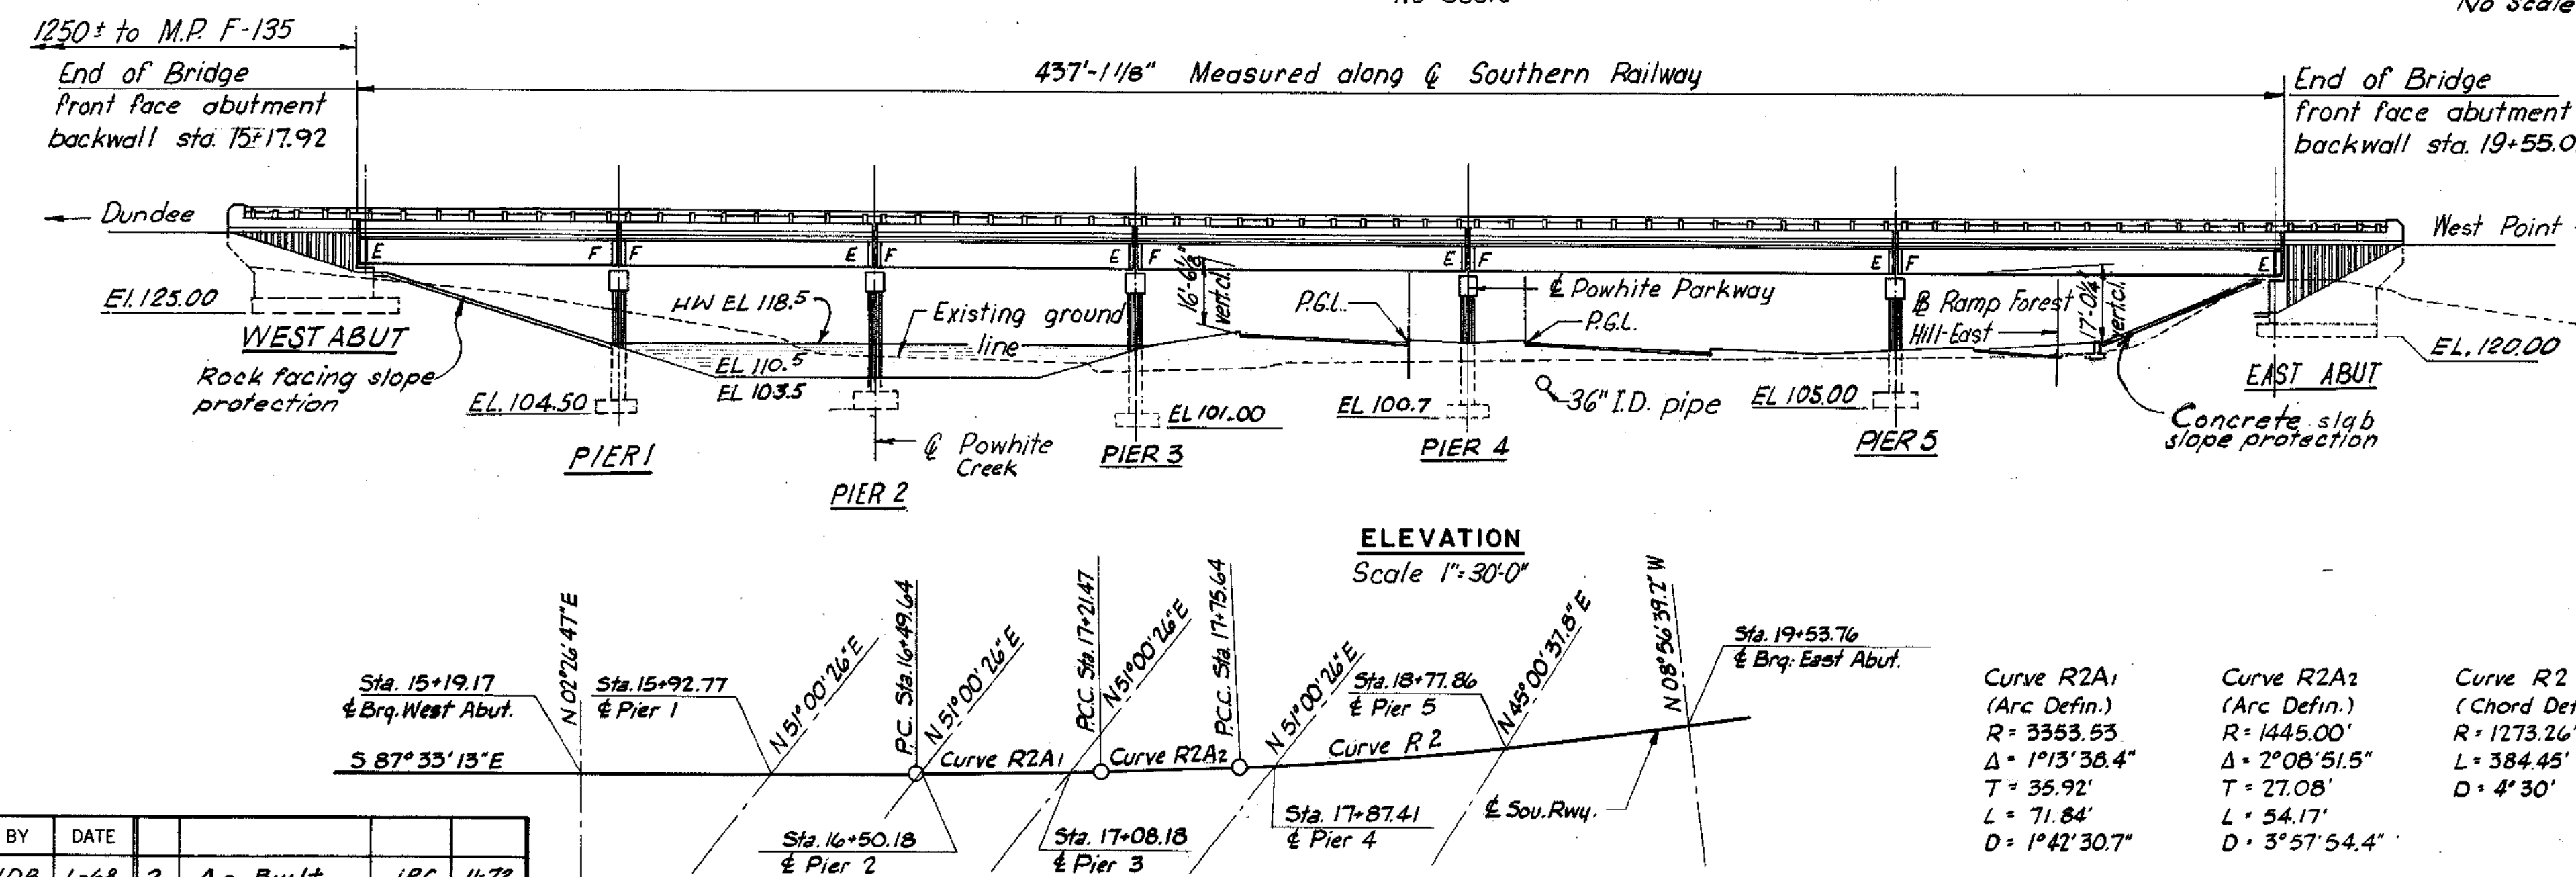







ELEVATION  
Scale 1"=30'-0"

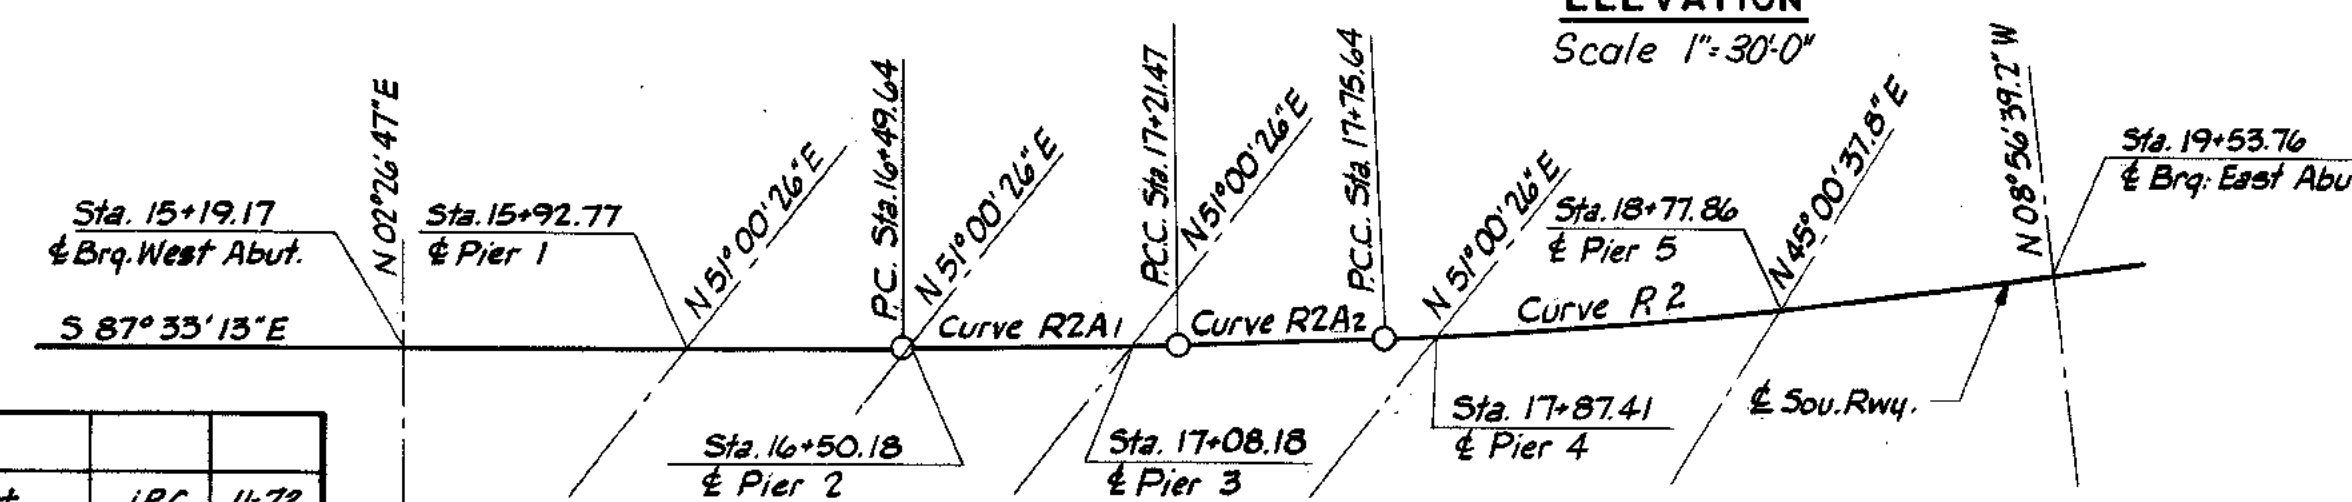

BRIDGE LAYOUT  
No Scale

BY	DATE	NO.	REVISION	BY	DATE
MADE	JDB 1-68	2	As Built	JRC	11-72
CHECKED	JGD 2-68	1	Dim. Unit 6 Brq. East	TEM	6-68
IN CHARGE	JGD				

RICHMOND EXPRESSWAY SYSTEM			
SECTION	PROJECT	SHEET NO.	TOTAL SHEETS
2	POWHITE PARKWAY	133	188

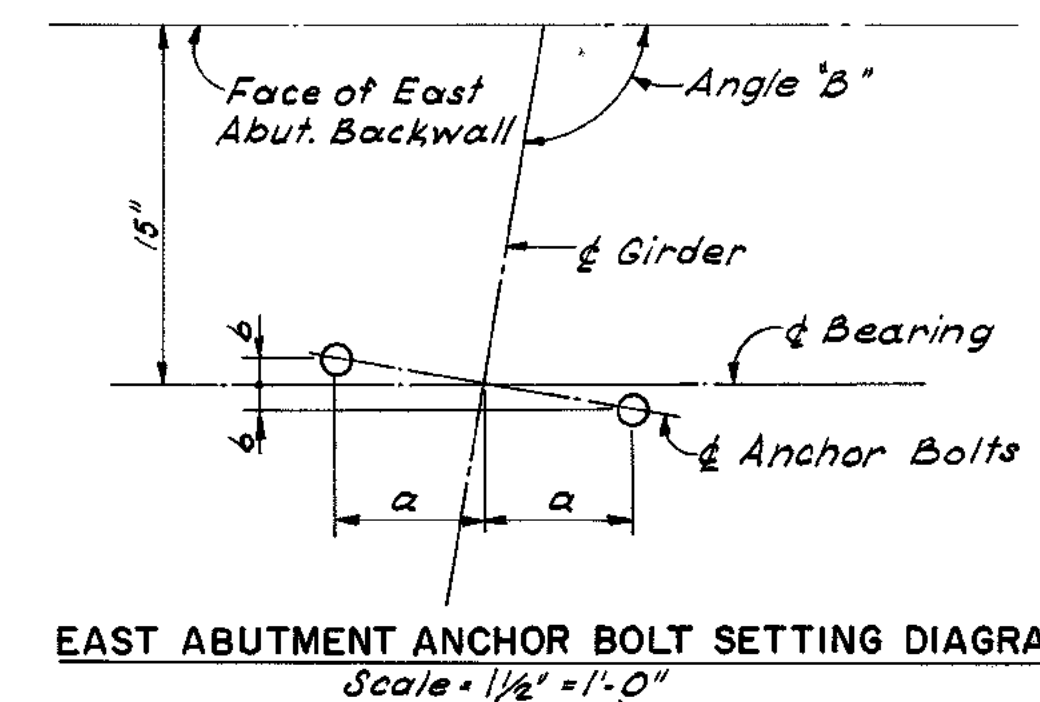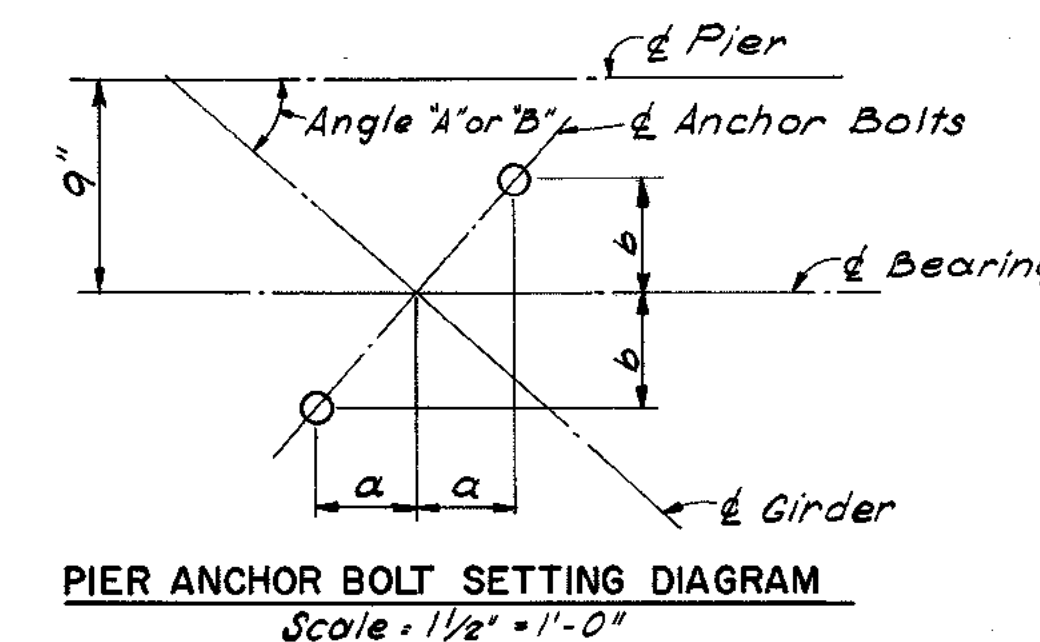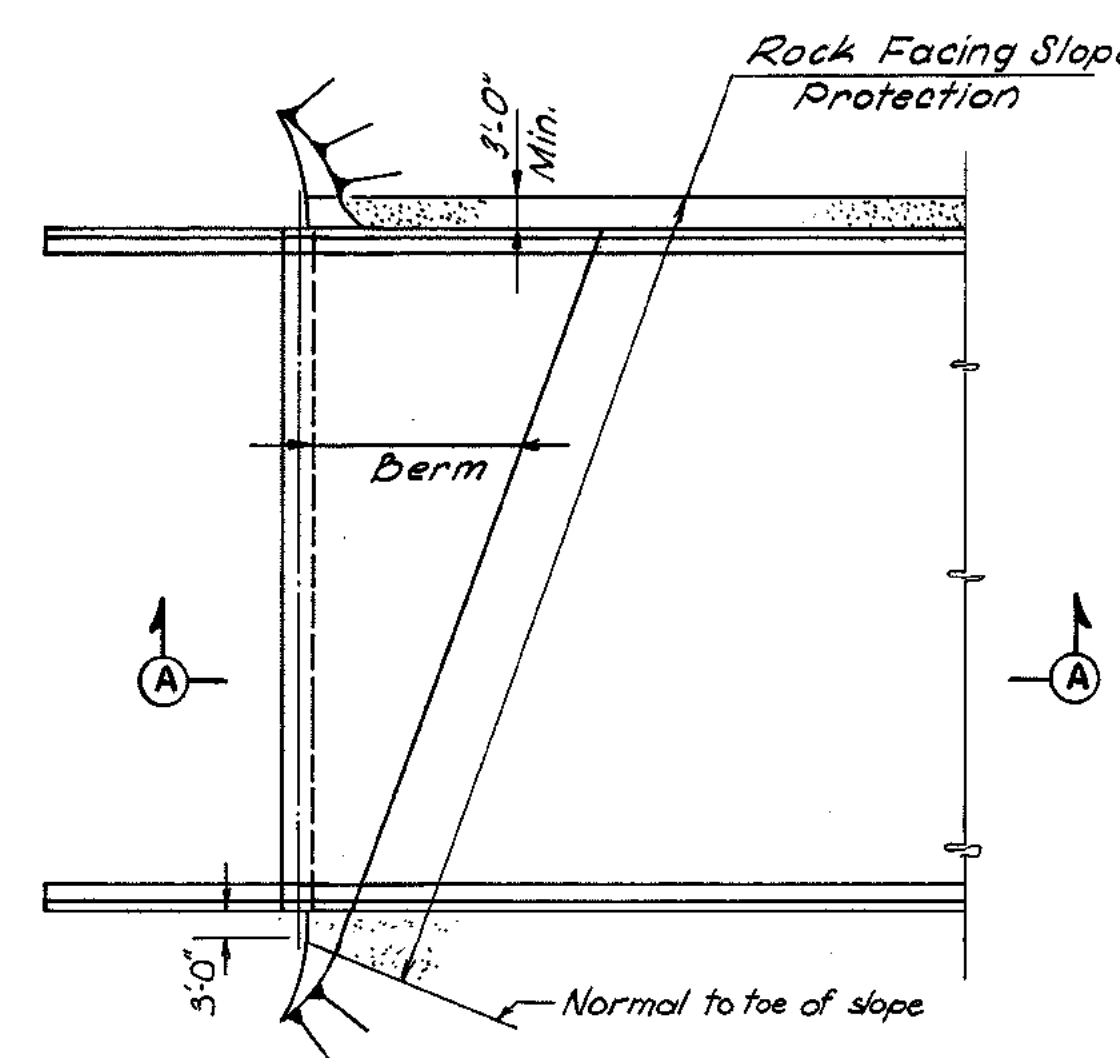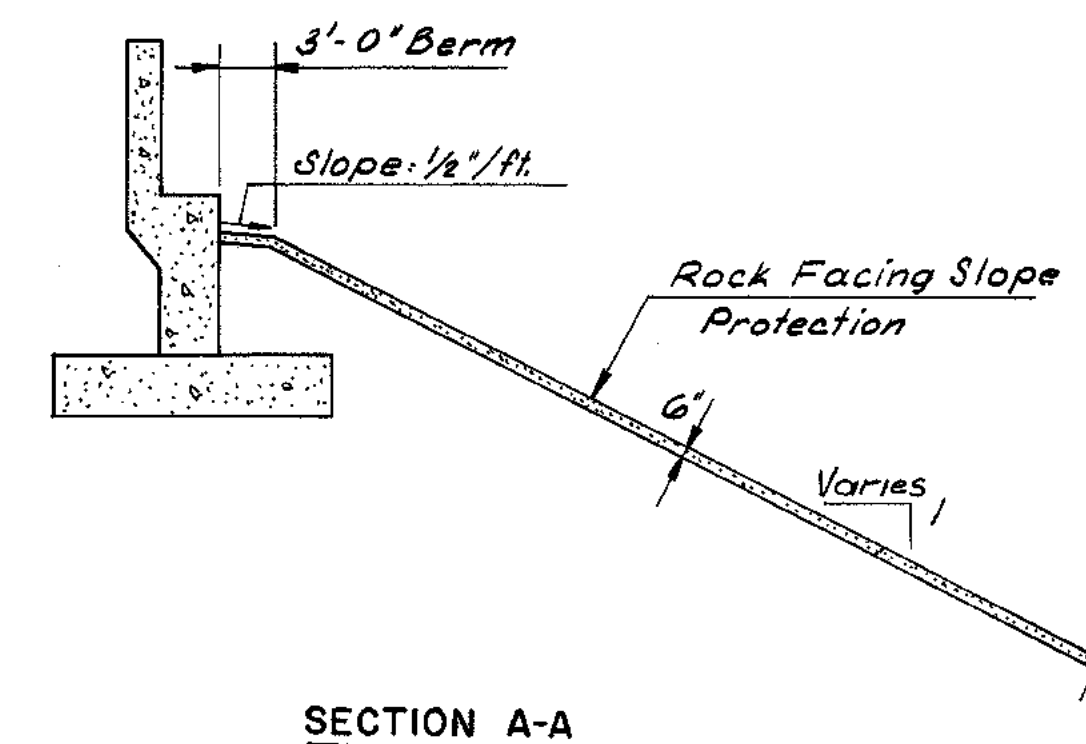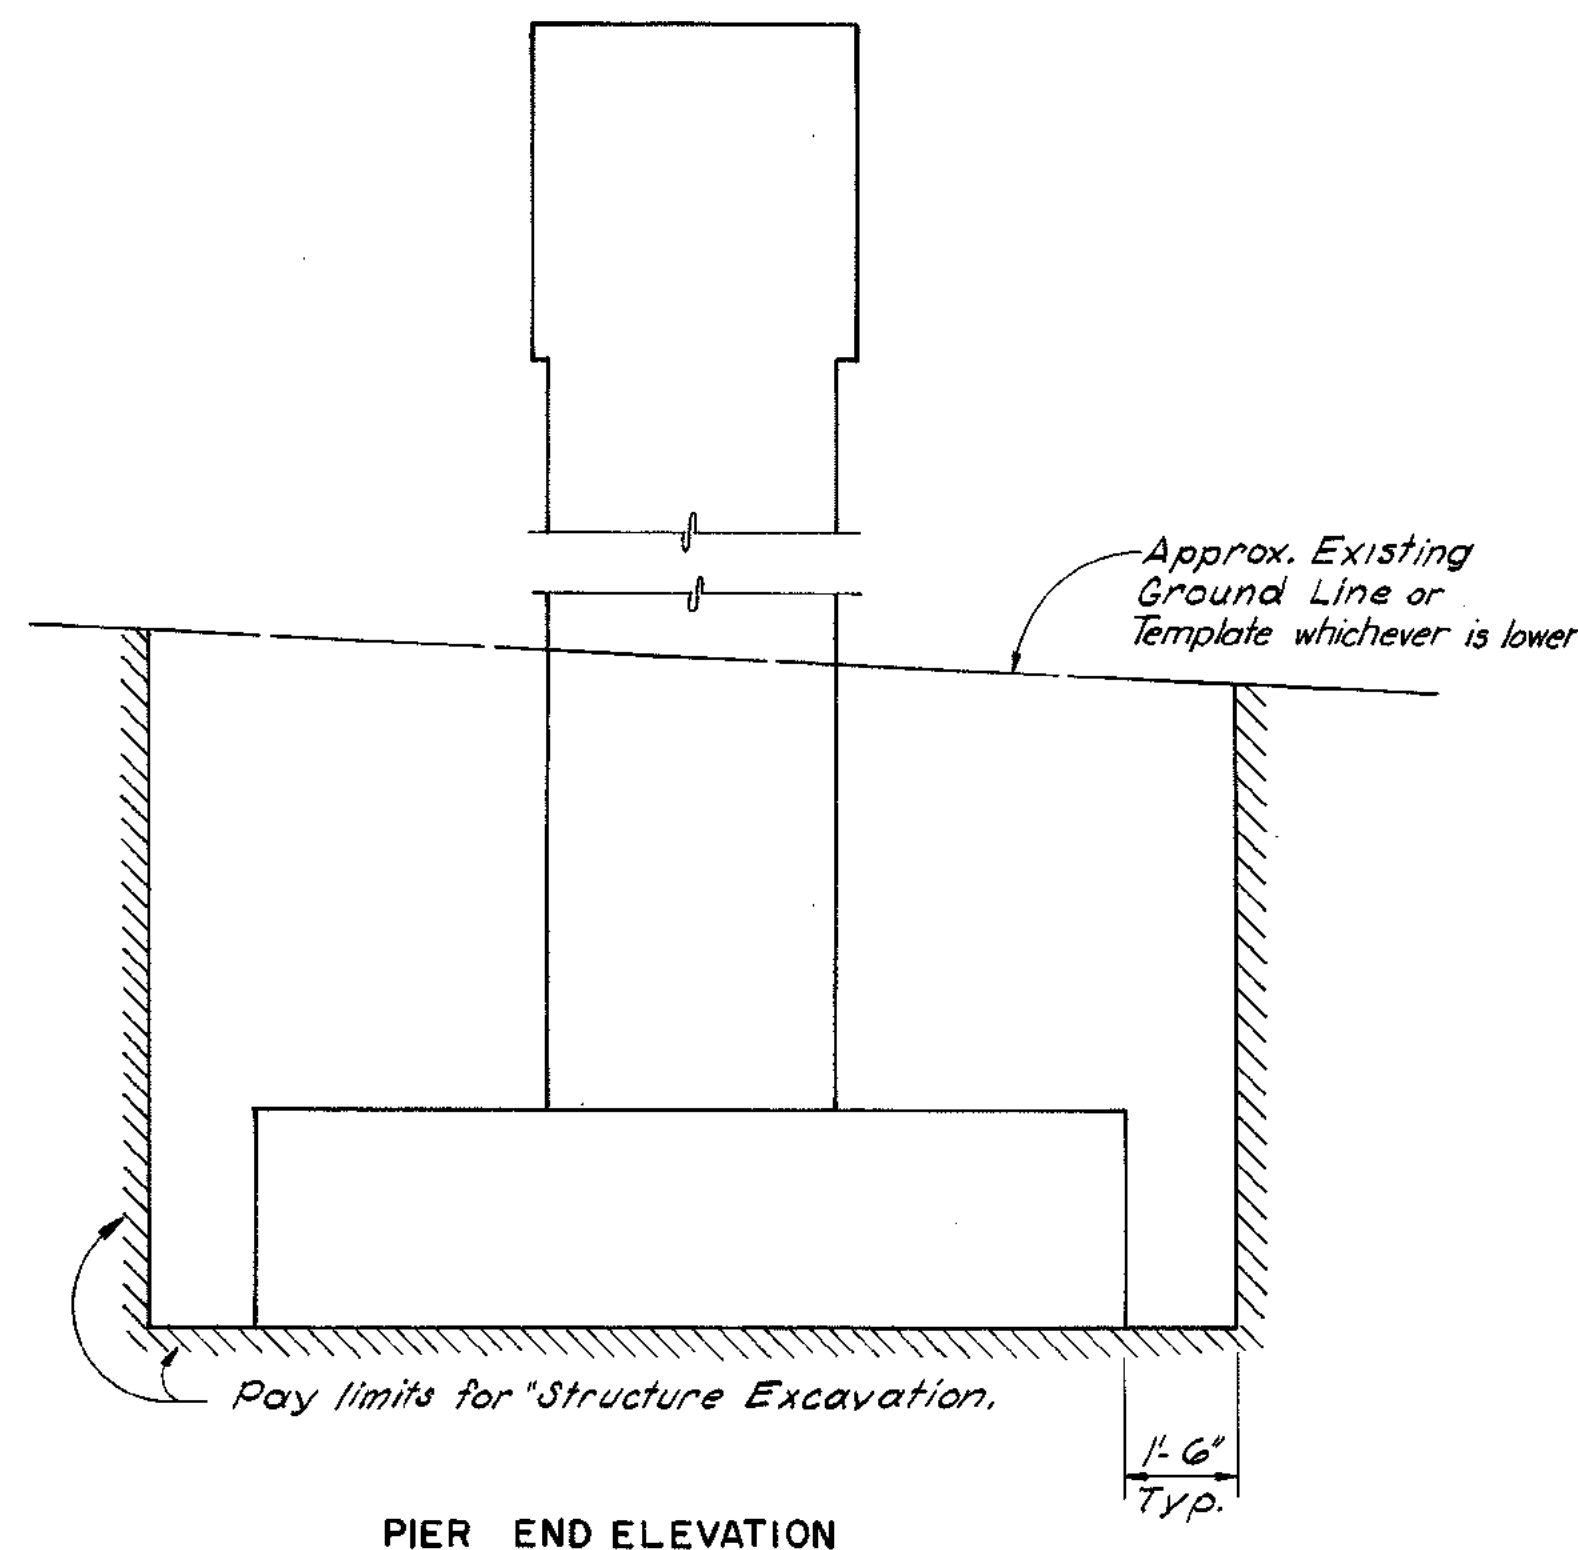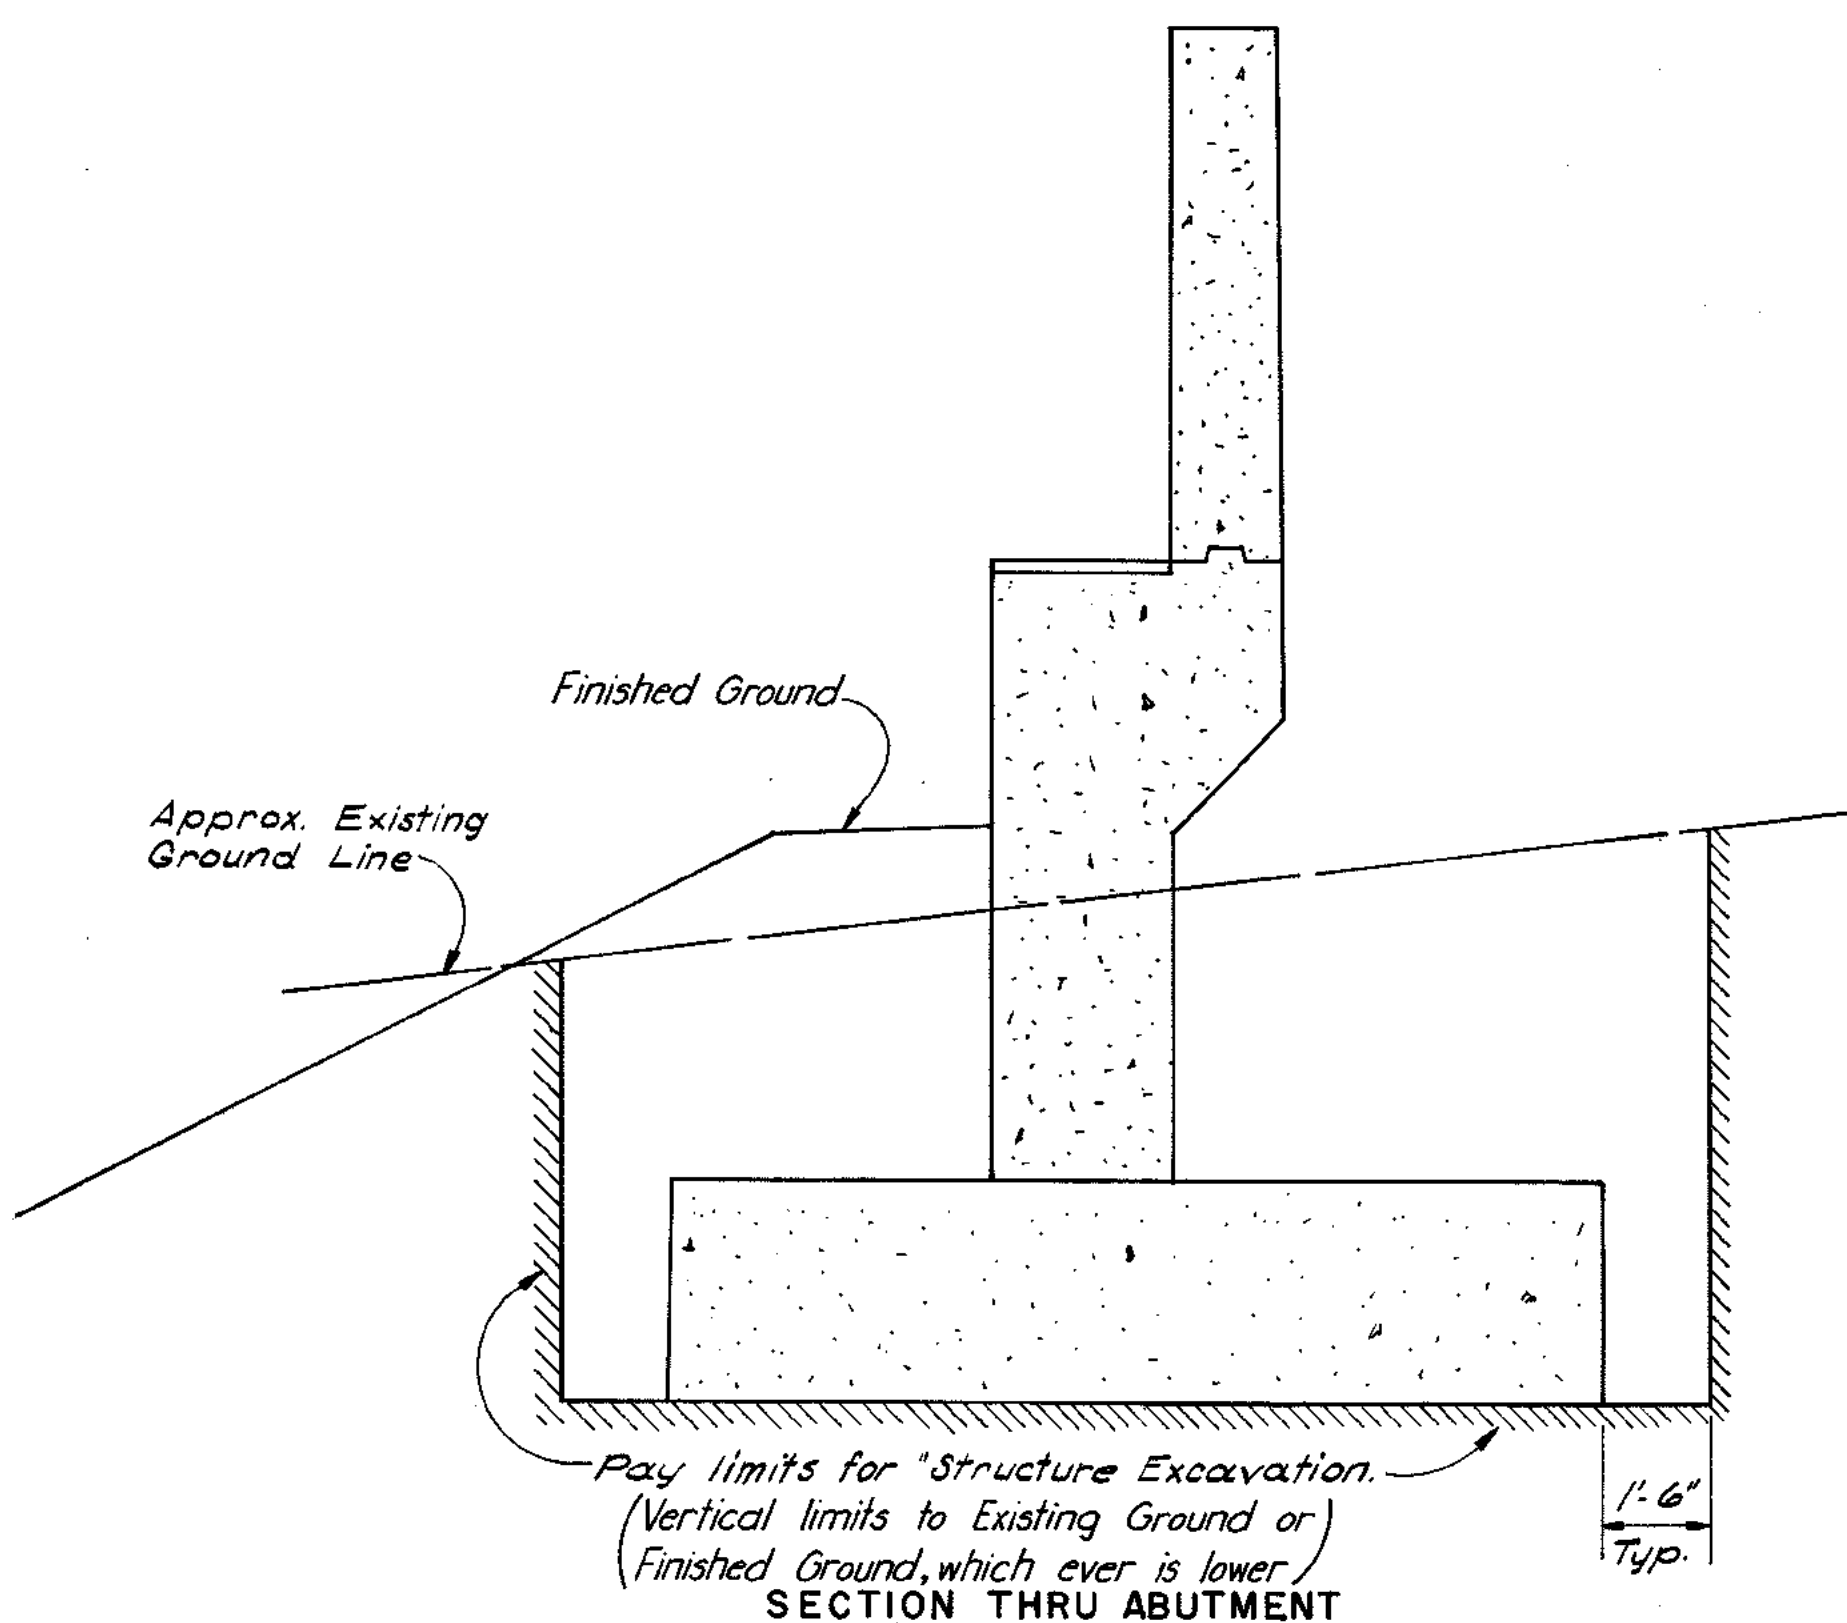

ESTIMATED QUANTITIES											
	Structure Excavation C.Y.	Concrete (a) C. Y.	Reinforcing Steel Lbs.	Structural Steel Lbs.	Aluminum Br. Railing 1 Rail L.F.	Bridge Drainage System L.S.	Porous Backfill C.Y.	Rock Facing Slope Protec. 6" Thick S.Y.	Asphalt Damp proofing S.Y.	Concrete Class A-3 Ret'g. Wall C.Y.	Concrete Slab Slope Protection S.Y.
		(b)			(c)	(d)					
Superstructure		544.88	83,283	1,482,037	1,008	1					
West Abutment	445	225.15	21,598				44	326	102		
Pier 1	304	184.45	40,506								
Pier 2	138	174.28	24,870								
Pier 3	263	203.09	41,816								
Pier 4	498	264.45	31,414								
Pier 5	356	231.15	41,800								
East Abutment	393	241.92	25,359				55		127	17	113
Total	2,397	1324.49(a) 544.88(b)	310,646	1,482,037	1,008	1	99	326	229	17	113

SLAB ELEVATIONS			
Location	Lt. Curb Elev.	Crown Elev.	Rt. Curb Elev.
Face of Bkwl. West Abut.	143.98	144.10	143.98
E. Pier 1	143.50	143.69	143.65
E. Pier 2	143.13	143.34	143.30
E. Pier 3	142.73	142.94	142.92
E. Pier 4	142.13	142.35	142.35
E. Pier 5	141.36	141.60	141.60
Face of Bkwl. East Abut.	140.76	140.88	140.76

ANCHOR BOLT SETTING DIMENSIONS					
Girder	Angle "A" or "B"		Girder	Angle "A"	
	a	b		a	b
S1-S16	7 5/8"	8 5/8"	S33	7 3/4"	10 1/4"
S17	7 1/2"	8 3/4"	S34	7 3/4"	10 3/4"
S18-S22	7 1/2"	8 1/4"	S35-S38	7 1/4"	10 3/4"
S23	7 3/4"	8 3/4"	S39	7 3/4"	10 3/4"
S24	7 5/8"	8 5/8"	S40	7 3/4"	10 3/4"
S25	7 3/4"	9"	S41-S46	7 1/4"	9 1/4"
S26	7 1/4"	8 1/4"	S47-S48	7 3/8"	9 1/4"
S27-S31	7 1/4"	8 3/4"			
S32	7 5/8"	8 7/8"			

AS BUILT

RICHMOND METROPOLITAN AUTHORITY RICHMOND EXPRESSWAY SYSTEM POWHITE PARKWAY SOUTHERN RAILWAY OVER POWHITE PARKWAY BRIDGE B-05	
QUANTITIES & MISC. DETAILS	
HAYES, SEAY, MATTERN & MATTERN Associate Engineers	SCALE: AS SHOWN
HOWARD, NEEDLES, TAMMEN & BERGENDOFF General Consultants	CONTRACT NO.: 2 SHEET NO. 2 OF 19

BY	DATE	4	As Built	R.J.H.	11-72
MADE	JDB 2-68	3	General	J.G.V.	10-70
CHECKED	JGD 3-68	2	Anchor Bolt set dim.	T.E.M.	6-68
IN CHARGE	JGD	1	Quantity	DSB	5-68

(a) Class A3, Unless noted.  
(b) Class A4.  
(c) Includes that portion on abutments & wingwalls.  
(d) Includes underdrains



RICHMOND EXPRESSWAY SYSTEM			
SECTION	PROJECT	SHEET NO.	TOTAL SHEETS
2	POWHITE PARKWAY	138	188

**Note to Contractor**  
 Attention is called to the apparent erratic location of the top of rock in the vicinity of Pier 5. If, after excavation for Pier 5, the majority of founding material located at Elevation 105 is rock, all pockets of decomposed material within the limits of the excavation shall be removed and backfilled with Class A3 concrete. Conversely, if the majority of founding material is decomposed rock, areas of projecting bedrock shall be removed to an elevation one foot below the footing elevation and backfilled to the footing elevation with a blanket of well compacted granular material similar in nature to the majority founding material.  
 Any additional excavation required by the above will be paid for at the unit price bid for Structure Excavation. Additional Class A3 concrete required, amounting to two cubic yard or more, will be paid for at the unit price bid for Concrete, Class A3, Substructures. No additional payment will be made for backfilling with granular material.

PIER	ELEVATION		DIMENSION					ALLOW.
	"C"	"D"	"A"	"B"	"F"	"W"	"T"	
1	136.07	104.5	37'-9"	37'-0"	31.57	12'-0"	3'-6"	7 ton
2	135.52	103.5	37'-9"	37'-0"	32.02	9'-0"	3'-6"	7 ton
3	135.31	101.0	38'-6"	40'-0"	34.31	12'-0"	3'-6"	6 ton
4	134.66	100.7	40'-6"	45'-0"	33.92	17'-0"	4'-3"	4 ton
5	133.87	105.0	39'-0"	45'-0"	28.87	17'-0"	4'-0"	4 ton

PIER	REINFORCING STEEL						
	"J"	"K"	"L"	"M"	"N"	"P"	
1	#11	#5@18"	#6@12"	#6@14"	#6@14"	#10@6"	
2	#9	-	-	#6@16"	#6@16"	#7@7"	
3	#11	#5@18"	#6@12"	#8@16"	#8@16"	#9@8"	
4	#10	-	-	#6@15"	#6@15"	#9@8"	
5	#9	-	-	#9@14"	#9@14"	#9@7"	#13' long

NOTE: Footing elevations are approximate only and may be varied to suit field conditions as directed by the Engineer. Vertical shaft reinforcing shall not be cut until these elevations are established. Where elevations change more than 2 ft., redesign will be required.

AS BUILT





RICHMOND METROPOLITAN AUTHORITY  
 RICHMOND EXPRESSWAY SYSTEM  
 POWHITE PARKWAY

SOUTHERN RAILWAY OVER  
 POWHITE PARKWAY  
 BRIDGE B-05

PIER DETAILS

HAYES, SEAY, MATTERN & MATTERN  
 Associate Engineers  
 HOWARD, NEEDLES, TAMMEN & BERGENDOFF  
 General Consultants


SCALE: 3/8" = 1'-0"  
 CONTRACT NO.: 2  
 SHEET NO. 7 OF 19

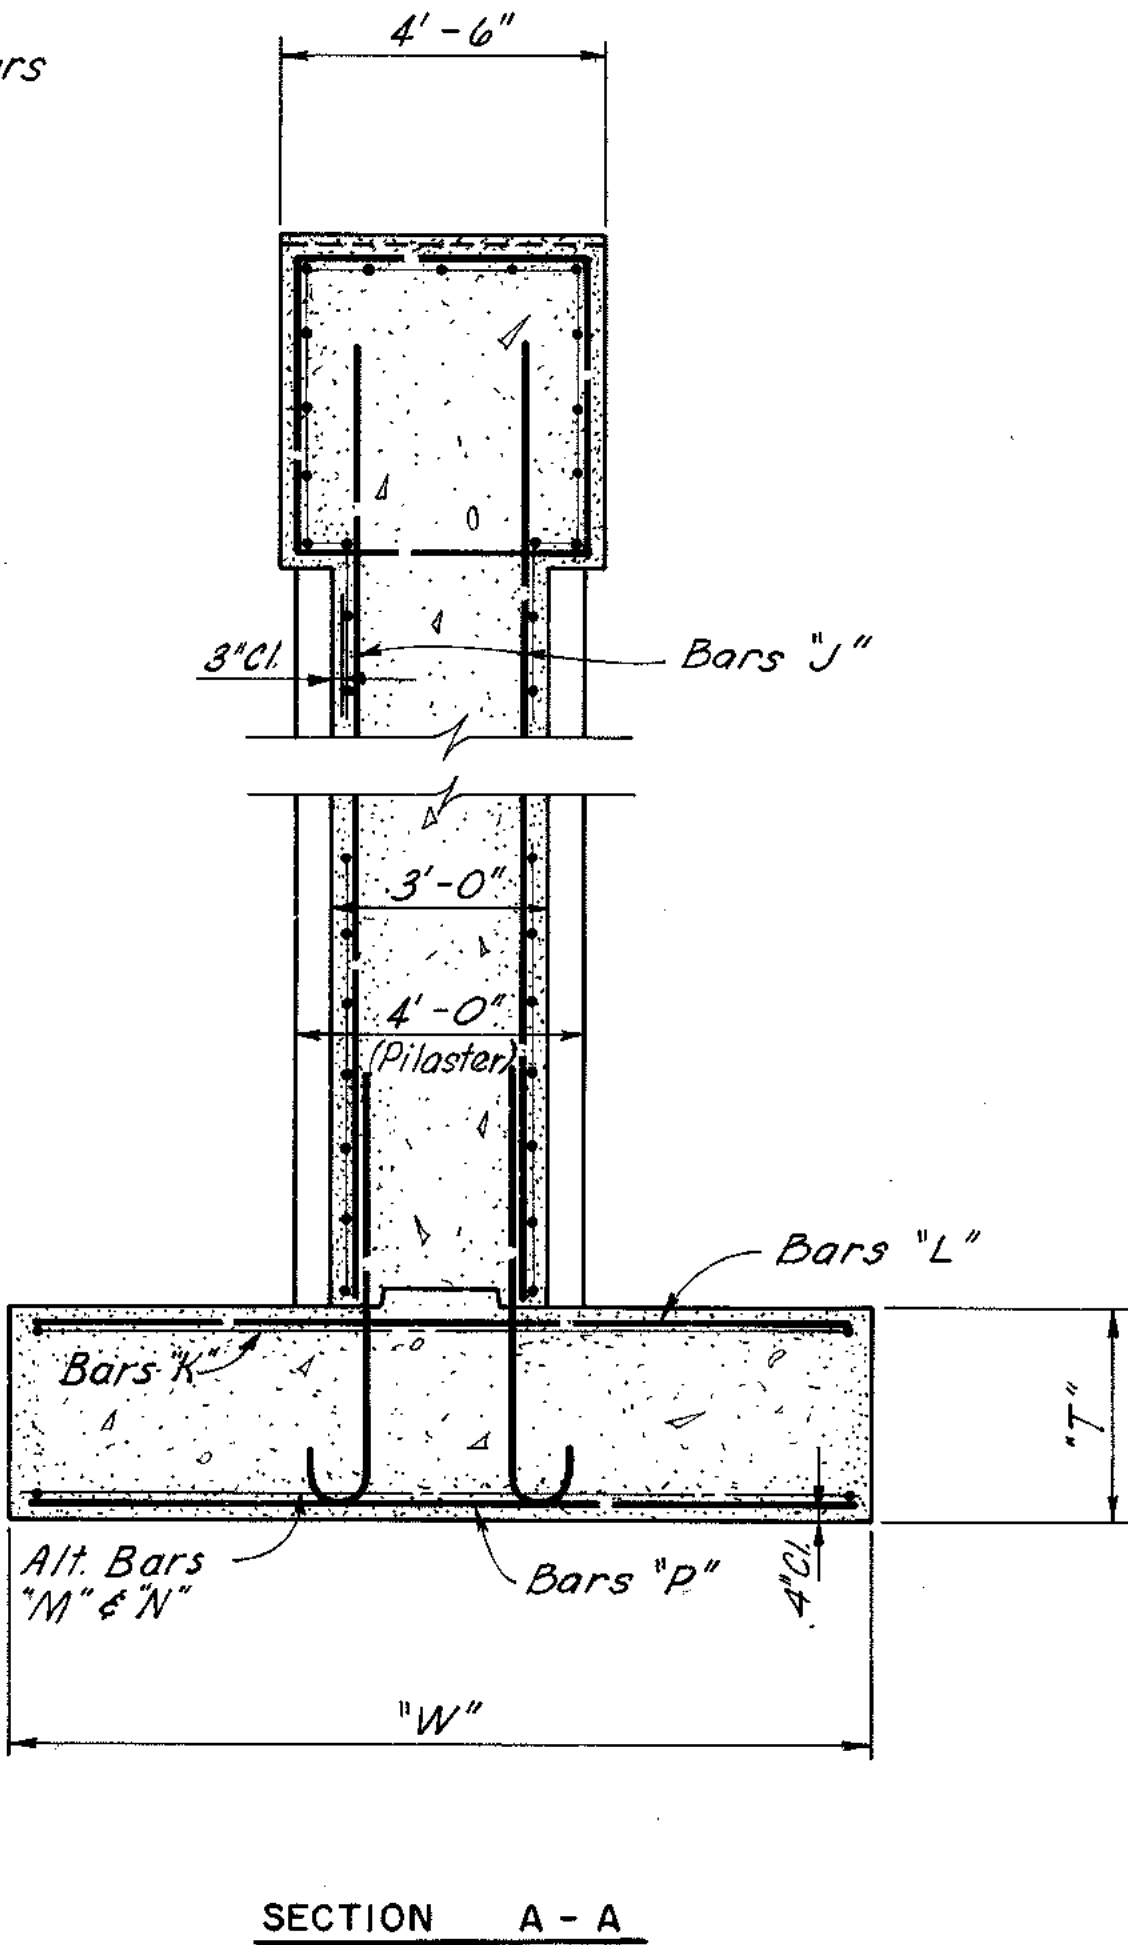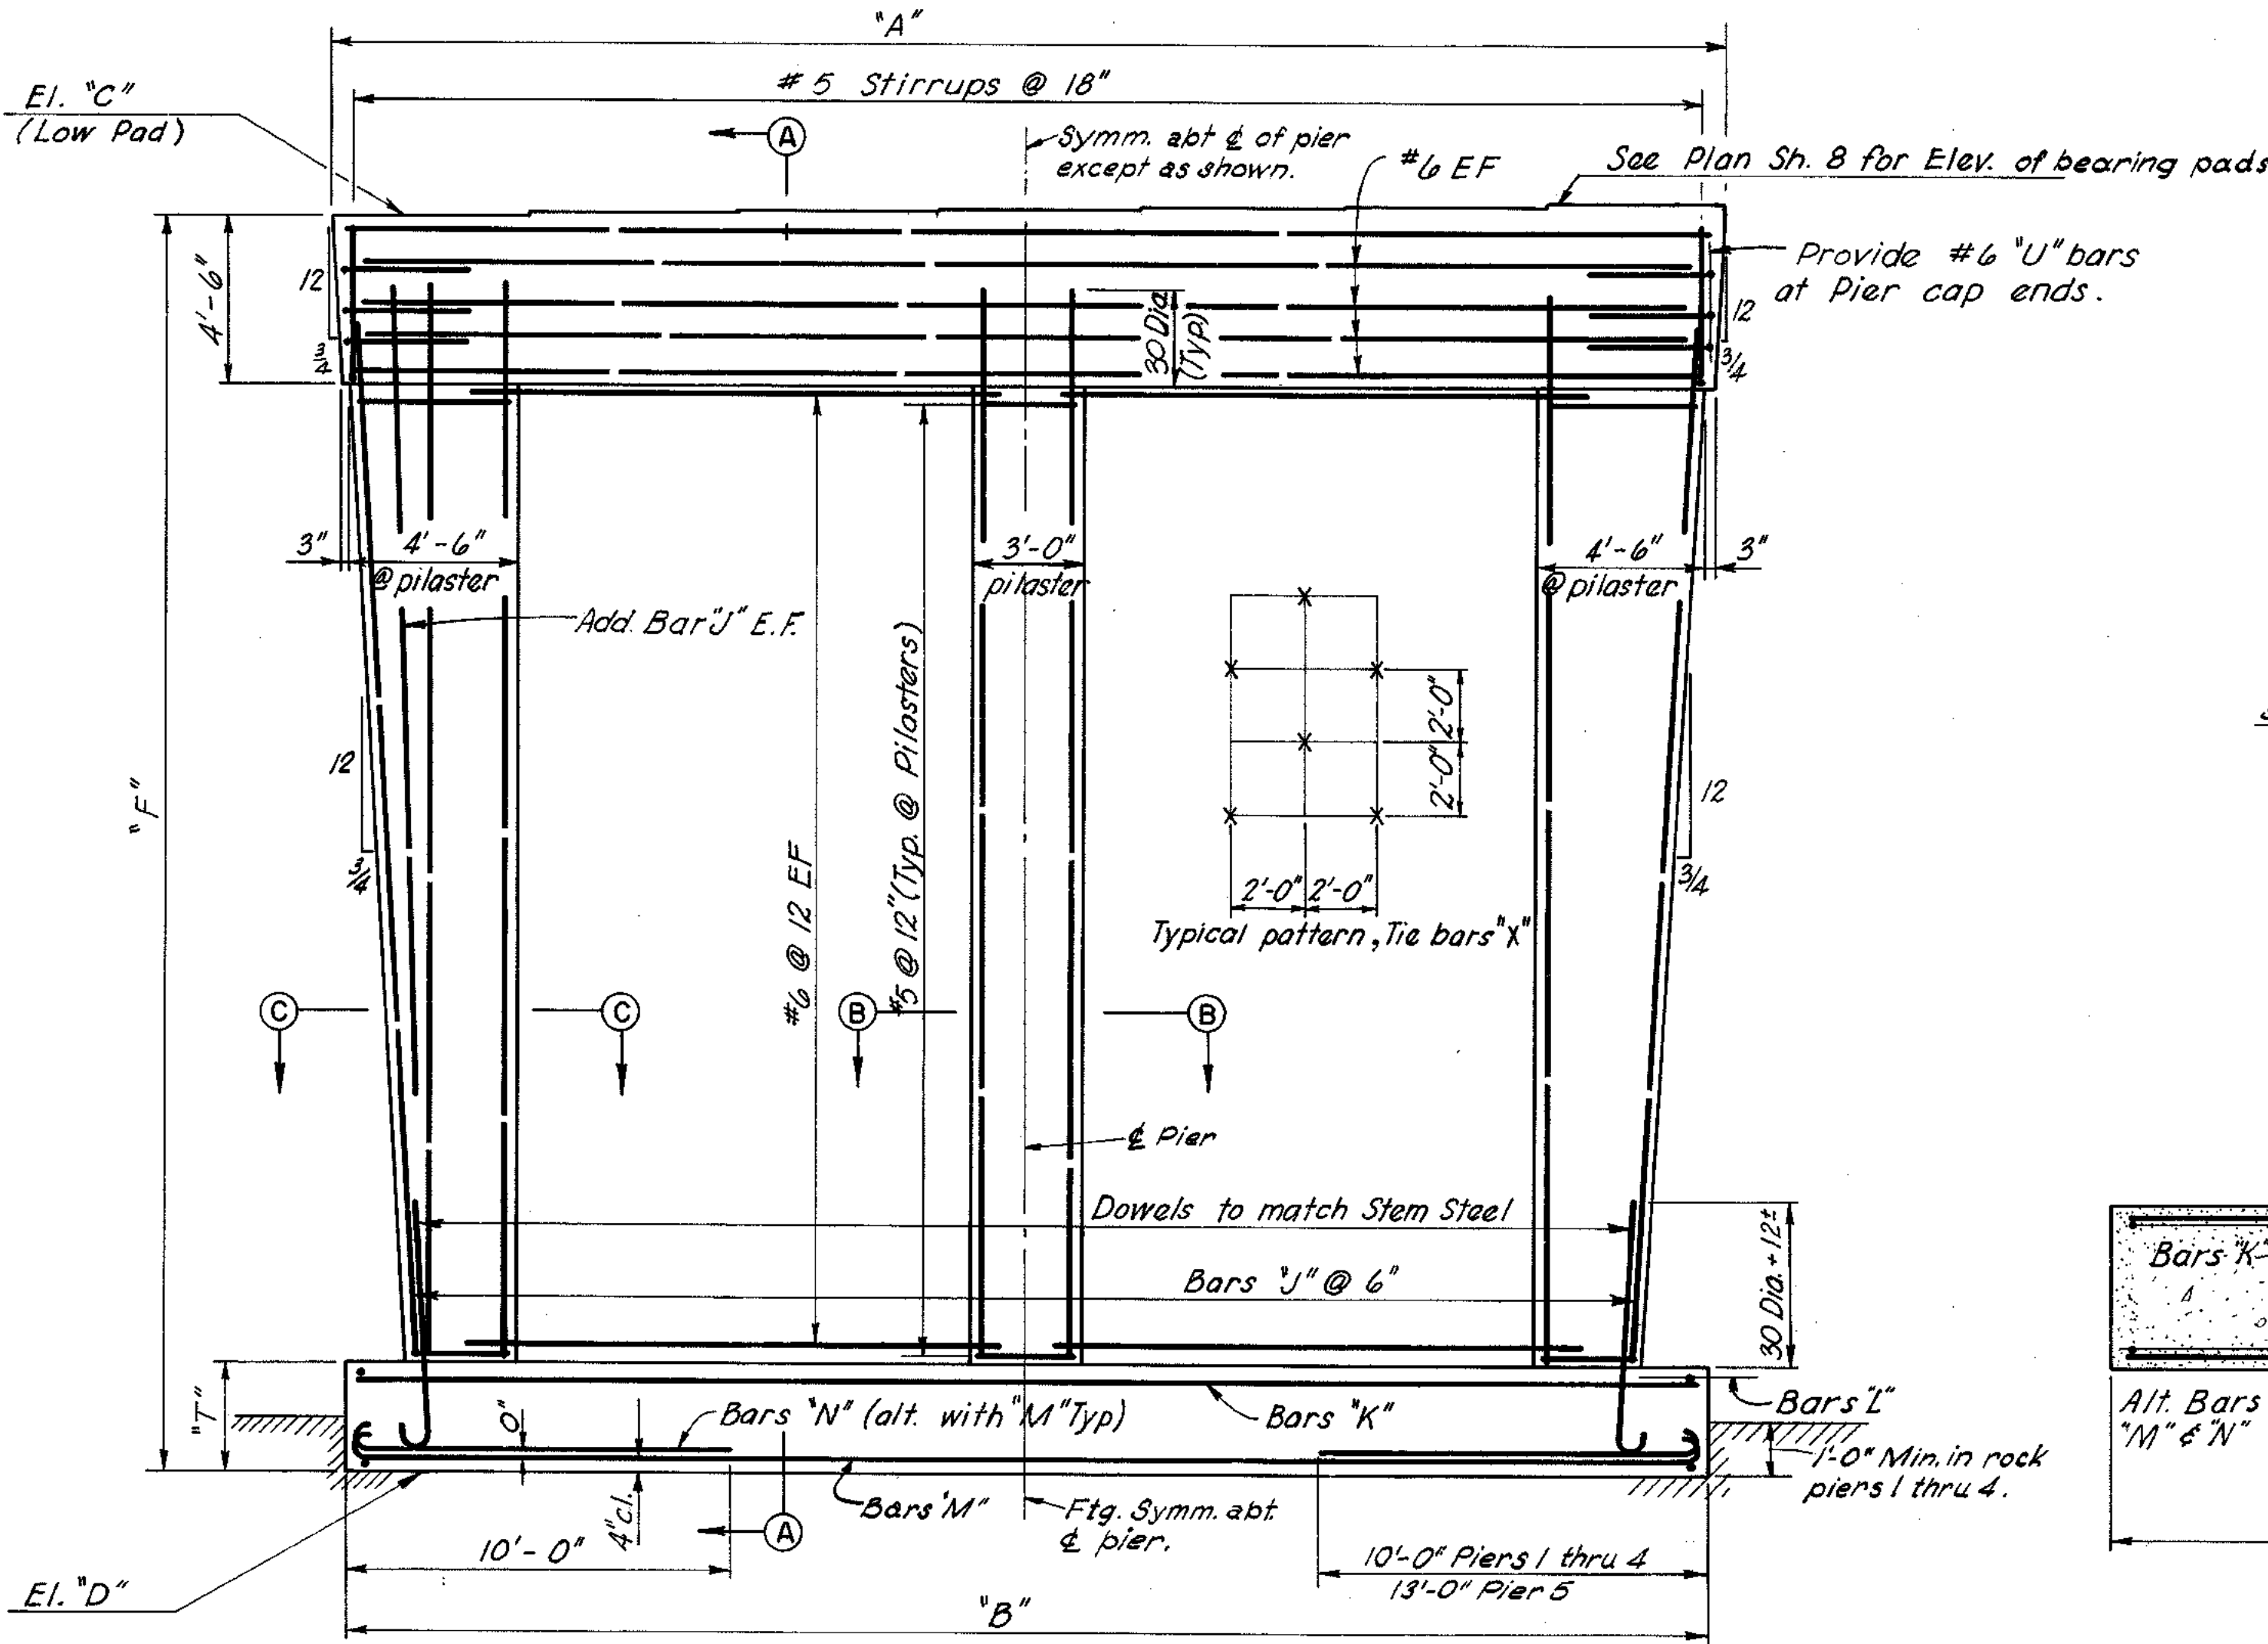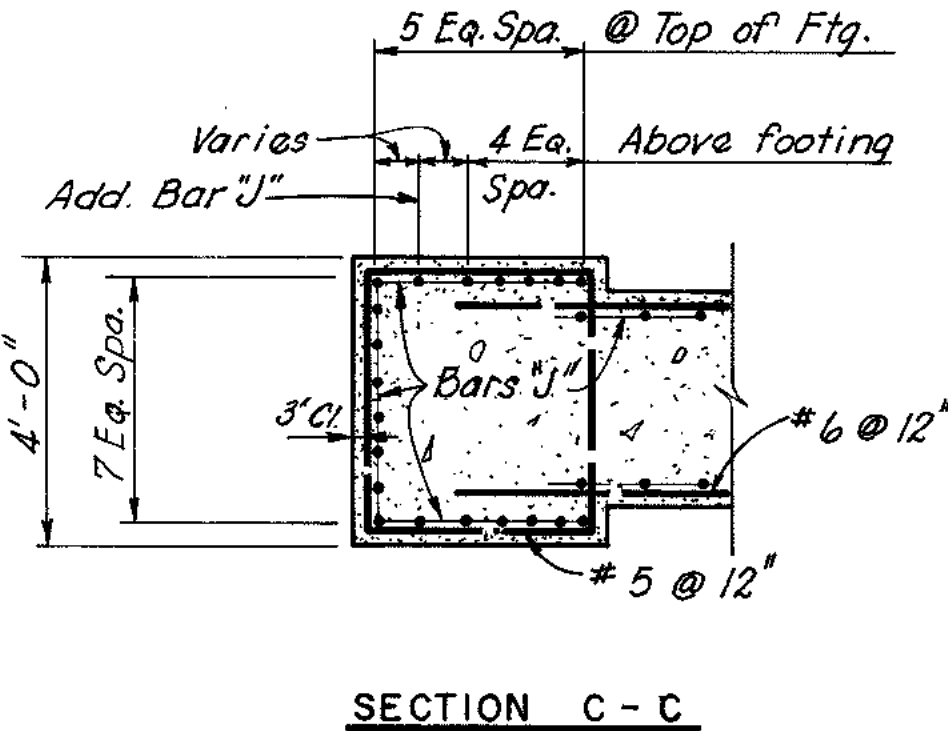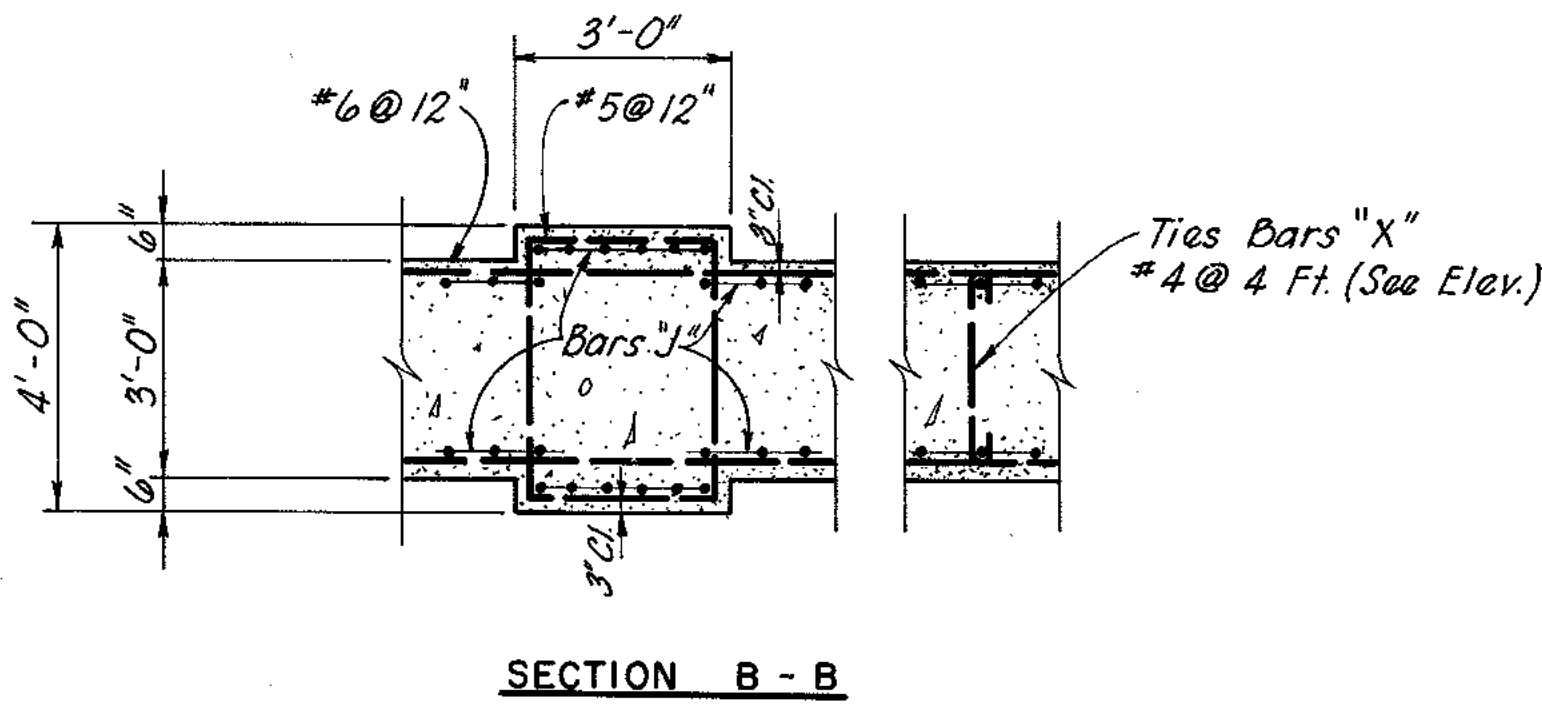


	BY	DATE	1	Note added	TEM	4-68
MADE	WCJ	1-68	2	Pad El & Dim.	TEM	6-68
CHECKED	THN	2-68	3	As Built	RH	11-72
IN CHARGE	JGD		NO.	REVISION	BY	DATE

TYPICAL ELEVATION  
 (Looking ahead on stationing)


RICHMOND EXPRESSWAY SYSTEM			
SECTION	PROJECT	SHEET NO.	TOTAL SHEETS
2	POWHITE PARKWAY	139	188

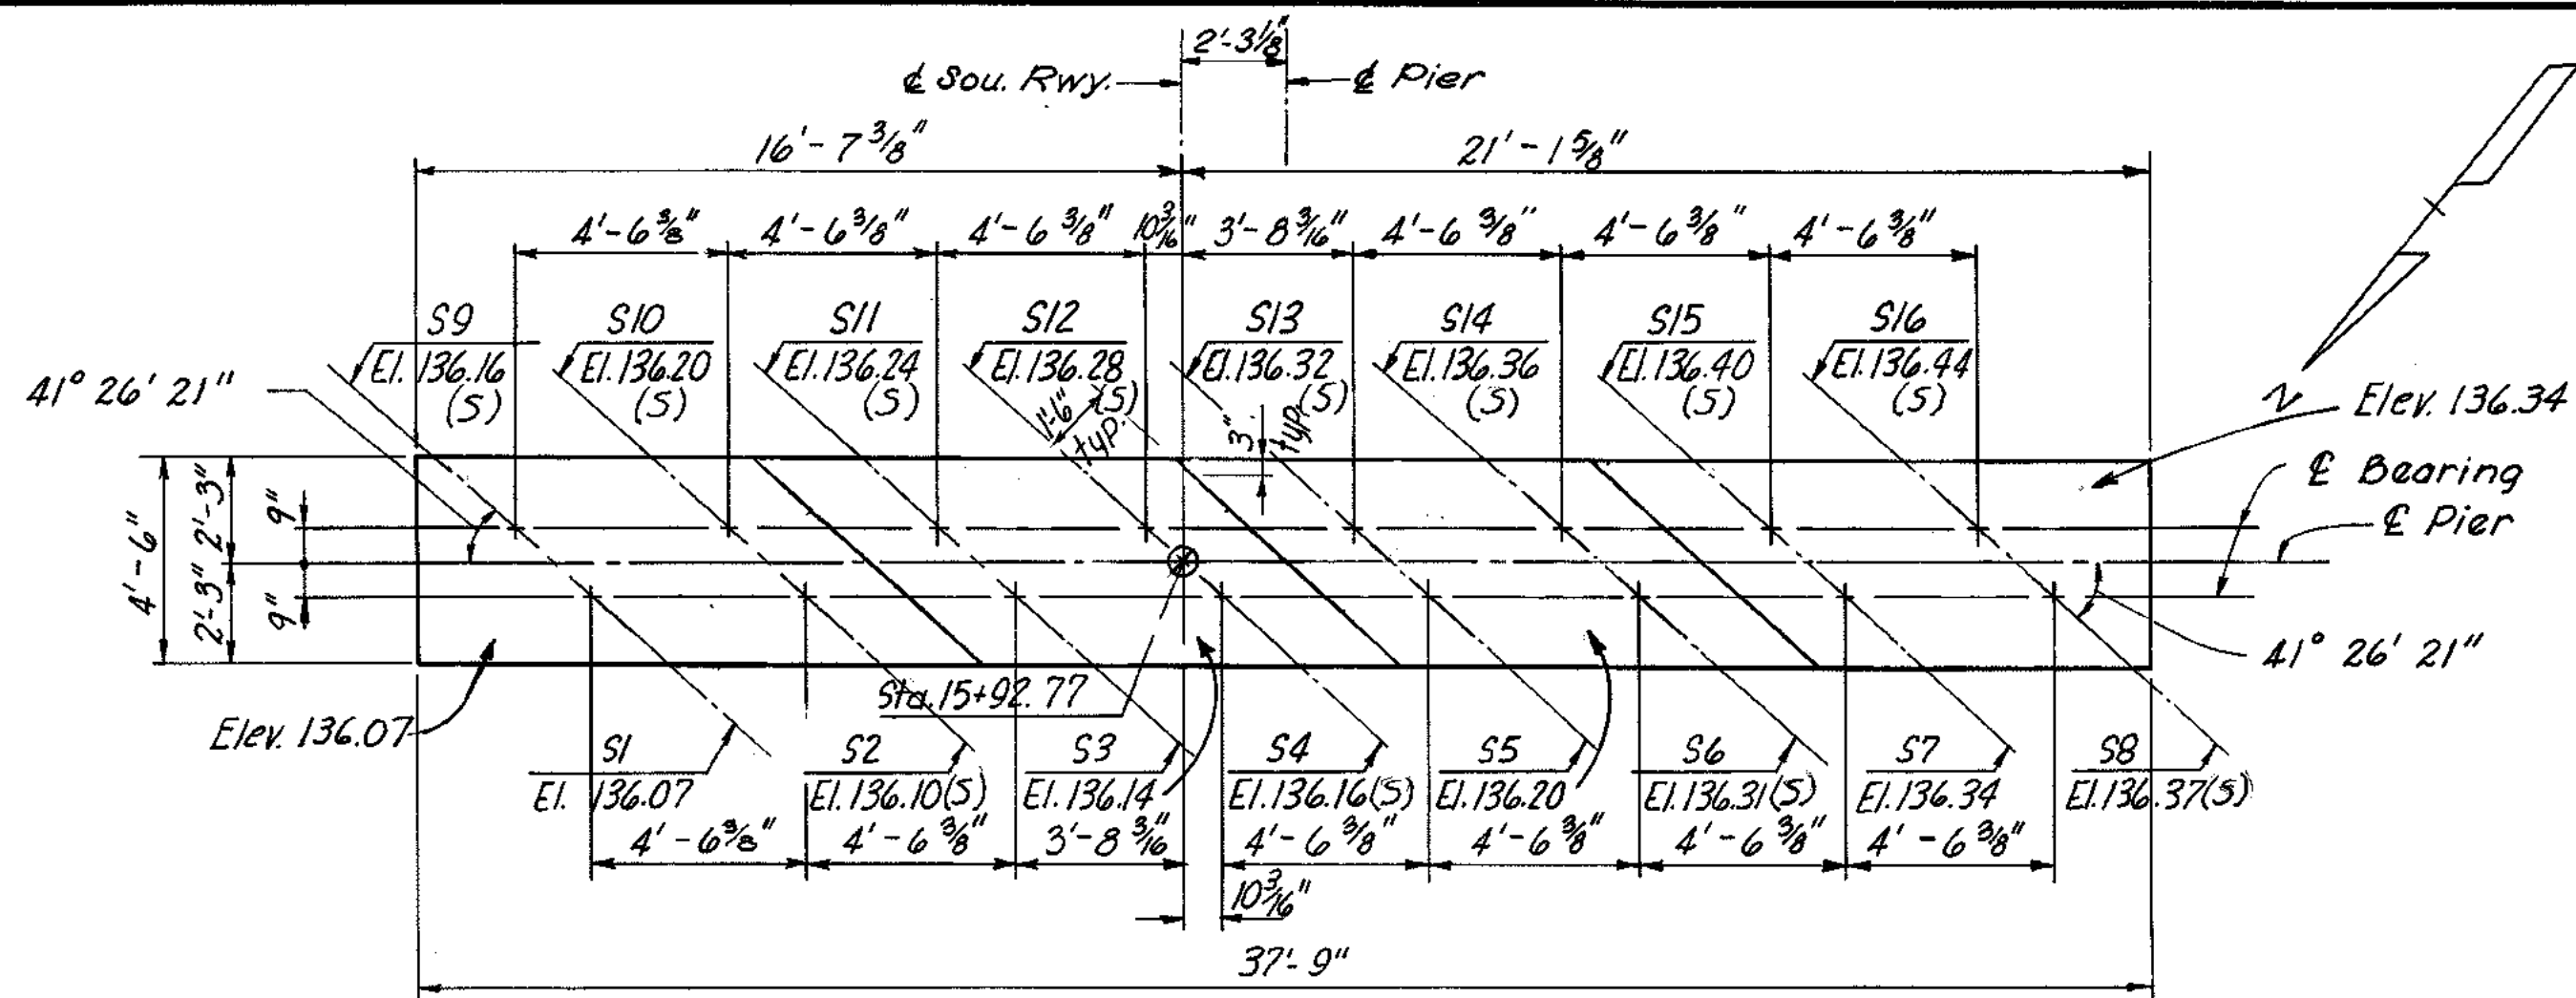


PLAN - PIER 1

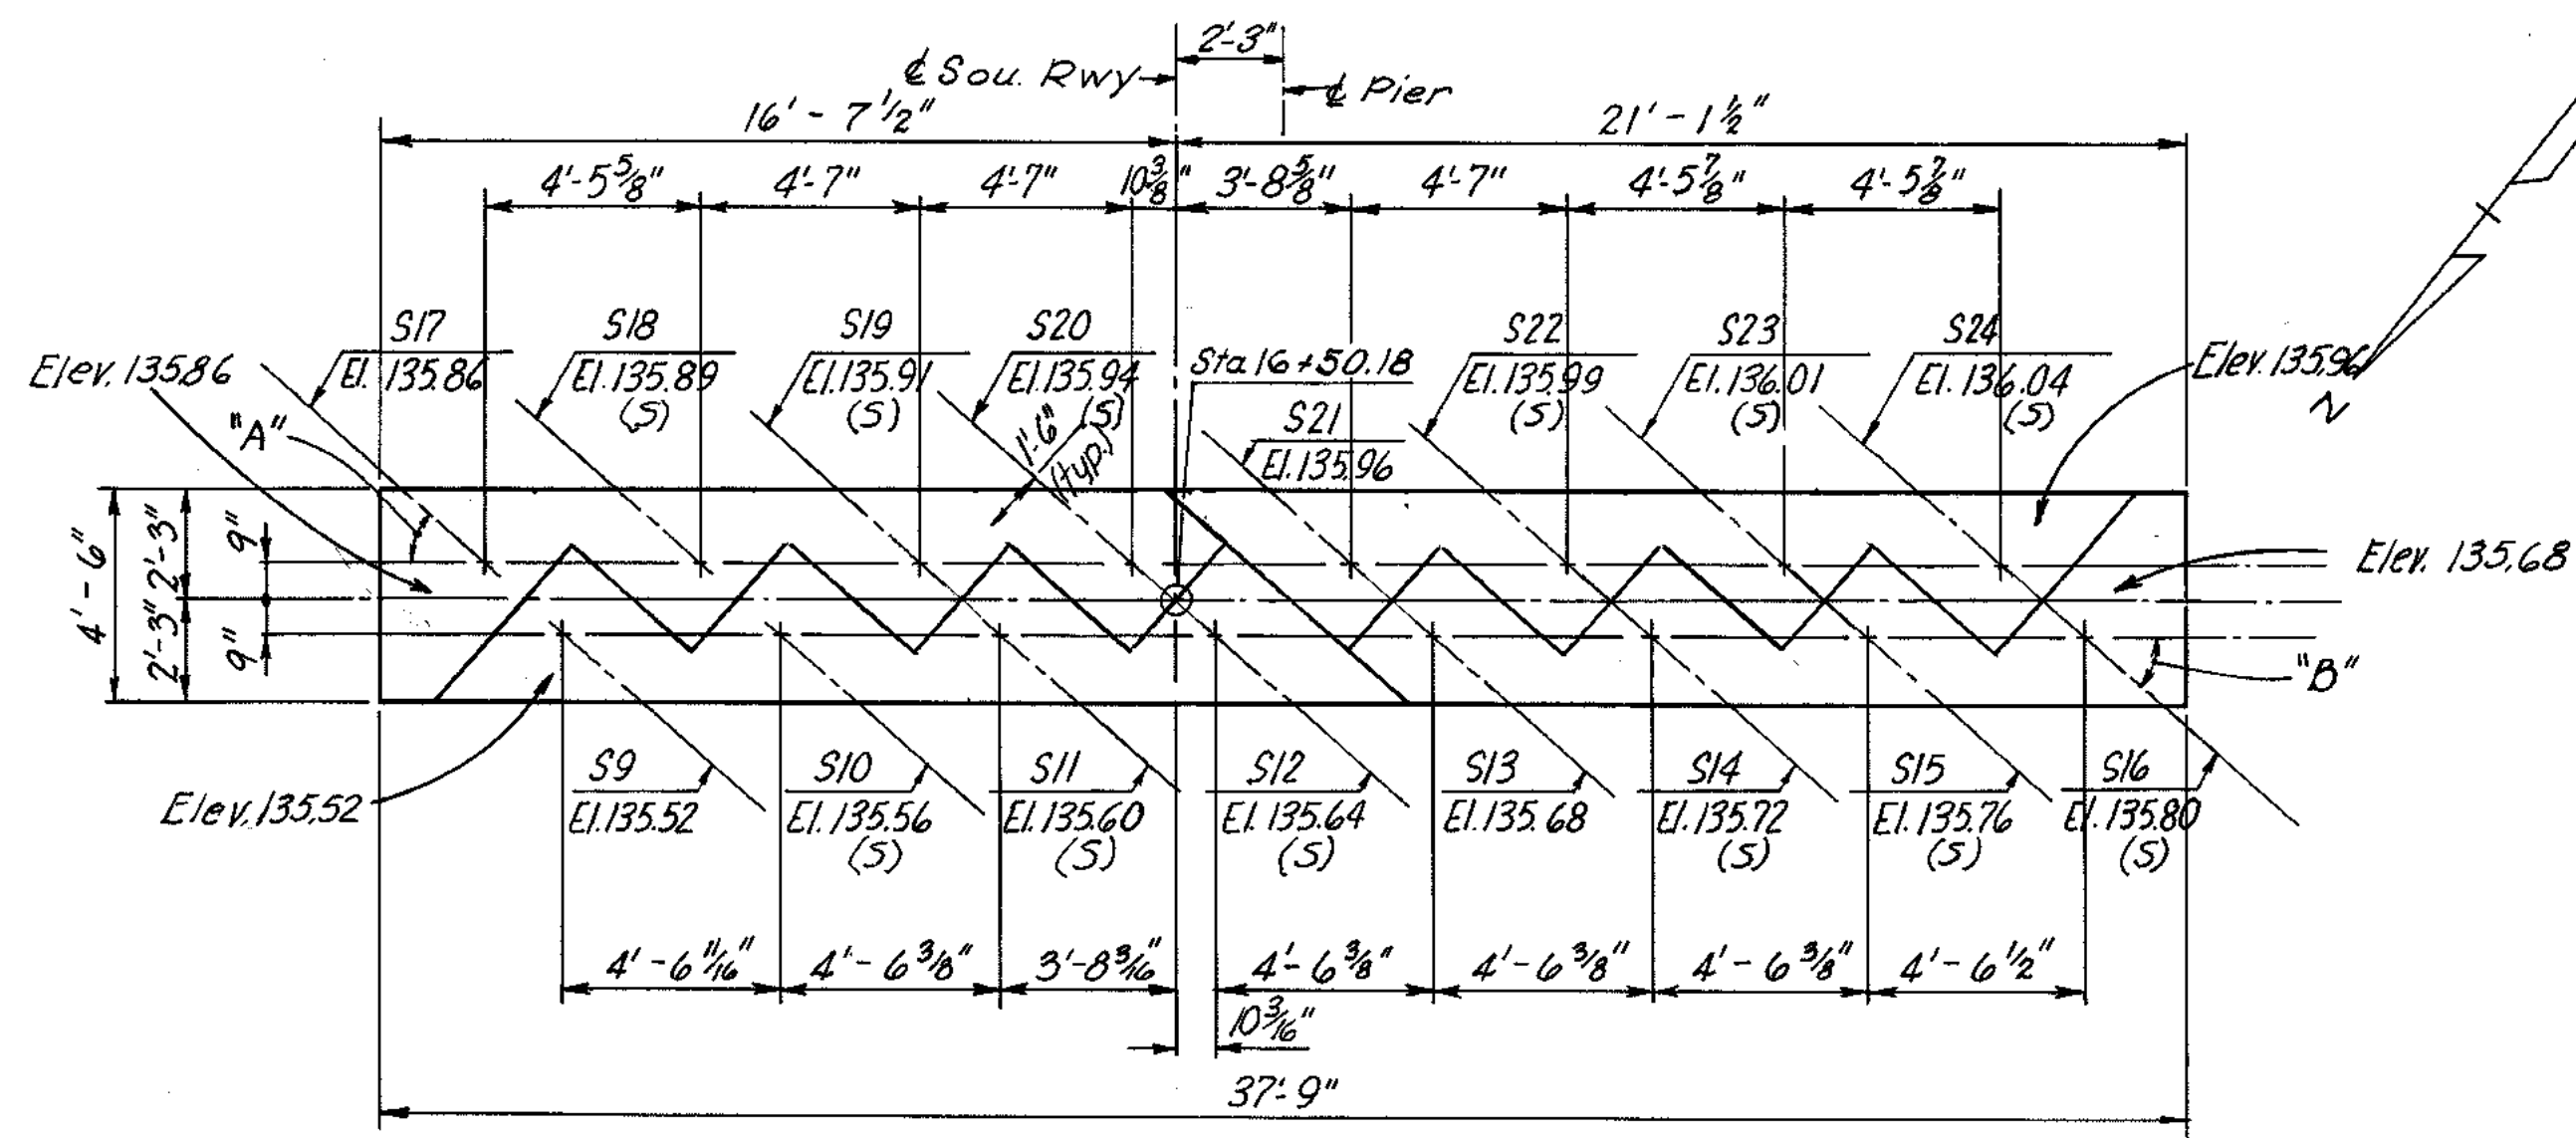


PLAN - PIER 2

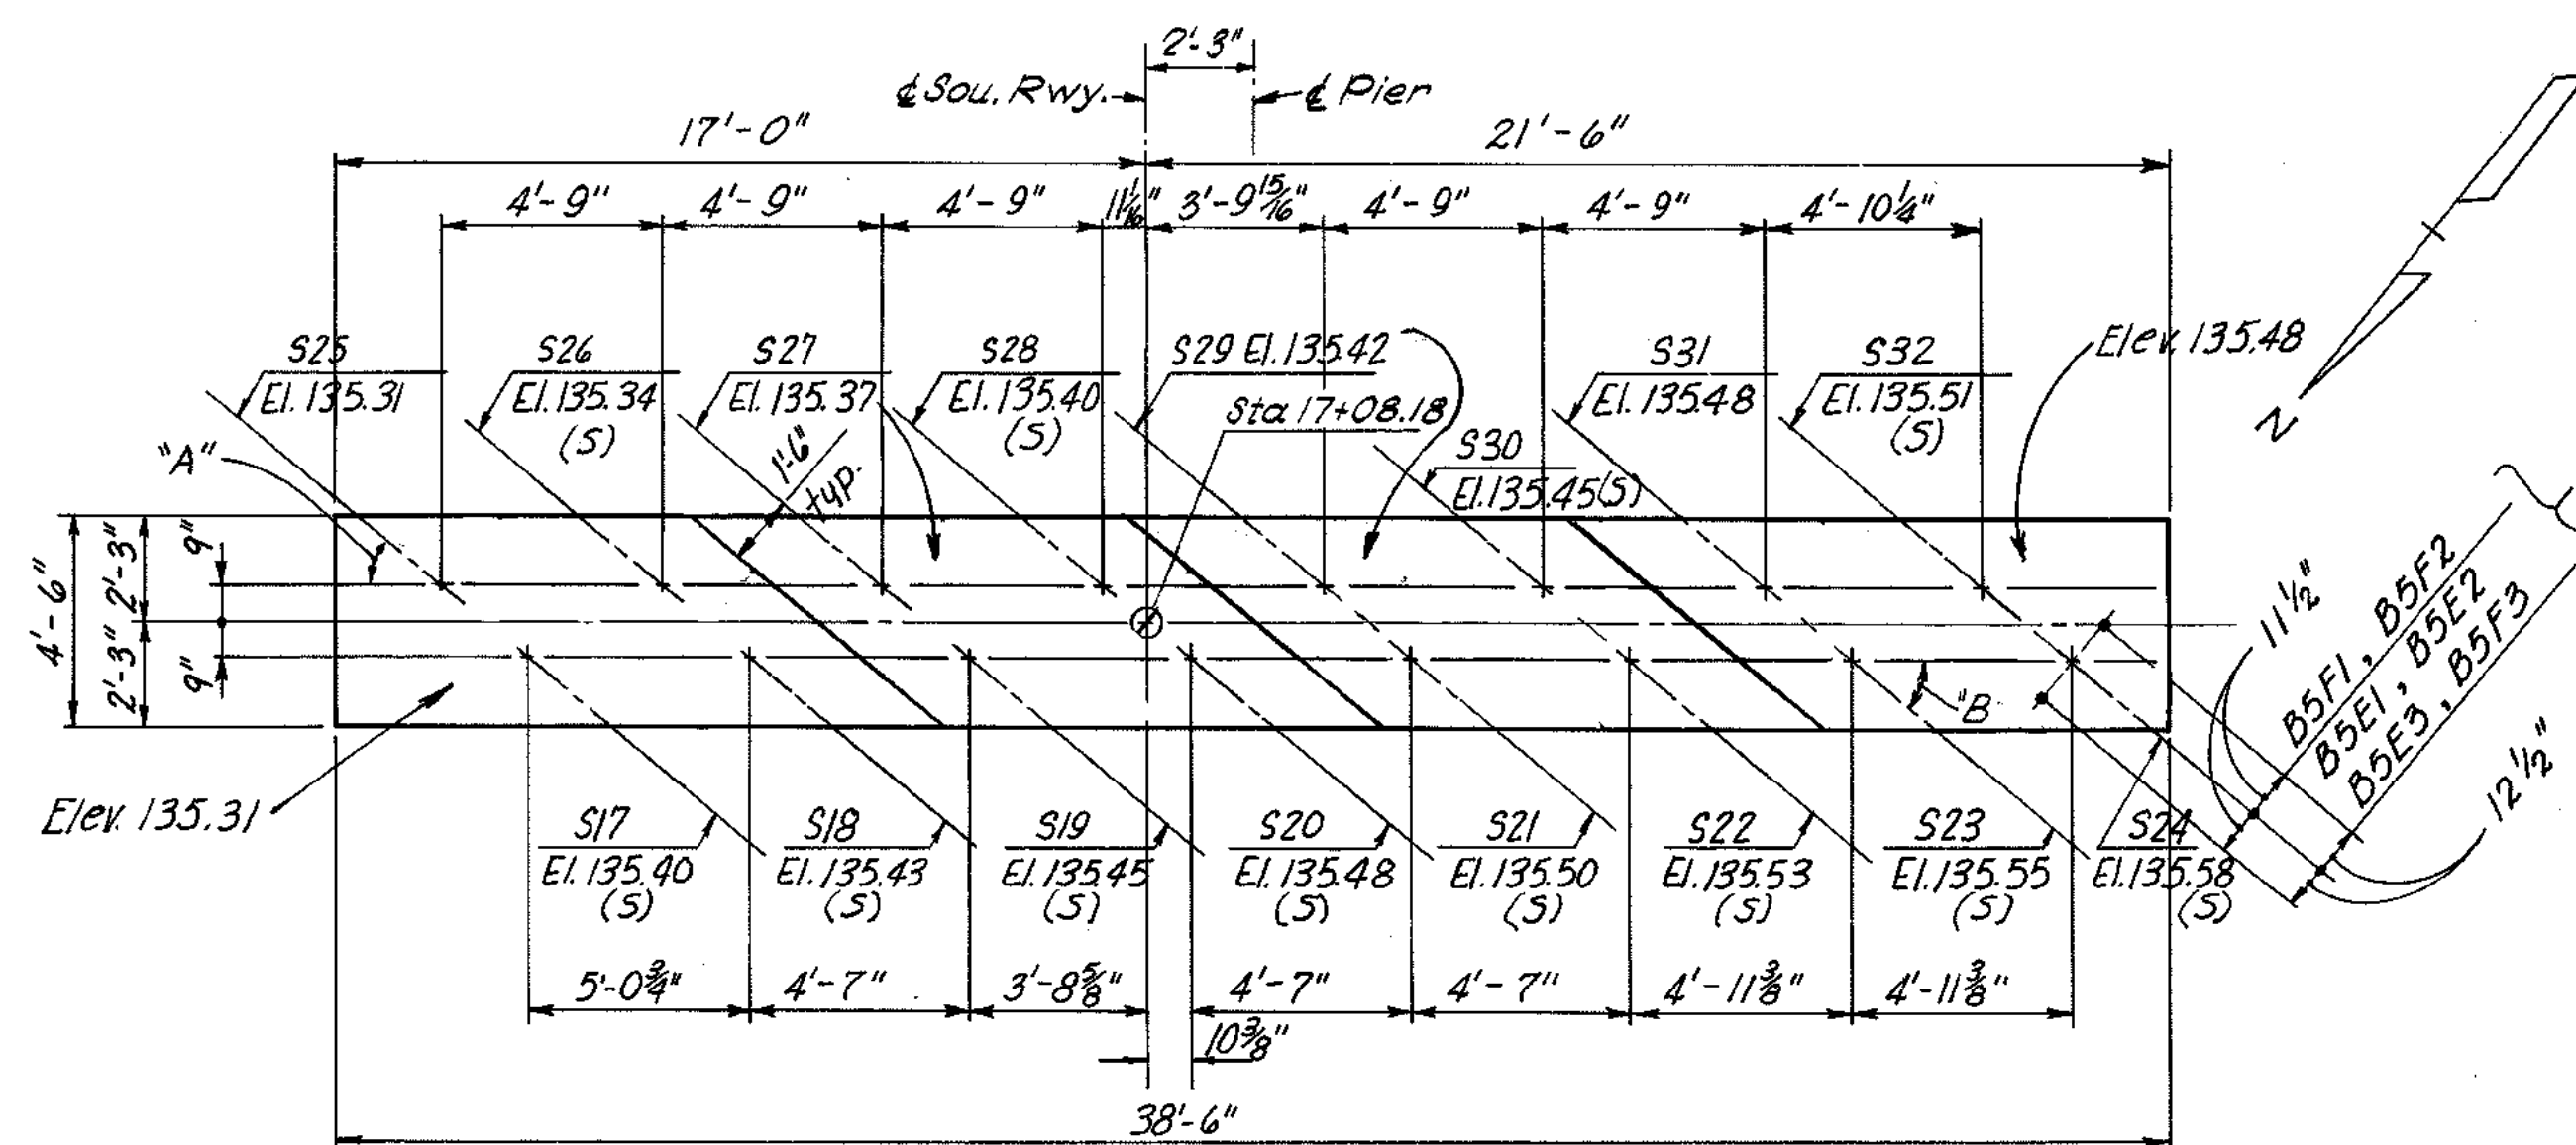

PLAN - PIER 3

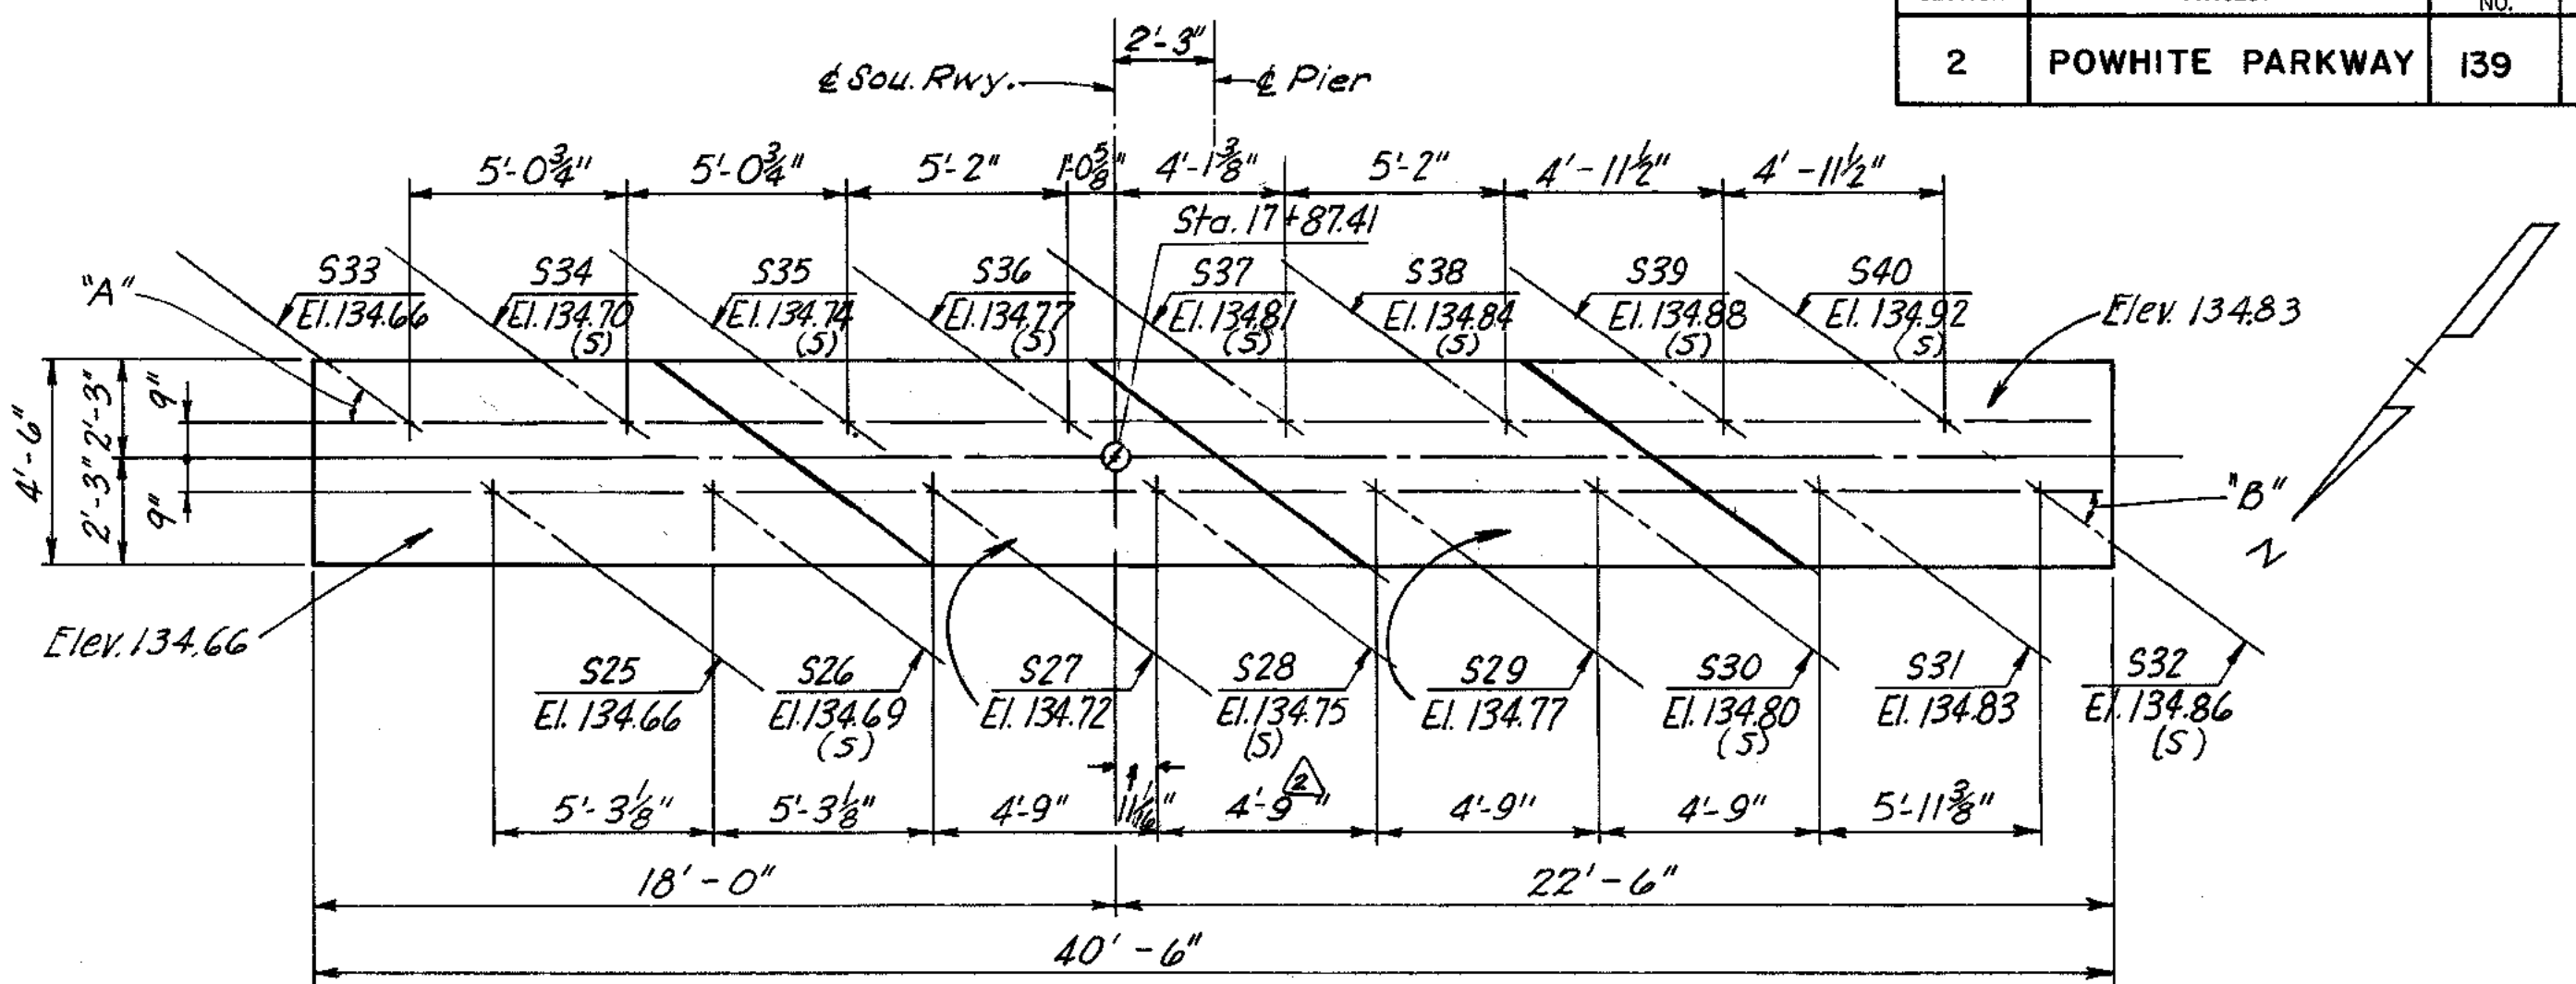

PLAN - PIER 4

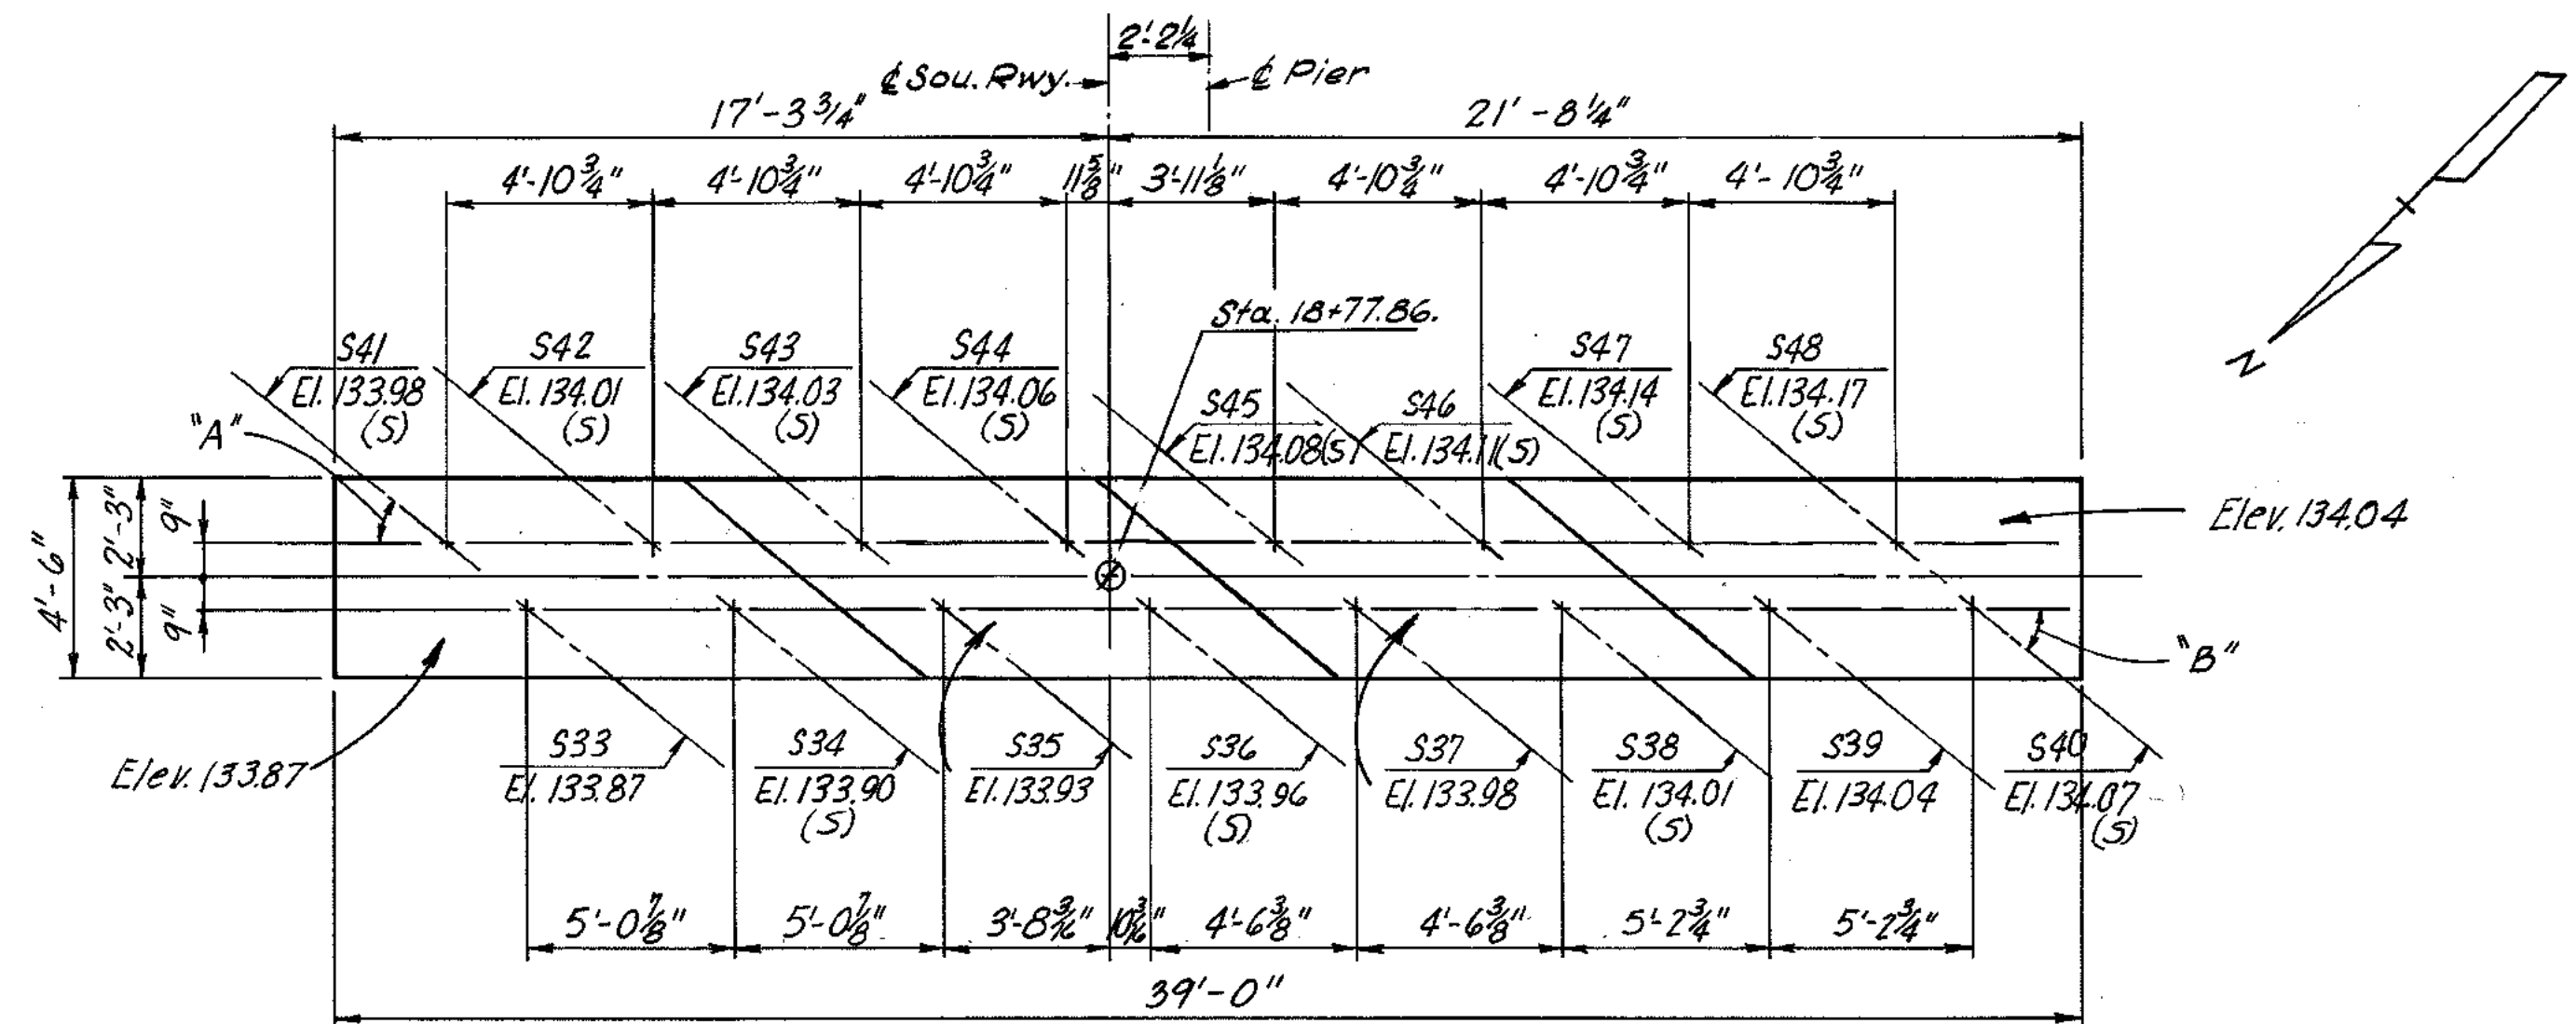

PLAN - PIER 5

### Notes:


- For angles "A" or "B" See Sheet 9.
- For anchor bolt location see Anchor Bolt Setting Dimensions - Sheet 2.
- (S) = Shimmed to Elevation shown. Shim constructed of single steel plate of required thickness.

**AS BUILT**

**RICHMOND METROPOLITAN AUTHORITY**  
**RICHMOND EXPRESSWAY SYSTEM**  
**POWHITE PARKWAY**  
**SOUTHERN RAILWAY OVER**  
**POWHITE PARKWAY**  
**BRIDGE 8-05**  
**PIER DETAILS**


SCALE: 1/4" = 1'-0"	CONTRACT NO. 2
HOWARD, NEEDLES, TAMMEN & BERGENDOFF General Consultants	SHEET NO. 8 OF 19

RICHMOND EXPRESSWAY SYSTEM			
SECTION	PROJECT	SHEET NO.	TOTAL SHEETS
2	POWHITE PARKWAY	140	188

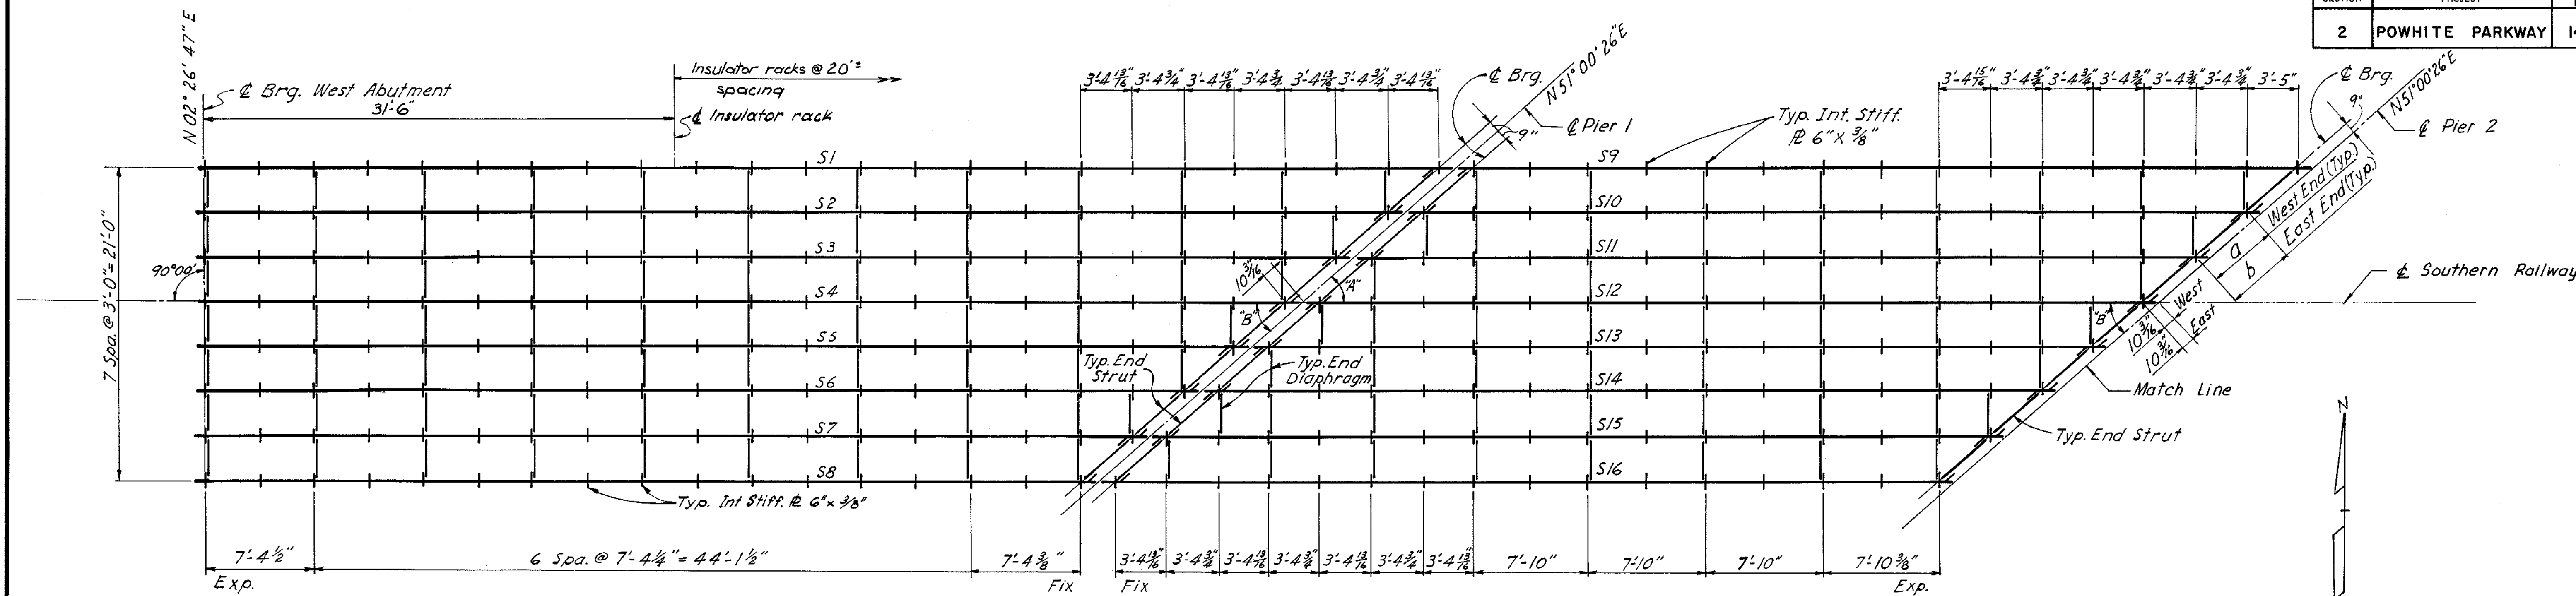

UNIT 1

UNIT 2

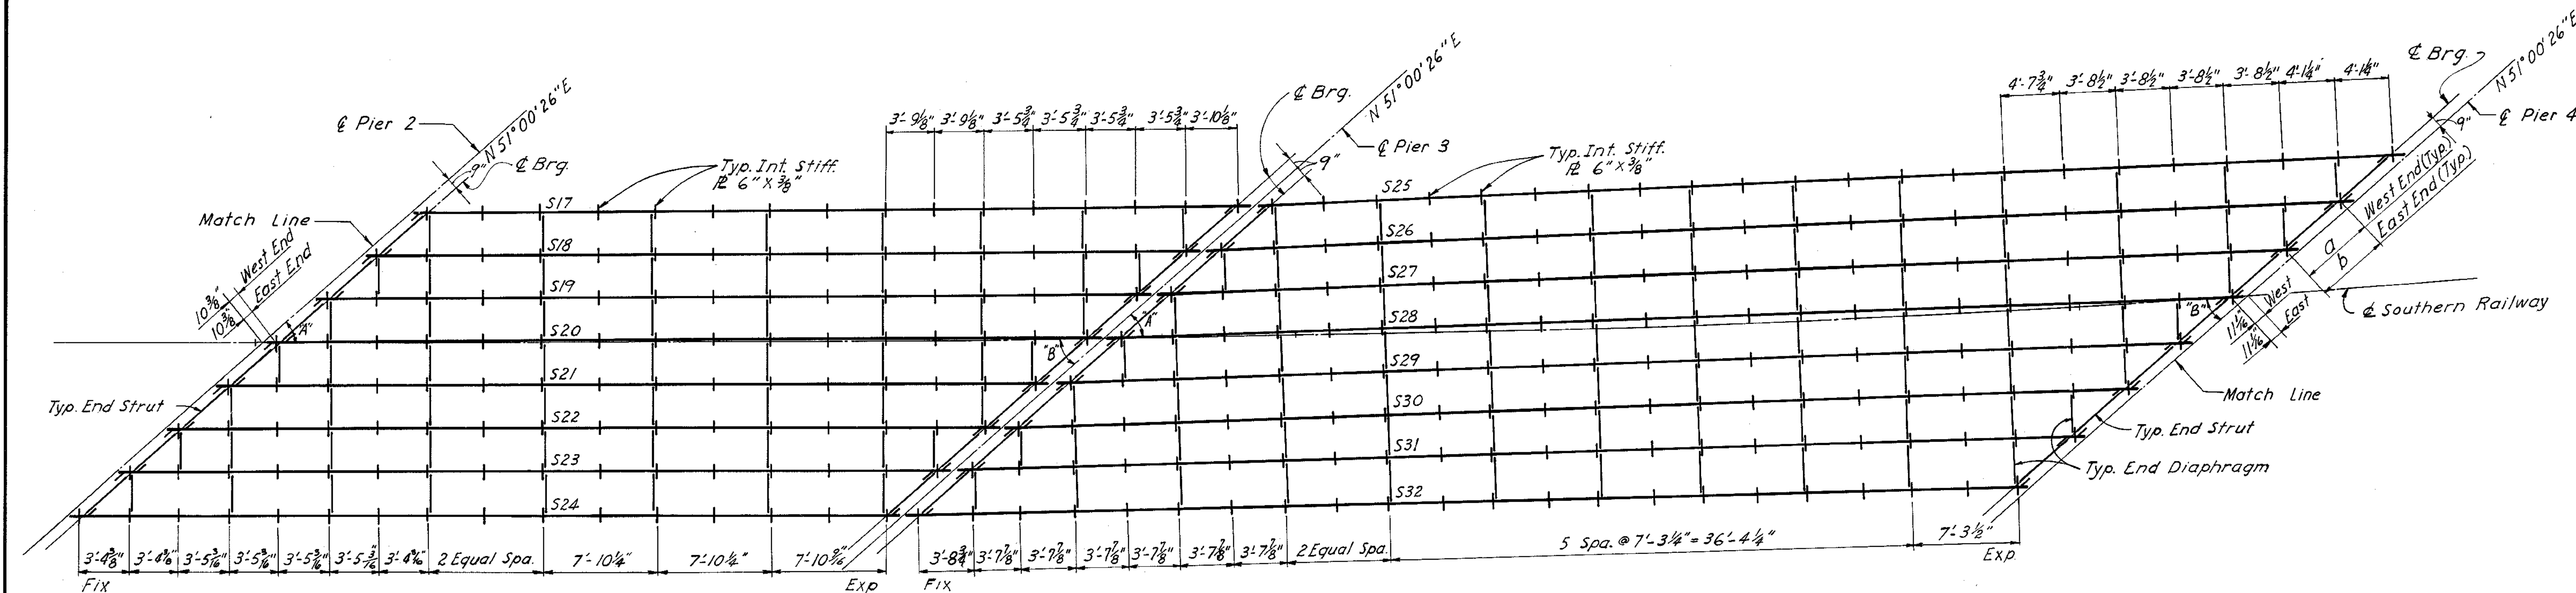

UNIT 3

UNIT 4

Note:  
See sh. 10 for shoe schedule.  
See Girder Details, Sheet 11, for dimensions not shown.  
Int. stiff. @ to be placed halfway between diaphragm connectors, unless otherwise shown.

**AS BUILT**

RICHMOND METROPOLITAN AUTHORITY  
RICHMOND EXPRESSWAY SYSTEM  
POWHITE PARKWAY

SOUTHERN RAILWAY OVER  
POWHITE PARKWAY  
BRIDGE B-05.

FRAMING PLAN

HAYES, SEAY, MATTERN & MATTERN  
Associate Engineers

HOWARD, NEEDLES, TAMMEN & BERGENDOFF  
General Consultants

SCALE: 3/16" = 1'-0"

CONTRACT NO.: 2

SHEET NO. 9 OF 19


MADE	BY	DATE	NO.	REVISION	BY	DATE	GIRDER	ANGLE "A"	ANGLE "B"	GIRDER	ANGLE "A"	ANGLE "B"	GIRDER	ANGLE "A"	ANGLE "B"
	H.B.	1-68	2	As BUILT	JRC	11-72	S1 Thru S8	90°00'00"	41°26'21"	S25	38°41'28"	38°41'28"	S39	35°52'18"	40°52'07"
							S9	41°25'19"	41°25'19"	S26	38°55'32"	38°55'32"	S40	36°14'36"	42°14'24"
							S10 Thru S16	41°26'21"	41°26'21"	S27 Thru S31	39°09'45"	39°09'45"	S41 Thru S48	37°45'11"	91°42'28"
							S17	40°30'28"	40°30'28"	S32	39°41'14"	39°41'14"			
							S18 Thru S22	40°53'59"	40°53'59"	S33	34°56'27"	40°56'15"			
							S23	41°12'35"	41°12'35"	S34	35°13'16"	41°13'04"			
							S24	41°31'24"	41°31'24"	S35 Thru S38	35°29'58"	41°29'46"			



Dimensions given along $\phi$ Brg.		
Location	West $a$	East $b$
S1-S2	3'-0"	4'-6 $\frac{3}{8}$ "
S2-S3	3'-0"	4'-6 $\frac{3}{8}$ "
S3-S4	3'-0"	4'-6 $\frac{3}{8}$ "
S4-S5	3'-0"	4'-6 $\frac{3}{8}$ "
S5-S6	3'-0"	4'-6 $\frac{3}{8}$ "
S6-S7	3'-0"	4'-6 $\frac{3}{8}$ "
S7-S8	3'-0"	4'-6 $\frac{3}{8}$ "
S9-S10	4'-6 $\frac{3}{8}$ "	4'-6 $\frac{1}{8}$ "
S10-S11	4'-6 $\frac{3}{8}$ "	4'-6 $\frac{3}{8}$ "
S11-S12	4'-6 $\frac{3}{8}$ "	4'-6 $\frac{3}{8}$ "
S12-S13	4'-6 $\frac{3}{8}$ "	4'-6 $\frac{3}{8}$ "
S13-S14	4'-6 $\frac{3}{8}$ "	4'-6 $\frac{3}{8}$ "
S14-S15	4'-6 $\frac{3}{8}$ "	4'-6 $\frac{3}{8}$ "
S15-S16	4'-6 $\frac{3}{8}$ "	4'-6 $\frac{1}{2}$ "
S17-S18	4'-5 $\frac{3}{8}$ "	5'-0 $\frac{3}{4}$ "
S18-S19	4'-7"	4'-7"
S19-S20	4'-7"	4'-7"
S20-S21	4'-7"	4'-7"
S21-S22	4'-7"	4'-7"
S22-S23	4'-5 $\frac{7}{8}$ "	4'-11 $\frac{3}{8}$ "
S23-S24	4'-5 $\frac{7}{8}$ "	4'-11 $\frac{3}{8}$ "
S25-S26	4'-9"	5'-3 $\frac{1}{8}$ "
S26-S27	4'-9"	5'-3 $\frac{1}{8}$ "
S27-S28	4'-9"	4'-9"
S28-S29	4'-9"	4'-9"
S29-S30	4'-9"	4'-9"
S30-S31	4'-9"	4'-9"
S31-S32	4'-10 $\frac{1}{4}$ "	5'-11 $\frac{3}{8}$ "
S33-S34	5'-0 $\frac{3}{4}$ "	5'-0 $\frac{3}{8}$ "
S34-S35	5'-0 $\frac{3}{4}$ "	5'-0 $\frac{3}{8}$ "
S35-S36	5'-2"	4'-6 $\frac{3}{8}$ "
S36-S37	5'-2"	4'-6 $\frac{3}{8}$ "
S37-S38	5'-2"	4'-6 $\frac{3}{8}$ "
S38-S39	4'-11 $\frac{1}{2}$ "	5'-2 $\frac{3}{4}$ "
S39-S40	4'-11 $\frac{1}{2}$ "	5'-2 $\frac{3}{4}$ "
S41-S42	4'-10 $\frac{3}{4}$ "	3'-0"
S42-S43	4'-10 $\frac{3}{4}$ "	3'-0"
S43-S44	4'-10 $\frac{3}{4}$ "	3'-0"
S44-S45	4'-10 $\frac{3}{4}$ "	3'-0"
S45-S46	4'-10 $\frac{3}{4}$ "	3'-0"
S46-S47	4'-10 $\frac{3}{4}$ "	3'-0"
S47-S48	4'-10 $\frac{3}{4}$ "	3'-0"

SHOE SCHEDULE		
Stringers	Exp. Shoe Type	Fix Shoe Type
S1-S5	B5E1	B5F1
S6-S24	B5E2	B5F2
S25-S32	B5E1	B5F1
S33-S40	B5E3	B5F3
S41-S46	B5E1	B5F1
S47-S48	B5E3	B5F3

RICHMOND EXPRESSWAY SYSTEM			
SECTION	PROJECT	SHEET NO.	TOTAL SHEETS
2	POWHITE PARKWAY	141	188

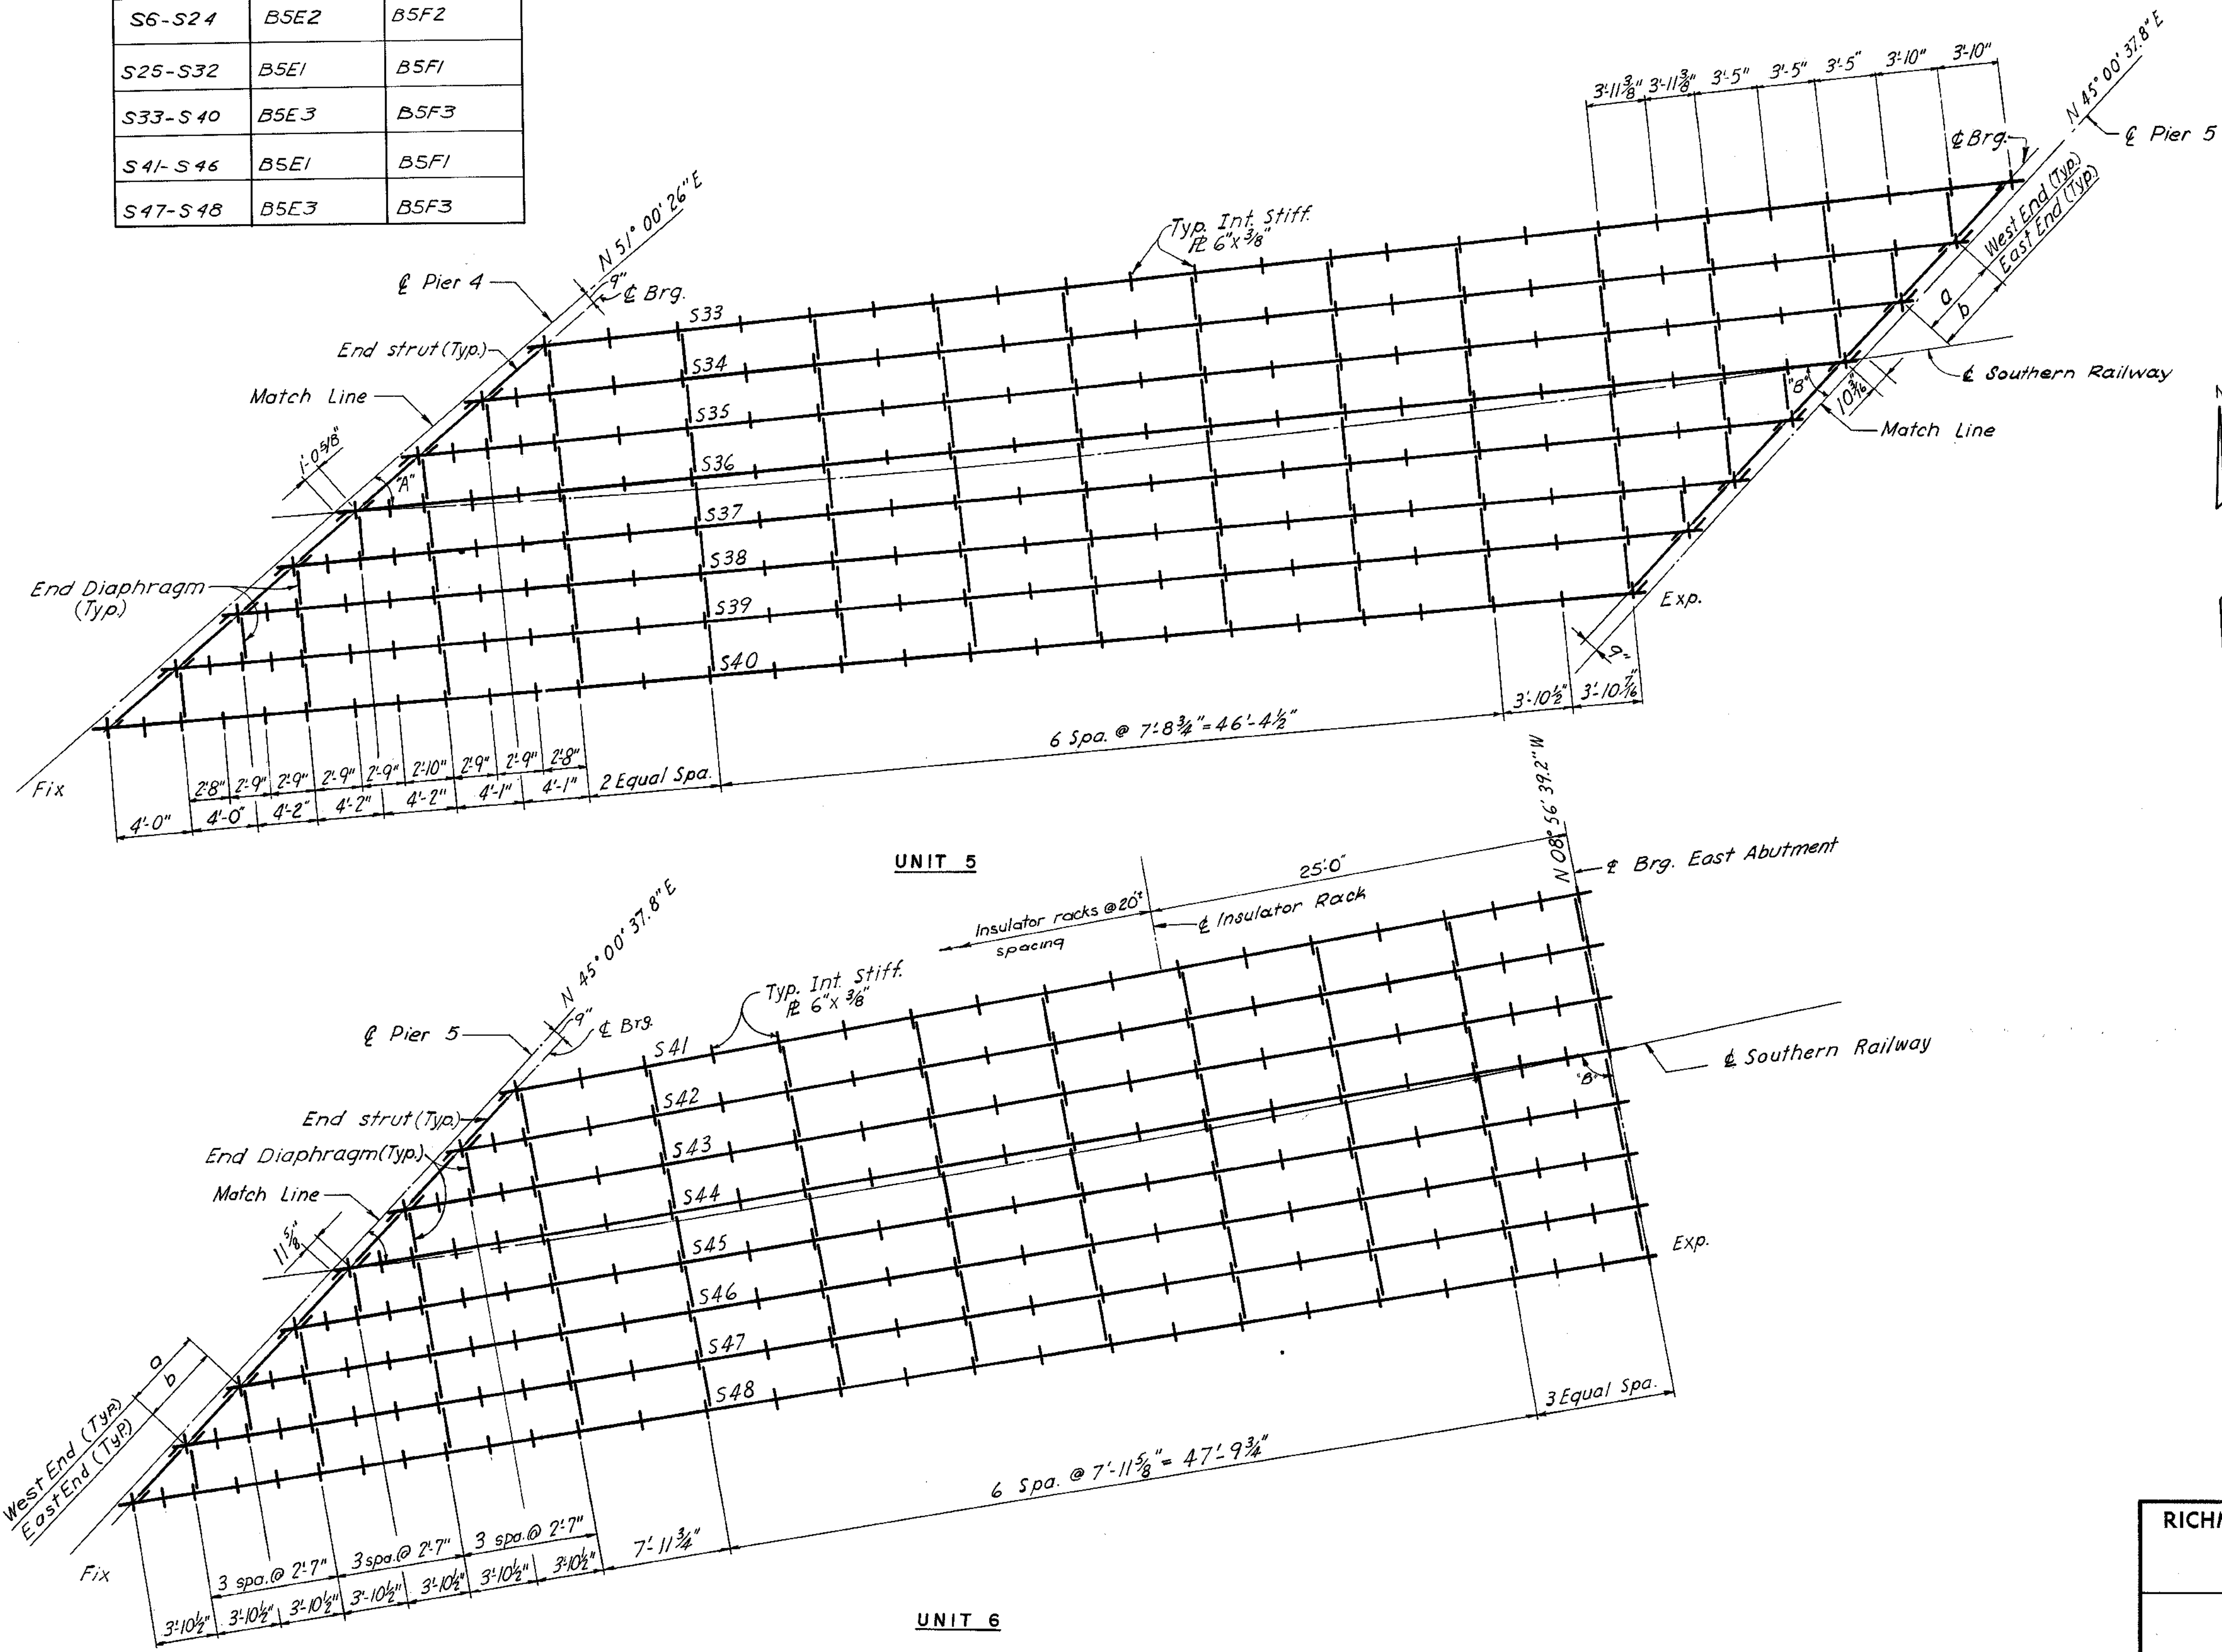

MADE	BY	DATE	NO.	REVISION	BY	DATE
	H.B.	1-68	2	As Built	JRC	11-72
CHECKED	T.H.M.	2-68	1	Drawn from Brg. Plan	DSB	6-68
IN CHARGE	JGD					

AS BUILT

**RICHMOND METROPOLITAN AUTHORITY**  
**RICHMOND EXPRESSWAY SYSTEM**  
 POWHITE PARKWAY


**SOUTHERN RAILWAY OVER**  
**POWHITE PARKWAY**  
 BRIDGE B-05

**FRAMING PLAN**

HAYES, SEAY, MATTERN & MATTERN Associate Engineers	SCALE: 3/16" = 1'-0" CONTRACT NO.: 2 SHEET NO. 10 OF 19
---	---

HOWARD, NEEDLES, TAMMEN & BERGENDOFF  
 General Consultants


GIRDER SUMMARY										
Girder Mark	PLATE A			PLATE B			Dimension			Brg. Stiff.
	Size	Length	Weld A	Size	Length	Weld B	C	D	E	
S1	18"x1 1/8"	16'-9 3/4"	3/8	18"x2 3/4"	51'-0"	1/2	1'-3"	82'-7 7/8"	1'-1 5/8"	8"x1"
S2	18"x1 3/8"	16'-10 5/8"	3/8	18"x2 1/2"	47'-6"	1/2		79'-3 1/8"		
S-3	18"x1 1/2"	15'-1 1/8"	3/8	18"x2 1/4"	47'-6"	3/8		75'-10 3/8"		
S-4	18"x1 1/2"	16'-5 3/4"	3/8	18"x2 3/8"	41'-6"	3/8		72'-5 1/2"		
S5	18"x1 1/4"	14'-9 1/8"	3/8	18"x1 3/8"	41'-6"	3/8		69'-0 3/4"		
S6	18"x1 1/8"	14'-3 3/4"	3/8	18"x1 3/8"	39'-0"	3/8		65'-7 1/8"		
S7	18"x1"	13'-7 3/8"	3/8	18"x1 1/2"	37'-0"	3/8		62'-3 3/8"		
S8	18"x 7/8"	13'-2"	3/8	18"x1 1/4"	34'-6"	3/8	1'-3"	58'-10 3/8"	1'-1 5/8"	8"x1"
S9	18"x 7/8"	14'-0 5/8"	3/8	18"x1 3/8"	29'-0"	3/8	1'-1 5/8"	55'-2 3/8"	1'-1 5/8"	8"x 3/4"
S10-S16	18"x 7/8"	14'-0 1/2"	3/8			3/8	1'-1 5/8"	55'-1 1/8"	1'-1 5/8"	
S17	18"x 7/8"	14'-7"	3/8			3/8	1'-1 7/8"	56'-2 1/4"	1'-1 7/8"	
S18	18"x 7/8"	14'-4 3/8"	3/8			3/8	1'-1 3/4"	55'-8 3/8"	1'-1 3/4"	
S19	18"x 7/8"	14'-4 3/8"	3/8			3/8	1'-1 3/4"	55'-8 3/8"	1'-1 3/4"	
S20	18"x 7/8"	14'-4 3/8"	3/8			3/8	1'-1 3/4"	55'-8 3/8"	1'-1 3/4"	
S21	18"x 7/8"	14'-4 3/8"	3/8			3/8	1'-1 3/4"	55'-8 3/8"	1'-1 3/4"	
S22	18"x 7/8"	14'-4 3/8"	3/8			3/8	1'-1 3/4"	55'-8 3/8"	1'-1 3/4"	
S23	18"x 7/8"	14'-2"	3/8			3/8	1'-1 3/4"	55'-8 3/8"	1'-1 3/4"	
S24	18"x 7/8"	13'-11 1/8"	3/8	18"x1 1/8"	29'-0"	3/8	1'-1 3/4"	55'-0 3/8"	1'-1 3/4"	8"x 3/4"
S25	18"x1 1/8"	16'-3 15/16"	3/8	18"x2 3/8"	47'-0"	1/2	1'-2 3/8"	77'-7 1/8"	1'-2 3/8"	8"x 7/8"
S26	18"x1 1/8"	16'-1 1/2"	3/8	18"x2 3/8"	47'-0"	1/2	1'-2 3/8"	77'-2 3/8"	1'-2 3/8"	8"x 7/8"
S27		15'-11 1/8"	3/8			1/2	1'-2 1/4"	76'-9 5/8"	1'-2 1/4"	
S28		15'-11 1/8"	3/8			1/2	1'-2 1/4"	76'-9 5/8"	1'-2 1/4"	
S29		15'-11 1/8"	3/8			1/2	1'-2 1/4"	76'-9 5/8"	1'-2 1/4"	
S30		15'-11 1/8"	3/8			1/2	1'-2 1/4"	76'-9 5/8"	1'-2 1/4"	
S31		15'-11 1/8"	3/8			1/2	1'-2 1/4"	76'-9 5/8"	1'-2 1/4"	
S32	18"x1 3/8"	15'-5 3/8"	3/8	18"x2 3/8"	47'-0"	1/2	1'-2 3/8"	75'-11 1/8"	1'-2 3/8"	8"x 7/8"
S33	20"x2"	17'-4"	3/8	20"x2 3/8"	54'-0"	1/2	1'-3 3/8"	86'-6 1/2"	1'-1 3/4"	9"x1"
S34		17'-5 3/8"	3/8			1/2	1'-3 5/8"	86'-10 3/8"	1'-1 3/8"	
S35		17'-7 1/8"	3/8			1/2	1'-3 1/2"	87'-2 1/4"	1'-1 5/8"	
S36		18'-0 3/8"	3/8	20"x2 3/8"	54'-0"	1/2	1'-3 1/2"	88'-0"	1'-1 5/8"	9"x1"
S37		16'-11 3/8"	3/8	20"x3"	57'-0"	1/2	1'-3 1/2"	88'-9 3/4"	1'-1 5/8"	
S38		17'-4 5/8"	3/8			1/2	1'-3 1/2"	89'-7 1/2"	1'-1 5/8"	
S39		17'-4 5/8"	3/8			1/2	1'-3 3/8"	89'-9"	1'-1 1/2"	
S40	20"x2"	17'-5 3/8"	3/8	20"x3"	57'-0"	1/2	1'-3 1/2"	89'-10 5/8"	1'-1 5/8"	9"x1"
S41	18"x1 1/8"	14'-2 1/2"	3/8	18"x1 3/8"	36'-6"	1/2	1'-2 3/8"	62'-9 3/8"	1'-3"	8"x1"
S42	18"x1 1/4"	14'-5 1/4"	3/8	18"x1 3/4"	40'-0"	3/8	1'-2 3/8"	66'-8 3/8"	1'-3"	
S43	18"x1 3/8"	14'-8 3/8"	3/8	18"x2"	43'-6"	3/8	1'-2 5/8"	70'-8 1/2"	1'-3"	
S44	18"x1 1/2"	15'-1 7/8"	3/8	18"x2 1/4"	46'-6"	3/8	1'-2 5/8"	74'-8 1/2"	1'-3"	
S45	18"x1 3/4"	16'-7 5/8"	3/8	18"x2 1/2"	47'-6"	1/2	1'-2 5/8"	78'-7 5/8"	1'-3"	
S46	18"x1 7/8"	16'-6 5/8"	3/8	18"x2 3/4"	51'-6"	1/2	1'-2 5/8"	82'-6 1/4"	1'-3"	8"x1"
S47	20"x1 1/8"	17'-7 1/8"	3/8	20"x2 3/4"	53'-6"	1/2	1'-2 5/8"	86'-6 3/4"	1'-3"	9"x1"
S48	20"x2"	17'-10"	3/8	20"x3"	57'-0"	1/2	1'-2 5/8"	90'-6 3/8"	1'-3"	9"x1"

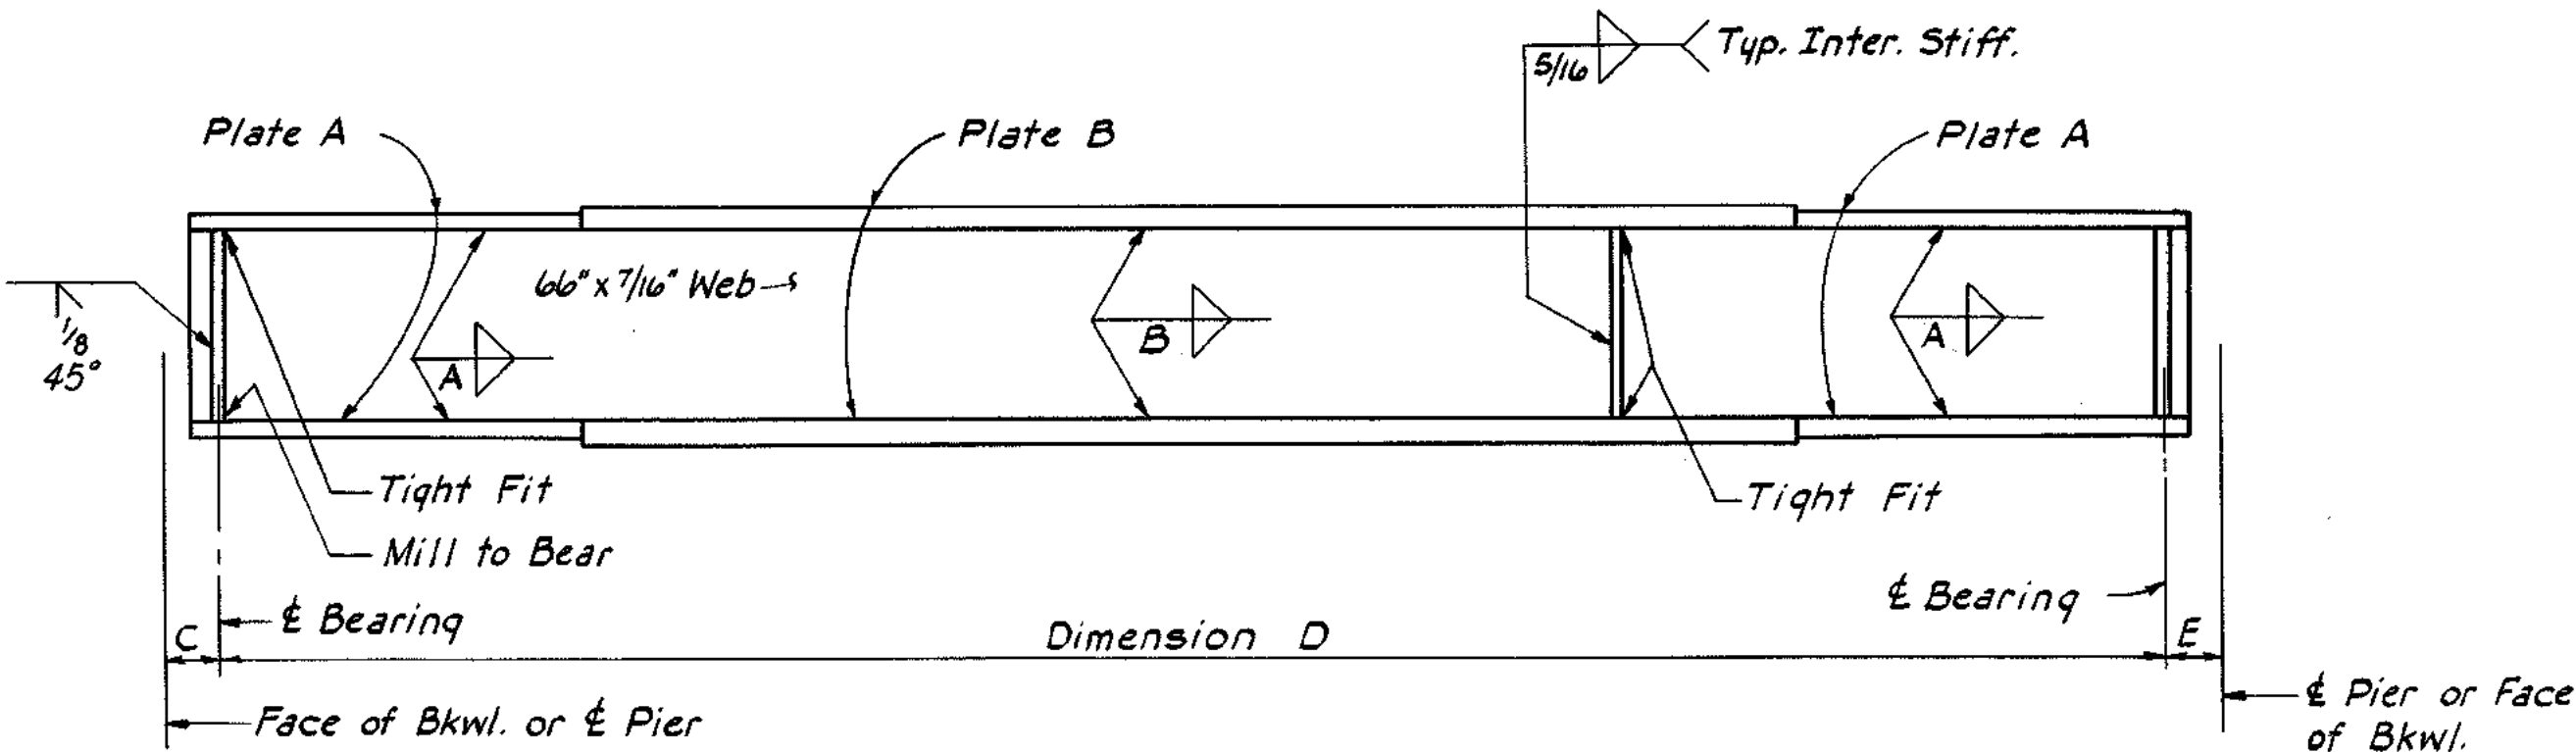


GIRDER DETAIL  
No Scale

DEAD LOAD DEFLECTION SUMMARY	
Girder Mark	Total Dead Load Defl. @ Girder
S1, S2	1/2"
S3	7/16"
S4	3/8"
S5, S6	5/16"
S7, S8	1/4"
S9, S24	3/16"
S25, S32	7/16"
S33, S38	9/16"
S39, S40	5/8"
S41	1/4"
S42	5/16"
S43, S44	3/8"
S45	7/16"
S46	1/2"
S47	9/16"
S48	5/8"


The above deflections are those anticipated to occur in the girder upon placement of the total dead load. The girders shall not be cambered to compensate for this deflection.

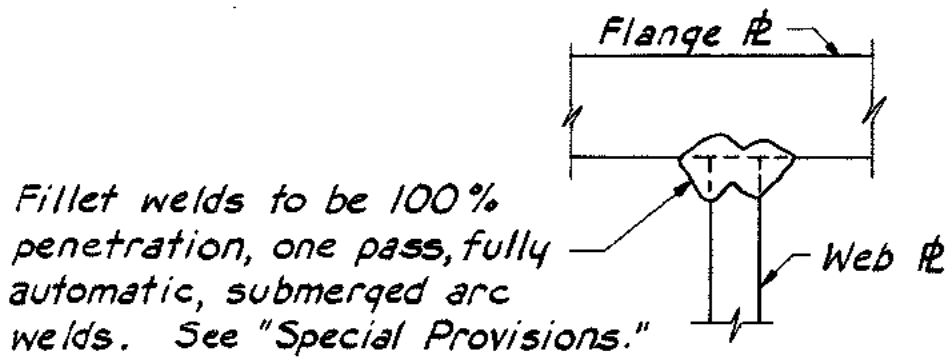

FLANGE PLATE WELDS  
No Scale

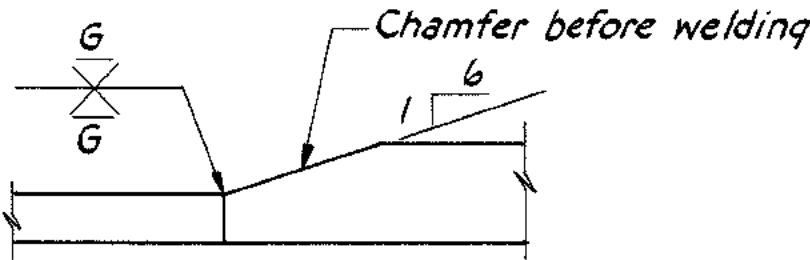

FLANGE THICKNESS TRANSITION  
No Scale

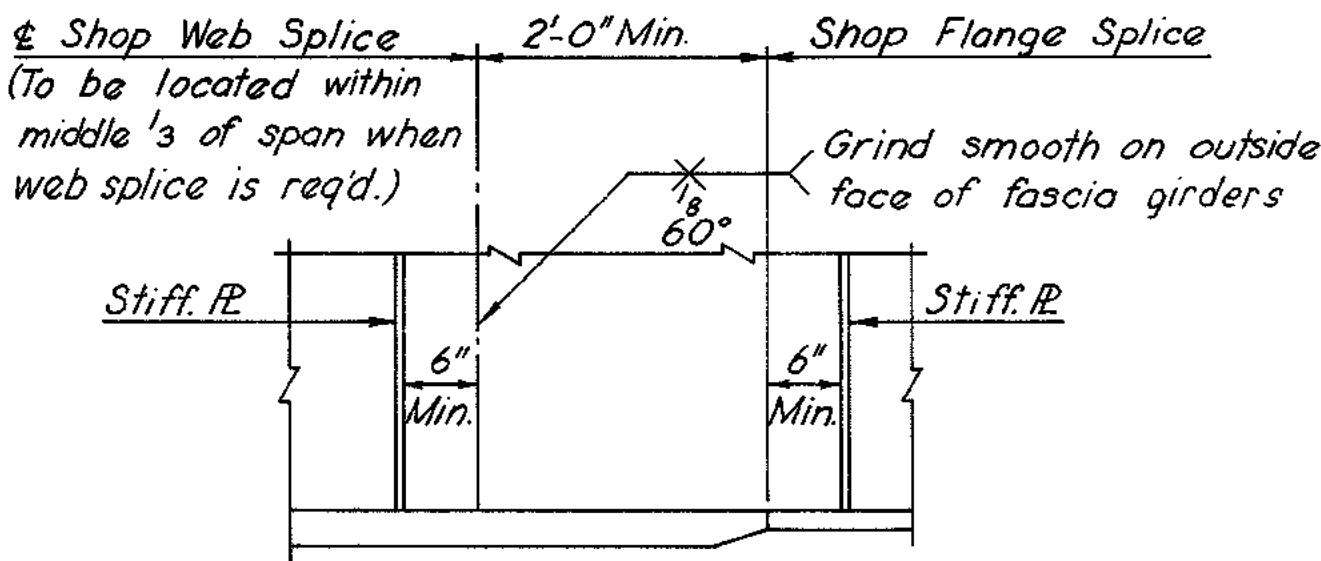

SHOP SPLICE DETAILS  
Scale: 3/4"=1'-0"

BY	DATE				
MADE	H.B.	1-68	2	As Built	JRC 11-72
CHECKED	THN	2-68	1	Girder Summary	T.E.M. 6-68
IN CHARGE	JGD				

AS BUILT

RICHMOND METROPOLITAN AUTHORITY  
RICHMOND EXPRESSWAY SYSTEM  
POWHITE PARKWAY

SOUTHERN RAILWAY OVER  
POWHITE PARKWAY  
BRIDGE B-05


GIRDER DETAILS

HAYES, SEAY, MATTERN & MATTERN  
Associate Engineers

HOWARD, NEEDLES, TAMMEN & BERGENDOFF  
General Consultants


SCALE: NO SCALE  
CONTRACT NO.: 2  
SHEET NO. 11 OF 19

RICHMOND EXPRESSWAY SYSTEM			
SECTION	PROJECT	SHEET NO.	TOTAL SHEETS
2	POWHITE PARKWAY	143	188

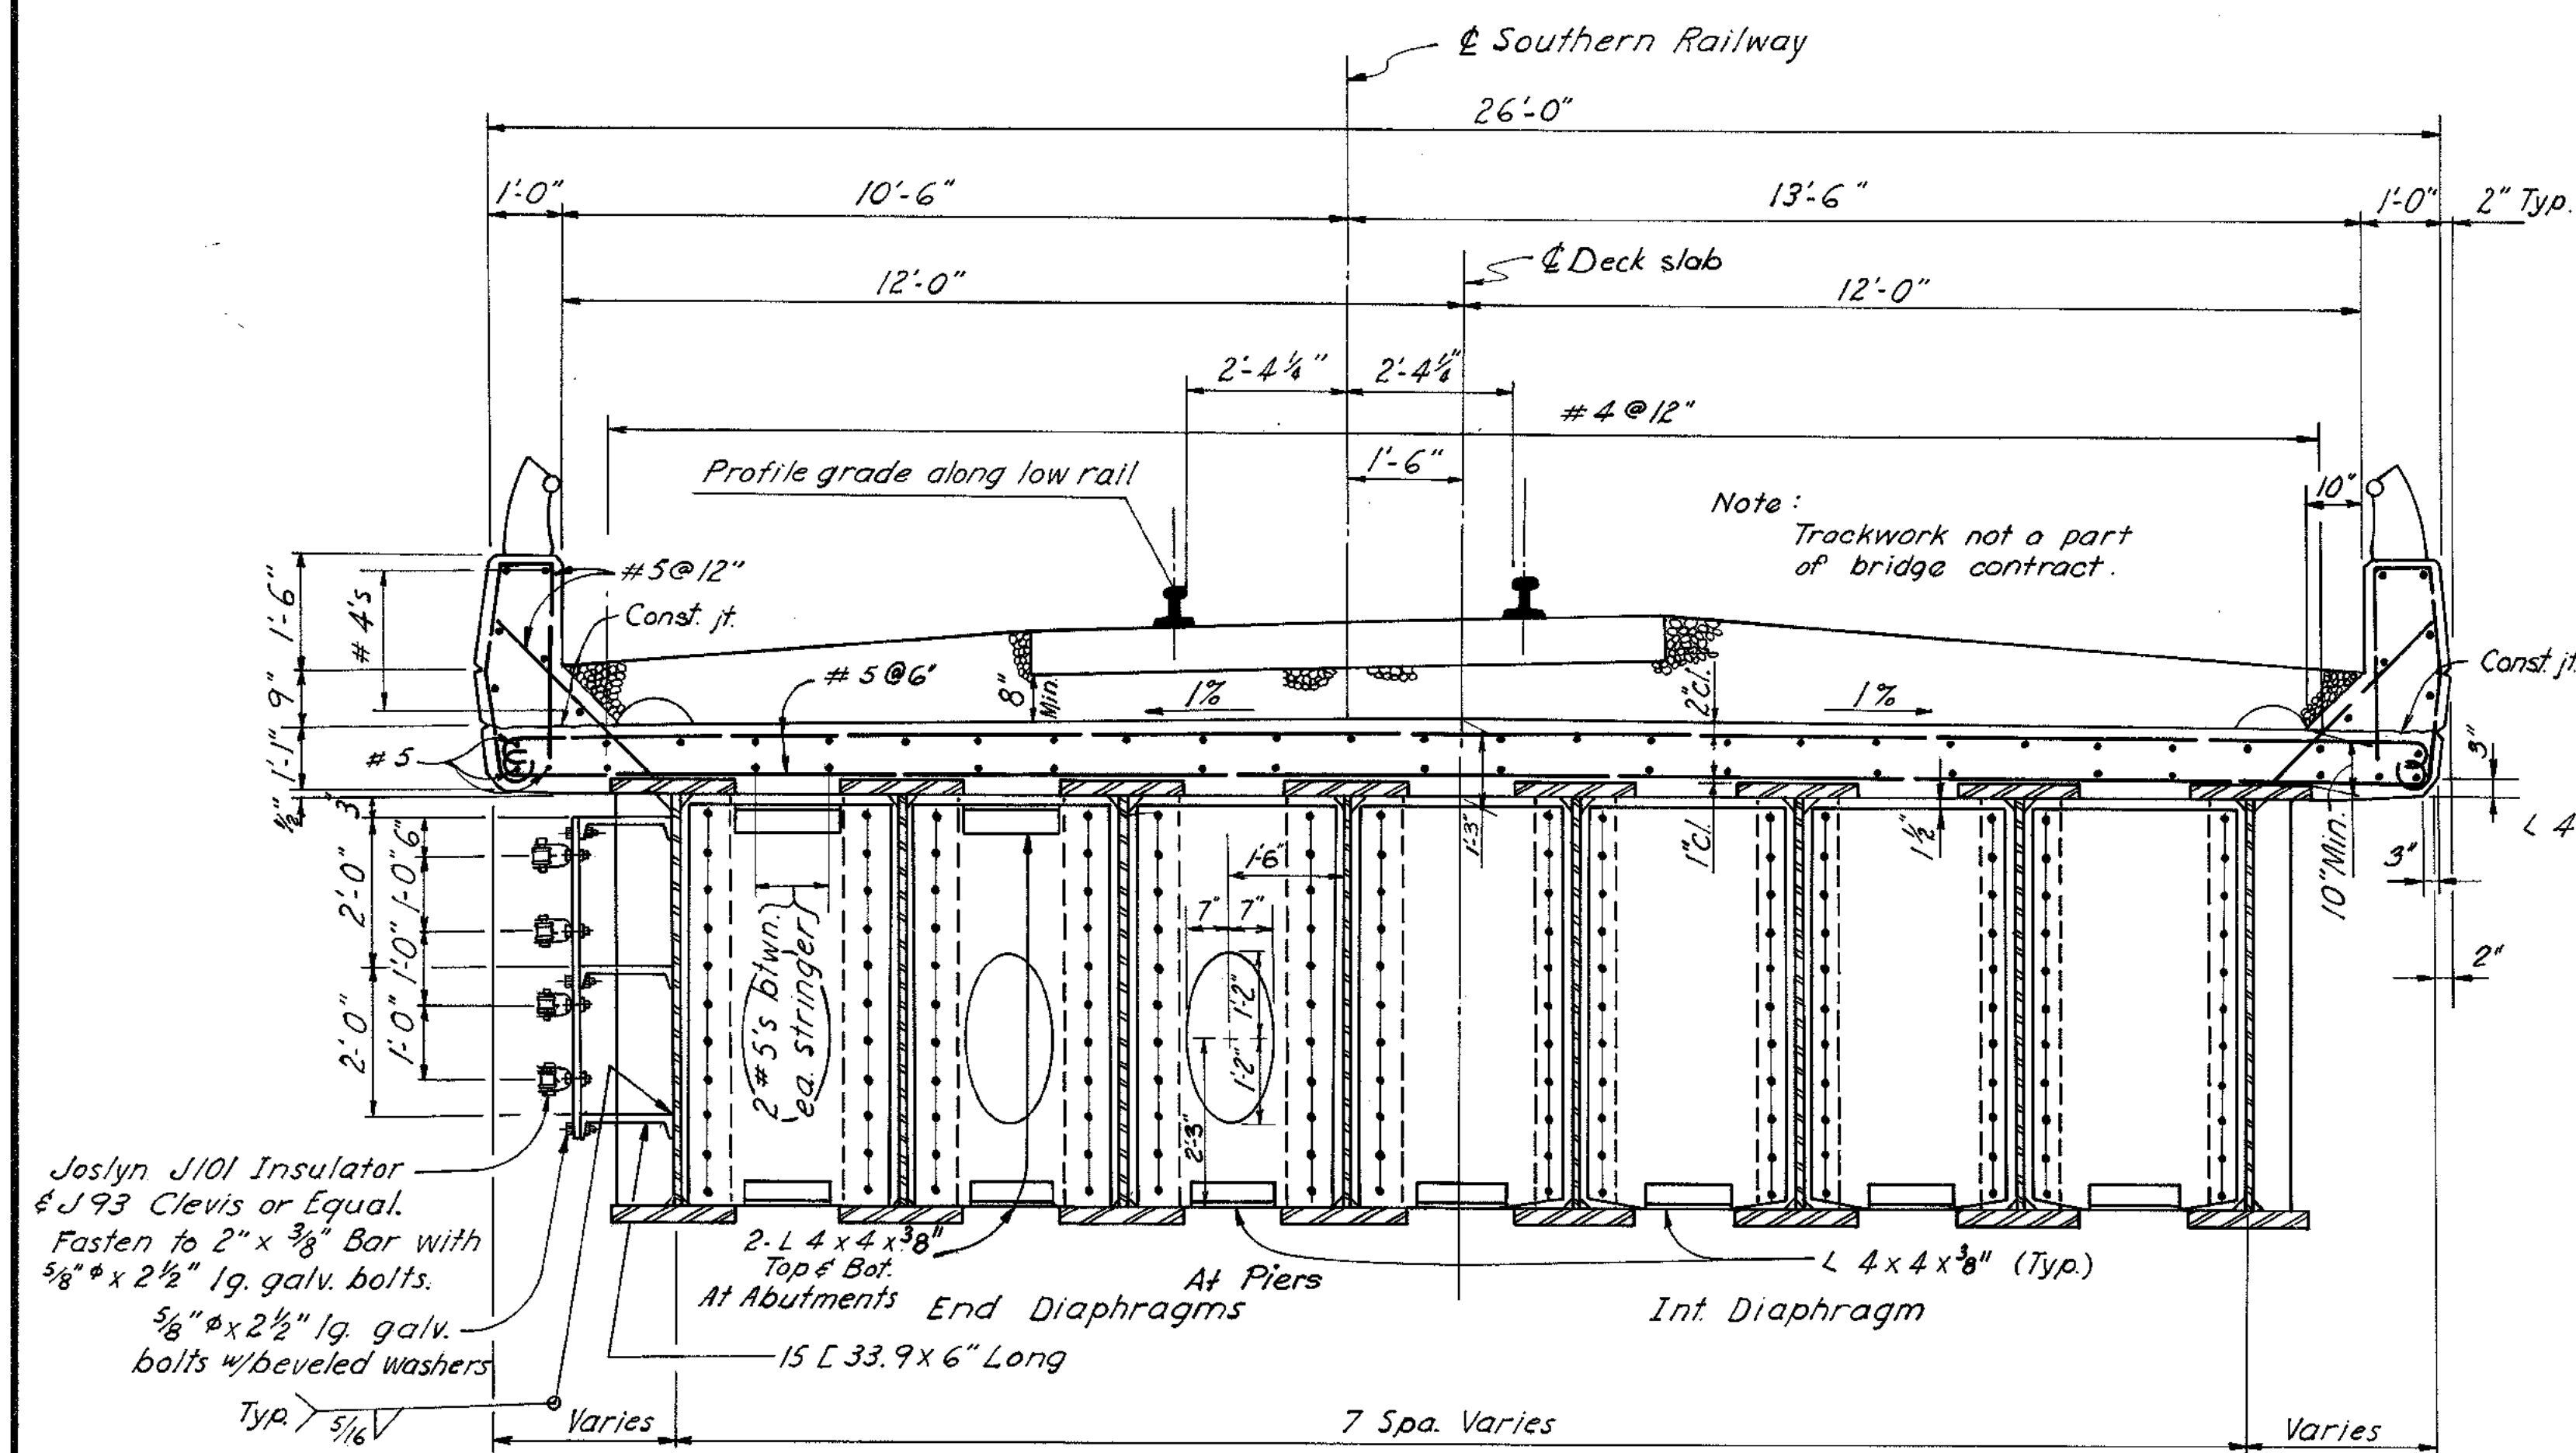


NOTE:  
Space racks 20'-0" apart along girders.  
Fasten high frequency wires to inside of  
insulators (Max. tension 250 #).


TYPICAL TRANSVERSE SECTION  
Scale: 1/2" = 1'-0"

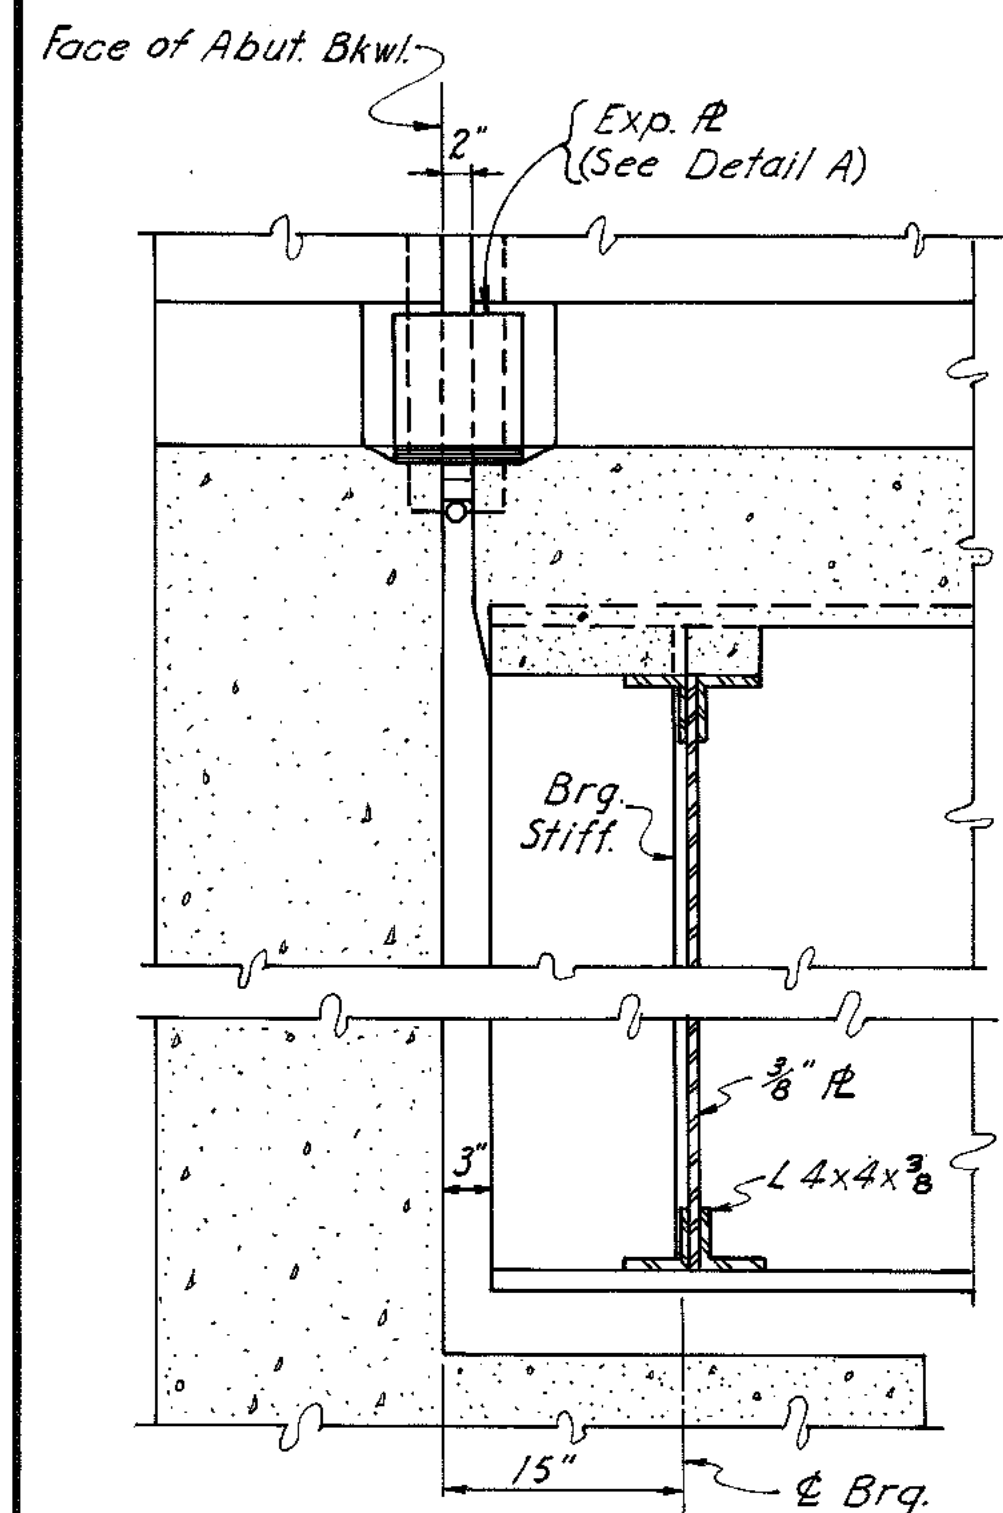


SECTION AT ABUTMENT  
Scale: 1" = 1'-0"

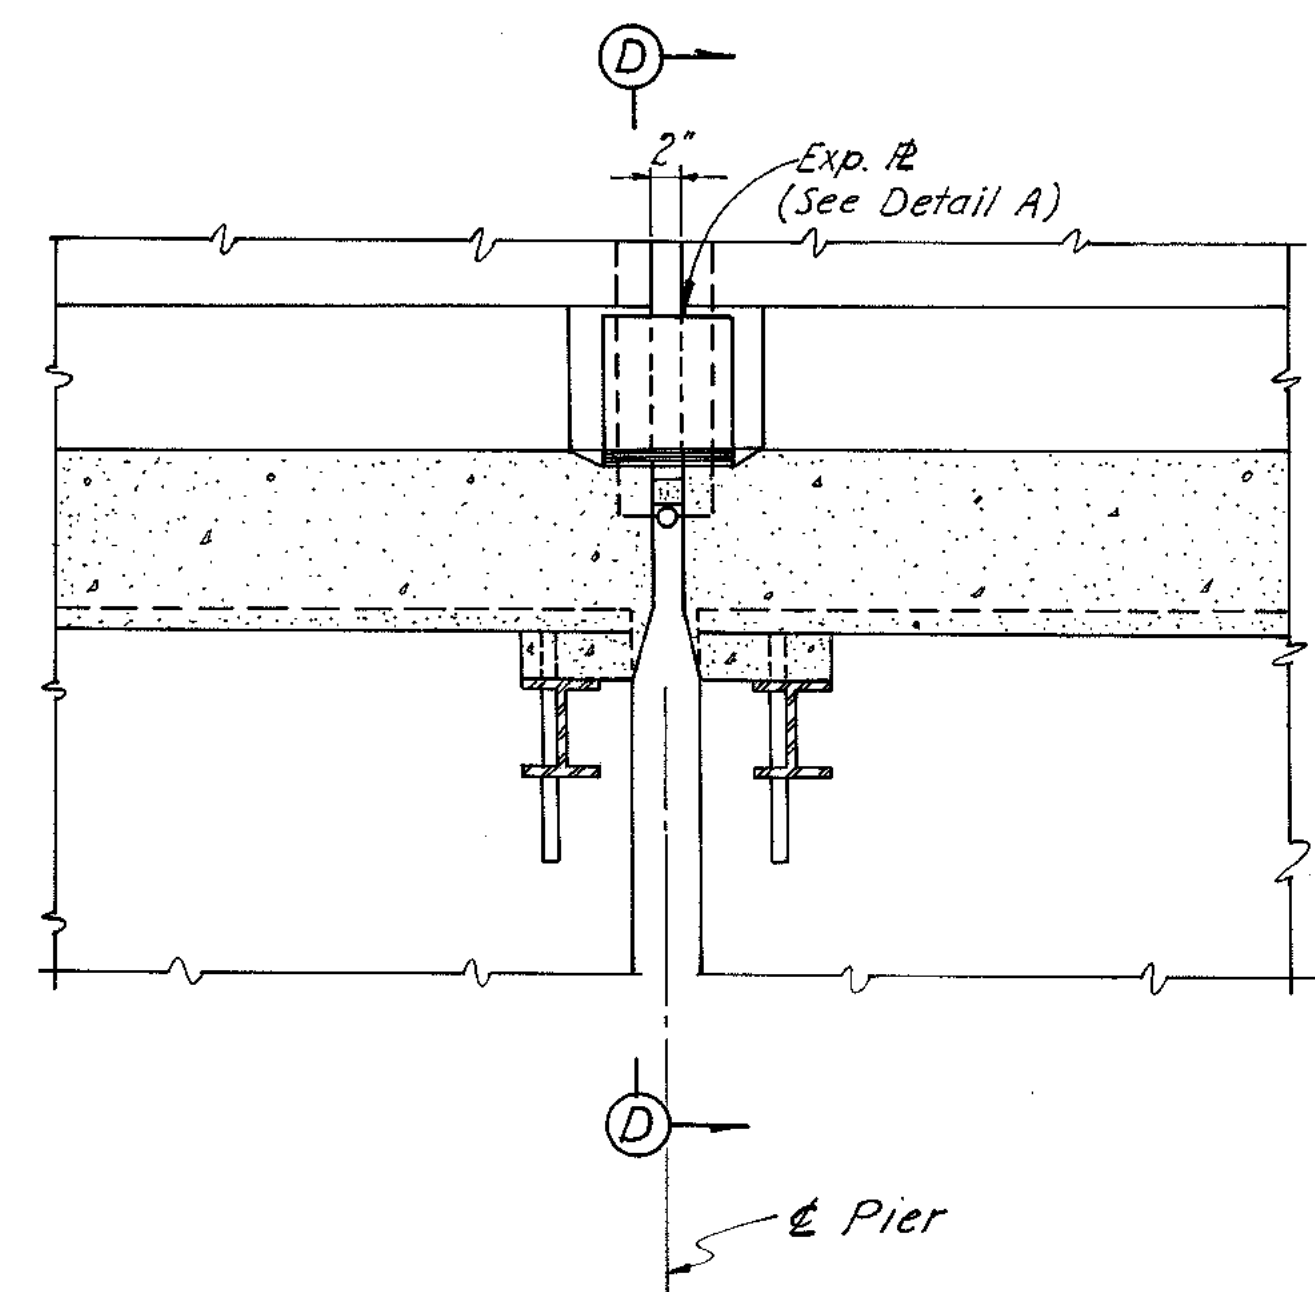

SECTION AT PIER  
Scale: 1" = 1'-0"

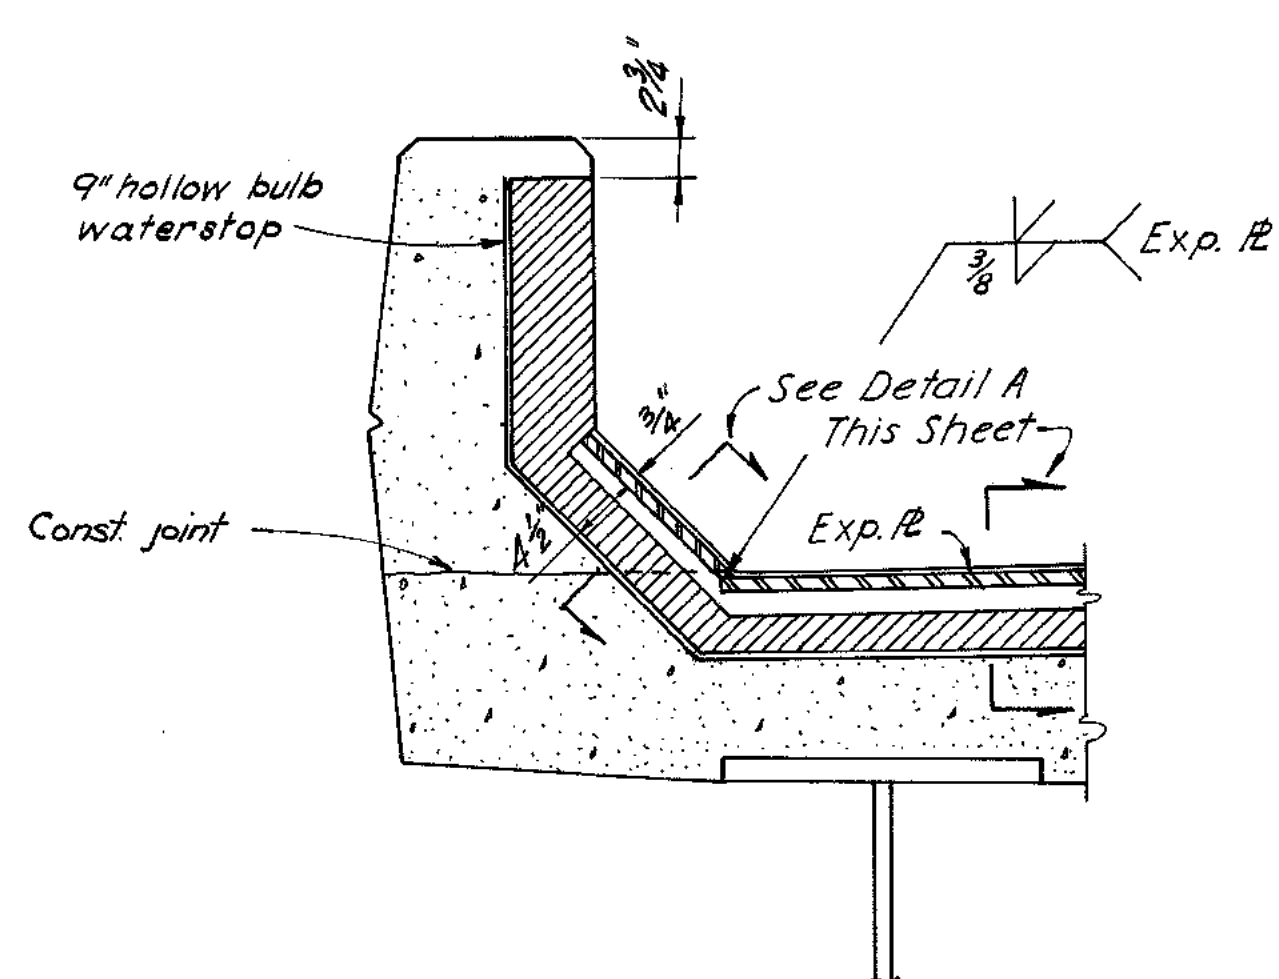


SECTION D-D  
Scale: 1" = 1'-0"

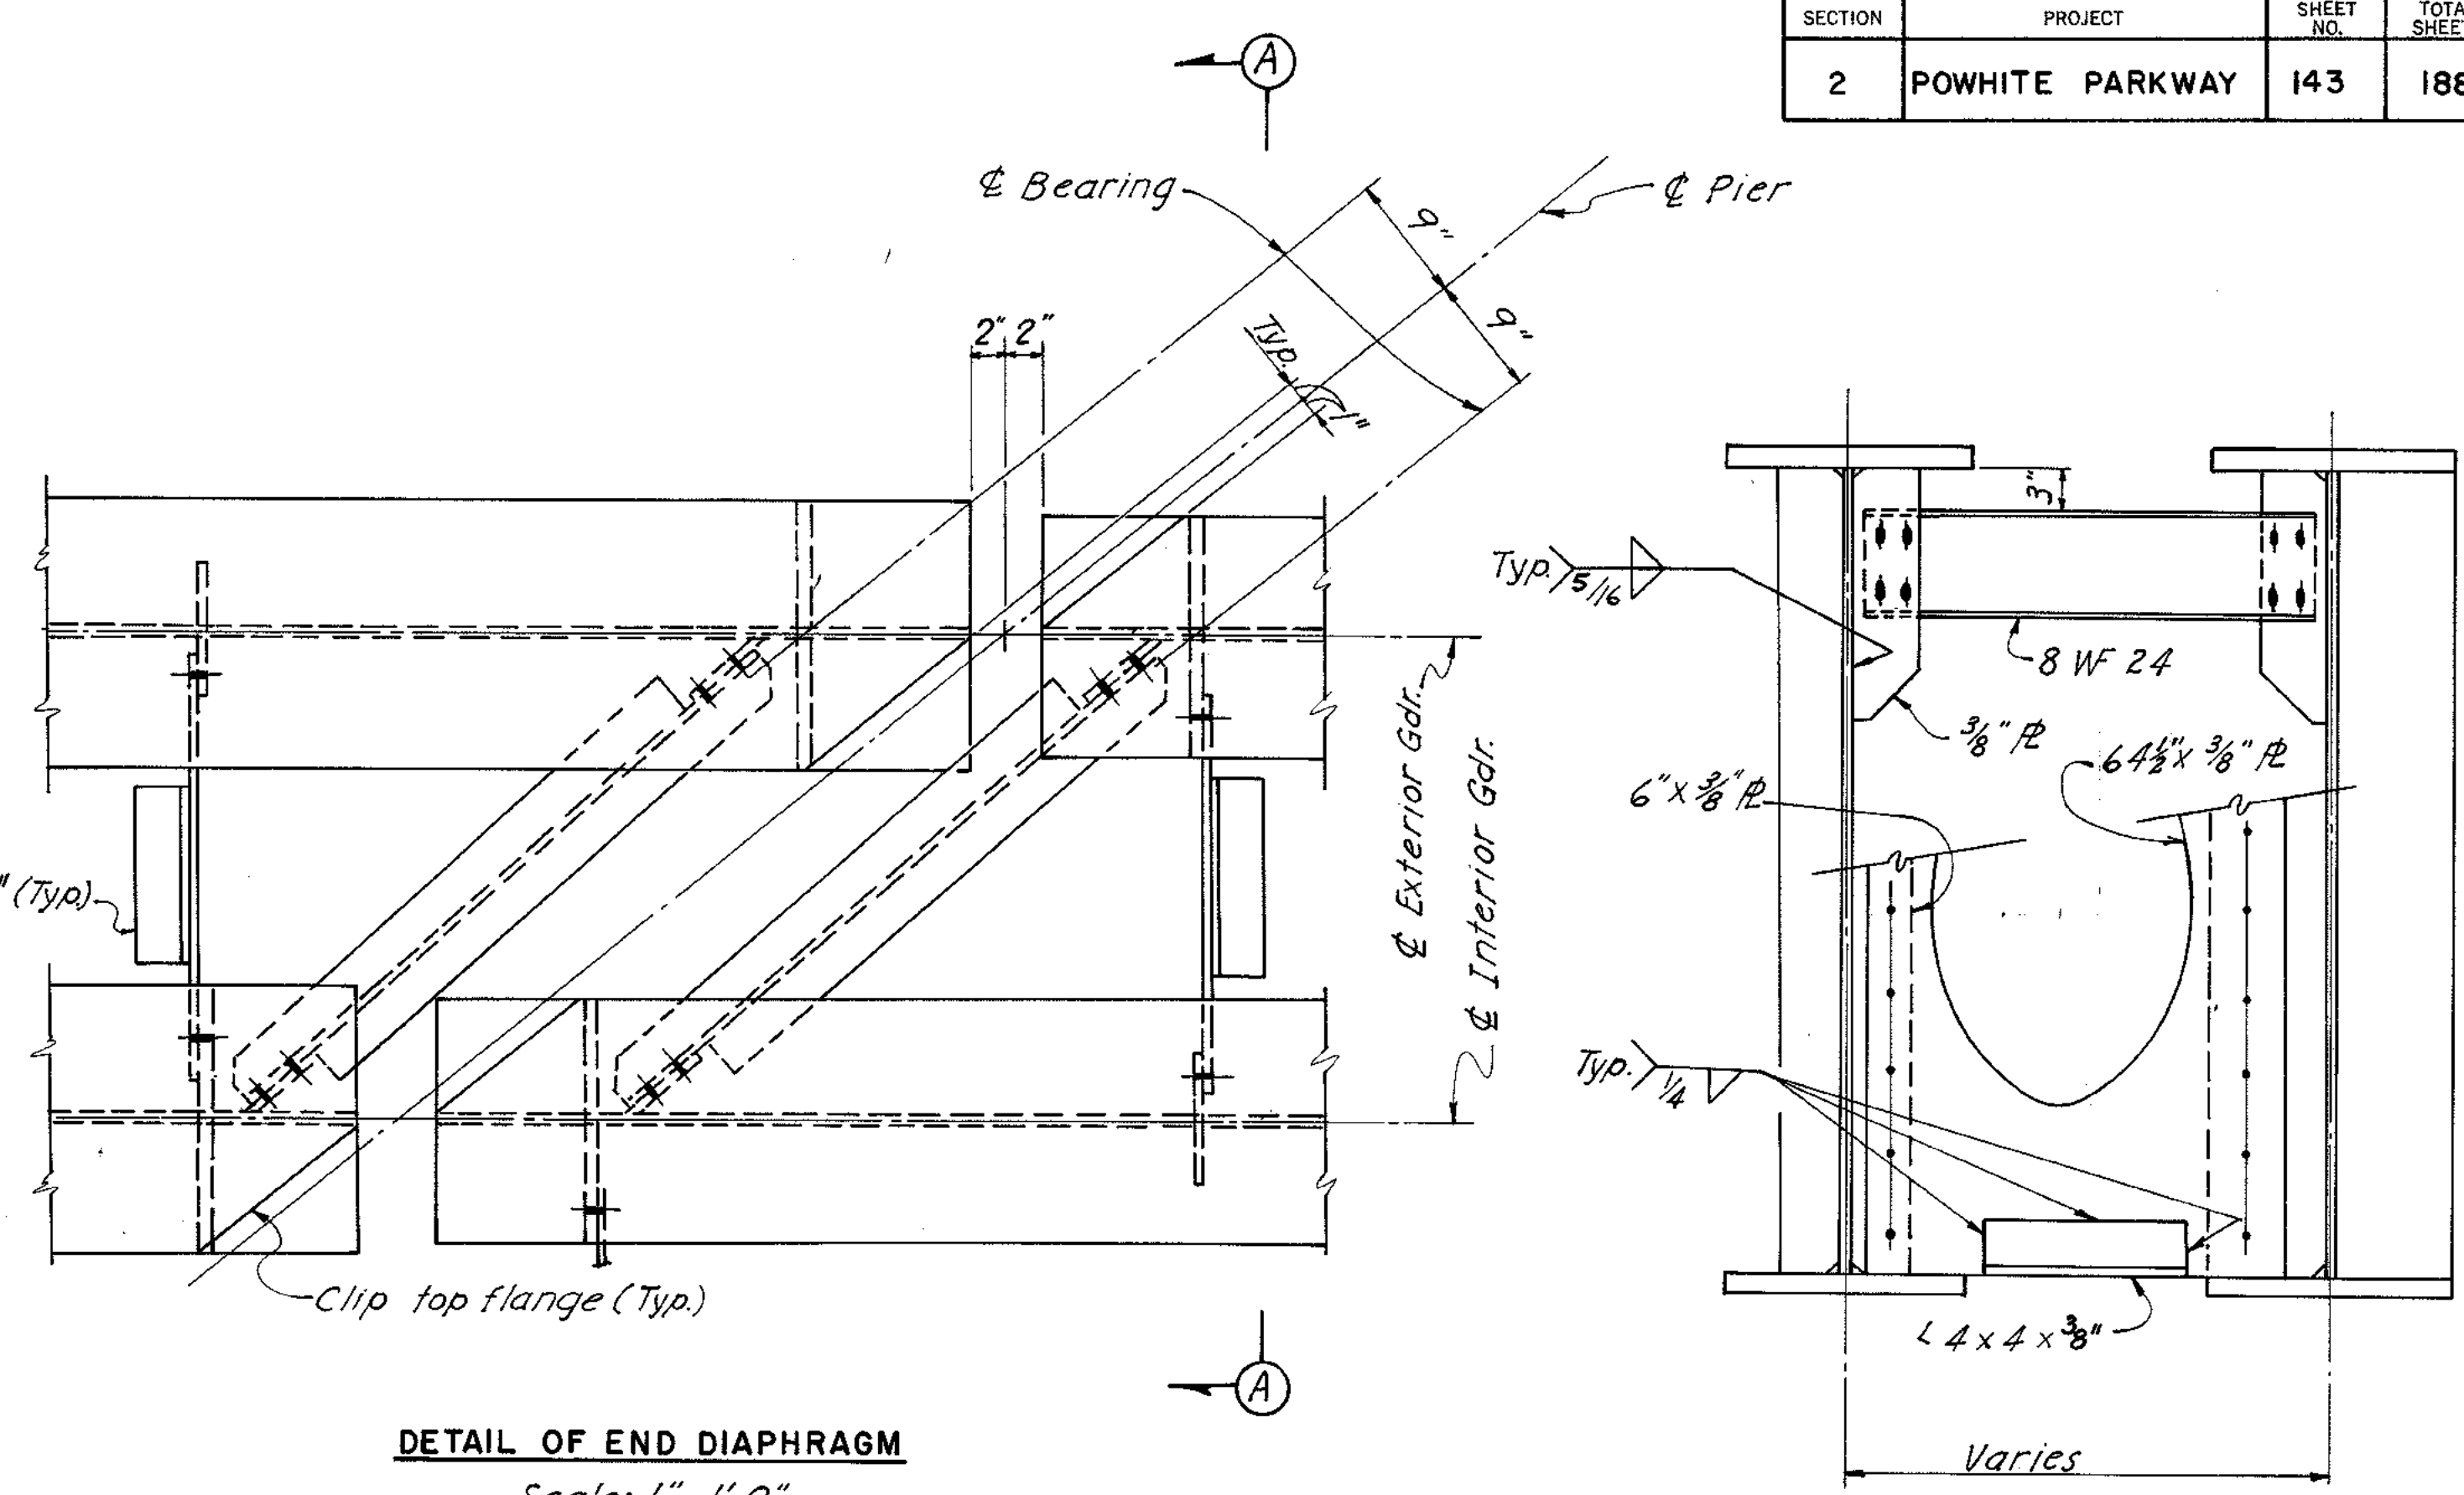

DETAIL OF END DIAPHRAGM  
Scale: 1" = 1'-0"

SECTION A-A  
Scale: 1" = 1'-0"

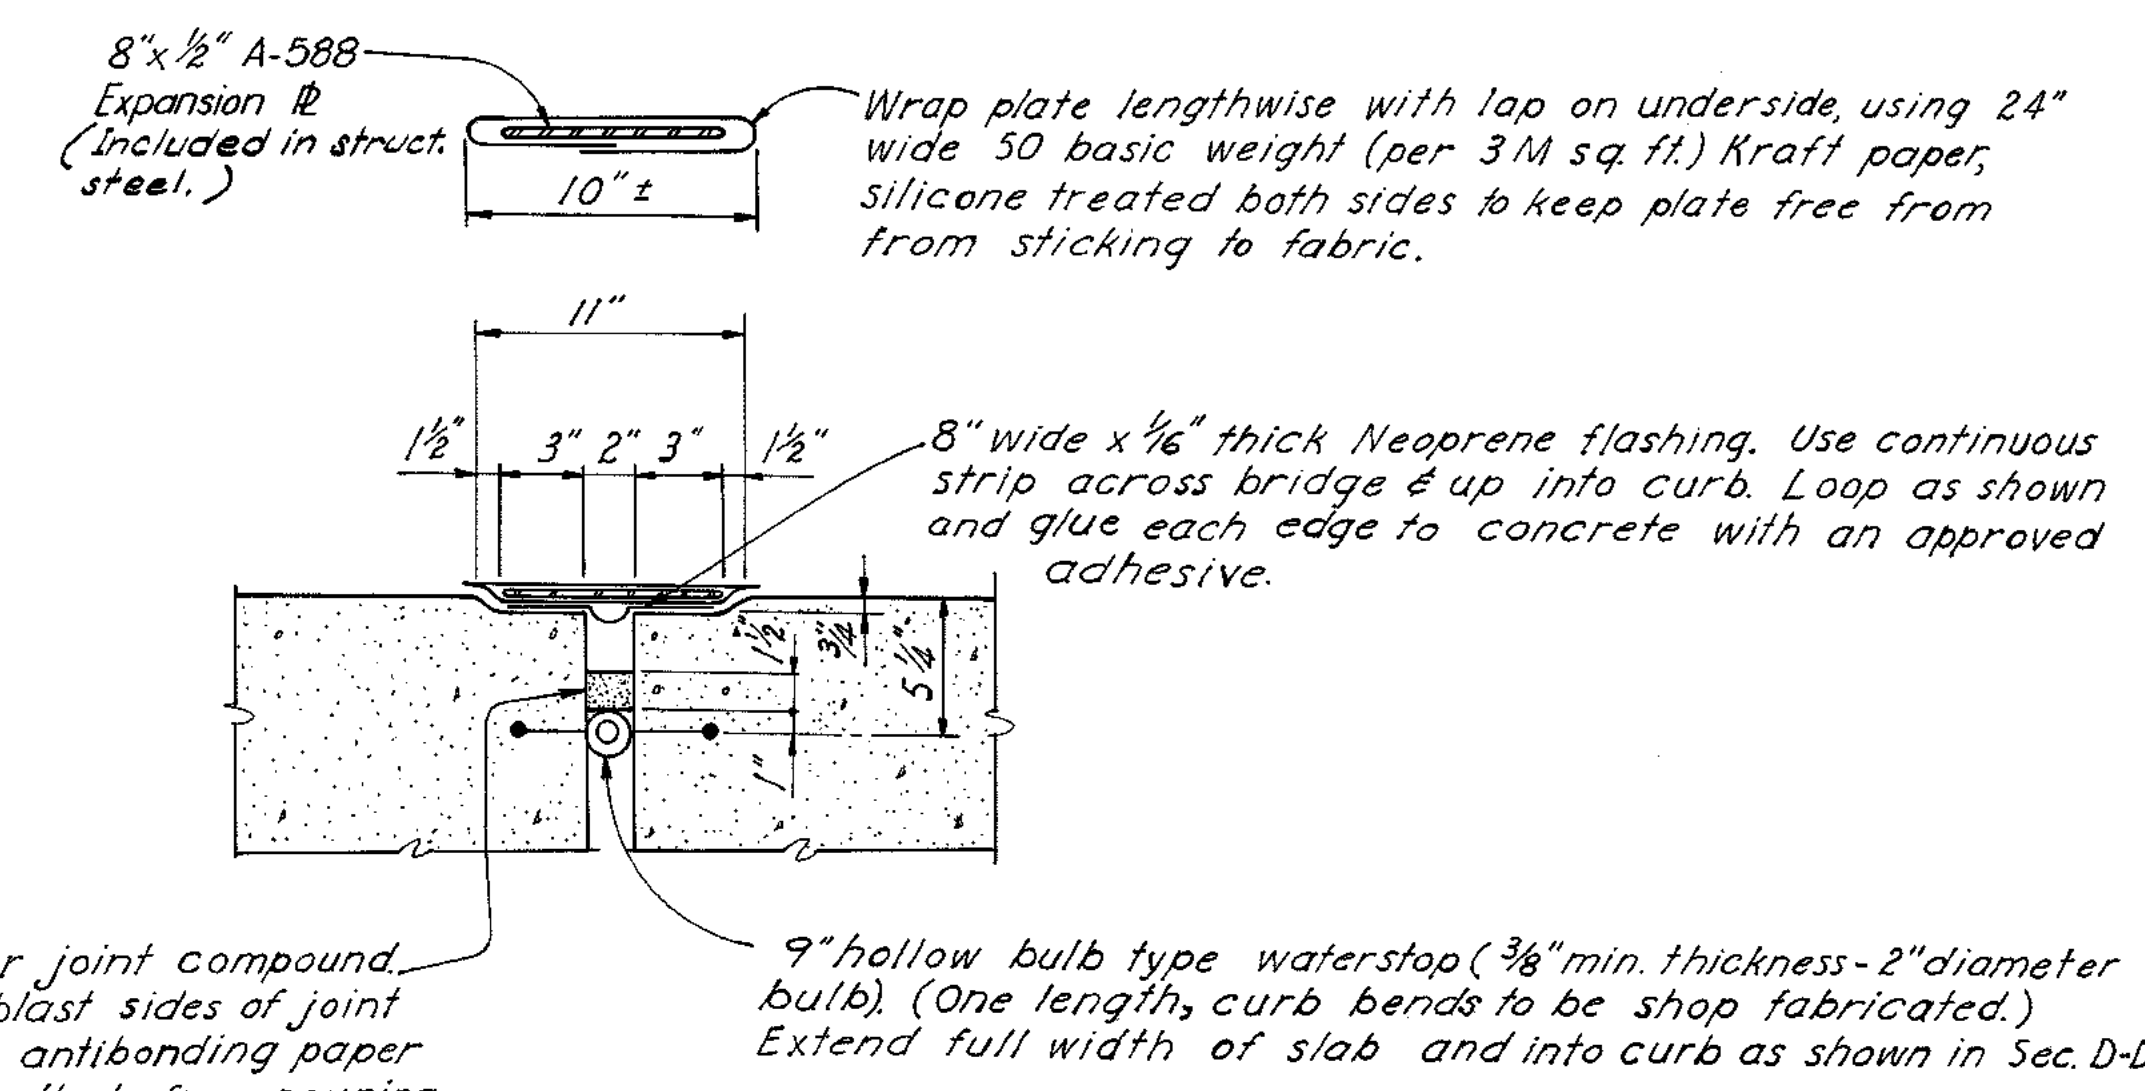


DETAIL A  
No Scale

AS BUILT

RICHMOND METROPOLITAN AUTHORITY RICHMOND EXPRESSWAY SYSTEM POWHITE PARKWAY	
SOUTHERN RAILWAY OVER POWHITE PARKWAY BRIDGE 8-05	
SUPERSTRUCTURE DETAILS	
HAYES, SEAY, MATTERN & MATTERN Associate Engineers	SCALE: AS SHOWN
HOWARD, NEEDLES, TAMMEN & BERGENDOFF General Consultants	CONTRACT NO. 2
	SHEET NO. 12 OF 19



	BY	DATE	3	As Built	JRC	11-72
MADE	HB	1-68	2	General	JGV	10-70
CHECKED	THN	2-68	1	End diaph & dim.	TEM	6-68
IN CHARGE	JGD		NO.	REVISION	BY	DATE



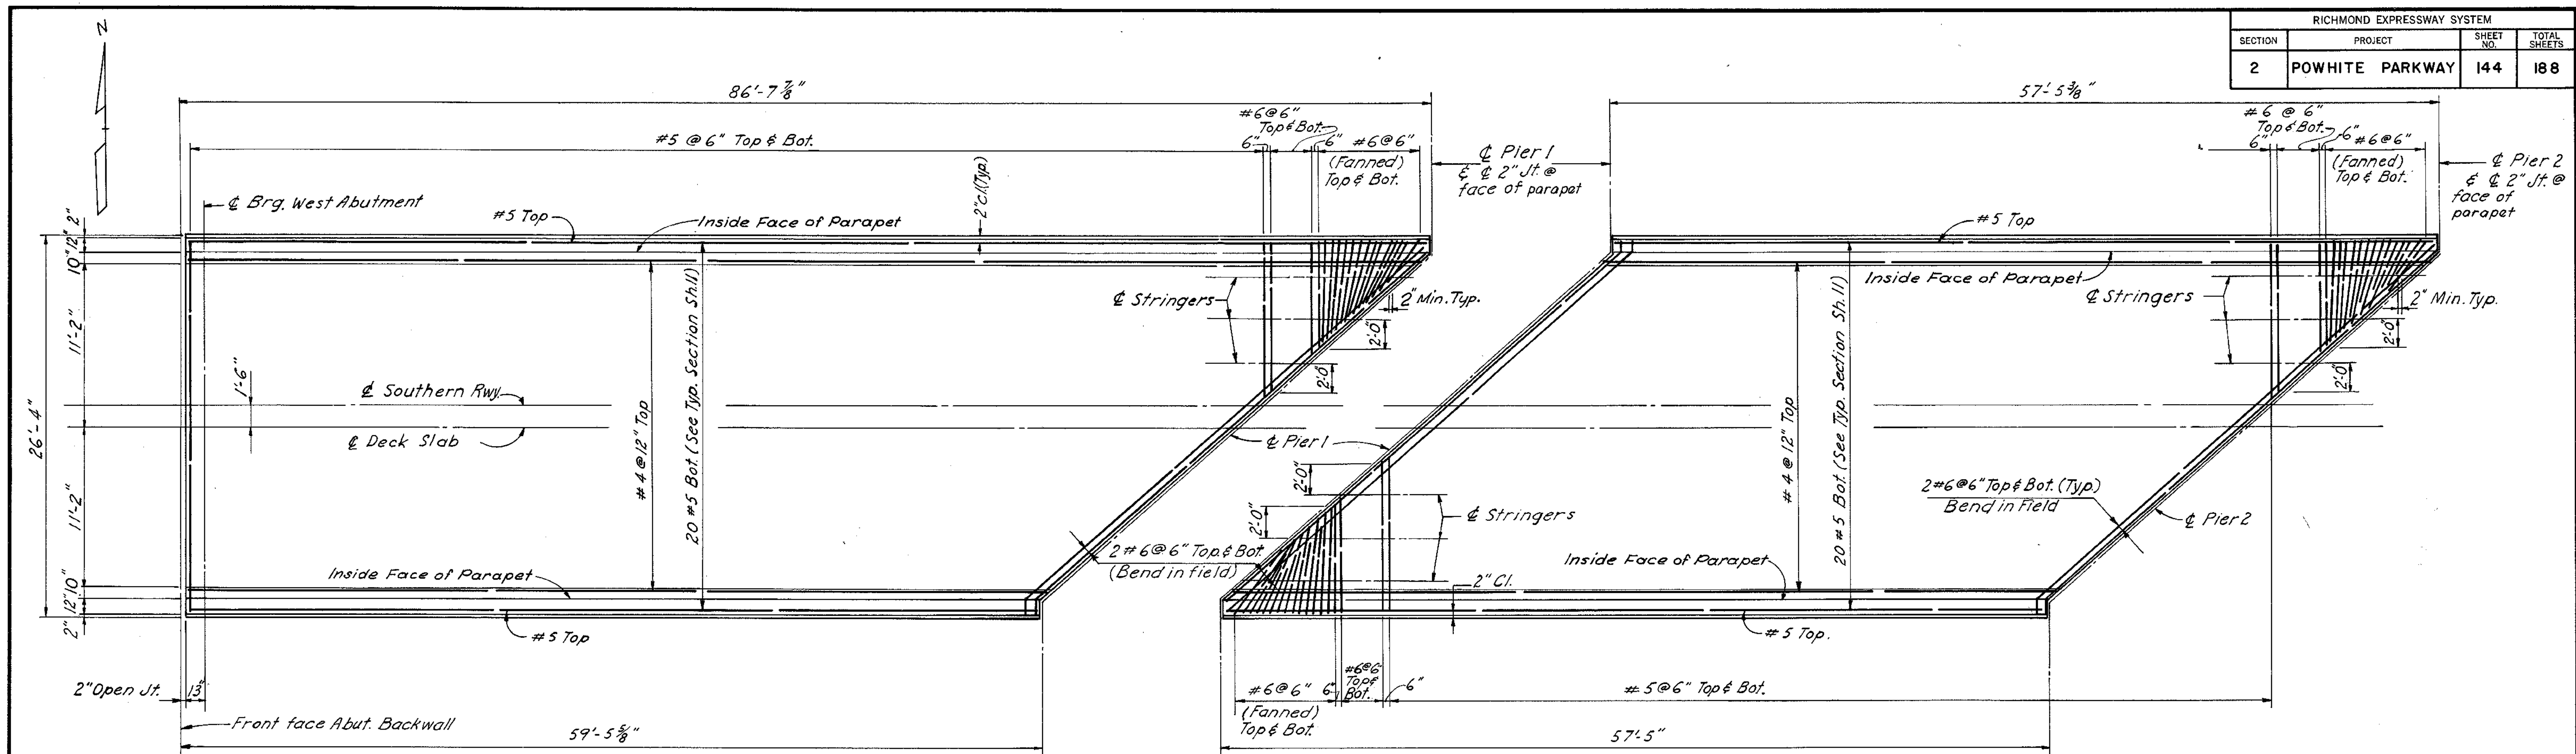

UNIT 1

UNIT 2

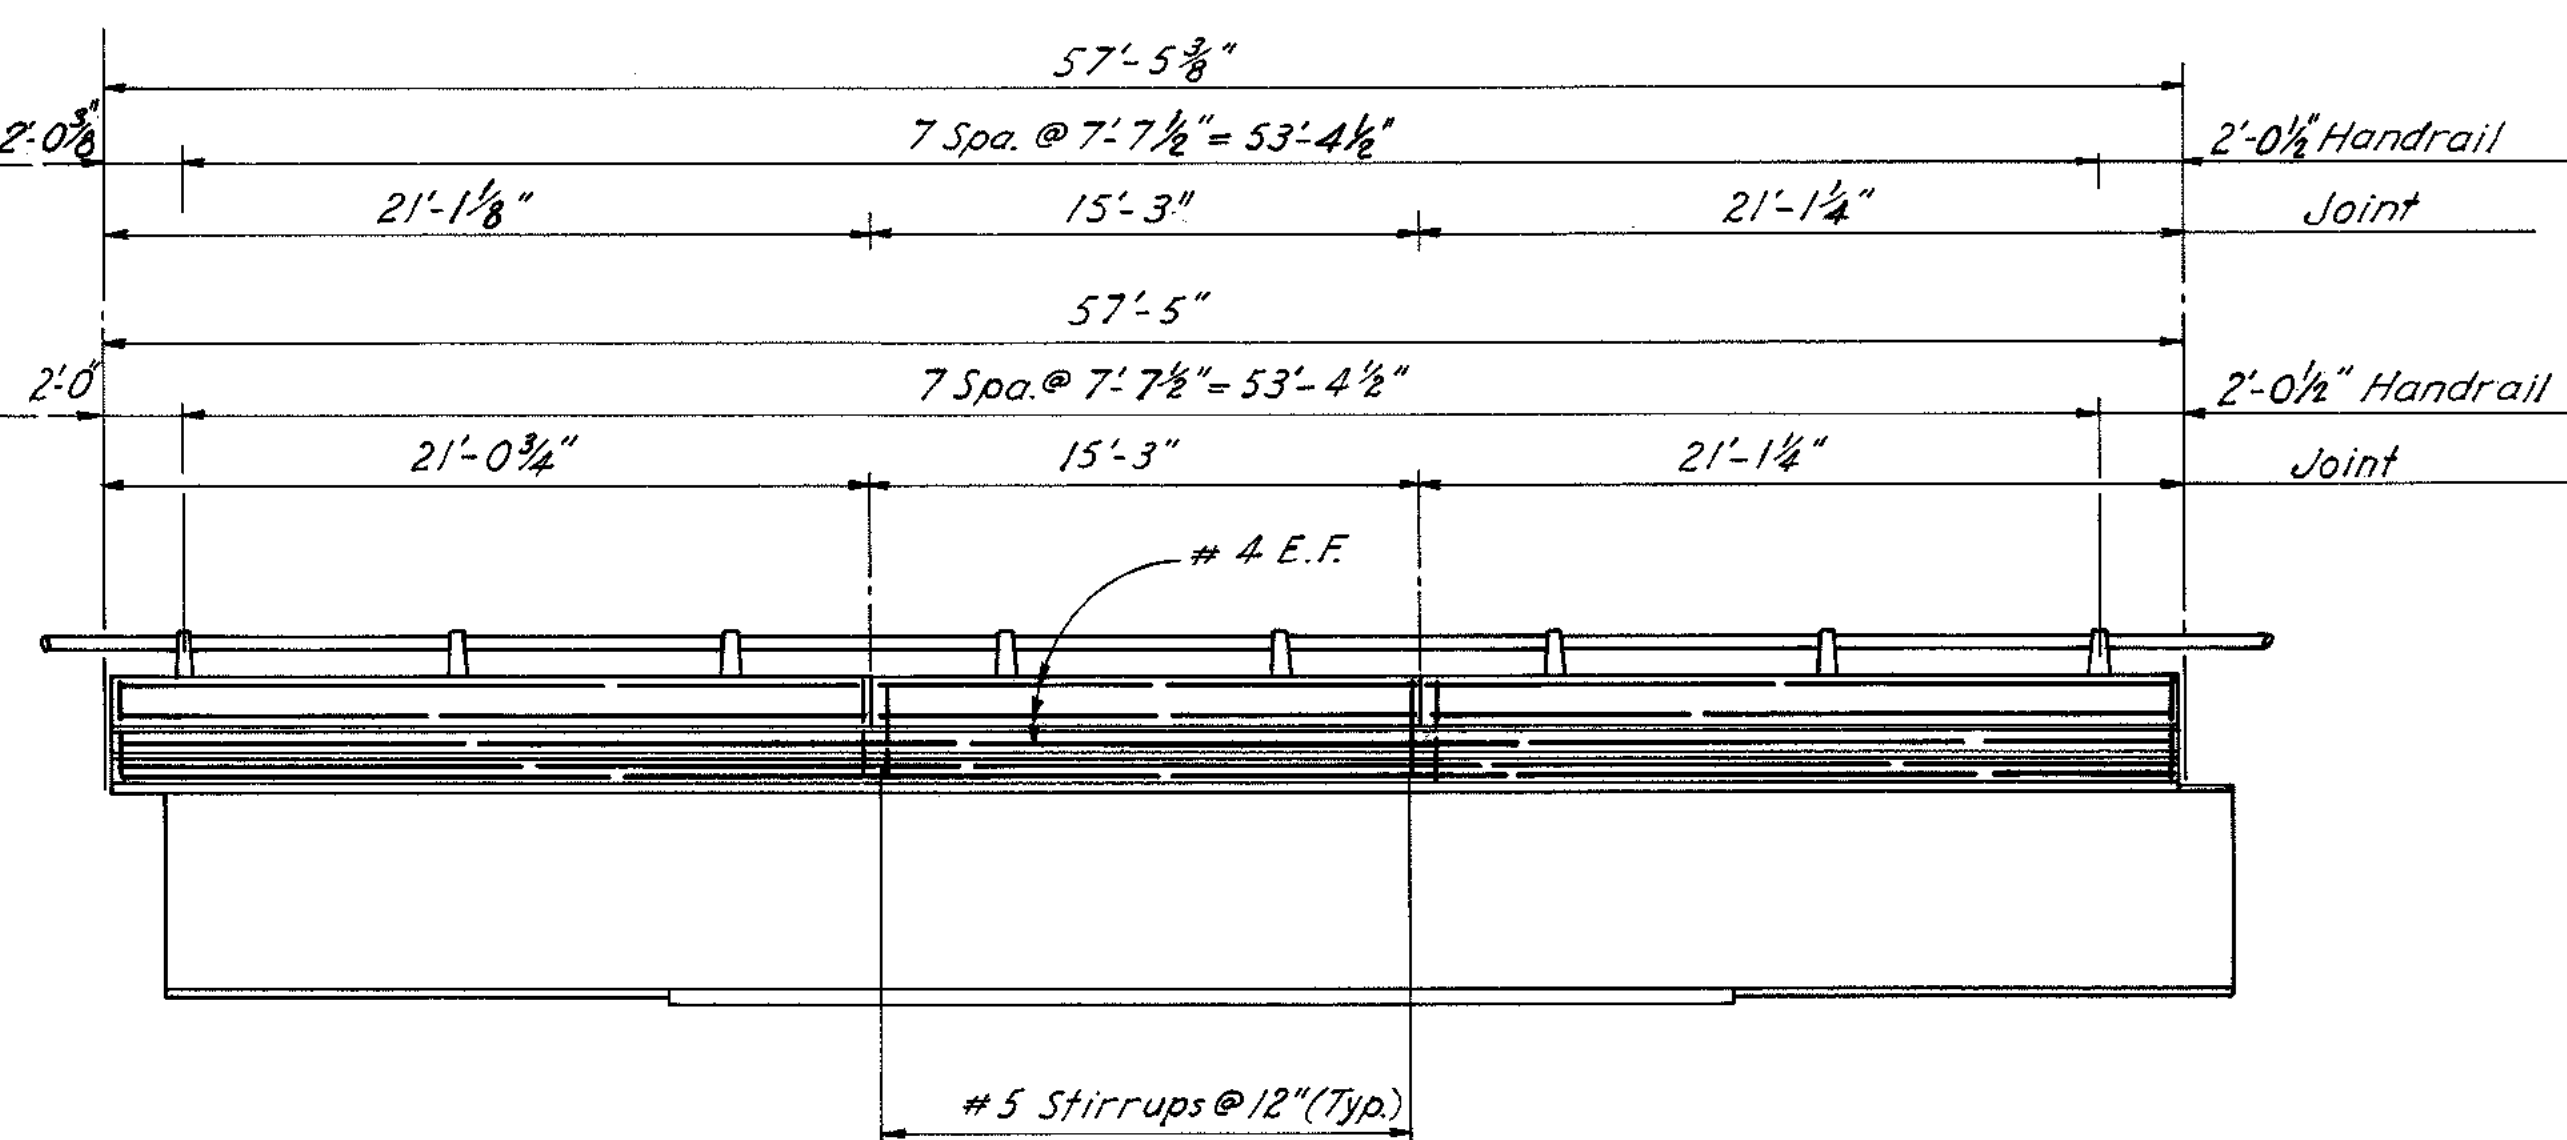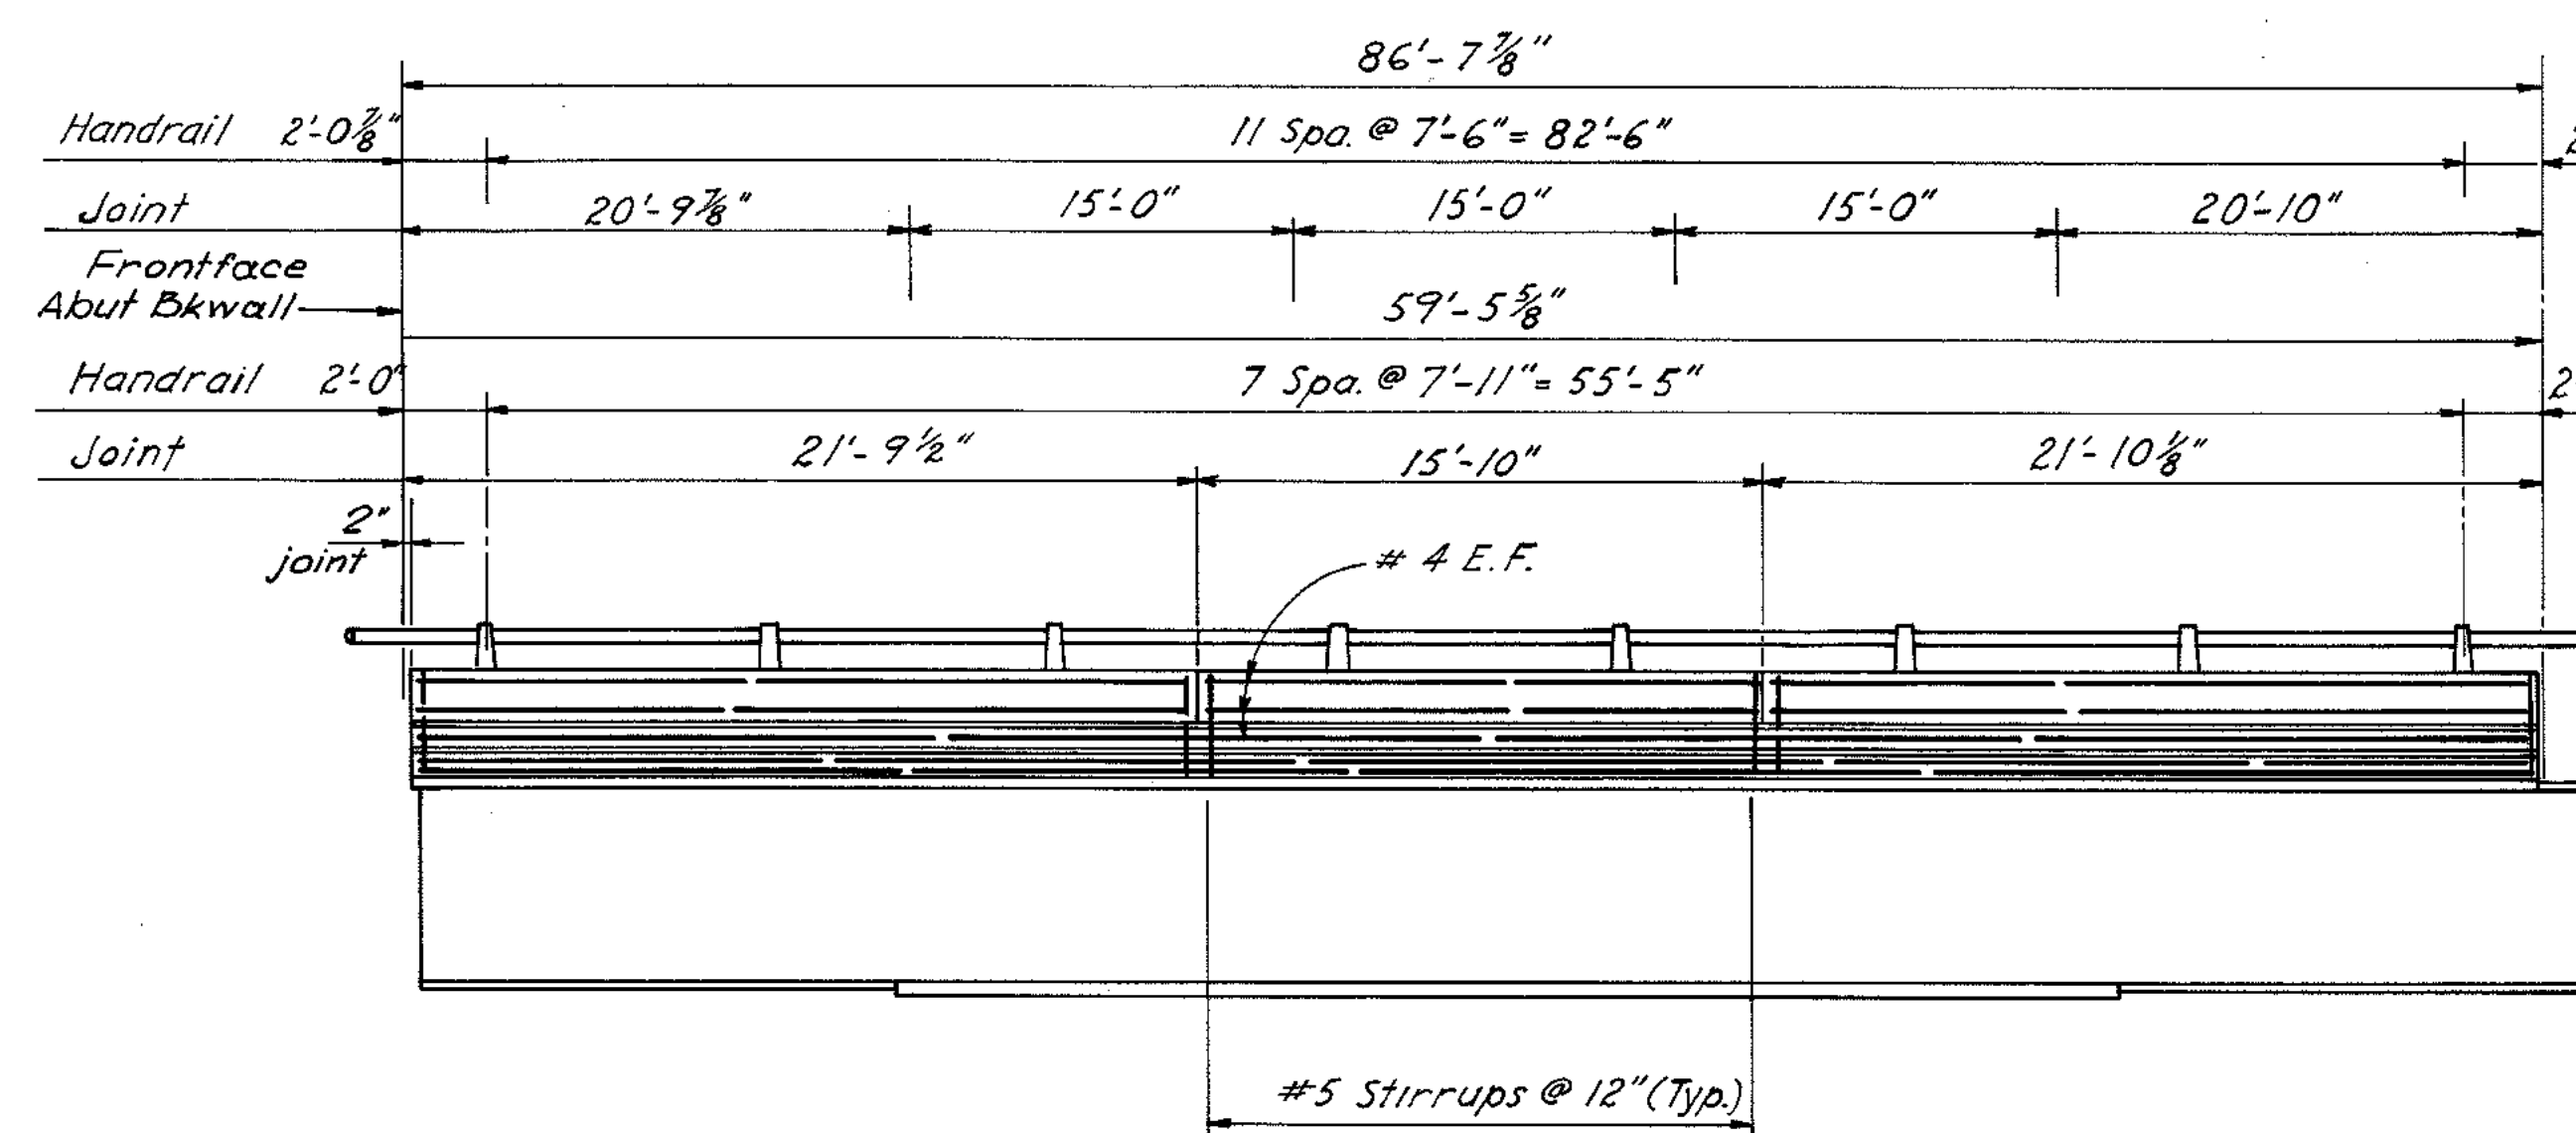

CURB AND PARAPET ELEVATION

MADE	BY	DATE	NO.	REVISION	BY	DATE
AJP	1-68	2	As Built	JRC	11-72	
THN	2-68	1	& Deck Slab	T.E.M	6-68	
JGD						

**AS BUILT**

RICHMOND METROPOLITAN AUTHORITY  
RICHMOND EXPRESSWAY SYSTEM  
POWHITE PARKWAY

SOUTHERN RAILWAY OVER  
POWHITE PARKWAY  
BRIDGE B-05

**DECK PLANS - UNITS 1 & 2**

HAYES, SEAY, MATTERN & MATTERN  
Associate Engineers


HOWARD, NEEDLES, TAMMEN & BERGENDOFF  
General Consultants

SCALE: 3/16" = 1'-0"

CONTRACT NO.: 2


SHEET NO. 13 OF 19

RICHMOND EXPRESSWAY SYSTEM				
SECTION	PROJECT	SHEET NO.	TOTAL SHEETS	
2	POWHITE PARKWAY	145	188	

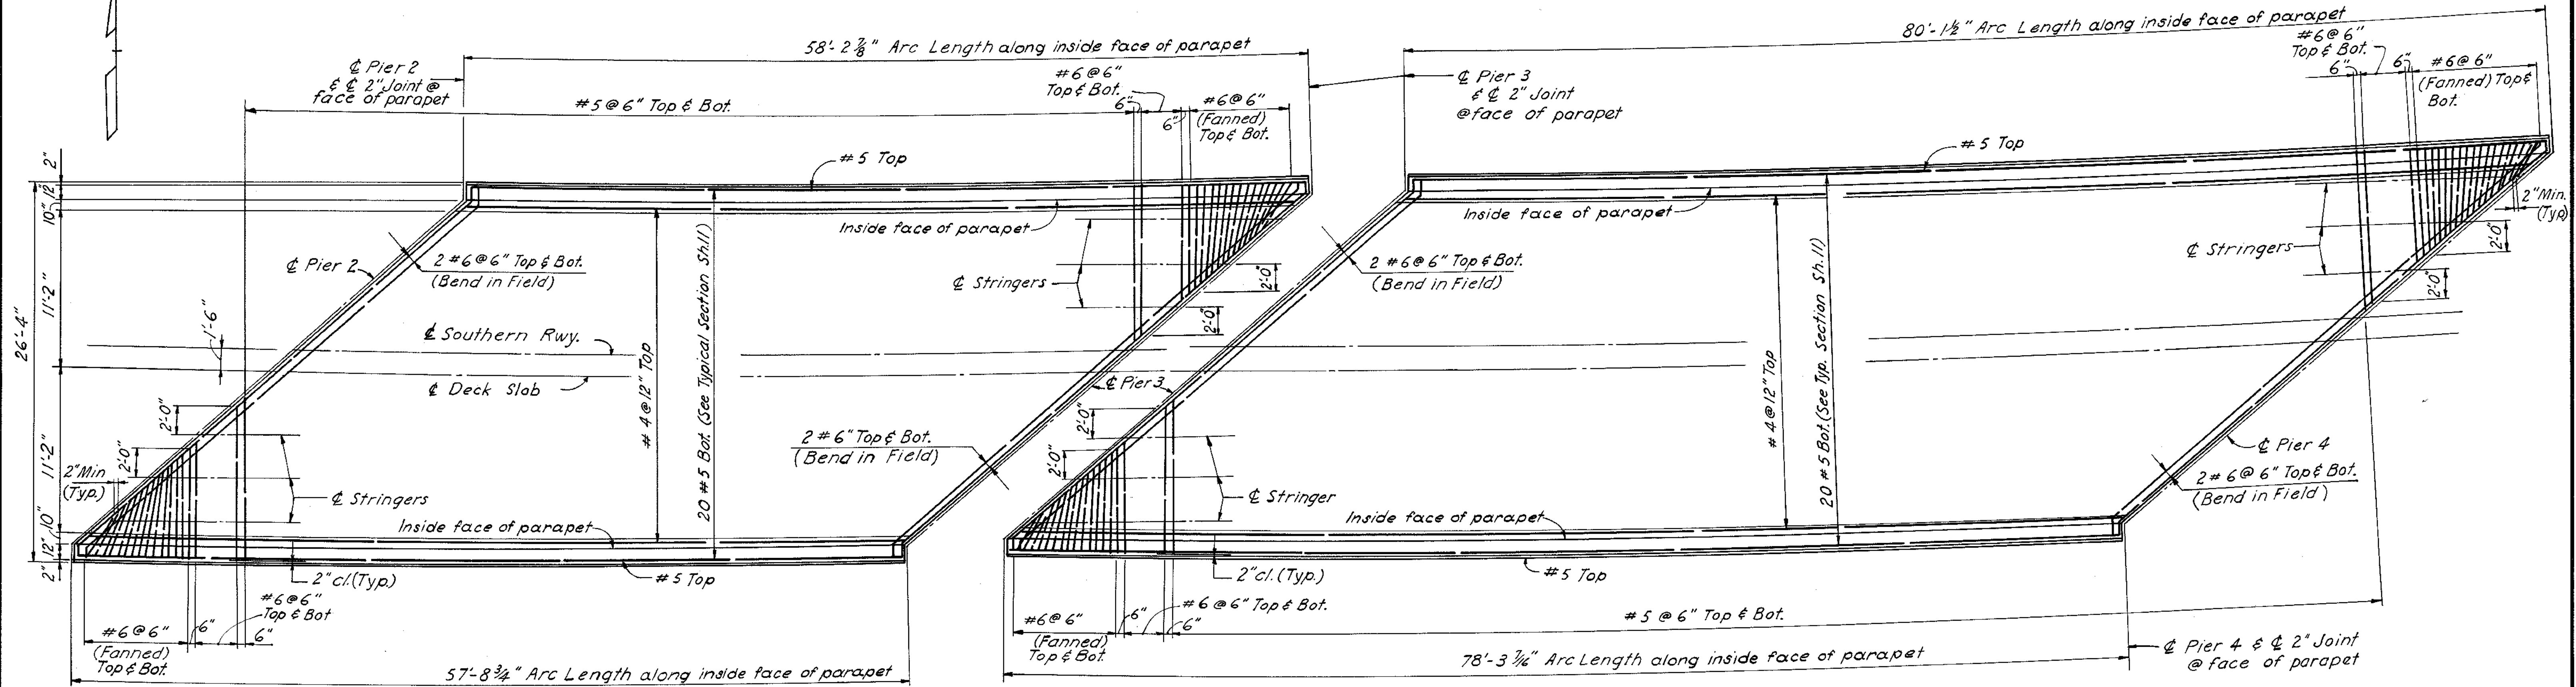

UNIT 3

UNIT 4

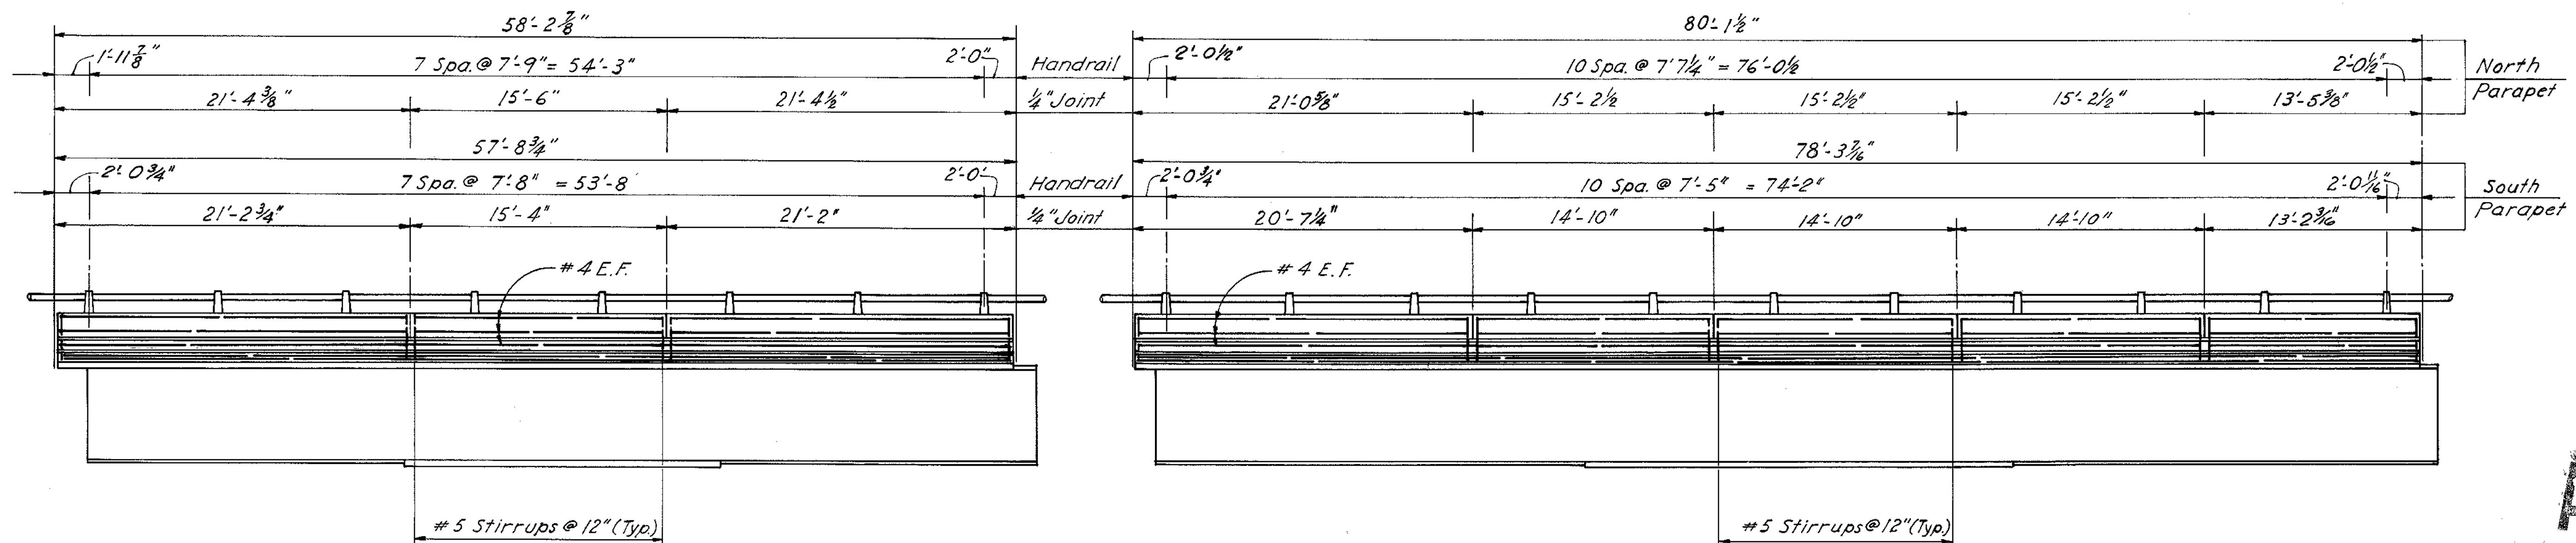

CURB AND PARAPET ELEVATION


**AS BUILT**

RICHMOND METROPOLITAN AUTHORITY	
RICHMOND EXPRESSWAY SYSTEM	
POWHITE PARKWAY	
SOUTHERN RAILWAY OVER	
POWHITE PARKWAY	
BRIDGE B-05	
<b>DECK PLANS- UNITS 3 &amp; 4</b>	
HAYES, SEAY, MATTERN & MATTERN Associate Engineers	SCALE: 3/16" = 1'-0"
HOWARD, NEEDLES, TAMMEN & BERGENDOFF General Consultants	CONTRACT NO.: 2
	SHEET NO. 14 OF 19


BY	DATE				
MADE	AJP	1-68	2	As Built	JRC 11-72
CHECKED	THN	2-68	1	Deck Slab	TEM 6-68
IN CHARGE	JGD			REVISION	BY DATE



RICHMOND EXPRESSWAY SYSTEM				
SECTION	PROJECT	SHEET NO.	TOTAL SHEETS	
2	POWHITE PARKWAY	146	188	

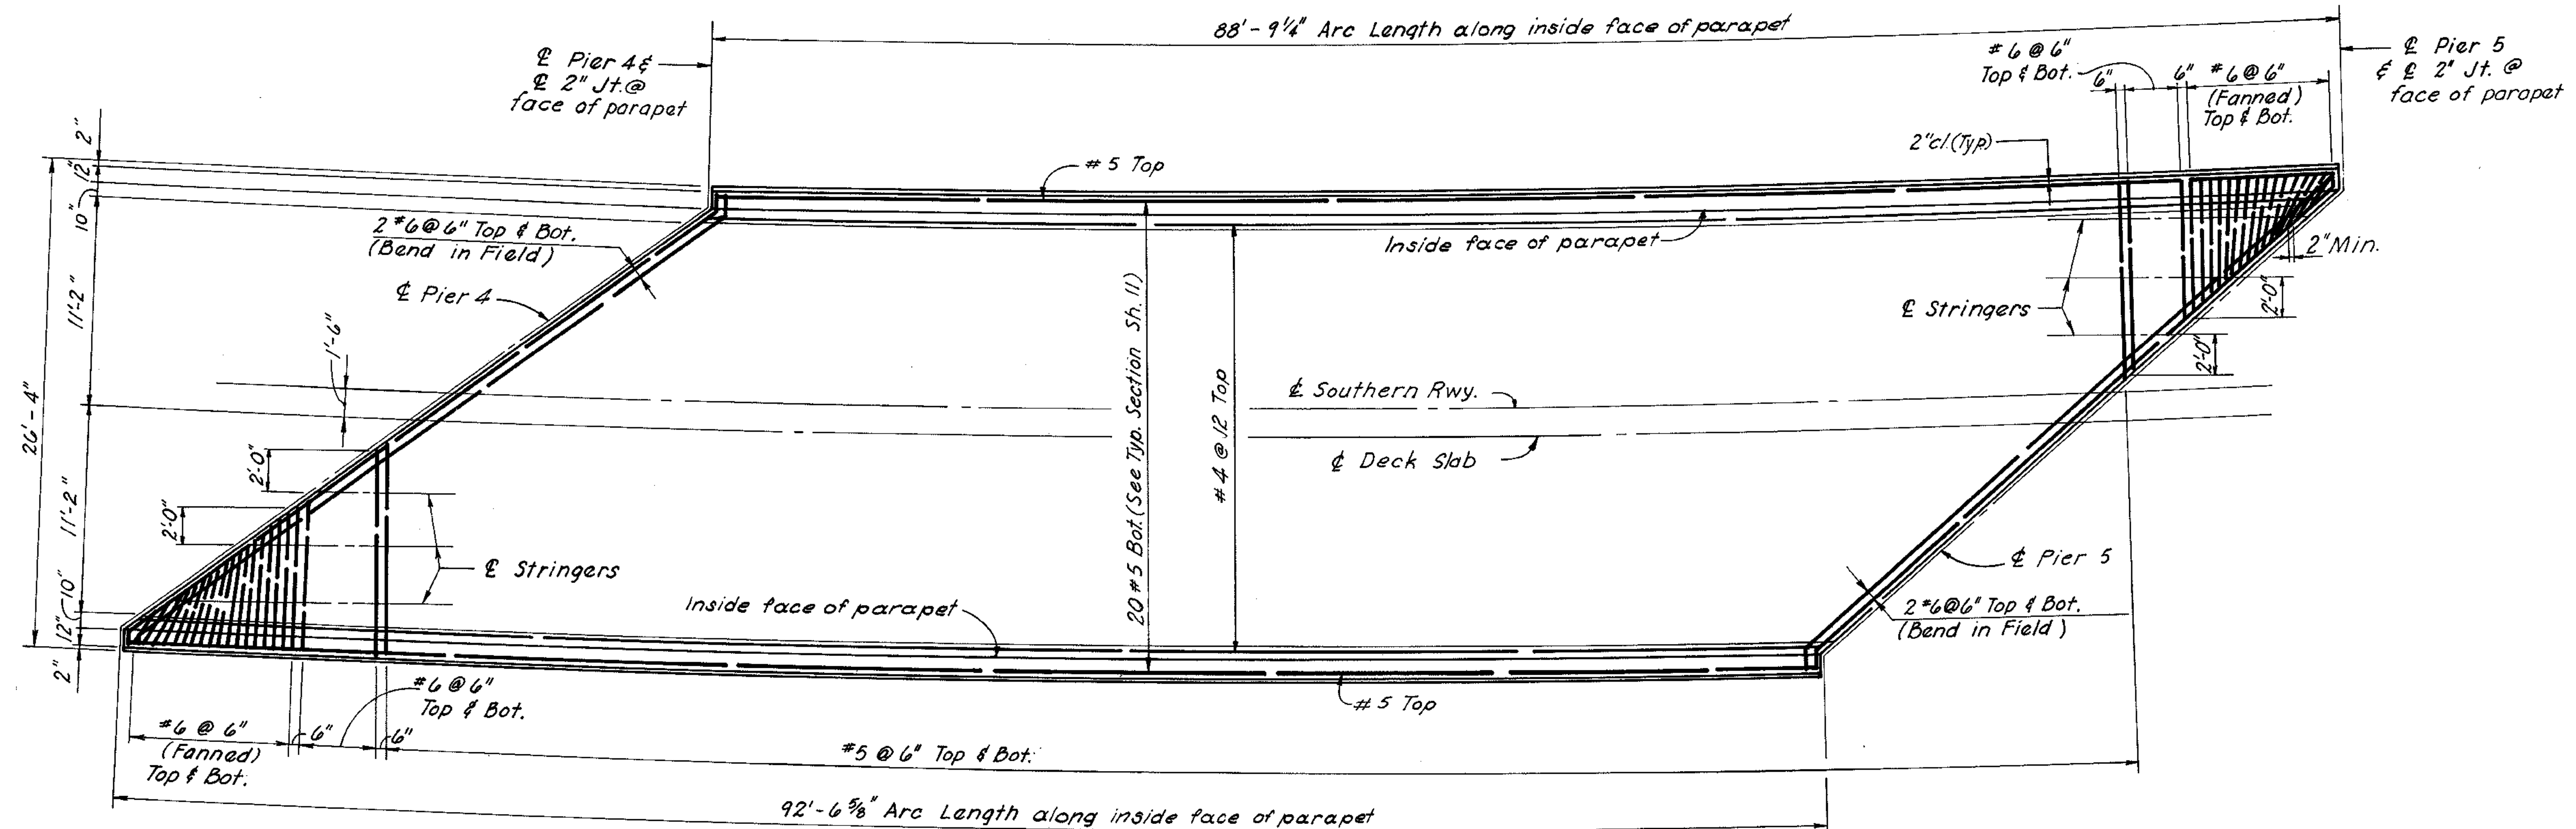

UNIT 5

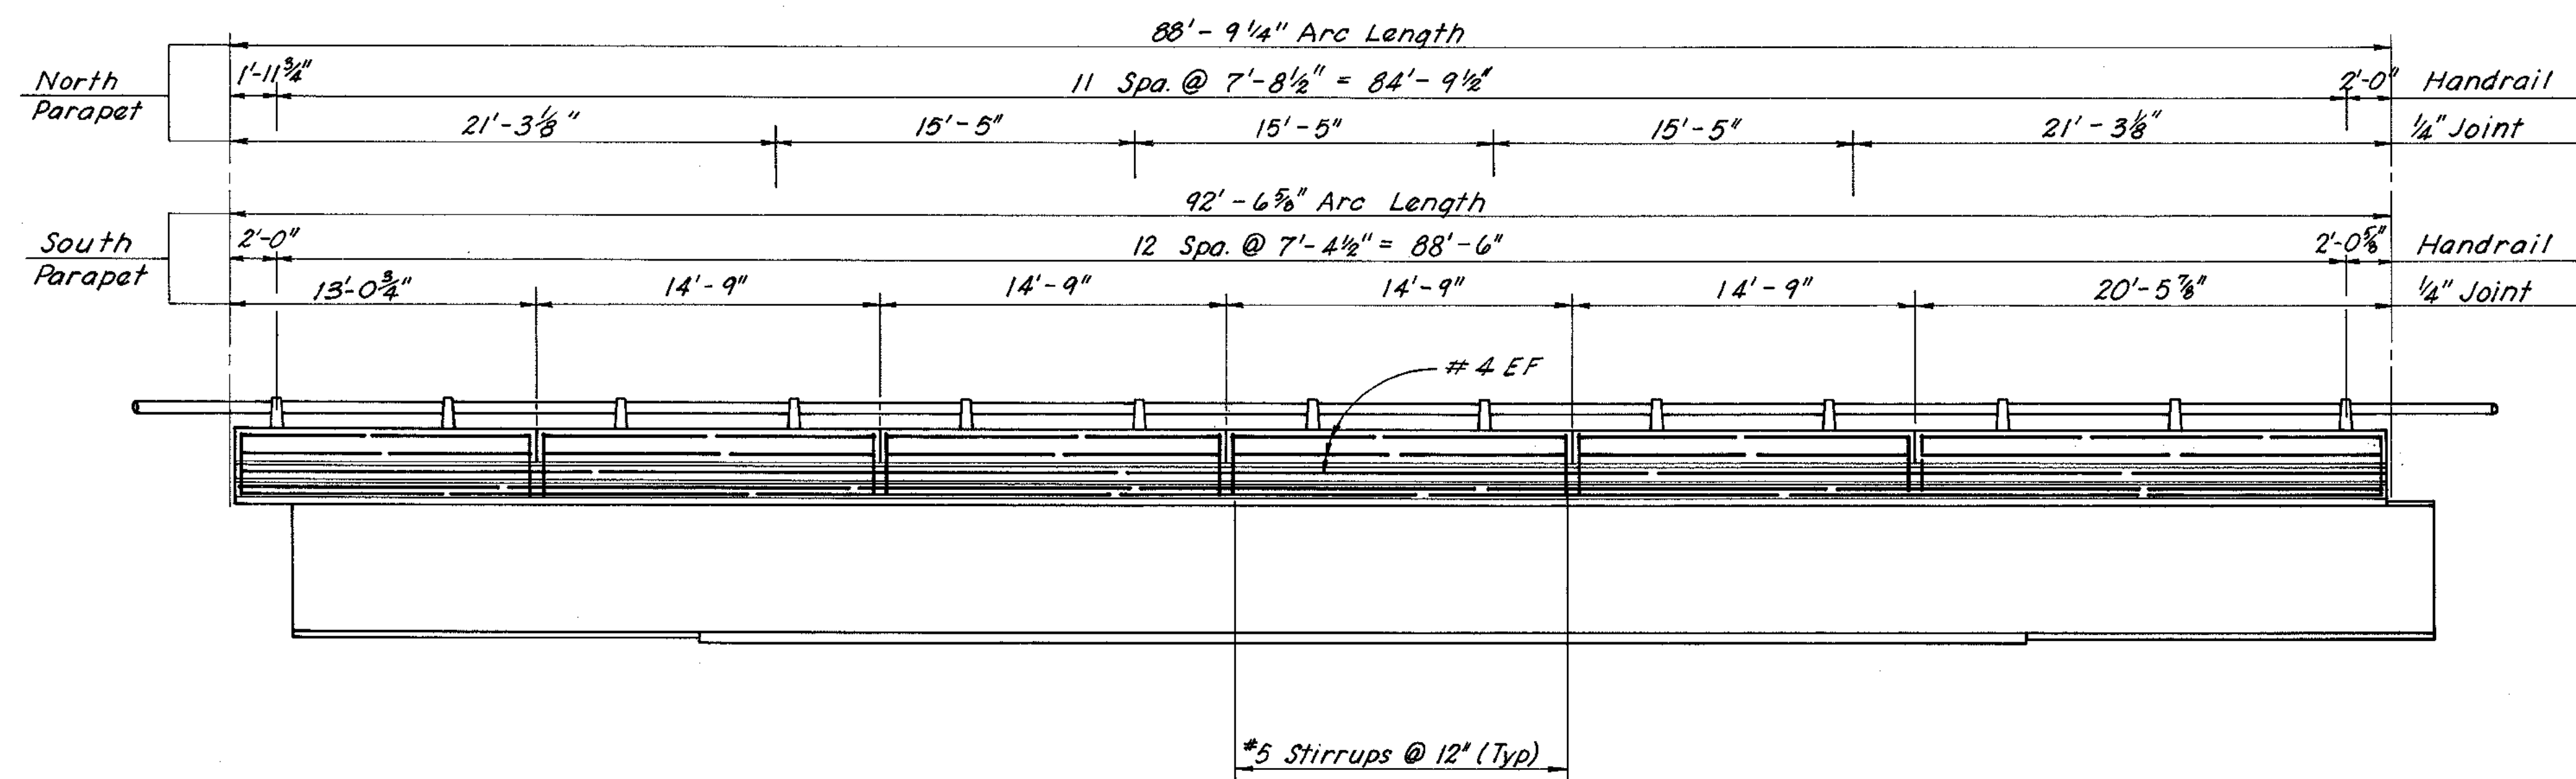


CURB AND PARAPET ELEVATION

MADE	BY	DATE	NO.	REVISION	BY	DATE
AJP	1-68	2	As Built	JRC	11-72	
THN	2-68	1	@ Deck Slab	TEM	6-68	
JGD						


**AS BUILT**

RICHMOND METROPOLITAN AUTHORITY RICHMOND EXPRESSWAY SYSTEM POWHITE PARKWAY	
SOUTHERN RAILWAY OVER POWHITE PARKWAY BRIDGE B-05	
<b>DECK PLANS-UNIT 5</b>	
HAYES, SEAY, MATTERN & MATTERN Associate Engineers	SCALE: 3/16" = 1'-0"
HOWARD, NEEDLES, TAMMEN & BERGENDOFF General Consultants	CONTRACT NO. 2
	SHEET NO. 15 OF 19

RICHMOND EXPRESSWAY SYSTEM			
SECTION	PROJECT	SHEET NO.	TOTAL SHEETS
2	POWHITE PARKWAY	147	188

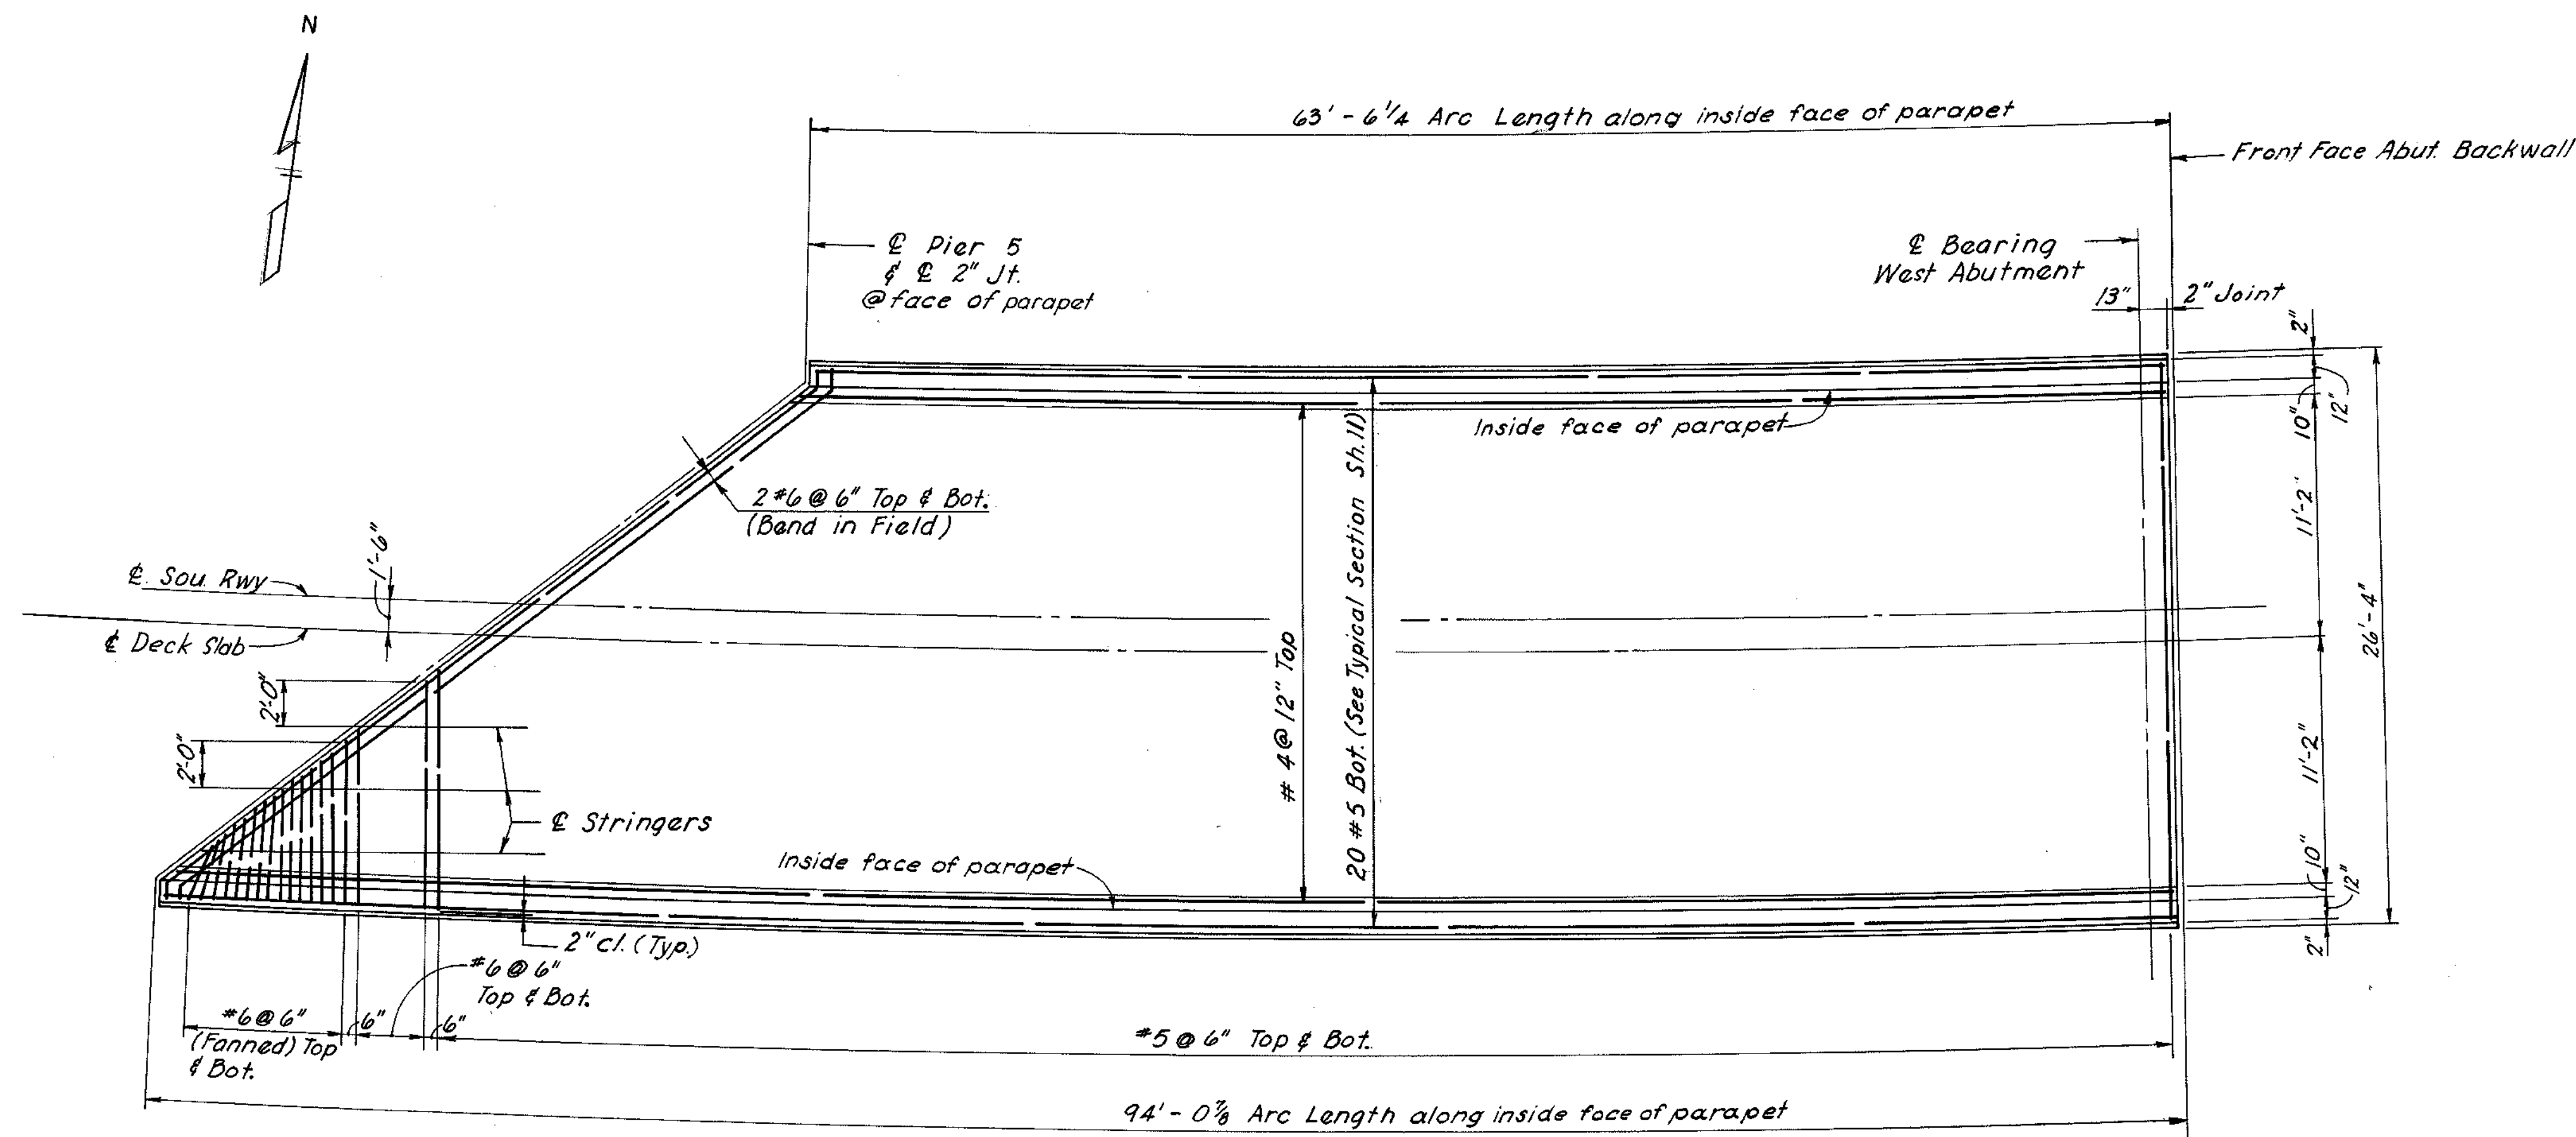

UNIT 6




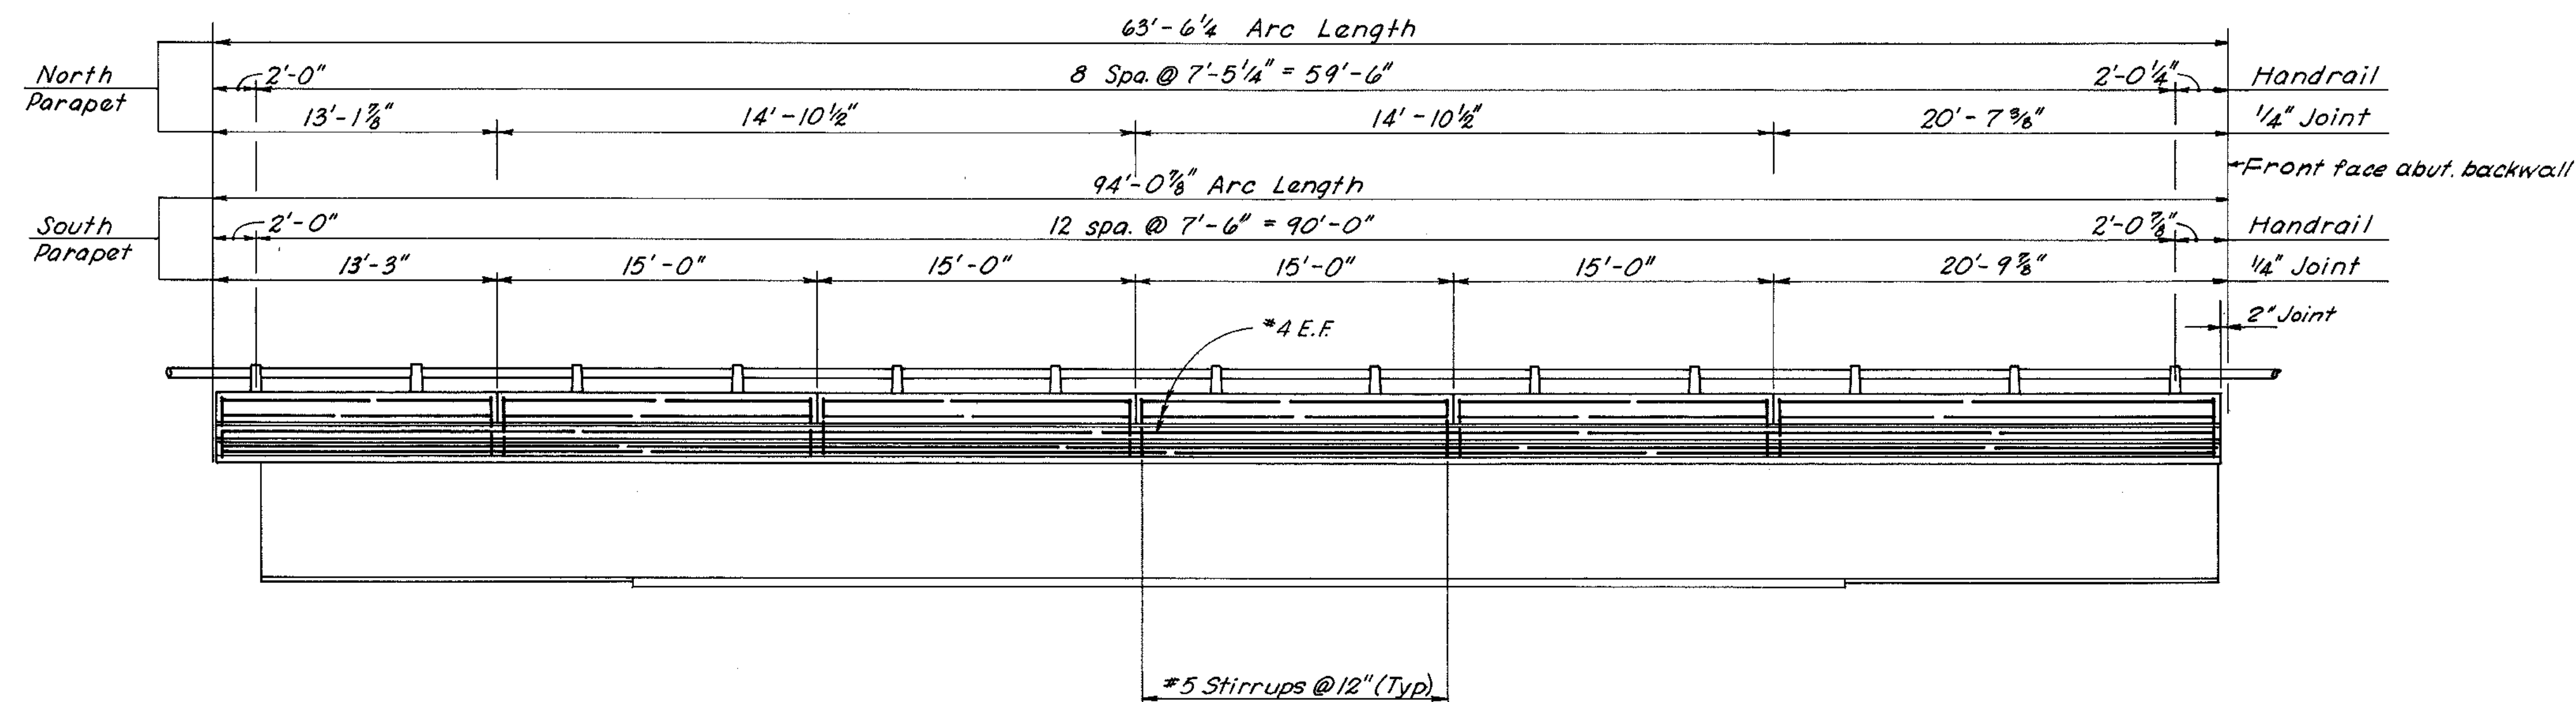


CURB AND PARAPET ELEVATION

AS BUILT

RICHMOND METROPOLITAN AUTHORITY RICHMOND EXPRESSWAY SYSTEM POWHITE PARKWAY	
SOUTHERN RAILWAY OVER POWHITE PARKWAY BRIDGE B-05	
DECK PLANS-UNIT 6	
HAYES, SEAY, MATTERN & MATTERN Associate Engineers	SCALE: 3/16" = 1'-0"
HOWARD, NEEDLES, TAMMEN & BERGENDOFF General Consultants	CONTRACT NO.: 2
	SHEET NO. 16 OF 19

BY	DATE				
MADE	AJP	1-68	2	As Built	R.J.H. 11-72
CHECKED	THN	2-68	1	Deck Slab	TEM. 6-68
IN CHARGE	JGD				

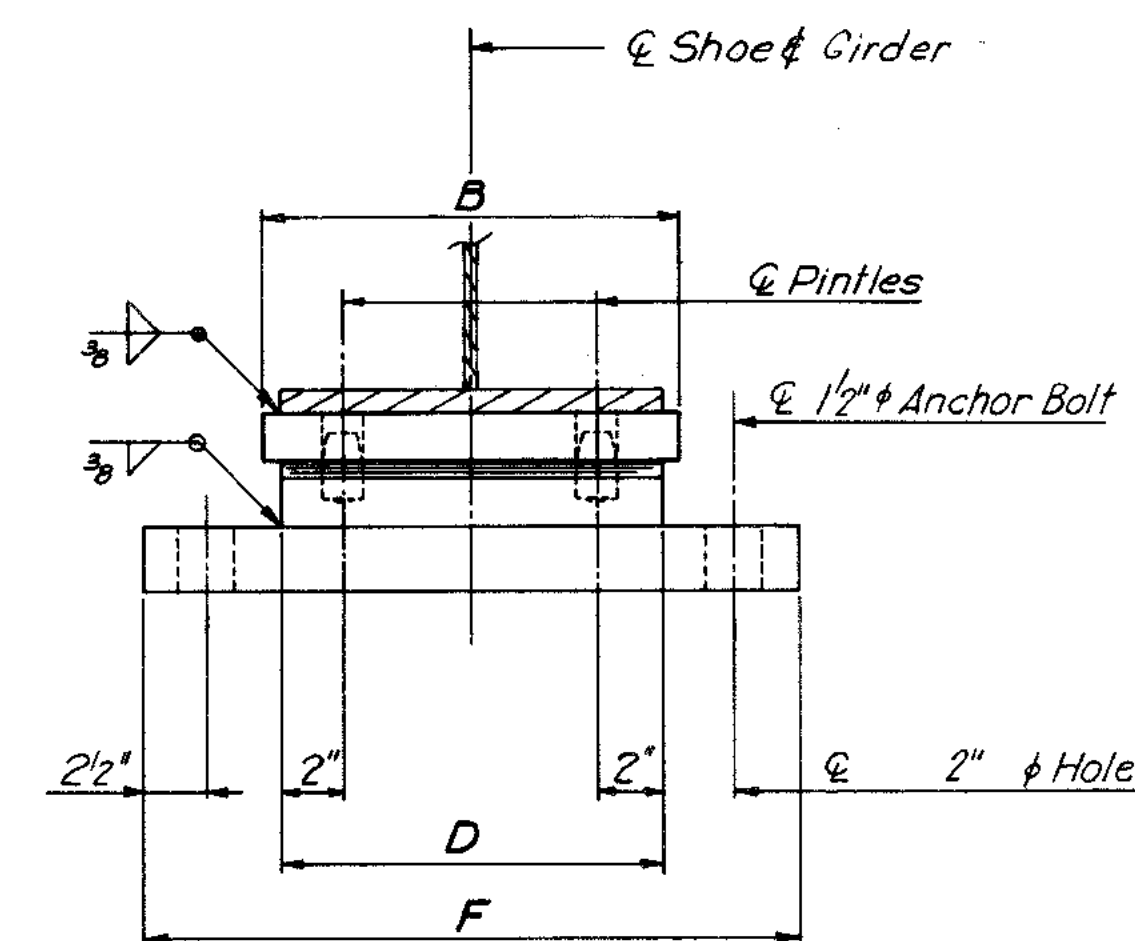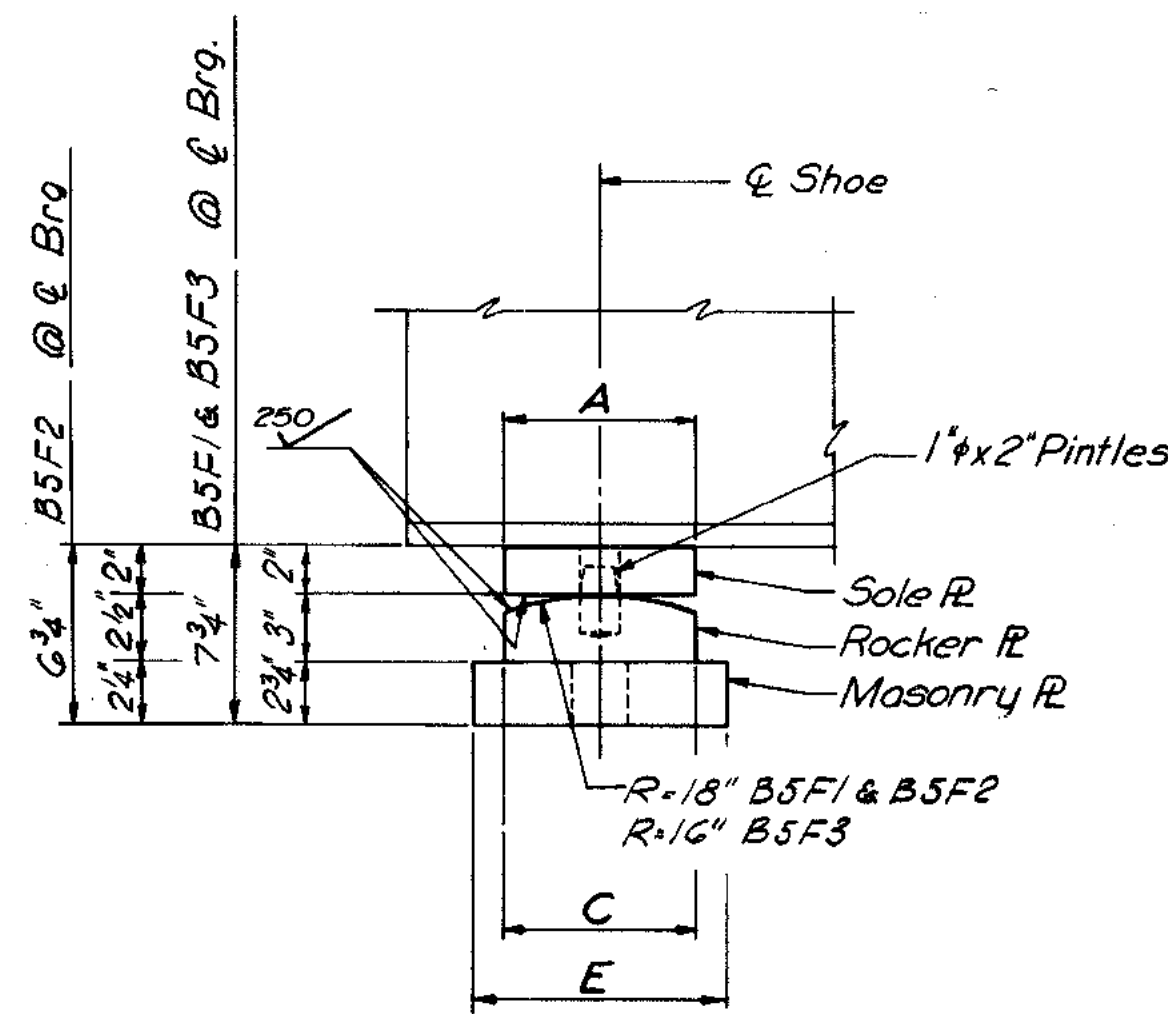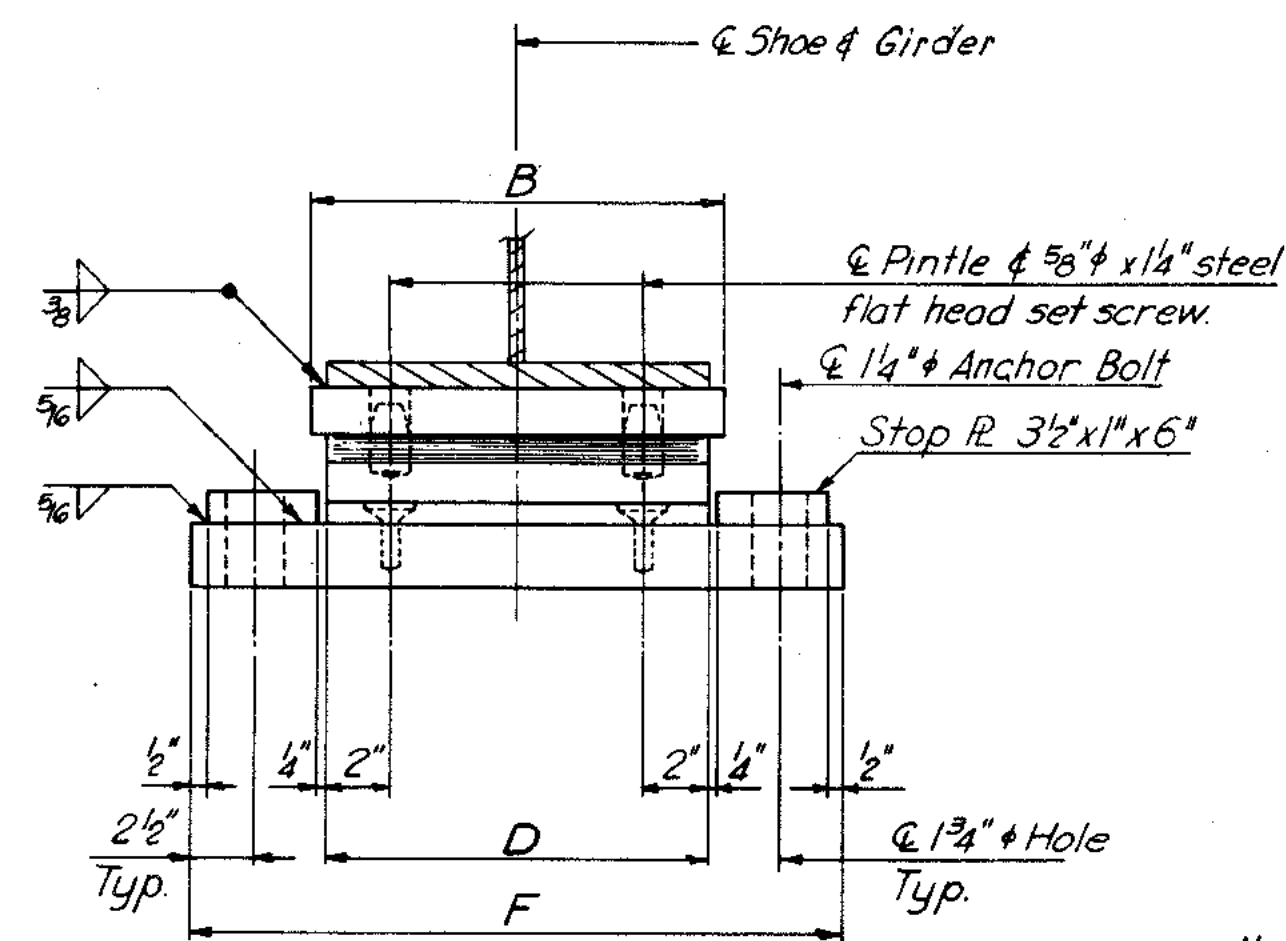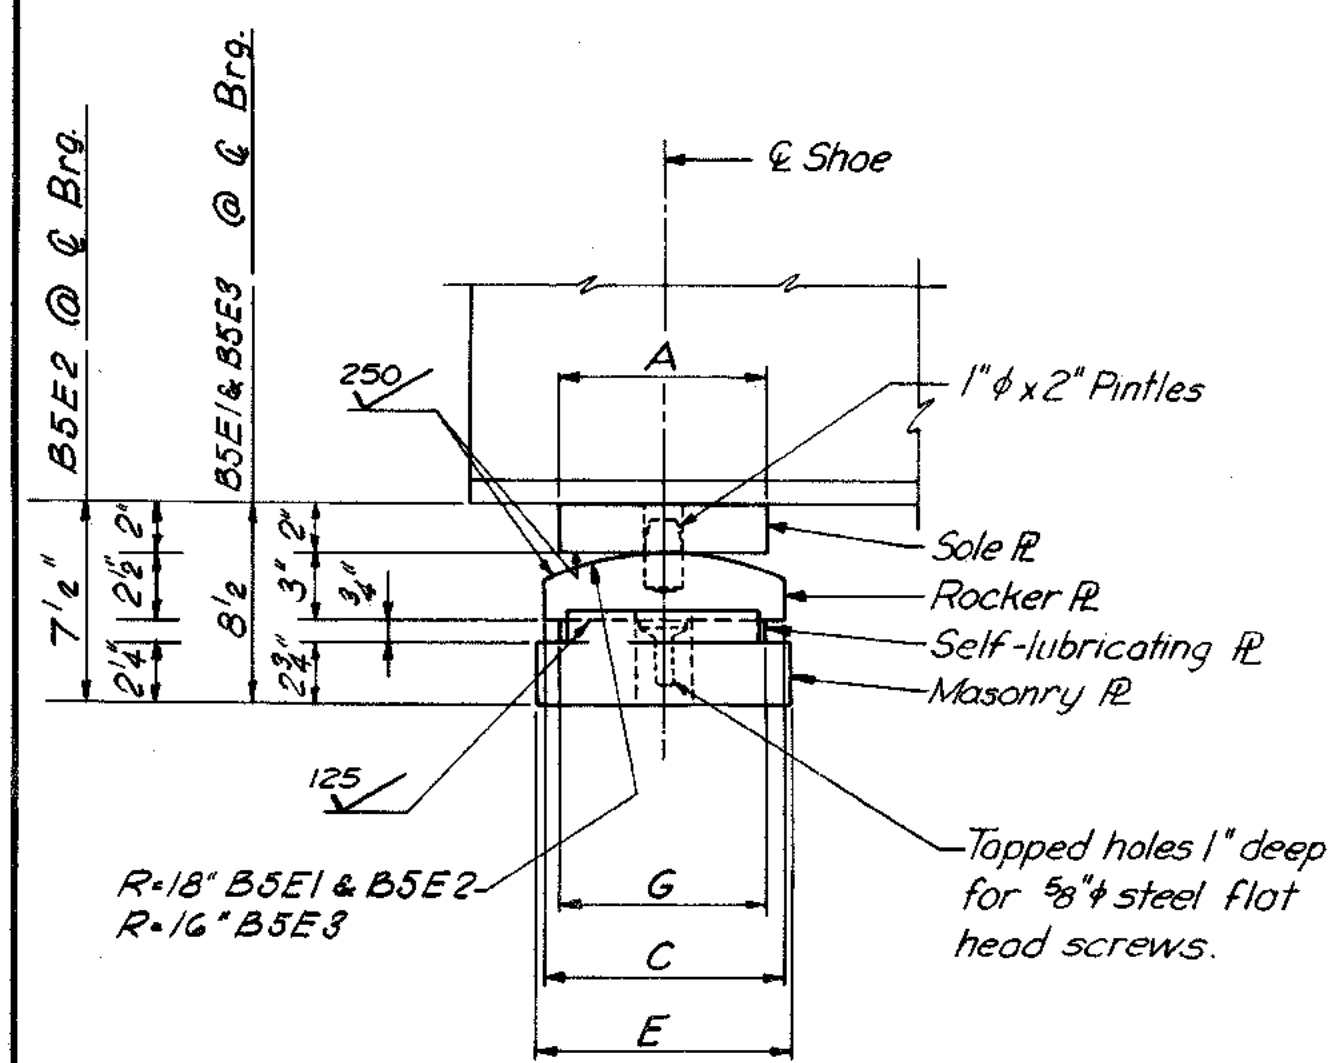

Note:  
Sole R is to be beveled  
to compensate for grade.

**SIDE ELEVATION**



END ELEVATION

**SIDE ELEVATION**

**END ELEVATION**

## EXPANSION SHOE


No Scale

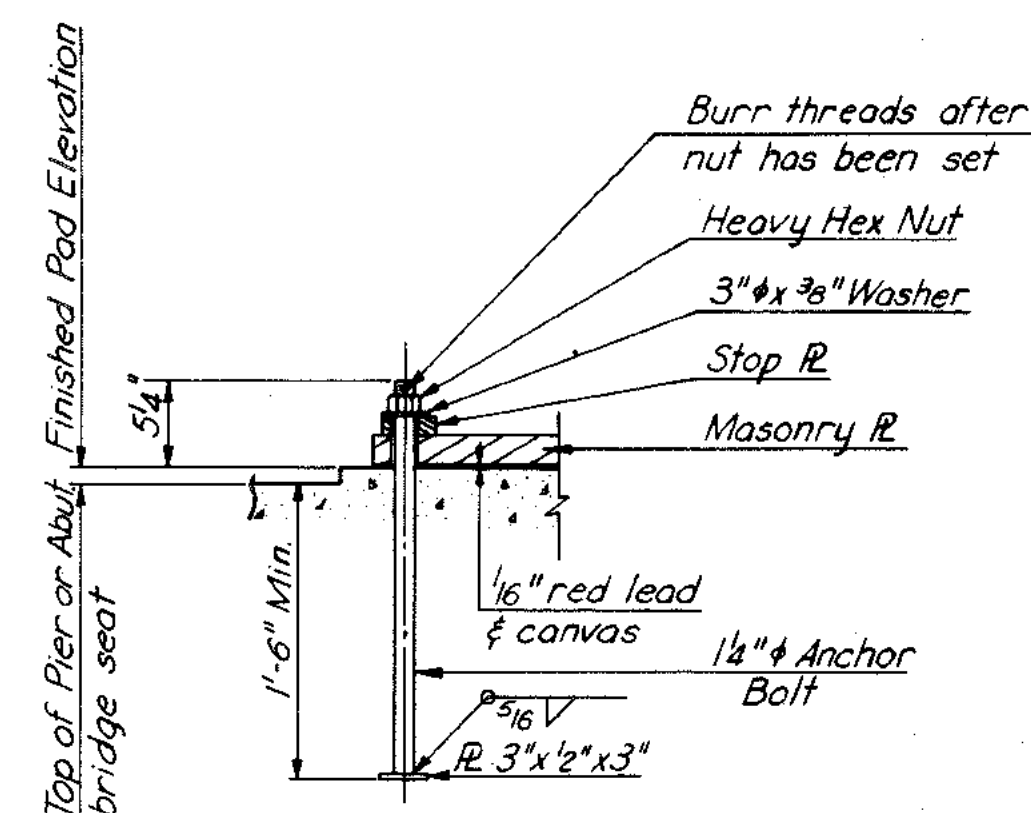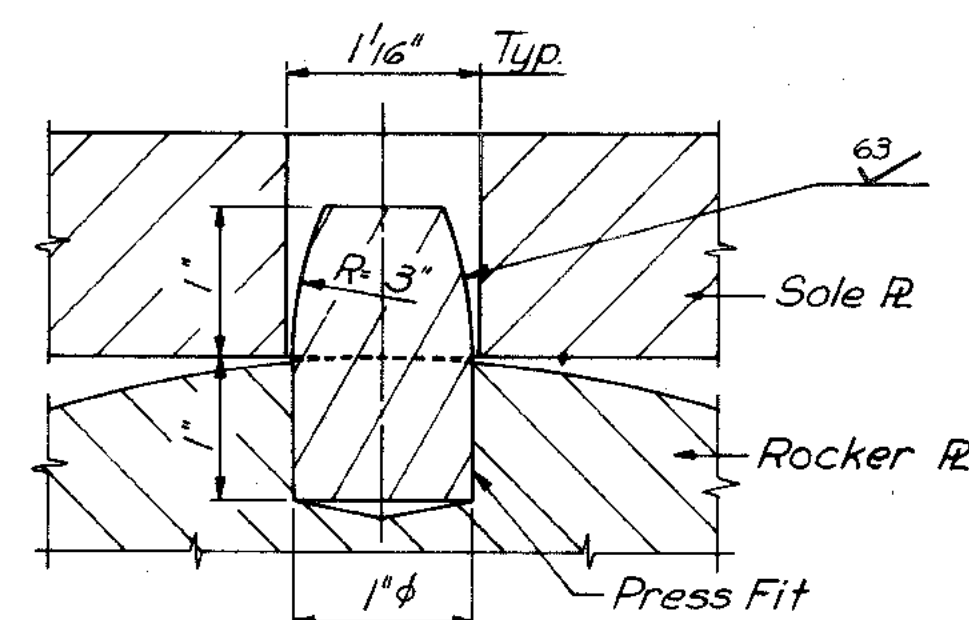

## EXPANSION SHOE

### ANCHOR BOLT DETAIL

No Scale

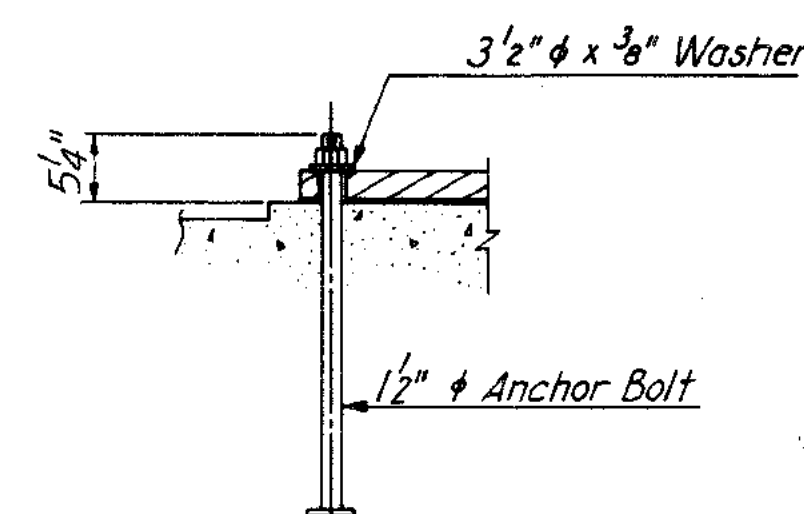

**FIXED SHOE**

Note:  
Anchor Bolt for Fixed Shoes  
same as Anchor Bolt for Exp. Shoes  
except as shown.

Shoe Notes:

*Top of masonry plates, bottom of rocker plates and top and bottom of sole plates shall be planed, straightened or otherwise treated to secure true plane surfaces.*

Contact surfaces noted on the plans with finish symbols shall be finished in accordance with the American Standards Association surface roughness requirement as defined in ASA B461, Surface Roughness, Waviness and Lay, Part I.

The plates comprising the expansion shoes shall be set so as to be truly centered under full dead load at a temperature of 68°F.

Concrete pads shall be formed integral with abutment or pier and not less than 1/8" or more than 1/4" above finished elevation. Dress down pads by rubbing, grinding or as otherwise approved by the Engineer, to true level surfaces at the finished elevation.


Anchor bolt assemblies shall conform to A.S.T.M. A-307 and shall be hot-dip galvanized conforming to A.S.T.M. A-153.

Templates shall be used to accurately set the anchor bolts.

Material for shoes (exclusive of self-lubricating plates) shall be high strength low alloy structural steel conforming to A.S.T.M. Specification A-588.

Material for self-lubricating plates shall be **Leaded Tin Bronze** conforming to A.S.T.M. specification B22, alloy D modified to the extent that 1.5 to 2.5 percent lead is allowable.

Shoes shall be included with structural steel item for payment.

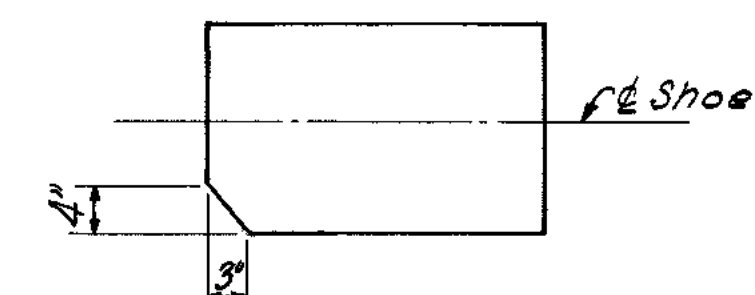[illegible]

	BY	DATE	3	As Built	R.J.H.	11-72
MADE	T.E.M.	1-17-68	2	General	J.G.V.	10-70
CHECKED	T.H.N.	2-68	1	Review Comm.	T.E.M.	6-68
IN CHARGE	J.G.D.		NO.	REVISION	BY	DATE

<p><b>RICHMOND METROPOLITAN AUTHORITY</b>  <b>RICHMOND EXPRESSWAY SYSTEM</b>          POWHITE PARKWAY</p>	
<p><b>SOUTHERN RAILWAY OVER</b>  <b>POWHITE PARKWAY</b>          BRIDGE B-05</p>	
<p><b>SHOE DETAILS</b></p>	
<p>HAYES, SEAY, MATTERN &amp; MATTERN          Associate Engineers</p>	<p>SCALE: <u>AS SHOWN</u></p>
<p>HOWARD, NEEDLES, TAMMEN &amp; BERGENDOFF          General Consultants</p>	<p>CONTRACT NO. <u>2</u></p> <p>SHEET NO. <u>17</u> OF <u>19</u></p>



# **Bridge 8**

**Northbound and Southbound Powhite Parkway (VA-76) Parallel Bridges  
Over  
The James River, Kanawha Canal and CSXT Railroad Tracks**

**Original Construction Plans for Bridge 8N and 8S**

**Record Set Plans**




INDEX OF SHEETS

SHEET NO.	TITLE
1	COVER SHEET
2-3	GENERAL PLAN AND ELEVATION
4	BRIDGE LAYOUT, GENERAL HOLES AND ESTIMATE OF QUANTITIES
5	PROFILES AND PAVEMENT ELEVATIONS
6	SOUTH ABUTMENT
7	NORTH ABUTMENT
8	ABUTMENT DETAILS
9	PIER 1
10	PIER 2
11	PIER 3
12	(DELETED)
13	PIER 4
14	(DELETED)
15	PIER 5
16	PIER 6
17	PIER 7
18	PIER 8
19	PIER 9
20	PIER 10
21	PIER 11
22	PIER 12
23	PIER 13
24	PIER 14
25	PIER 15
26	PIER 16
27	PIER 17
28	FRAMING PLAN - UNITS 1, 2, 3 AND 4
29	FRAMING PLAN - UNITS 5 THRU 12
30	FRAMING PLAN - UNITS 13, 14 AND 15
31	FRAMING PLAN - UNITS 16, 17 AND 18
32-33	STRUCTURAL STEEL DETAILS
34	SHOES
35	JOINT DETAILS
36	DRAINAGE SCUPPERS
37	DECK PLAN - UNITS 1, 2, 3 AND 4
38	DECK PLAN - UNITS 5 THRU 12
39	DECK PLAN - UNITS 13, 14 AND 15
40	DECK PLAN - UNITS 16, 17 AND 18
41	DECK DETAILS
42	ALUMINUM RAILING DETAILS
43	(DELETED)
44	ELECTRICAL DETAILS
45	APPROACH SLABS
46	SLOPE PROTECTION
47-53	BORING LOGS

RICHMOND  
METROPOLITAN AUTHORITY

PLAN AND PROFILE OF PROPOSED  
RICHMOND EXPRESSWAY SYSTEM

CHESTERFIELD COUNTY  
CITY OF RICHMOND  
JAMES RIVER BRIDGE

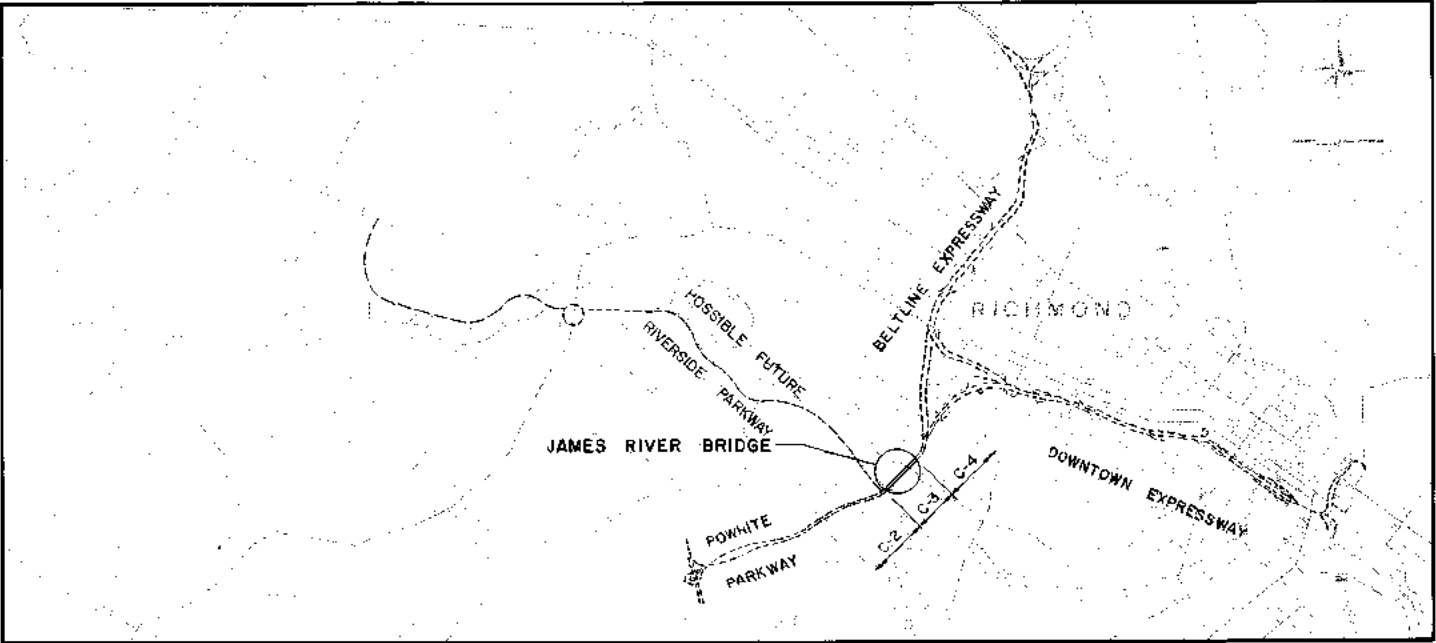

CONTRACT C-3

BRIDGE B-8

CONVENTIONAL SIGNS		
STATE LINE	LEVEE OR EMBANKMENT	
COUNTY LINE	BRIDGES	
CITY, TOWN OR VILLAGE	CULVERTS	
RIGHT OF WAY LINE	DROP INLET	
FENCE LINE	TROLLEY POLES	
UNFENCED PROPERTY LINE	POWER POLES	
FENCED PROPERTY LINE	TELEPHONE OR TELEGRAPH POLES	
TRAVELED WAY	MARSH	
GUARD RAIL	WOODS	
RETAINING WALL	GROUND ELEVATION	
RAILROADS	GRADE ELEVATION	
BASE OR SURVEY LINE	POLES WITHIN CONSTRUCTION LIMITS	

LIMITED ACCESS HIGHWAY

RICHMOND EXPRESSWAY SYSTEM			
SECTION	PROJECT	SHEET NO.	TOTAL SHEETS
3	JAMES RIVER BRIDGE	1	53


SUBMITTED BY	
Date	
1-22-71	John P. Fowler HOWARD, NEEDLES TAMMEN & BERGENDOFF GENERAL CONSULTANT

RECOMMENDED BY	
Date	
1-22-71	General Manager RICHMOND METROPOLITAN AUTHORITY


APPROVED BY	
Date	
1-22-71	Chairman RICHMOND METROPOLITAN AUTHORITY

Plans Revised			
Sheet No.	Date	Sheet No.	Date
1-6,9-16,28,29	2-20-71		
32,38,41,43,46	2-20-71		
1,2,3,17,37	3-9-71		
38,39,40	3-9-71		
1,4,35,36,44	4-5-71		
21	8-3-71		
23	4-18-72		
45	5-2-72		

RICHMOND EXPRESSWAY SYSTEM			
SECTION	PROJECT	SHEET NO.	TOTAL SHEETS
3	JAMES RIVER BRIDGE	2	53

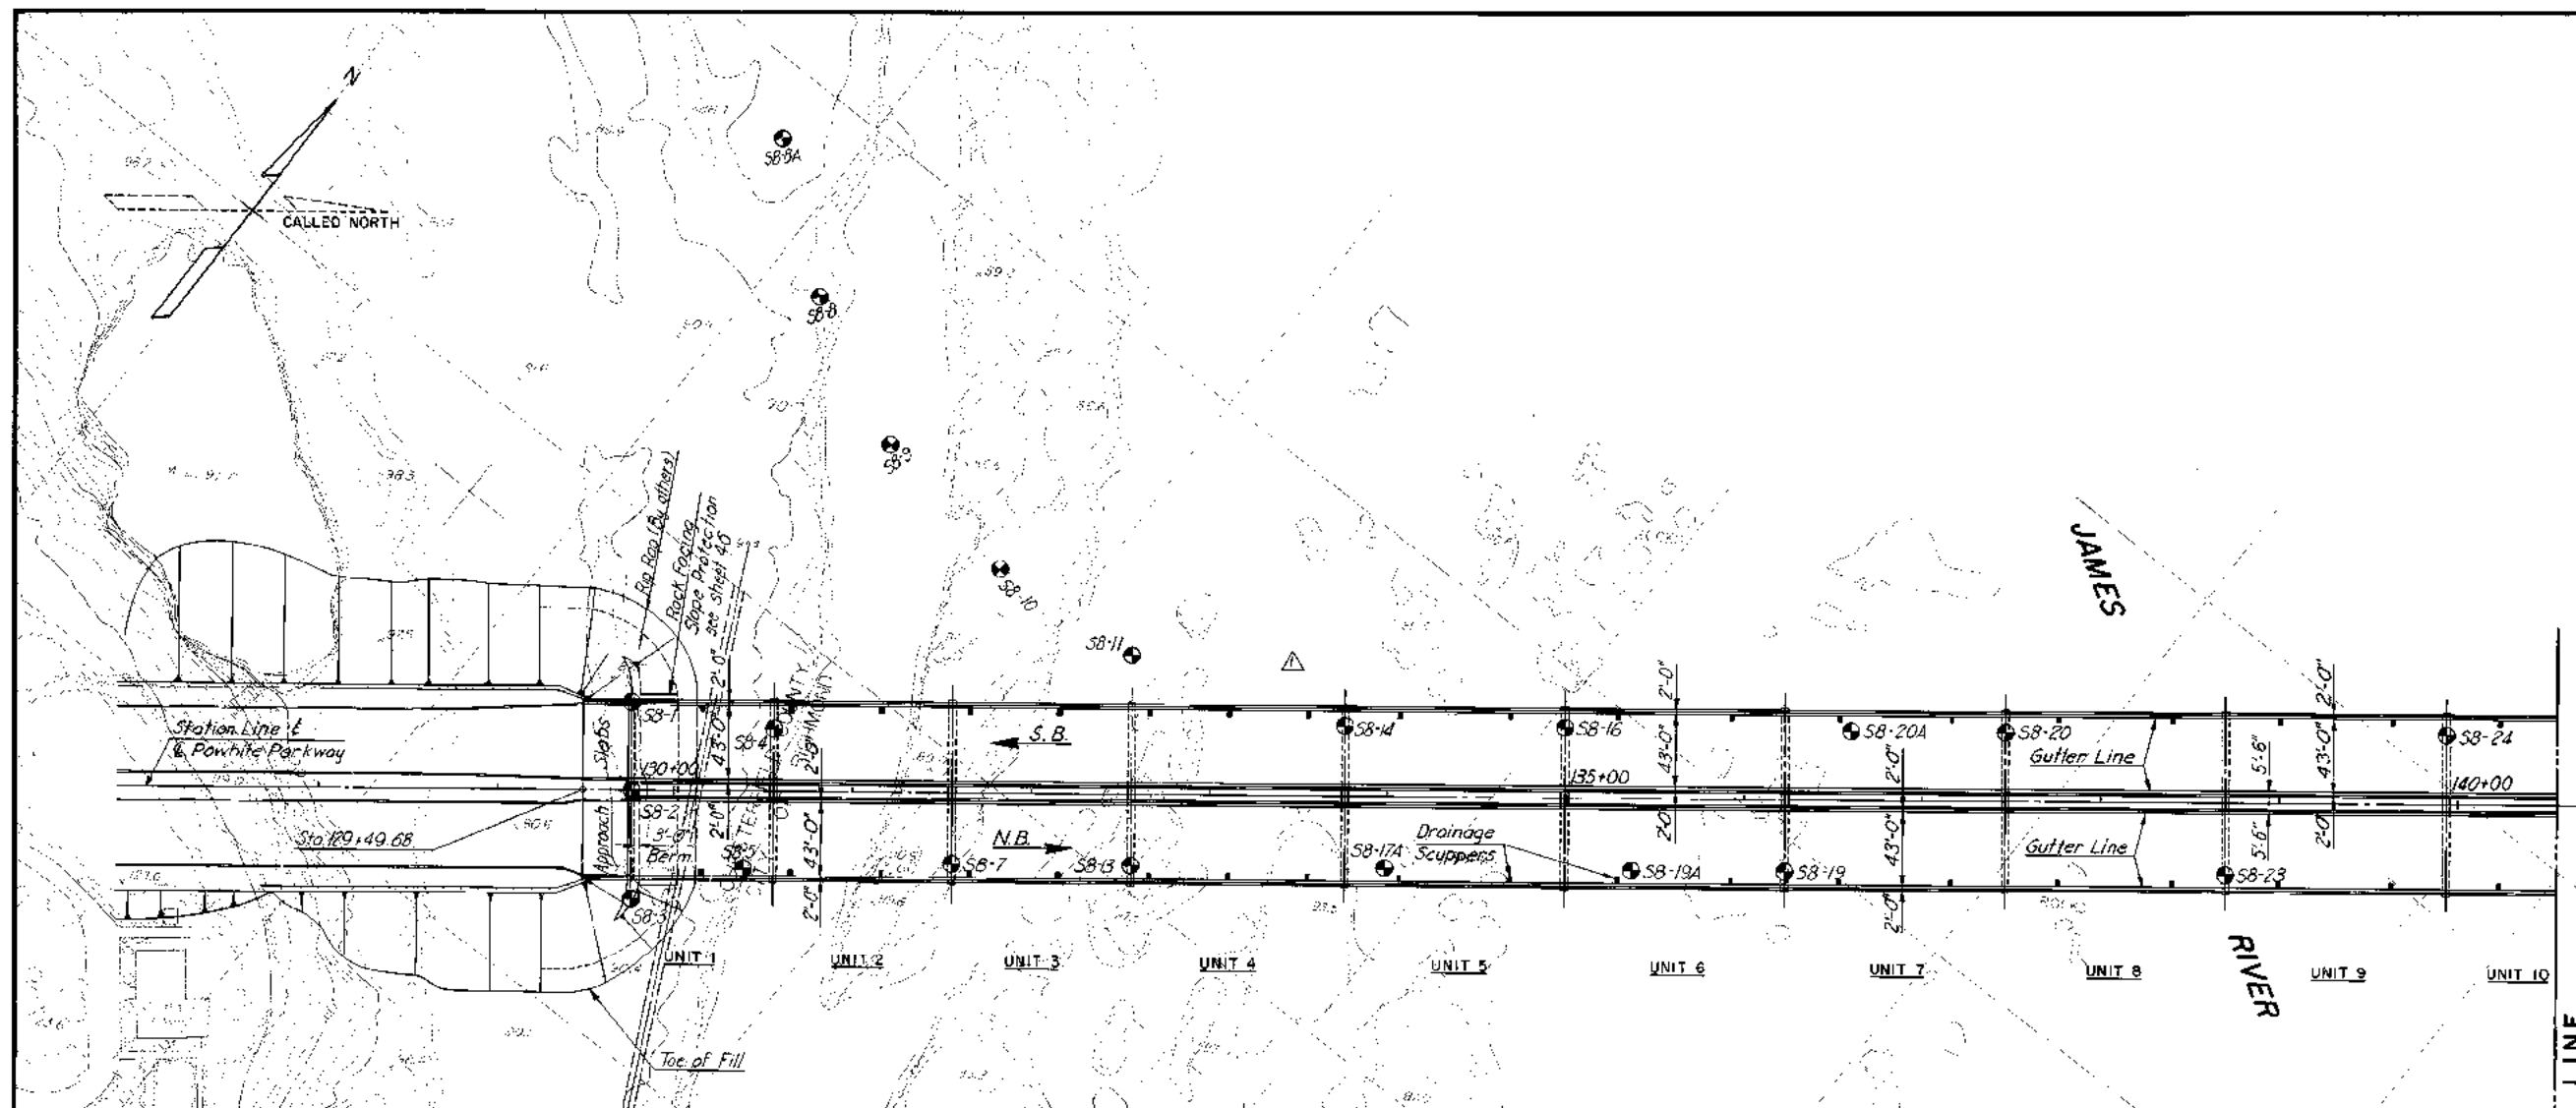

PLAN

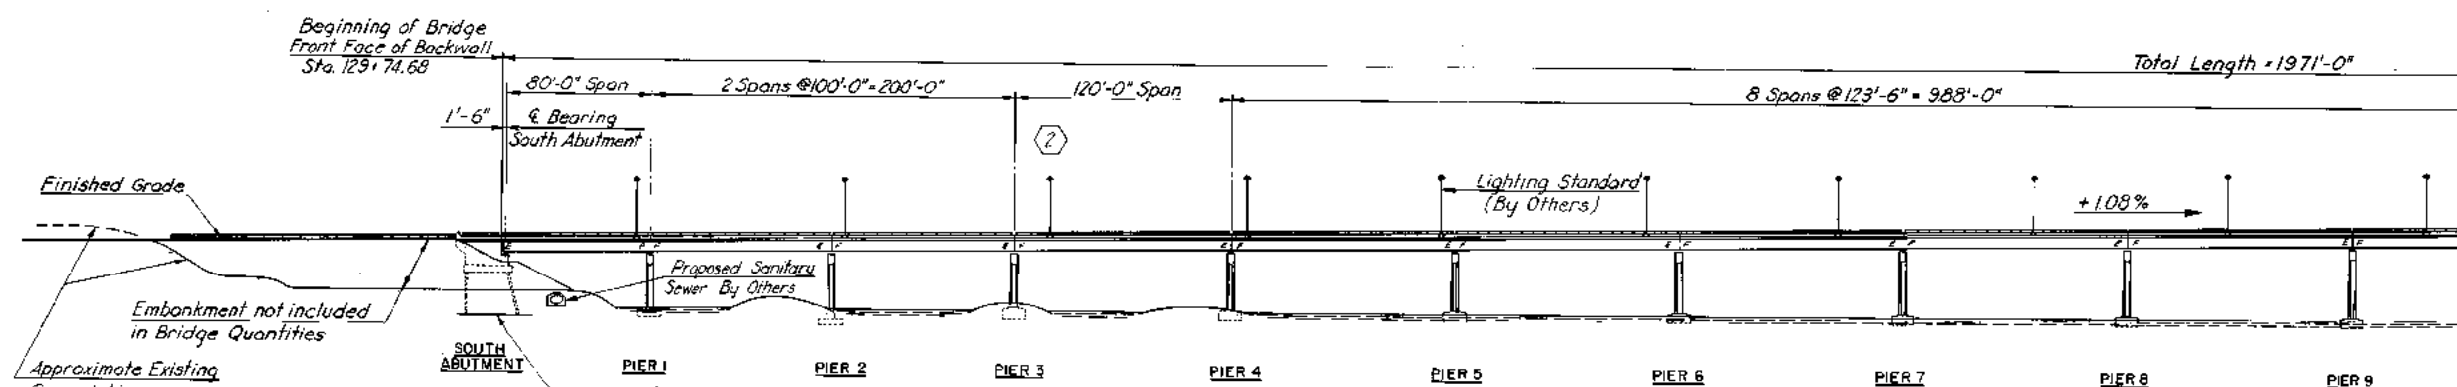

ELEVATION

NOTES:  
For Bridge Layout and General Notes see sheet no. 4.  
For Profiles see sheet no. 5.  
⊕ Indicates 2" Cased Hole Boring.

BY	DATE	AS BUILT	JRC	12-72
MADE	HBW	8-67	Light Std. Location	JGV 3/9/77
CHECKED	FXH	2-68	Remove Ramp Taper	H.B.W. 2/20/77
IN CHARGE	FXH	NO.	REVISION	BY DATE

CURVE				DATA				SUMMARY			
CURVE NO.	Δ	D	R	T	L	BACK TANGENT BEARING	FORWARD TANGENT BEARING	BEGIN CURVE	COORDINATES NORTH	COORDINATES EAST	P.I.
1	8°00'00"	10°00'00"	572.96'	40.06'	80.00'	S52°46'10.5"W	S60°46'10.5"W	P.C. 10+00.00	52,630.09	50,936.00	10+40.06
2	61°13'55.5"	33°22'40.4"	310.00'	188.46'	331.30'	S60°46'10.5"W	N57°59'54.0"W	P.C. 10+80.00	52,647.09	50,869.14	12+63.45
3	30°20'00"	10°00'00"	572.96'	153.52'	300.00'	N57°59'54.0"W	N27°59'54.0"W	P.C. 14+11.30	52,654.72	50,553.48	15+64.82
									52,736.08	50,423.28	P.T. 17+11.30

RICHMOND METROPOLITAN AUTHORITY  
RICHMOND EXPRESSWAY SYSTEM



JAMES RIVER BRIDGE  
GENERAL PLAN AND ELEVATION

HOWARD, NEEDLES, TAMMEN & BERGENDOFF  
Consulting Engineers  
NEW YORK ALEXANDRIA KANSAS CITY

SCALE: 1" = 50'  
CONTRACT NO.: C-3  
SHEET NO. 2 OF 53



RICHMOND EXPRESSWAY SYSTEM			
SECTION	PROJECT	SHEET NO.	TOTAL SHEETS
3	JAMES RIVER BRIDGE	3	53

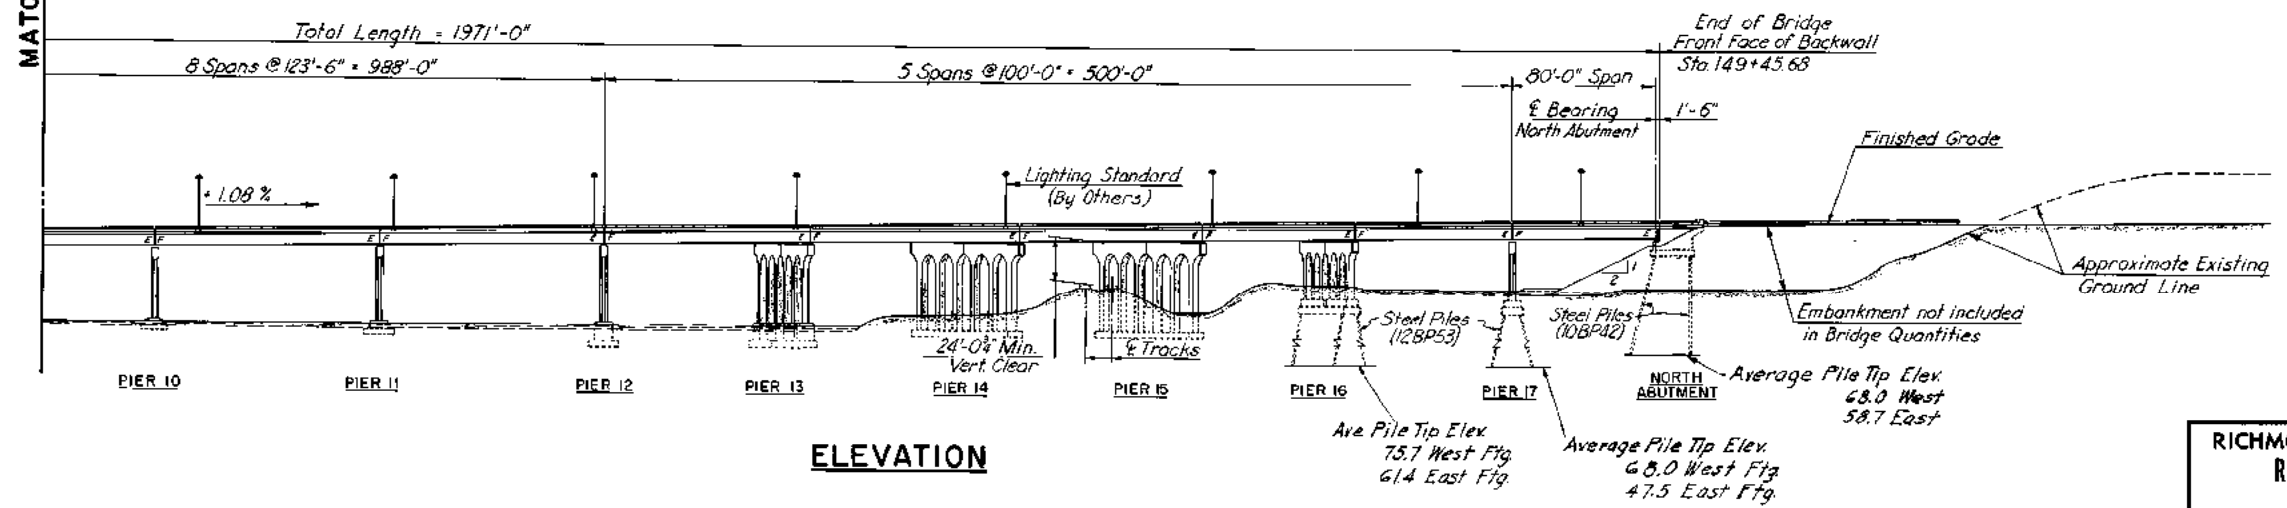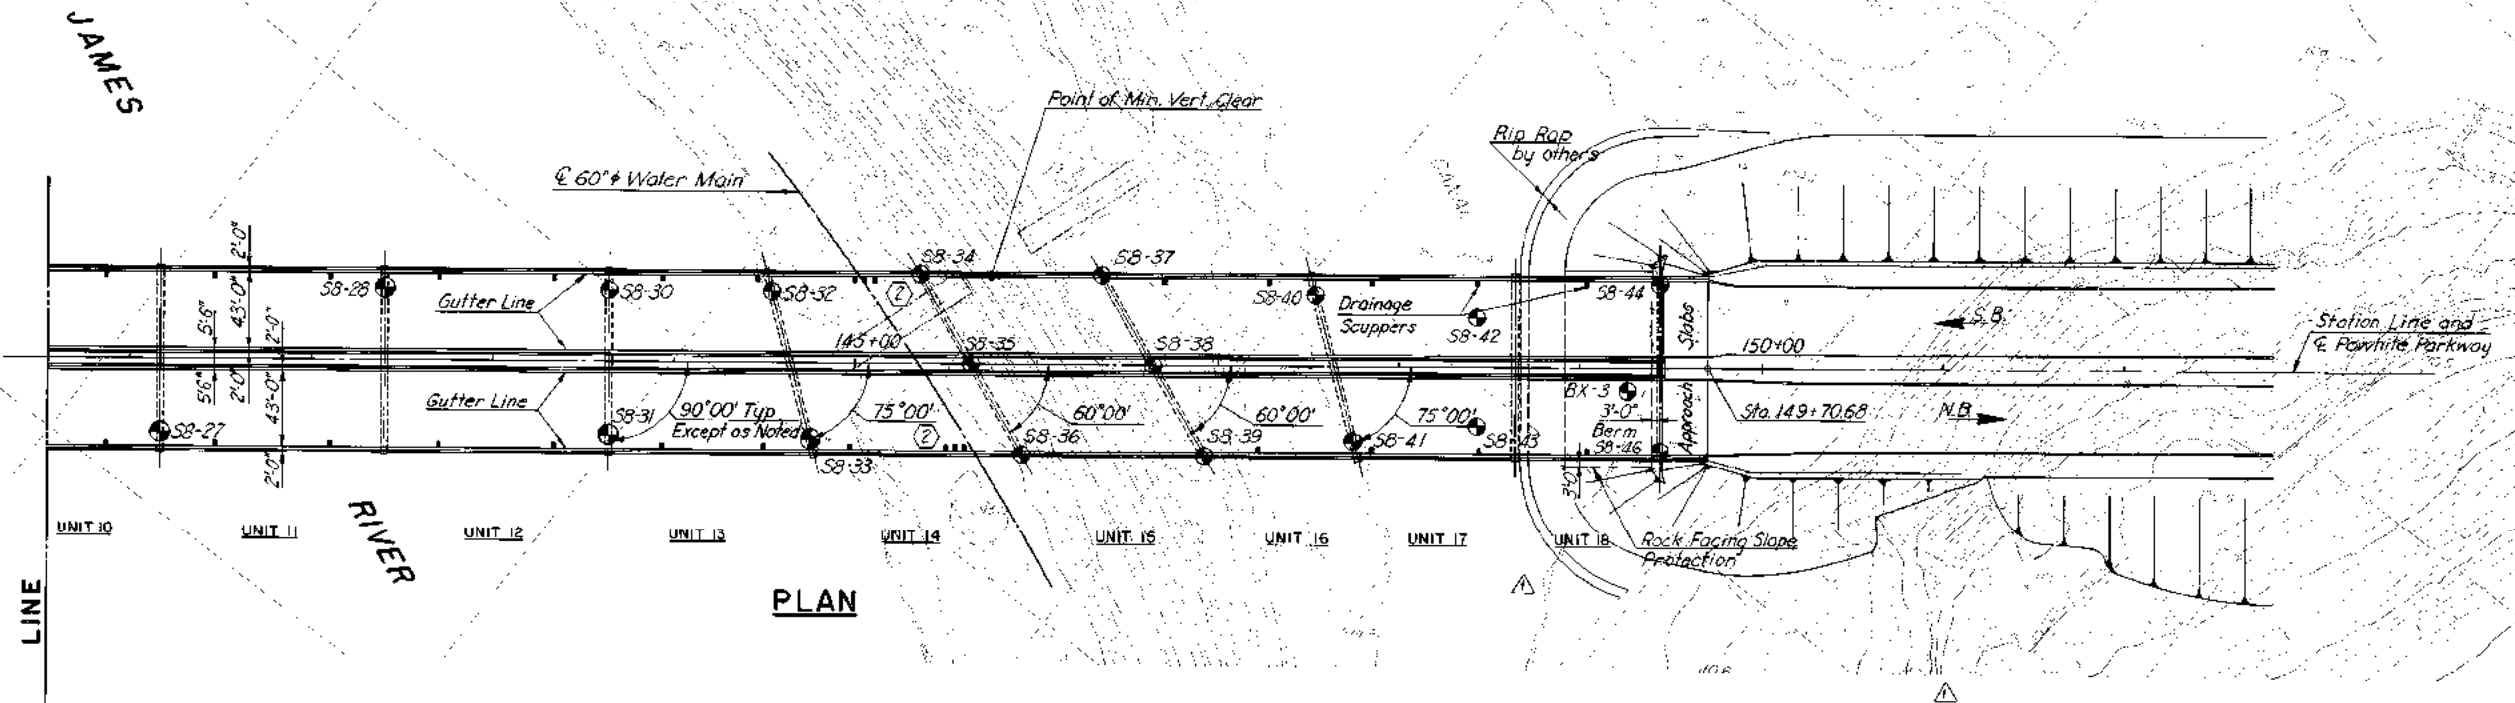

**NOTES:**  
 For Bridge Layout and General Notes see sheet no. 4.  
 For Profiles see sheet no. 5.  
 Indicates 2" & Cased Hole Boring.

**RICHMOND METROPOLITAN AUTHORITY  
 RICHMOND EXPRESSWAY SYSTEM**

**JAMES RIVER BRIDGE  
 GENERAL PLAN AND ELEVATION**

HOWARD, NEEDLES, TAMMEN & BERGENDOFF  
 consulting engineers  
 NEW YORK ALEXANDRIA KANSAS CITY  
 SCALE: 1" = 50'  
 CONTRACT NO. C-3  
 SHEET NO. 3 OF 53

BY	DATE	3	AS BUILT	JRC	12-72
MADE	HBW	8-67	Scupper Location	JGV	3/9/71
CHECKED	FXH	2-68	Elim. Disposal Area Add Foot Path	E.V.R.	2/20/71
IN CHARGE	FXH		NO. REVISION	BY	DATE

# ESTIMATE OF QUANTITIES

	Struct. Excav. of Piers 10 To 13 Incl.	Struct. Excav. Except Piers 10 To 13 Incl.	Porous Backfill	Steel Sheet Piling (Left in Place)	Steel Piles 10B-42	Steel Piles 12B-53	Concrete Class A3 Substructure	Concrete Class A3 Appr. Slabs	Concrete Class A4	Concrete Class T3	Reinforcing Steel	Structural Steel	Aluminum Bridge Railing	Dampproofing	6" Pipe Underdrain	△	Rock Facing Slope Protec- tion 6" Thick	Water Barriers 4" Curbed Walls Inc. L. Sampling	N.Y. Core Borings in Rock
	G.Y.	G.Y.	G.Y.	S.F.	L.F.	L.F.	G.Y.	G.Y.	G.Y.	G.Y.	Lbs.	Lbs.	L.F.	S.Y.	L.F.		S.Y.	L.F.	L.F.
Superstructure									60598		1345522	6310579	7965						
South Abutment		624	48		1520.8		2950				13465			142	133		170		
North Abutment		608	48		3.2±0		286.7				13465			144	136		844		
Pier 1		923	△				2709	△			44586	△							
Pier 2		358	△				2626	△			44586	△							
Pier 3		123	△				2745	△			44434	△							△
Pier 4		97	△				3118	△			44435	△							△
Pier 5		156	△				3242	△			44434	△							△
Pier 6		132	△				2981	△			44435	△							△
Pier 7		133					3418				44434								
Pier 8		105					3284				44435								
Pier 9		154					3183				44434								
Pier 10	245						382.7			510	56790							12	385
Pier 11	705						547.5				74957							12.5	114.6
Pier 12	842						575.5				75469							47.6	41.4
Pier 13	886						596.8			285	89317							18.7	400
Pier 14		845		1469			448.2			612	78522								
Pier 15		946		1494			483.3			250	78522								
Pier 16		656		2260		1465.7	370.8			156.7	46374								
Pier 17		478		2197		2048.8	353.0			151.3	43678								
Approach Slabs								238.6			51421								
		△					△		△		△	△	△						
TOTAL	2678	5808	96	7920	5049.8	35145	7075.1	238.6	60598	473.7	2361755	6310579	7965	286	269		1014	80	234.5

## GENERAL NOTES:

ROADWAY Twin Roadways 45'-0" clear.  
CAPACITY Dead Load-Includes 15 lbs. per sq. ft. for future wearing surface.  
Live Loads-HS20-44 loading and B.P.R. Modified Loading for Military Vehicles.

SPECIFICATIONS GENERAL - Virginia Department of Highway Road and Bridge Specifications, 1970.  
DESIGN - A.A.S.H.O. Standard Specifications for Highway Bridges, 1961, modified by Special Design Provisions.  
WELDING - 1969 Standard Specifications for Welded Highway and Railway Bridges of the American Welding Society.  
ELECTRICAL - National Electrical Code, National Electrical Safety Code.

CONTRACT SPECIAL PROVISIONS Specifications and Contract Special Provisions referred to above are necessary to make these plans complete.

DATUM CITY OF RICHMOND  
TEMPERATURE The normal temperature referred to on the plans is 68°F. The temperature range for movement is 0°F to 120°F.

DIMENSIONS All dimensions are measured horizontally and vertically unless otherwise noted.

FOUNDATIONS All footing concrete shall be placed in the dry except where Class T3 Concrete is indicated on the plans or approved by the Engineer. Special attention is called to Sections 401.04 and 401.05 of the General Specifications, and to the Contract Special Provisions, concerning preparation of foundations for footings.

Because of the erratic nature of ground conditions at the site, elevations of the bottoms of the footings shown on the plans shall be considered approximate only. Should excavations at the time of construction reveal the foundations to be inadequate, redesign may be required.

## CONCRETE NOTES






Concrete in superstructure shall be Class A4. All other concrete (except tremie seal concrete) shall be Class A3. All exposed edges and corners shall have a 3/4" chamfer or fillet unless otherwise noted. Care in the method of vibration, the use of low-sump concrete, and/or other means shall be employed to prevent downgrade movement of newly placed slab concrete when the gradient is over 2%.

All reinforcing steel shall conform to A.S.T.M. A-615, Grade 40. Reinforcing bar dimensions on the detailed drawings are to centers of bars unless otherwise noted. Clear distance between reinforcing steel and face of concrete shall be as noted on the plans. All bar laps shall be as shown on the plans.

## STEEL NOTES

Structural steel shall conform to A.S.T.M. Specification A36 except as noted.

All field connections shall be made with 7/8" diameter high strength bolts unless otherwise noted. Bolts shall conform to A.S.T.M. Specification A-325.

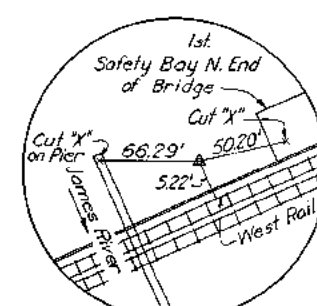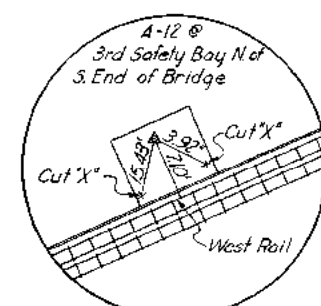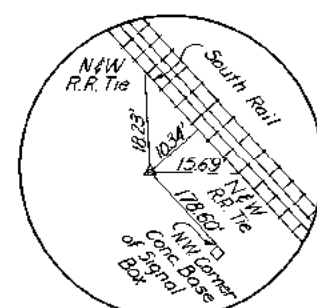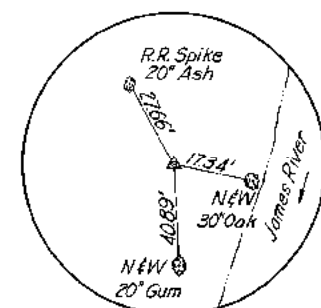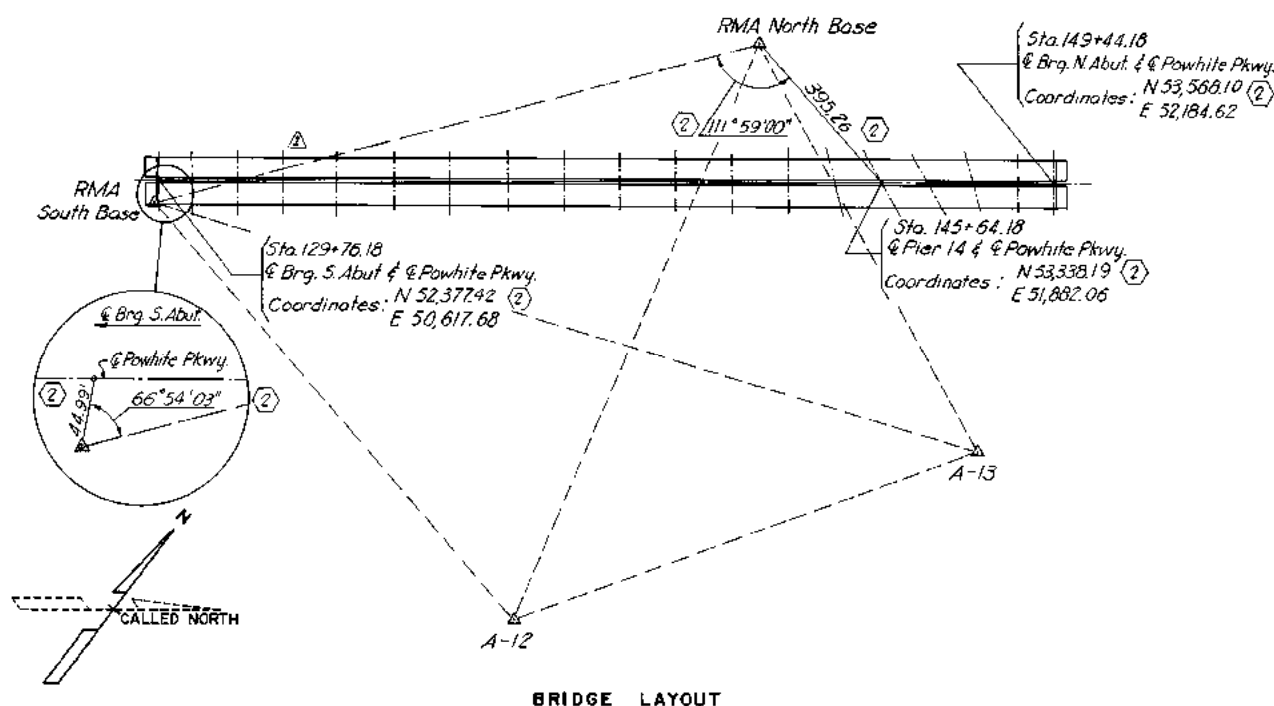


BY	DATE	As Built	JRC	12-72
MADE	HBW	11-67	Bridge Layout	H.B.W. 4/5/71
CHECKED	FXH	2-68	Quantities & Ramp Widening	H.B.W. 2/20/71
IN CHARGE	FXH	NO.	REVISION	BY DATE

RICHMOND METROPOLITAN AUTHORITY  
RICHMOND EXPRESSWAY SYSTEM


JAMES RIVER BRIDGE  
BRIDGE LAYOUT  
GENERAL NOTES  
ESTIMATE OF QUANTITIES

HOWARD, NEEDLES, TAMMEN & BERGLAND/DOFF CONSULTING ENGINEERS NEW YORK ALEXANDRIA TARKANS CITY	SCALE: NO. SCALE CONTRACT NO. C-3 SHEET NO. 4 OF 53
---	---

RICHMOND EXPRESSWAY SYSTEM			
SECTION	PROJECT	SHEET NO.	TOTAL SHEETS
3	JAMES RIVER BRIDGE	9	53

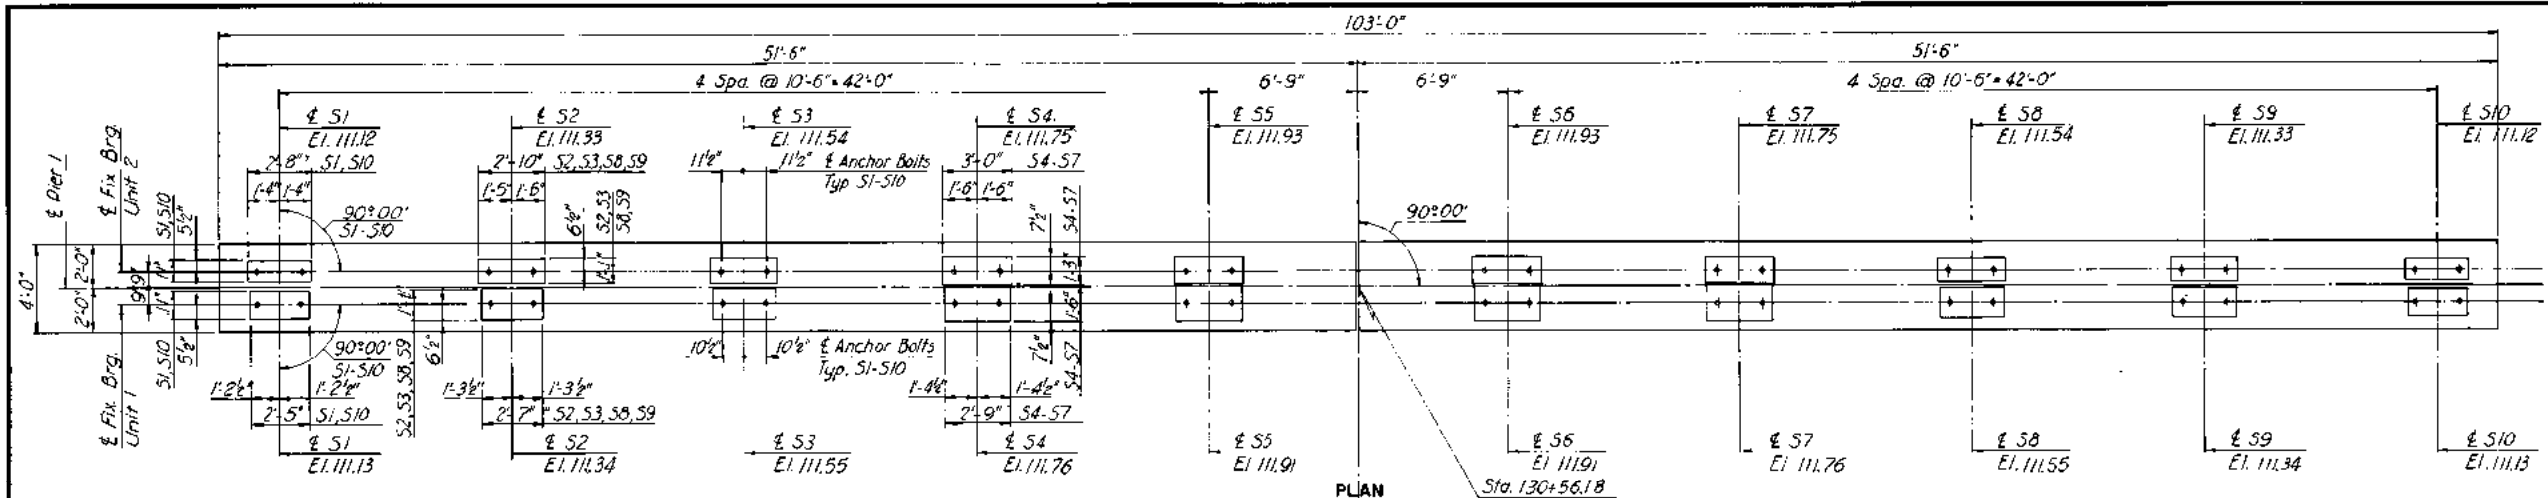

PLAN  
Scale: 1/4" = 1'-0"

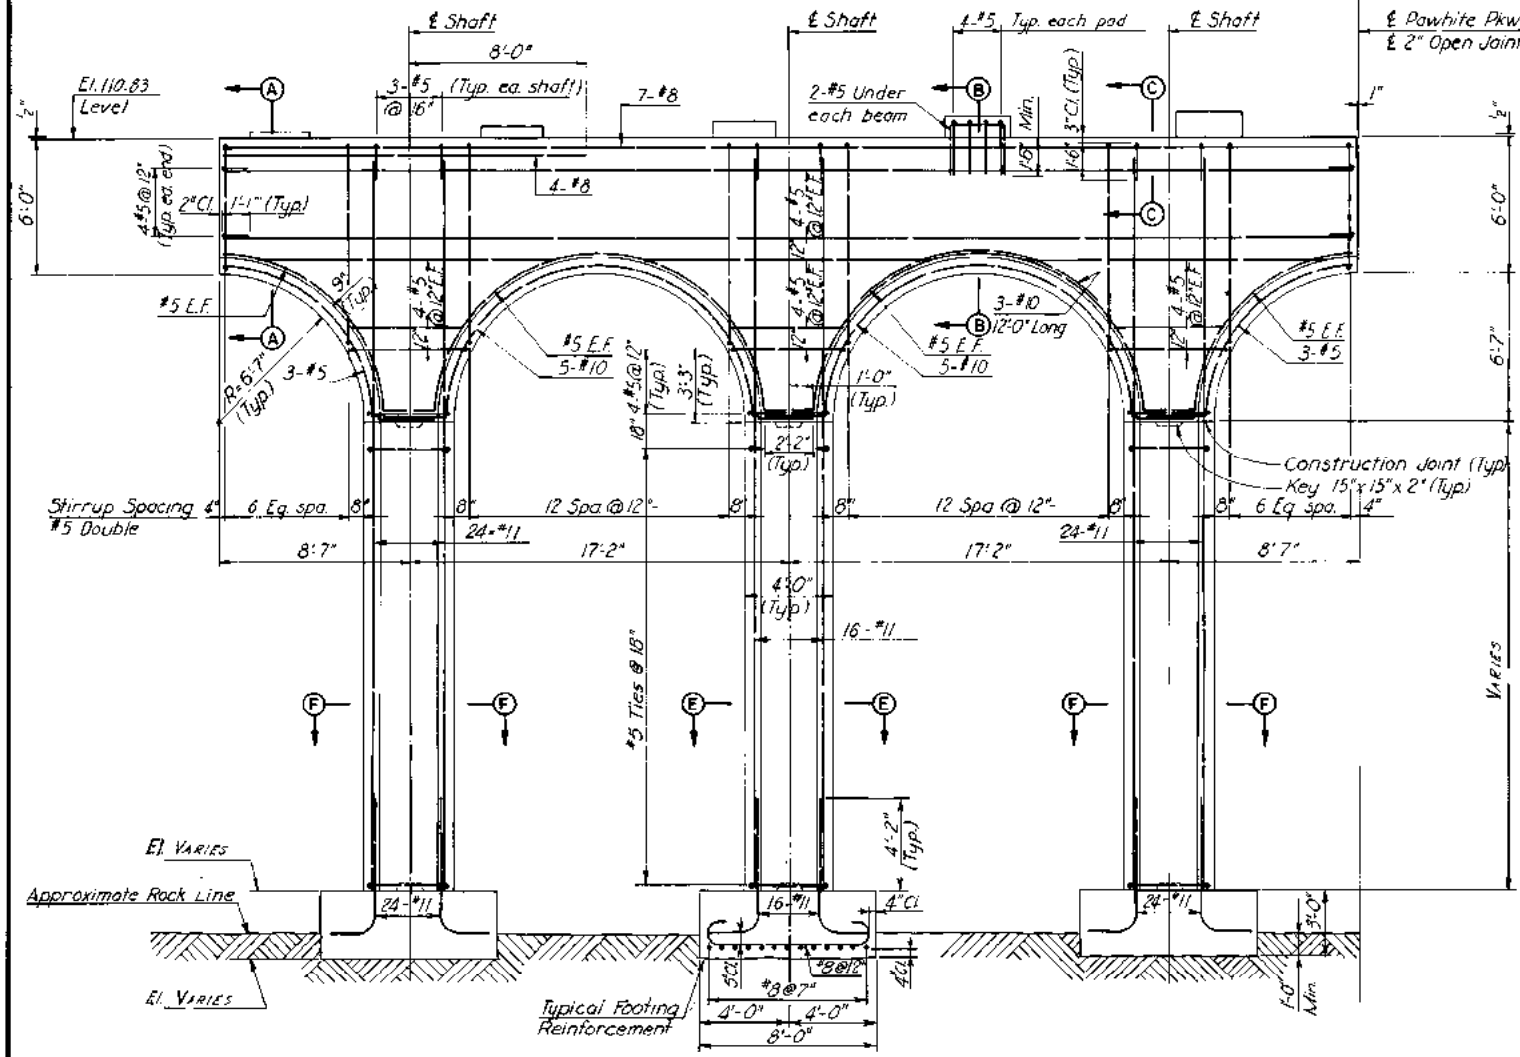


HALF ELEVATION  
Scale: 1/4" = 1'-0"


Note:  
Pier symmetrical about  
Powhite Pkwy.

FOOTING NO.	TOP ELEV.	AVE. BOTTOM ELEV.	STEM LENGTH
1 L W	80.36	76.46	17.89
1 C W	79.32	75.58	18.93
1 R W	78.55	75.12	19.70
1 L E	79.43	74.95	18.82
1 C E	80.28	76.59	17.97
1 R E	80.88	77.04	17.37


1 - Pier No.  
L-C-R = Left-Center-Right  
W-E = West-East

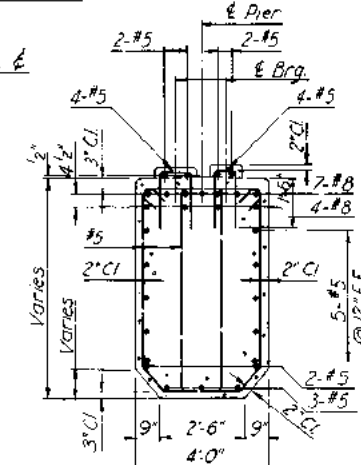


SECTION A-A  
Scale: 3/8" = 1'-0"

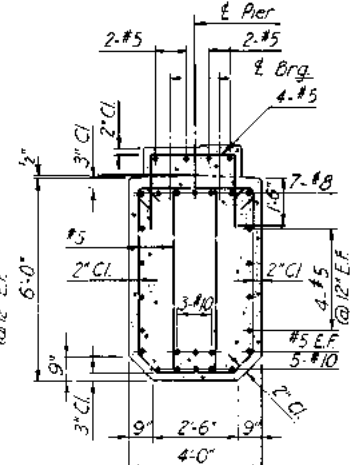


SECTION B-B  
Scale: 3/8" = 1'-0"

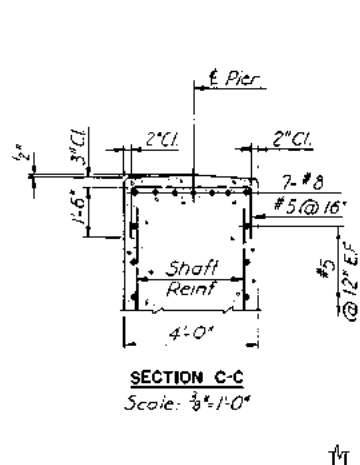


SECTION C-C  
Scale: 3/8" = 1'-0"

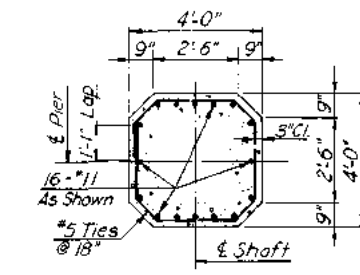

SECTION E-E  
Scale: 3/8" = 1'-0"

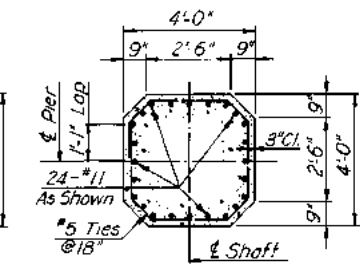

SECTION F-F  
Scale: 3/8" = 1'-0"

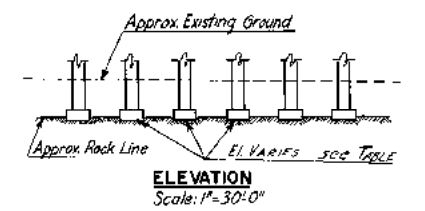

ELEVATION  
Scale: 1" = 30'-0"

NOTES:

Pier foundations are designed for an allowable bearing pressure of 7 Tons/S.F.

BY	DATE	NO.	REVISION	BY	DATE
MADE	L.B.P.	7-67	2	AS BUILT	JRC 12-72
CHECKED	FXH	2-68	Complete	J.G.V.	2-20-77
IN CHARGE	FXH				


RICHMOND METROPOLITAN AUTHORITY  
RICHMOND EXPRESSWAY SYSTEM

JAMES RIVER BRIDGE  
PIER 1


HOWARD, NEEDLES, TAMMEN & BERGENDOFF  
consulting engineers  
NEW YORK ALEXANDRIA KANSAS CITY

SCALE: AS SHOWN  
CONTRACT NO. C-3  
SHEET NO. 9 of 53

RICHMOND EXPRESSWAY SYSTEM			
SECTION	PROJECT	SHEET NO.	TOTAL SHEETS
3	JAMES RIVER BRIDGE	10	53

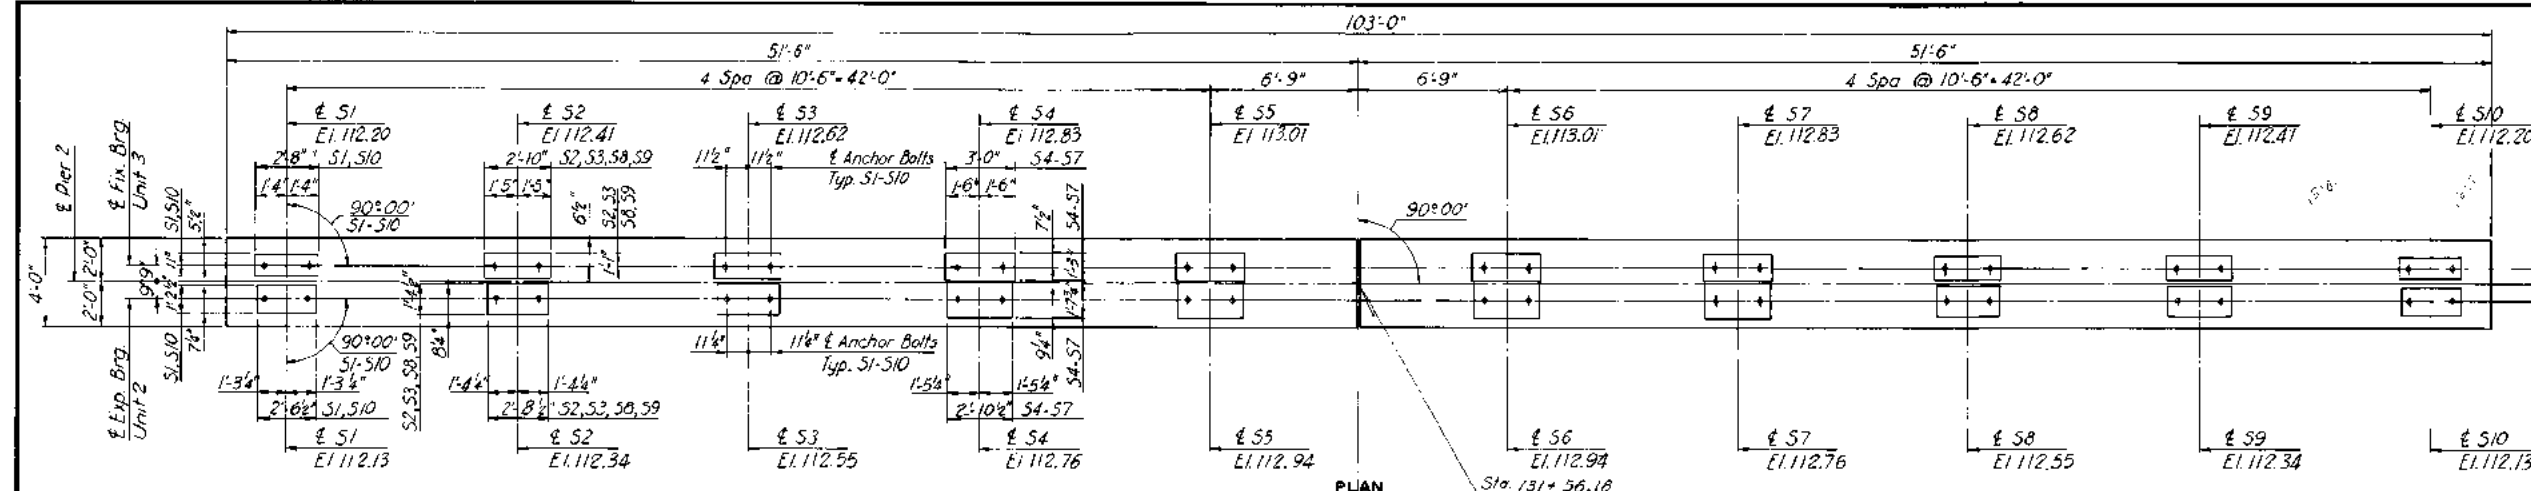


PLAN  
Scale: 1/4" = 1'-0"

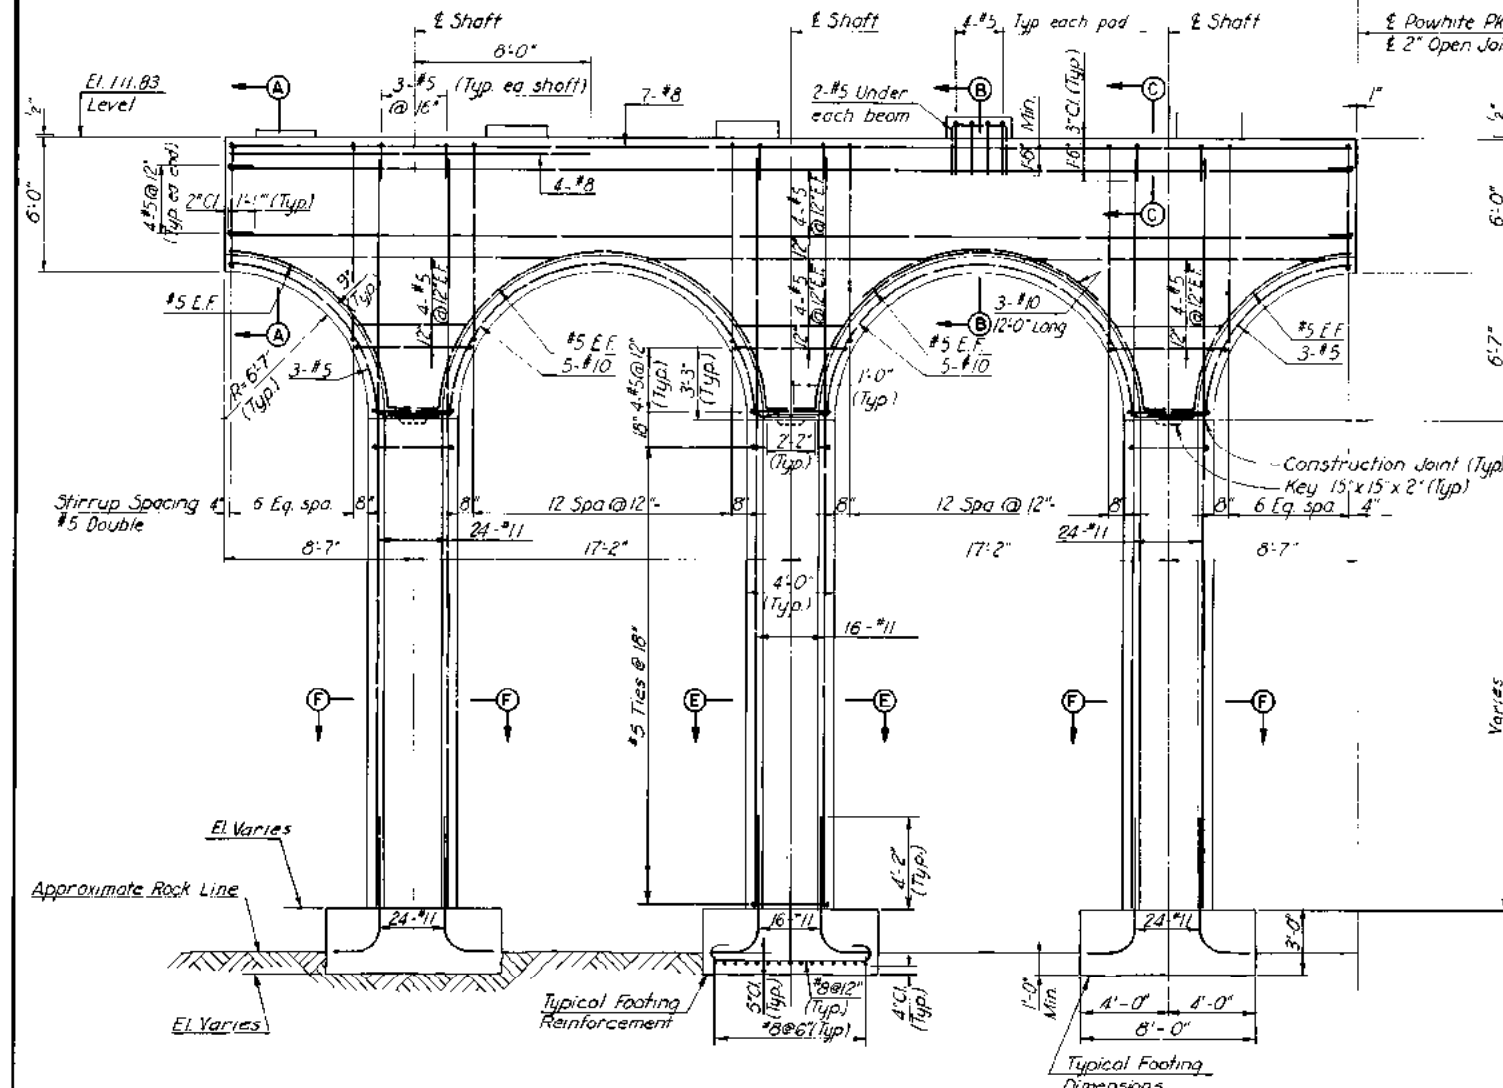


HALF ELEVATION  
Scale: 1/4" = 1'-0"

Note:  
Pier symmetrical about  
Powhite Pkwy.


FOOTING NO.	TOP ELEV.	AVE. BOTTOM ELEV.	STEM LENGTH
2 LW	82.81	78.95	16.44
2 CW	84.21	80.62	15.04
2 RW	81.24	77.77	18.01
2 LE	81.81	78.30	17.44
2 CE	81.17	77.33	18.08
2 RE	80.36	76.84	18.89

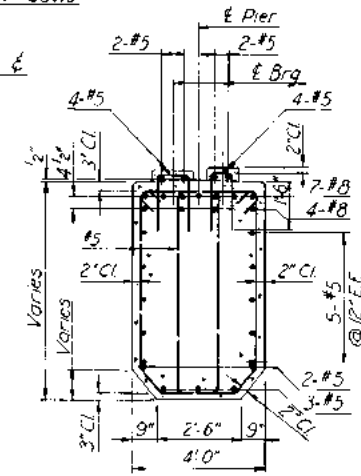


SECTION A-A  
Scale: 3/8" = 1'-0"

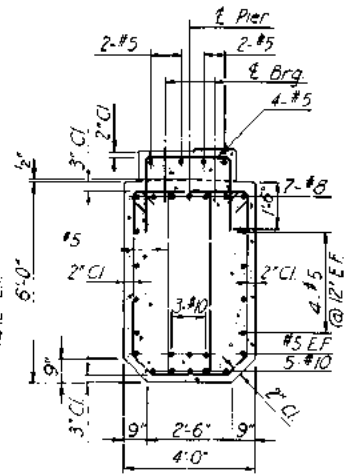


SECTION B-B  
Scale: 3/8" = 1'-0"

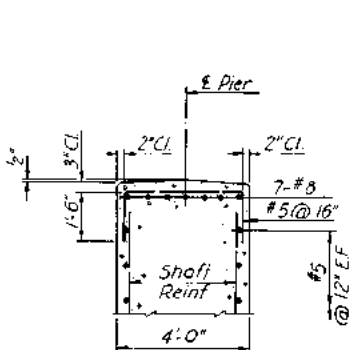


SECTION C-C  
Scale: 3/8" = 1'-0"

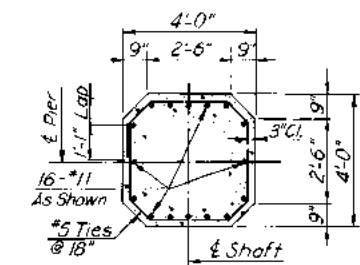

SECTION E-E  
Scale: 3/8" = 1'-0"

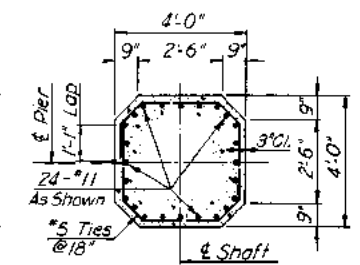

SECTION F-F  
Scale: 3/8" = 1'-0"

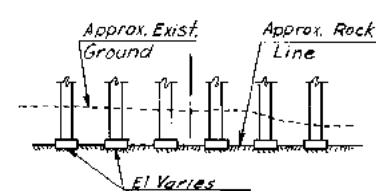

ELEVATION  
Scale: 1" = 30'-0"

NOTES:

Pier foundations are designed for an allowable bearing pressure of 10 Tons/S.F.

RICHMOND METROPOLITAN AUTHORITY  
RICHMOND EXPRESSWAY SYSTEM



JAMES RIVER BRIDGE  
PIER 2

HOWARD, NEEDLES, TAMMEN & BERGENDOFF  
consulting engineers  
NEW YORK ALEXANDRIA KANSAS CITY








SCALE: AS SHOWN  
CONTRACT NO. C-3  
SHEET NO. 10 OF 53

MADE	BY	DATE	BY	DATE
LBR	7-67	2	AS BUILT	JRC 12-72
CHECKED	FXH	2-68	Complete	H.B.W. 2/20/71
IN CHARGE	FXH	NO	REVISION	BY DATE

RICHMOND EXPRESSWAY SYSTEM			
SECTION	PROJECT	SHEET NO.	TOTAL SHEETS
3	JAMES RIVER BRIDGE	13	53

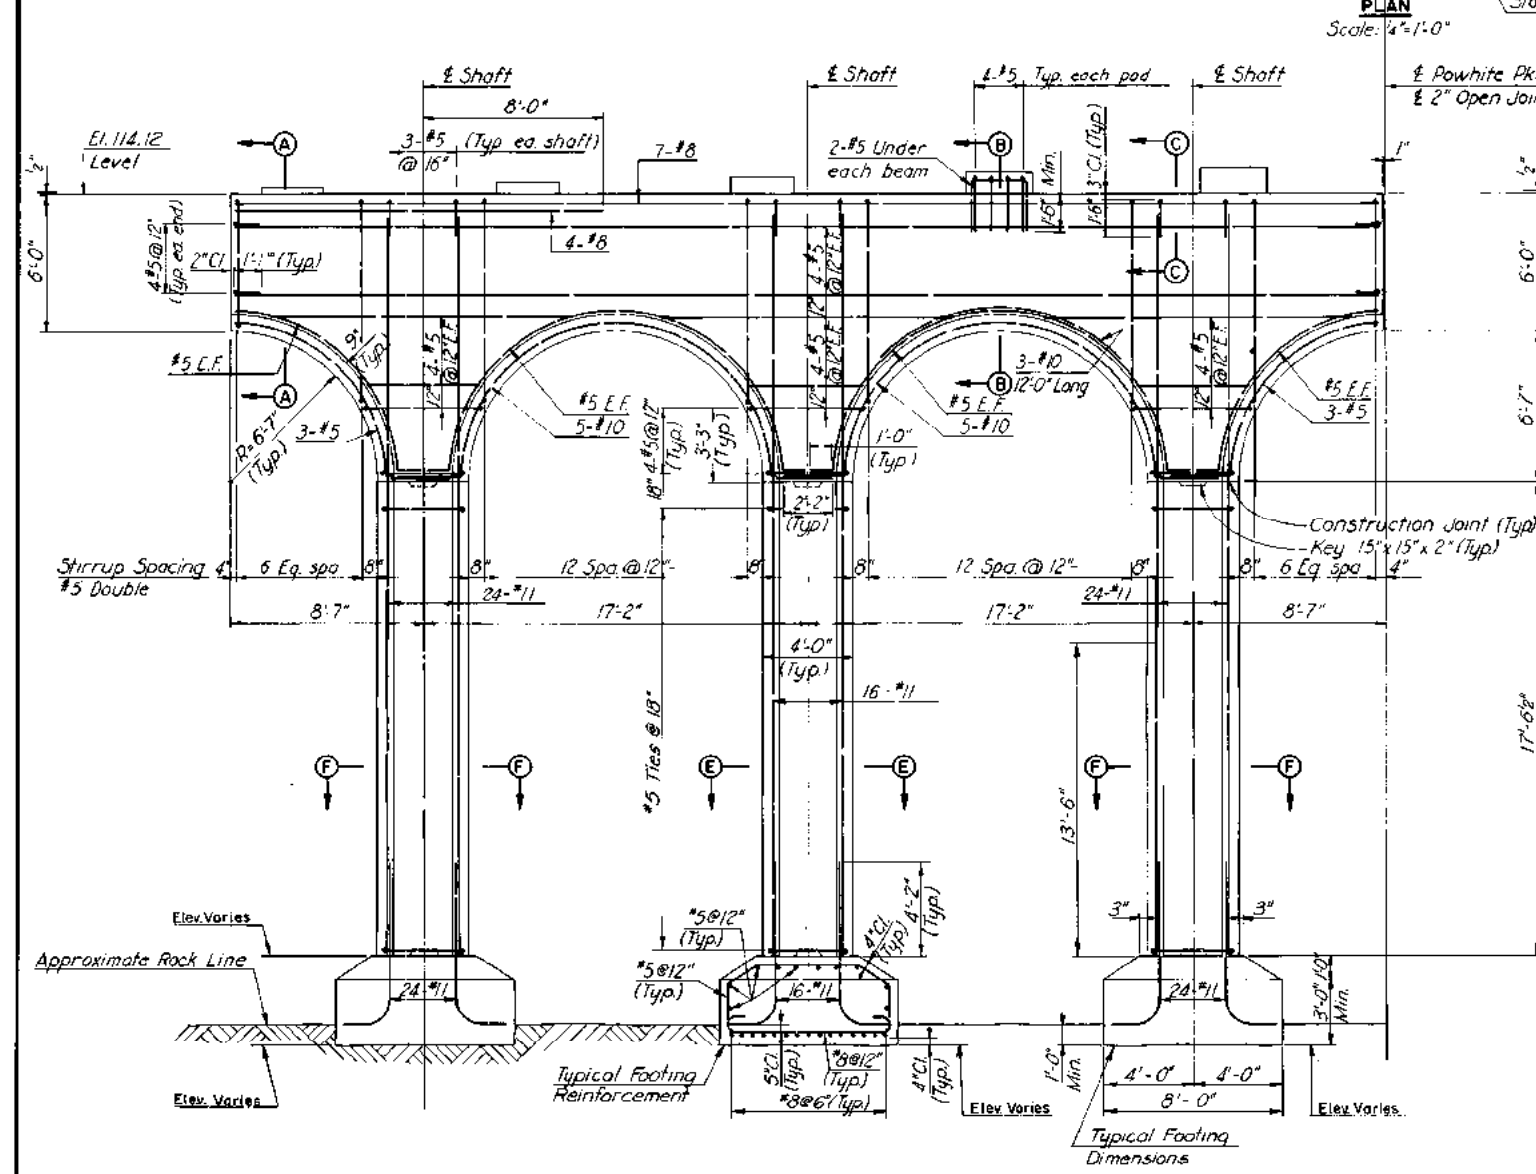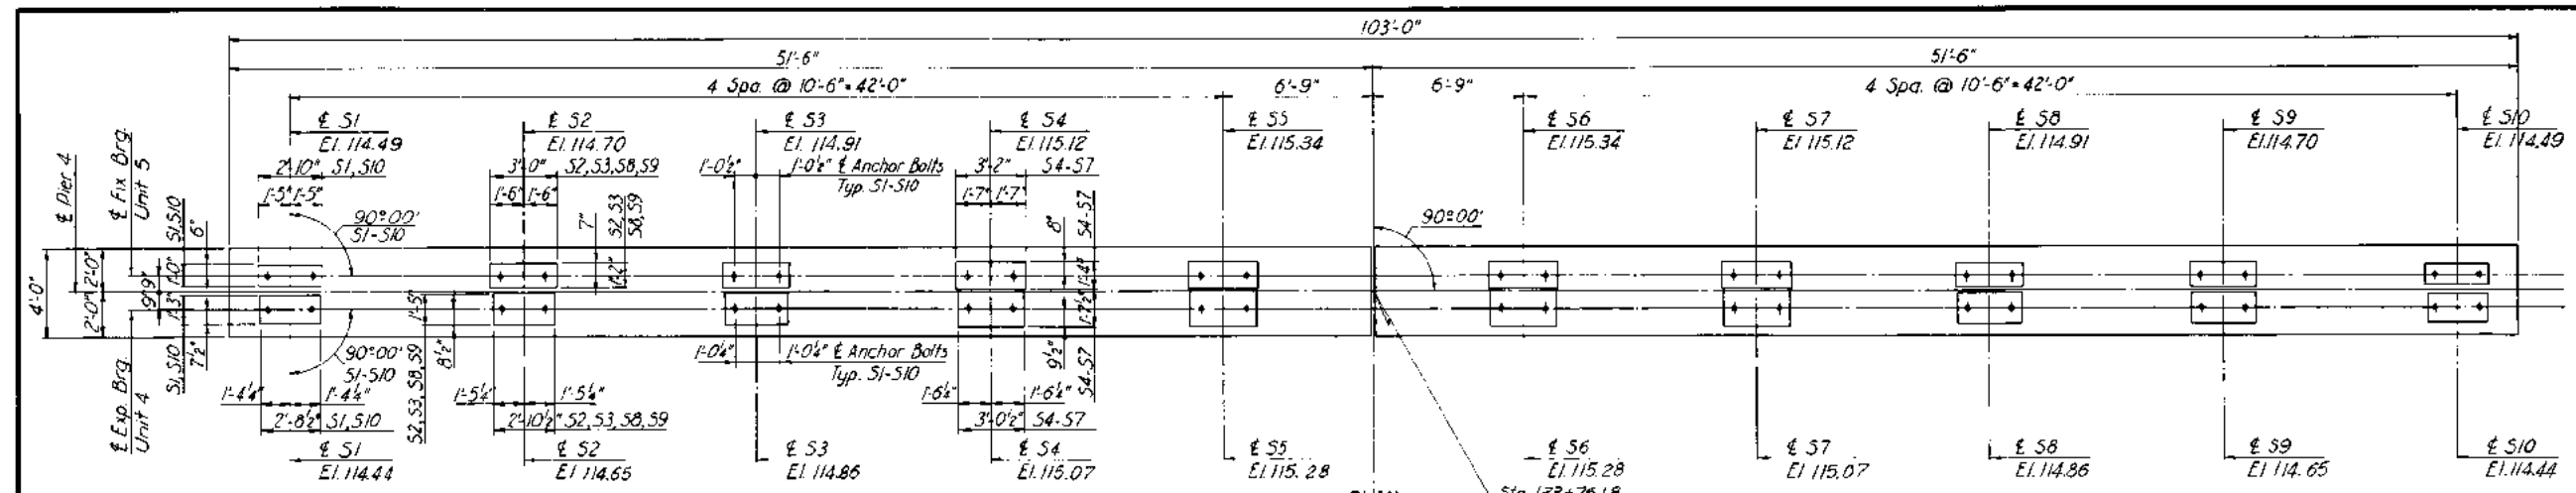

FOOTING NO.	AVE. BOTTOM ELEV.
4 L W	77.83
4 O W	77.24
4 R W	77.57
4 L E	77.86
4 O E	77.79
4 R E	77.93

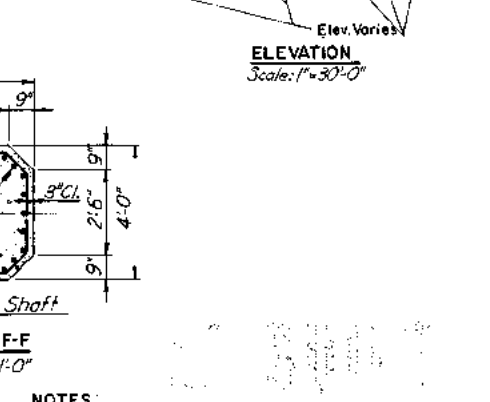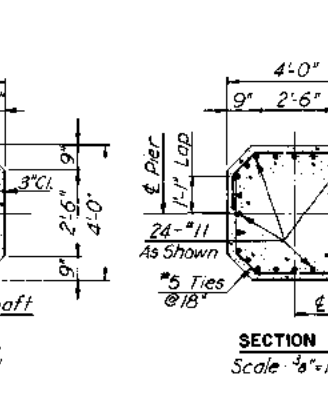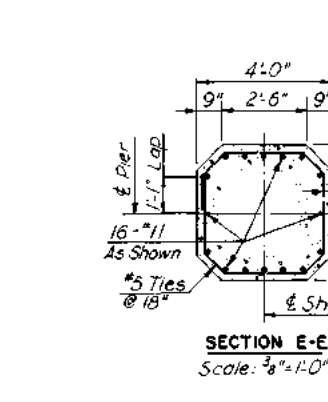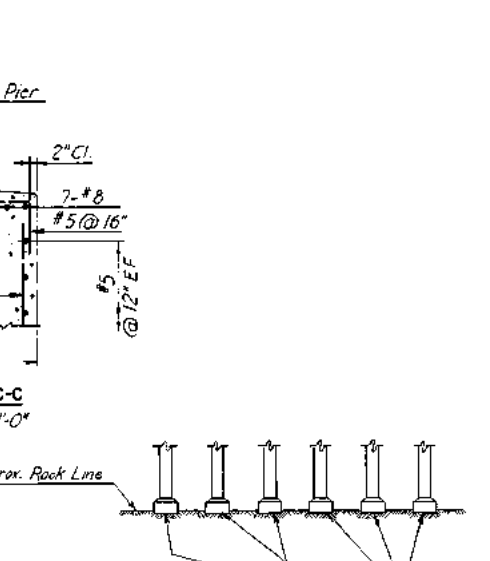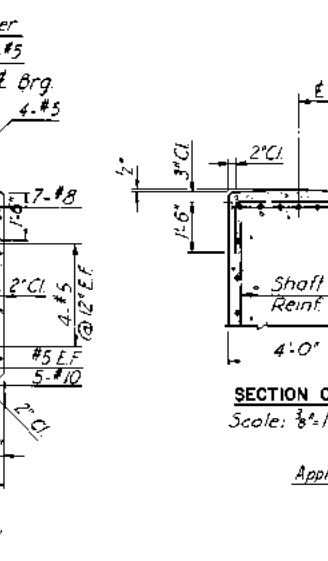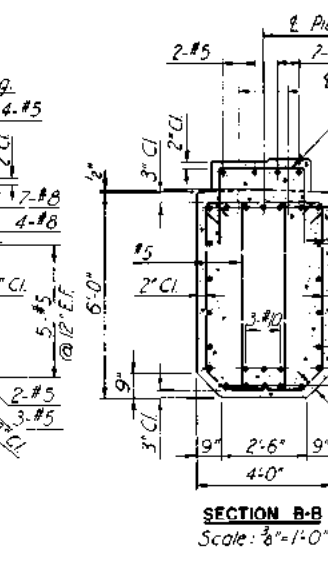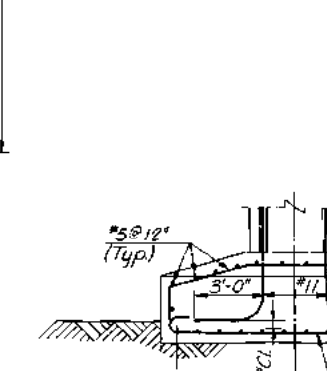

NOTES:  
Pier foundations are designed for an allowable bearing pressure of 10 Tons/S.F.

RICHMOND METROPOLITAN AUTHORITY  
RICHMOND EXPRESSWAY SYSTEM

JAMES RIVER BRIDGE  
PIER 4


HOWARD, NEEDLES, TAMMEN & BERGENDOFF  
Consulting Engineers  
NEW YORK ALEXANDRIA KANSAS CITY

SCALE: AS SHOWN  
CONTRACT NO.: C-3  
SHEET NO. 13 OF 53

BY	DATE	NO.	REVISION	BY	DATE
MADE	L.B.P. 7-67	2	AS BUILT	JRC	12-72
CHECKED	FXH 2-68	1	Complete	JGV	2-20-71
IN CHARGE	FXH	NO.	REVISION	BY	DATE

Note:  
Pier symmetrical about  
Powhite Pkwy. except for  
bottom of footing elevations


RICHMOND EXPRESSWAY SYSTEM			
SECTION	PROJECT	SHEET NO.	TOTAL SHEETS
3	JAMES RIVER BRIDGE	15	53

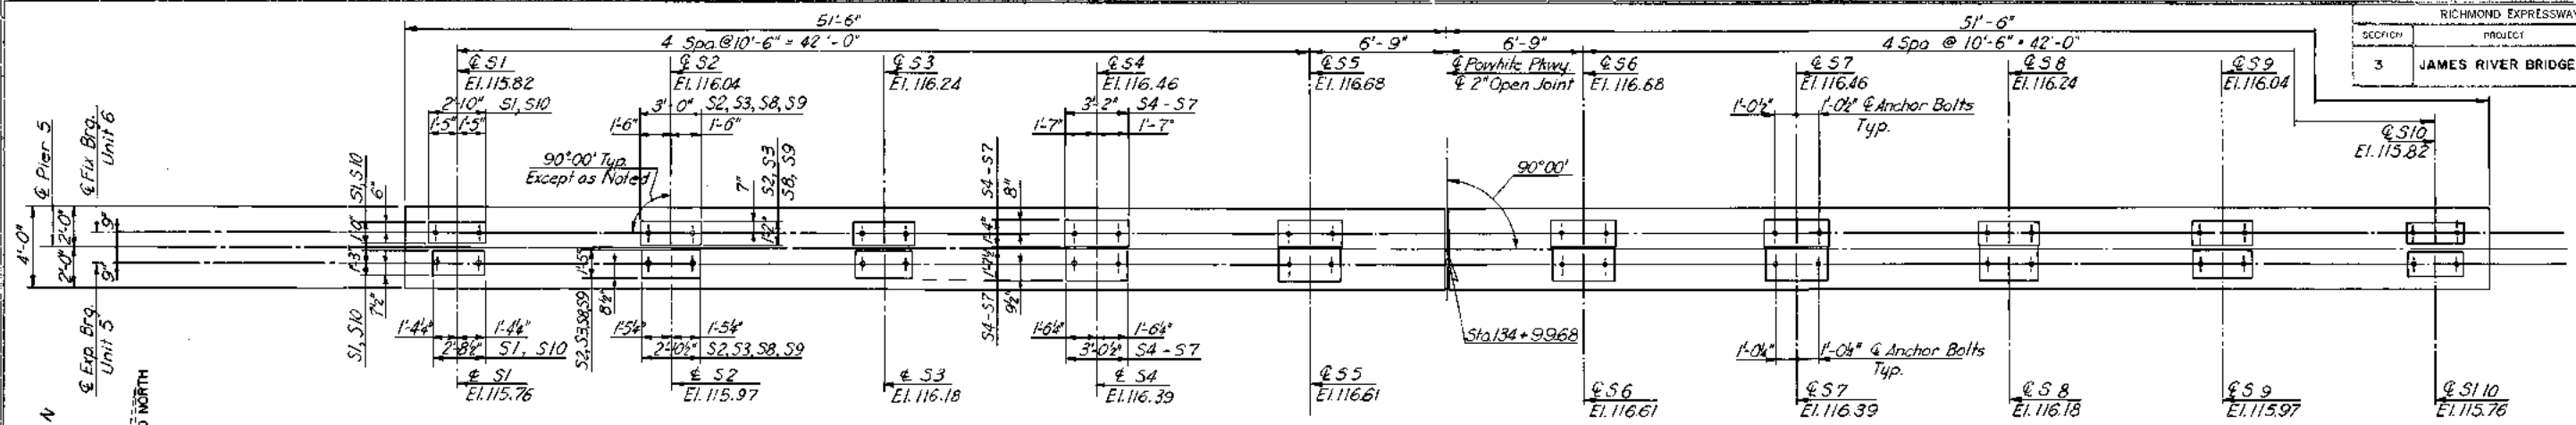



PLAN  
Scale: 1/4"=1'-0"

FOOTING NO.	AVE. BOTTOM ELEV.
5 LW	78.56
5 CW	77.78
5 RW	77.24
5 LE	76.23
5 CE	77.57
5 RE	76.71


Symm. about  $\epsilon$  except for bottom of Ptg. Elevations

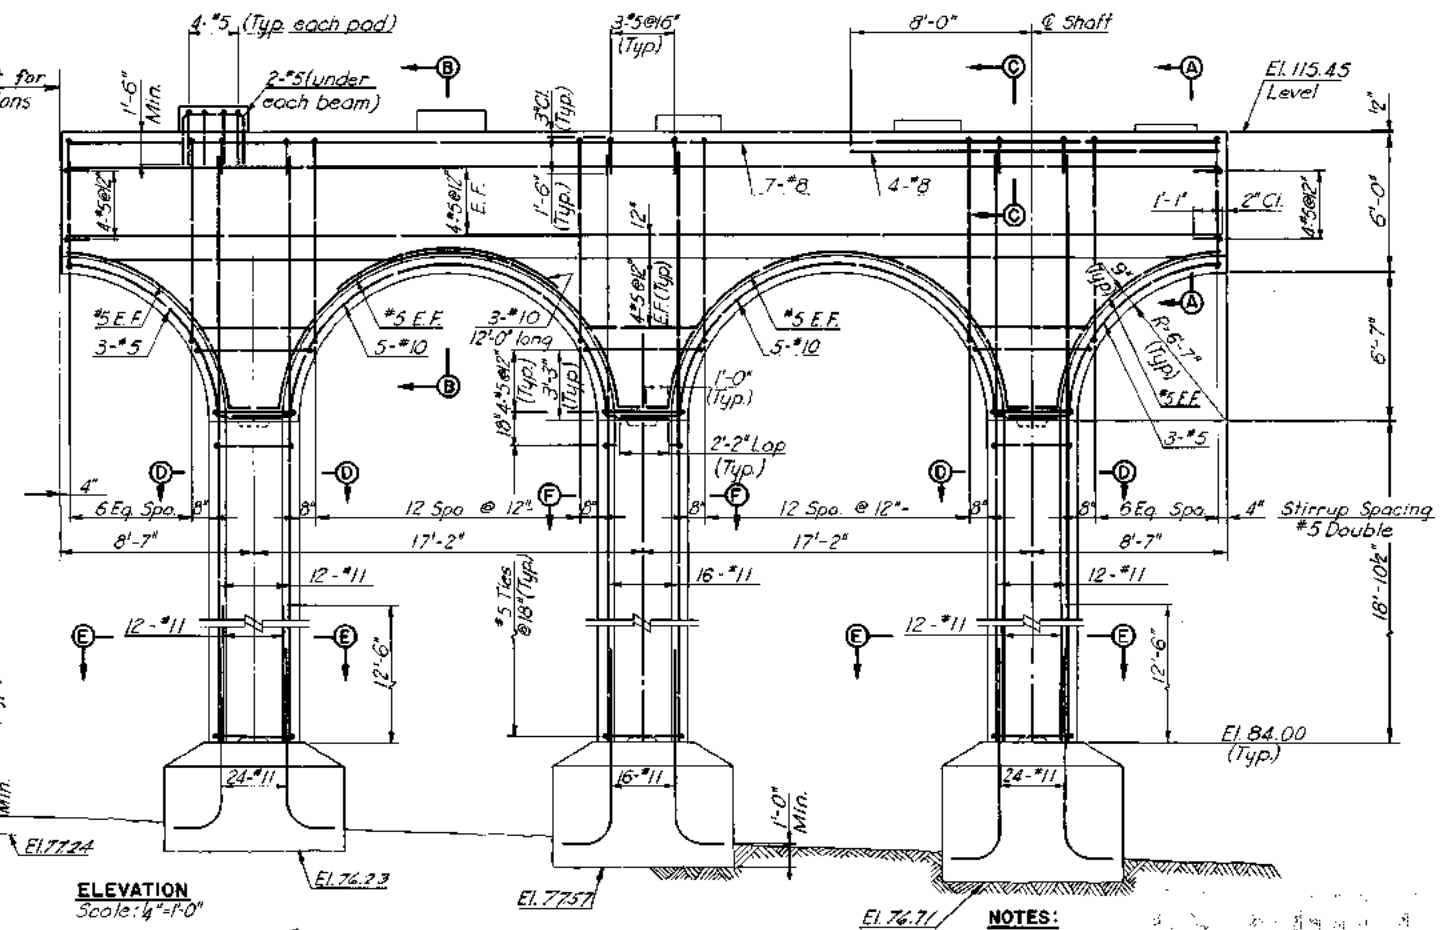


ELEVATION  
Scale: 1/4"=1'-0"

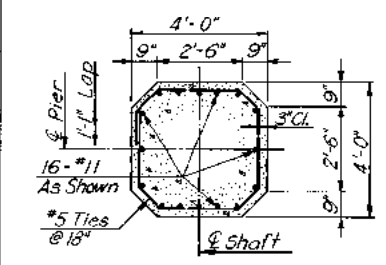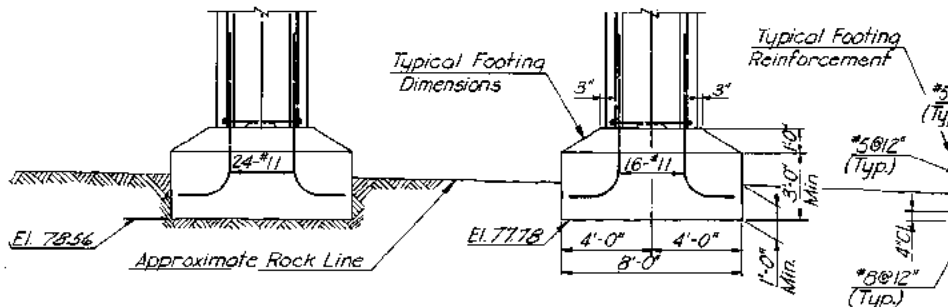


SECTION F-F  
Scale: 3/8"=1'-0"

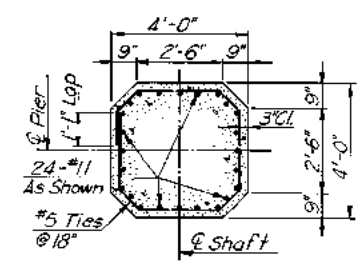


SECTION E-E  
Scale: 3/8"=1'-0"

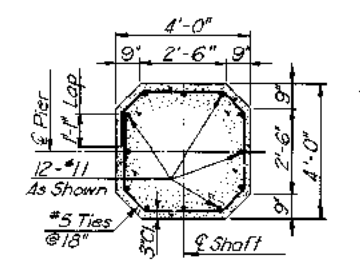


SECTION D-D  
Scale: 3/8"=1'-0"

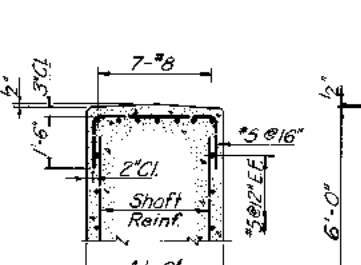


SECTION C-C  
Scale: 3/8"=1'-0"

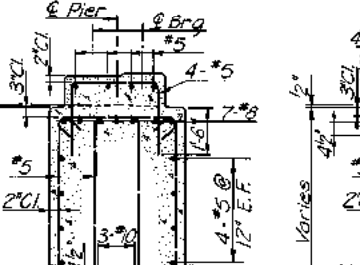

SECTION B-B  
Scale: 3/8"=1'-0"

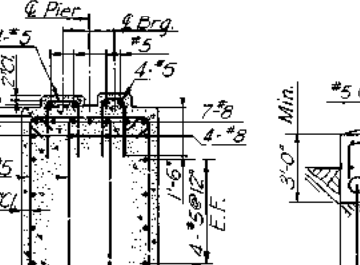

SECTION A-A  
Scale: 3/8"=1'-0"

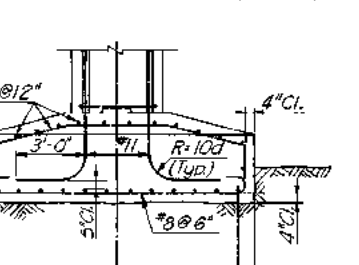

FOOTING END VIEW  
Scale: 1/4"=1'-0"

Pier foundations are designed for an allowable bearing pressure of 10 Tons/S.F.


RICHMOND METROPOLITAN AUTHORITY  
RICHMOND EXPRESSWAY SYSTEM

JAMES RIVER BRIDGE  
PIER 5

HOWARD, NEEDLES, TAMMEN & BERGENDOFF  
CONSULTING ENGINEERS  
NEW YORK ALEXANDRIA KANSAS CITY  
SCALE: AS SHOWN  
CONTRACT NO. C-3  
SHEET NO. 15 OF 53

BY	DATE	NO.	REVISION	BY	DATE
MADE	HBW 11-67	2	AS BUILT	JRC	12-72
CHECKED	FXH 2-68		Pier made Symm about $\epsilon$	ES	3/20/77
IN CHARGE	FXH				


RICHMOND EXPRESSWAY SYSTEM			
SECTION	PROJECT	SHEET NO.	TOTAL SHEETS
3	JAMES RIVER BRIDGE	16	53

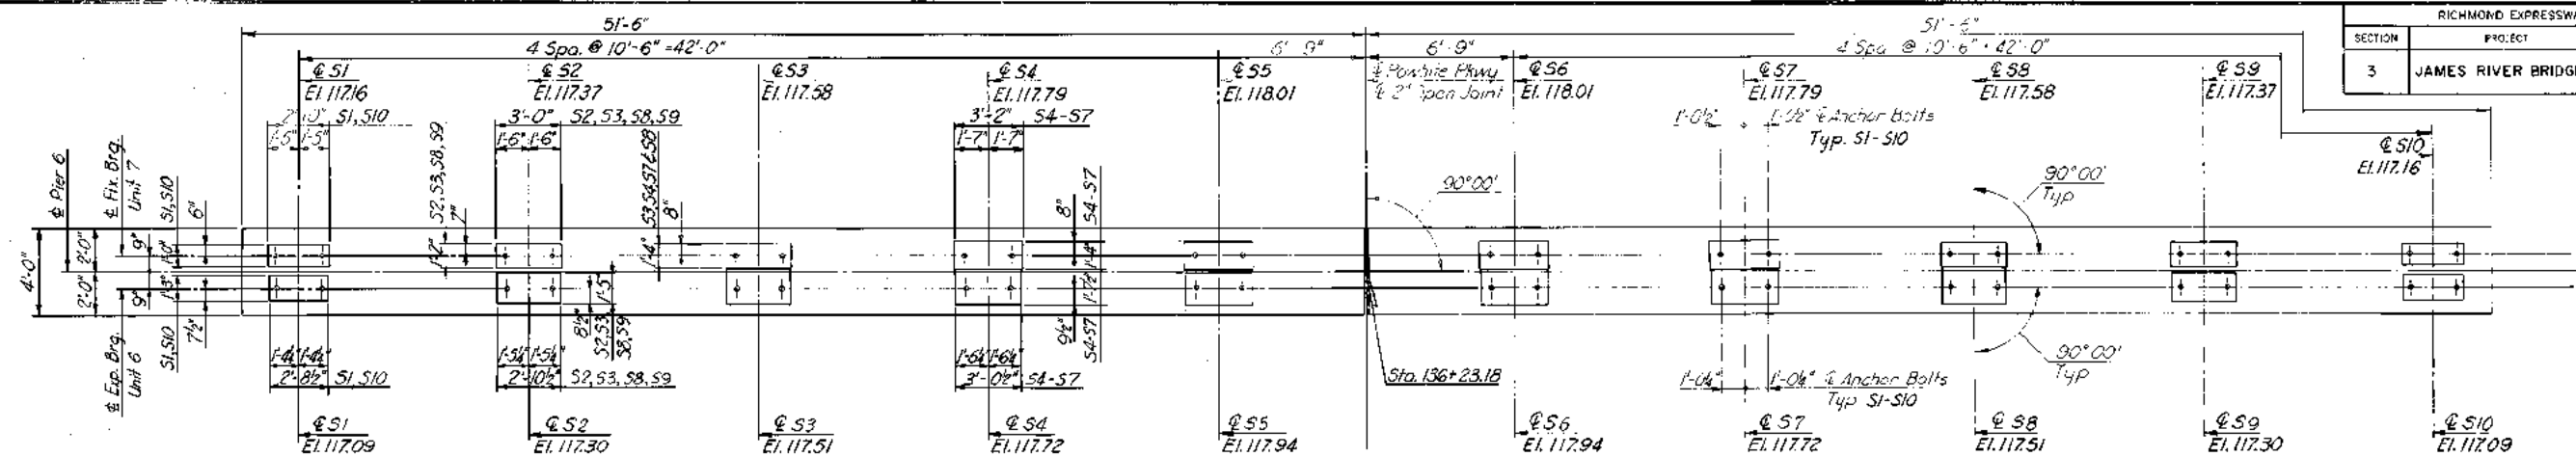

PLAN  
Scale: 1/8"=1'-0"

FOOTING NO.	AVE. BOTTOM ELEV.
6LW	79.30
6CW	79.05
6RW	79.90
6LE	79.02
6CE	78.36
6RE	78.36

Symm. about C

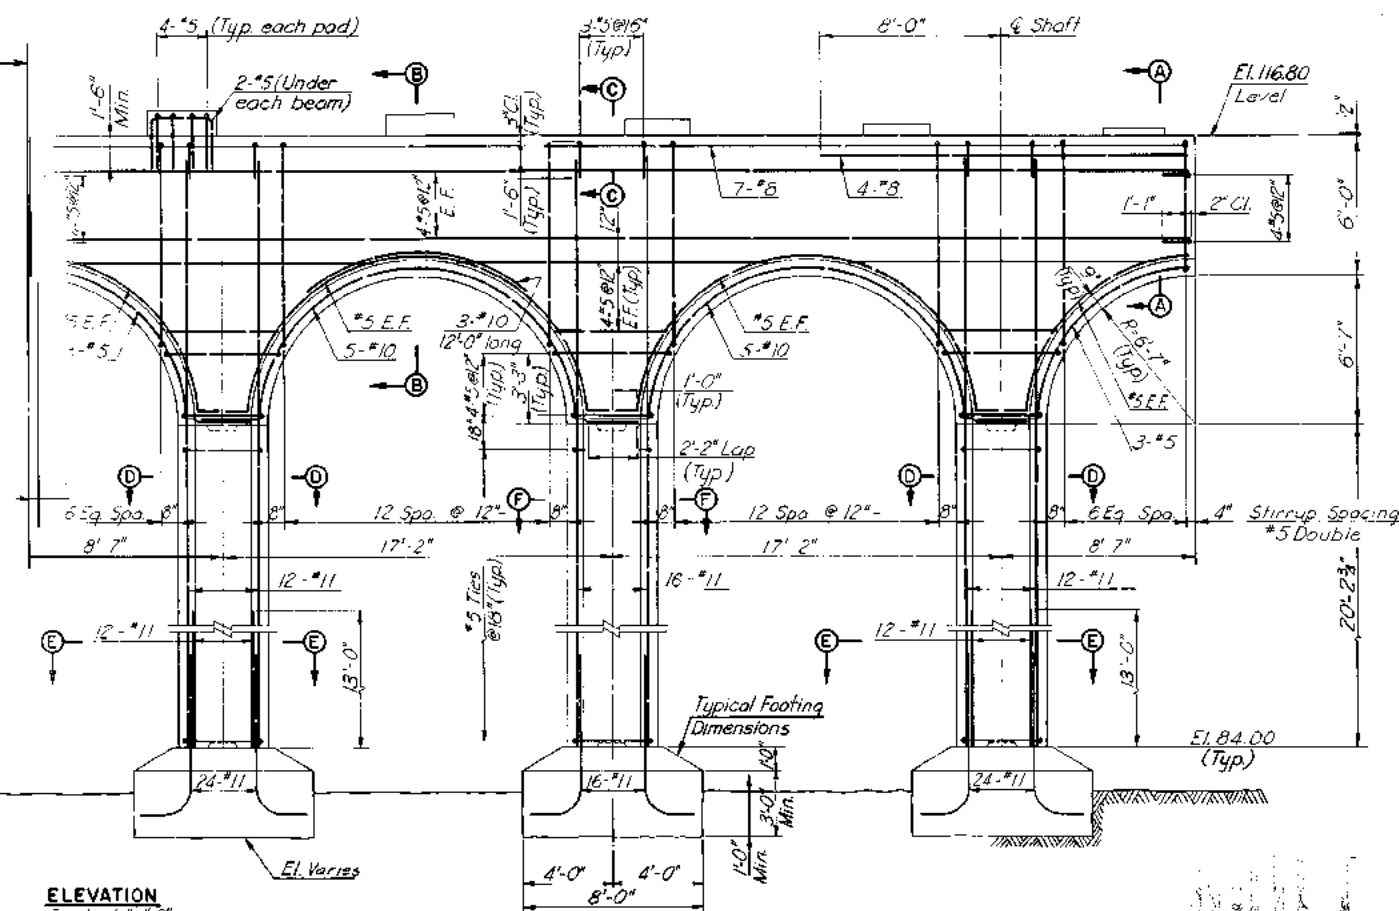

ELEVATION  
Scale: 1/4"=1'-0"


NOTES:

Pier foundations are designed for an allowable bearing pressure of 10 Tons/S.F.


RICHMOND METROPOLITAN AUTHORITY  
RICHMOND EXPRESSWAY SYSTEM

JAMES RIVER BRIDGE  
PIER 6


HOWARD, NEEDLES, TAMMEN & BERGENDOFF  
Consulting Engineers  
NEW YORK ALEXANDRIA KANSAS CITY  
SCALE: AS SHOWN  
CUST. PROJ. NO. C-3  
SHEET NO. 16 OF 53

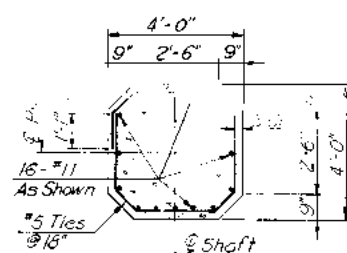


SECTION F-F  
Scale: 3/8"=1'-0"

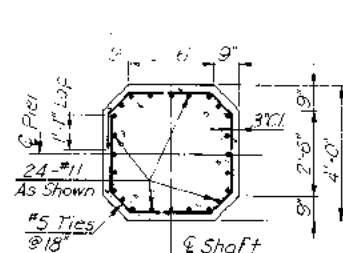


SECTION E-E  
Scale: 3/8"=1'-0"

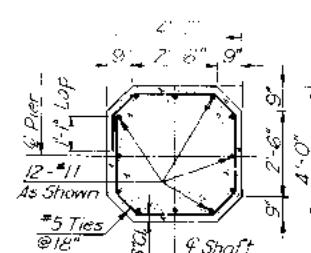


SECTION D-D  
Scale: 3/8"=1'-0"

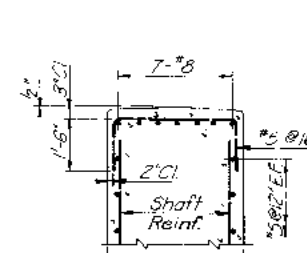


SECTION C-C  
Scale: 3/8"=1'-0"

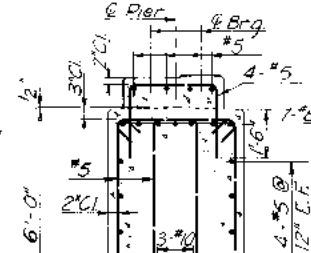

SECTION B-B  
Scale: 3/8"=1'-0"

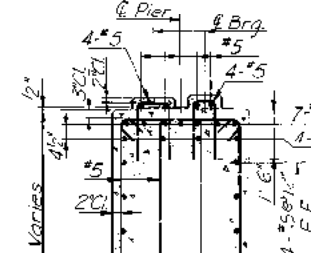






SECTION A-A  
Scale: 3/8"=1'-0"

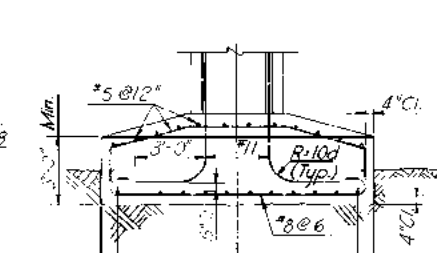

FOOTING END VIEW  
Scale: 1/4"=1'-0"

MADE	BY	DATE	2	AS BUILT	JRC	12-72
CHECKED	FXH	2-68	1	Pier Symm. double	JGV	2-20-71
IN CHARGE	FXH		NO.	REVISION	BY	DATE

RICHMOND EXPRESSWAY SYSTEM			
SECTION	PROJECT	SHEET NO.	TOTAL SHEETS
3	JAMES RIVER BRIDGE	18	53

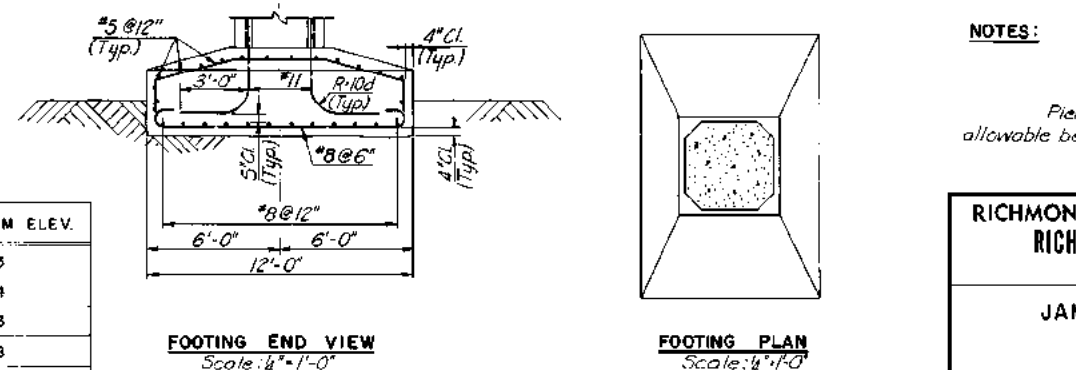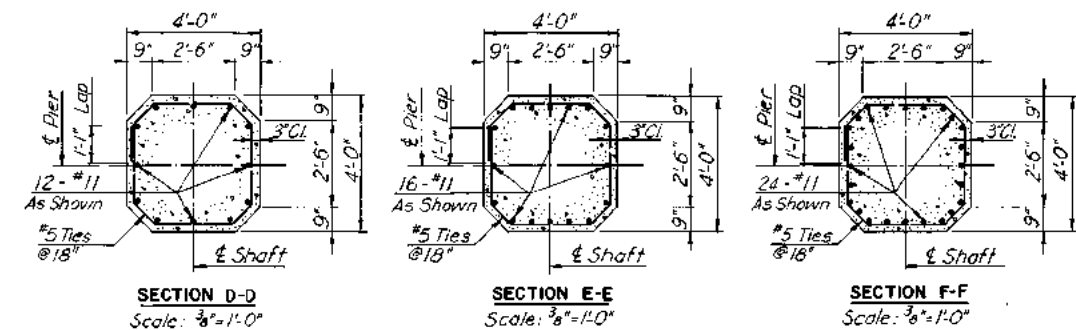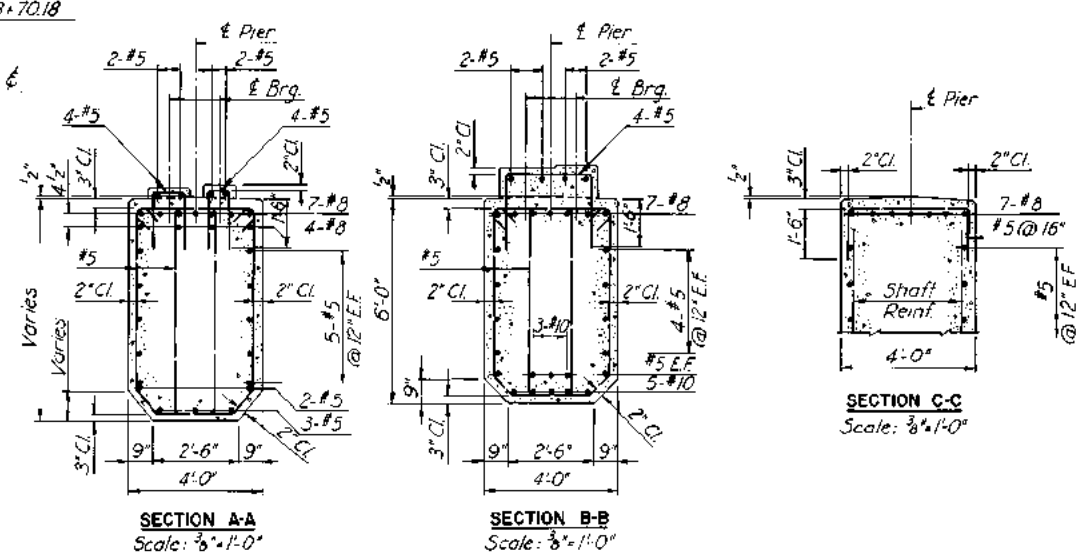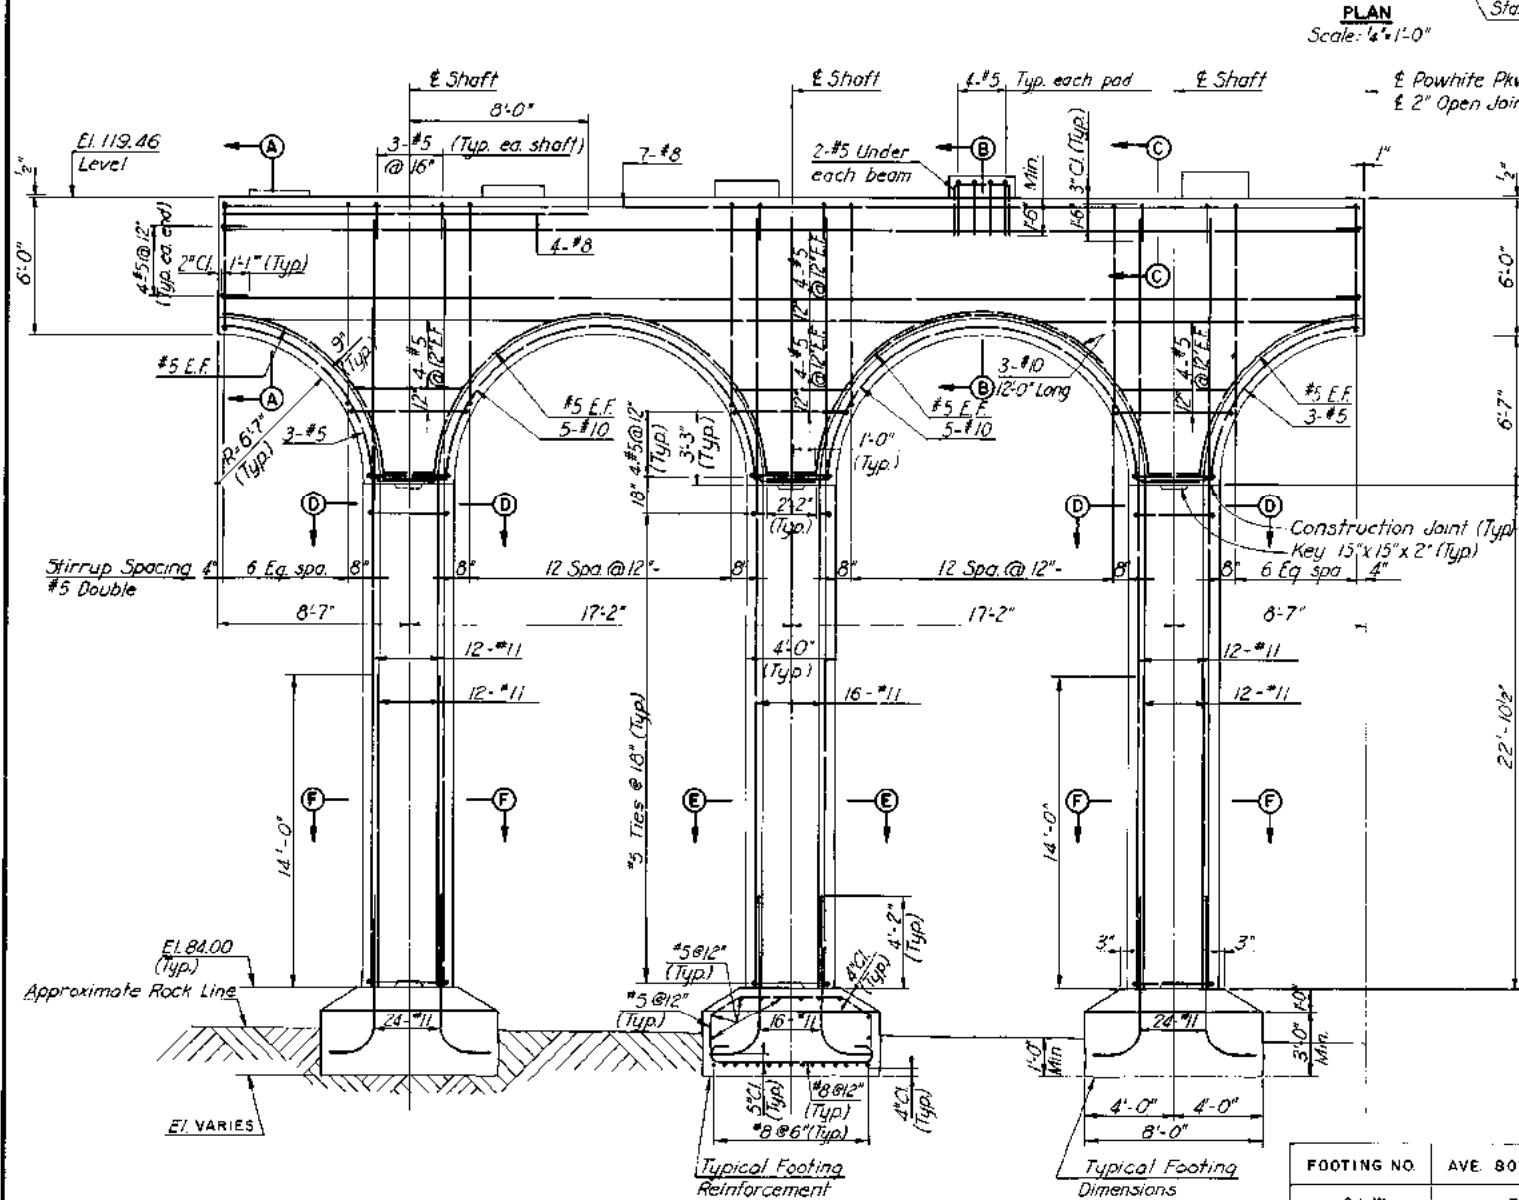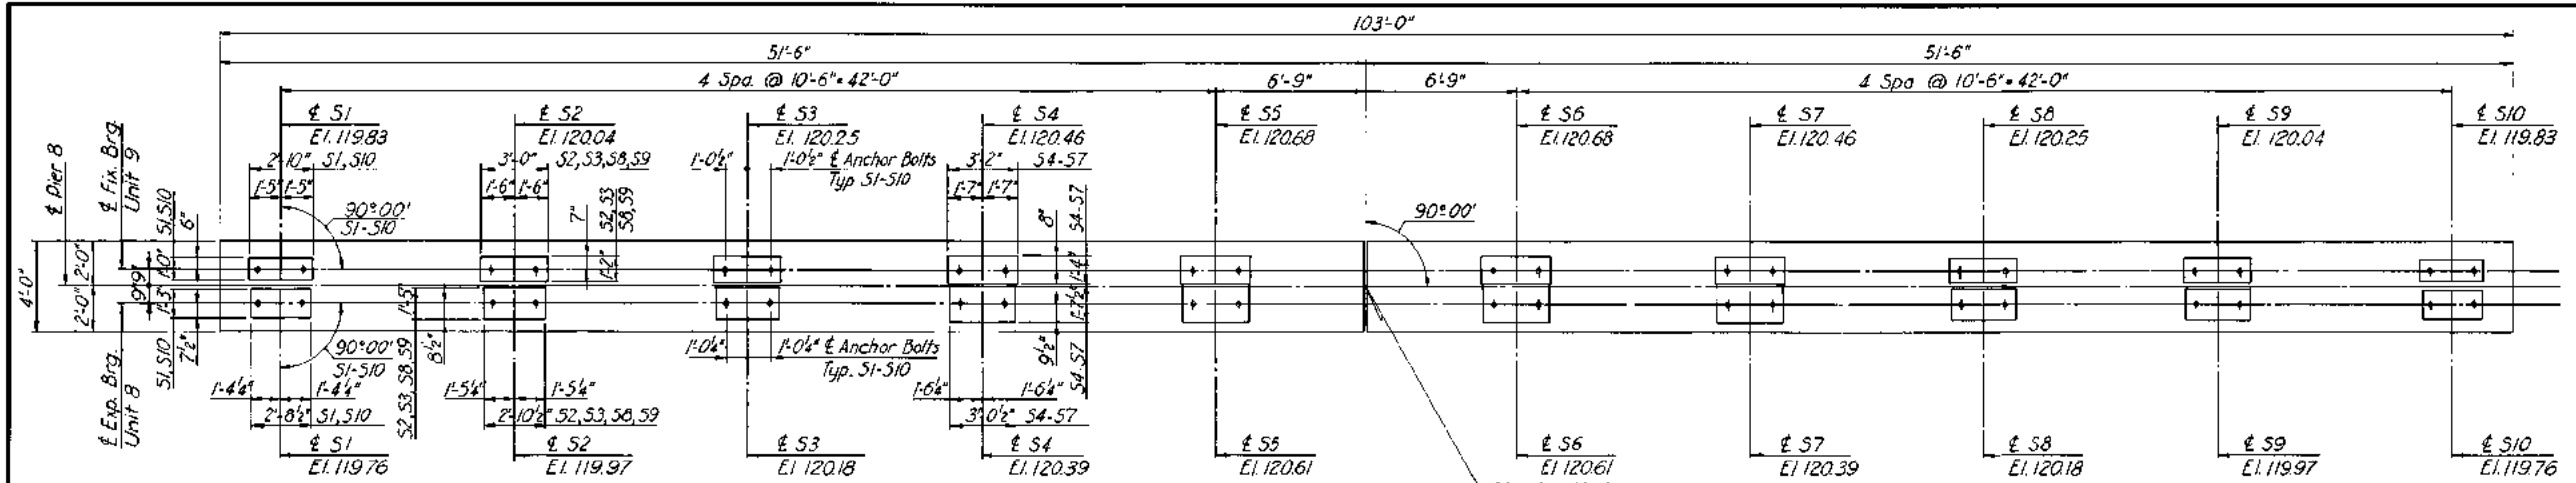

#### NOTES:

Pier foundations are designed for an allowable bearing pressure of 10 Tons/SF.

RICHMOND METROPOLITAN AUTHORITY  
RICHMOND EXPRESSWAY SYSTEM

JAMES RIVER BRIDGE  
PIER 8

HOWARD, NEEDLES, TAMMEN & BERGENDOFF  
consulting engineers  
NEW YORK ALEXANDRIA KANSAS CITY

SCALE: AS SHOWN  
CONTRACT NO. C-3  
SHEET NO. 18 OF 53

FOOTING NO.	AVE. BOTTOM ELEV.
8LW	79.3
8CW	78.4
8RW	78.3
8LE	76.8
8CE	76.7
8RE	74.4


BY	DATE			
MADE	HBW	7-67		
CHECKED	FXH	2-68	AS BUILT	JRC 12-72
IN CHARGE	FXH	NO.	REVISION	BY DATE








RICHMOND EXPRESSWAY SYSTEM			
SECTION	PROJECT	SHEET NO.	TOTAL SHEETS
3	JAMES RIVER BRIDGE	22	53

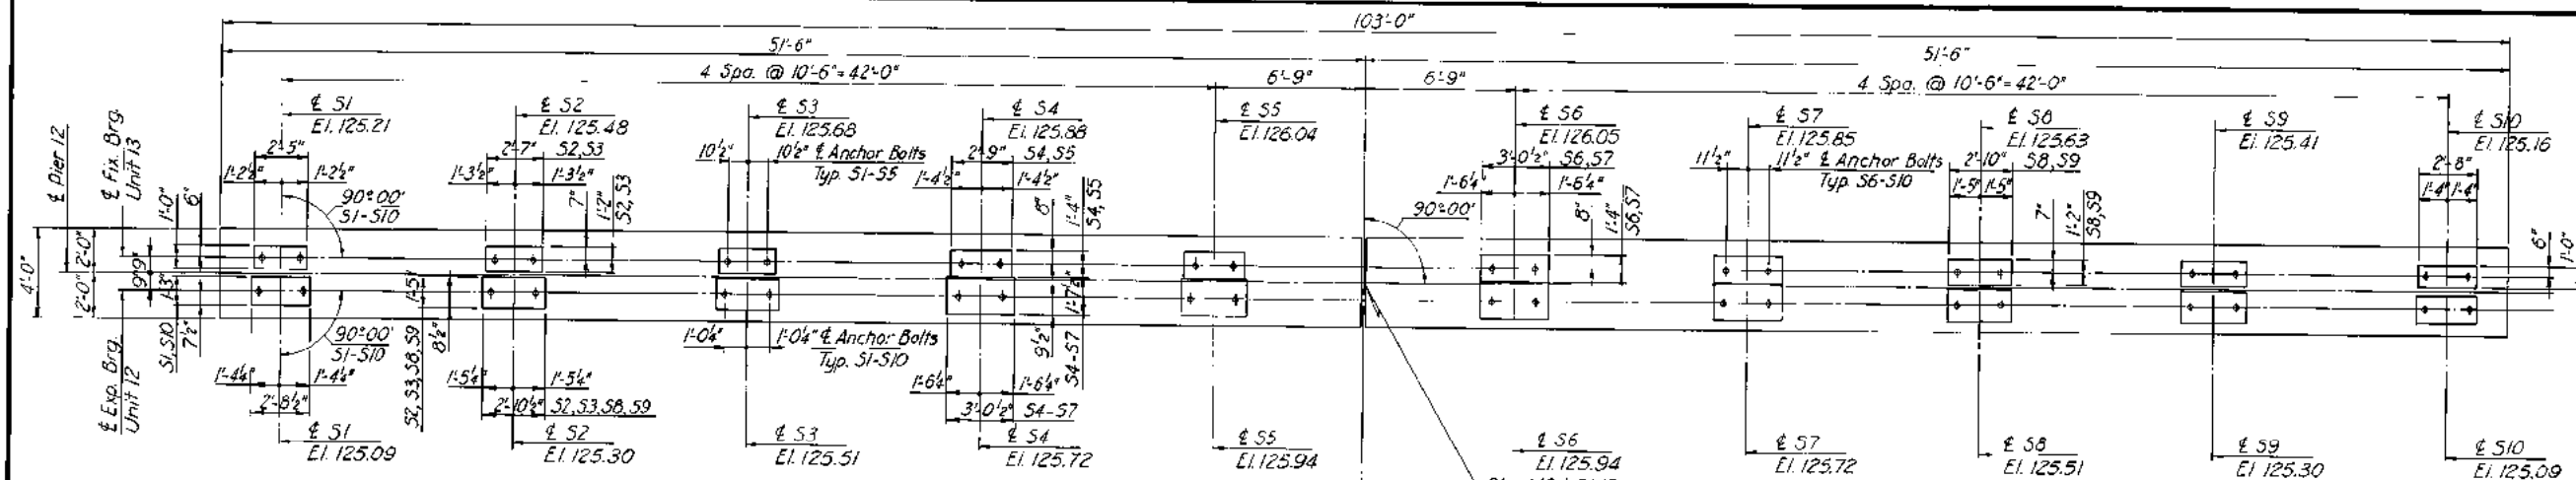


PLAN  
Scale: 1/4"=1'-0"

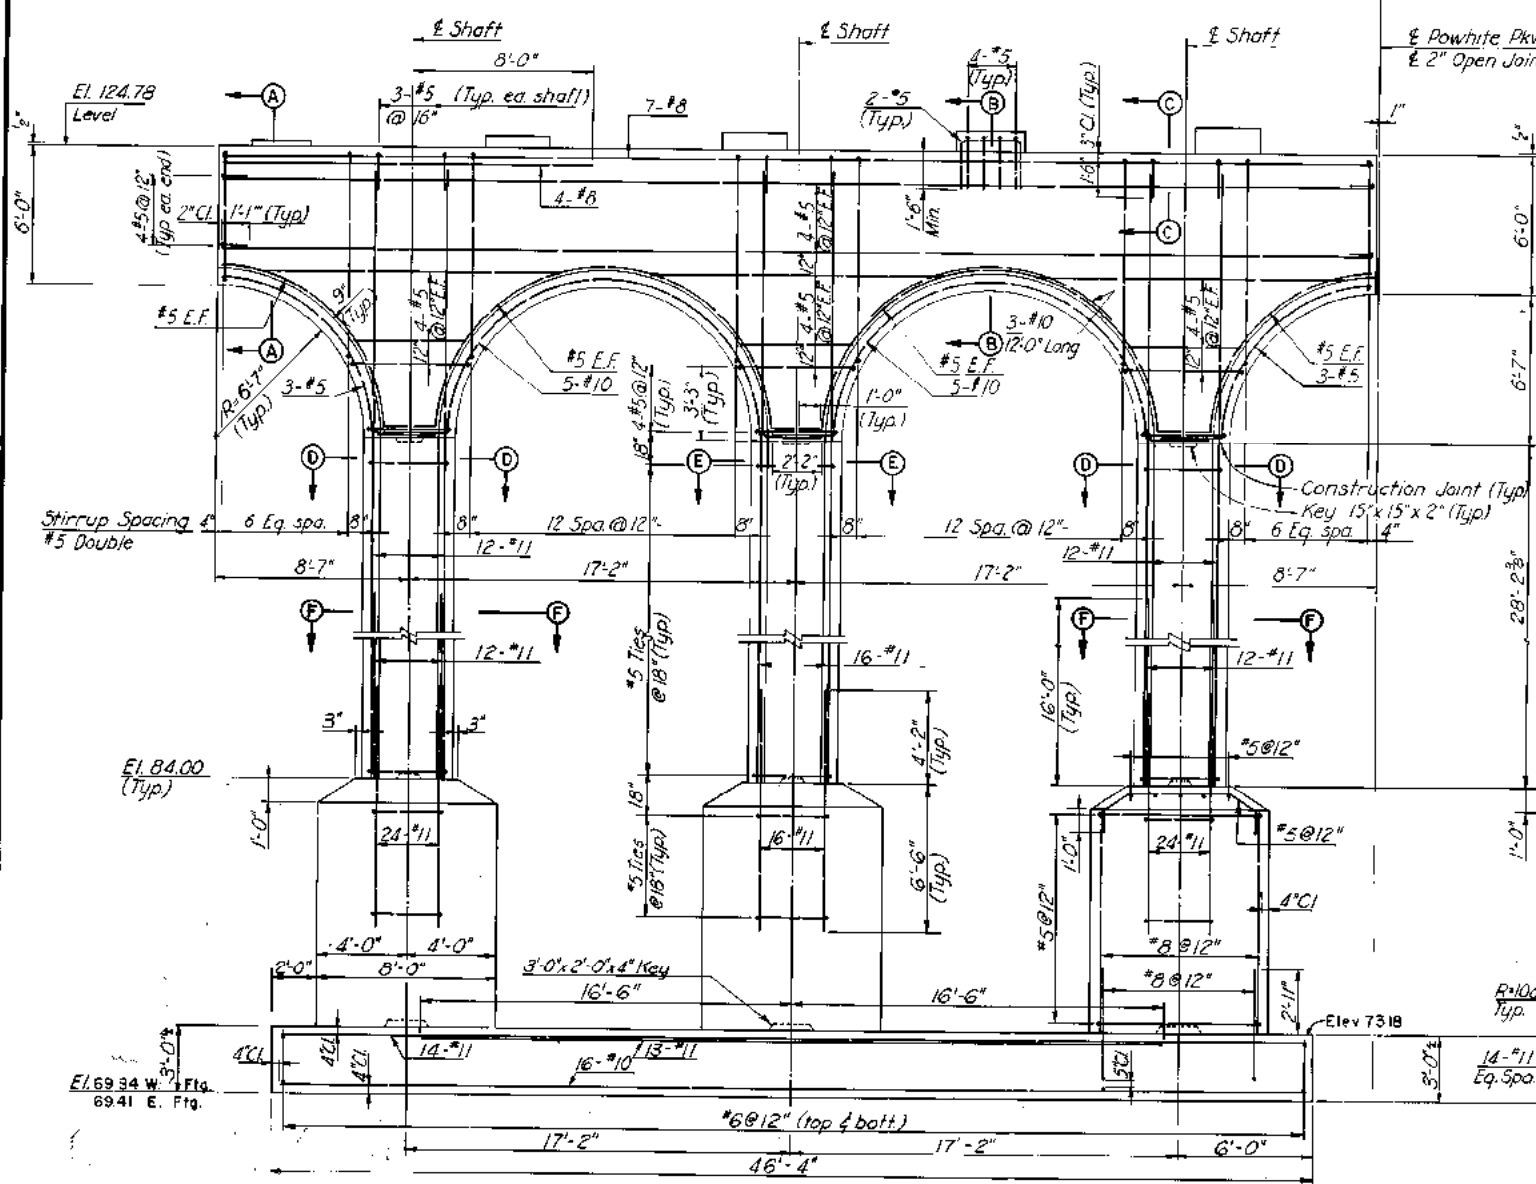


HALF ELEVATION  
Scale: 1/4"=1'-0"


Note:  
Pier symmetrical about  
Powhite Pkwy.

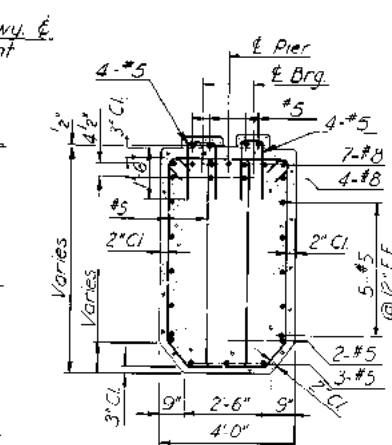


SECTION A-A  
Scale: 3/8"=1'-0"

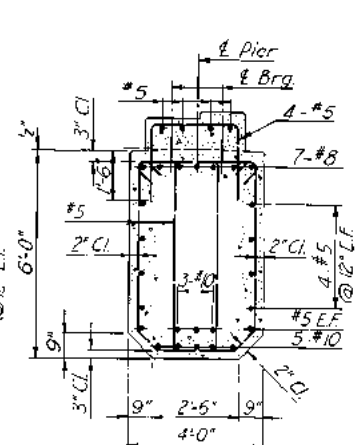


SECTION B-B  
Scale: 3/8"=1'-0"

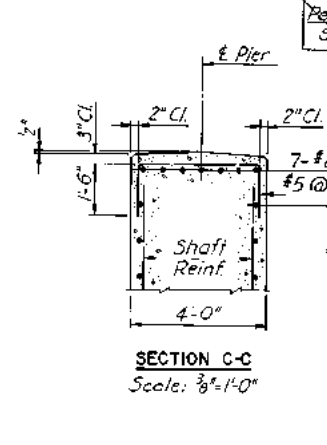


SECTION C-C  
Scale: 3/8"=1'-0"

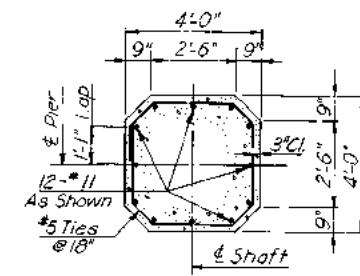


SECTION D-D  
Scale: 3/8"=1'-0"

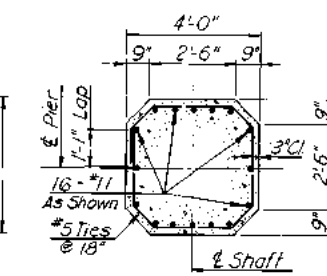


SECTION E-E  
Scale: 3/8"=1'-0"

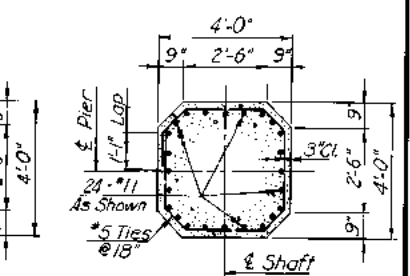


SECTION F-F  
Scale: 3/8"=1'-0"

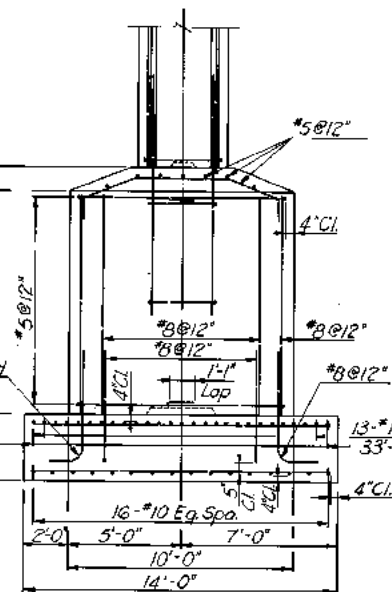

FOOTING END VIEW  
Scale: 1/4"=1'-0"

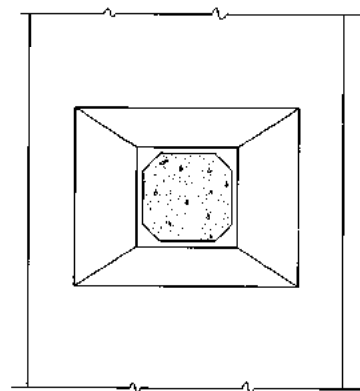

PART FOOTING PLAN  
Scale: 1/4"=1'-0"

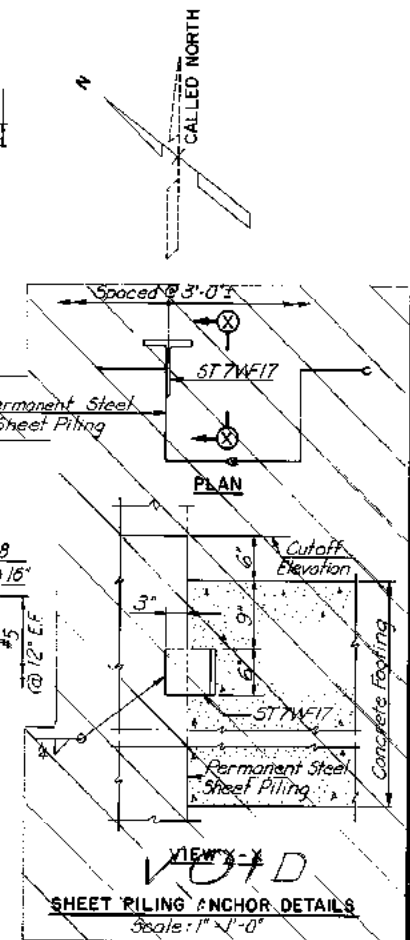

SHEET PILING ANCHOR DETAILS  
Scale: 1"=1'-0"

NOTES:

**AS BUILT**

Pier foundations are designed for an allowable bearing pressure of 3 1/2 Tons/5F.

RICHMOND METROPOLITAN AUTHORITY  
RICHMOND EXPRESSWAY SYSTEM

JAMES RIVER BRIDGE  
PIER 12



HOWARD, NEEDLES, TAMMEN & BERGENCOFF  
consulting engineers  
NEW YORK ALLEXANDRIA KANSAS CITY

SCALE: AS SHOWN  
CONTRACT NO.: C-3  
SHEET NO. 22 OF 53

BY	DATE			
MADE	HBW	7-67		
CHECKED	FXH	3-68	AS BUILT	JRC 12-72
IN CHARGE	EXH.		NO. REVISION	BY DATE




RICHMOND EXPRESSWAY SYSTEM			
SECTION	PROJECT	SHEET NO.	TOTAL SHEETS
3	JAMES RIVER BRIDGE	23	53

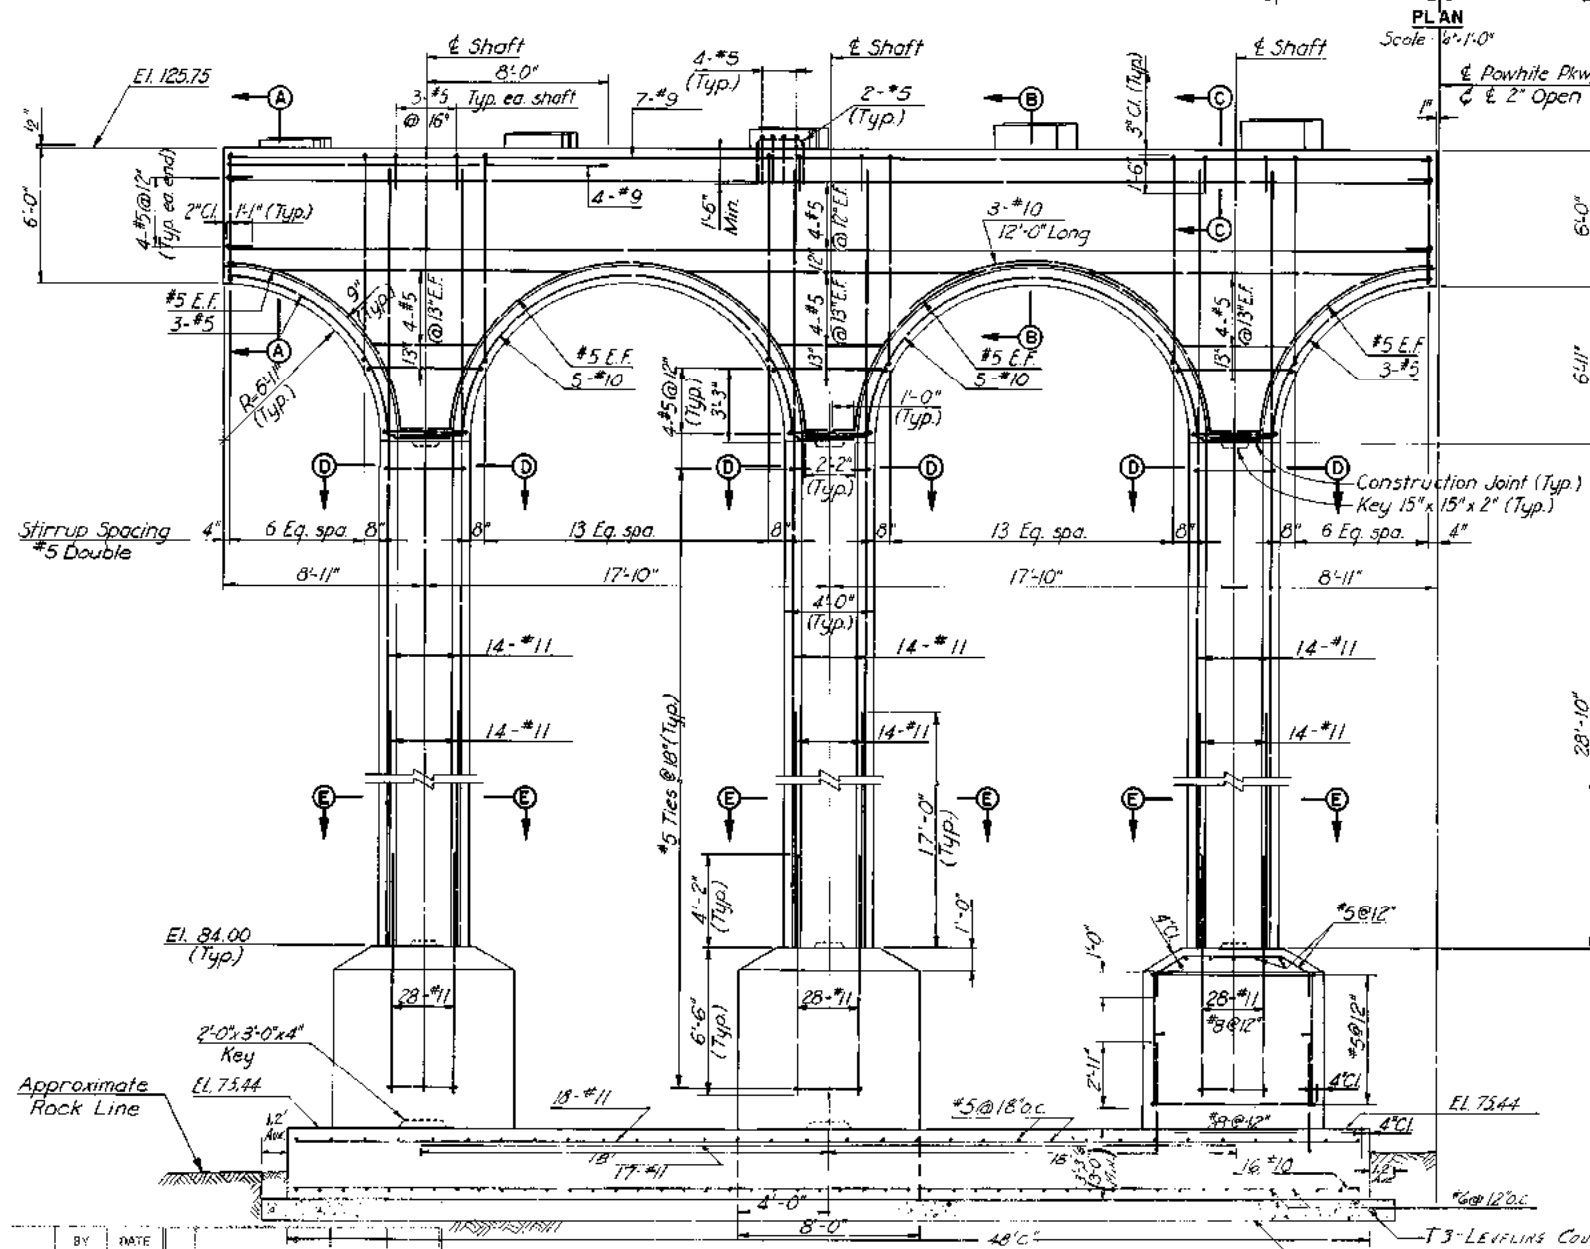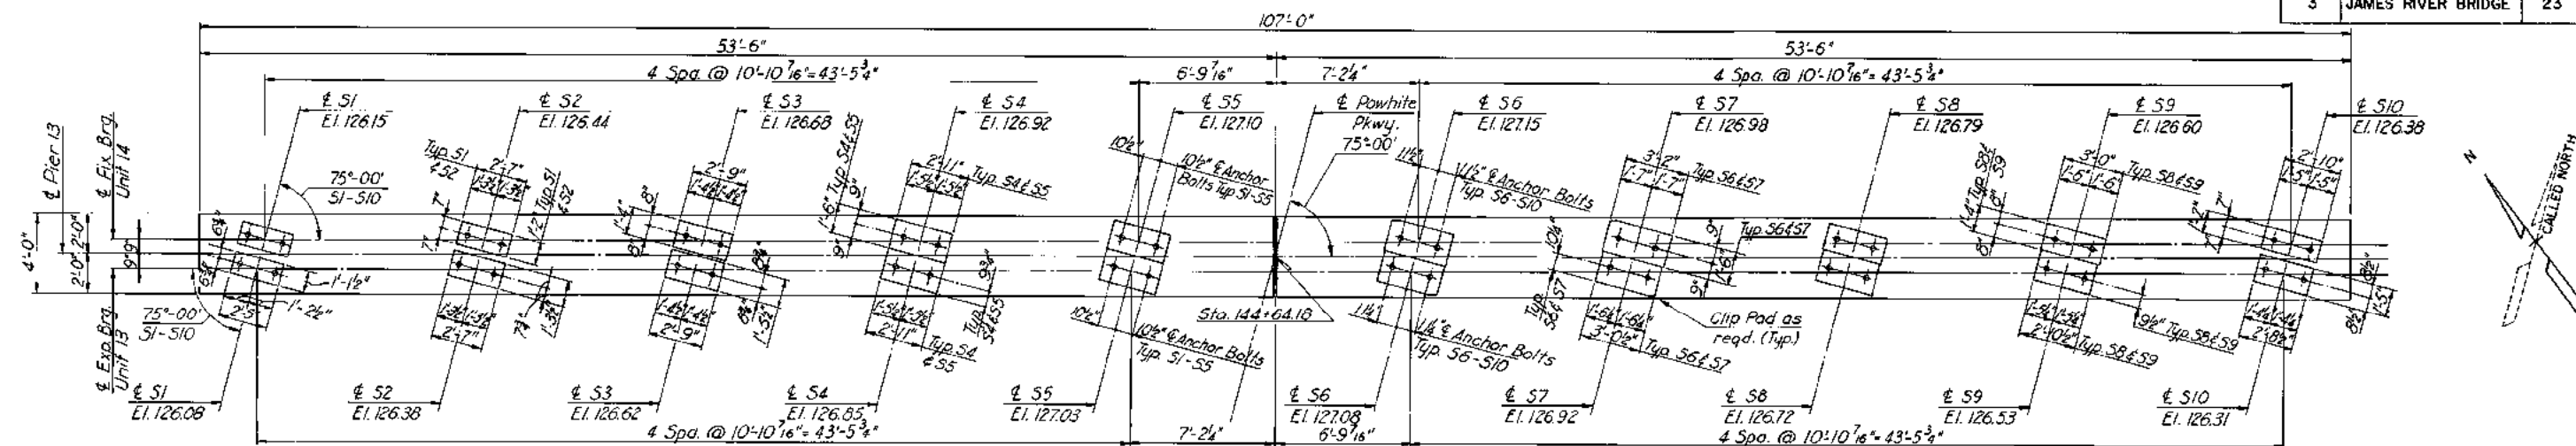


**HALF ELEVATION**  
Scale: 1/4"=1'-0"

Note:  
Pier symmetrical about  
2" Open Joint except as shown.

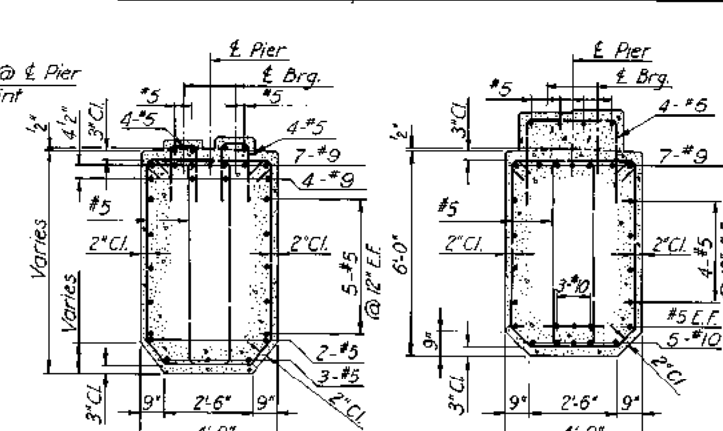


**SECTION A-A**  
Scale: 3/8"=1'-0"

**SECTION B-B**  
Scale: 3/8"=1'-0"

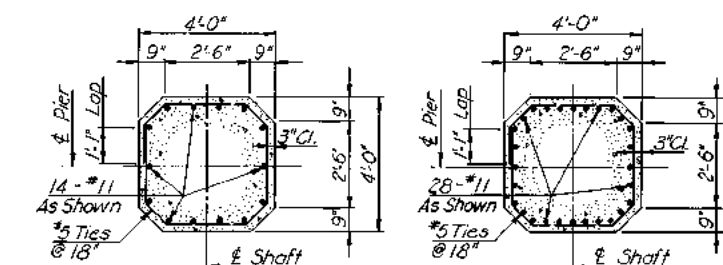


**SECTION D-D**  
Scale: 3/8"=1'-0"

**SECTION E-E**  
Scale: 3/8"=1'-0"

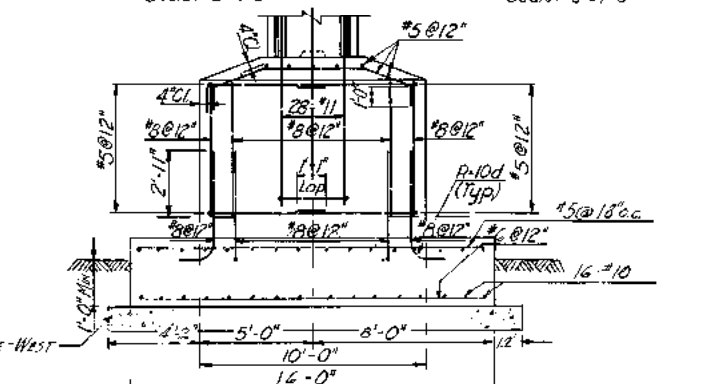

**FOOTING END VIEW**  
Scale: 1/4"=1'-0"

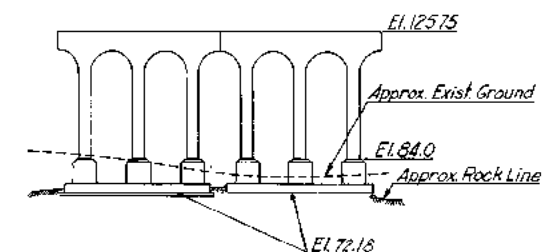

**ELEVATION**  
Scale: 1"=30'



NOTES:  
Foundation elevations are approximate  
and may be varied to suit field conditions  
as directed by the Engineer.  
Pier foundations are designed for an  
allowable bearing pressure of 5 tons/sq. ft.

**JAMES RIVER BRIDGE**  
**PIER 13**

	BY	DATE				
PAUL	L.B.P.	7-67	2	AS BUILT	JRC	12-72
CHIEF	FX.H.	3-68	1	Rev. Footings	JRC	4-12-72
IN CHARGE	FX.H.	NO.		REVISION	BY	DATE





















AS SHOWN  
C-3  
23 53

RICHMOND EXPRESSWAY SYSTEM			
SECTION	PROJECT	SHEET NO.	TOTAL SHEETS
3	JAMES RIVER BRIDGE	24	53

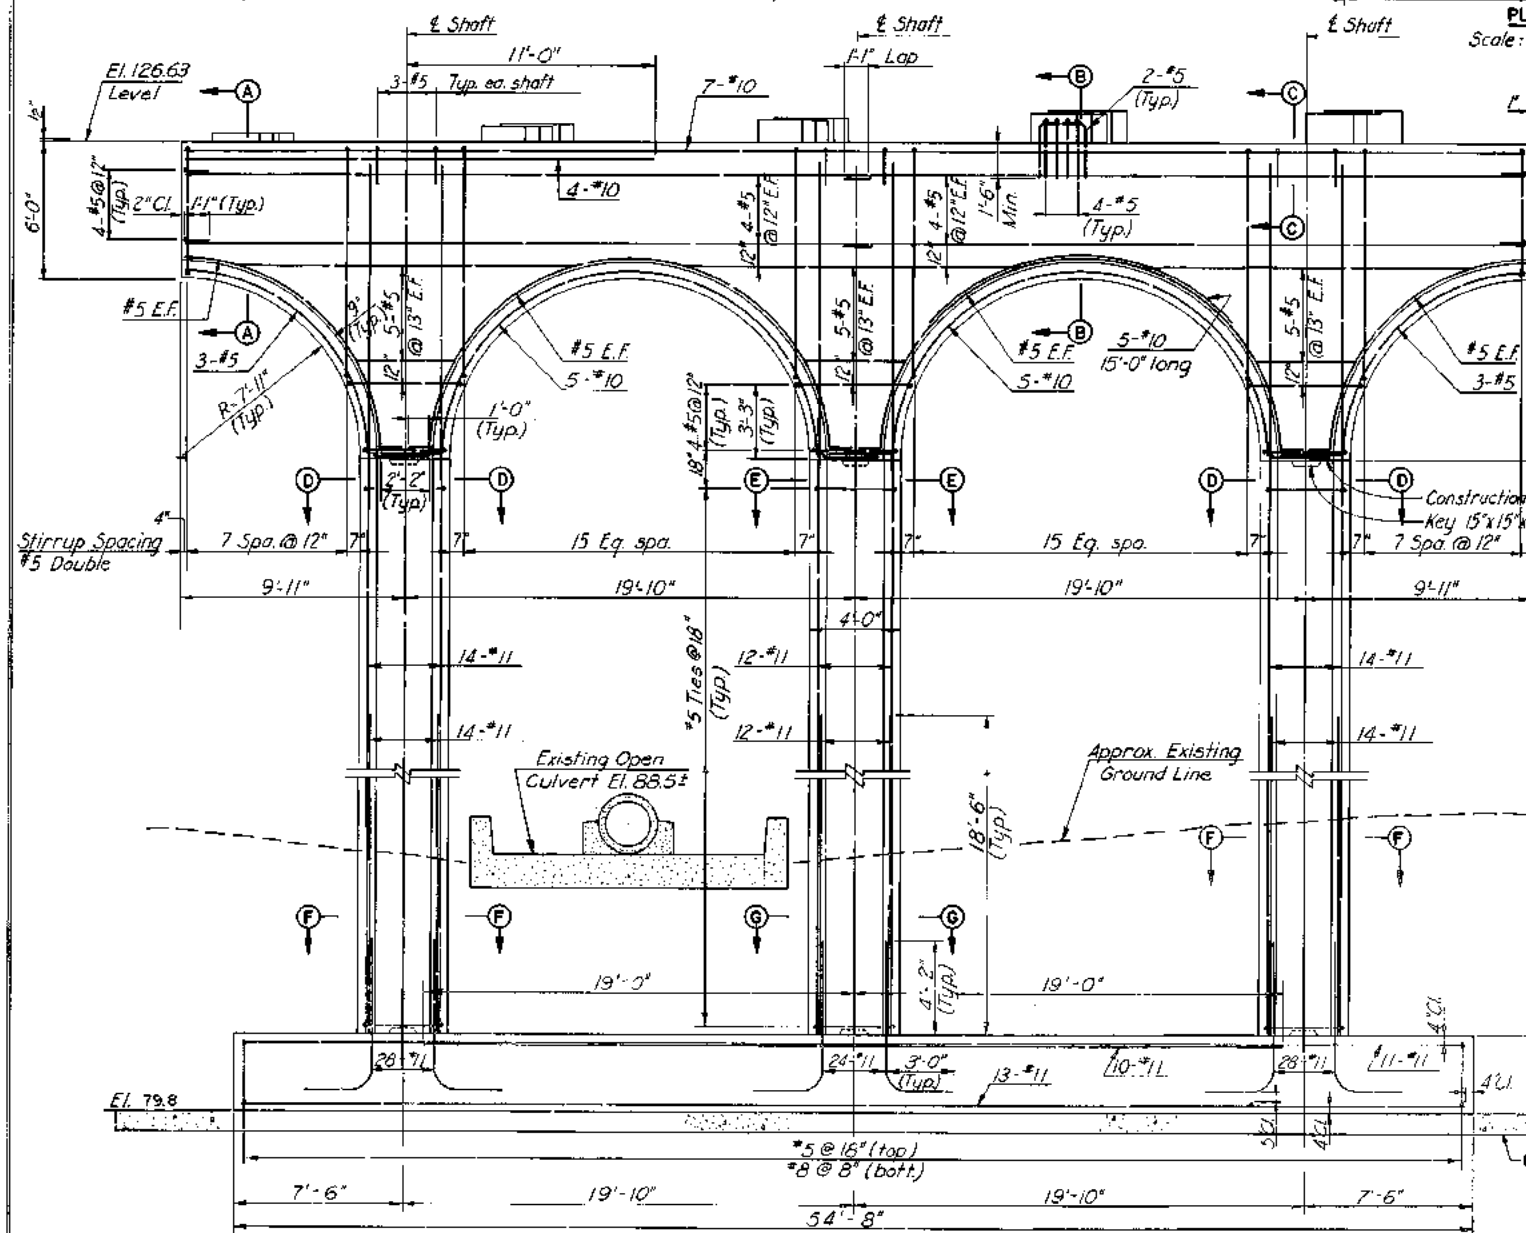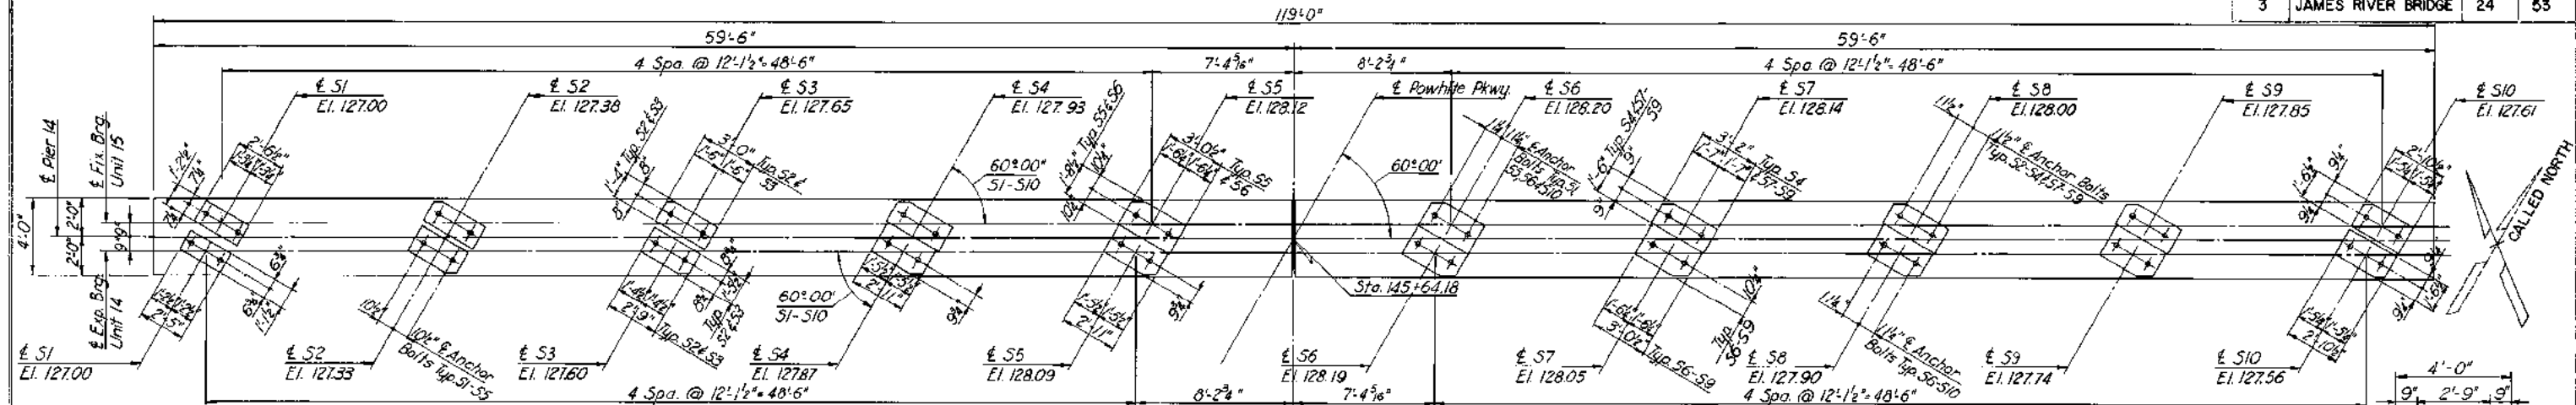

PLAN  
Scale: 1/4"=1'-0"

HALF ELEVATION  
Scale: 1/4"=1'-0"

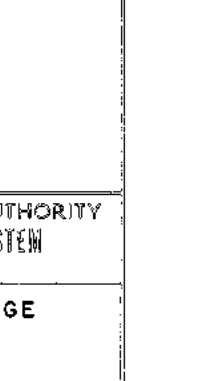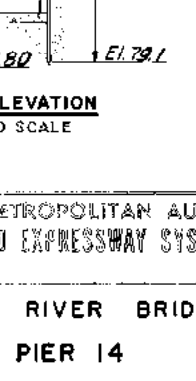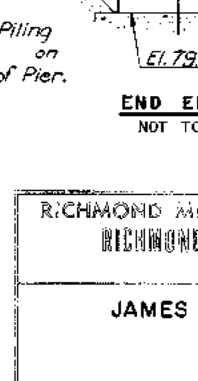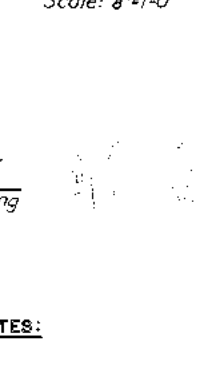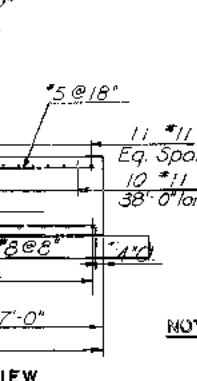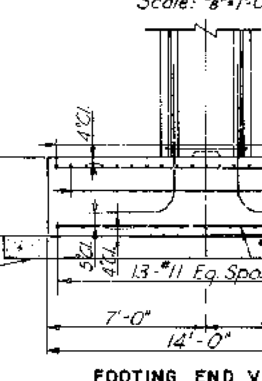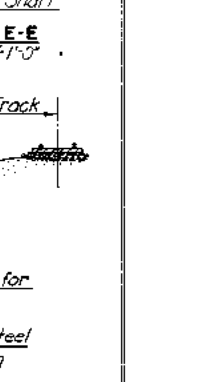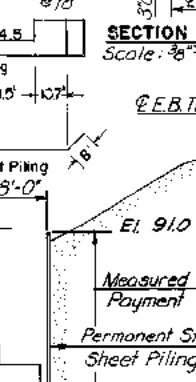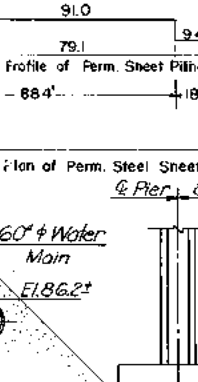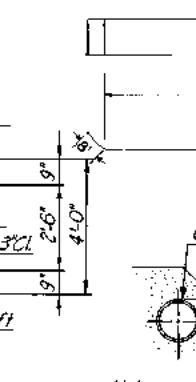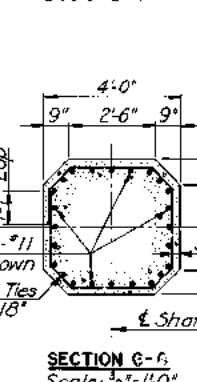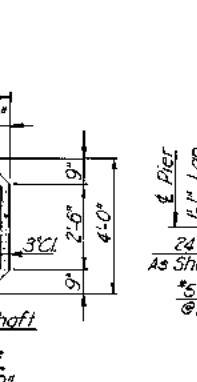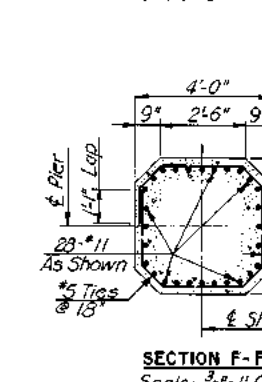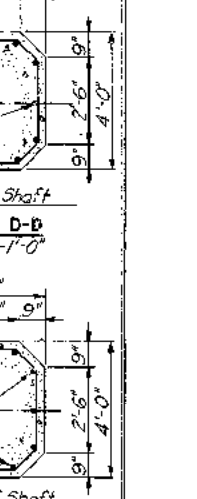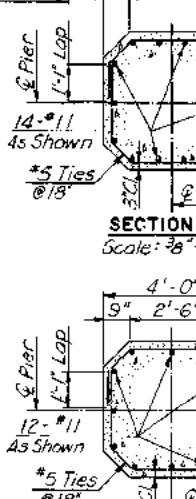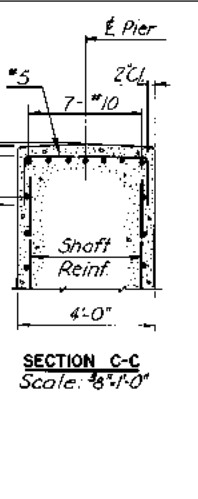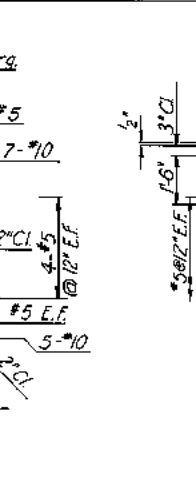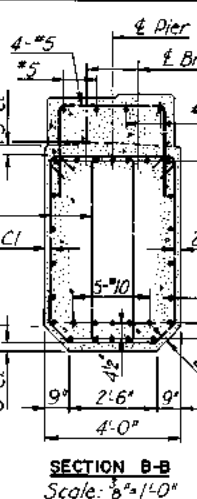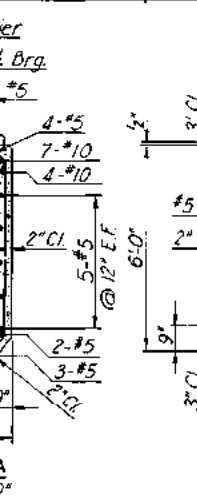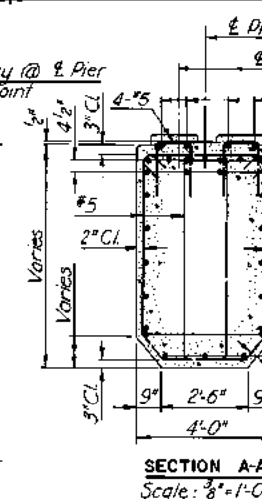

FOOTING END VIEW  
Scale: 1/4"=1'-0"

FOOTING END VIEW  
Scale: 1/4"=1'-0"


FOOTING END VIEW  
Scale: 1/4"=1'-0"

FOOTING END VIEW  
Scale: 1/4"=1'-0"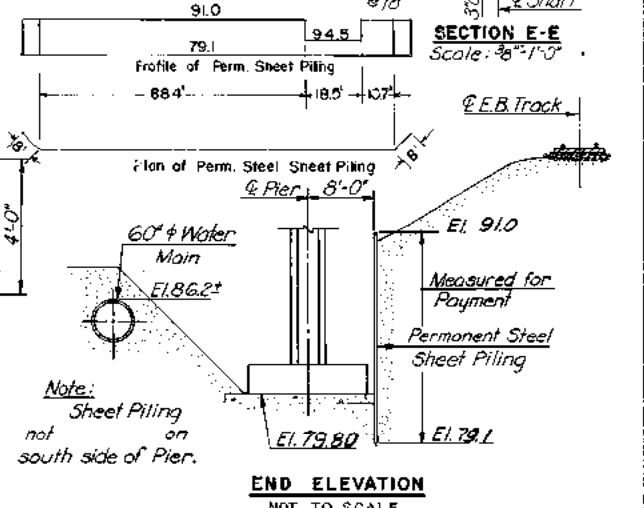

END ELEVATION  
NOT TO SCALE

MADE	RY	DATE	NO.	REVISION	BY	DATE
FXH	LBP	7-67	1	AS BUILT	JRC	12-72
FXH	FXH	3-68	1	REVISION	BY	DATE

Notes:  
Pier symmetrical about  
El. 2" open joint.

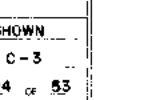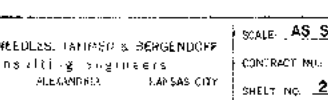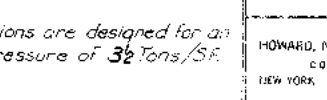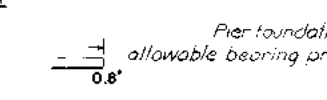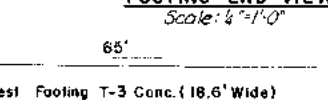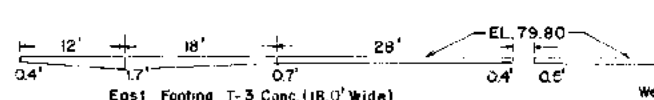

NOTES:  
Pier foundations are designed for an  
allowable bearing pressure of 3 1/2 tons/S.F.

RICHMOND METROPOLITAN AUTHORITY  
RICHMOND EXPRESSWAY SYSTEM





JAMES RIVER BRIDGE  
PIER 14

SCALE: AS SHOWN

HOWARD, NEEDLES, TAMMIS & BERGENCOFF  
CONSULTING ENGINEERS  
NEW YORK, ALEXANDRIA, LAFAYETTE CITY

CONTRACT NO. C-3  
SHEET NO. 24 OF 53

RICHMOND EXPRESSWAY SYSTEM			
SECTION	PROJECT	SHEET NO.	TOTAL SHEETS
3	JAMES RIVER BRIDGE	25	53

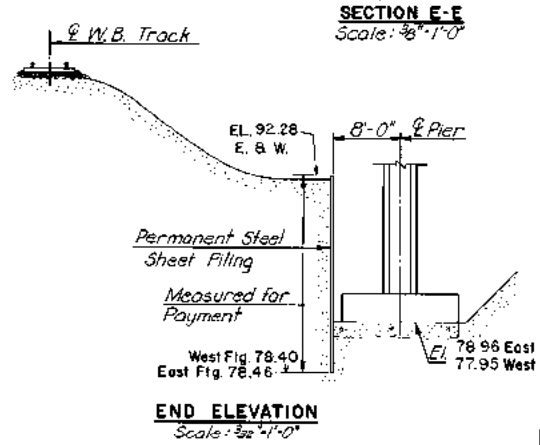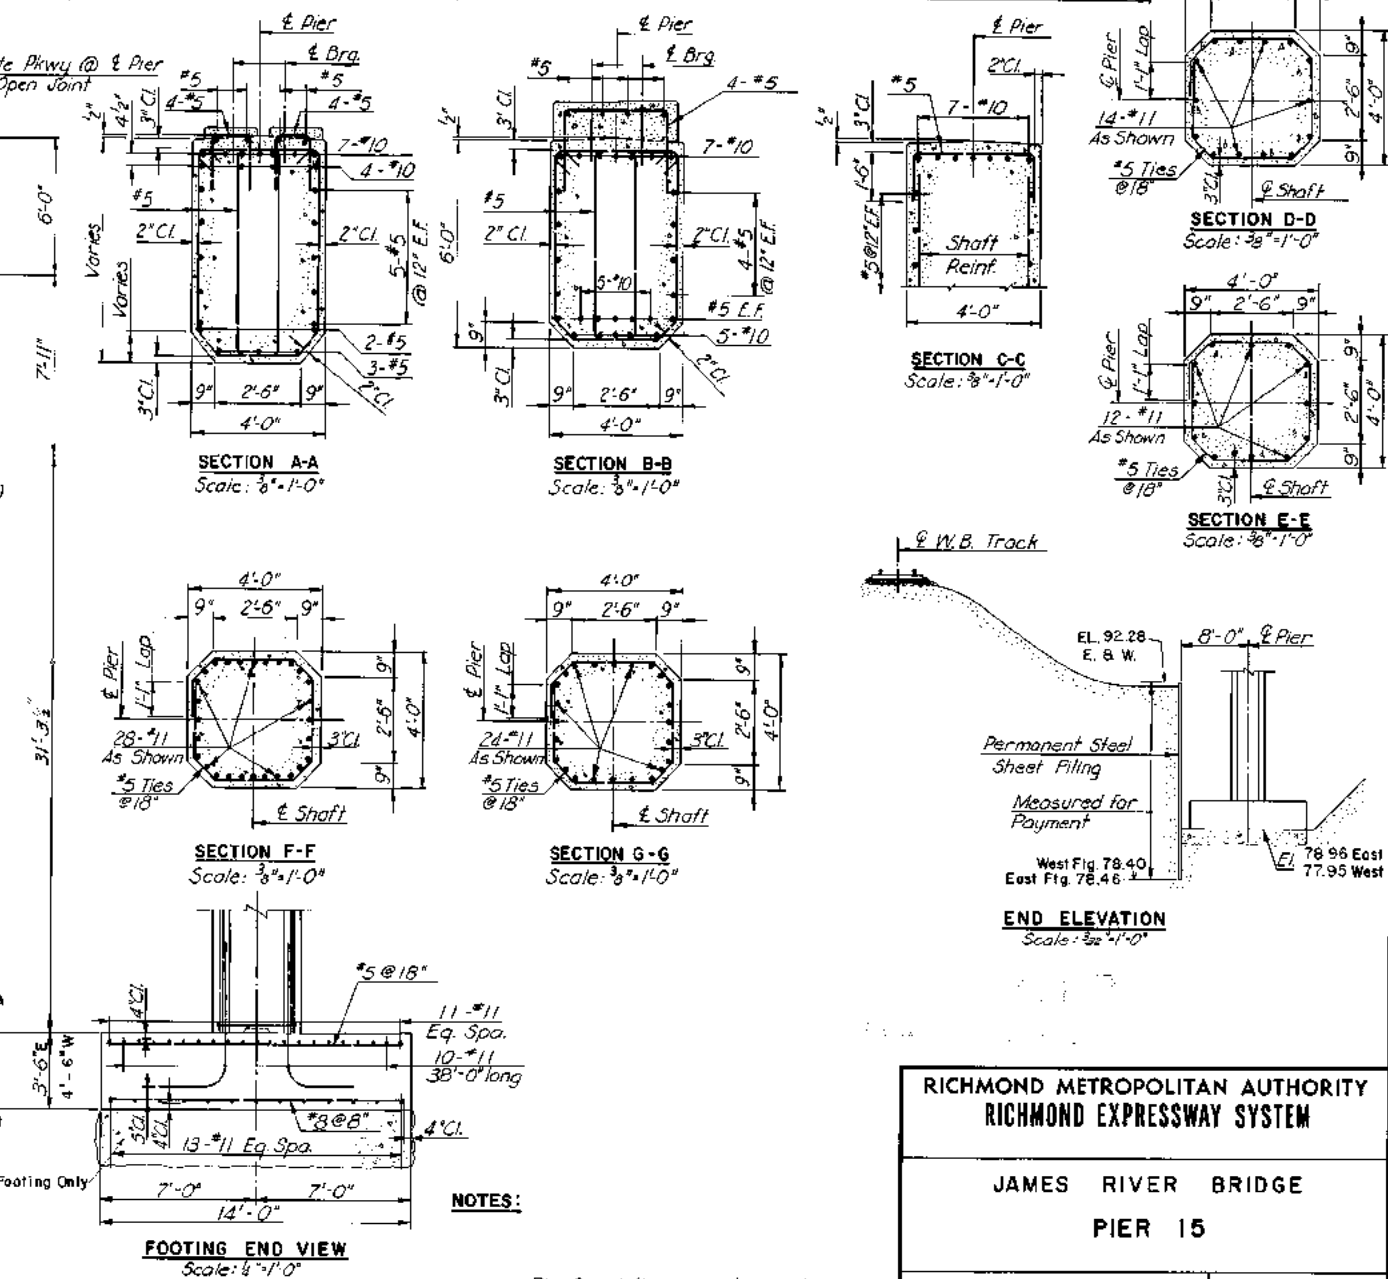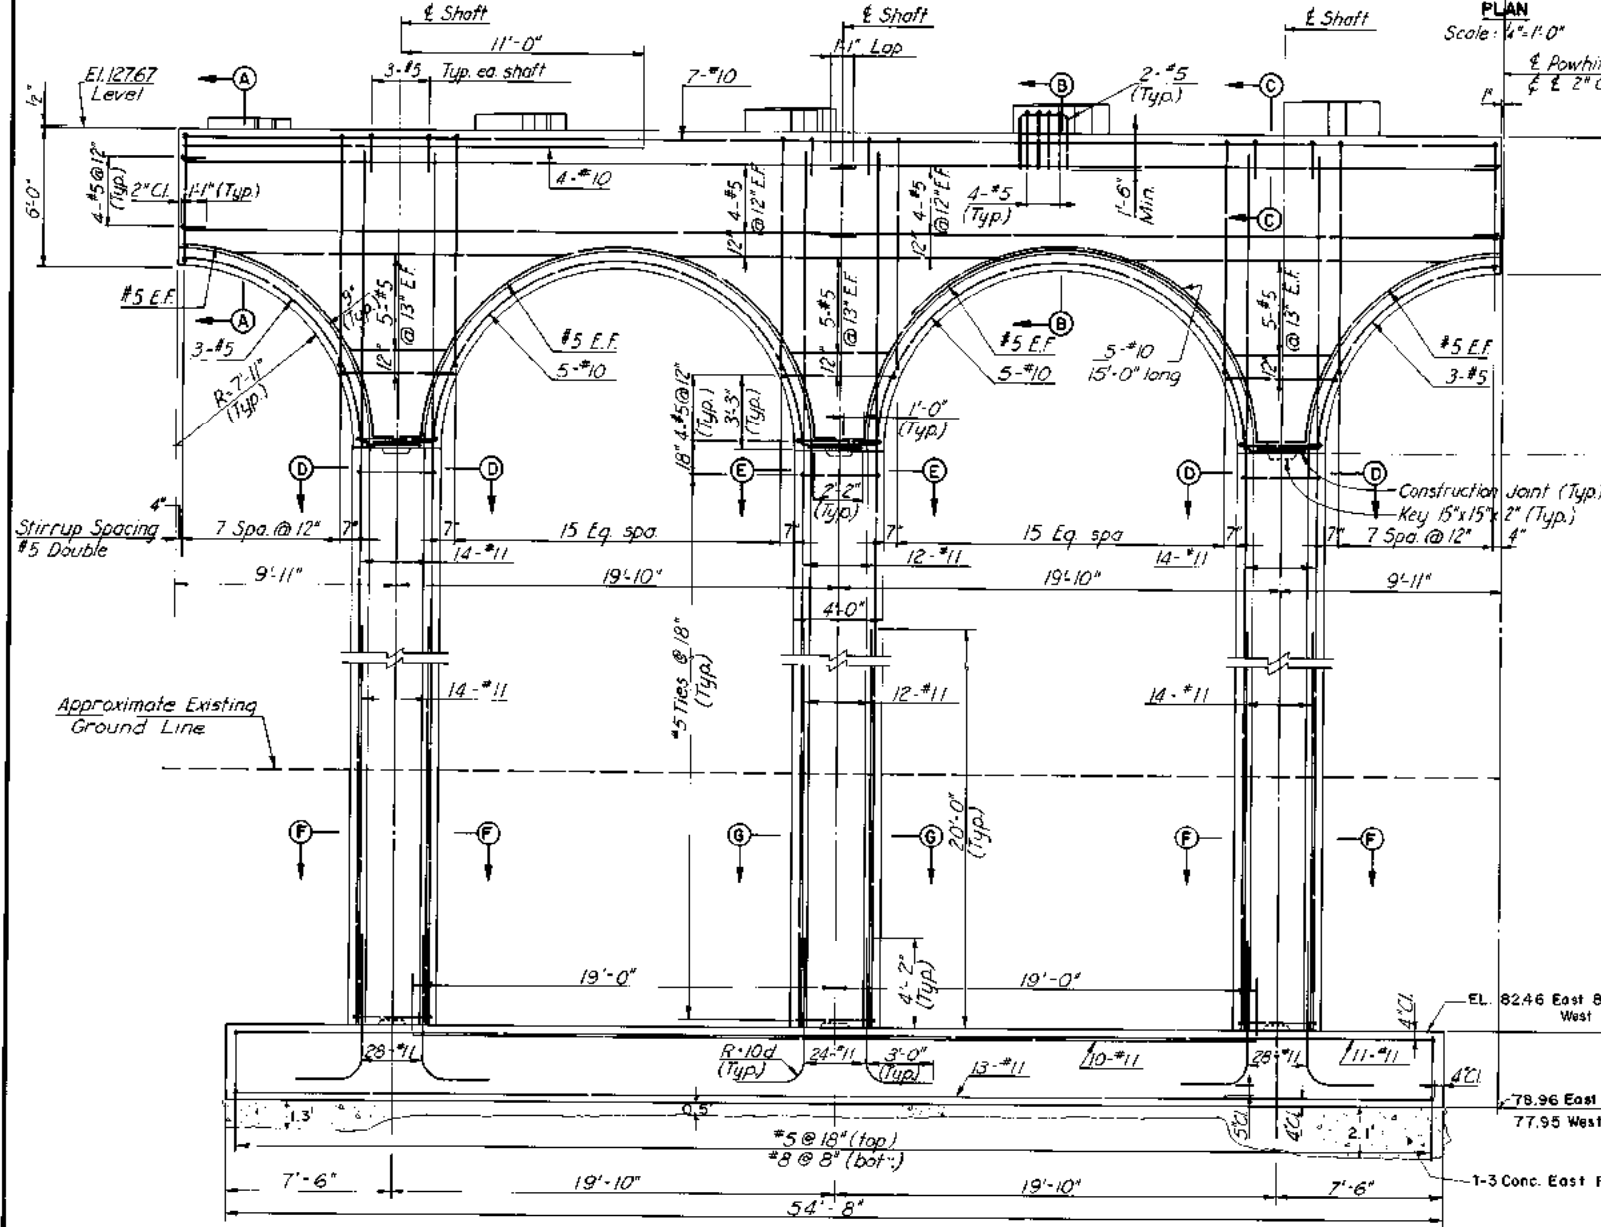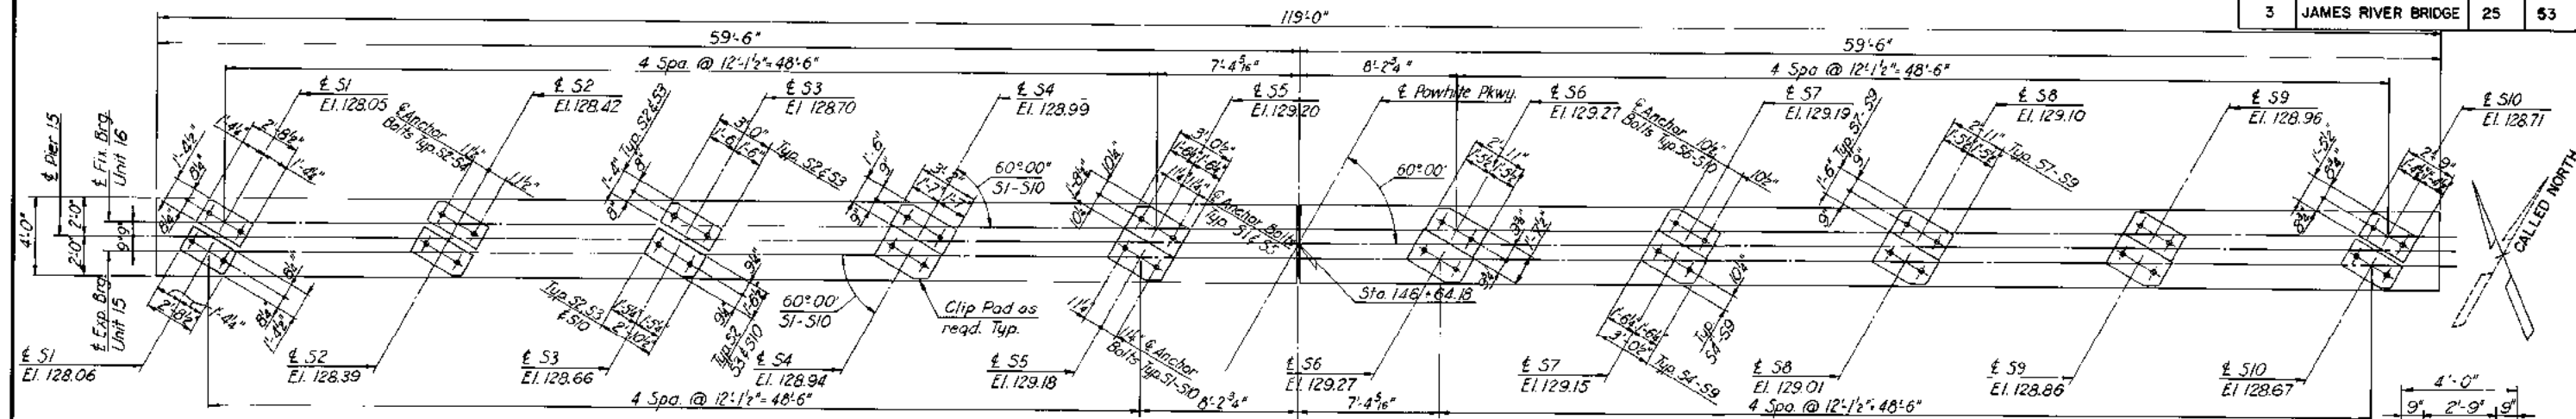

MADE	BY	DATE	NO.	REVISION	BY	DATE
	HBW	7-67				
CHECKED	FXH	3-68				
IN CHARGE	FXH					

**HALF ELEVATION**  
Scale: 1/4"=1'-0"

Note:  
Pier symmetrical about  
E 2" open joint.

**NOTES:**

Pier foundations are designed for an allowable bearing pressure of 3 1/2 Tons/S.F.








RICHMOND METROPOLITAN AUTHORITY  
RICHMOND EXPRESSWAY SYSTEM

JAMES RIVER BRIDGE  
PIER 15

HOWARD, NEEDLES, TAMMEN & BERGENSOFF  
consulting engineers  
NEW YORK ALEXANDRIA KANSAS CITY

SCALE: AS SHOWN  
CONTRACT NO. C-3  
SHEET NO. 25 OF 53



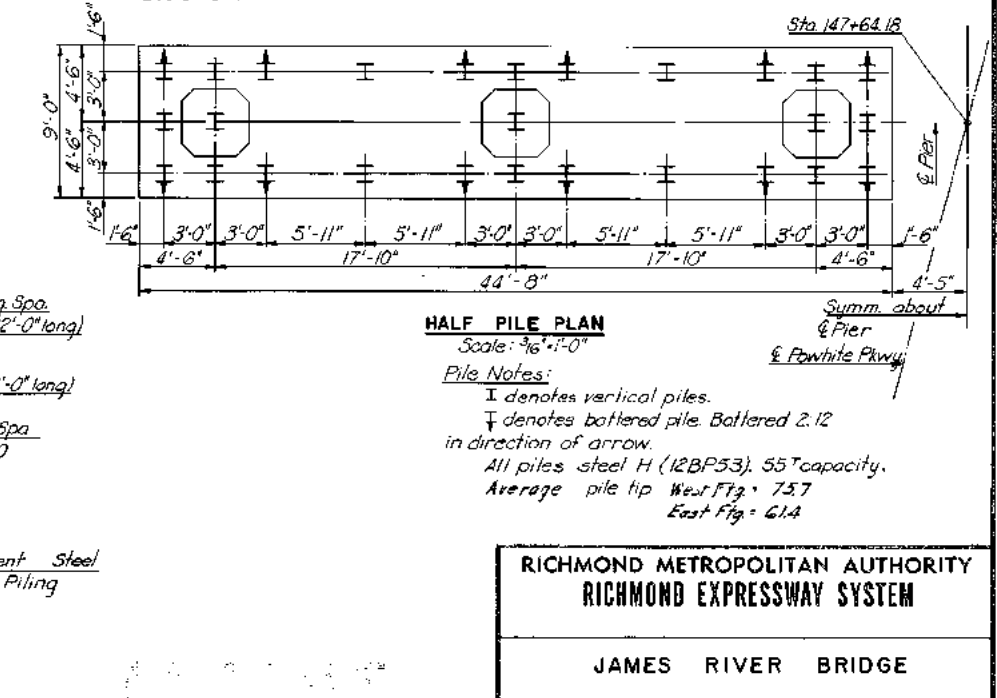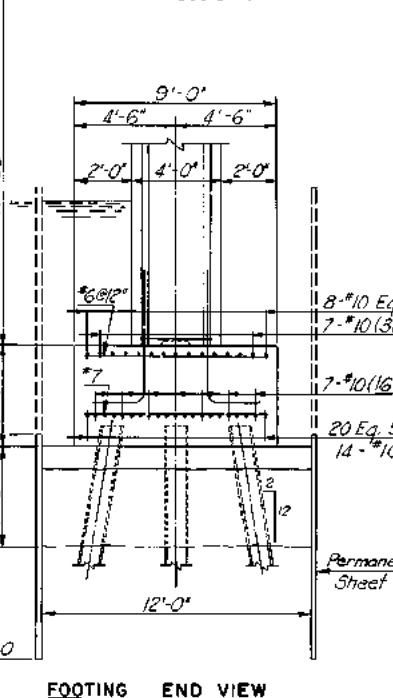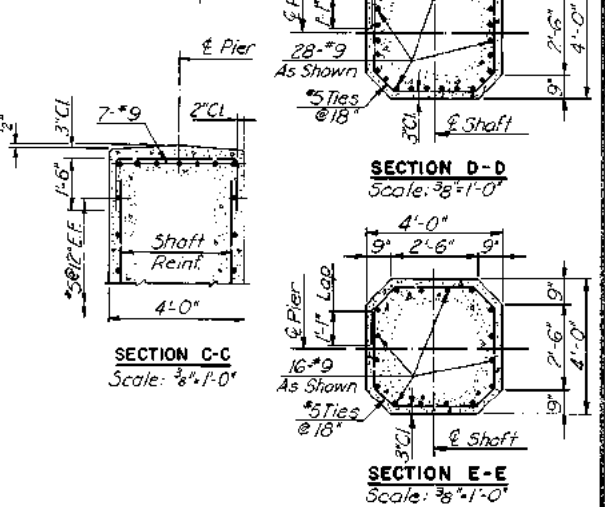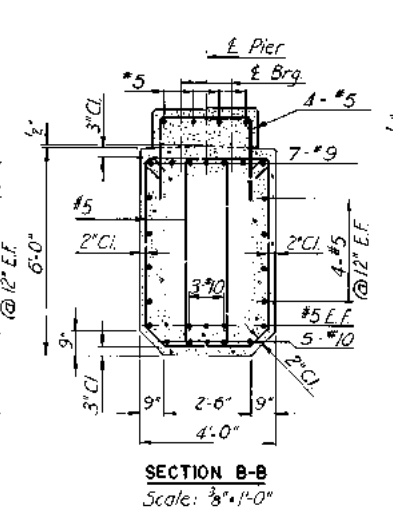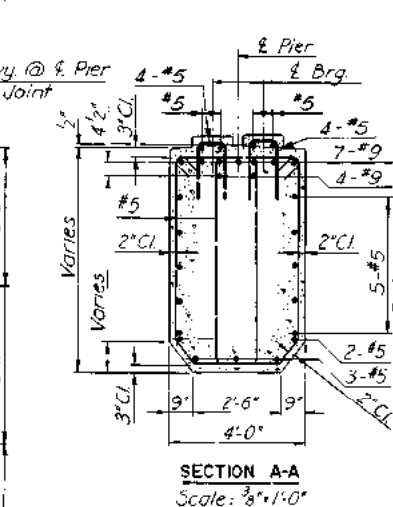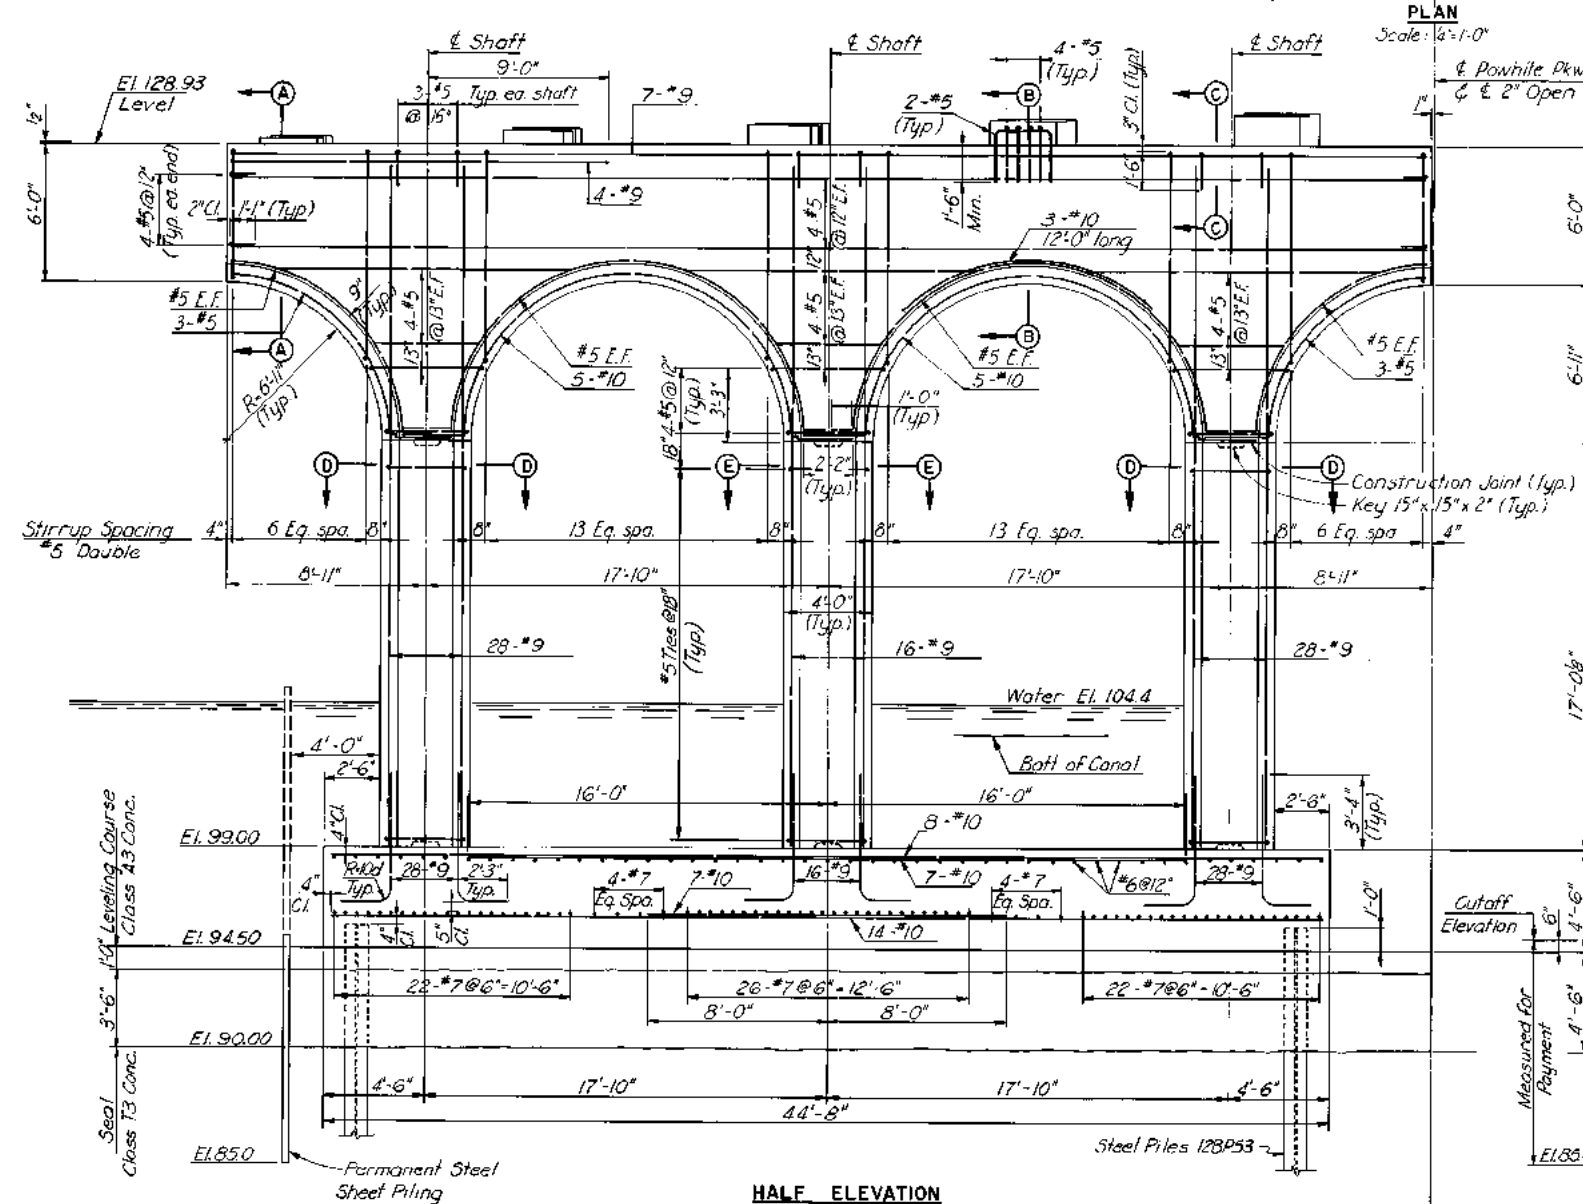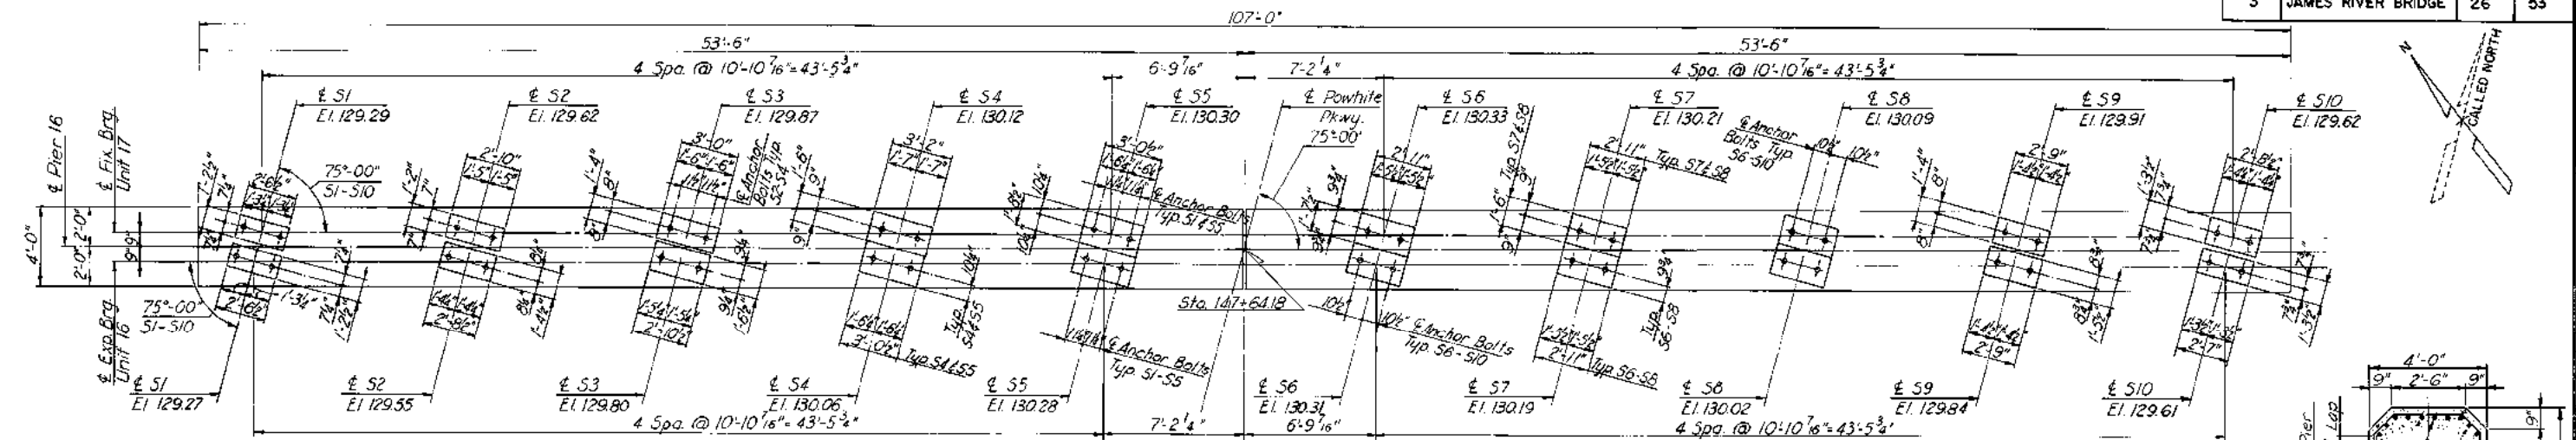

BY	DATE				
MADE	HBW	7-67			
CHECKED	FXH	3-68	1	AS BUILT	12-72
IN CHARGE	FXH		NO.	REVISION	BY DATE

Note:  
Pier symmetrical about  
2" Open Joint.

**RICHMOND METROPOLITAN AUTHORITY**  
**RICHMOND EXPRESSWAY SYSTEM**



**JAMES RIVER BRIDGE**  
**PIER 16**

HOWARD, NEEDLES, TAMMEN & BERGENDOFF  
consulting engineers  
NEW YORK ALEXANDRIA KANSAS CITY


SCALE: AS SHOWN  
CONTRACT NO. C-3  
SHEET NO. 26 OF 53



RICHMOND EXPRESSWAY SYSTEM			
SECTION	PROJECT	SHEET NO.	TOTAL SHEETS
3	JAMES RIVER BRIDGE	28	53

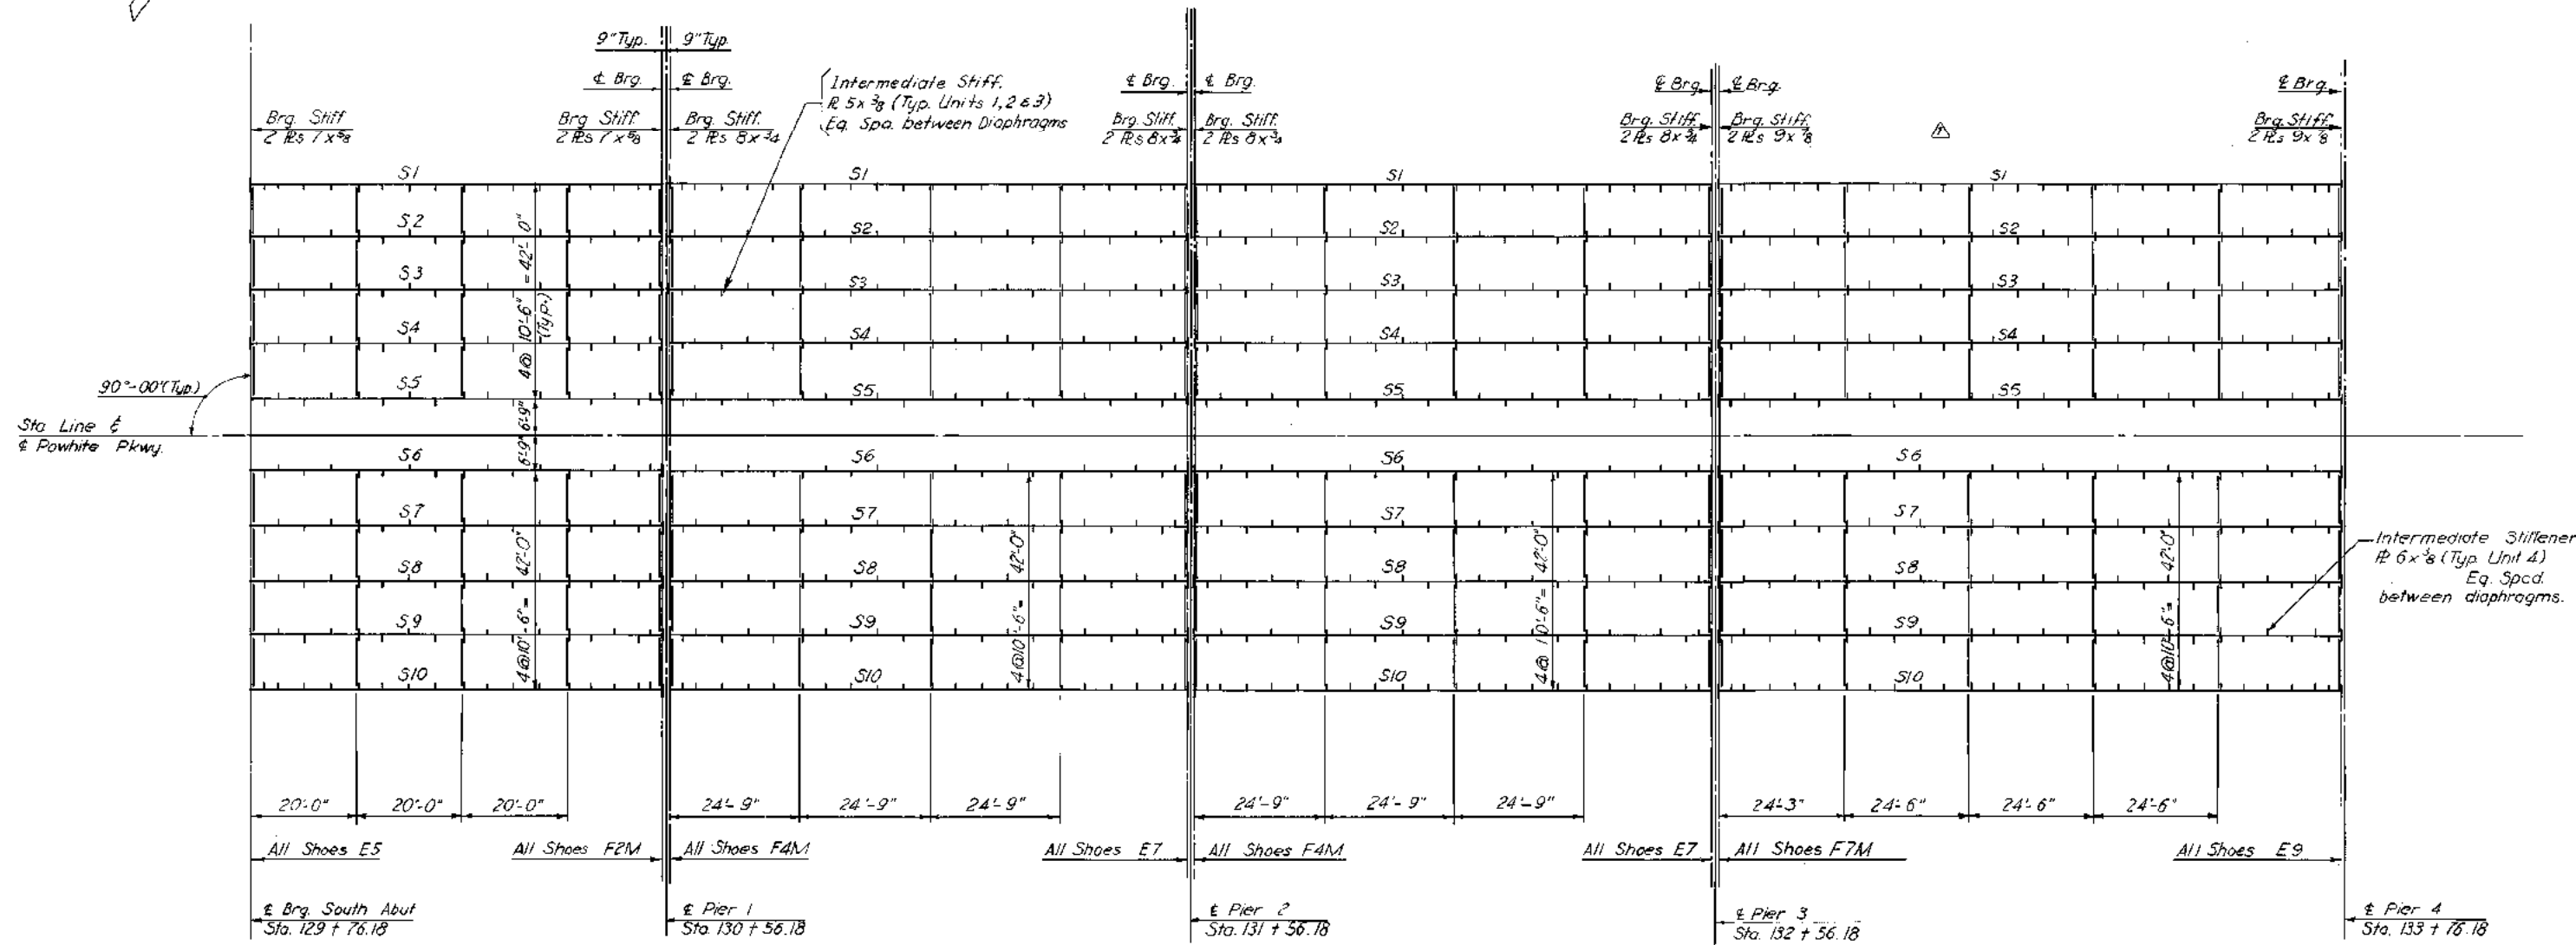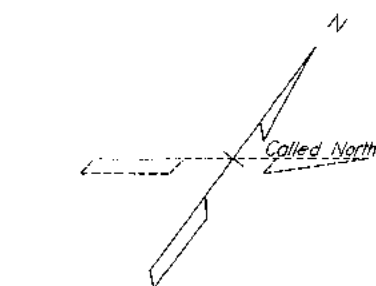

STRINGER LENGTHS (c to c Bearing)					
Unit	Stringer	Length	Unit	Stringer	Length
1	S1-S10	79'-3"	3	S1-S10	98'-6"
2	S1-S10	98'-6"	4	S1-S10	118'-6"

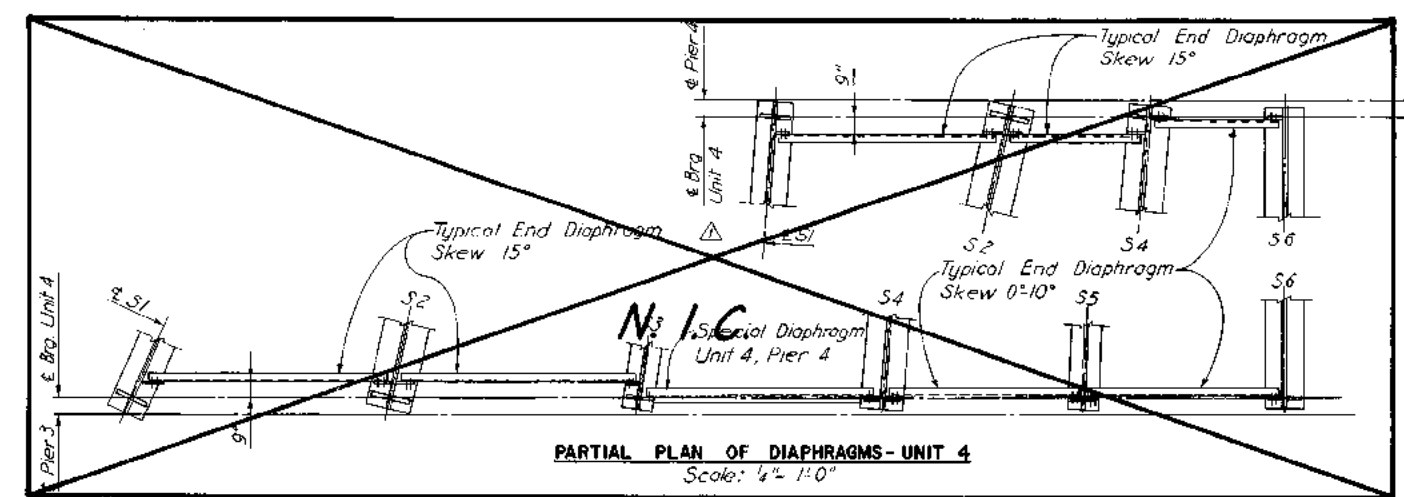

PARTIAL PLAN OF DIAPHRAGMS - UNIT 4  
Scale: 1/4" = 1'-0"

BY	DATE	NO.	REVISION	BY	DATE
MADE	EVR 7-67	2	A. BUILT	JRC	12-72
CHECKED	FXH 8-67		Remove Ramp Taper	H.B.W.	2/20/71
IN CHARGE	FXH				


RICHMOND METROPOLITAN AUTHORITY  
RICHMOND EXPRESSWAY SYSTEM

JAMES RIVER BRIDGE  
FRAMING PLAN UNITS 1,2,3 & 4

HOWARD, NEEDLES, TAMMEN & BERGENDOFF  
consulting engineers  
NEW YORK ALEXANDRIA RICHMOND CITY  
SCALE: 1/4" = 1'-0" (Unless Noted)  
C-3  
SHEET NO. 28 OF 53




RICHMOND EXPRESSWAY SYSTEM			
SECTION	PROJECT	SHEET NO.	TOTAL SHEETS
3	JAMES RIVER BRIDGE	29	53

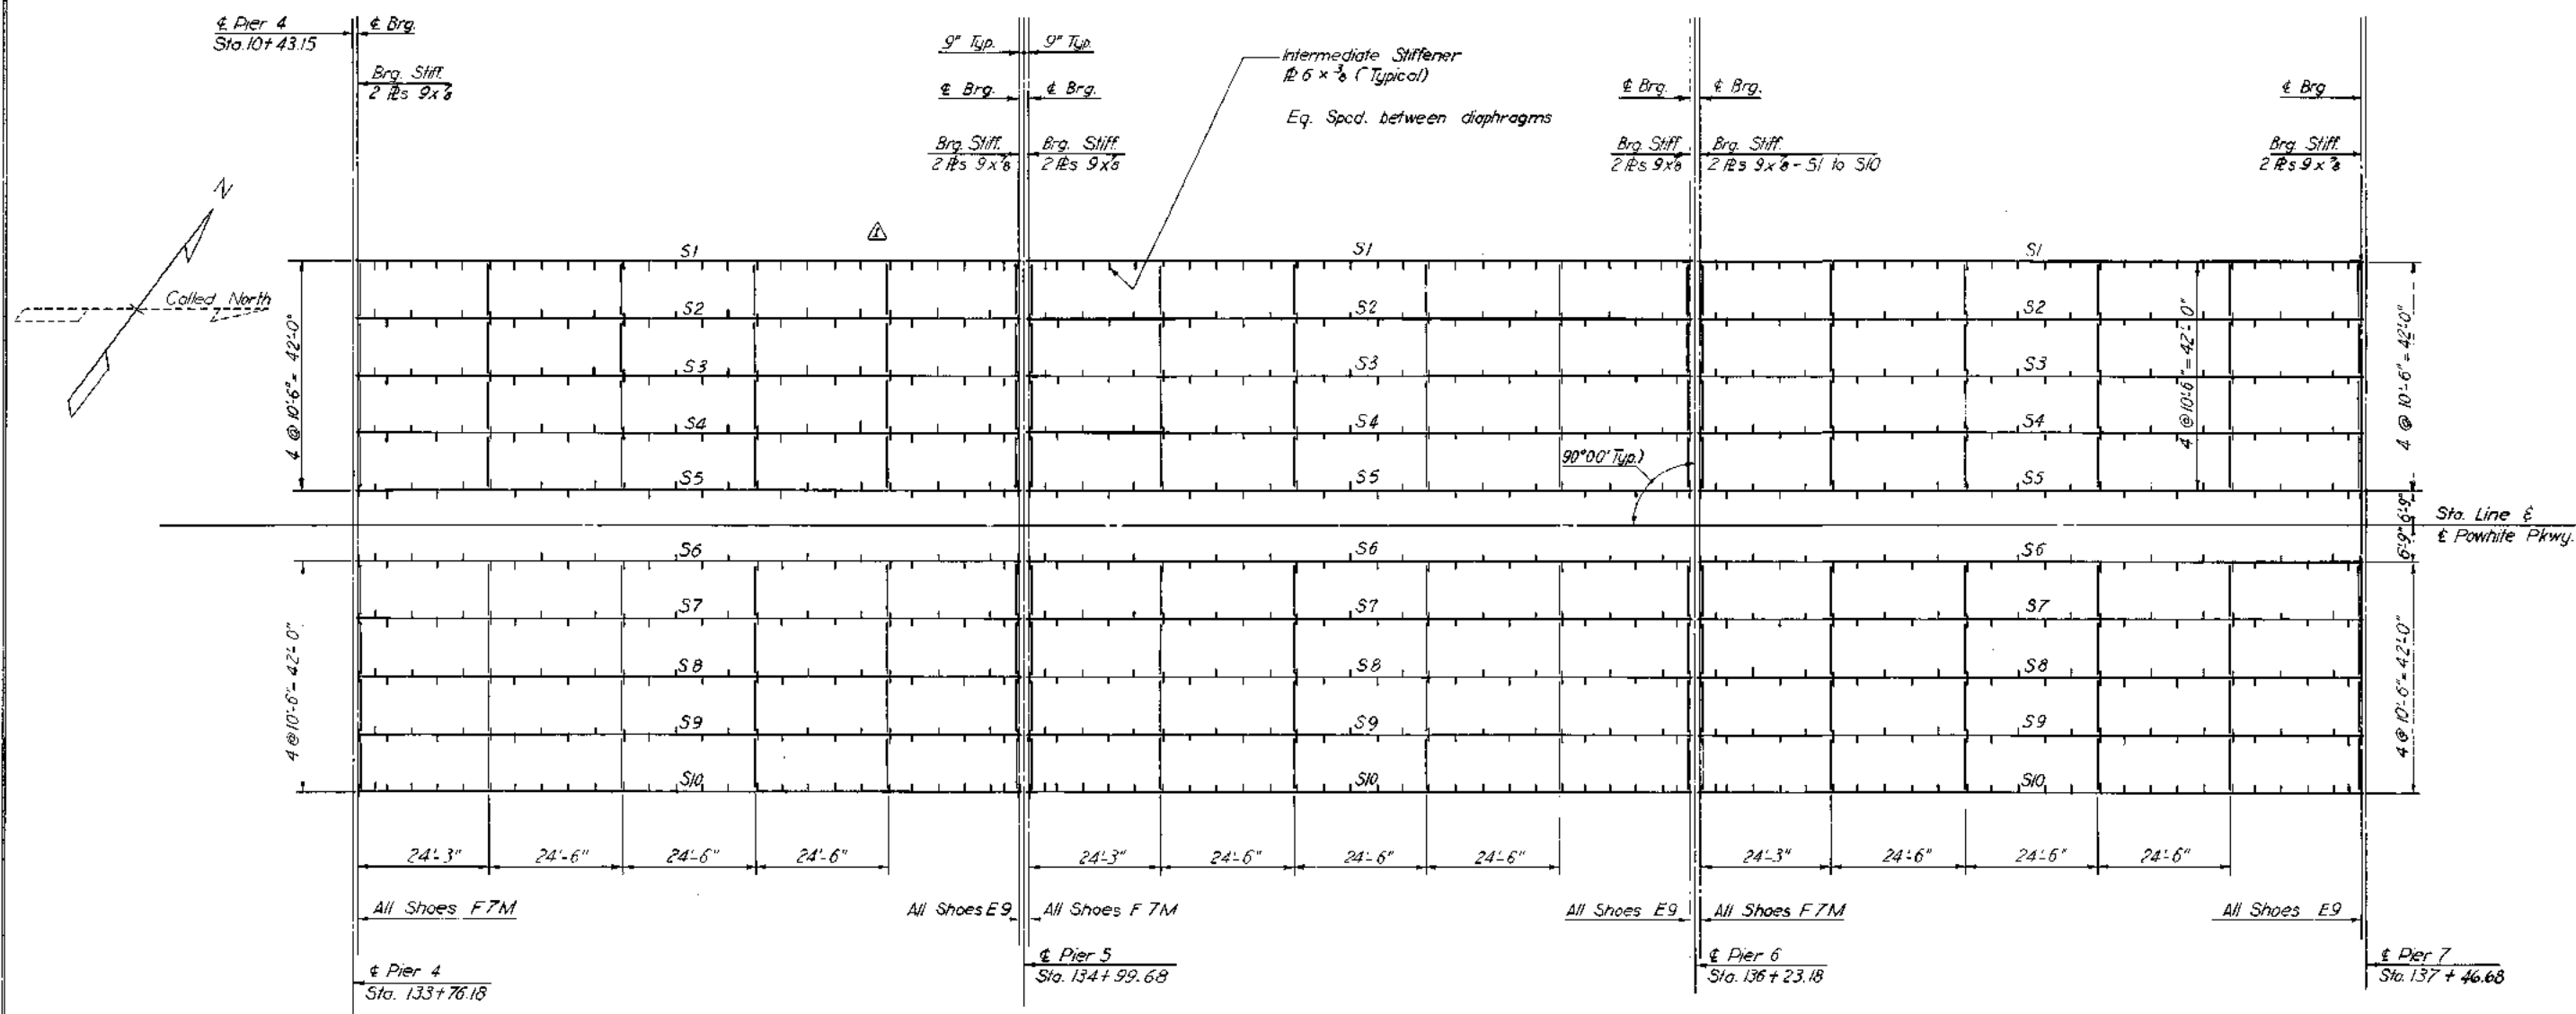

STRINGER LENGTHS (CC. Bearing)		
Unit	Stringer	Length
5-12	S1-S10	122'-0"

MADE	BY	DATE	NO.	REVISION	BY	DATE
EVR	7-67	2	AS BUILT	JRC	12-72	
CHECKED	FXH	8-67	Removed Ramp Widening	ER	2/20/77	
IN CHARGE	FXH					

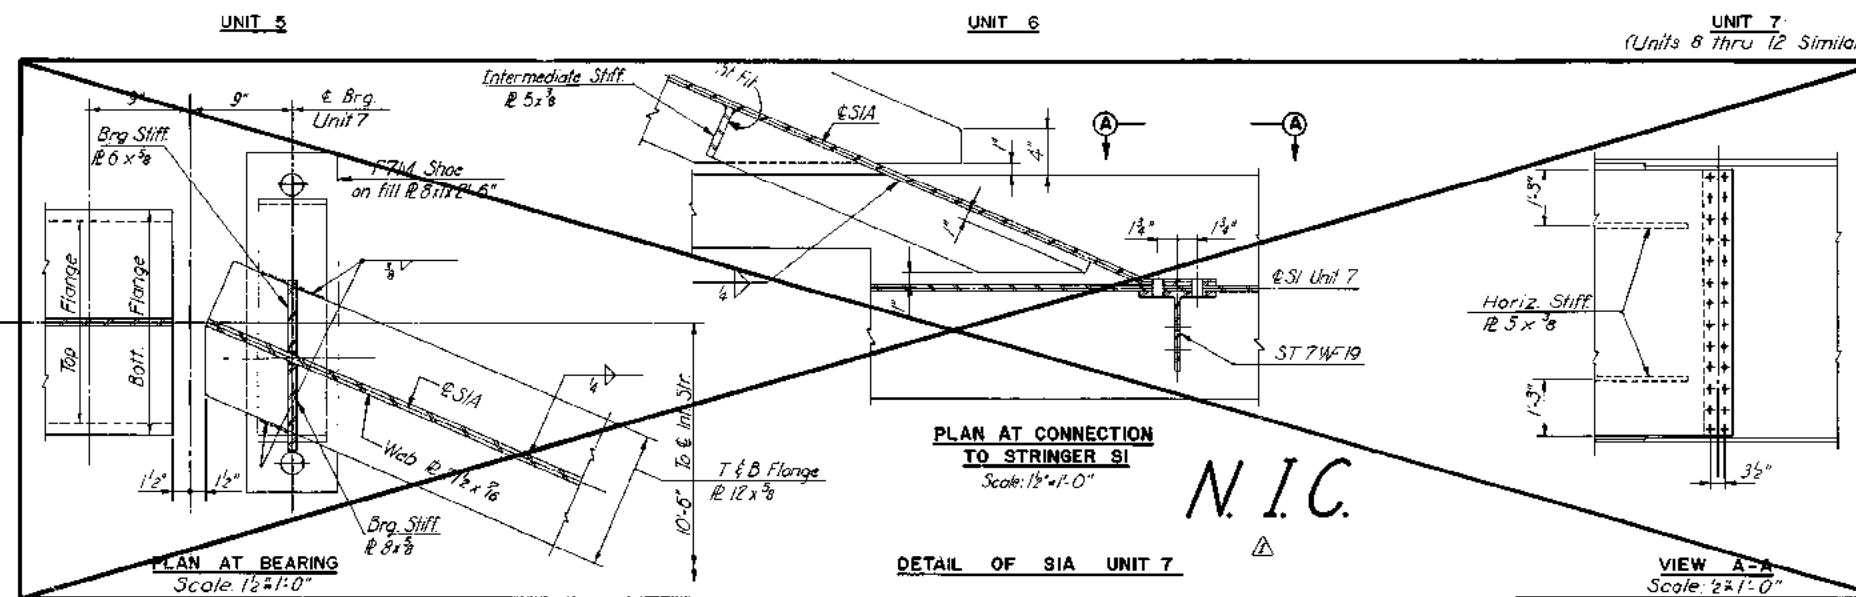


RICHMOND METROPOLITAN AUTHORITY  
RICHMOND EXPRESSWAY SYSTEM

JAMES RIVER BRIDGE  
FRAMING PLAN UNITS 5 THRU 12

HOWARD, NEEDLES, TAMMEN & BERGENCOFF  
Consulting Engineers  
NEW YORK ALEXANDRIA KANSAS CITY  
SCALE: 1/8"=1'-0" (Unless Noted)  
CIV. ENGR. NO. C-3  
SHEET NO. 29 OF 53

RICHMOND EXPRESSWAY SYSTEM			
SECTION	PROJECT	SHEET NO.	TOTAL SHEETS
3	JAMES RIVER BRIDGE	30	53

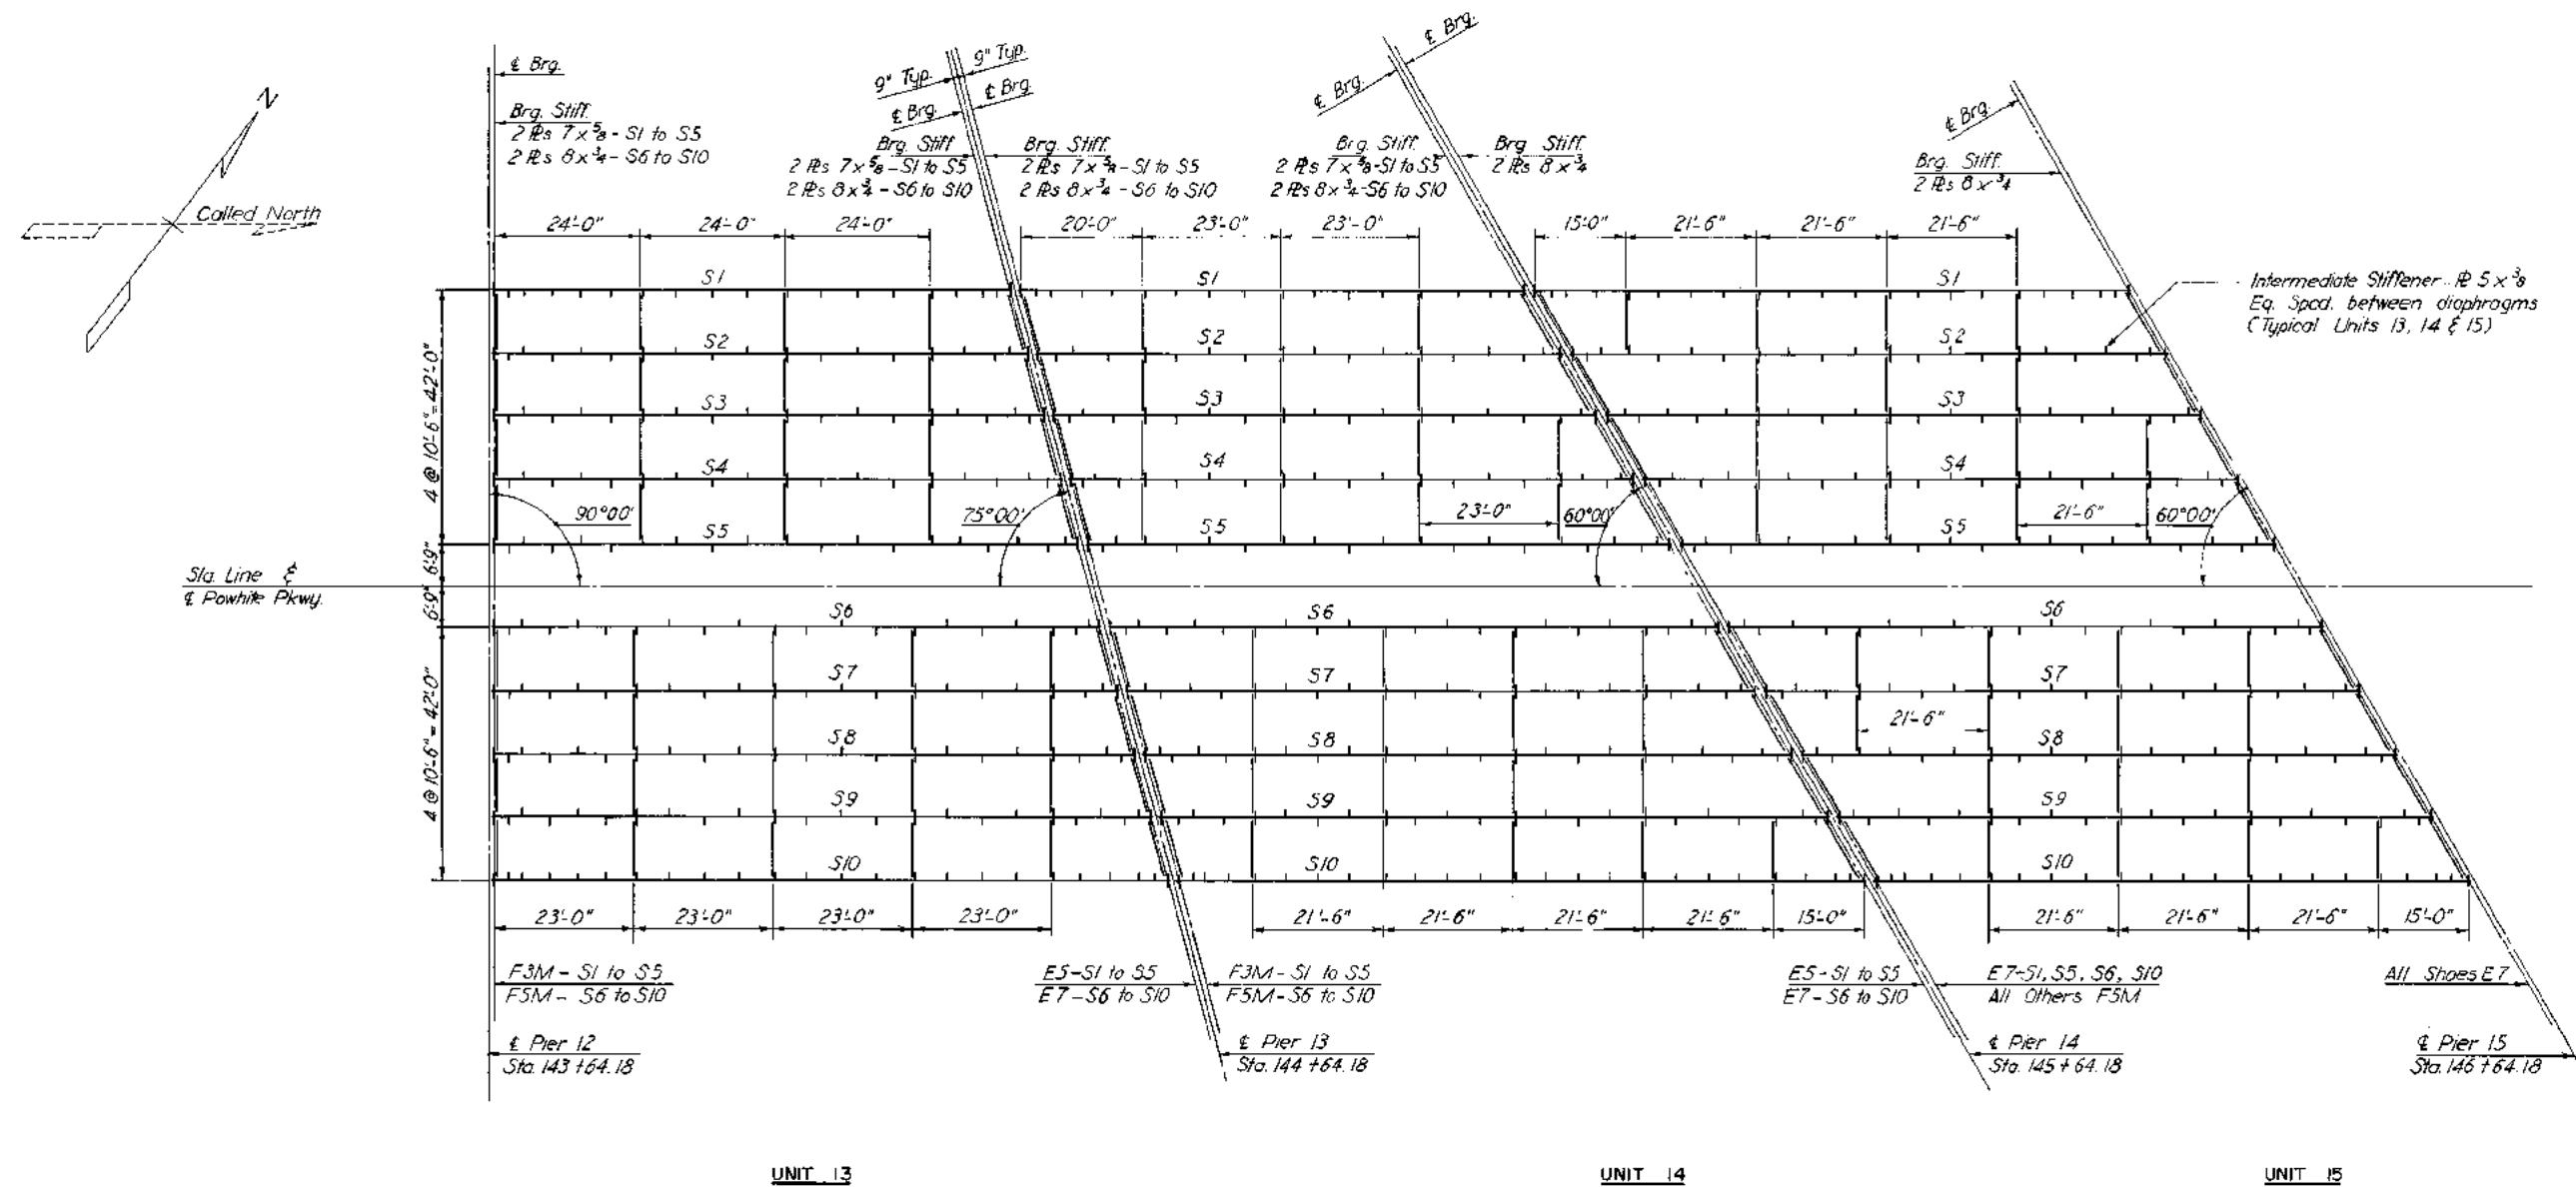

STRINGER LENGTHS (c to c Bearing)								
Unit	Stringer	Length	Unit	Stringer	Length	Unit	Stringer	Length
13	S1	85'-4 $\frac{1}{2}$ "	13 (cont'd)	S8	105'-10 $\frac{1}{8}$ "	14 (cont'd)	S5	96'-3 $\frac{1}{4}$ "
	S2	86'-2 $\frac{1}{16}$ "		S9	108'-8 $\frac{1}{16}$ "		S6	100'-5 $\frac{3}{8}$ "
	S3	91'-0 $\frac{7}{16}$ "		S10	111'-6 $\frac{7}{16}$ "		S7	103'-8 $\frac{5}{16}$ "
	S4	93'-10 $\frac{3}{16}$ "	14	S1	83'-3 $\frac{5}{16}$ "		S8	106'-11 $\frac{5}{16}$ "
	S5	96'-8"		S2	85'-6 $\frac{1}{4}$ "		S9	110'-2 $\frac{5}{16}$ "
	S6	100'-3 $\frac{3}{8}$ "		S3	89'-9 $\frac{1}{4}$ "		S10	113'-5 $\frac{5}{16}$ "
	S7	103'-1 $\frac{1}{8}$ "		S4	93'-0 $\frac{1}{4}$ "		15	S1-S10


MADE	BY	DATE	NO.	REVISION	EY	DATE
	EVR	7-67				
CHECKED	FXH	8-67	1	AS BUILT	JRC	12-72
IN CHARGE	FXH					

RICHMOND METROPOLITAN AUTHORITY  
RICHMOND EXPRESSWAY SYSTEM

JAMES RIVER BRIDGE  
FRAMING PLAN UNITS 13, 14 & 15

HOWARD, NEEDLES, TAMMEN & BERGENDOFF CONSULTING ENGINEERS NEW YORK ALBANY RAPIDS CITY	SCALE: 1" = 15'-0" CON. NO. C-3 SHEET NO. 30 OF 53
---	--

RICHMOND EXPRESSWAY SYSTEM			
SECTION	PROJECT	SHEET NO.	TOTAL SHEETS
3	JAMES RIVER BRIDGE	31	53

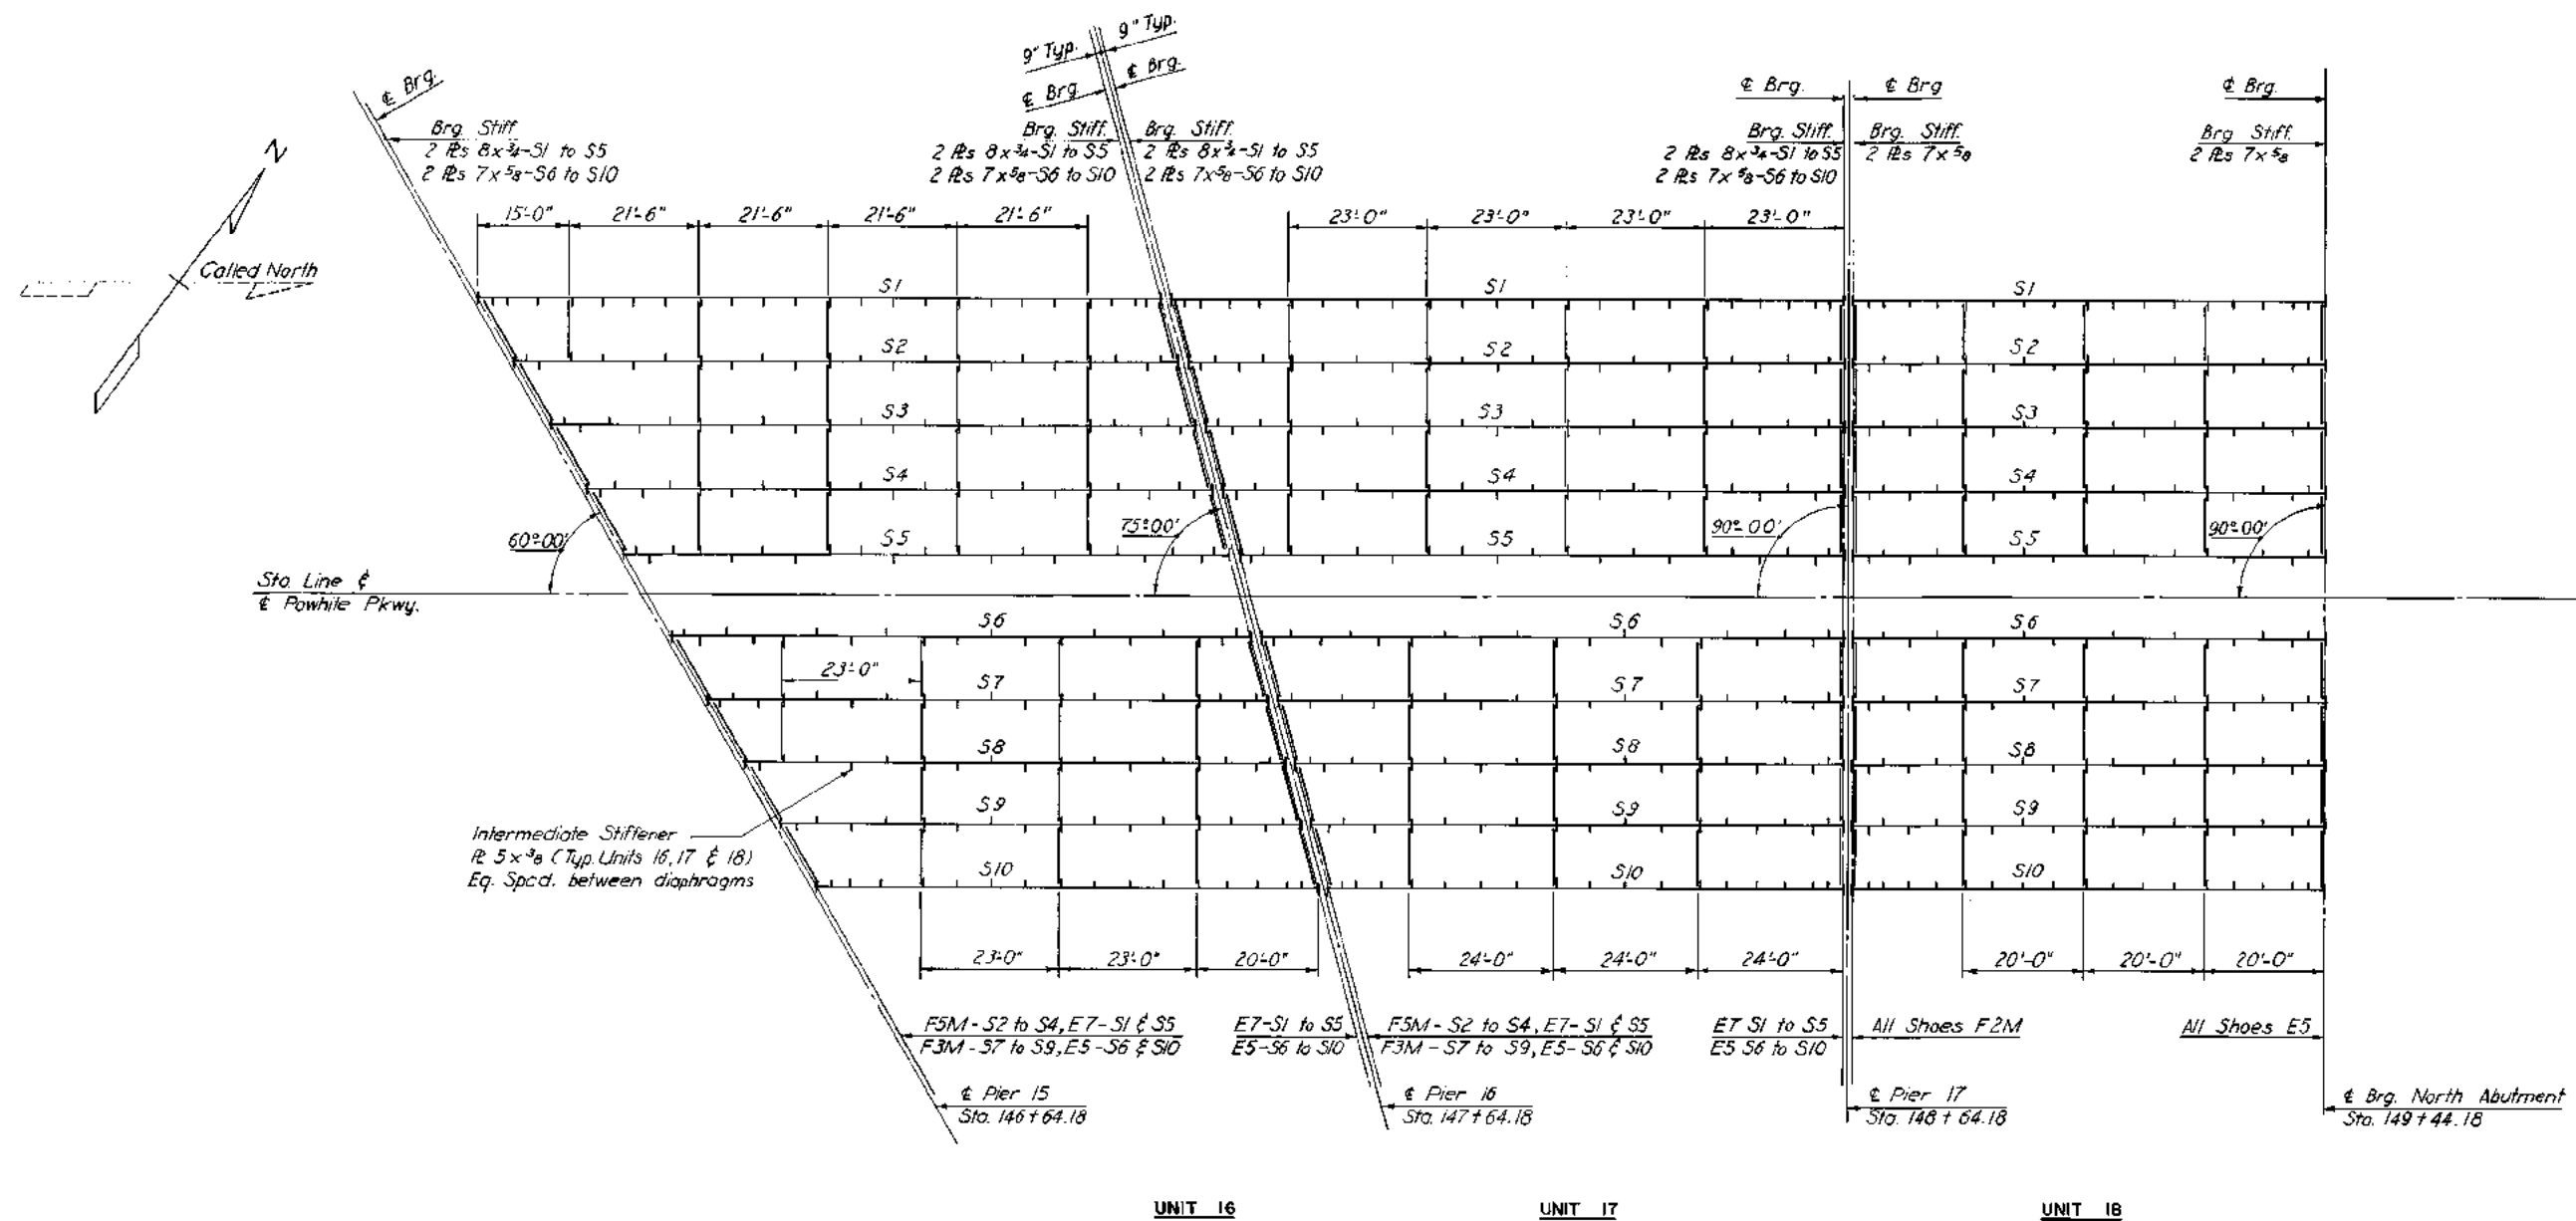



STRINGER LENGTHS (c to c Bearing)								
Unit	Stringer	Length	Unit	Stringer	Length	Unit	Stringer	Length
16	S1	113'-5 <sup>9</sup> / <sub>16</sub> "	16 (cont'd)	S8	89'-9 <sup>1</sup> / <sub>4</sub> "	17 (cont'd)	S5	100'-3 <sup>3</sup> / <sub>8</sub> "
	S2	110'-2 <sup>9</sup> / <sub>16</sub> "		S9	85'-6 <sup>1</sup> / <sub>4</sub> "		S6	96'-8"
	S3	106'-11 <sup>5</sup> / <sub>16</sub> "		S10	83'-3 <sup>5</sup> / <sub>16</sub> "		S7	93'-10 <sup>3</sup> / <sub>16</sub> "
	S4	103'-8 <sup>5</sup> / <sub>16</sub> "		S1	111'-6 <sup>5</sup> / <sub>16</sub> "		S8	91'-0 <sup>7</sup> / <sub>16</sub> "
	S5	100'-5 <sup>3</sup> / <sub>8</sub> "	17	S2	108'-8 <sup>1</sup> / <sub>16</sub> "		S9	88'-2 <sup>1</sup> / <sub>16</sub> "
	S6	96'-3 <sup>1</sup> / <sub>4</sub> "		S3	105'-10 <sup>7</sup> / <sub>8</sub> "		S10	85'-4 <sup>15</sup> / <sub>16</sub> "
	S7	93'-0 <sup>1</sup> / <sub>4</sub> "		S4	103'-1 <sup>1</sup> / <sub>8</sub> "	18	S1-S10	79'-3"

MADE	EVR	7-67					
CHECKED	FXH	8-67	1	AS BUILT	JRC	12-72	
IN CHARGE	FXH		NO.	REVISION	BY	DATE	


RICHMOND METROPOLITAN AUTHORITY RICHMOND EXPRESSWAY SYSTEM	
JAMES RIVER BRIDGE FRAMING PLAN UNITS 16, 17 & 18	
FORWARD, NEEDLES, TAMMEN & BERGENDOFF CONSULTING ENGINEERS NEW YORK ALEXANDRIA KANSAS CITY	SCALE 1" = 15'-0" CONTRACT NO. C-3 SHEET NO. 31 OF 53




RICHMOND EXPRESSWAY SYSTEM			
SECTION	PROJECT	SHEET NO.	TOTAL SHEETS
3	JAMES RIVER BRIDGE	32	53

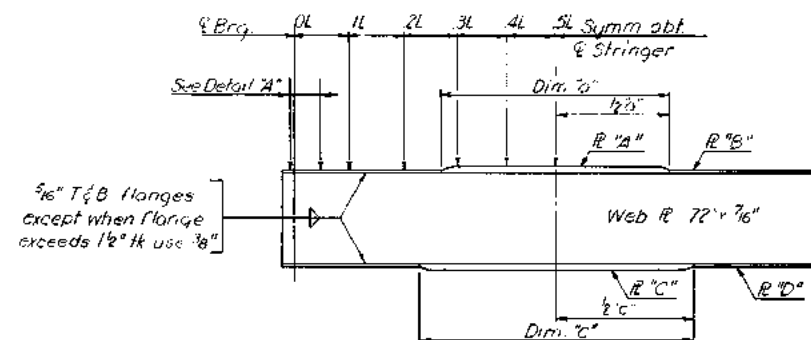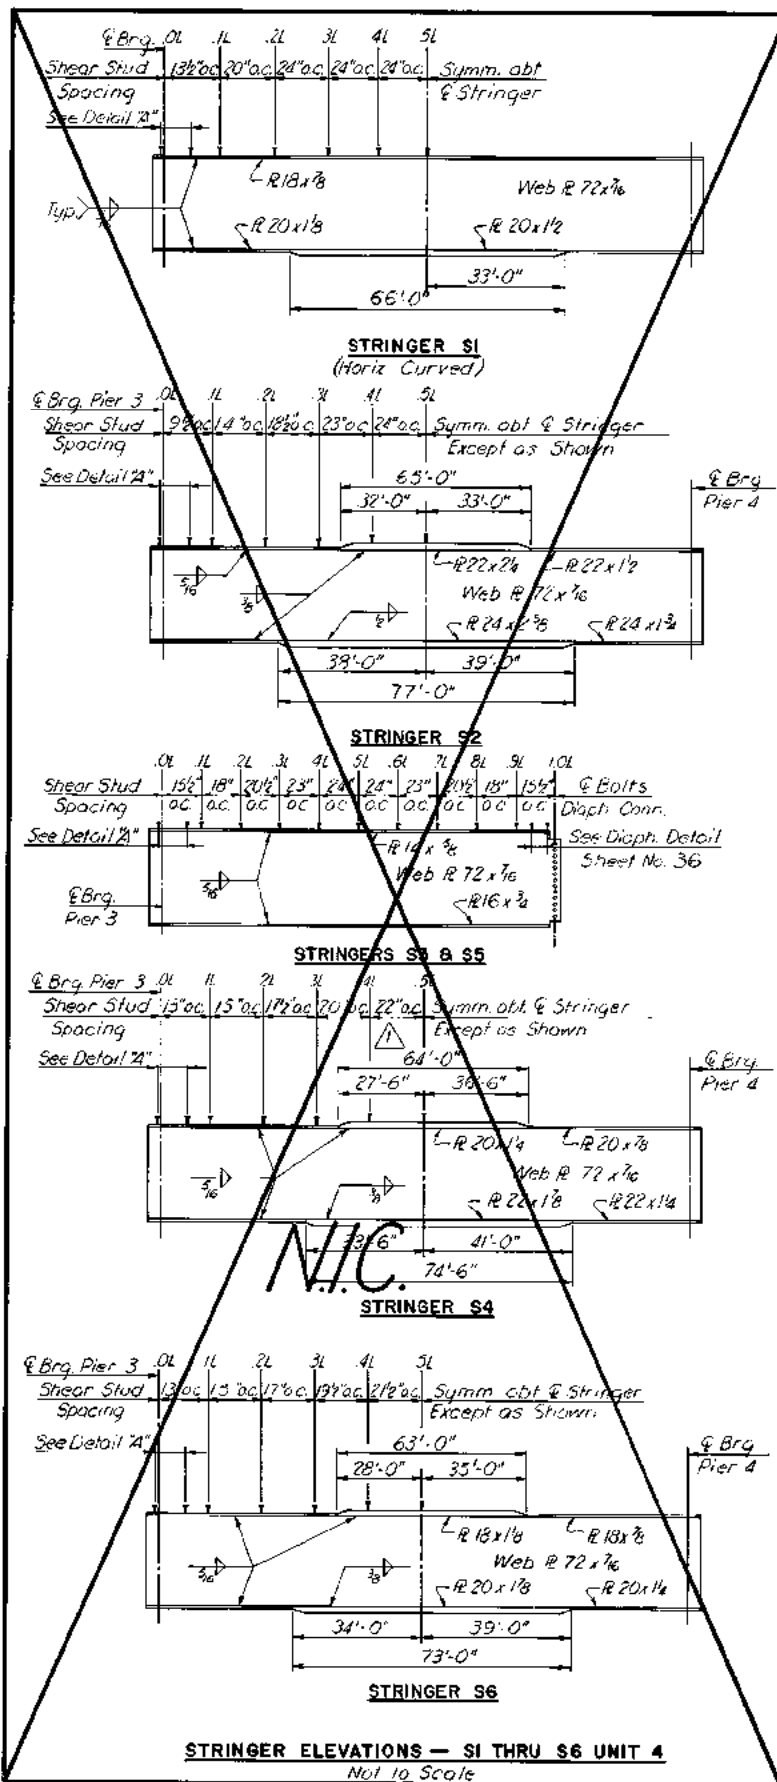

TYPICAL STRINGER ELEVATION  
Not to Scale

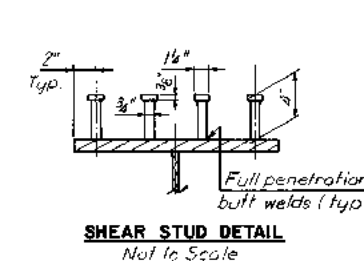


SHEAR STUD DETAIL  
Not to Scale

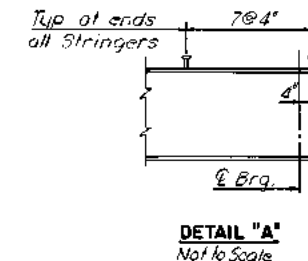

DETAIL "A"  
Not to Scale

**SHEAR STUD NOTE:**  
Capacity = 3400 lbs. per stud.  
The contractor may, if he elects, use three 3/8" diameter studs at the same longitudinal spacing in lieu of four 1/2" diameter studs shown.  
Stud rows shall be placed parallel to the main deck reinforcing.  
Shear stud spacing shown is maximum spacing.

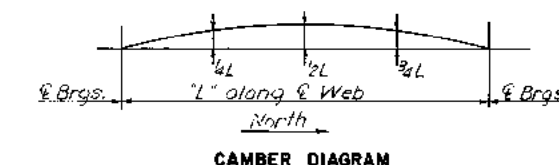

CAMBER DIAGRAM

**NOTE TO FABRICATOR:**  
Stringers fabricated with an upward camber amounting to (see table). This will provide approximate compensation for deflection under full dead load.

STRINGER SCHEDULE												
UNIT	STRINGER	R "A"	Dim."a"	R "B"	R "C"	Dim."c"	R "D"	SHEAR STUD SPACING				
								0L-1L	1L-2L	2L-3L	3L-4L	4L-5L
1	S5&S6	14x 3/8	F.L.	—	16x 3/8	F.L.	—	12"	13 1/2"	16"	18 1/2"	20 1/2"
	S1-S4, S7-S10	14x 3/8	F.L.	—	16x 1	40'-6"	16x 3/8	11 1/2"	13 1/2"	15 1/2"	18"	20"
2		16x 3/8	F.L.	—	18x 3/8	52'-6"	18x 3/8	13 1/2"	15 1/2"	18 1/2"	21 1/2"	24 1/2"
		16x 3/8	F.L.	—	18x 1 1/8	60'-6"	18x 3/8	12"	14"	16"	19"	21"
	S5&S6	16x 3/8	F.L.	—	18x 1 1/8	60'-6"	18x 3/8	12"	14"	16"	19"	21"
	S1-S4, S7-S10	16x 3/8	F.L.	—	18x 1 1/2	58'-6"	18x 1	12"	14"	16"	19"	21"
3	S5&S6	16x 3/8	F.L.	—	18x 1 1/8	60'-6"	18x 3/8	12"	14"	16"	19"	21"
	S1-S4, S7-S10	16x 3/8	F.L.	—	18x 1 1/2	58'-6"	18x 1	12"	14"	16"	19"	21"
4		See Elevations and Sheet										
	S1-S4, S7-S10	18x 1 1/2	62'-0"	18x 3/8	20x 1 1/8	70'-6"	20x 1 1/4	12 1/2"	14 1/2"	17 1/2"	21"	23"
5	S5&S6	18x 1 1/2	53'-0"	18x 3/8	20x 1 1/8	77'-0"	20x 1 1/4	12 1/2"	14 1/2"	18 1/2"	23 1/2"	24"
		18x 1 1/2	60'-0"	18x 3/8	20x 1 1/2	77'-0"	20x 1 1/4	13 1/2"	15 1/2"	20"	24"	24"
		18x 1 1/2	F.L.	—	20x 1 1/2	77'-0"	20x 1 1/4	14 1/2"	16 1/2"	20 1/2"	23 1/2"	24"
		18x 1 1/2	F.L.	—	20x 1 1/2	73'-0"	20x 1 1/4	12 1/2"	14 1/2"	17 1/2"	21"	23"
6	S1-S4, S7-S10	18x 1 1/2	68'-6"	18x 3/8	20x 2	73'-0"	20x 1 1/8	12 1/2"	14 1/2"	17 1/2"	21 1/2"	23 1/2"
	S5&S6	18x 1 1/2	66'-0"	18x 3/8	20x 2	73'-0"	20x 1 1/8	12 1/2"	14 1/2"	17 1/2"	21"	23"
7 thru 12	S1-S4, S7-S10	18x 1 1/2	68'-5"	18x 3/8	20x 2	73'-6"	20x 1 1/8	12 1/2"	14 1/2"	17 1/2"	21 1/2"	23 1/2"
	S5&S6	18x 1 1/2	68'-5"	18x 3/8	20x 2	73'-6"	20x 1 1/8	12 1/2"	14 1/2"	17 1/2"	21 1/2"	23 1/2"
13	S1	14x 3/8	F.L.	—	16x 1 1/2	51'-0"	16x 3/8	11 1/2"	13"	15 1/2"	18"	20"
	S2	14x 3/8	F.L.	—	16x 1 1/2	51'-0"	16x 3/8	11 1/2"	13"	15 1/2"	18"	20"
	S3	14x 3/8	F.L.	—	16x 1 1/2	55'-6"	16x 3/8	11 1/2"	13 1/2"	16 1/2"	18 1/2"	20"
	S4	14x 3/8	F.L.	—	16x 1 1/2	55'-6"	16x 1	12"	13 1/2"	15 1/2"	18 1/2"	20"
	S5	14x 3/8	F.L.	—	16x 1 1/2	51'-0"	16x 1	12"	14"	16 1/2"	21"	24"
	S6	16x 3/8	F.L.	—	18x 1 1/2	62'-6"	18x 3/8	12"	14"	17 1/2"	22"	24"
	S7	16x 3/8	F.L.	—	18x 1 1/2	61'-0"	18x 1/8	12"	14"	16"	19 1/2"	21"
	S8	16x 1	S1'-0"	16x 3/4	18x 1 1/4	66'-6"	18x 1/8	12"	14"	17"	19 1/2"	21"
	S9	16x 1	57'-0"	16x 3/4	18x 1 1/2	67'-0"	18x 1/4	12"	14"	17"	20"	22"
	S10	16x 1 1/8	63'-6"	16x 3/4	18x 1 1/2	68'-6"	18x 1 1/8	12 1/2"	14"	16 1/2"	20 1/2"	22 1/2"
15	S1-S4, S7-S10	16x 3/4	F.L.	—	18x 1 1/2	58'-6"	18x 1	12"	14"	16"	19"	21"
	S5&S6	16x 3/4	F.L.	—	19x 1 1/2	60'-6"	18x 3/4	12"	14"	18"	22"	24"
16	S1	16x 1 1/2	63'-6"	16x 3/4	18x 2	67'-6"	18x 1 1/2	12 1/2"	14 1/2"	16 1/2"	20 1/2"	22 1/2"
	S2	16x 1	57'-0"	16x 3/4	18x 1 1/2	67'-0"	18x 1 1/2	12"	14"	17"	20"	22"
	S3	16x 1	51'-0"	16x 3/4	18x 1 1/2	66'-6"	18x 1 1/2	12"	14"	17"	19 1/2"	21"
	S4	16x 3/8	F.L.	—	18x 1 1/2	61'-0"	18x 1/4	12"	14"	16"	19 1/2"	21"
	S5	16x 3/4	F.L.	—	18x 1 1/2	62'-6"	18x 3/8	12"	14"	17 1/2"	22"	24"
	S6	14x 3/8	F.L.	—	16x 1 1/2	57'-0"	16x 1	12"	14"	16 1/2"	21"	24"
	S7	14x 3/8	F.L.	—	16x 1 1/2	53'-6"	16x 1	12"	13 1/2"	15 1/2"	18 1/2"	20"
	S8	14x 3/8	F.L.	—	16x 1 1/2	55'-6"	16x 3/8	11 1/2"	13 1/2"	16 1/2"	18 1/2"	20"
	S9	14x 3/8	F.L.	—	16x 1 1/2	51'-0"	16x 3/8	11 1/2"	13 1/2"	15 1/2"	18"	20"
	S10	14x 3/8	F.L.	—	16x 1 1/8	51'-0"	16x 3/4	11 1/2"	13"	15 1/2"	18"	20"
19	S1-S4, S7-S10	14x 3/8	F.L.	—	16x 1	40'-6"	16x 3/4	11 1/2"	13 1/2"	15 1/2"	18"	20"
	S5&S6	14x 3/8	F.L.	—	16x 3/8	F.L.	—	12"	13 1/2"	15 1/2"	18 1/2"	20 1/2"

**NOTES:**  
For General Notes see sheet no. 4.  
For Joint Details see sheet no. 35.  
For Shear Details see sheet no. 34.  
Scupper locations shown on Deck Plans. For Scupper Details see sheet no. 36.  
For stringer lengths see Framing Plans.

CAMBER				SCHEDULE			
UNIT	STRINGER	4 & 3/4	1/2	UNIT	STRINGER	4 & 3/4	1/2
1	S1 - S10	3"	1"	13	S6	1 1/2"	1 1/2"
		1 1/2"	1 1/2"		S7	1 1/2"	2 1/2"
2		1 1/2"	1 1/2"	14	S8	1 1/2"	2 1/2"
	S1 - S10	1 1/2"	1 1/2"		S9	1 1/2"	2 1/2"
3		1 1/2"	1 1/2"	15	S10	1 1/2"	2 1/2"
	S1 - S10	1 1/2"	1 1/2"		S1 - S10	1 1/2"	1 1/2"
4	S1 - S10	2"	2 3/4"	16	S1	1 1/2"	2 1/2"
	S5 & S6	2 1/2"	3"		S2	1 1/2"	2 3/8"
5	S1 - S4, S7 - S10	2 1/2"	2 1/2"	17	S3	1 1/2"	2 1/2"
	S5 & S6	2 1/2"	3"		S4	1 1/2"	2 1/2"
6	S1 - S4, S7 - S10	2 1/2"	2 1/2"	18	S5	1 1/2"	2 1/2"
	S5 & S6	2 1/2"	3"		S6 & S7	1 1/2"	1 1/2"
7 thru 12	S1 - S4, S7 - S10	2 1/2"	2 1/2"	19	S8	1 1/2"	1 1/2"
	S5 & S6	2 1/2"	3"		S9	1"	1 3/8"
13	S1	1"	1 3/8"	20	S10	3/4"	1 1/2"
	S2	1"	1 3/8"		S1 - S10	3/4"	1"
14	S3	1 1/2"	1 1/2"	21			
	S4 & S5	1 1/2"	1 1/2"				


RICHMOND METROPOLITAN AUTHORITY  
RICHMOND EXPRESSWAY SYSTEM

JAMES RIVER BRIDGE  
STRUCTURAL STEEL DETAILS


HOWARD, NEEDLES, TAMMEN & BERGENDOFF  
Consulting Engineers  
NEW YORK ALEXANDRIA KANSAS CITY  
SCALE: AS SHOWN  
CONTRACT NO: C-3  
SHEET NO: 32 OF 53

BY	DATE	REVISION	BY	DATE
MADE	HBW 7-67	2 AS BUILT	JRC	12-72
CHECKED	FXH 8-67	Remove Ramp Top of Strs.	H.B.W.	2/20/77
IN CHARGE	FXH			


RICHMOND EXPRESSWAY SYSTEM				
SECTION	PROJECT	SHEET NO.	TOTAL SHEETS	
3	JAMES RIVER BRIDGE	33	53	

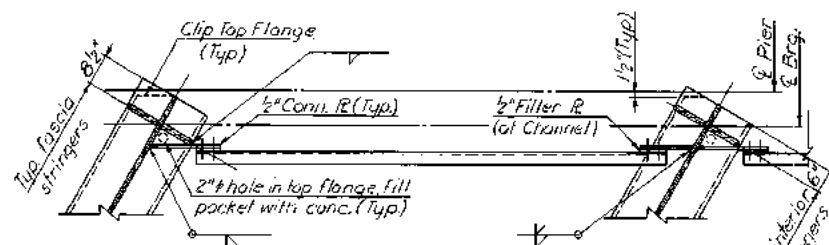

PLAN - SKEW 30°

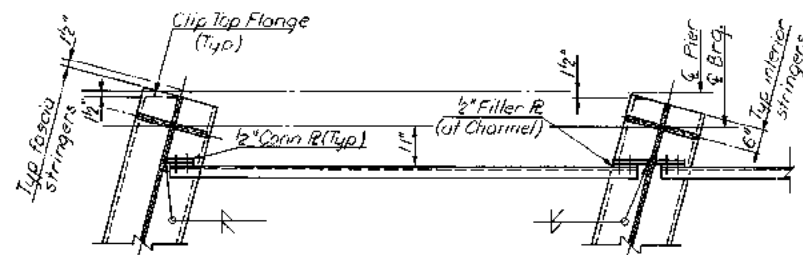


PLAN - SKEW 15°

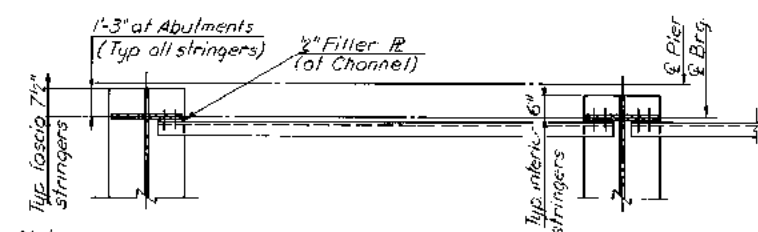

PLAN - SKEW 0° THRU 10°


Note:  
For Skew up to 10°  
Bearing Stiffeners to  
be parallel to C Brg.

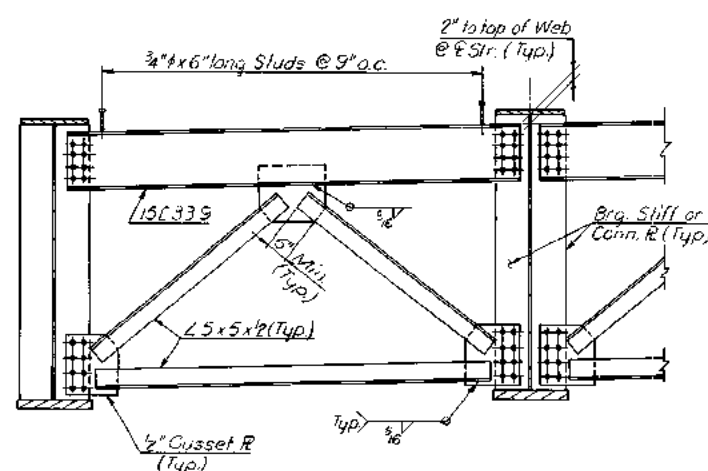

ELEVATION

TYPICAL END DIAPHRAGM DETAILS

Scale: 1/2" = 1'-0"

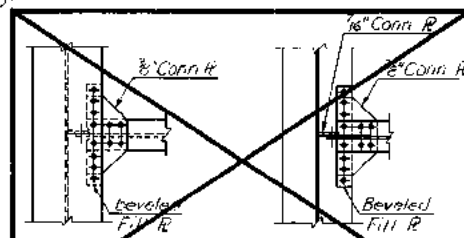


SECTION B-B

Scale: 1/2" = 1'-0"


SECTION C-C

Scale: 1/2" = 1'-0"

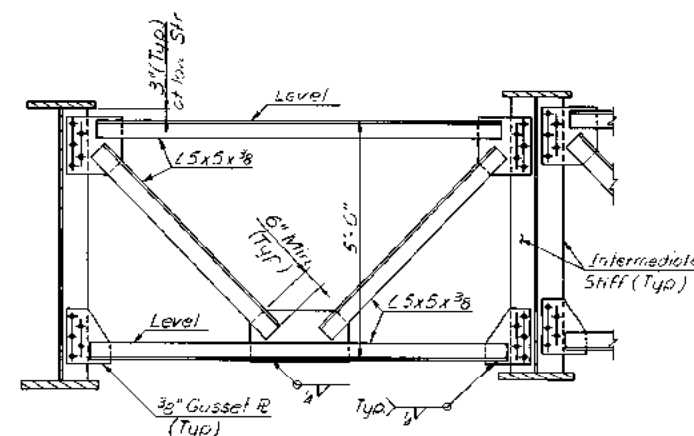


TYPICAL INTERMEDIATE DIAPHRAGM

Scale: 1/2" = 1'-0"

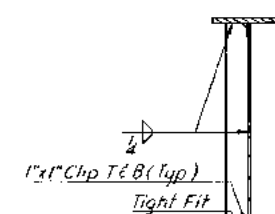


INTERMEDIATE STIFFENER DETAILS

Not to Scale

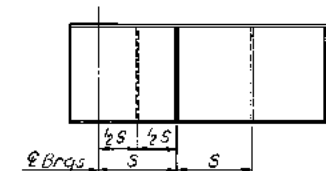


BEARING STIFFENER DETAIL

Not to Scale

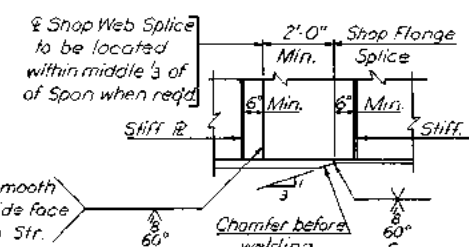


SHOP SPLICE DETAIL

Not to Scale

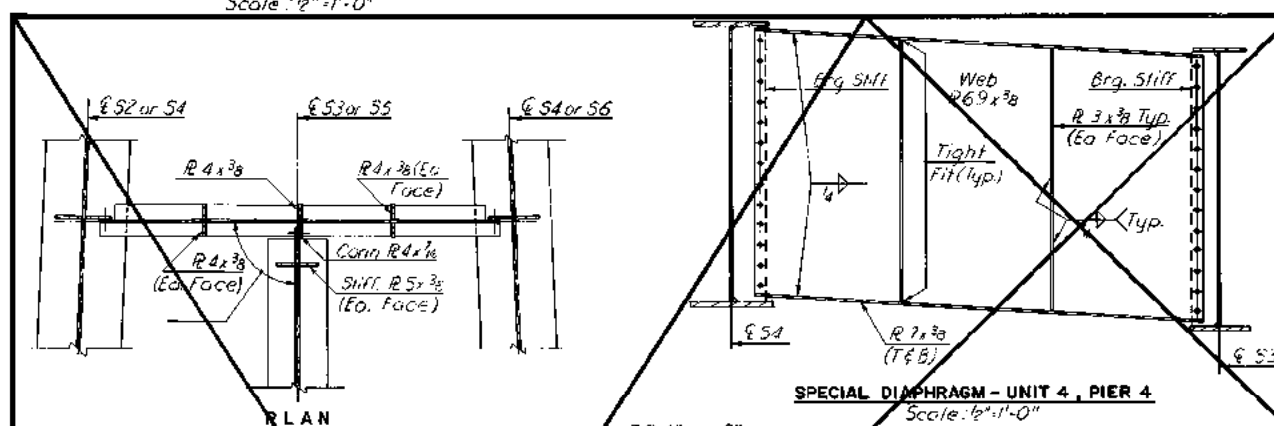


SPECIAL DIAPHRAGM - UNIT 4, PIER 4

Scale: 1/2" = 1'-0"

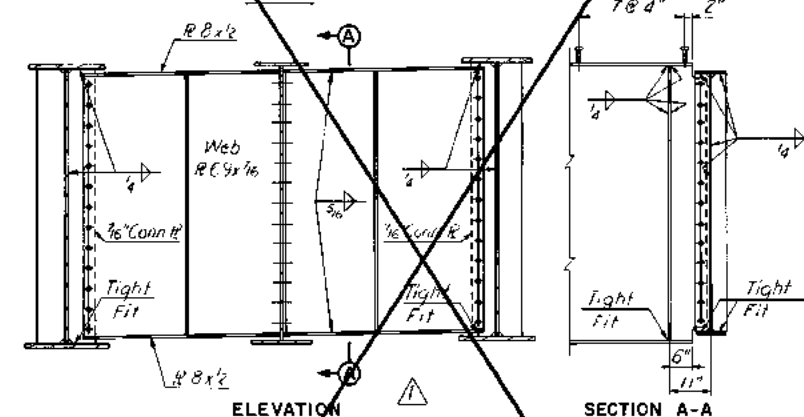

DETAILS OF DIAPHRAGM AT END OF STRINGER S3 & S5 - UNIT 4

Scale: 1/2" = 1'-0"

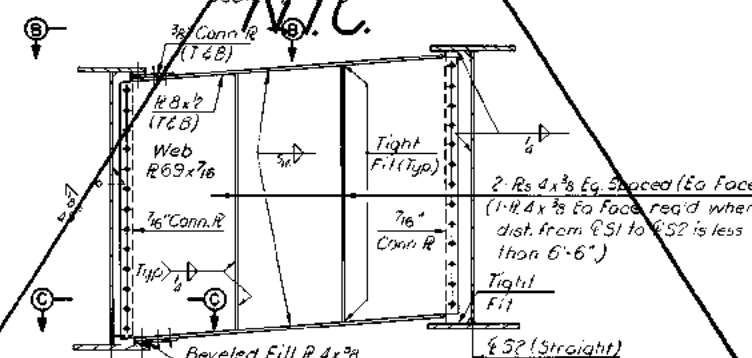

INTERMEDIATE DIAPHRAGM BETWEEN STRINGERS S1 & S2 - UNIT 4

Scale: 1/2" = 1'-0"

MADE	BY	DATE	NO.	REVISION	BY	DATE
MBW	7-67	2	AS BUILT	JRC	12-72	
FXH	8-67	1	Remove Ramp Framing	J.G.V.	2-70-71	
FXH						


RICHMOND METROPOLITAN AUTHORITY  
RICHMOND EXPRESSWAY SYSTEM

JAMES RIVER BRIDGE  
STRUCTURAL STEEL DETAILS


HOWARD, NELLES, JAMMEN & BERGENDOFF  
consulting engineers  
NEW YORK ALEXANDRIA KANSAS CITY

SCALE: AS SHOWN  
LION KALE INC. C-3  
SHEET NO. 33 OF 53


RICHMOND EXPRESSWAY SYSTEM			
SECTION	PROJECT	SHEET NO.	TOTAL SHEETS
3	JAMES RIVER BRIDGE	34	53

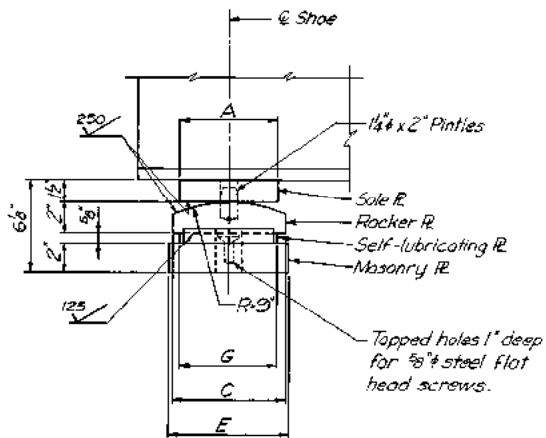


SIDE ELEVATION

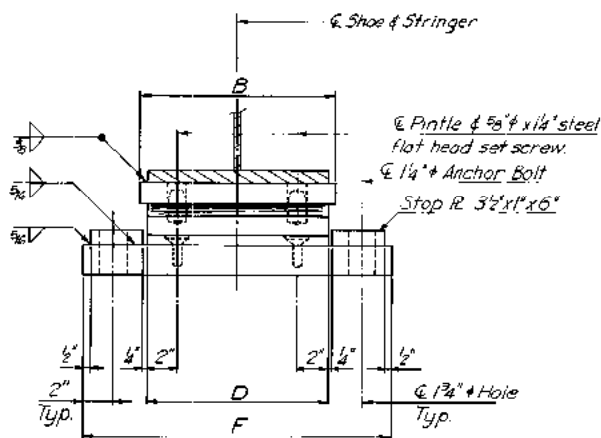

END ELEVATION

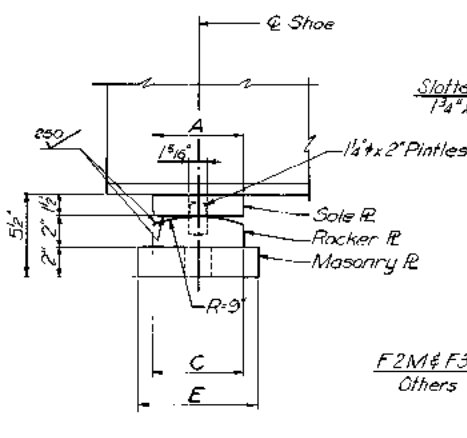


SIDE ELEVATION

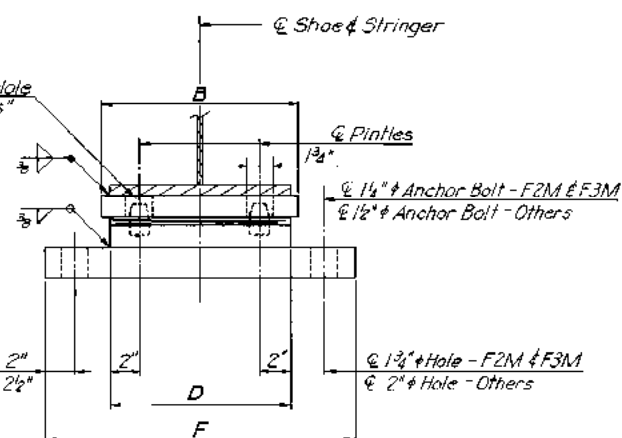


END ELEVATION

### EXPANSION SHOE

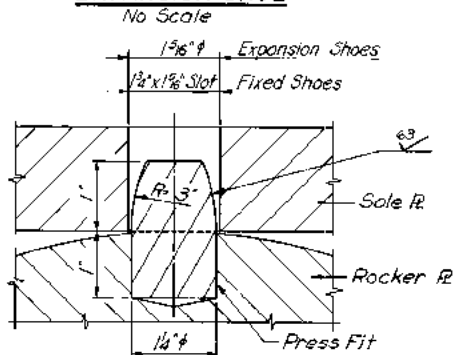

### PINTLE DETAIL

Scale: 3/4\"/>

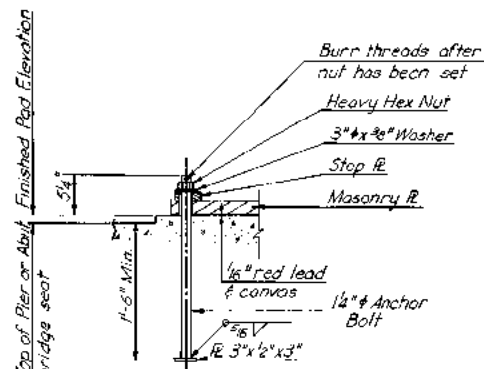


### EXPANSION SHOE

### ANCHOR BOLT DETAIL

No Scale

### FIXED SHOE

No Scale

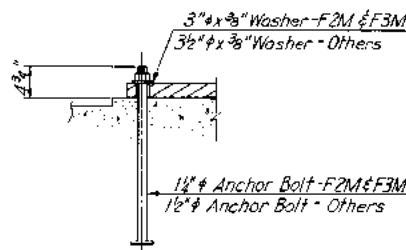

### FIXED SHOE

Note:

Anchor Bolt for Fixed Shoes same as Anchor Bolt for Exp Shoes except as shown.

### Shoe Notes:

Top of masonry plates, bottom of rocker plates and top and bottom of sole plates planed, straightened or otherwise treated to secure true level surfaces. Contact surfaces noted on the plans with finish symbols shall be finished in accordance with the American National Standards Institute surface roughness requirement, as defined in A5A B46.1 Surface Roughness, Waviness and Lay, Part I.

The plates comprising the expansion shoes shall be set so as to be truly centered under full dead load at a temperature of 68°F.

Concrete pads shall be formed integral with abutment or pier and not less than 6\"/>

Anchor bolt assemblies shall conform to A.S.T.M. A-307 and shall be hot-dip galvanized conforming to A.S.T.M. A-153.

Templates shall be used to accurately set the anchor bolts.

Material for shoes (exclusive of self-lubricating plates) shall be high strength low alloy structural steel conforming to A.S.T.M. Specification A-588.

Material for self-lubricating plates shall be Leaded Tin Bronze conforming to A.S.T.M. Specification B22, alloy D modified to the extent that 1.5 to 2.5 percent lead is allowable.

Shoes shall be included with structural steel item for payment.

SHOE DIMENSIONS														
EXPANSION SHOES	A	B	C	D	E	F	G	FIXED SHOES	A	B	C	D	E	F
E4	6"	1-3/4"	8"	1-1/4"	9 1/2"	2-1/4"	7"	F2M	6"	1'-5 1/2"	6"	1'-4 1/2"	7"	2'-1"
E5	6"	1-5/8"	9"	1'-4 1/8"	9 1/2"	2-1 1/8"	7"	F3M	6"	1'-5 1/8"	6"	1'-4 1/8"	8"	2'-1 1/4"
E6	6"	1-3/4"	8"	1-5/8"	9 1/2"	2-1 1/8"	6"	F4M	6"	1'-7"	6"	1'-6"	7"	2'-1 1/4"
E7	6"	1-7/8"	9 1/2"	1'-6"	10 1/2"	2-2 1/2"	7 1/2"	F5M	6"	1'-1"	6"	1'-6"	8"	2'-4"
E8	6"	1-7/8"	8"	1-2 3/8"	9 1/2"	2-1 1/8"	6 1/2"	F6M	6"	1'-9/8"	6"	1'-9/8"	7"	2'-3 1/2"
E9	6"	1'-9/8"	10"	1'-8"	11"	2-4 1/2"	7 1/2"	F7M	6"	1'-9"	6"	1'-8"	8"	2'-6"
E11	6"	1'-11/8"	10"	1'-10"	11 1/2"	2-6"	7 1/2"	F8M	6"	1'-11/8"	6"	1'-10"	8"	2'-8"
E12	6"	2-1/8"	8"	2-7/8"	9 1/2"	2-1 1/4"	6 1/2"	F9M	6"	2-1/8"	6"	2-7/8"	7"	2'-10"
E14	6"	2-1/8"	1'-0"	2-9/8"	1'-1"	2-1 1/4"	2-1/2"							

BY	DATE				
MADE	HBW	5-67	2 AS BUILT	JRC	12-72
CHECKED	FXH	8-67	Delete Shoes	HBW	2/20/77
IN CHARGE	FXH		NO. REVISION	BY	DATE

### RICHMOND METROPOLITAN AUTHORITY RICHMOND EXPRESSWAY SYSTEM

### JAMES RIVER BRIDGE SHOES

HOWARD, NEEDLES, TAMMEN & BERGENDORFF  
consulting engineers  
NEW YORK ALEXANDRIA KANSAS CITY


SCALE: AS SHOWN  
CONTRACT NO.: C-3  
SHEET NO. 34 of 53








RICHMOND EXPRESSWAY SYSTEM			
SECTION	PROJECT	SHEET NO.	TOTAL SHEETS
3	JAMES RIVER BRIDGE	39	53

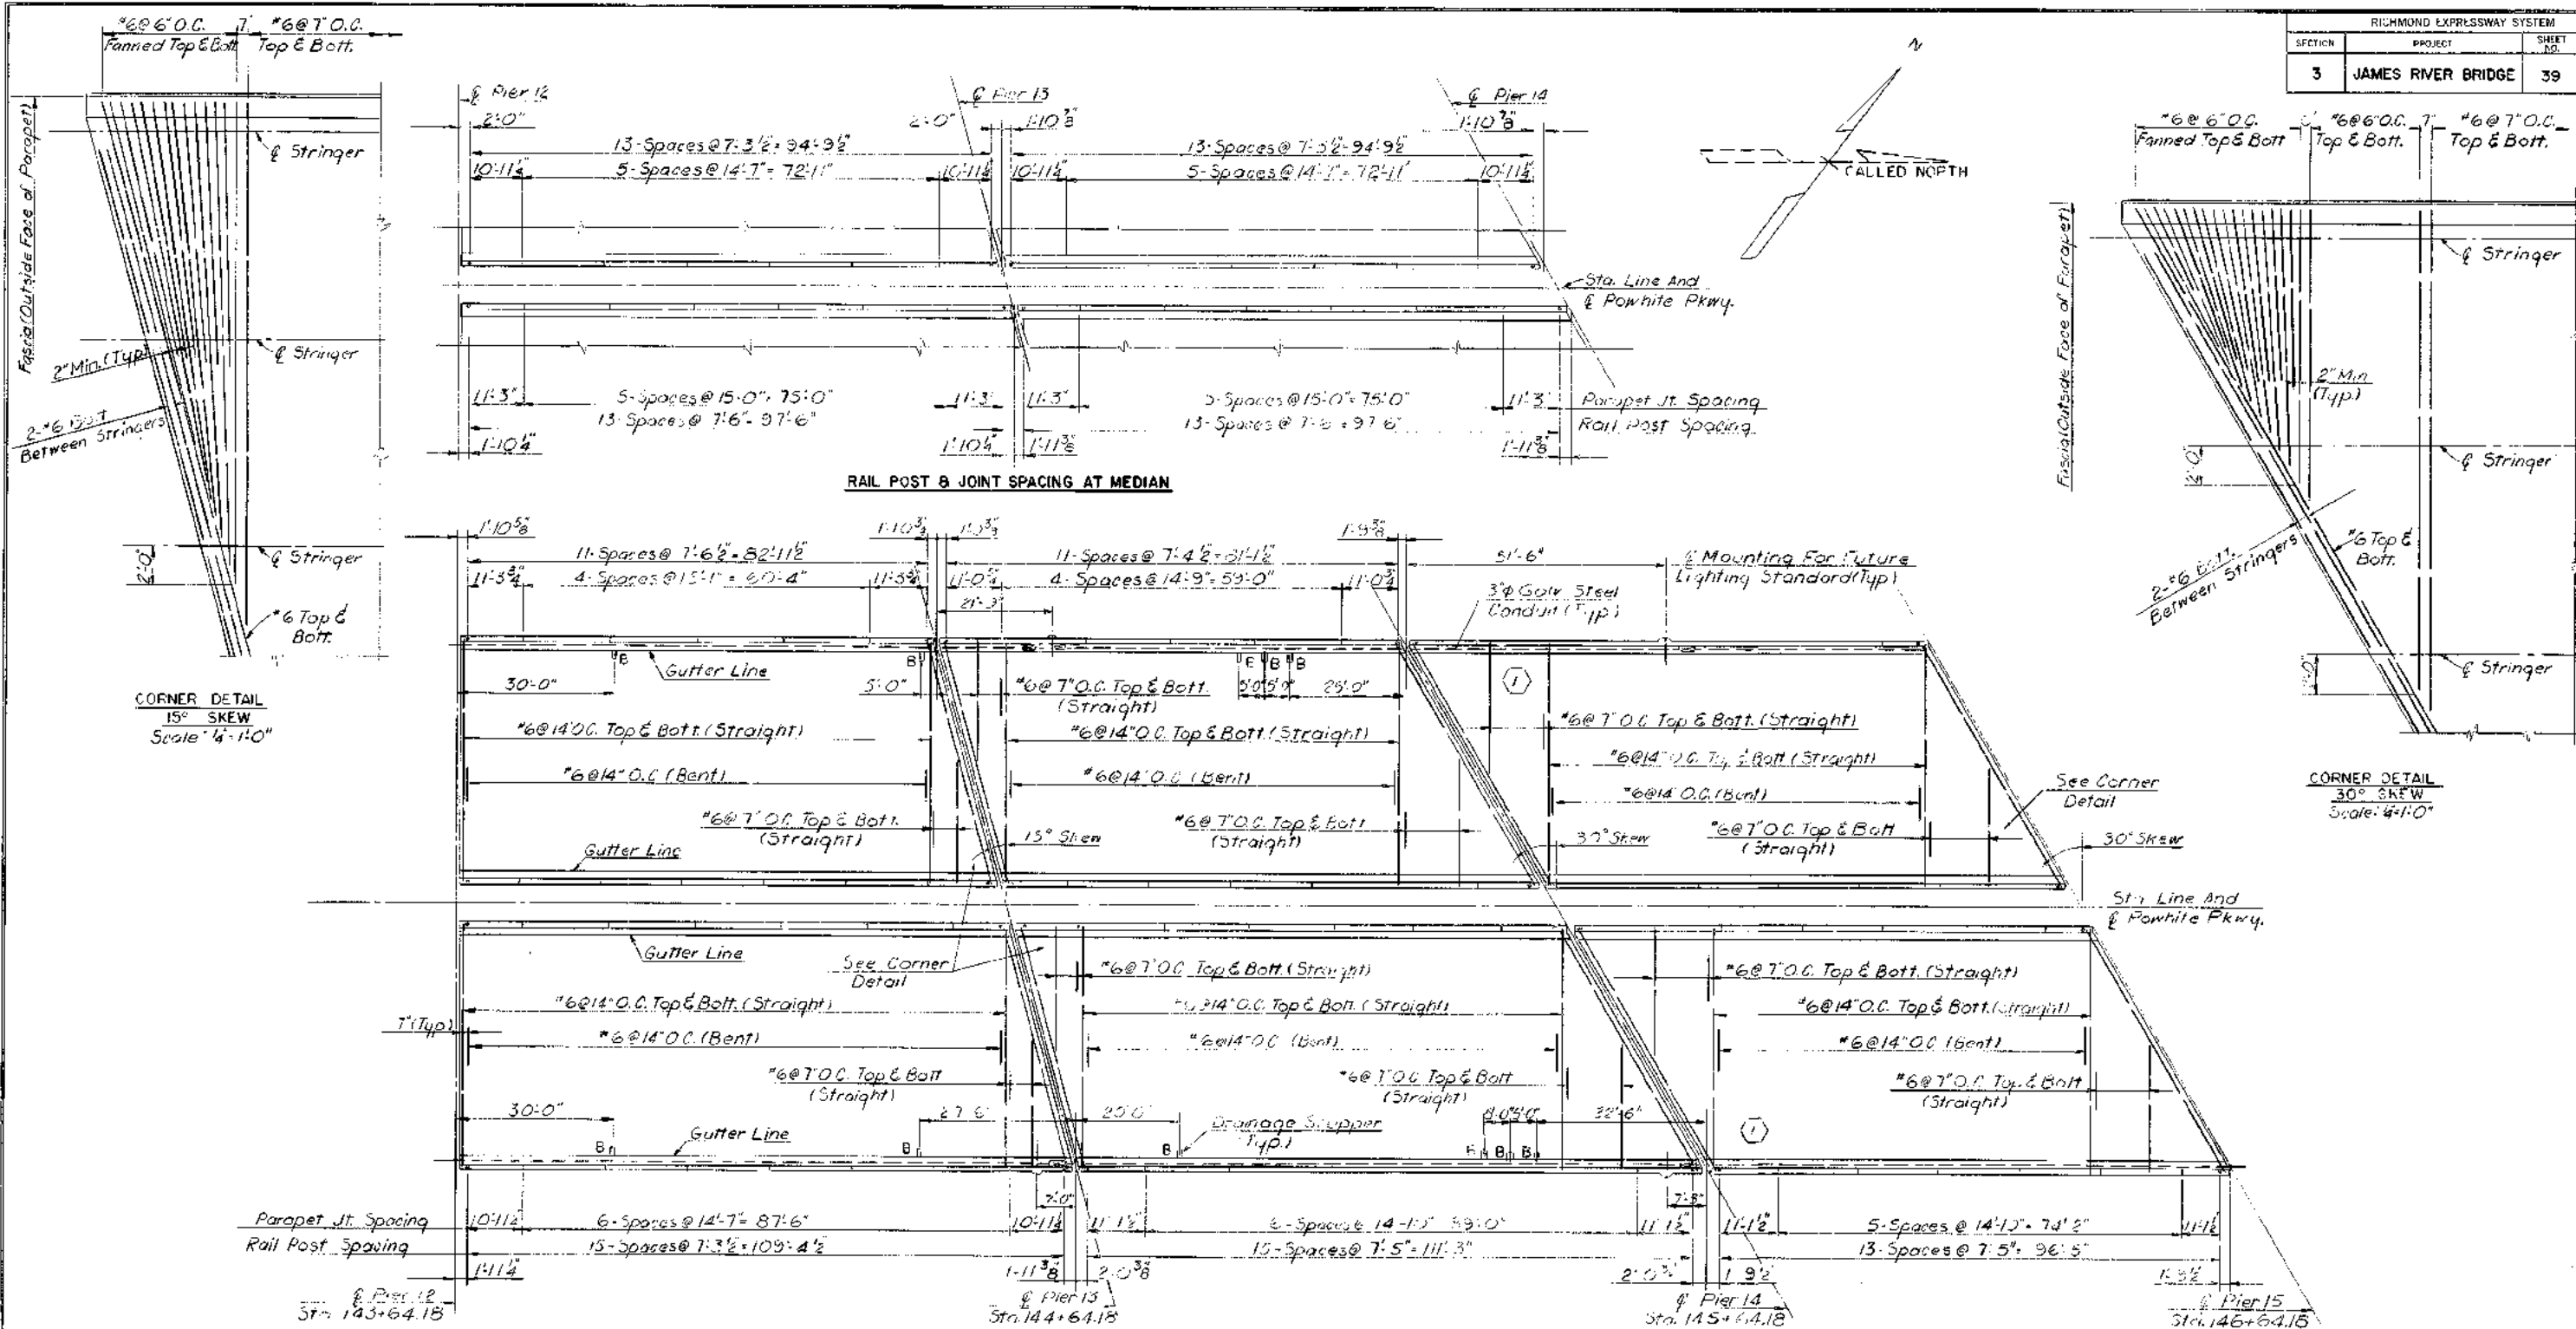

CORNER DETAIL  
15° SKEW  
Scale: 1/4" = 1'-0"

CORNER DETAIL  
30° SKEW  
Scale: 1/4" = 1'-0"

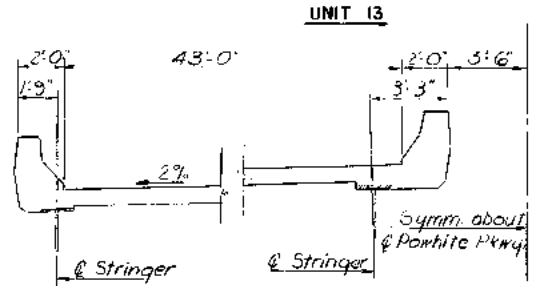

TYPICAL SECTION  
LOOKING NORTH  
NO SCALE

Notes:  
For Notes See Sheet No. 37


BY	DATE	NO.	REV	BY	DATE
WADL	DEK. 7-67	2	AS BUILT	JRC	12-72
CHECKED	H.B.W. 9-67	1	Light Std. & Supper Location	J.G.V.	3/9/71
IN CHARGE	F.X.H.				

RICHMOND METROPOLITAN AUTHORITY  
RICHMOND EXPRESSWAY SYSTEM

JAMES RIVER BRIDGE  
DECK PLAN - UNITS 13, 14 & 15


HOWARD, NEEDLES, TAMMEN & BERGENDOFF consulting engineers NEW YORK ALEXANDRIA KANSAS CITY		SCALE: 1/4" = 1'-0" UNLESS NOTED CONTRACT NO.: 5-72 SHEET NO. 39 OF 53
---	--	--

RICHMOND EXPRESSWAY SYSTEM			
SECTION	PROJECT	SHEET NO.	TOTAL SHEETS
3	JAMES RIVER BRIDGE	40	53

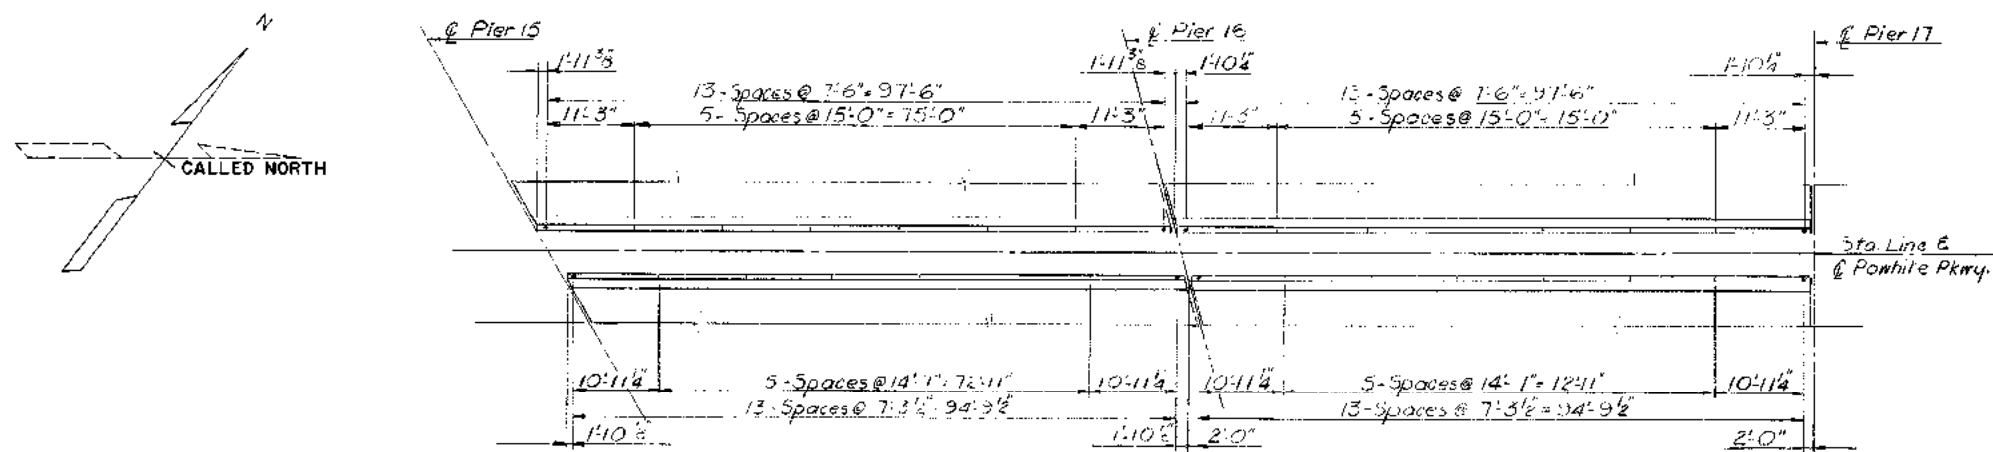


RAIL POST & JOINT SPACING AT MEDIAN


TYPICAL SECTION  
SCALE: 1/4" = 1'-0"

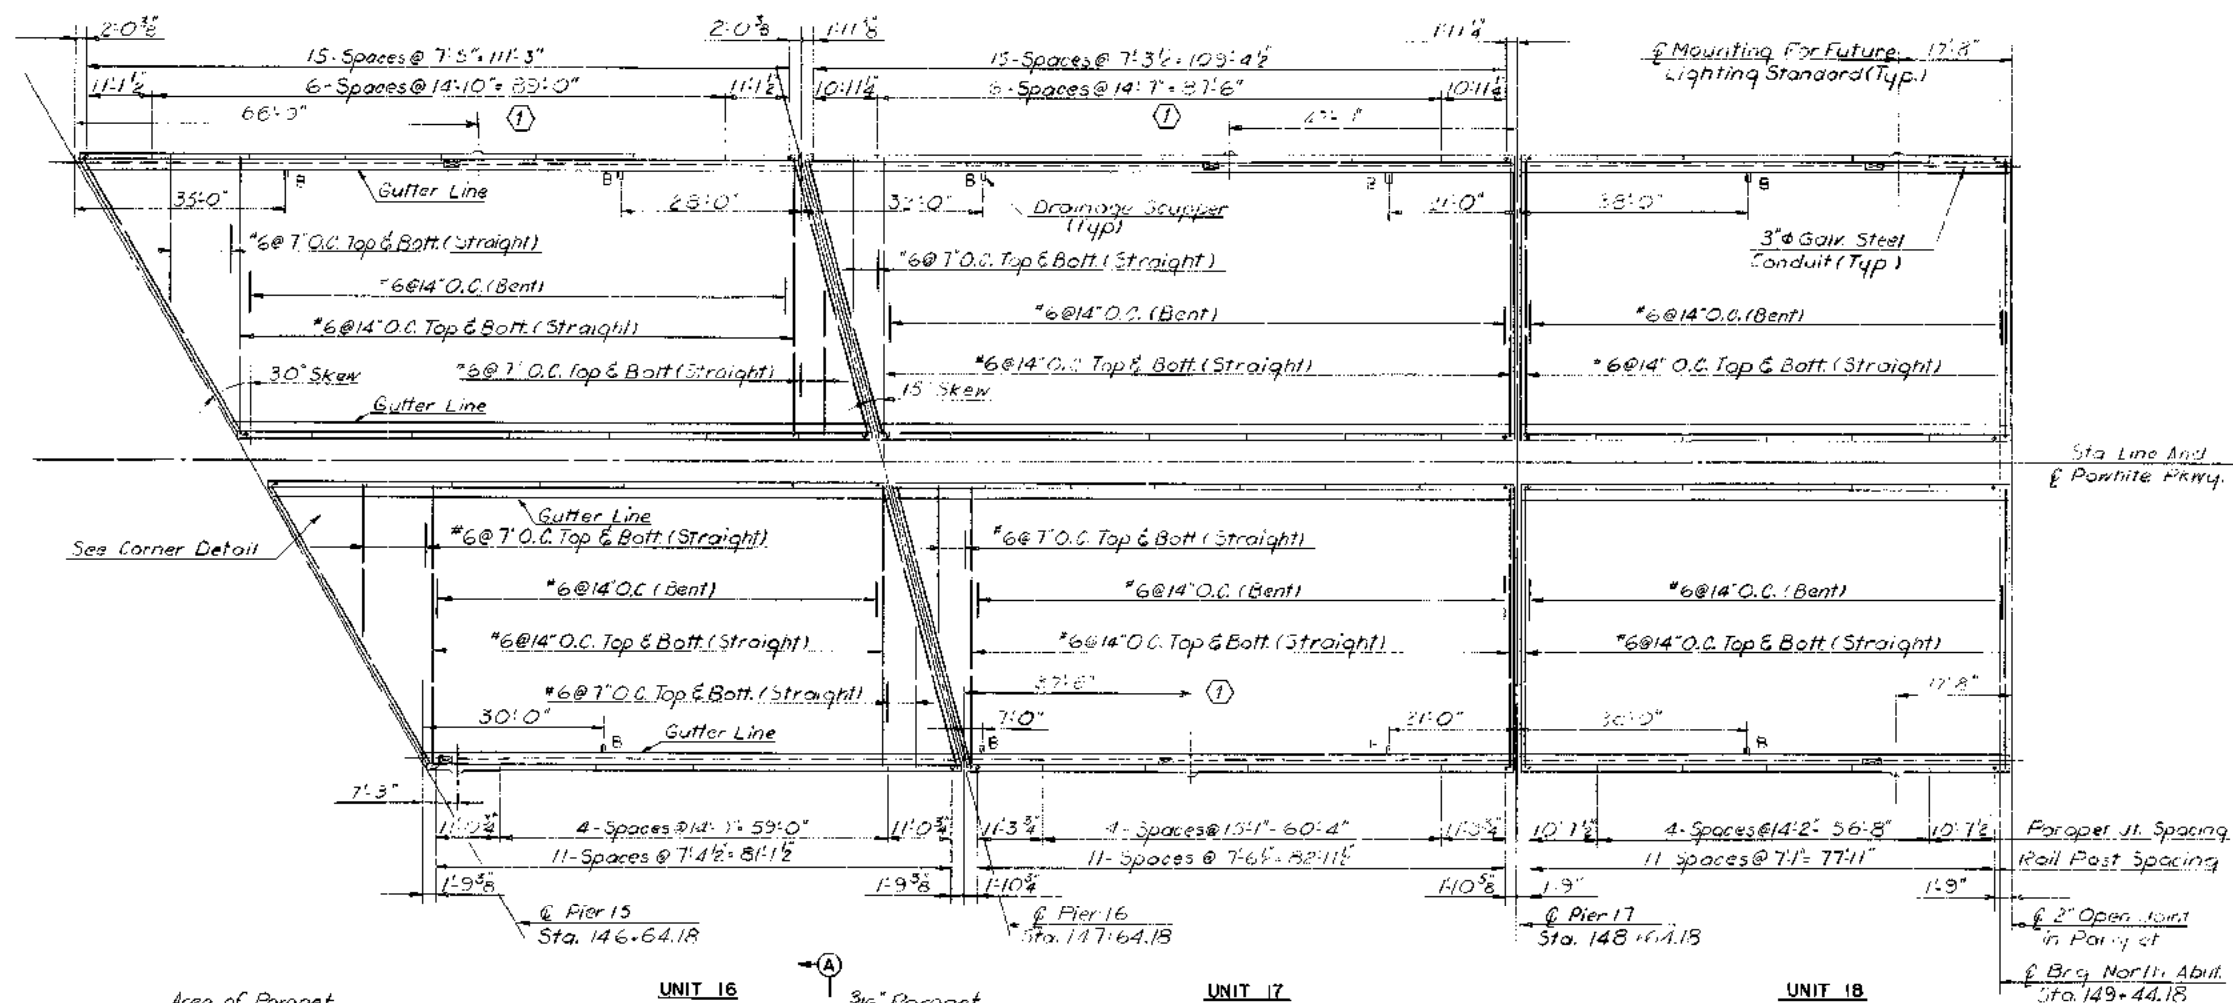

See Corner Detail

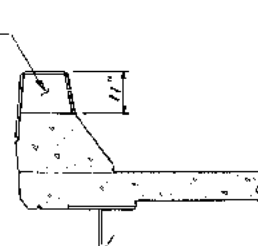


SECTION A-A  
Scale: 1/2" = 1'-0"

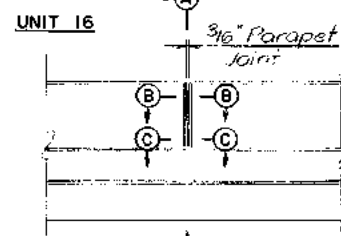


ELEVATION  
Scale: 1/2" = 1'-0"

PARAPET JOINT DETAILS

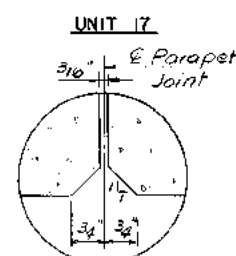

SECTION B-B  
Half Size

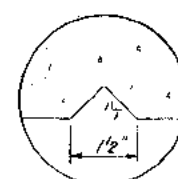

SECTION C-C  
Half Size

Notes:  
For Notes See Sheet No. 37  
For Corner Details See Sheet No. 39


RICHMOND METROPOLITAN AUTHORITY  
RICHMOND EXPRESSWAY SYSTEM

JAMES RIVER BRIDGE  
DECK PLAN - UNITS 16, 17 & 18


HOWARD, NEEDLES, TAMMEN & BERGENDOFF  
consulting engineers  
NEW YORK ALEXANDRIA KANSAS CITY  
SCALE: 1/32" UNLESS NOTED  
CONTRACT NO.: 5-3  
SHEET NO. 40 OF 53

BY	DATE	NO.	REVISION	BY	DATE
MADE	DEK. 7-67	2	AS BUILT	JRC	12-72
CHECKED	H.B.W. 9-67	1	Light Sta. Location	H.B.W.	3/9/71
IN CHARGE	E.X.H.				

RICHMOND EXPRESSWAY SYSTEM			
SECTION	PROJECT	SHEET NO.	TOTAL SHEETS
3	JAMES RIVER BRIDGE	41	53

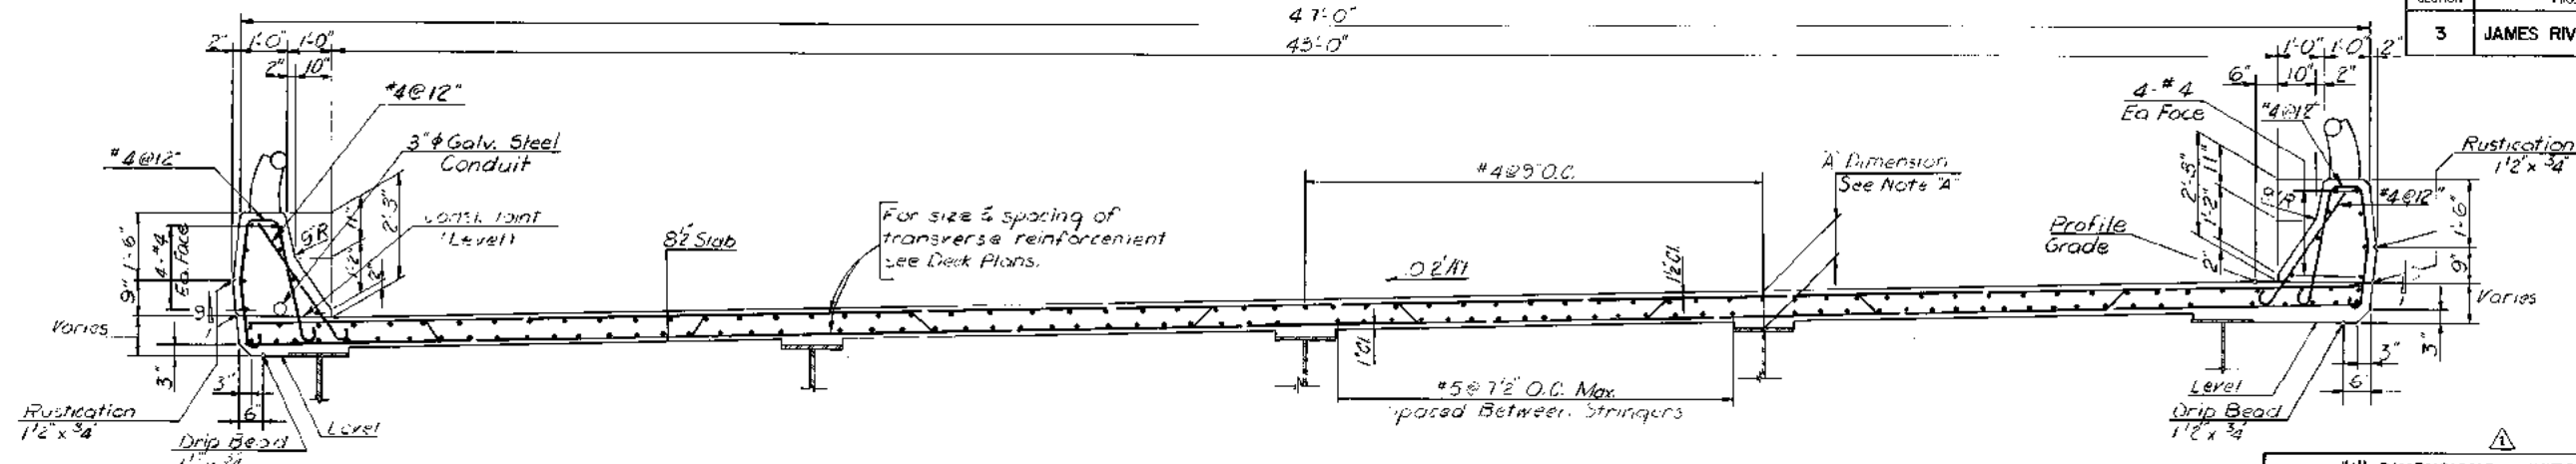


TYPICAL CROSS SECTION S.B. (N.B. OPPOSITE HAND)  
SCALE: 1/2\"/>

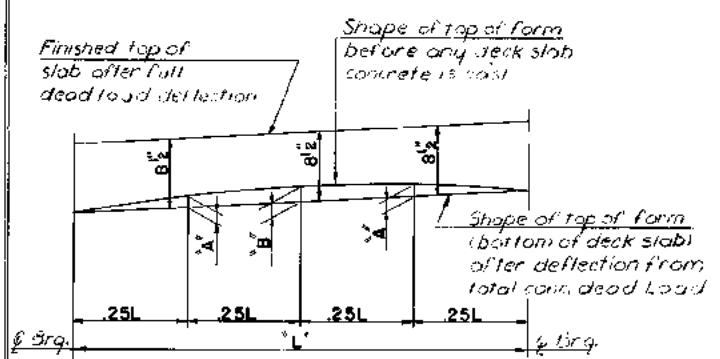

DEAD LOAD DEFLECTION DIAGRAM  
NO SCALE

NOTE TO CONTRACTOR

The deflection of the stringer upon placement of the first concrete deck slab in practice the stringers, in place, are not likely to have the exact camber to compensate for these deflections during construction. The residual amounts shall be provided for by adjusting forms to vary the thickness of the concrete 1/4\"/>

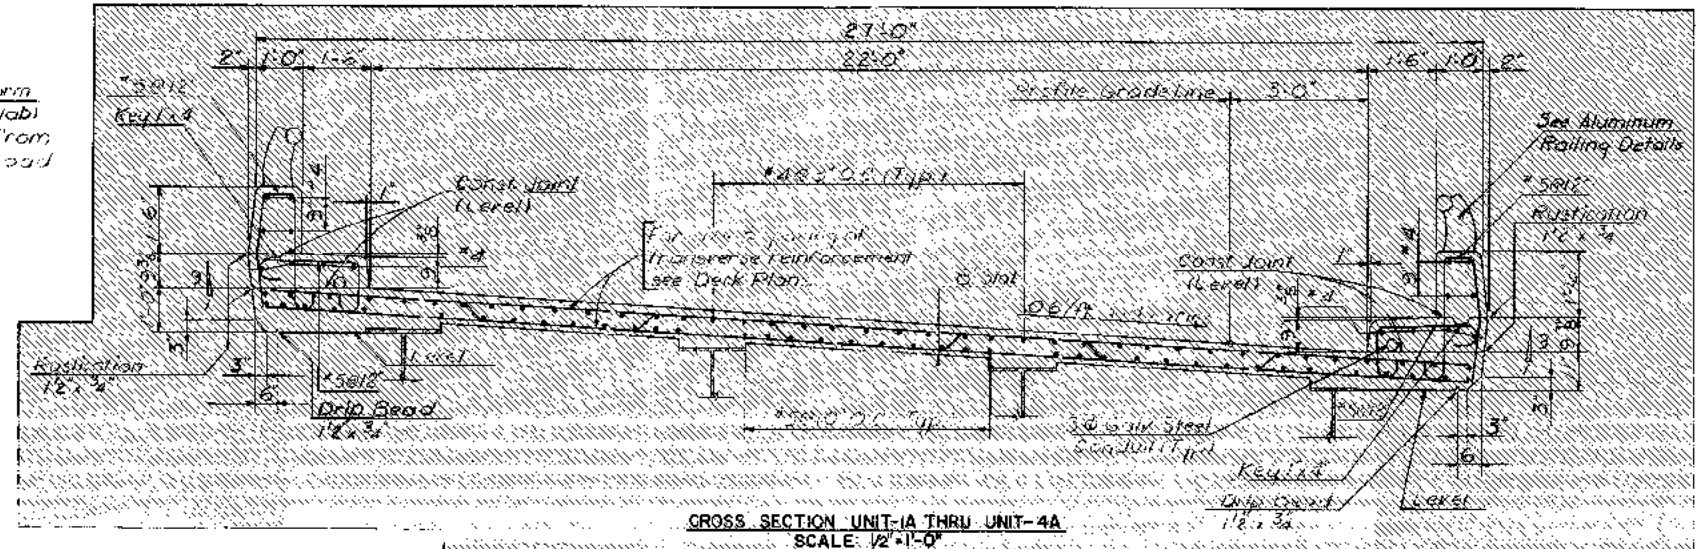

CROSS SECTION UNIT 1A THRU UNIT 4A  
SCALE: 1/2\"/>


"A" DIMENSIONS— UNITS 1 THRU 18			
UNIT 1		UNIT 7	
S5 & S6	10 3/8	S5 & S6	10 3/8
S1-S4 & S7-S10	9 3/4	S2-S4 & S7-S9	10 1/4
UNIT 2 & 3		S5 & S6	10 1/8
S5 & S6	10 1/4	S1 & S10	10 1/2
S1-S4 & S7-S10	9 3/4	UNIT 8 THRU 12	
UNIT 4		S2-S4 & S7-S9	10 1/4
SHAT PIER 3	10 1/2	S5 & S6	10 1/8
SHAT PIER 4	10 1/8	S1 & S10	10 1/2
S5	11	UNIT 13 & 14	
S6	10 1/2	S1	10 3/8
S7	10 1/2	S2, S3, S4 & S7	9 3/4
S8	9 3/4	S5 & S6	10 1/4
S9	10 1/2	S8 & S9	10 1/2
S1-S10	10 1/8	S10	10 1/2
UNIT 5		UNIT 15	
S1	10 1/8	S2-S4 & S7-S9	9 3/4
S2	9 3/4	S5 & S6	10 1/4
S3	9 3/4	S1 & S10	10 1/2
S4 & S6	10 1/8	UNIT 16 & 17	
S2-S4 & S7-S9	10 1/4	S1	10 1/2
S1 & S10	10 1/2	S2 & S3	10 1/2
UNIT 6		S4, S7, S8 & S9	9 3/4
S5 & S6	10 1/8	S5 & S6	10 1/4
S2-S4 & S7-S9	10 1/4	S10	10 1/2
S1 & S10	10 1/2	UNIT 18	
		S2-S4 & S7-S9	9 3/4
		S5 & S6	10 1/2
		S1 & S10	10 1/2

"A" DIMENSIONS— UNITS 1A THRU 4A			
UNIT 1A		UNIT 4A	
S1, S2 & S3	9 3/4	S1 (AT PIER 3A)	9 3/4
S4	10	S1 (AT PIER 3)	10 1/4
UNIT 2A & 3A		S2 & S3	9 3/4
S1, S2 & S3	9 3/4	S4	10
S4	9 3/4		


Note "A"

"A" Dimension is given at the intersection of the @ Stringer and @ Bearing. Dimension shown is measured from top of top flange to construction joint for Fascia Stringers with 1'9\"/>


DEFLECTION SCHEDULE											
UNIT	STRINGER	A	B	UNIT	STRINGER	A	B	UNIT	STRINGER	A	B
1	SI-S10	5 3/8	7 3/8	7-12	SI-S10	1 5/8	2 1/4		S1	1 3/8	2"
2	SI-S10	1 1/8	1 1/2		S1	3/4	1"		S2	1 3/8	1 3/8
	SI-S10	1 1/8	1 1/2		S2	7/8	1 1/8		S3	1 1/4	1 3/4
3	SI-S10	1 1/8	1 1/2		S3	7/8	1 1/4		S4	1 1/4	1 5/8
	SI-S10	1 1/8	1 1/2		S4	1"	1 3/8		S5	1 1/8	1 5/8
	SI-S10	1 1/8	1 1/2		S5	1"	1 1/2		S6	1"	1 1/2
4	SI-S10	1 1/8	1 1/2		S6	1 1/8	1 5/8		S7	1"	1 1/2
	SI-S10	1 1/8	1 1/2		S7	1 1/4	1 5/8		S8	7/8	1 1/4
	SI-S10	1 1/8	1 1/2		S8	1 1/4	1 3/4		S9	7/8	1 1/8
	SI-S10	1 1/8	1 1/2		S9	1 3/8	1 7/8		S10	3/4	1"
5	SI-S10	1 5/8	2 1/4		S10	1 3/8	2"	18	SI-S10	5/8	7/8
6	SI-S10	1 3/8	2 1/4	15	SI-S10	1 1/8	1 1/2				

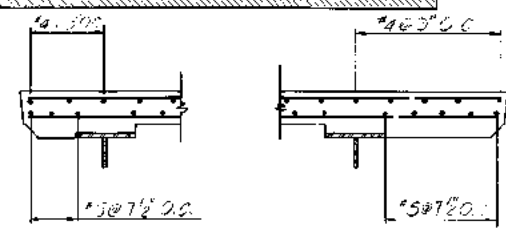

LONGITUDINAL REINFORCEMENT AT FASCIA

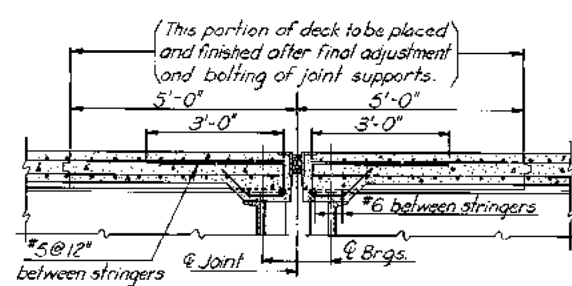

TYPICAL SECTION AT JOINT

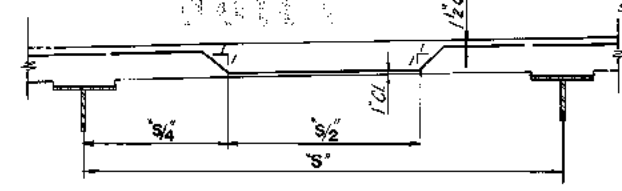

TYPICAL BENT BAR DETAIL

Notes:  
For Notes see Sheet No. 37.  
All Bar clearances to conc. face are 2\"/>

RY	DATE	BY	DATE
MADE	DEK. 7-67	2	AS BUILT
CHECKED	H.B.W. 9-67	Δ	K-Sections & Deflections
IN CHARGE	F.X.H.	NO.	REVISION
		BY	DATE
		JRC	12-72
		EP	2/20/71

RICHMOND METROPOLITAN AUTHORITY  
RICHMOND EXPRESSWAY SYSTEM

JAMES RIVER BRIDGE  
DECK DETAILS

HOWARD, NEEDLES, TAMMEN & BERGENDOFF  
consulting engineers  
NEW YORK ALEXANDRIA KANSAS CITY  
SCALE: 2 1/2\"/>



# **Bridge 8**

**Northbound and Southbound Powhite Parkway (VA-76) Parallel Bridges  
Over  
The James River, Kanawha Canal and CSXT Railroad Tracks**

**Widening Construction Plans for Bridge 8N and 8S**

**Record Set Plans**




**REVISED BY..**


**DESIGNED BY...**

## INDEX OF SHEETS

SHEET NO.	TITLE
1	COVER SHEET
2-3	GENERAL PLAN AND ELEVATION
4	GENERAL NOTES AND ESTIMATED QUANTITIES
5-7	SOUTH ABUTMENT DETAILS
8-10	NORTH ABUTMENT DETAILS
11	FLARED TERMINAL WALL DETAILS
12-28	PIER DETAILS
29	MISCELLANEOUS SUBSTRUCTURE DETAILS
30-44	FRAMING PLANS
45	STEEL DETAILS
46	SHOE DETAILS
47	CAMBER DIAGRAMS AND SCHEDULE
48-49	DECK SLAB ELEVATIONS
50	TYPICAL CROSS SECTION AND PARAPET DETAILS
51-65	DECK PLANS
66-67	LIGHTING STANDARD AND ELECTRICAL DETAILS
68	DEAD LOAD DEFLECTION DIAGRAM AND SCHEDULE
69	JOINT DETAILS
70	DRAIN ASSEMBLY DETAILS
71	ALUMINUM RAILING DETAILS
72-89	BAR LIST
90	BAR BENDS
91	SLOPE PROTECTION
92	APPROACH SLAB DETAILS
93-99	BORING LOGS
100	CONSTRUCTION SEQUENCE AND METHOD
101	MAINTENANCE AND PROTECTION OF TRAFFIC
102	PARTIAL EMBANKMENT PLAN
103	TYPICAL ROADWAY SECTION
104-105	EMBANKMENT CROSS SECTION
106	EROSION CONTROL

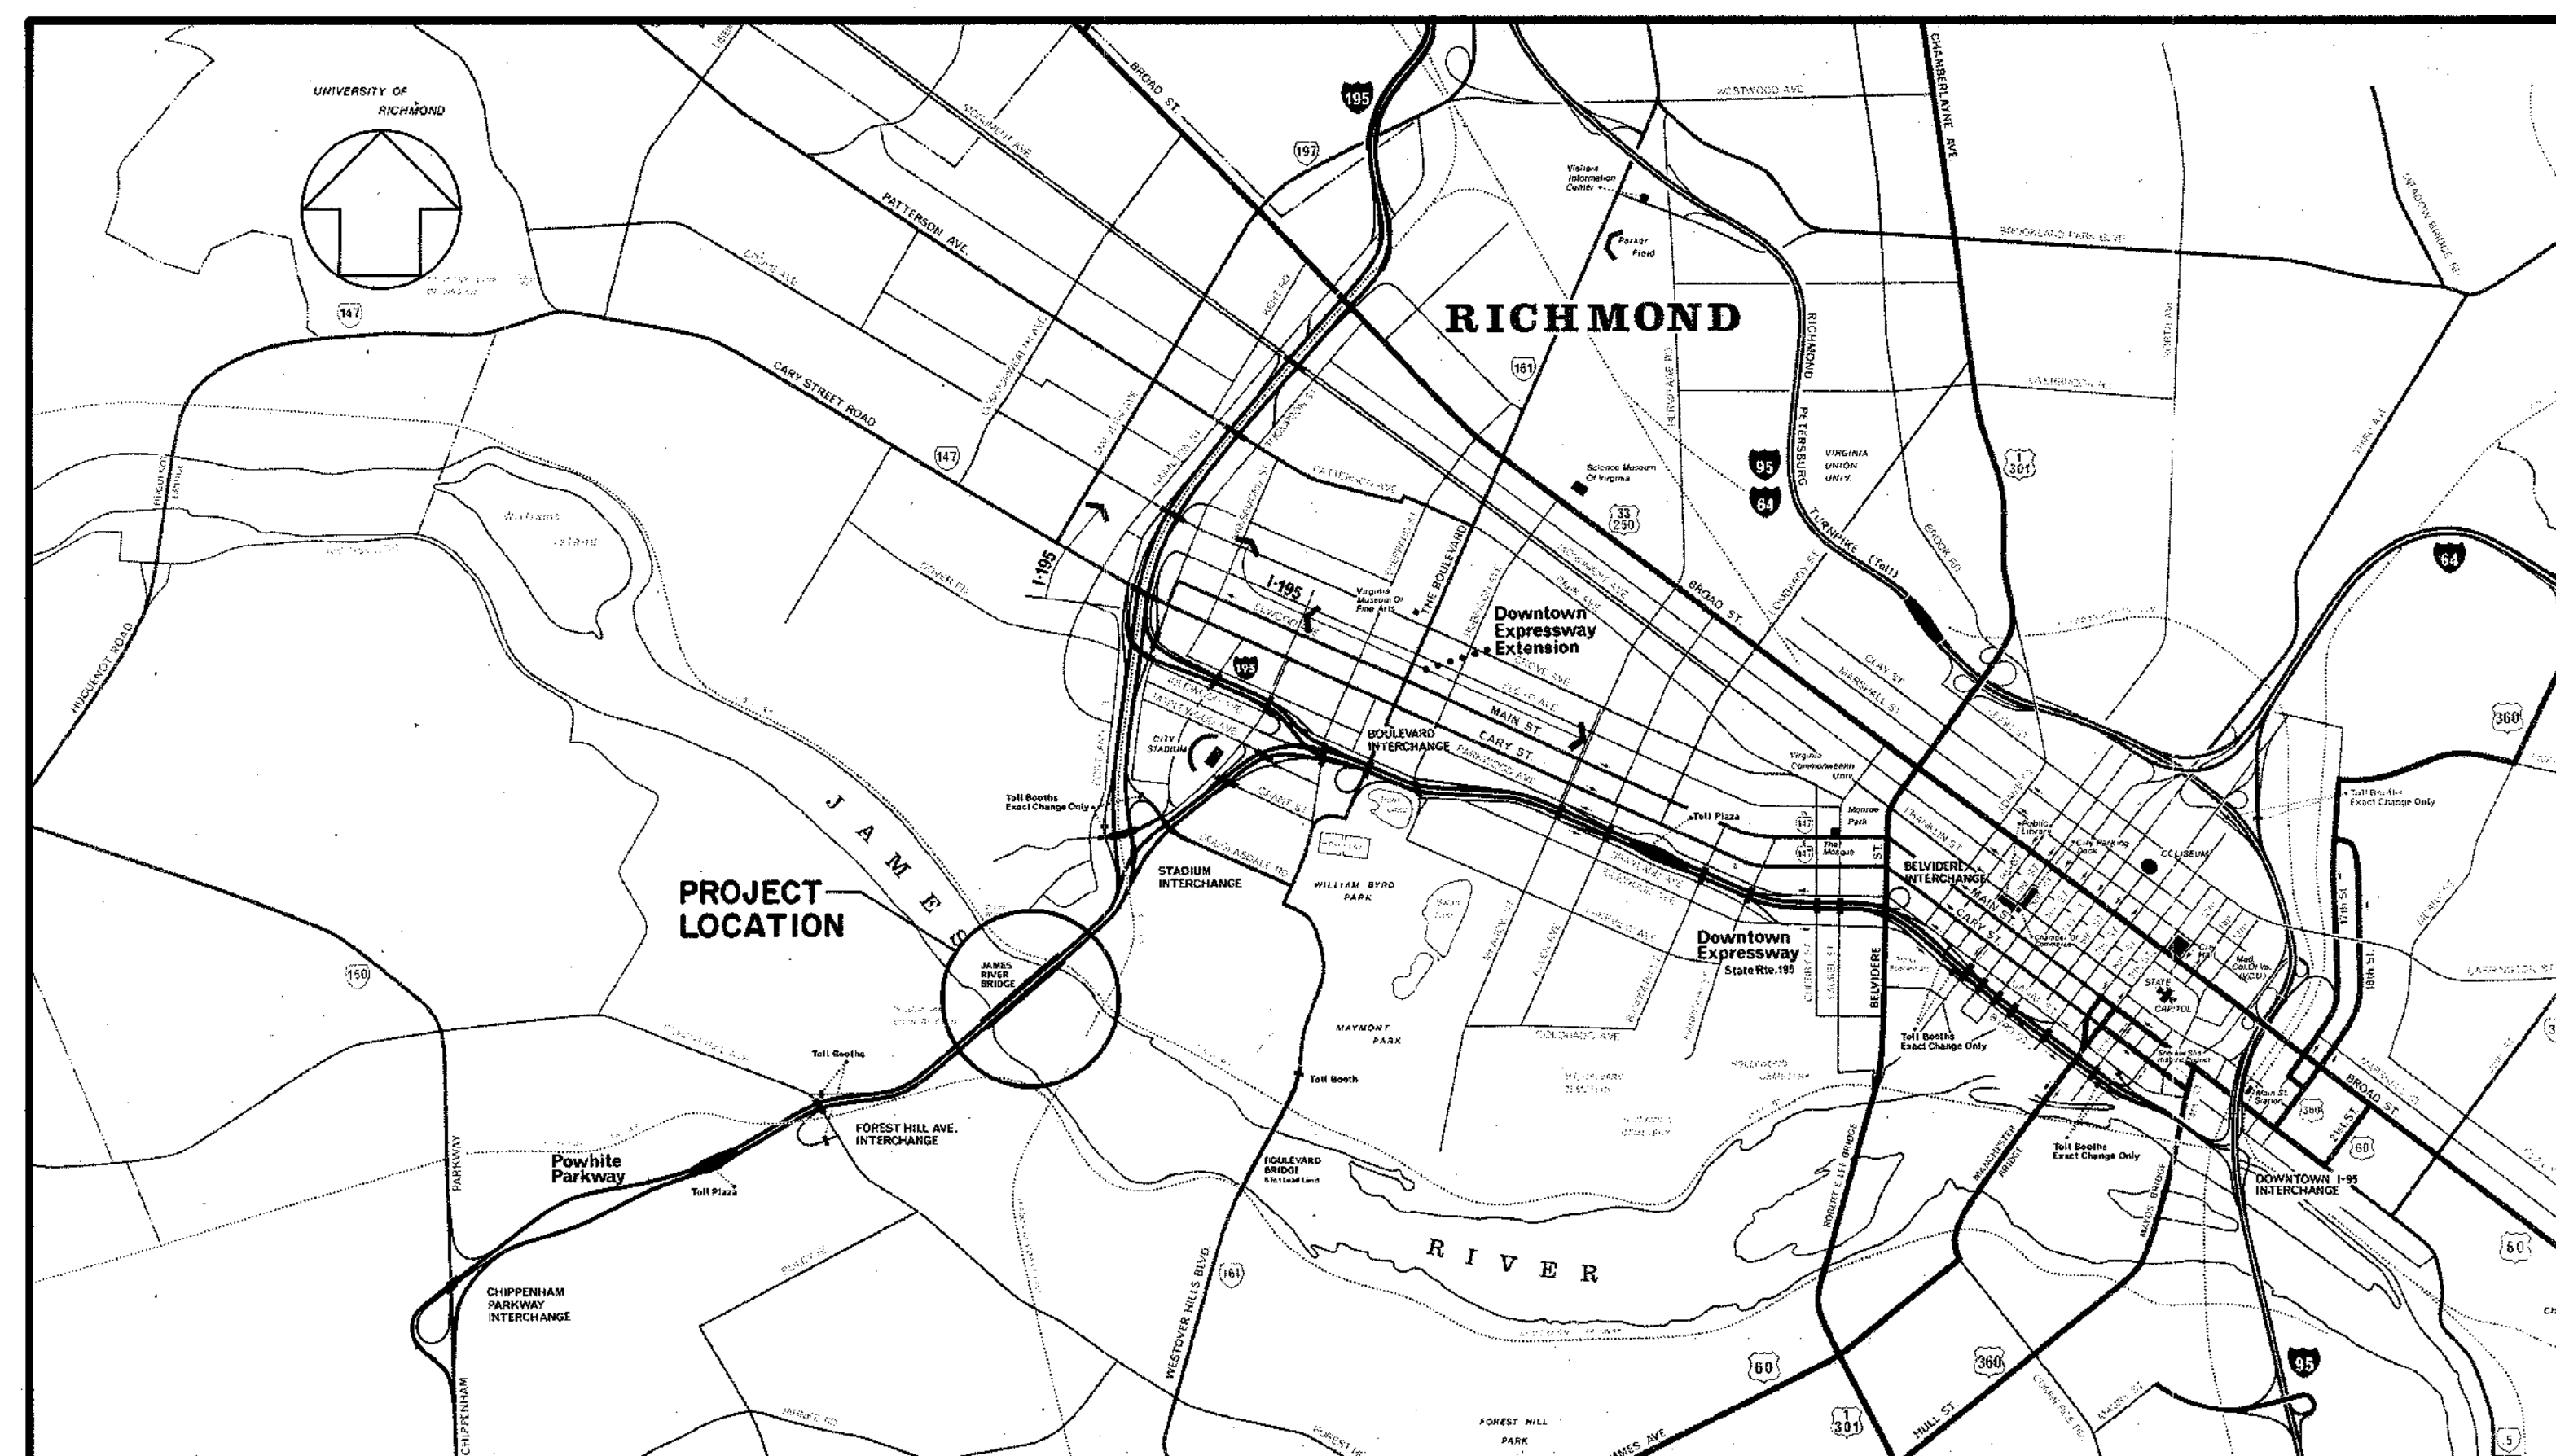

## CONVENTIONAL SIGNS

STATE LINE	=====	LEVEE OR EMBANKMENT	=====
COUNTY LINE	=====	BRIDGES	=====
CITY, TOWN OR VILLAGE	=====	CULVERTS	=====
RIGHT OF WAY LINE	=====	DROP INLET	=====
FENCE LINE	=====	TROLLEY POLES	=====
UNFENCED PROPERTY LINE	=====	POWER POLES	=====
FENCED PROPERTY LINE	=====	TELEPHONE OR TELEGRAPH POLES	=====
TRAVELED WAY	=====	MARSH	=====
GUARD RAIL	=====	HEDGE	=====
RETAINING WALL	=====	WOODS	=====
RAILROADS	=====	GROUND ELEVATION	=====
BASE OR SURVEY LINE	=====	GRADE ELEVATION	=====
		POLES WITHIN CONSTRUCTION LIMITS	=====

# CONTRACT C-13

AS BUILT



## LIMITED ACCESS HIGHWAY.

RICHMOND EXPRESSWAY SYSTEM			
SECTION	PROJECT	SHEET NO.	TOTAL SHEET
13	WIDENING JAMES RIVER BRIDGE	1	106

## SUBMITTED BY

Date	
3-16-81	
Date	HOWARD, NEEDLES, TAMMEN & BERGENDORF

## RECOMMENDED BY

	RECOMMENDED BY
Date	
3-29-82	
Date	GENERAL MANAGER, RICHMOND METROPOLITAN AUTHORITY


APPROVED BY

3-29-87	CHAIRMAN, RICHMOND METROPOLITAN AUTHORITY
Date	


## Plans Revised

[illegible]

RICHMOND EXPRESSWAY SYSTEM			
SECTION	PROJECT	SHEET NO.	TOTAL SHEETS
13	WIDENING JAMES RIVER BRIDGE	2	106

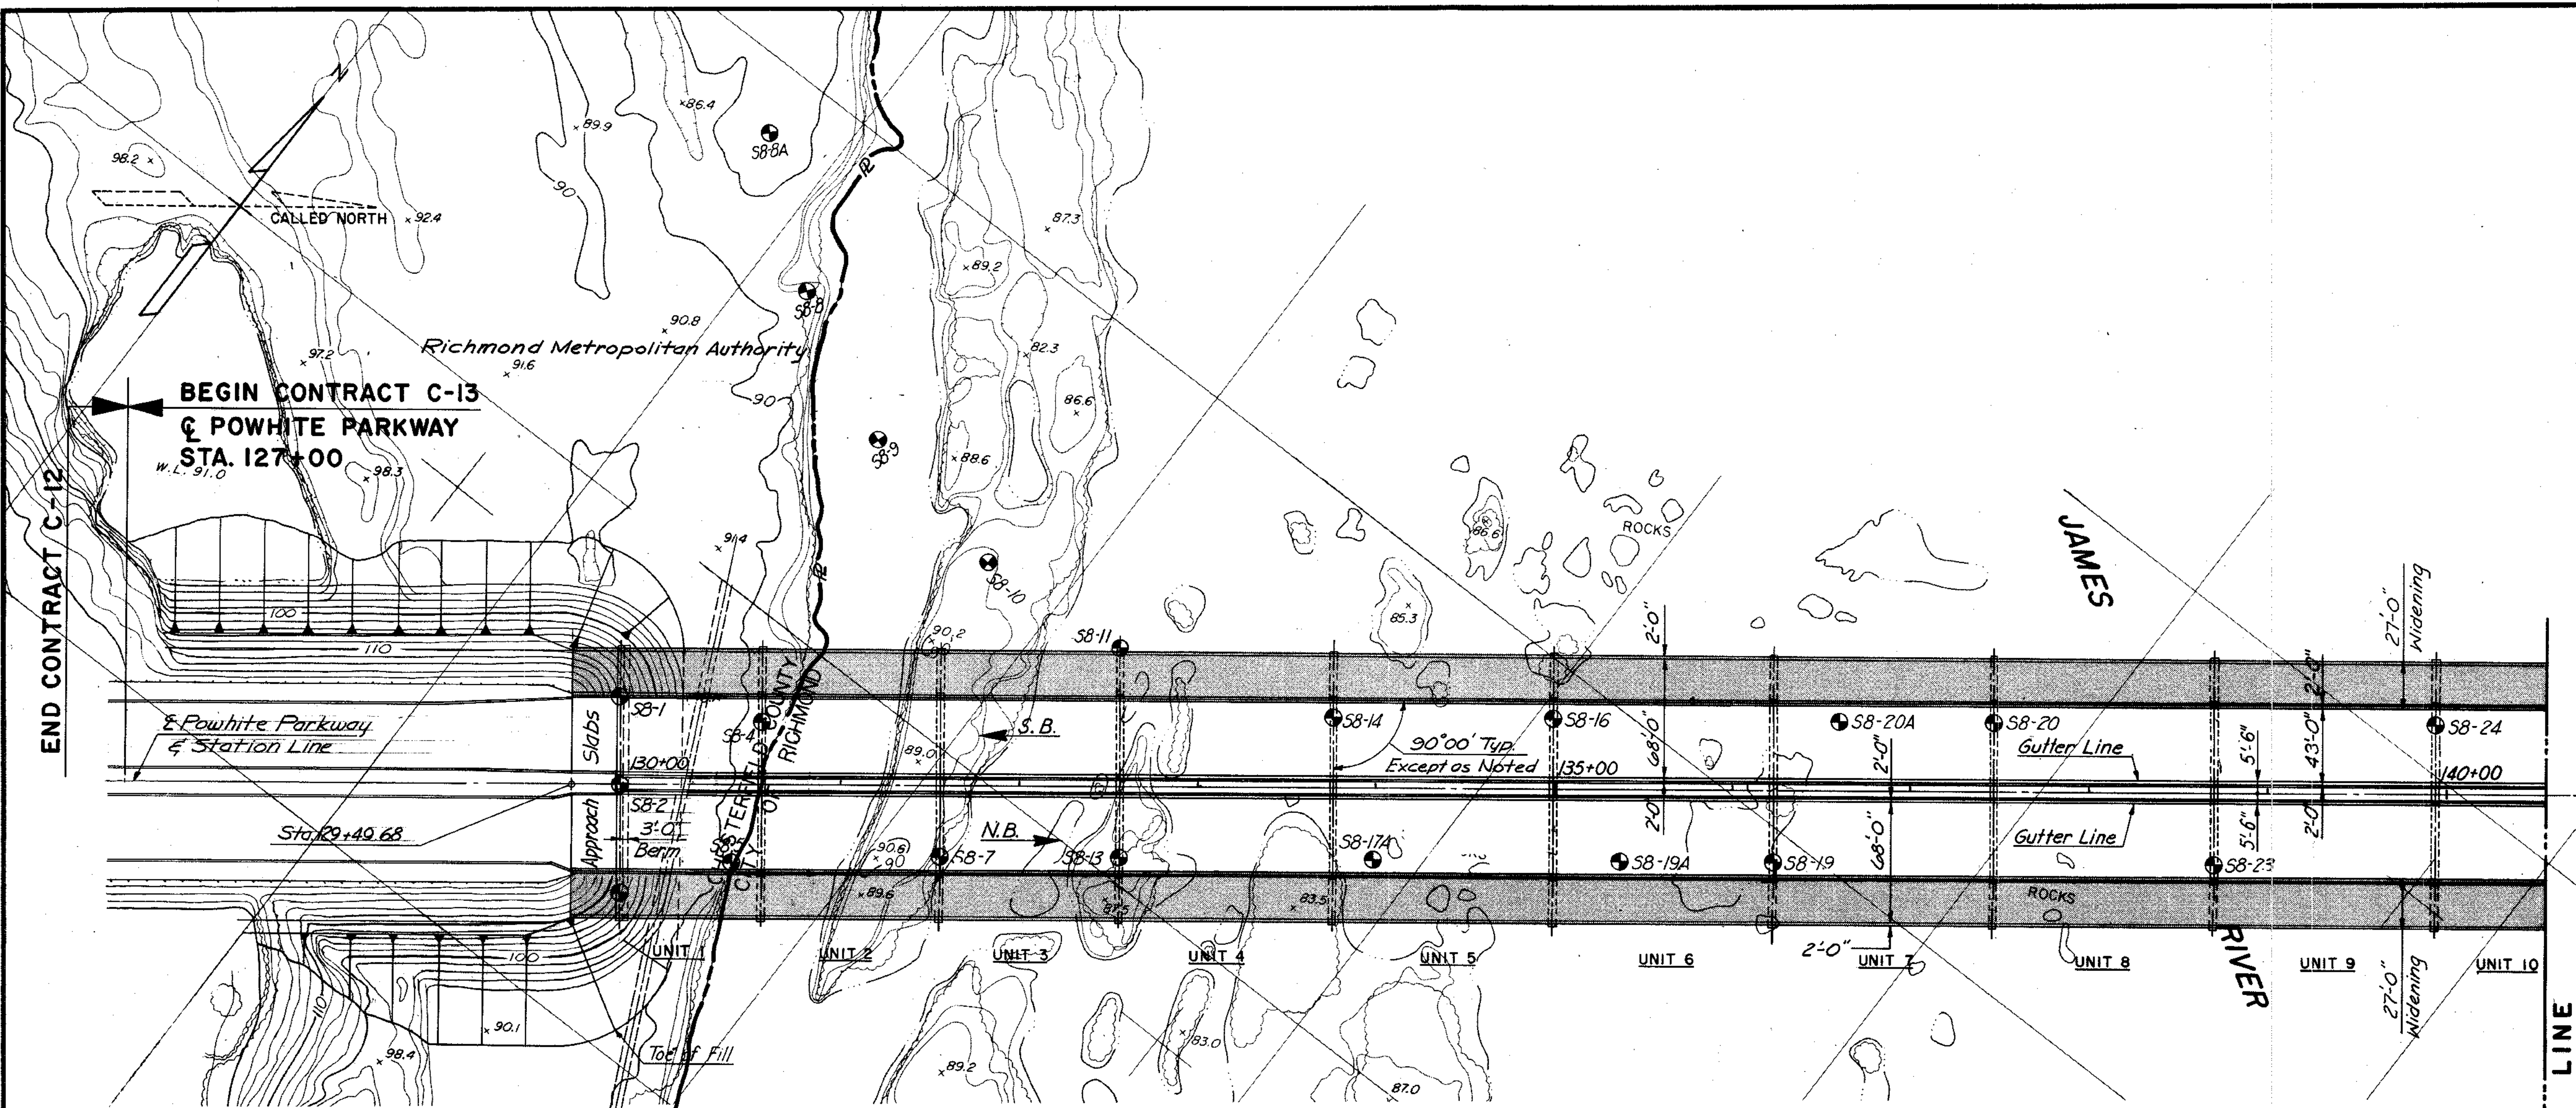

PLAN

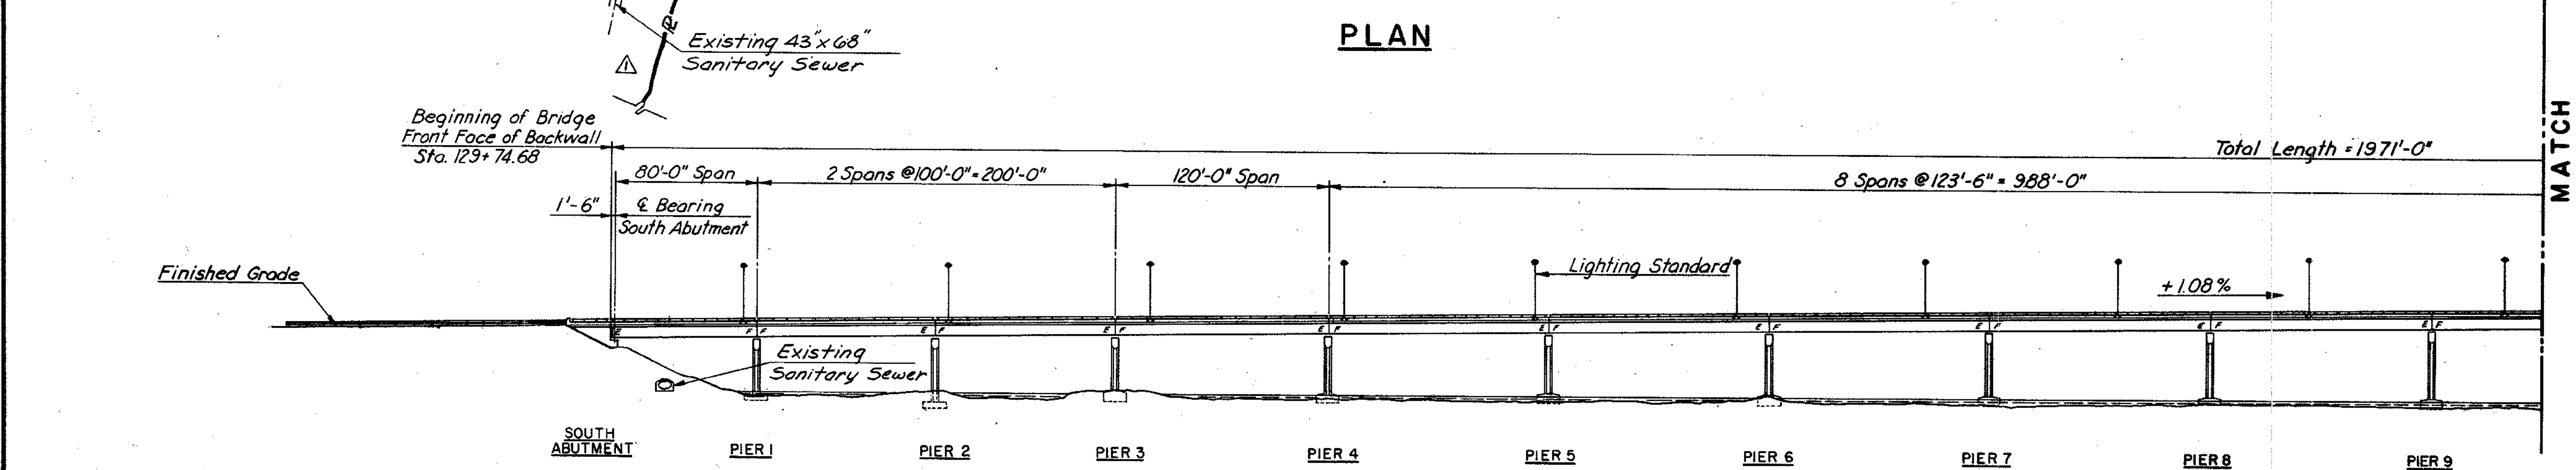

ELEVATION

BY	DATE	NO.	REVISION	BY	DATE
MADE	ALC 3-87		As Built	TEM	3-89
CHECKED	TEP 3-87		Property Line	ALC	4-87
IN CHARGE	S.R.				

AS BUILT

RICHMOND METROPOLITAN AUTHORITY  
RICHMOND EXPRESSWAY SYSTEM


GENERAL PLAN AND ELEVATION

HOWARD, NEEDLES, TAMMEN & BERGENDOFF  
consulting engineers  
Alexandria, Virginia

SCALE: 1" = 50'  
CONTRACT NO.: C-13  
SHEET NO. 2 OF 106



RICHMOND EXPRESSWAY SYSTEM			
SECTION	PROJECT	SHEET NO.	TOTAL SHEETS
13	WIDENING JAMES RIVER BRIDGE	3	106

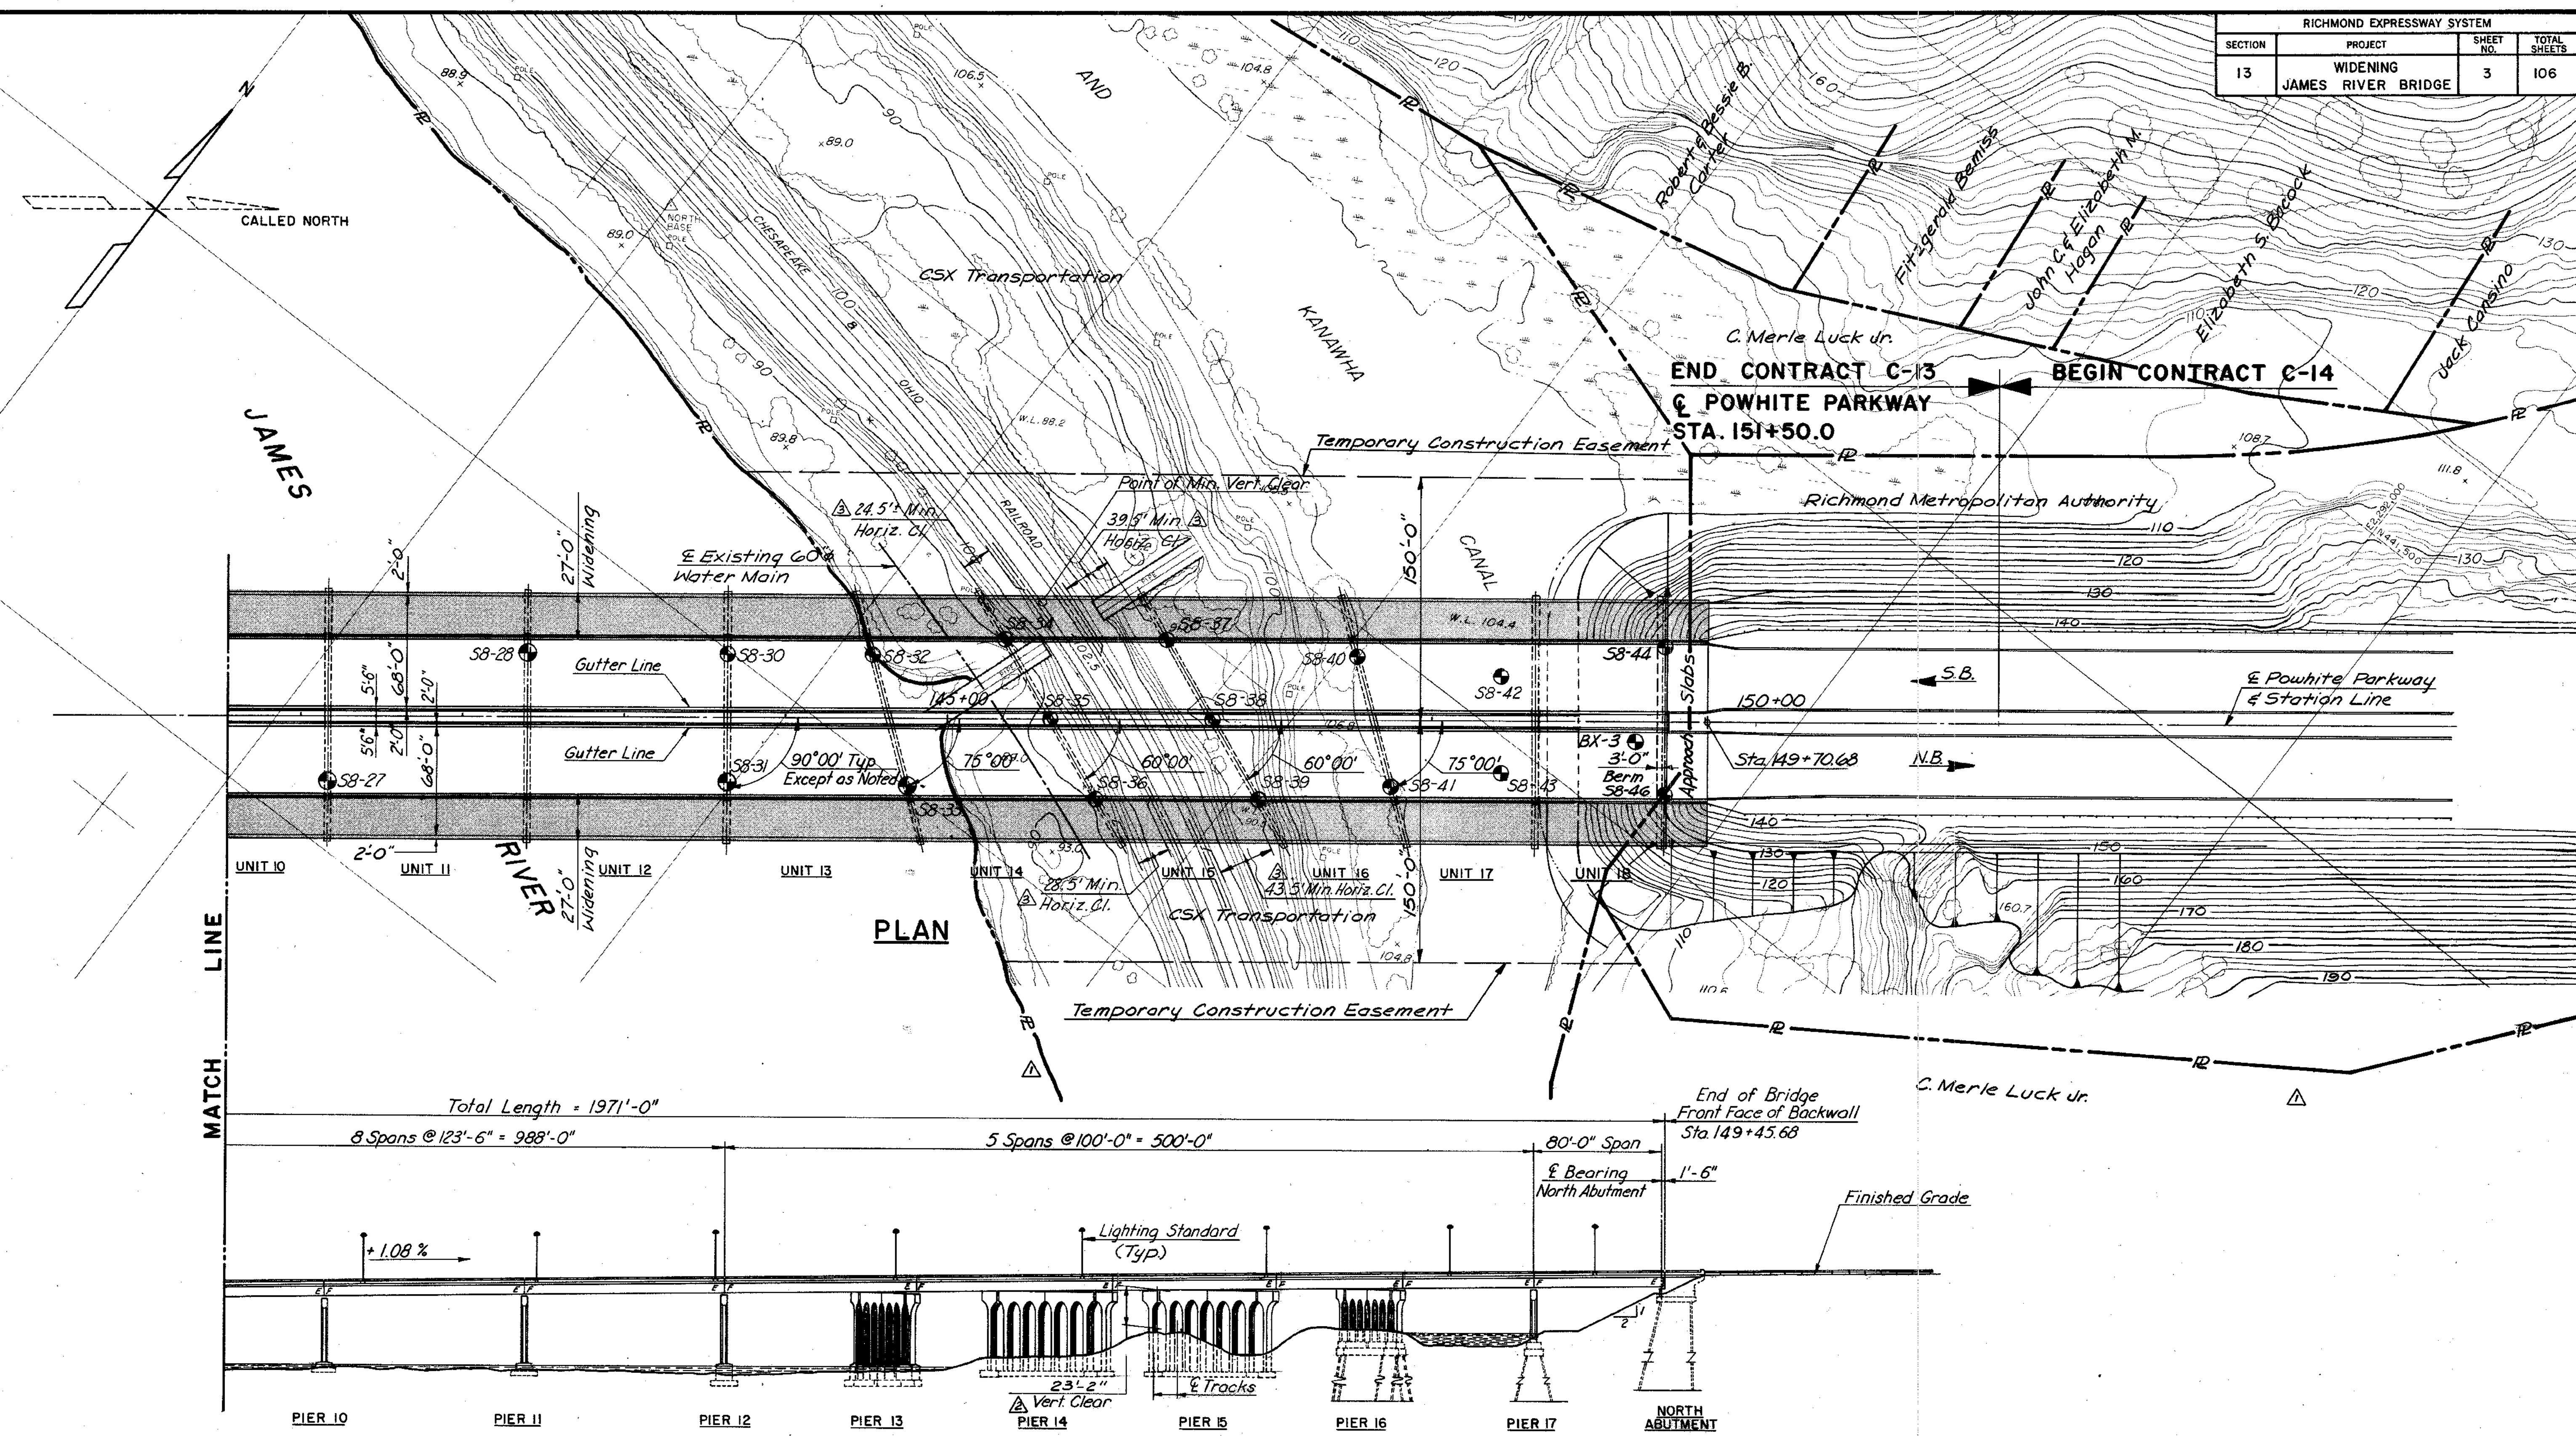

As Built TEM 3.89				
BY	DATE	Added Horiz. Cl.	EUM	7-87
MADE	ALC. 3-87	Vert. Clear	ALC	5-87
CHECKED	TEP 3-87	Property Line	ALC	4-87
IN CHARGE	S.R.	NO.	REVISION	BY DATE

AS BUILT

RICHMOND METROPOLITAN AUTHORITY  
RICHMOND EXPRESSWAY SYSTEM

GENERAL PLAN AND ELEVATION

HOWARD, NEEDLES, TAMMEN & BERGENDOFF  
consulting engineers  
Alexandria, Virginia

SCALE: 1" = 50'  
CONTRACT NO.: C-13  
SHEET NO. 3 of 106

#### **4 ESTIMATE OF QUANTITIES \***

[illegible]

### GENERAL NOTES

WIDTH: SPACING OF 27'-0" TO THE EAST AND WEST OF THE  
EXISTING STRUCTURE.

SPAN LAYOUT: 18-SIMPLE SPAN, STEEL PLATE GIRDER WITH SPANS OF  
2-80 FEET, 7-100 FEET, 1-100 FEET AND 8-123.5 FEET.

CAPACITY: HS20-44 LOADING AND ALTERNATE MILITARY LOADING.  
DESIGN LOADING INCLUDES 15 P.S.F. FOR FUTURE  
WEARING SURFACE AND 20 P.S.F. ALLOWANCE FOR  
CONSTRUCTION TOLERANCES AND CONSTRUCTION METHODS.

SPECIFICATIONS:

CONSTRUCTION: VIRGINIA DEPARTMENT OF HIGHWAYS AND TRANSPORTATION  
ROAD AND BRIDGE SPECIFICATIONS, 1982.

DESIGN: AASHTO STANDARD SPECIFICATIONS FOR HIGHWAY BRIDGES,  
1983, INCLUDING INTERIM SPECIFICATIONS, 1984, AND  
VDHT MODIFICATIONS.

STANDARDS: VIRGINIA DEPARTMENT OF HIGHWAYS AND TRANSPORTATION  
ROAD AND BRIDGE STANDARDS, 1982.

ALL DIMENSIONS ARE MEASURED HORIZONTALLY AND VERTICALLY UNLESS  
OTHERWISE SPECIFIED.

THESE PLANS ARE INCOMPLETE UNLESS ACCOMPANIED BY THE SUPPLEMENTAL SPECIFICATIONS AND SPECIAL PROVISIONS INCLUDED IN THE CONTRACT DOCUMENTS.

ALL STRUCTURAL STEEL SHALL BE A36, EXCEPT AS NOTED.

FINISH PAINT SHALL BE LIGHT GREEN, FEDERAL STANDARD 595-24227.

CONCRETE IN SUPERSTRUCTURE SHALL BE CLASS A4. ALL OTHER CONCRETE, EXCEPT TREMIE SEAL CONCRETE, SHALL BE CLASS A3.

ALL DEFORMED REINFORCING BARS SHALL CONFORM TO ASTM A615, GRADE 60.

ALL REINFORCING BAR DIMENSIONS ON THE DETAILED DRAWINGS ARE TO CENTER OF BARS EXCEPT WHERE OTHERWISE NOTED AND ARE SUBJECT TO FABRICATION AND CONSTRUCTION TOLERANCES.

ALL FOOTING CONCRETE SHALL BE PLACED IN THE DRY EXCEPT WHERE CLASS T3 CONCRETE IS INDICATED ON THE PLANS OR APPROVED BY THE ENGINEER.

BECAUSE OF THE ERRATIC NATURE OF THE GROUND CONDITIONS AT THE SITE, ELEVATIONS OF THE BOTTOM OF THE FOOTINGS SHOWN ON THE PLANS SHALL BE CONSIDERED APPROXIMATE ONLY. DURING CONSTRUCTION SHOULD EXCAVATION OPERATIONS REVEAL THAT THE FOUNDATION IS INADEQUATE, REDESIGN MAY BE REQUIRED AT THE DISCRETION OF THE ENGINEER.

STEEL PILES 10BP42 ARE DESIGNED FOR A CAPACITY OF 55 TONS PER PILE.  
ALL PILES SHALL BE DRIVEN TO PRACTICAL REFUSAL.

PRIOR TO THE COMMENCEMENT OF ANY WORK THE CONTRACTOR SHALL FIELD VERIFY ALL DIMENSIONS AND ELEVATIONS OF THE EXISTING STRUCTURE AND REPORT TO THE ENGINEER ANY DISCREPANCIES BETWEEN FIELD MEASUREMENTS AND MEASUREMENTS SHOWN ON THE CONTRACT PLANS.

△ ELEVATIONS TAKEN FROM CITY OF RICHMOND DATUM.

\* For additional quantities see  
Sheet Nos. 67 & 101.

\*\* The total weight of structural steel, 3,541,900 lbs, includes the shoes.

		A As Built		TEM 3-89	
	BY	DATE	A Quantities	ALC	4-87
MADE	ALC	3-87	A Quantities	ALC	4-87
CHECKED	TFP	3-87	A Quantities & Added Note	ALC	4-87
IN CHARGE	S.R	NO.	REVISION	BY	DATE

**RICHMOND METROPOLITAN AUTHORITY  
RICHMOND EXPRESSWAY SYSTEM**

GENERAL NOTES  
AND  
ESTIMATED QUANTITIES









HOWARD, NEEDLES, TAMMEN & BERGENDOFF  
consulting engineers  
Alexandria, Virginia

SCALE: AS SHOWN  
CONTRACT NO.: C - 13  
SHEET NO. 4 OF 106

AS BUILT



RICHMOND EXPRESSWAY SYSTEM			
SECTION	PROJECT	SHEET NO.	TOTAL SHEETS
13	WIDENING JAMES RIVER BRIDGE	12	106

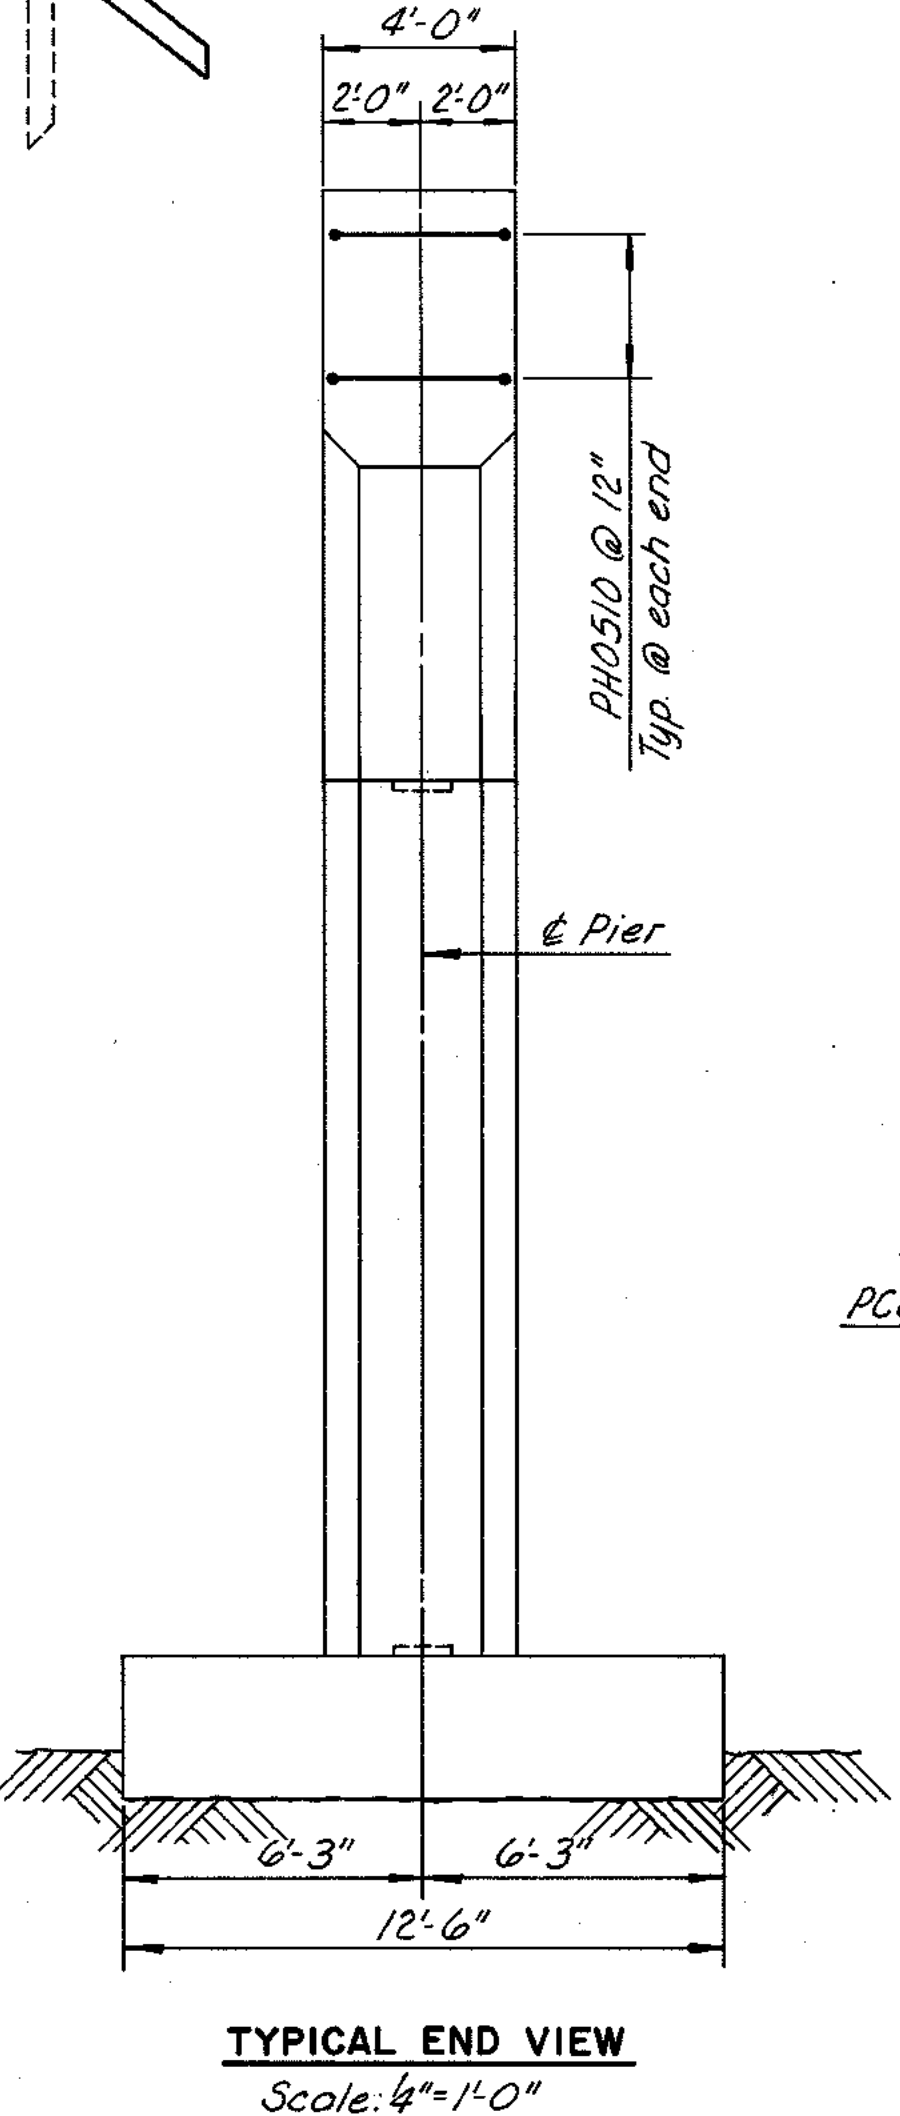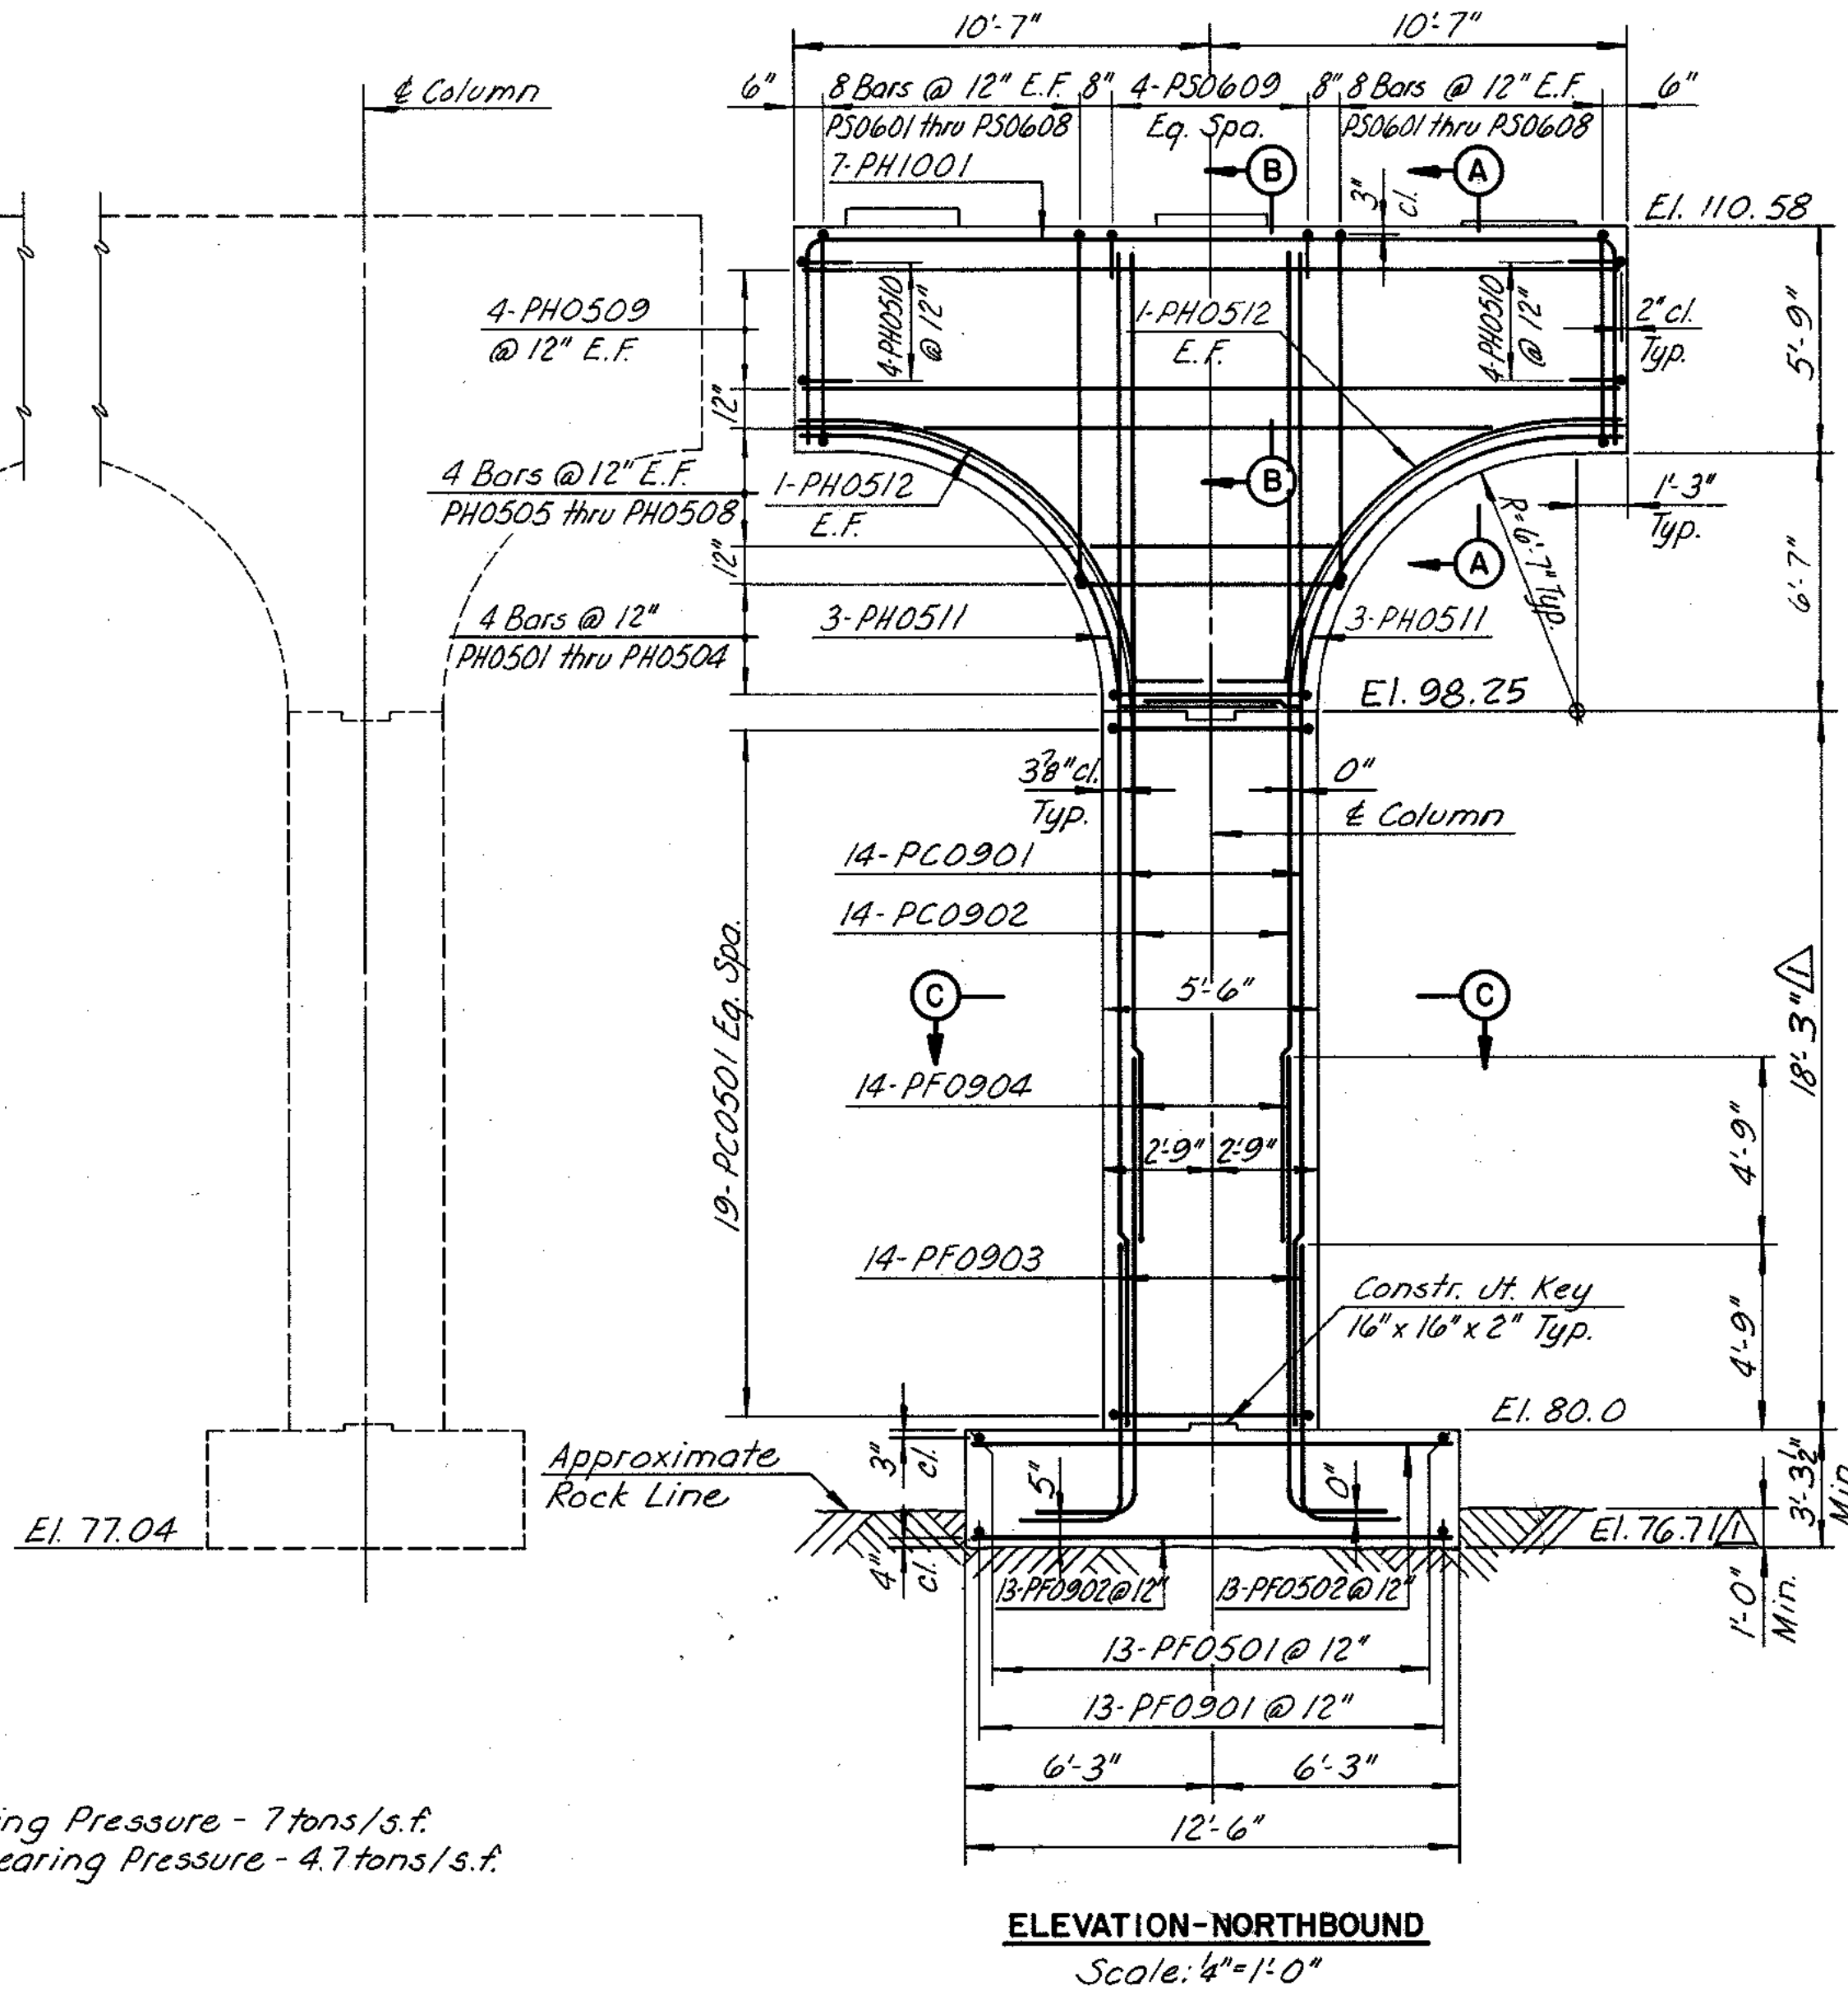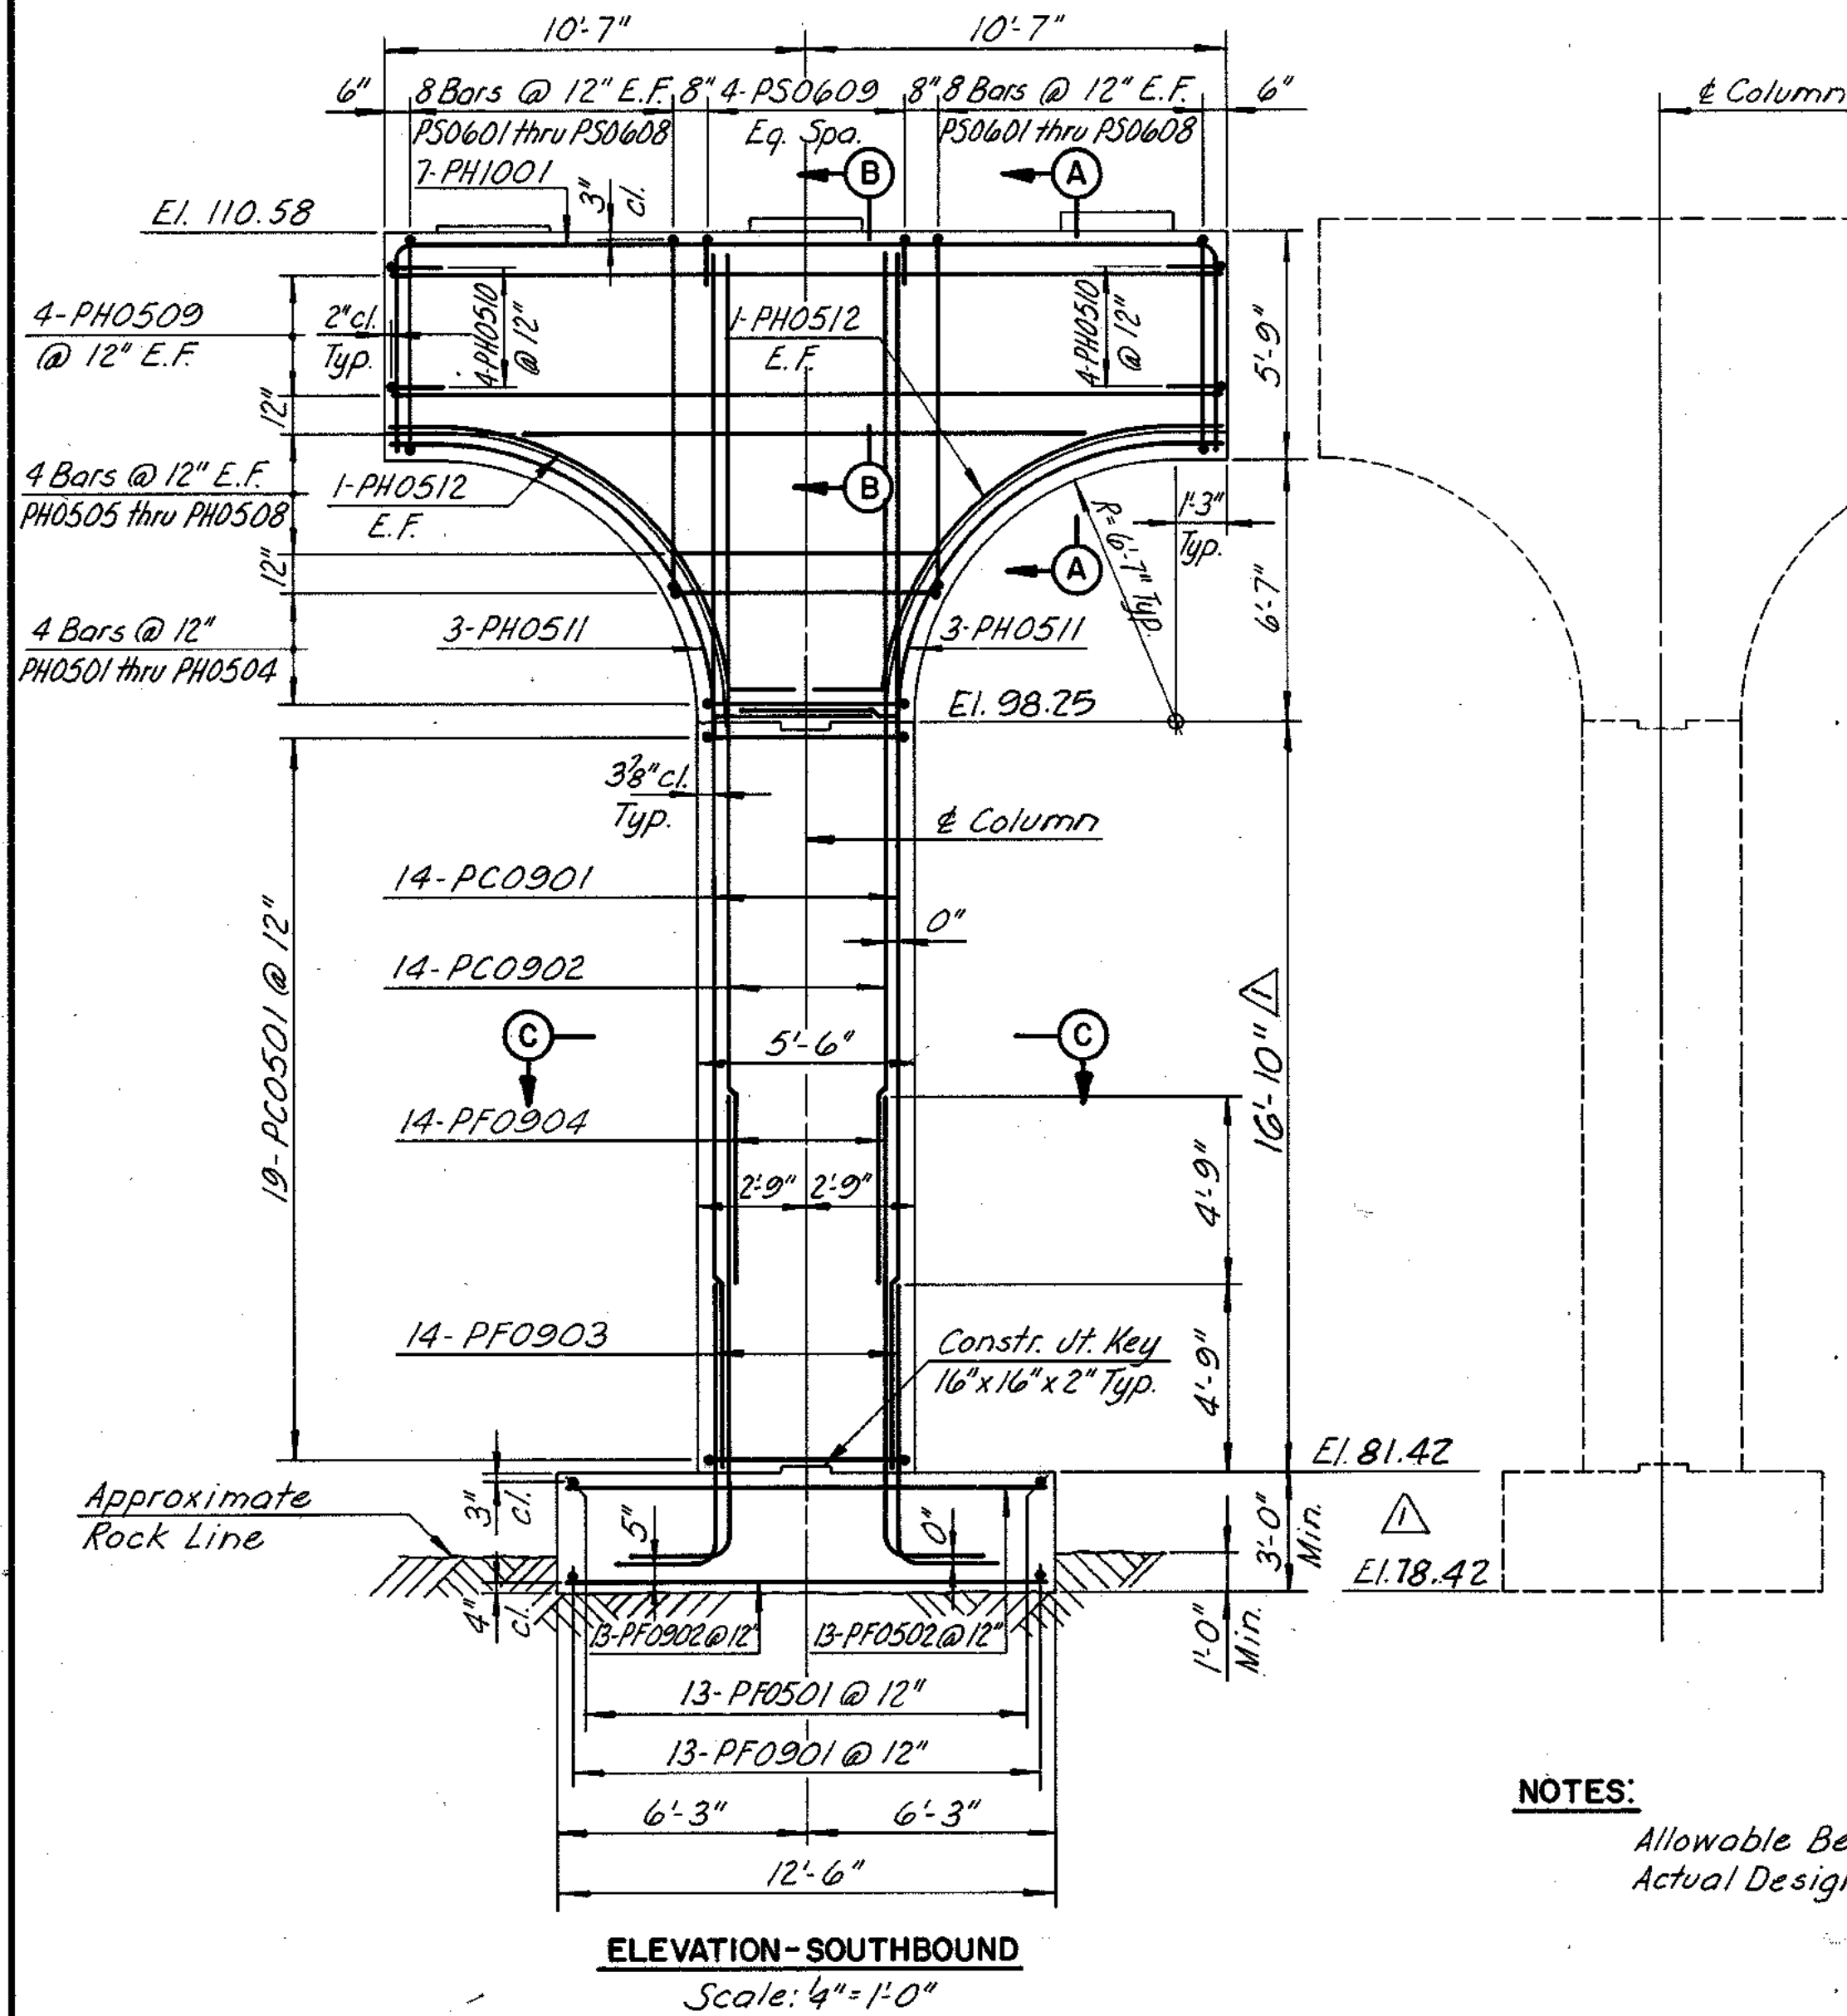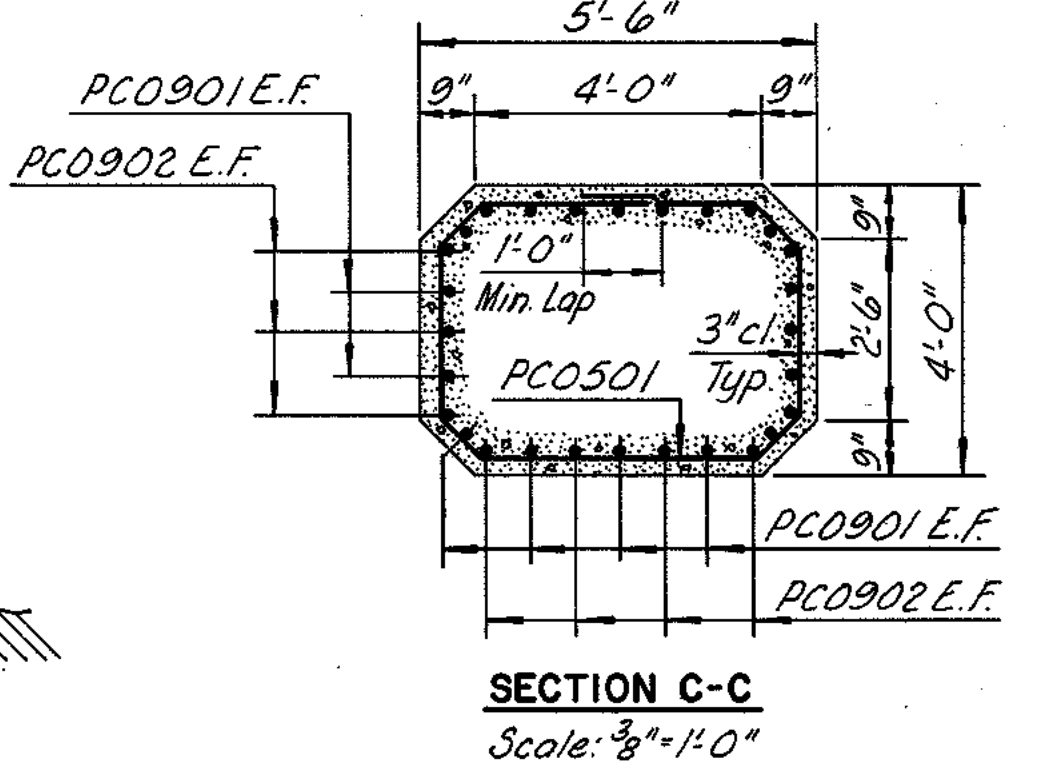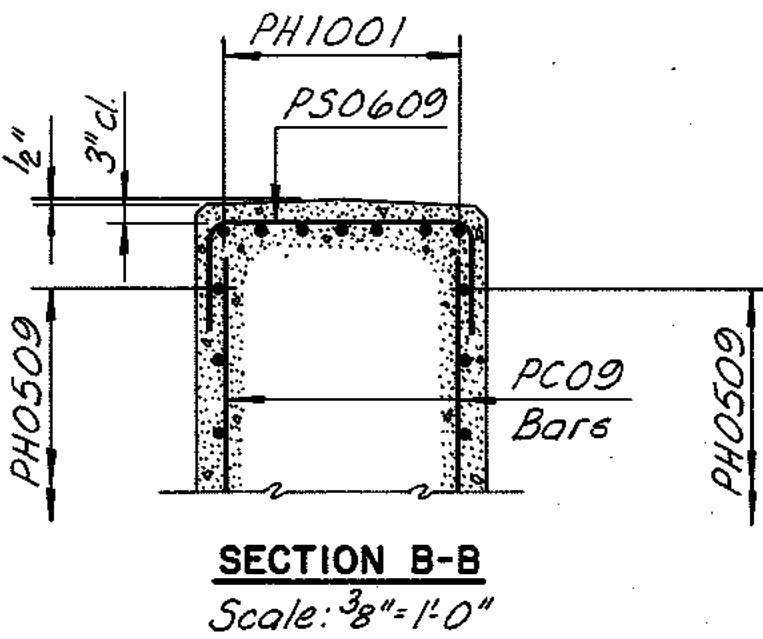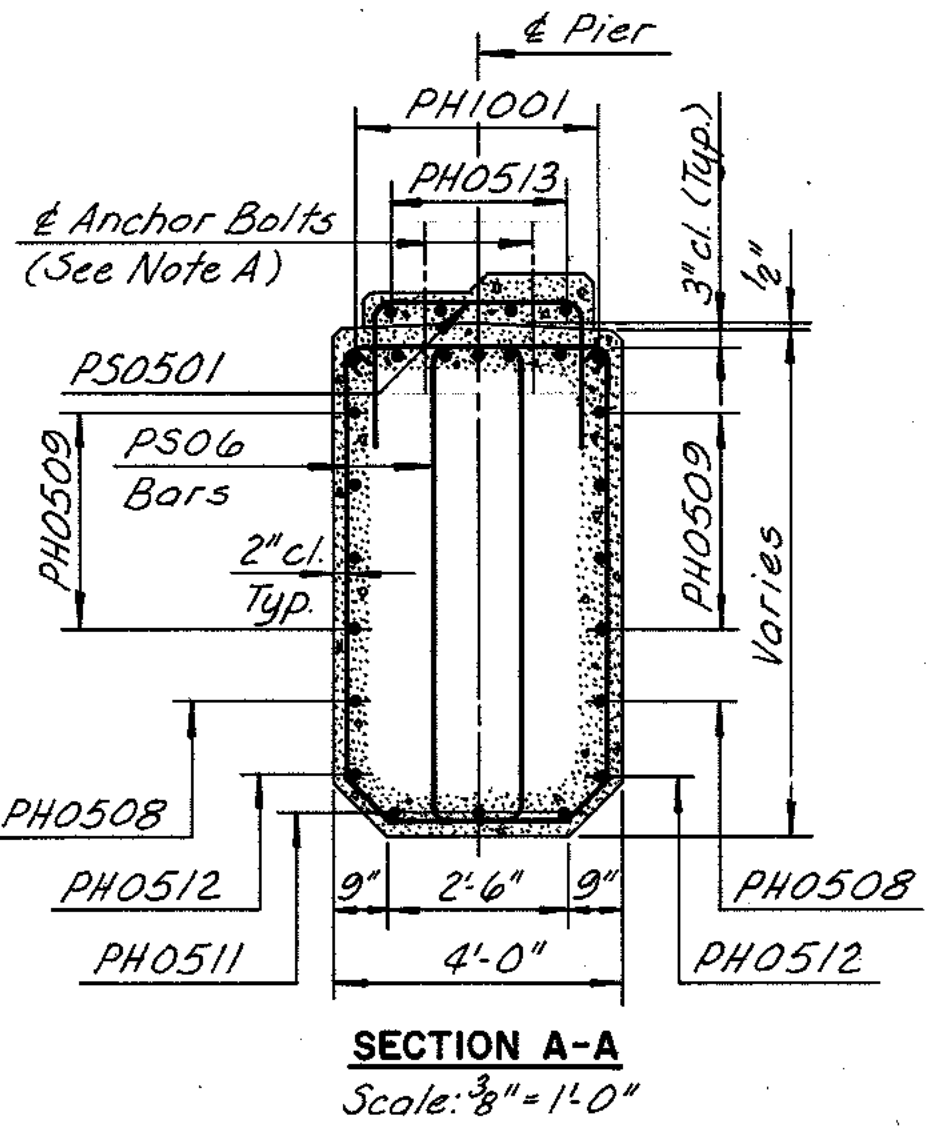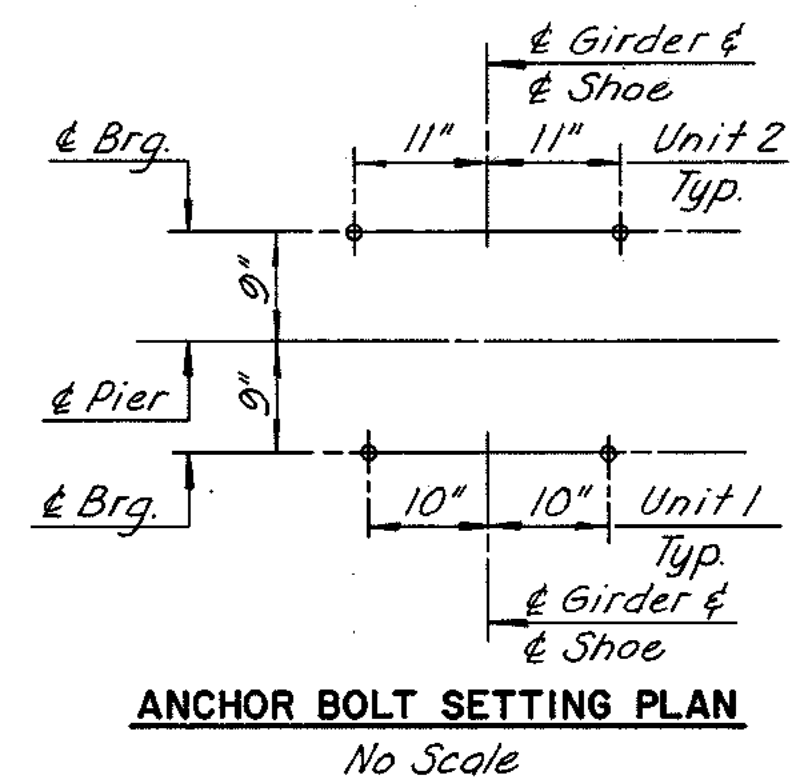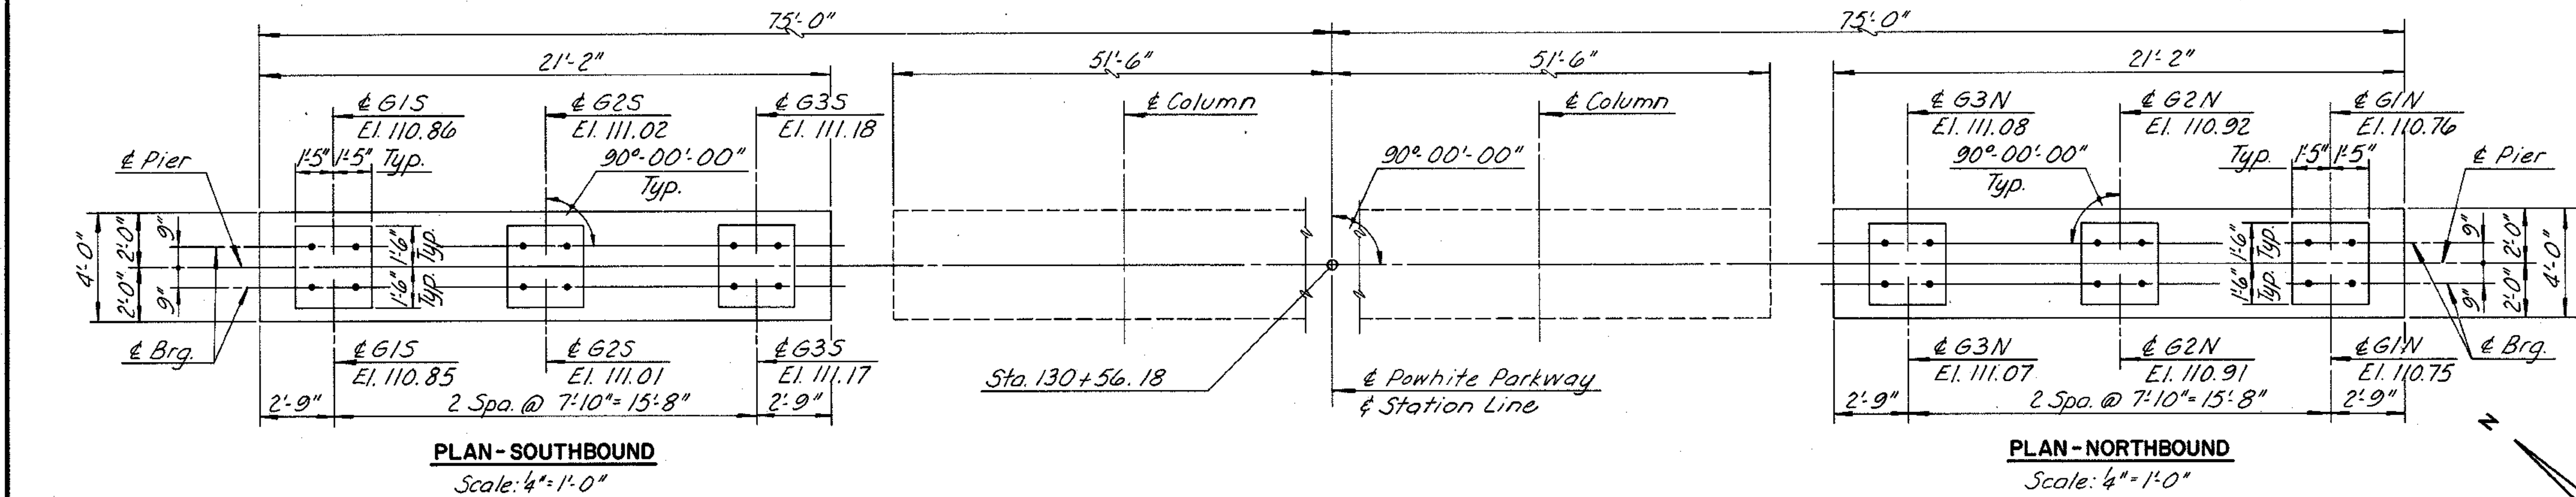

**NOTES:**  
Allowable Bearing Pressure - 7 tons/s.f.  
Actual Design Bearing Pressure - 4.7 tons/s.f.

**NOTE A:**  
Rod reinforcing bars are to be spaced to clear Anchor Bolts.

BY	DATE			
MADE	EJM 2-87			
CHECKED	TFR 3-87	As Built	TEM 3-89	
IN CHARGE	S.R	NO.	REVISION	BY DATE

RICHMOND METROPOLITAN AUTHORITY  
RICHMOND EXPRESSWAY SYSTEM








PIER 1 DETAILS

HOWARD, NEEDLES, TAMMEN & BERGENDOFF  
consulting engineers  
Alexandria, Virginia

SCALE: AS SHOWN  
CONTRACT NO.: C-13  
SHEET NO. 12 of 106

AS BUILT

RICHMOND EXPRESSWAY SYSTEM			
SECTION	PROJECT	SHEET NO.	TOTAL SHEETS
13	WIDENING JAMES RIVER BRIDGE	14	106

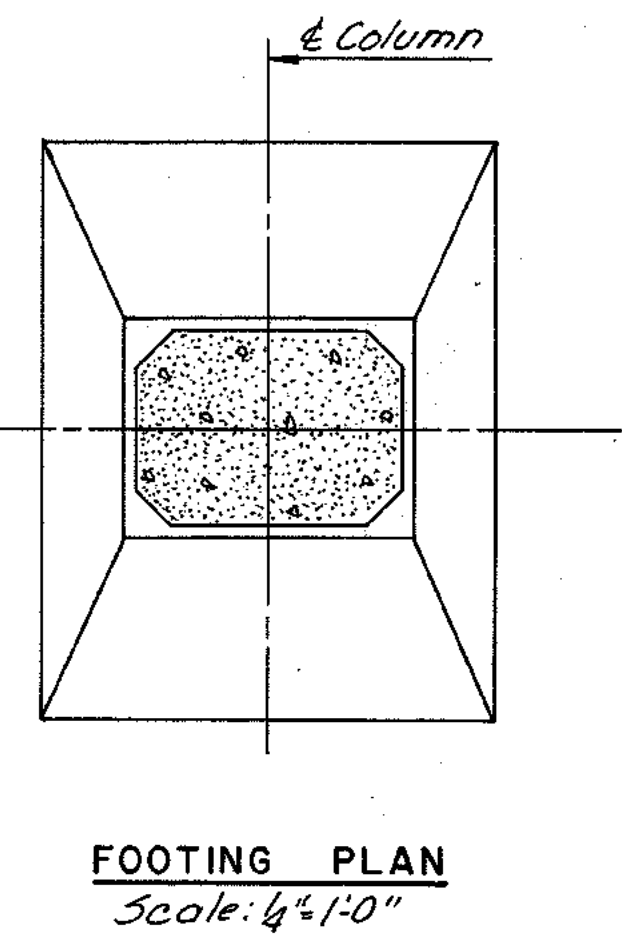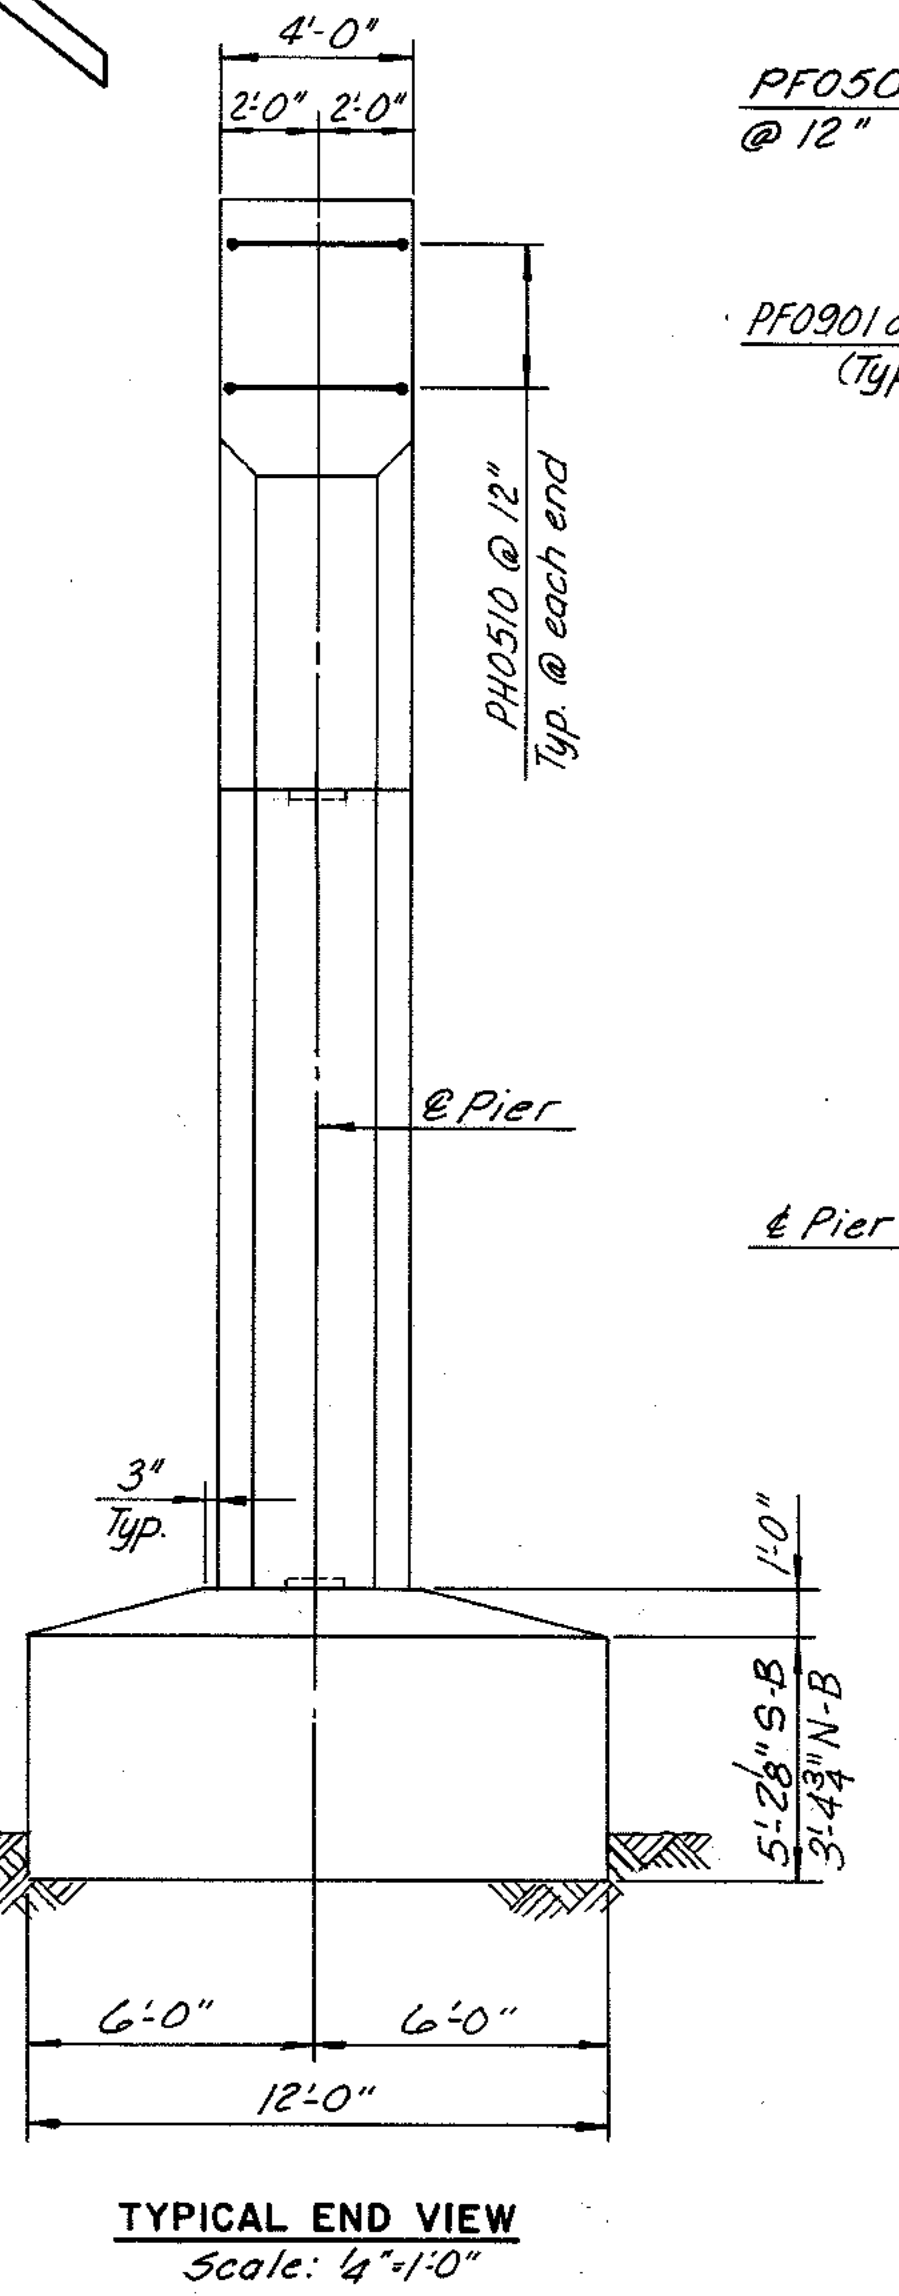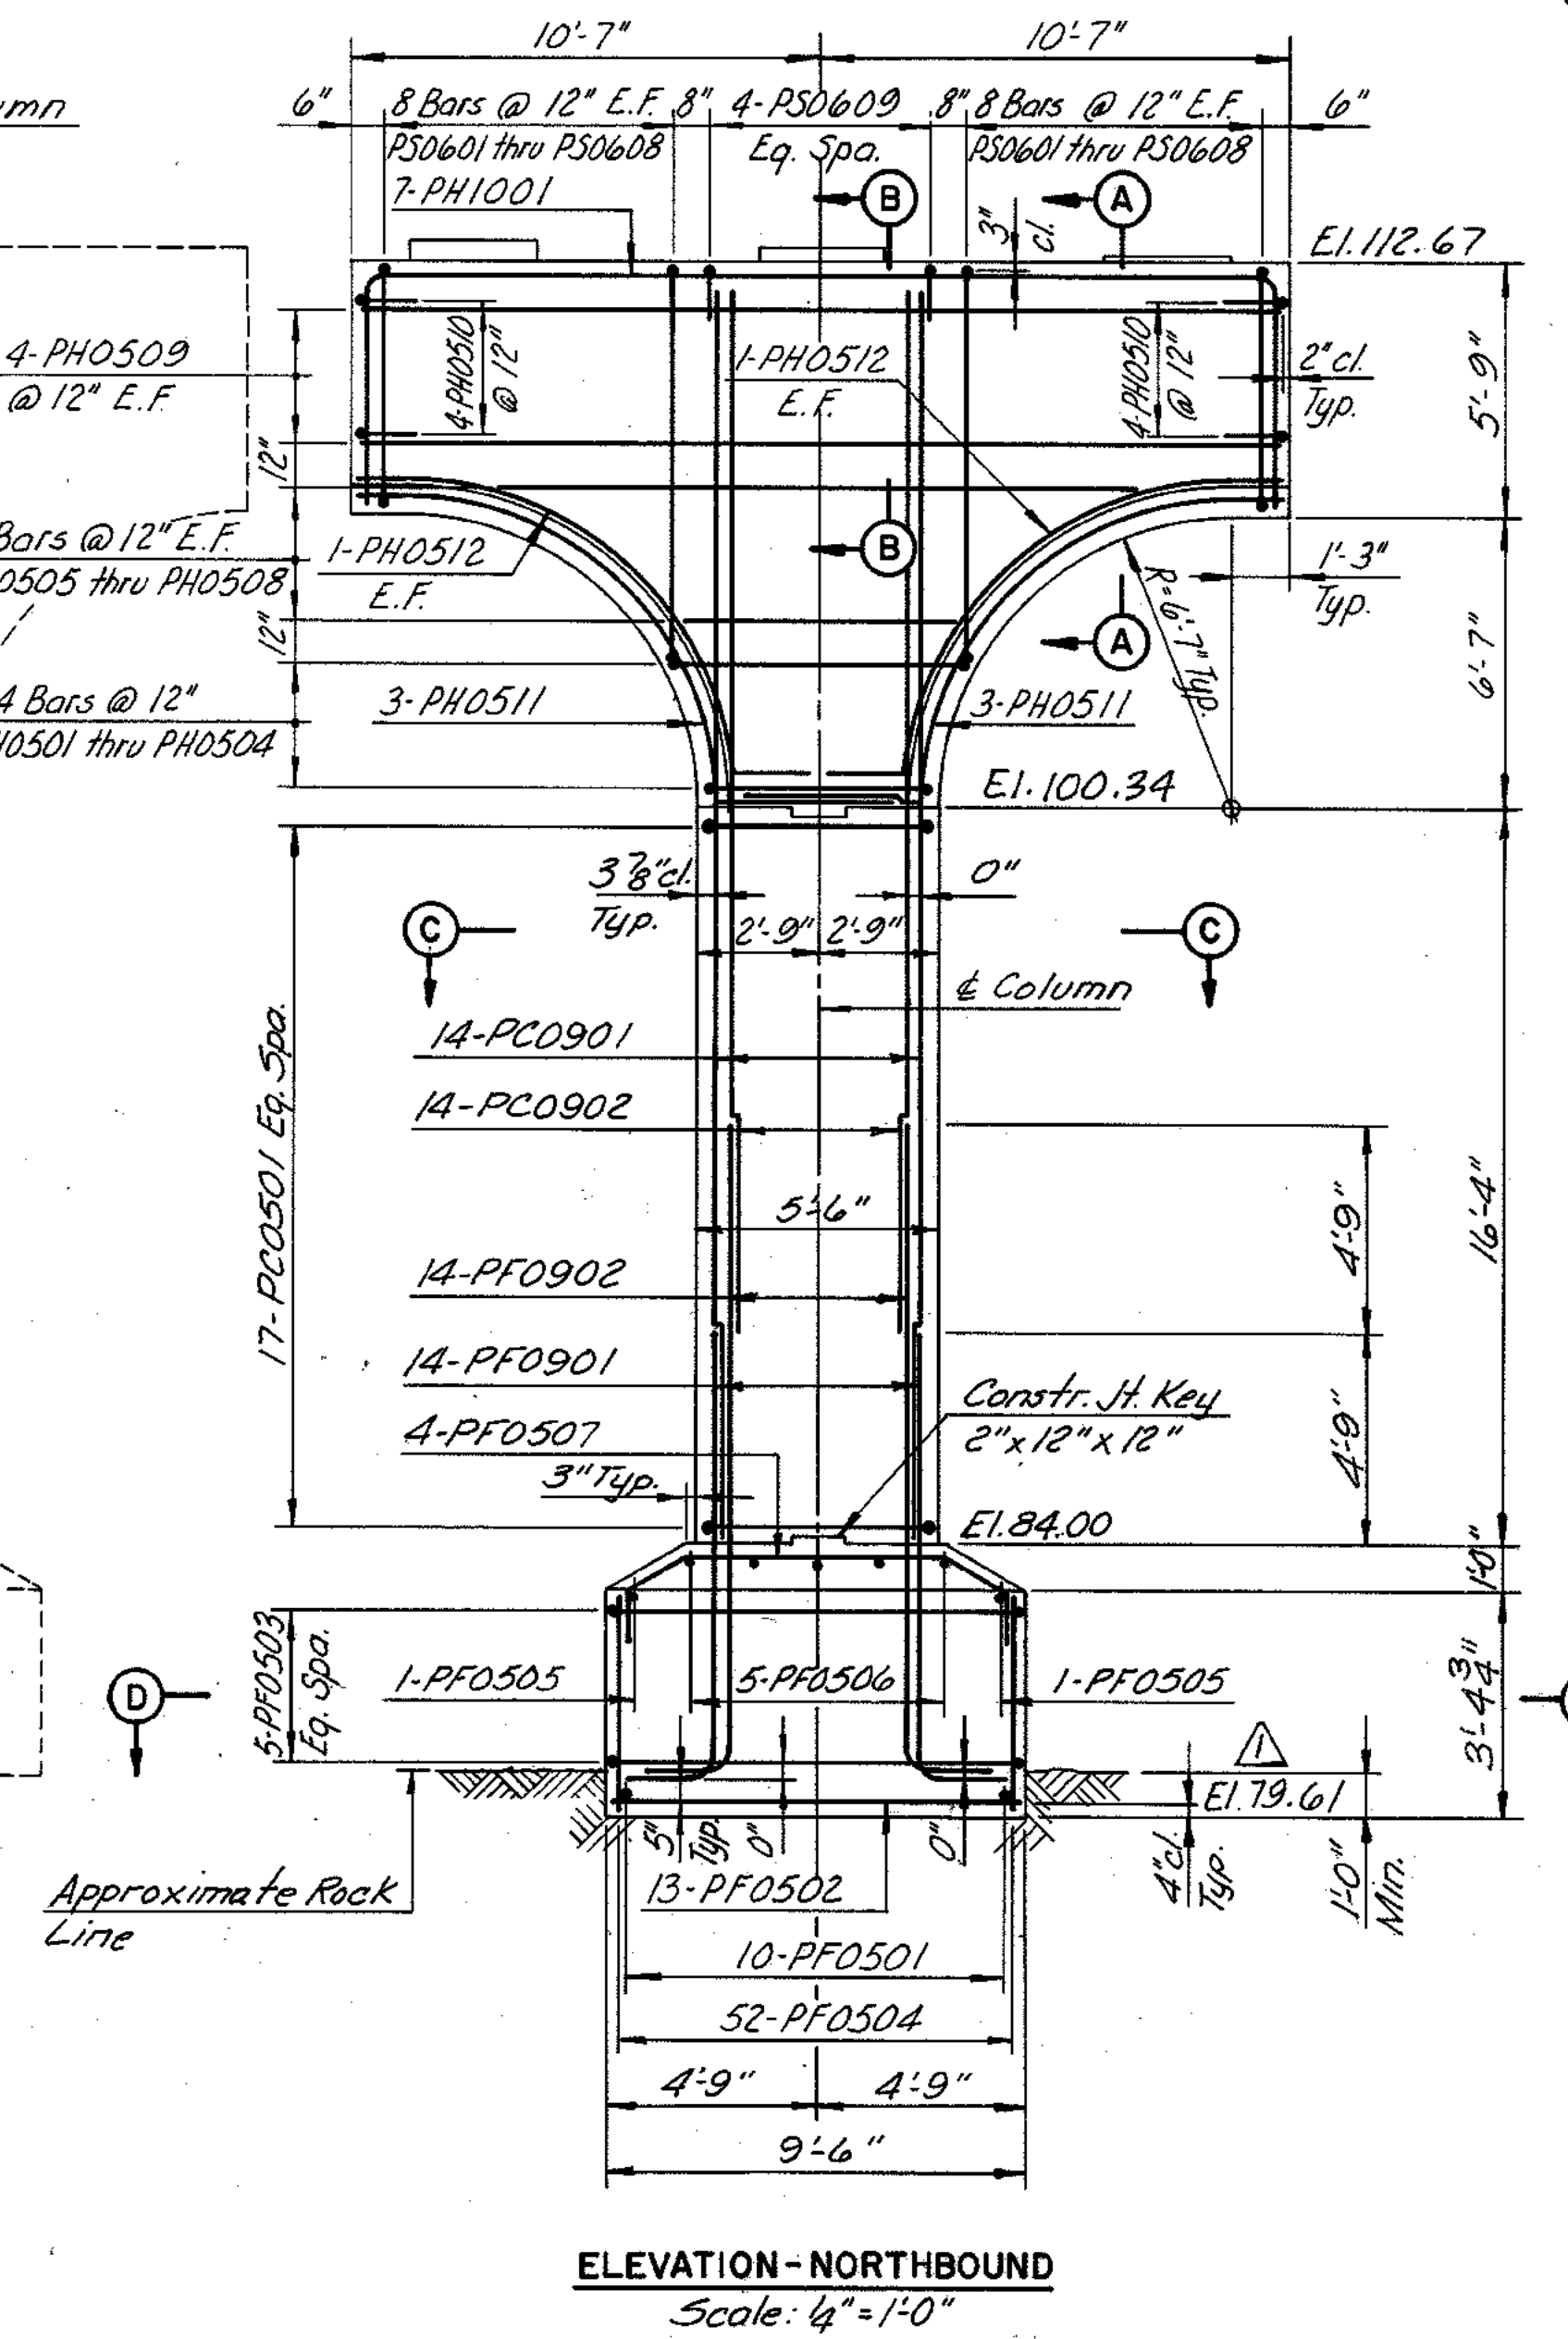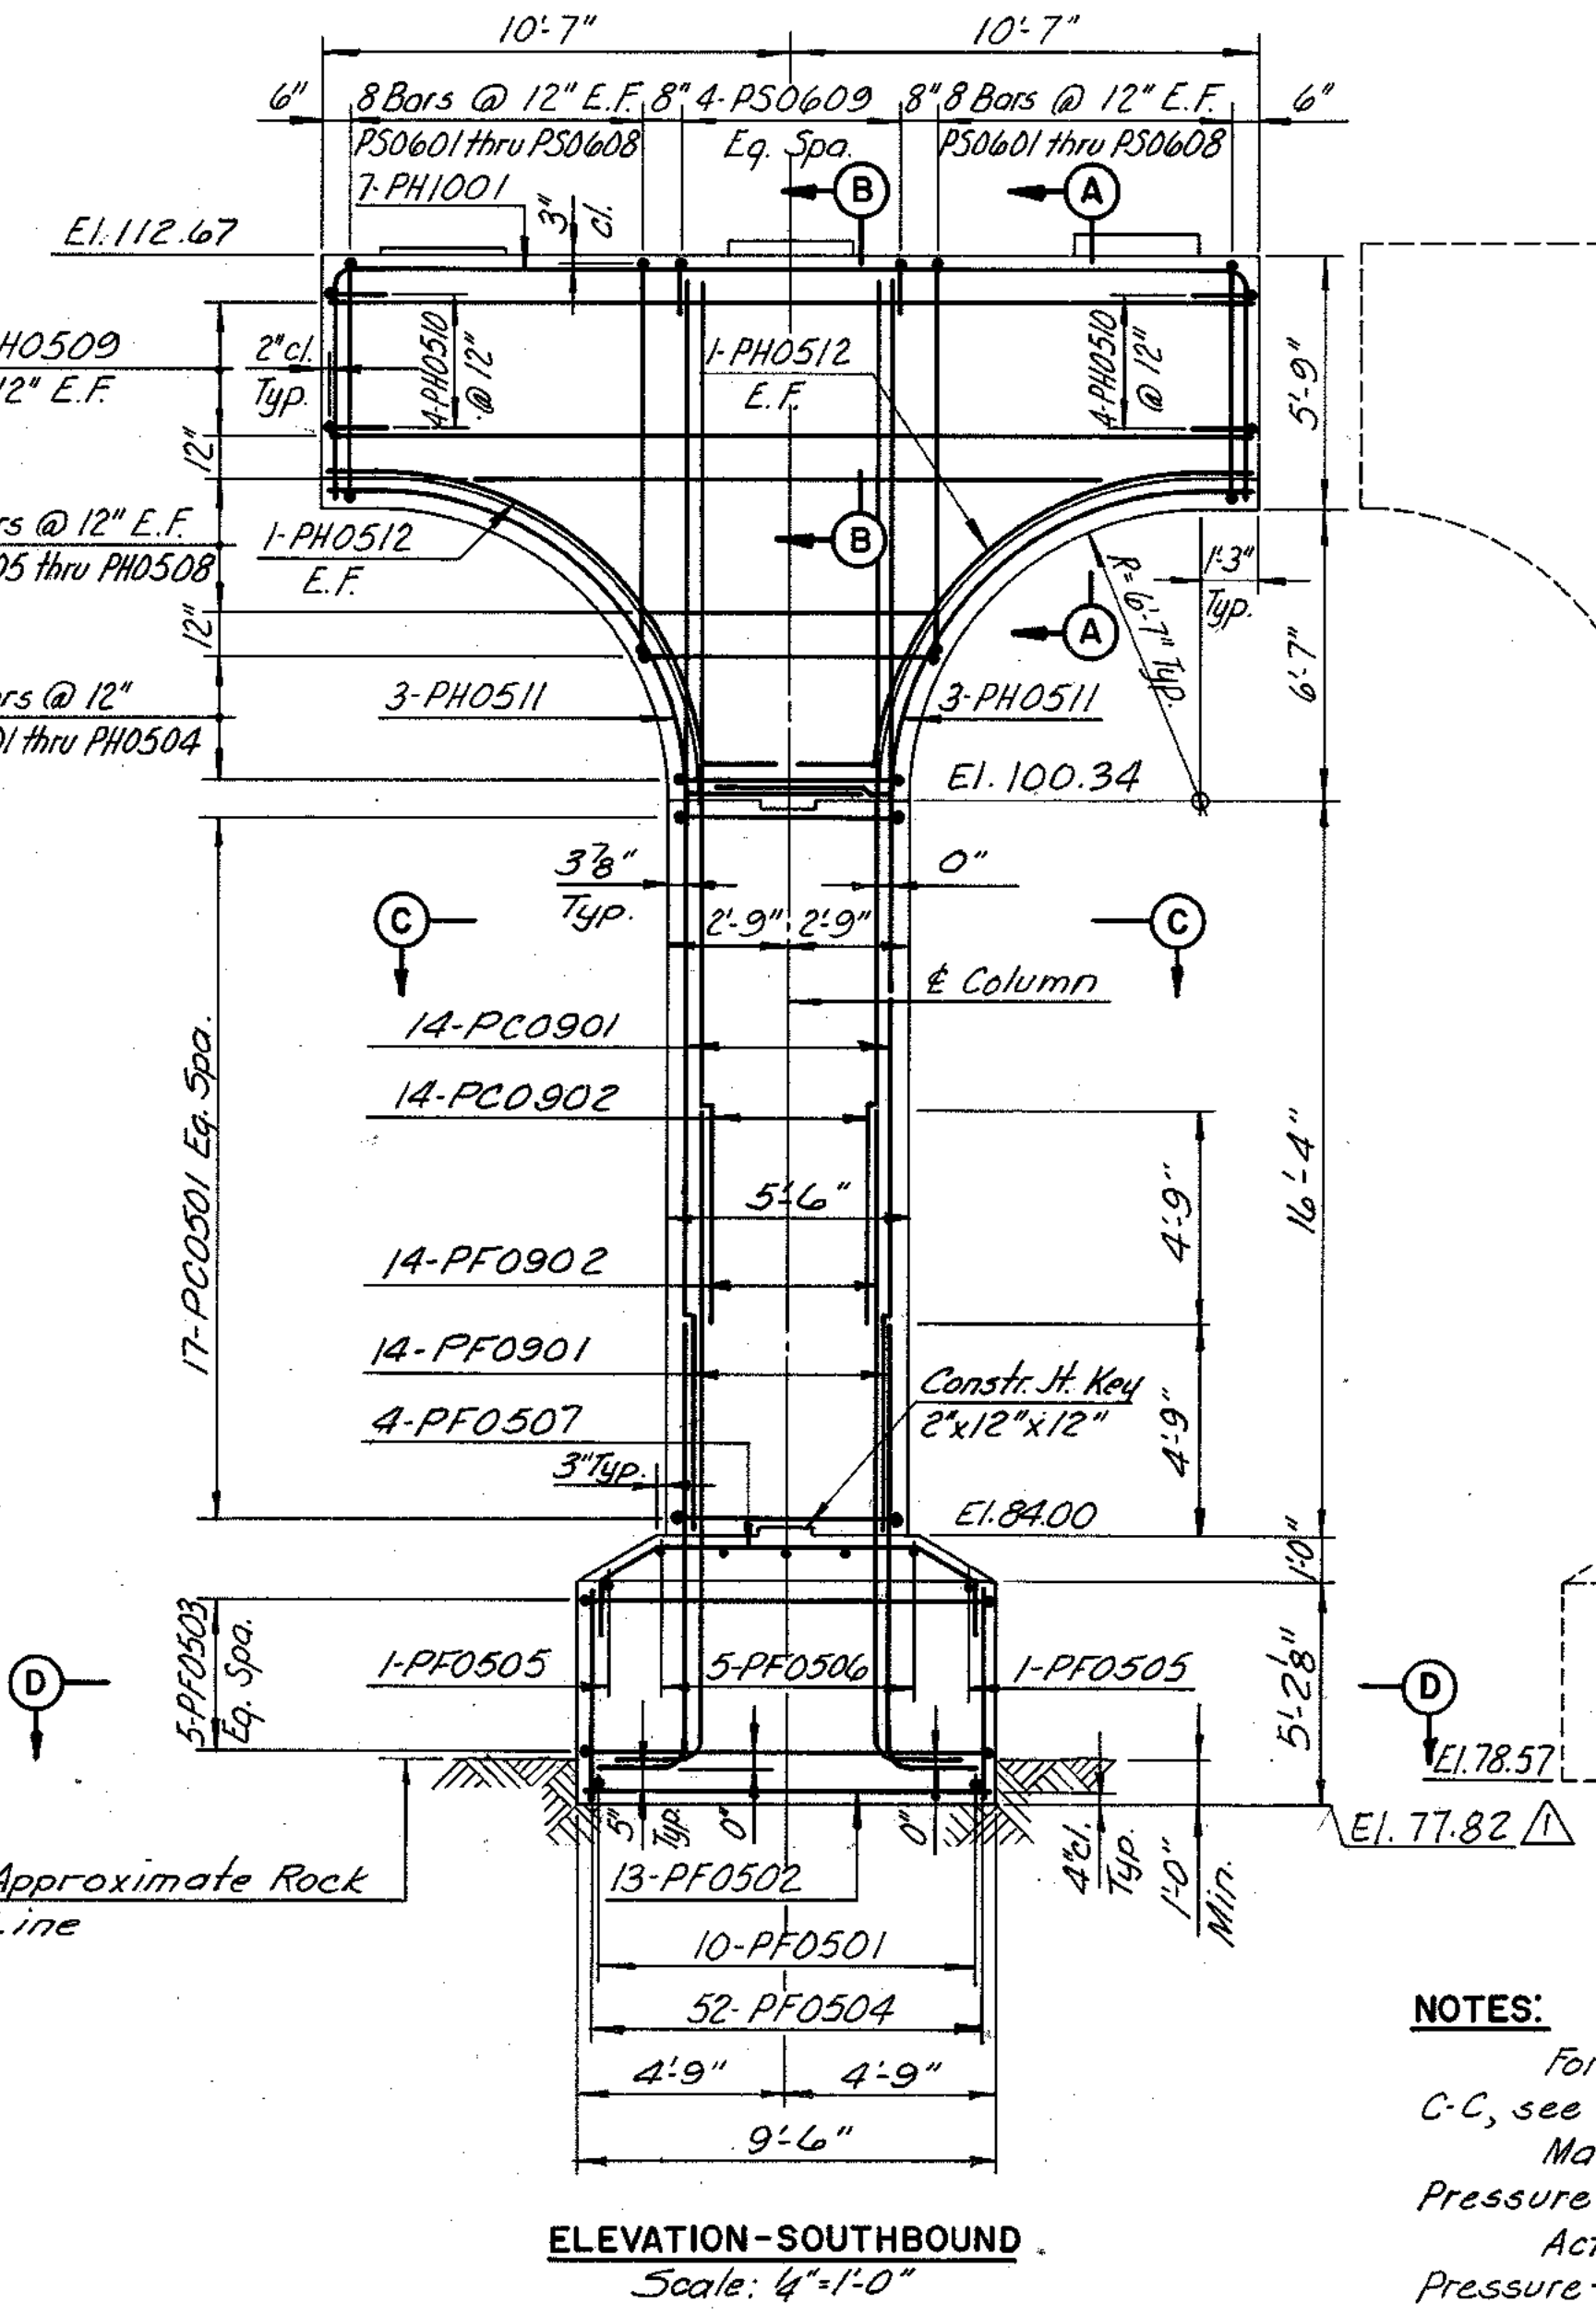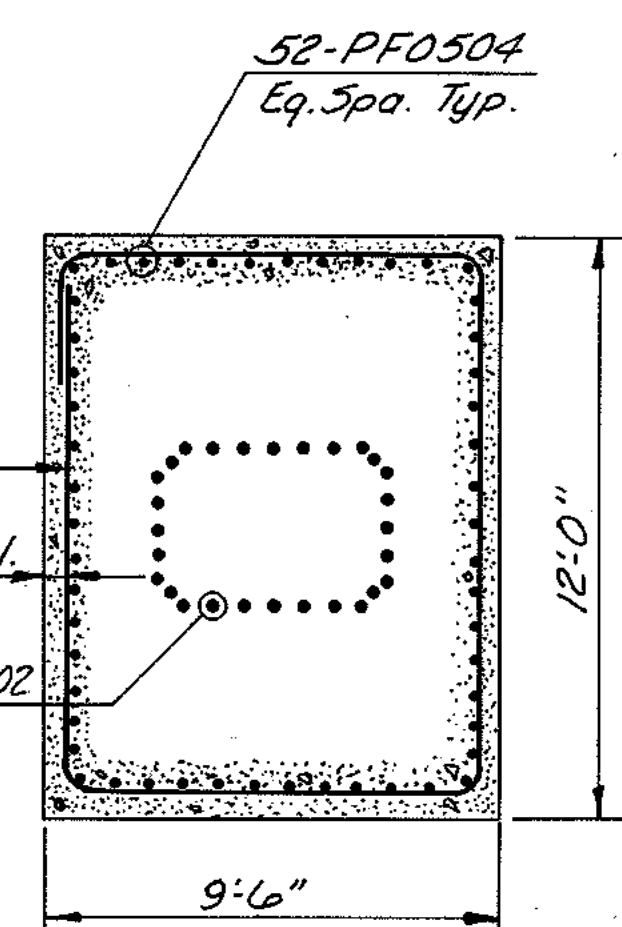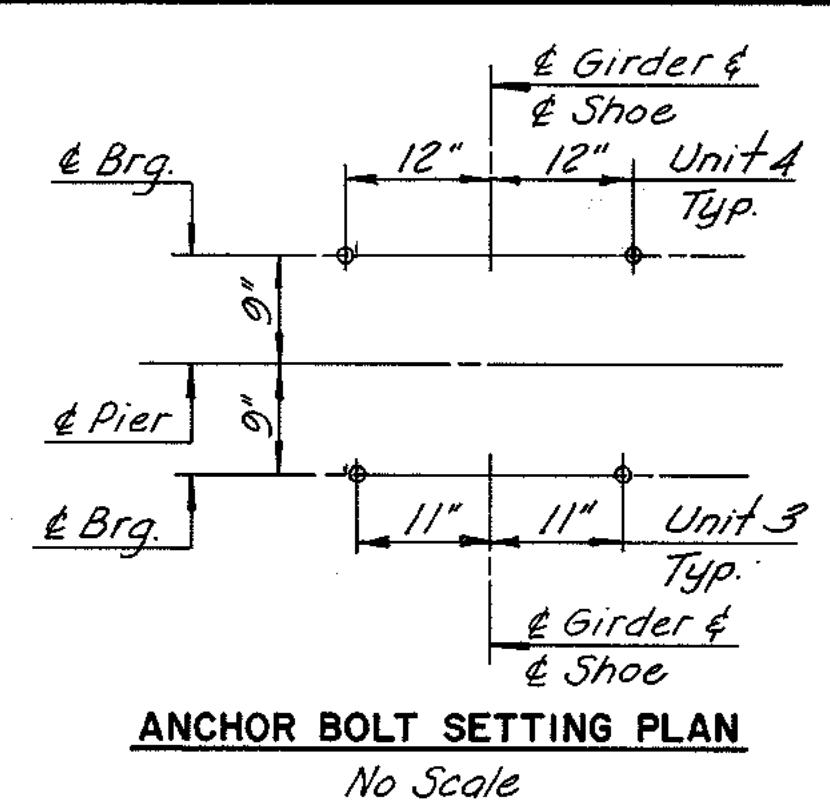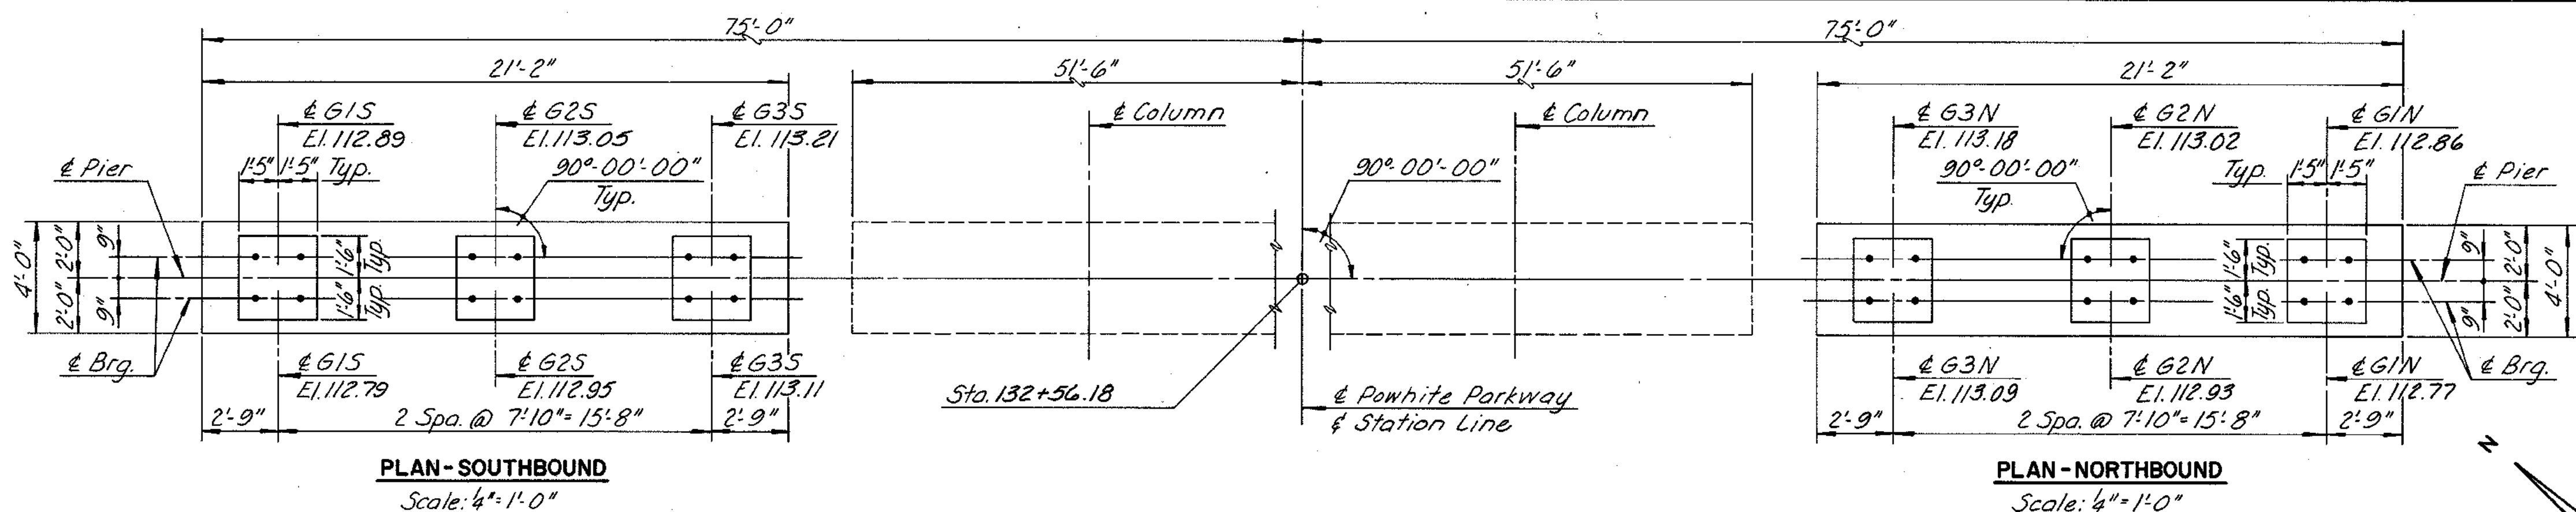

**NOTES:**  
For Sections A-A, B-B and C-C, see Sheet No. 12  
Maximum Allowable Bearing Pressure - 10 tons / s.f.  
Actual Design Bearing Pressure - 7.9 tons / s.f.

BY	DATE			
MADE	T.A.L.	3-87		
CHECKED	T.F.R.	3-87	As Built	TEM 3-89
IN CHARGE	S.R.			

**RICHMOND METROPOLITAN AUTHORITY**  
**RICHMOND EXPRESSWAY SYSTEM**

**PIER 3 DETAILS**




HOWARD, NEEDLES, TAMMEN & BERGENDOFF  
consulting engineers  
Alexandria, Virginia

SCALE: AS SHOWN  
CONTRACT NO.: C-13  
SHEET NO. 14 OF 106


**AS BUILT**




RICHMOND EXPRESSWAY SYSTEM			
SECTION	PROJECT	SHEET NO.	TOTAL SHEETS
13	WIDENING JAMES RIVER BRIDGE	16	106

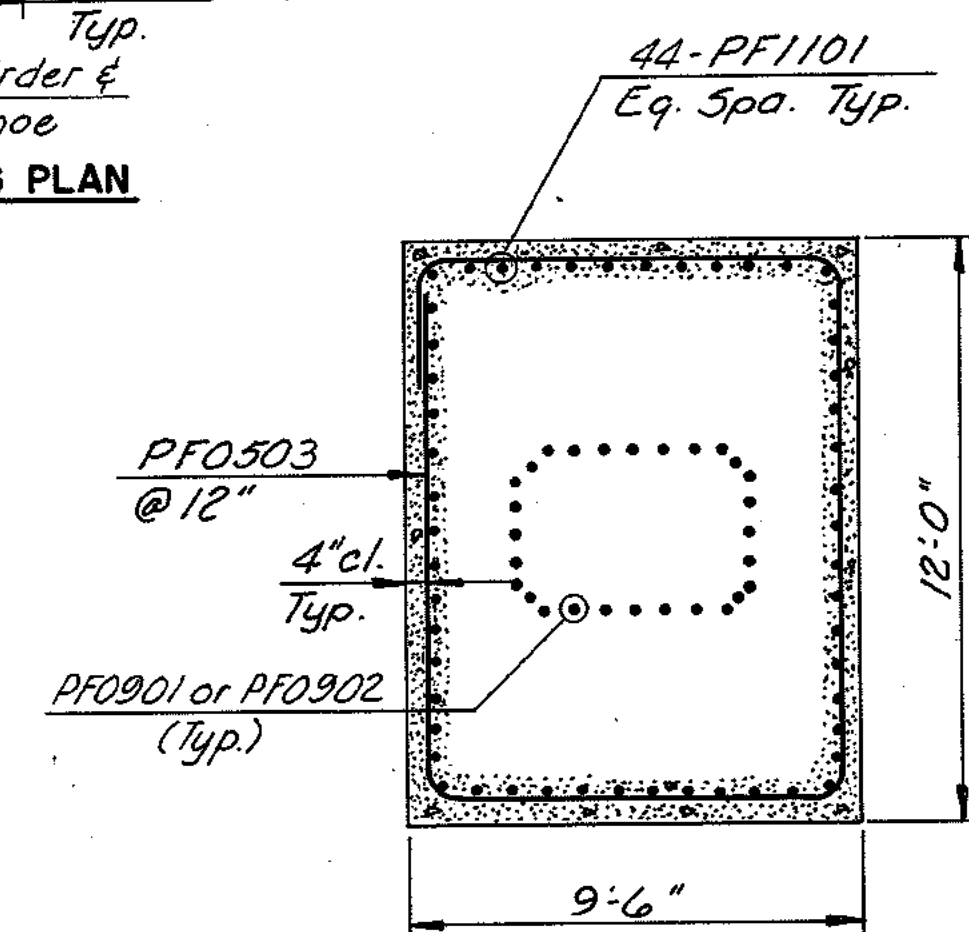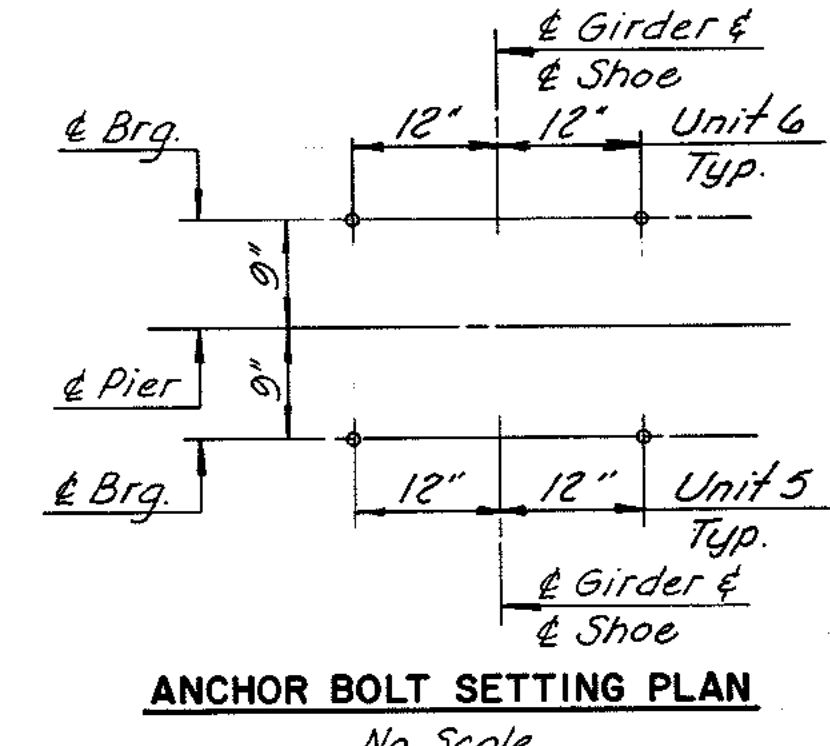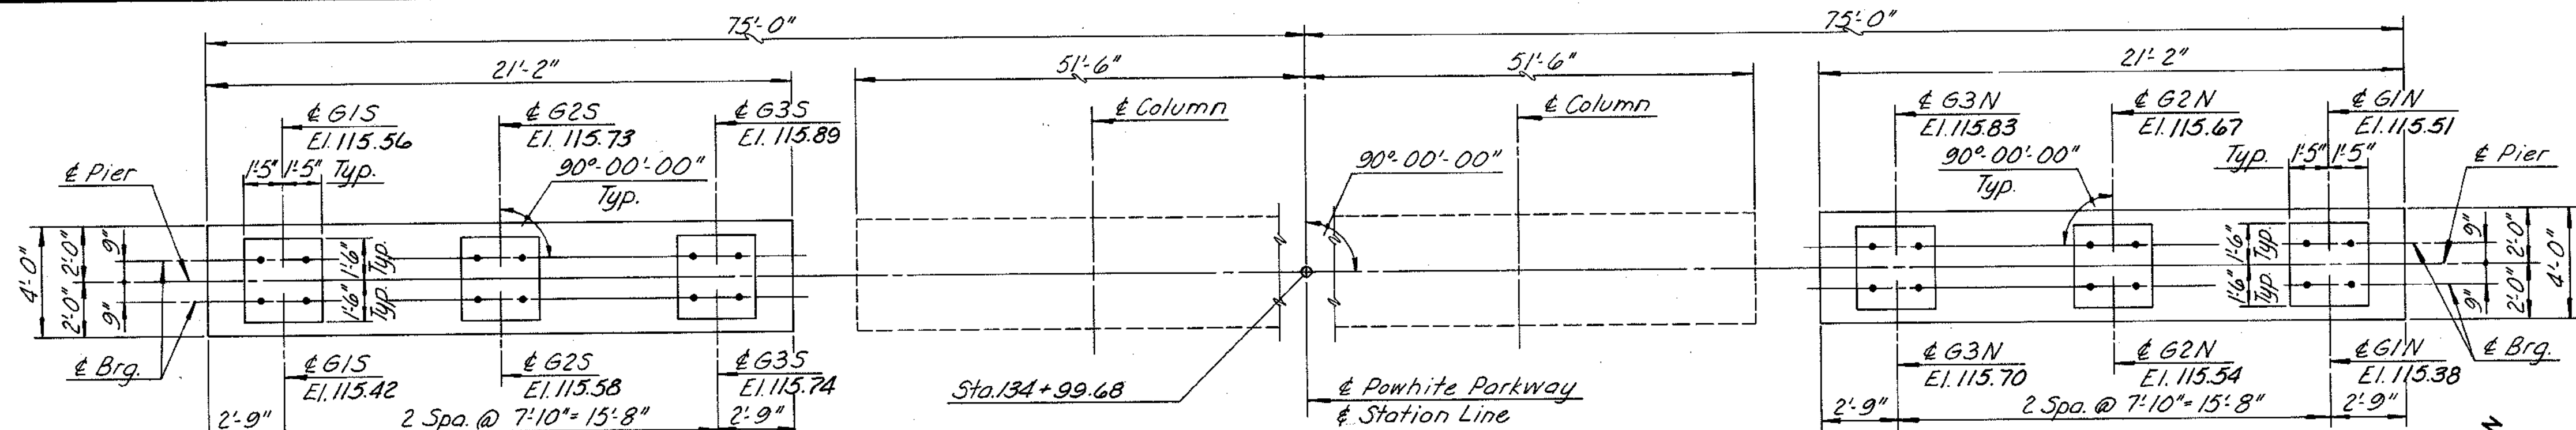


SECTION E-E  
Scale: 4"=1'-0"

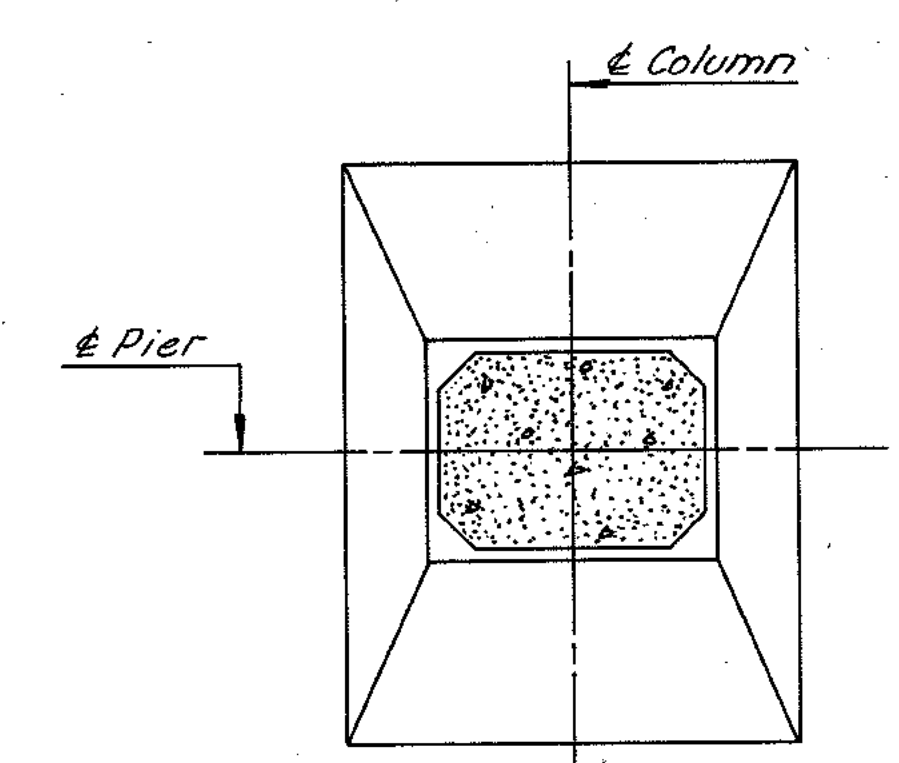


FOOTING PLAN  
Scale: 4"=1'-0"

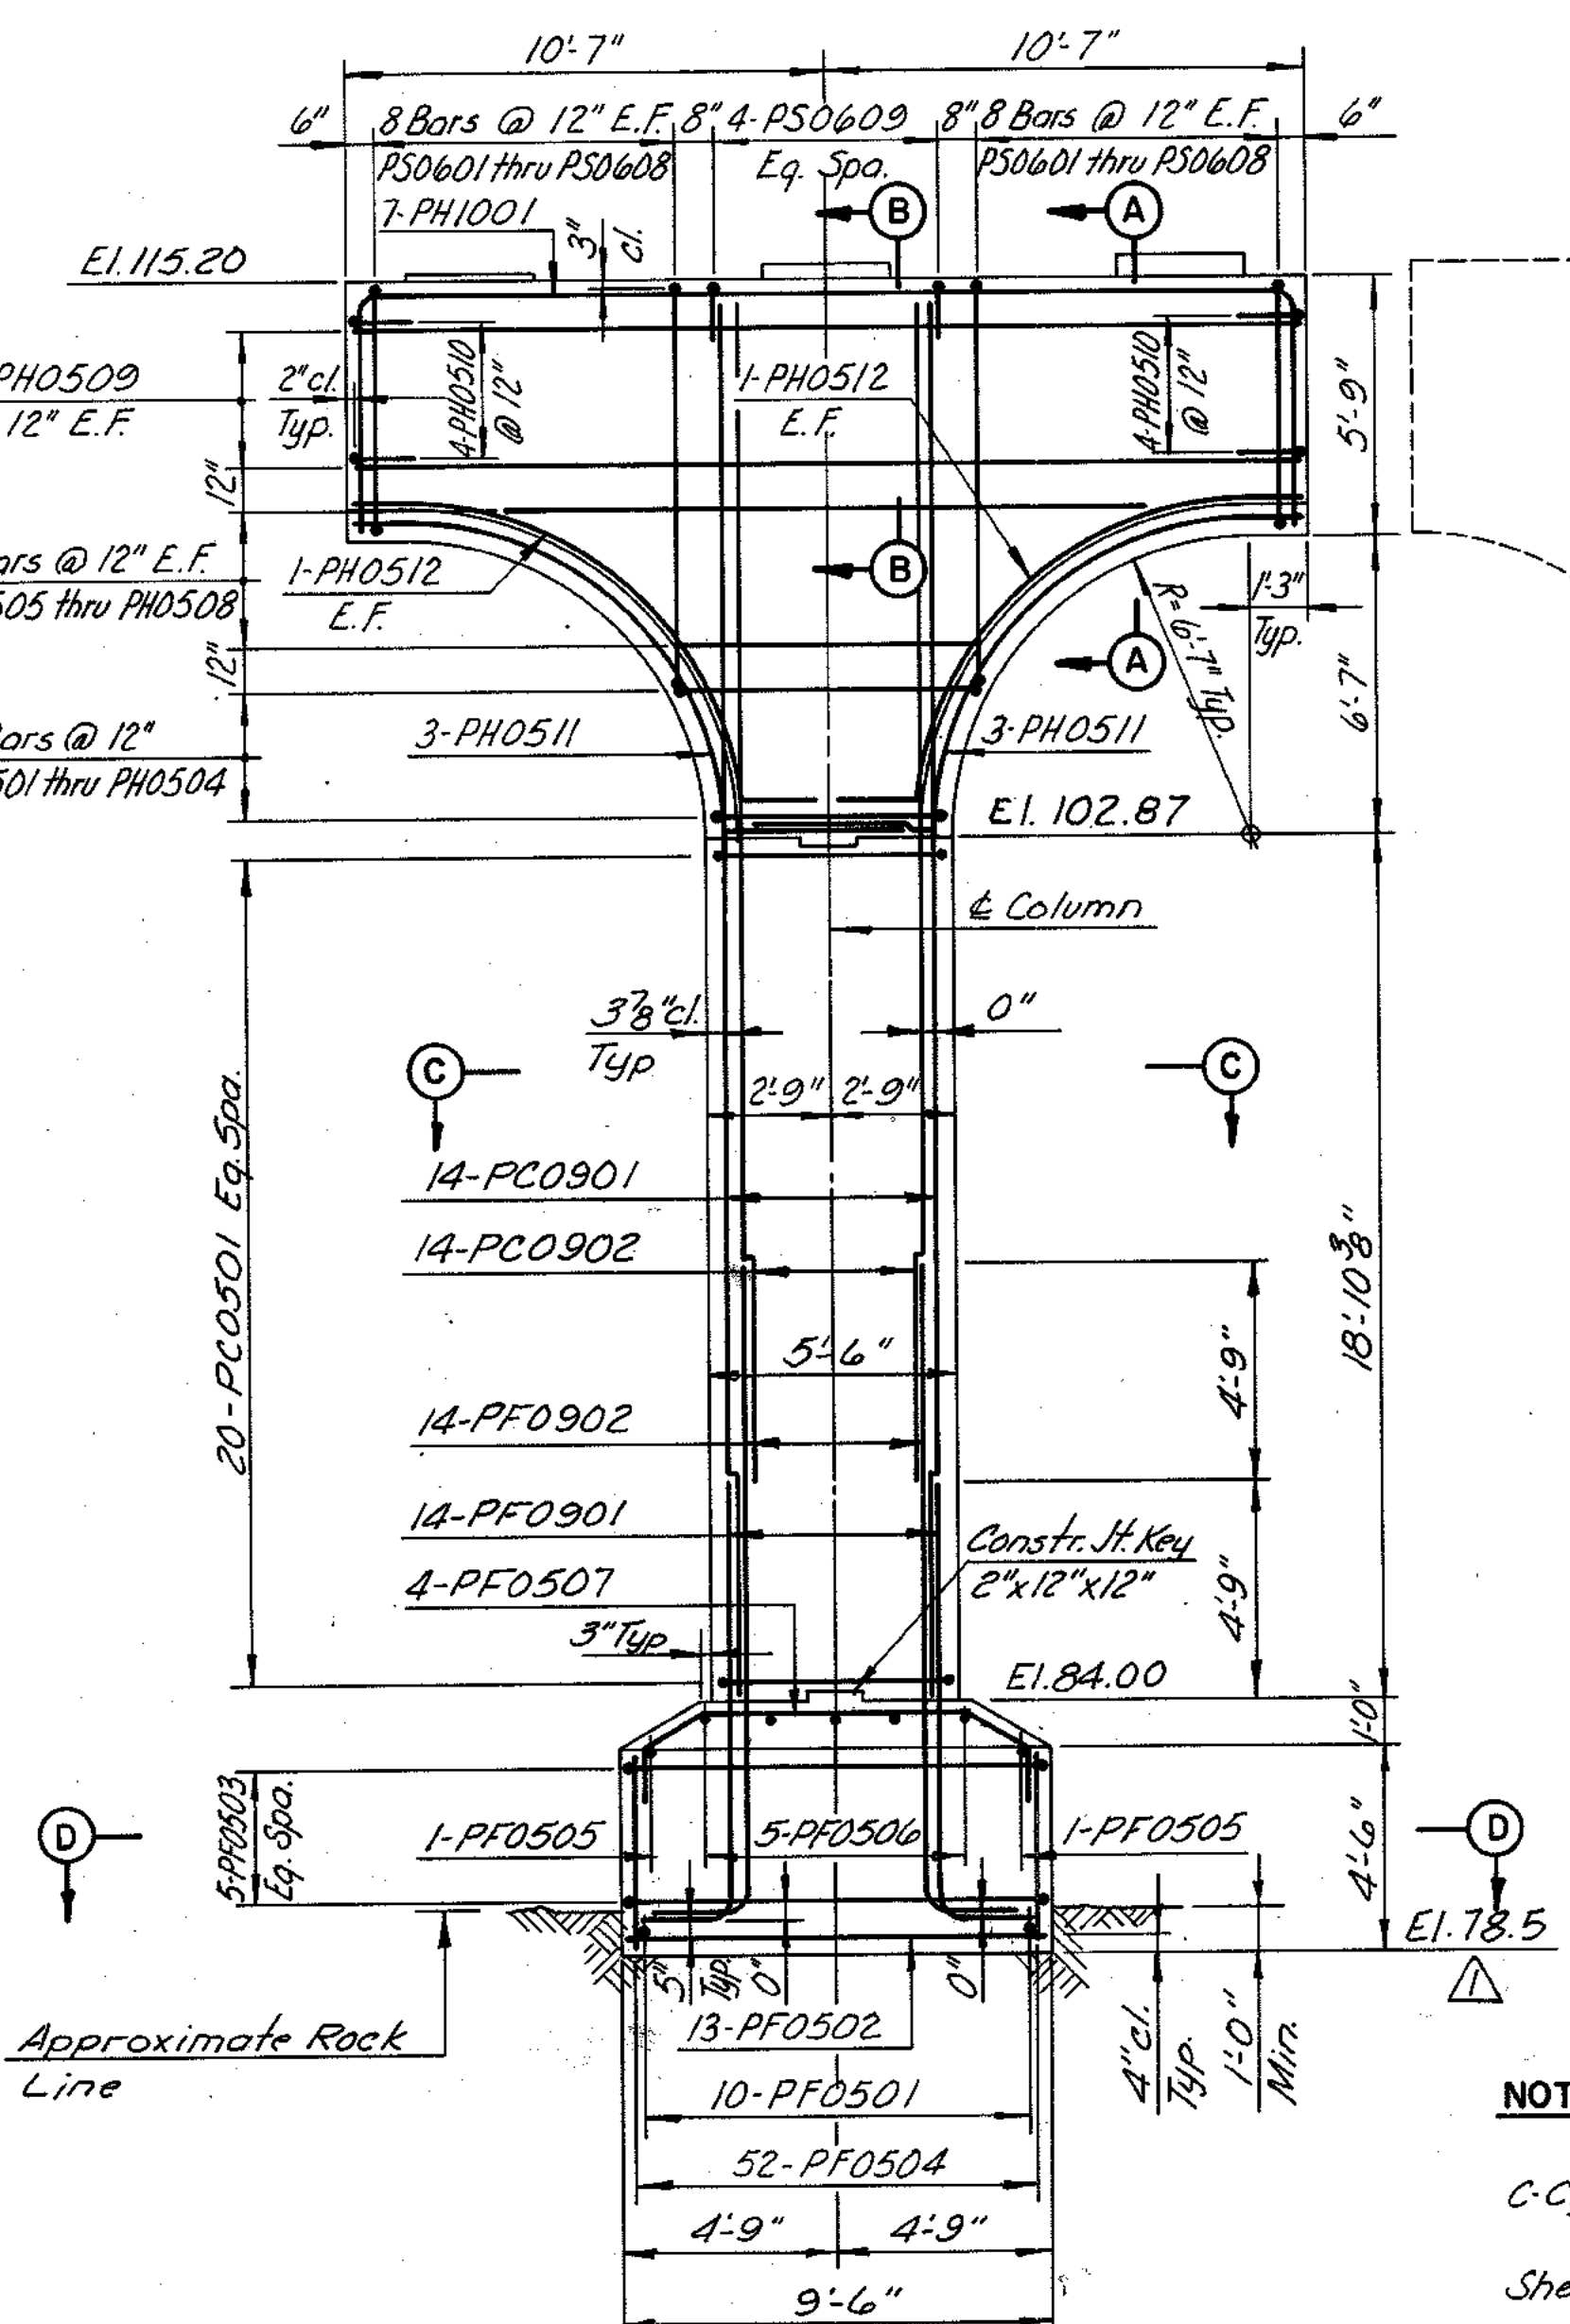

ELEVATION - SOUTHBOUND  
Scale: 4"=1'-0"

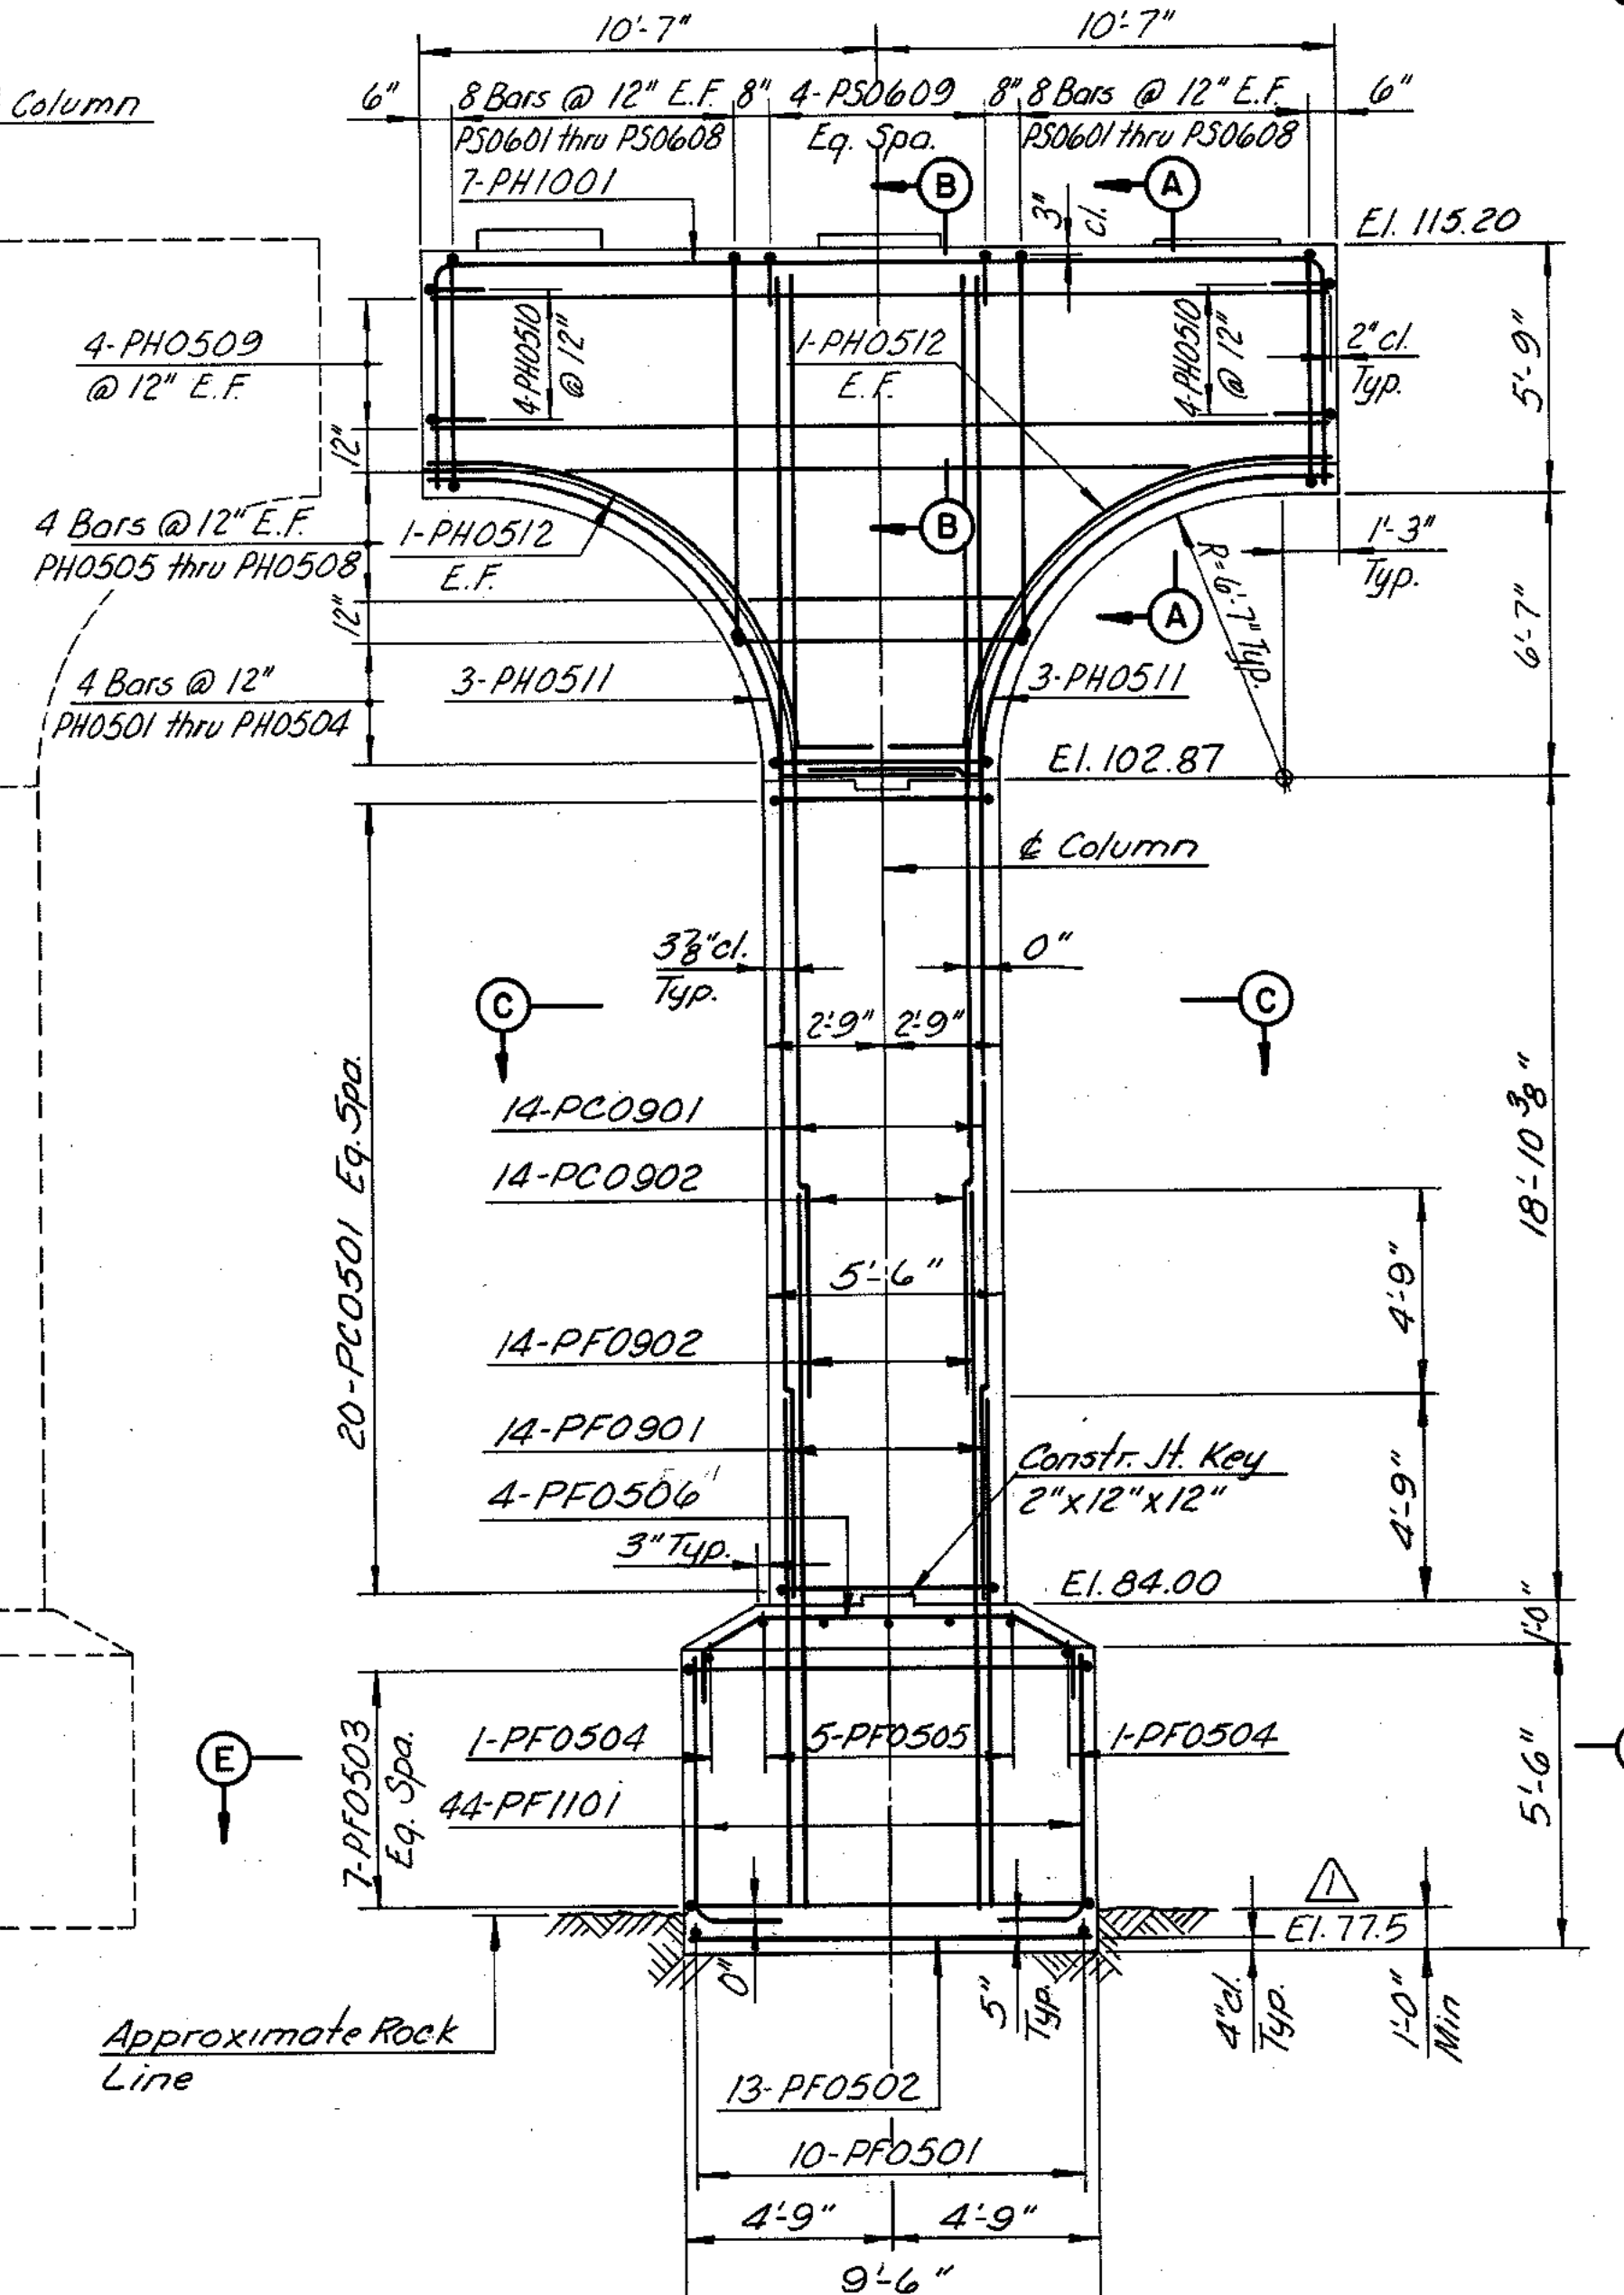

ELEVATION - NORTHBOUND  
Scale: 4"=1'-0"

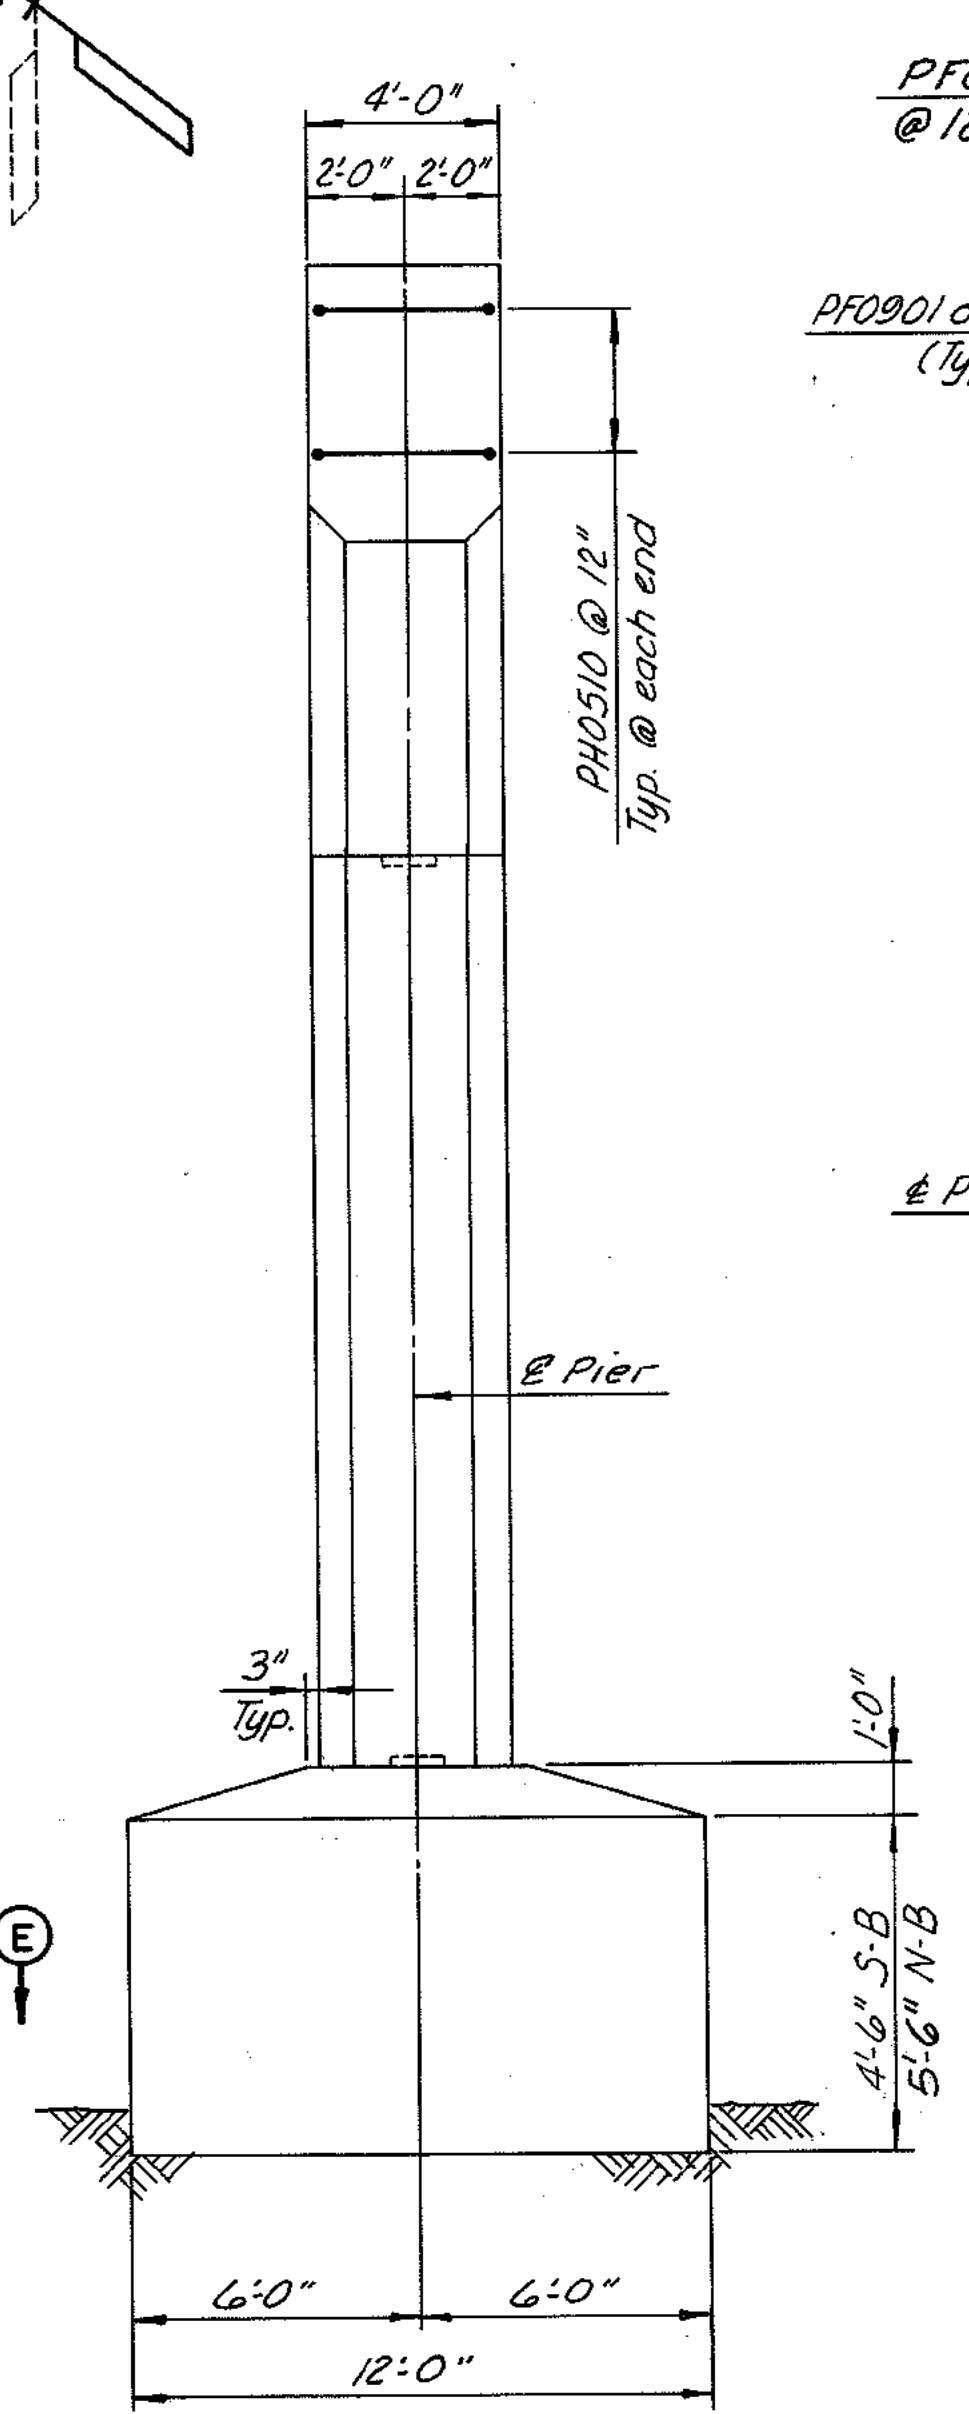

TYPICAL END VIEW  
Scale: 4"=1'-0"

**NOTES:**  
For Sections A-A, B-B and C-C, see Sheet No. 12  
For Section D-D, see Sheet No. 14  
Maximum Allowable Bearing Pressure - 10 tons/s.f.  
Actual Design Bearing Pressure - 8.4 tons/s.f.

BY	DATE				
MADE	T.A.L.	3-87			
CHECKED	T.F.P.	3-87	As Built	TEM	3-89
IN CHARGE	S.R.				







**RICHMOND METROPOLITAN AUTHORITY  
RICHMOND EXPRESSWAY SYSTEM**

**PIER 5 DETAILS**

HOWARD, NEEDLES, TAMMEN & BERGENDOFF  
consulting engineers  
Alexandria, Virginia  
SCALE: AS SHOWN  
CONTRACT NO.: C-13  
SHEET NO. 16 of 106

**AS BUILT**

RICHMOND EXPRESSWAY SYSTEM			
SECTION	PROJECT	SHEET NO.	TOTAL SHEETS
13	WIDENING JAMES RIVER BRIDGE	18	106

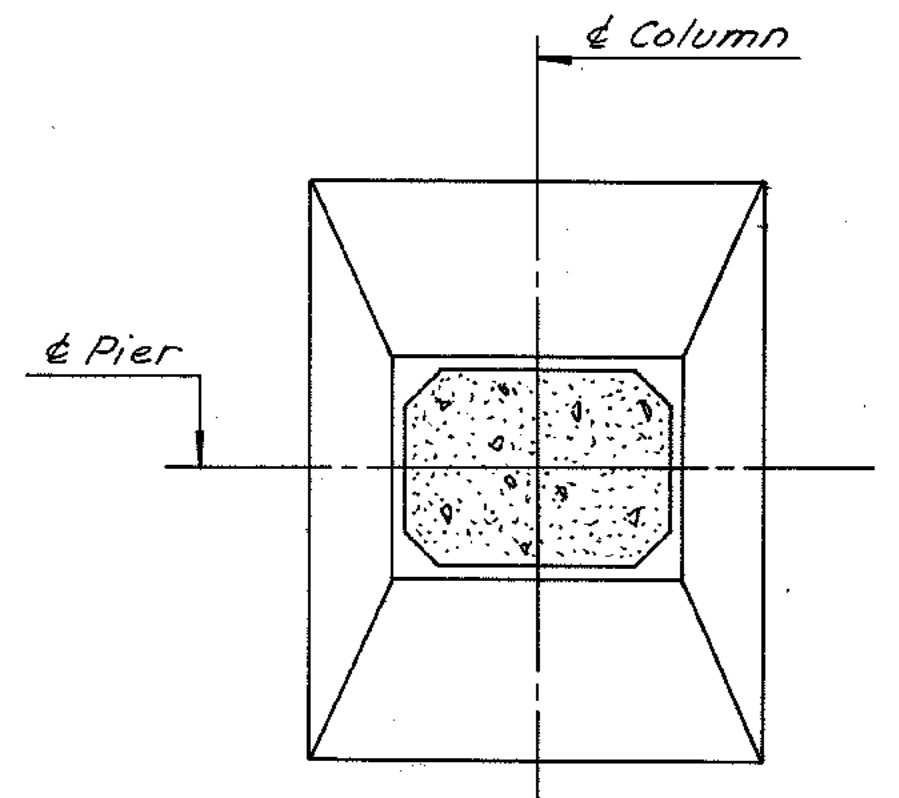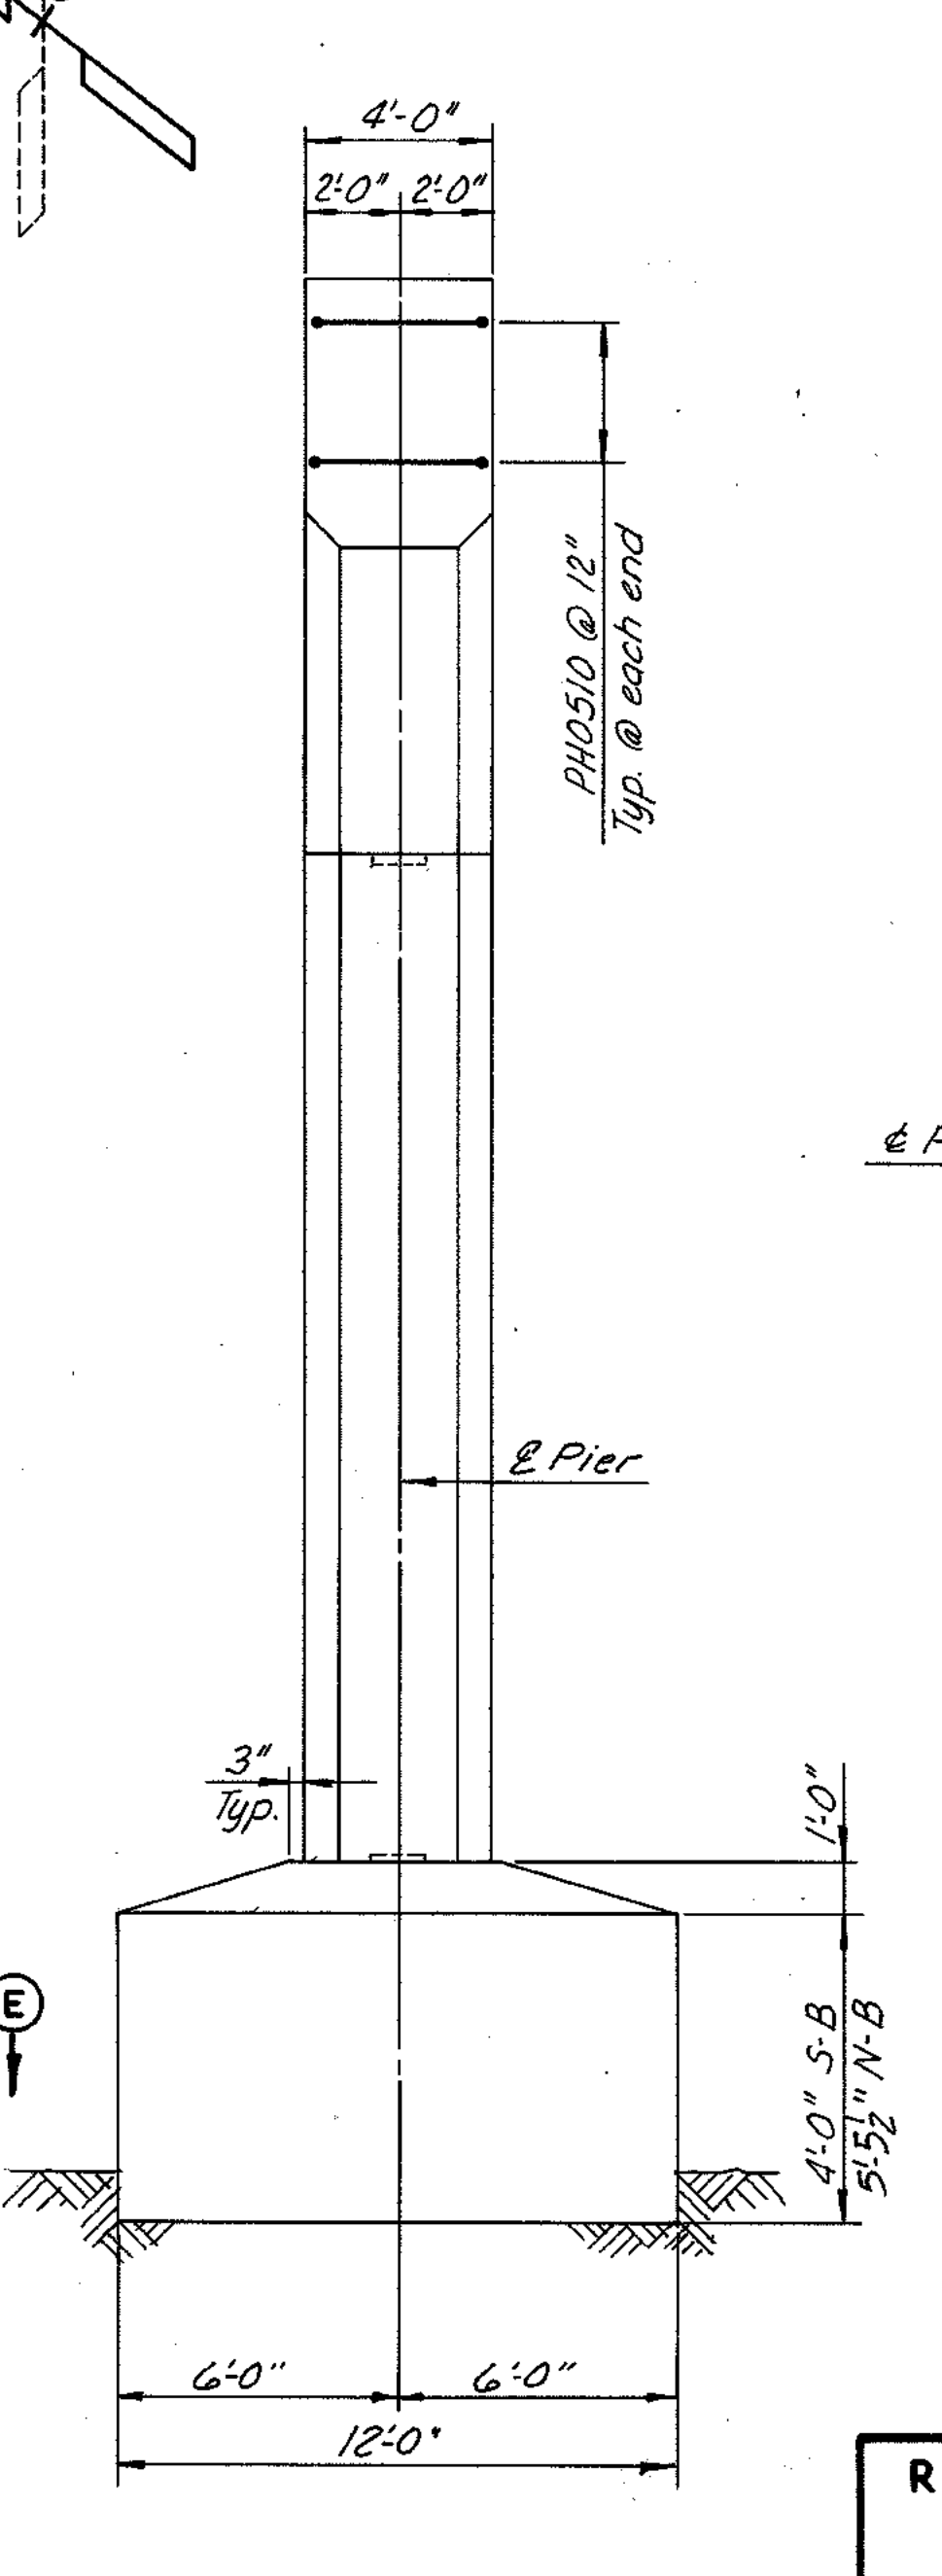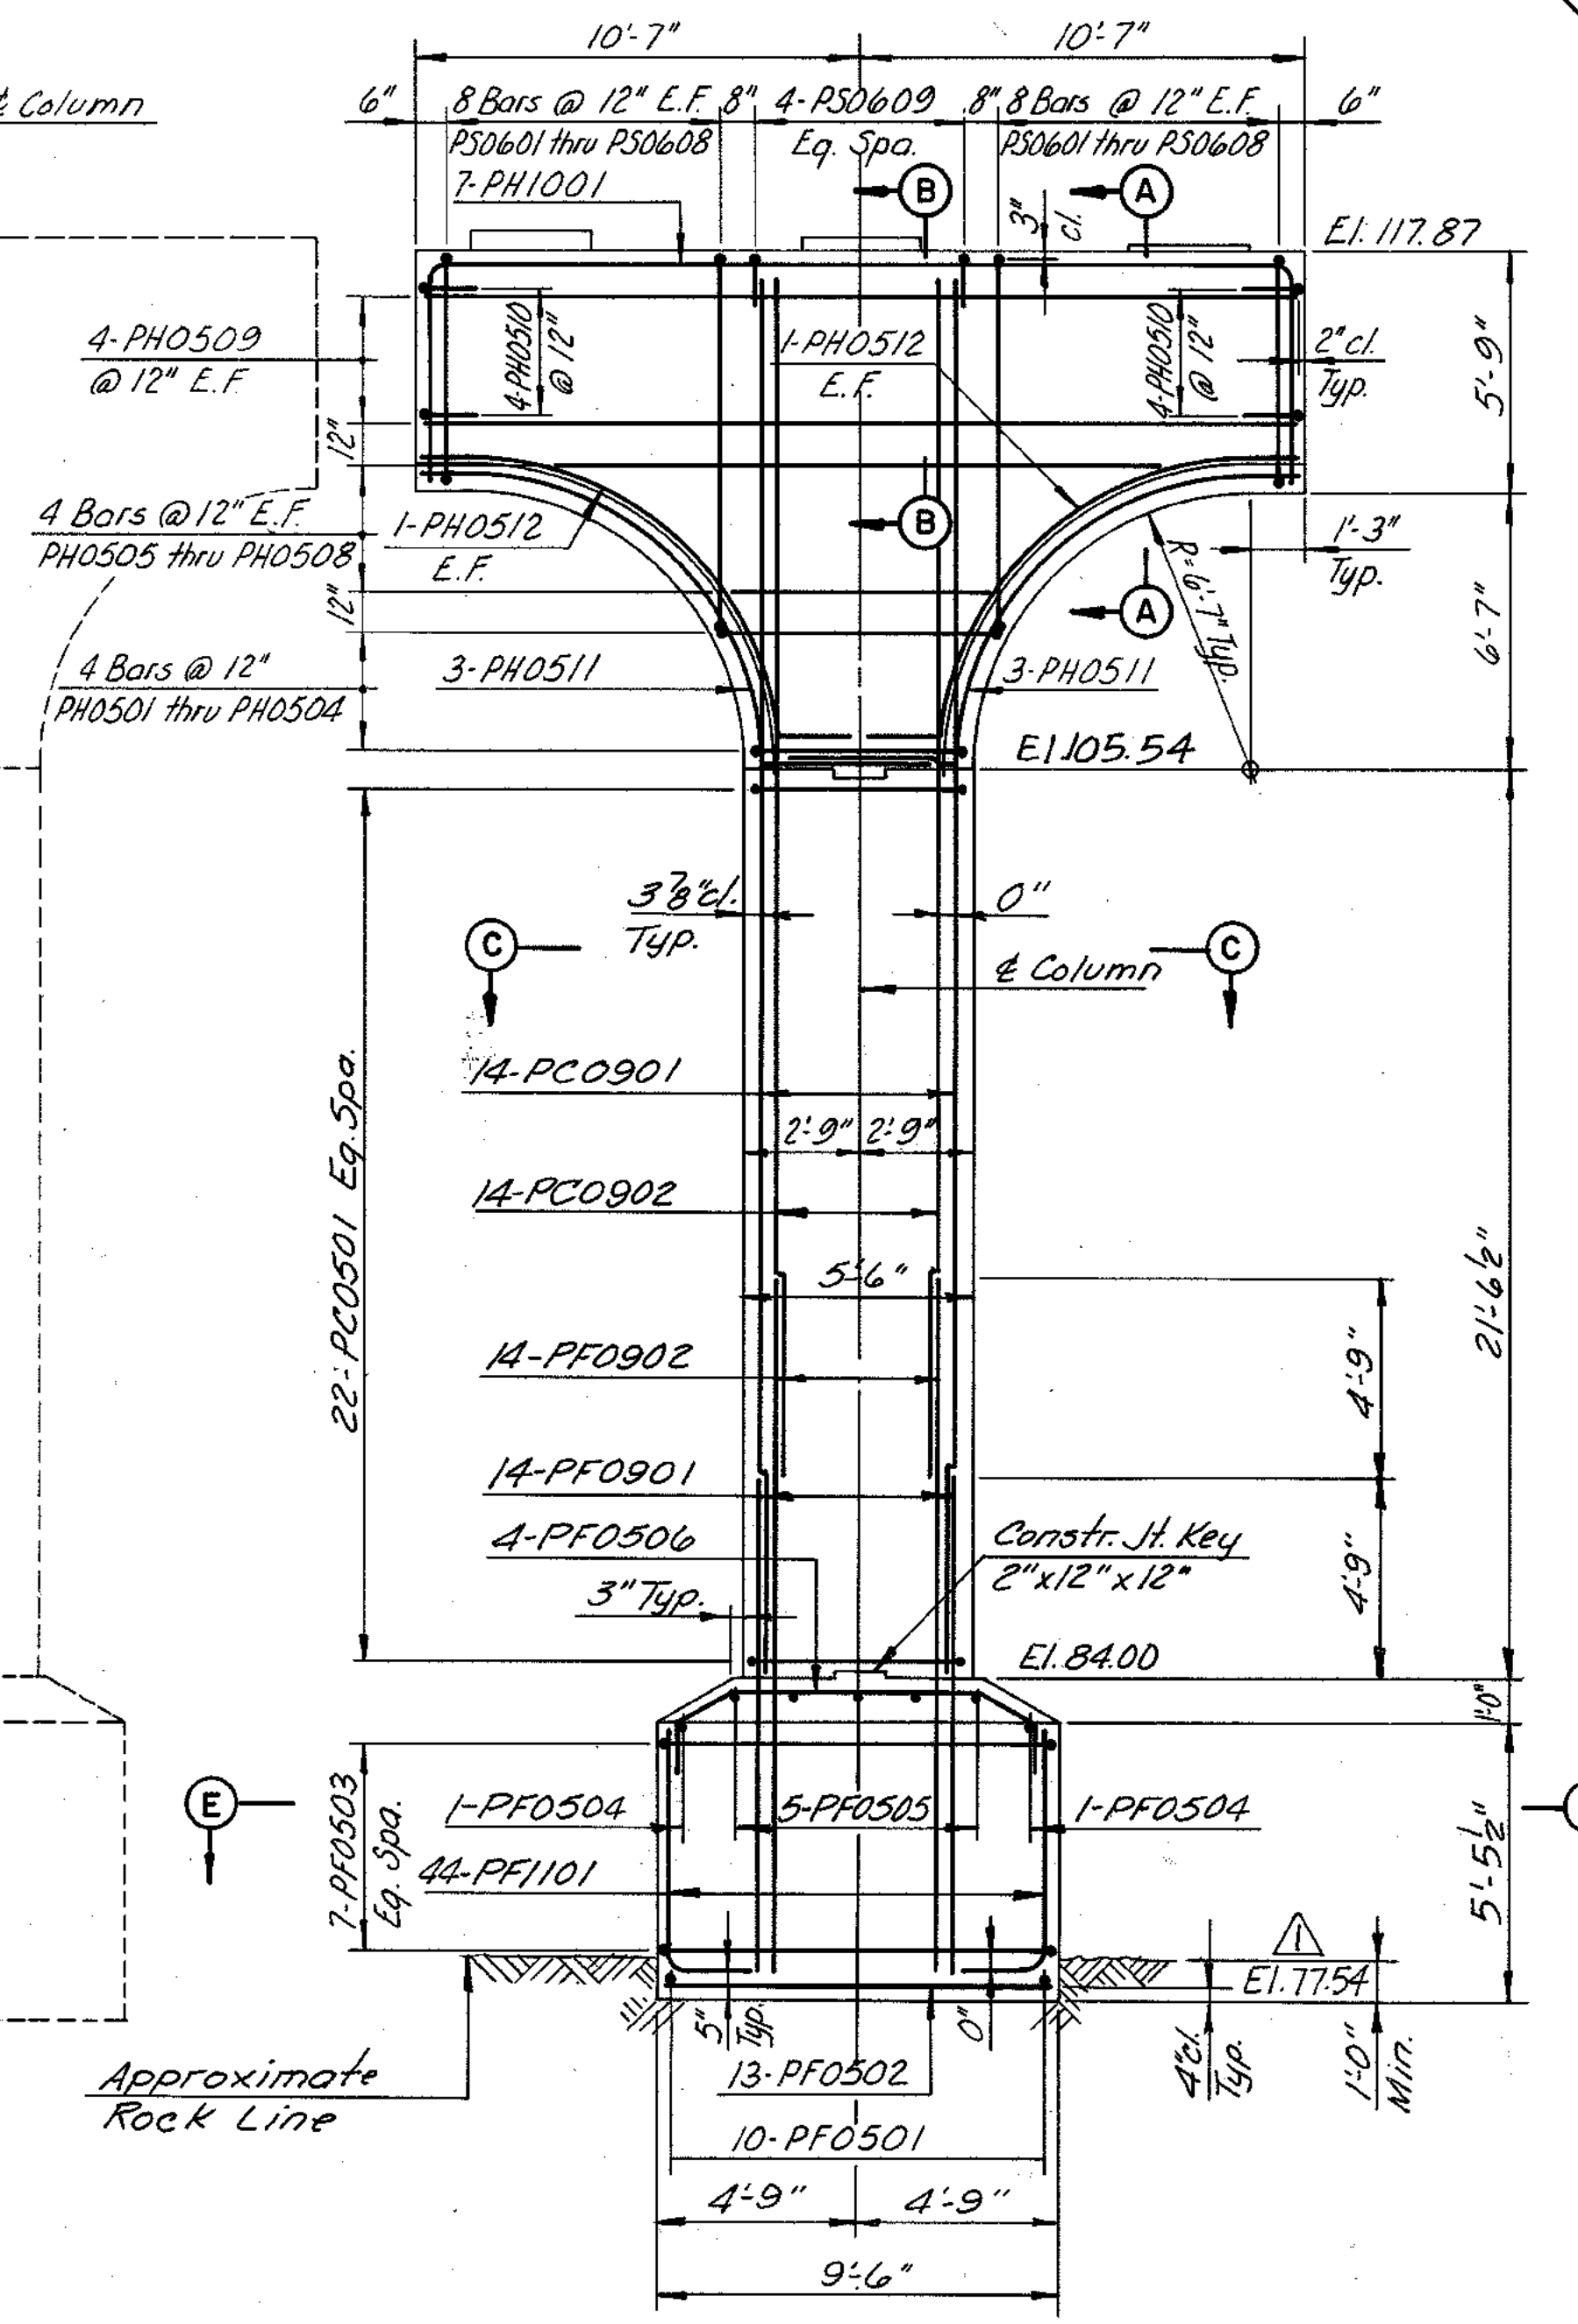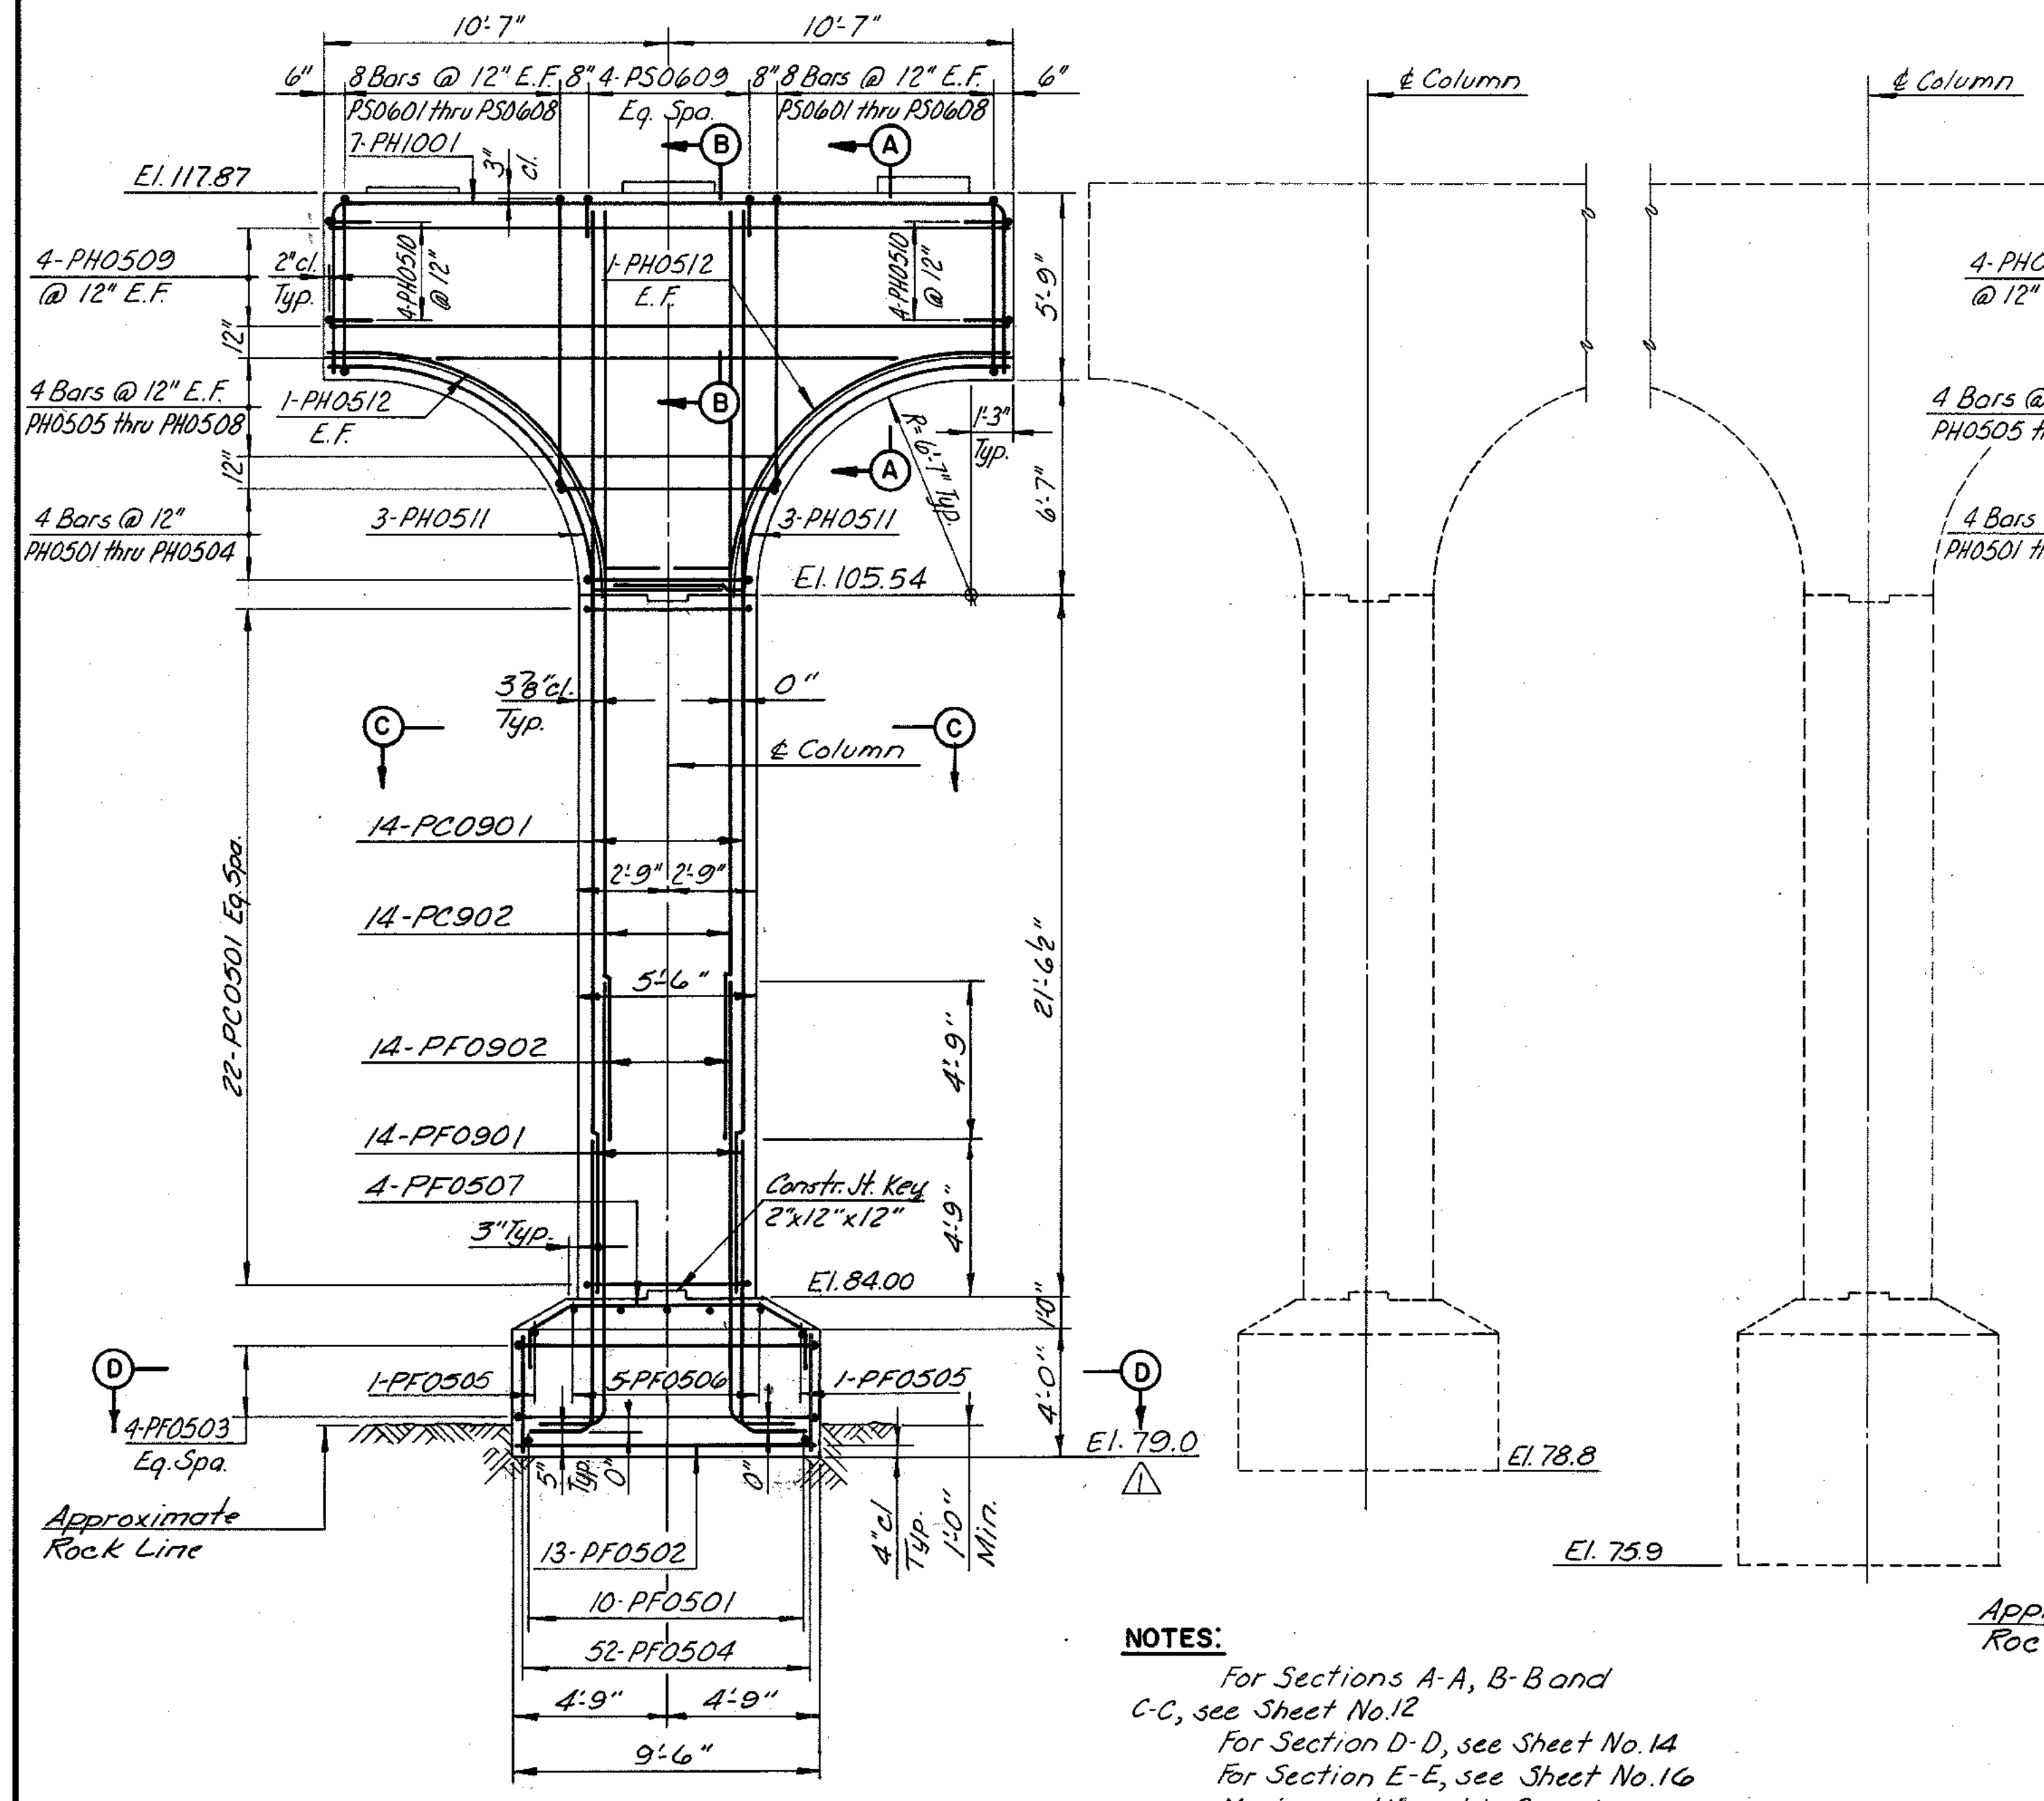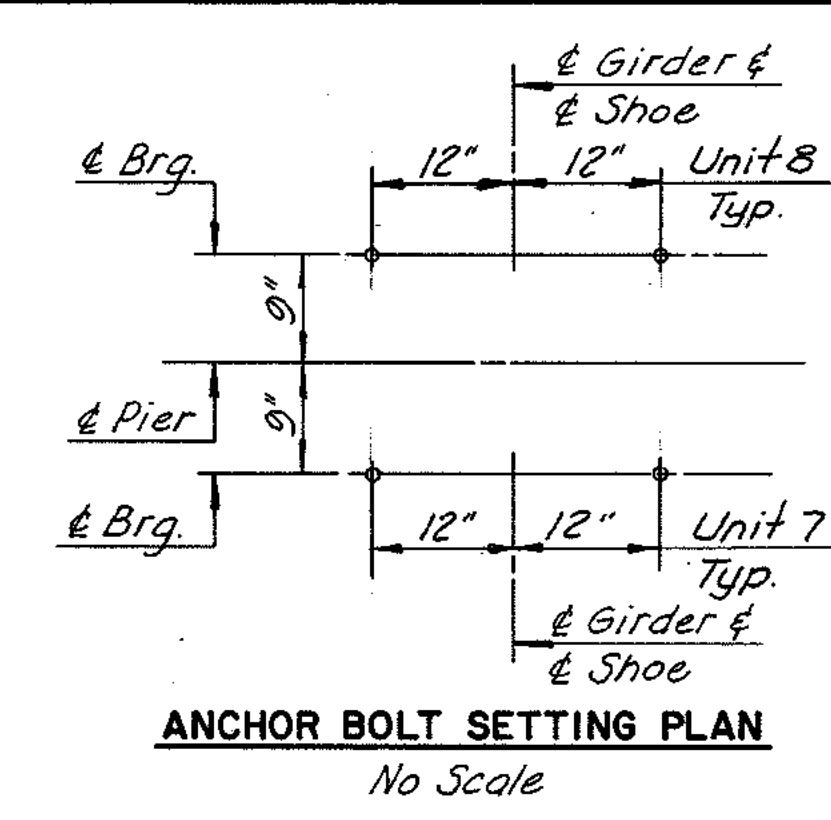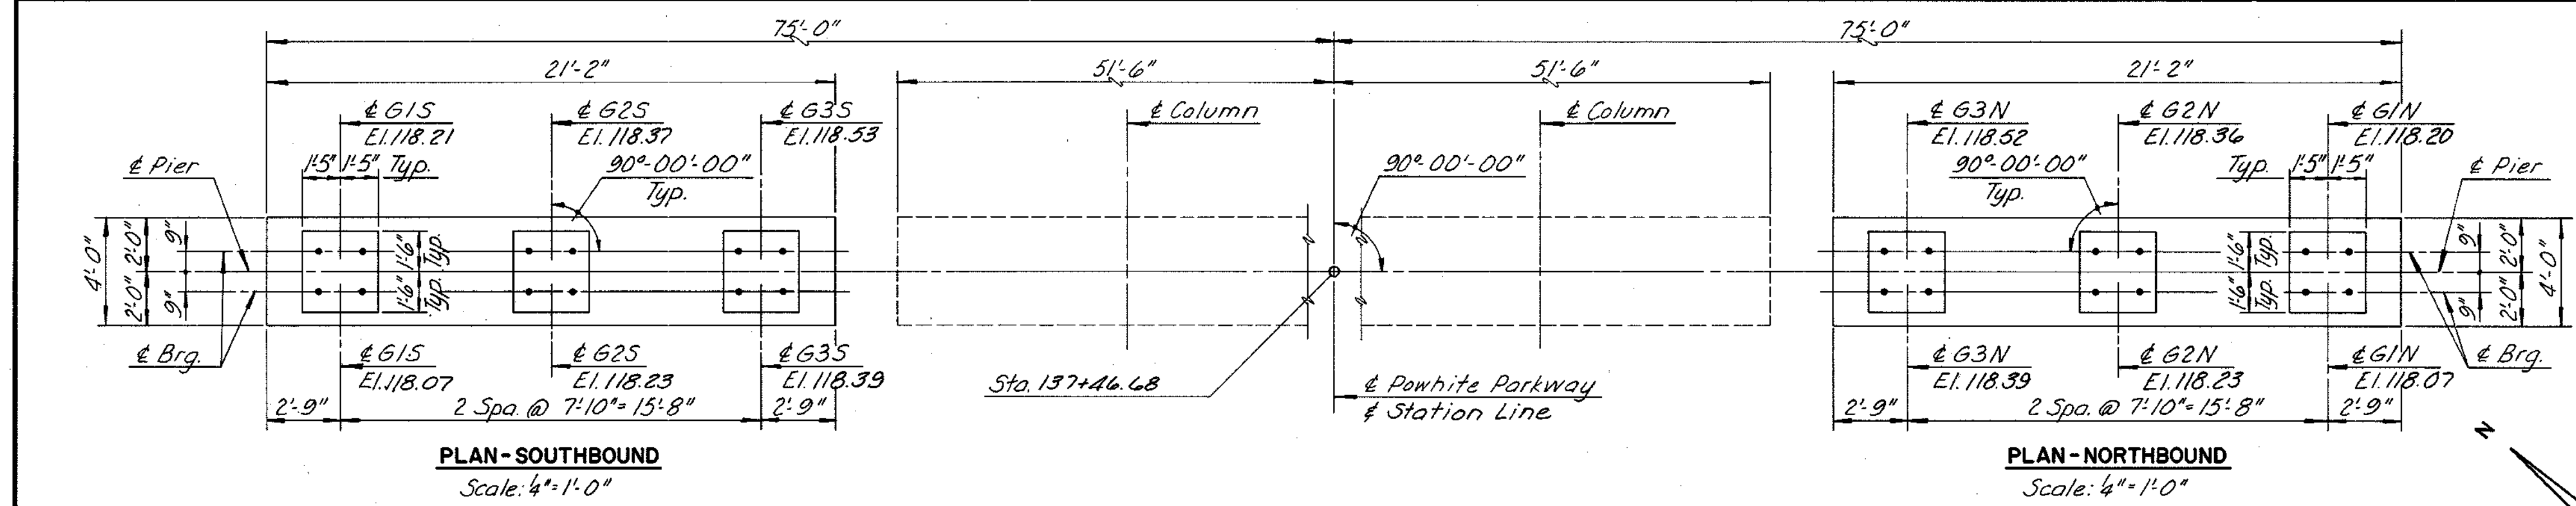

**NOTES:**  
 For Sections A-A, B-B and C-C, see Sheet No. 12  
 For Section D-D, see Sheet No. 14  
 For Section E-E, see Sheet No. 16  
 Maximum Allowable Bearing Pressure - 10 tons/s.f.  
 Actual Design Bearing Pressure -  
 Southbound 7.9 tons/s.f.  
 Northbound 8.3 tons/s.f.

BY	DATE				
MADE	TAL	3-87			
CHECKED	T.F.R	3-87	As Built	TEM	3-89
IN CHARGE	S.R.				

**RICHMOND METROPOLITAN AUTHORITY**  
**RICHMOND EXPRESSWAY SYSTEM**







**PIER 7 DETAILS**

HOWARD, NEEDLES, TAMMEN & BERGENDOFF  
consulting engineers  
Alexandria, Virginia

SCALE: AS SHOWN  
CONTRACT NO.: C-13  
SHEET NO. 18 OF 106

**AS BUILT**

RICHMOND EXPRESSWAY SYSTEM			
SECTION	PROJECT	SHEET NO.	TOTAL SHEETS
13	WIDENING JAMES RIVER BRIDGE	22	106

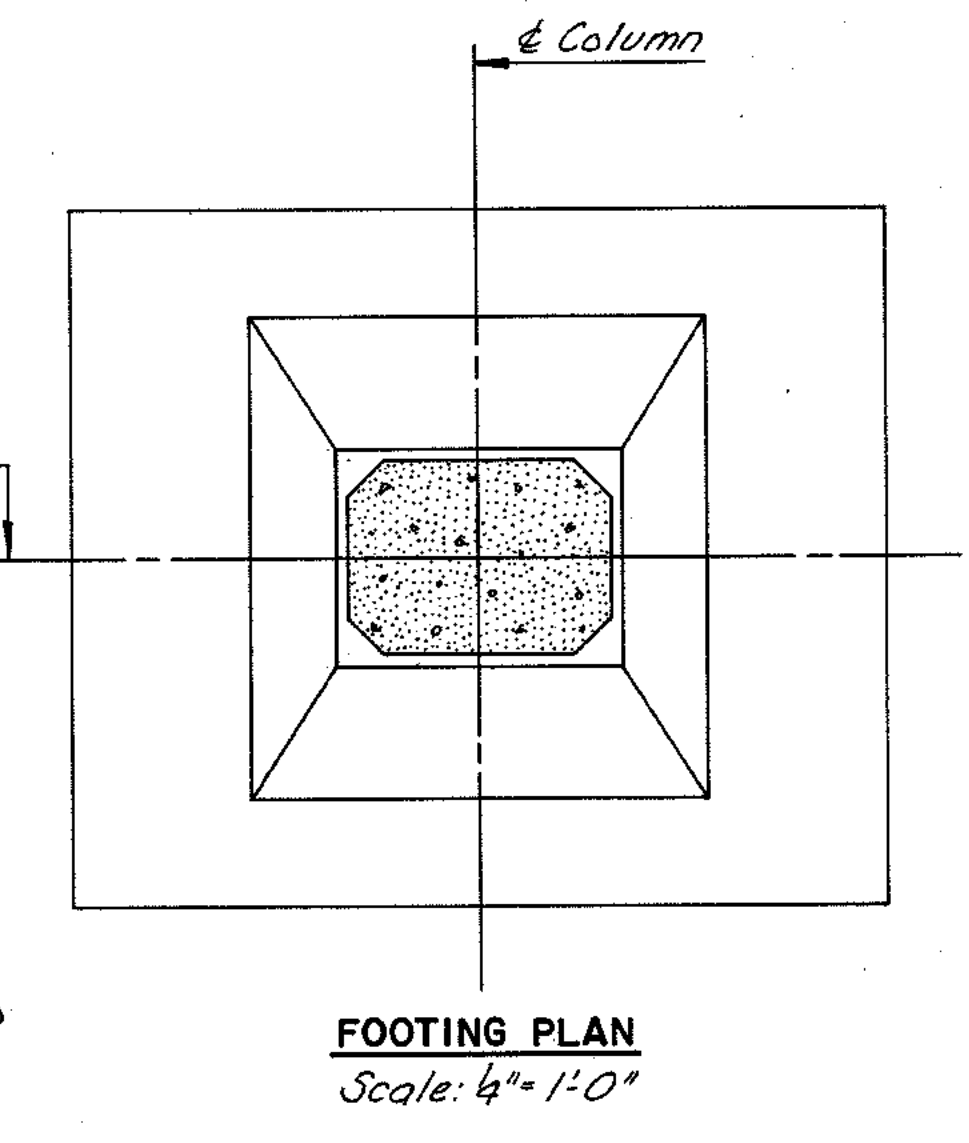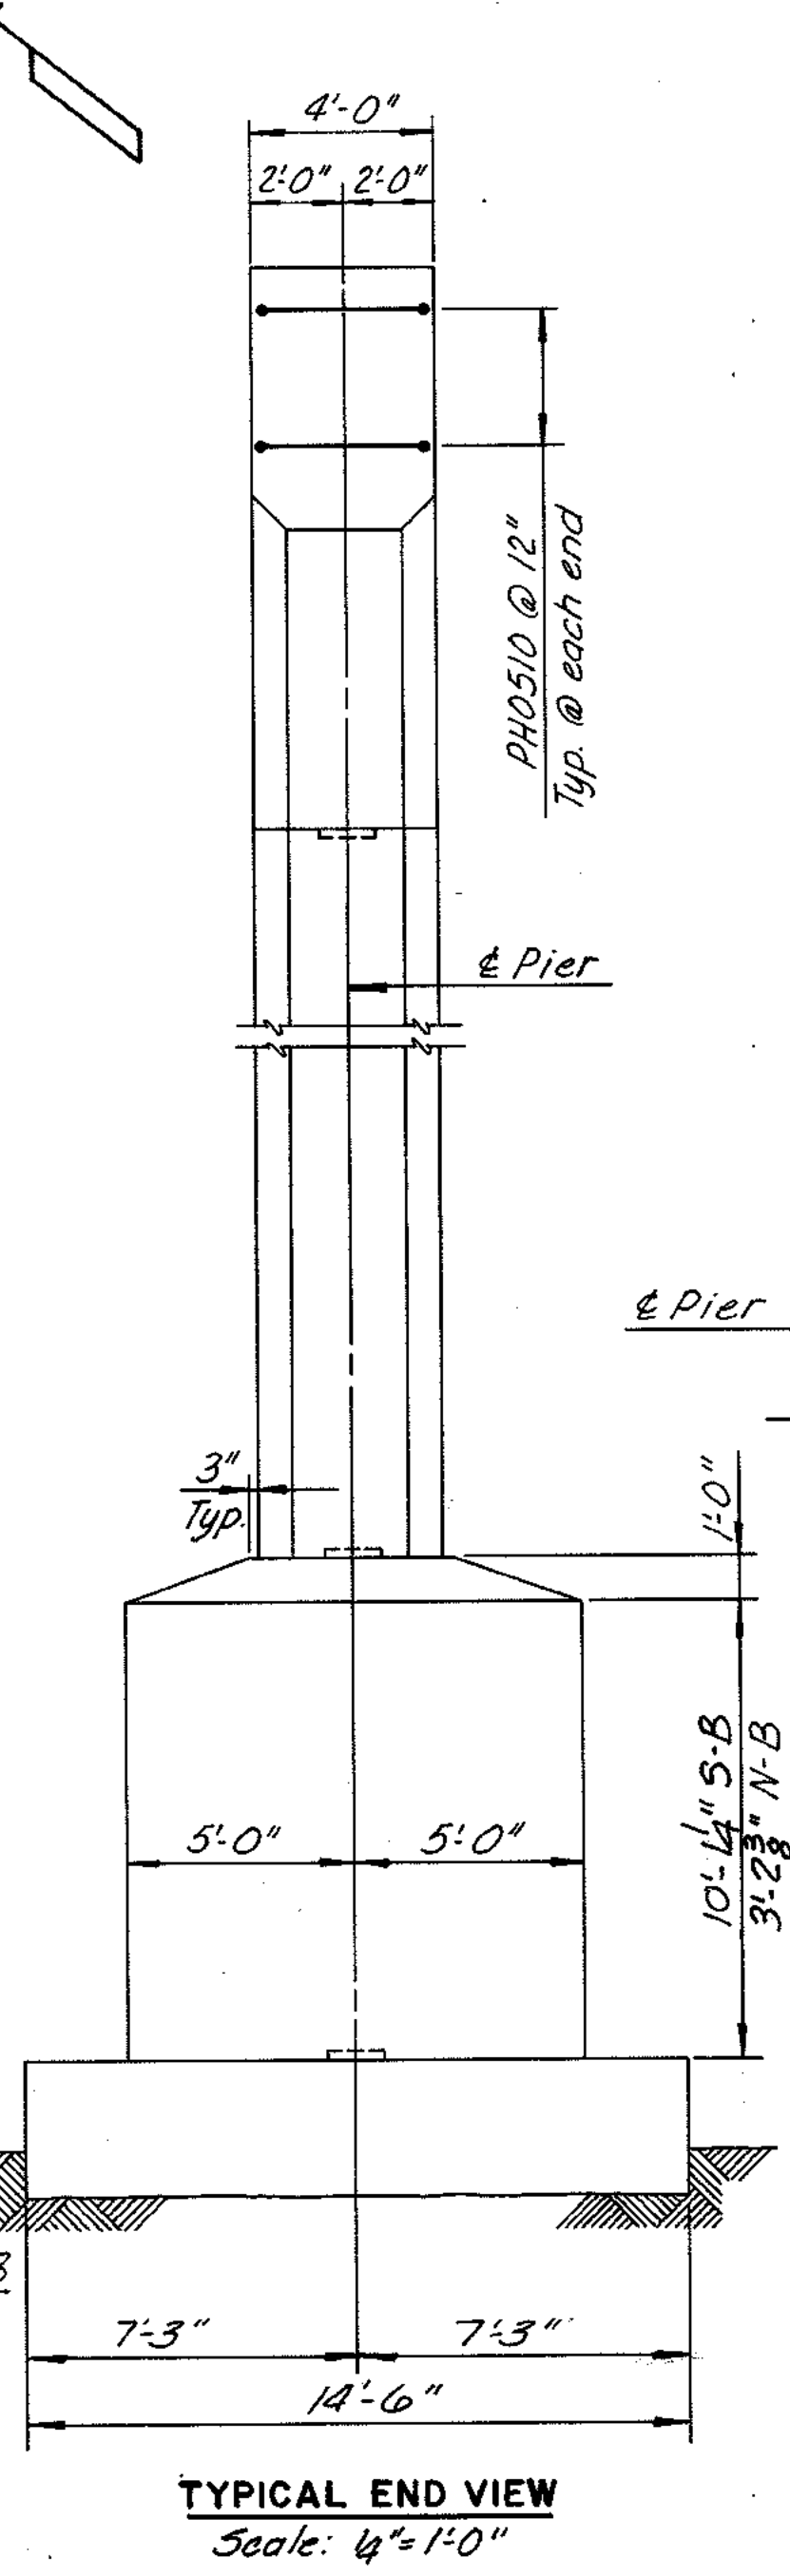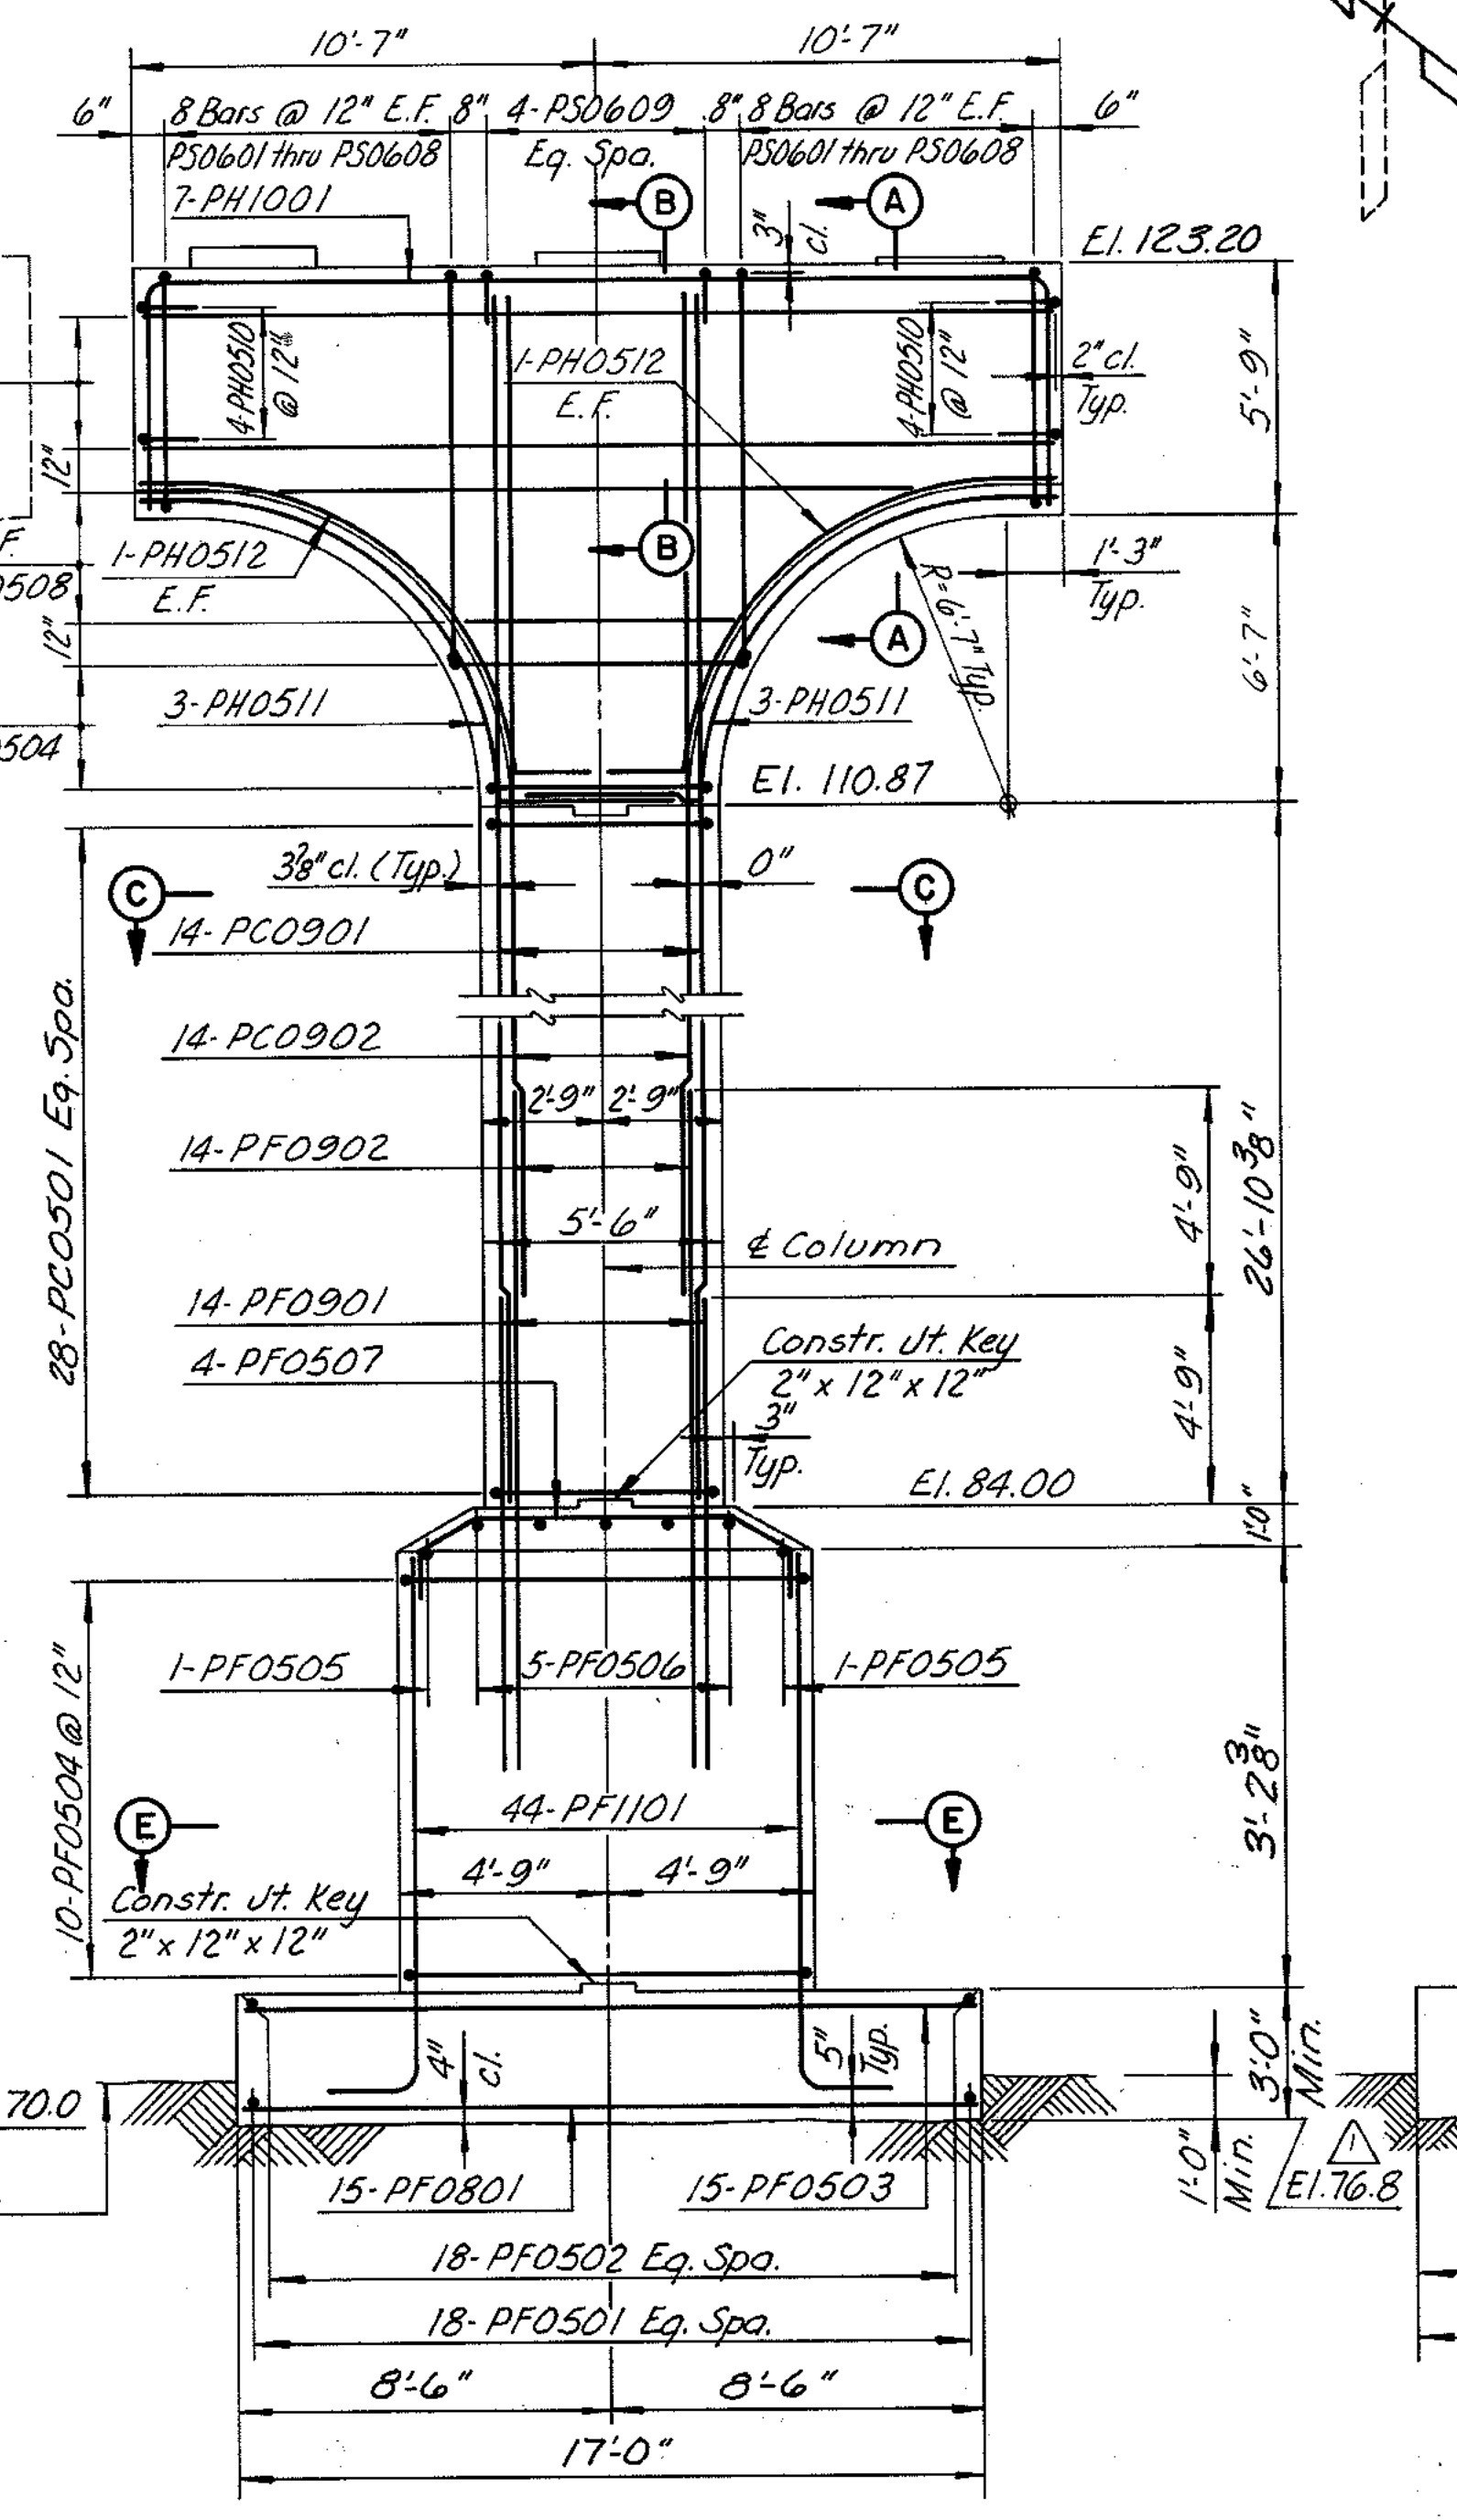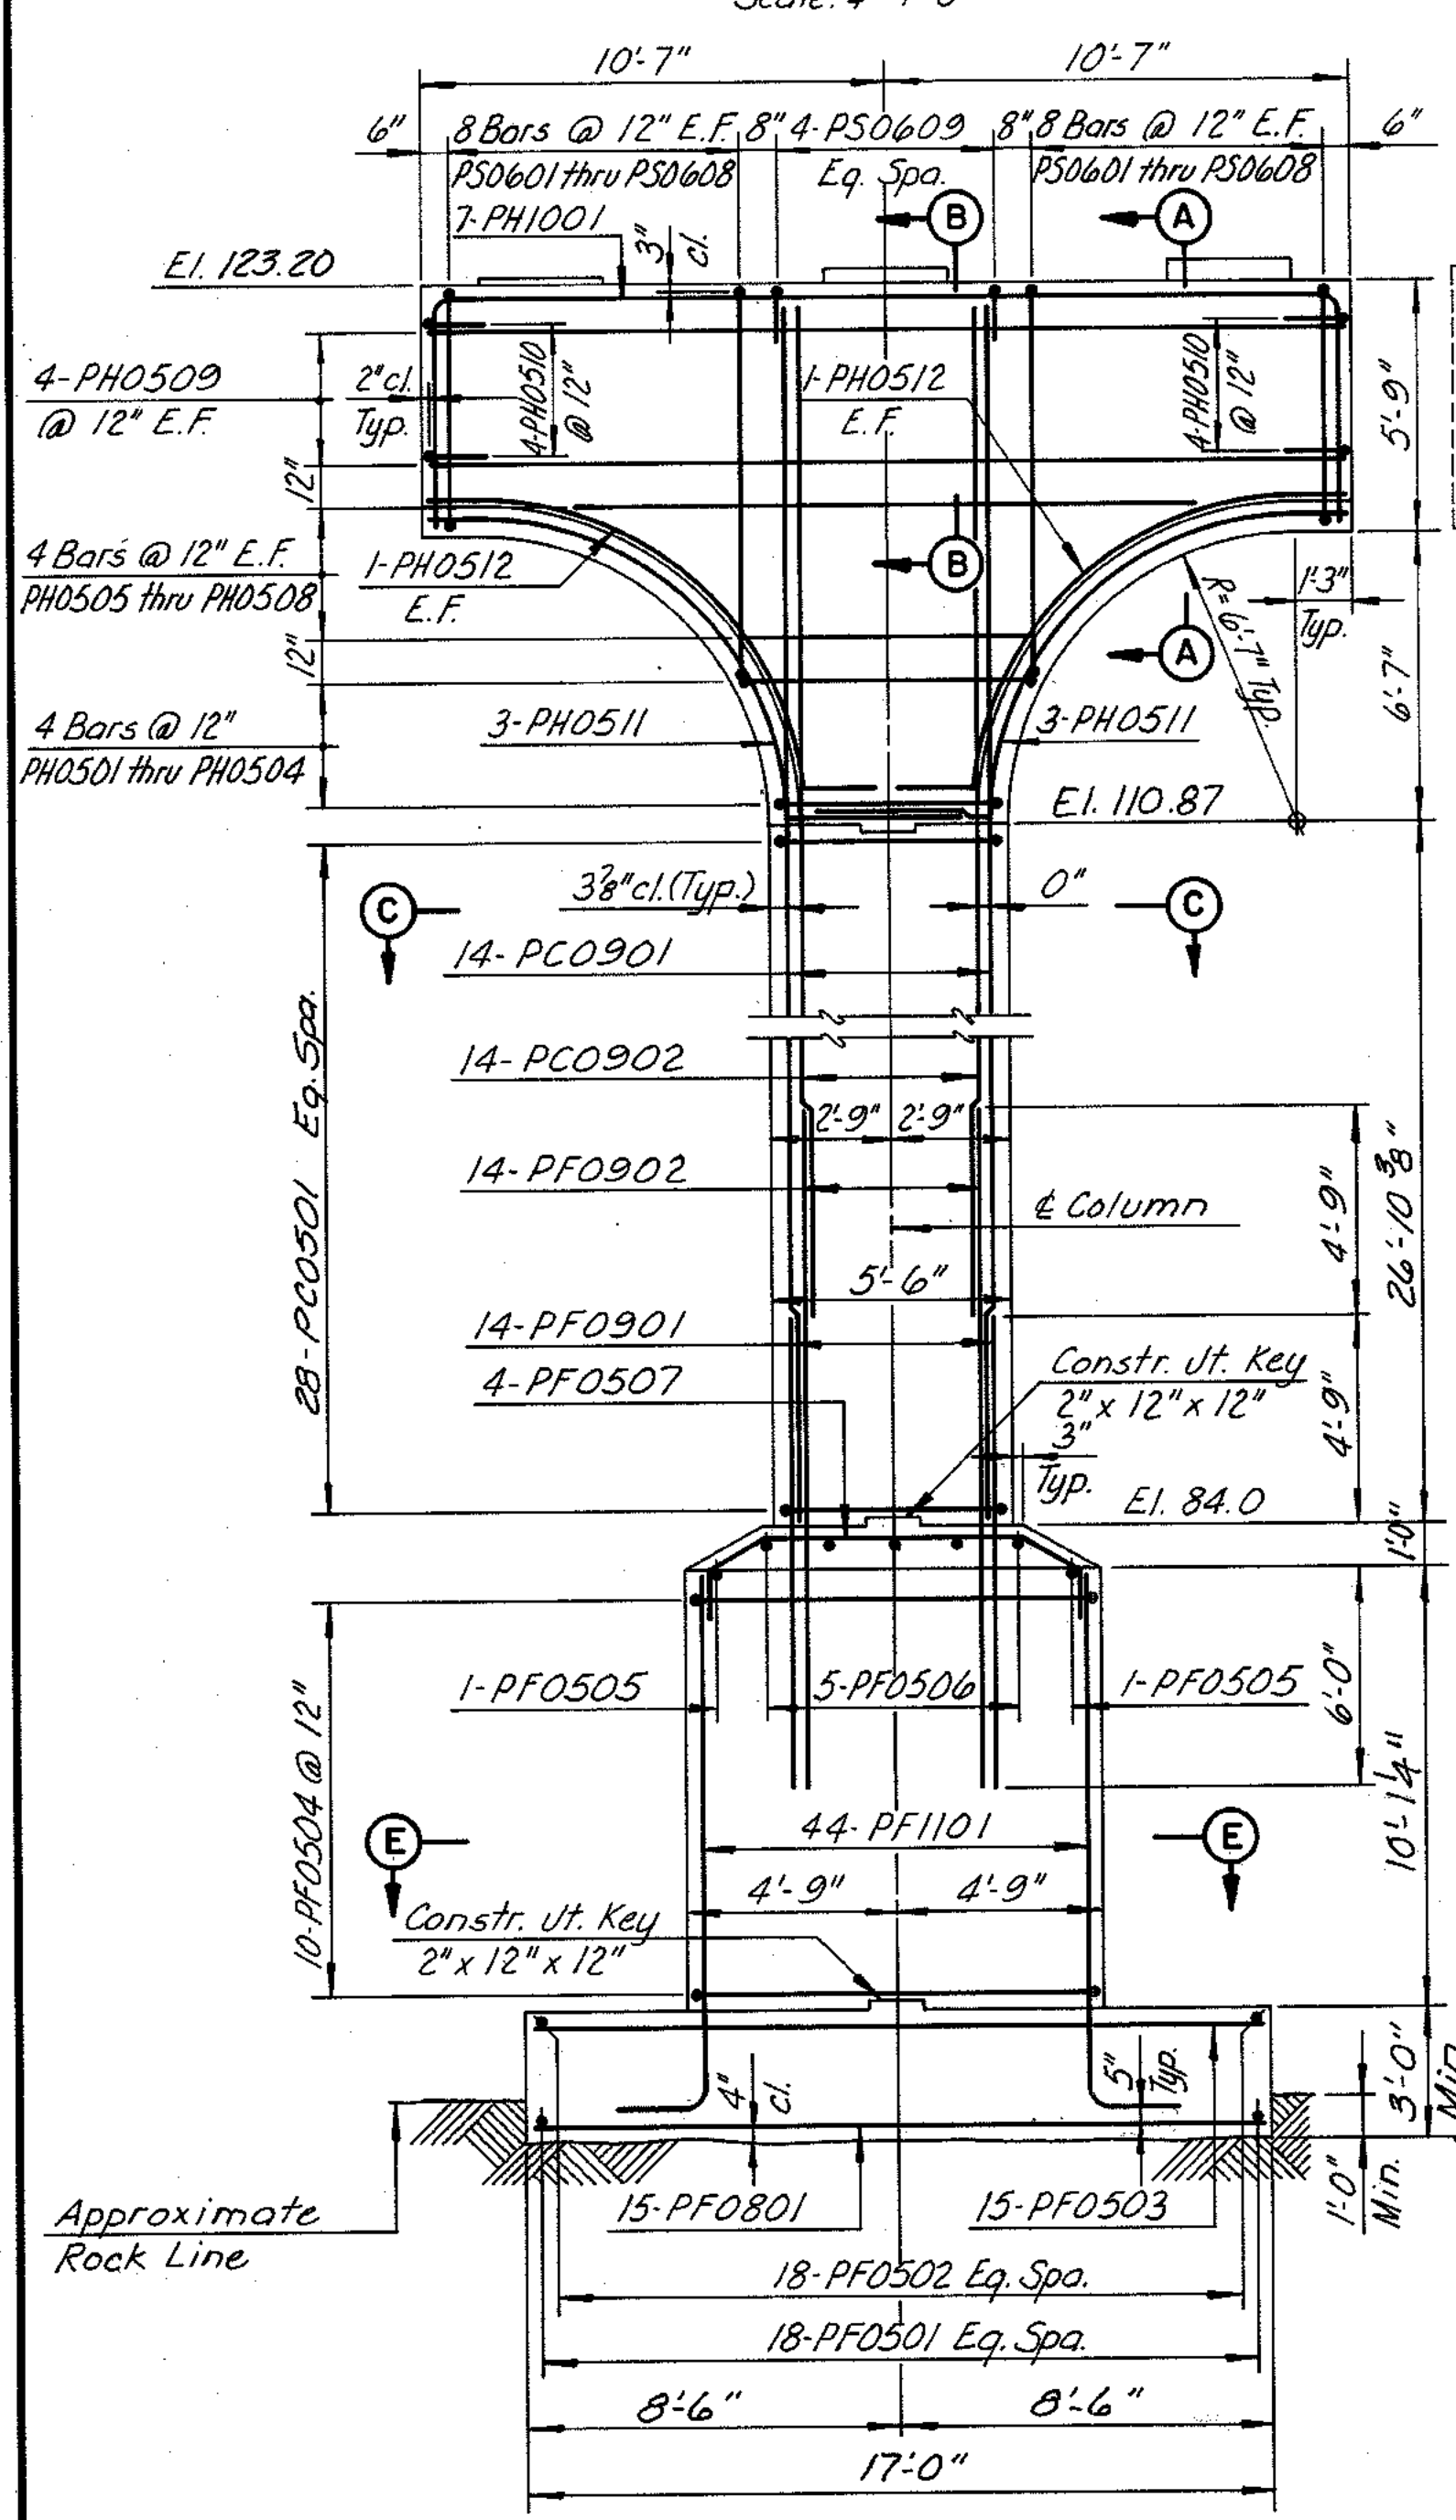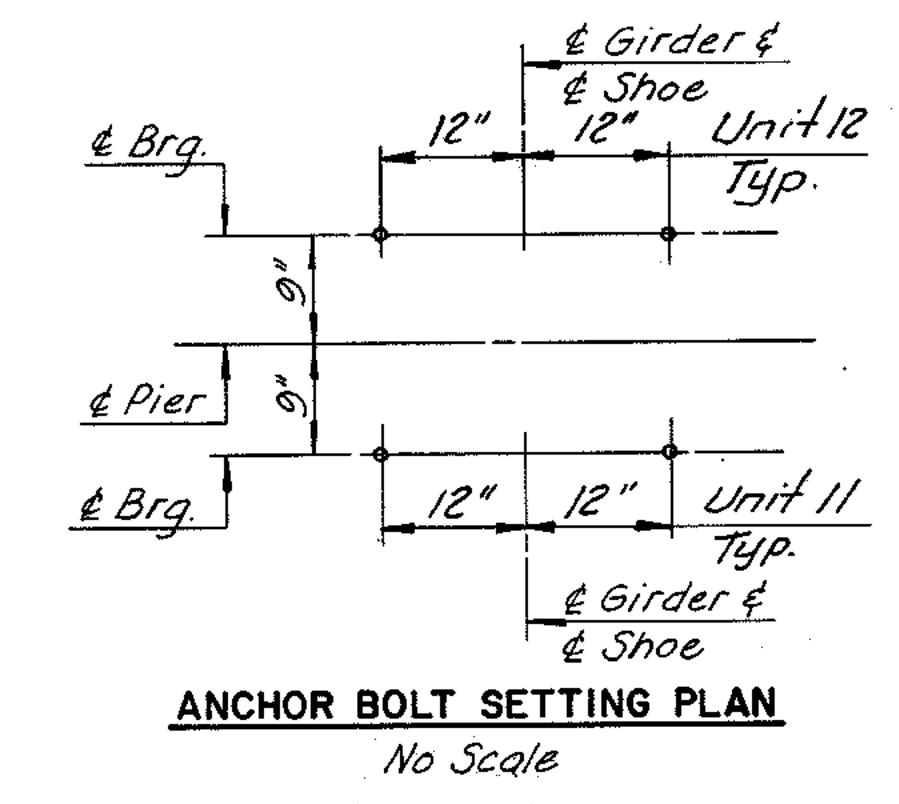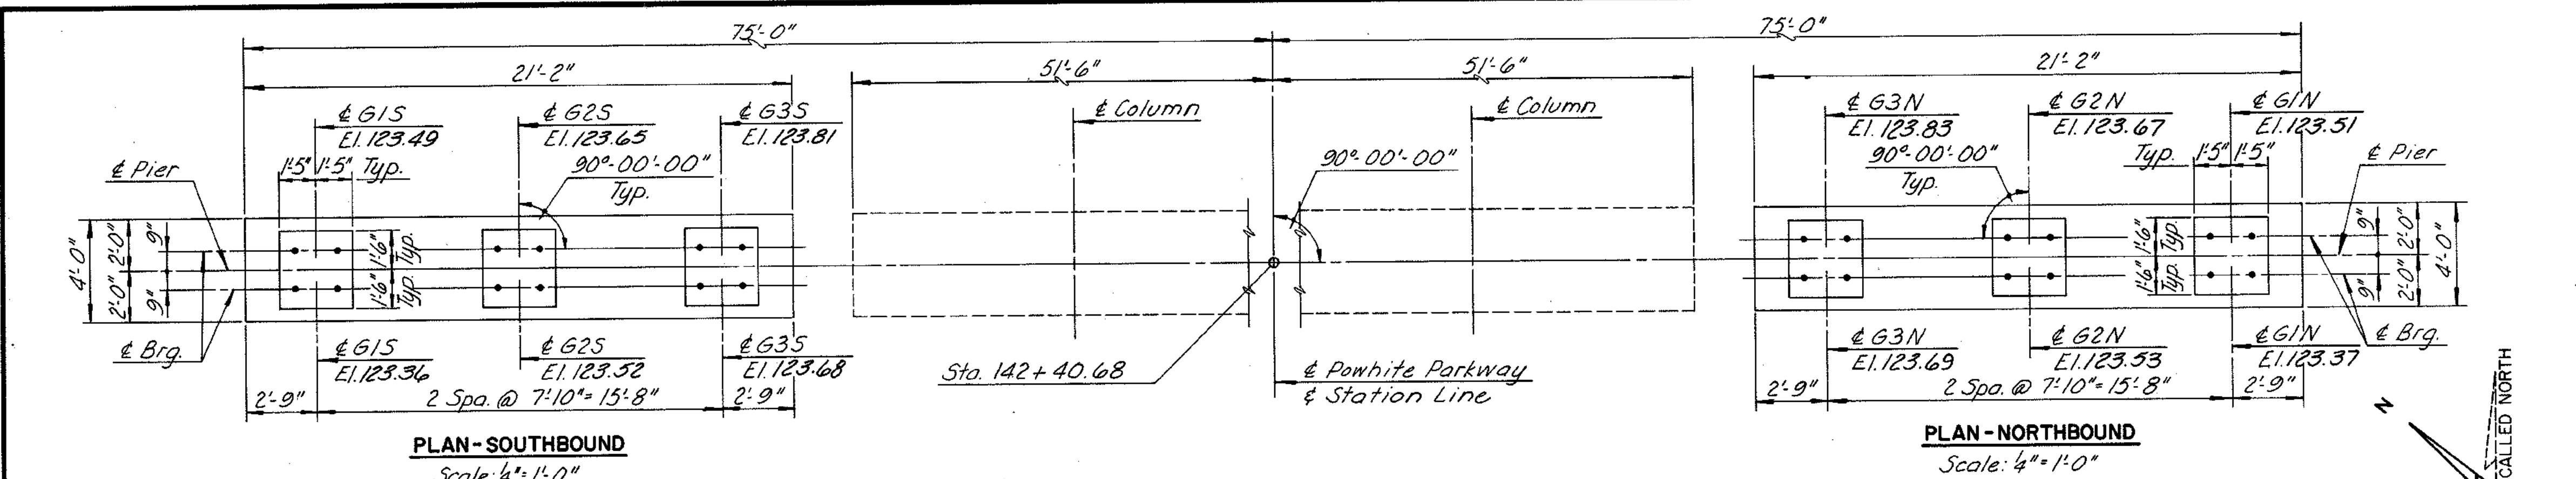

**NOTES:**  
For Sections A-A, B-B and C-C, see Sheet No. 12  
For Section E-E, see Sheet No. 16  
Maximum Allowable Bearing Pressure - 3.5 tons/s.f.  
Actual Design Bearing Pressure - 3.3 tons/s.f.

MADE	BY	DATE			
CHECKED	EUM	3-87			
IN CHARGE	TEP	3-87			

**RICHMOND METROPOLITAN AUTHORITY  
RICHMOND EXPRESSWAY SYSTEM**


**PIER II DETAILS**

HOWARD, NEEDLES, TAMMEN & BERGENDOFF consulting engineers Alexandria, Virginia		SCALE: AS SHOWN
CONTRACT NO. C-13		
SHEET NO. 22 OF 106		

**AS BUILT**




RICHMOND EXPRESSWAY SYSTEM			
SECTION	PROJECT	SHEET NO.	TOTAL SHEETS
13	WIDENING JAMES RIVER BRIDGE	25	106


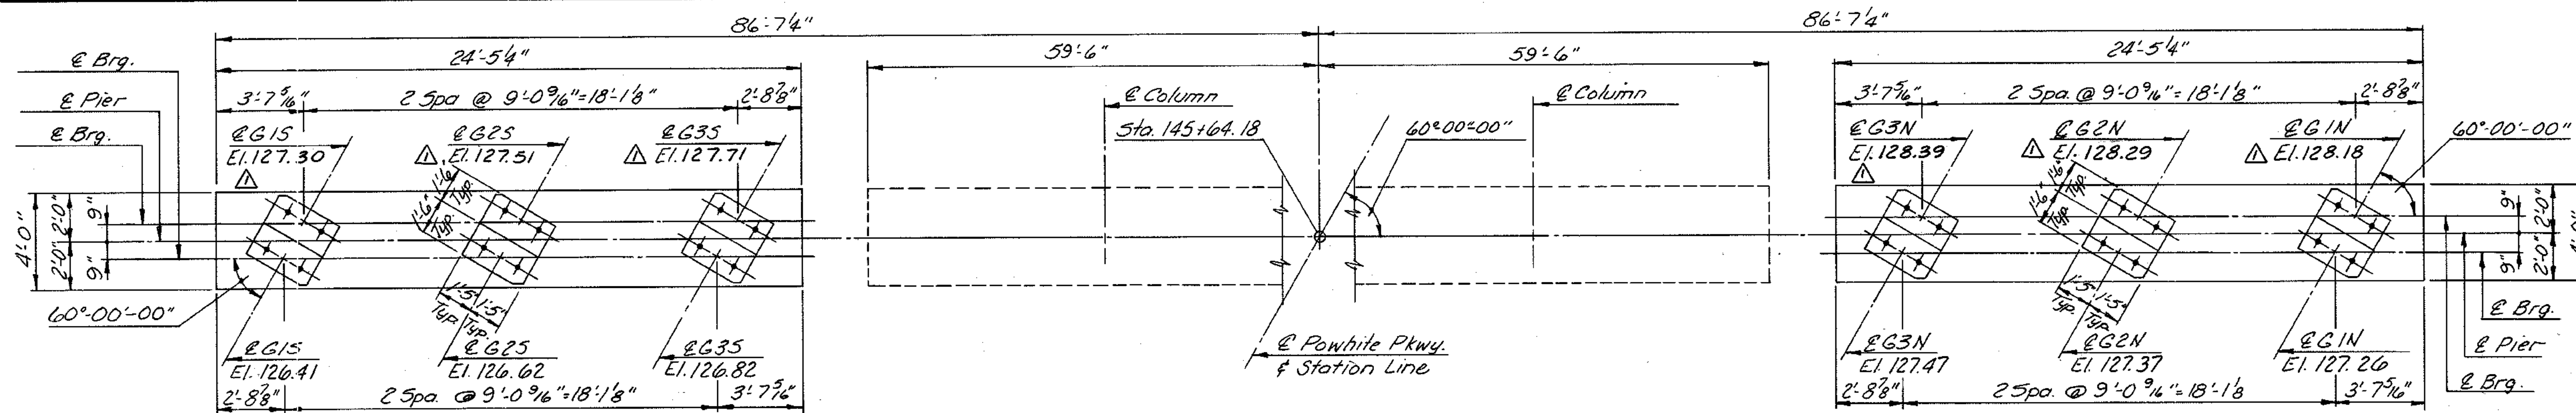


PLAN - SOUTHBOUND  
Scale: 4"=1'-0"

PLAN - NORTHBOUND  
Scale: 4"=1'-0"

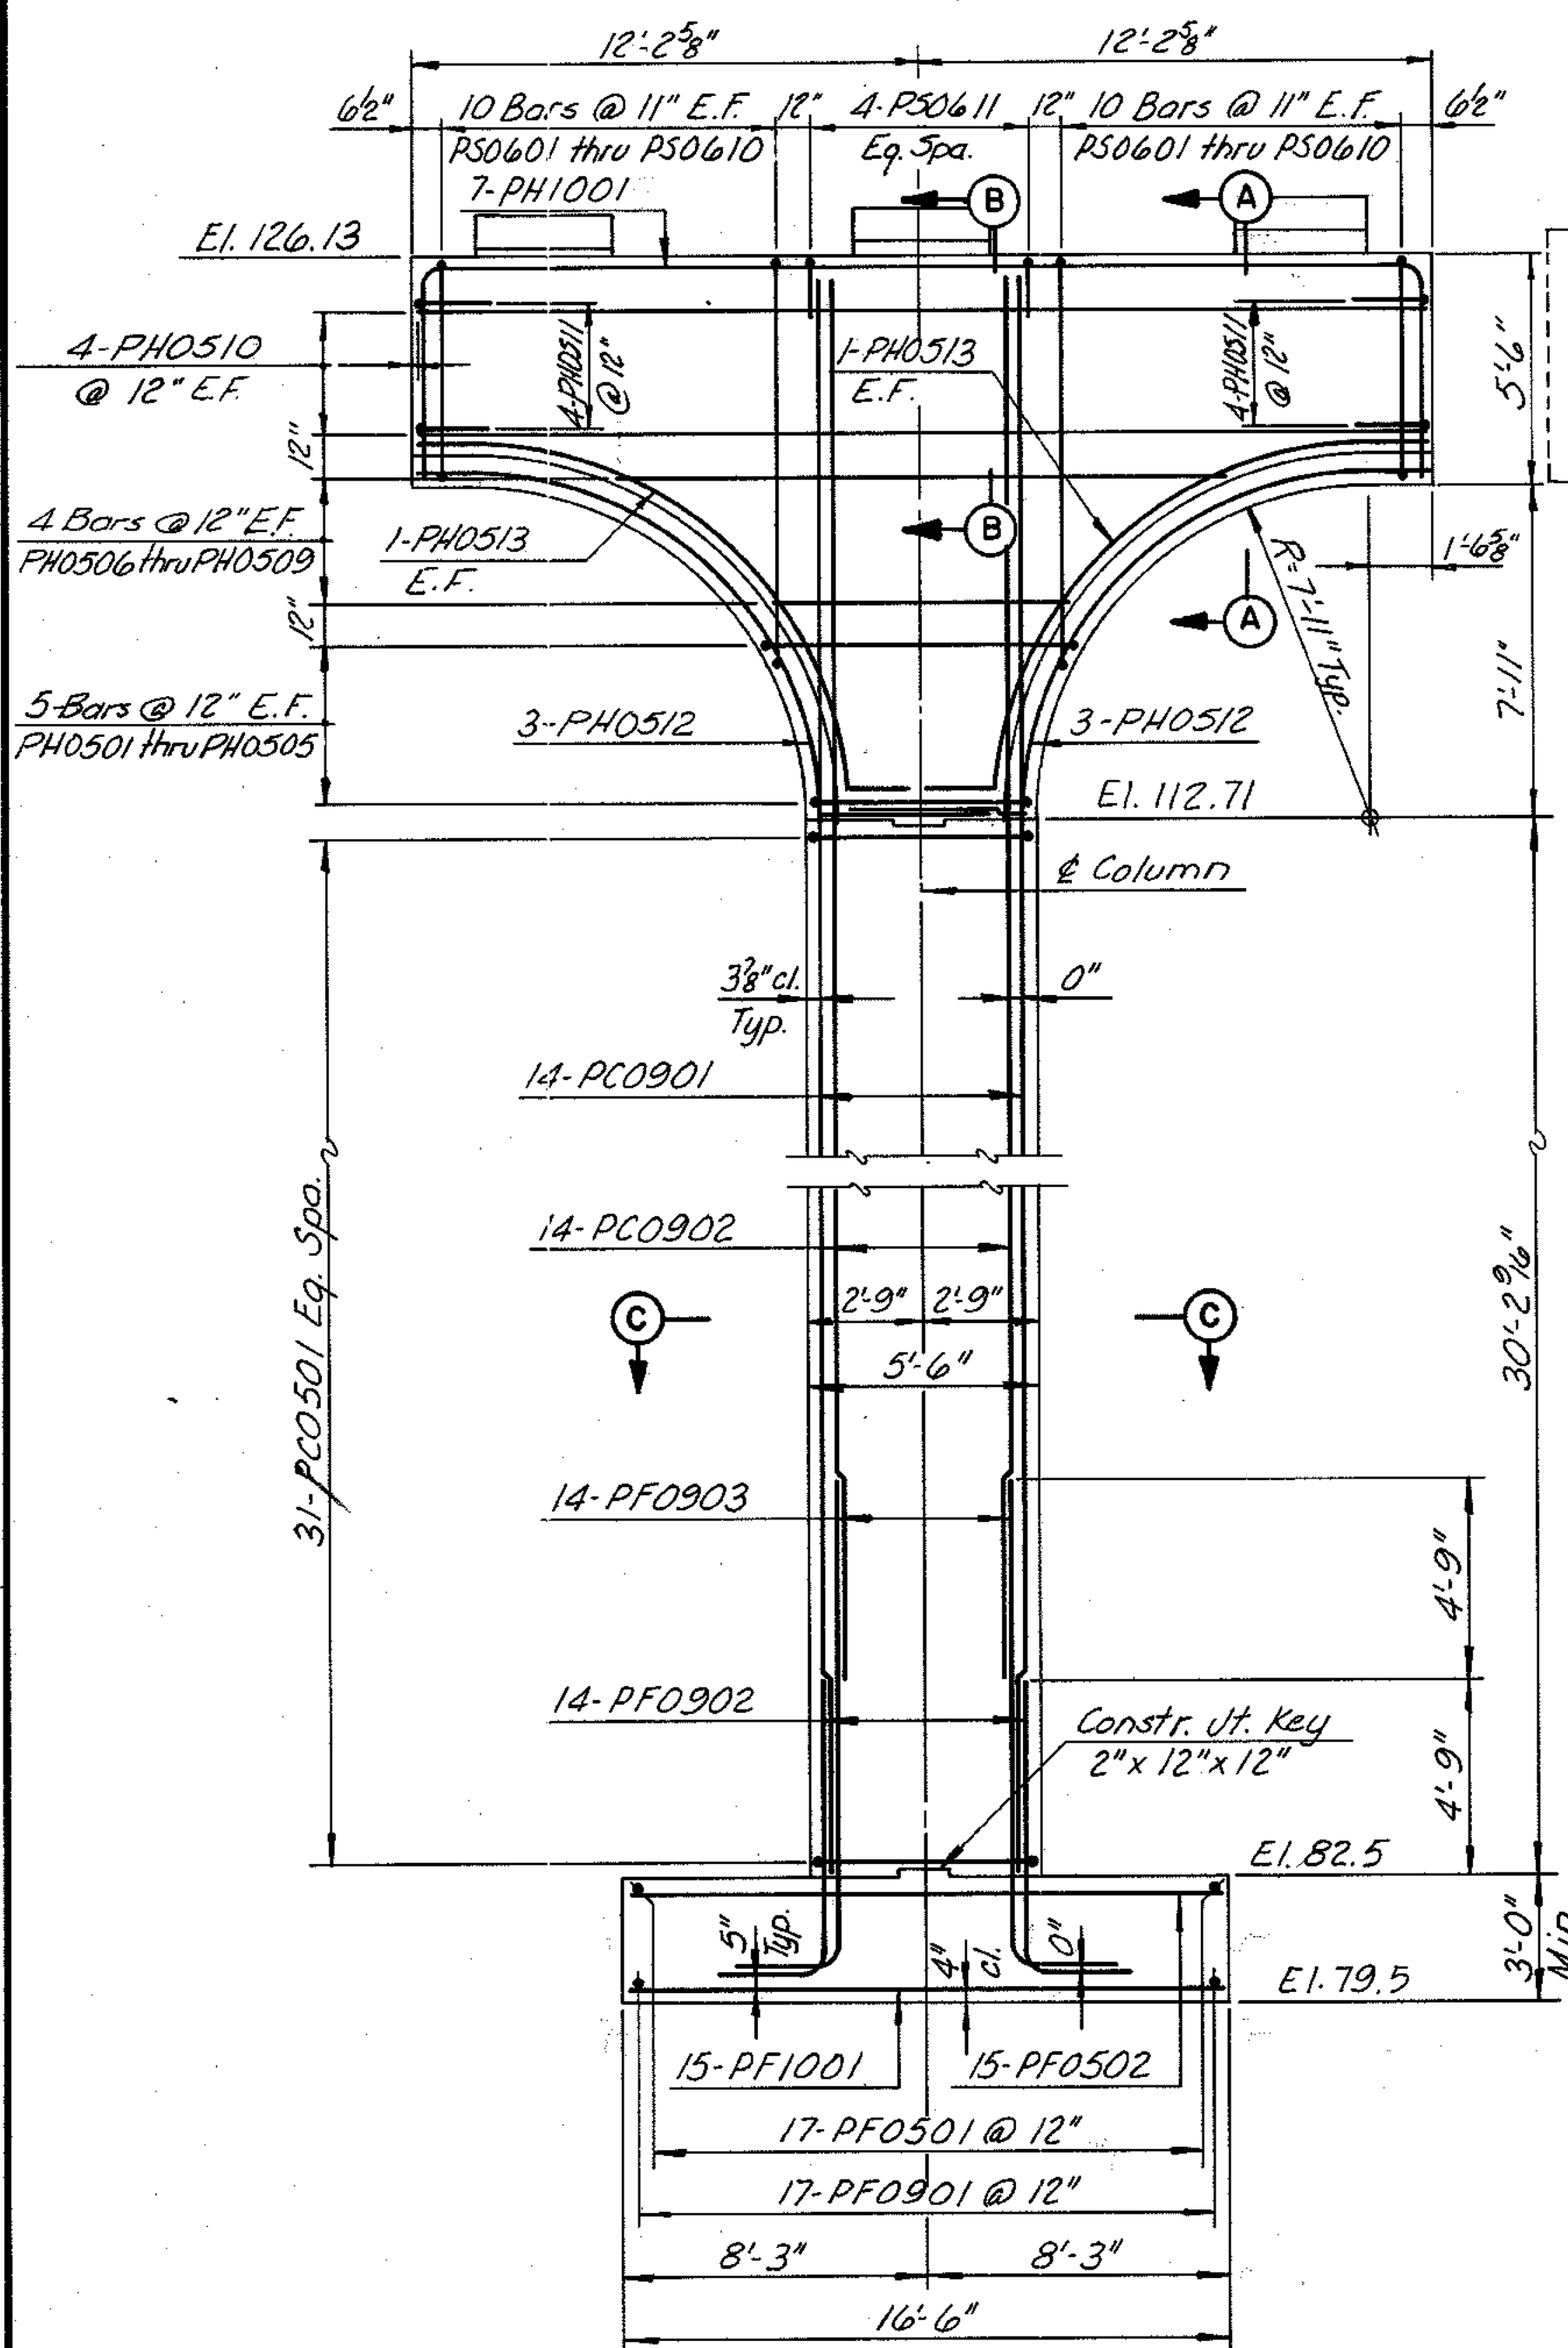

ELEVATION - SOUTHBOUND  
Scale: 4"=1'-0"

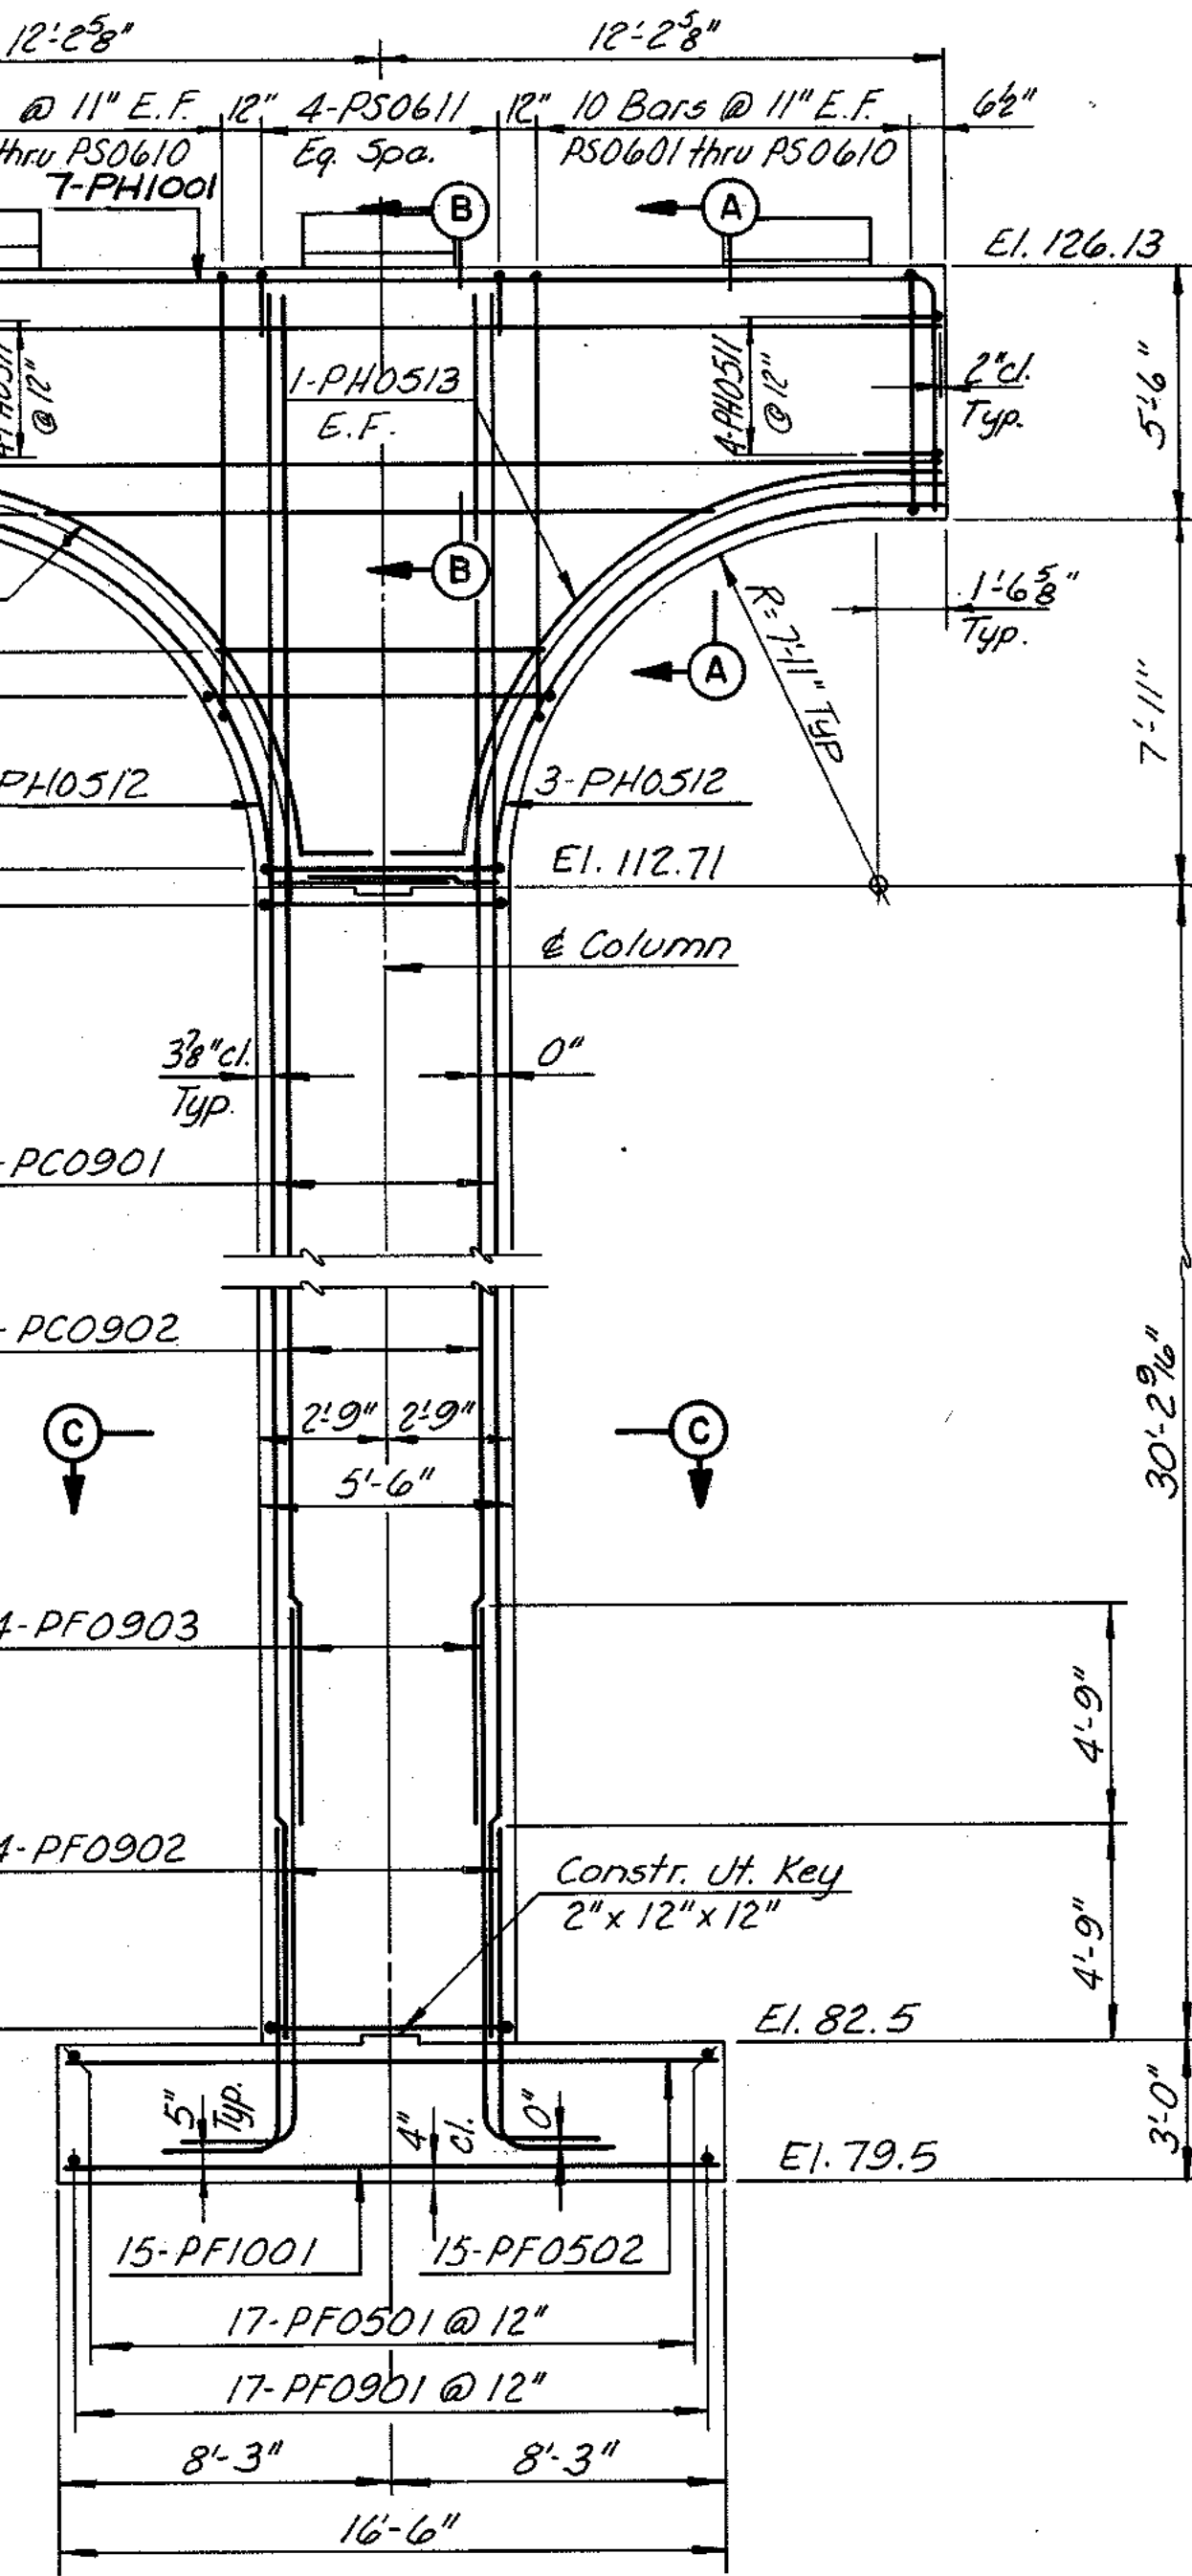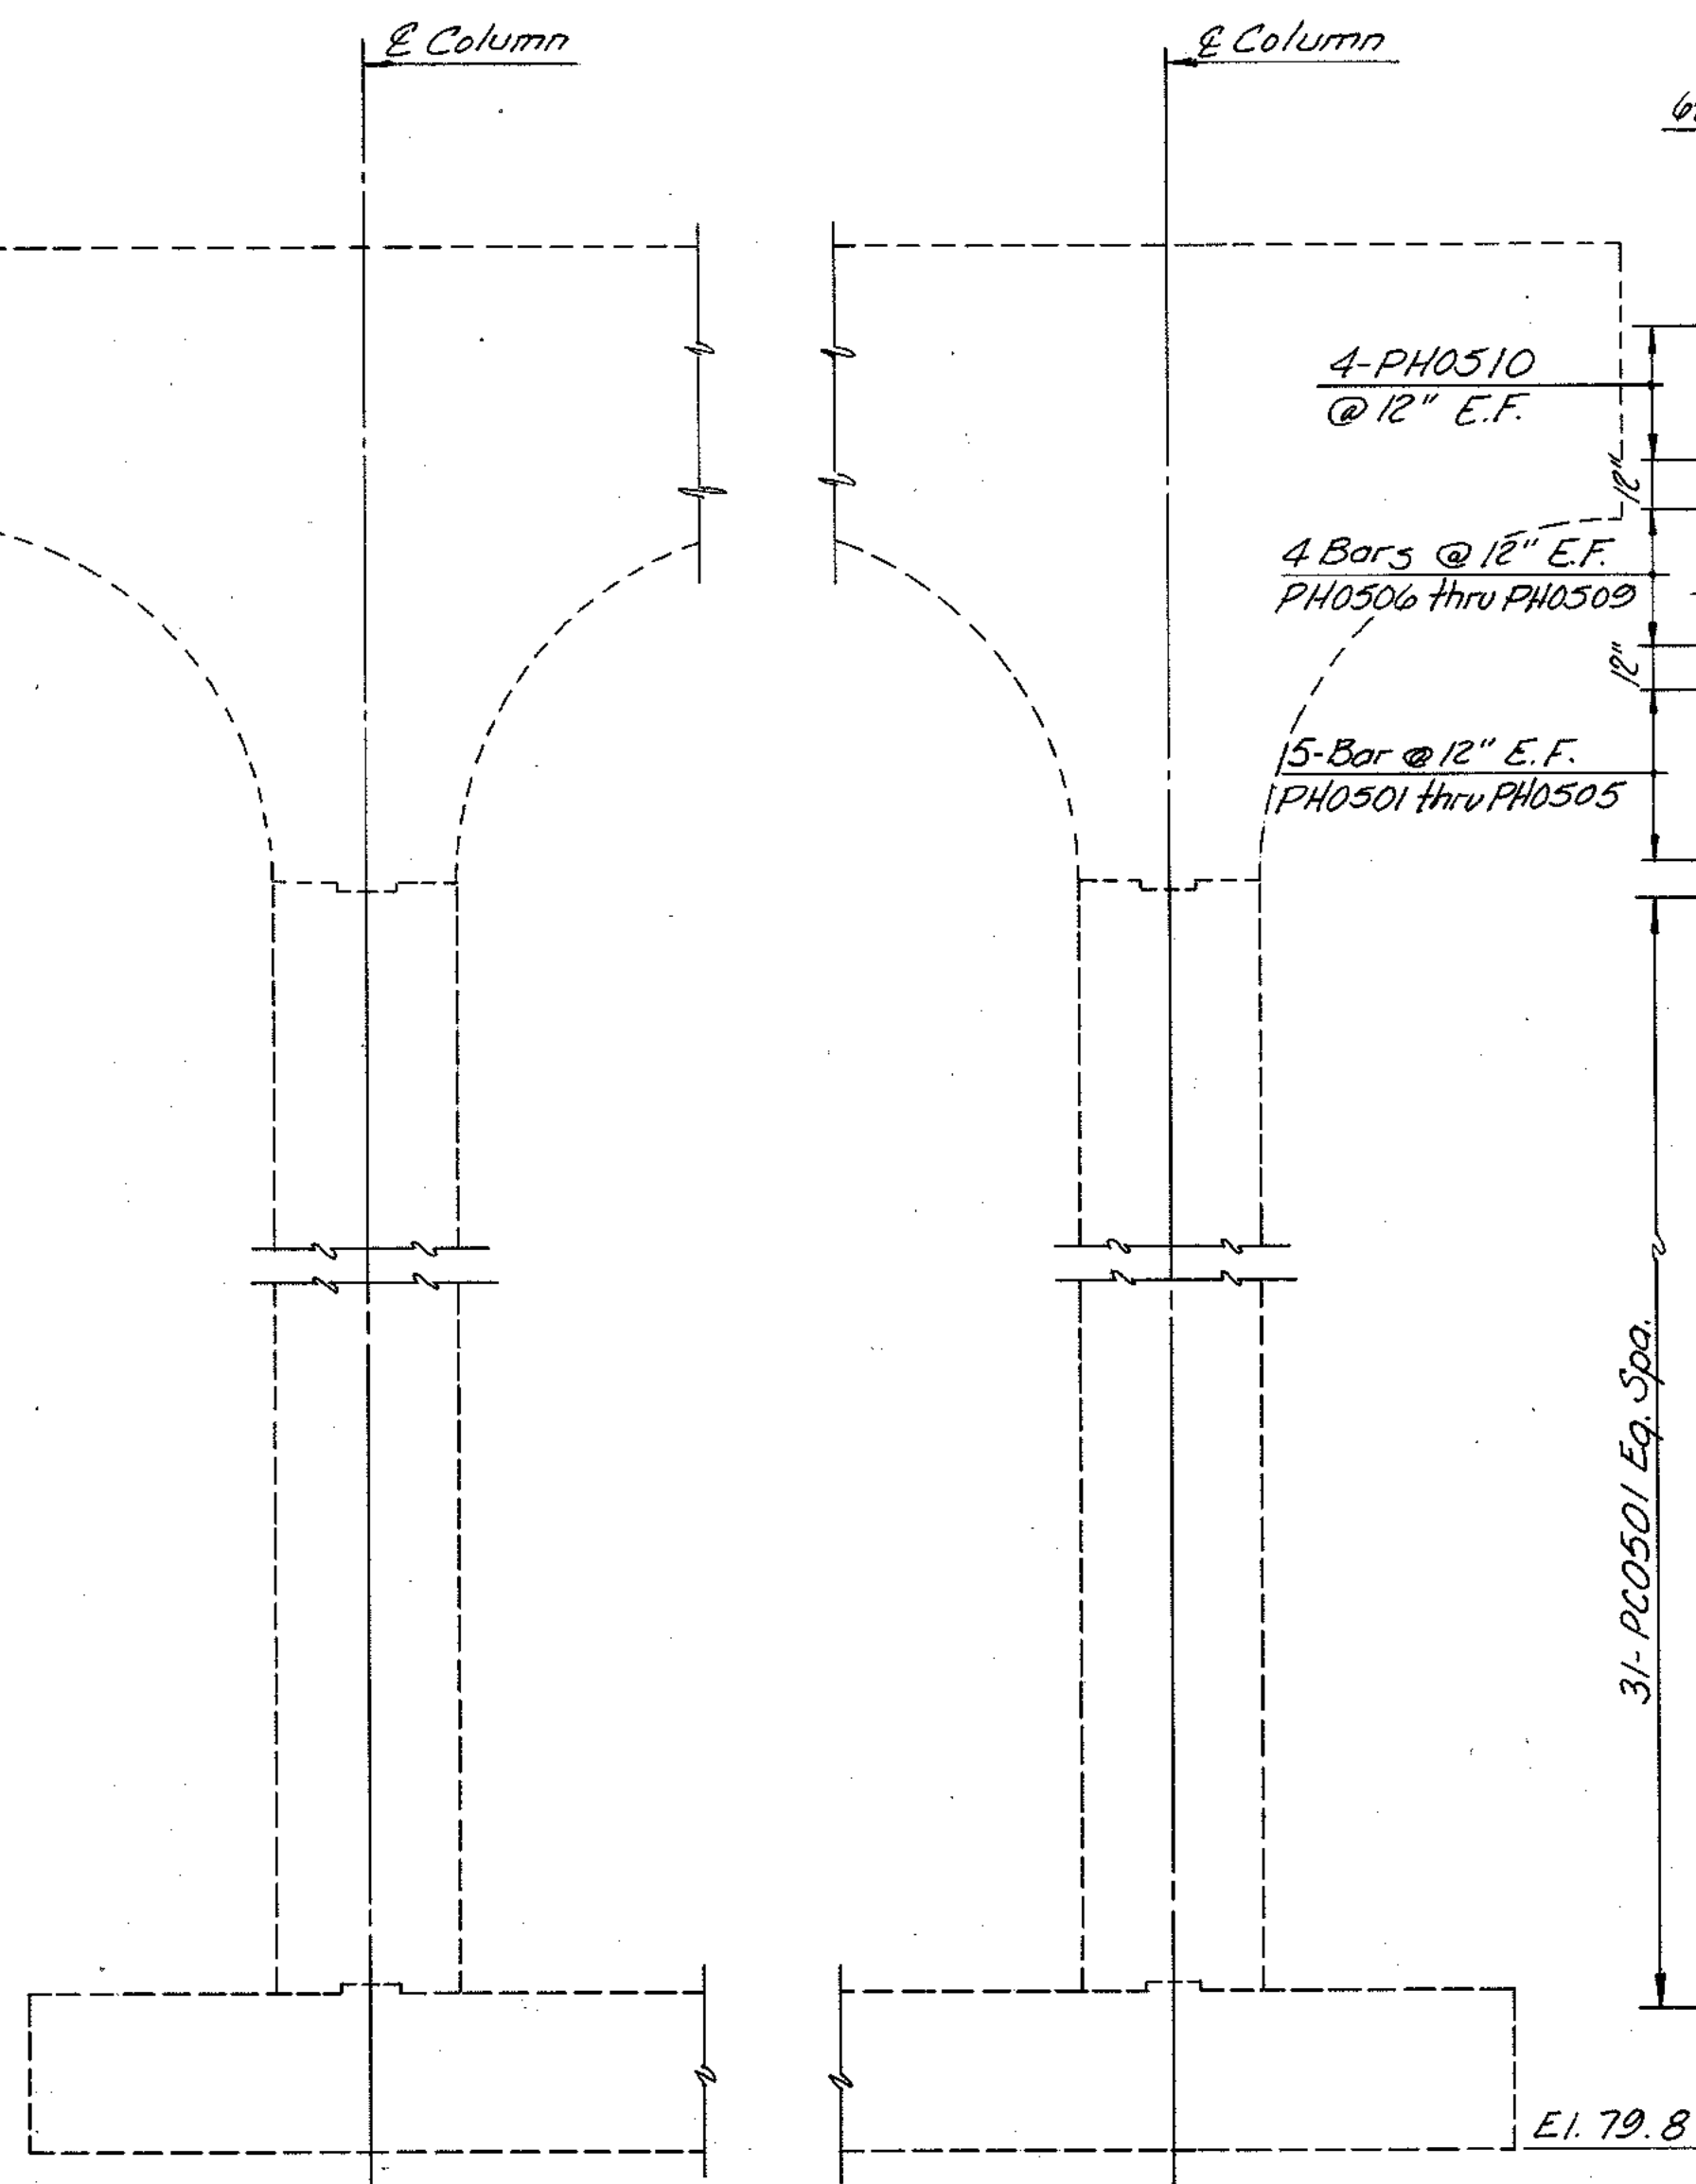



ELEVATION - NORTHBOUND  
Scale: 4"=1'-0"

**NOTES:**


- For Sections B-B and C-C see Sheet No. 12
- For Anchor Bolt Setting Plan, see Sheet No. 29
- For Steel Sheet Piling requirements, see Sheet No. 29
- Maximum Allowable Bearing Pressure - 3.5 tons/s.f.
- Actual Design Bearing Pressure - Southbound - 3.3 tons/s.f.
- Northbound - 3.0 tons/s.f.

**NOTE A:**

- Pad reinforcing bars are to be spaced to clear Anchor Bolts.

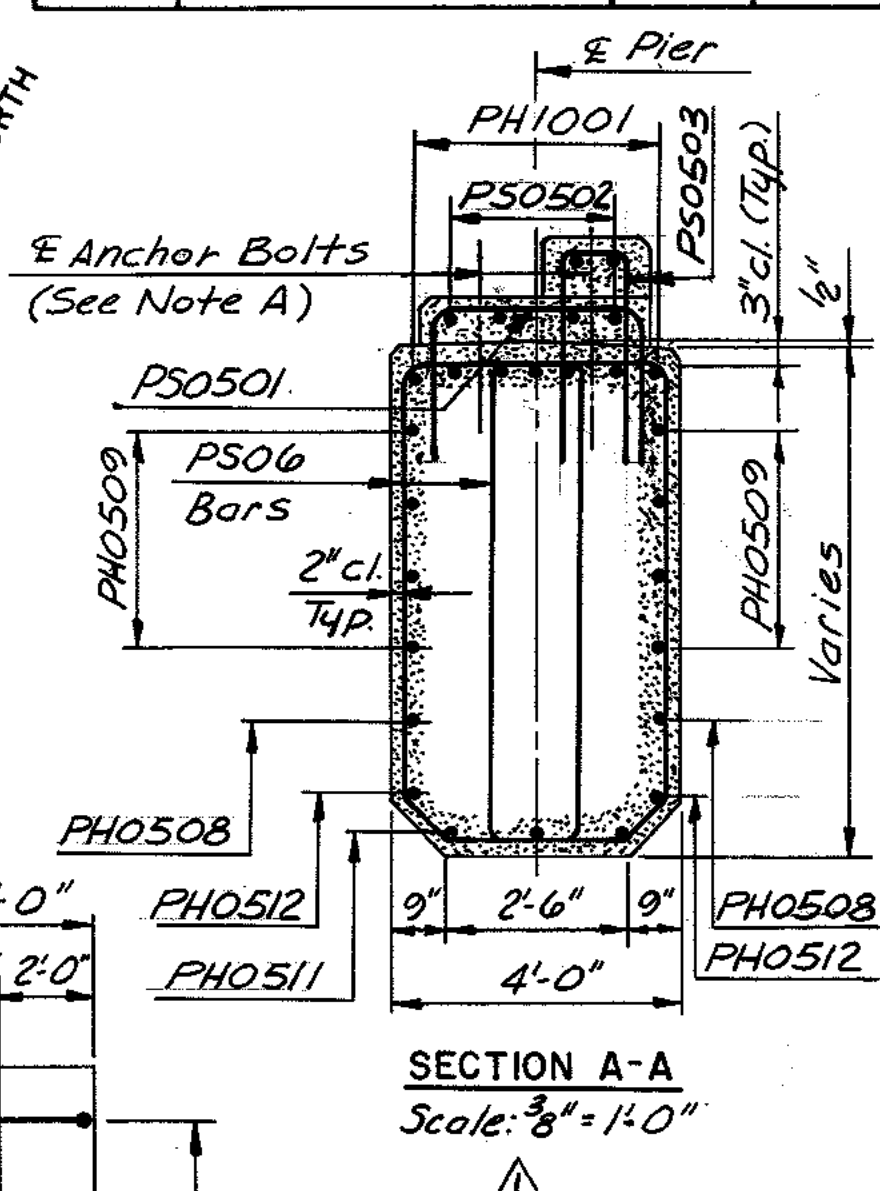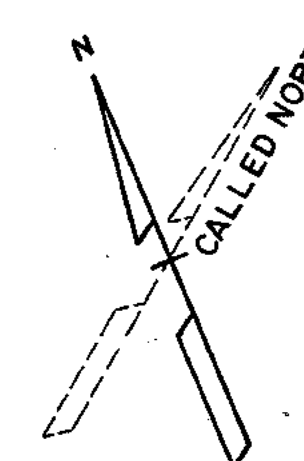

SECTION A-A  
Scale: 3/8"=1'-0"

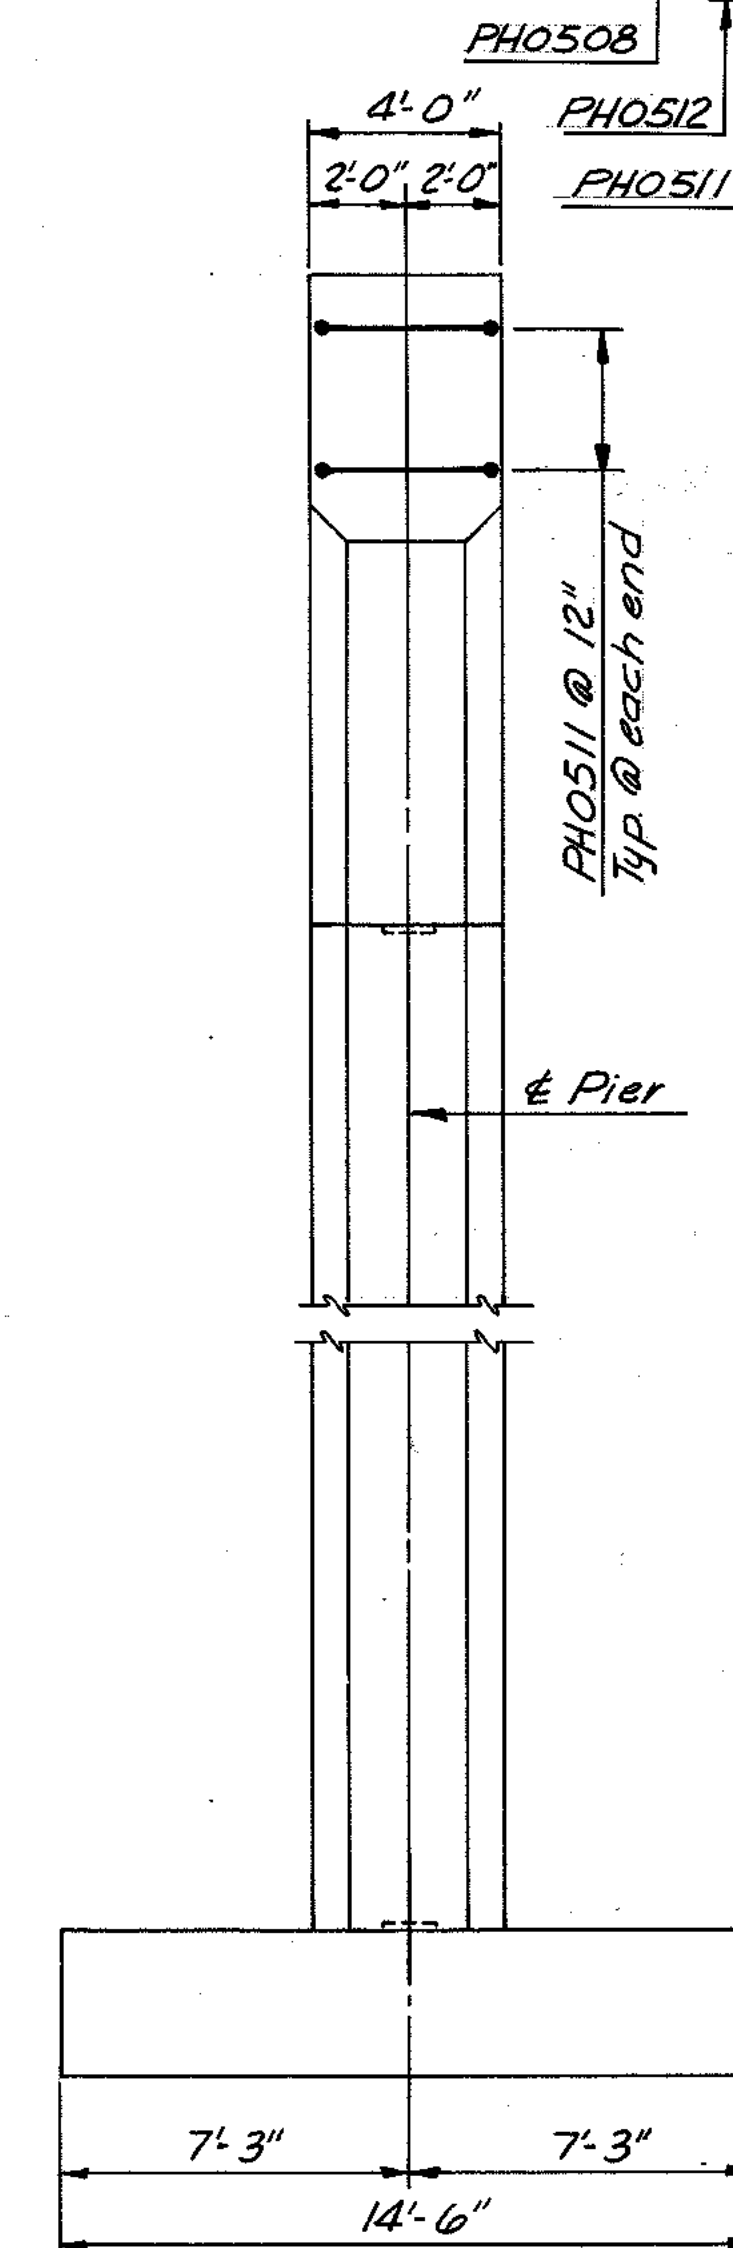

TYPICAL END VIEW  
Scale: 4"=1'-0"

RICHMOND METROPOLITAN AUTHORITY  
RICHMOND EXPRESSWAY SYSTEM

PIER 14 DETAILS

HOWARD, NEEDLES, TAMMEN & BERGENDOFF  
consulting engineers  
Alexandria, Virginia

SCALE: AS SHOWN  
CONTRACT NO.: C-13  
SHEET NO. 25 OF 106


AS BUILT

BY	DATE	REVISION	BY	DATE
MADE	EUM 2-87	As Built	TEM	3-89
CHECKED	TFR 3-87	EL. & Plans Added Sect. A-A	ALC	5-87
IN CHARGE	S.R.			




RICHMOND EXPRESSWAY SYSTEM			
SECTION	PROJECT	SHEET NO.	TOTAL SHEETS
13	WIDENING JAMES RIVER BRIDGING	27	106

**NOTE:**  
For Sections A-A, B-B and C-C, see Sheet No. 12.  
For Anchor Bolt Setting Plan, see Sheet No. 29.

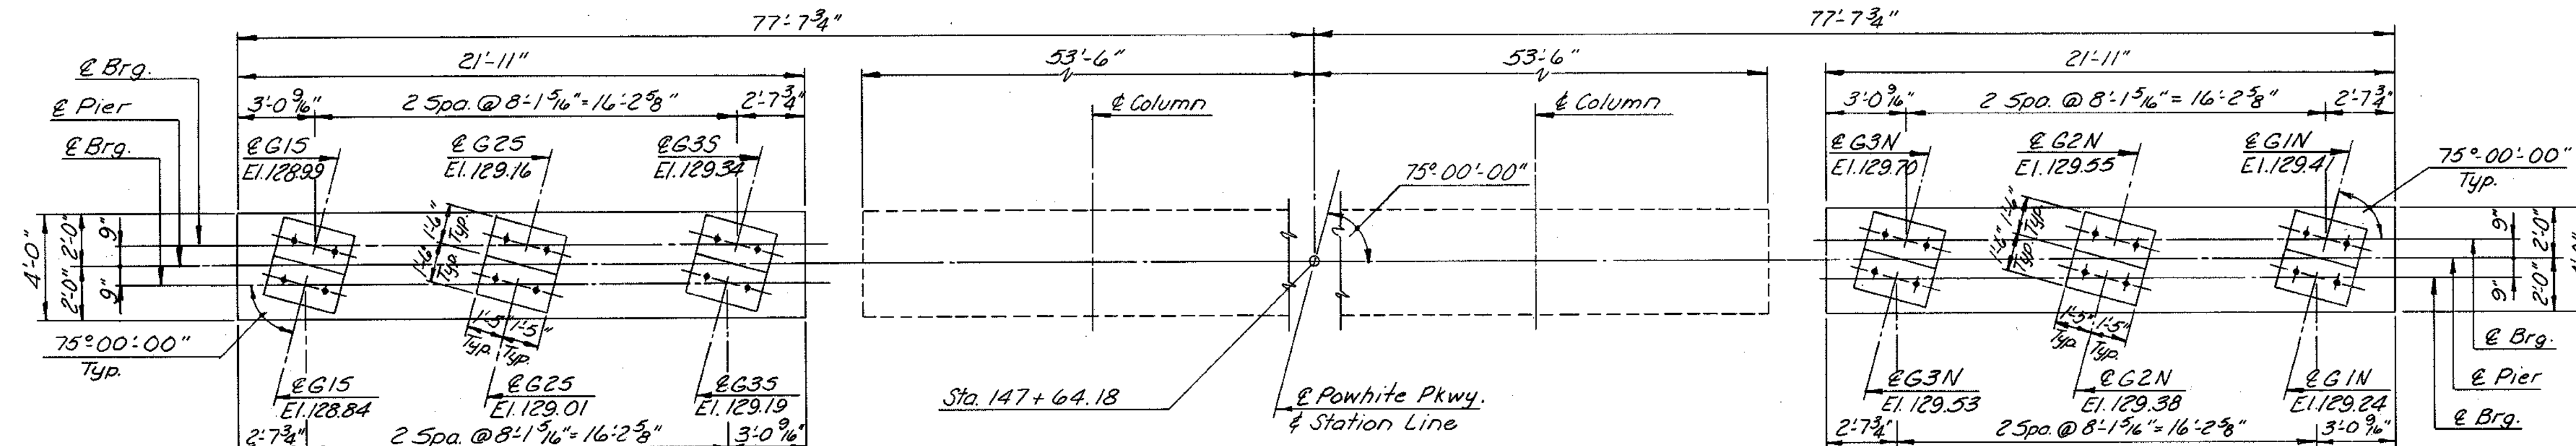


**PLAN-SOUTHBOUND**  
Scale: 4"=1'-0"


**PLAN-NORTHBOUND**  
Scale: 4"=1'-0"

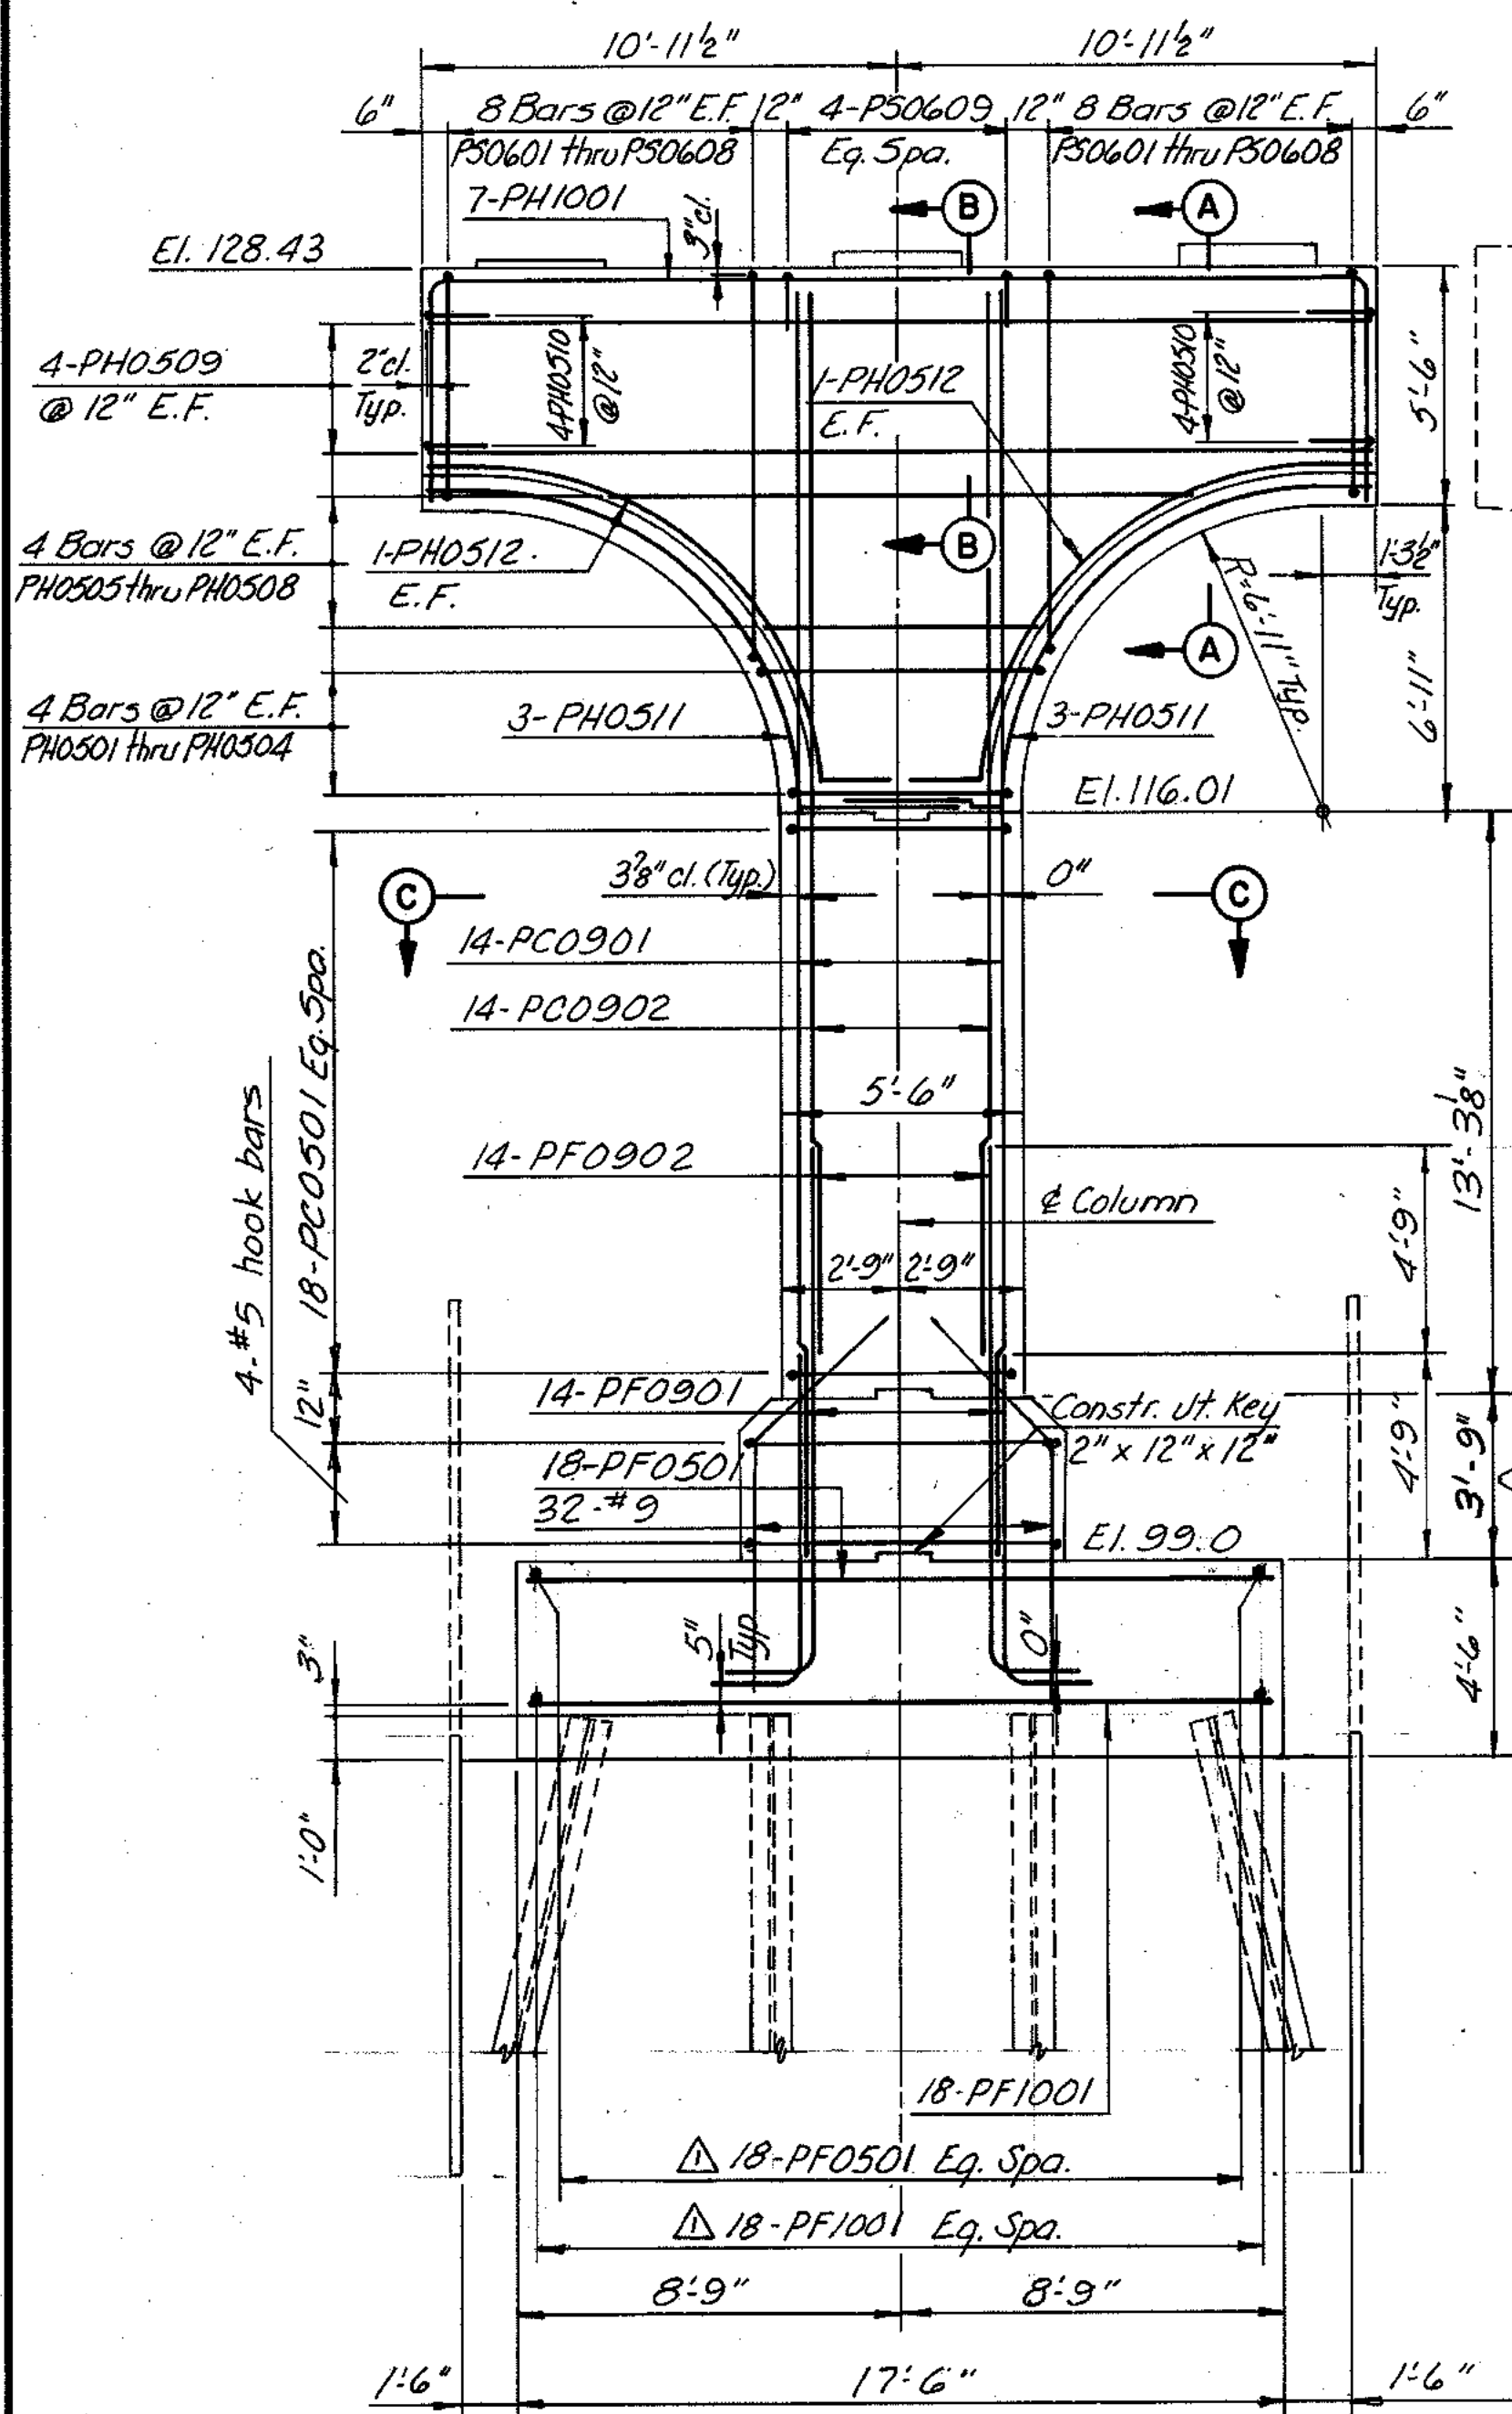

**ELEVATION-SOUTHBOUND**  
Scale: 4"=1'-0"

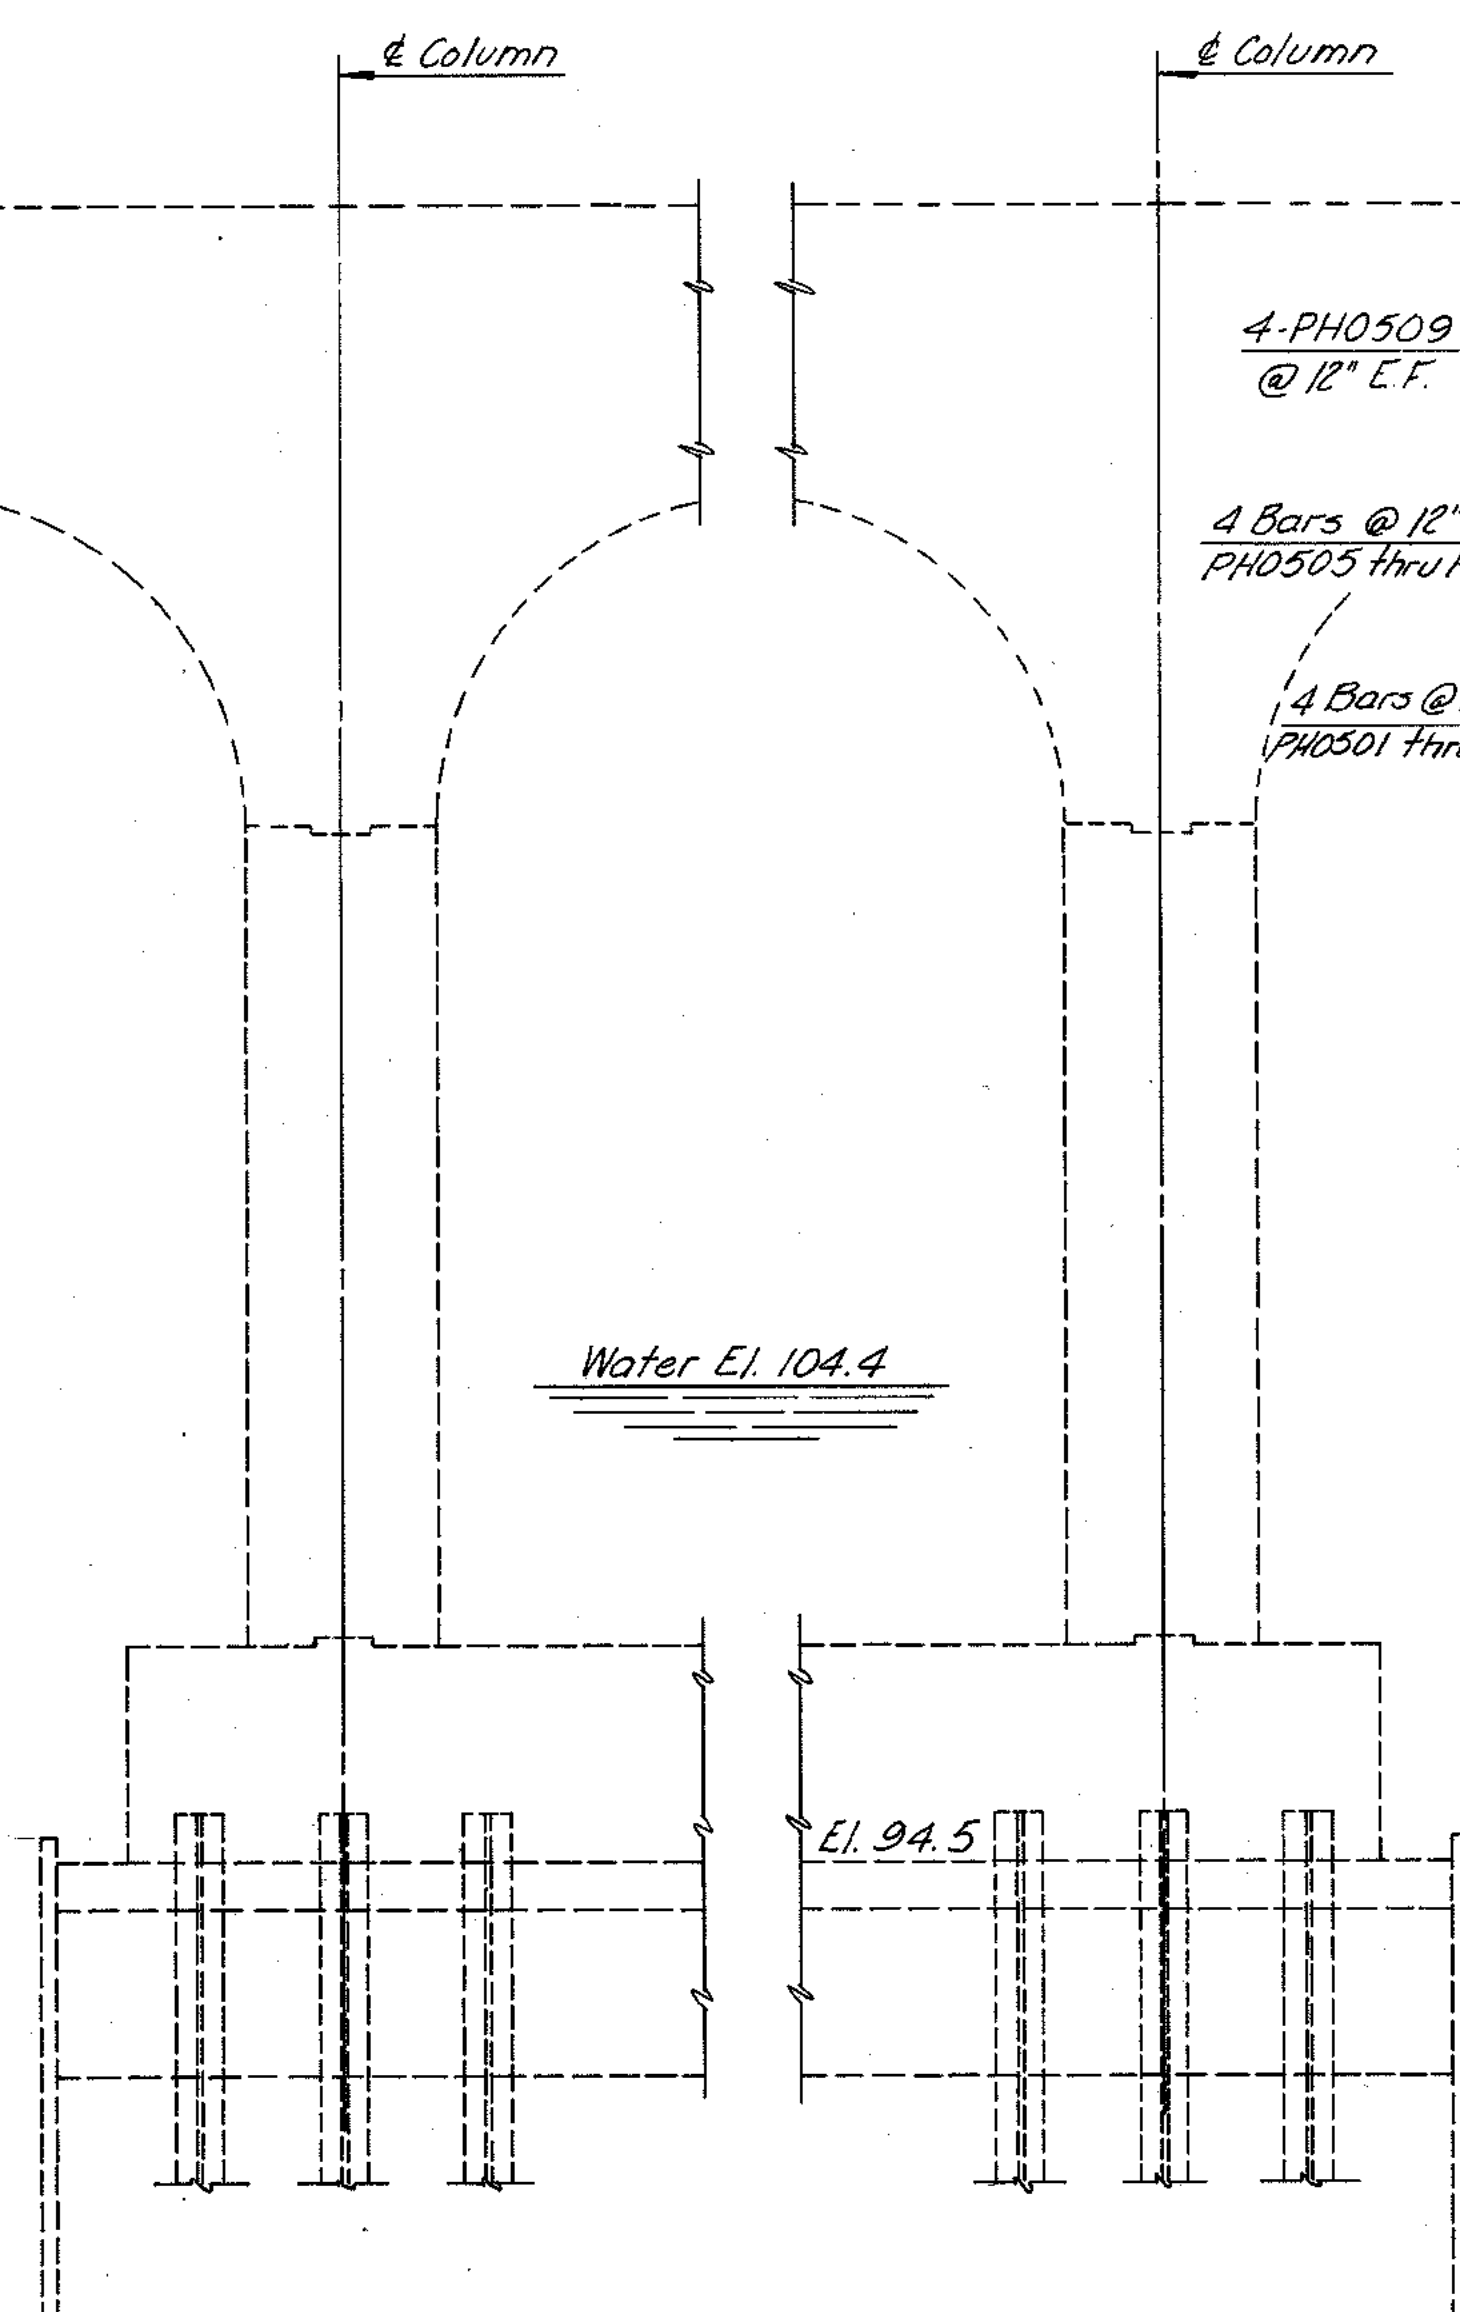


**ELEVATION-NORTHBOUND**  
Scale: 4"=1'-0"

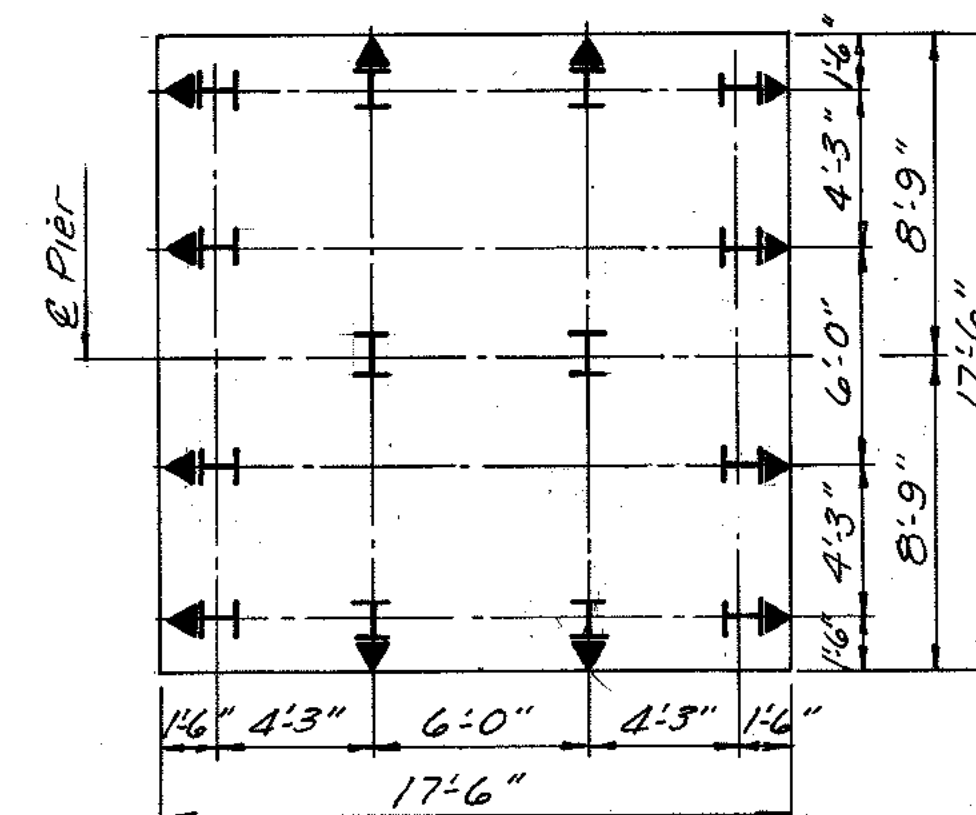

**TYPICAL PILE PLAN**  
Scale: 3/4"=1'-0"

**PILE NOTES:**

- Indicates vertical piles.
- Indicates pile battered 2:12 in direction of arrow.

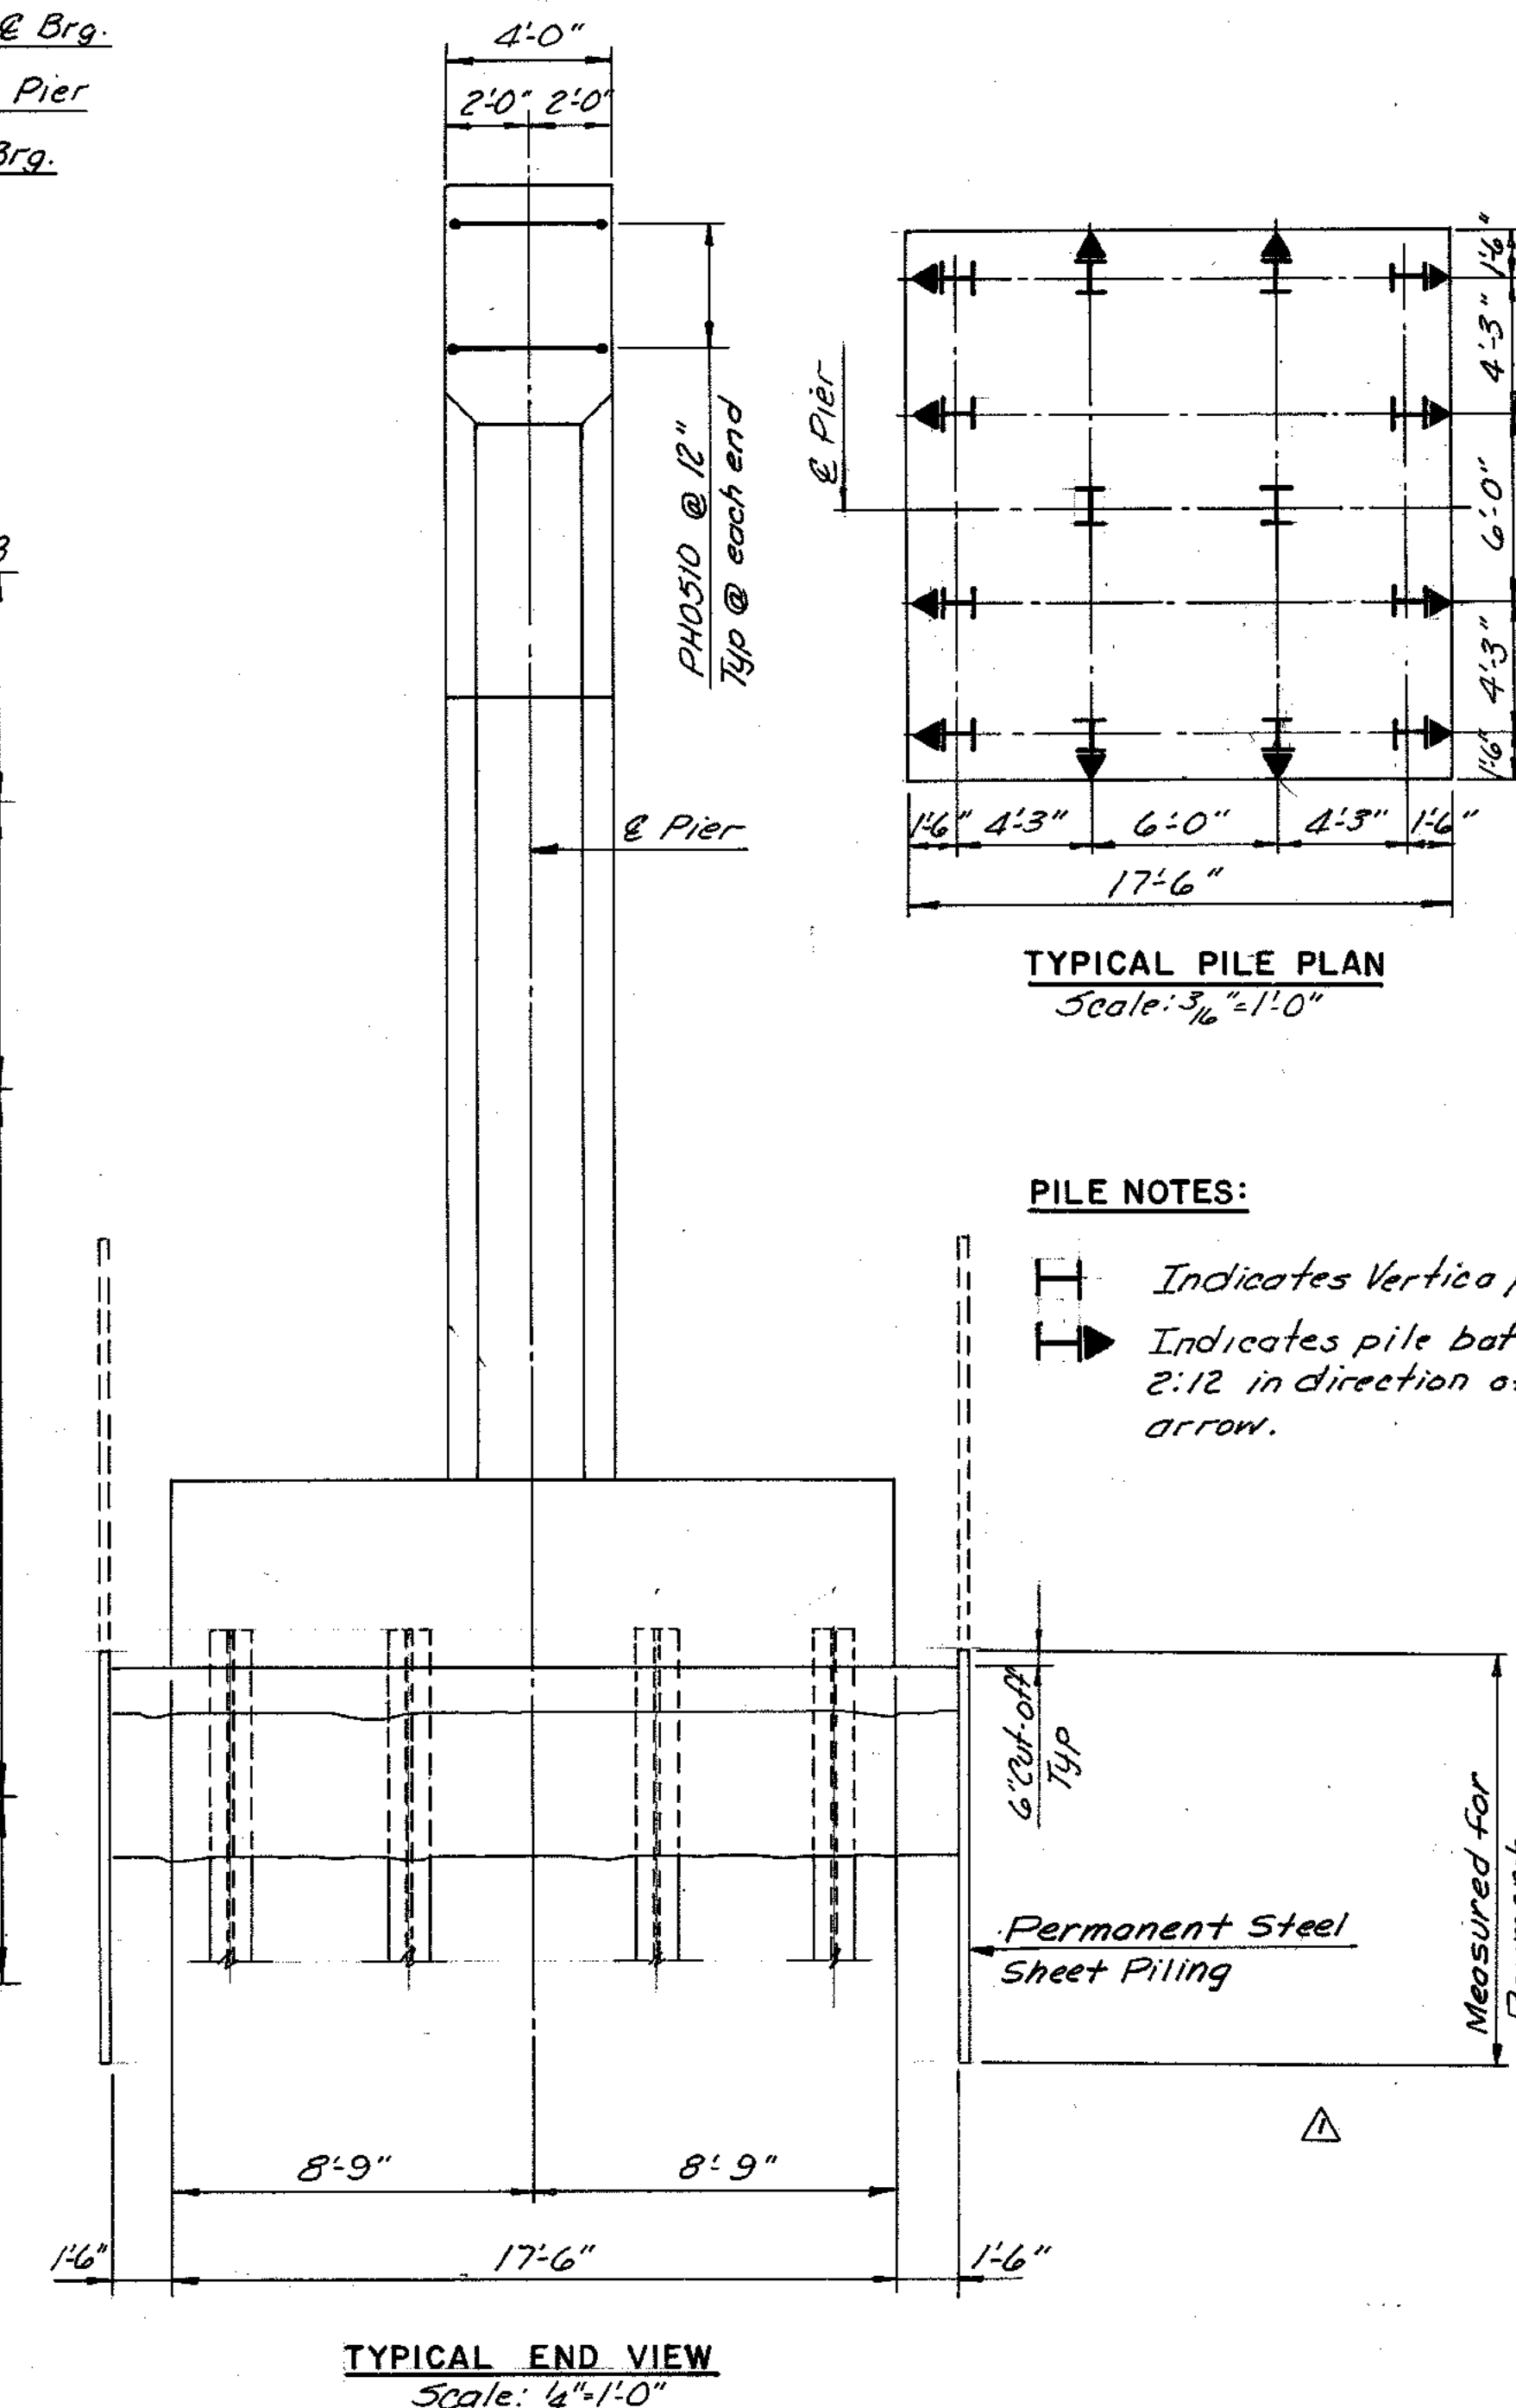

**TYPICAL END VIEW**  
Scale: 4"=1'-0"

**RICHMOND METROPOLITAN AUTHORITY  
RICHMOND EXPRESSWAY SYSTEM**








**PIER 16 DETAILS**

HOWARD, NEEDLES, TAMMEN & BERGENDOFF  
consulting engineers  
Alexandria, Virginia

SCALE: AS SHOWN  
CONTRACT NO.: C-13  
SHEET NO. 27 OF 106

**AS BUILT**


BY	DATE	REVISION	BY	DATE
MADE	EUM 3-87	As Built	TEM	3-89
CHECKED	T.F.P. 3-87	Both Elevation & End View	ALC	4-87
IN CHARGE	S.R.			

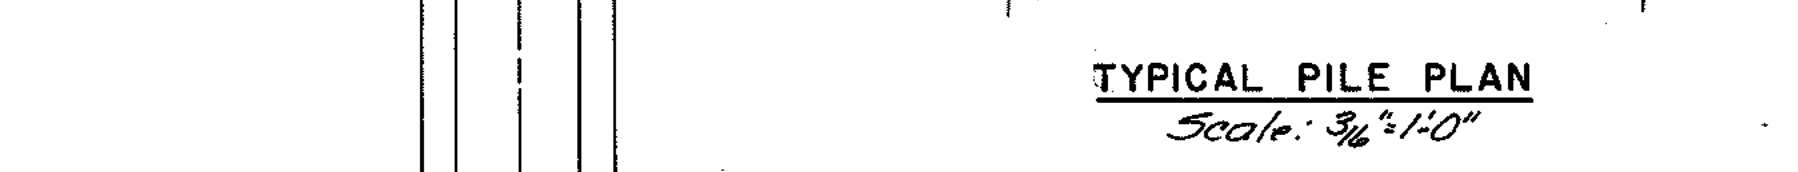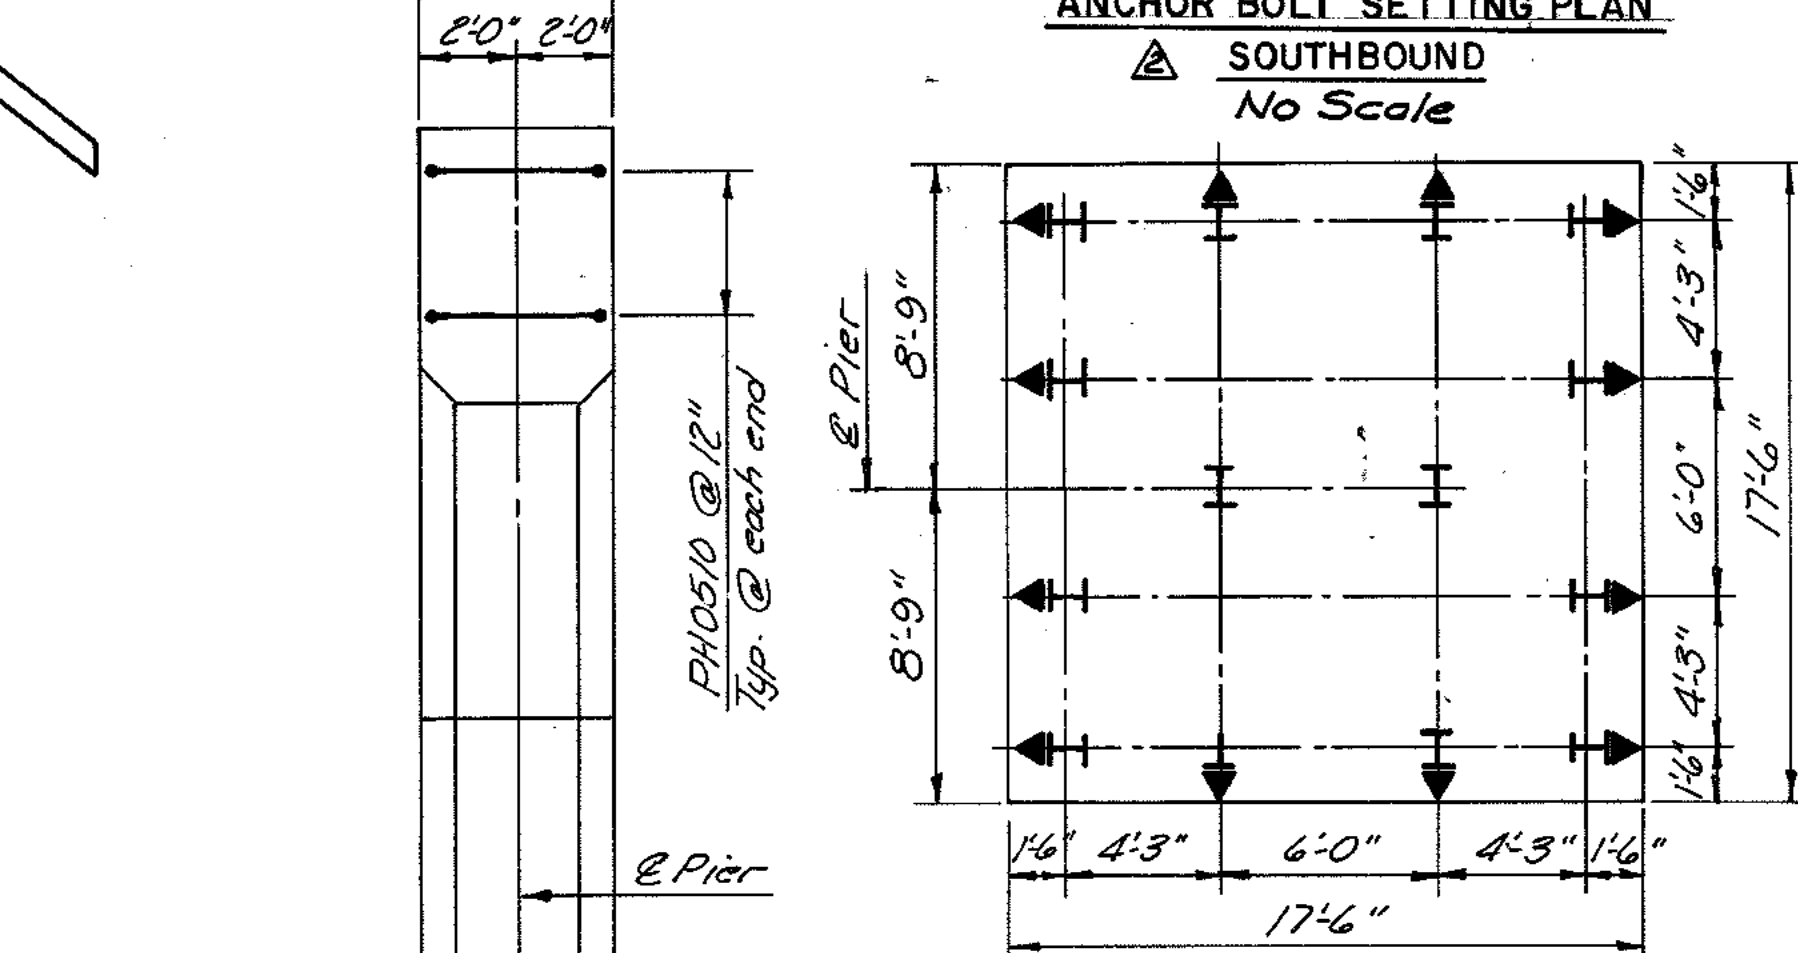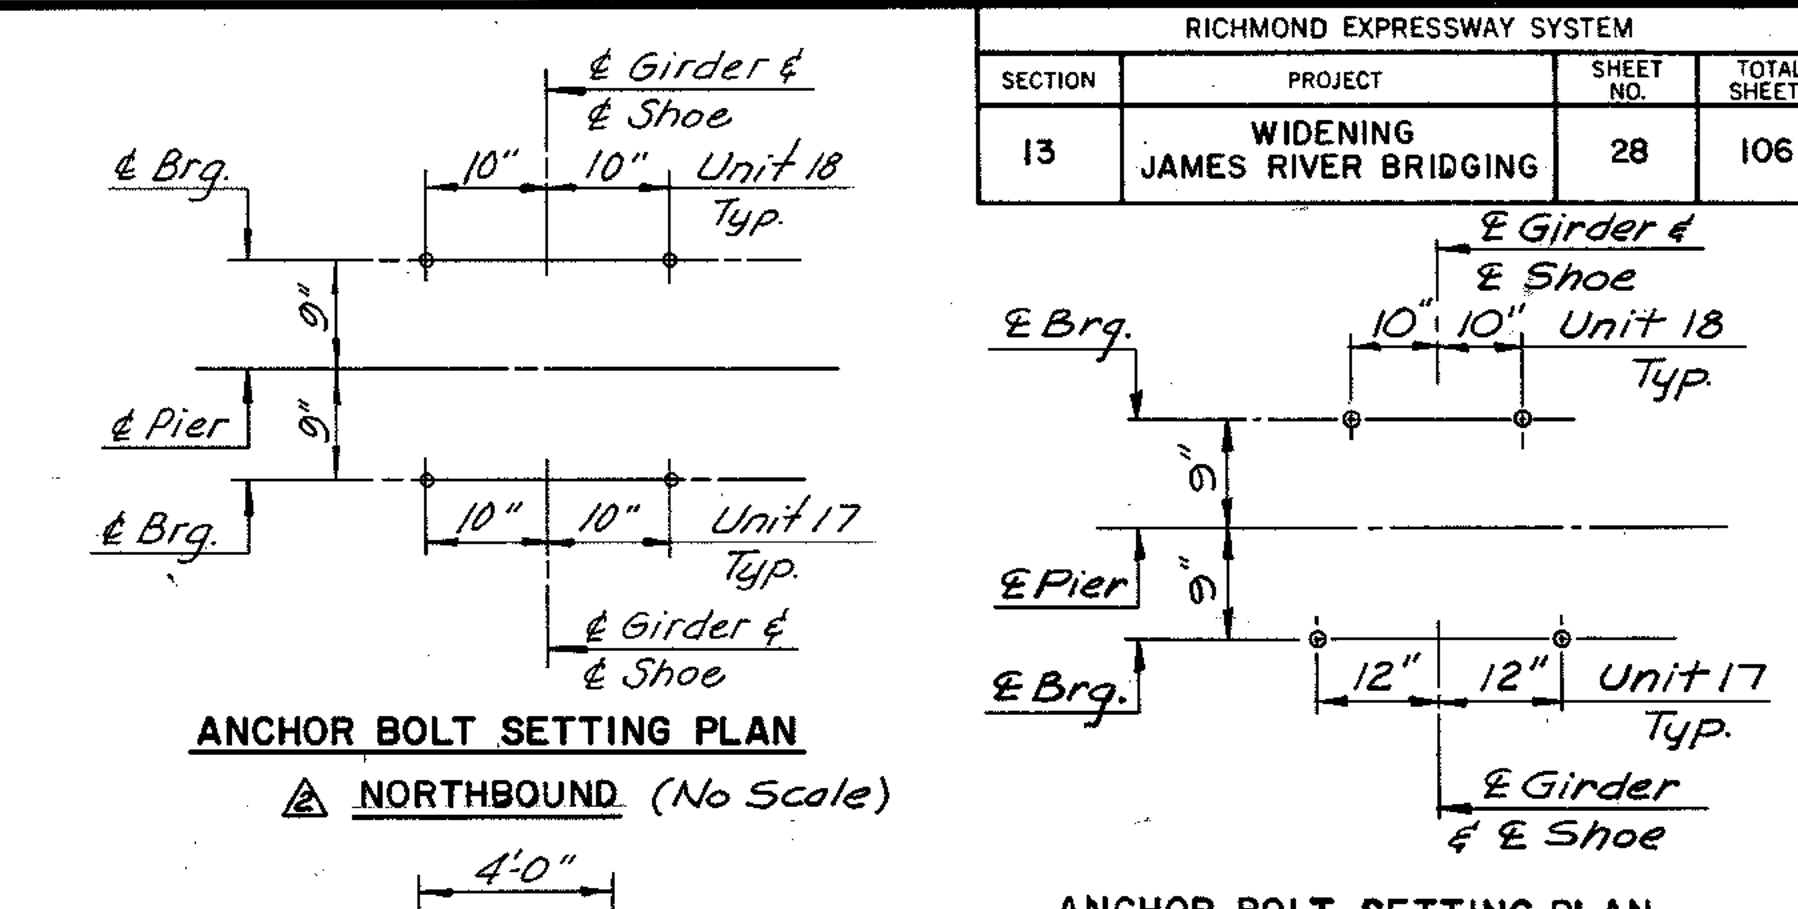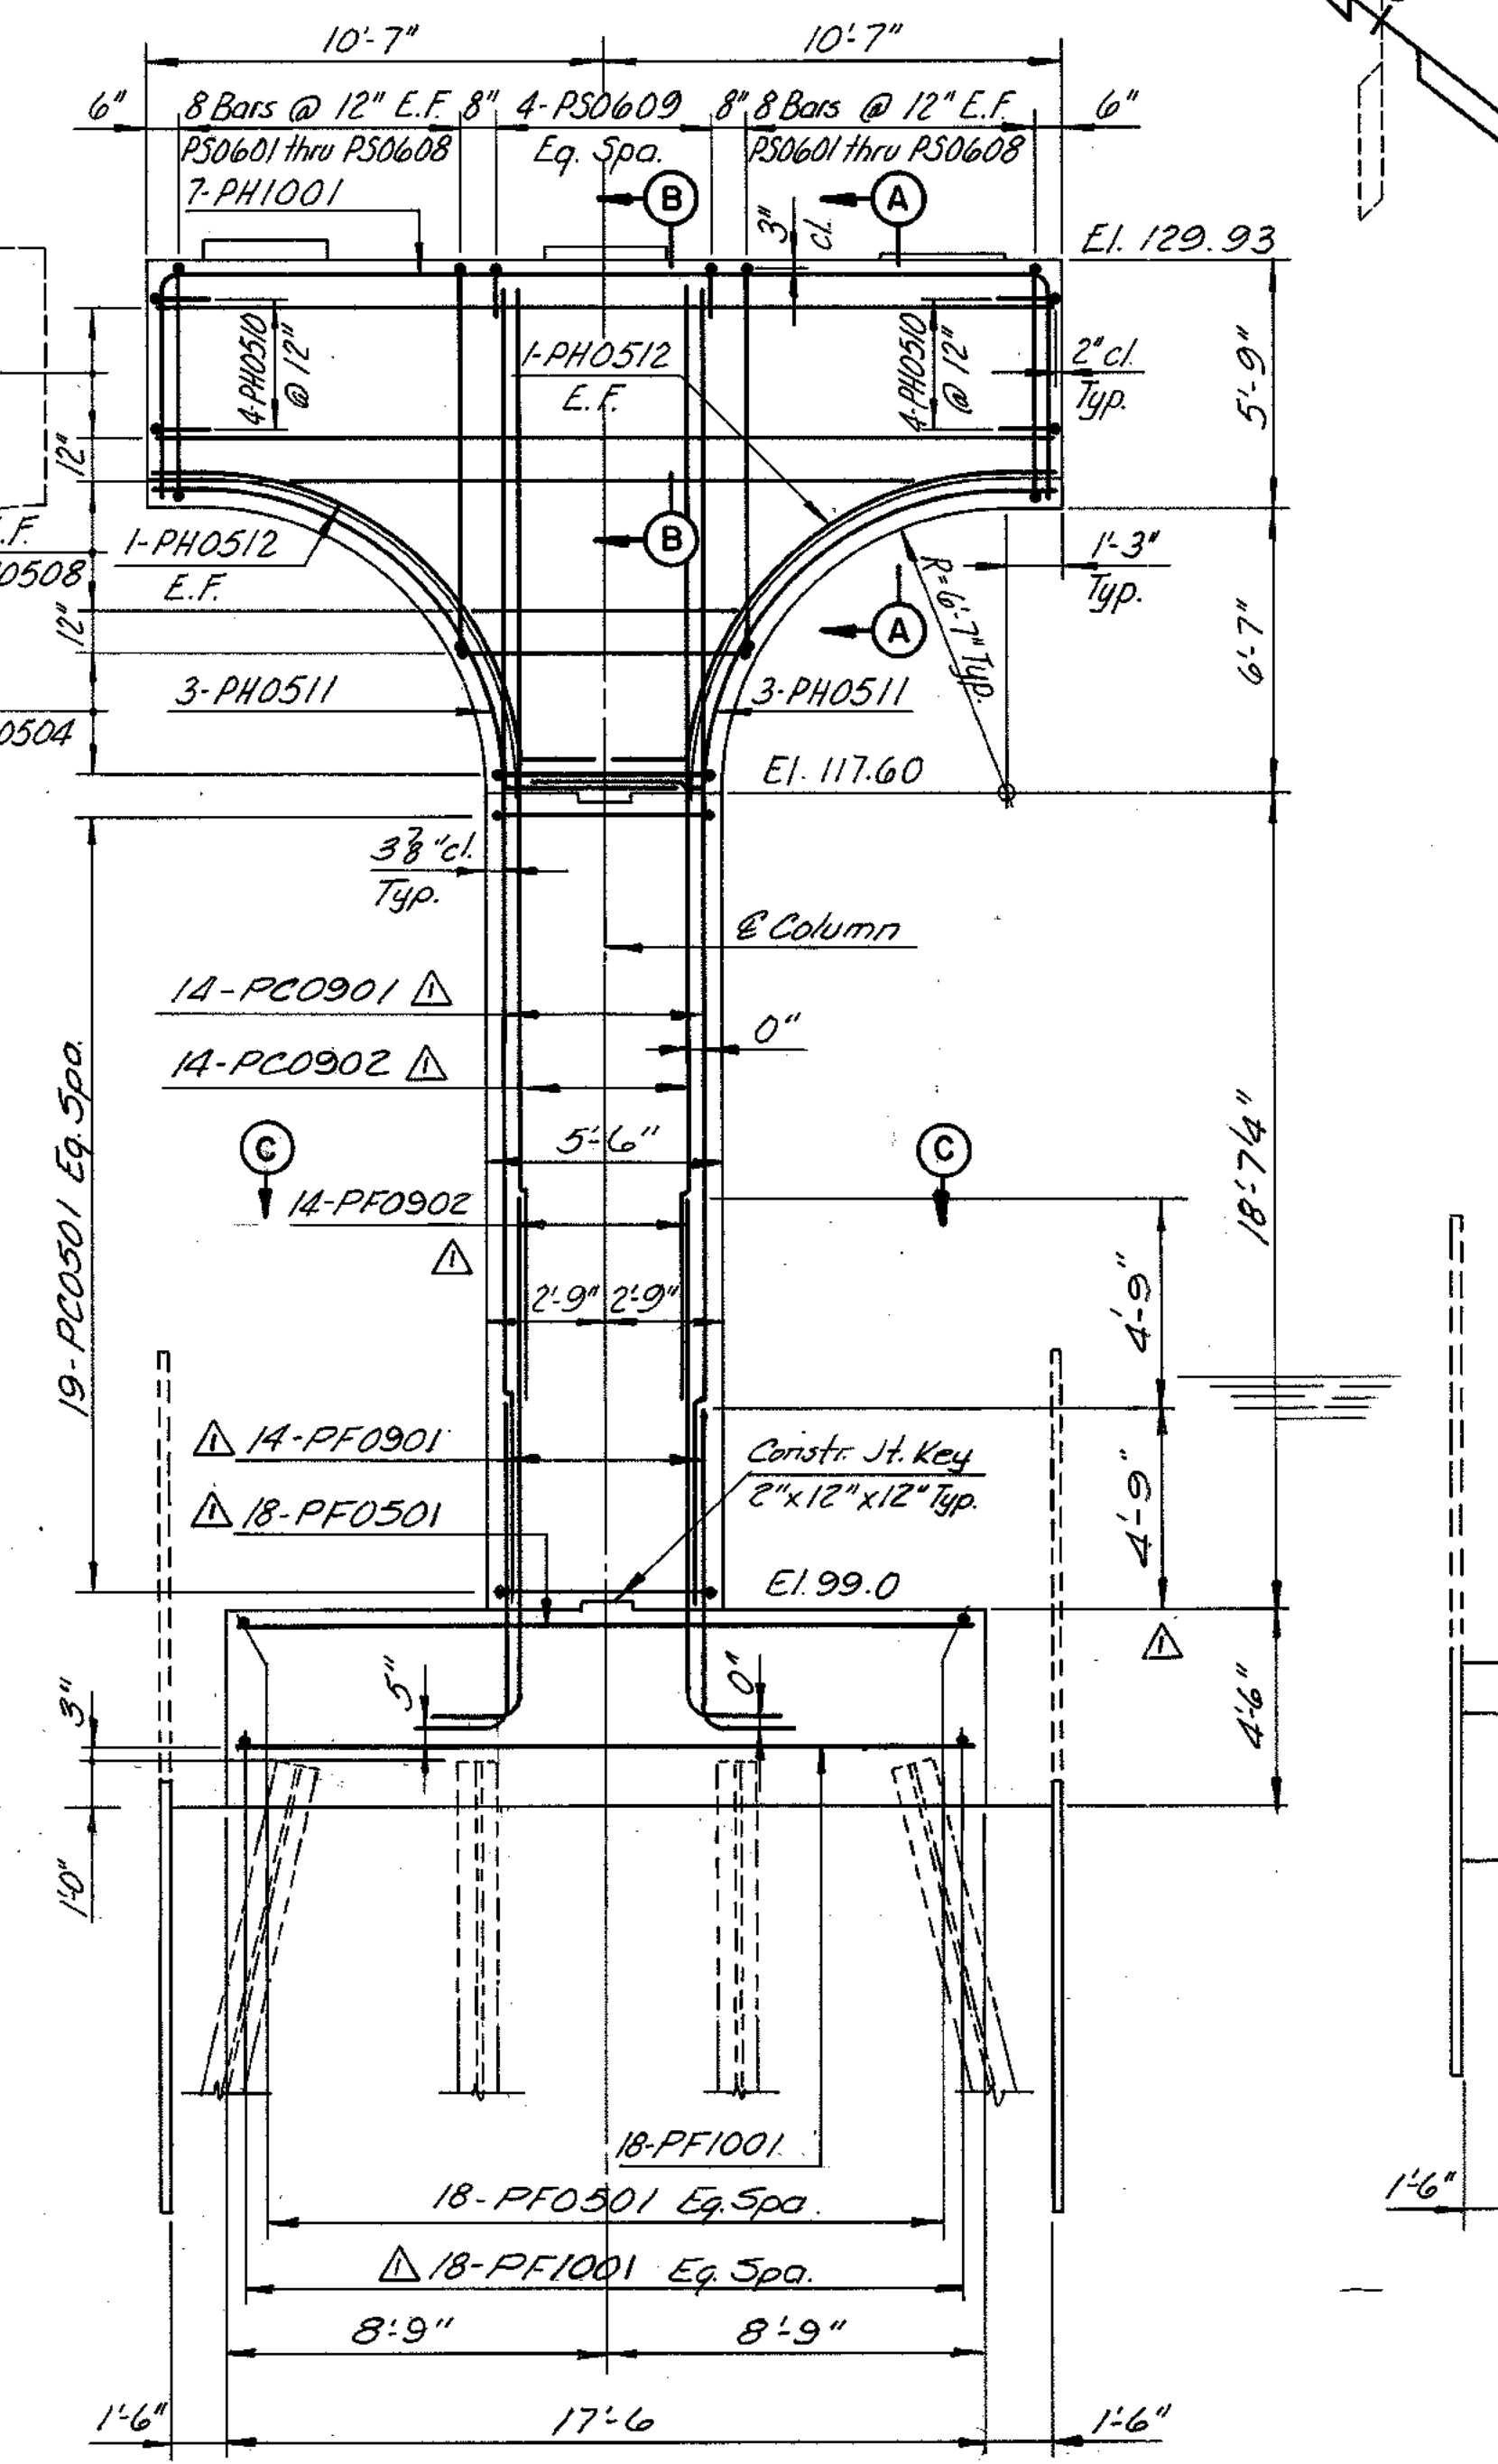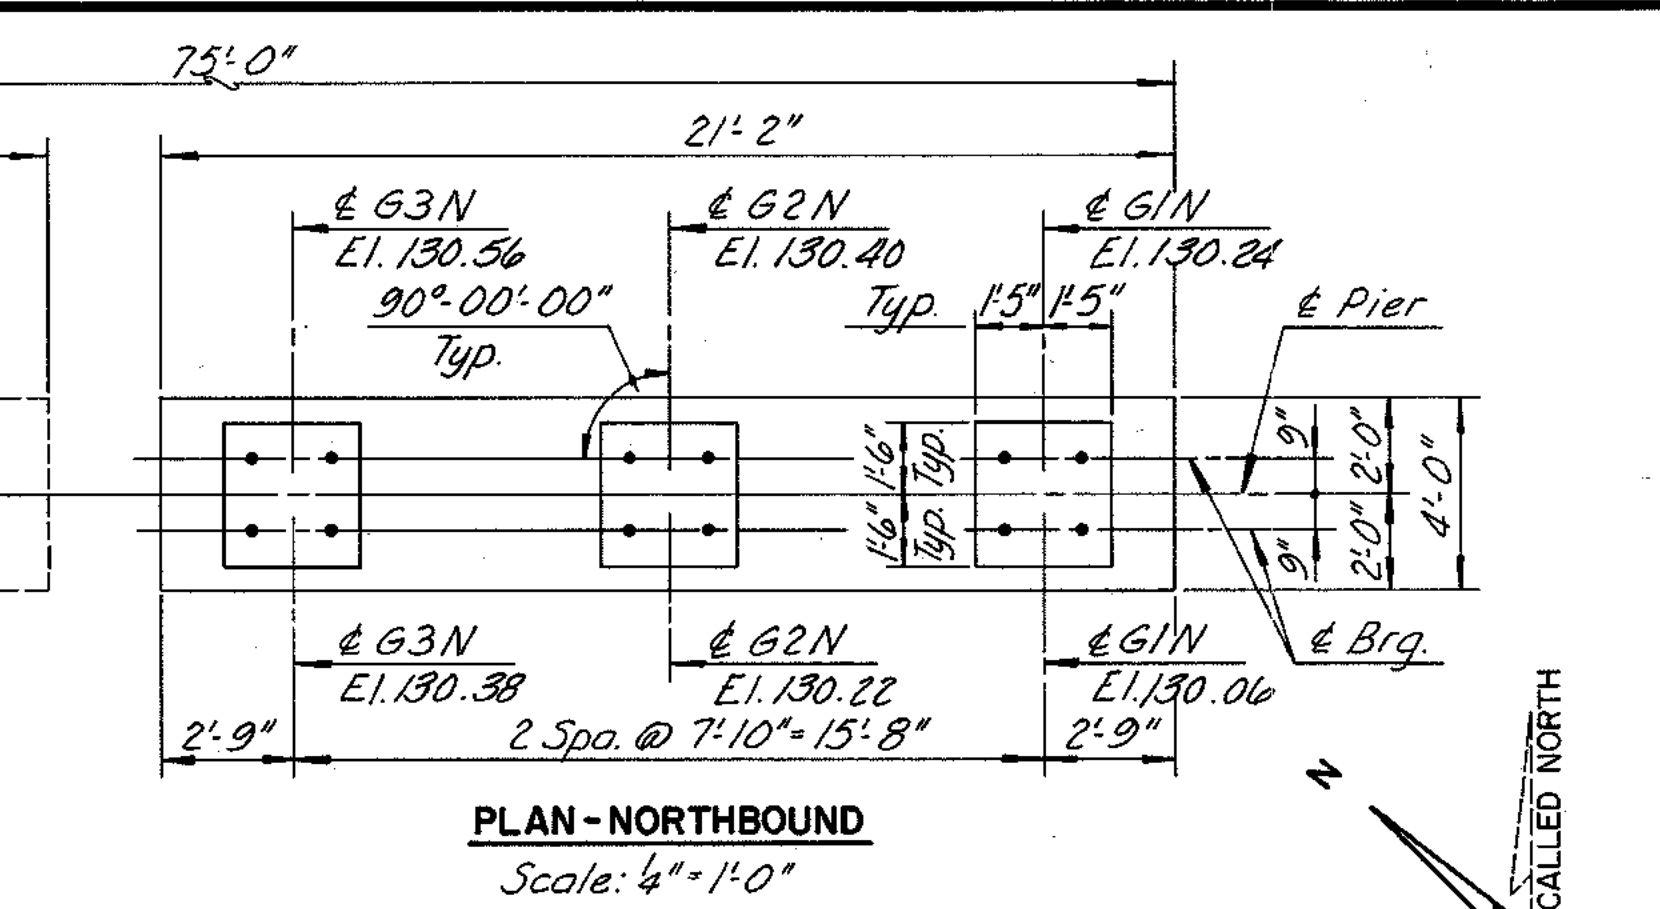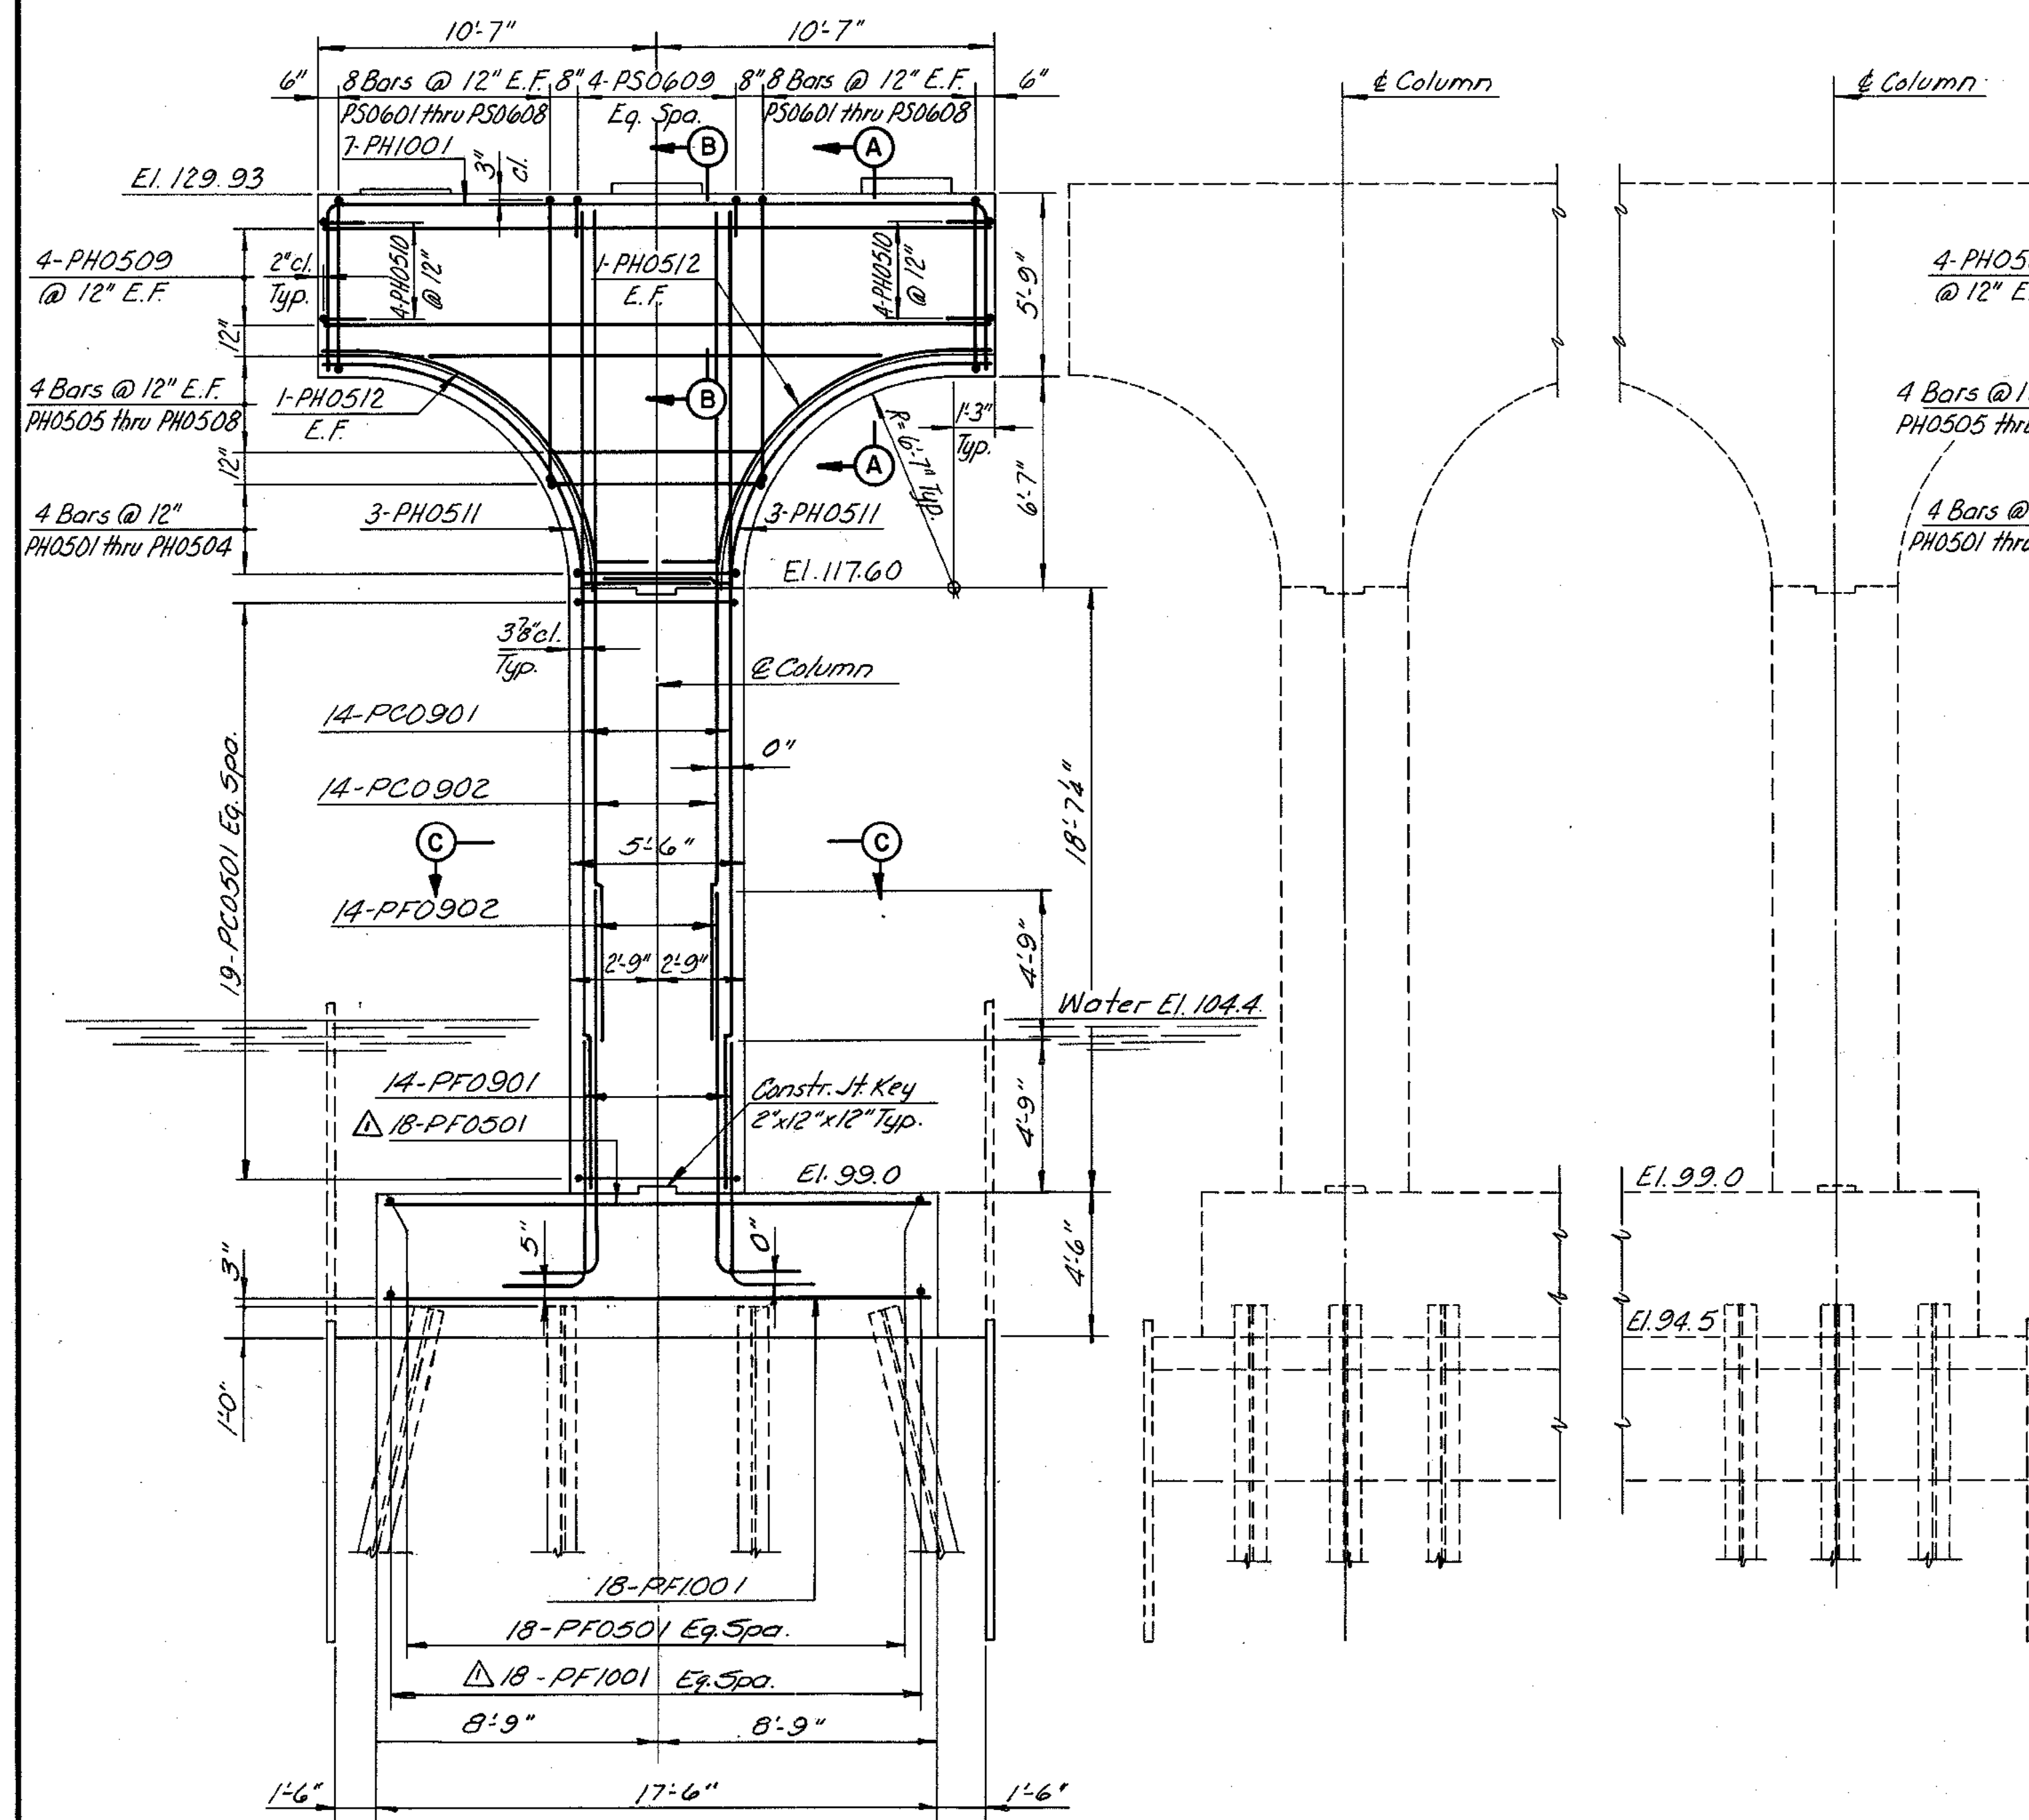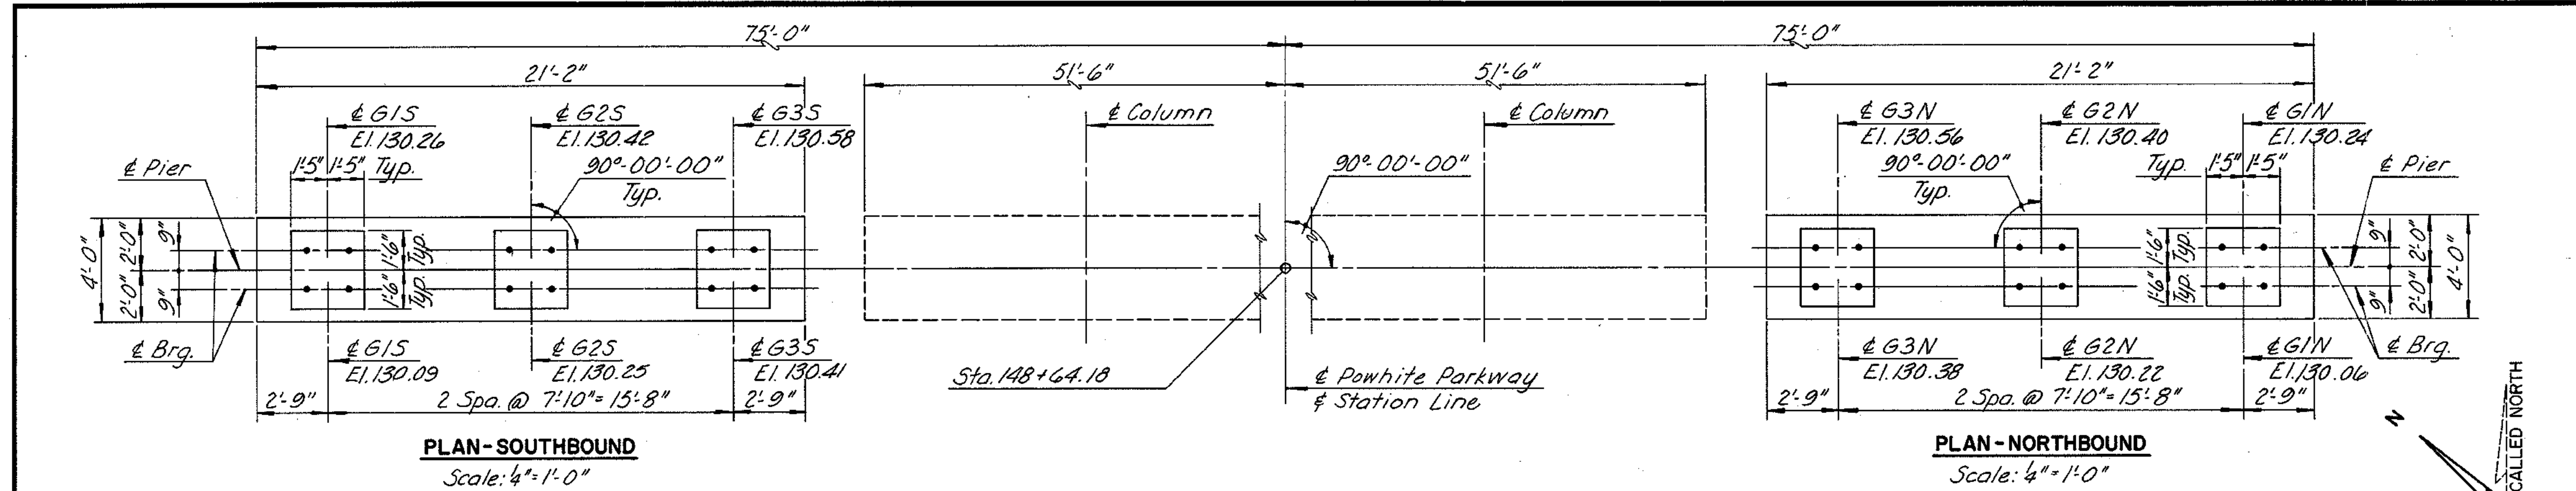

**PILE NOTES:**

**H** Indicates vertical piles

**H▶** Indicates piles battered  
2:12 in direction of  
arrow.

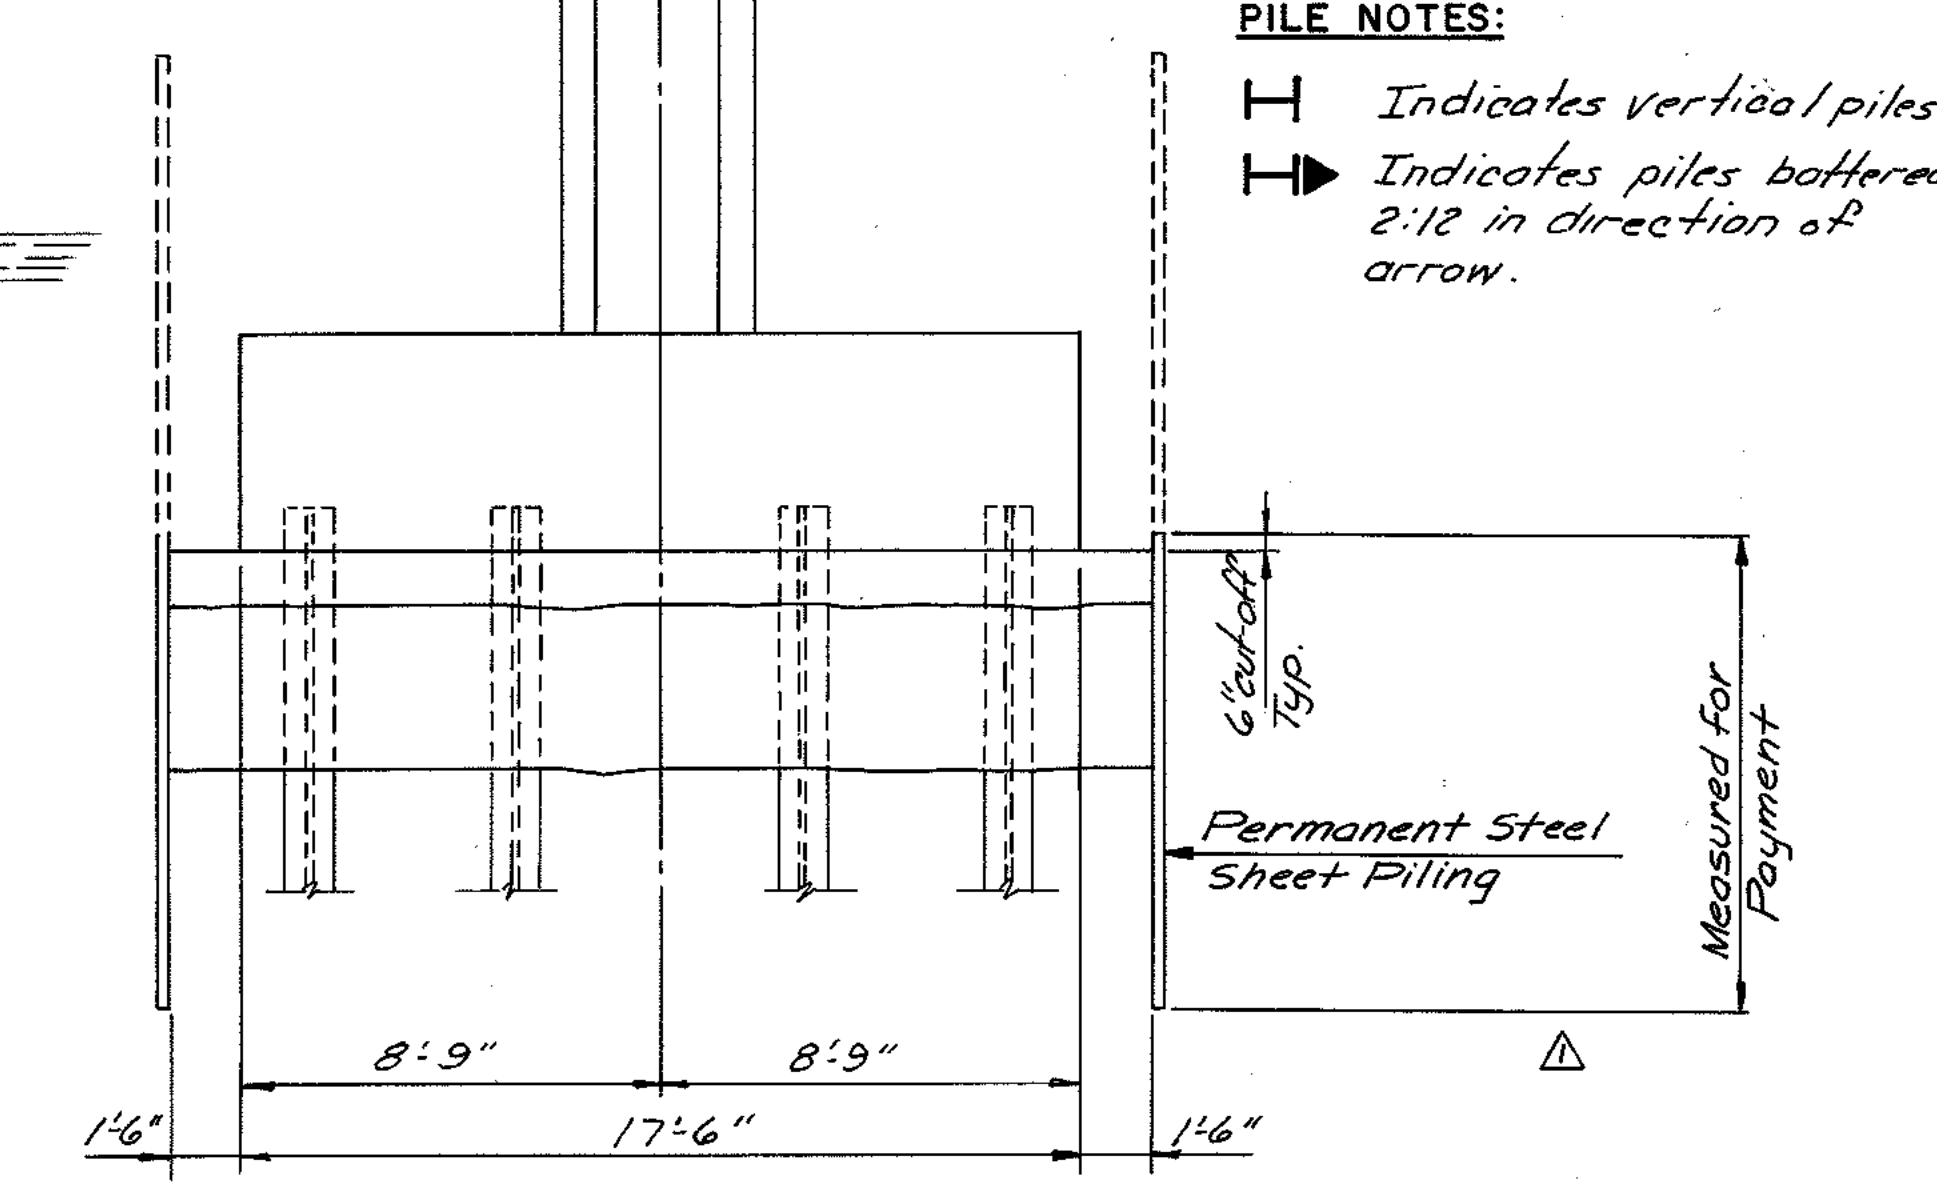

**RICHMOND METROPOLITAN AUTHORITY  
RICHMOND EXPRESSWAY SYSTEM**

PIER 17 DETAILS

HOWARD, NEEDLES, TAMMEN & BERGENDOFF  
consulting engineers  
Alexandria, Virginia

SCALE: AS SHOWN  
CONTRACT NO.: C-13  
SHEET NO. 28 OF 10


AS BUILT

	BY	DATE	As Built	TEM	3-89
MADE	TAL.	3-87	Rev Anchor Bolt	A/C	G-87
CHECKED	T.F.F.	3-87	Both Elevation & End View	A/C	4-87
IN CHARGE	S.R.		NO. REVISION	BY	DATE




RICHMOND EXPRESSWAY SYSTEM			
SECTION	PROJECT	SHEET NO.	TOTAL SHEETS
13	WIDENING JAMES RIVER BRIDGE	31	106

NOTE:  
For Steel Details, see Sheet No. 45.

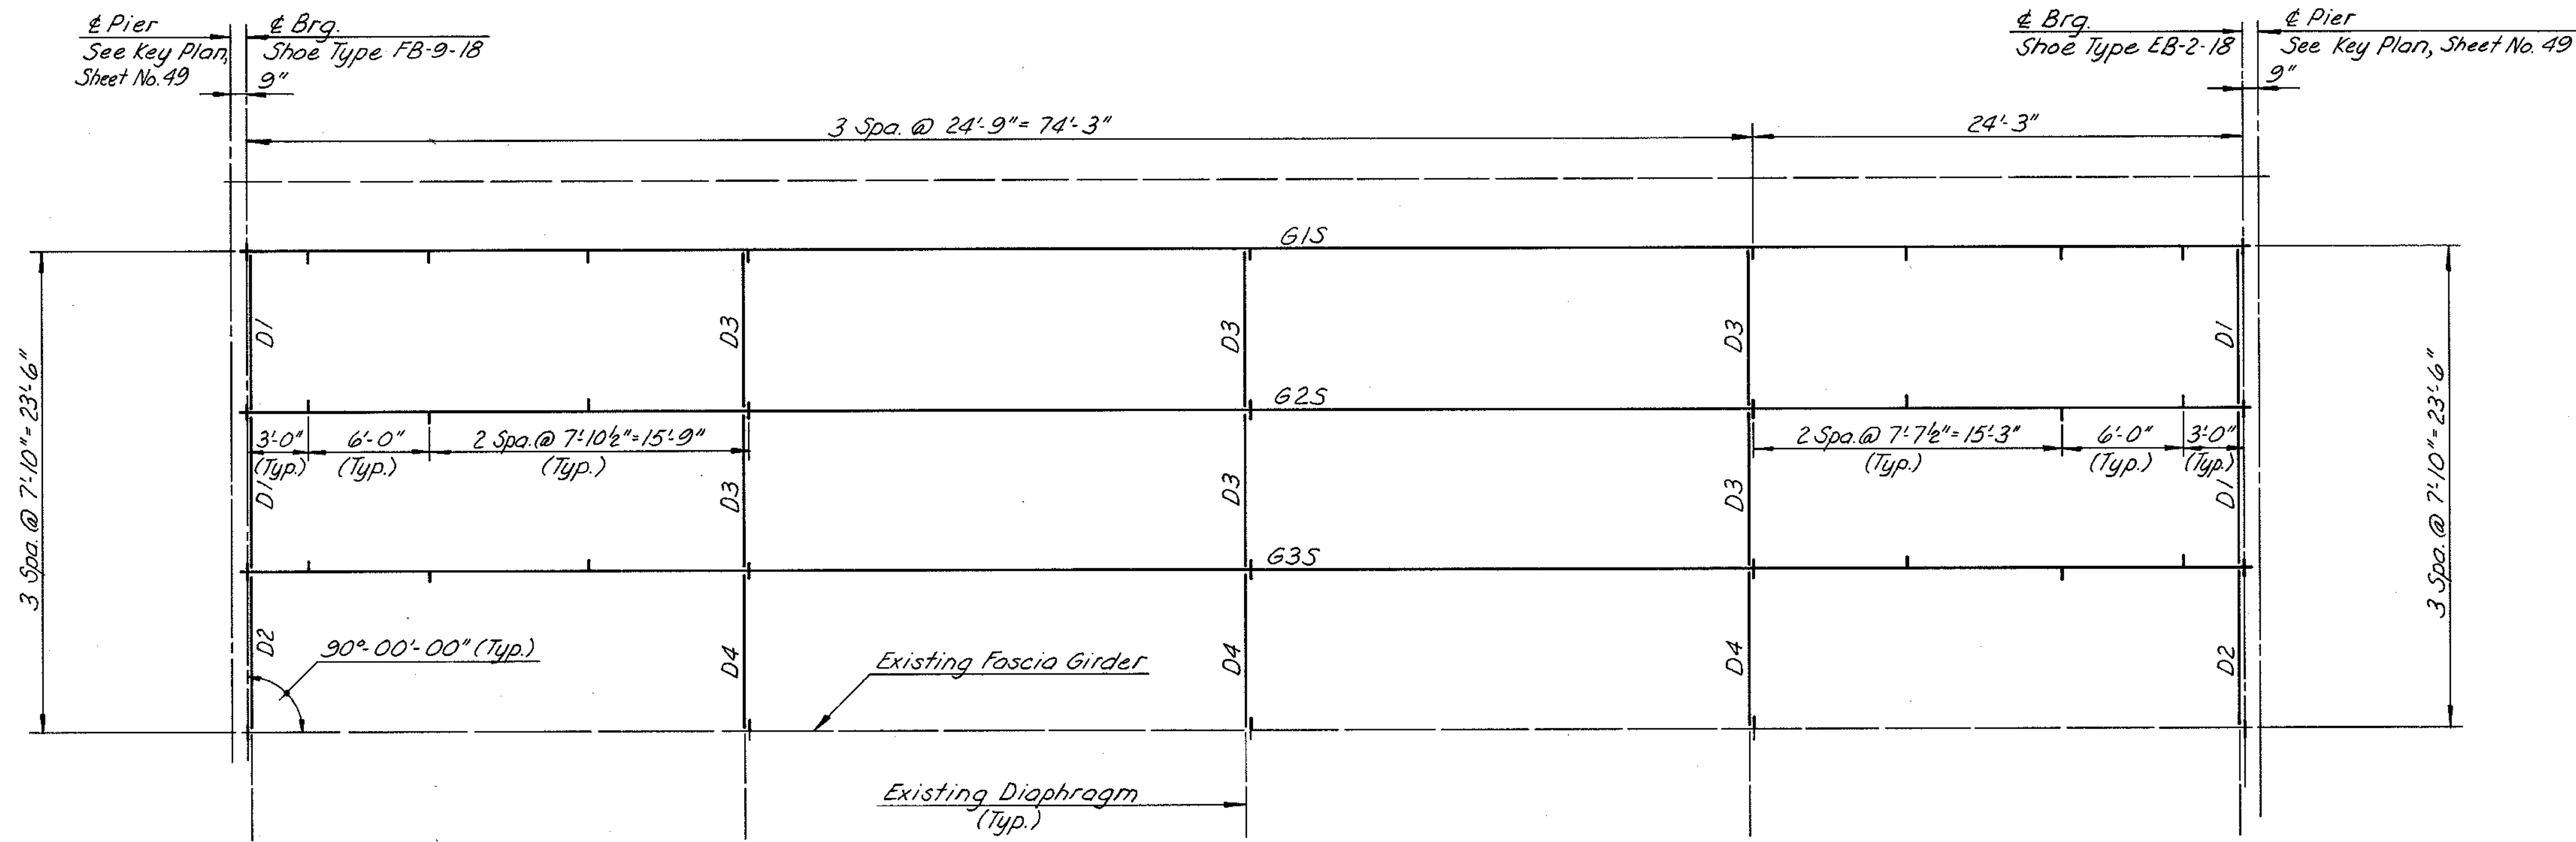

FRAMING PLAN - UNITS 2 & 3 SOUTHBOUND & NORTHBOUND  
(SOUTHBOUND SHOWN)  
Scale:  $\frac{3}{16}'' = 1'-0''$

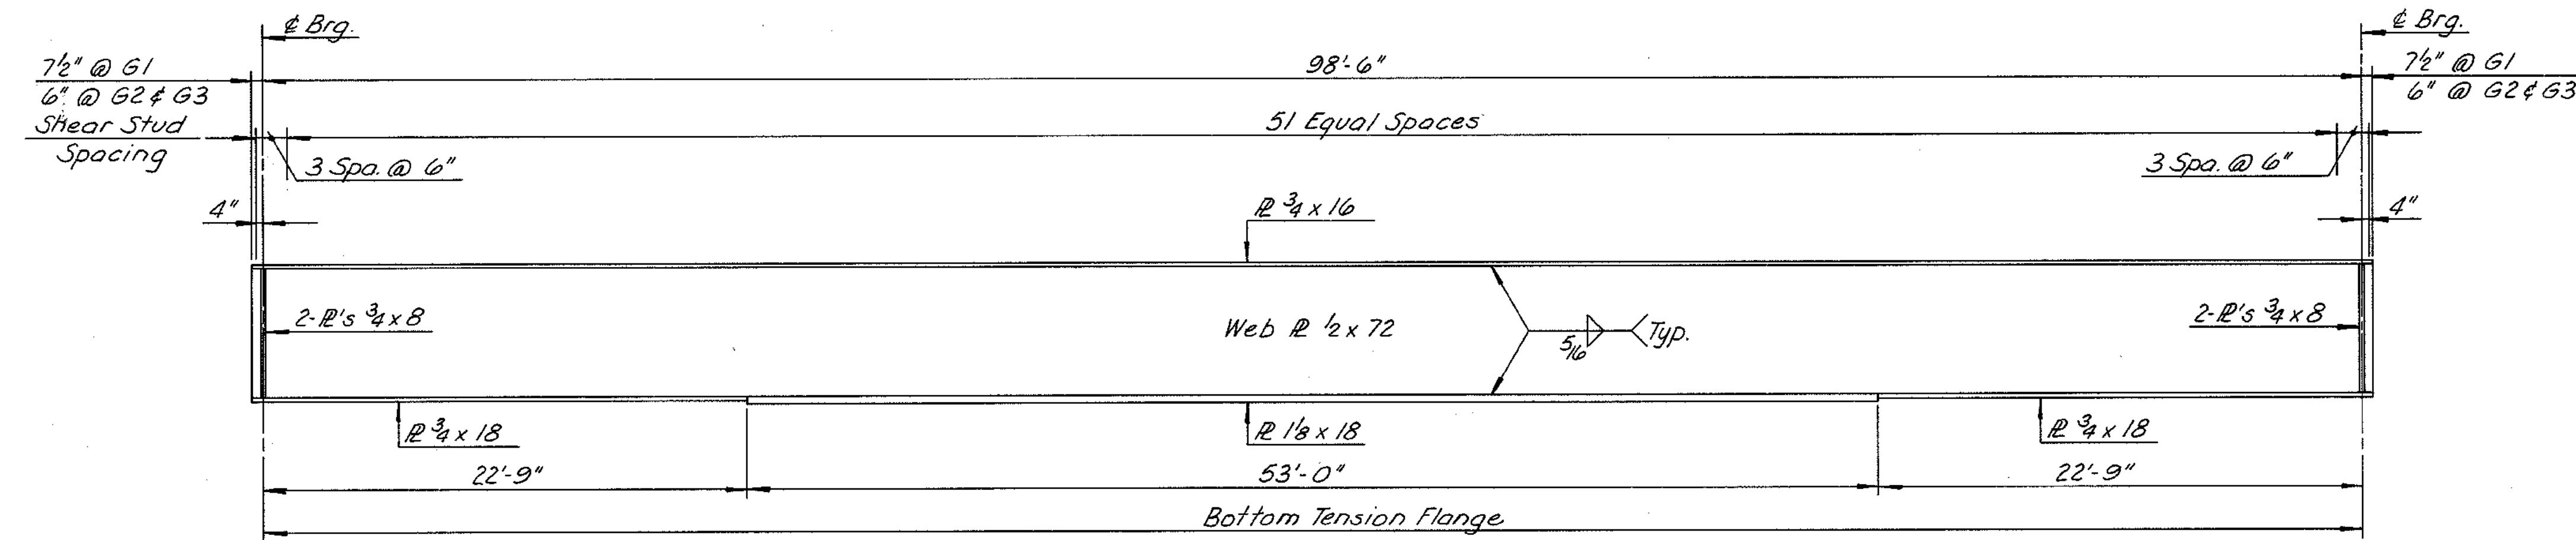

GIRDER ELEVATION - UNITS 2 & 3 SOUTHBOUND & NORTHBOUND  
Scale:  $\frac{3}{16}'' = 1'-0''$

BY	DATE				
MADE	EUM	1-87			
CHECKED	TFP	3-87	As Built	TEM	3-89
IN CHARGE	SR				

AS BUILT

RICHMOND METROPOLITAN AUTHORITY  
RICHMOND EXPRESSWAY SYSTEM

FRAMING PLAN & GIRDER ELEVATION  
UNITS 2 & 3 SOUTHBOUND & NORTHBOUND


HOWARD, NEEDLES, TAMMEN & BERGENDOFF  
consulting engineers  
Alexandria, Virginia

SCALE: AS SHOWN  
CONTRACT NO.: C-13  
SHEET NO. 31 OF 106




RICHMOND EXPRESSWAY SYSTEM			
SECTION	PROJECT	SHEET NO.	TOTAL SHEETS
13	WIDENING JAMES RIVER BRIDGE	32	106

NOTE:  
For Steel Details, see Sheet No. 45.

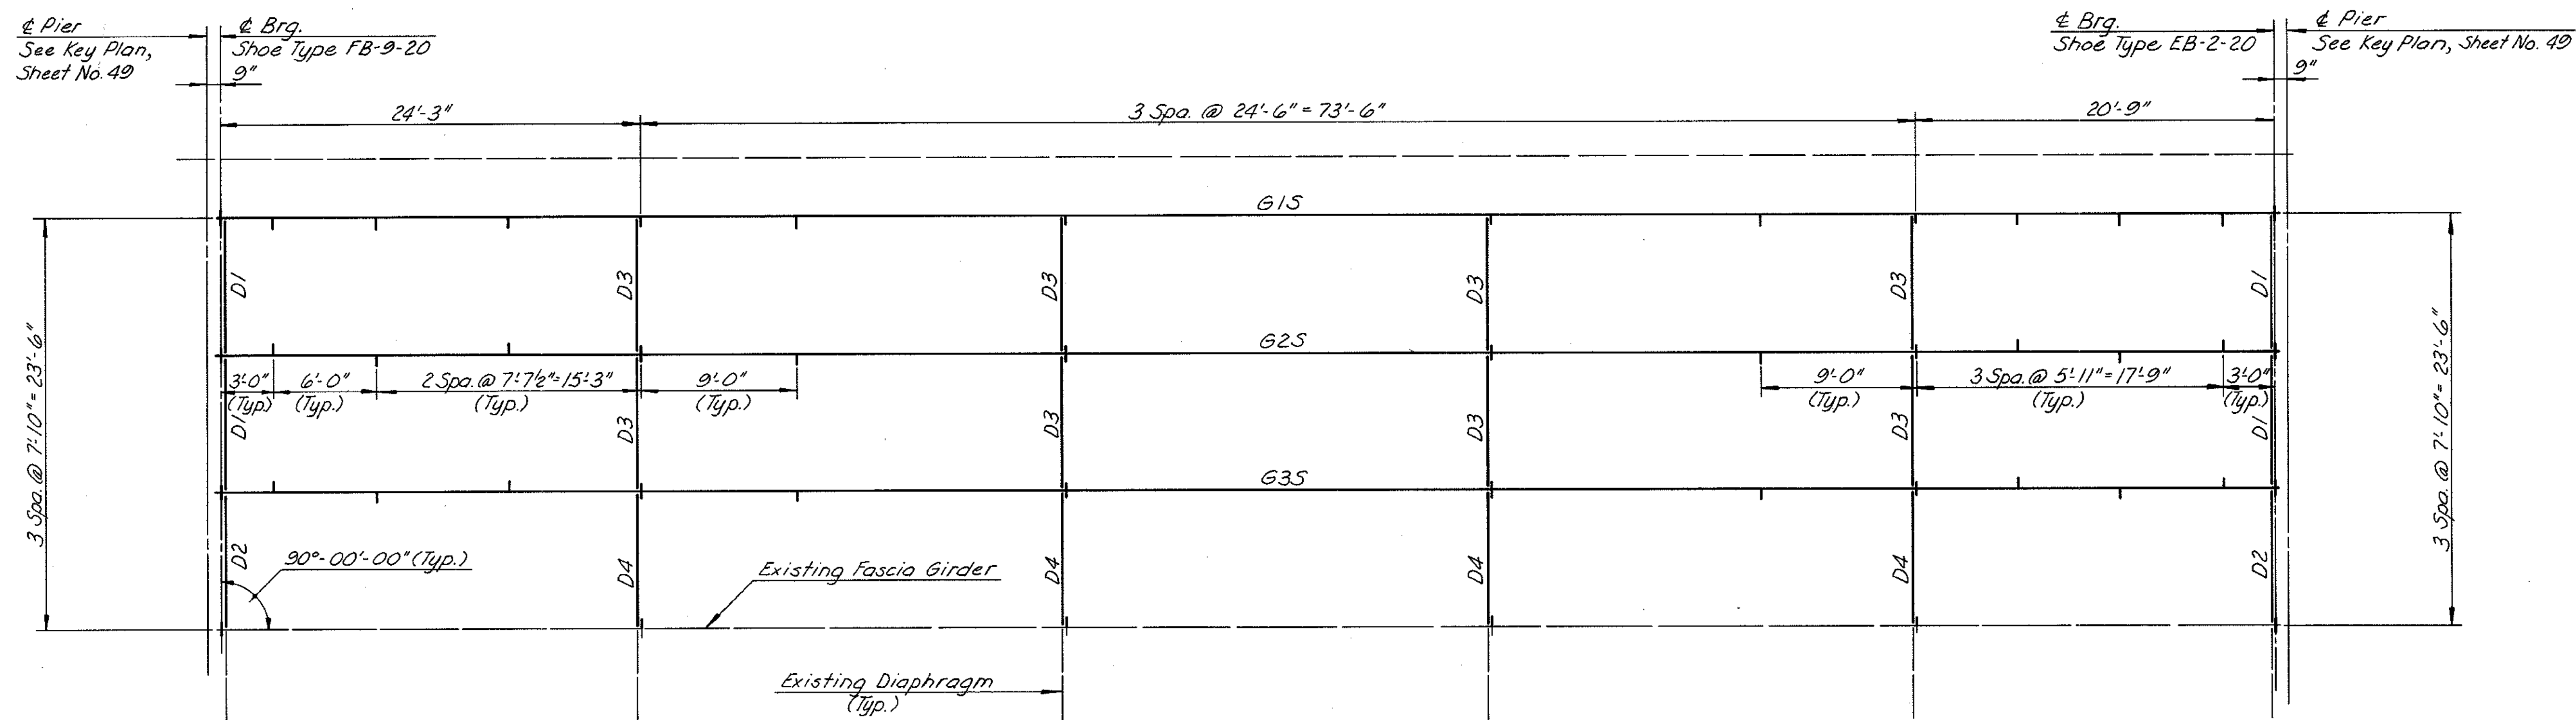

FRAMING PLAN - UNIT 4 SOUTHBOUND & NORTHBOUND  
(SOUTHBOUND SHOWN)  
Scale:  $\frac{3}{16}'' = 1'-0''$

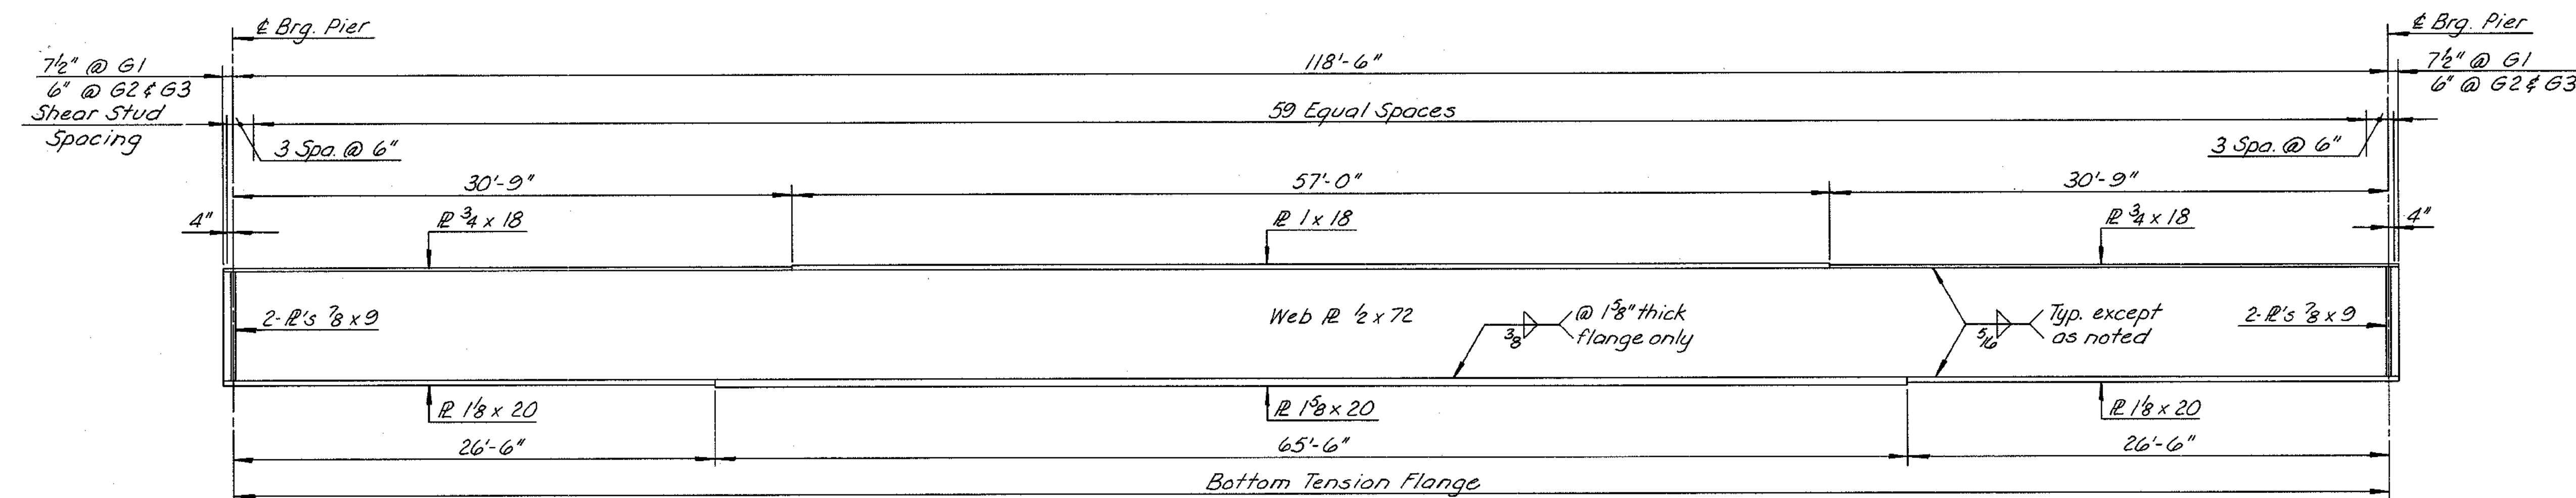


GIRDER ELEVATION - UNIT 4 SOUTHBOUND & NORTHBOUND  
Scale:  $\frac{3}{16}'' = 1'-0''$

BY	DATE				
MADE	EUM	1-87			
CHECKED	TFP	3-87	As-Built	TEM	3-89
IN CHARGE	SR		NO.	REVISION	BY DATE

AS BUILT


RICHMOND METROPOLITAN AUTHORITY RICHMOND EXPRESSWAY SYSTEM	
FRAMING PLAN & GIRDER ELEVATION UNIT 4 SOUTHBOUND & NORTHBOUND	
HOWARD, NEEDLES, TAMMEN & BERGENDOFF consulting engineers Alexandria, Virginia	SCALE: AS SHOWN CONTRACT NO.: C-13 SHEET NO. 32 OF 106

RICHMOND EXPRESSWAY SYSTEM			
SECTION	PROJECT	SHEET NO.	TOTAL SHEETS
13	WIDENING JAMES RIVER BRIDGE	33	106

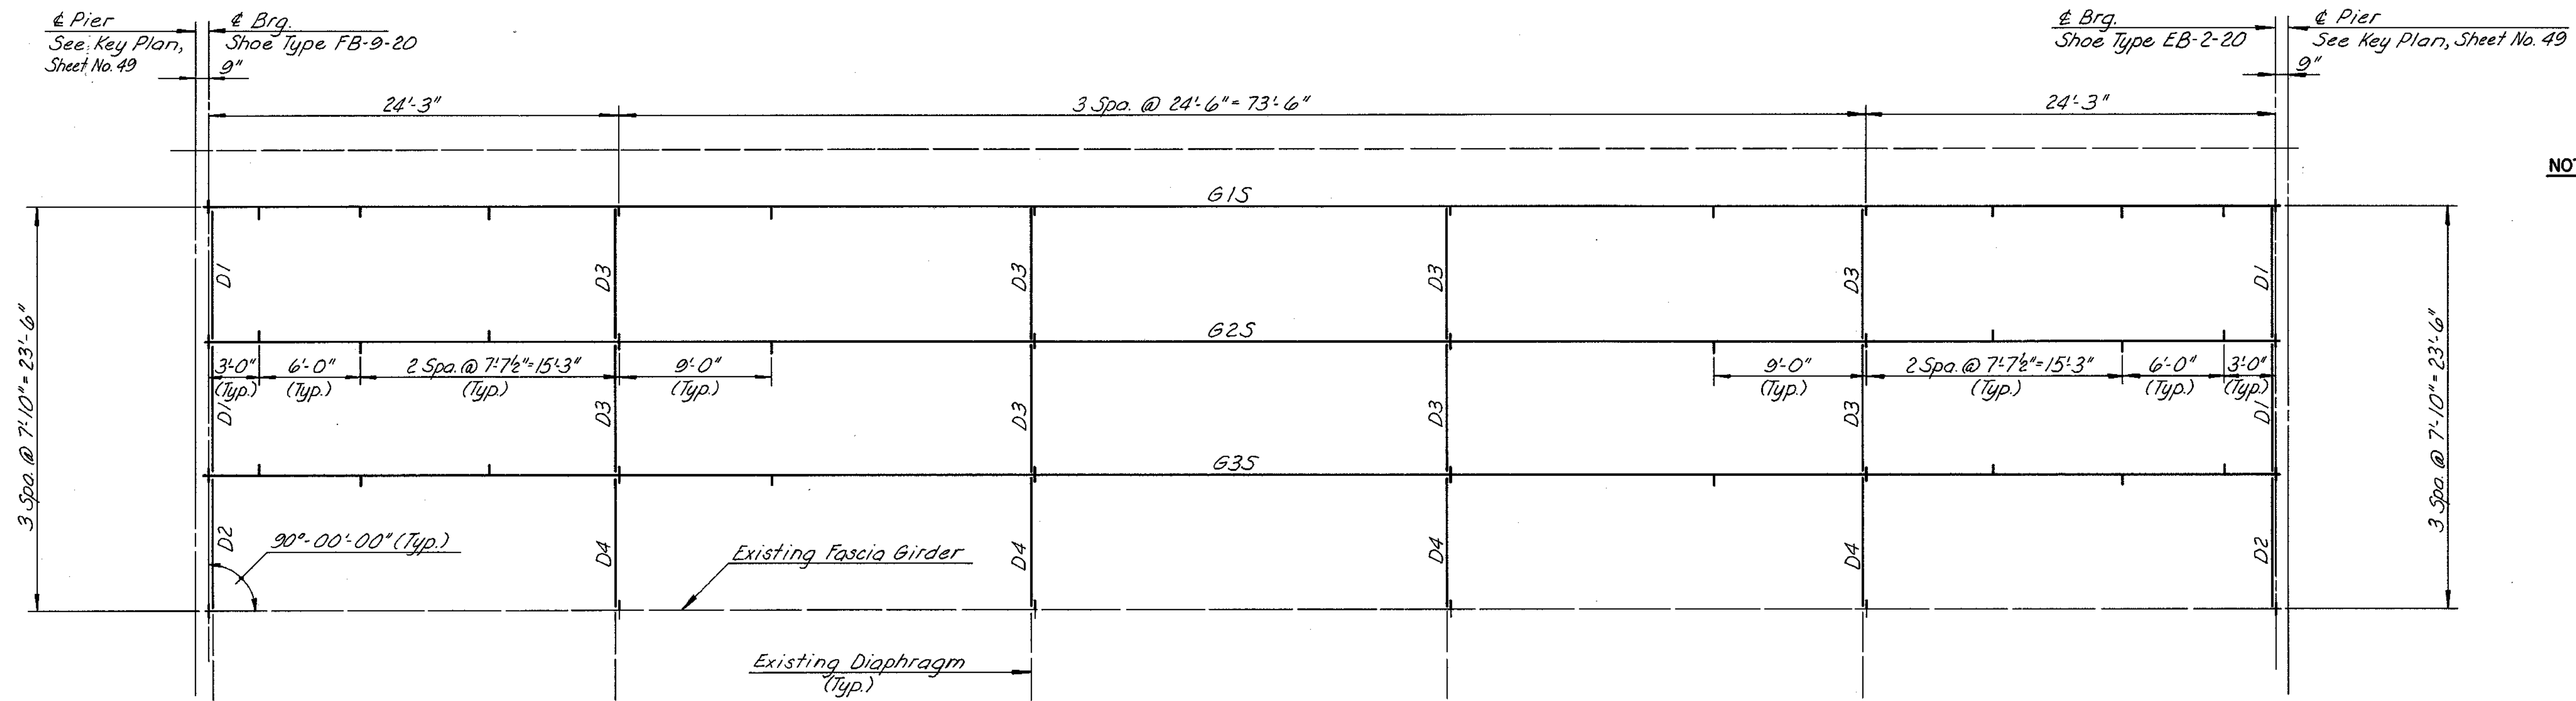

NOTE:  
For Steel Details, see Sheet No. 45.

FRAMING PLAN-UNITS 5 THRU 12 SOUTHBOUND & NORTHBOUND  
(SOUTHBOUND SHOWN)  
Scale:  $\frac{3}{16}'' = 1'-0''$

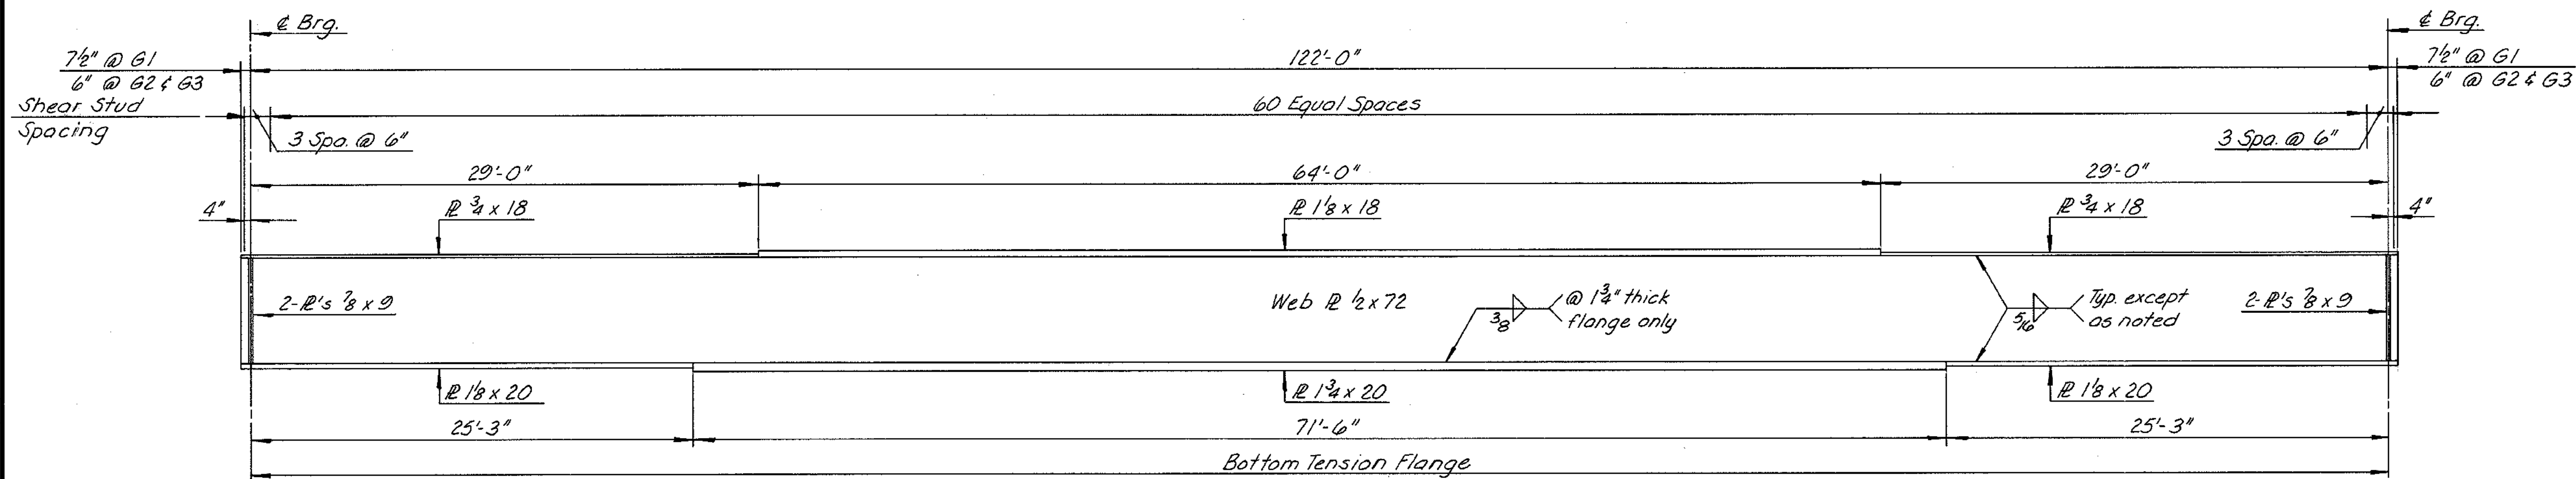

GIRDER ELEVATION-UNITS 5 THRU 12 SOUTHBOUND & NORTHBOUND  
Scale:  $\frac{3}{16}'' = 1'-0''$


BY	DATE				
MADE	EJM	1-87			
CHECKED	TFP	3-87	As Built	TEM	3-89
IN CHARGE	SR				

AS BUILT


RICHMOND METROPOLITAN AUTHORITY RICHMOND EXPRESSWAY SYSTEM	
FRAMING PLAN & GIRDER ELEVATION UNITS 5 THRU 12 SOUTHBOUND & NORTHBOUND	
HOWARD, NEEDLES, TAMMEN & BERGENDOFF consulting engineers Alexandria, Virginia	SCALE: AS SHOWN CONTRACT NO.: C-13 SHEET NO. 33 OF 106

RICHMOND EXPRESSWAY SYSTEM			
SECTION	PROJECT	SHEET NO.	TOTAL SHEETS
13	WIDENING JAMES RIVER BRIDGE	34	106

NOTE:  
For Steel Details, see Sheet No. 45.

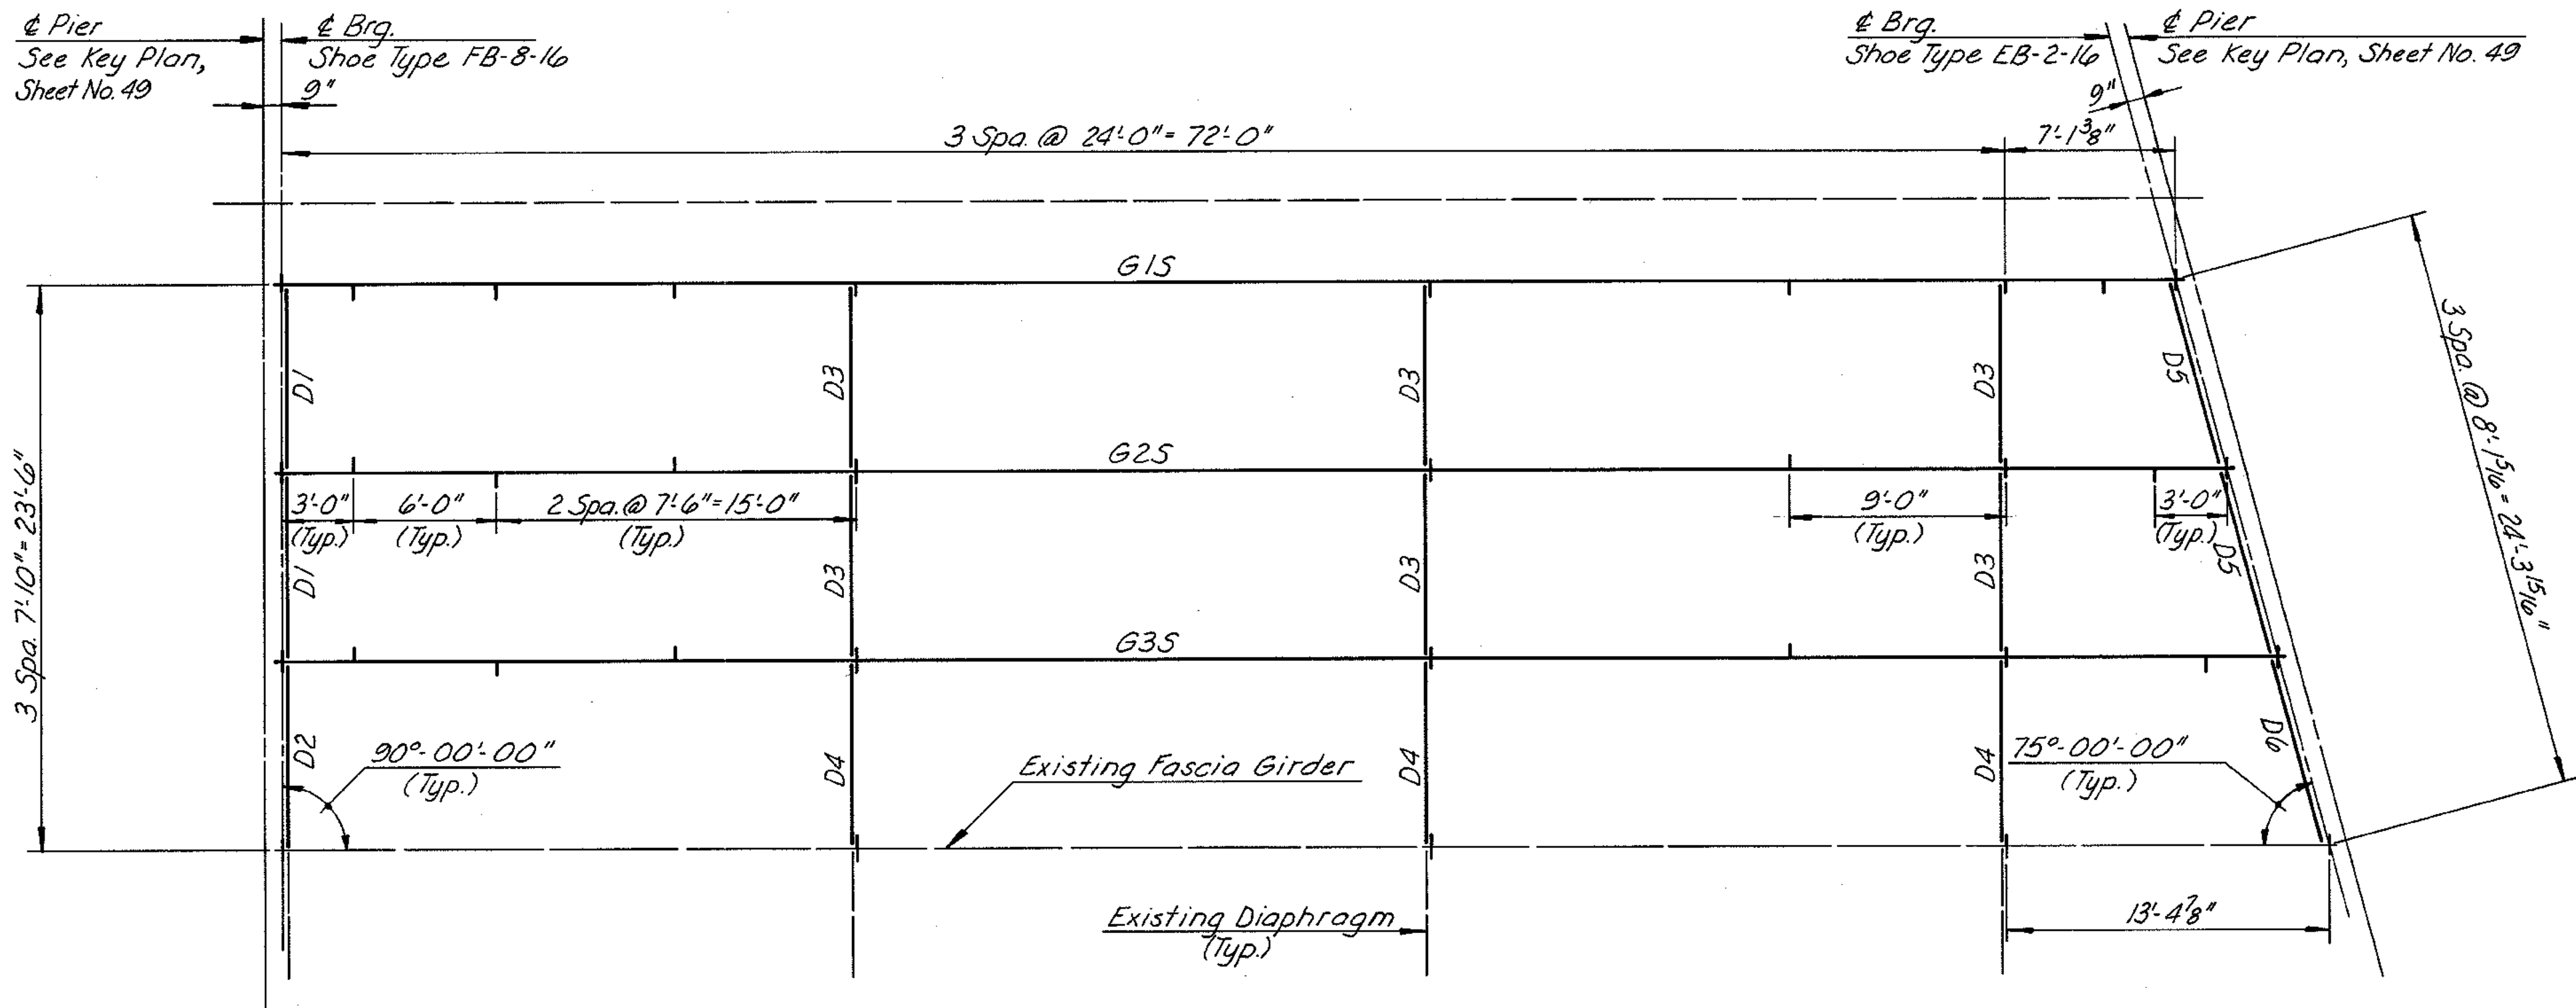

FRAMING PLAN-UNIT 13 SOUTHBOUND  
Scale: 3/16" = 1'-0"

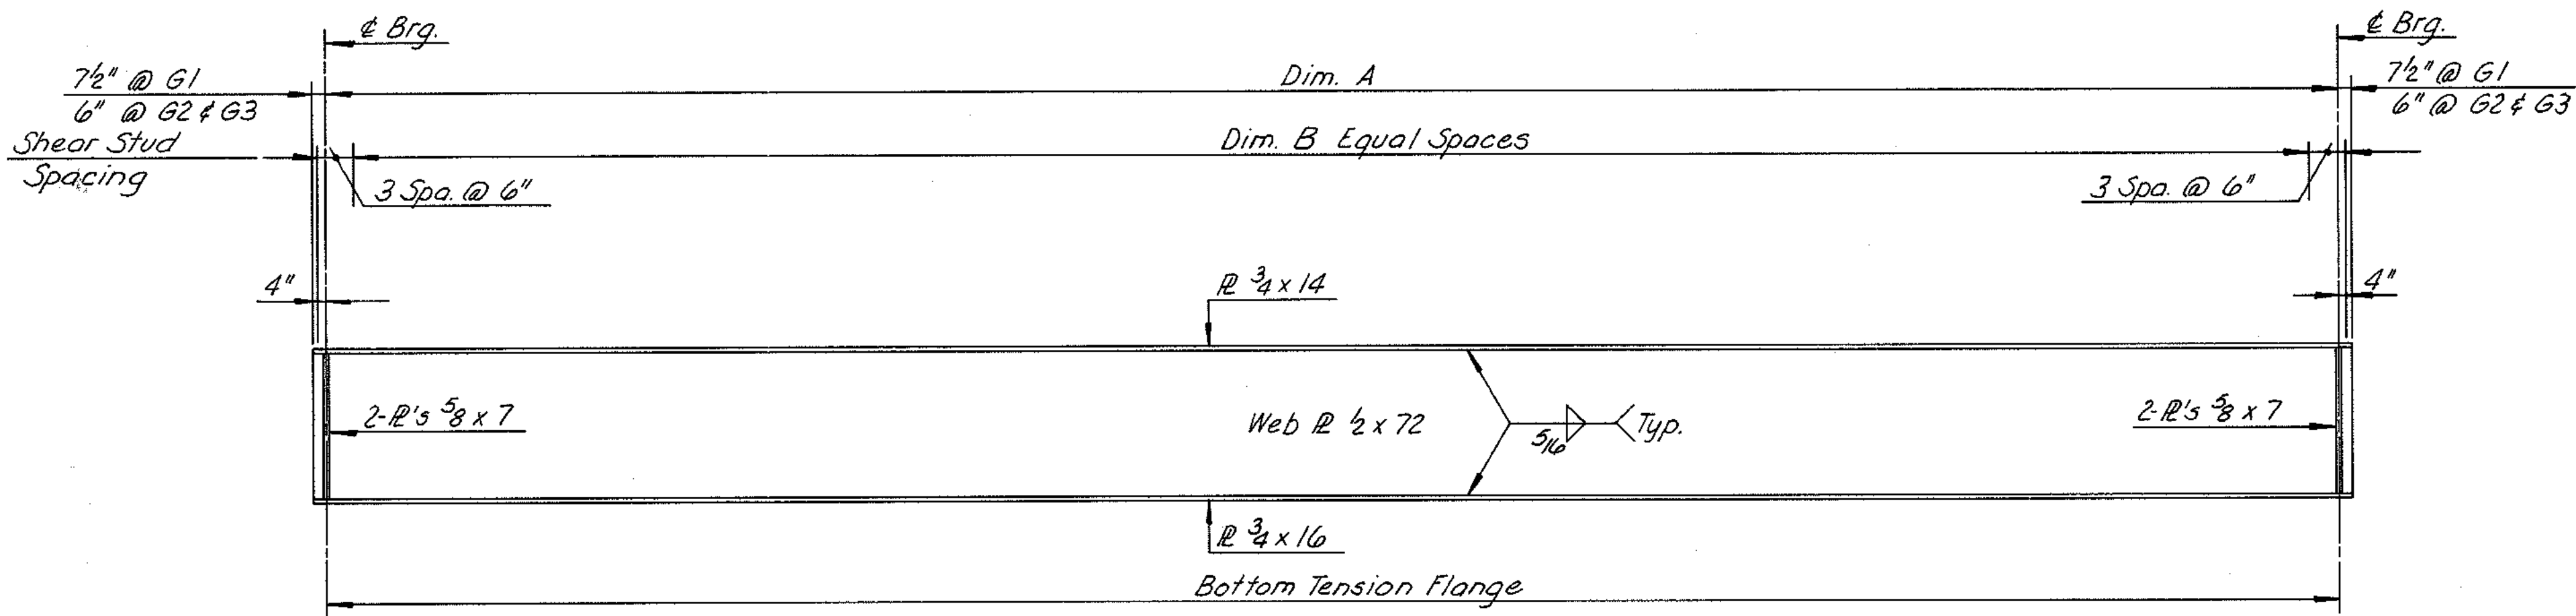

GIRDER ELEVATION-UNIT 13 SOUTHBOUND  
Scale: 3/16" = 1'-0"

GIRDER	DIM. A	DIM. B
G1	79'-1 3/8"	43
G2	81'-2 1/2"	44
G3	83'-3 3/4"	45



BY	DATE	NO.	REVISION	BY	DATE
MADE	EUM 1-87				
CHECKED	TFP 3-87		As Built	TEM	3-89
IN CHARGE	SR				

AS BUILT

RICHMOND METROPOLITAN AUTHORITY RICHMOND EXPRESSWAY SYSTEM	
FRAMING PLAN & GIRDER ELEVATION UNIT 13 SOUTHBOUND	
HOWARD, NEEDLES, TAMMEN & BERGENDOFF consulting engineers Alexandria, Virginia	SCALE: AS SHOWN CONTRACT NO.: C-13 SHEET NO. 34 OF 106

RICHMOND EXPRESSWAY SYSTEM			
SECTION	PROJECT	SHEET NO.	TOTAL SHEETS
13	WIDENING JAMES RIVER BRIDGE	35	106

NOTE:  
For Steel Details, see Sheet No. 45

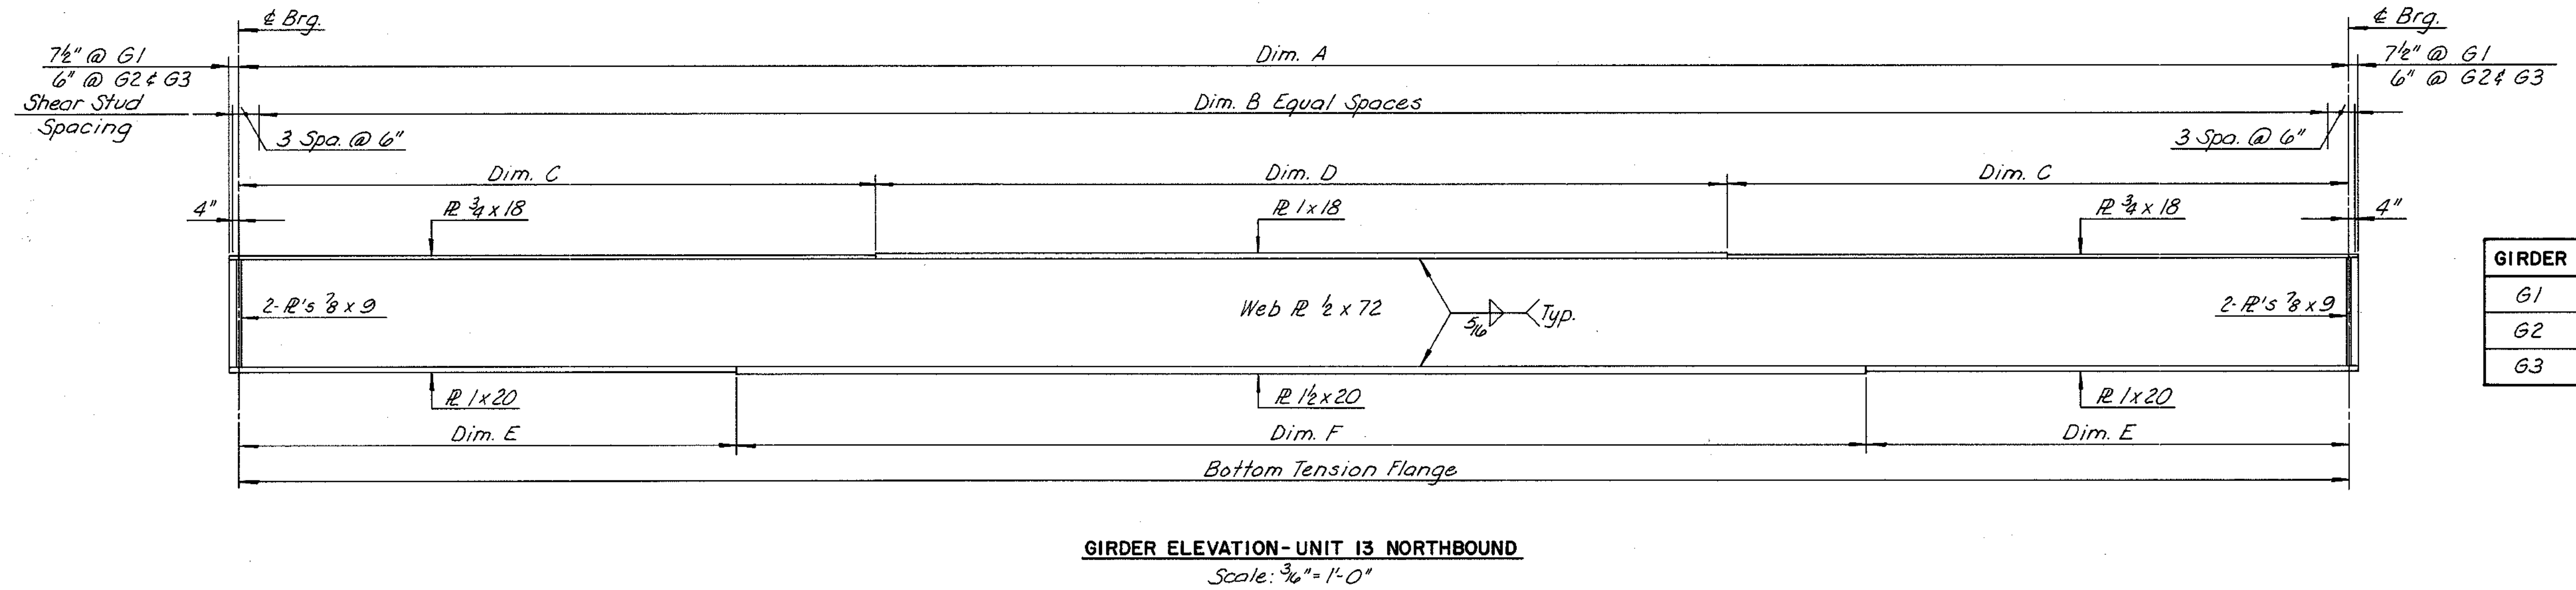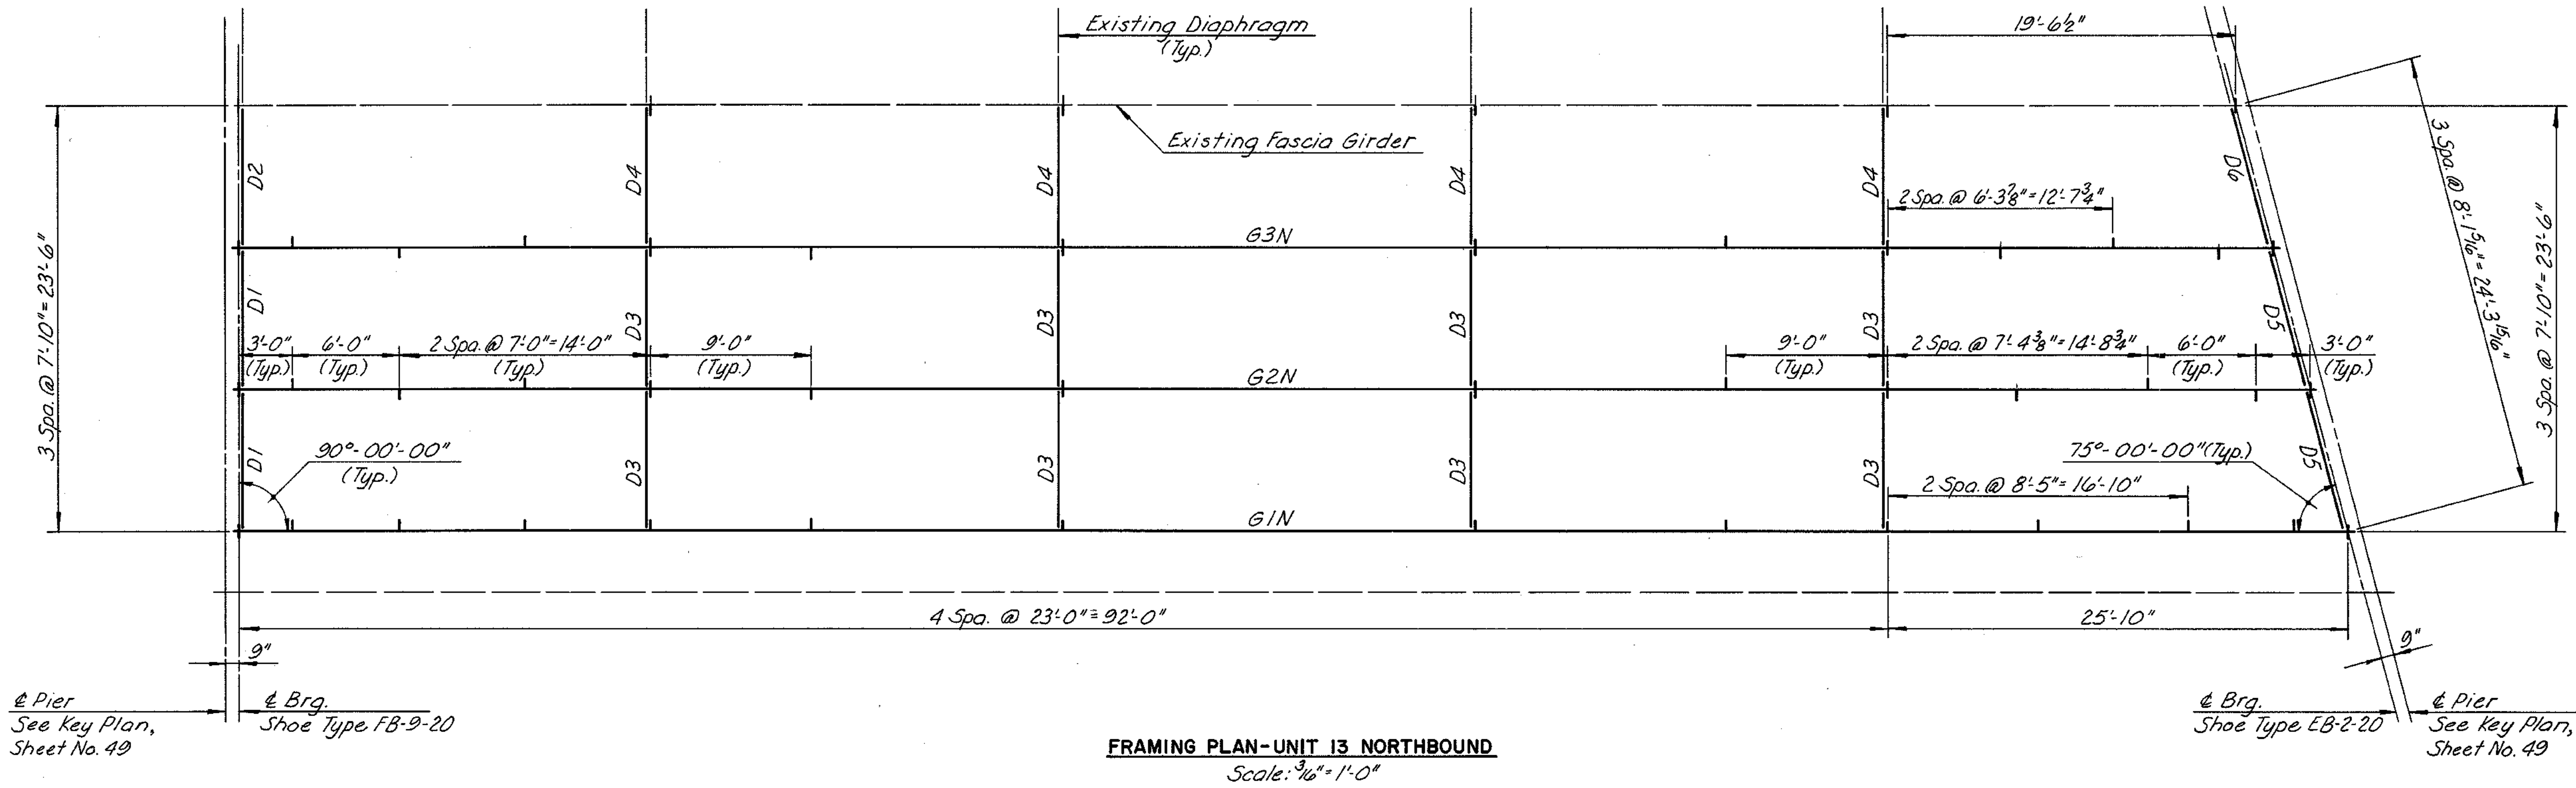

GIRDER	DIM. A	DIM. B	DIM. C	DIM. D	DIM. E	DIM. F
G1	117'-10"	58	32'-11"	52'-0"	25'-8"	66'-6"
G2	115'-8 3/4"	57	32'-1 3/8"	51'-6"	24'-7 3/8"	66'-6"
G3	113'-7 7/8"	56	33'-9 3/16"	46'-0"	25'-6 3/16"	62'-6"

BY	DATE				
MADE	EJM	1-87			
CHECKED	TFP	3-87	As Built	TEM	3-89
IN CHARGE	SR				

AS BUILT

RICHMOND METROPOLITAN AUTHORITY  
RICHMOND EXPRESSWAY SYSTEM

FRAMING PLAN & GIRDER ELEVATION  
UNIT 13 NORTHBOUND


HOWARD, NEEDLES, TAMMEN & BERGENDOFF  
consulting engineers  
Alexandria, Virginia

SCALE: AS SHOWN  
CONTRACT NO.: C-13  
SHEET NO. 35 OF 106




RICHMOND EXPRESSWAY SYSTEM			
SECTION	PROJECT	SHEET NO.	TOTAL SHEETS
13	WIDENING JAMES RIVER BRIDGE	36	106

NOTE:  
For Steel Details, see Sheet No. 45.

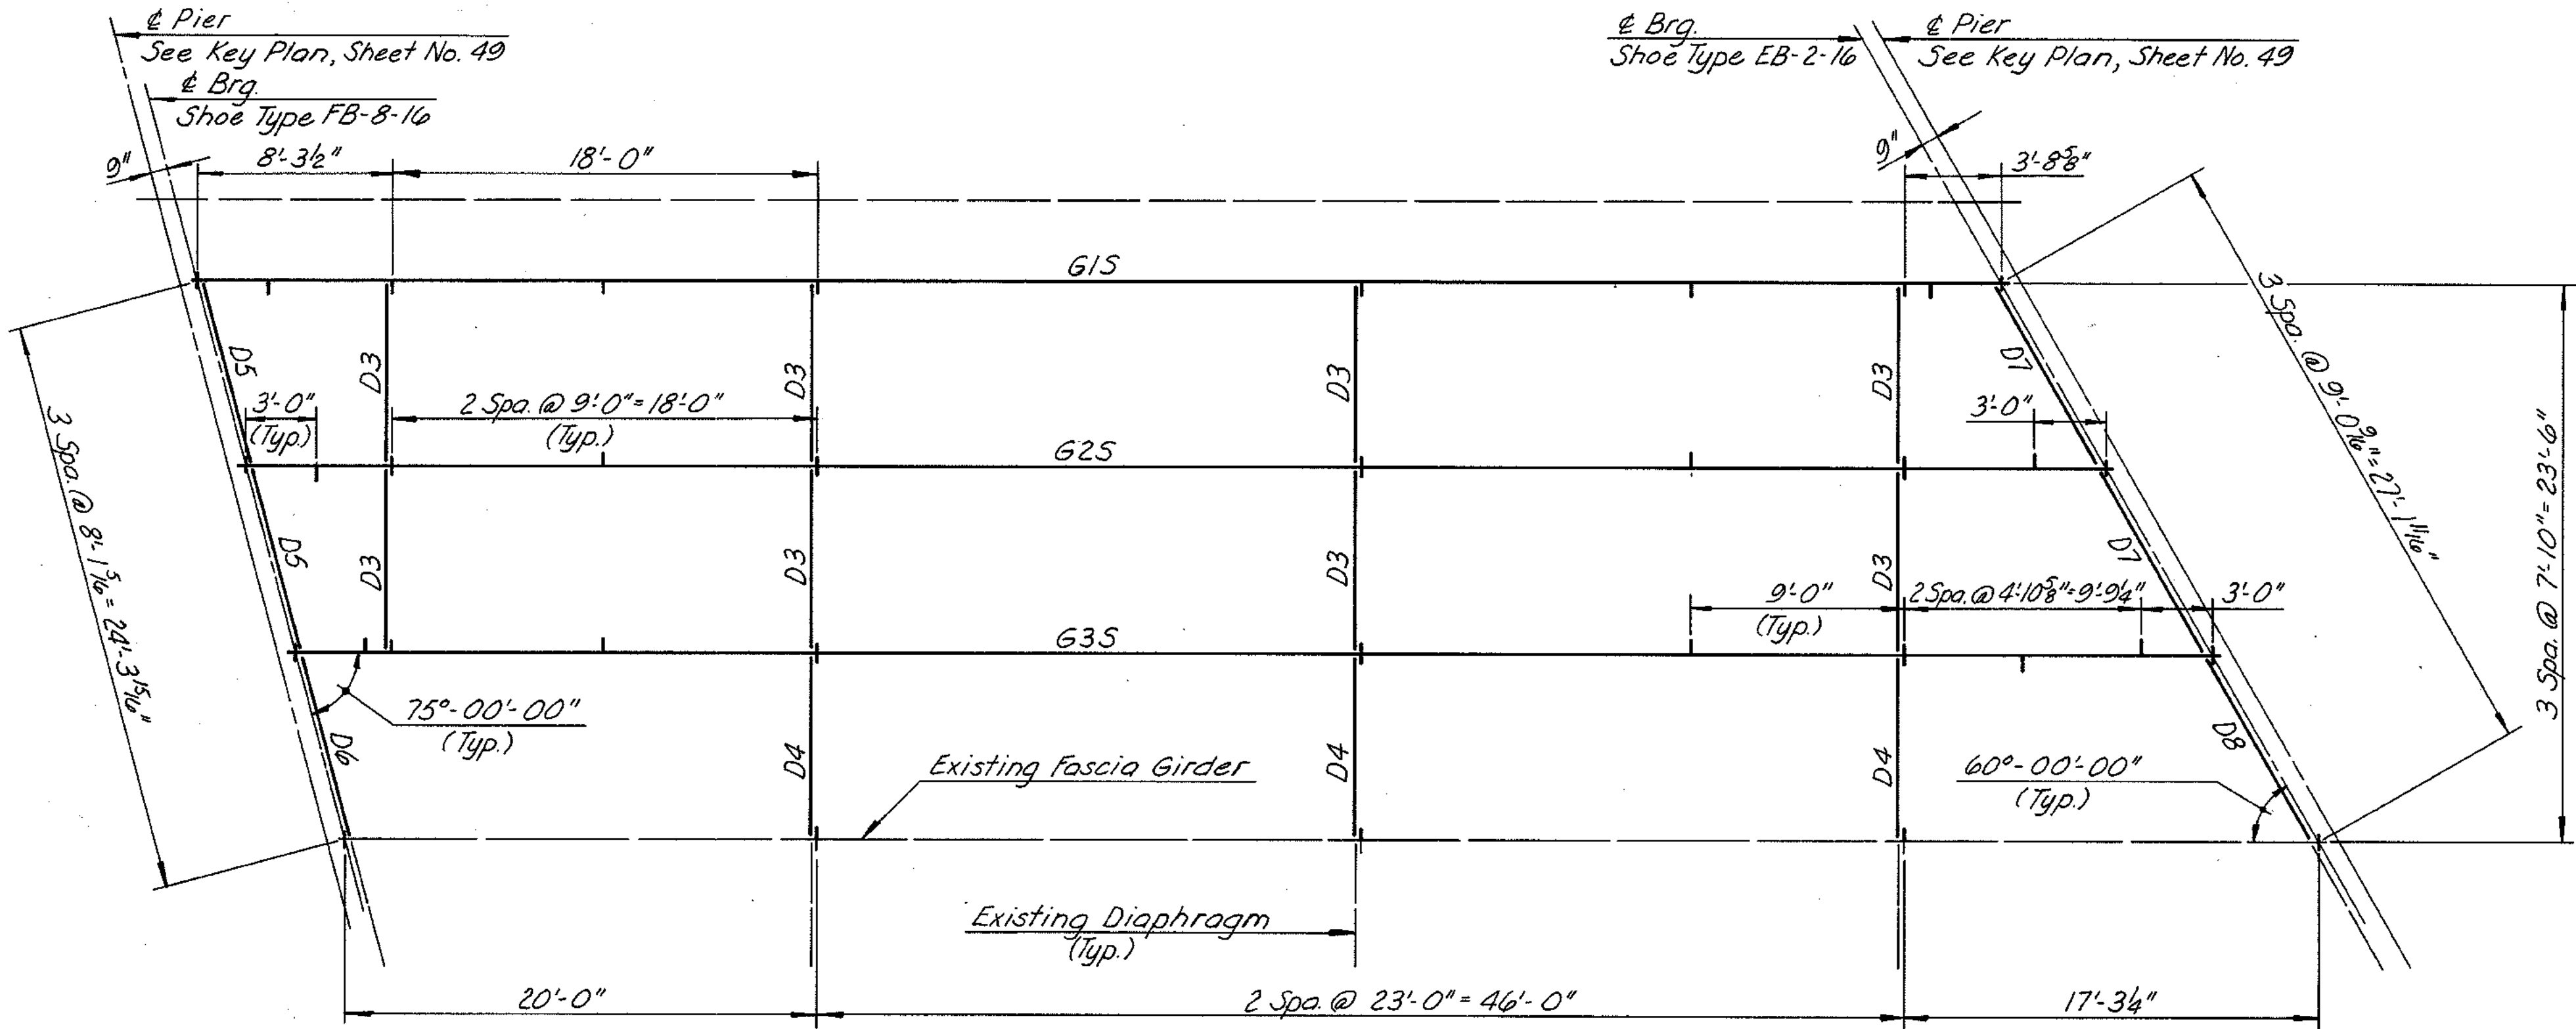

FRAMING PLAN - UNIT 14 SOUTHBOUND  
Scale: 3/16" = 1'-0"

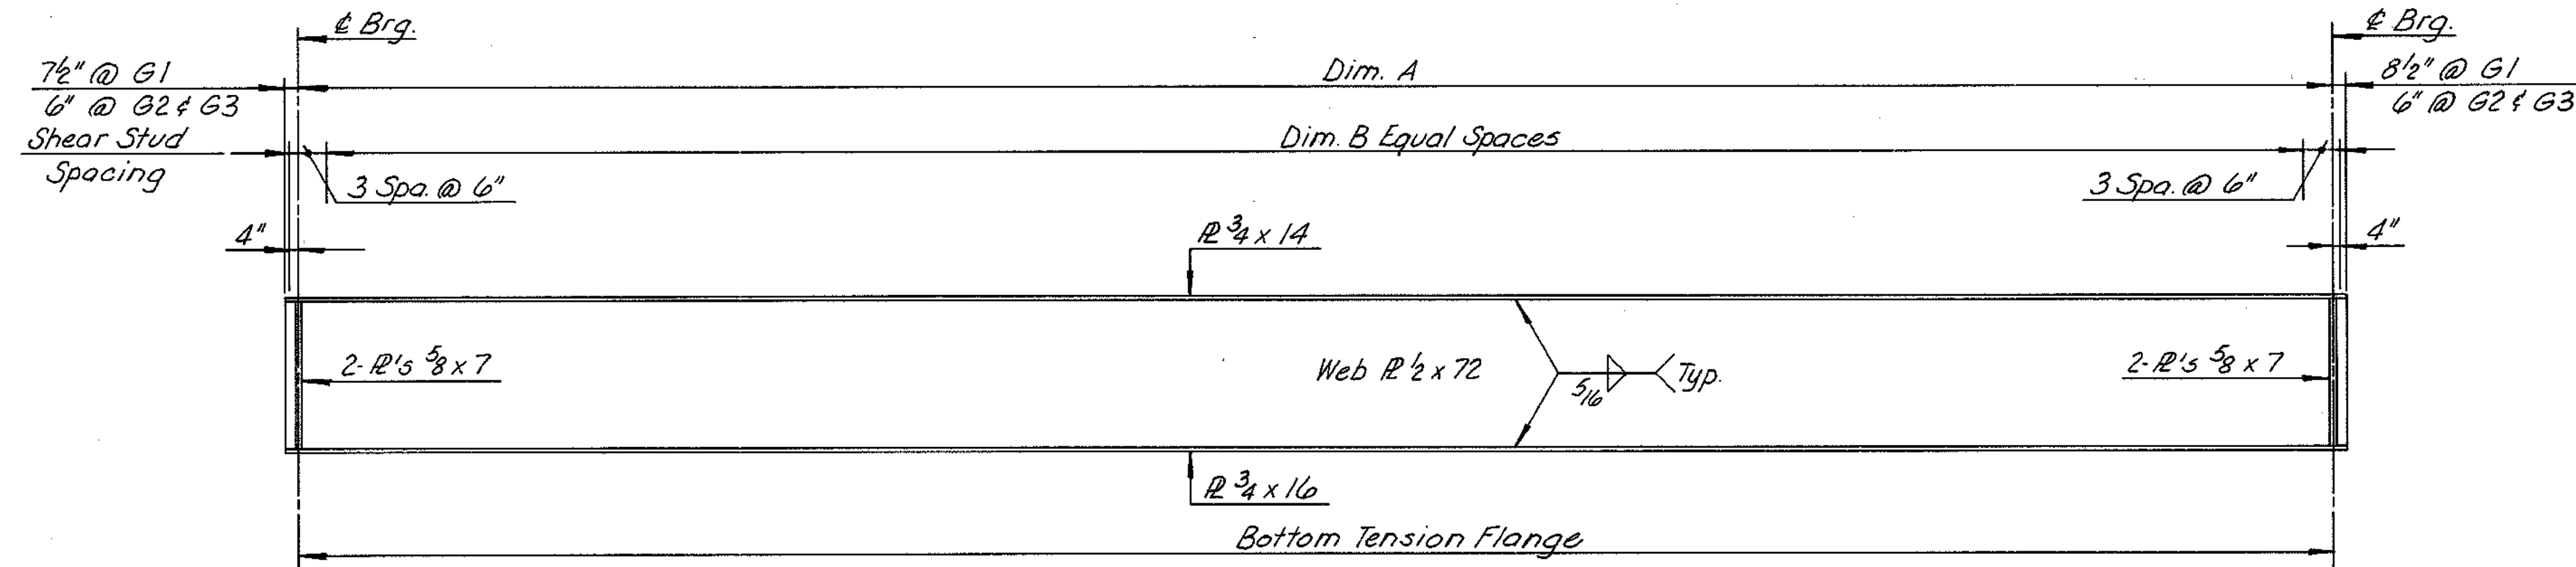

GIRDER ELEVATION - UNIT 14 SOUTHBOUND  
Scale: 3/16" = 1'-0"

GIRDER	DIM. A	DIM. B
G1	76'-0"	43
G2	78'-5 1/8"	44
G3	80'-10 1/4"	46



BY	DATE				
MADE	EUM	1-87			
CHECKED	TFP	3-87	As Built	TEM	3-89
IN CHARGE	SR				

RICHMOND METROPOLITAN AUTHORITY RICHMOND EXPRESSWAY SYSTEM	
FRAMING PLAN & GIRDER ELEVATION UNIT 14 SOUTHBOUND	
HOWARD, NEEDLES, TAMMEN & BERGENDOFF consulting engineers Alexandria, Virginia	SCALE: AS SHOWN CONTRACT NO.: C-13 SHEET NO. 36 OF 106

AS BUILT

RICHMOND EXPRESSWAY SYSTEM			
SECTION	PROJECT	SHEET NO.	TOTAL SHEETS
13	WIDENING JAMES RIVER BRIDGE	37	106

NOTE:  
For Steel Details, see Sheet No. 45.

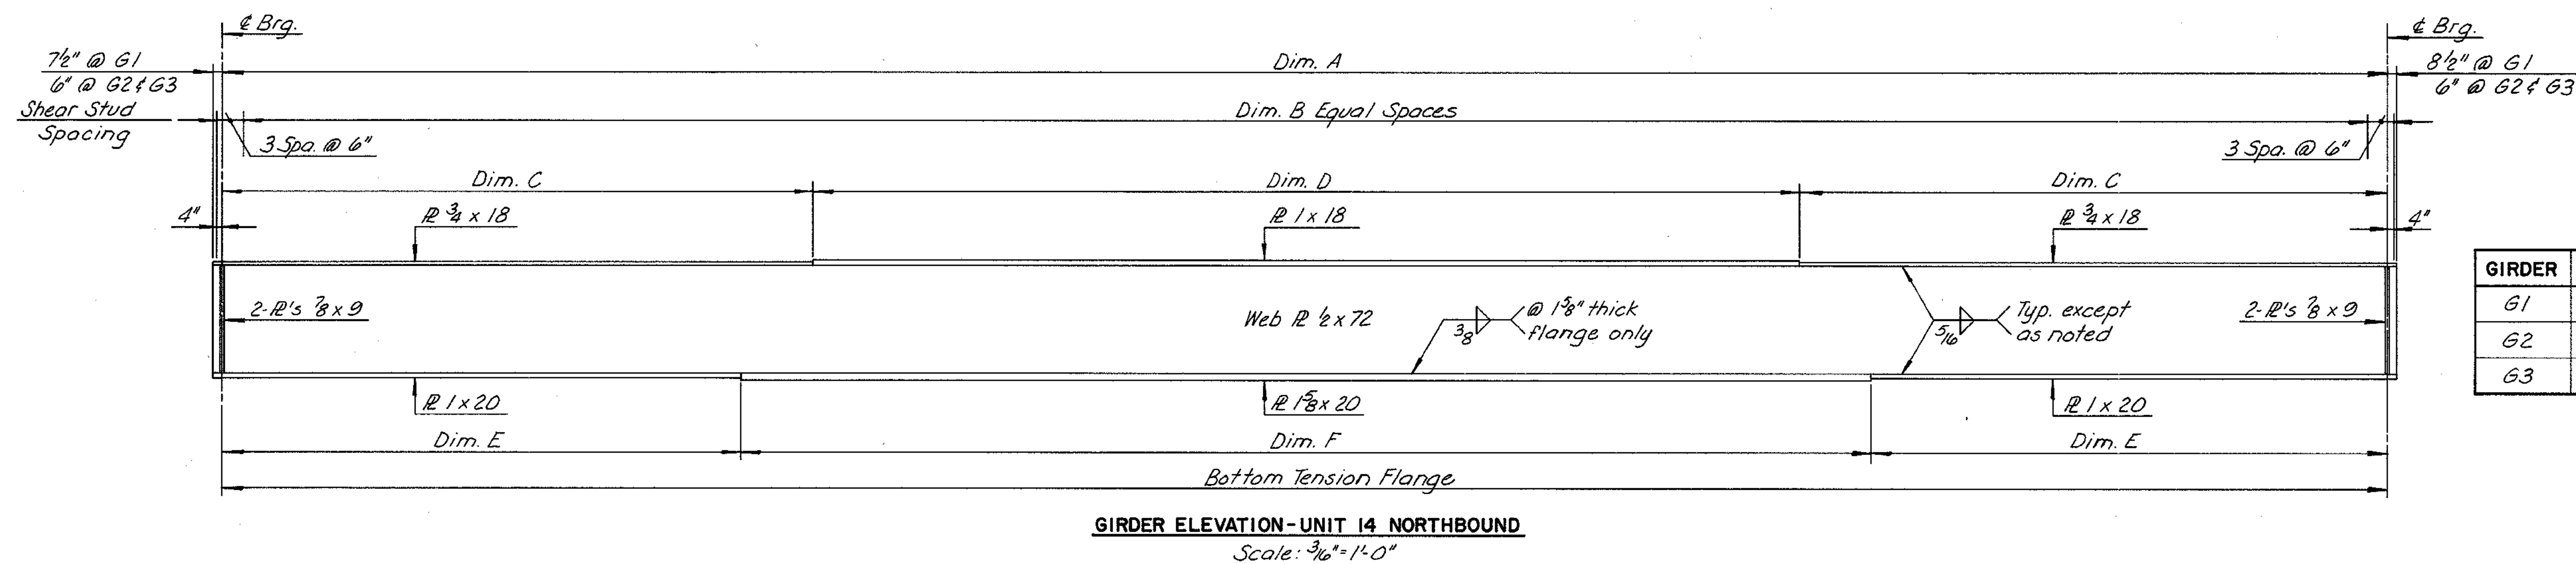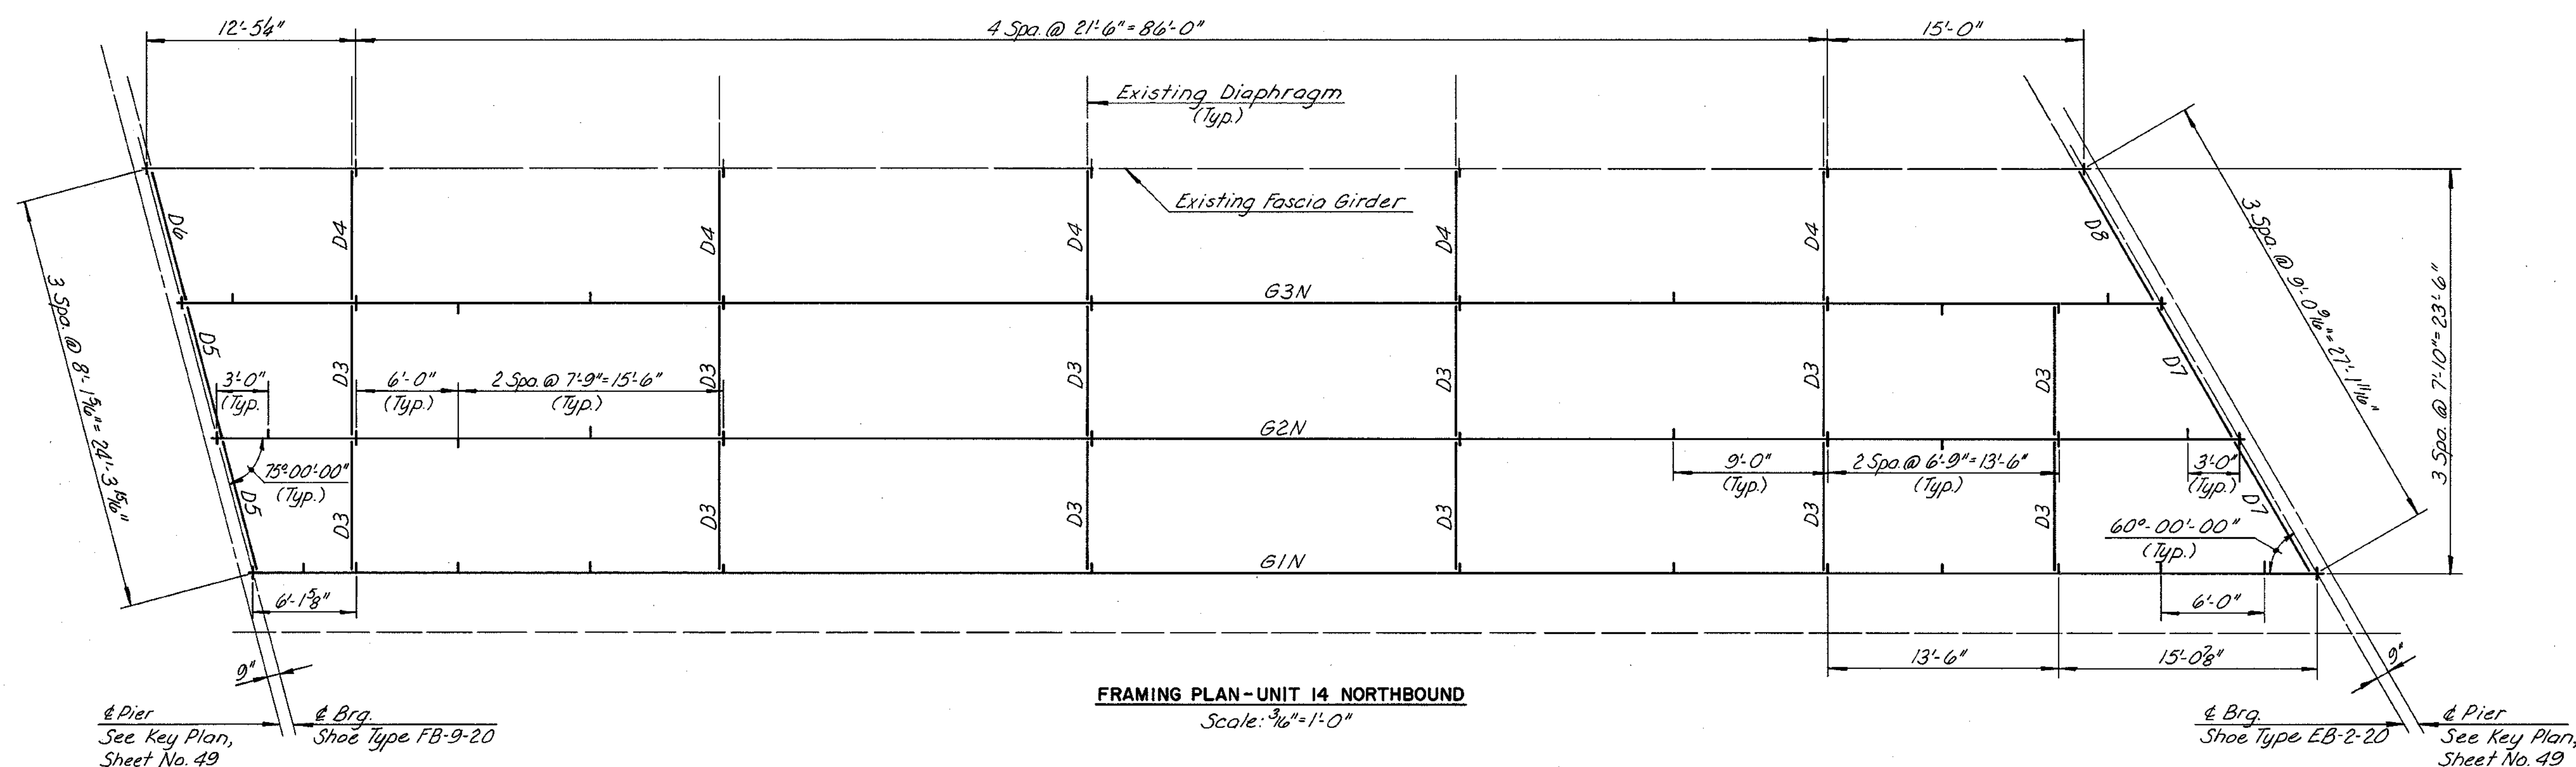


GIRDER	DIM. A	DIM. B	DIM. C	DIM. D	DIM. E	DIM. F
G1	120'-8 1/2"	60	32'-10 1/4"	55'-0"	26'-1 1/4"	68'-6"
G2	118'-3 1/2"	59	30'-10 3/4"	56'-6"	26'-7 3/4"	65'-0"
G3	115'-10 3/8"	58	31'-11 3/16"	52'-0"	24'-8 3/16"	66'-6"

BY	DATE				
MADE	EJM	1-87			
CHECKED	TFP	3-87	As Built	TEM	3-89
IN CHARGE	JR				


AS BUILT

RICHMOND METROPOLITAN AUTHORITY RICHMOND EXPRESSWAY SYSTEM	
FRAMING PLAN & GIRDER ELEVATION UNIT 14 NORTHBOUND	
HOWARD, NEEDLES, TAMMEN & BERGENDOFF consulting engineers Alexandria, Virginia	SCALE: AS SHOWN CONTRACT NO.: C-13 SHEET NO. 37 OF 106

RICHMOND EXPRESSWAY SYSTEM			
SECTION	PROJECT	SHEET NO.	TOTAL SHEETS
13	WIDENING JAMES RIVER BRIDGE	38	106

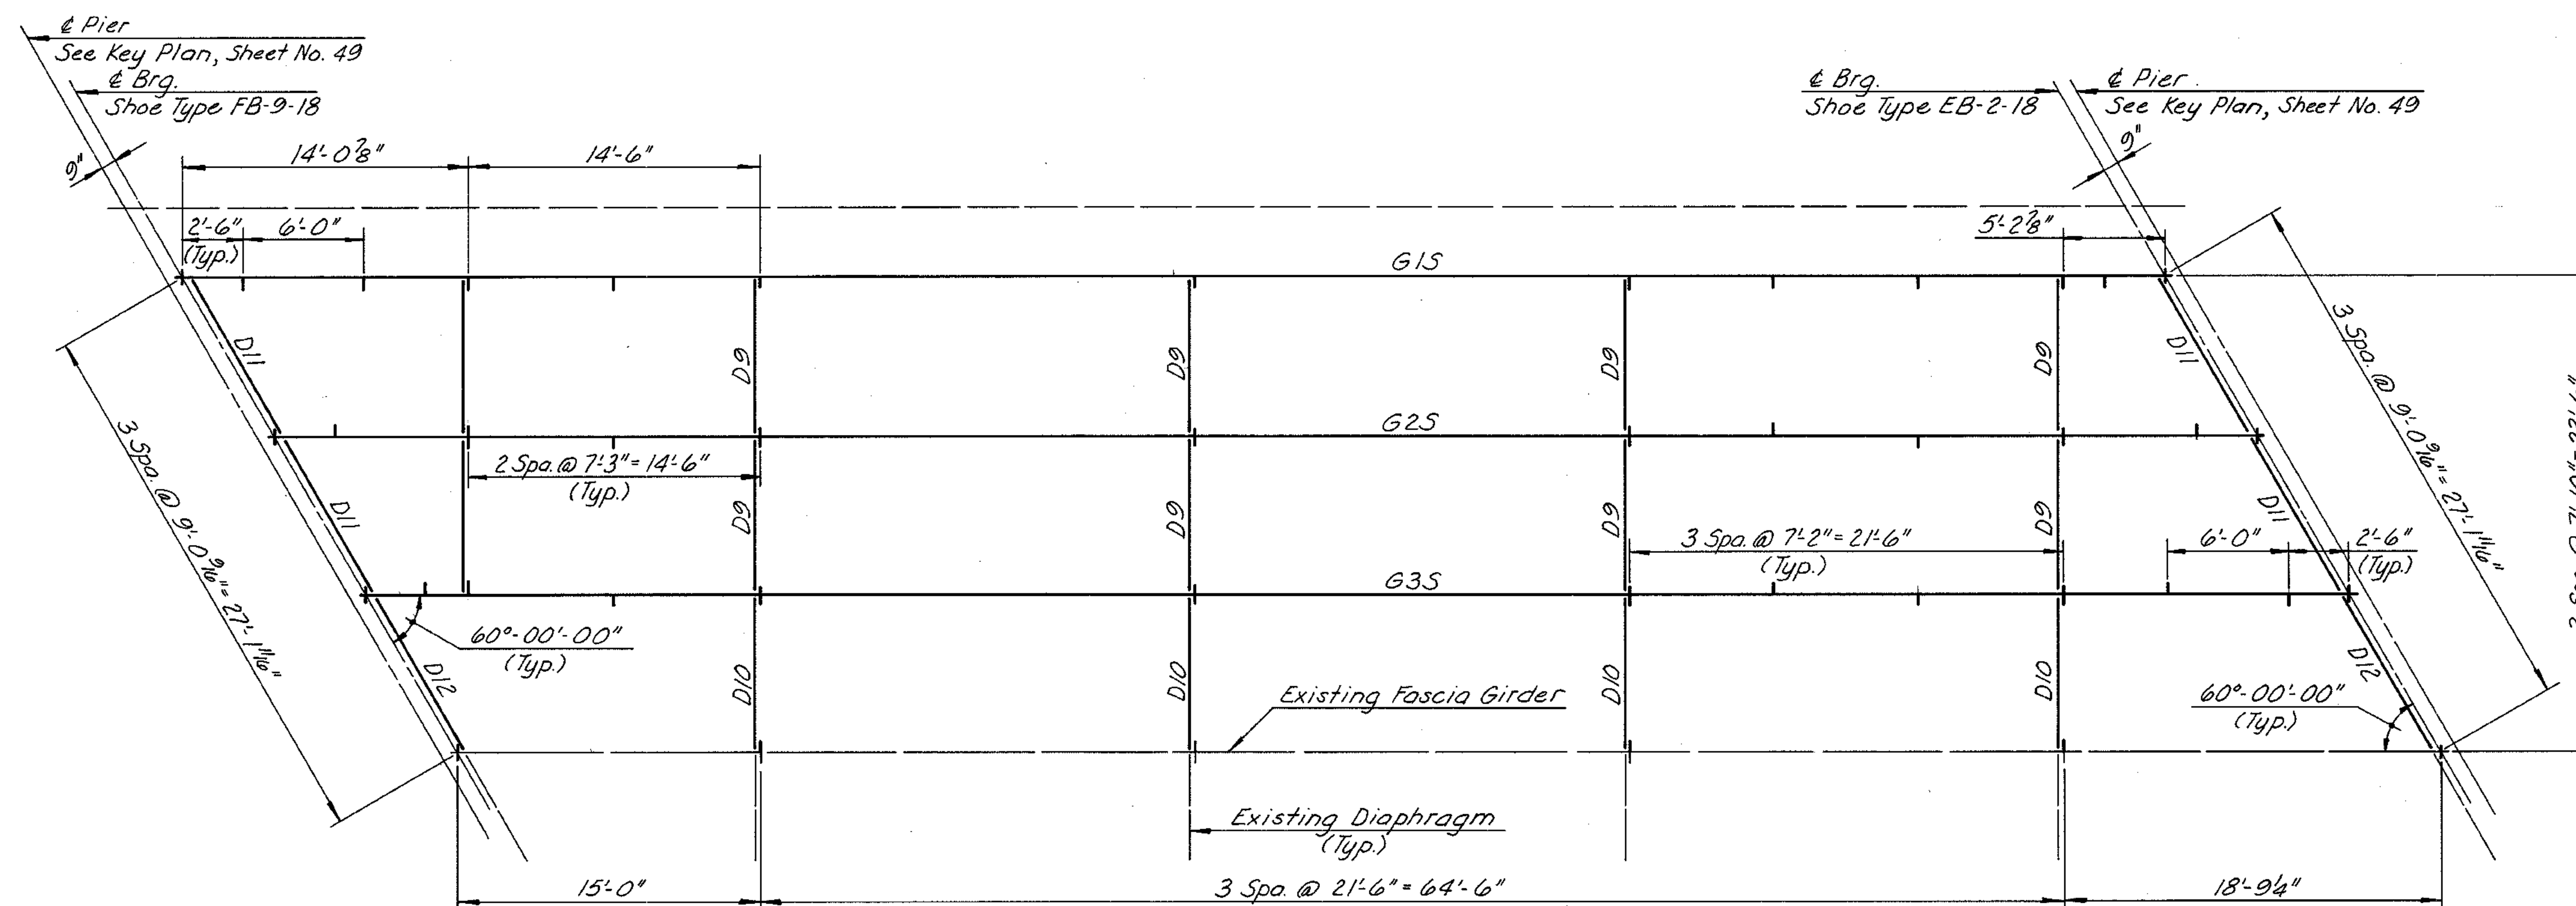


△ **FRAMING PLAN-UNIT 15 SOUTHBOUND**  
Scale:  $\frac{3}{16}'' = 1'-0''$

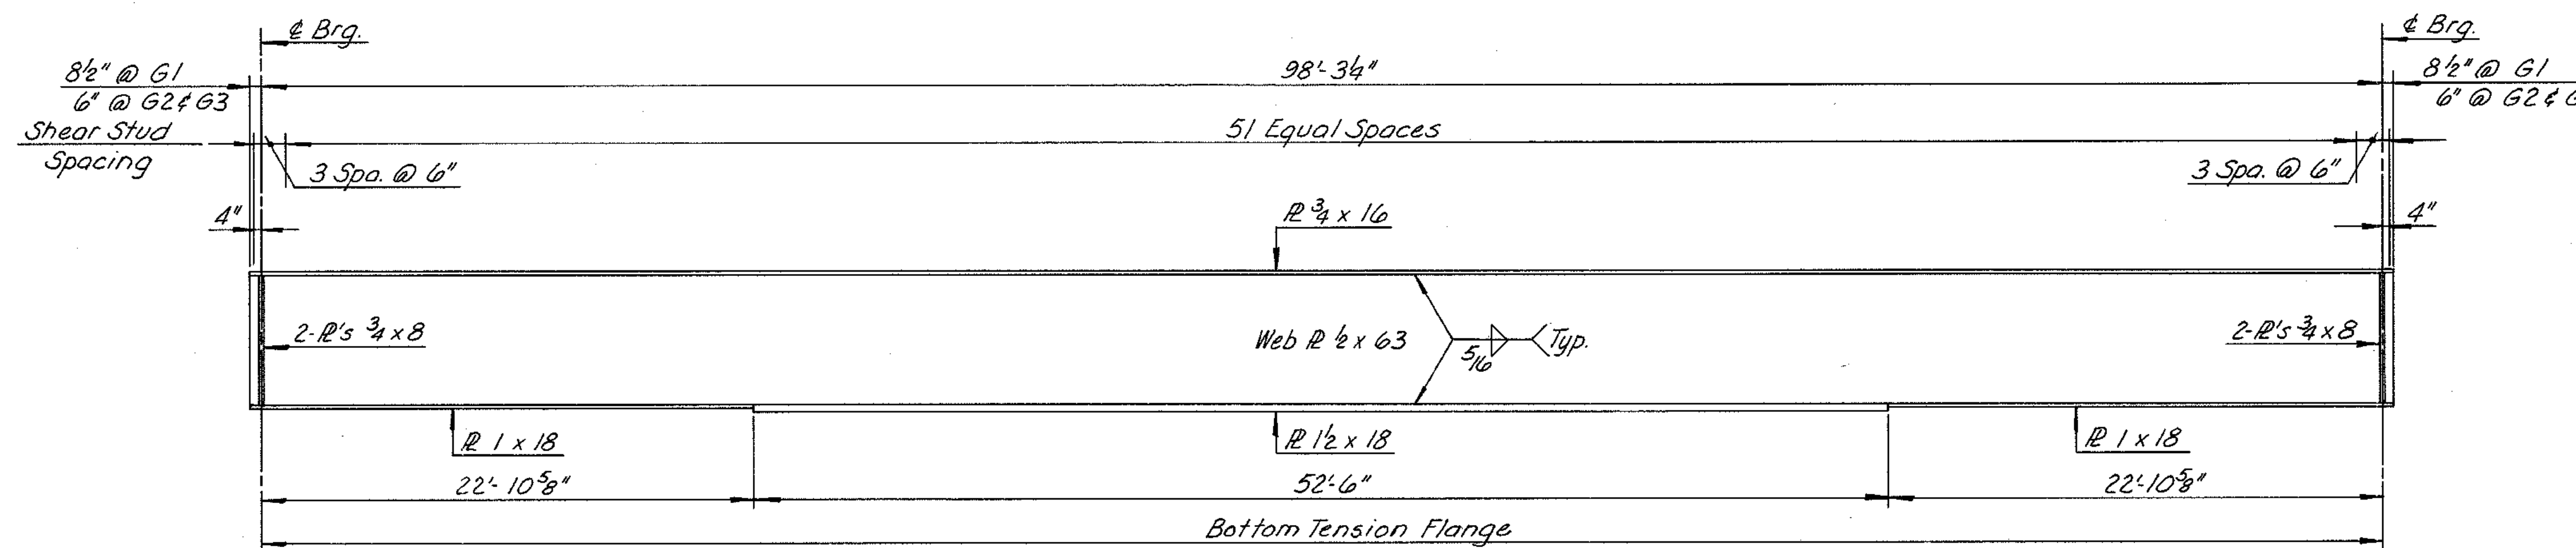


△ **GIRDER ELEVATION-UNIT 15 SOUTHBOUND**  
Scale:  $\frac{3}{16}'' = 1'-0''$

**NOTE:**  
For Section A-A, see Sheet No. 45.  
For Diaphragms 11 & 12, see Sheet No. 39.  
For Additional Steel Details, see Sheet No. 45.

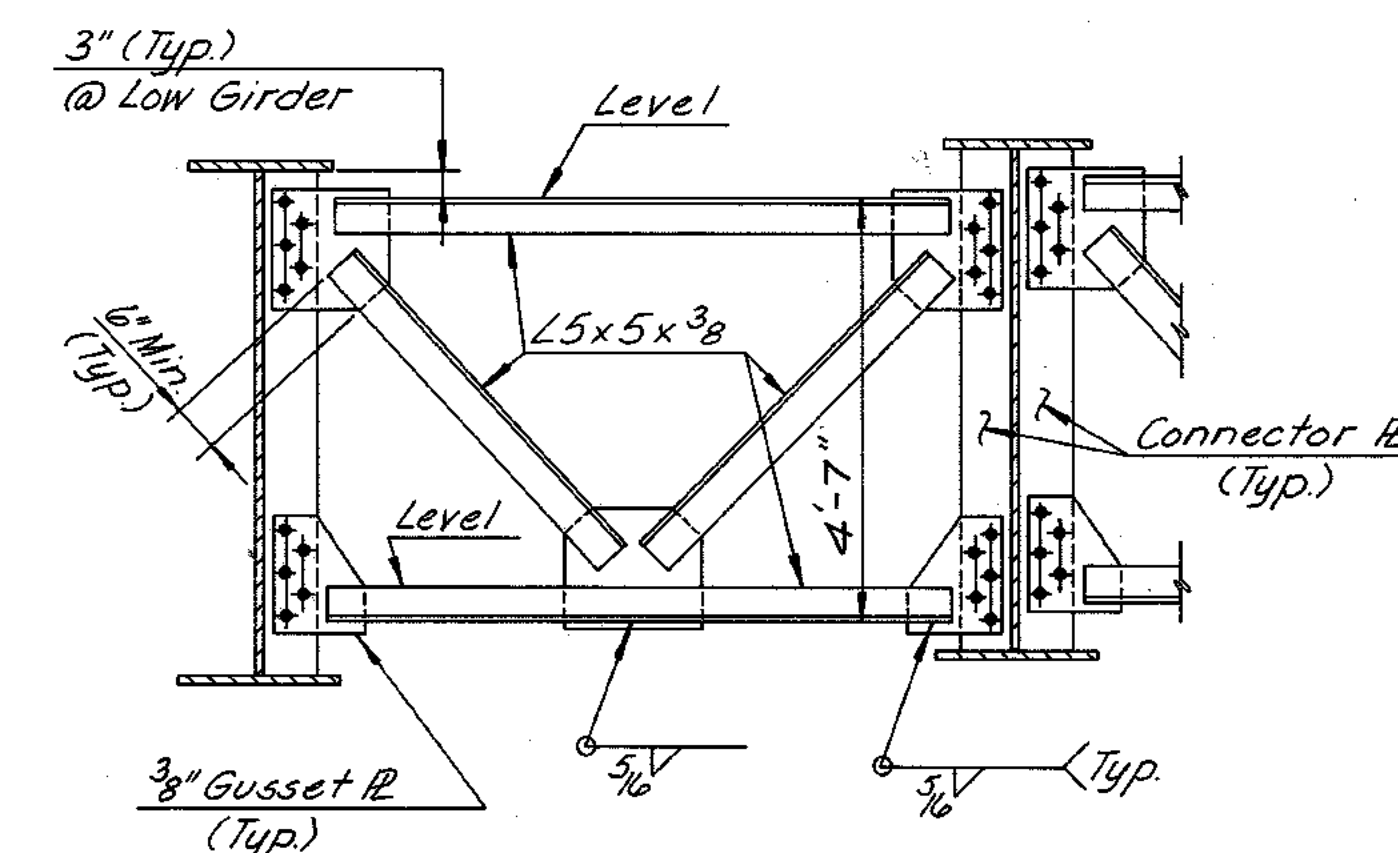

△ **INTERMEDIATE DIAPHRAGM D9**  
Scale:  $\frac{1}{2}'' = 1'-0''$

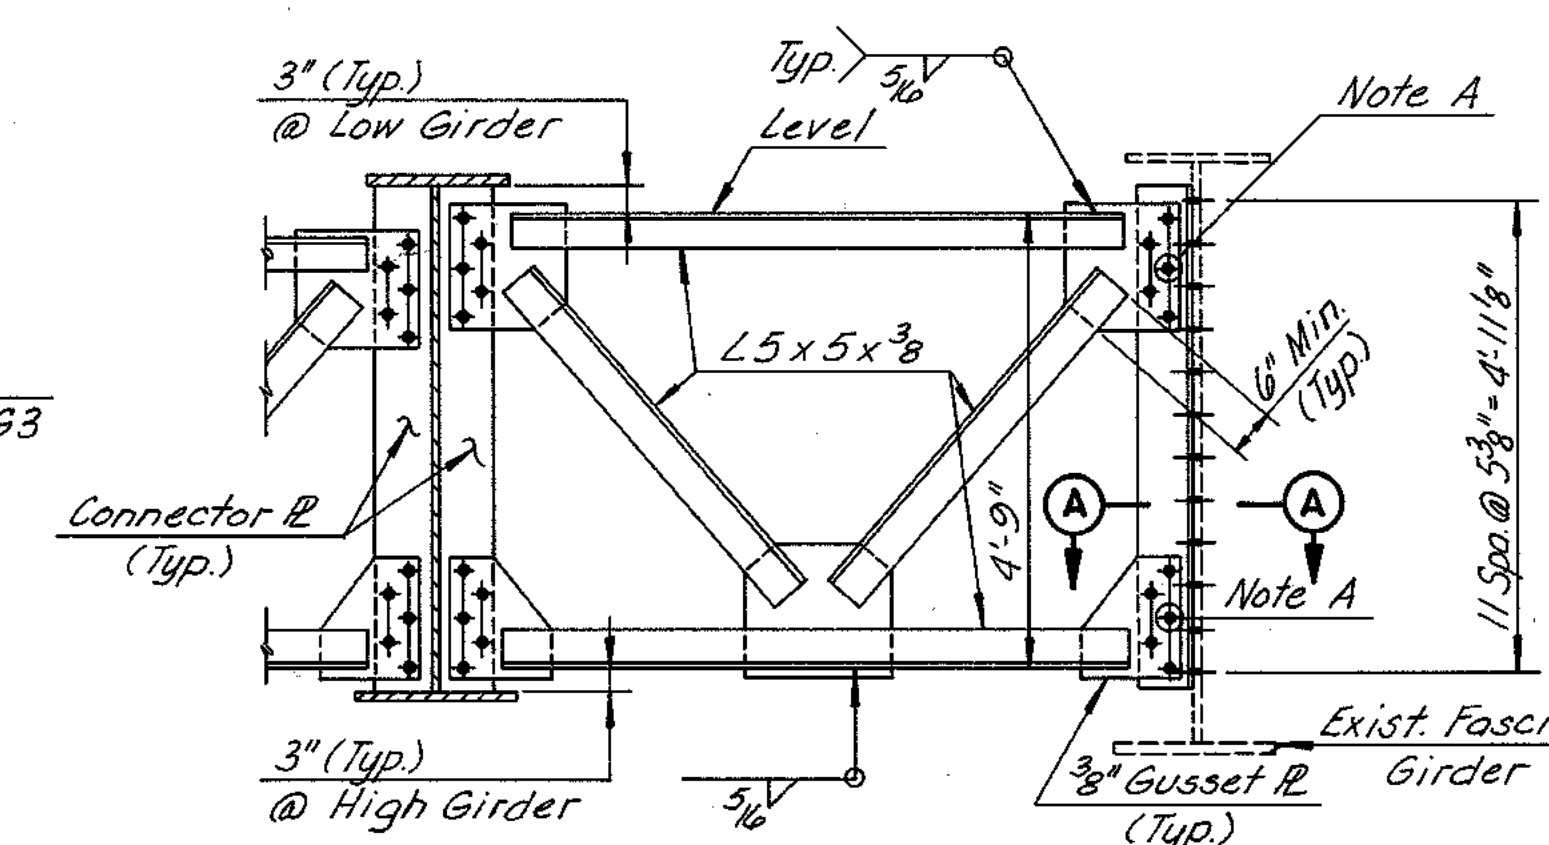


△ **INTERMEDIATE DIAPHRAGM D10**  
Scale:  $\frac{1}{2}'' = 1'-0''$

MADE	BY	DATE	NO.	REVISION	BY	DATE
EJM	1-87	As Built	TEM	3-89		
CHECKED	TFP	3-87	△	DIAPHRAGM & GIRDER REV.	EJM	5-87
IN CHARGE	SR					


AS BUILT

RICHMOND METROPOLITAN AUTHORITY RICHMOND EXPRESSWAY SYSTEM	
FRAMING PLAN & GIRDER ELEVATION UNIT 15 SOUTHBOUND	
HOWARD, NEEDLES, TAMMEN & BERGENDOFF consulting engineers Alexandria, Virginia	SCALE: AS SHOWN CONTRACT NO.: C-13 SHEET NO. 38 OF 106

RICHMOND EXPRESSWAY SYSTEM			
SECTION	PROJECT	SHEET NO.	TOTAL SHEETS
13	WIDENING JAMES RIVER BRIDGE	39	106

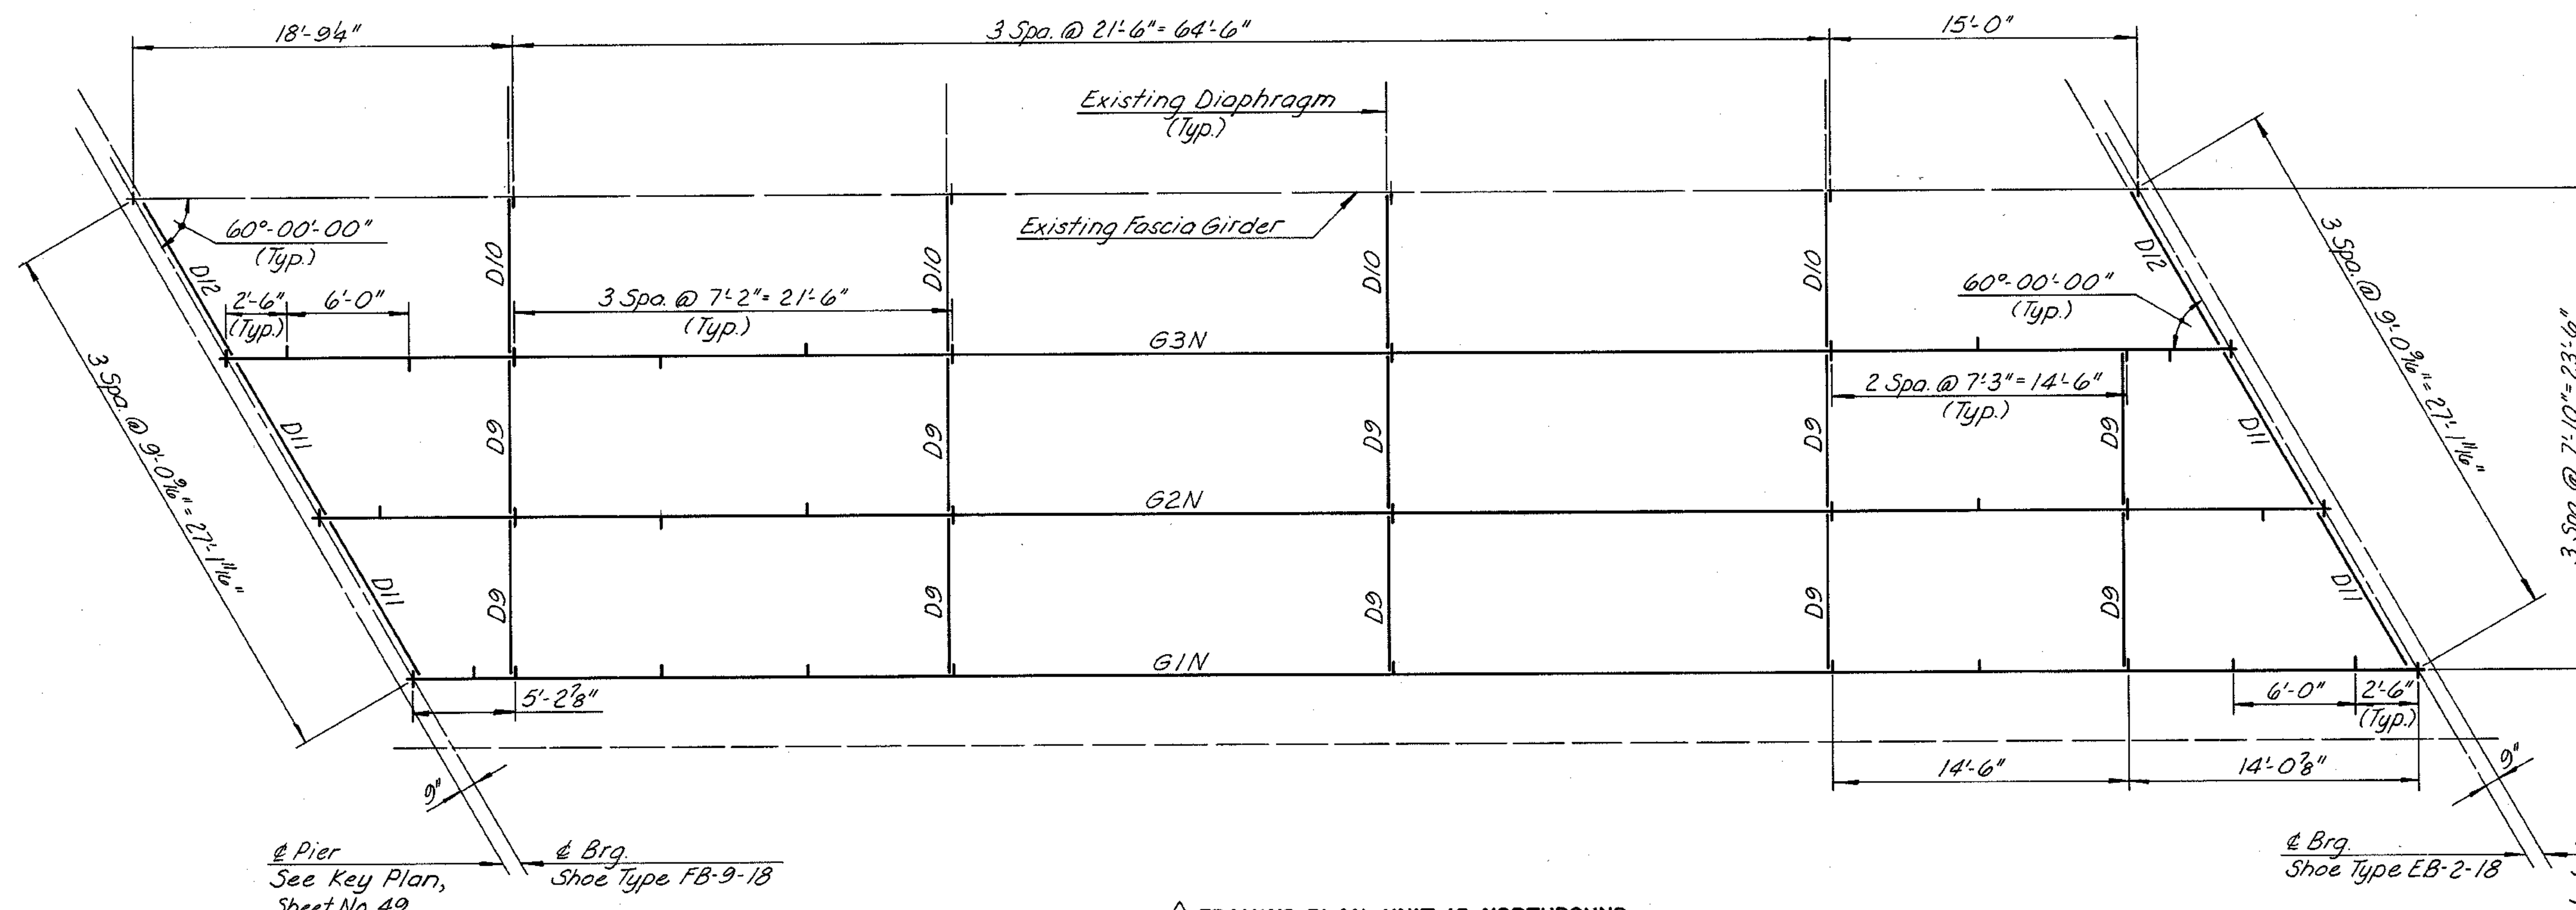


△ FRAMING PLAN-UNIT 15 NORTHBOUND  
Scale: 3/16" = 1'-0"

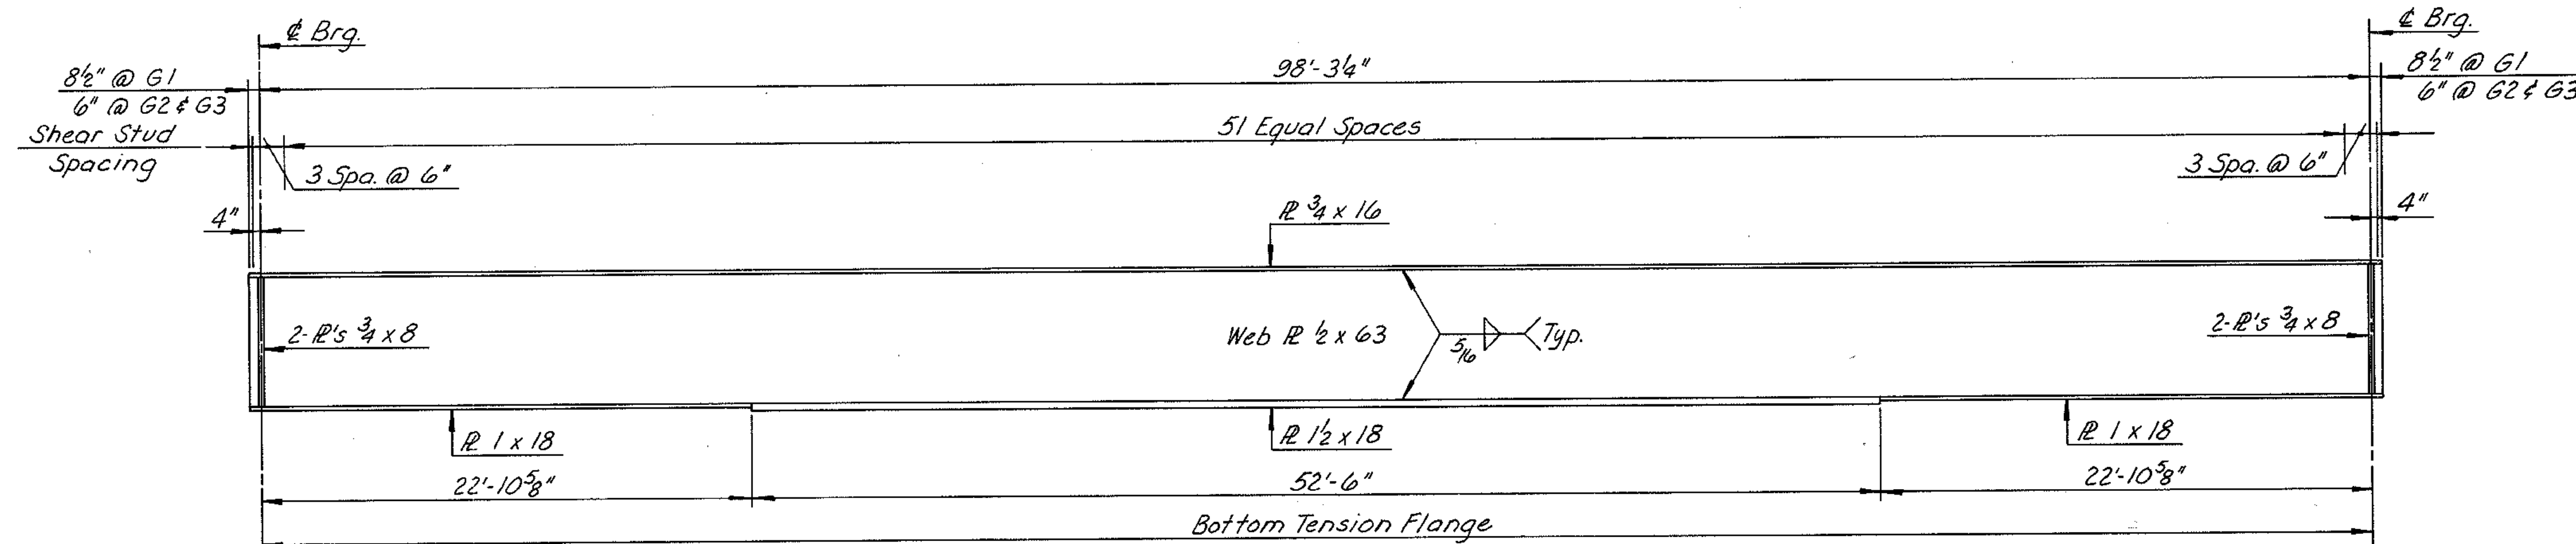


△ GIRDER ELEVATION-UNIT 15 NORTHBOUND  
Scale: 3/16" = 1'-0"

NOTE:  
For Steel Details, see Sheet No. 45.

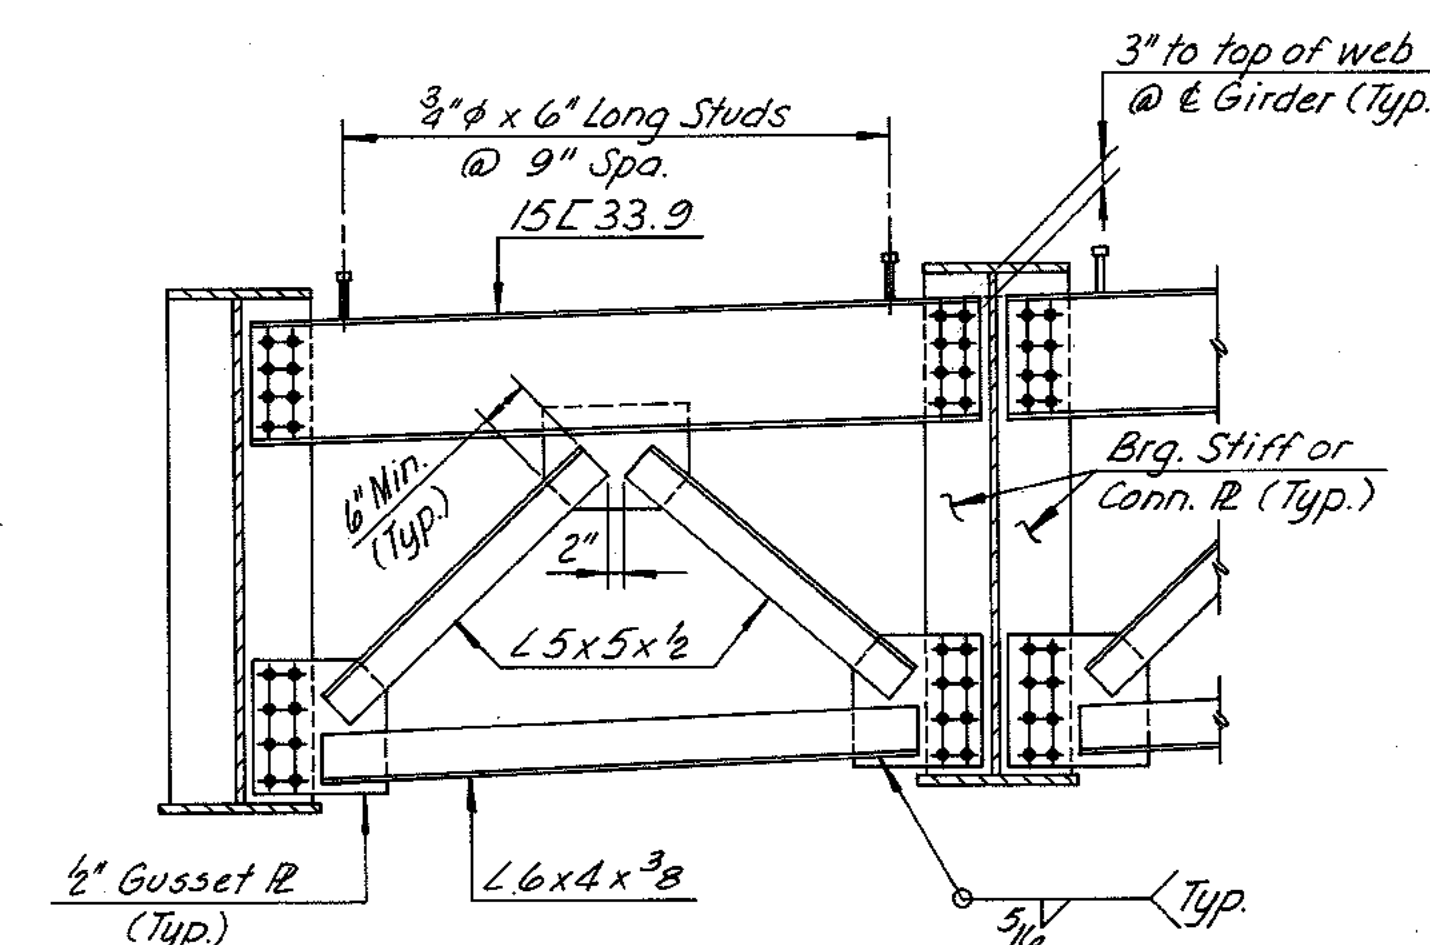

△ END DIAPHRAGM D11  
Scale: 1/2" = 1'-0"

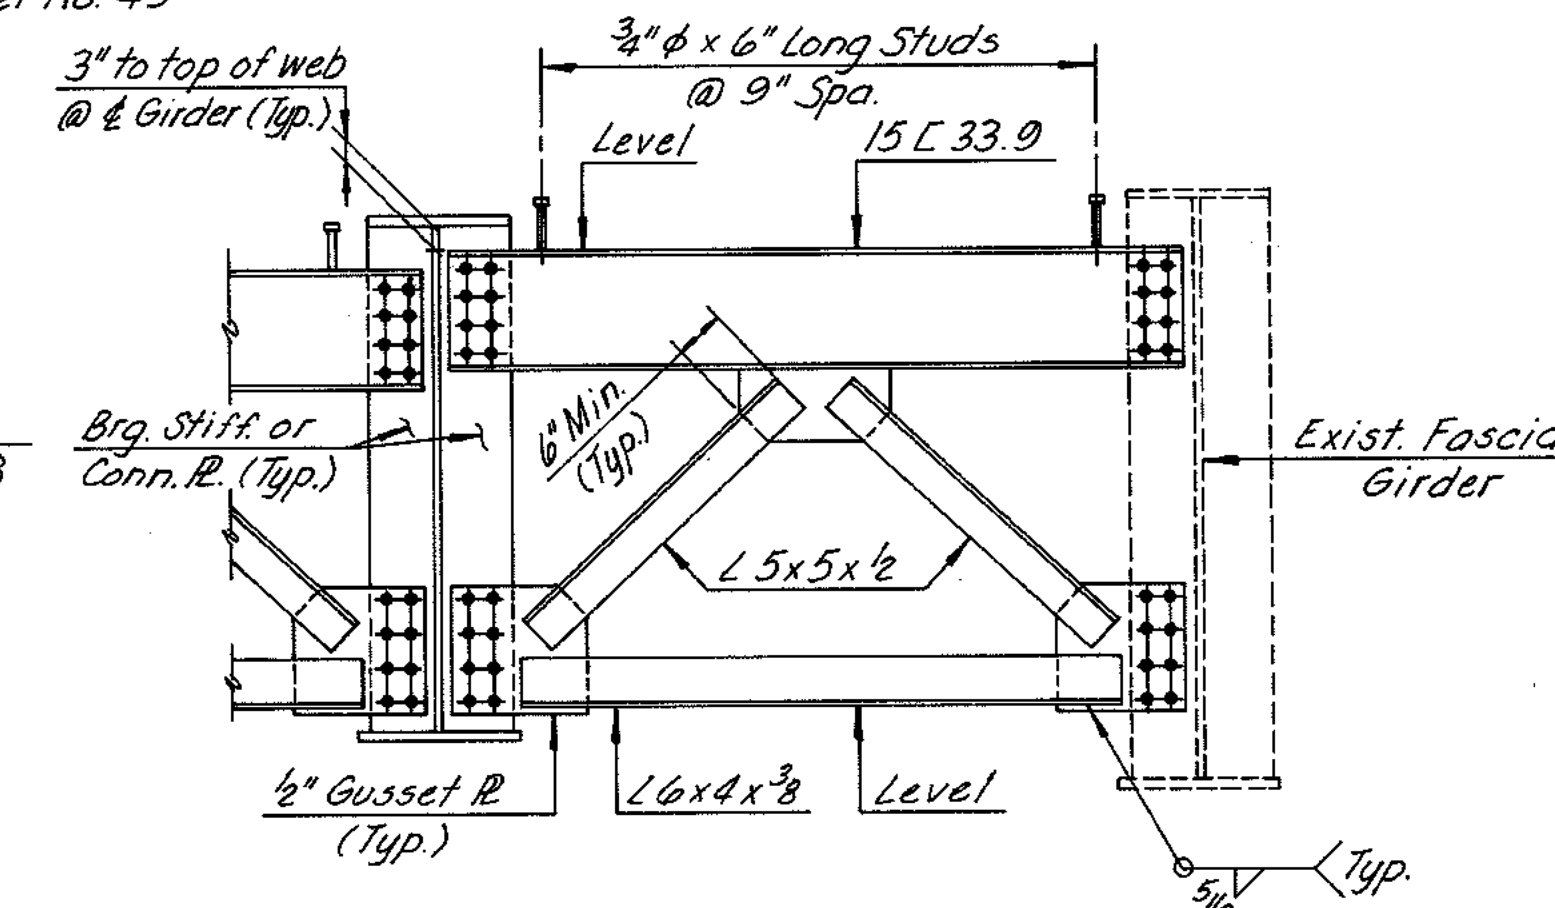

△ END DIAPHRAGM D12  
Scale: 1/2" = 1'-0"

BY	DATE	NO.	REVISION	BY	DATE
MADE	EJM 1-87				
CHECKED	TFP 3-87	△	Rev. Diaph. & Girder	EJM	5-87
IN CHARGE	SR				

AS BUILT

RICHMOND METROPOLITAN AUTHORITY  
RICHMOND EXPRESSWAY SYSTEM

FRAMING PLAN & GIRDER ELEVATION  
UNIT 15 NORTHBOUND


HOWARD, NEEDLES, TAMMEN & BERGENDOFF  
consulting engineers  
Alexandria, Virginia

SCALE: AS SHOWN  
CONTRACT NO.: C-13  
SHEET NO. 39 OF 106




RICHMOND EXPRESSWAY SYSTEM			
SECTION	PROJECT	SHEET NO.	TOTAL SHEETS
13	WIDENING JAMES RIVER BRIDGE	40	106

NOTE:  
For Steel Details, see Sheet No. 45.

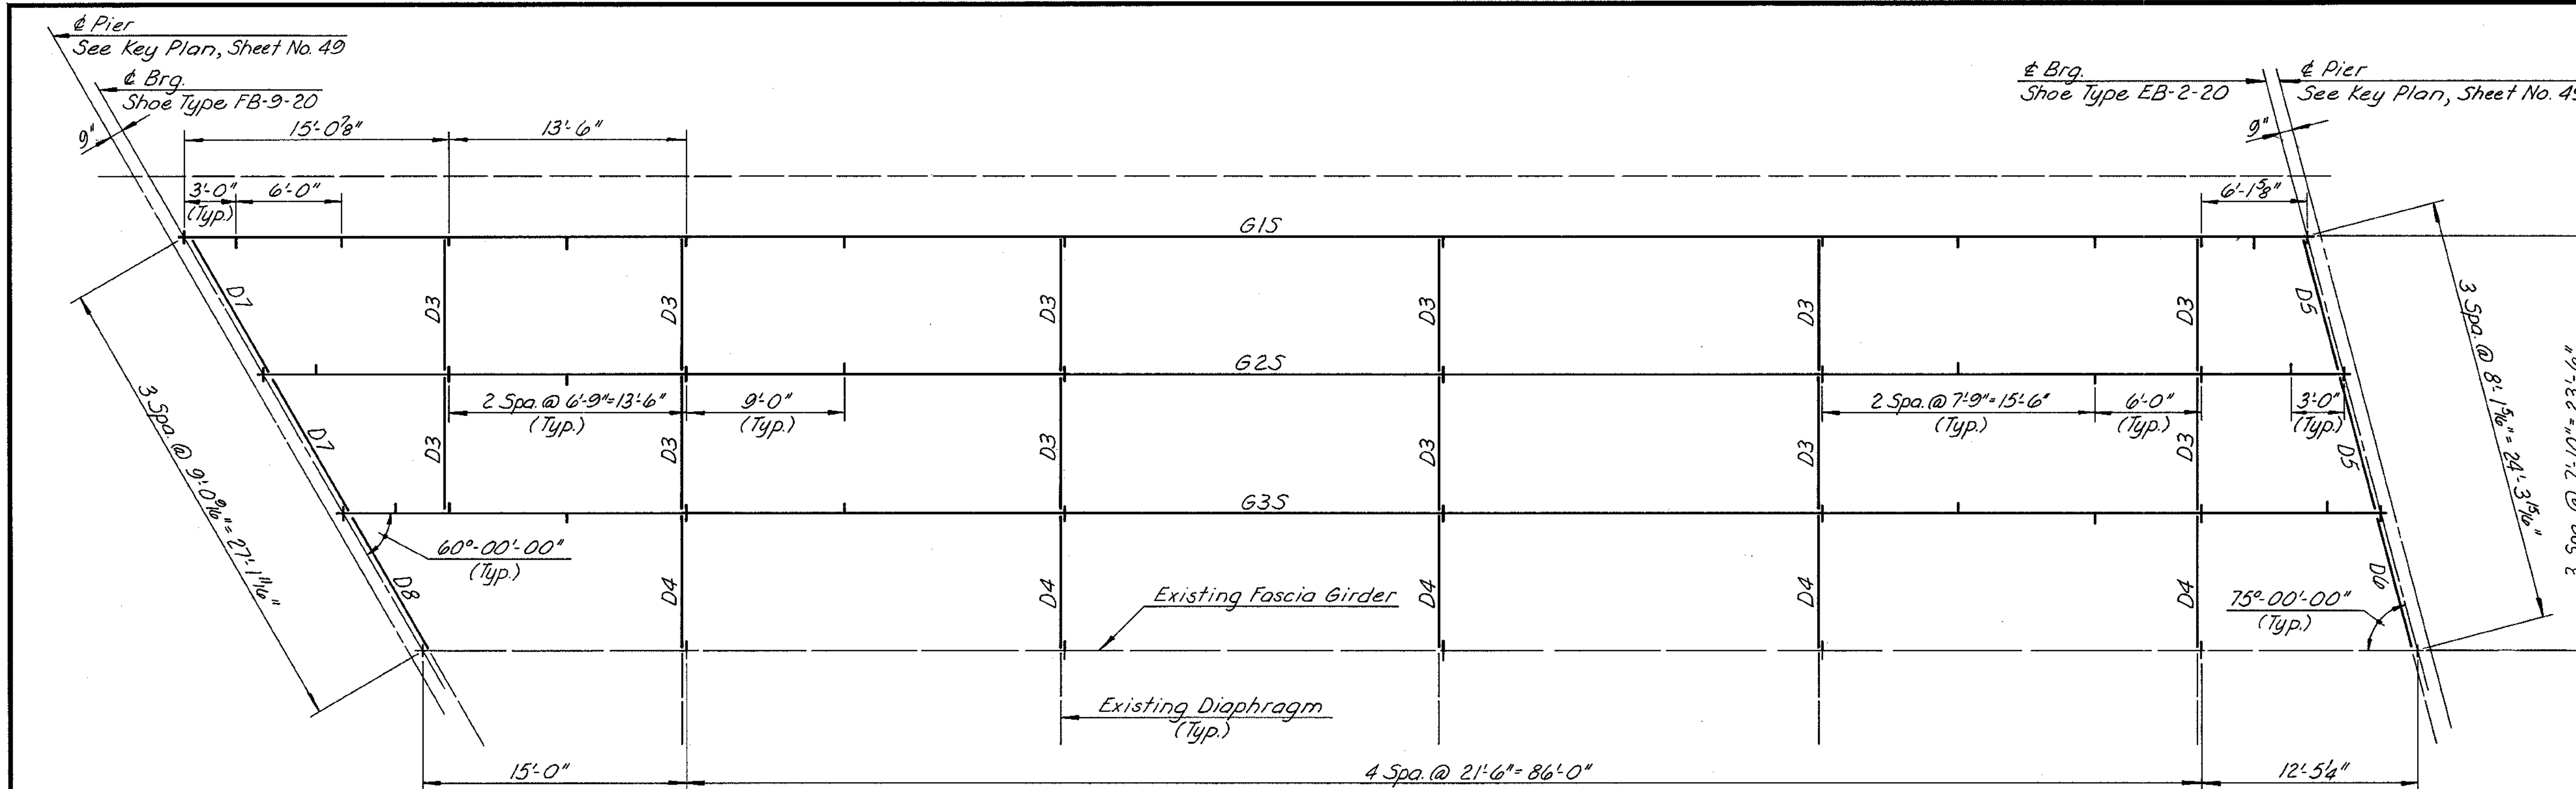

FRAMING PLAN - UNIT 16 SOUTHBOUND  
Scale: 3/16" = 1'-0"

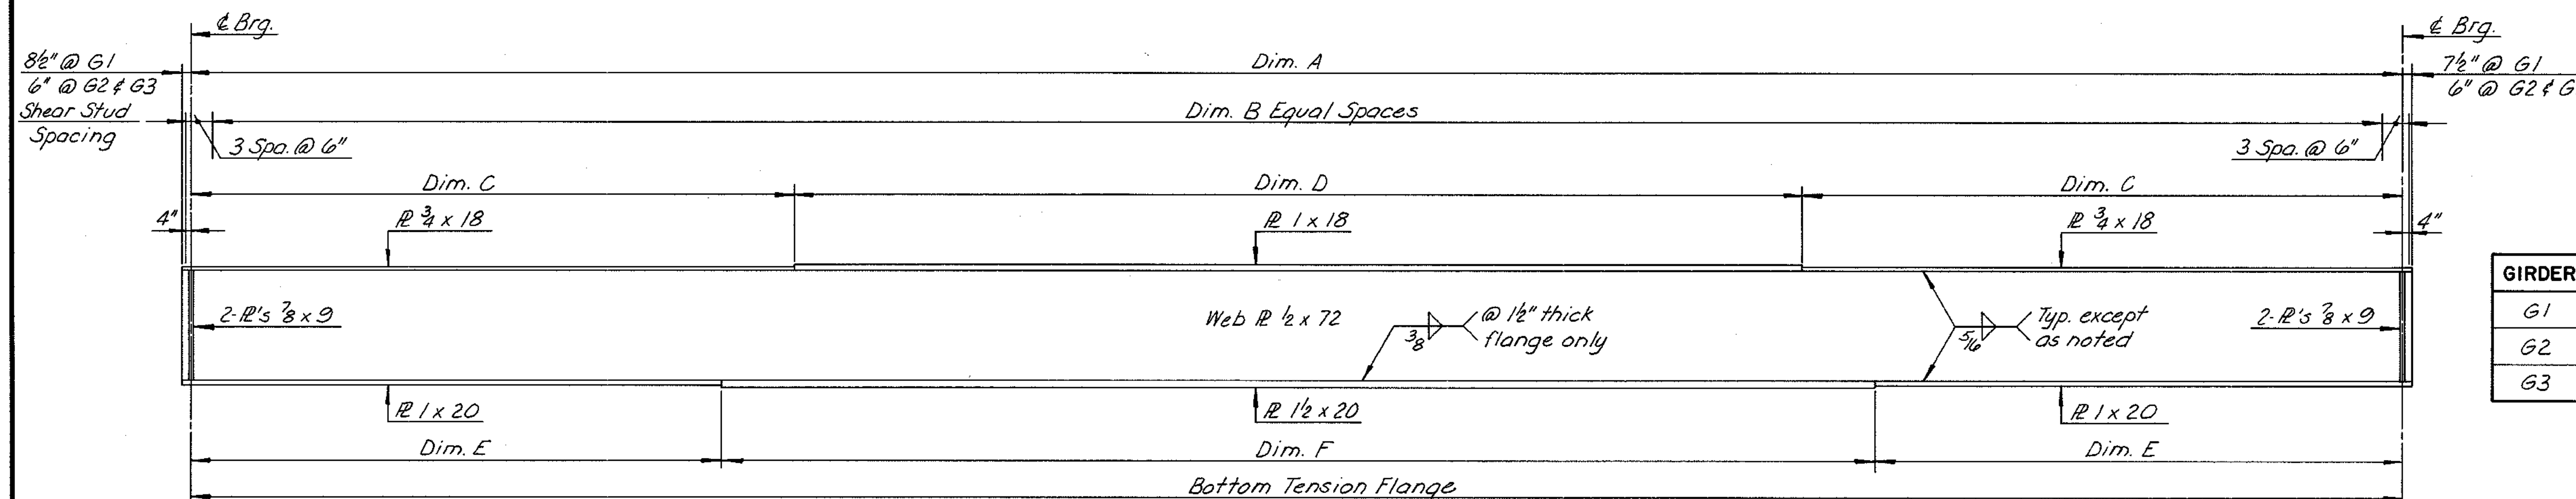

GIRDER ELEVATION - UNIT 16 SOUTHBOUND  
Scale: 3/16" = 1'-0"

GIRDER	DIM. A	DIM. B	DIM. C	DIM. D	DIM. E	DIM. F
G1	120'-8 1/2"	60	32'-10 1/4"	55'-0"	26'-1 1/4"	68'-6"
G2	118'-3 1/2"	59	30'-10 3/4"	54'-6"	26'-7 3/4"	65'-0"
G3	115'-10 3/8"	58	31'-11 3/8"	52'-0"	24'-8 3/8"	66'-6"



BY	DATE				
MADE	EUM	1-87			
CHECKED	TFP	3-87	As Built	TEM	3-89
IN CHARGE	SR		NO.	REVISION	BY DATE

AS BUILT

RICHMOND METROPOLITAN AUTHORITY RICHMOND EXPRESSWAY SYSTEM	
FRAMING PLAN & GIRDER ELEVATION UNIT 16 SOUTHBOUND	
HOWARD, NEEDLES, TAMMEN & BERGENDOFF consulting engineers Alexandria, Virginia	SCALE: AS SHOWN CONTRACT NO.: C-13 SHEET NO. 40 OF 106

RICHMOND EXPRESSWAY SYSTEM			
SECTION	PROJECT	SHEET NO.	TOTAL SHEETS
13	WIDENING JAMES RIVER BRIDGE	41	106

NOTE:  
For Steel Details, see Sheet No. 45.

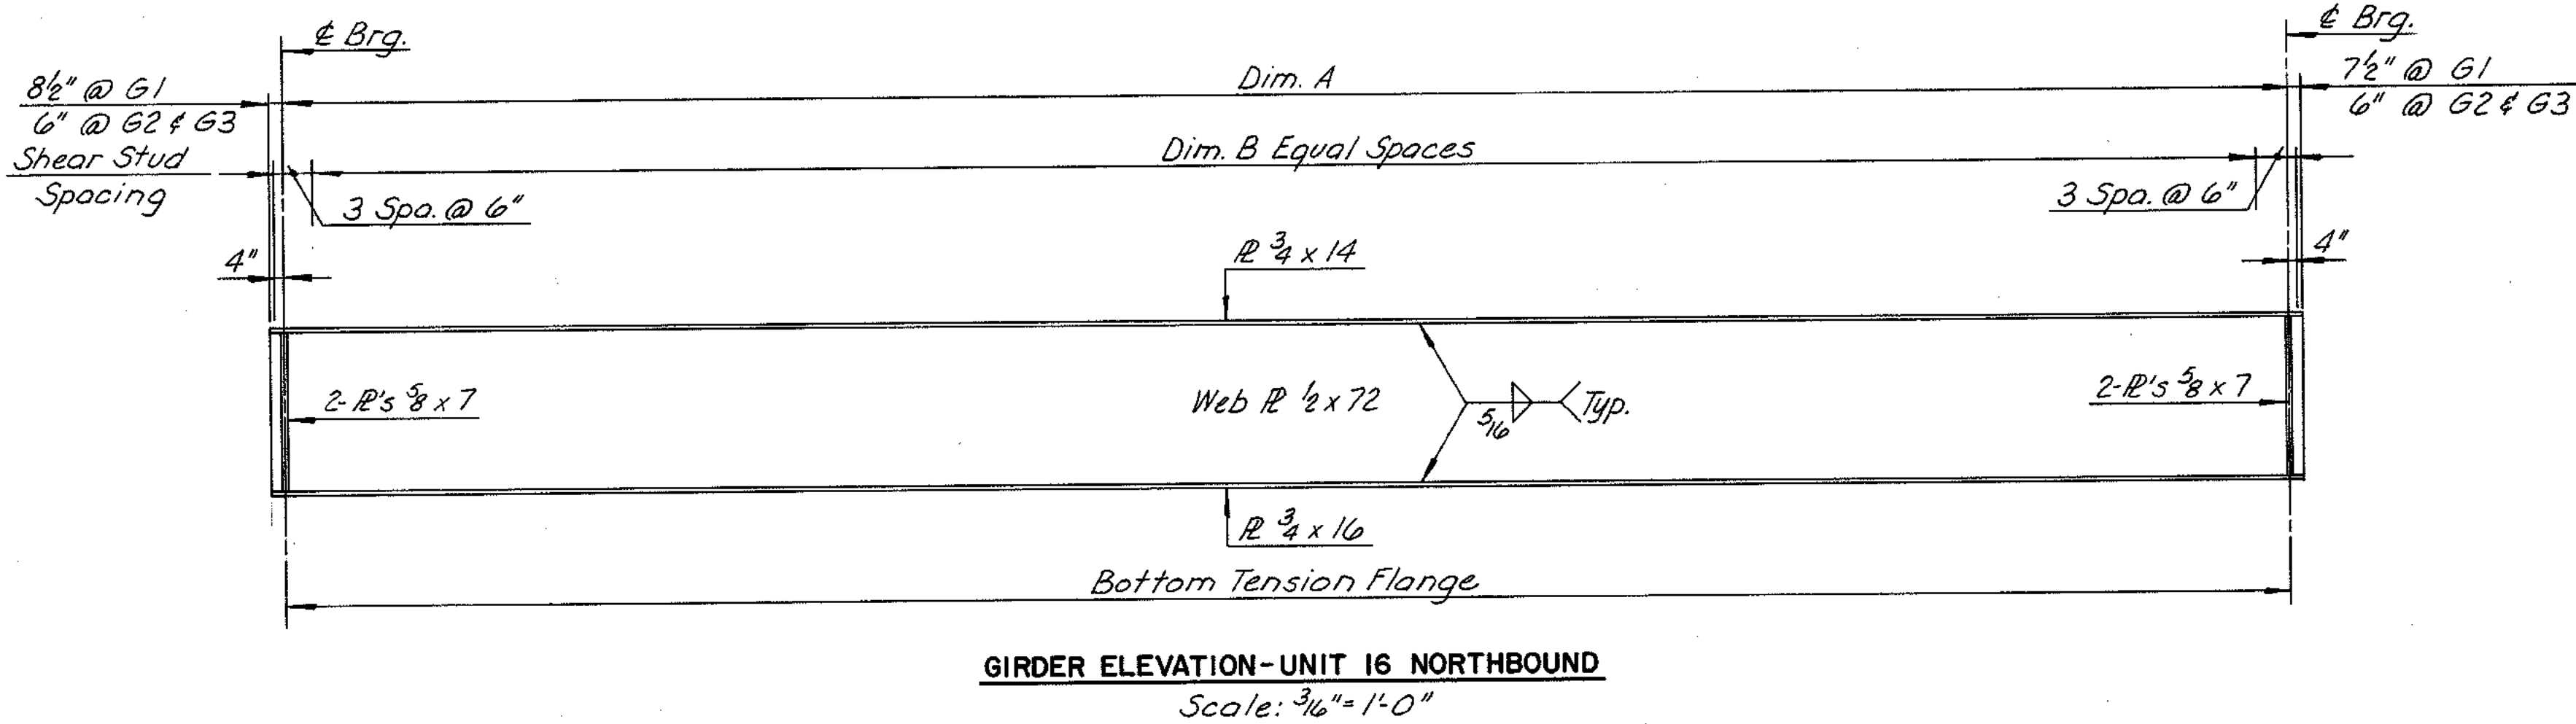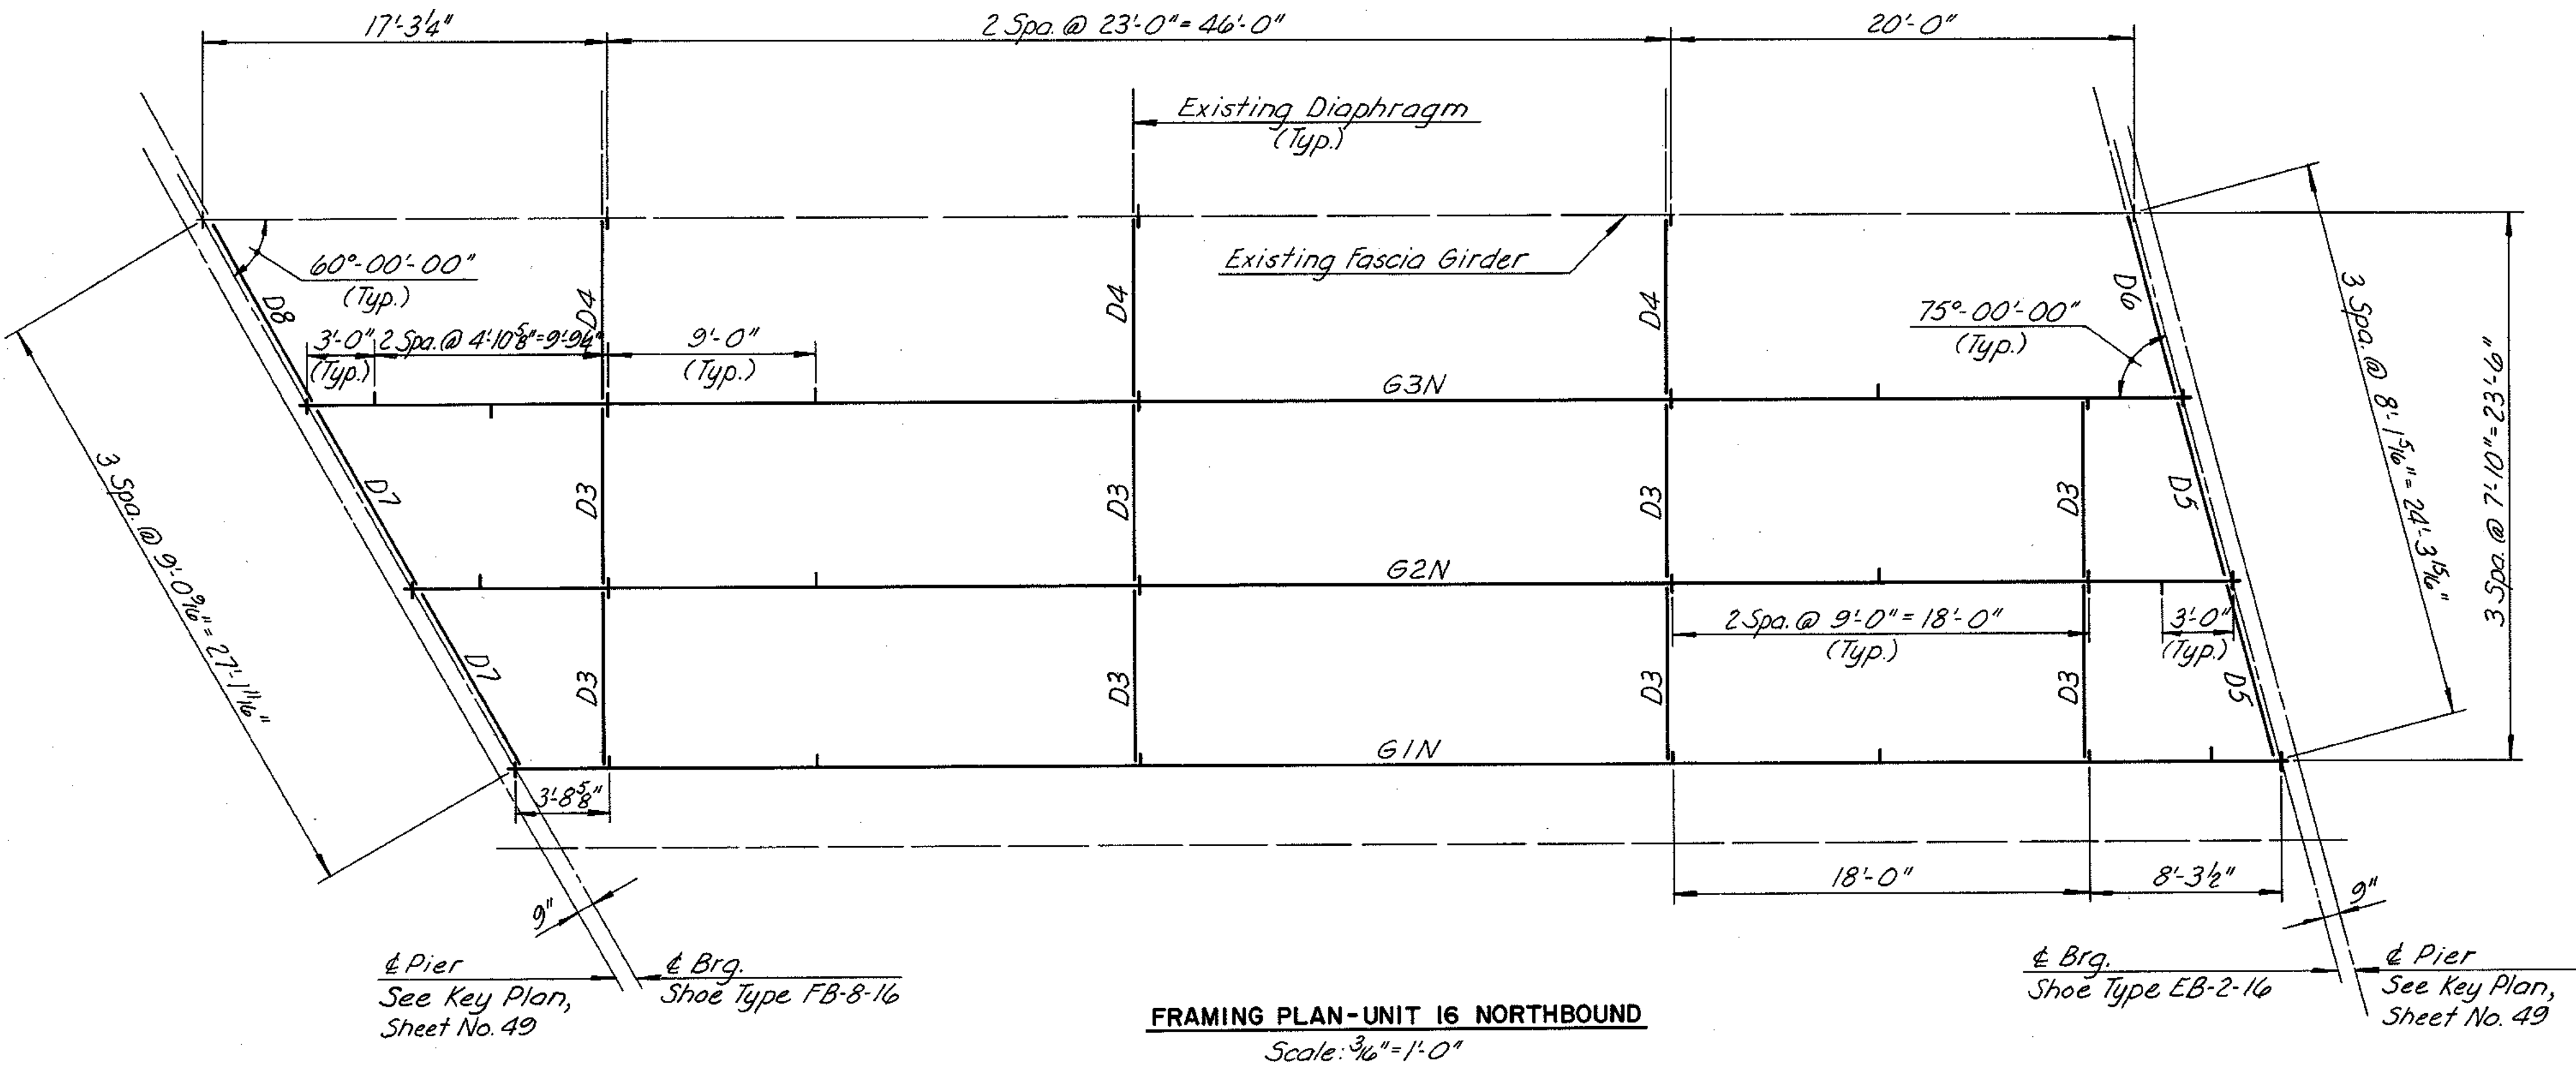

GIRDER	DIM. A	DIM. B
G1	76'-0"	43
G2	78'-5 1/8"	44
G3	80'-10 1/4"	46

BY	DATE	NO.	REVISION	BY	DATE
MADE	EJM 1-87				
CHECKED	TFP 3-87		As Built	TEM 3-89	
IN CHARGE	SR				

RICHMOND METROPOLITAN AUTHORITY  
RICHMOND EXPRESSWAY SYSTEM

FRAMING PLAN & GIRDER ELEVATION  
UNIT 16 NORTHBOUND


HOWARD, NEEDLES, TAMMEN & BERGENDOFF  
consulting engineers  
Alexandria, Virginia

SCALE: AS SHOWN  
CONTRACT NO: C-13  
SHEET NO. 41 OF 106


AS BUILT

RICHMOND EXPRESSWAY SYSTEM			
SECTION	PROJECT	SHEET NO.	TOTAL SHEETS
13	WIDENING JAMES RIVER BRIDGE	42	106

NOTE:  
For Steel Details, see Sheet No. 45.

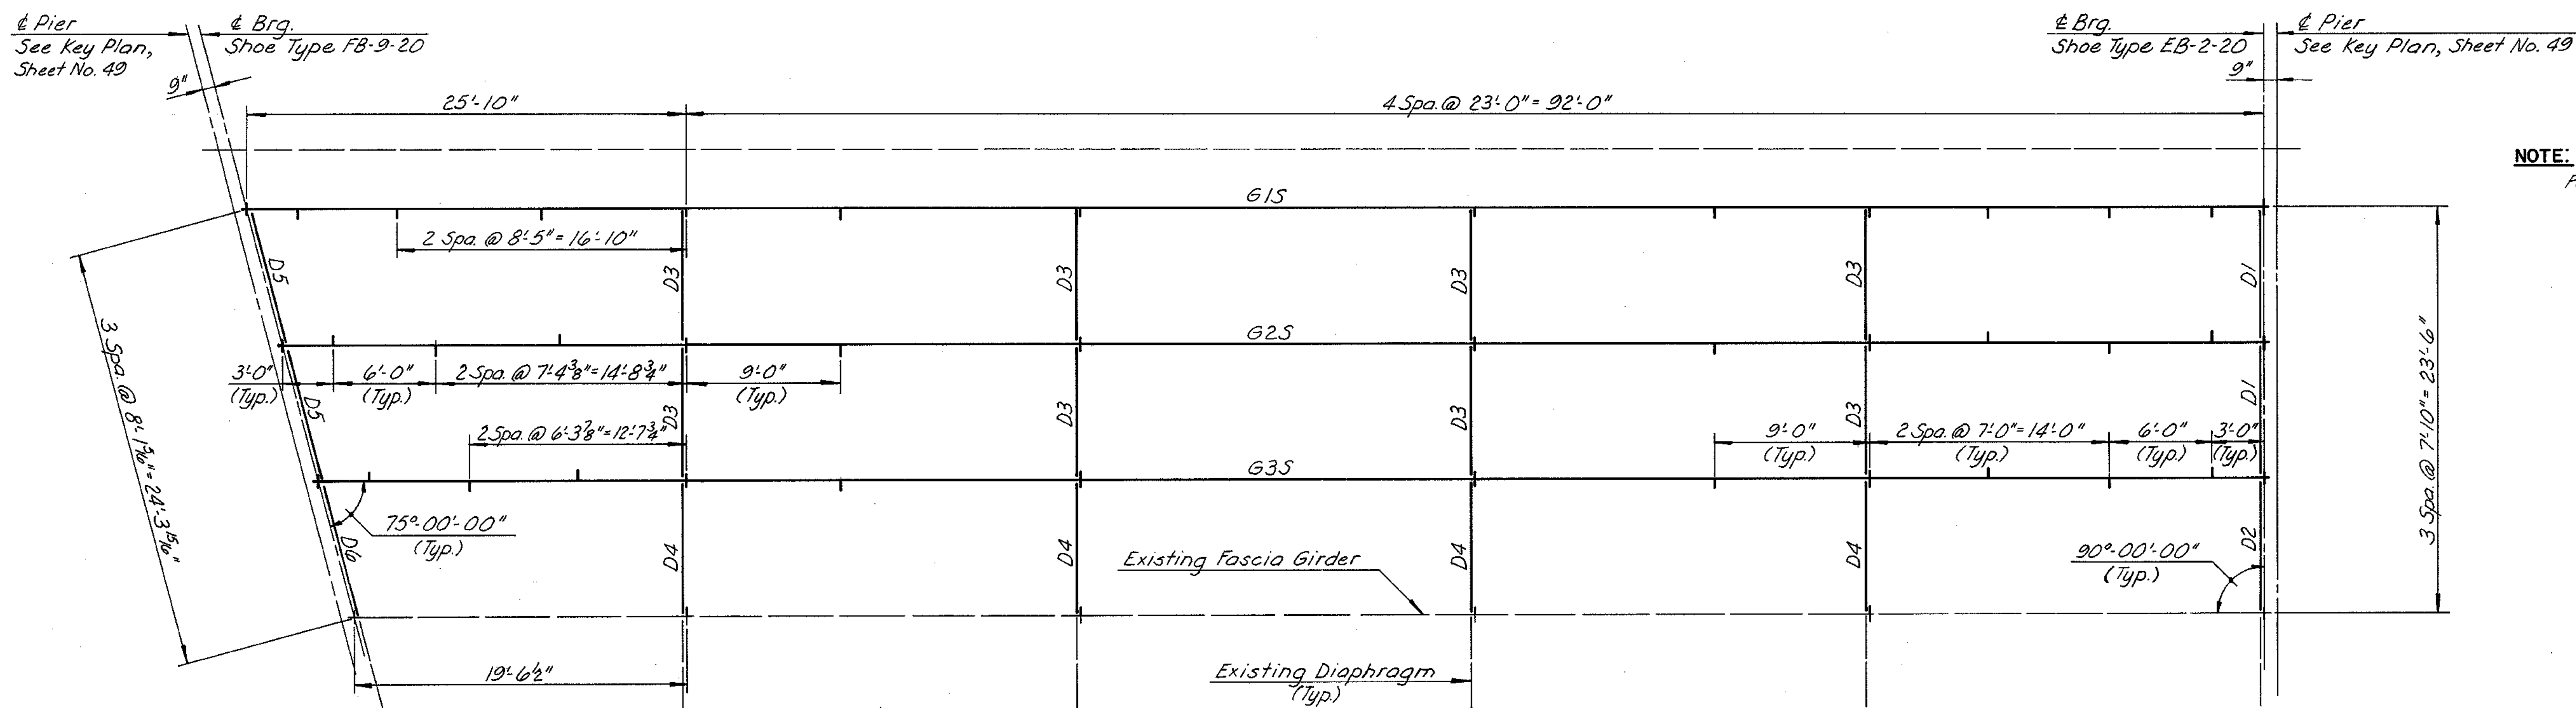

FRAMING PLAN-UNIT 17 SOUTHBOUND  
Scale:  $\frac{3}{16}" = 1'-0"$

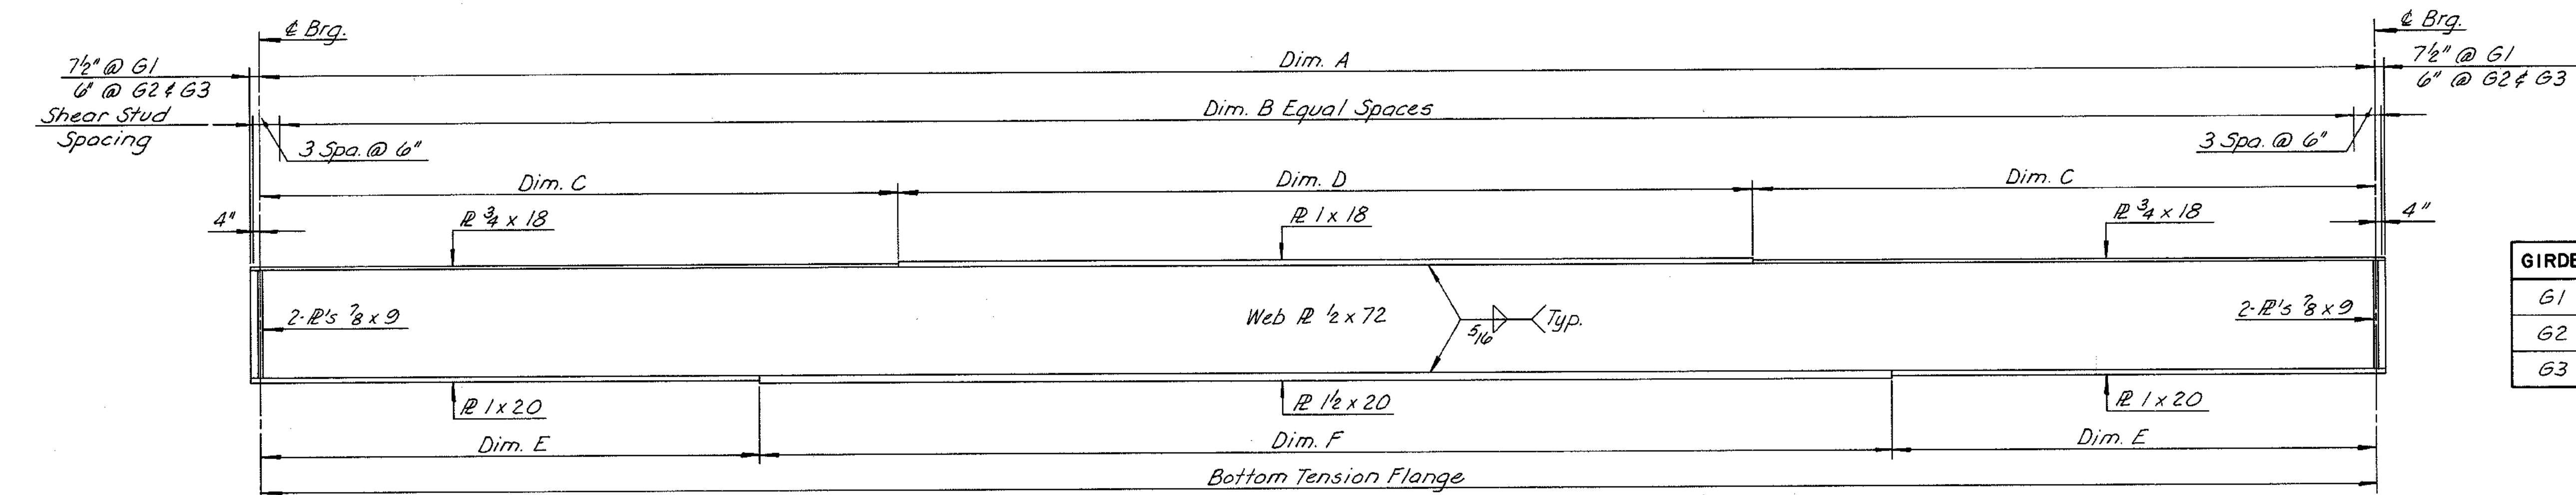

GIRDER ELEVATION-UNIT 17 SOUTHBOUND  
Scale:  $\frac{3}{16}" = 1'-0"$

GIRDER	DIM. A	DIM. B	DIM. C	DIM. D	DIM. E	DIM. F
G1	117'-10"	58	32'-11"	52'-0"	25'-8"	66'-6"
G2	115'-8 $\frac{3}{4}"$	57	32'-1 $\frac{3}{8}"$	51'-6"	24'-7 $\frac{3}{8}"$	66'-6"
G3	113'-7 $\frac{5}{8}"$	56	33'-9 $\frac{9}{16}"$	46'-0"	25'-6 $\frac{1}{2}"$	62'-6"

BY	DATE				
MADE	EJM	1-87			
CHECKED	TFP	3-87	As Built	TEM	3-89
IN CHARGE	SR				

AS BUILT

RICHMOND METROPOLITAN AUTHORITY  
RICHMOND EXPRESSWAY SYSTEM



FRAMING PLAN & GIRDER ELEVATION  
UNIT 17 SOUTHBOUND

HOWARD, NEEDLES, TAMMEN & BERGENDOFF  
consulting engineers  
Alexandria, Virginia

SCALE: AS SHOWN  
CONTRACT NO.: C-13  
SHEET NO. 42 OF 106

RICHMOND EXPRESSWAY SYSTEM			
SECTION	PROJECT	SHEET NO.	TOTAL SHEETS
13	WIDENING JAMES RIVER BRIDGE	43	106

NOTE:  
For Steel Details, see Sheet No. 45.

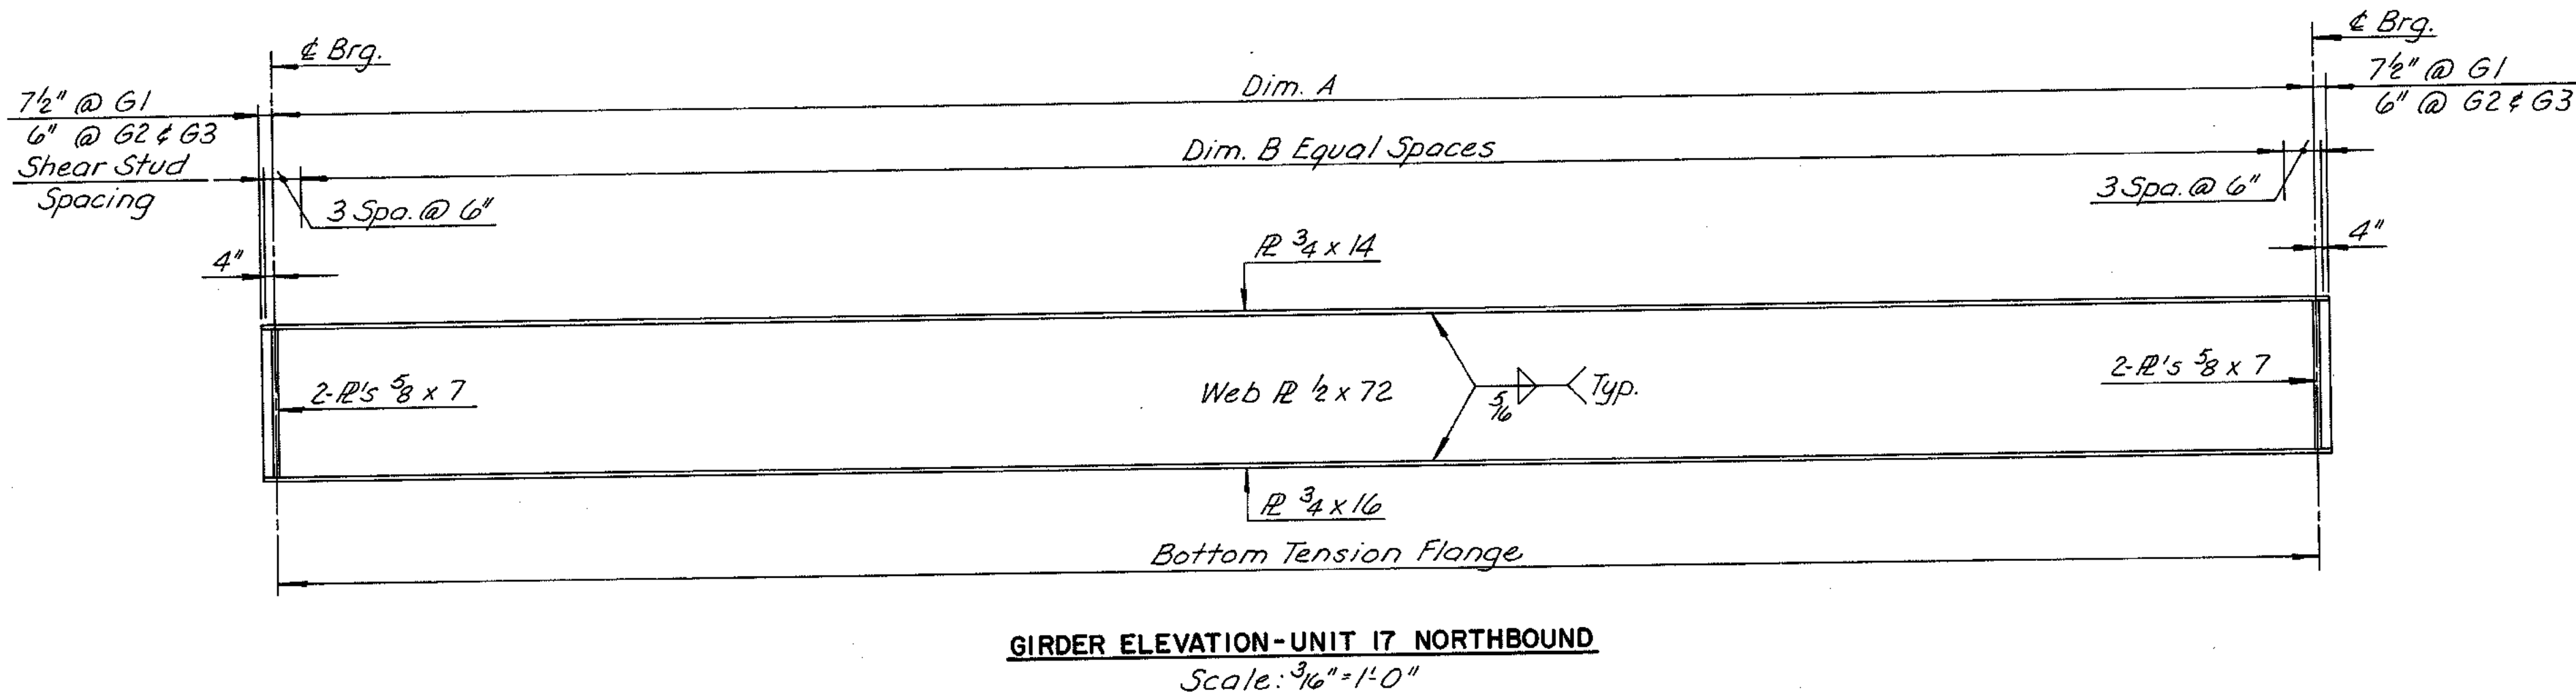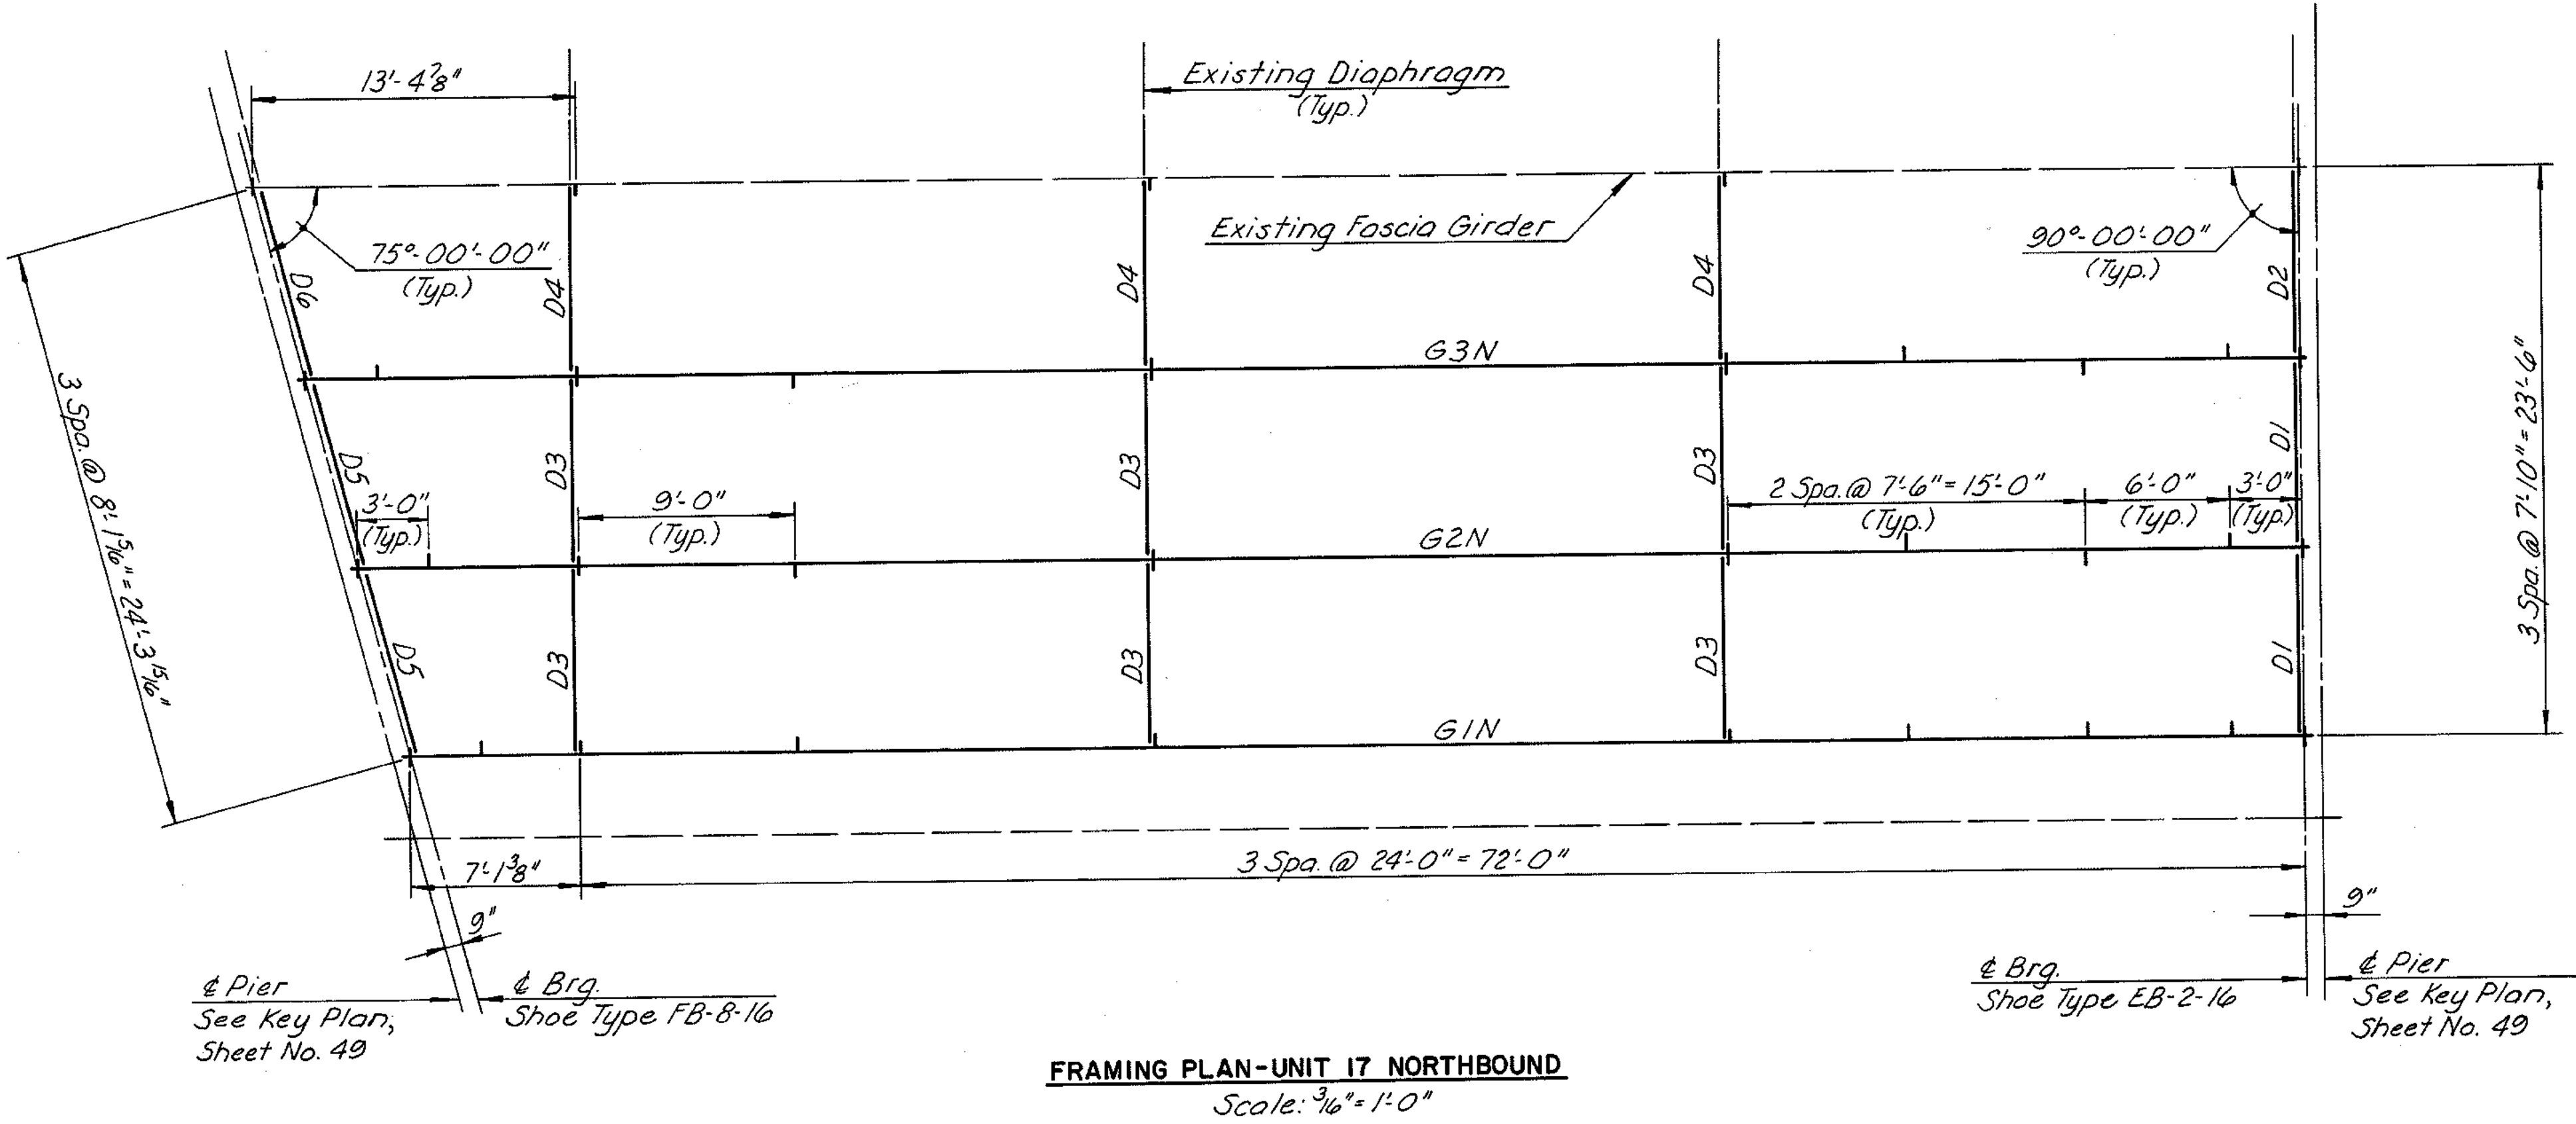

GIRDER	DIM. A	DIM. B
G1	79'-1 3/8"	43
G2	81'-2 1/2"	44
G3	83'-3 3/4"	45

MADE	BY	DATE			
CHECKED	EUM	1-87			
IN CHARGE	TFP	3-87	As Built	TEM	3-89
	SR		NO.	REVISION	BY DATE


AS BUILT

RICHMOND METROPOLITAN AUTHORITY RICHMOND EXPRESSWAY SYSTEM	
FRAMING PLAN & GIRDER ELEVATION UNIT 17 NORTHBOUND	
HOWARD, NEEDLES, TAMMEN & BERGENDOFF consulting engineers Alexandria, Virginia	SCALE: AS SHOWN CONTRACT NO.: C-13 SHEET NO. 43 OF 106




RICHMOND EXPRESSWAY SYSTEM			
SECTION	PROJECT	SHEET NO.	TOTAL SHEETS
13	WIDENING JAMES RIVER BRIDGE	44	106

NOTE:  
For Steel Details, see Sheet No. 45.

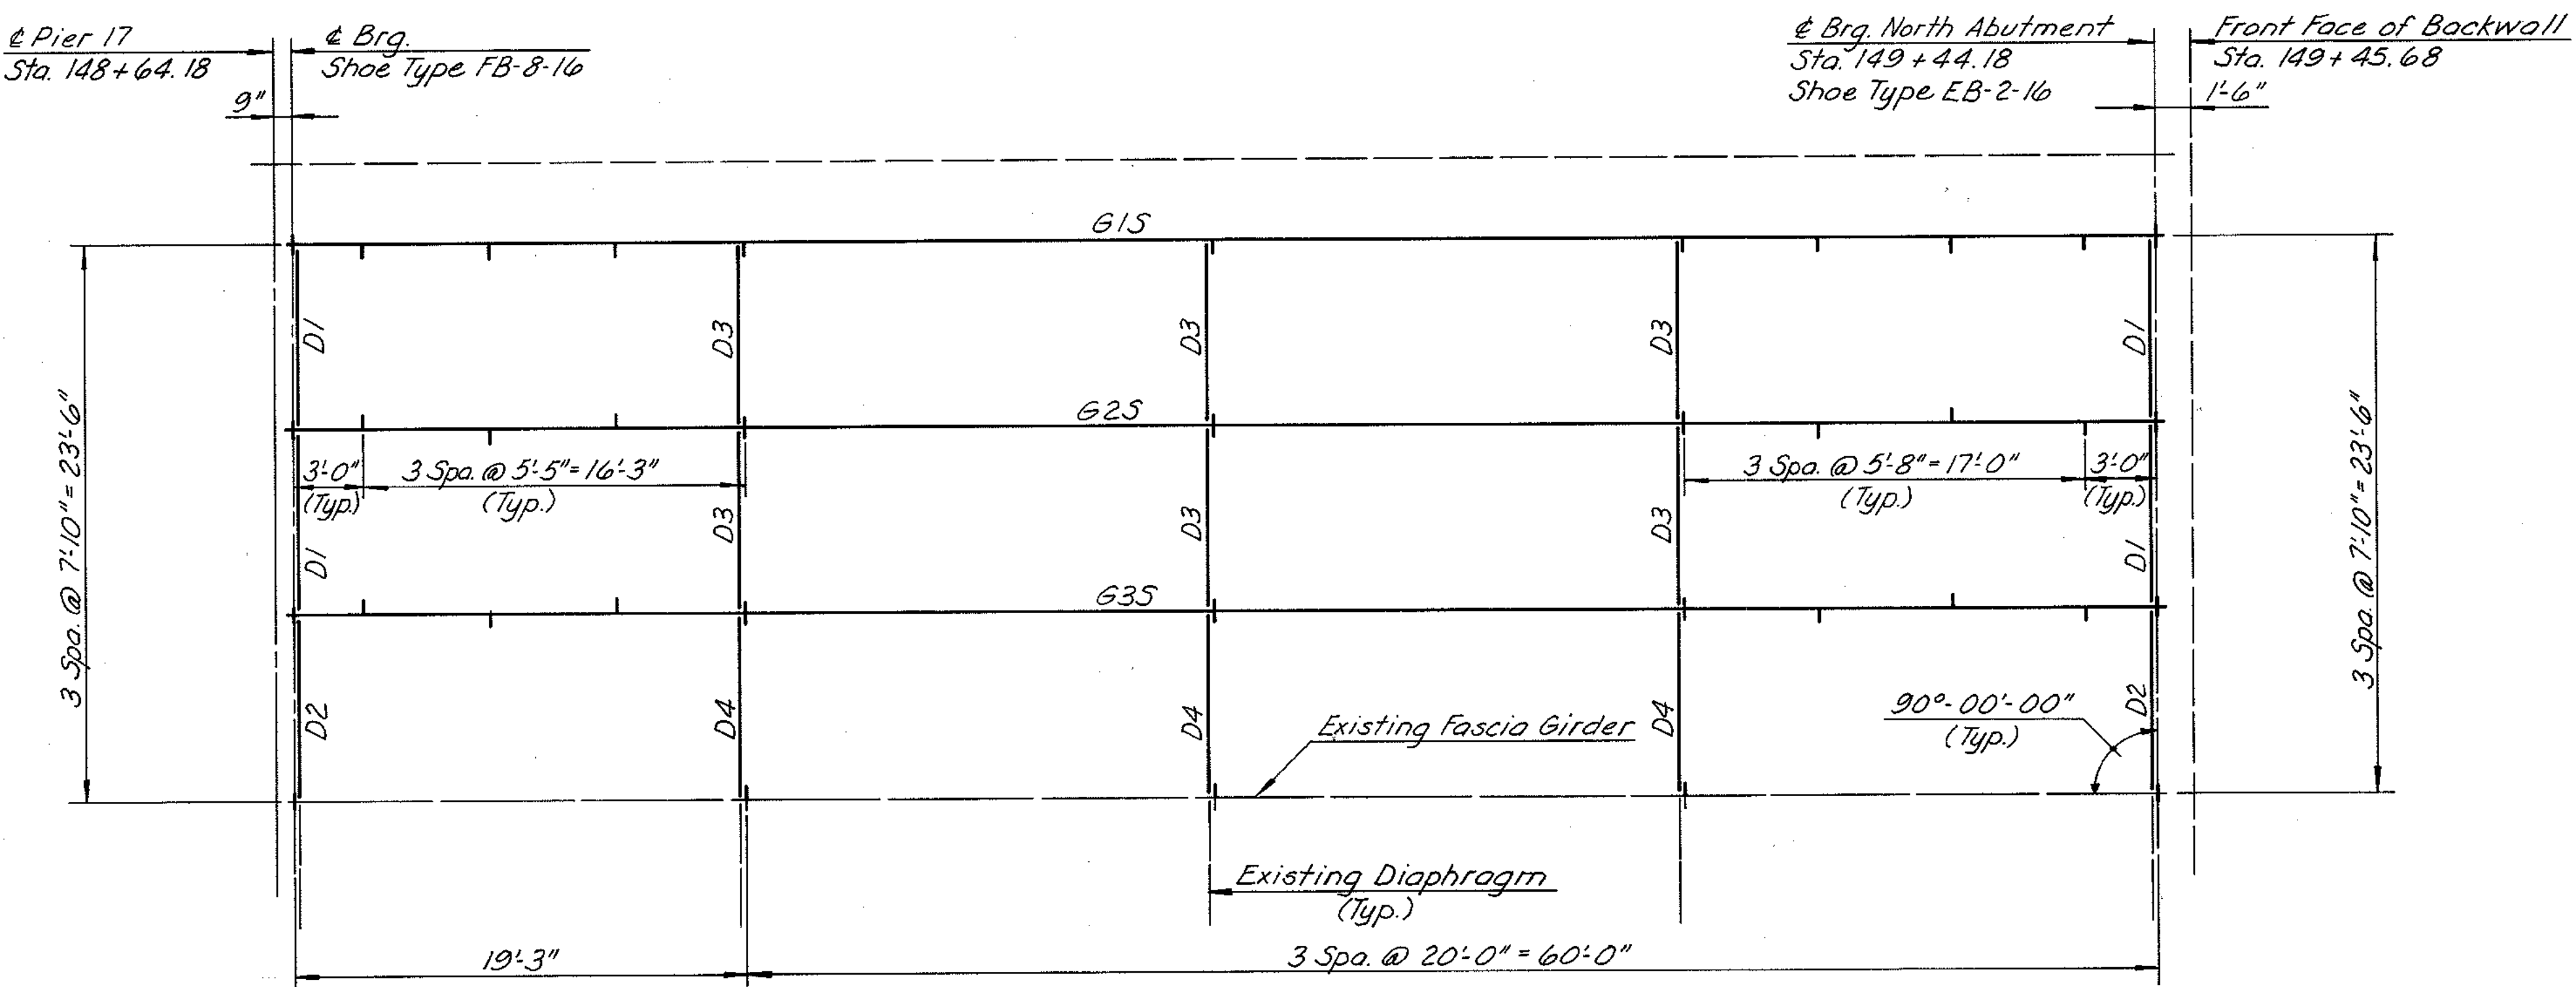

FRAMING PLAN - UNIT 18 SOUTHBOUND & NORTHBOUND  
(SOUTHBOUND SHOWN)  
Scale: 3/16" = 1'-0"

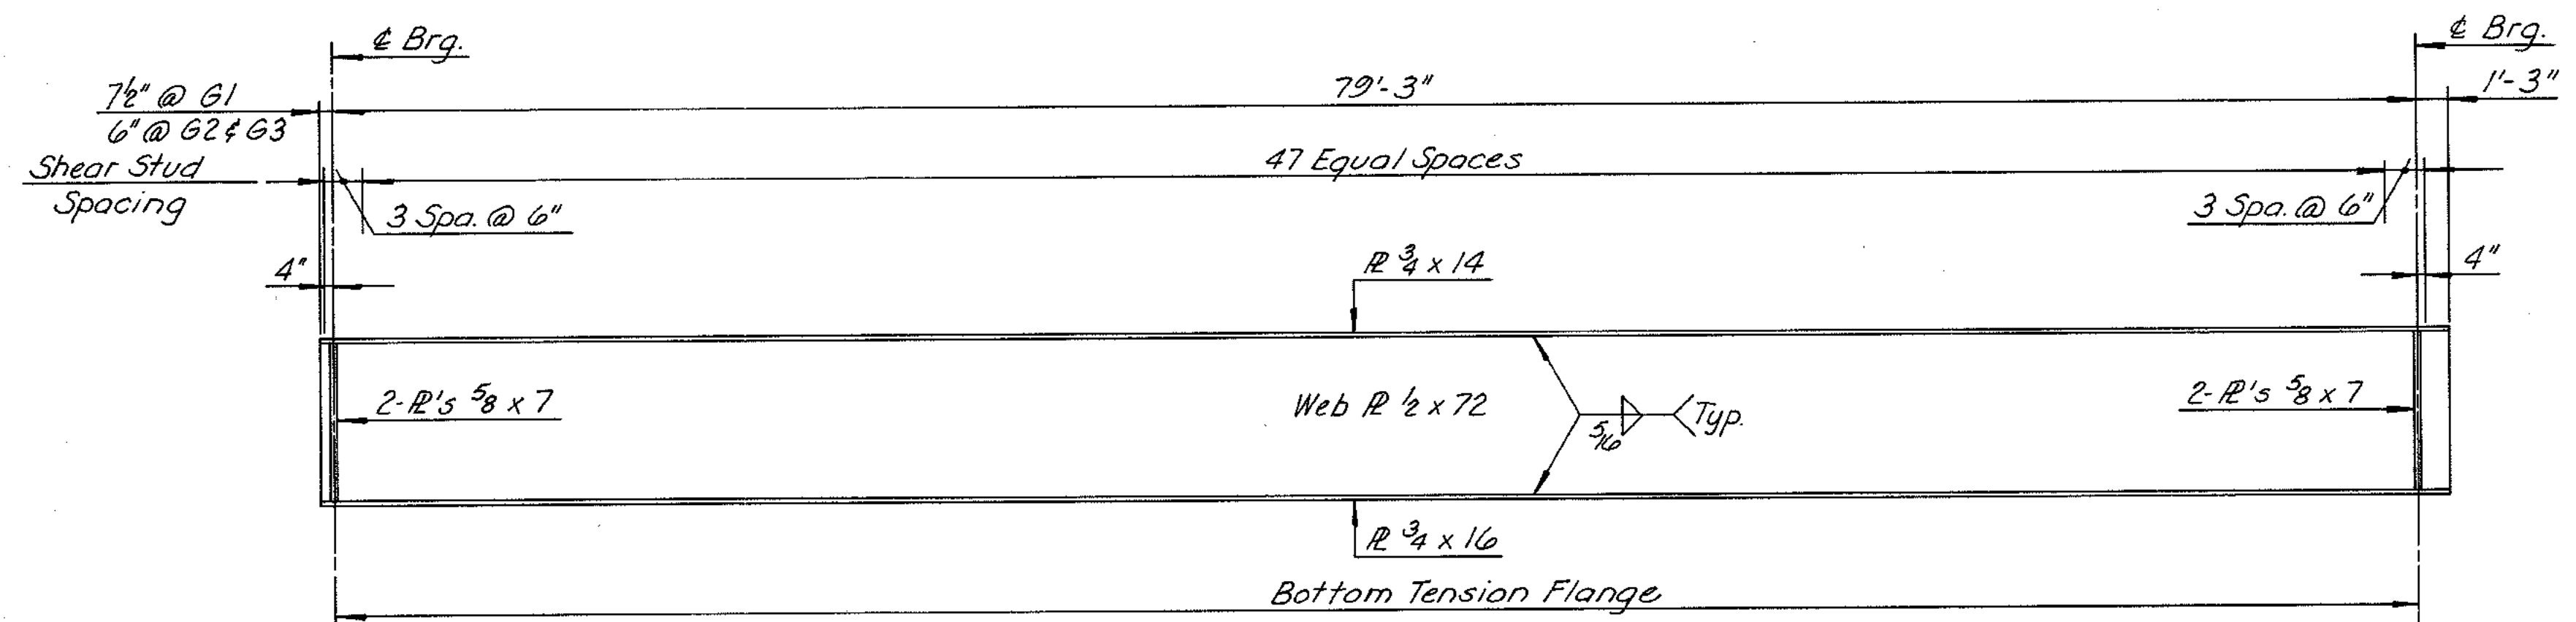


GIRDER ELEVATION - UNIT 18 SOUTHBOUND & NORTHBOUND  
Scale: 3/16" = 1'-0"

MADE	BY	DATE			
CHECKED	TFP	3-87	As Built	TEM	3-89
IN CHARGE	SR				


RICHMOND METROPOLITAN AUTHORITY RICHMOND EXPRESSWAY SYSTEM	
FRAMING PLAN & GIRDER ELEVATION UNIT 18 SOUTHBOUND & NORTHBOUND	
HOWARD, NEEDLES, TAMMEN & BERGENDOFF consulting engineers Alexandria, Virginia	SCALE: AS SHOWN CONTRACT NO.: C-13 SHEET NO. 44 OF 106

AS BUILT


RICHMOND EXPRESSWAY SYSTEM			
SECTION	PROJECT	SHEET NO.	TOTAL SHEETS
13	WIDENING JAMES RIVER BRIDGE	45	106

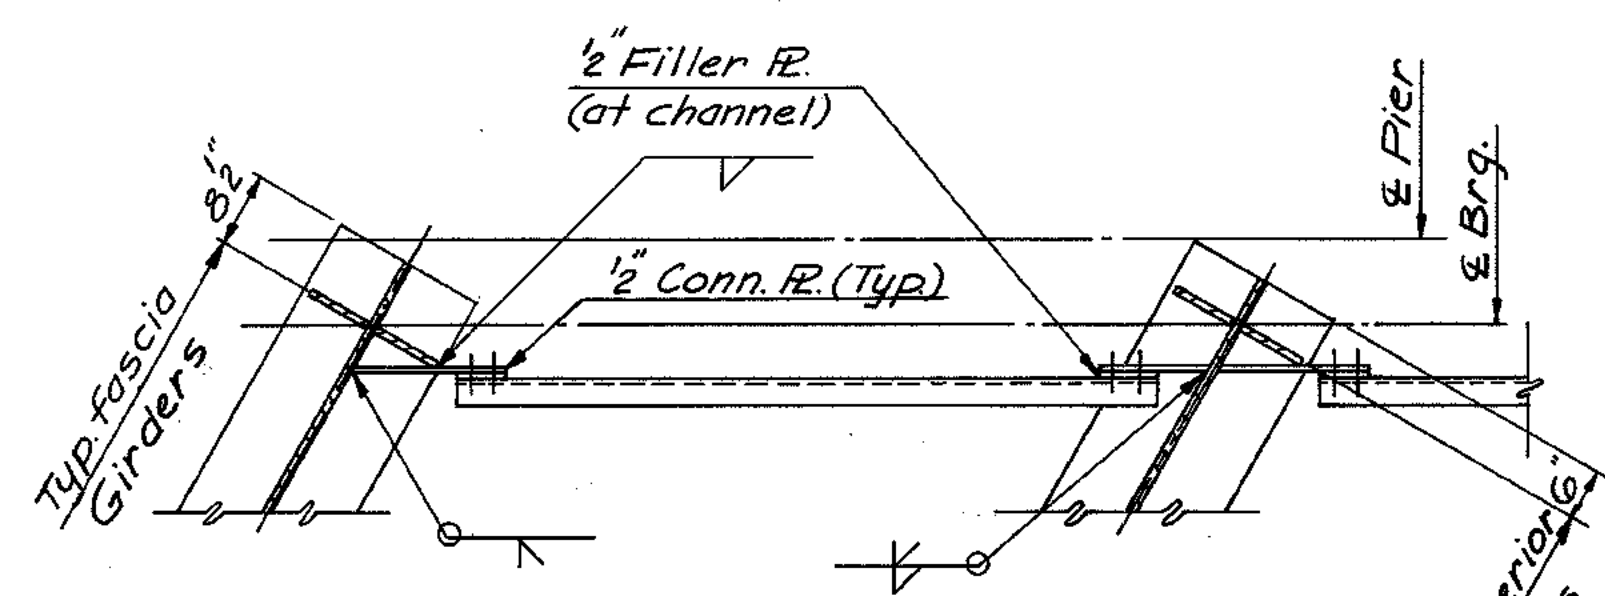


PLAN-DIAPHRAGM D7 & D11

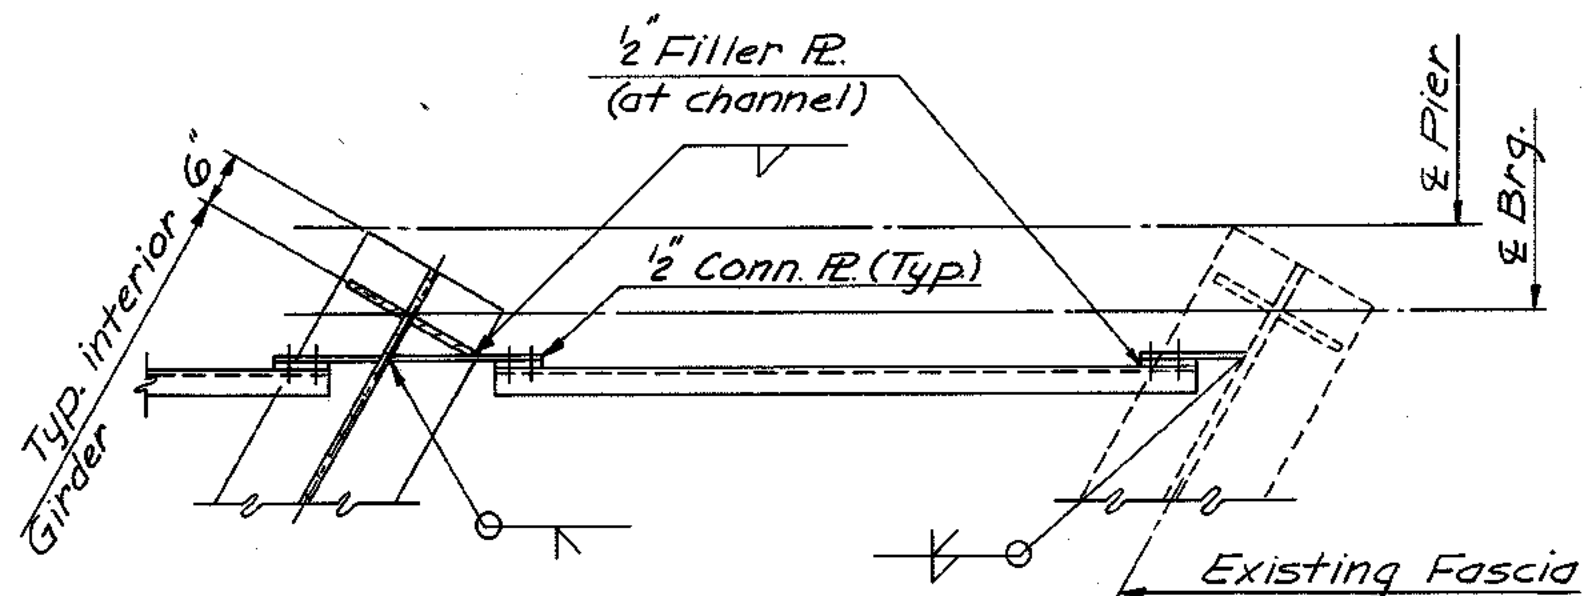


PLAN-DIAPHRAGM D8 & D12

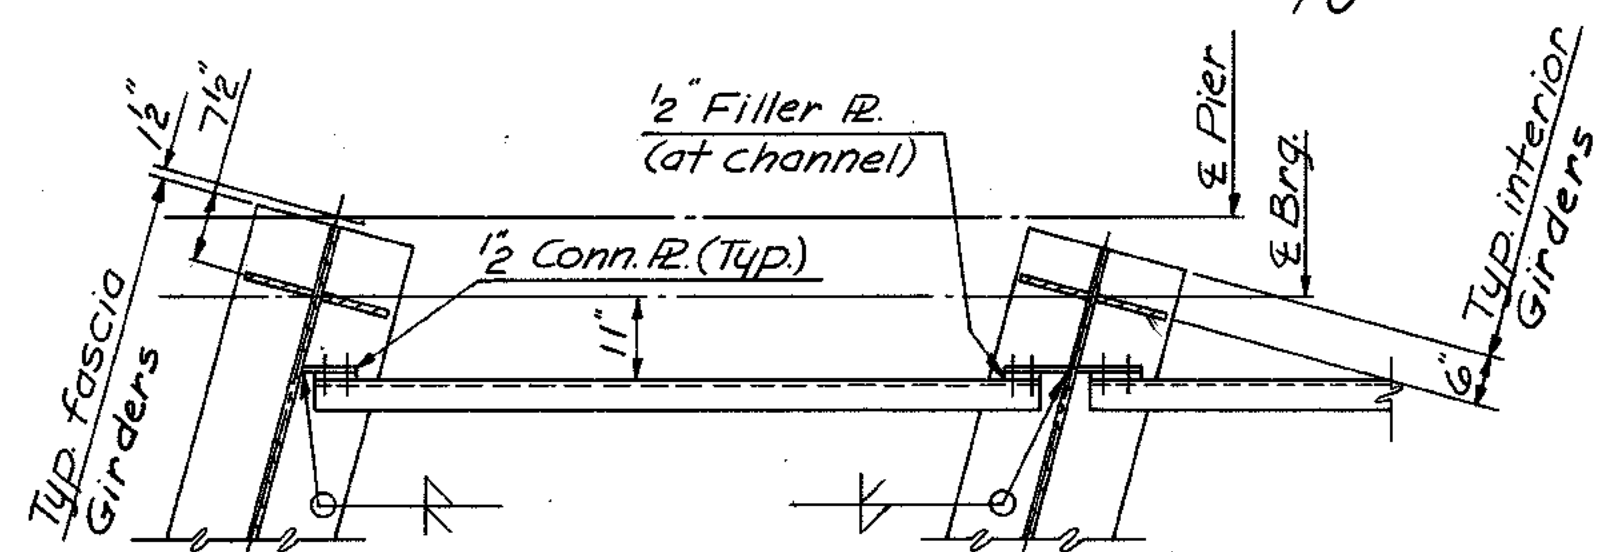


PLAN-DIAPHRAGM D5

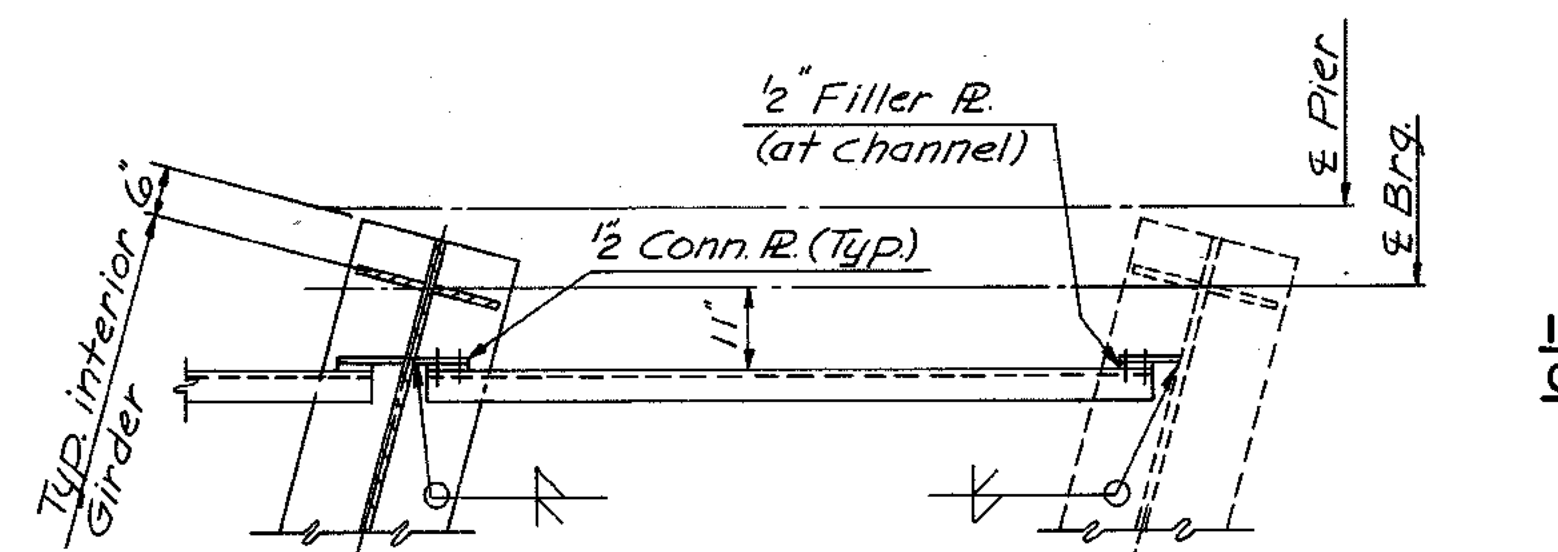


PLAN-DIAPHRAGM D6

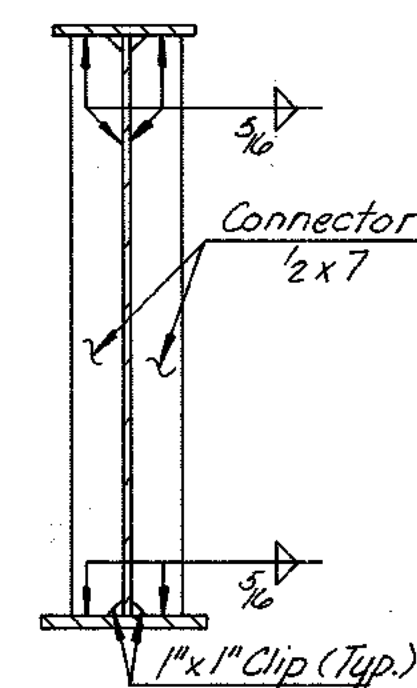


INTERMEDIATE DIAPHRAGM CONNECTOR PLATE DETAIL  
No Scale

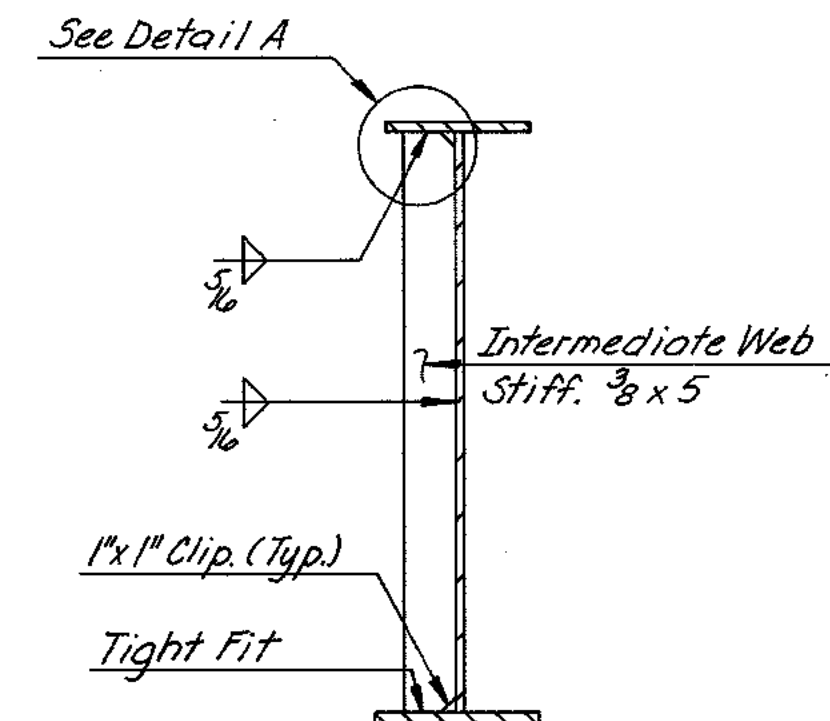


INTERMEDIATE WEB STIFFENER DETAIL  
No Scale

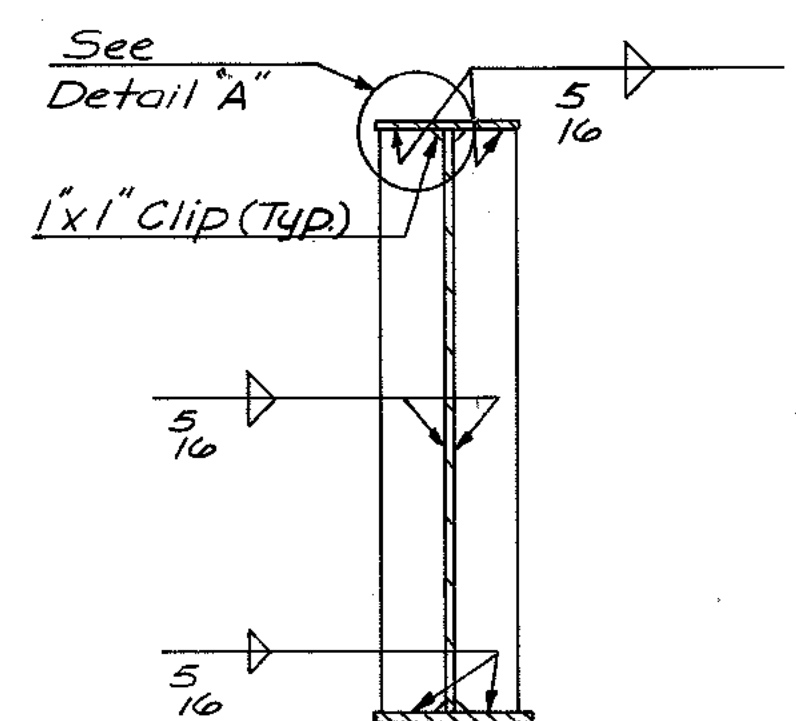


BEARING STIFFENER DETAIL  
No Scale

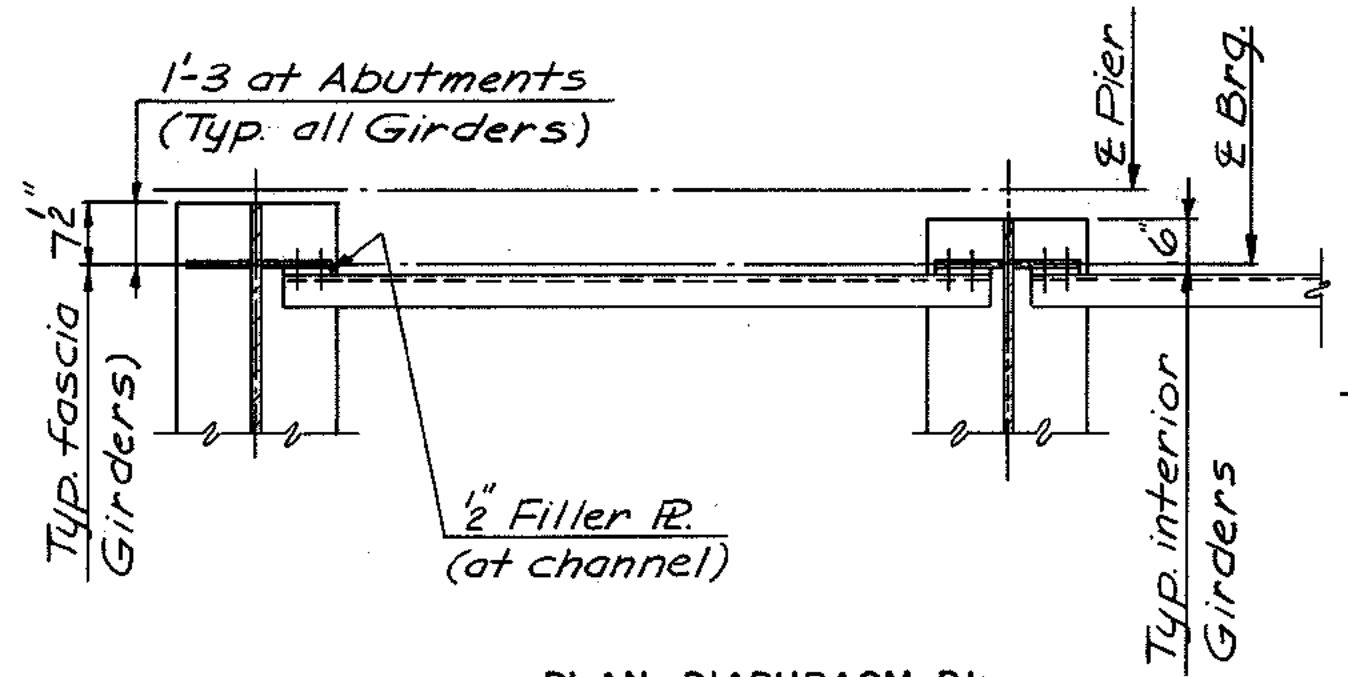


PLAN-DIAPHRAGM D1

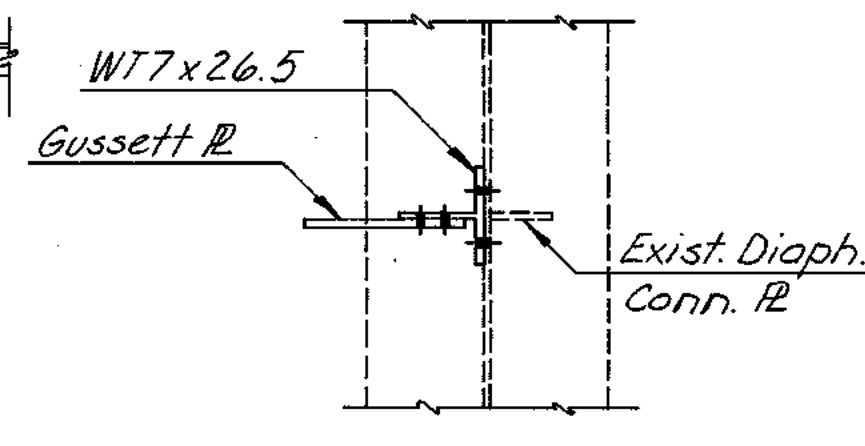


SECTION A-A  
Scale: 3/4"=1'-0"

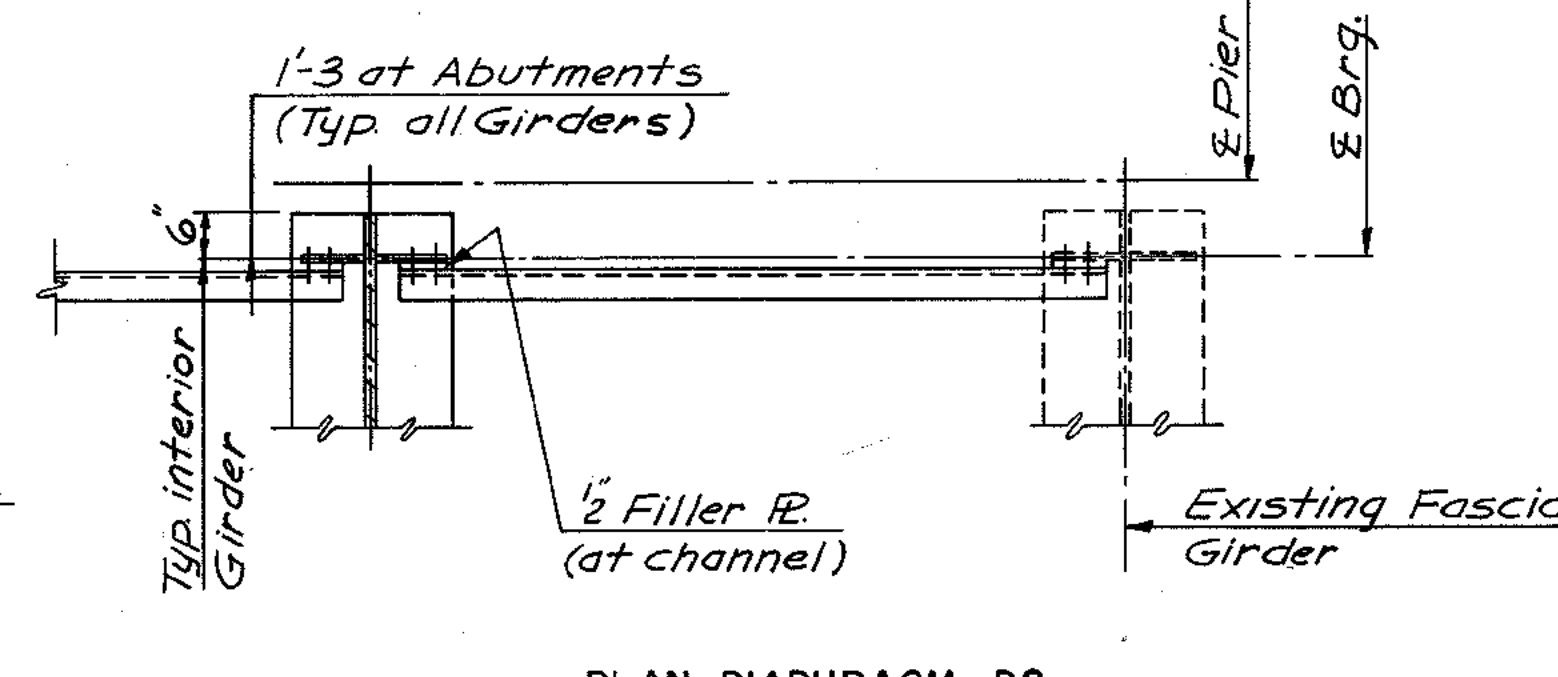


PLAN-DIAPHRAGM D2

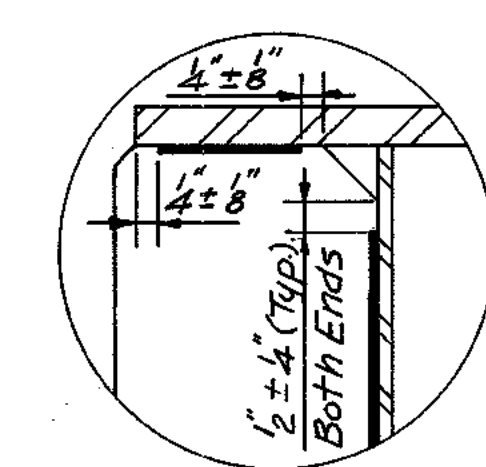


DETAIL "A"  
No Scale

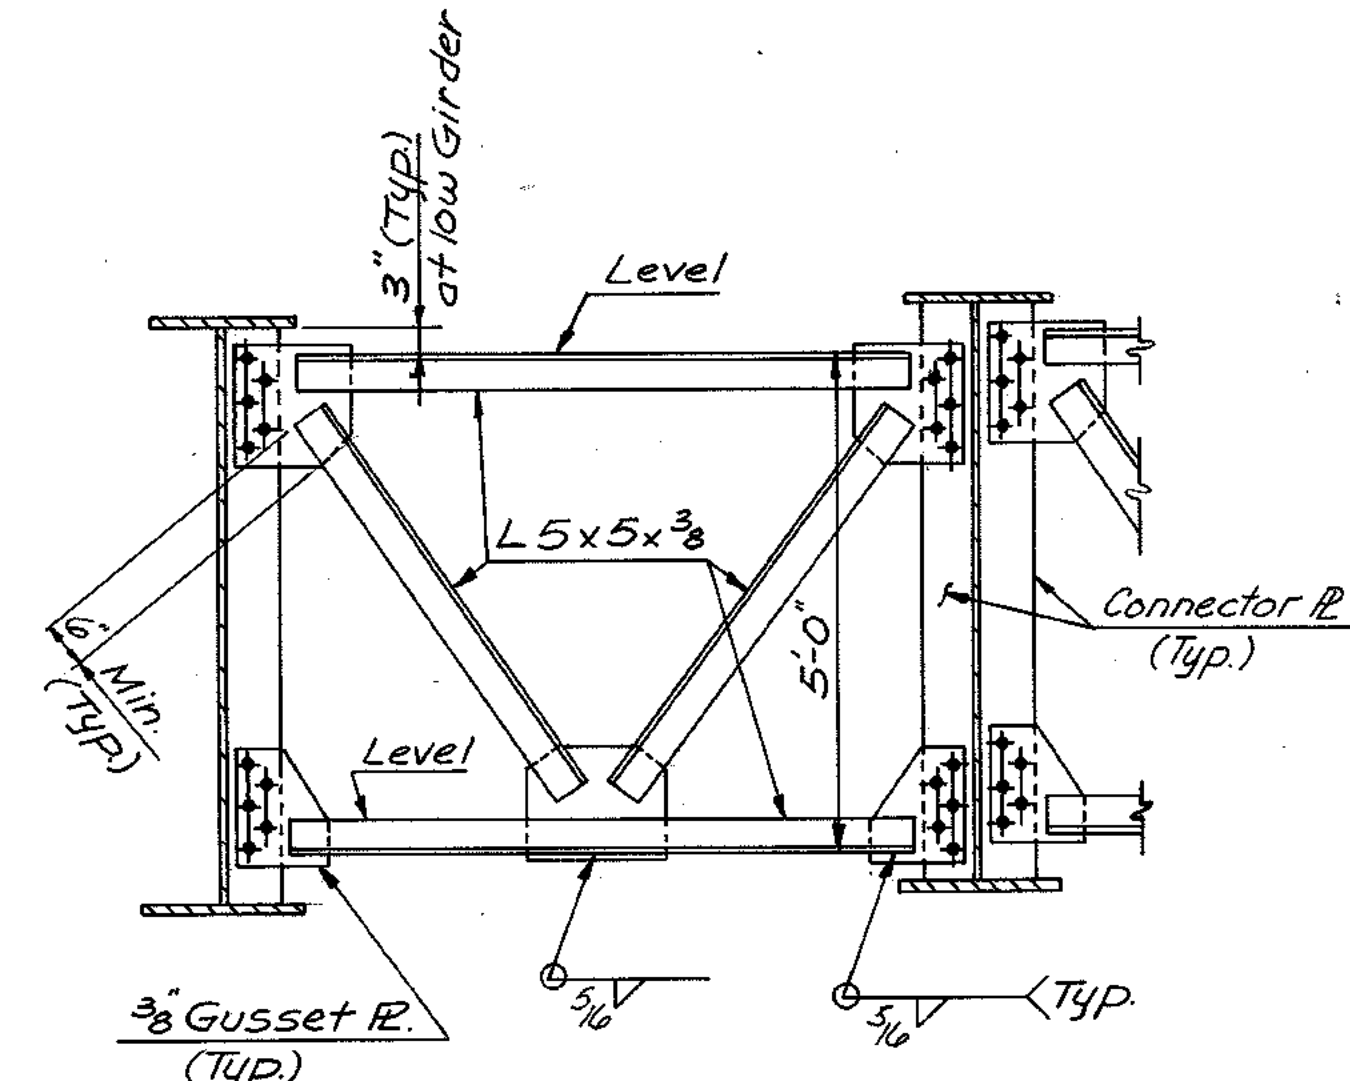


INTERMEDIATE DIAPHRAGM D3,  
Scale: 1/2"=1'-0"

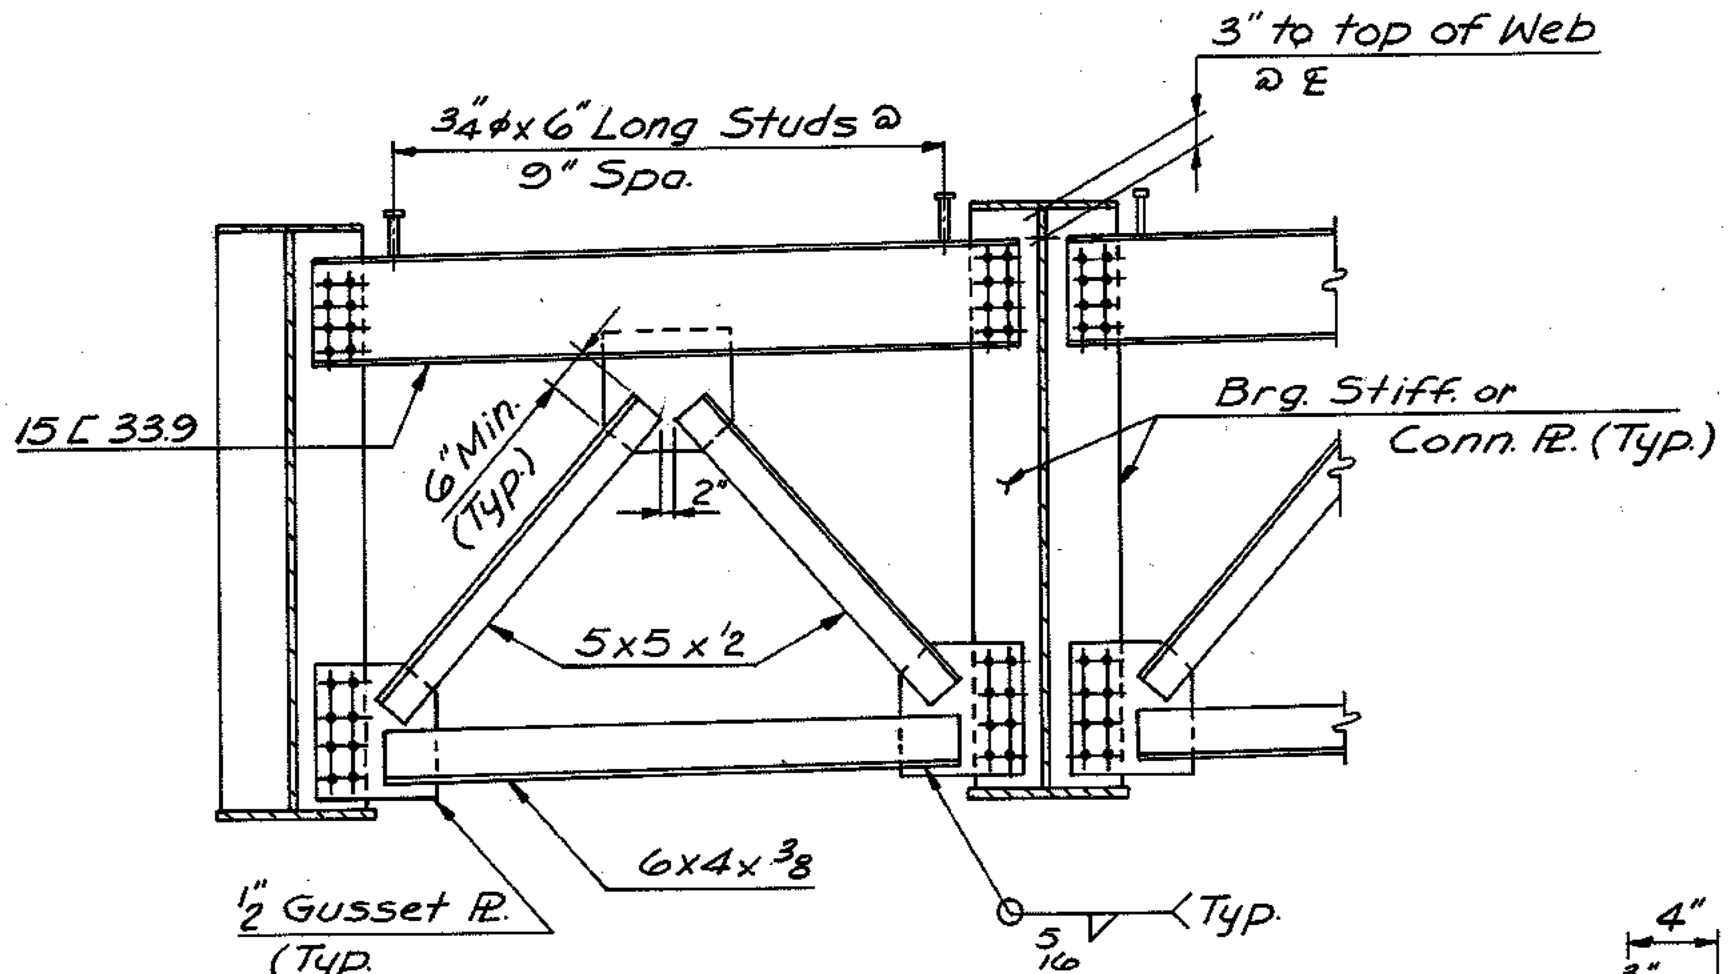


ELEVATION  
END DIAPHRAGM DETAILS - D1, D5, D7  
Scale: 1/2"=1'-0"

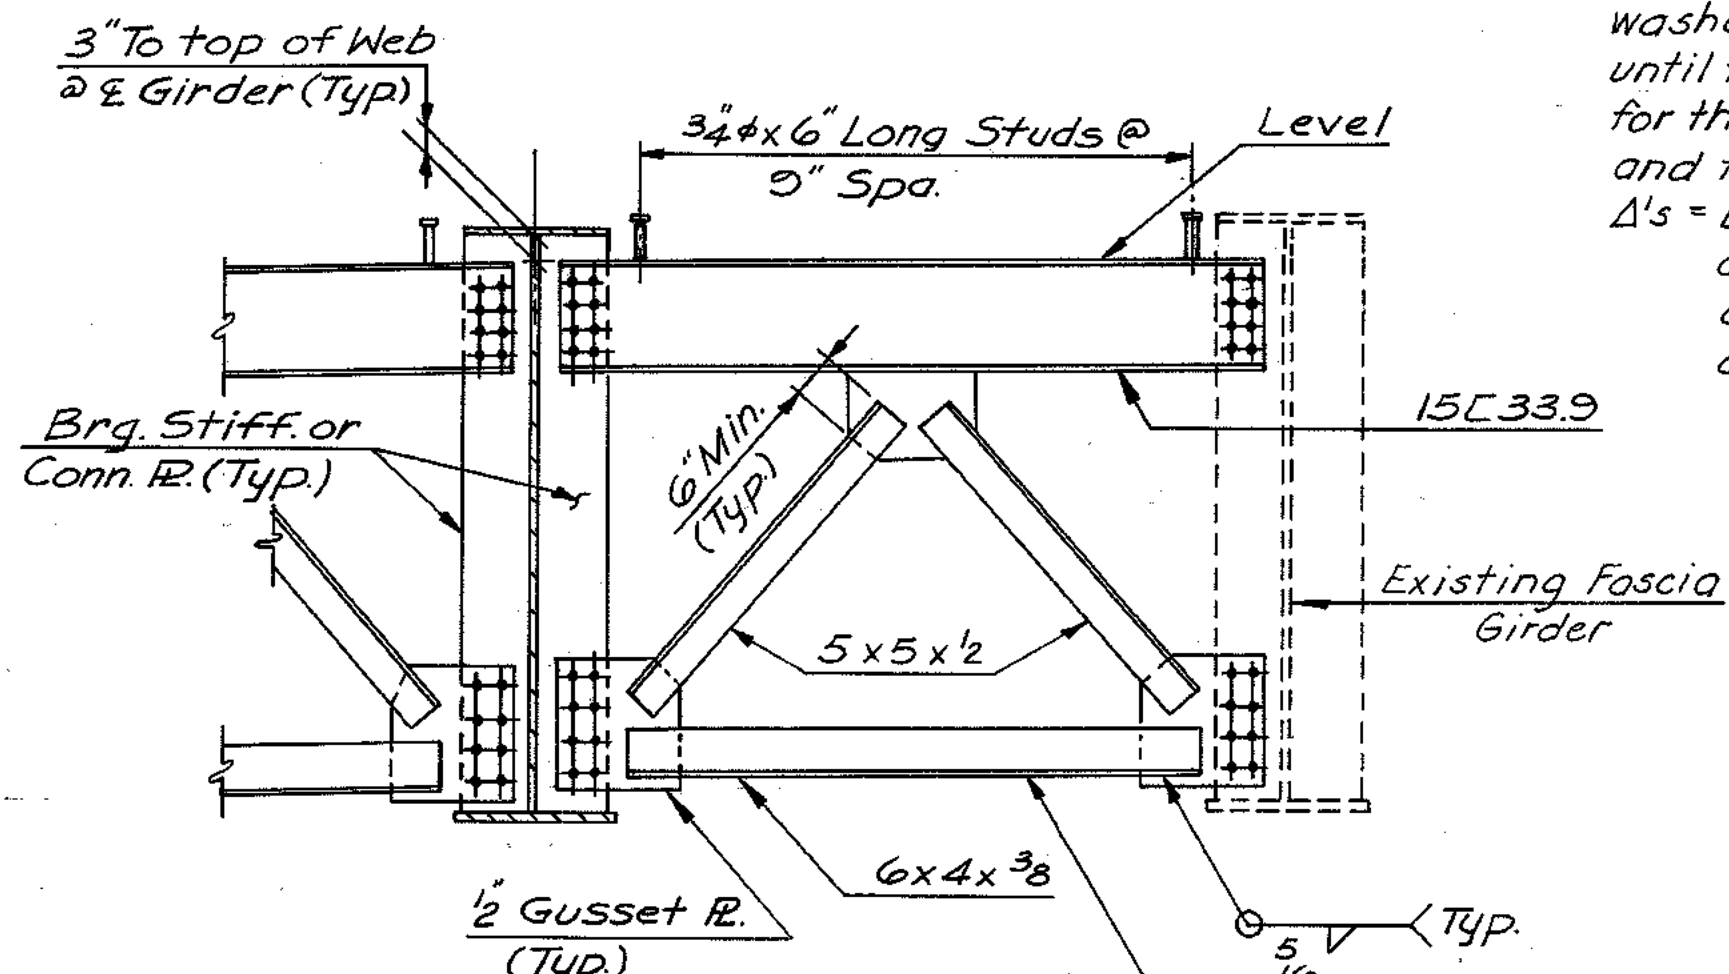


ELEVATION  
END DIAPHRAGM DETAILS - D2, D6, D8  
Scale: 1/2"=1'-0"

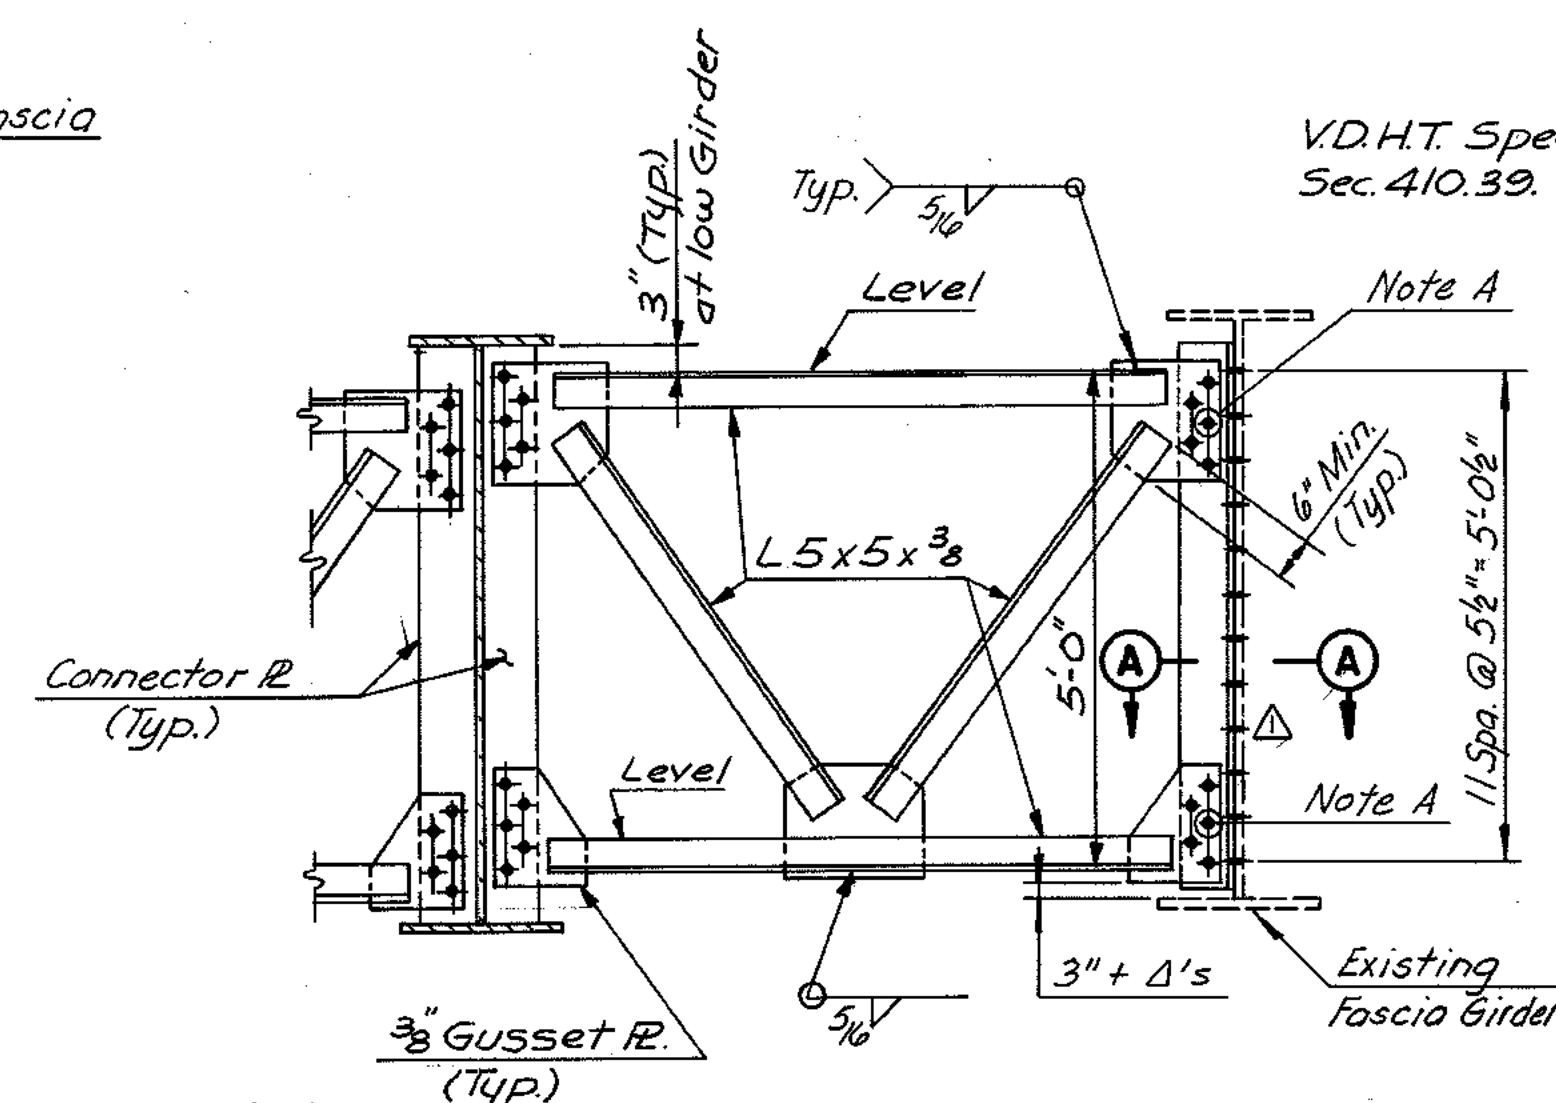

INTERMEDIATE DIAPHRAGM D4  
Scale: 1/2"=1'-0"

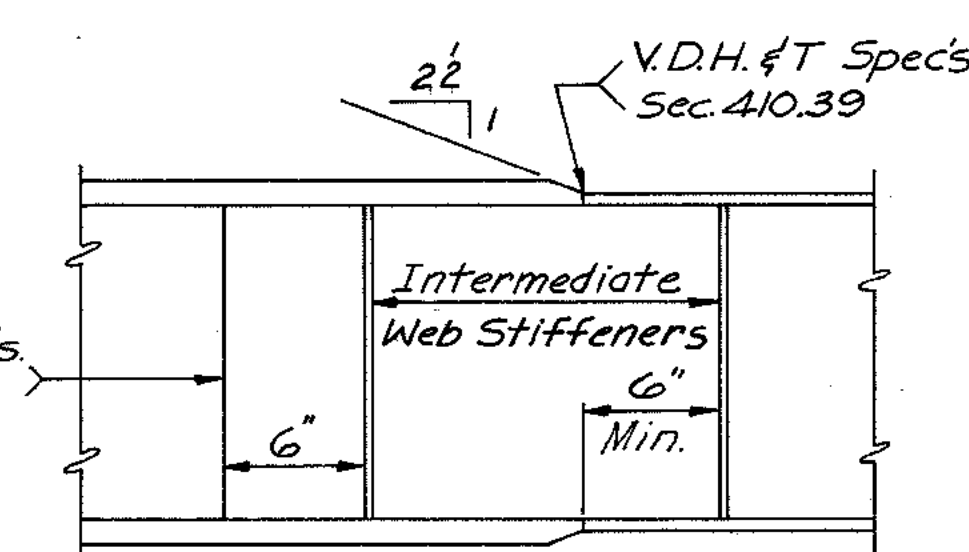

WELDED SPLICE DETAIL  
No Scale

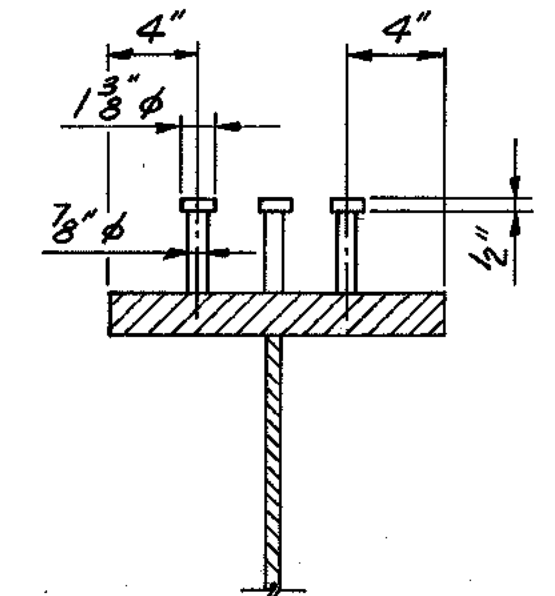

SHEAR STUD DETAIL  
No Scale

NOTES:  
Capacity = 6010 lbs. per stud shear spacing shown is maximum spacing.  
All connections shall be made with 3/8" H.S. Bolts and shall conform to ASTM A-325.

AS BUILT





BY	DATE	As Built	TEM	3-89
MADE	ALC 3-87	Added Diaphs.	ALC	5-87
CHECKED	T.F.P. 3-87	Revised Conn. R.	T.F.P.	4-87
IN CHARGE	SR.			

RICHMOND METROPOLITAN AUTHORITY  
RICHMOND EXPRESSWAY SYSTEM

STEEL DETAILS

HOWARD, NEEDLES, TAMMEN & BERGENDOFF  
consulting engineers  
Alexandria, Virginia

SCALE: AS SHOWN  
CONTRACT NO.: C-13  
SHEET NO. 45 of 106

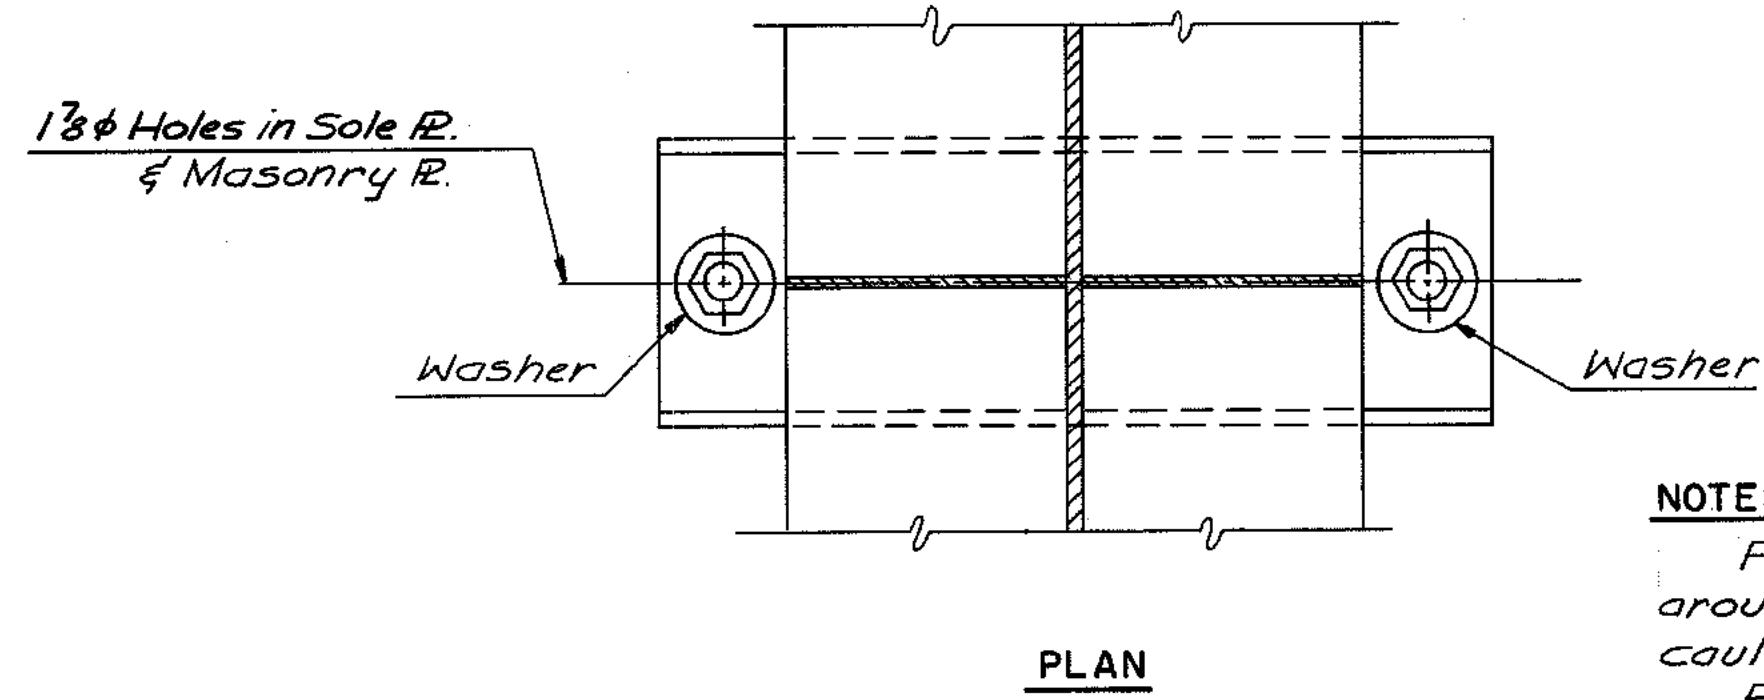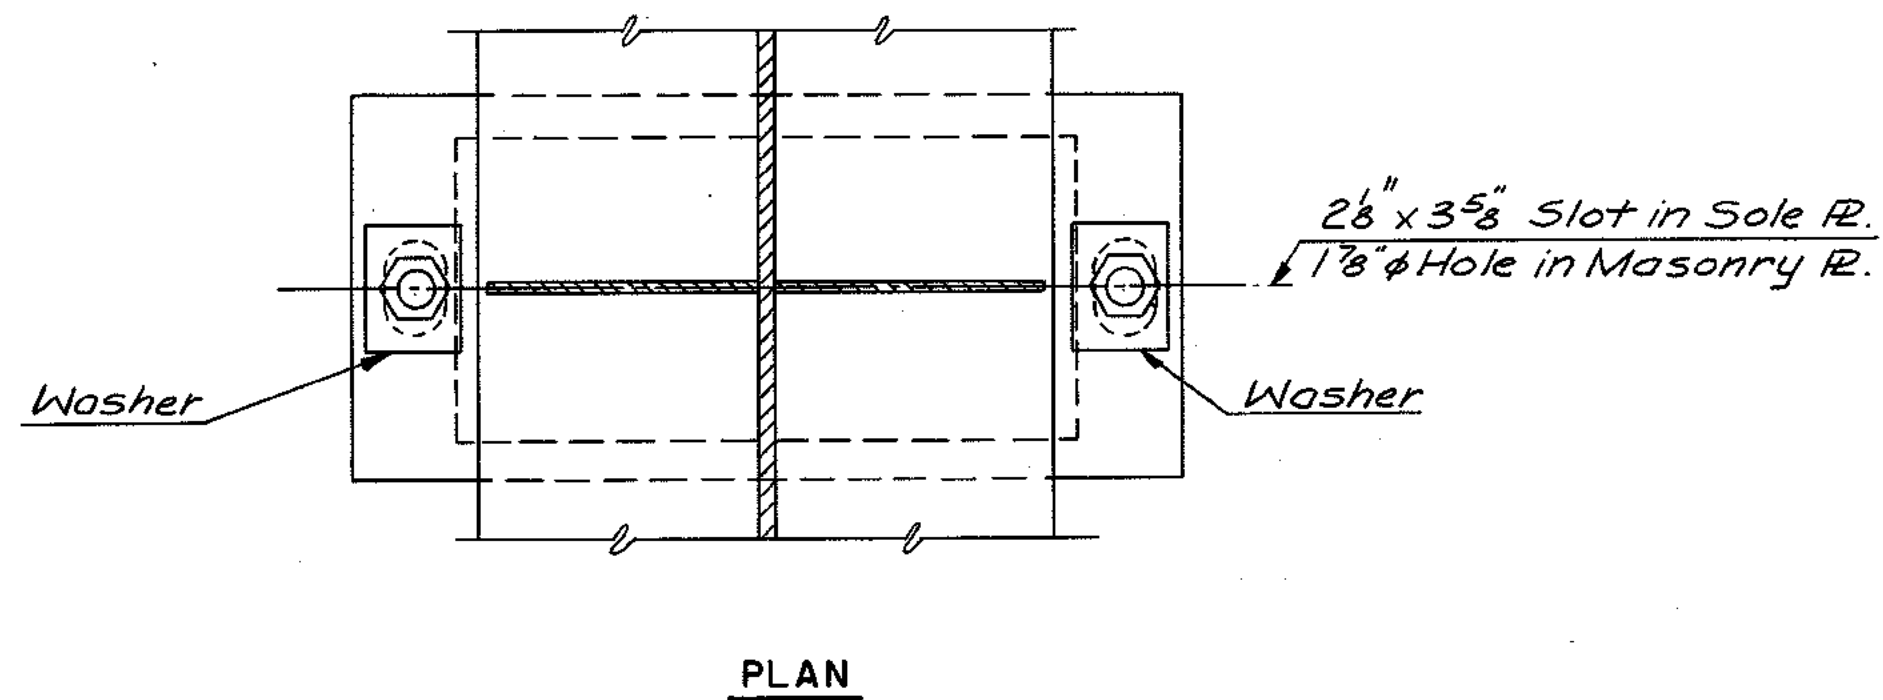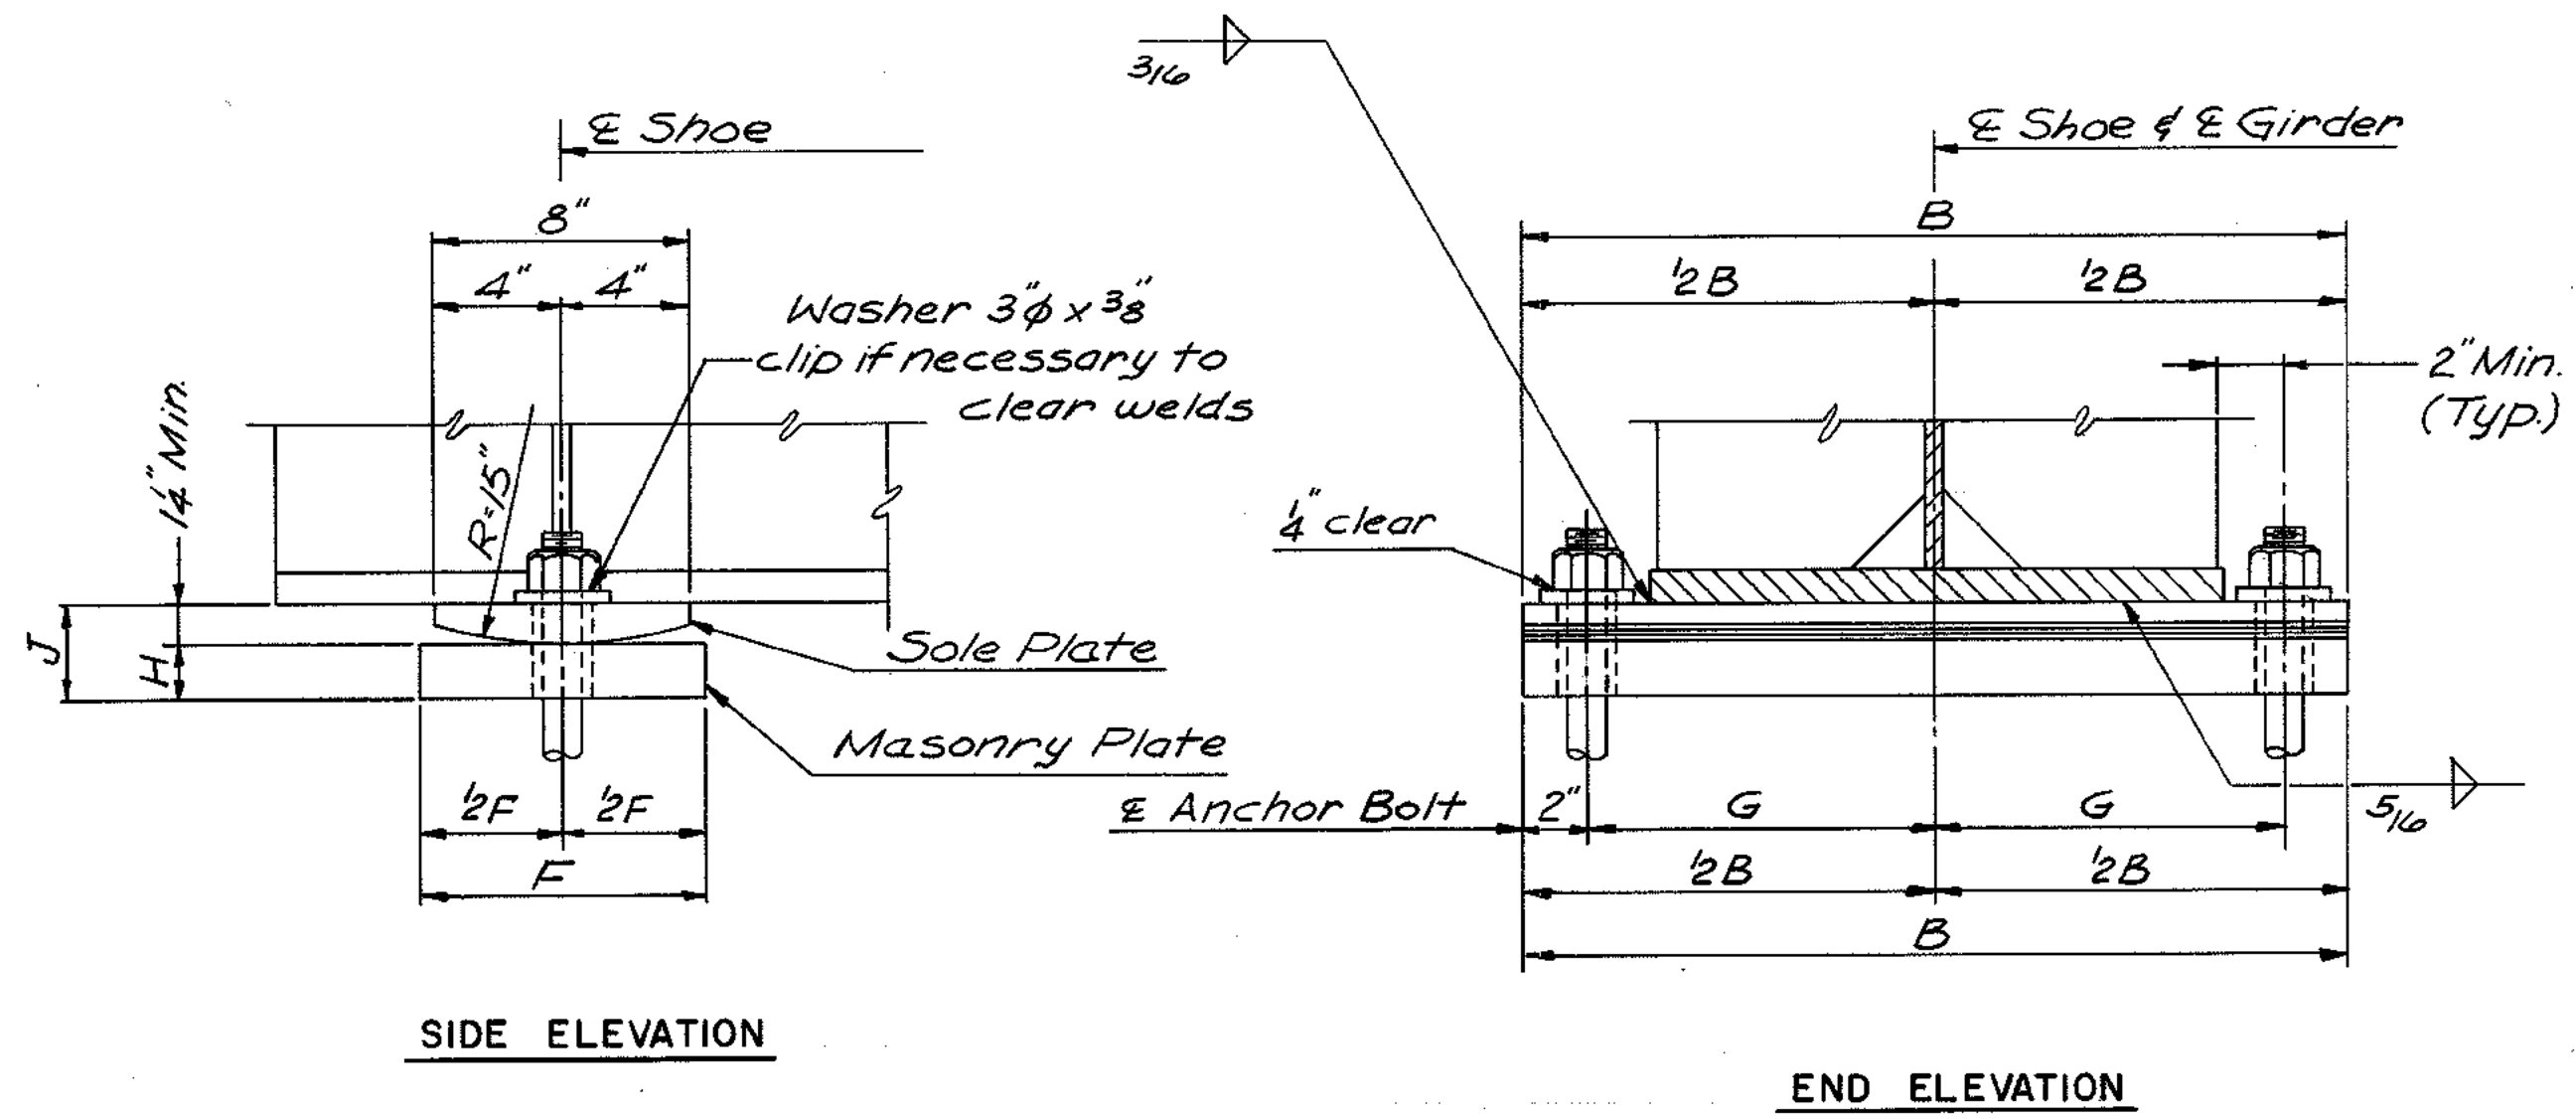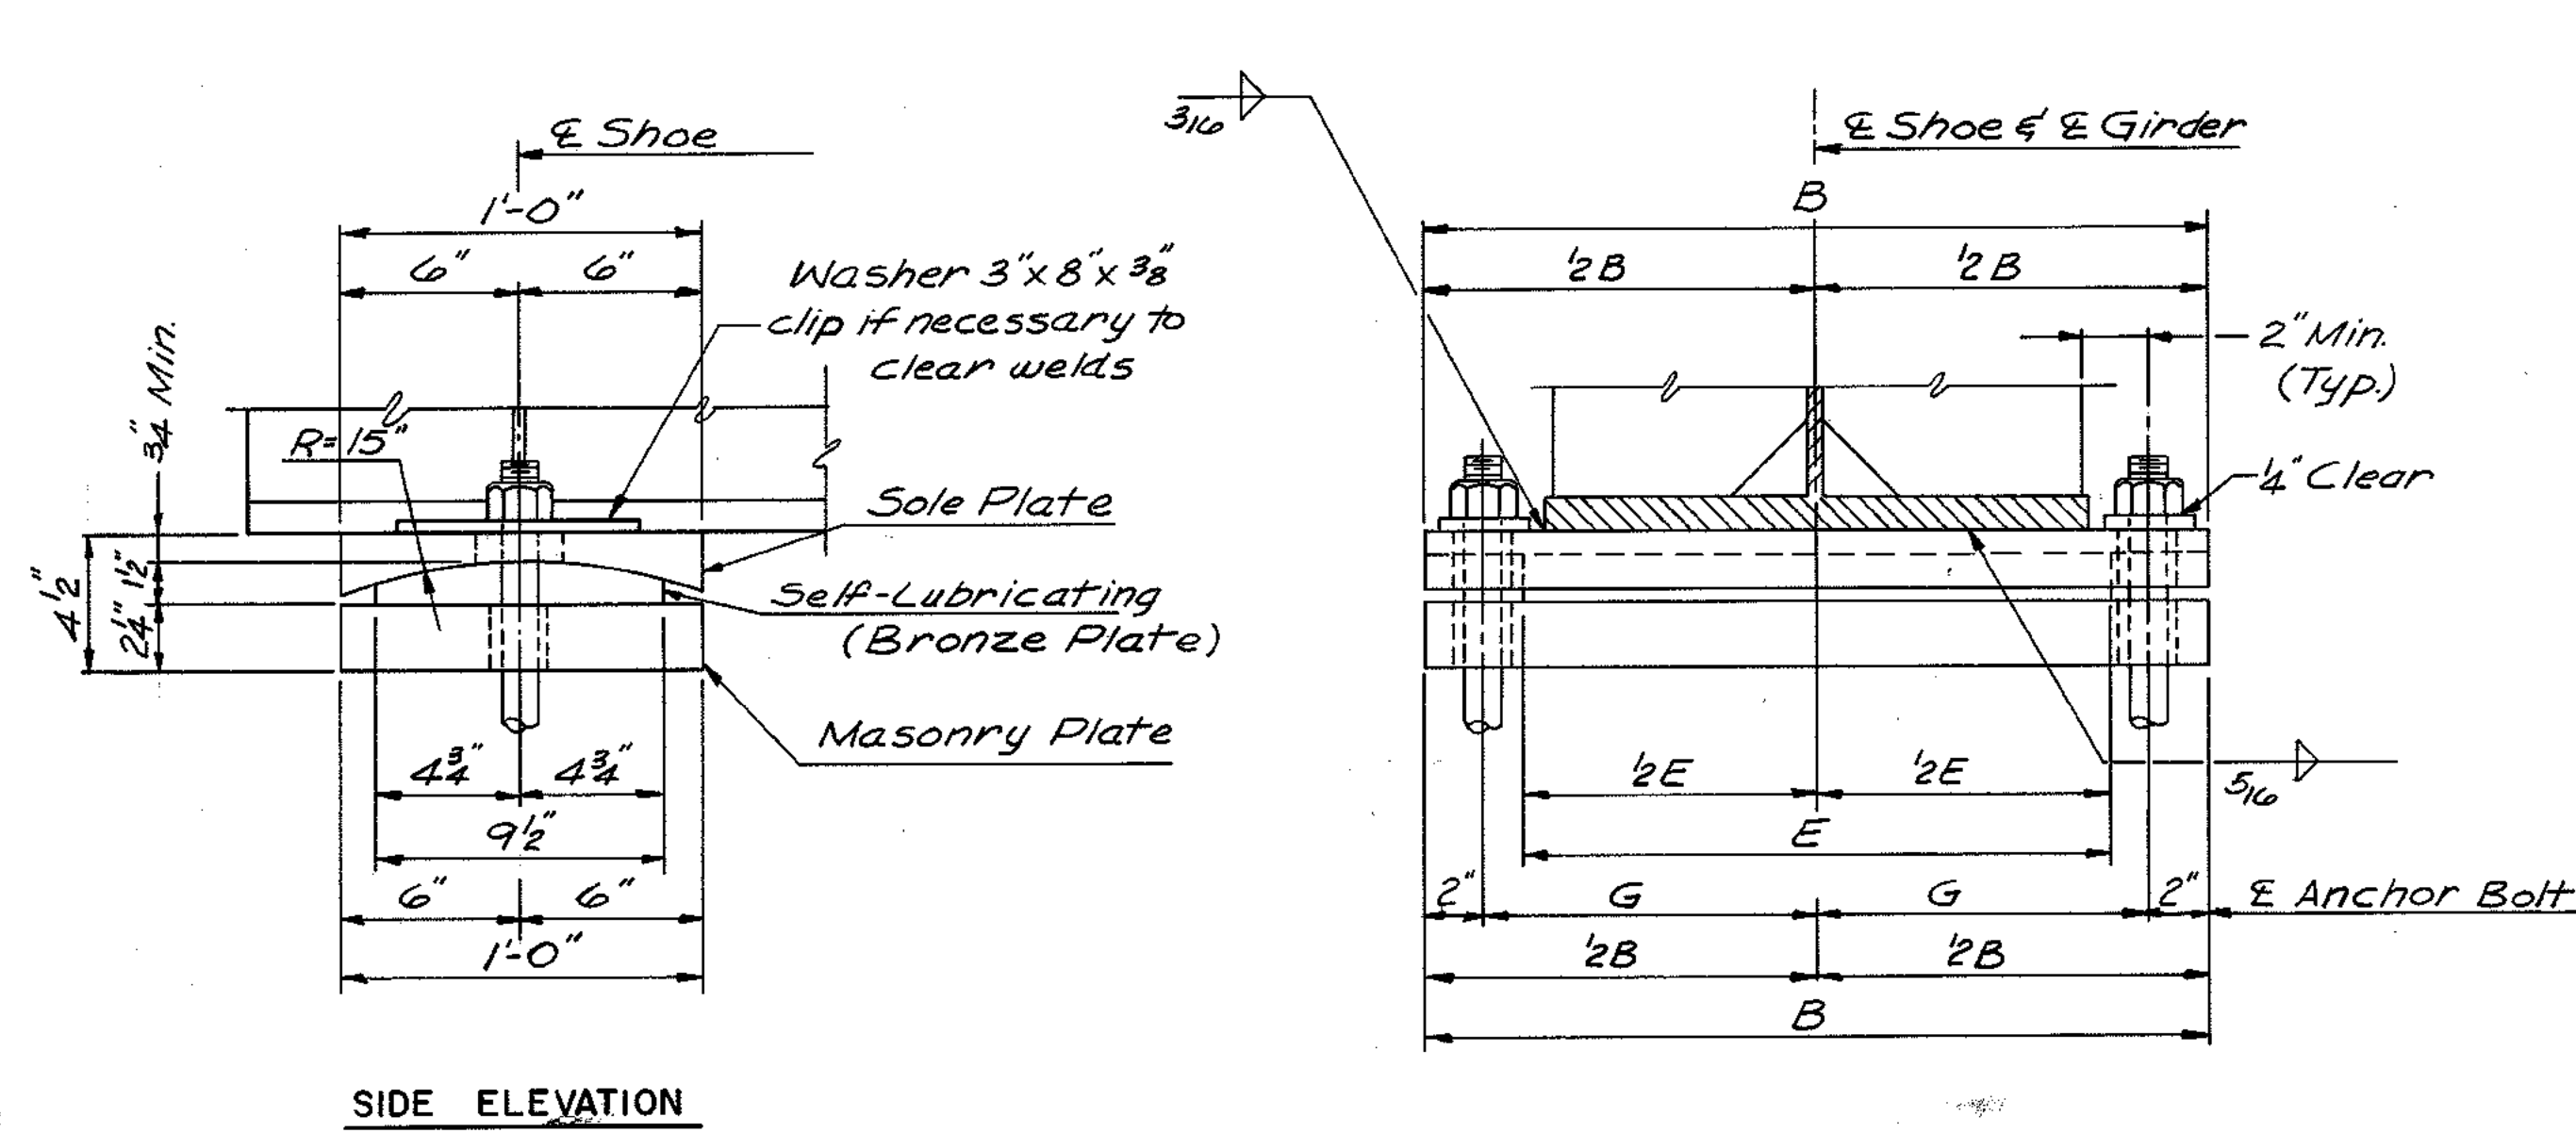


EXPANSION SHOE EB-2  
No Scale

FIXED SHOE  
No Scale

**NOTES:**  
Fill slots and holes in masonry plate around anchor bolts with a nonhardening caulking compound or elastic joint sealer. For expansion bearing, bevel sole plate to match grade.  
Steel in bearing may be ASTM A36, A572, Grade 50, or A588 and shall be painted. Surface of sole plate and masonry plate in contact with bronze plates shall not be painted, but coated with multipurpose grease before shipment. Prior to assembly in place these surfaces shall be thoroughly coated with additional antioxidant lubricant furnished by the manufacturer.  
Radius may be machined to compensate for grade.  
Bearing shall be set so that at 68°F, it is at the midpoint of its movement.  
For Expansion bearing, 15" Radius tolerances:  
Sole Plate - 0" + .01"  
Bronze Plate - .01" + 0"

EXPANSION SHOES												
SHOE TYPE	NO. REQ'D	A	B	C	D	E	F	G	H	J	L	
EB-2-16	24		2'-0"			1'-5 1/2"		10"			1'-7"	
EB-2-18	18		2'-2"			1'-7 1/2"		11"			1'-7"	
EB-2-20	66		2'-4"			1'-9 1/2"		1'-0"			1'-7"	

FIXED SHOES												
SHOE TYPE	NO. REQ'D	A	B	C	D	E	F	G	H	J	L	
FB-8-16	24		2'-0"			8"	10"	1 1/2"	2 3/4"	1'-2"		
FB-9-18	18		2'-2"			9"	11"	1 1/2"	4 1/2"	1'-2 1/4"		
FB-9-20	66		2'-4"			9"	1'-0"	1 1/2"	4 1/2"	1'-2 1/4"		

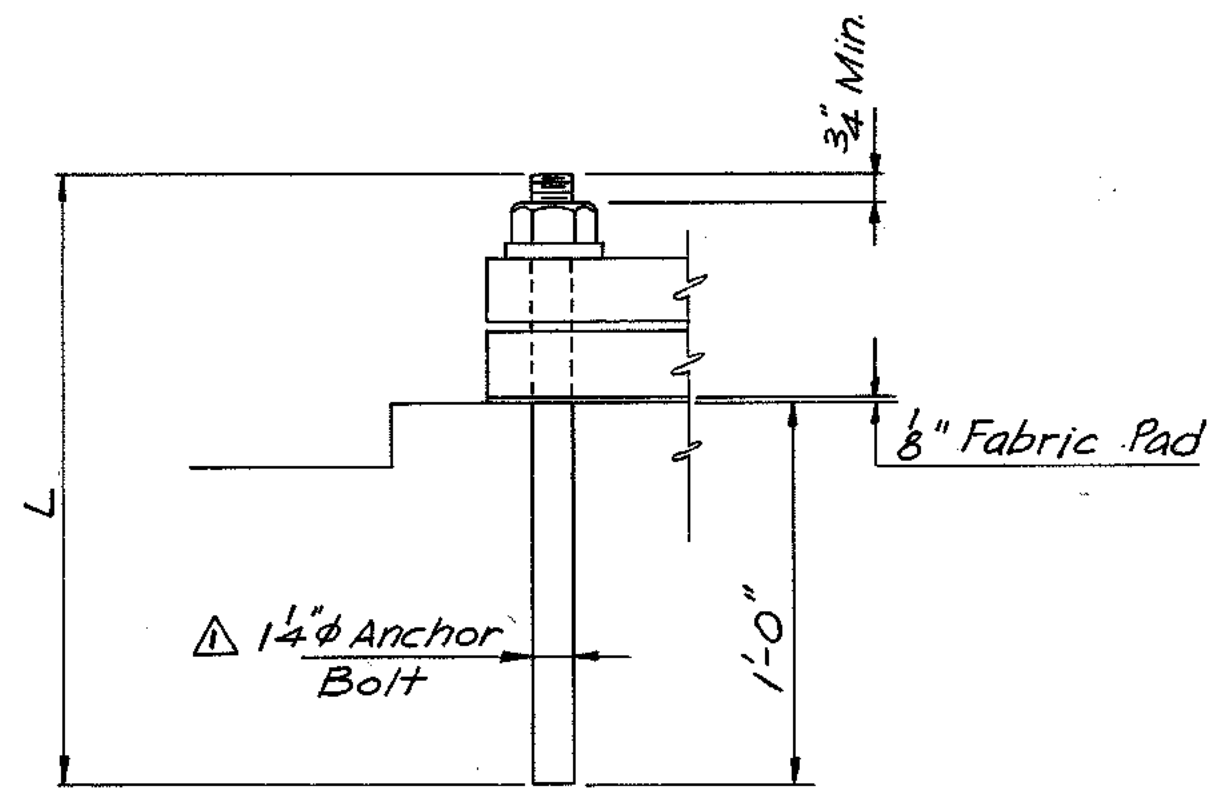

ANCHOR BOLT DETAIL  
No Scale

BY	DATE	REVISION	BY	DATE
MADE	ALC 2-87	As Built	TEM	3-89
CHECKED	TFP 3-87	1 1/4" Anchor Bolt	ALC	4-87
IN CHARGE	S.R.			




AS BUILT

RICHMOND METROPOLITAN AUTHORITY  
RICHMOND EXPRESSWAY SYSTEM

SHOE DETAILS

HOWARD, NEEDLES, TAMMEN & BERGENDOFF  
consulting engineers  
Alexandria, Virginia  
SCALE: AS SHOWN  
CONTRACT NO. C-13  
SHEET NO. 46 OF 106

RICHMOND EXPRESSWAY SYSTEM			
SECTION	PROJECT	SHEET NO.	TOTAL SHEETS
13	WIDENING JAMES RIVER BRIDGE	51	106

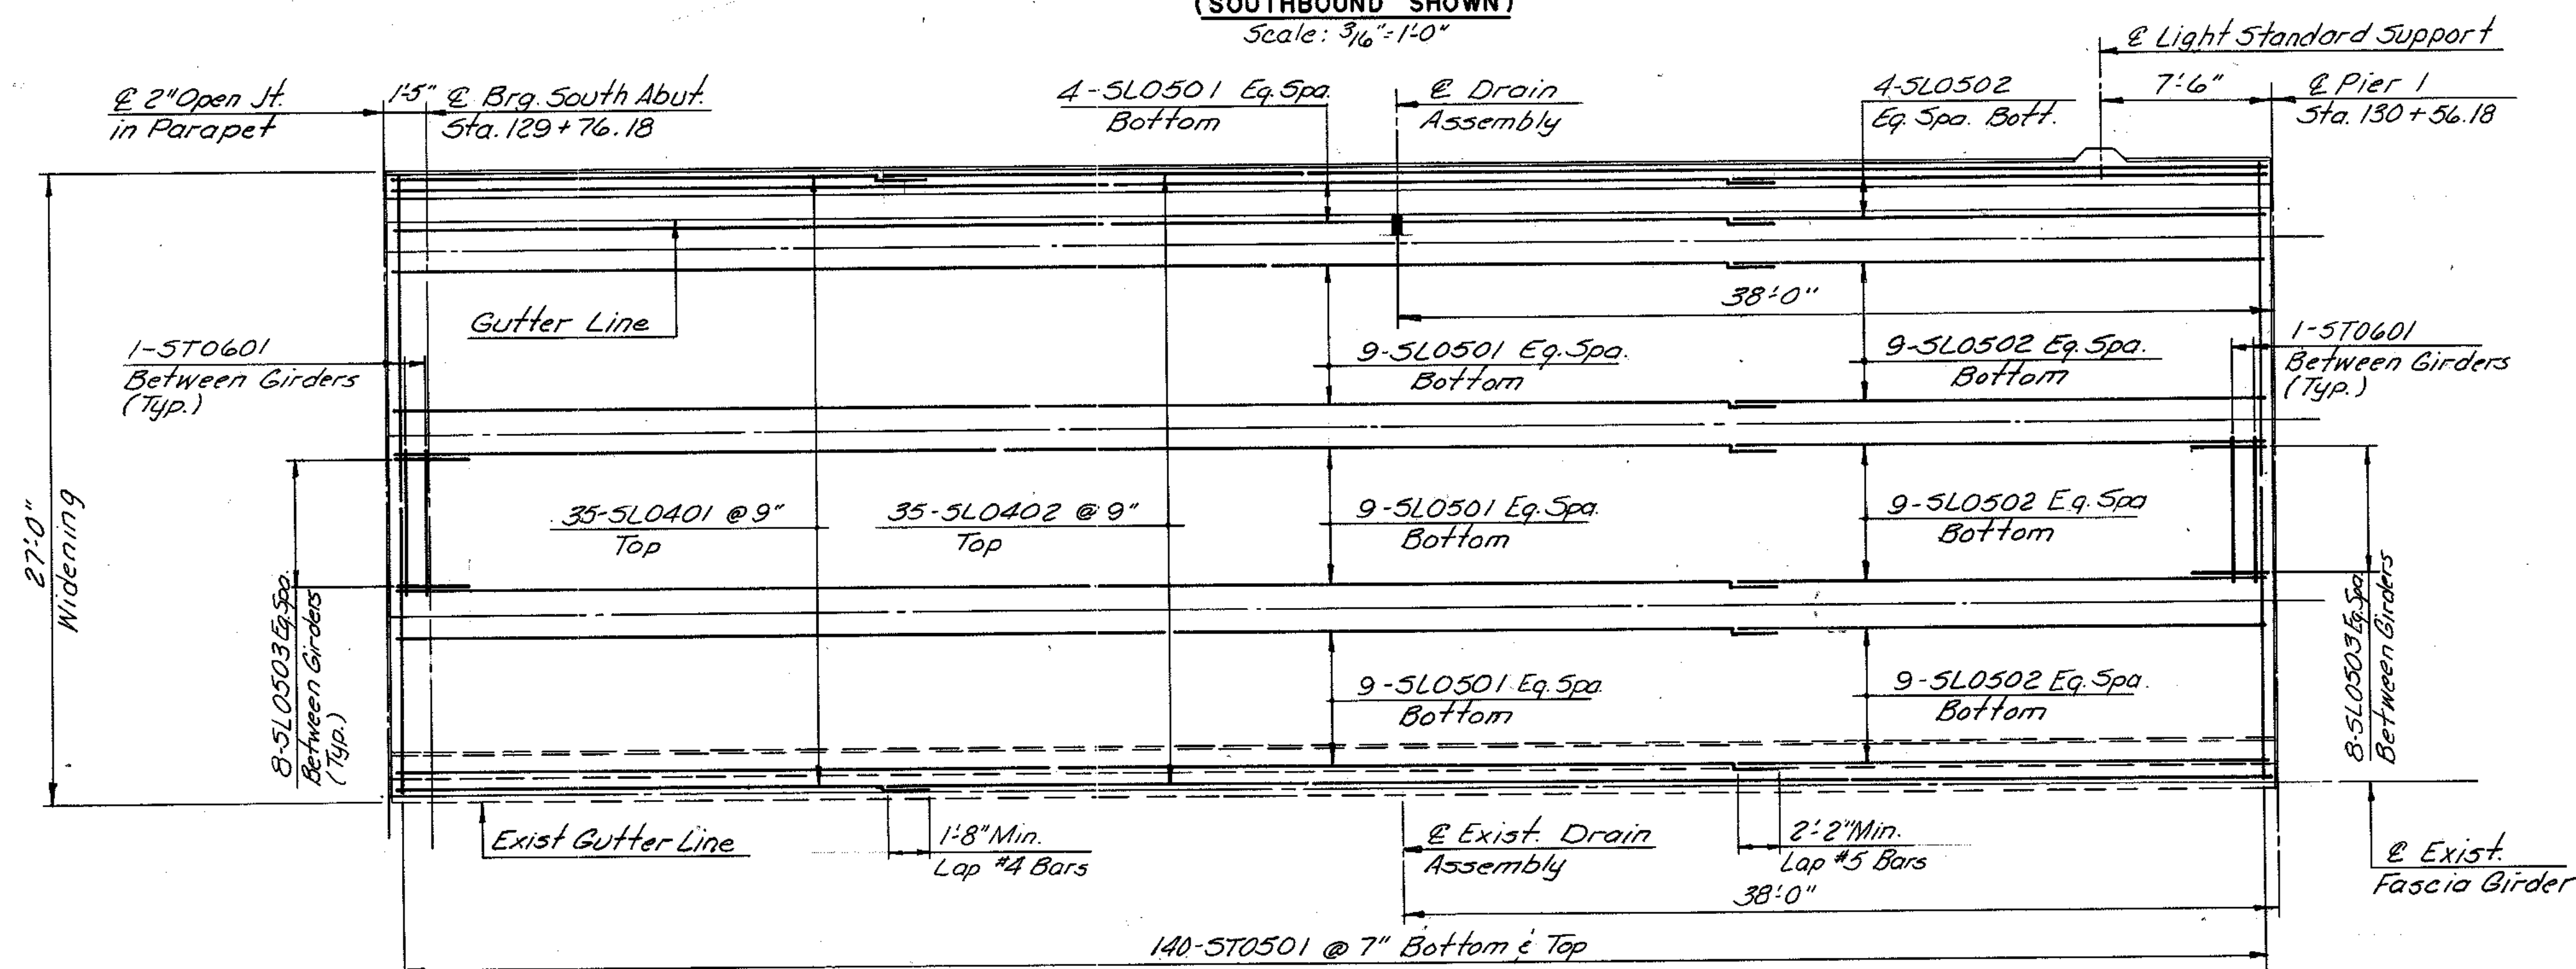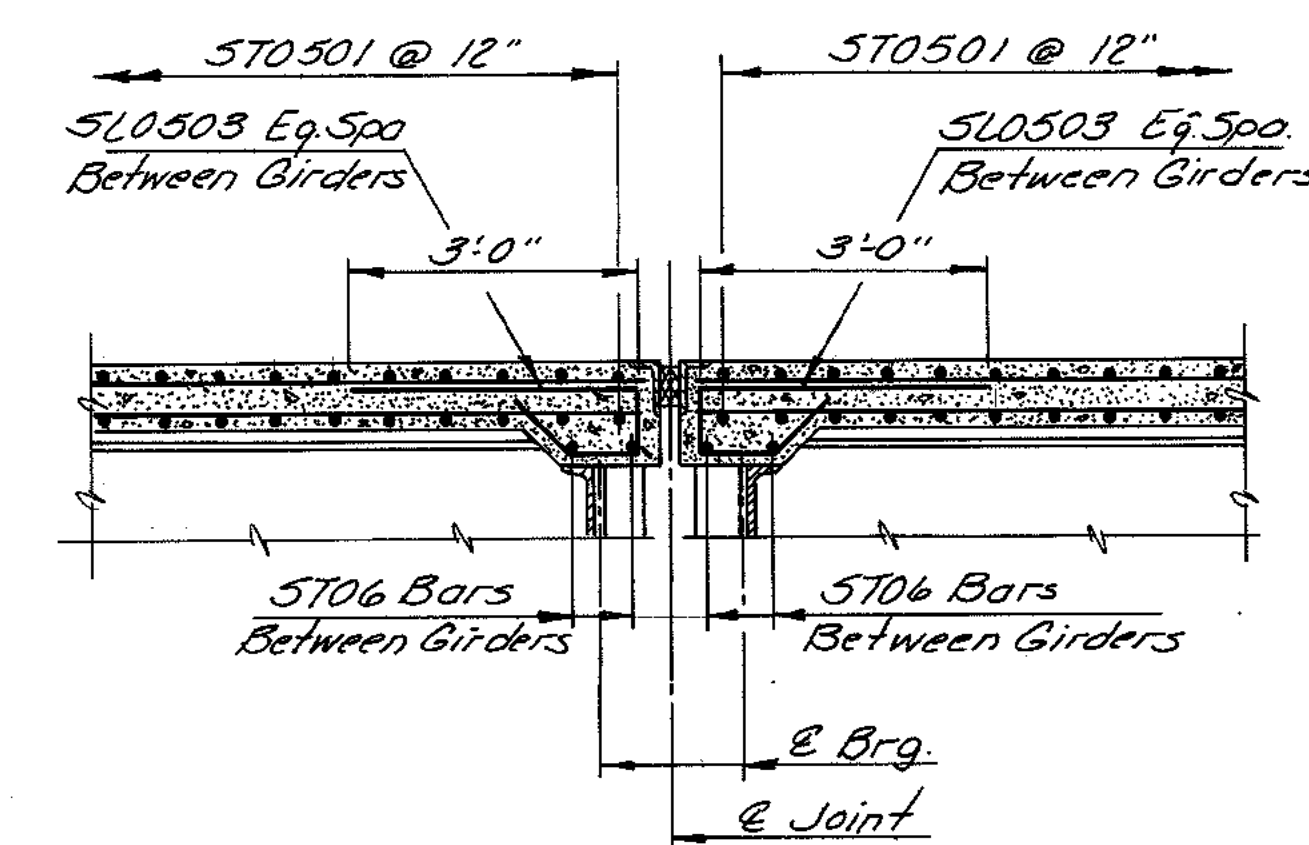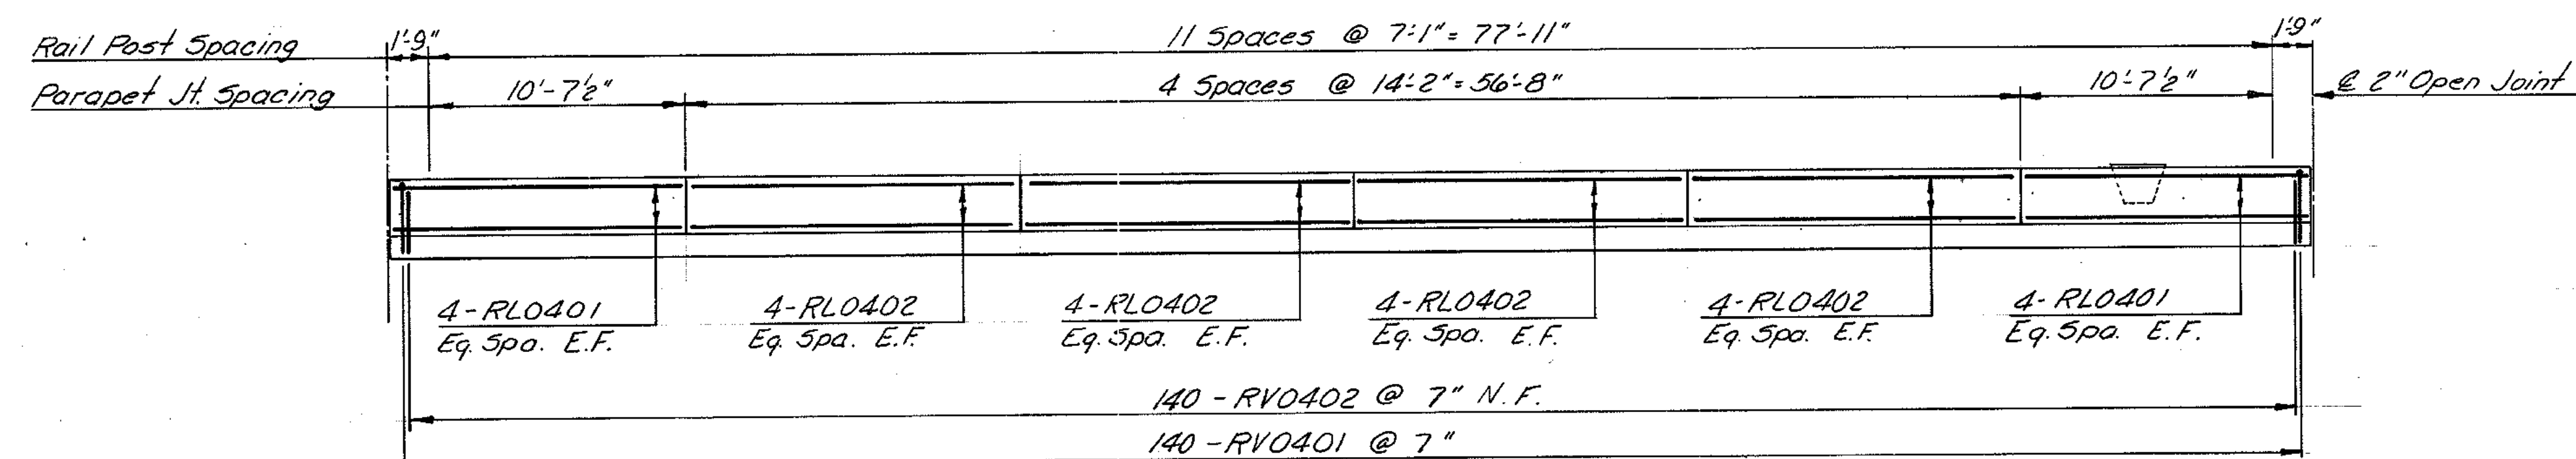

BY	DATE				
MADE	TAL	3-87			
CHECKED	T.F.R.	3-87	As Built	TEM	3-89
IN CHARGE	S.R.		NO.	REVISION	BY DATE

AS BUILT

RICHMOND METROPOLITAN AUTHORITY  
RICHMOND EXPRESSWAY SYSTEM


DECK PLAN  
UNIT I SOUTHBOUND & NORTHBOUND

HOWARD, NEEDLES, TAMMEN & BERGENDOFF  
consulting engineers  
Alexandria, Virginia


SCALE: AS SHOWN  
CONTRACT NO.: C-13  
SHEET NO. 51 OF 106



RICHMOND EXPRESSWAY SYSTEM			
SECTION	PROJECT	SHEET NO.	TOTAL SHEETS
13	WIDENING JAMES RIVER BRIDGE	52	106

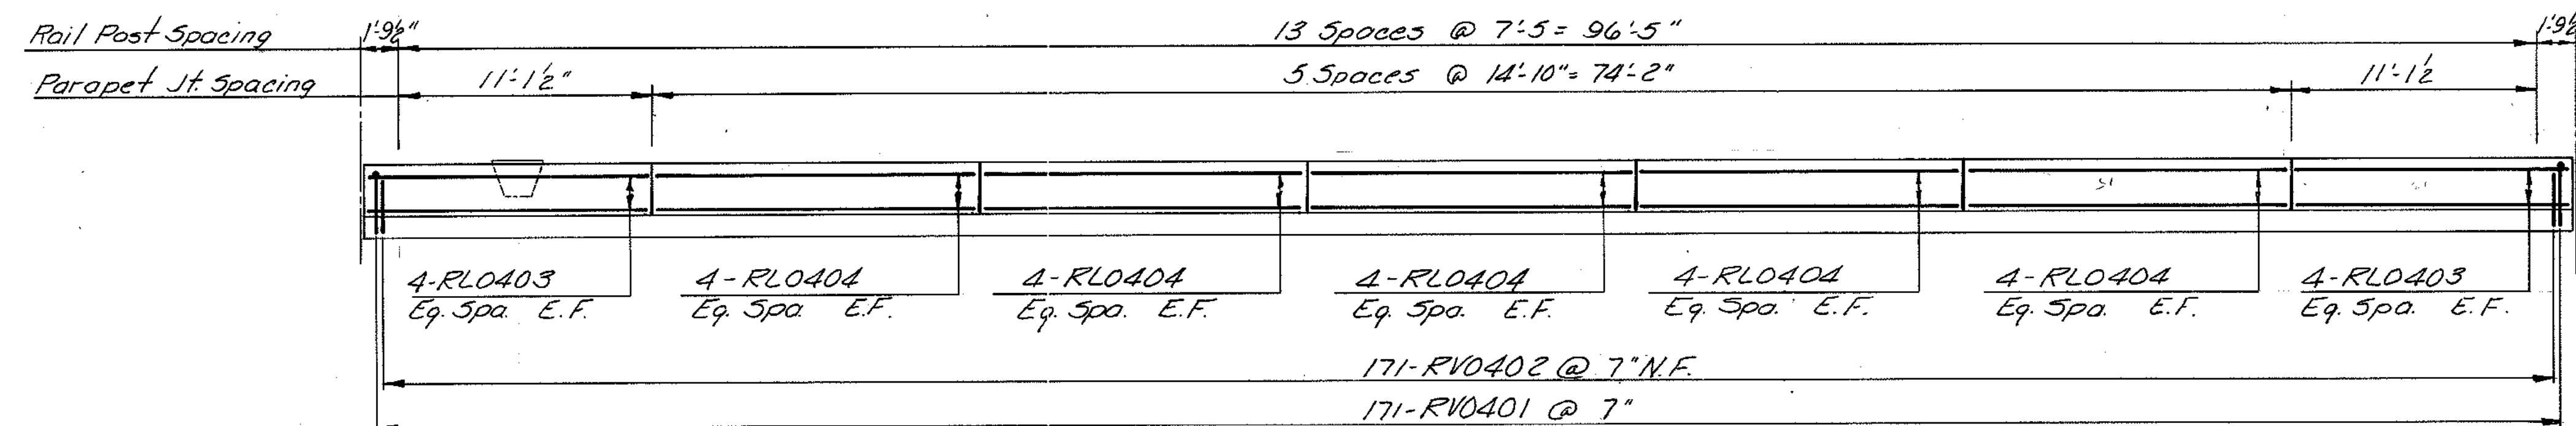

PARAPET ELEVATION - UNITS 2 & 3 SOUTHBOUND & NORTHBOUND  
(SOUTHBOUND SHOWN)  
Scale: 3/16" = 1'-0"

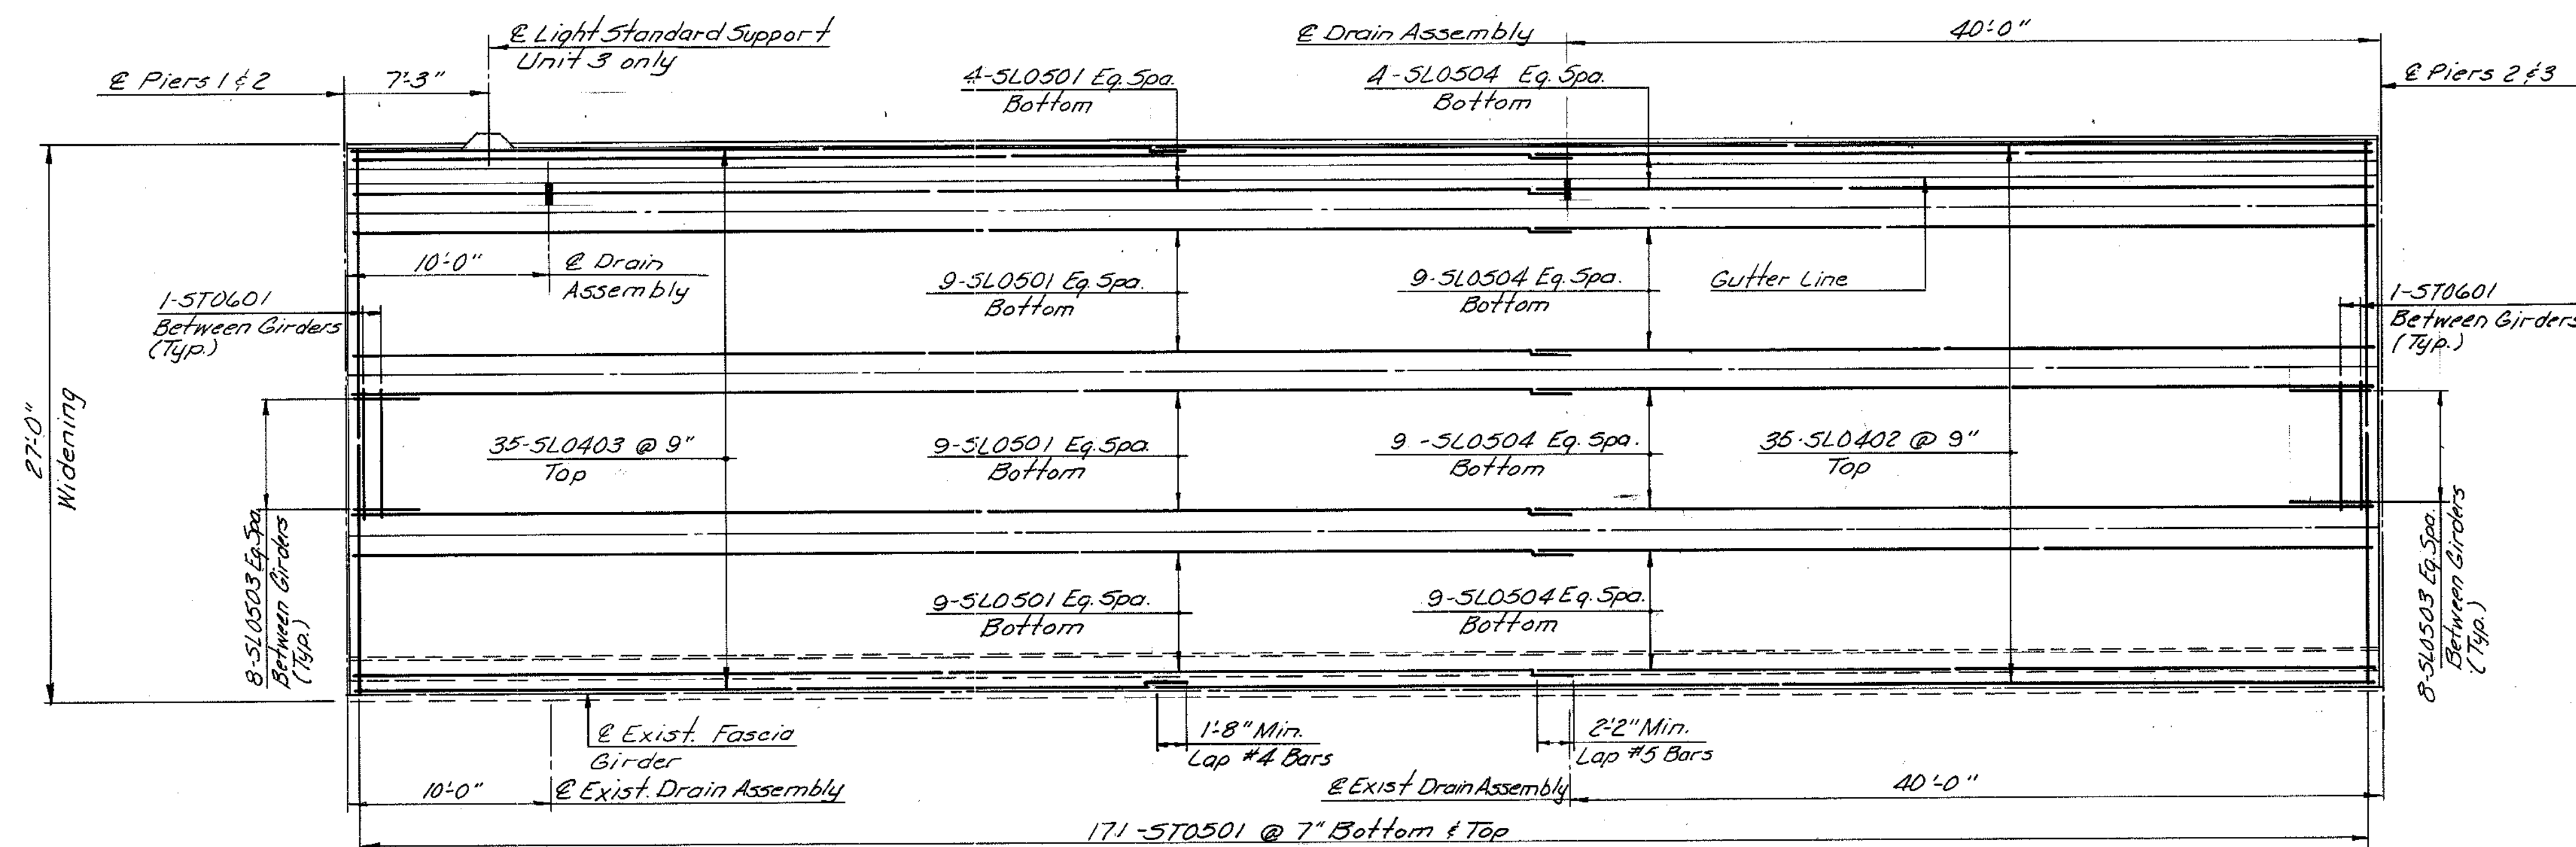

DECK PLAN - UNITS 2 & 3 SOUTHBOUND & NORTHBOUND  
(SOUTHBOUND SHOWN)  
Scale: 3/16" = 1'-0"

BY	DATE				
MADE	TAL	3-87			
CHECKED	TEP	3-87	As Built	TEM	3-89
IN CHARGE	S.R.				

AS BUILT

RICHMOND METROPOLITAN AUTHORITY  
RICHMOND EXPRESSWAY SYSTEM


DECK PLAN  
UNITS 2 & 3 SOUTHBOUND & NORTHBOUND

HOWARD, NEEDLES, TAMMEN & BERGENDOFF  
consulting engineers  
Alexandria, Virginia


SCALE: AS SHOWN  
CONTRACT NO.: C-13  
SHEET NO. 52 OF 106




RICHMOND EXPRESSWAY SYSTEM			
SECTION	PROJECT	SHEET NO.	TOTAL SHEETS
13	WIDENING JAMES RIVER BRIDGE	54	106

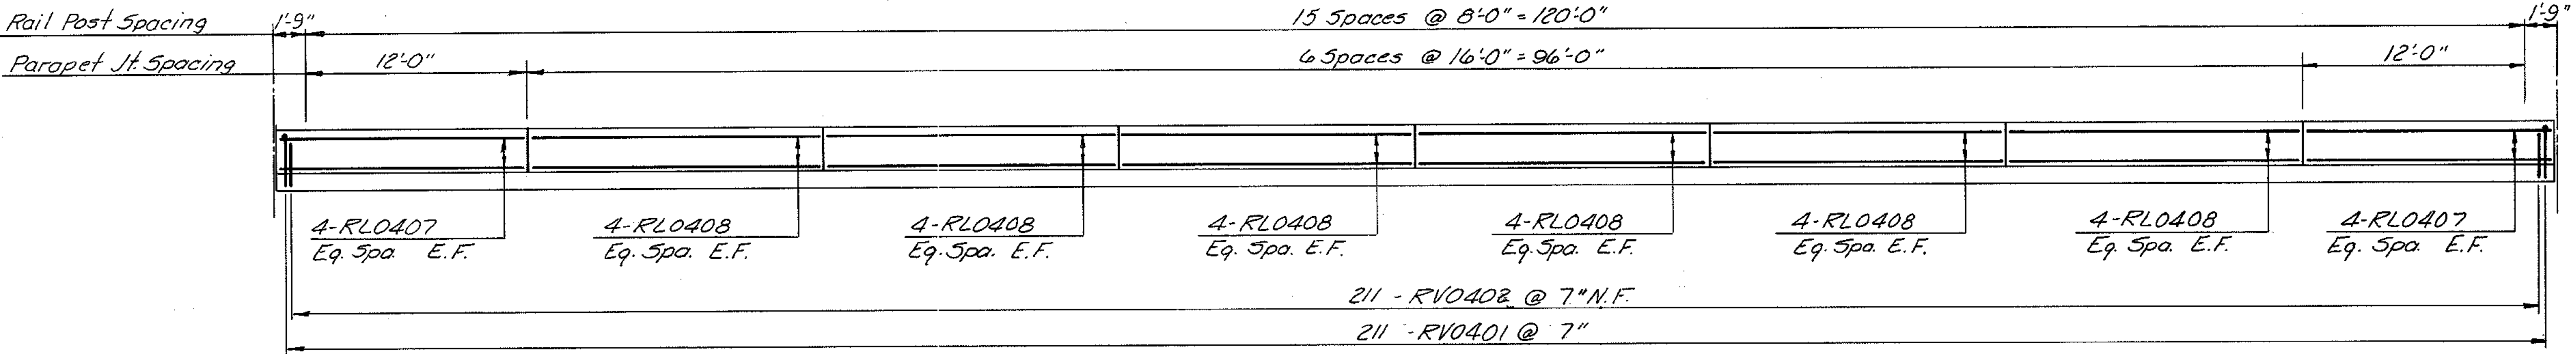

PARAPET ELEVATION - UNITS 5 THRU 12 SOUTHBOUND & NORTHBOUND  
(SOUTHBOUND SHOWN)  
Scale: 3/16"=1'-0"

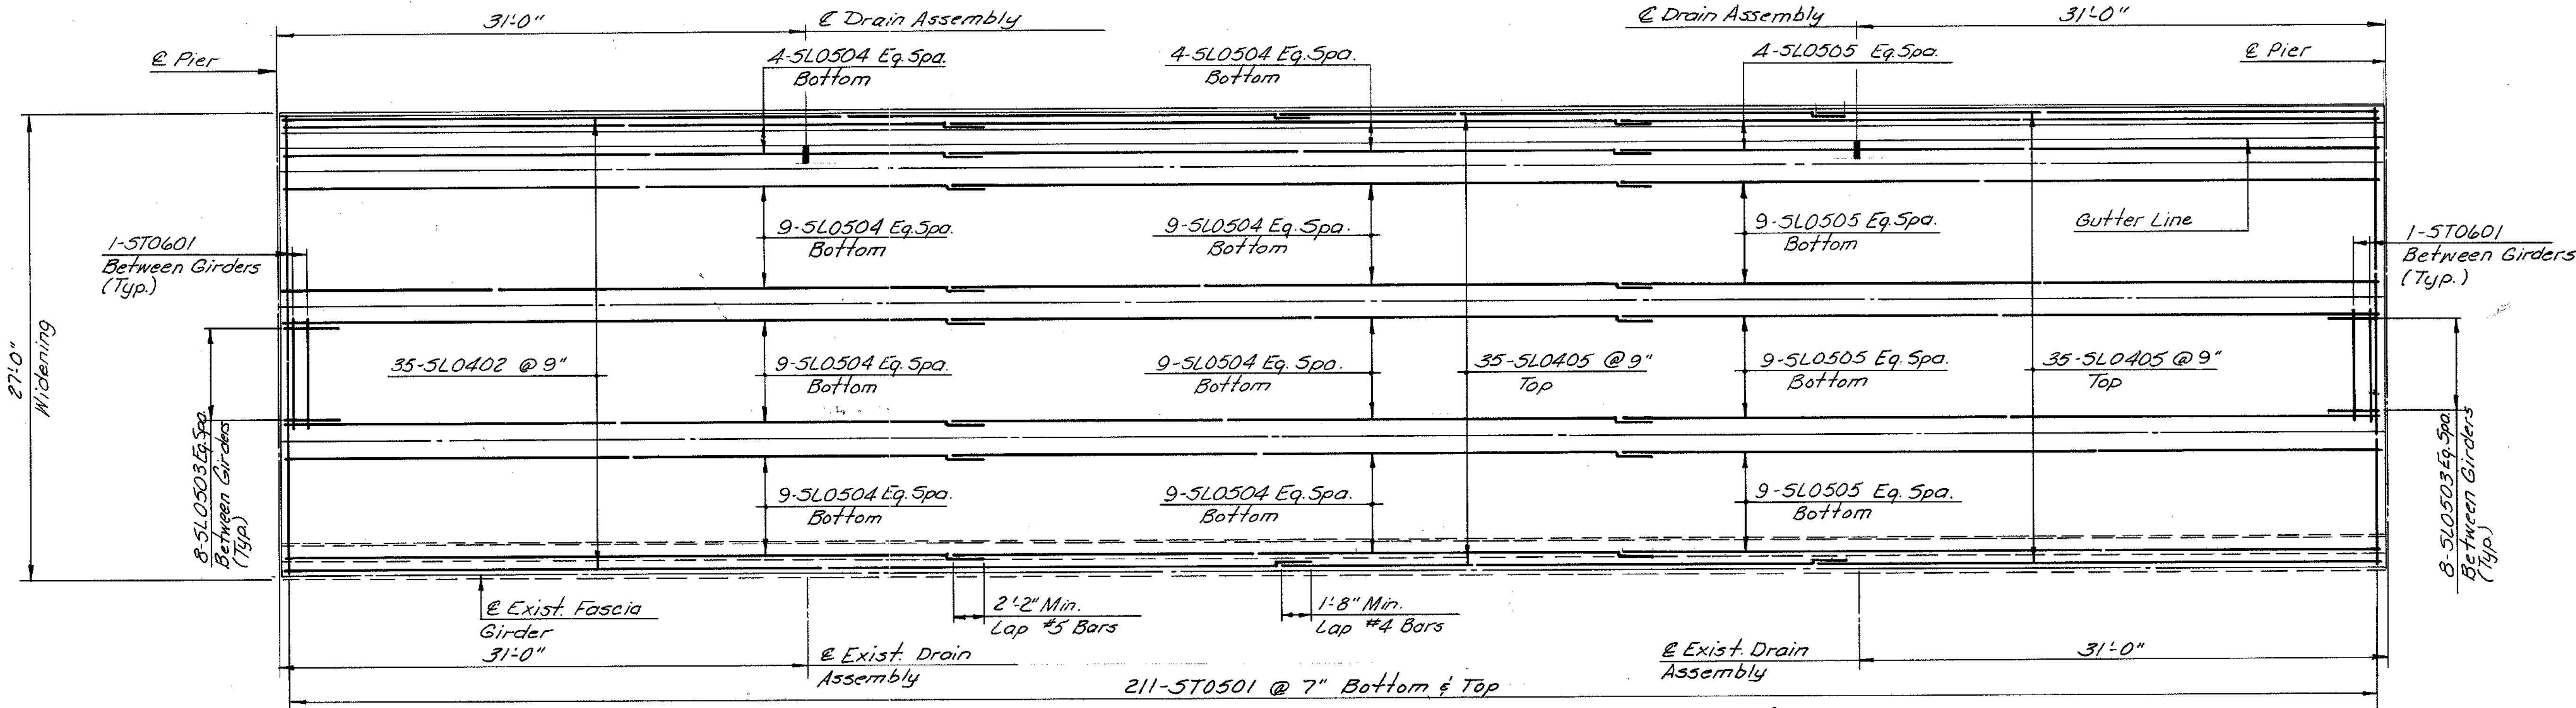

DECK PLAN - UNITS 5 THRU 12 SOUTHBOUND & NORTHBOUND  
(SOUTHBOUND SHOWN)  
Scale: 3/16"=1'-0"

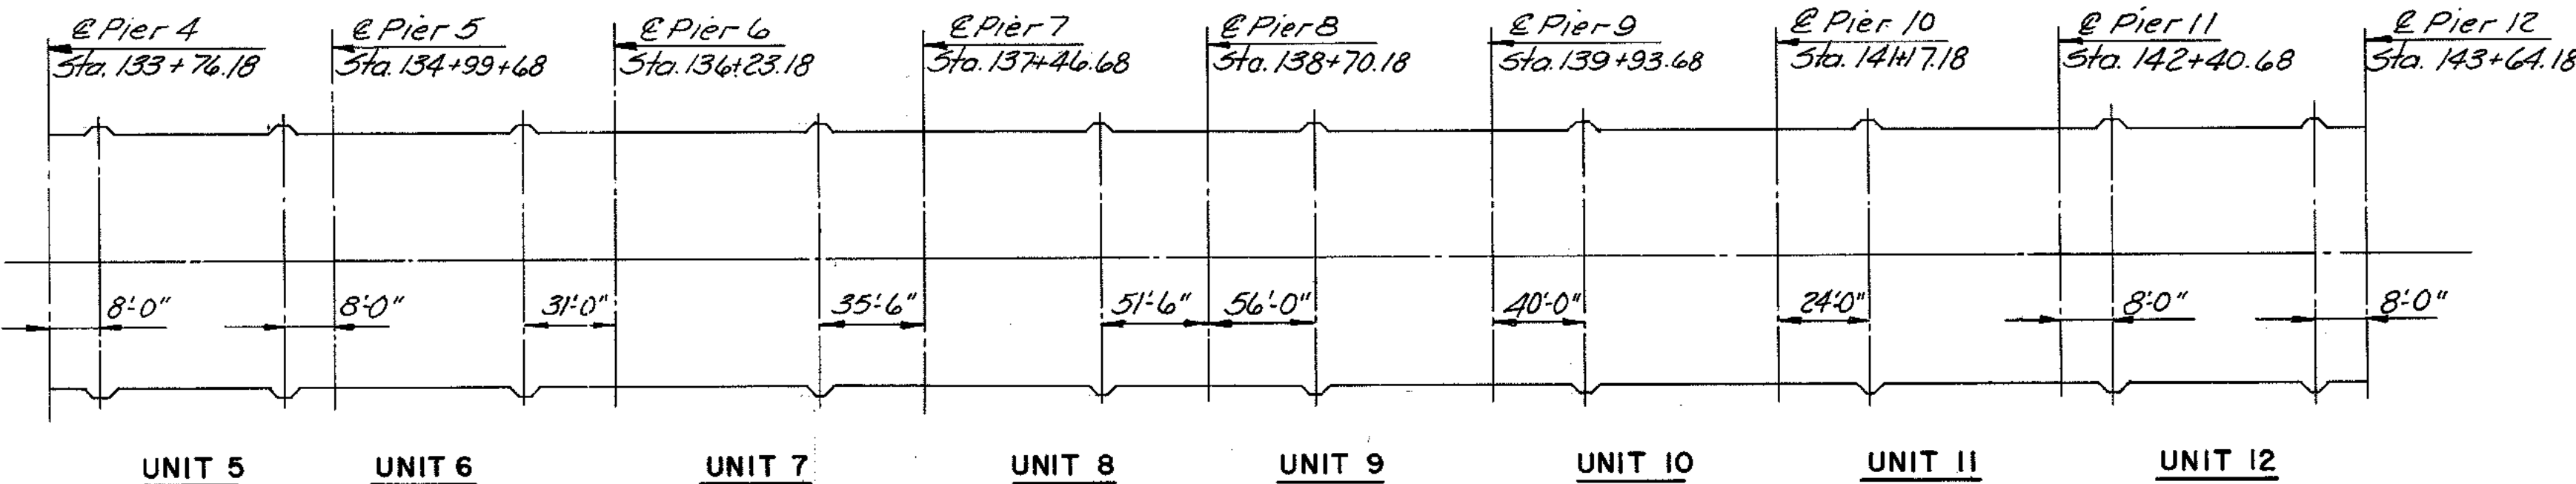

LIGHTING STANDARD LOCATIONS FOR UNITS 5 THRU 12  
No Scale

AS BUILT

BY	DATE				
MADE	TAL	3-87			
CHECKED	TRP	3-87	As Built	TEM	3-89
IN CHARGE	S.R.				


RICHMOND METROPOLITAN AUTHORITY  
RICHMOND EXPRESSWAY SYSTEM

DECK PLAN  
UNITS 5 THRU 12 SOUTHBOUND & NORTHBOUND


HOWARD, NEEDLES, TAMMEN & BERGENDOFF  
consulting engineers  
Alexandria, Virginia

SCALE: AS SHOWN  
CONTRACT NO.: C-13  
SHEET NO. 54 of 106

RICHMOND EXPRESSWAY SYSTEM			
SECTION	PROJECT	SHEET NO.	TOTAL SHEETS
13	WIDENING JAMES RIVER BRIDGE	55	106

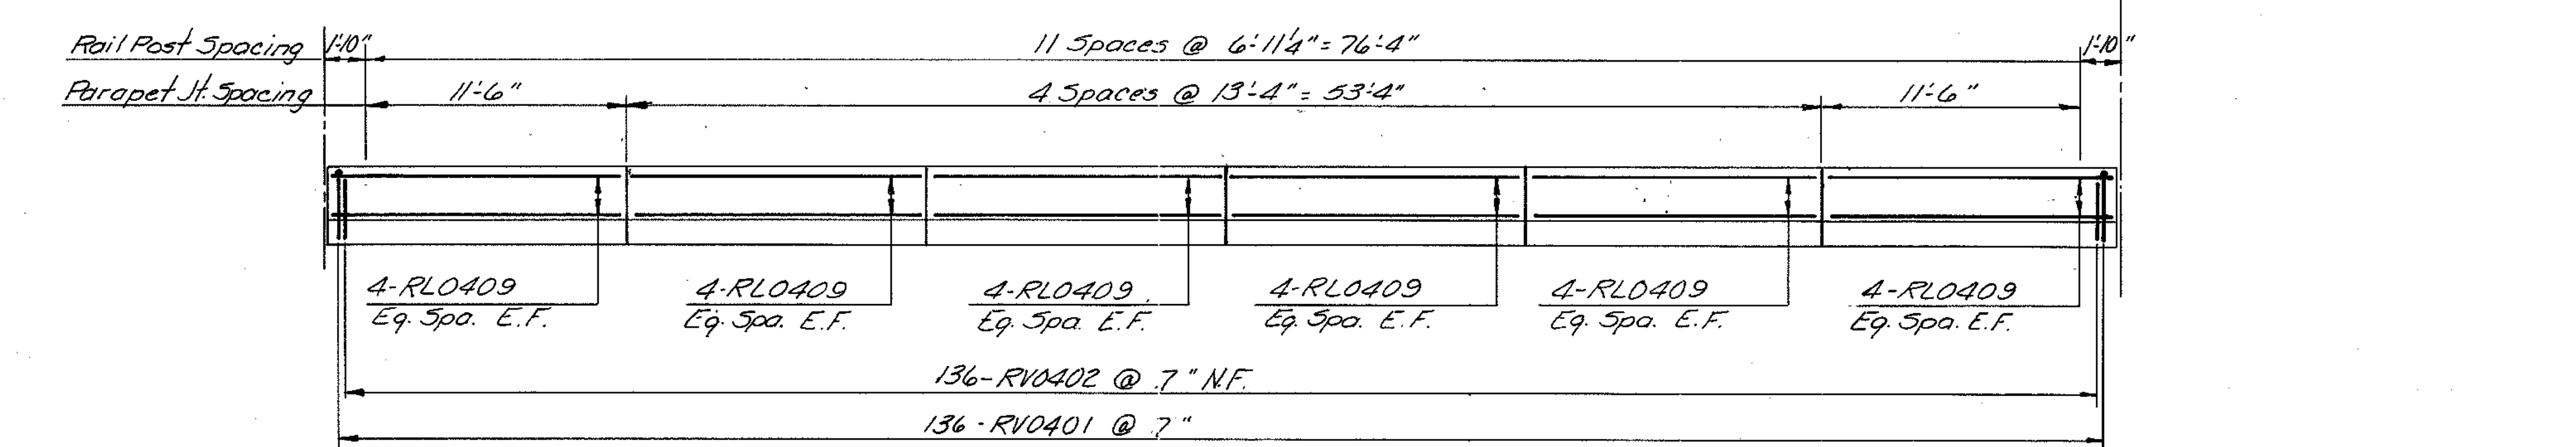

PARAPET ELEVATION - UNIT 13 SOUTHBOUND  
Scale: 3/16" = 1'-0"

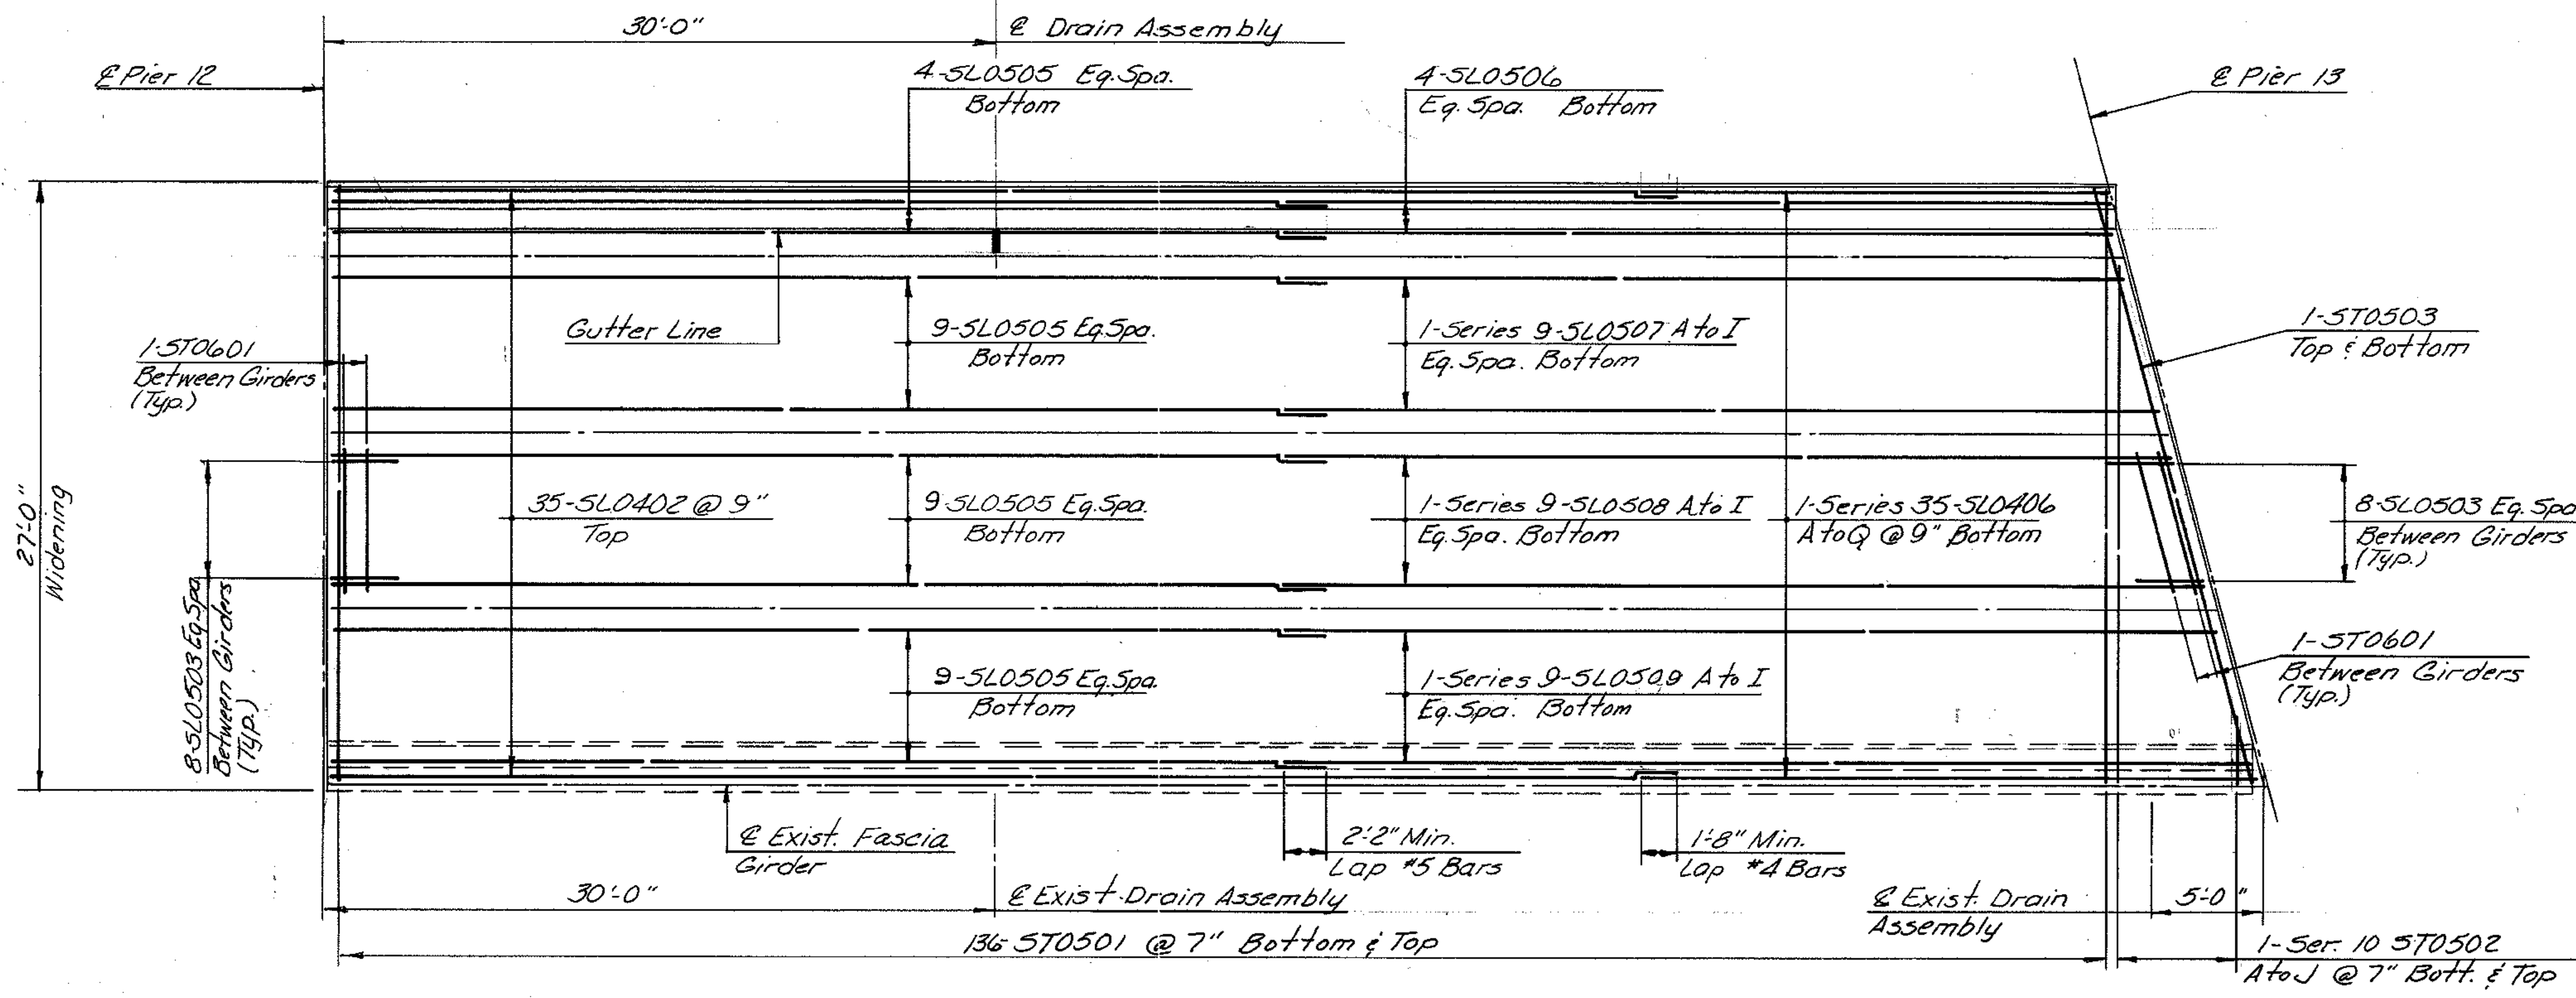

DECK PLAN - UNIT 13 SOUTHBOUND  
Scale: 3/16" = 1'-0"



MADE	CHECKED	IN CHARGE	BY	DATE	NO.	REVISION	BY	DATE
TAL	TFP	SR		3-87		As Built	TEM	3-89

AS BUILT

RICHMOND METROPOLITAN AUTHORITY RICHMOND EXPRESSWAY SYSTEM	
DECK PLAN - UNIT 13 SOUTHBOUND	
HOWARD, NEEDLES, TAMMEN & BERGENDOFF consulting engineers Alexandria, Virginia	SCALE: AS SHOWN CONTRACT NO.: C-13 SHEET NO. 55 OF 106



SECTION	PROJECT	SHEET NO.	TOTAL SHEETS
13	WIDENING JAMES RIVER BRIDGE	56	106

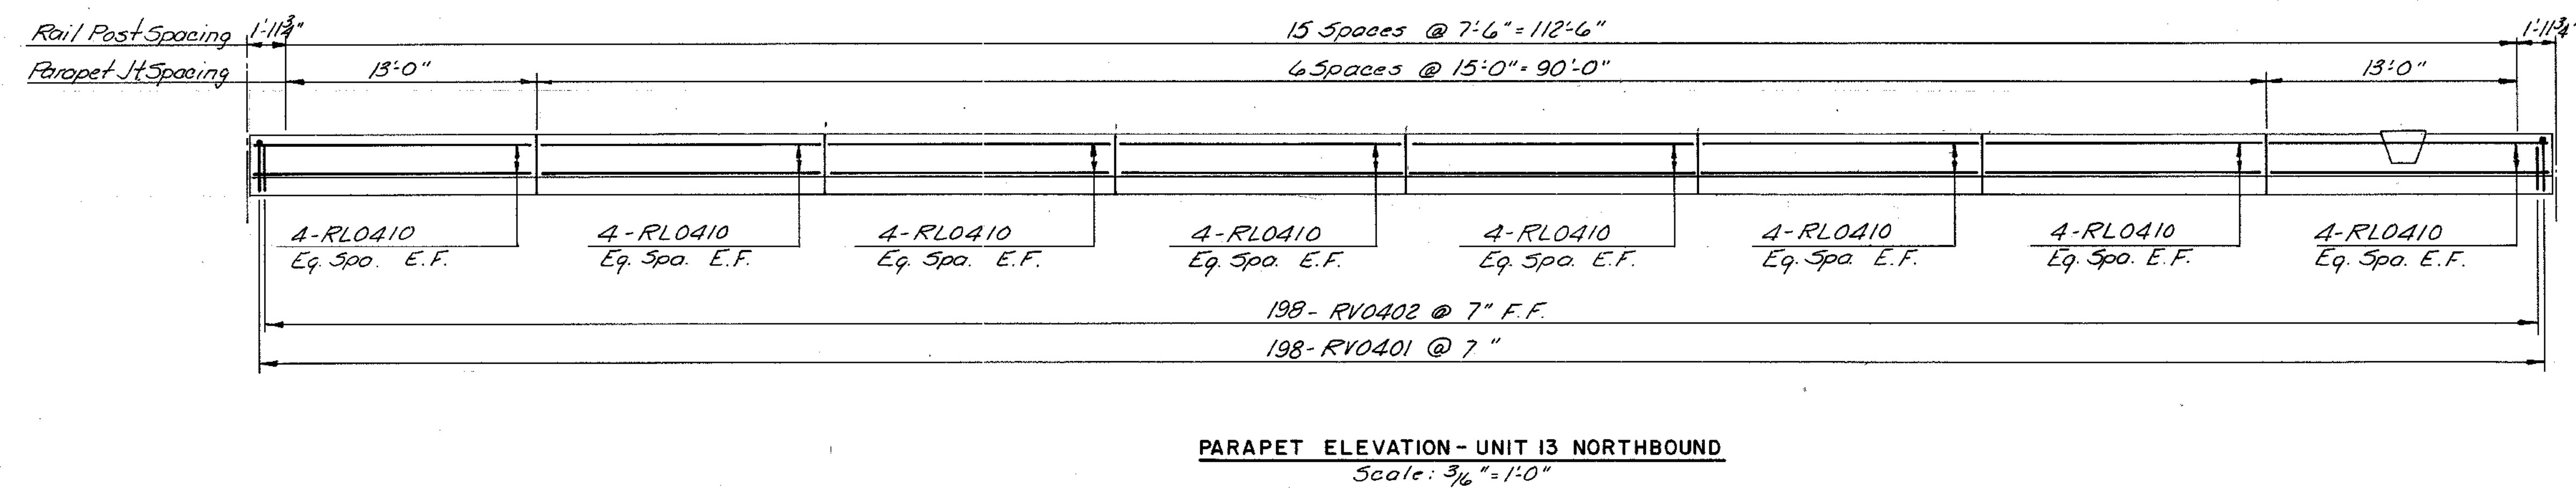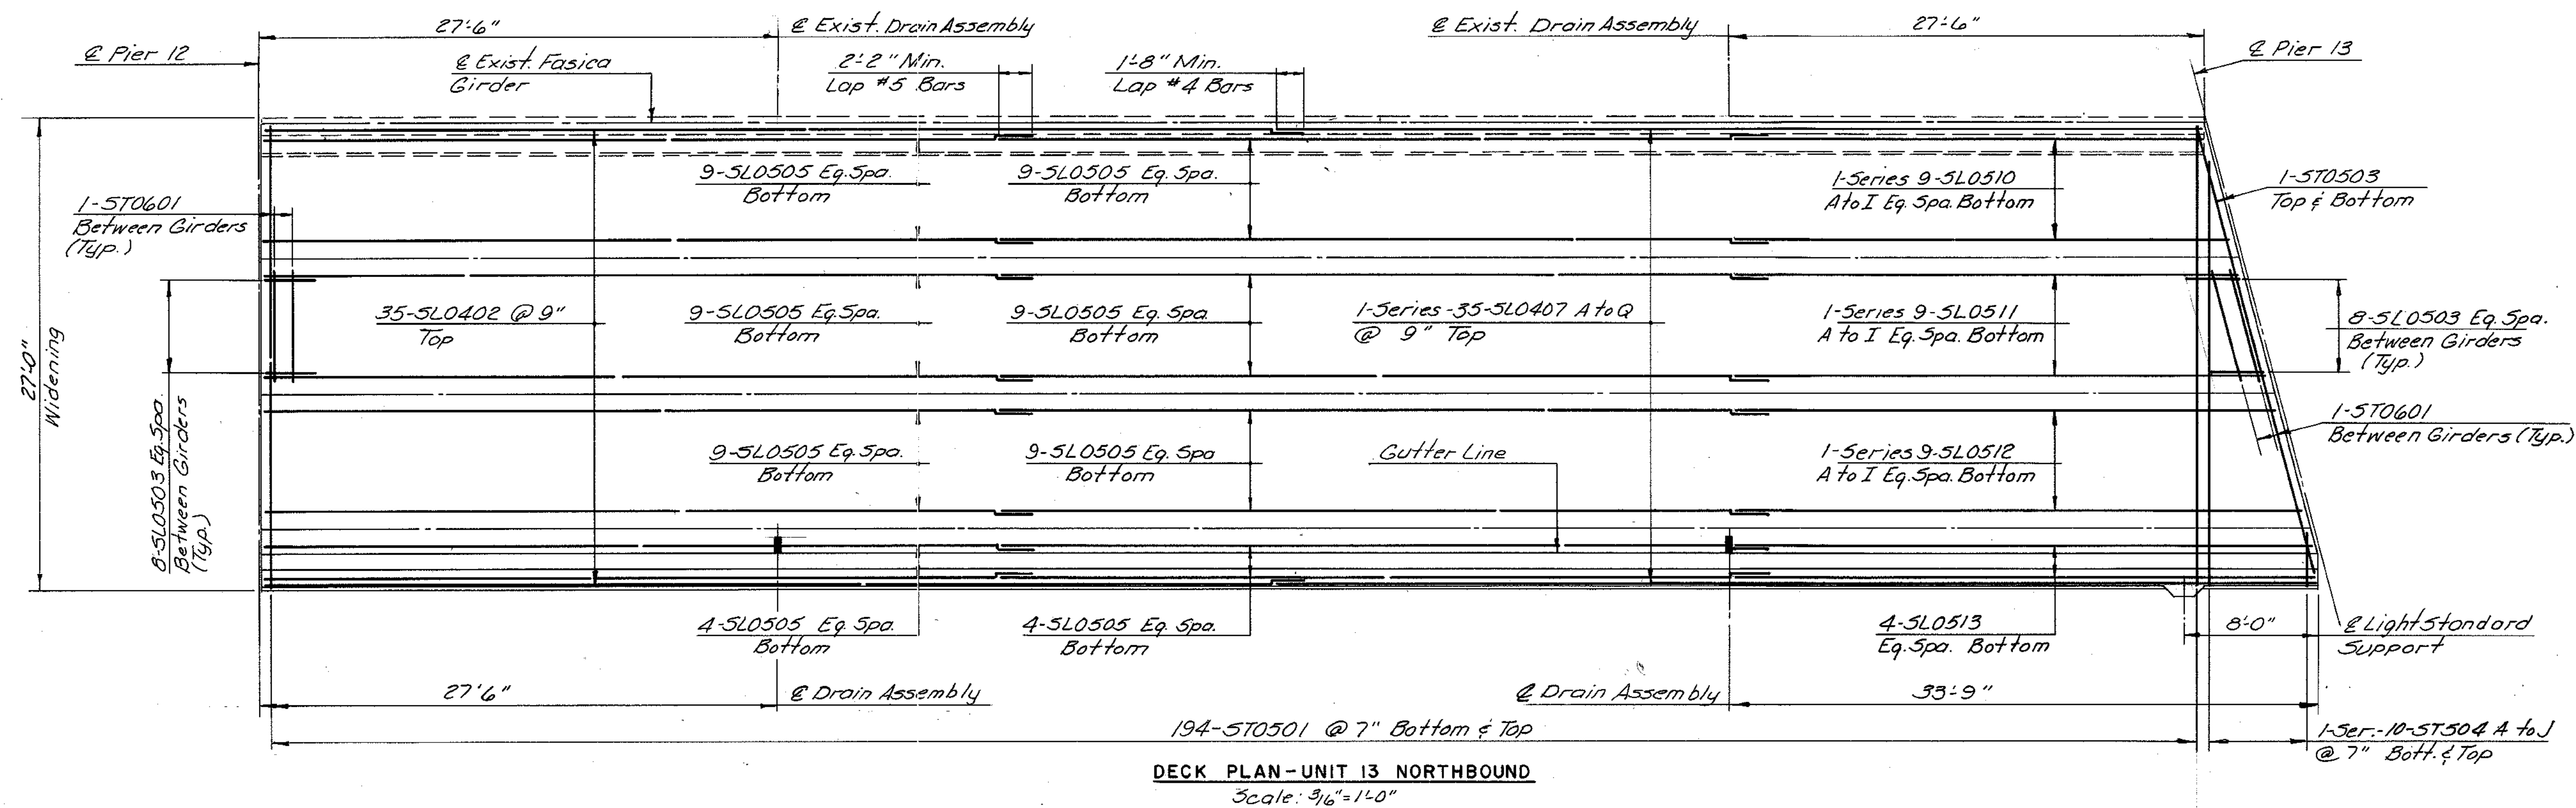

	BY	DATE				
MADE	TAL	3-87				
CHECKED	T.F.P.	3-87		As Built	TEM	3-89
IN CHARGE	S.R.		NO.	REVISION	BY	DATE

**RICHMOND METROPOLITAN AUTHORITY  
RICHMOND EXPRESSWAY SYSTEM**


DECK PLAN - UNIT 13 NORTHBOUND

HOWARD, NEEDLES, TAMMEN & BERGENDOFF  
consulting engineers  
Alexandria, Virginia

SCALE: AS SHOWN  
CONTRACT NO.: C-13  
SHEET NO. 56 OF 106

AS BUILT

RICHMOND EXPRESSWAY SYSTEM			
SECTION	PROJECT	SHEET NO.	TOTAL SHEETS
13	WIDENING JAMES RIVER BRIDGE	57	106

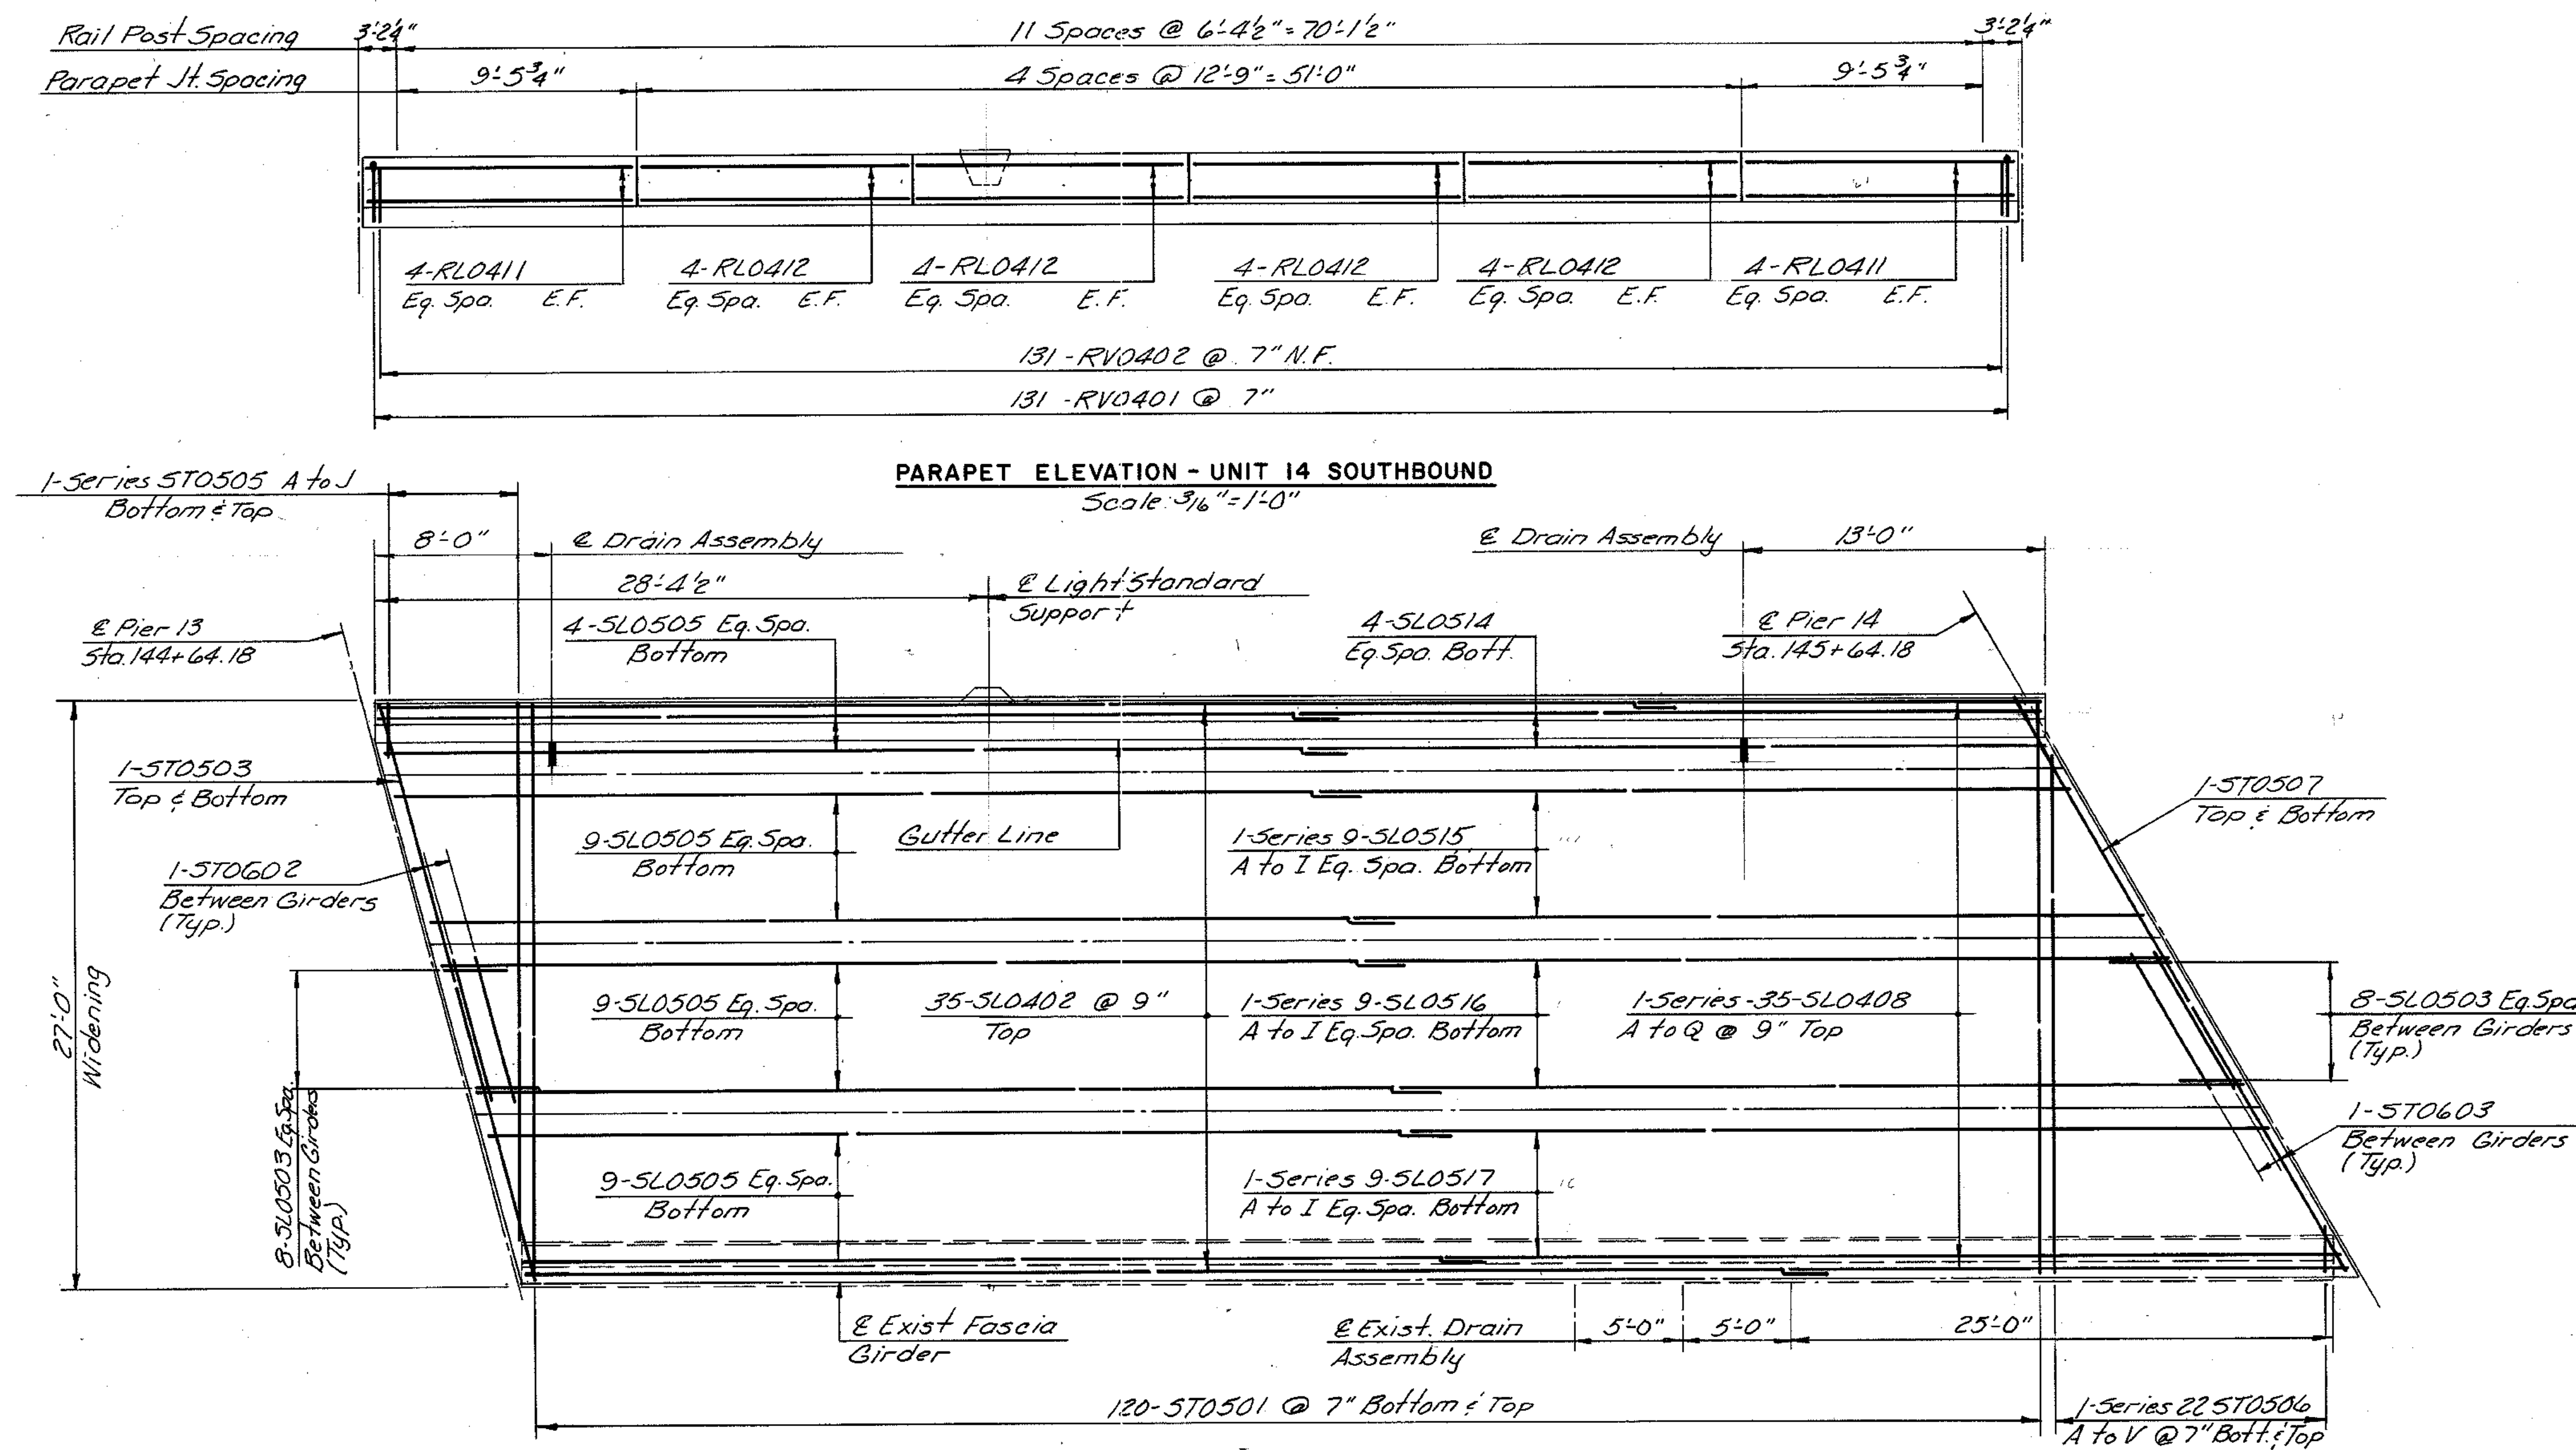

DECK PLAN - UNIT 14 SOUTHBOUND  
Scale: 3/16"=1'-0"

	BY	DATE			
MADE	TAL	3-87			
CHECKED	TRP	3-87	As Built	TEM	3-89
IN CHARGE	S.R.		NO.	REVISION	BY DATE

AS BUILT

RICHMOND METROPOLITAN AUTHORITY  
RICHMOND EXPRESSWAY SYSTEM


DECK PLAN - UNIT 14 SOUTHBOUND

HOWARD, NEEDLES, TAMMEN & BERGENDOFF  
consulting engineers  
Alexandria, Virginia


SCALE: AS SHOWN  
CONTRACT NO.: C-13  
SHEET NO. 57 OF 106



RICHMOND EXPRESSWAY SYSTEM			
SECTION	PROJECT	SHEET NO.	TOTAL SHEETS
13	WIDENING JAMES RIVER BRIDGE	59	106

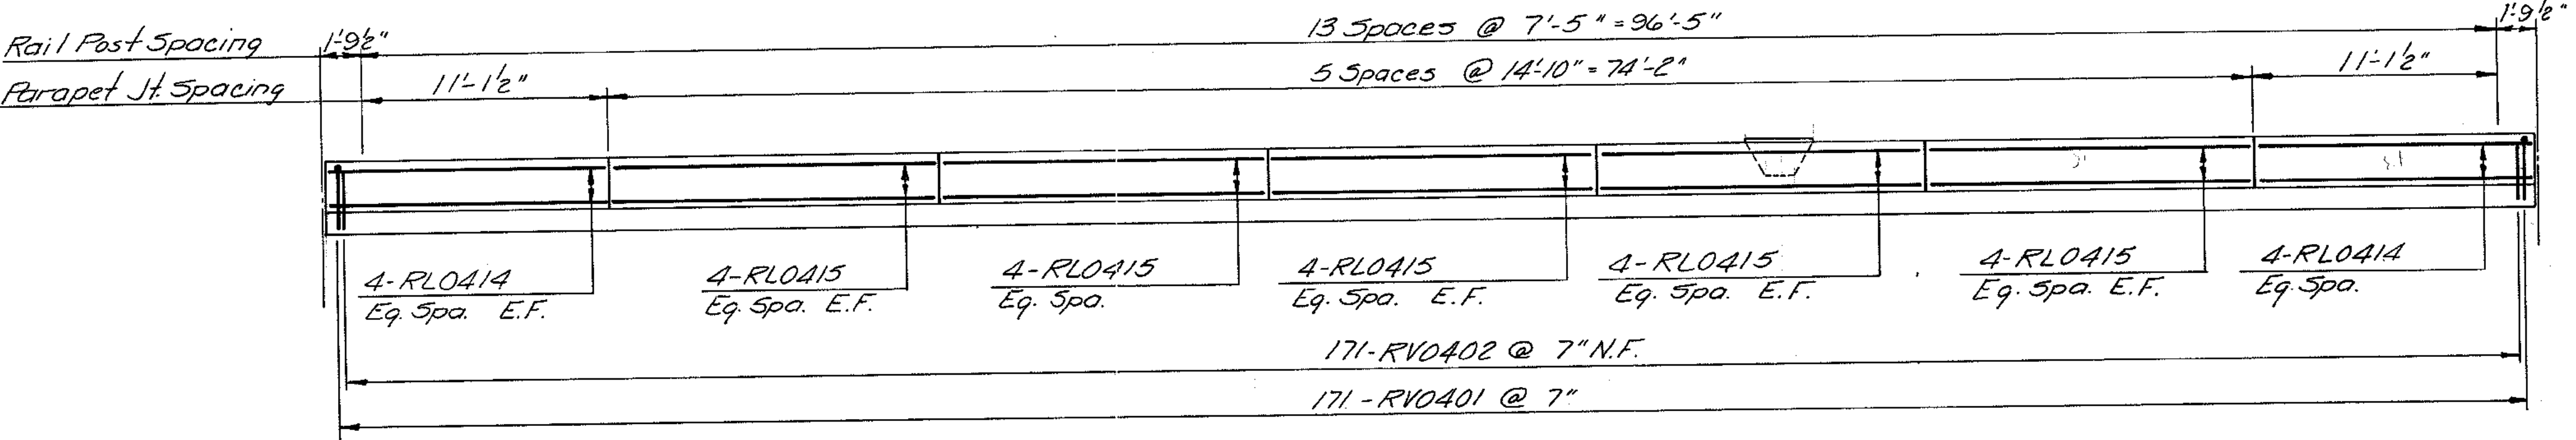

PARAPET ELEVATION - UNIT 15 SOUTHBOUND  
Scale: 3/16" = 1'-0"

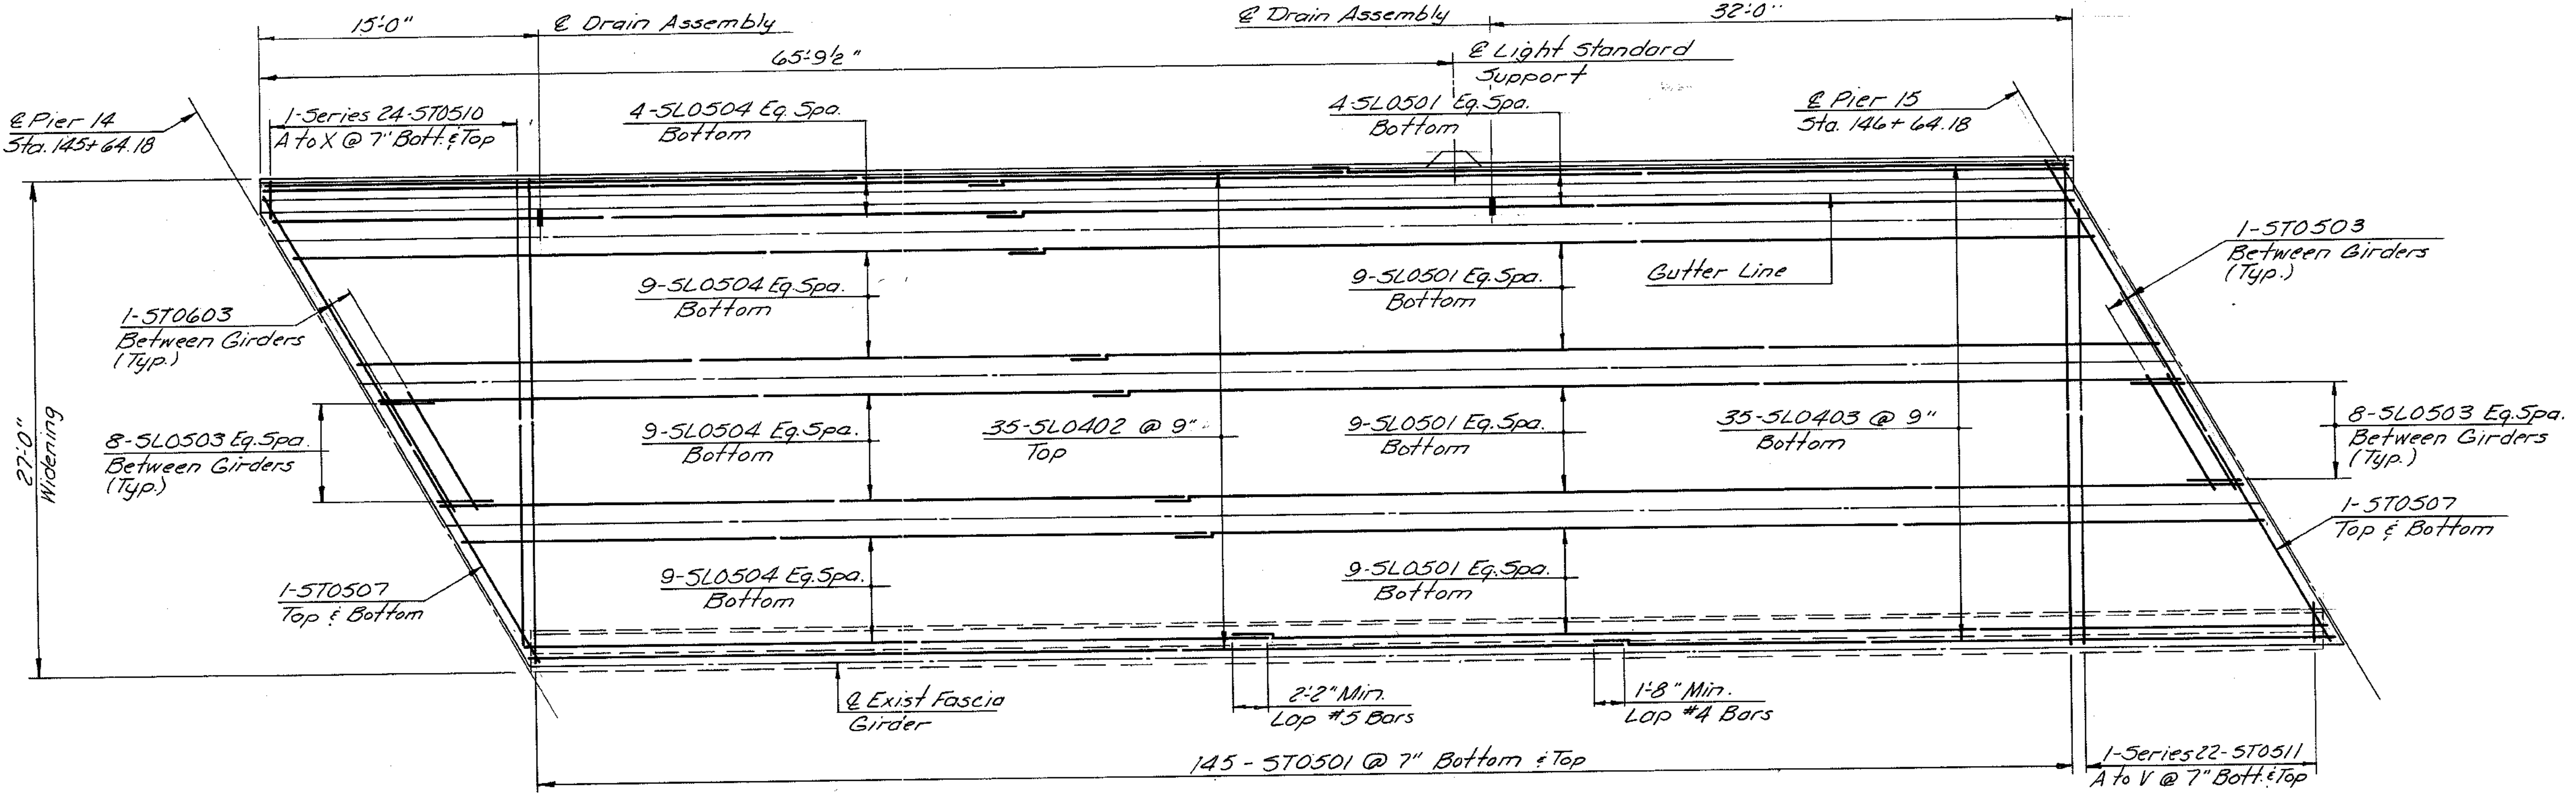

DECK PLAN - UNIT 15 SOUTHBOUND  
Scale: 3/16" = 1'-0"

BY	DATE				
MADE	TAL	3-87			
CHECKED	T.F.P.	3-87	As Built	TEM	3-89
IN CHARGE	S.R.				

AS BUILT

RICHMOND METROPOLITAN AUTHORITY  
RICHMOND EXPRESSWAY SYSTEM


DECK PLAN - UNIT 15 SOUTHBOUND

HOWARD, NEEDLES, TAMMEN & BERGENDOFF  
consulting engineers  
Alexandria, Virginia


SCALE: AS SHOWN  
CONTRACT NO.: C-13  
SHEET NO. 59 OF 106



RICHMOND EXPRESSWAY SYSTEM			
SECTION	PROJECT	SHEET NO.	TOTAL SHEETS
13	WIDENING JAMES RIVER BRIDGE	60	106

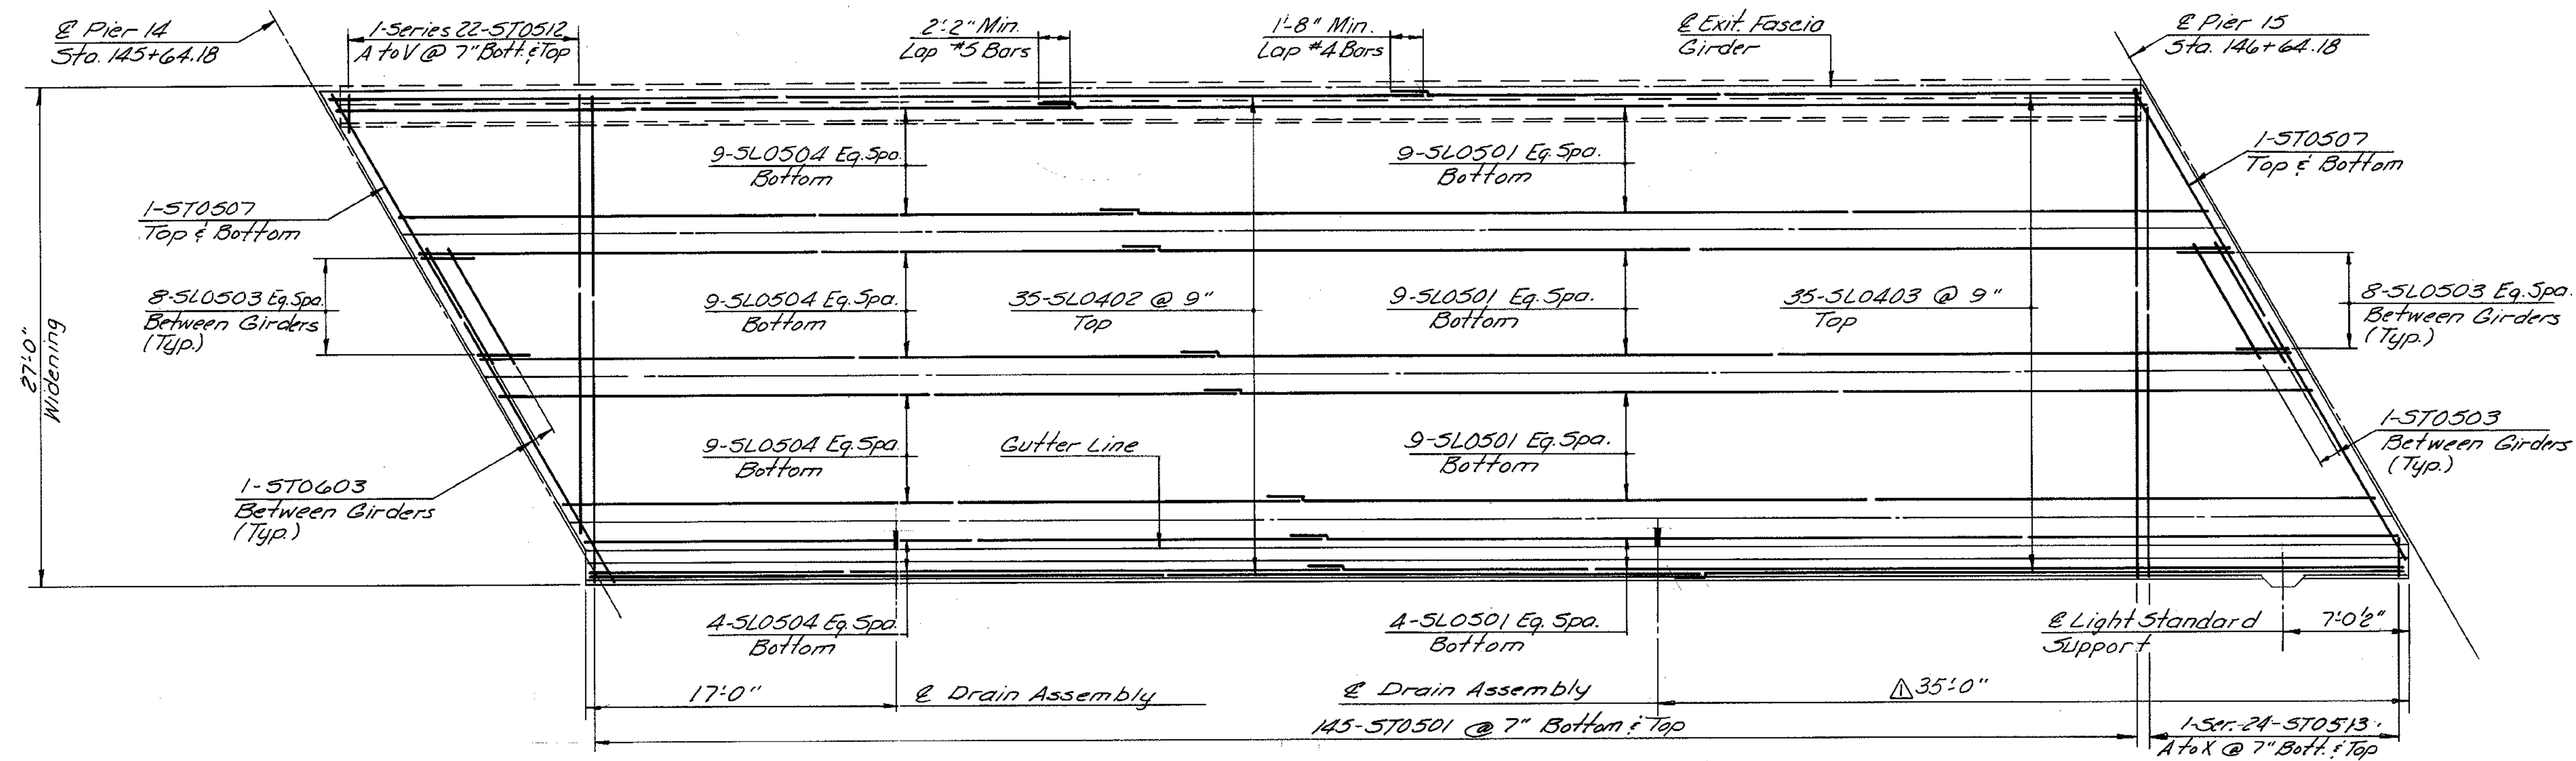

DECK PLAN - UNIT 15 NORTHBOUND  
Scale: 3/16"=1'-0"

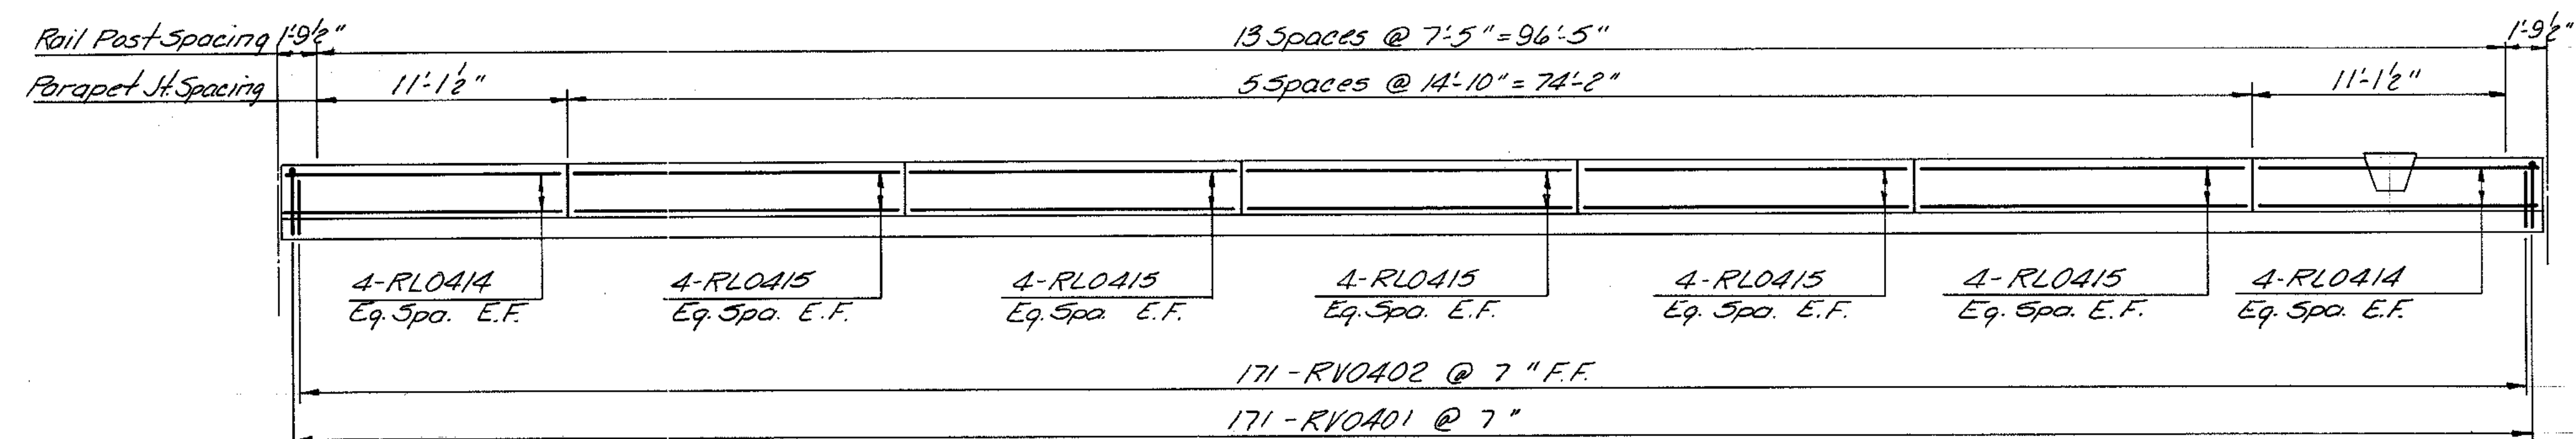


PARAPET ELEVATION - UNIT 15 NORTHBOUND  
Scale: 3/16"=1'-0"

BY	DATE				
MADE	TAL 3-87	As Built	TEM 3-89		
CHECKED	TFP 3-87	Rel. Drain Assbly	EJM 7-87		
IN CHARGE	S.R.	NO.	REVISION	BY	DATE

AS BUILT


RICHMOND METROPOLITAN AUTHORITY RICHMOND EXPRESSWAY SYSTEM	
DECK PLAN - UNIT 15 NORTHBOUND	
HOWARD, NEEDLES, TAMMEN & BERGENDOFF consulting engineers Alexandria, Virginia	SCALE: AS SHOWN CONTRACT NO.: C-13 SHEET NO. 60 of 106

RICHMOND EXPRESSWAY SYSTEM			
SECTION	PROJECT	SHEET NO.	TOTAL SHEETS
13	WIDENING JAMES RIVER BRIDGE	61	106

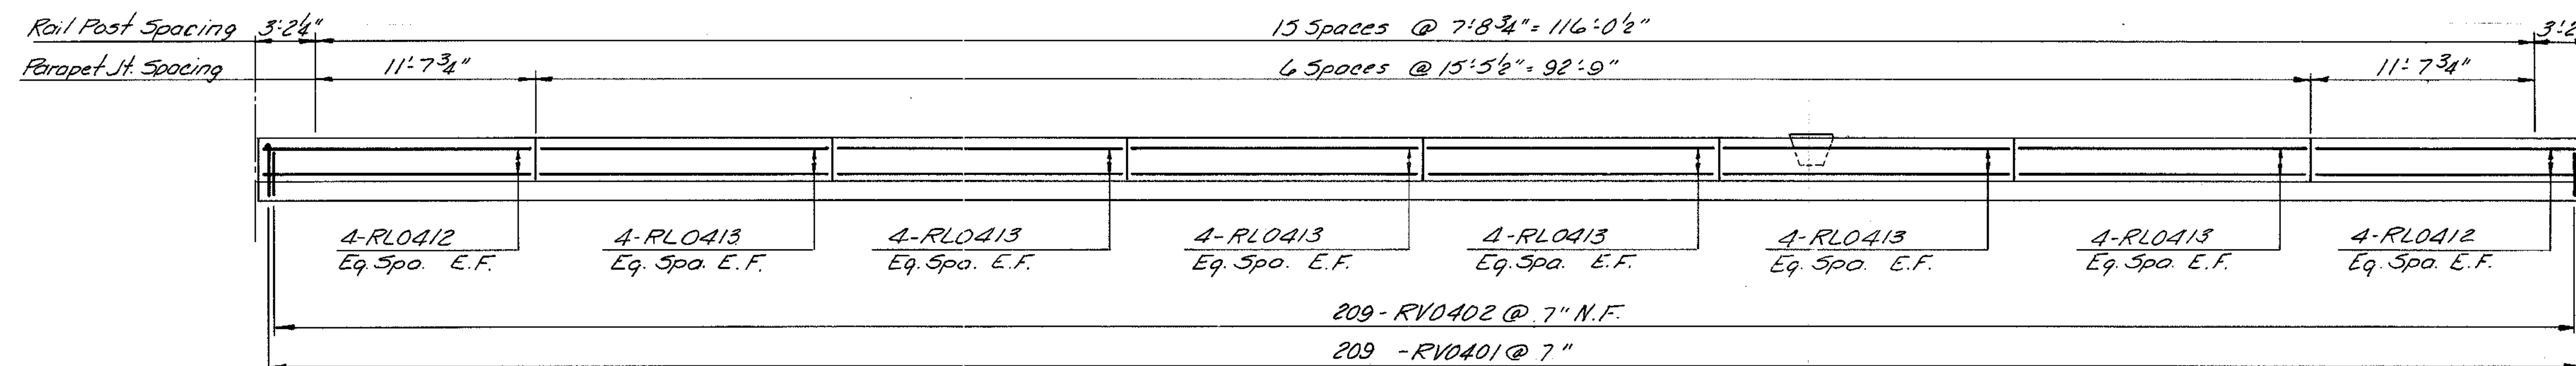

PARAPET ELEVATION-UNIT 16 SOUTHBOUND

Scale: 3/16" = 1'-0"

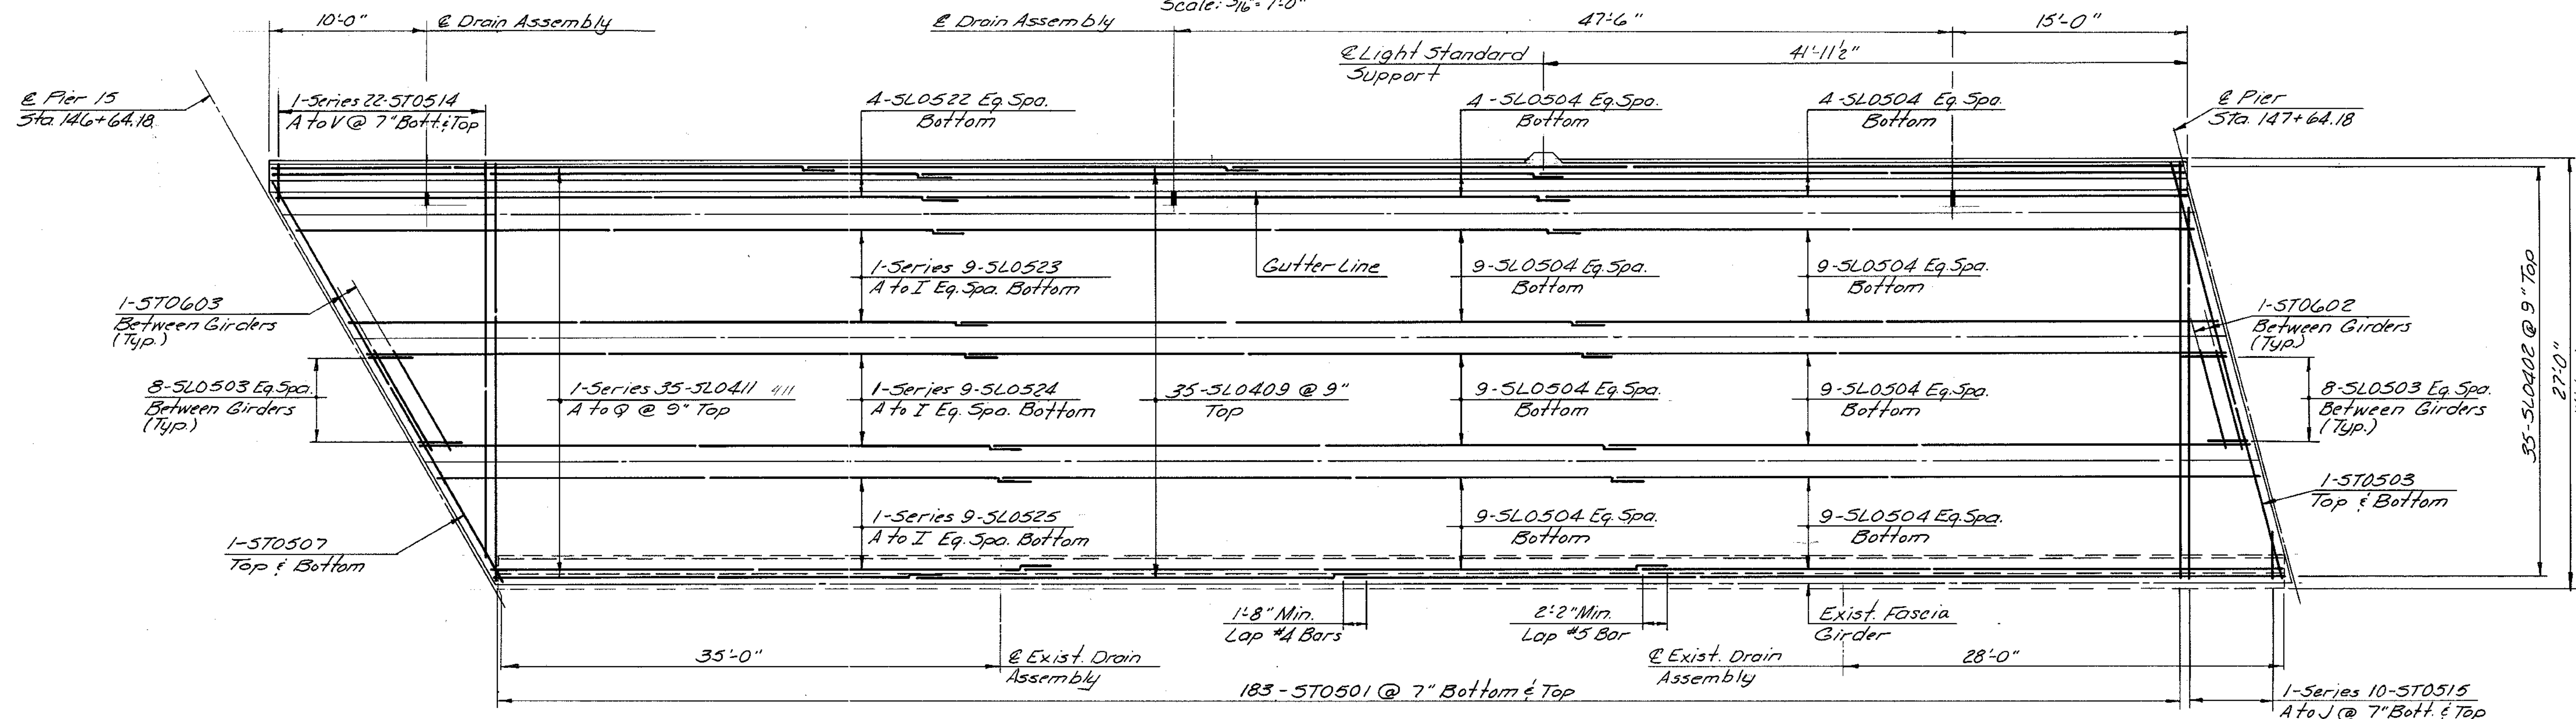

DECK PLAN-UNIT 16 SOUTHBOUND

Scale: 3/16" = 1'-0"

BY	DATE				
MADE	TAL	3-87			
CHECKED	TFP	3-87	As Built	TEM	3-89
IN CHARGE	S.R.				

RICHMOND METROPOLITAN AUTHORITY  
RICHMOND EXPRESSWAY SYSTEM



DECK PLAN - UNIT 16 SOUTHBOUND

HOWARD, NEEDLES, TAMMEN & BERGENDOFF  
consulting engineers  
Alexandria, Virginia

SCALE: AS SHOWN  
CONTRACT NO.: C-13  
SHEET NO. 61 OF 106

AS BUILT

RICHMOND EXPRESSWAY SYSTEM			
SECTION	PROJECT	SHEET NO.	TOTAL SHEETS
13	WIDENING JAMES RIVER BRIDGE	62	106

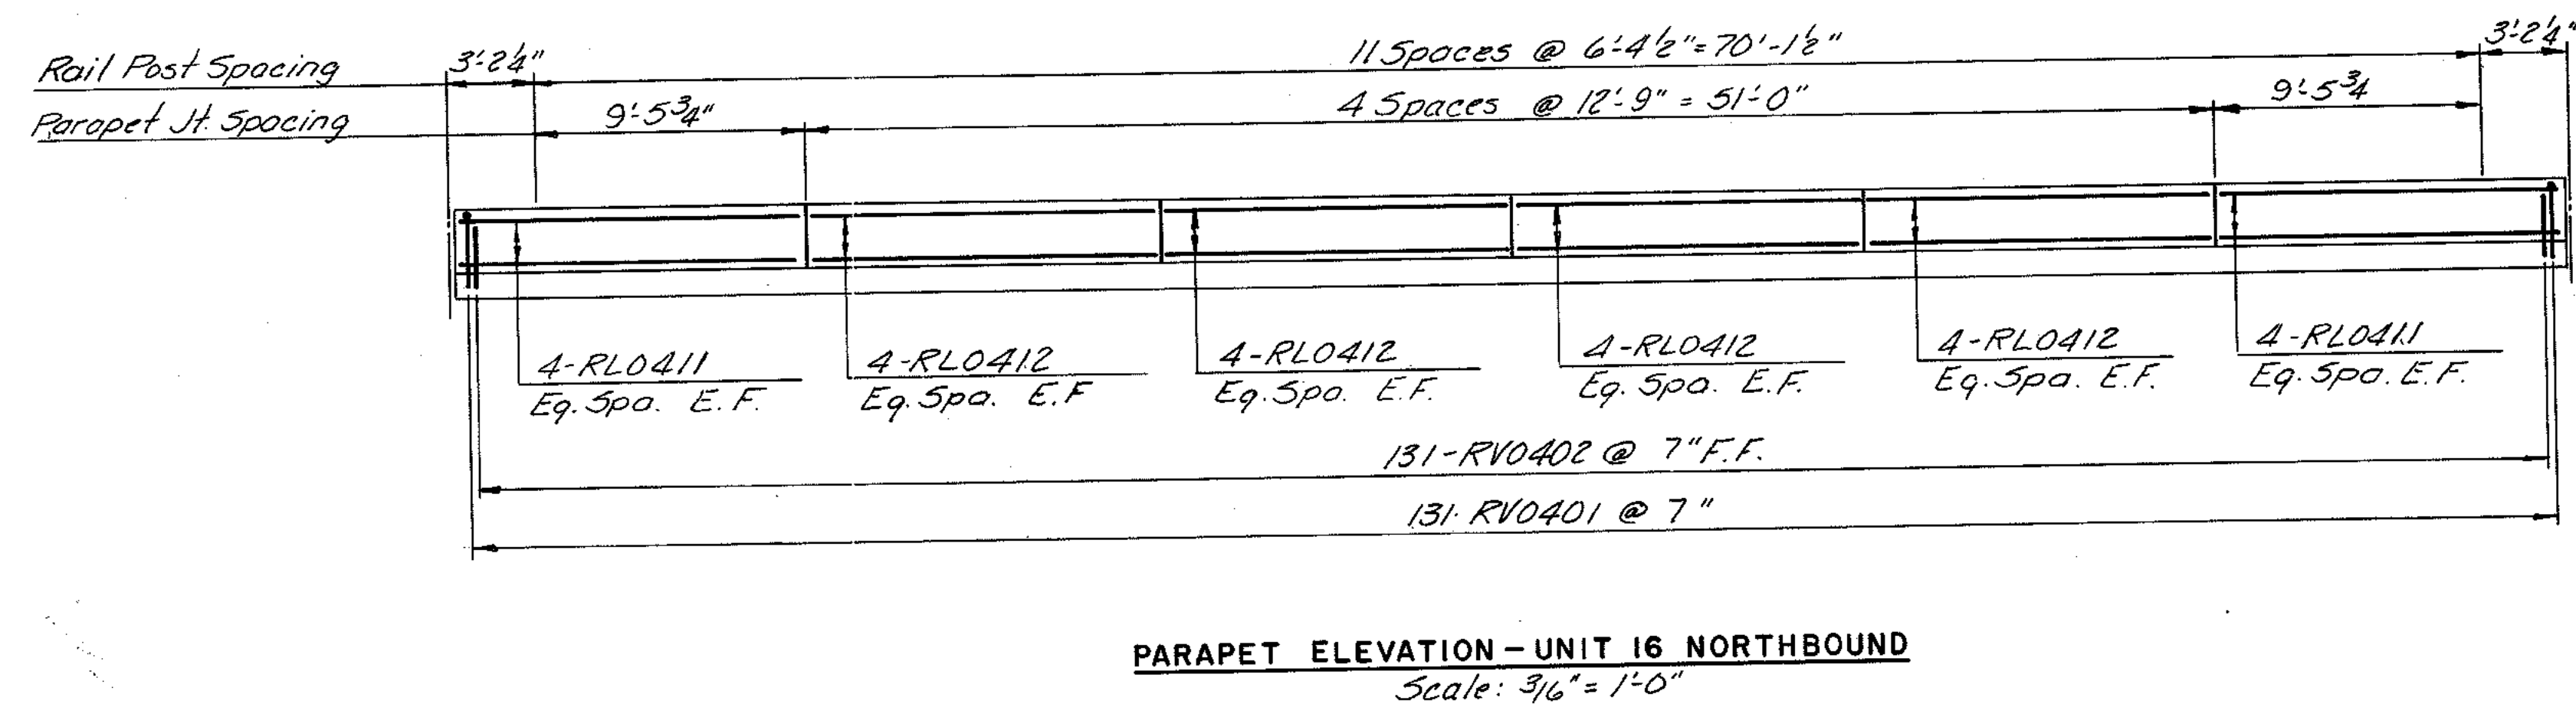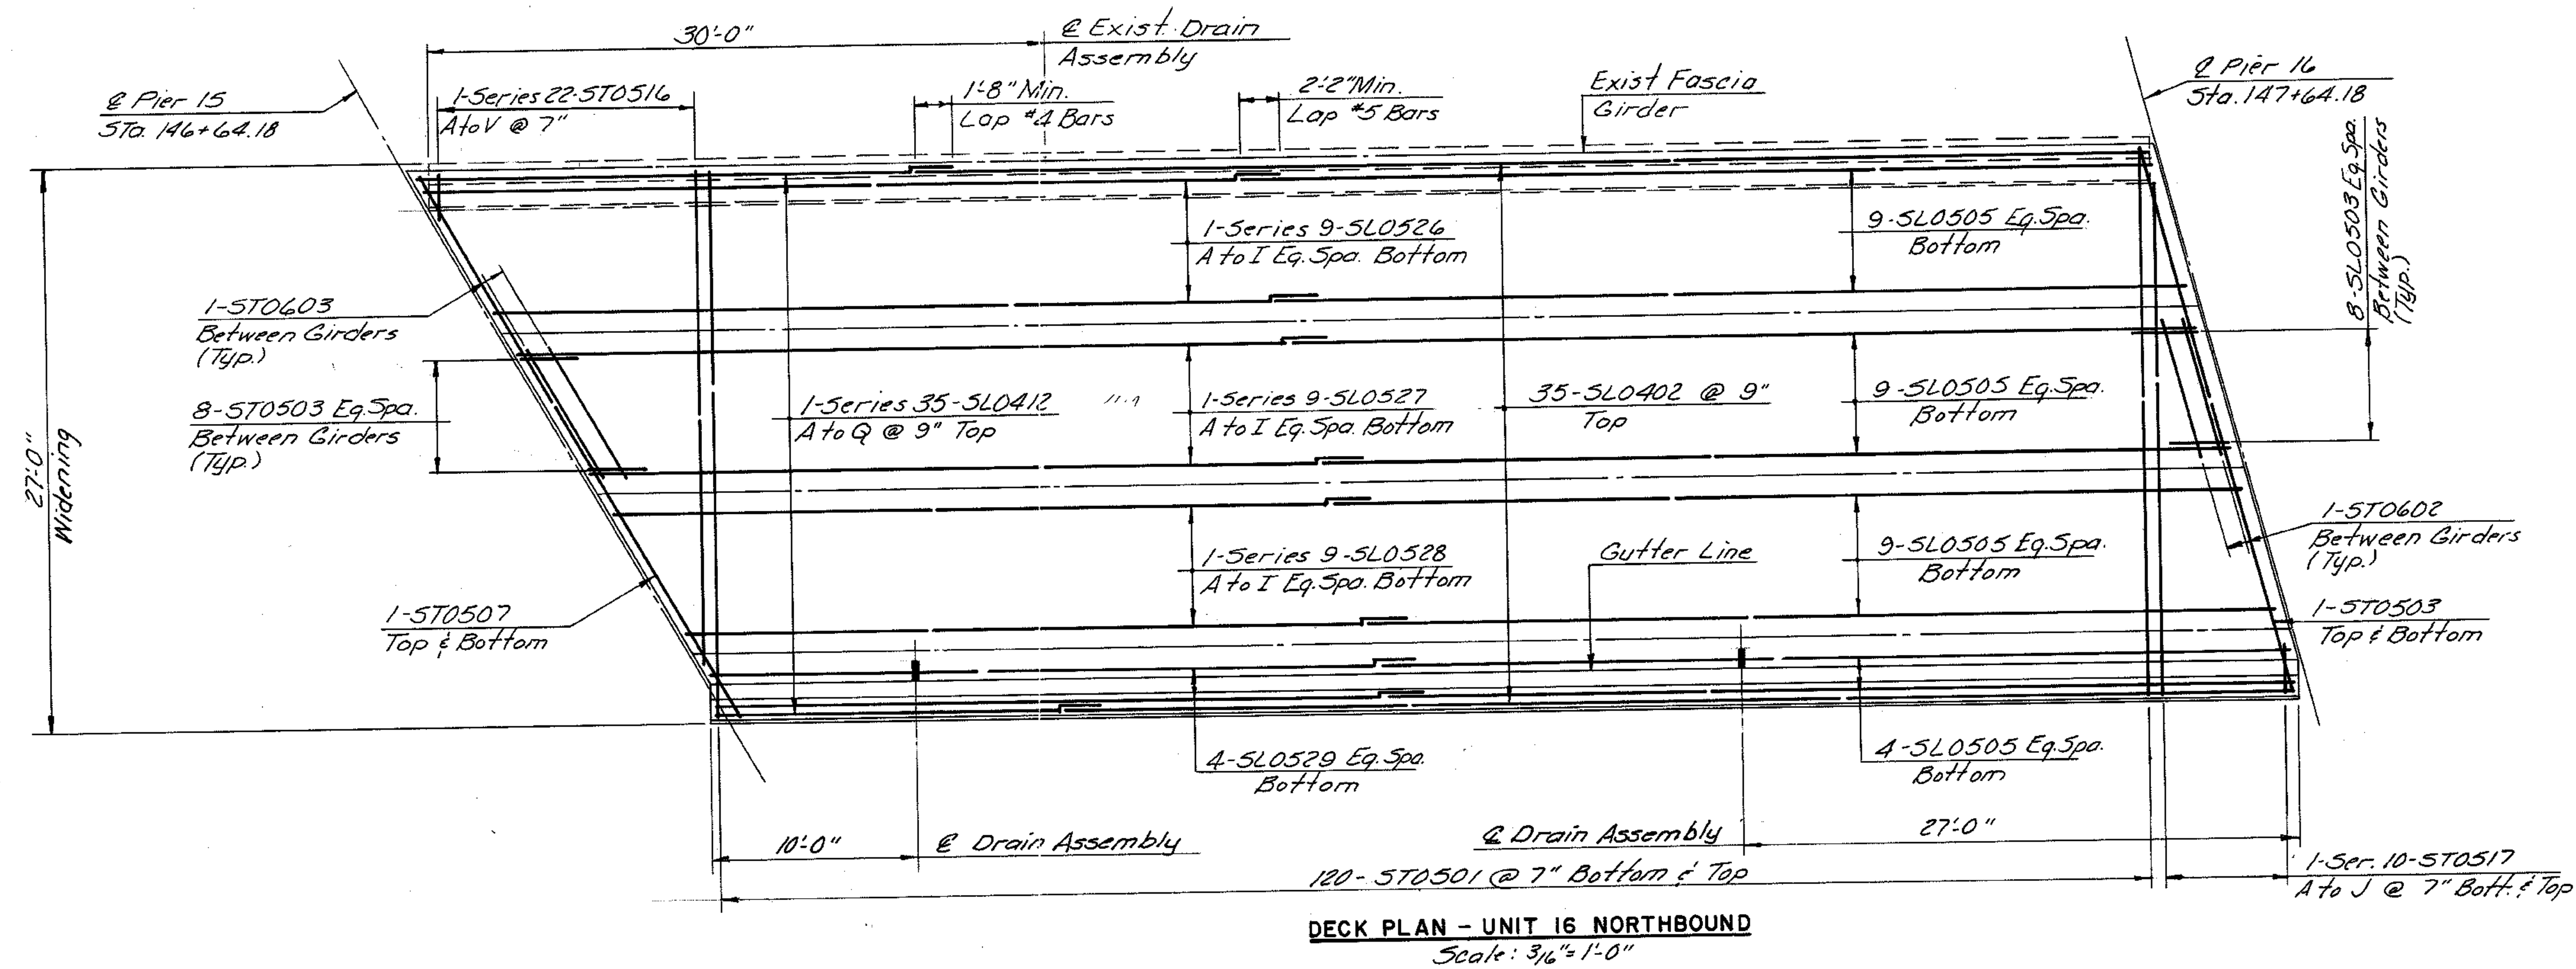


BY	DATE				
MADE	TAL	3-87			
CHECKED	T.F.P.	3-87	As Built	TEM	3-89
IN CHARGE	S.R.				

AS BUILT


RICHMOND METROPOLITAN AUTHORITY RICHMOND EXPRESSWAY SYSTEM	
DECK PLAN - UNIT 16 NORTHBOUND	
HOWARD, NEEDLES, TAMMEN & BERGENDOFF consulting engineers Alexandria, Virginia	SCALE: AS SHOWN CONTRACT NO.: C-13 SHEET NO. 62 OF 106

RICHMOND EXPRESSWAY SYSTEM			
SECTION	PROJECT	SHEET NO.	TOTAL SHEETS
13	WIDENING JAMES RIVER BRIDGE	63	106

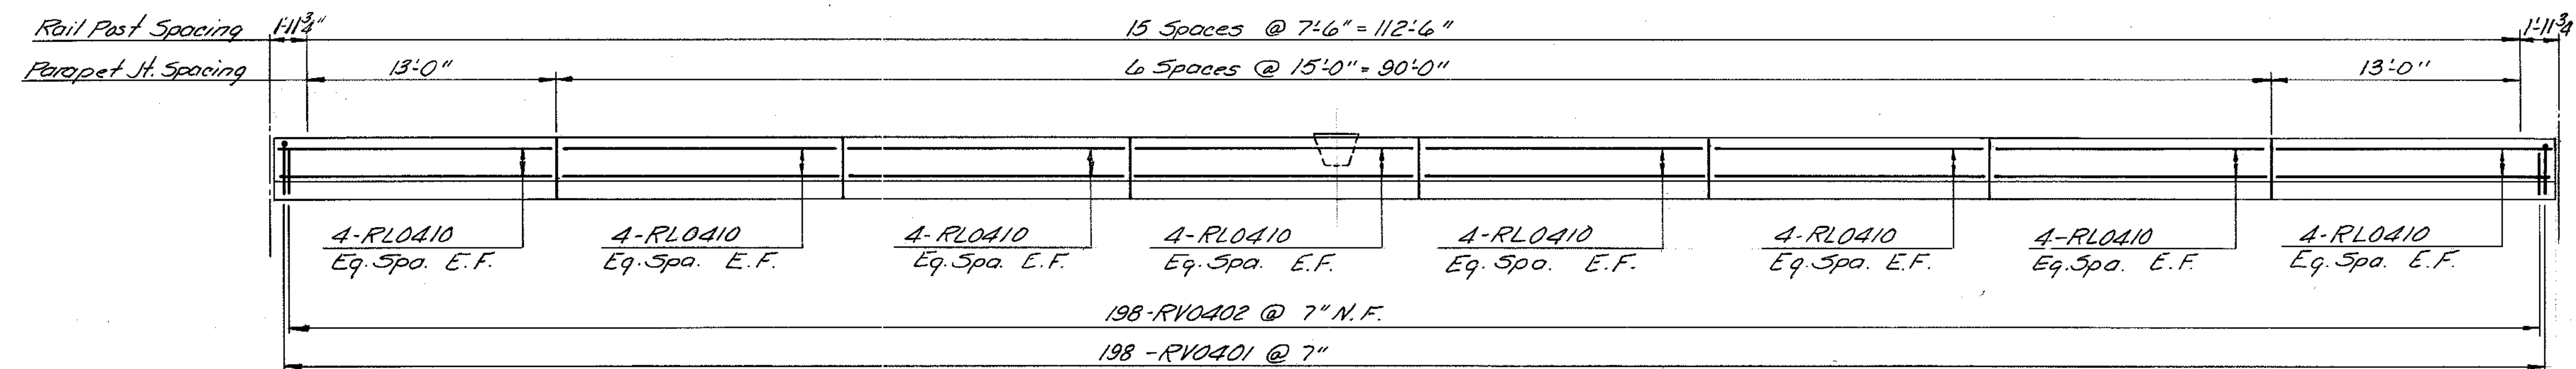

PARAPET ELEVATION-UNIT 17 SOUTHBOUND

Scale: 3/16" = 1'-0"

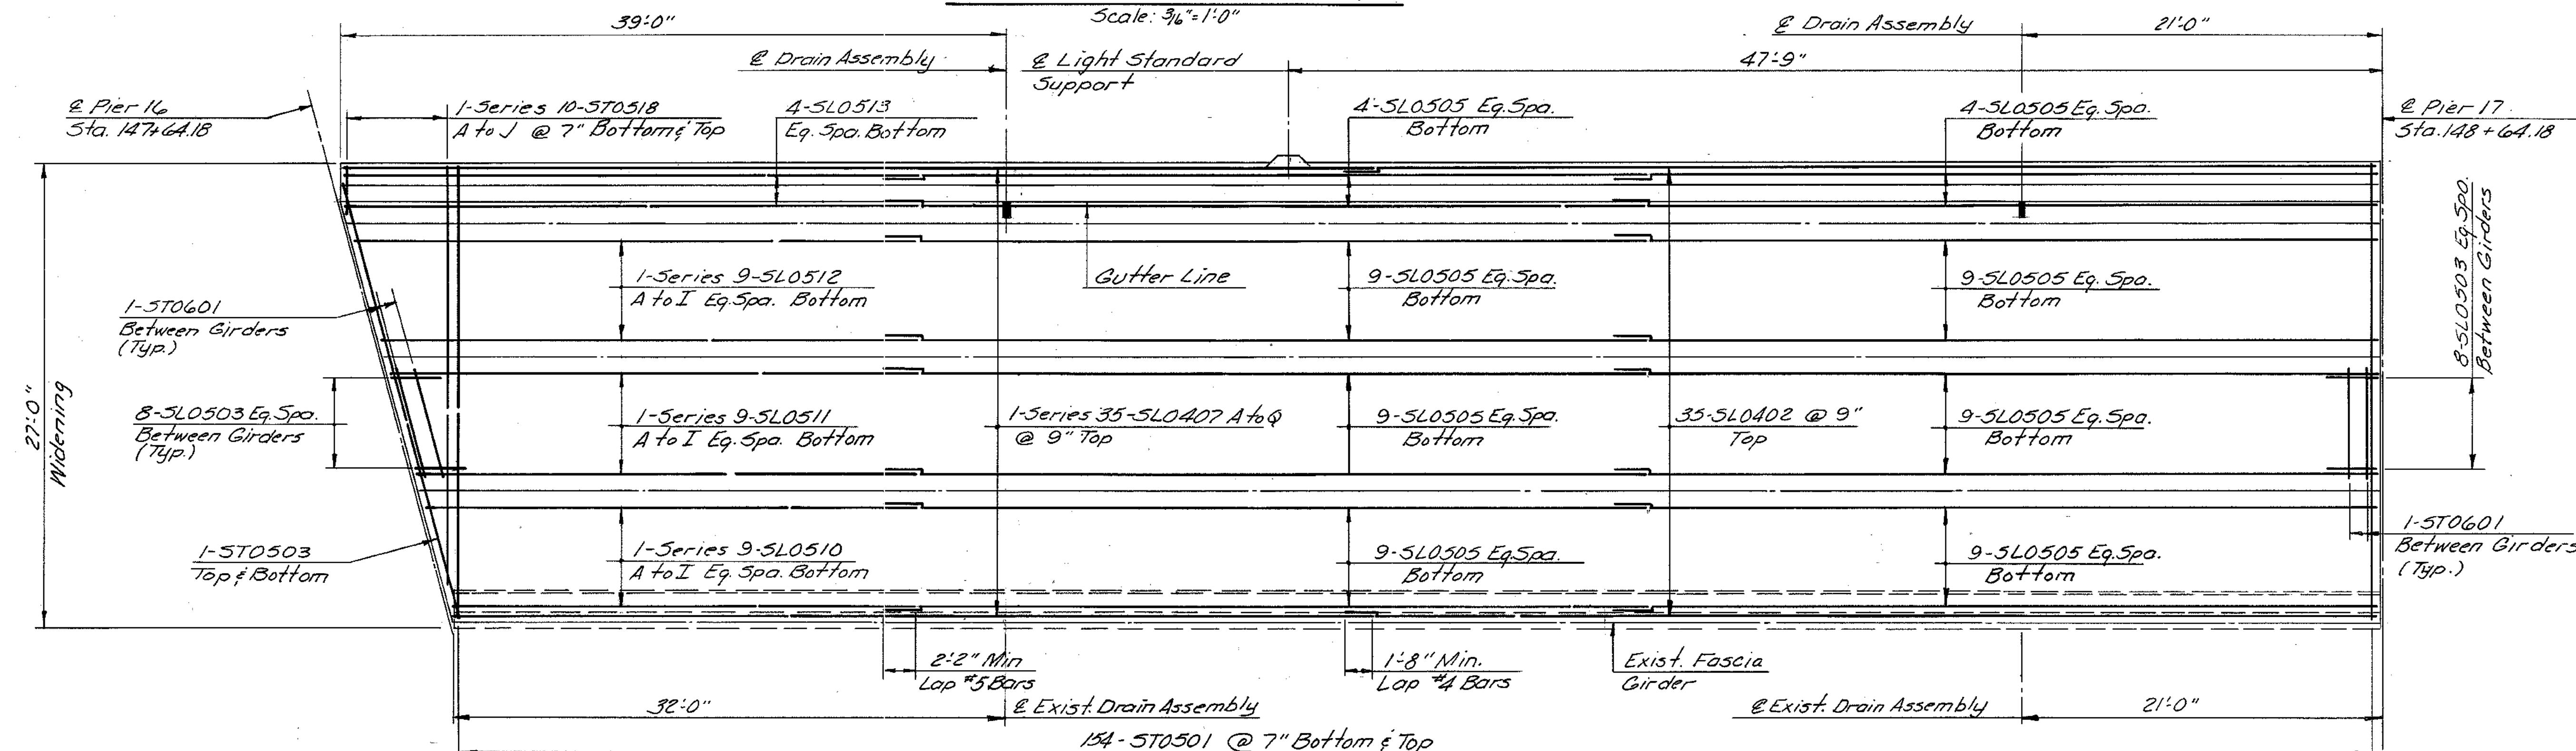

DECK PLAN - UNIT 17 SOUTHBOUND

Scale: 3/16" = 1'-0"

BY	DATE				
MADE	TAL	3-87			
CHECKED	T.F.P.	3-87	As Built	T&M	3-89
IN CHARGE	S.R.				

AS BUILT

RICHMOND METROPOLITAN AUTHORITY  
RICHMOND EXPRESSWAY SYSTEM


DECK PLAN - UNIT 17 SOUTHBOUND

HOWARD, NEEDLES, TAMMEN & BERGENDOFF  
consulting engineers  
Alexandria, Virginia


SCALE: AS SHOWN  
CONTRACT NO.: C-13  
SHEET NO. 63 OF 106



RICHMOND EXPRESSWAY SYSTEM			
SECTION	PROJECT	SHEET NO.	TOTAL SHEETS
13	WIDENING JAMES RIVER BRIDGE	64	106

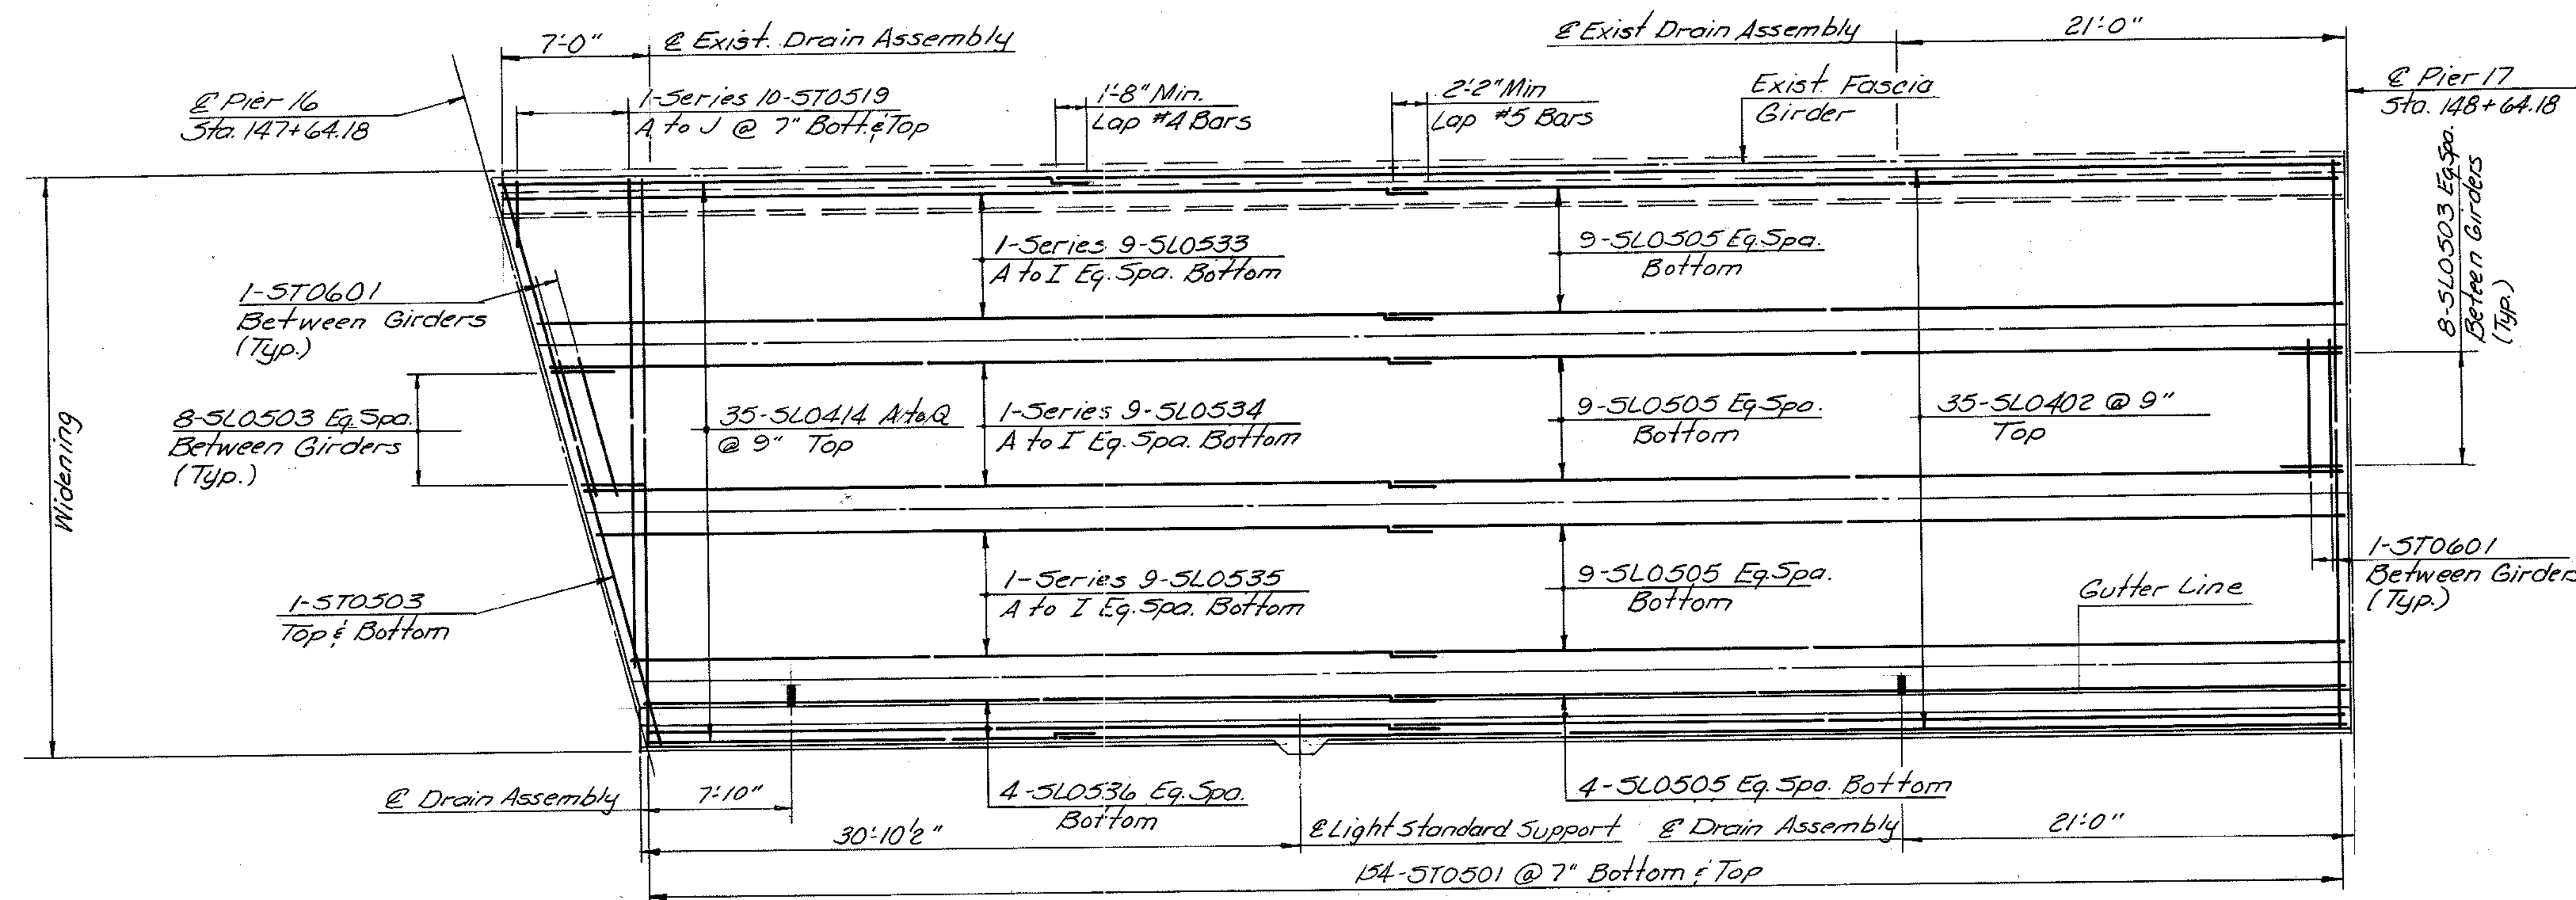

DECK PLAN - UNIT 17 NORTHBOUND  
Scale:  $\frac{3}{16}'' = 1'-0''$

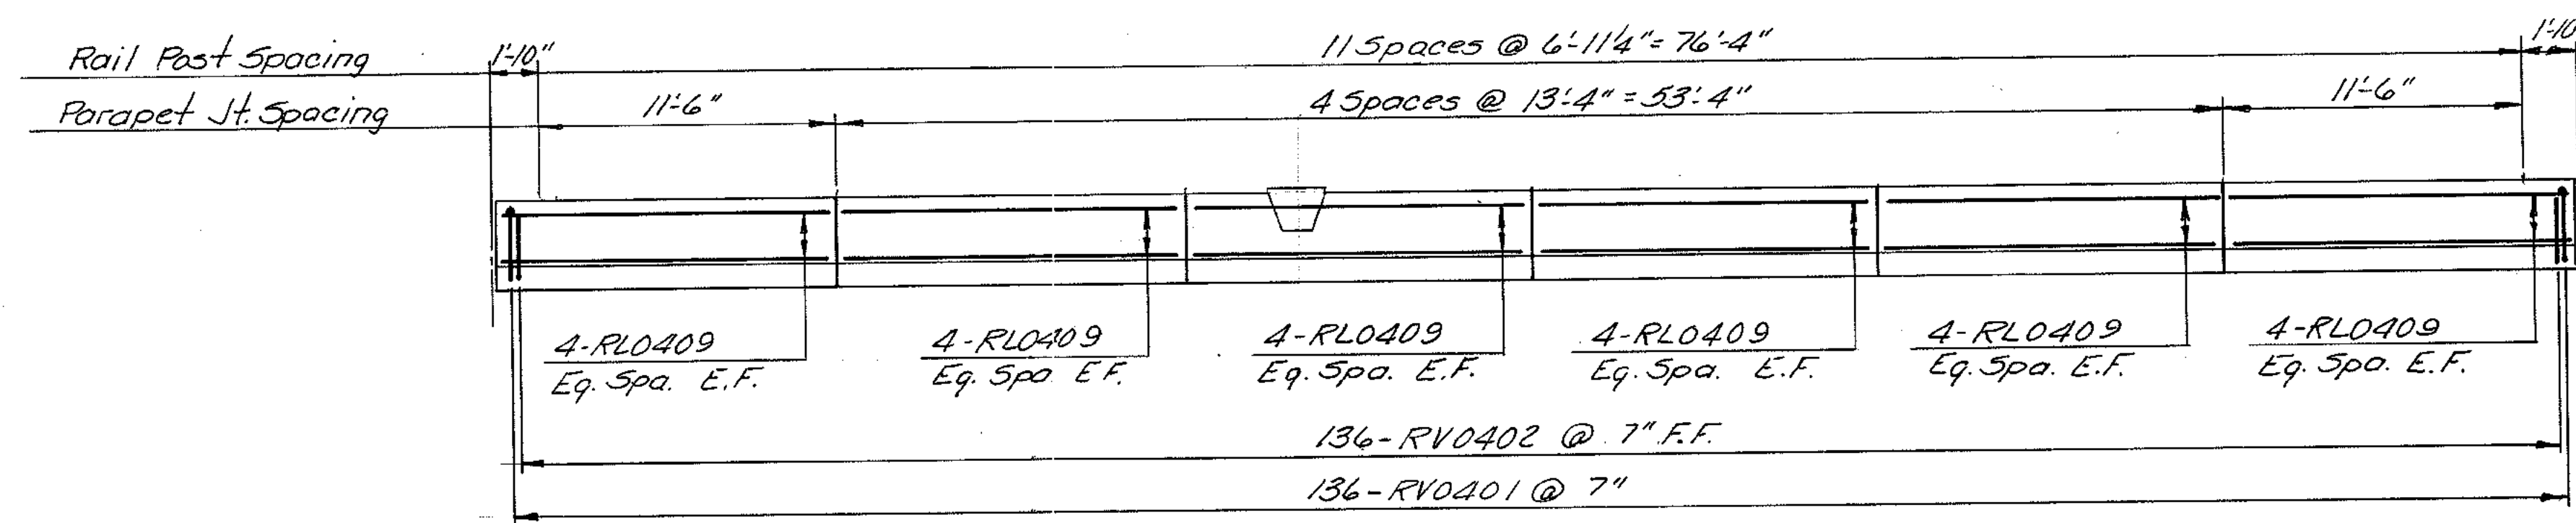

PARAPET ELEVATION - UNIT 17 NORTHBOUND  
Scale:  $\frac{3}{16}'' = 1'-0''$

BY	DATE				
MADE	TAL	3-87			
CHECKED	TRP	3-87	As Built	TEM	3-89
IN CHARGE	S.R.				

AS BUILT


RICHMOND METROPOLITAN AUTHORITY  
RICHMOND EXPRESSWAY SYSTEM

DECK PLAN - UNIT 17 NORTHBOUND


HOWARD, NEEDLES, TAMMEN & BERGENDOFF  
consulting engineers  
Alexandria, Virginia

SCALE: AS SHOWN  
CONTRACT NO.: C-13  
SHEET NO. 64 OF 106

RICHMOND EXPRESSWAY SYSTEM			
SECTION	PROJECT	SHEET NO.	TOTAL SHEETS
13	WIDENING JAMES RIVER BRIDGE	65	106

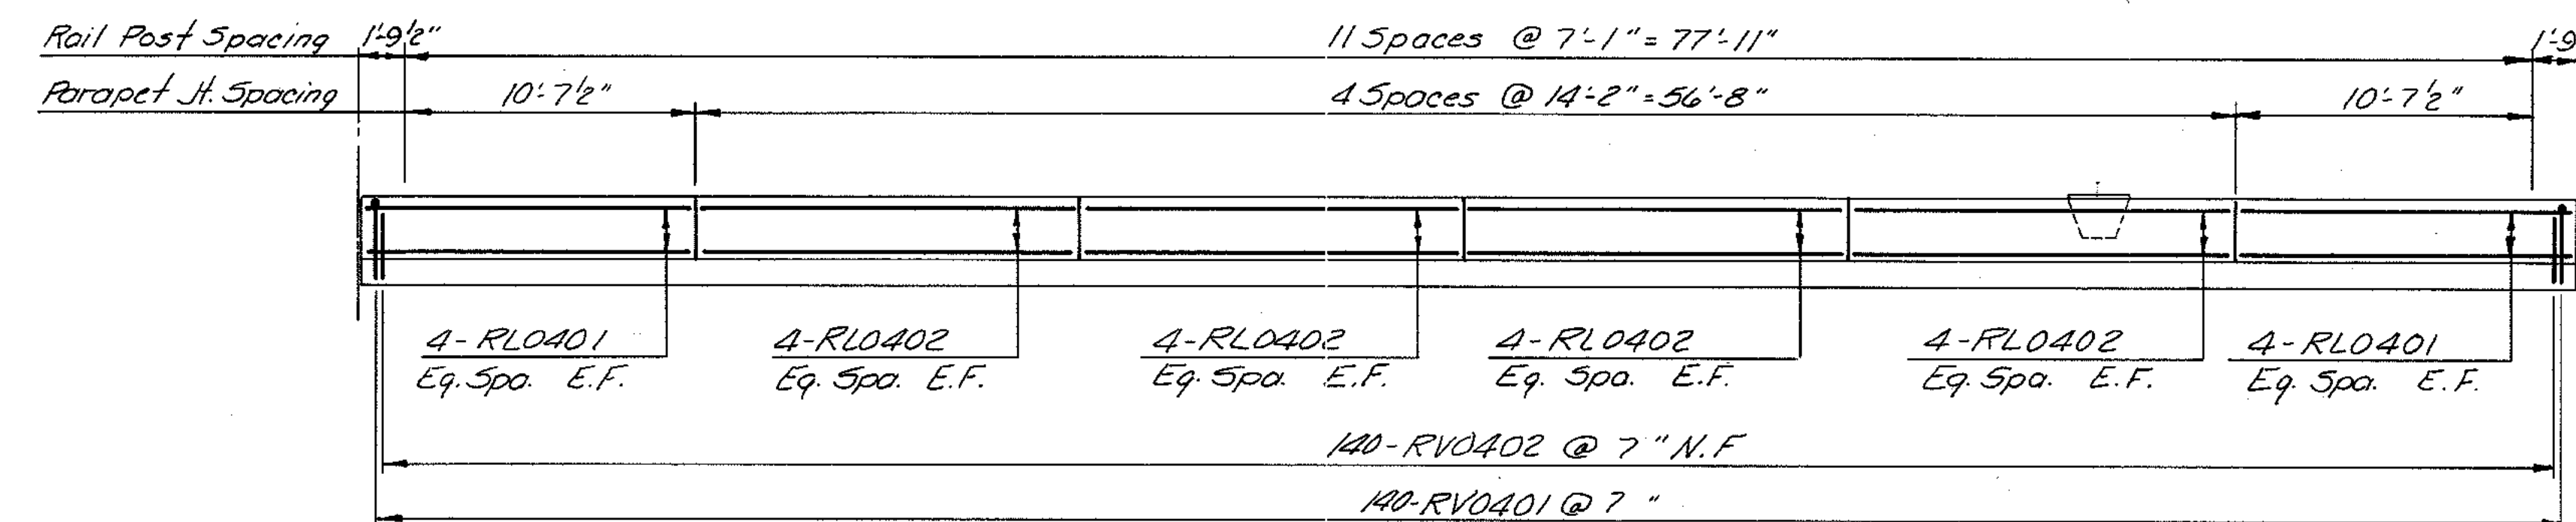

PARAPET ELEVATION - UNIT 18 SOUTHBOUND & NORTHBOUND  
(SOUTHBOUND SHOWN)

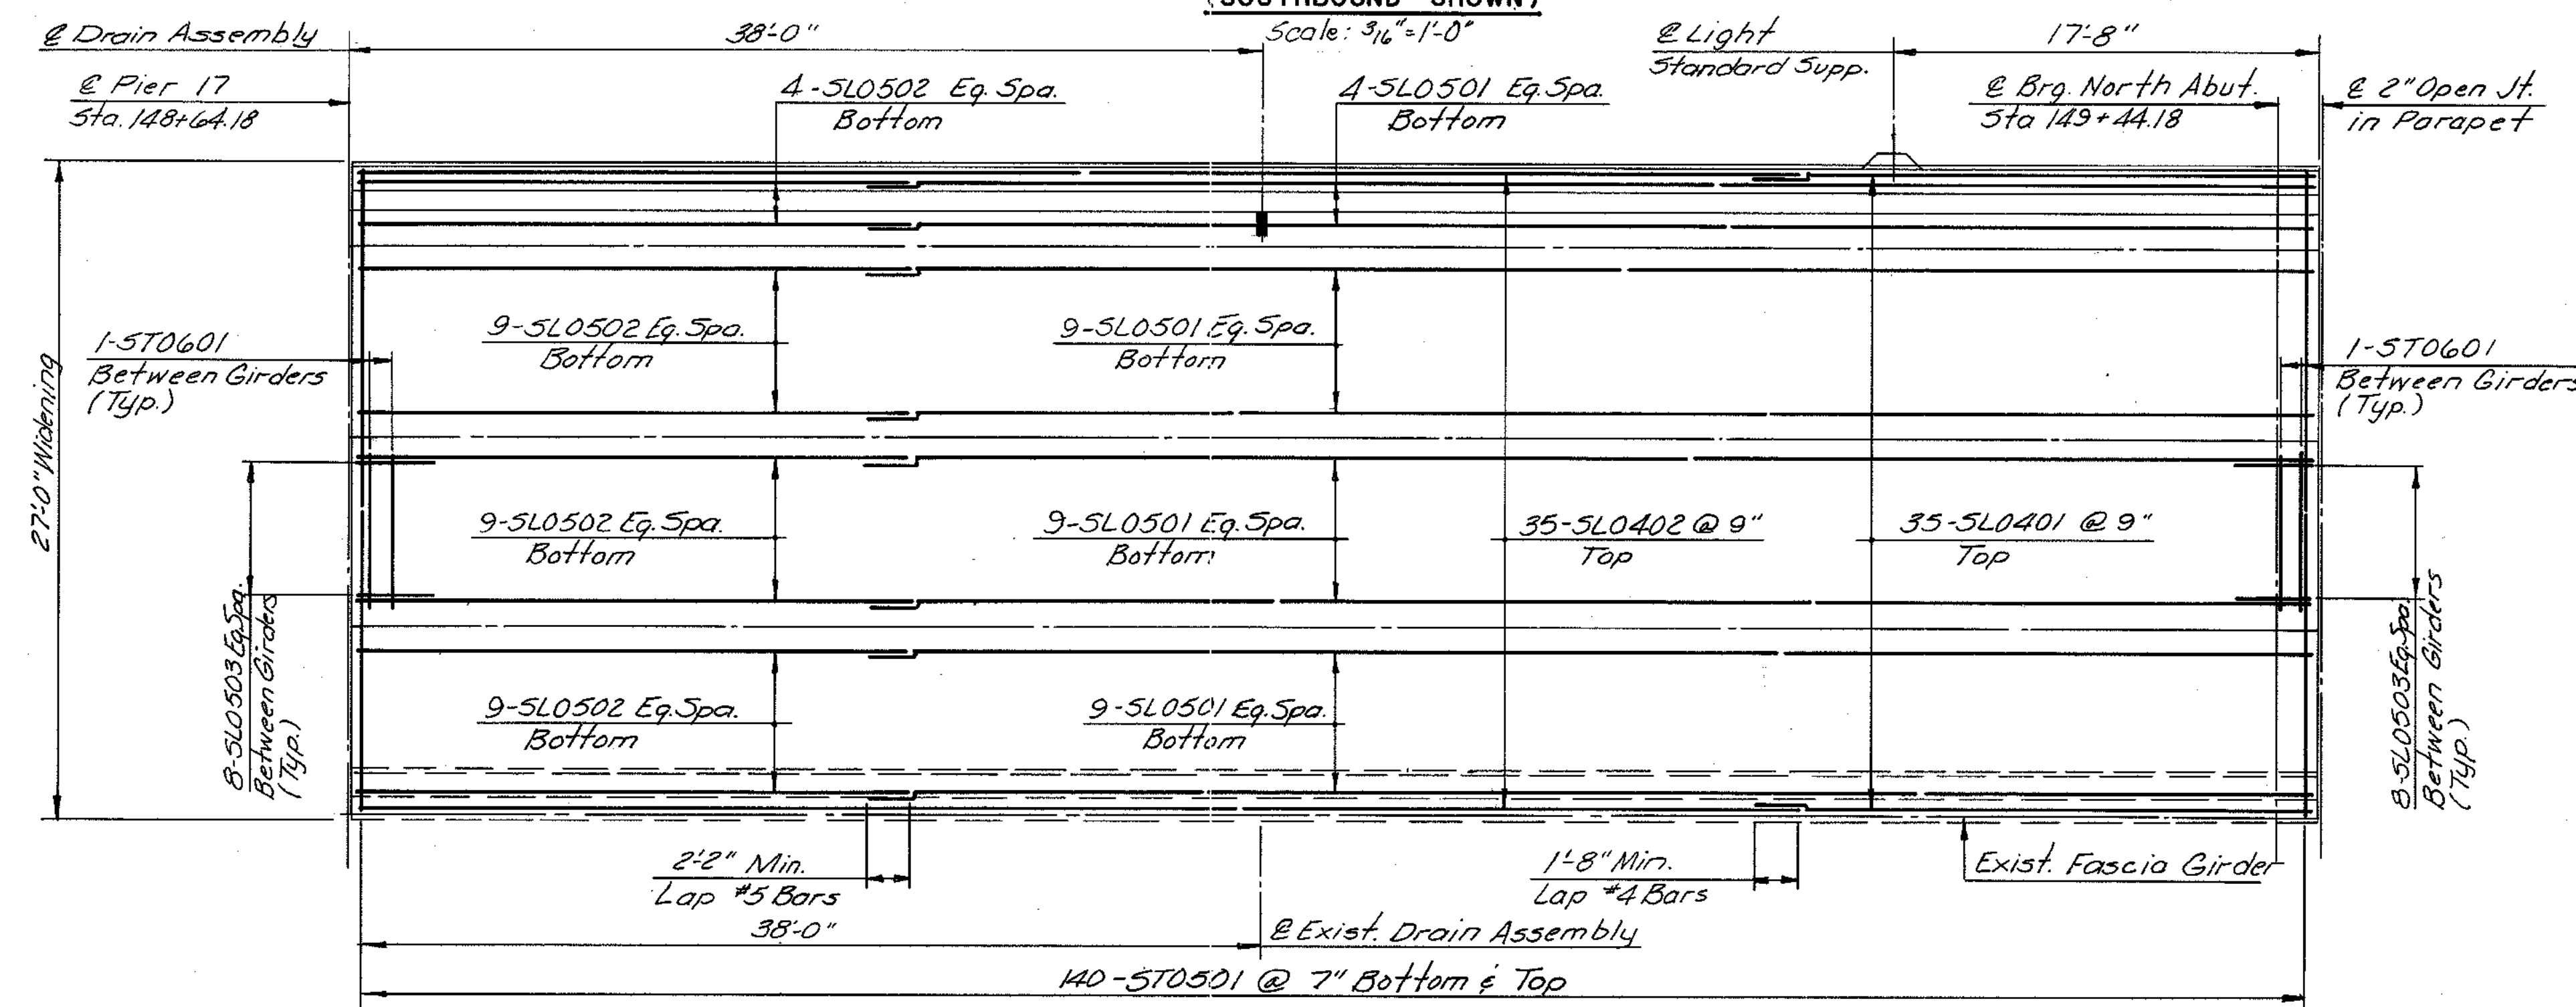

DECK PLAN - UNIT 18 SOUTHBOUND & NORTHBOUND  
(SOUTHBOUND SHOWN)  
Scale: 3/16"=1'-0"

BY	DATE				
MADE	TAL	3-87			
CHECKED	TEP	3-87	As Built	TEM	3-89
IN CHARGE	S.R.				

RICHMOND METROPOLITAN AUTHORITY  
RICHMOND EXPRESSWAY SYSTEM

DECK PLAN  
UNIT 18 SOUTHBOUND & NORTHBOUND

HOWARD, NEEDLES, TAMMEN & BERGENDOFF  
consulting engineers  
Alexandria, Virginia

SCALE: AS SHOWN  
CONTRACT NO.: C-13  
SHEET NO. 65 OF 106

AS BUILT

**Bridge 12**

**Douglasdale Road  
Over**

**Downtown Expressway Connector (VA-146)**

**Record Set Plans**





RICHMOND EXPRESSWAY SYSTEM			
SECTION	PROJECT	SHEET NO.	TOTAL SHEETS
7	DOWNTOWN EXPRESSWAY	84	

INDEX	Sheet
GENERAL PLAN AND ELEVATION	1
EAST ABUTMENT	2
WEST ABUTMENT	3
ABUTMENT DETAILS	4
PIERS	5
FRAMING PLAN	6
FRAMING DETAILS	7
DECK PLAN	8
JOINT DETAILS	9
APPROACH SLAB AND SLOPE PROTECTION DETAILS	10
BORING LOGS	11
BORING LOGS	12
STANDARD SHOE DETAILS	S1
STANDARD ALUMINUM RAILING DETAILS	S2
STANDARD ELECTRICAL DETAILS	S3
STANDARD ARCHITECTURAL DETAILS	S4
STANDARD UTILITY SUPPORT DETAILS AT BR. ABUTTS.	S5, S8
STANDARD CONDUIT INSTALLATION DETAILS	S12
LIMITS OF EXCAVATION AND BACKFILL	S13

Two roadways 24'-0" and 36'-0" clear. Two 5'-0" side walks and 4'-0" median with a 1" joint. Dead Load Includes 15 lbs. per sq. ft. for future wearing surface. Live Loads - HS20-44 loading.

GENERAL: Virginia Department of Highway Road and Bridge Specifications 1970.  
DESIGN: A.A.S.H.O. Standard Specifications for Highway Bridges 1969 and 1970-72 Interim Specification, modified by Special Design Provisions.  
WELDING: 1972 Structural Welding Code of the American Welding Society.

CONTRACT SPECIAL PROVISIONS  
Specifications and Contract Special Provisions referred to above are necessary to make these plans complete.

DATUM: City of Richmond  
TEMPERATURE: The normal temperature referred to on the plan is 60°F. The temperature range for movement is 0°F to 120°F.

DIMENSIONS: All dimensions are measured horizontally and vertically unless otherwise noted.

EXCAVATION: Excavation below subgrade and cut slope template, shall be classified as Structure Excavation. All excavation above these limits shall be classified as Regular Excavation and is not included in the Structural Quantities.

FOUNDATIONS: Footings shall rest on firm material. Foundation material shall be dry and special attention is called to Section 401.05 of General Specifications and to the Contract Special Provisions, concerning preparation of foundations for footings.

CONCRETE NOTES:  
Concrete in superstructure shall be Class A4. All other concrete shall be Class A3. All exposed edges and corners shall have a 1/4" chamfer or fillet unless otherwise noted.  
Finishing concrete surfaces: See the Standard Architectural Detail Sheets and the Contract Special Provisions for types and details.

STEEL NOTES:  
All reinforcing steel shall be intermediate grade. All reinforcing bar dimensions on the detailed drawings are to centers of bars unless otherwise noted. Clear distance between reinforcing steel and face of concrete shall be as noted on the plans. All bar laps shall be 30 diameters of the smaller diameter bar unless otherwise noted.

Structural steel shall conform to A.S.T.M. Specification A36 except as noted. All field connections shall be made with high strength bolts. High strength bolts shall be 1/2" diameter unless otherwise noted and shall conform to A.S.T.M. Specification A-325.

BENCH MARK: B-12 Copperweld rod in west end of median on Douglasdale Road. Elev. 192.01



AS BUILT

RICHMOND METROPOLITAN AUTHORITY  
RICHMOND EXPRESSWAY SYSTEM  
DOWNTOWN EXPRESSWAY


BRIDGE NO. 12  
DOUGLASDALE EAST ROAD OVER  
S-E & E-S ROADWAYS  
GENERAL PLAN AND ELEVATION

HOWARD, NEEDLES, TAMMEN & BERGENDOFF  
consulting engineers  
NEW YORK ALEXANDRIA KANSAS CITY

SCALE: 1"=20'  
CONTRACT NO. 7  
SHEET NO. 1 OF 12

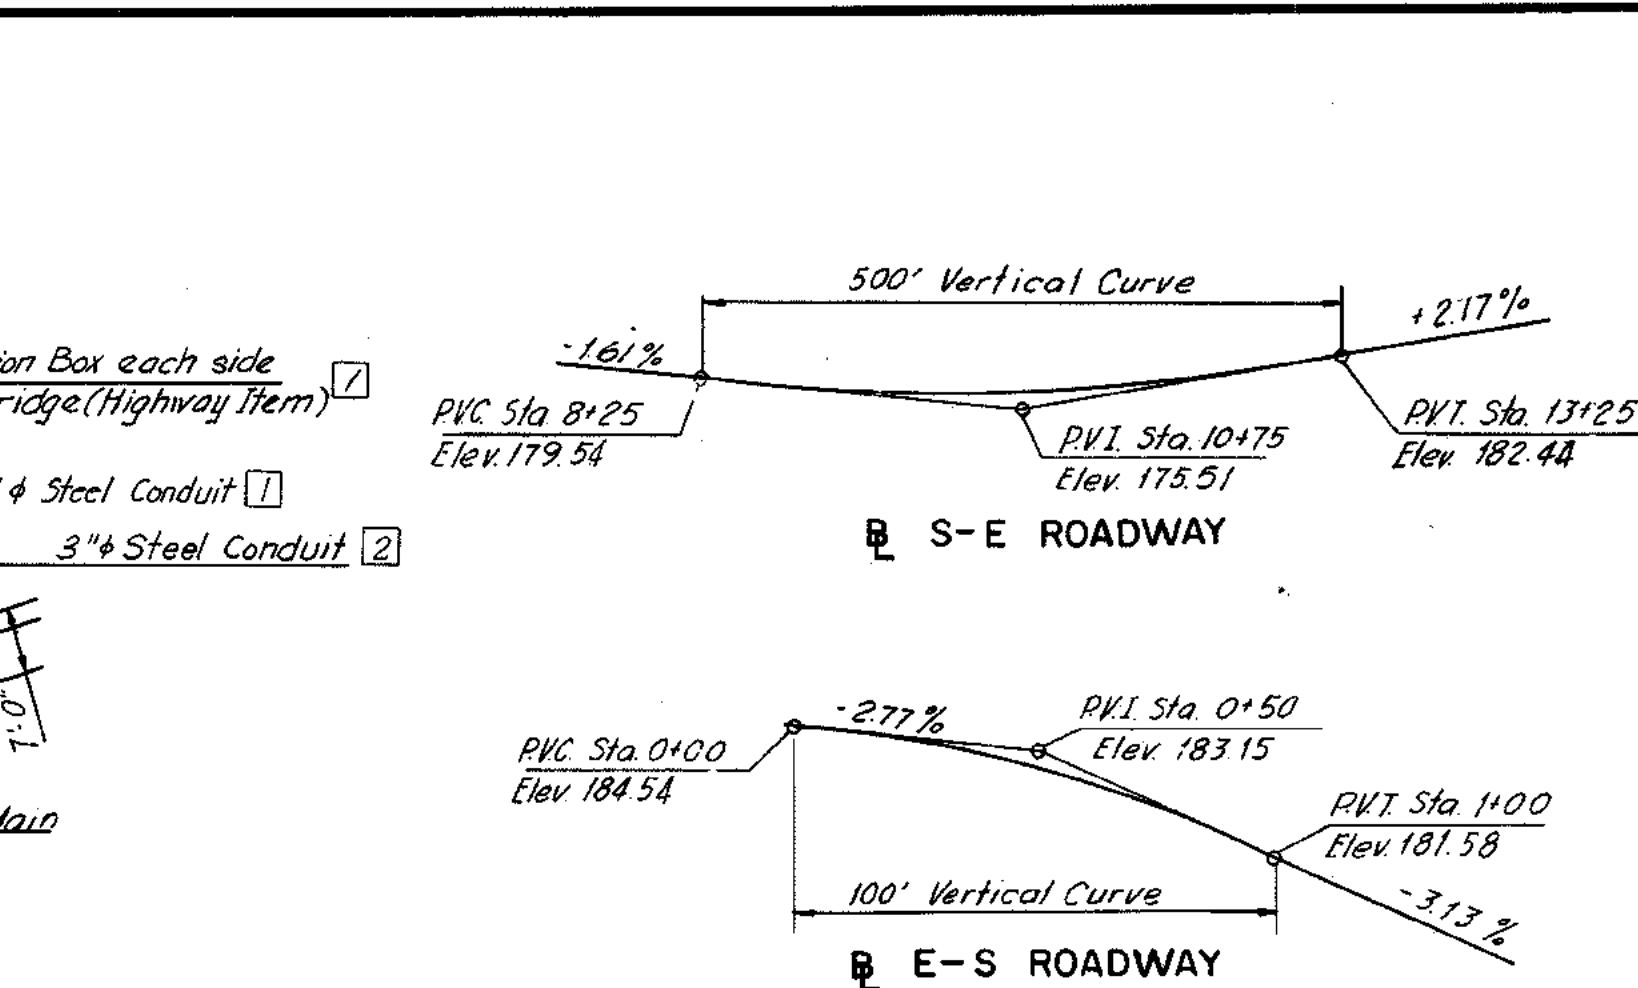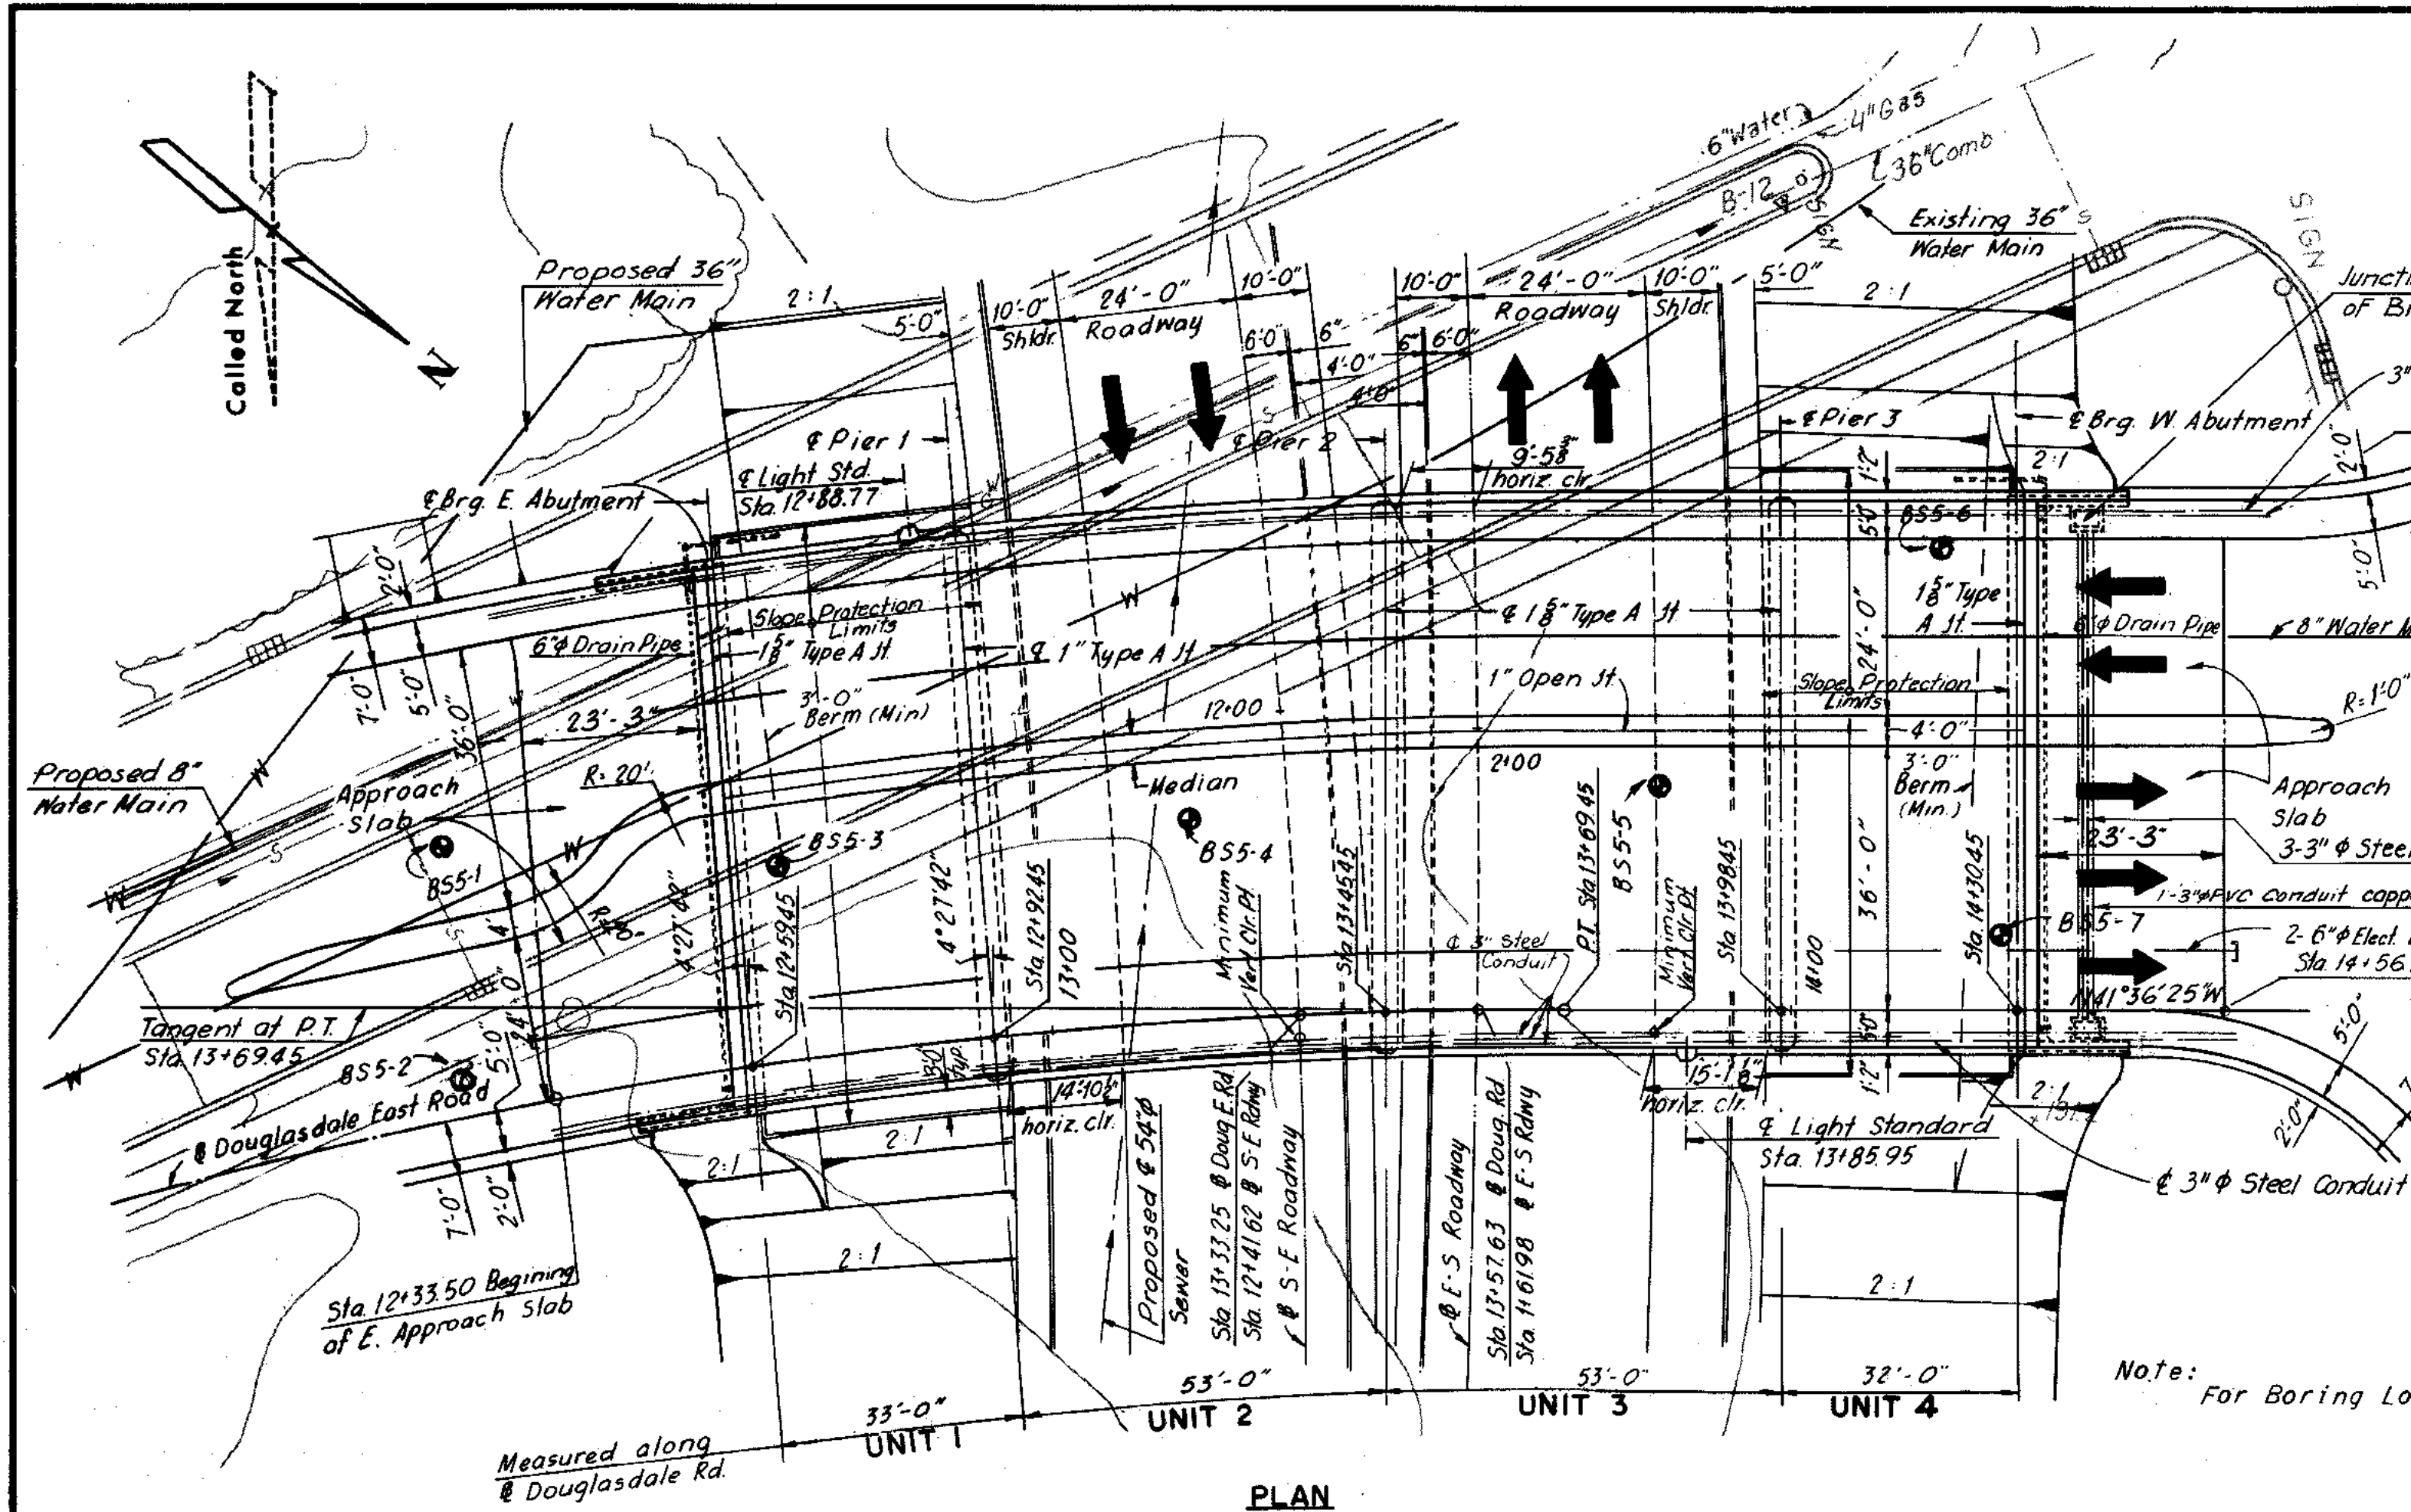

PROFILE GRADE DATA

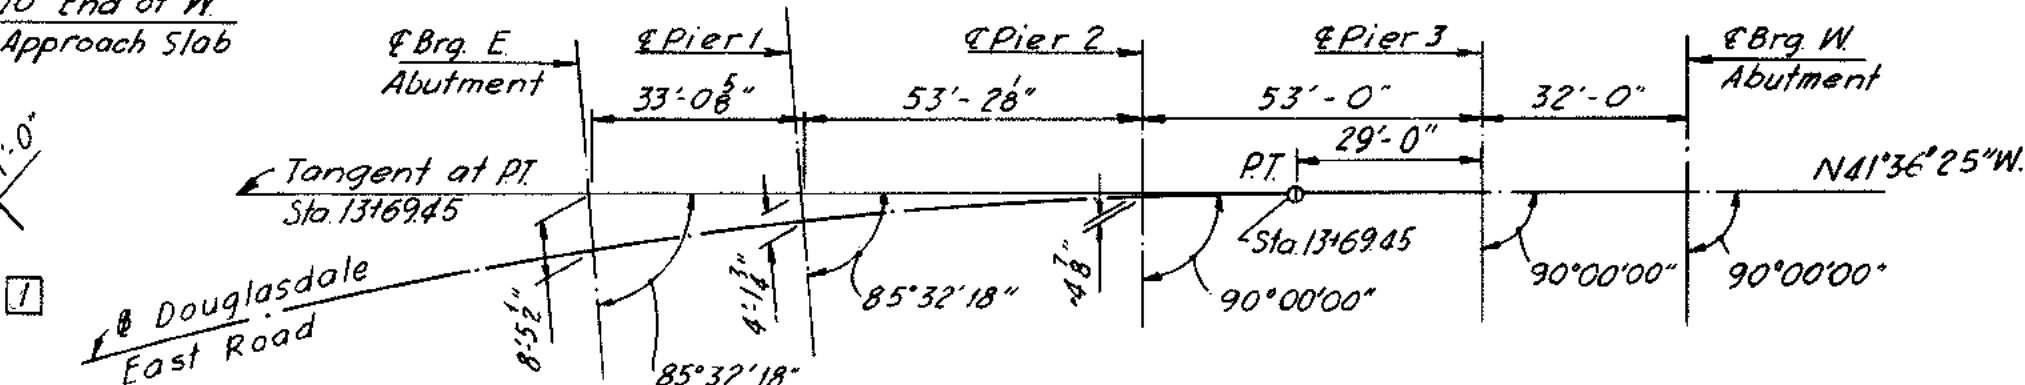

LAYOUT SKETCH

no scale

### CURVE DATA

Douglasdale East Road

P.I. = Sta. 12+21.35  
A = 24°03'23"  
D = 8°00'00"  
T = 152.60'  
L = 300.70'  
R = 716.20'

S-E Roadway

P.I. = Sta. 10+68.11  
A = 34°20'58"  
D = 5°00'00"  
T = 354.17'  
L = 686.99'  
R = 1145.92'

E-S Roadway

P.I. = Sta. 6+43.88  
A = 37°15'41"  
D = 3°00'00"  
T = 643.88'  
L = 1242.04'  
R = 1909.86'

### ESTIMATED QUANTITIES

	Struc. Excav. Cu. yds.	CONCRETE			Reinf. Steel Lbs.	Str. Stl. Mild Car. Lbs.	Porous Backfill Cu. yds.	Underdrain 6" dia. pipe Lin. ft.	10BP42 Stl. Pile Lin. ft.	Con. Slab St. Prot. Sq. yds.	Asphalt Damp prf. Sq. yds.	Metal Conduit Lin. ft.	Conduit 6" dia. VEP Co Lin. ft.	Water Main 8" dia. Lin. ft.	Aluminum Railing (2-rails) Lin. ft.	PVC Conduit Lin. ft.
		Class A4 Cu. yds.	Class A3 Cu. yds.	Class A3 Appr. Sl. Cu. yds.												
Superstructure		440.0			95,614	326,332						1,539	448	211	403	66
East Abutment	230.8		145.6		7,846		9	92	391.8	357.7	57					
Pier 1	356.6		142.9		16,397											
Pier 2	239.1		132.9		15,882											
Pier 3	313.3		138.4		16,012											
West Abutment	288.5		148.0		7,852		9	96	503.2	358.2	57					
Approach Slabs				147.6	38,885											
TOTAL	1,428.3	440.0	707.8	147.6	198,488	326,332	18	188	895.0	715.9	114	1,539	448	211	403	66

### ESTIMATED QUANTITIES NOTES

- (a) Class A3, unless noted  
(b) Class A4  
\* Frame and Cover only

Notes:  
The cost of furnishing and installing 2" and 3" galvanized steel conduit shall be included in the bid price for the item "Metal Conduit".

BY	DATE	REVISION	BY	DATE
MADE	S.S.W. 10-25-74			
CHECKED	G.C.C. 2-14-78			
IN CHARGE	F.K.D.			

### ELEVATION



Note: Pile Tip elevations shown are estimated elevations.




Proposed 54" Sewer, Invert Elev. 164.72

Note: For Boring Log see Sheet 11 and 12

Boring, denotes 2 1/4" Cased hole






RICHMOND EXPRESSWAY SYSTEM			
SECTION	PROJECT	SHEET NO.	TOTAL SHEETS
7	DOWNTOWN EXPRESSWAY	88	

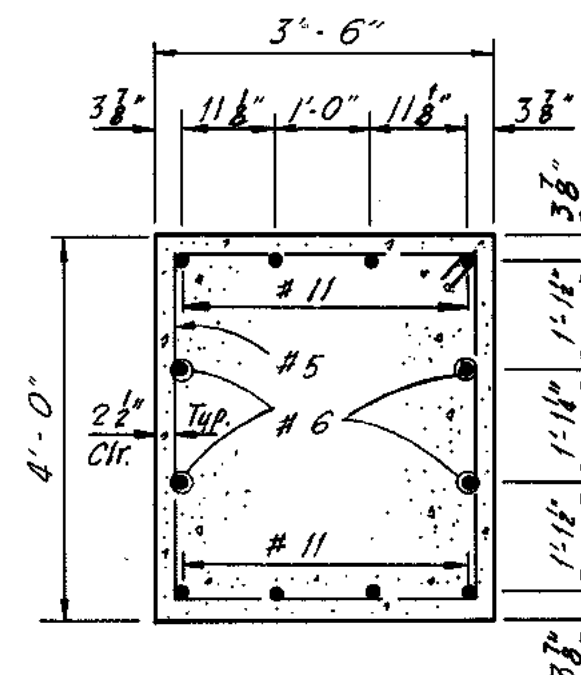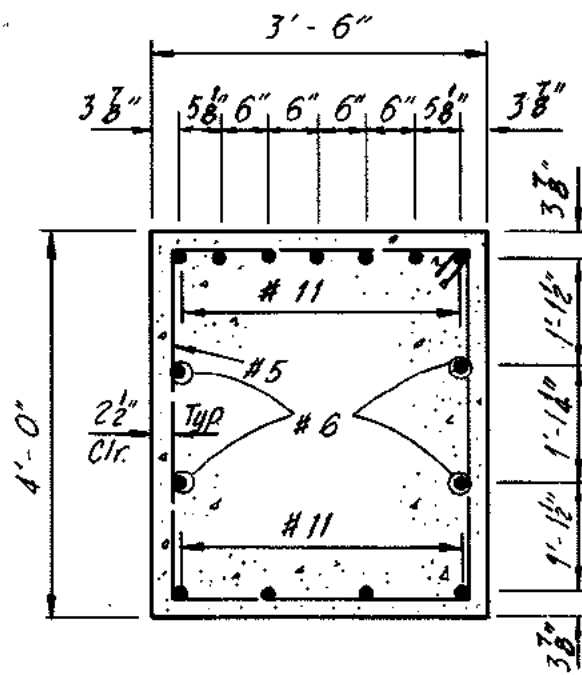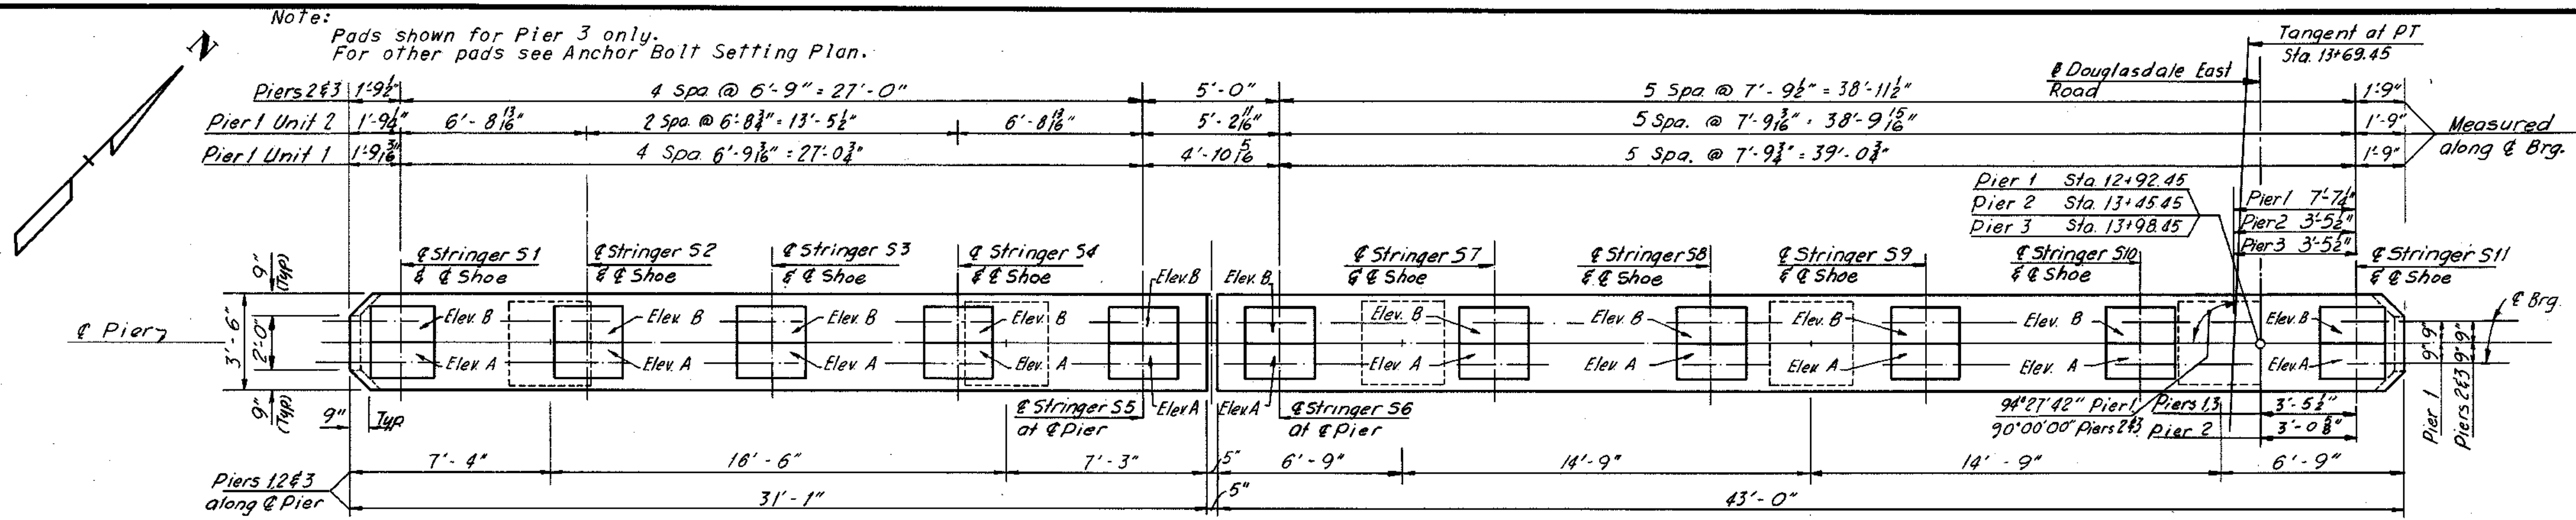

SECTION A-A  
Scale 1/2" = 1'-0"




SECTION B-B  
Scale 1/2" = 1'-0"

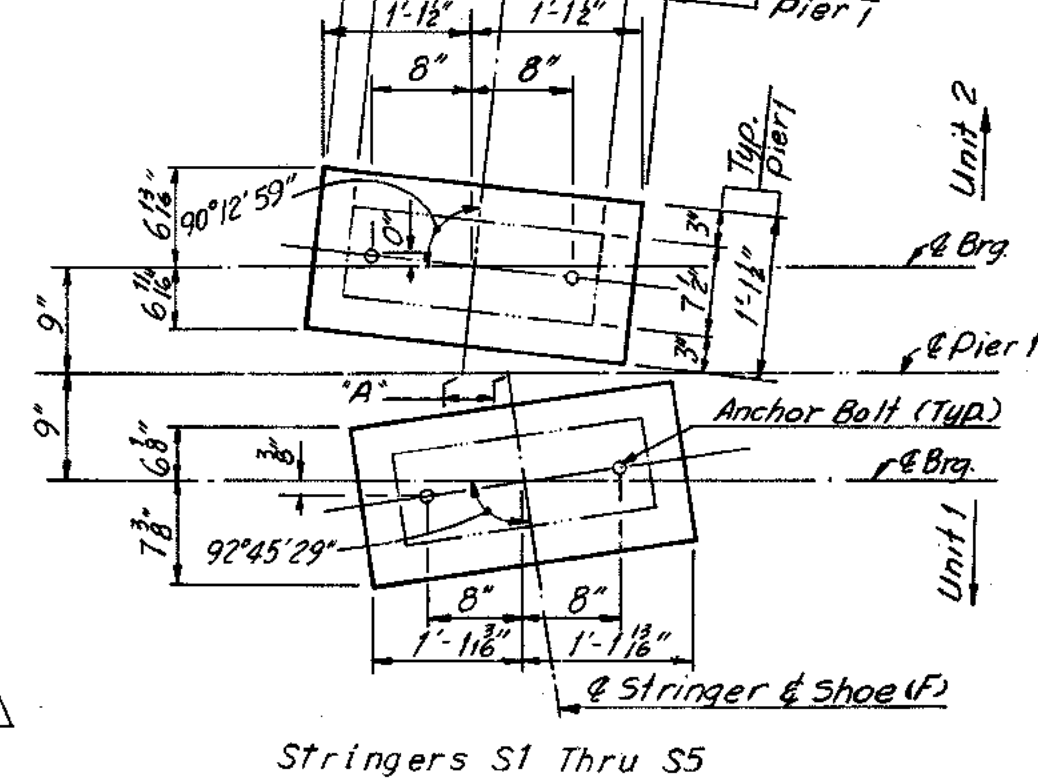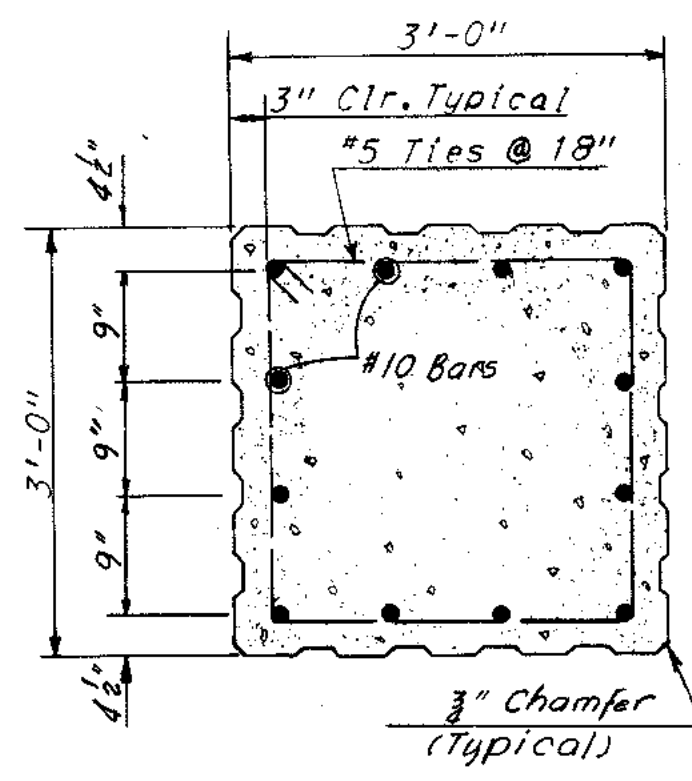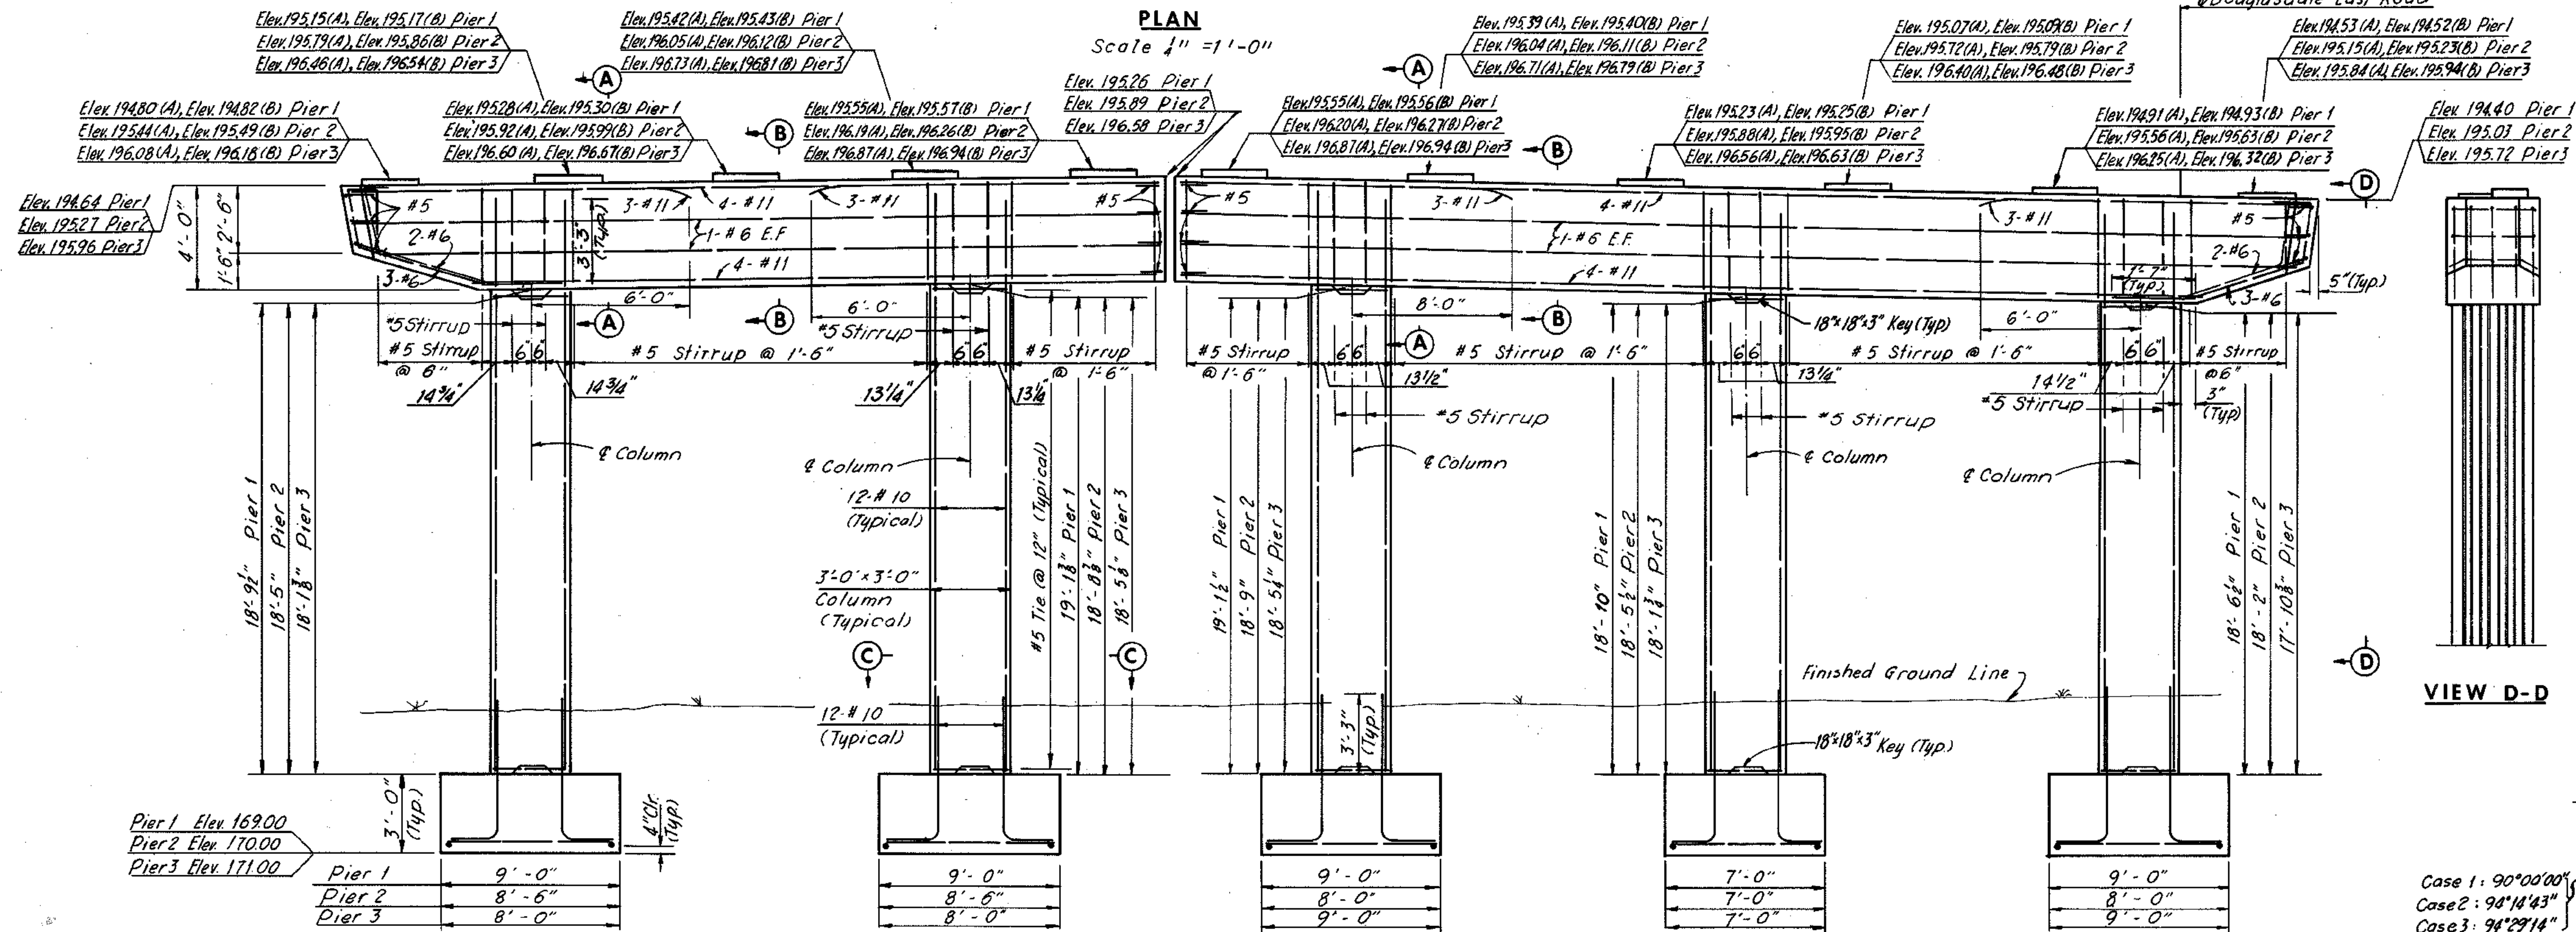

SECTION C-C  
Scale 1/2" = 1'-0"

SECTION D-D  
Scale 1/2" = 1'-0"

VIEW D-D

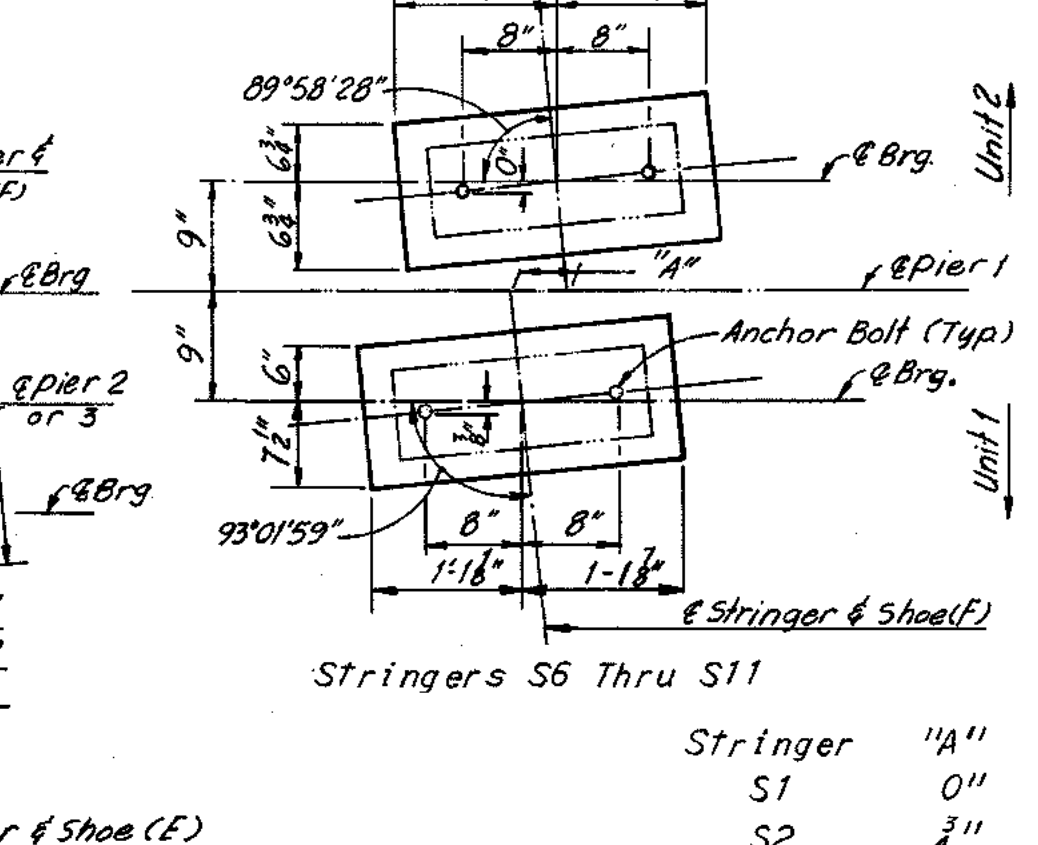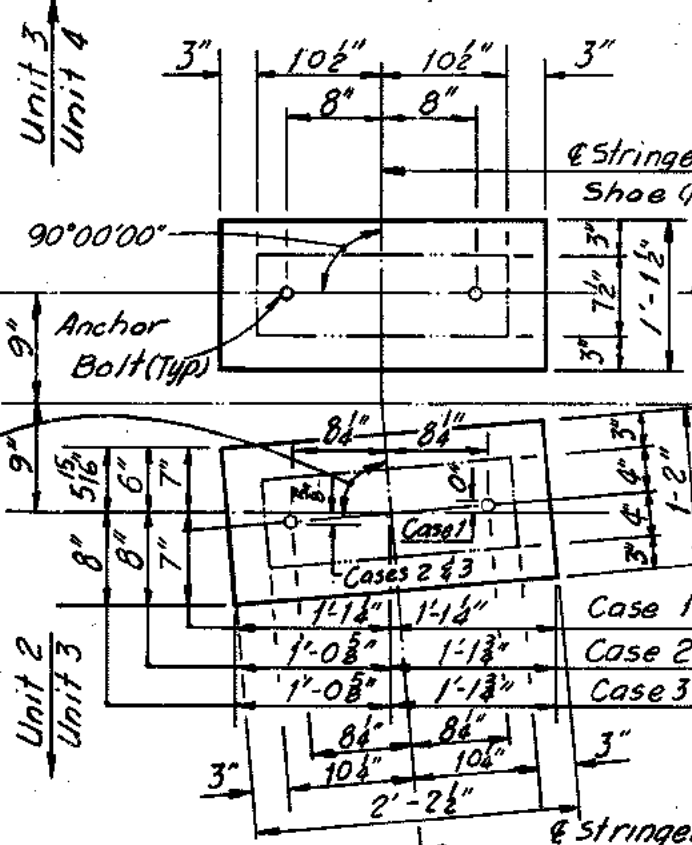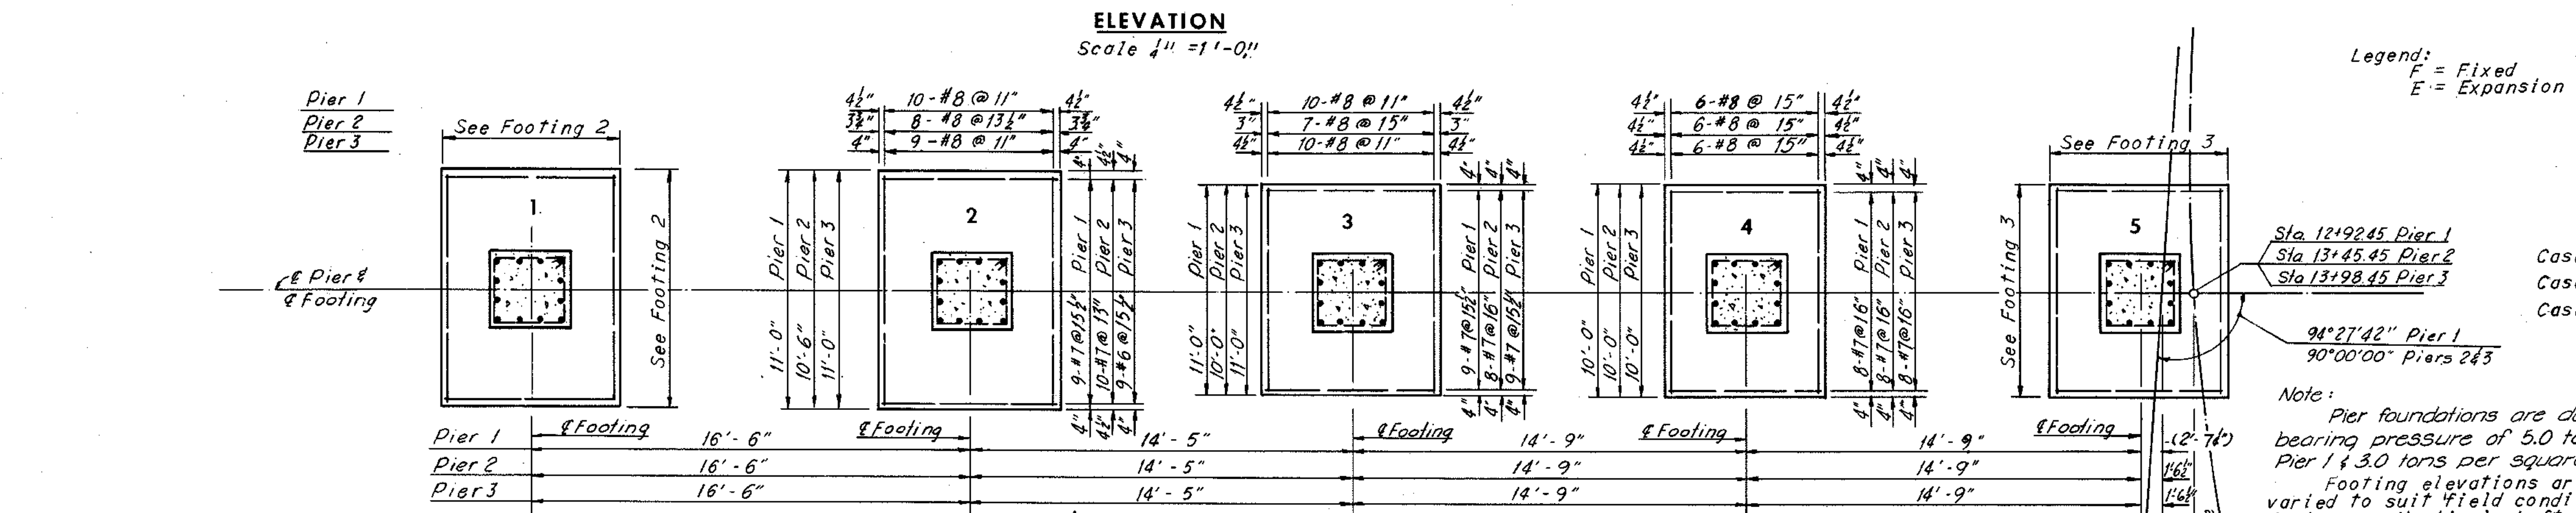

ANCHOR BOLT SETTING PLAN

Stringer	"A"
S1	0"
S2	2 1/2"
S3	1 1/2"
S4	1 1/2"
S5	1 1/2"
S6	2 1/2"
S7	2 1/2"
S8	1 1/2"
S9	1 1/2"
S10	2 1/2"
S11	0"



**AS BUILT**

**RICHMOND METROPOLITAN AUTHORITY**  
**RICHMOND EXPRESSWAY SYSTEM**  
**DOWNTOWN EXPRESSWAY**

**BRIDGE NO. 12**  
**DOUGLASDALE EAST ROAD OVER**  
**S-E-E-S ROADWAYS**

**PIERS**





HOWARD, NEEDLES, TAMMEN & BERGENDOFF  
consulting engineers  
NEW YORK ALEXANDRIA KANSAS CITY

SCALE: As noted  
CONTRACT NO.: 7  
SHEET NO.: 5 OF 12

BY	DATE	REVISION	BY	DATE
MADE	S.S.W. 12-22-67			
CHECKED	G.C.C. 12-12-68	1 As Built	T.E.M. 9-75	
IN CHARGE	F.K.D.			

RICHMOND EXPRESSWAY SYSTEM			
SECTION	PROJECT	SHEET NO.	TOTAL SHEETS
7	DOWNTOWN EXPRESSWAY	89	

SHOE SCHEDULE			
EXPANSION SHOES		FIXED SHOES	
TYPE	NO. REQD.	TYPE	NO. REQD.
E1	44	F1	36
		F1M	8

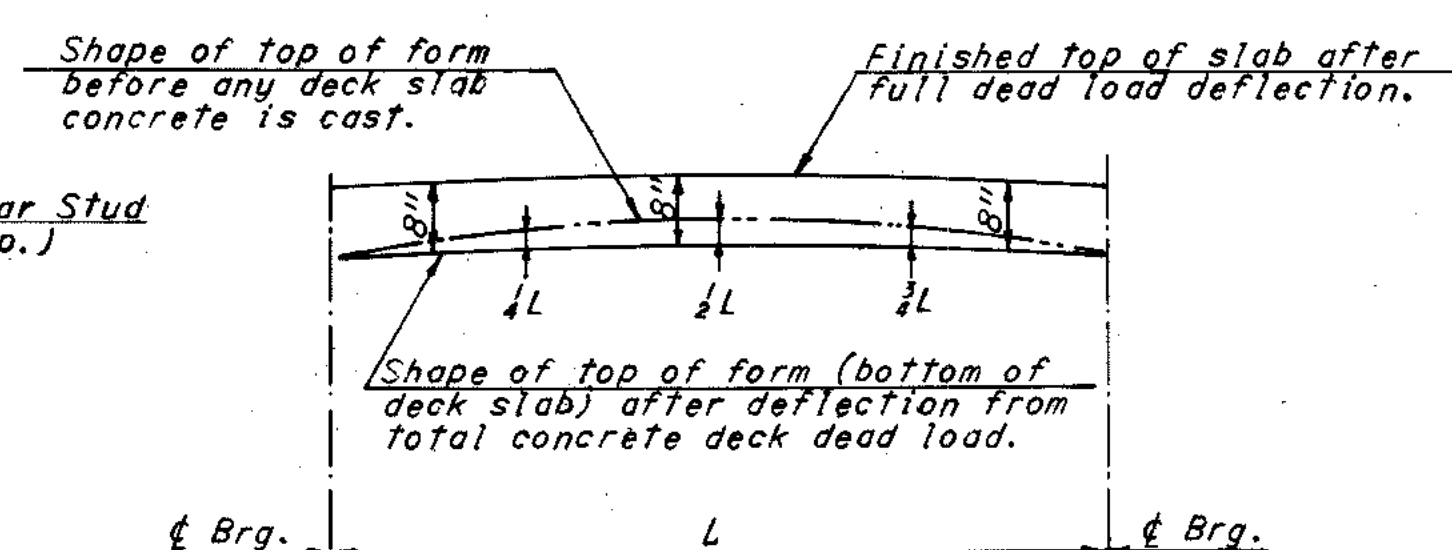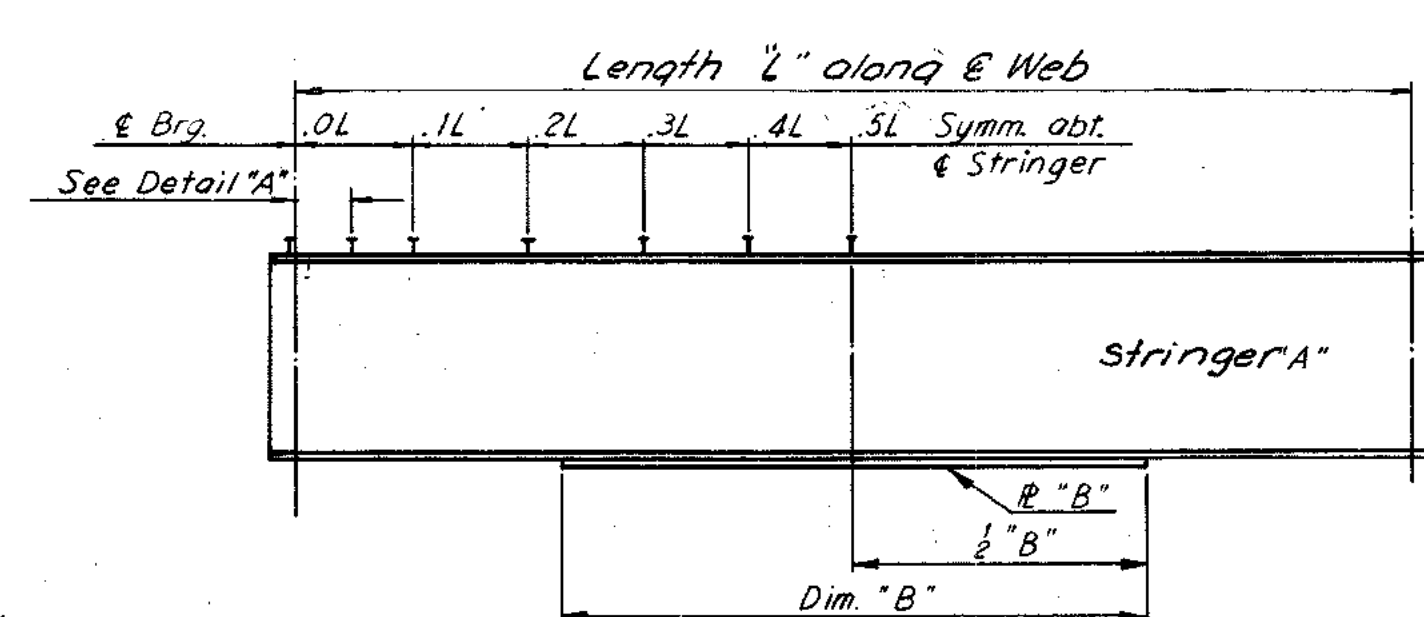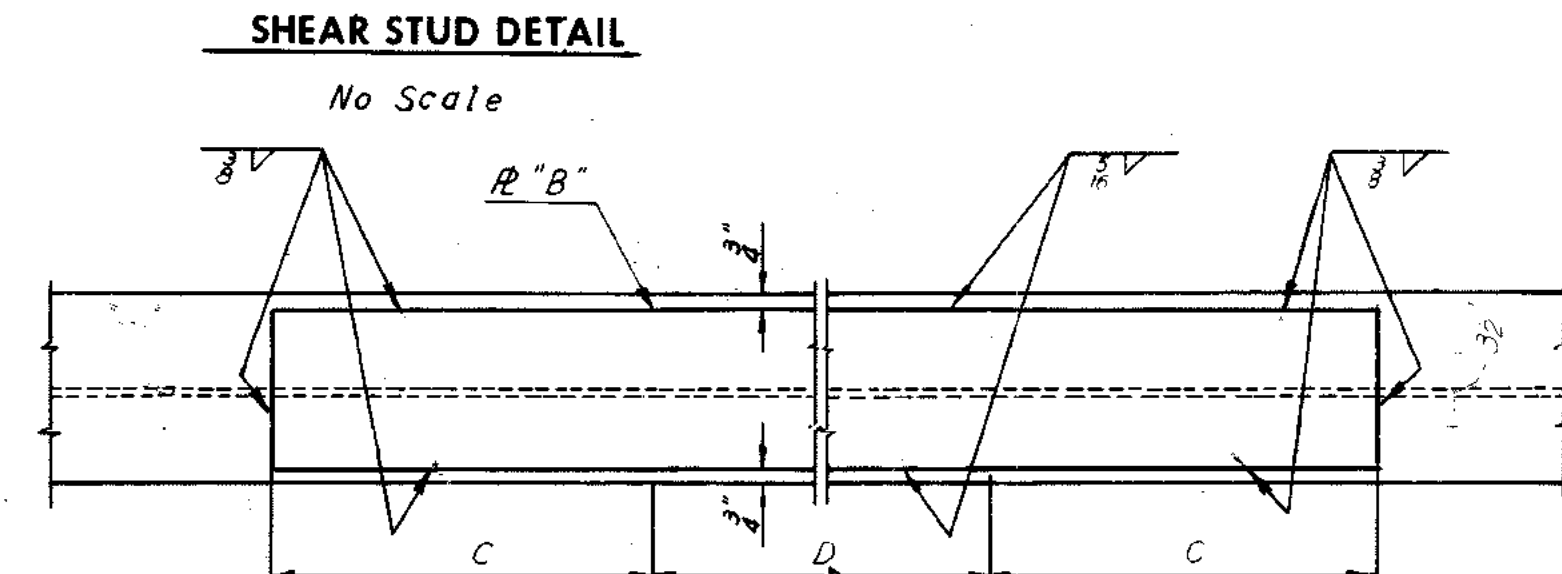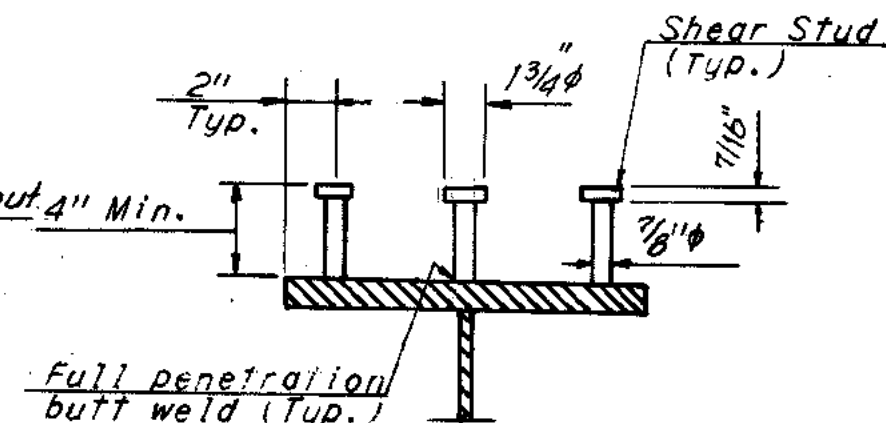

**NOTE TO CONTRACTOR**

Deflections given are those anticipated to occur in the stringer upon placement of the total concrete deck dead load.

In practice, the stringers in place are not likely to have the exact camber to compensate for these deflections during construction. The residual amounts shall be provided by adjusting forms to vary the thickness of the concrete haunch between the bottom of the slab and the top of stringer, without altering the slab thickness.



RICHMOND METROPOLITAN AUTHORITY  
RICHMOND EXPRESSWAY SYSTEM  
DOWNTOWN EXPRESSWAY

BRIDGE NO. 12  
DOUGLASDALE EAST ROAD OVER  
S-E-E-S ROADWAYS  
FRAMING PLAN

HOWARD, NEEDLES, TAMMEN & BERGENDORFF  
consulting engineers  
NEW YORK ALEXANDRIA KANSAS CITY

SCALE: As noted  
CONTRACT NO.: 7  
SHEET NO. 6 OF 12


UNIT	STRINGER	D.L. DEFLECTION		CAMBER SCHEDULE	
		4L	2L	4L	2L
1	S1	1/16	1/16	1/16	1/16
	S2S3S4	1/16	1/16	1/16	1/16
	S5	1/16	1/16	1/16	1/16
	S6	1/16	1/16	1/16	1/16
	S7S8S9S10	1/16	1/16	1/16	1/16
2	S11	1/16	1/16	1/16	1/16
	S1	1/16	1/16	1/16	1/16
	S2	1/16	1/16	1/16	1/16
	S3	1/16	1/16	1/16	1/16
	S4	1/16	1/16	1/16	1/16
	S5	1/16	1/16	1/16	1/16
	S6	1/16	1/16	1/16	1/16
	S7	1/16	1/16	1/16	1/16
	S8	1/16	1/16	1/16	1/16
	S9	1/16	1/16	1/16	1/16
	S10	1/16	1/16	1/16	1/16
3	S11	1/16	1/16	1/16	1/16
	S2S3S4	1/16	1/16	1/16	1/16
	S5	1/16	1/16	1/16	1/16
	S6	1/16	1/16	1/16	1/16
	S7S8S9S10	1/16	1/16	1/16	1/16
4	S11	1/16	1/16	1/16	1/16
	S1	1/16	1/16	1/16	1/16
	S2S3S4	1/16	1/16	1/16	1/16
	S5	1/16	1/16	1/16	1/16
	S6	1/16	1/16	1/16	1/16

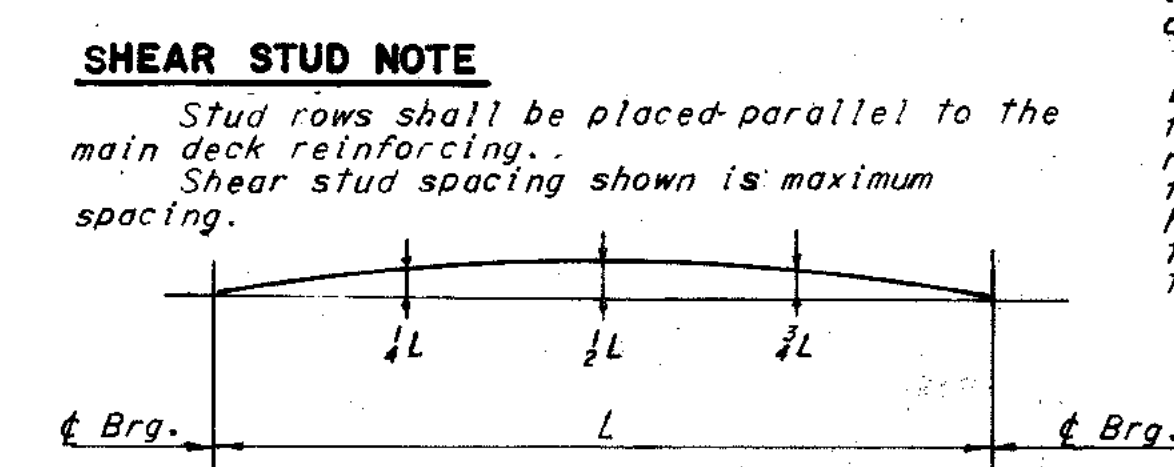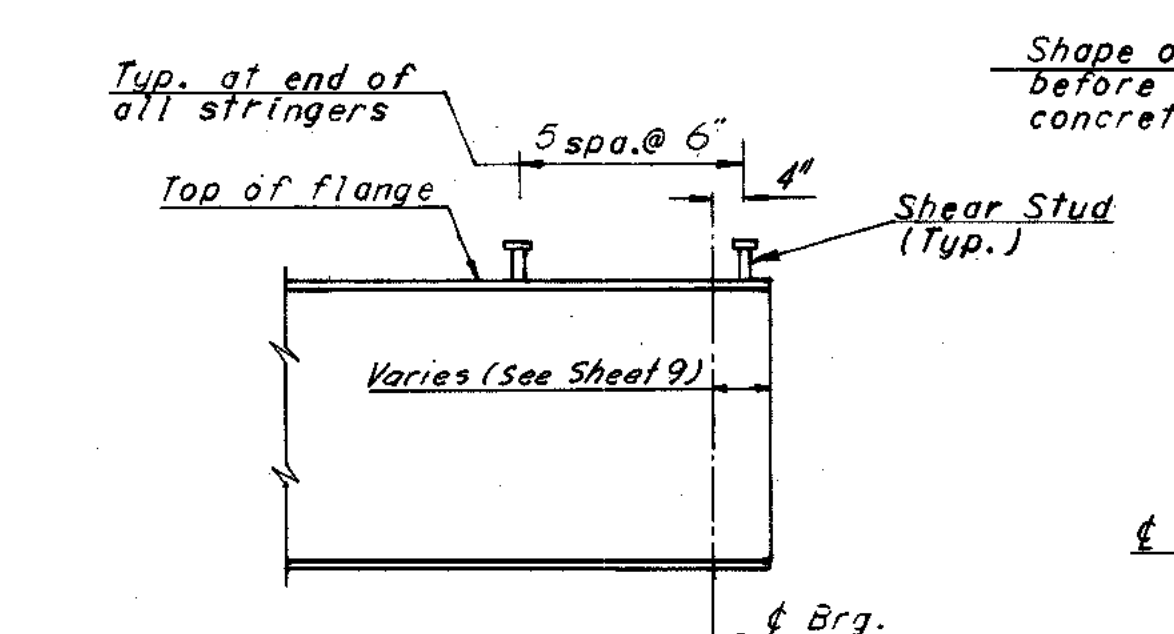

**NOTE TO FABRICATOR**

Stringers shall be fabricated with an upward camber amounting to the tabulated value. This will provide approximate compensation for deflection under full dead load and for conformity with finished grade. Dimensions are in inches.

**FRAMING PLAN**  
Scale: 3/8" = 1'-0"

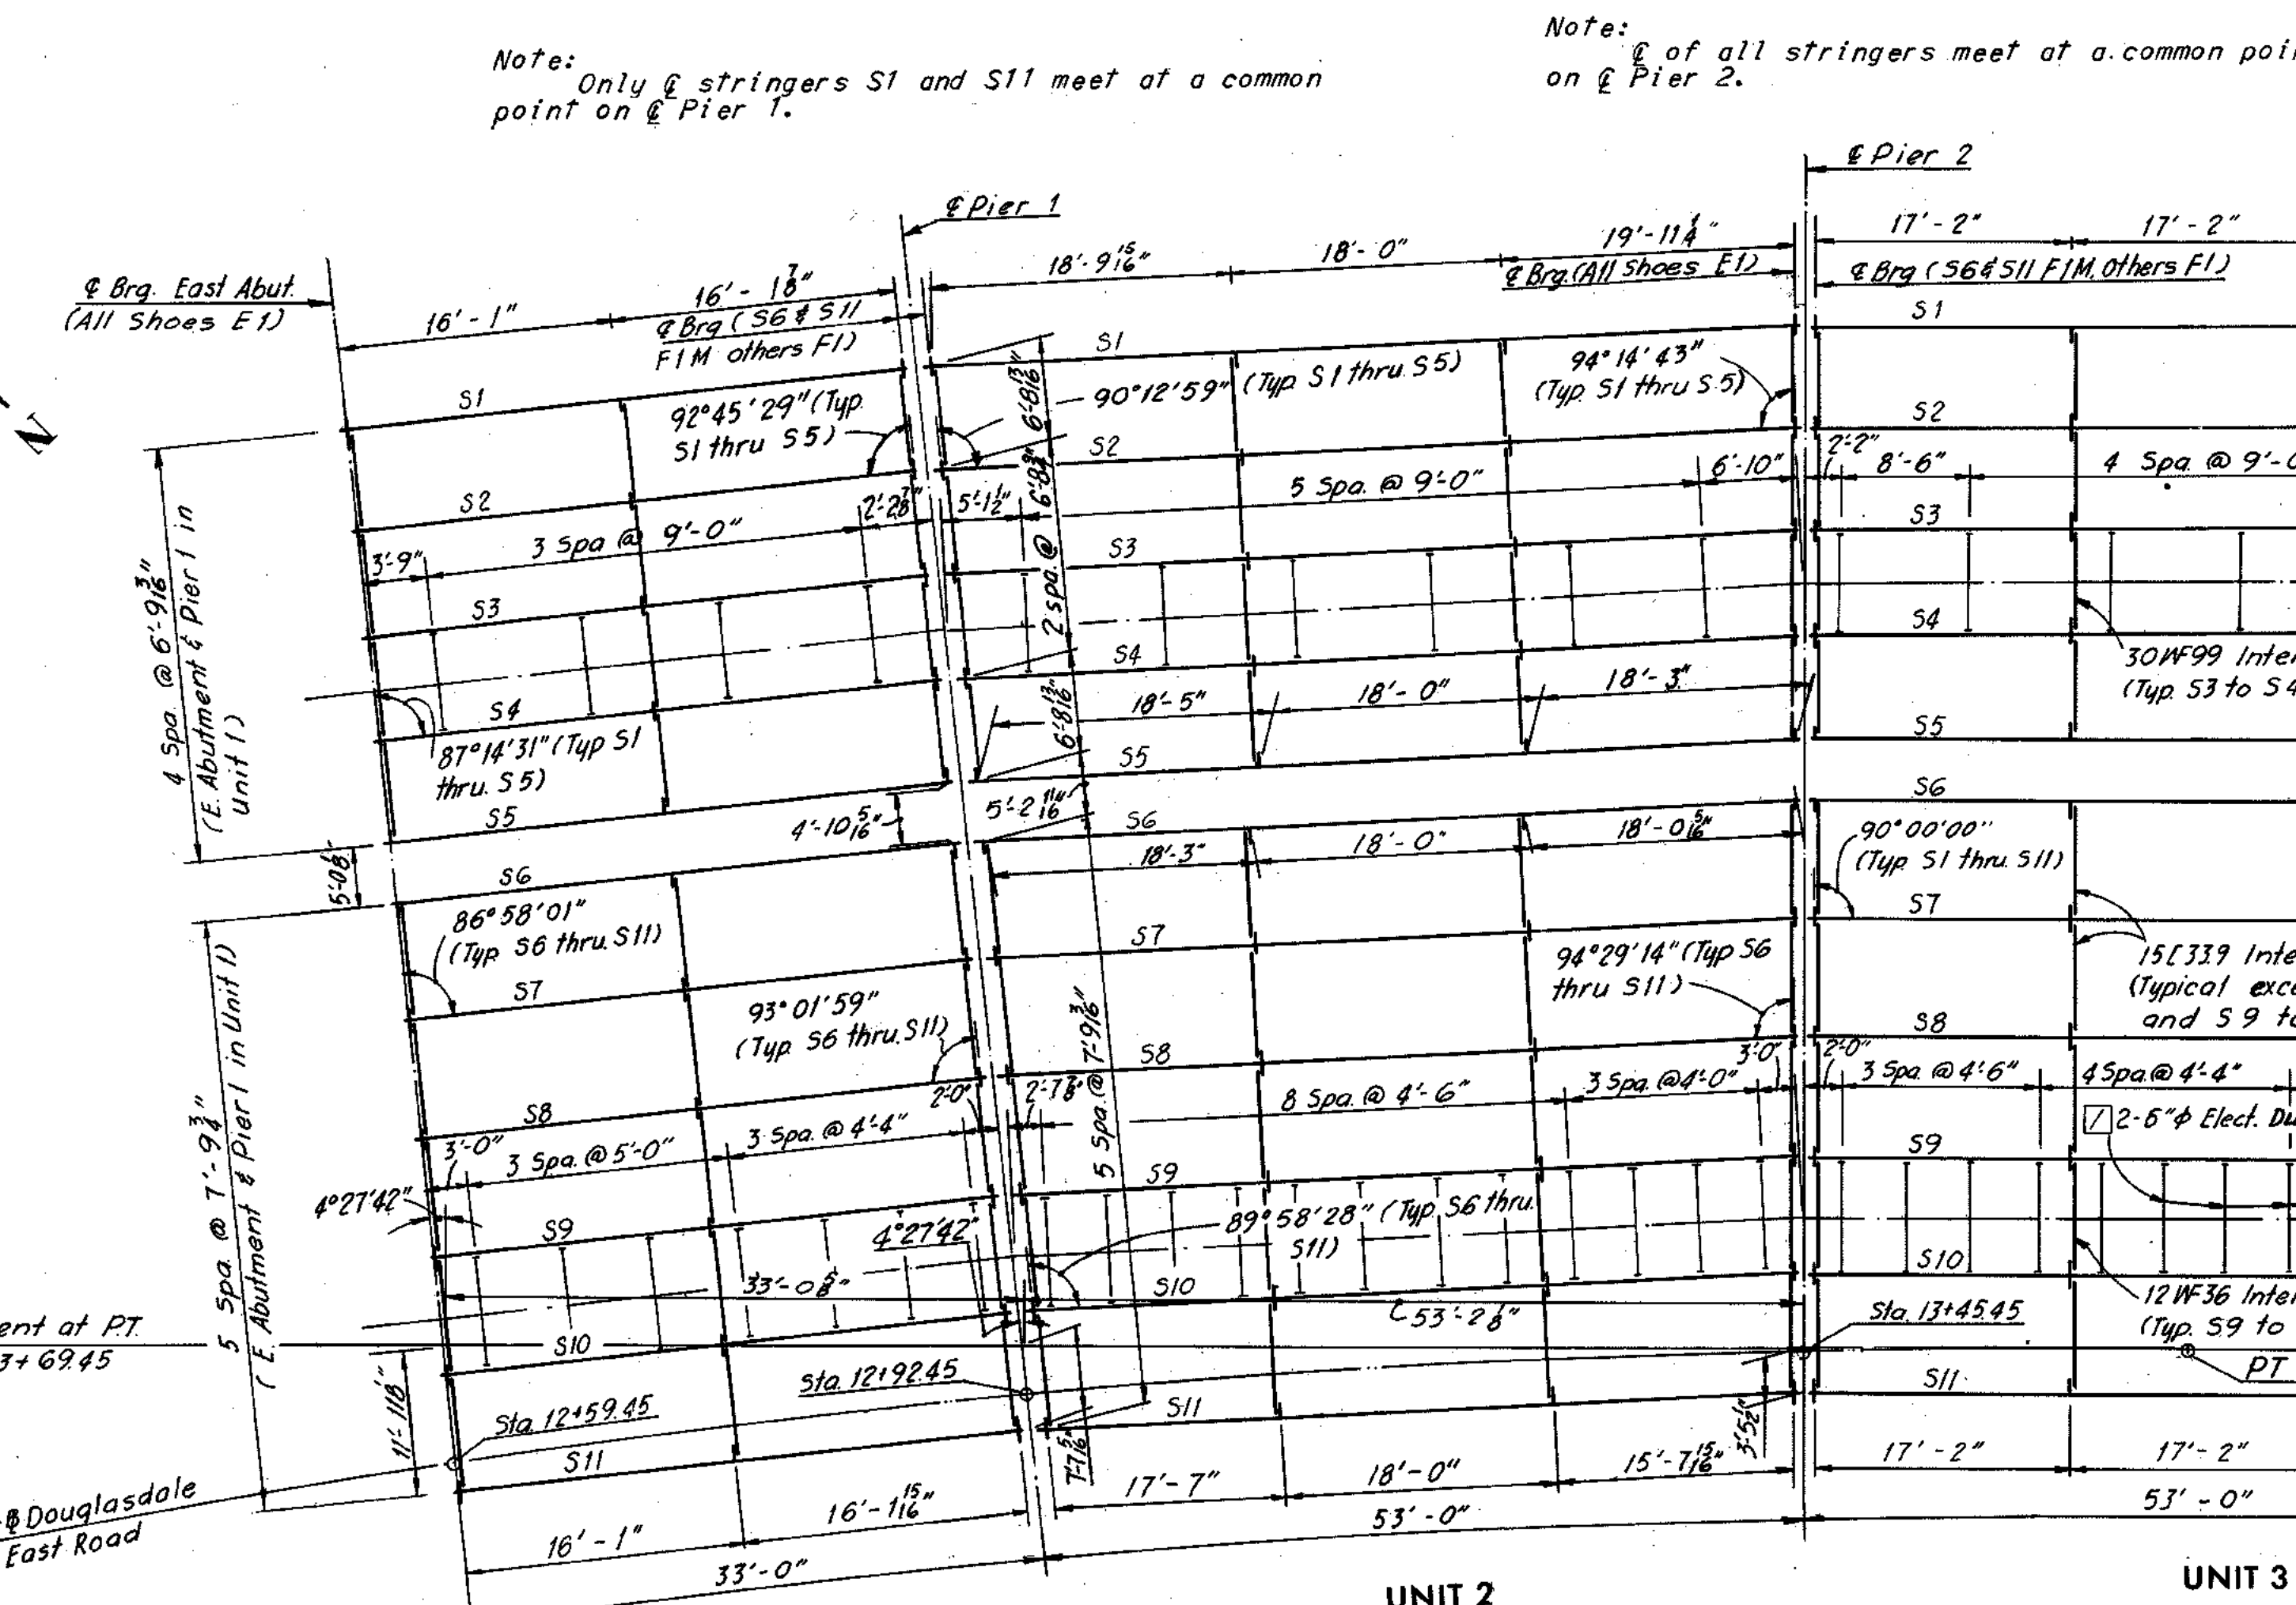

UNIT	STRINGER	LENGTH	STRINGER "A"	R "B"	DIM "B"	C	D	MAX. SHEAR STUD SPACING				
								0.0L-0.1L	0.1L-0.2L	0.2L-0.3L	0.3L-0.4L	0.4L-0.5L
1	S1	32'-2 1/2"	36 W 135	—	—	—	—	10 1/2"	11"	1'-1"	1'-2"	1'-2"
	S2ThruS5	32'-2 1/2"	33 W 118	—	—	—	—	8 1/2"	9"	10"	1'-1"	1'-4"
	S6ThruS10	32'-2 1/2"	33 W 118	—	—	—	—	8 1/2"	9"	10"	1'-1"	1'-4"
	S11	32'-2 1/2"	36 W 135	—	—	—	—	10 1/2"	11"	1'-1"	1'-2"	1'-2"
	S1	56'-1'-0"	36 W 135	10 1/2"x8"	40'-0"	2'-0"	36'-0"	7 1/2"	8 1/2"	10"	1'-0"	1'-4"
2	S2	56'-1'-0"	33 W 118	10 1/2"x8"	43'-0"	2'-0"	39'-0"	7 1/2"	8 1/2"	10"	1'-0"	1'-4"
	S3	55'-1'-0"	33 W 118	10 1/2"x8"	43'-0"	2'-0"	39'-0"	7 1/2"	8 1/2"	10"	1'-0"	1'-4"
	S4	55'-1'-0"	33 W 118	10 1/2"x8"	43'-0"	2'-0"	39'-0"	7 1/2"	8 1/2"	10"	1'-0"	1'-4"
	S5	54'-1'-0"	33 W 118	10 1/2"x8"	41'-0"	2'-0"	37'-0"	7 1/2"	8 1/2"	10"	1'-0"	1'-4"
	S6	54'-1'-0"	33 W 118	10 1/2"x8"	41'-0"	2'-0"	37'-0"	7 1/2"	8 1/2"	10"	1'-0"	1'-4"
	S7	53'-1'-0"	33 W 118	10 1/2"x8"	41'-0"	2'-0"	37'-0"	7 1/2"	8 1/2"	10"	1'-0"	1'-4"
	S8	53'-1'-0"	33 W 118	10 1/2"x8"	41'-0"	2'-0"	37'-0"	7 1/2"	8 1/2"	10"	1'-0"	1'-4"
	S9	52'-1'-0"	33 W 118	10 1/2"x8"	41'-0"	2'-0"	37'-0"	7 1/2"	8 1/2"	10"	1'-0"	1'-4"
	S10	51'-1'-0"	33 W 118	10 1/2"x8"	41'-0"	2'-0"	37'-0"	7 1/2"	8 1/2"	10"	1'-0"	1'-4"
	S11	51'-1'-0"	36 W 150	—	—	—	—	7 1/2"	8 1/2"	10"	1'-0"	1'-4"
	S1 and S11	51'-6"	36 W 150	—	—	—	—	7 1/2"	8 1/2"	10"	1'-0"	1'-4"
3	S2ThruS10	51'-6"	33 W 118	10 1/2"x8"	39'-0"	2'-0"	35'-0"	7 1/2"	8 1/2"	10"	1'-0"	1'-4"
	S1 and S11	31'-3"	36 W 135	—	—	—	—	10 1/2"	11"	1'-1"	1'-2"	1'-2"
4	S2ThruS10	31'-3"	33 W 118	—	—	—	—	8 1/2"	9"	10"	1'-1"	1'-4"


**Note:** Stringers having a total camber of less than 1" are not required to be shop cambered, but should be turned so that any mill tolerance deviation from straightness will be in the direction shown by the Camber diagram.

If stringers are not cambered distance top of stringers to top of slab will vary along the stringer in accordance with the offset dimensions shown in the Camber diagram, and with a minimum distance as shown in cross-section on Sheet 7.

MADE	BY	DATE	As Built		
CHECKED	G.C.C.	2-2-68	5'-4" VEPPO Camber changed to 6'-0"	L.B.P.	1-74
IN CHARGE	F.K.D.				

**Note:**  
For Structural Steel Quantities see Sheet 1.  
For Standard Shoe details see Sheet S1.  
For Framing details see Sheet 7.

\*Denotes spacing which begins at termination of 5 spaces @ 6".

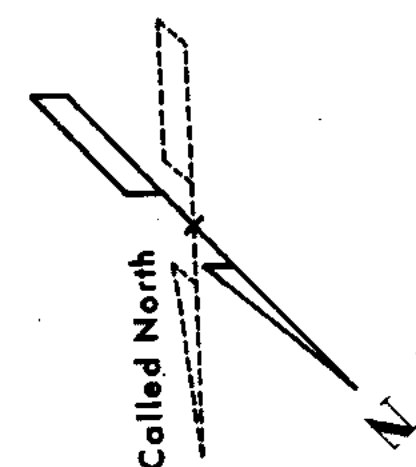

**Note:** Only @ stringers S1 and S11 meet at a common point on @ Pier 1.



**Note:** @ of all stringers meet at a common point on @ Pier 2.

**AS BUILT**






RICHMOND EXPRESSWAY SYSTEM			
SECTION	PROJECT	SHEET NO.	TOTAL SHEETS
7	DOWNTOWN EXPRESSWAY	91	

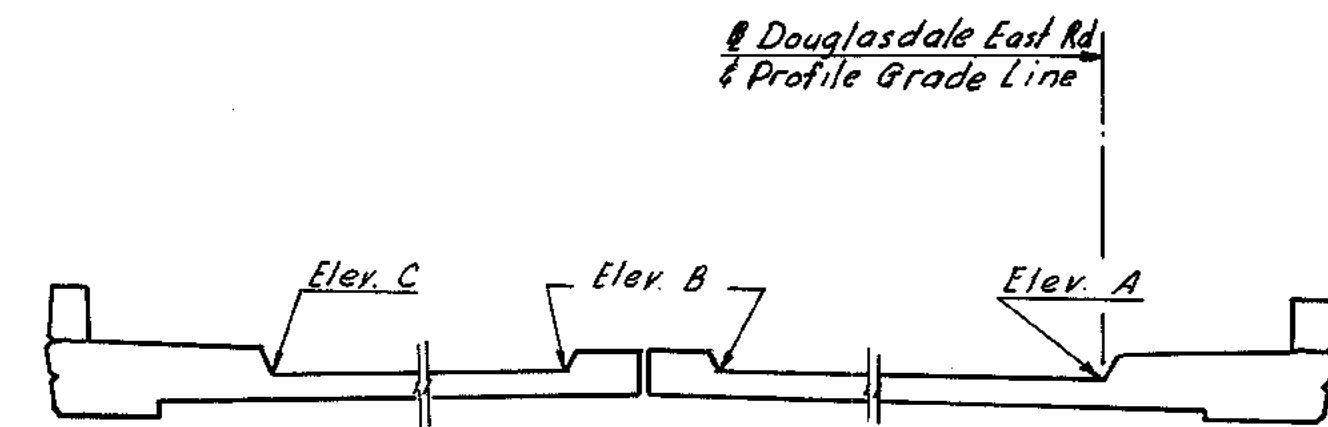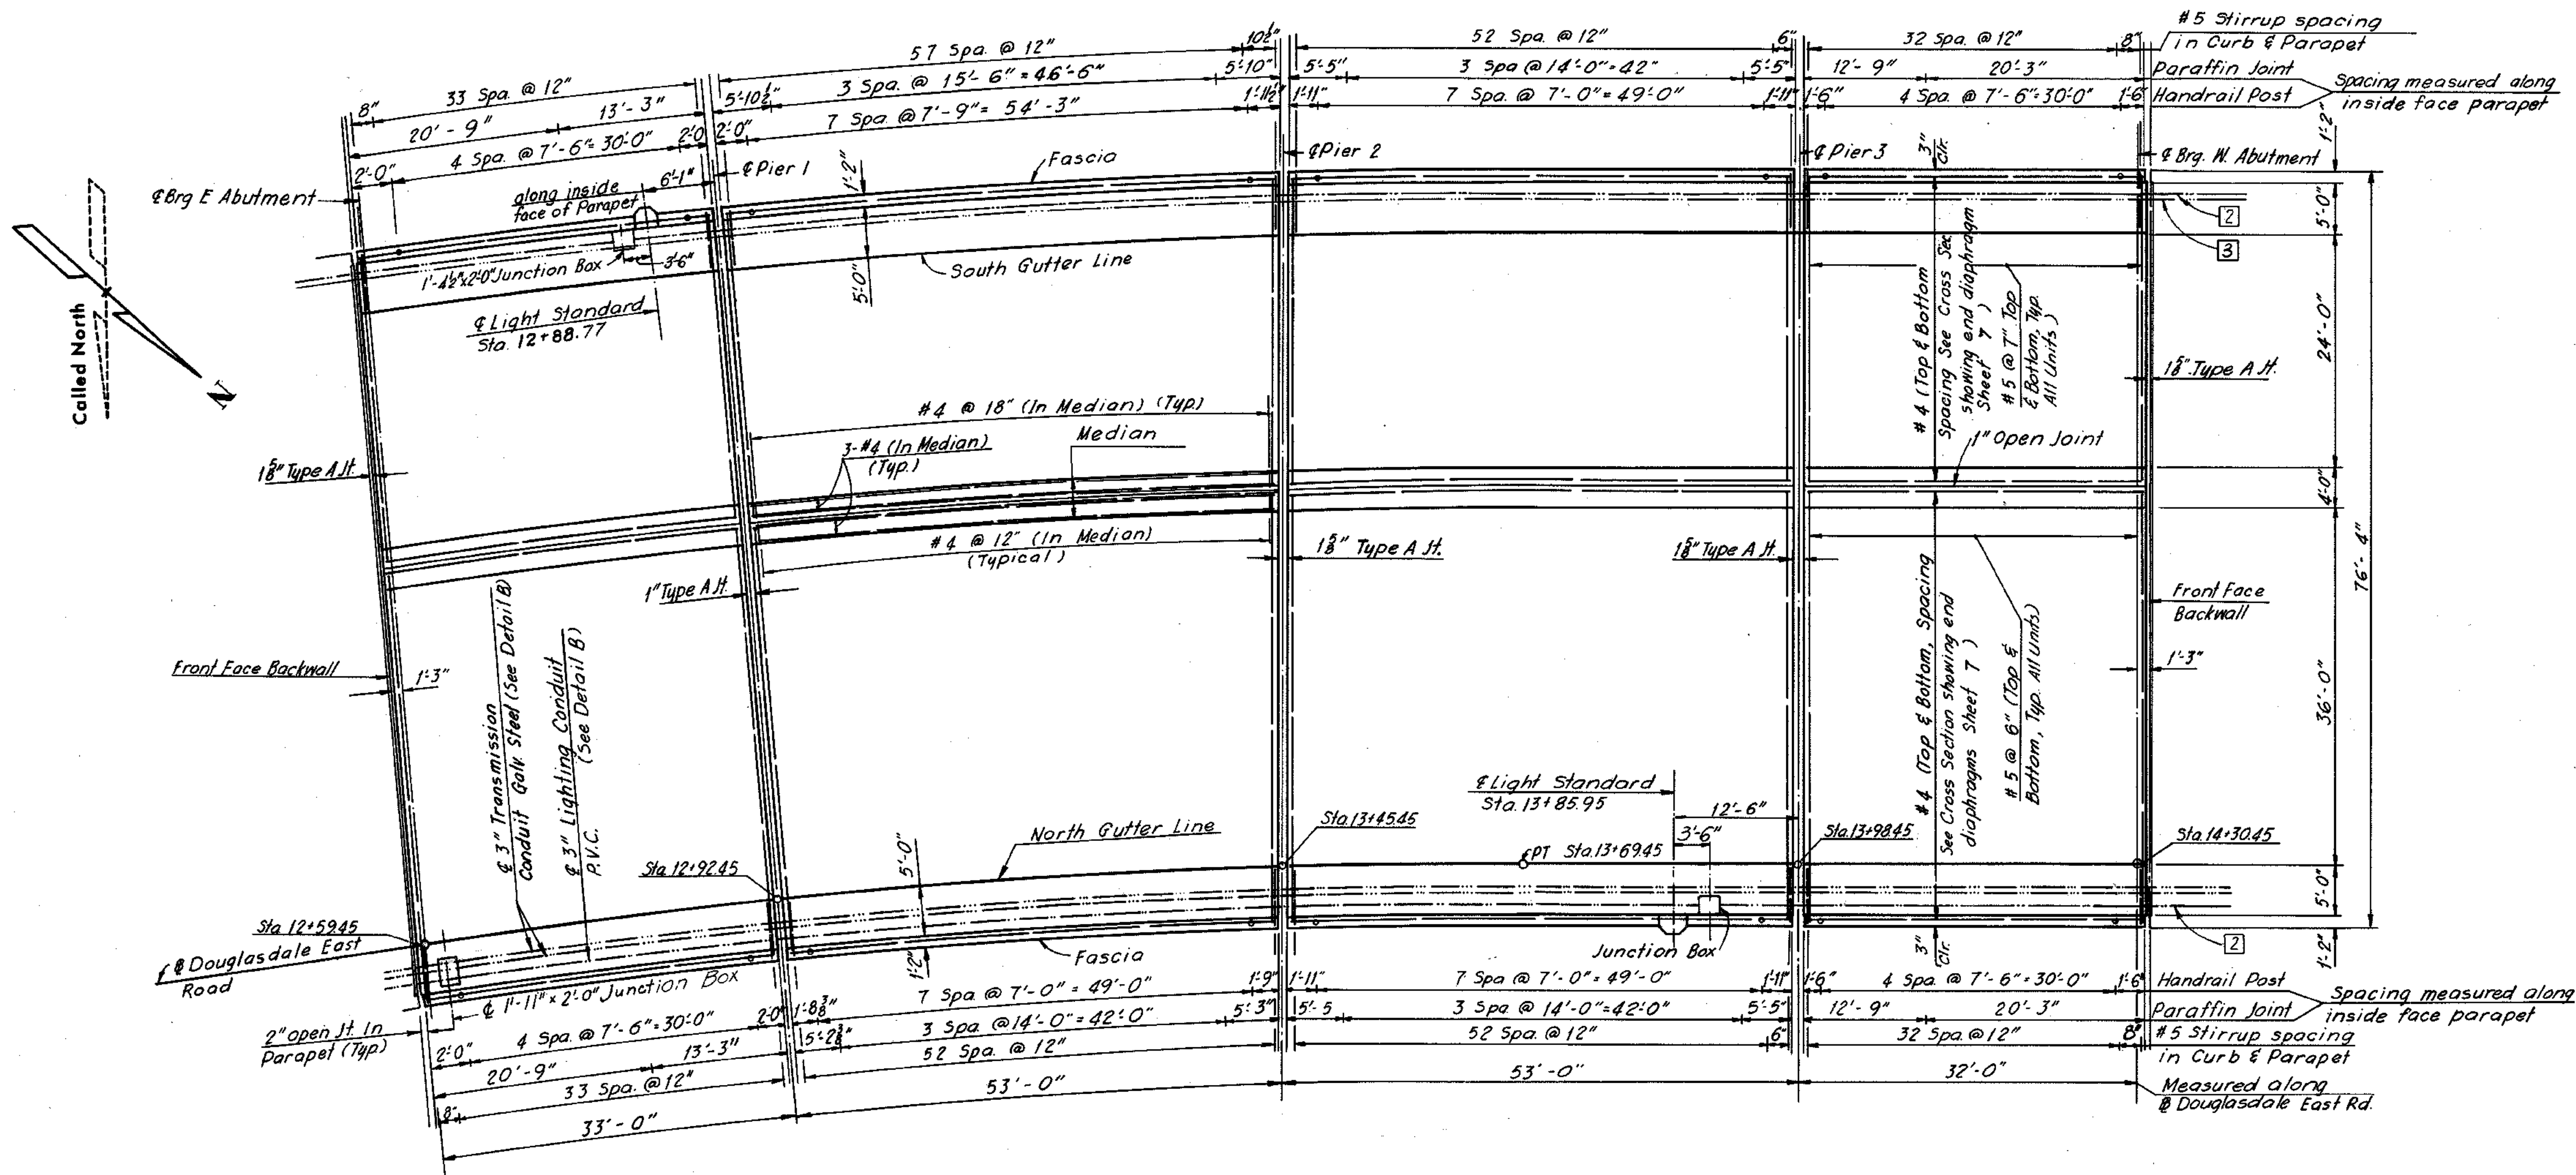


GUTTERLINE ELEVATIONS			
STATION	ELEV A	ELEV B	ELEV C
12+50.00	198.24	198.96	198.48
12+58.20	198.34	—	—
12+59.45	198.36	—	—
12+60.00	198.37	199.09	198.61
12+60.86	—	199.10	—
12+61.14	—	199.10	—
12+62.76	—	—	198.64
12+70.00	198.50	199.22	198.74
12+80.00	198.63	199.35	198.87
12+90.00	198.76	199.48	199.00
12+92.45	198.79	—	—
12+93.47	—	199.52	—
12+93.57	—	199.53	—
12+94.19	—	—	199.05
13+00.00	198.89	199.61	199.13
13+10.00	199.02	199.74	199.26
13+20.00	199.15	199.87	199.39
13+30.00	199.28	200.00	199.52
13+40.00	199.41	200.13	199.65
13+45.45	199.49	—	—
13+46.80	—	200.22	—
13+46.72	—	200.22	—
13+47.42	—	—	199.75
13+50.00	199.55	200.27	199.79
13+60.00	199.68	200.40	199.92
13+70.00	199.81	200.53	200.05
13+80.00	199.94	200.66	200.18
13+90.00	200.07	200.79	200.31
13+98.45	200.18	200.90	200.42
14+00.00	200.20	200.92	200.44
14+10.00	200.33	201.05	200.57
14+20.00	200.46	201.18	200.70
14+30.00	200.59	201.31	200.83
14+30.45	200.60	201.32	200.84
14+31.70	200.62	201.34	200.86
14+40.00	200.72	201.44	200.96

DECK PLAN  
Scale: 3/32" = 1'-0"

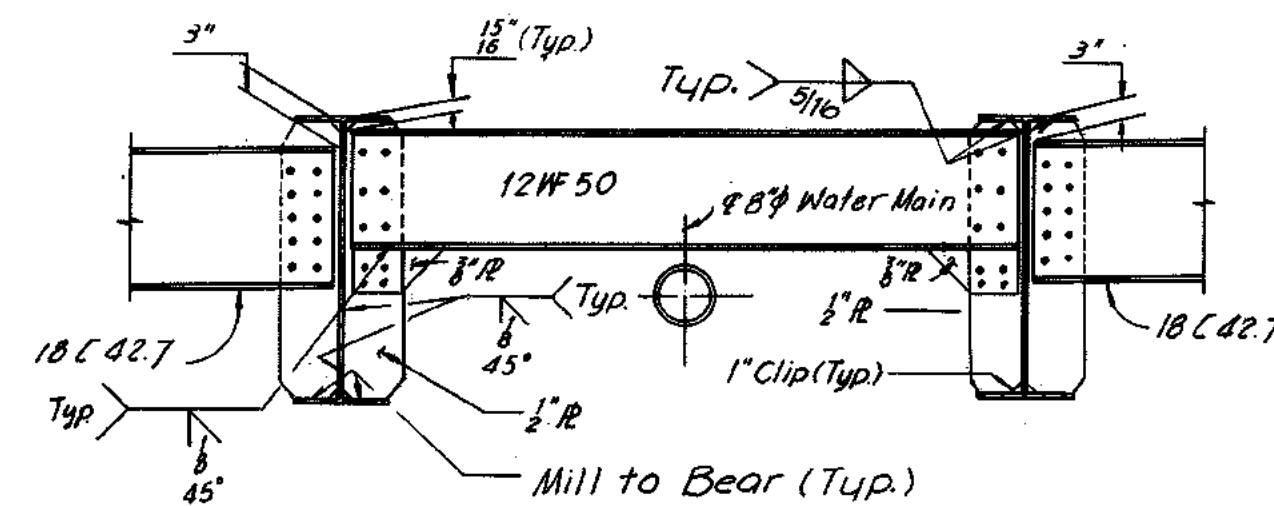

END DIAPHRAGM AT UTILITY BAY  
DETAIL D

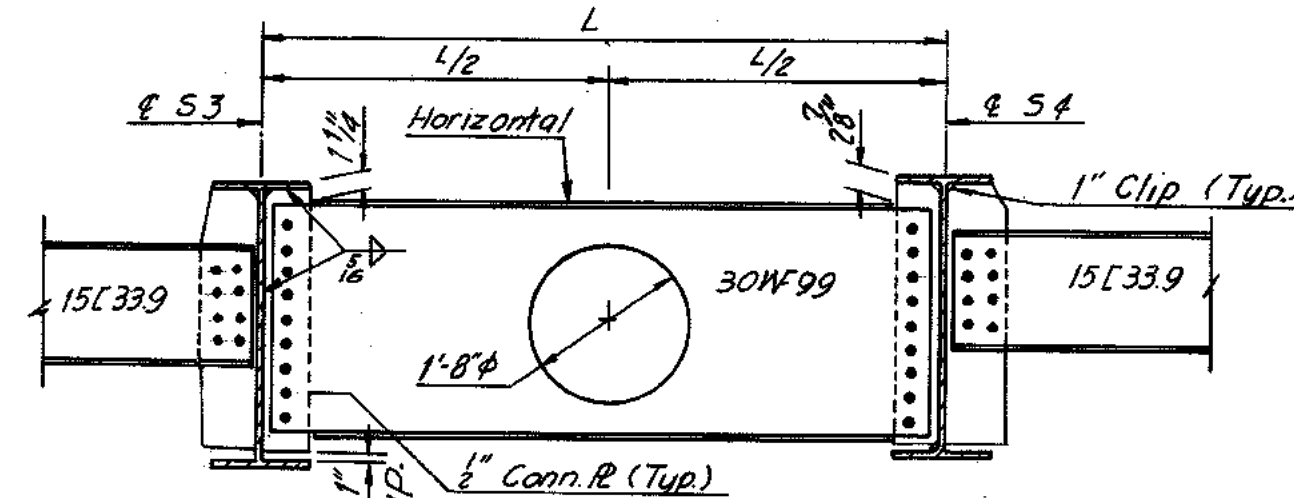


INTERMEDIATE DIAPHRAGM AT UTILITY BAY  
DETAIL C


No Scale

3 Junction Boxes  
each:  
2'-0" x 1'-4 1/2"  
2'-0" x 1'-1 1/2"  
2'-0" x 1'-11"

Note:  
For Superstructure concrete quantities see Sheet 1.  
For Framing Plan see Sheet 6.  
For Framing details see Sheet 7.  
For Joint details see Sheet 9.  
For Standard Lighting details see Sheet 54.  
For Standard handrail (2 rails) details see Sheet 53.

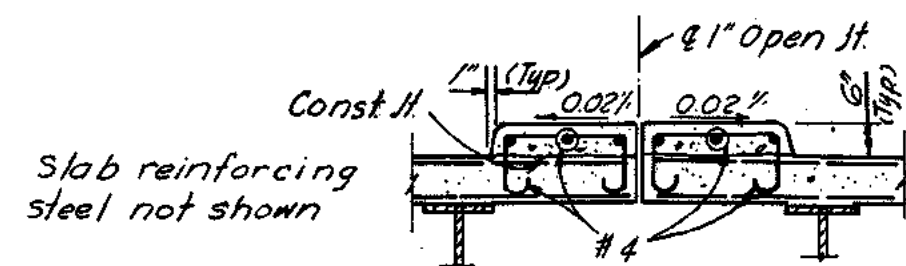

DETAIL A  
Scale: 3/8" = 1'-0"

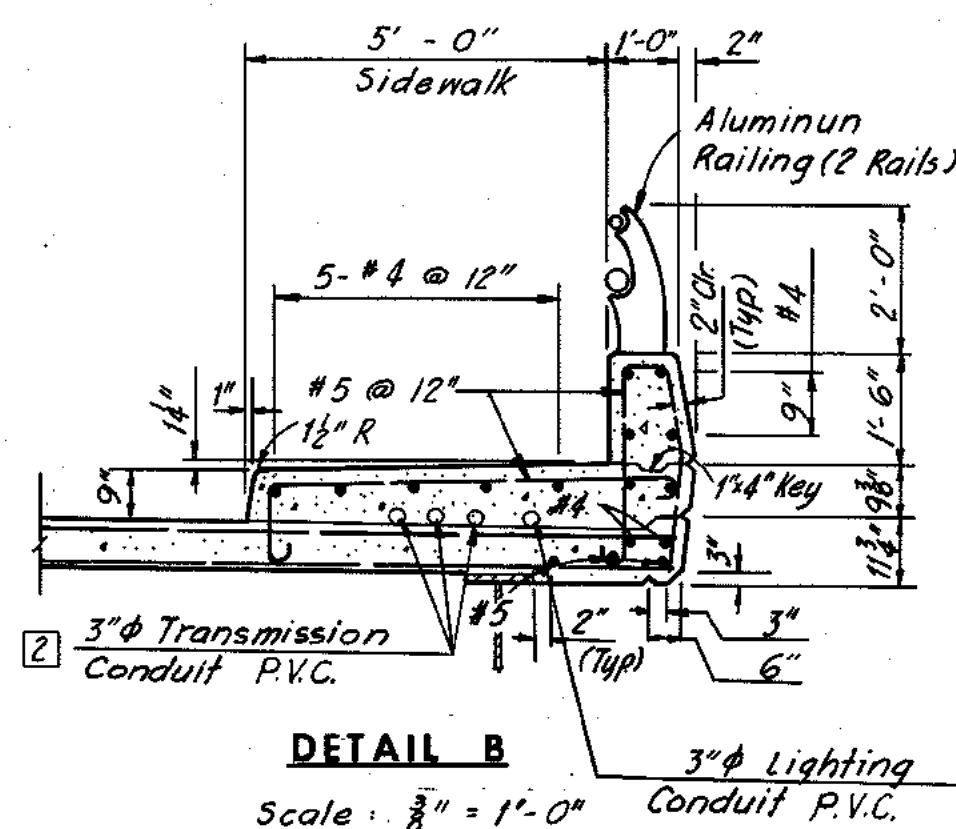

DETAIL B  
Scale: 3/8" = 1'-0"

	BY	DATE	4	As Built	TEM	9-75
			3	Move 3\"/>	TEM	1-74
MADE	S.S.W.	11-8-68	2	2\"/>	L.B.P.	1-74
CHECKED	G.C.C.	2-10-68	1	General Revisions	S.S.W.	5-14-68
IN CHARGE	F.K.D.		NO.	REVISION	BY	DATE

RICHMOND METROPOLITAN AUTHORITY  
RICHMOND EXPRESSWAY SYSTEM  
DOWNTOWN EXPRESSWAY

BRIDGE NO. 12  
DOUGLASDALE EAST ROAD OVER  
S-E-S ROADWAYS  
DECK PLAN

HOWARD, NEEDLES, TAMMEN & BERGENDOFF  
consulting engineers  
NEW YORK ALEXANDRIA KANSAS CITY

SCALE: As noted  
CONTRACT NO. 7  
SHEET NO. 8 OF 12

AS BUILT





# **Bridge 13**

**Douglasdale Road  
Over**

**Northbound and Southbound Powhite Parkway (VA-76) connector to I-195 and CSX Railroad**

**Record Set Plans**



RICHMOND EXPRESSWAY SYSTEM			
SECTION	PROJECT	SHEET NO.	TOTAL SHEETS
4	BELTLINE EXPRESSWAY	118	155

# GENERAL NOTES

ROADWAY: One 28'-0" clear roadway, two 5'-0" sidewalks.  
CAPACITY: Dead Load includes 15 lbs. per sq. ft. for future wearing surface.  
Live Loads - HS20-44 loading.

SPECIFICATIONS: GENERAL: Virginia Department of Highway Road and Bridge Specifications 1970.  
DESIGN: A.A.S.H.O. Standard Specifications for Highway Bridges 1961 modified by Special Design Provisions.  
WELDING: 1969 Standard Specifications for Welded Highway and Railway Bridges of the American Welding Society.

CONTRACT SPECIAL PROVISIONS  
Specifications and Contract Special Provisions referred to above are necessary to make these plans complete.

DATUM: City of Richmond  
TEMPERATURE: The normal temperature referred to on the plan is 68°F. The temperature range for movement is 0°F to 120°F.

DIMENSIONS: All dimensions are measured horizontally and vertically unless otherwise noted.

EXCAVATION: Excavation below subgrade and cut slope template shall be classified as Structure Excavation. All excavation above these limits shall be classified as Regular Excavation and is not included in the Structural Quantities.

FOUNDATIONS: Footings shall rest on firm material. Foundation material shall be dry and special attention is called to Section 401.05 of General Specifications and to the Contract Special Provisions, concerning preparation of foundations for footings.

CONCRETE NOTES: Concrete in superstructure shall be Class A3. All other concrete shall be Class A3. All exposed edges and corners shall have a 1" chamfer or fillet unless otherwise noted. Care in the method of vibration, the use of low-slump concrete, and/or other means shall be employed to prevent downward movement of newly placed slab concrete.  
Finishing Concrete Surfaces: See the Standard Architectural Detail Sheets and the Contract Special Provisions for types and details.

All reinforcing steel shall conform to A.S.T.M. A615, Grade 60. All reinforcing bar dimensions on the detailed drawings are to centers of bars unless otherwise noted. Clear distance between reinforcing steel and face of concrete shall be as noted on the plans. All bar laps shall be 30 diameters of the smaller diameter bar unless otherwise noted.

STEEL NOTES: Structural steel shall conform to A.S.T.M. Specification A36 except as noted.  
All field connections shall be made with high strength bolts. High strength bolts shall be used unless otherwise noted and shall conform to A.S.T.M. Specification A 325.

BENCH MARK: A-16 Copperweld rod N.W. of R.R. Bridge on Douglasdale Road. Elev. 213.60.

Boring denotes 2 1/4" Cased hole.

# INDEX


GENERAL PLAN AND ELEVATION	Sheet 1
WEST ABUTMENT	2
EAST ABUTMENT	3
PIERS 1 AND 3	4
PIERS 4 AND 5	5
FRAMING PLAN	6
DECK PLAN	7
FRAMING DETAILS	8
JOINT DETAILS	9
APPROACH SLAB AND SLOPE PROTECTION DETAILS	10
BORING LOGS	11
BORING LOGS	12
STANDARD SHOULDER DETAILS	13
STANDARD ALUMINUM RAILING DETAILS	14
STANDARD ELECTRICAL DETAILS	15
STANDARD ARCHITECTURAL DETAILS	16
STANDARD UTILITY SUPPORT DETAILS AT BR. ABUTTS.	17
STANDARD CONDUIT INSTALLATION DETAILS	18

# RICHMOND METROPOLITAN AUTHORITY RICHMOND EXPRESSWAY SYSTEM BELTLINE EXPRESSWAY


# BRIDGE NO 13 DOUGLASDALE ROAD OVER BELTLINE EXPRESSWAY AND R.F.&P.R.R. GENERAL PLAN AND ELEVATION

HOWARD, NEEDLES, TAMMEN & BERGENDOFF  
consulting engineers  
NEW YORK ALEXANDRIA KANSAS CITY  
SCALE: 1"=20'  
CONTRACT NO. 4  
SHEET NO. 1 of 12


Note: The 36" Water Main location is approximate. Before beginning construction contractor must locate this main.

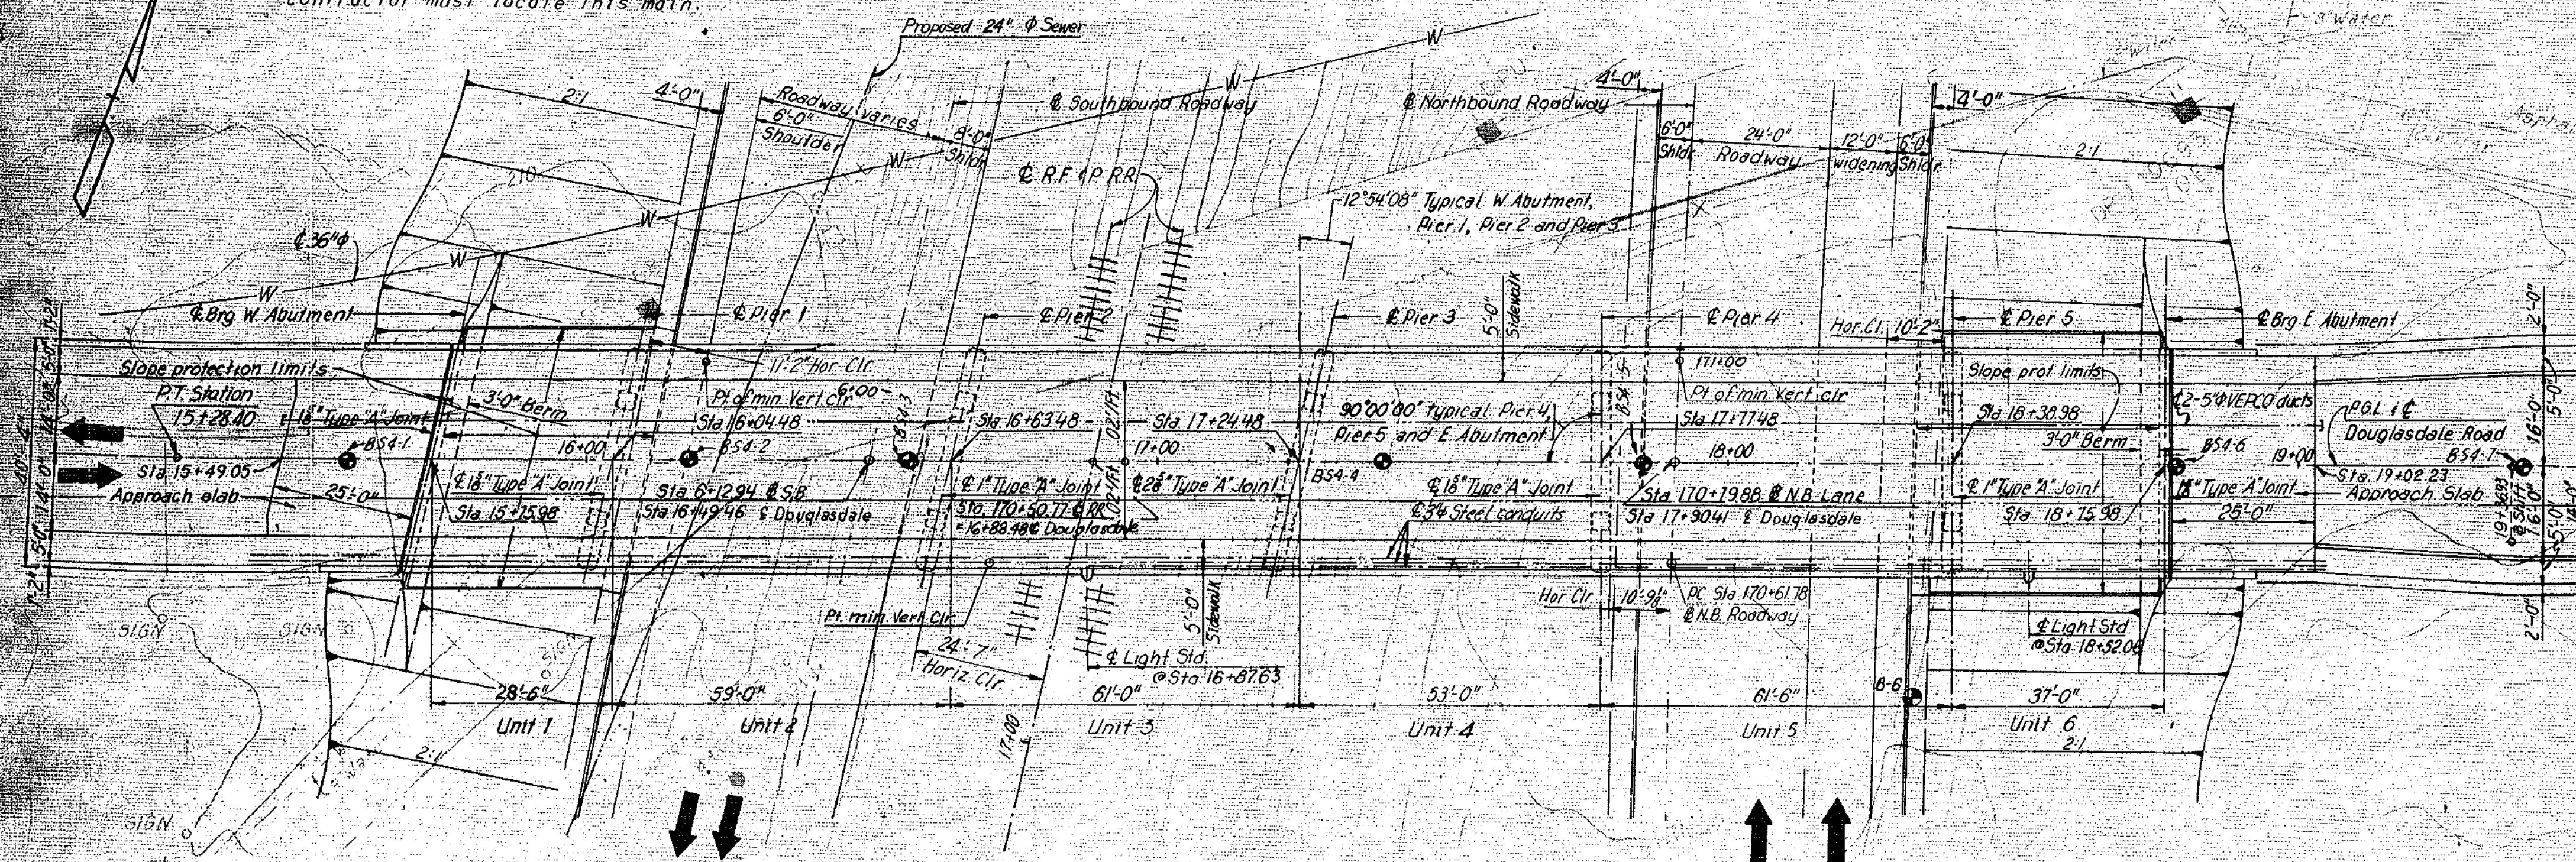

PLAN

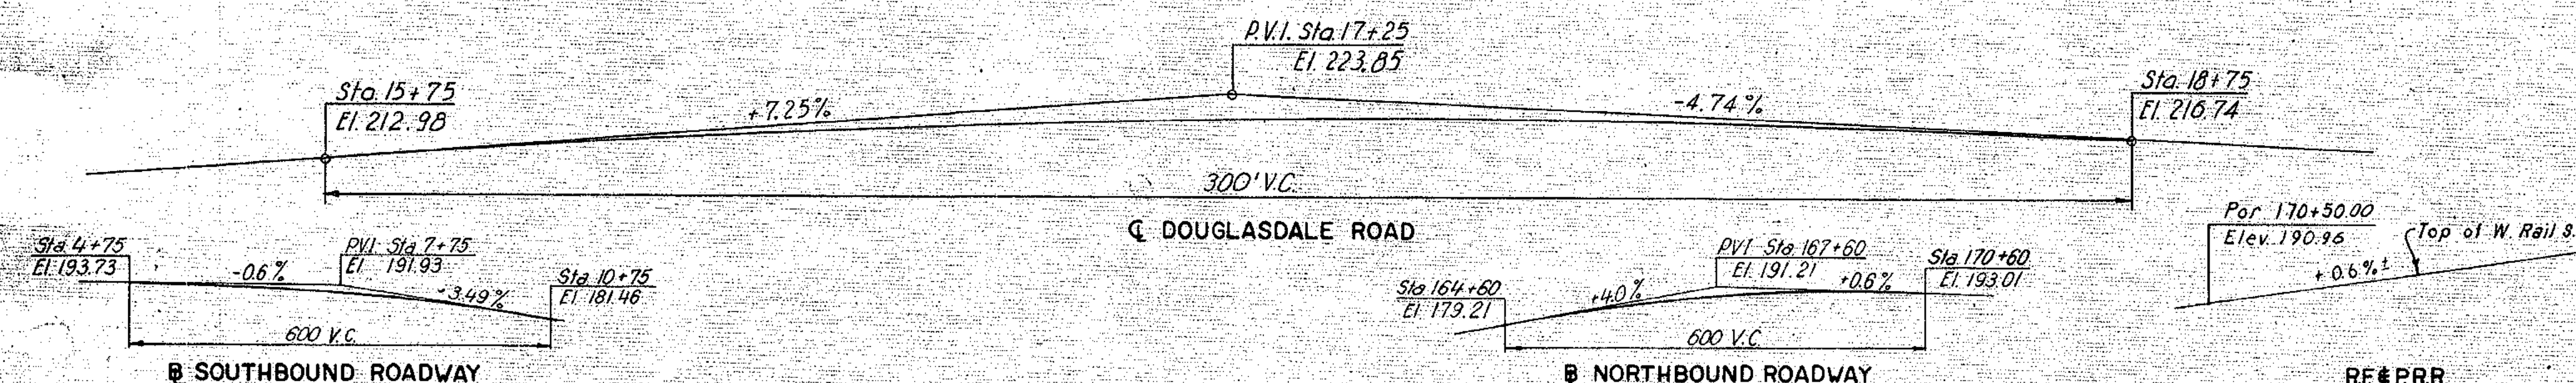

PROFILE GRADES

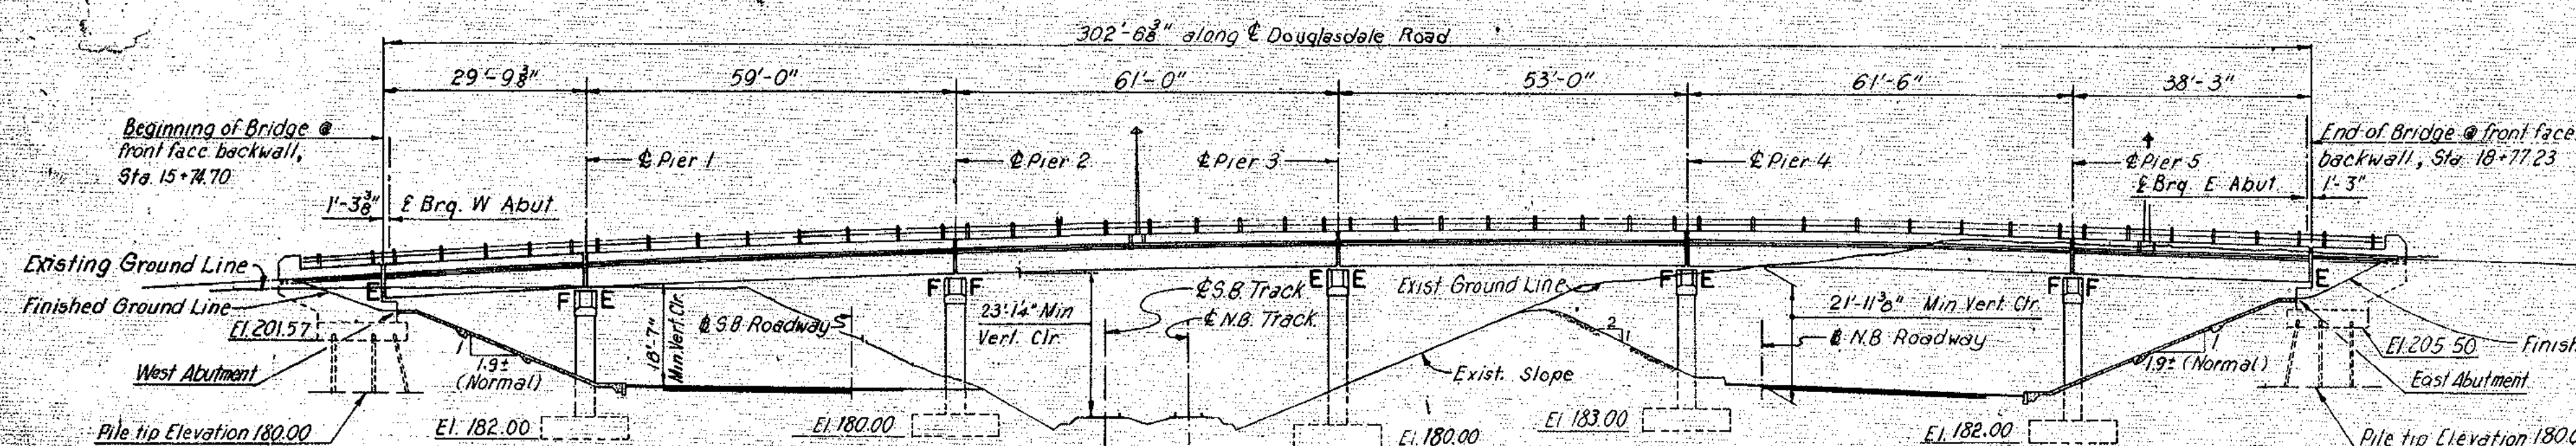

# CURVE DATA

Northbound Roadway  
P.I. = Sta. 173+60.82  
Δ = 17°47'52"  
D = 3°00'00"  
T.A. = 299.04'  
L = 593.26'  
R = 1,909.86'

Note: Pile Tip Elevations shown estimated.

(a) Class A3, unless noted  
(b) Class A4  
\* Frame and Cover only.







# ELEVATION

	Struct. Excav. Cu. Yds.	Concrete (a) Cu. Yds.	Reinf. Steel lbs.	Str. S.F. Mild Cordon lbs.	Aluminum Railing (2-rails) Lin. Ft.	Porous Backfill Cu. Yds.	Under drain & Dia. Pipe Lin. Ft.	Steel Piles 108x42 Lin. Ft.	Con. Slab S.F. Prot. Sq. Yds.	Asphalt damp proofing Conc. (a) Cu. Yds.	Approach Slab Conc. (a) Cu. Yds.	Metal Conduit 20 Dia. Lin. Ft.	Conduit 12 Dia. Lin. Ft.	Water Main 8 Dia. Lin. Ft.	*Junction Box Lbs.
Superstructure	—	464.8 (b)	87,170	333,000	650	—	—	—	—	—	—	7	914	704	358
West Abutment	130	80.0	13,500	—	—	5.2	50	307	193.3	27	40.4	—	—	—	—
Pier 1	185	65.1	10,220	—	—	—	—	—	—	—	—	—	—	—	—
Pier 2	119	67.5	11,120	—	—	—	—	—	—	—	—	—	—	—	—
Pier 3	204	67.9	11,400	—	—	—	—	—	—	—	—	—	—	—	—
Pier 4	171	66.4	10,740	—	—	—	—	—	—	—	—	—	—	—	—
Pier 5	156	66.6	10,690	—	—	—	—	—	—	—	—	—	—	—	—
East Abutment	126	77.5	13,100	—	—	4.8	49	358	239.7	25	39.4	—	—	—	—
TOTAL	1091	464.8 (b) 491.0	167,940	333,000	650	10	99	665	433	52	79.8	7	914	704	358

MADE	BY	DATE	3	Profile Grade	R.S.	4-0-71
CHECKED	IV	3-4-68	2	General	J.G.M.	10-70
IN CHARGE	NAA	3-6-68	1	General Revisions	RLM	5-17-68
	FKD		NO.	REVISION	BY	DATE





RICHMOND EXPRESSWAY SYSTEM			
SECTION	PROJECT	SHEET NO.	TOTAL SHEETS
4	BELTLINE EXPRESSWAY	121	155

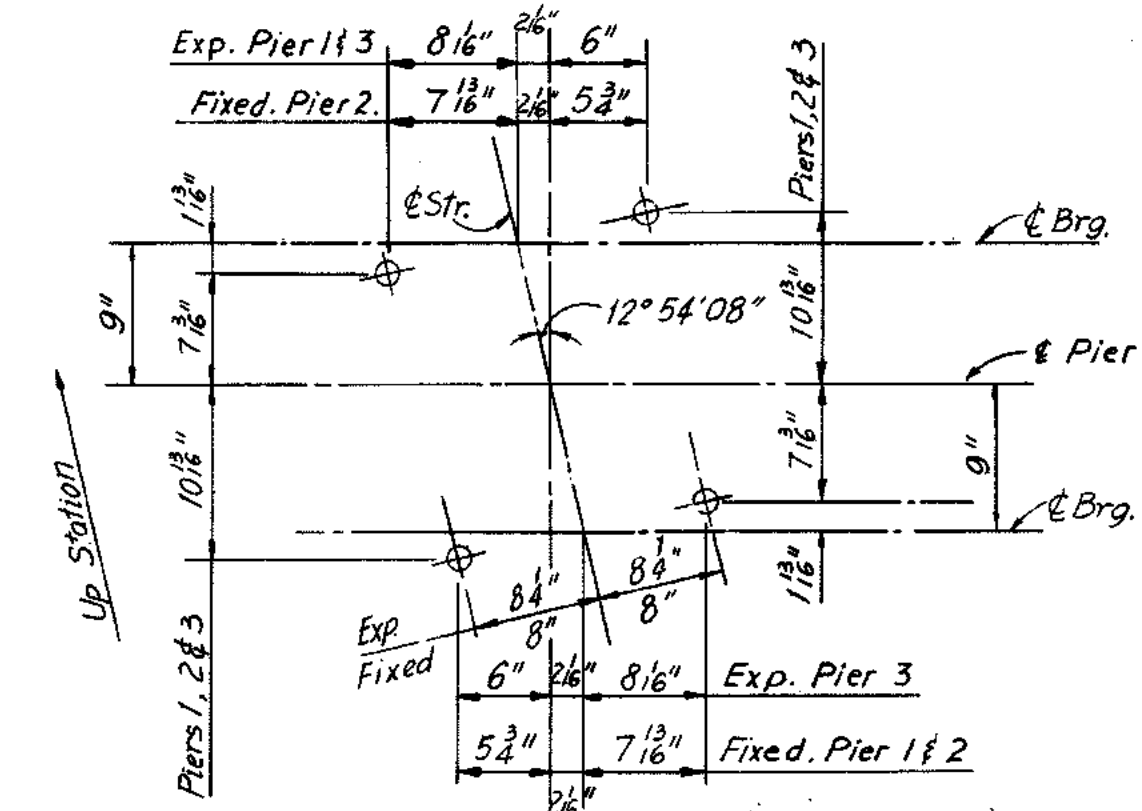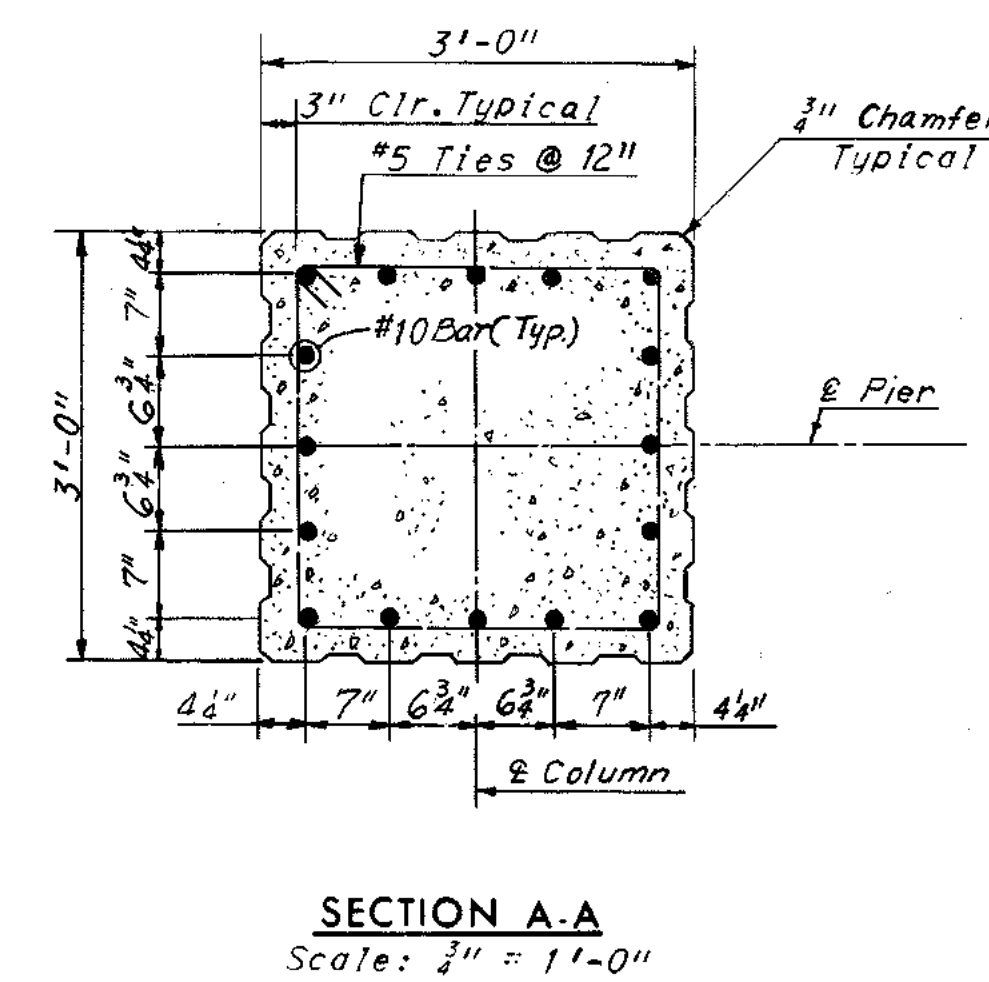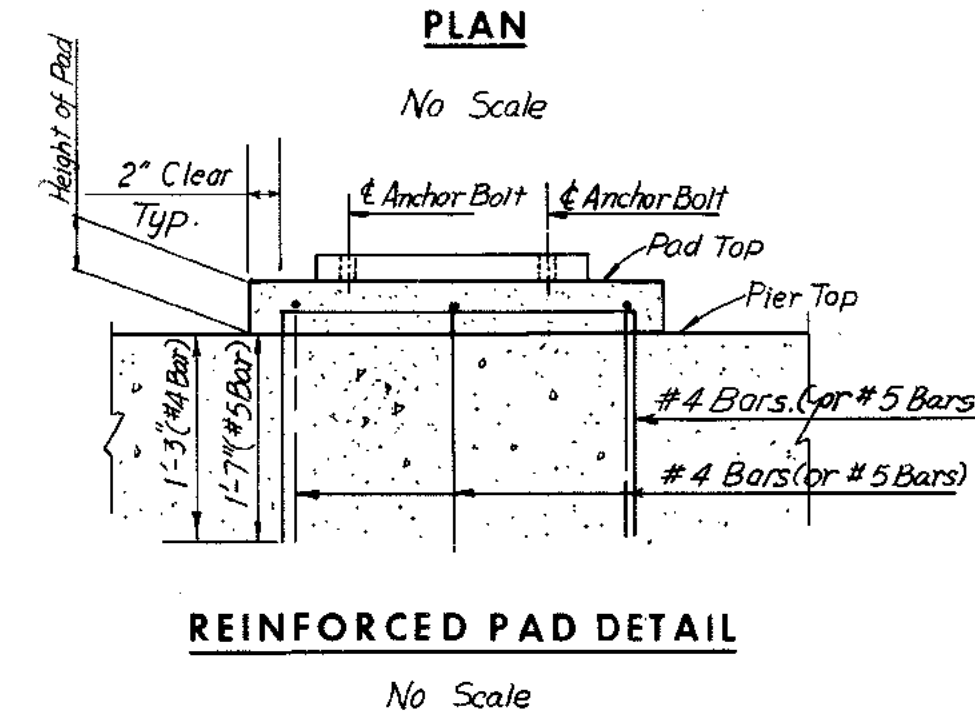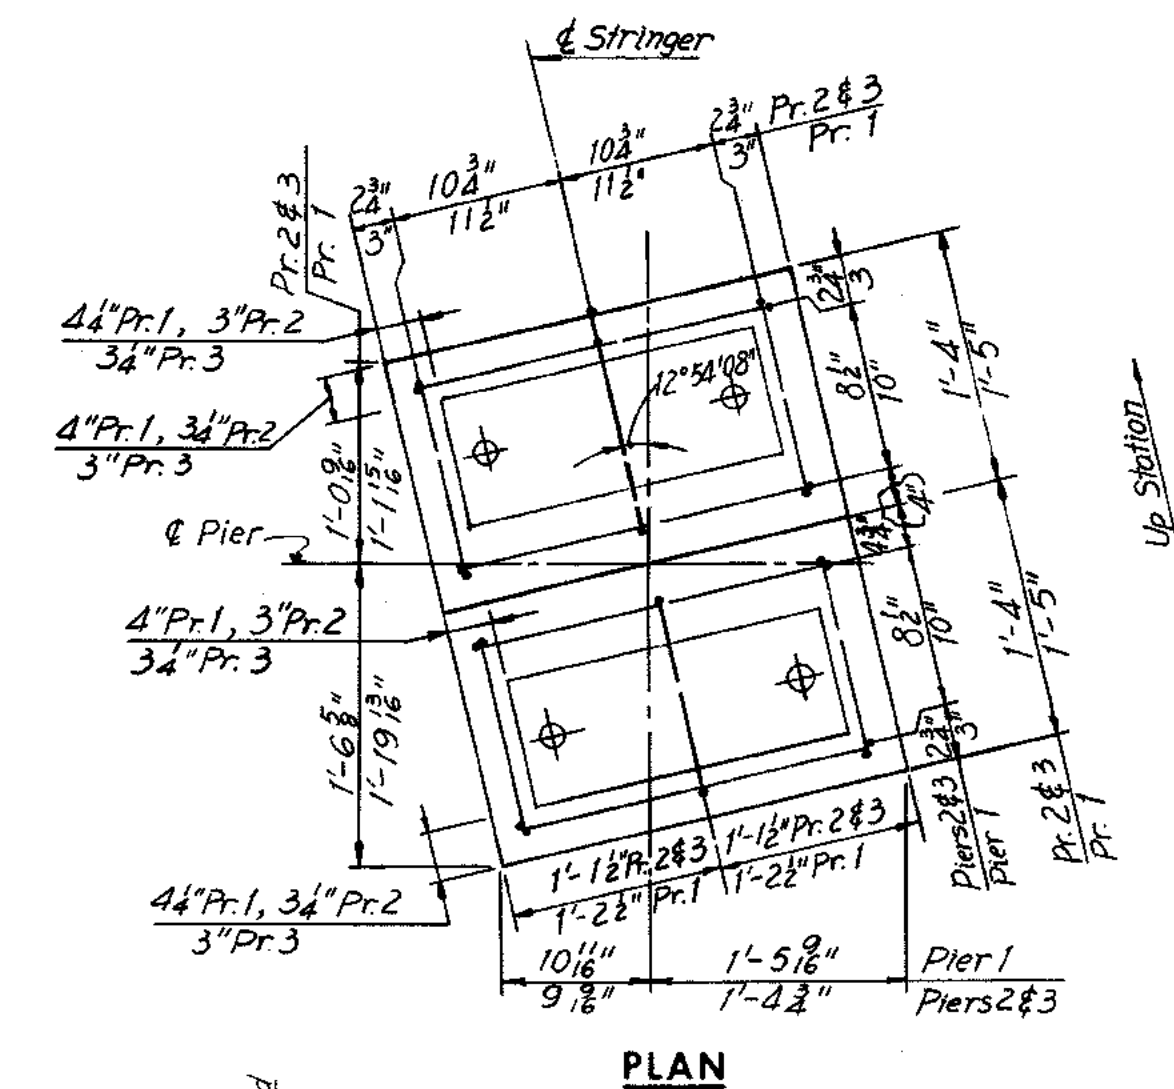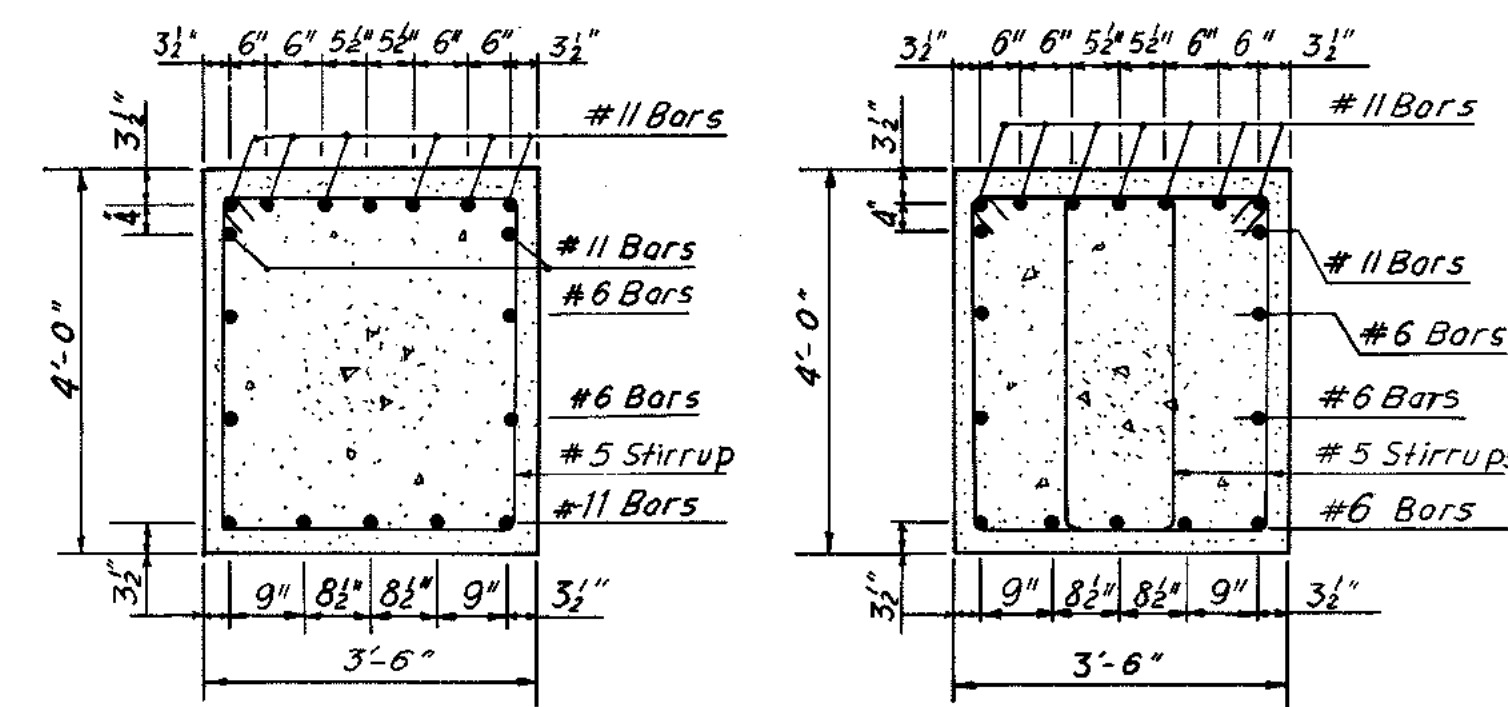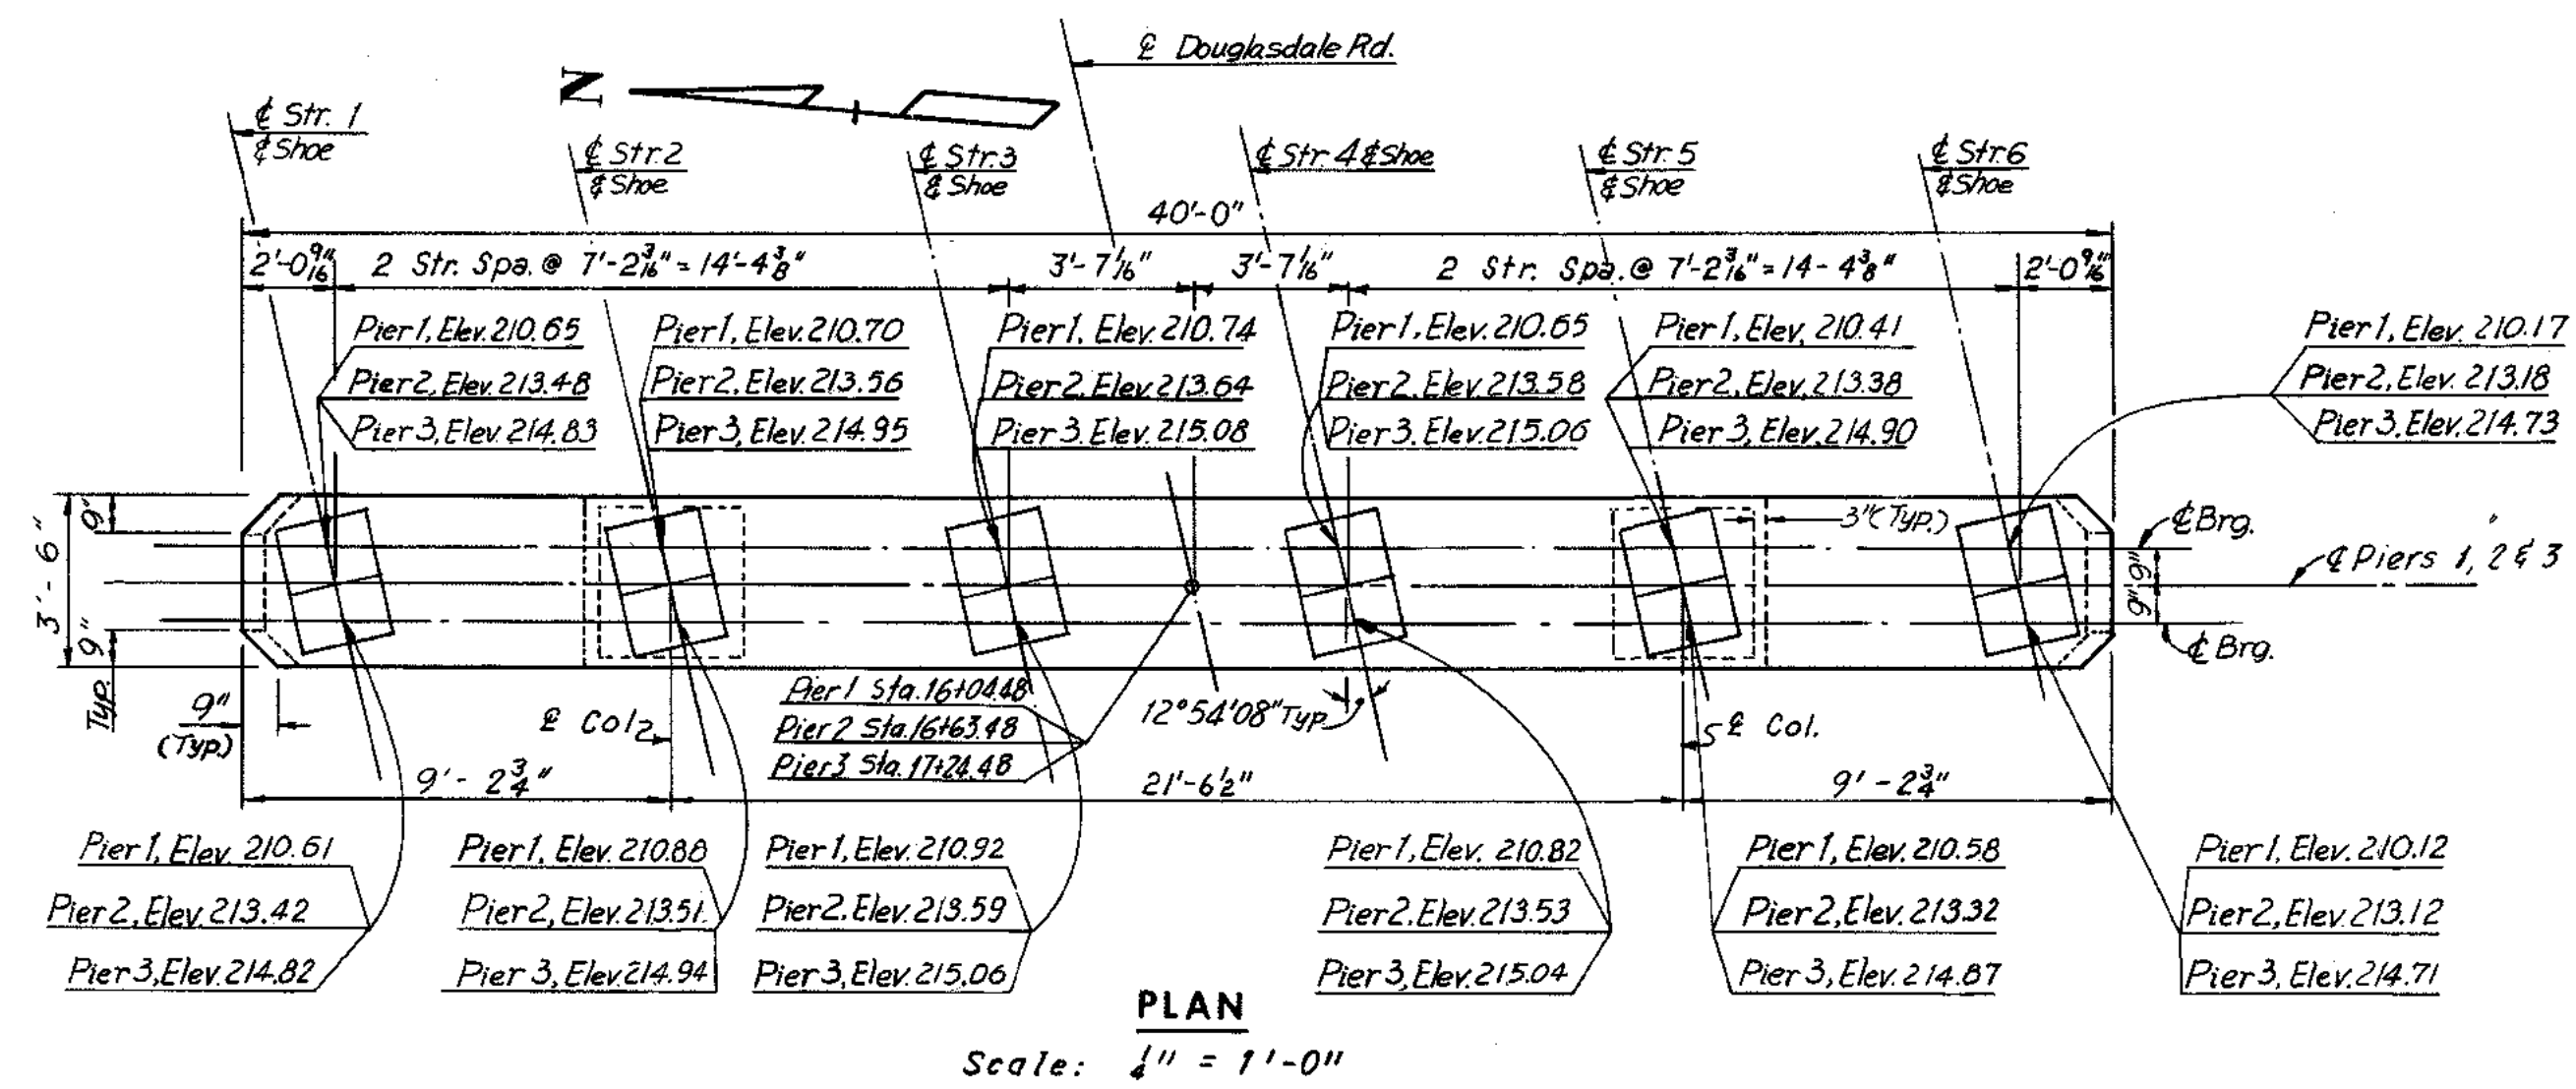

Note:  
Pads with heights of 4" or less shall not be reinforced.  
Pads with heights between 4" and 8" use #4 bar.  
Pads with heights between 8" and 12" use #5 bar.

Notes:  
For shoe details see Sheet S1.  
For Framing Plan see Sheet 6.

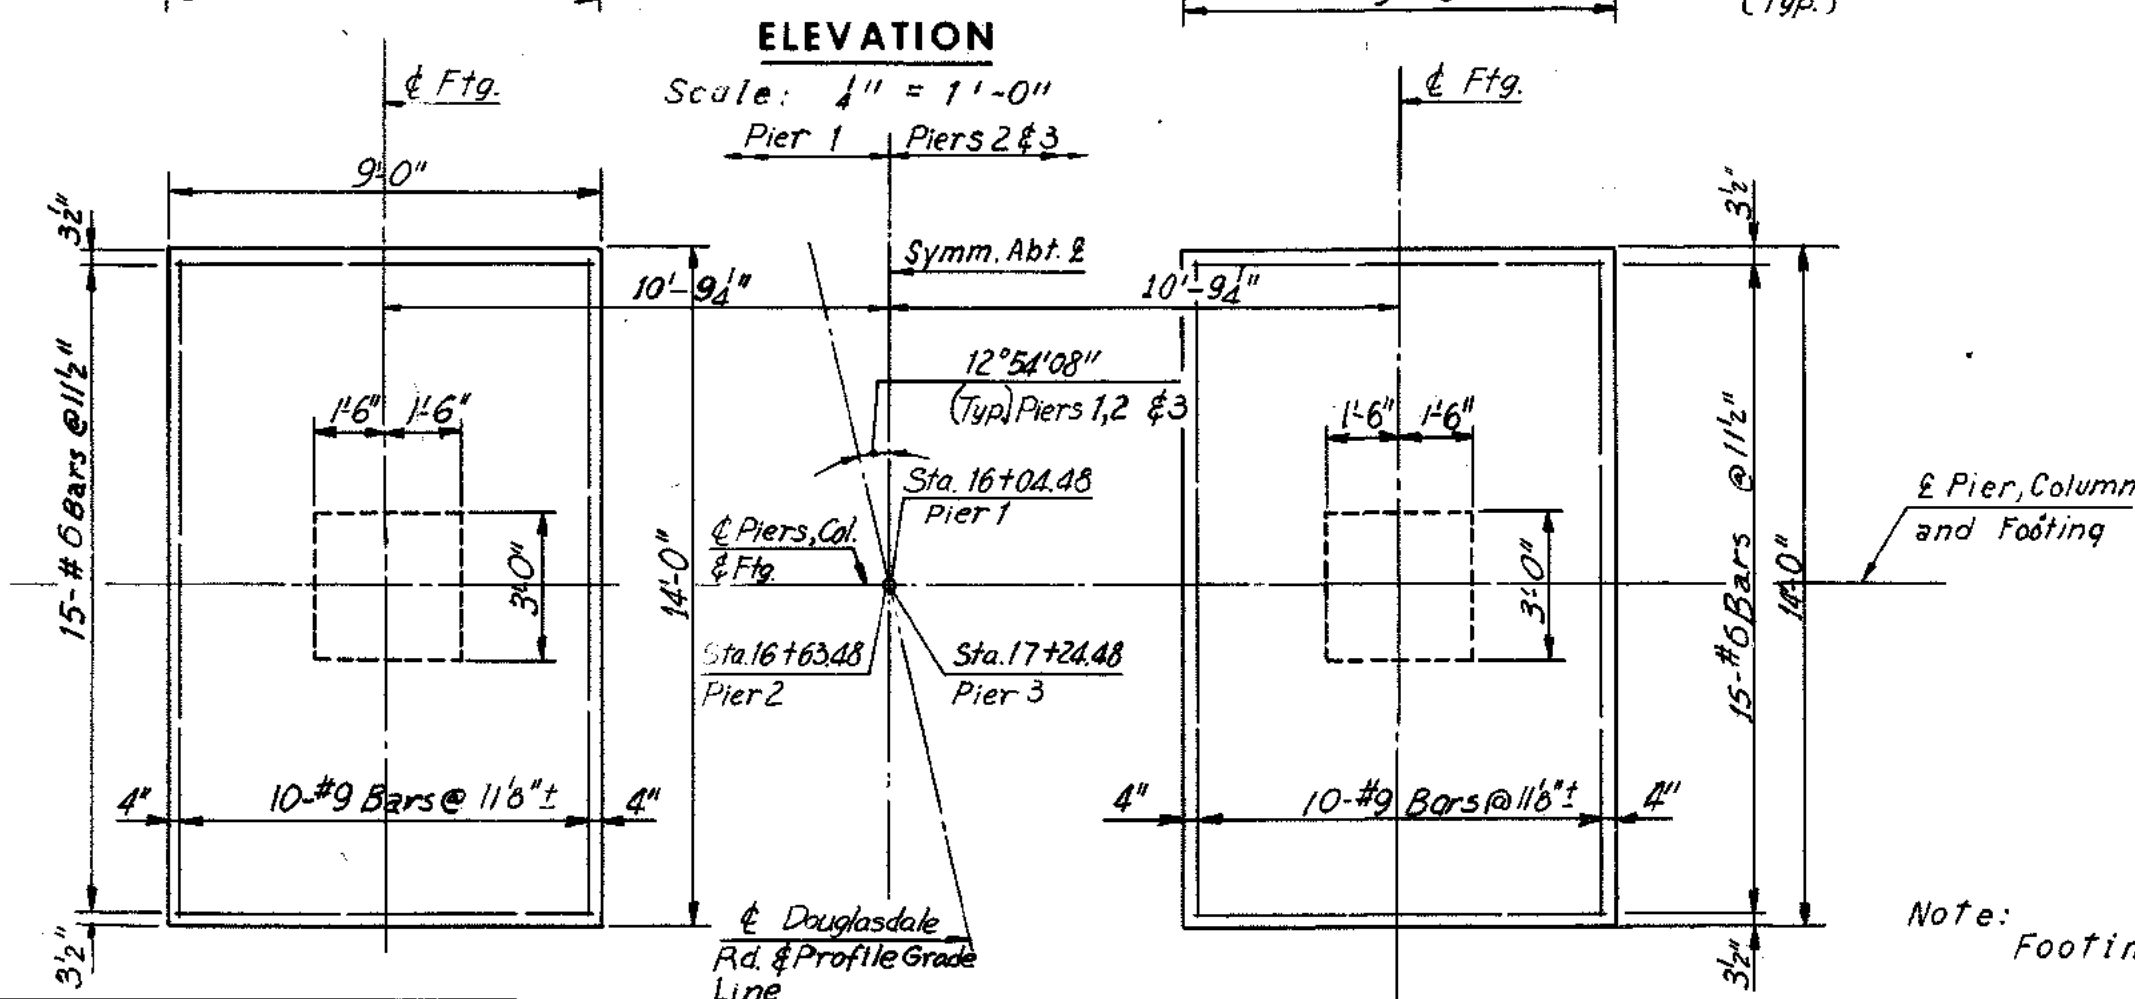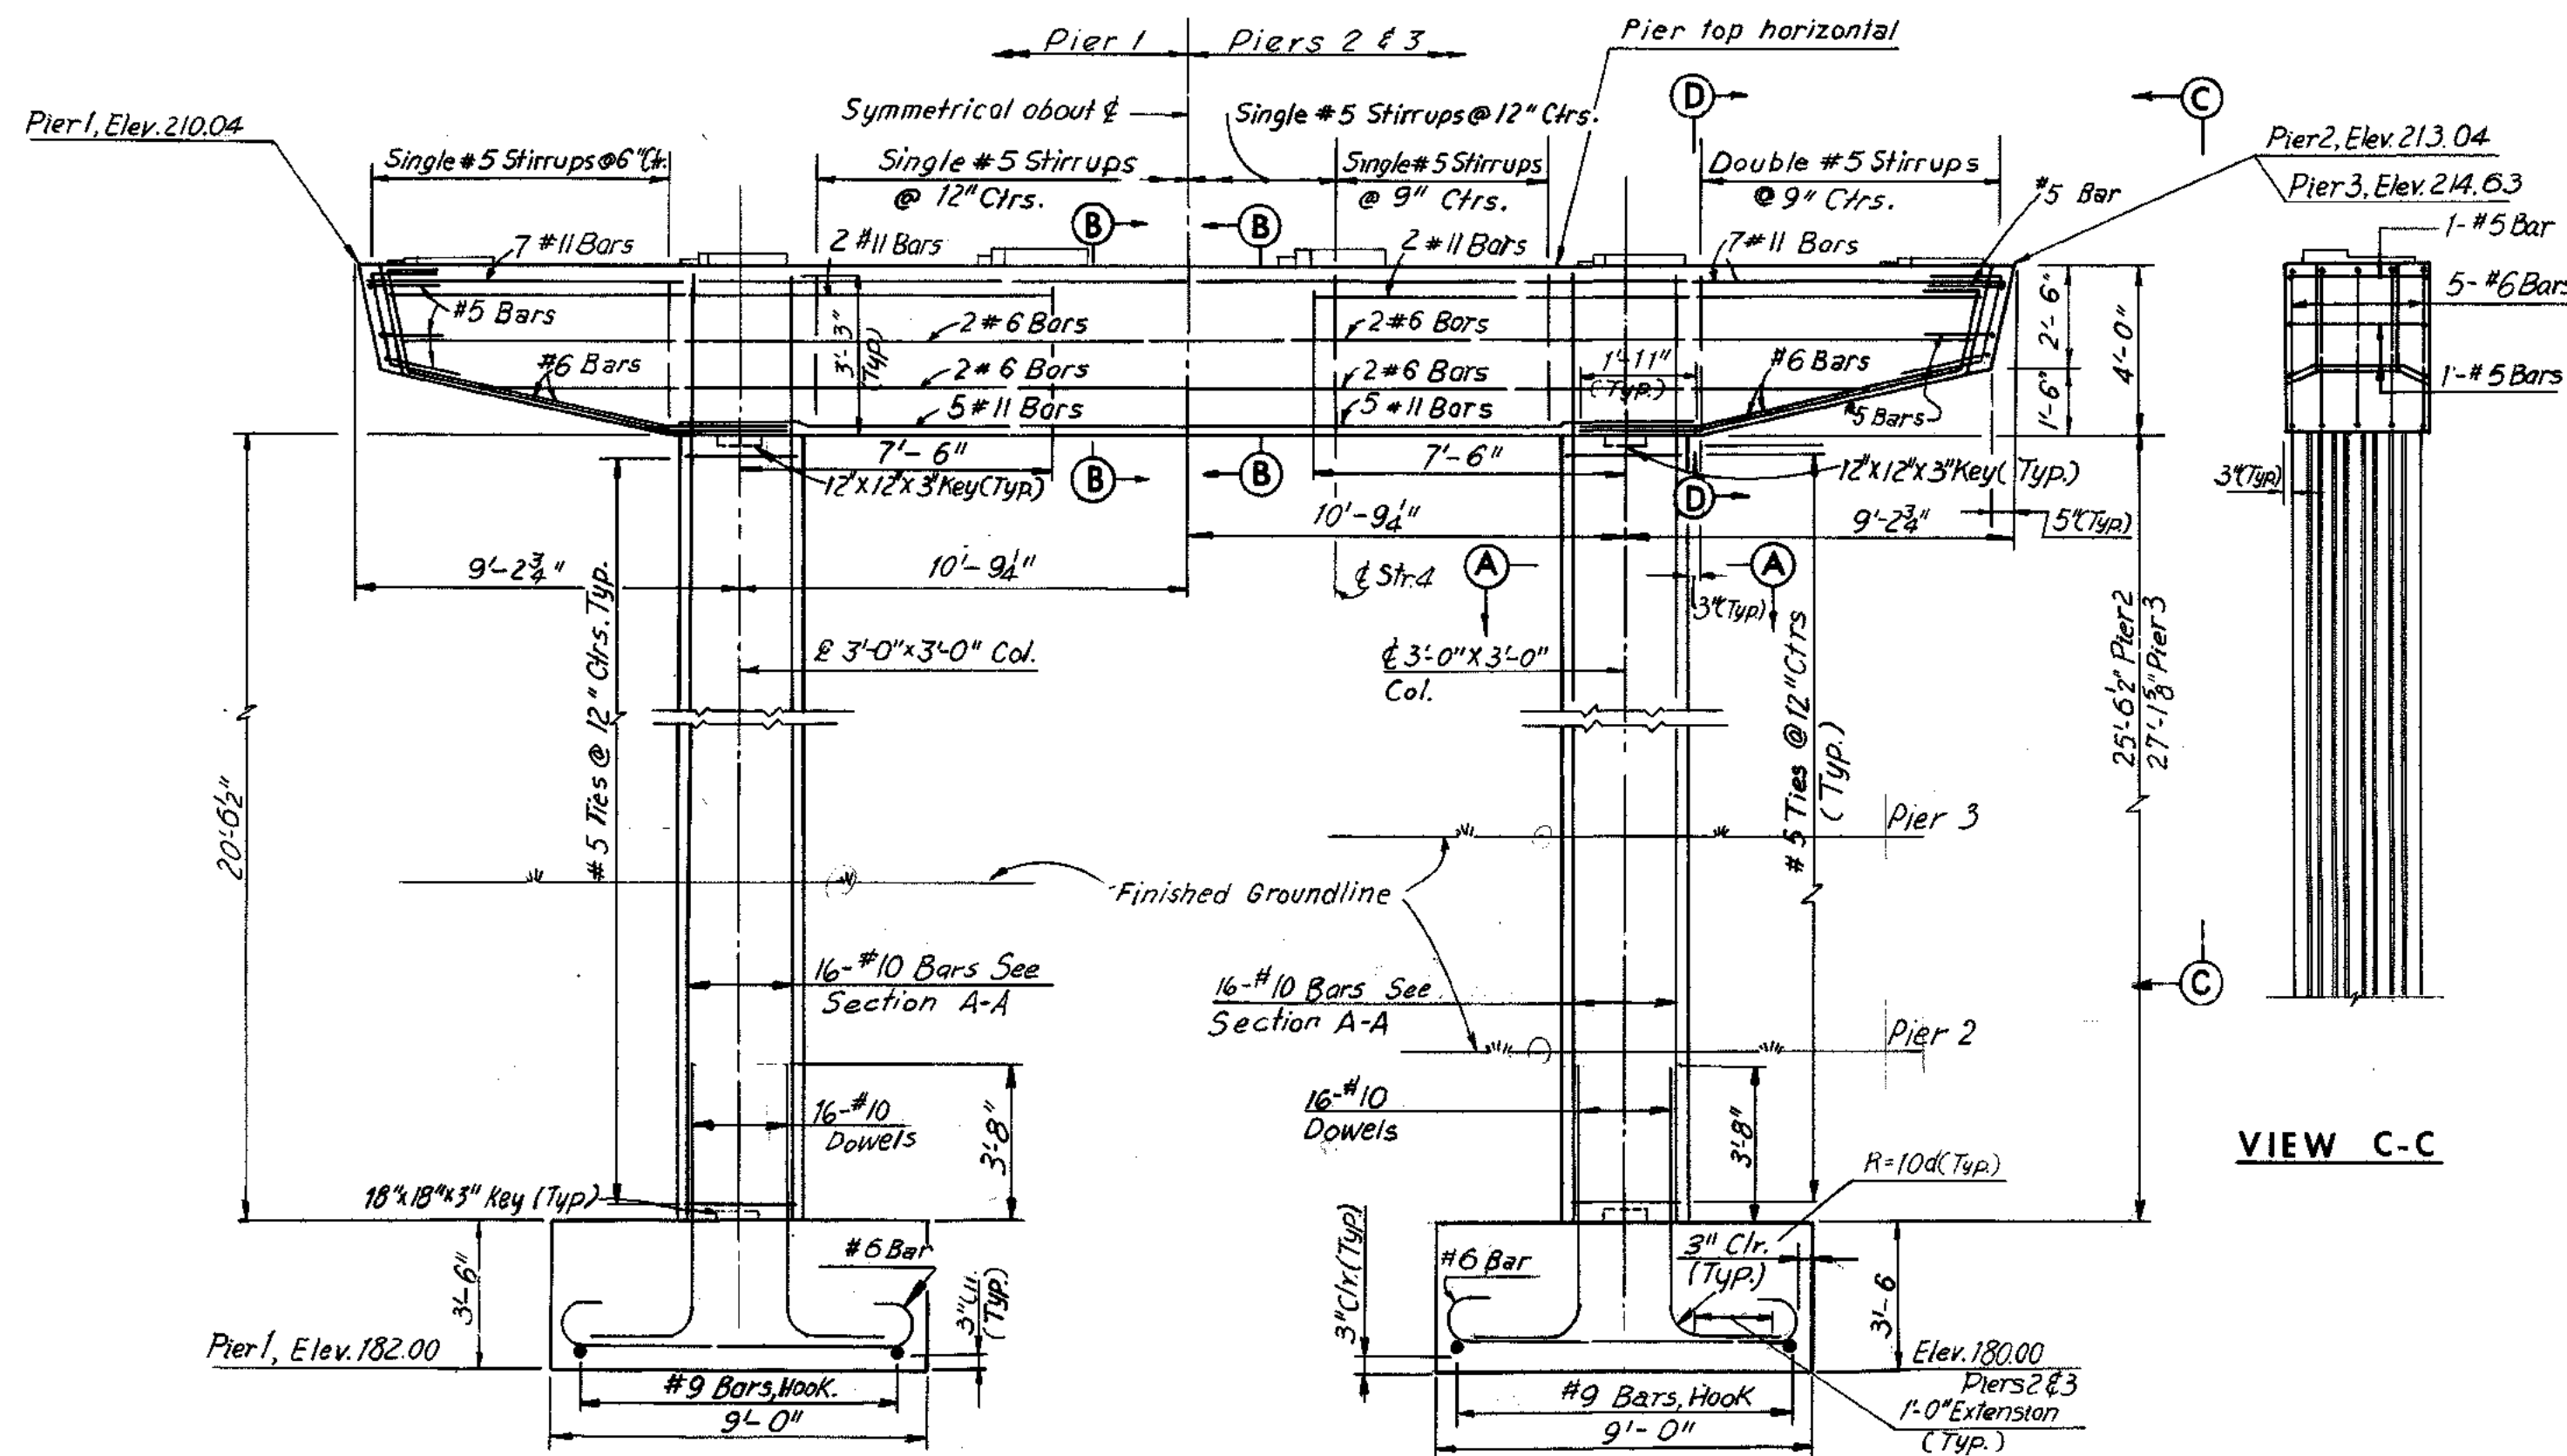

Note:  
Footing elevations are exact.


**AS BUILT**

BY	DATE	REVISION	BY	DATE
MADE	M.A.A. 9-29-67	2	As Built	R.H. 2-2-73
CHECKED	S.S.W. 3-6-68	1	Profile Grade	P.S. 4-7-71
IN CHARGE	FKD	NO.	REVISION	BY


**RICHMOND METROPOLITAN AUTHORITY**  
**RICHMOND EXPRESSWAY SYSTEM**  
**BELTLINE EXPRESSWAY**  
**BRIDGE NO. 13**  
**DOUGLASDALE ROAD OVER**  
**BELTLINE EXPRESSWAY AND R.F.&P.R.**  
**PIERS 1, 2 AND 3**

HOWARD, NEEDLES, TAMMEN & BERGENDOFF consulting engineers NEW YORK ALEXANDRIA KANSAS CITY	SCALE: As Noted CONTRACT NO.: 4 SHEET NO. 4 OF 12
---	---

RICHMOND EXPRESSWAY SYSTEM			
SECTION	PROJECT	SHEET NO.	TOTAL SHEETS
4	BELTLINE EXPRESSWAY	122	155

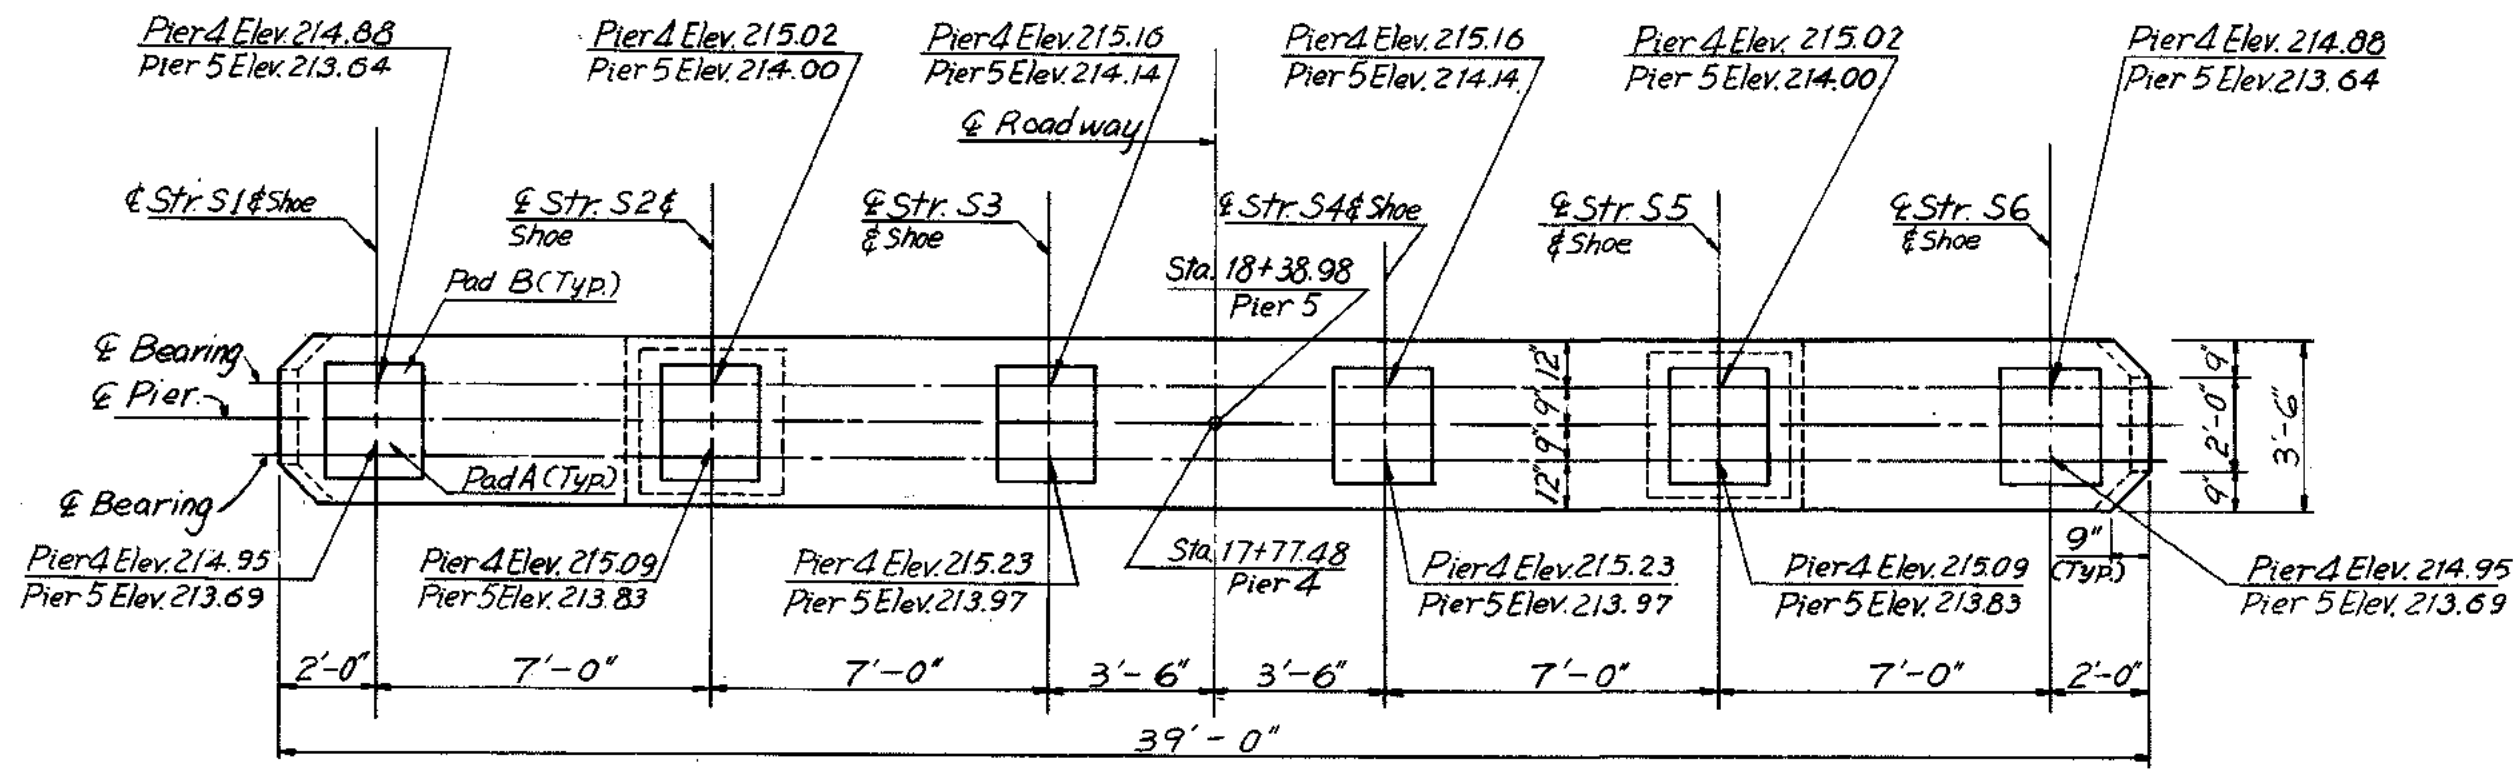


PLAN  
Scale: 1/4" = 1'-0"

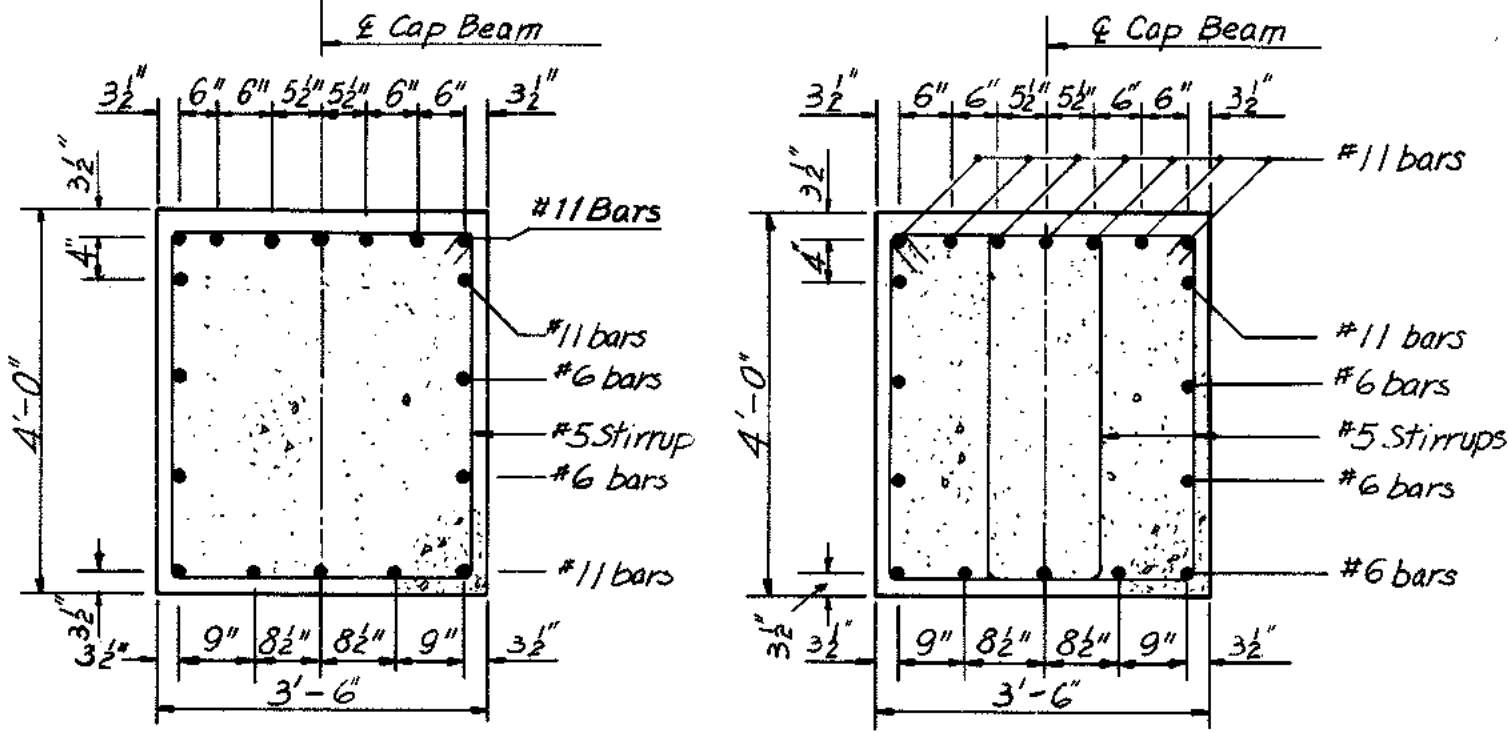


SECTION B-B  
Scale: 1/2" = 1'-0"


SECTION D-D  
Scale: 1/2" = 1'-0"

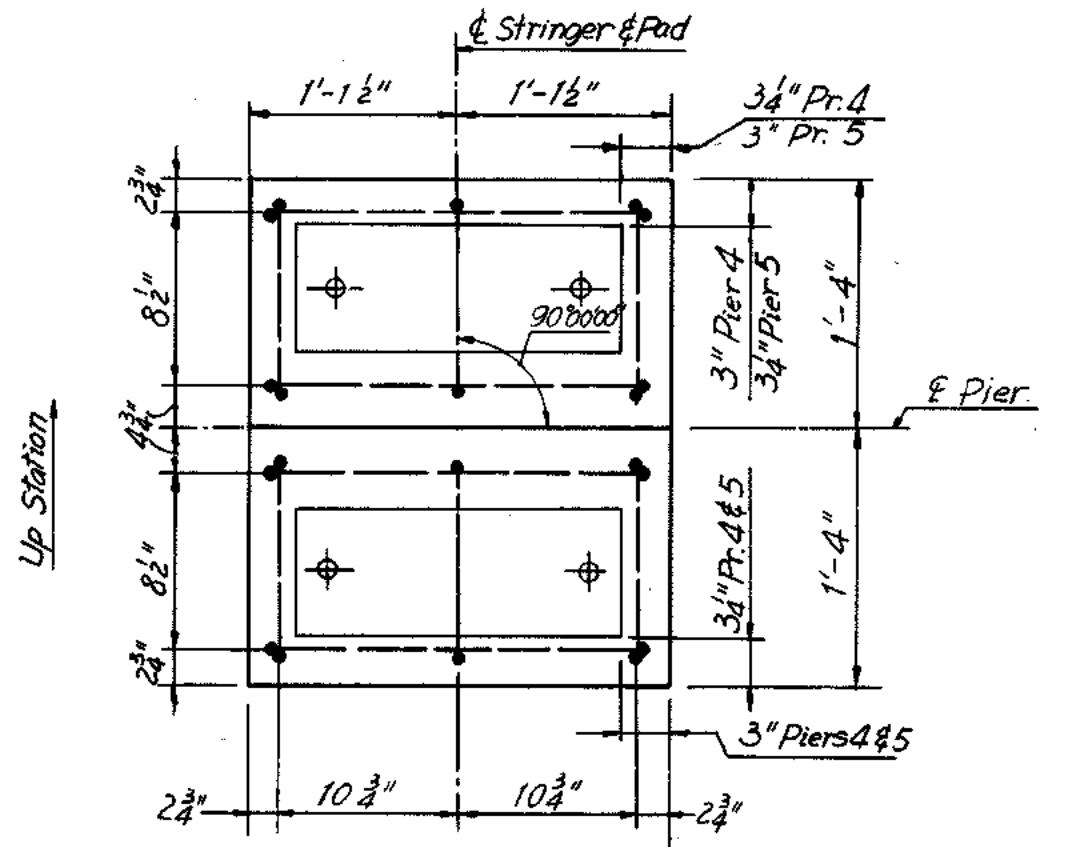


PLAN  
No Scale

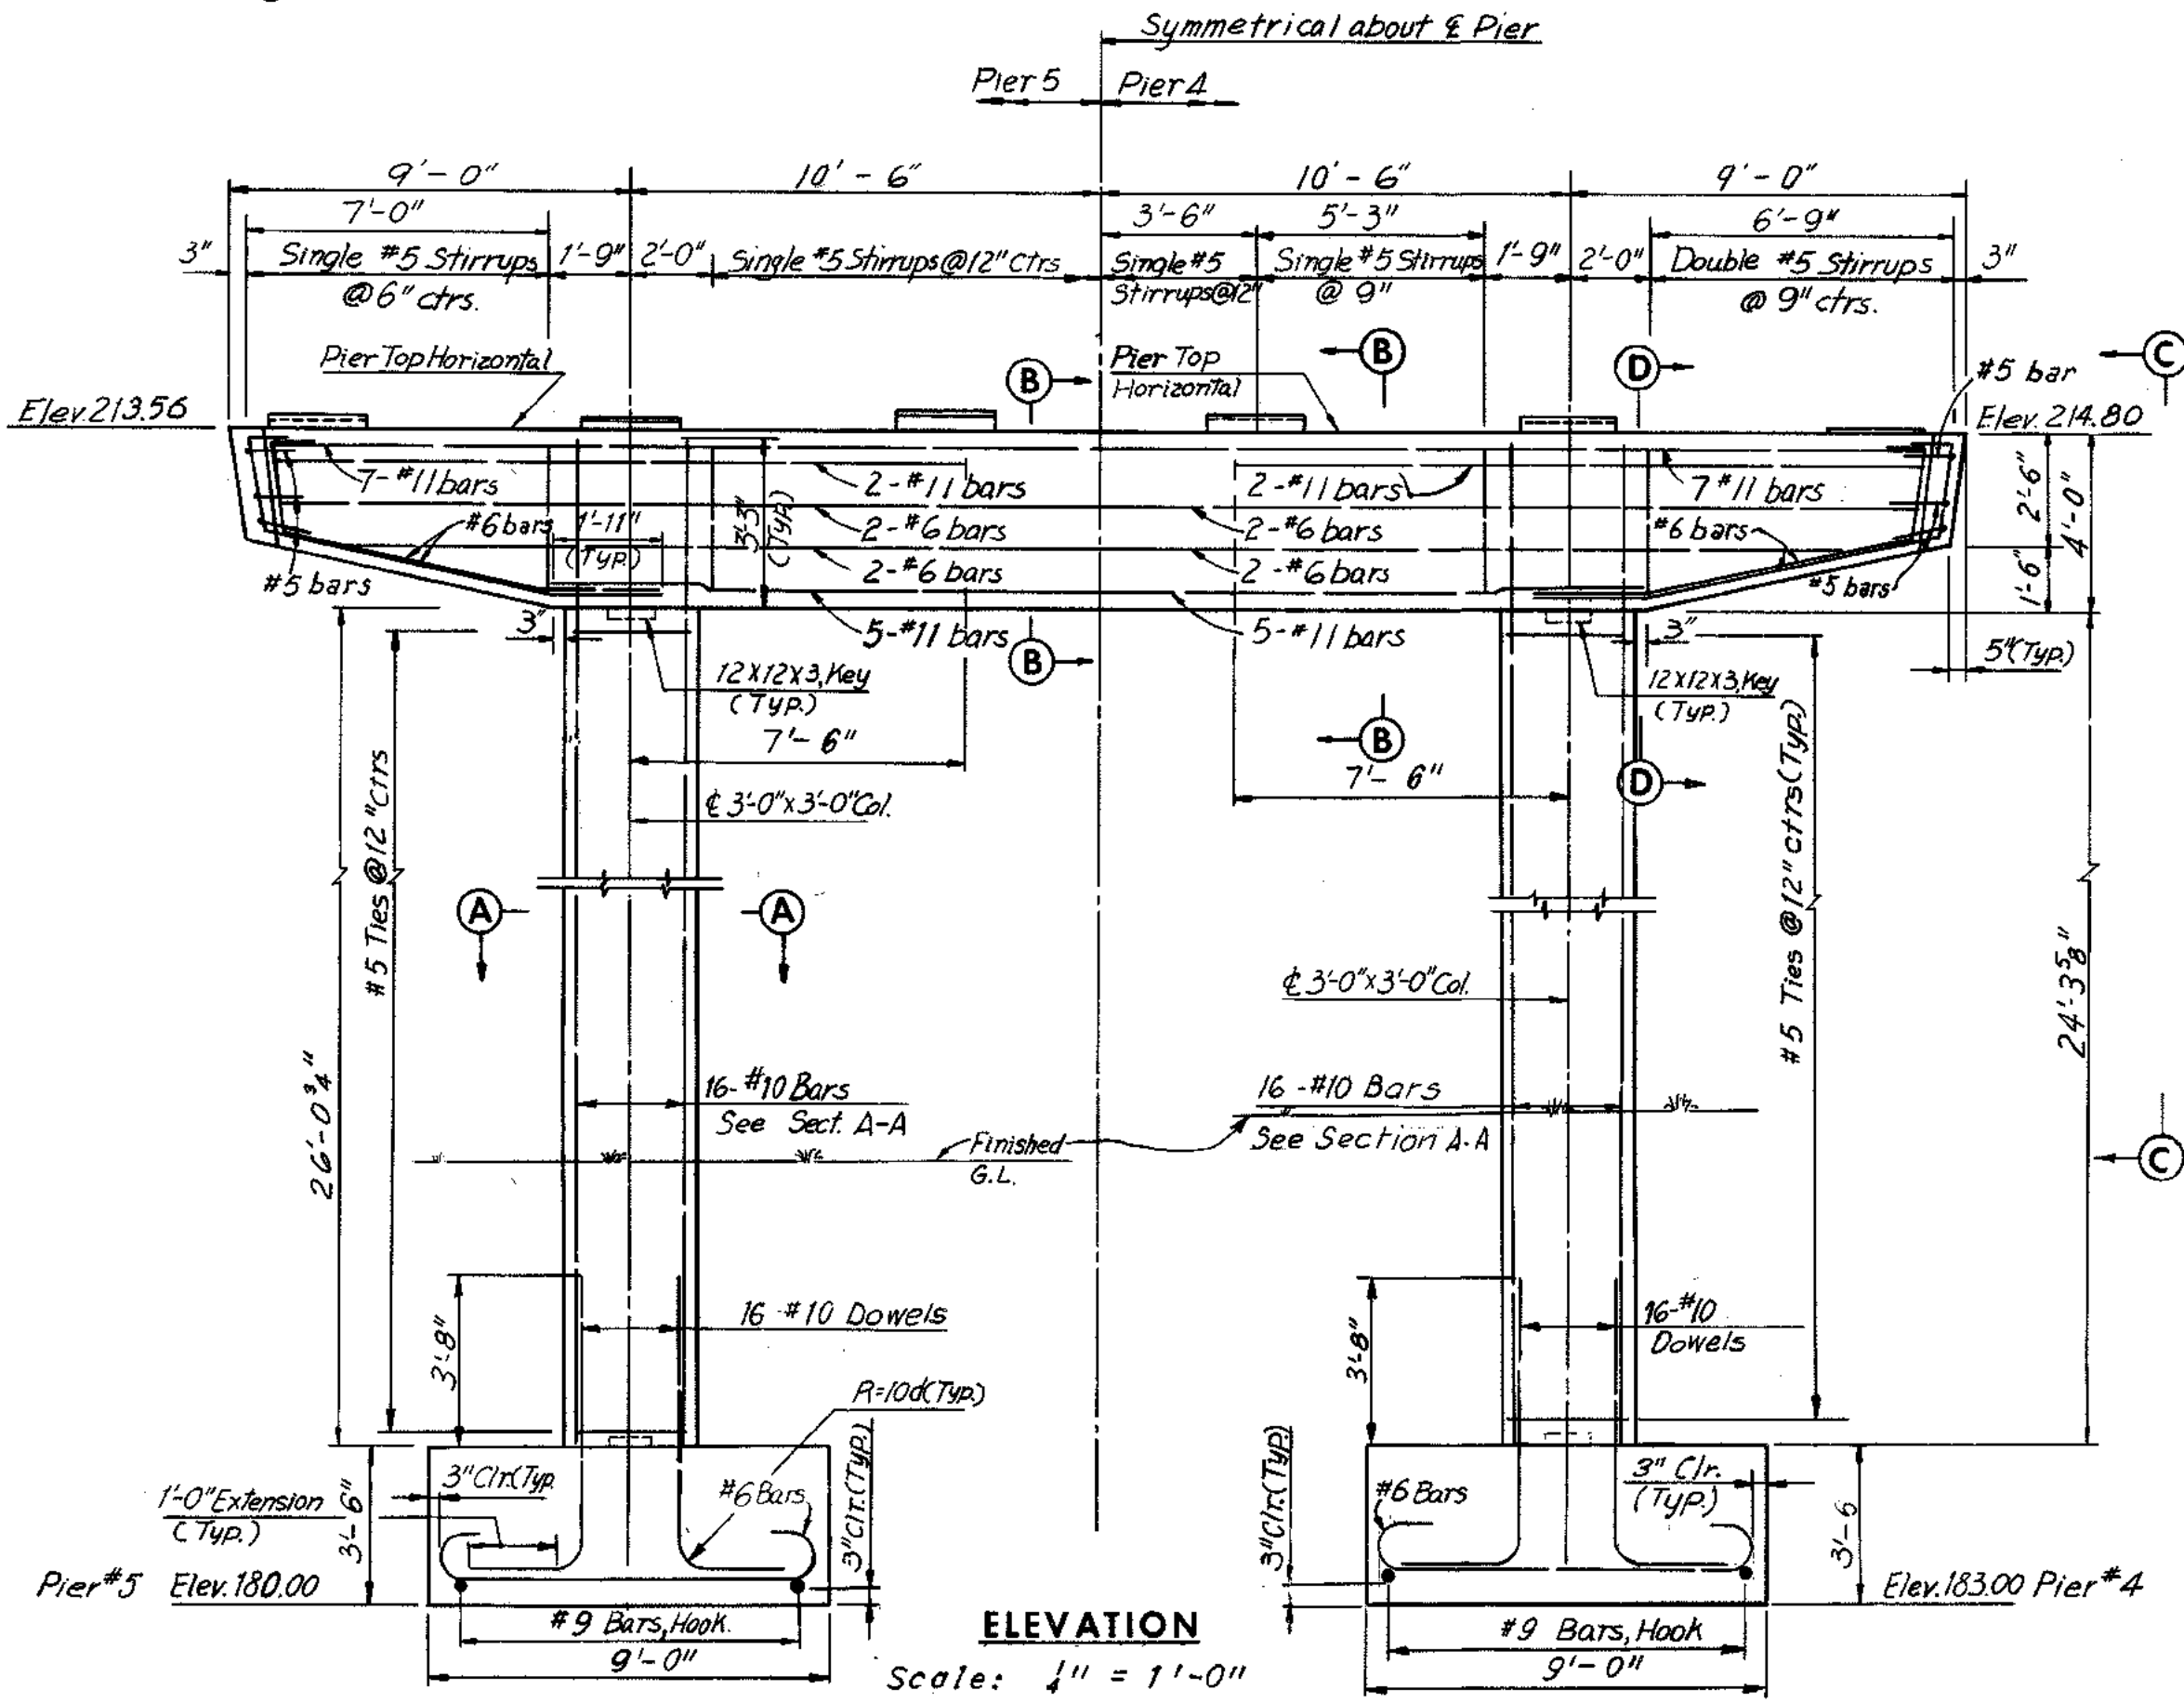

ELEVATION  
Scale: 1/4" = 1'-0"

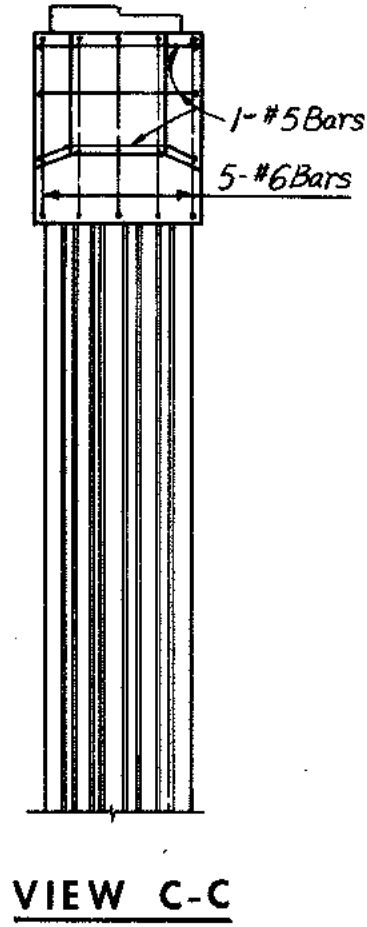


VIEW C-C

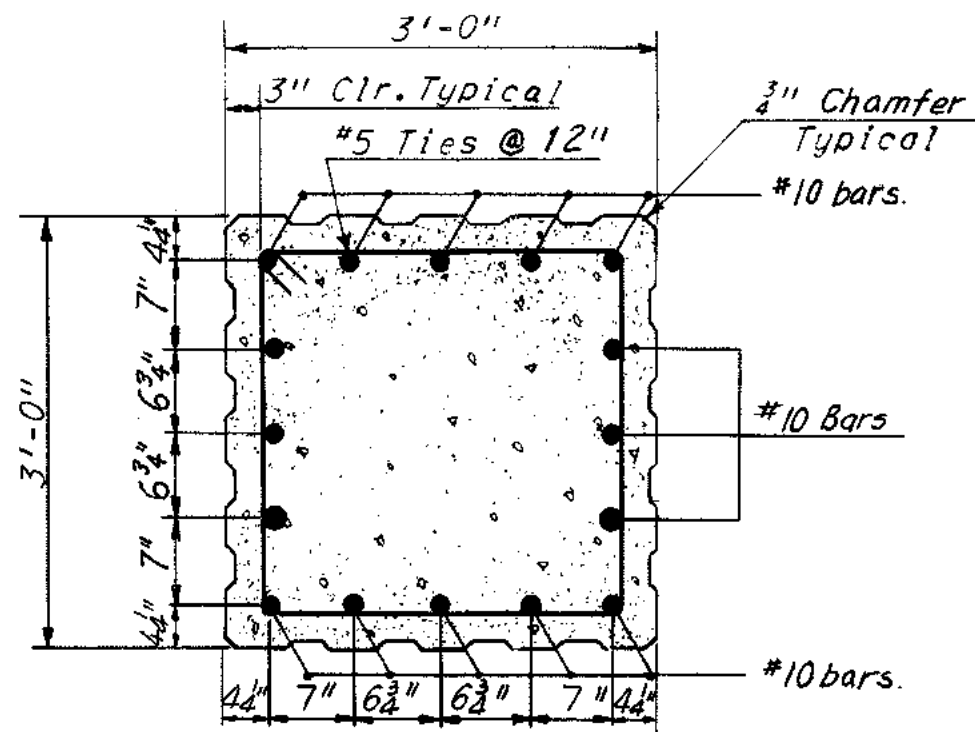


SECTION A-A  
Scale: 1/2" = 1'-0"

Note:  
Piers with heights of 4" or less shall not be reinforced.  
Piers with heights between 4" and 8" use #4 bar.

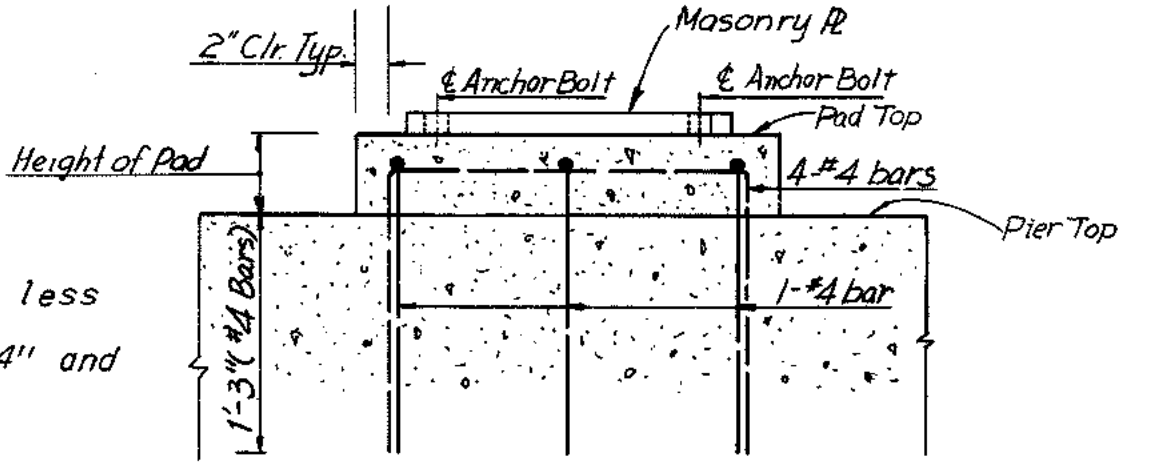

REINFORCED PAD DETAILS  
No Scale

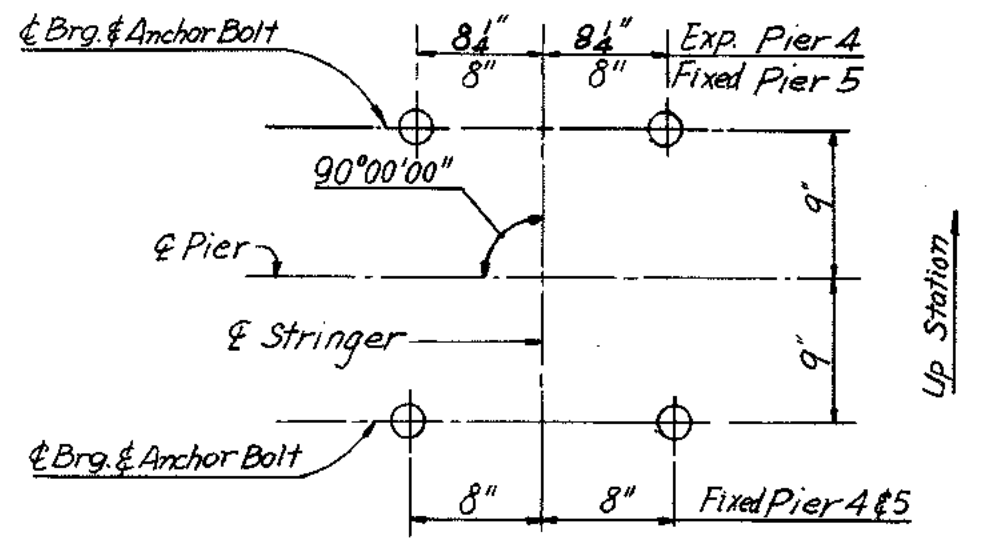

ANCHOR BOLT SETTING PLAN  
No Scale

AS BUILT

Notes:  
For shoe details see Sheet S1.  
For Framing Plan see Sheet 6.


RICHMOND METROPOLITAN AUTHORITY  
RICHMOND EXPRESSWAY SYSTEM  
BELTLINE EXPRESSWAY  
BRIDGE NO 13  
DOUGLASDALE ROAD OVER  
BELTLINE EXPRESSWAY AND R.F.&P.R.R.  
PIERS 4 AND 5

HOWARD, NEEDLES, TAMMEN & BERGENDOFF  
consulting engineers  
NEW YORK ALEXANDRIA KANSAS CITY

SCALE: As Noted  
CONTRACT NO.: 4  
SHEET NO. 5 OF 12


BY	DATE	REVISION	BY	DATE
MADE	G.C.C. 9-30-61	2	As Built	R.H. 2-2-73
CHECKED	S.S.W. 2-15-68	1	Profile Grade	P.S. 4-7-71
IN CHARGE	F.K.D.	NO.	REVISION	BY DATE

FOOTING PLAN  
Scale: 1/4" = 1'-0"

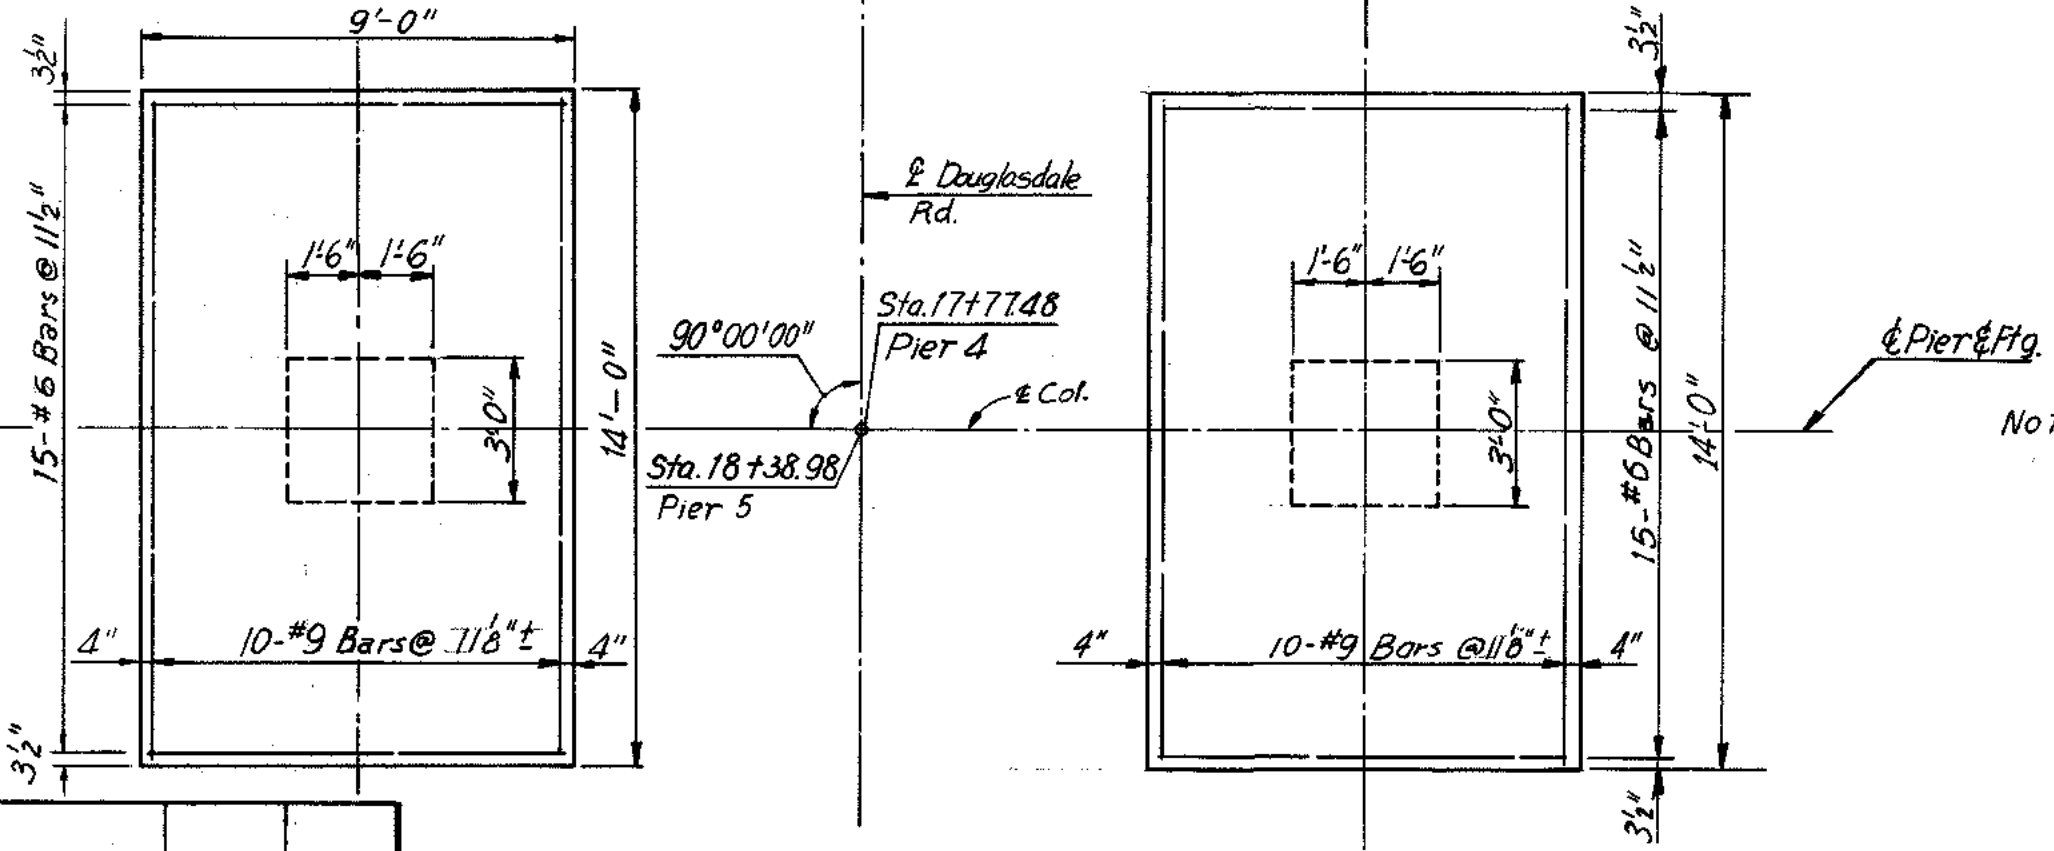

Note: Footing elevations are exact.



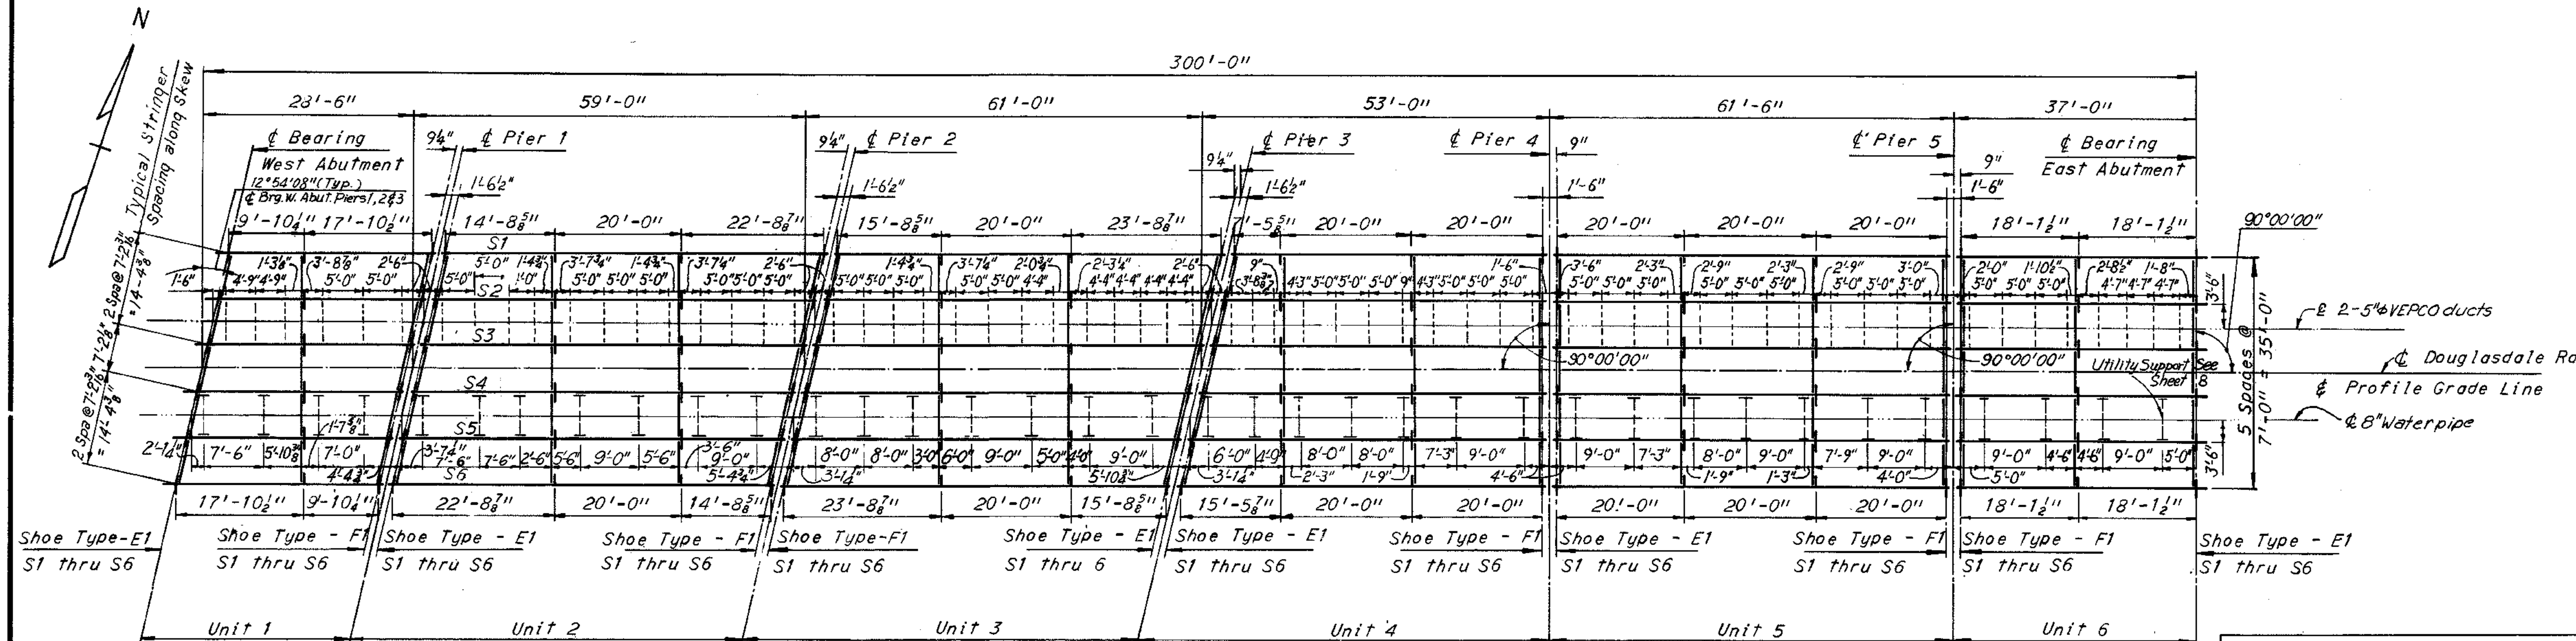

FRAMING PLAN

Scale: 1" = 15'-0"


SHOE SCHEDULE			
EXPANSION SHOES		FIXED SHOES	
TYPE	NO. REQD.	TYPE	NO. REQD.
E1	36	F1	36

DETAIL A  
No Scale

SHEAR STUD NOTE


Capacity = 3,400 lbs. per stud.  
The contractor may, if he elects, use three 1/2" diameter studs at the same longitudinal spacing in lieu of the four 1/2" diameter studs shown.  
Stud rows shall be placed parallel to the main deck reinforcing.  
Shear stud spacing shown is maximum spacing.

Shape of top of form before any deck slab concrete is cast.

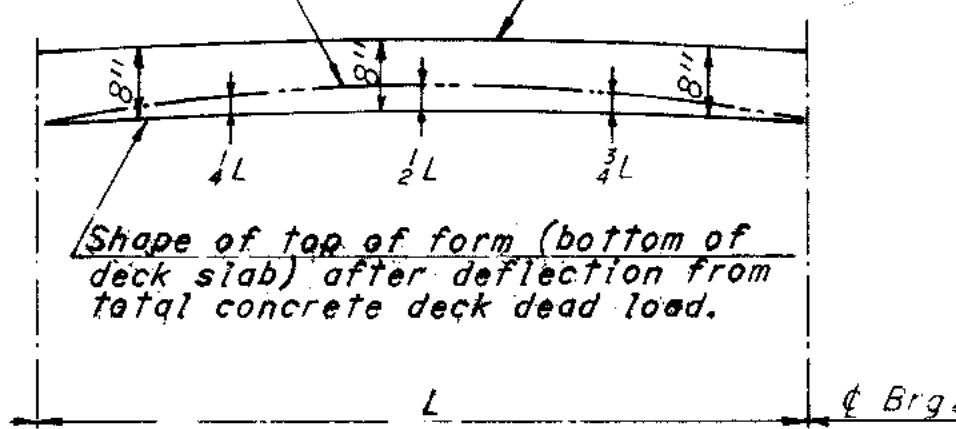


DEAD LOAD DEFLECTION DIAGRAM

No Scale

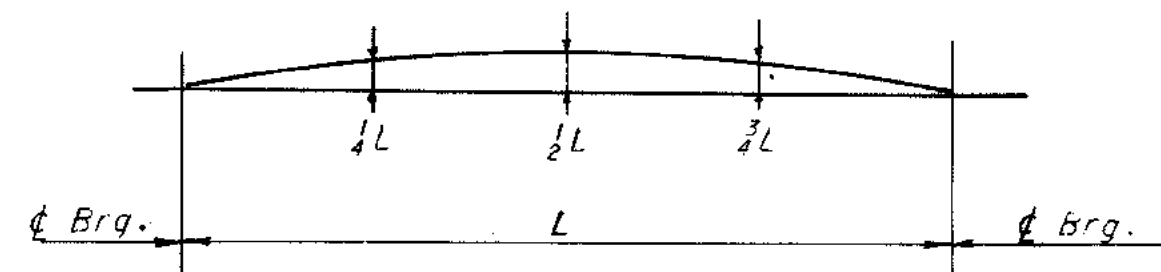


CAMBER DIAGRAM

No Scale

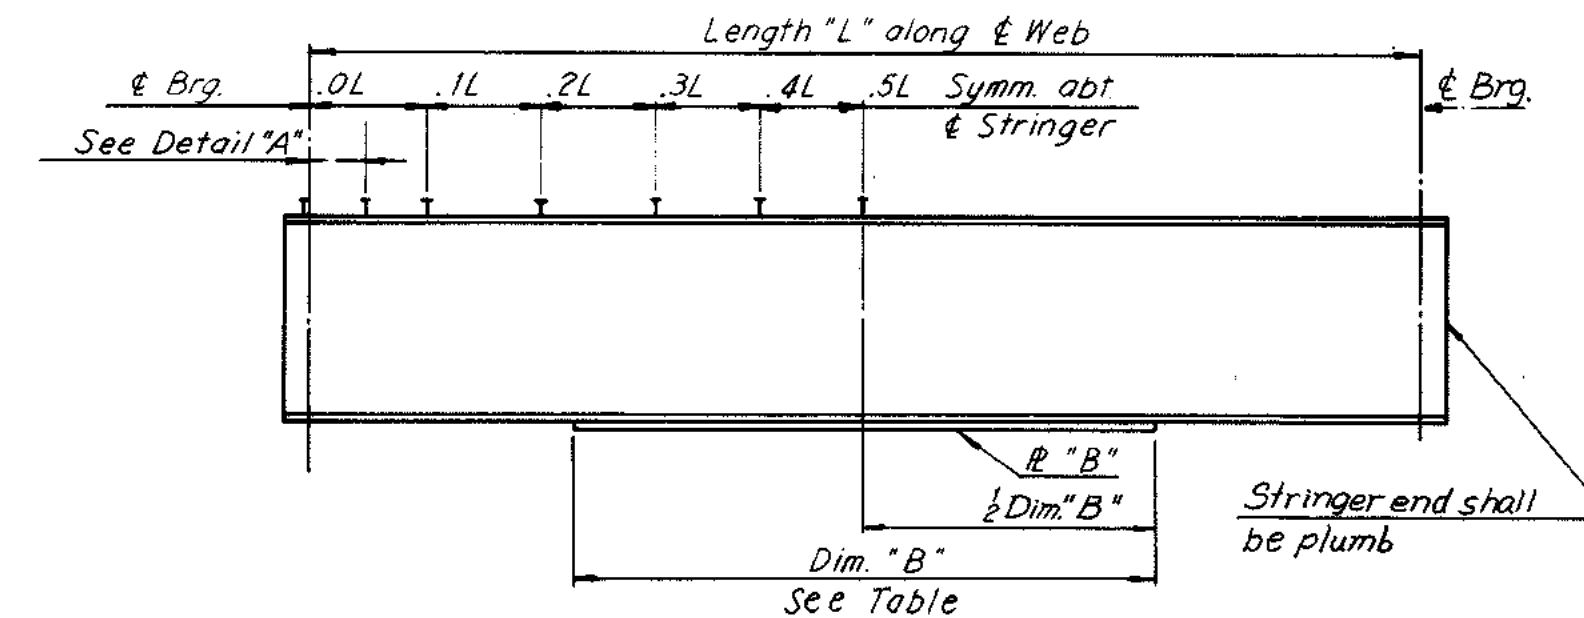

STRINGER ELEVATION

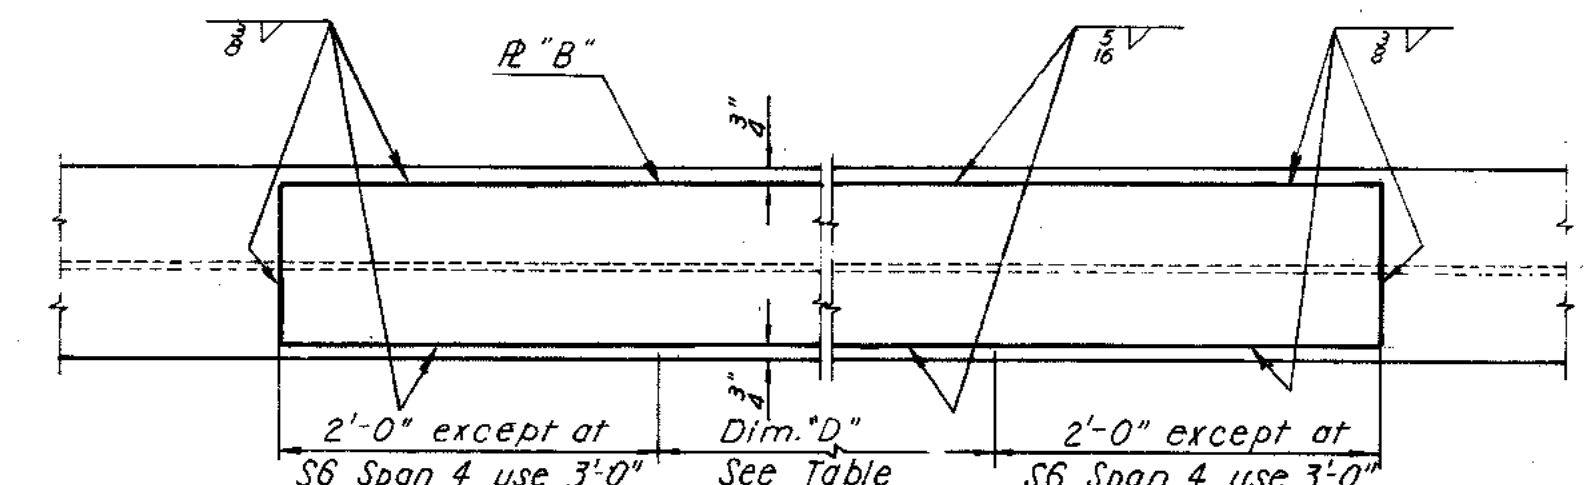


COVER PLATE DETAIL

\* ... Spacing begins at the termination of 7 spaces at 4" ctrs.

DEAD LOAD DEFLECTION SCHEDULE												
UNIT 1			UNIT 2		UNIT 3		UNIT 4		UNIT 5		UNIT 6	
STRINGER	¼L ¾L	½L	¼L ¾L	½L	¼L ¾L	½L	¼L ¾L	½L	¼L ¾L	½L	¼L ¾L	½L
S1	16 <sup>111</sup>	8 <sup>111</sup>	5 <sup>111</sup> 8 <sup>111</sup>	15 <sup>111</sup> 16 <sup>111</sup>	16 <sup>111</sup>	1 <sup>111</sup>	4 <sup>111</sup>	7 <sup>111</sup> 8 <sup>111</sup>	16 <sup>111</sup>	16 <sup>111</sup>	8 <sup>111</sup>	16 <sup>311</sup>
S2	16 <sup>111</sup>	8 <sup>111</sup>	3 <sup>111</sup> 16 <sup>111</sup>	3 <sup>111</sup> 16 <sup>111</sup>	16 <sup>111</sup>	15 <sup>111</sup> 16 <sup>111</sup>	5 <sup>111</sup> 16 <sup>111</sup>	2 <sup>111</sup>	16 <sup>111</sup>	1 <sup>111</sup>	8 <sup>111</sup>	8 <sup>111</sup>
S3	16 <sup>111</sup>	8 <sup>111</sup>	3 <sup>111</sup> 16 <sup>111</sup>	13 <sup>111</sup> 16 <sup>111</sup>	16 <sup>111</sup>	15 <sup>111</sup> 16 <sup>111</sup>	3 <sup>111</sup>	9 <sup>111</sup> 16 <sup>111</sup>	16 <sup>111</sup>	1 <sup>111</sup>	8 <sup>111</sup>	8 <sup>111</sup>
S4	16 <sup>111</sup>	8 <sup>111</sup>	9 <sup>111</sup> 16 <sup>111</sup>	13 <sup>111</sup> 16 <sup>111</sup>	16 <sup>111</sup>	15 <sup>111</sup> 16 <sup>111</sup>	3 <sup>111</sup>	9 <sup>111</sup> 16 <sup>111</sup>	16 <sup>111</sup>	1 <sup>111</sup>	8 <sup>111</sup>	8 <sup>111</sup>
S5	16 <sup>111</sup>	8 <sup>111</sup>	3 <sup>111</sup> 16 <sup>111</sup>	13 <sup>111</sup> 16 <sup>111</sup>	16 <sup>111</sup>	15 <sup>111</sup> 16 <sup>111</sup>	2 <sup>111</sup>	11 <sup>111</sup> 16 <sup>111</sup>	15 <sup>111</sup>	1 <sup>111</sup>	8 <sup>111</sup>	8 <sup>111</sup>
S6	16 <sup>111</sup>	8 <sup>111</sup>	8 <sup>111</sup> 16 <sup>111</sup>	19 <sup>111</sup> 16 <sup>111</sup>	16 <sup>111</sup>	1 <sup>111</sup>	2 <sup>111</sup>	3 <sup>111</sup>	11 <sup>111</sup>	16 <sup>111</sup>	8 <sup>111</sup>	3 <sup>111</sup> 16 <sup>111</sup>

STRINGER SCHEDULE														
UNIT	STRINGER	LENGTH "L"	STRINGER SIZE	R "B"	DIM. "B"	DIM. "D"	SHEAR STUD SPACING					CAMBER SCHEDULE		
							.0L-.1L *	.1L-.2L	.2L-.3L	.3L-.4L	.4L-.5L	1/4L	1/2L	3/4L
1	S1 & S6	27'-8 1/2"	36 W 135	—	—	—	9 1/2"	11"	13 1/2"	16 1/2"	22"	7 1/8"	5 1/8"	7 1/8"
	S2 & S5	27'-8 1/2"	33 W 118	—	—	—	9 1/2"	11"	13 1/2"	16 1/2"	22"	7 1/8"	5 1/8"	7 1/8"
	S3 & S4	27'-8 1/2"	33 W 118	—	—	—	9 1/2"	11"	13 1/2"	16 1/2"	22"	7 1/8"	5 1/8"	7 1/8"
2	S1 & S6	57'-5 1/2"	36 W 135	10 1/2 x 3	43'-2"	39'-2"	8"	9 1/2"	11 1/2"	14"	18 1/2"	2 3/8"	3 1/8"	2 3/8"
	S2 & S5	57'-5 1/2"	36 W 135	10 1/2 x 3	43'-2"	39'-2"	8"	9 1/2"	11 1/2"	14"	18 1/2"	2 3/8"	3 1/8"	2 3/8"
	S3 & S4	57'-5 1/2"	36 W 135	10 1/2 x 3	43'-2"	39'-2"	8"	9 1/2"	11 1/2"	14"	18 1/2"	2 3/8"	3 1/8"	2 3/8"
3	S1 & S6	59'-5 1/2"	36 W 135	10 1/2 x 3	44'-8"	40'-8"	8"	9 1/2"	11 1/2"	14"	18 1/2"	2 3/8"	3 1/8"	2 3/8"
	S2 & S5	59'-5 1/2"	36 W 135	10 1/2 x 3	44'-8"	40'-8"	8"	9 1/2"	11 1/2"	14"	18 1/2"	2 3/8"	3 1/8"	2 3/8"
	S3 & S4	59'-5 1/2"	36 W 135	10 1/2 x 3	44'-8"	40'-8"	8"	9 1/2"	11 1/2"	14"	18 1/2"	2 3/8"	3 1/8"	2 3/8"
4	S1	47'-5 5/8"	36 W 135	10 1/2 x 3	35'-8"	31'-8"	8"	9"	11"	14"	18 1/2"	1 3/8"	1 3/8"	1 3/8"
	S2	49'-0 7/8"	36 W 135	10 1/2 x 3	36'-10"	32'-10"	8"	9"	11"	14"	18 1/2"	1 3/8"	1 3/8"	1 3/8"
	S3	50'-8 1/8"	36 W 135	10 1/2 x 3	38'-1"	34'-1"	8"	9"	11"	14"	18 1/2"	1 3/8"	1 3/8"	1 3/8"
	S4	52'-3 3/8"	36 W 135	10 1/2 x 3	39'-3"	35'-3"	8"	9"	11"	14"	18 1/2"	1 3/8"	1 3/8"	1 3/8"
	S5	53'-10 5/8"	36 W 135	10 1/2 x 3	40'-5"	36'-5"	8"	9"	11"	14"	18 1/2"	1 3/8"	1 3/8"	1 3/8"
5	S1 & S6	60'-0"	36 W 135	10 1/2 x 3	45'-0"	41'-0"	8"	9 1/2"	11 1/2"	14"	18 1/2"	2 3/8"	3 1/8"	2 3/8"
	S2 & S5	60'-0"	36 W 135	10 1/2 x 3	45'-0"	41'-0"	8"	9 1/2"	11 1/2"	14"	18 1/2"	2 3/8"	3 1/8"	2 3/8"
	S3 & S4	60'-0"	36 W 135	10 1/2 x 3	45'-0"	41'-0"	8"	9 1/2"	11 1/2"	14"	18 1/2"	2 3/8"	3 1/8"	2 3/8"
6	S1 & S6	36'-3"	36 W 135	—	—	—	9 1/2"	11"	13 1/2"	16 1/2"	22"	4"	1 1/2"	4"
	S2 & S5	36'-3"	33 W 118	—	—	—	9 1/2"	11"	13 1/2"	16 1/2"	22"	4"	1 1/2"	4"
	S3 & S4	36'-3"	33 W 118	—	—	—	9 1/2"	11"	13 1/2"	16 1/2"	22"	4"	1 1/2"	4"

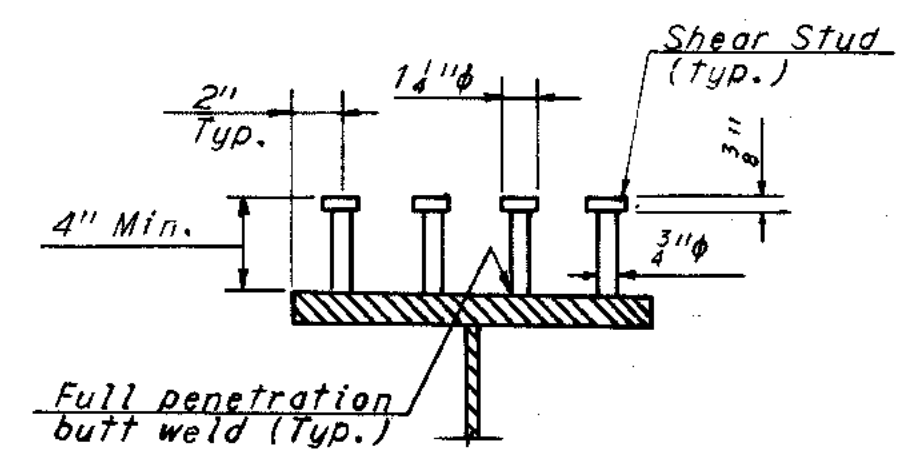

SHEAR STUD DETAIL

No Scale

AS BUILT

RICHMOND METROPOLITAN AUTHORITY  
RICHMOND EXPRESSWAY SYSTEM  
BELTLINE EXPRESSWAY

BRIDGE NO 13  
DOUGLASDALE ROAD OVER  
BELTLINE EXPRESSWAY AND R.F.&P.R.R.

FRAMING PLAN

BY	DATE	NO.	REVISION	BY	DATE
4	As BUILT	RH	2-2-73		
3	Profile Grade	P.S.	4-7-71		
2	General	10-70			
1	General Revisions	MMH	3-12-68		
NO.	REVISION	BY	DATE		


MADE	A.H.H.	11-20-67
CHECKED	S.S.W.	2-9-68
IN CHARGE	F.K.D.	

Note: Stringers having a total camber of less than 1" are not required to be shop cambered, but should be turned so that any mill tolerance deviation from straightness will be in the direction shown by the camber diagram.  
If stringers are not cambered distance top of stringers to top of slab will vary along the stringer in accordance with the offset dimensions shown in the camber diagram, and with a minimum distance as shown in cross-section on Sheet 7.

HOWARD, NEEDLES, TAMMEN & BERGENDOFF  
consulting engineers  
NEW YORK ALEXANDRIA KANSAS CITY

SCALE: As Noted  
CONTRACT NO: 4  
SHEET NO: 6 OF 12

RICHMOND EXPRESSWAY SYSTEM			
SECTION	PROJECT	SHEET NO.	TOTAL SHEETS
4	BELTLINE EXPRESSWAY	124	155

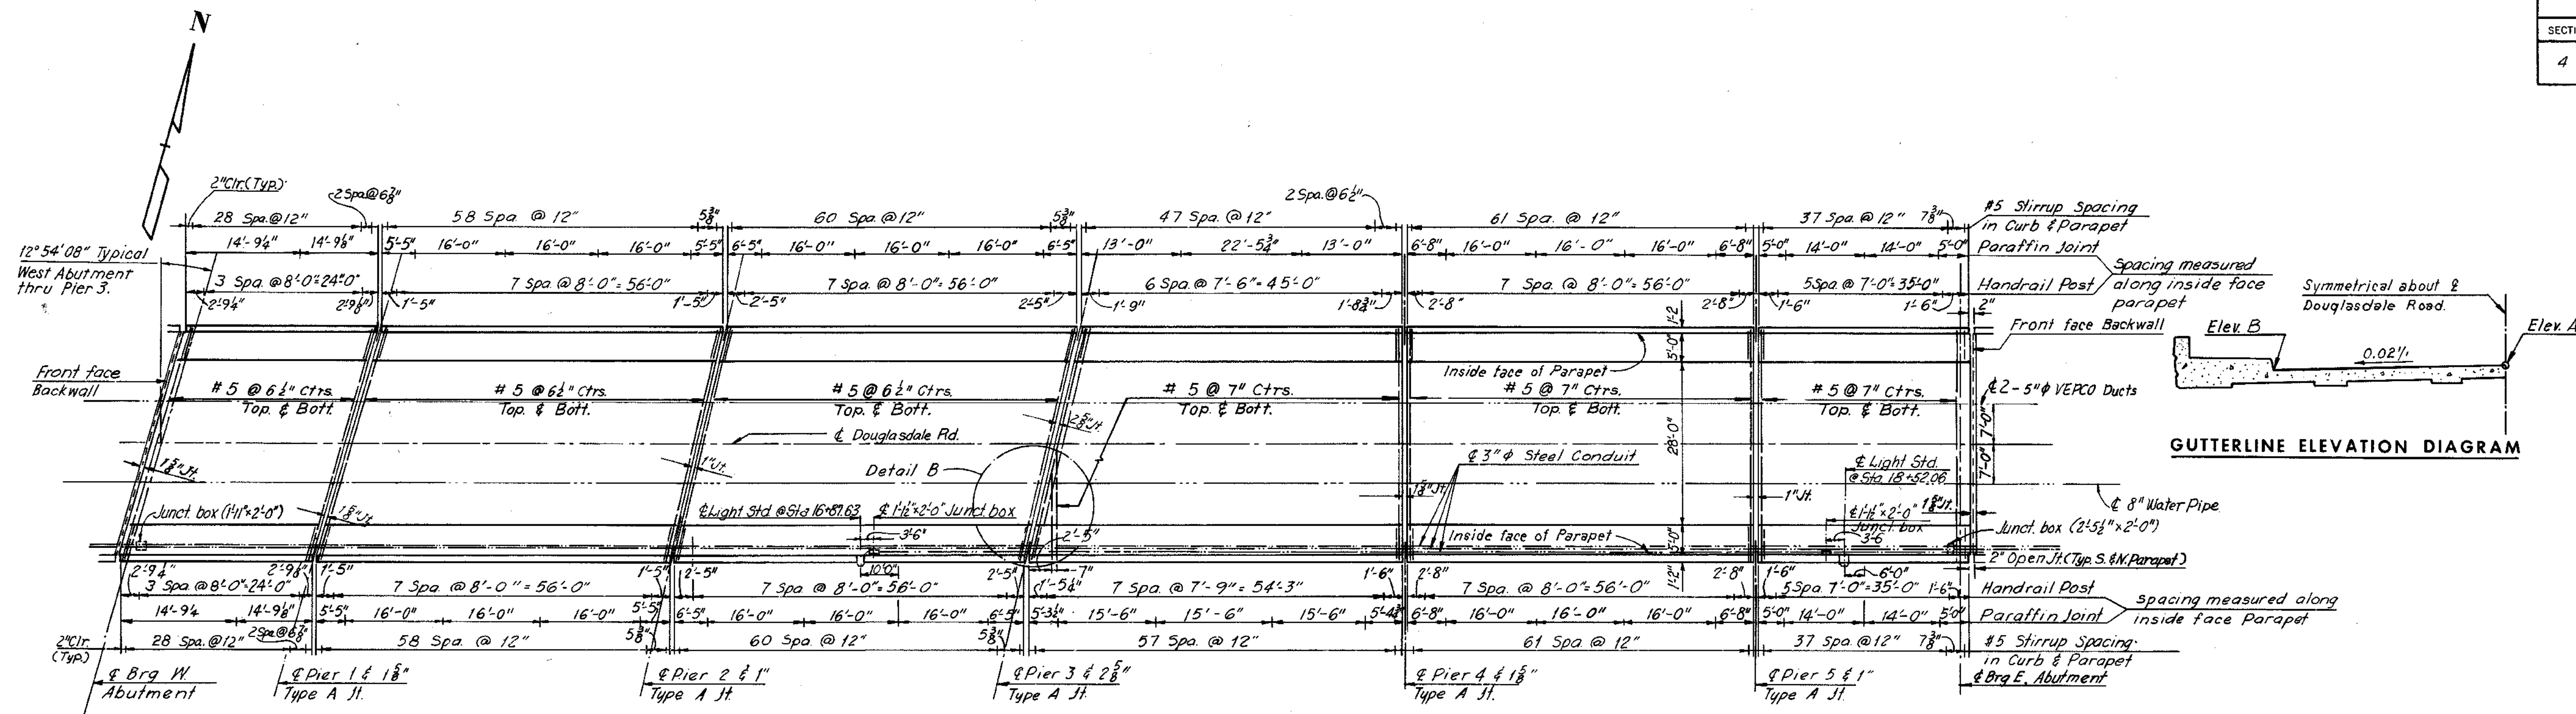


**DECK PLAN**  
Scale:  $\frac{1}{16}'' = 1'-0''$

Note: For reinforcing steel at joints see Sheet 9 joint details.



**TABLE OF ELEVATIONS**

STATION	ELEV. A	ELEV. B
15+50.00	211.17	210.89
60.00	211.89	211.61
70.00	212.62	212.34
71.49	—	212.45
74.70	212.96	—
77.91	—	212.92
80.00	213.34	213.06
90.00	214.03	213.75
16+00.00	214.67	214.39
01.28	—	214.47
04.48	214.95	—
07.69	—	214.86
10.00	215.28	215.00
20.00	215.84	215.56
30.00	216.37	216.09
40.00	216.85	216.57
50.00	217.30	217.02
60.00	217.70	217.42
60.28	—	217.43
63.48	217.83	—
66.69	—	217.67
70.00	218.07	217.79
80.00	218.40	218.12
90.00	218.68	218.40
17+00.00	218.93	218.65
10.00	219.13	218.85
20.00	219.30	219.02
21.28	—	219.03
24.48	219.36	—
27.69	—	219.12
30.00	219.42	219.14
40.00	219.51	219.23
50.00	219.55	219.27
60.00	219.56	219.28
70.00	219.52	219.24
77.48	219.47	219.19
80.00	219.45	219.17
90.00	219.33	219.05
18+00.00	219.18	218.90
10.00	218.99	218.71
20.00	218.75	218.47
30.00	218.48	218.20
38.98	218.20	217.92
40.00	218.16	217.88
50.00	217.81	217.53
60.00	217.42	217.14
70.00	216.97	216.69
77.23	216.63	216.35
80.00	216.50	216.22
90.00	216.03	215.75
19+00.00	215.55	215.27

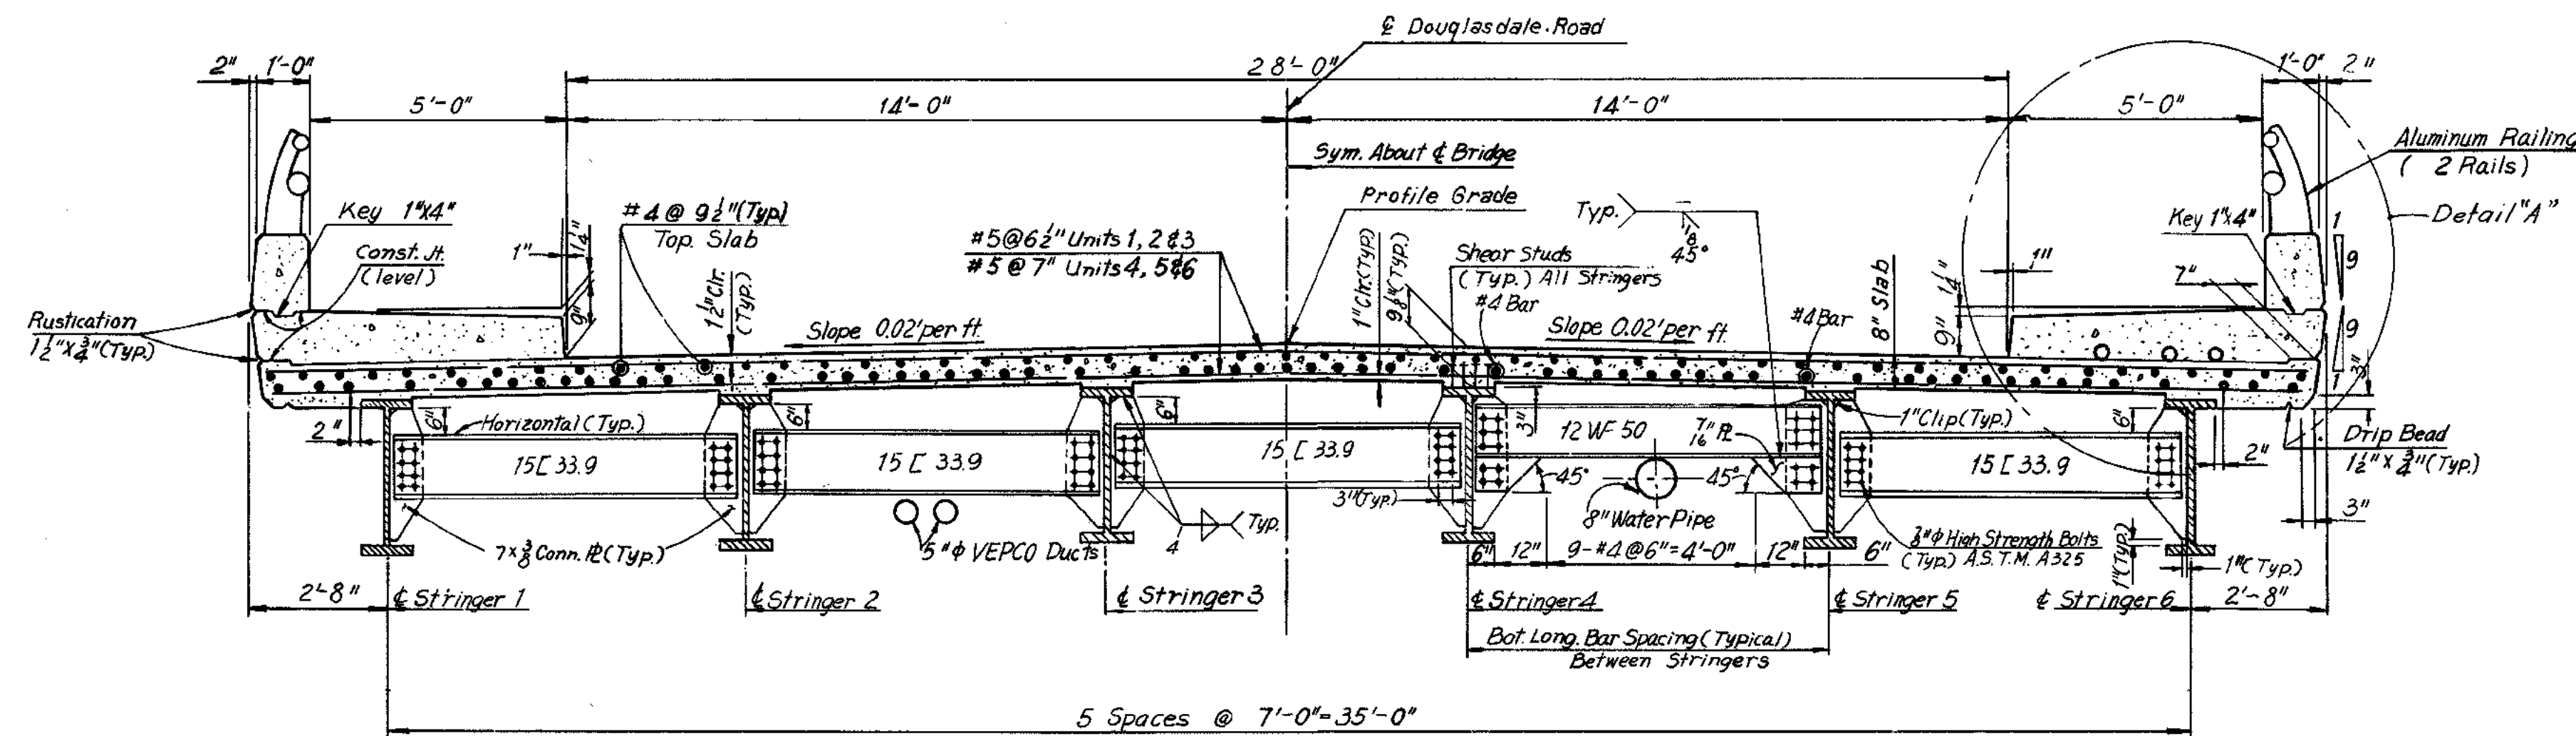

**TYPICAL CROSS SECTION  
INTERMEDIATE DIAPHRAGM**

Scale:  $\frac{3}{8}'' = 1'-0''$

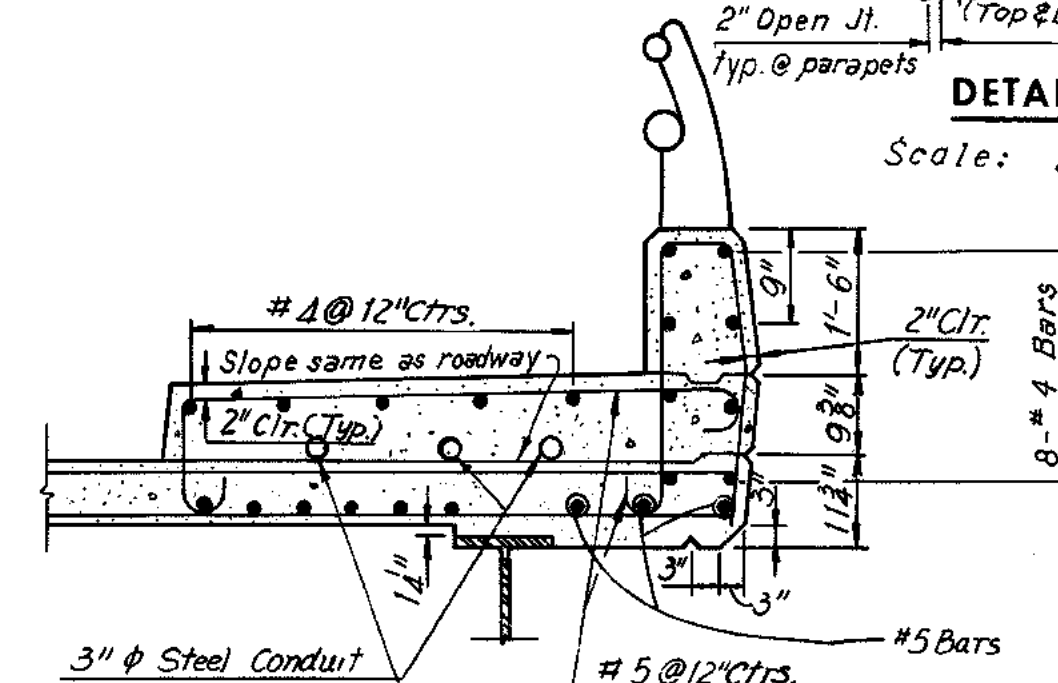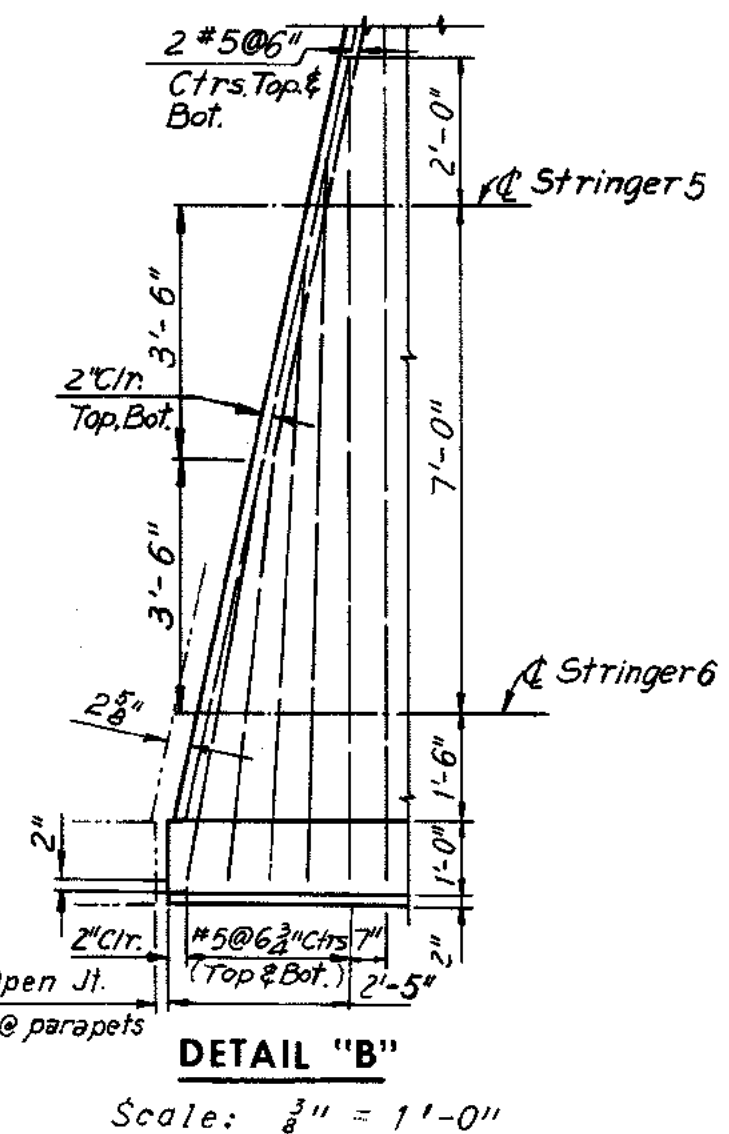

Notes:  
For Superstructure Quantities see Sheet 1.  
For Framing and Utility support details see Sheet 8.  
For Joint details see Sheet 9.  
For Lighting details see Sheet S4.  
For details of transmission ducts see Sheet S4.

**RICHMOND METROPOLITAN AUTHORITY  
RICHMOND EXPRESSWAY SYSTEM  
BELTLINE EXPRESSWAY**

**BRIDGE NO 13  
DOUGLASDALE ROAD OVER  
BELTLINE EXPRESSWAY AND R.F.P.R.R.**


**DECK PLAN**

HOWARD, NEEDLES, TAMMEN & BERGENDOFF  
consulting engineers  
NEW YORK ALEXANDRIA KANSAS CITY  
SCALE: As Noted  
CONTRACT NO. 4  
SHEET NO. 7 OF 12


BY	DATE	3	As Built	R.H.	2-5-73
MADE	AMH 10-9-67	2	Profile Grade	L.B.P.	4-6-71
CHECKED	SSM 2-8-68	1	General Revisions	M.H.H.	3-12-68
IN CHARGE	FKD				

**ASBUILT**


RICHMOND EXPRESSWAY SYSTEM			
SECTION	PROJECT	SHEET NO.	TOTAL SHEETS
4	BELTLINE EXPRESSWAY	115/1	1

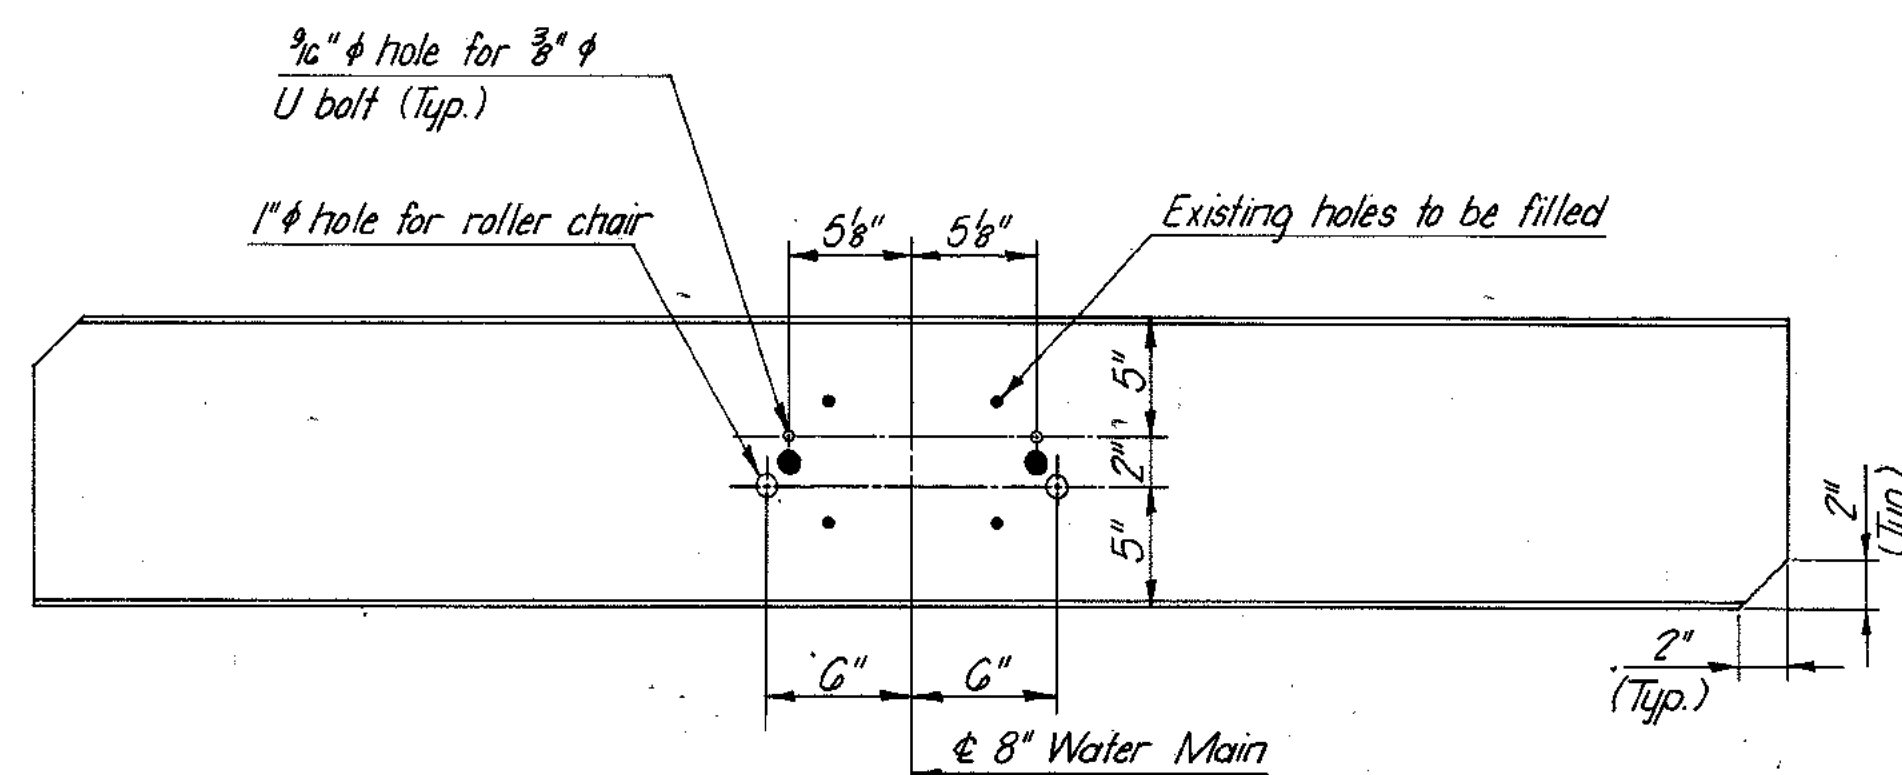

**PLAN**  
Scale: 1/2" = 1'-0"

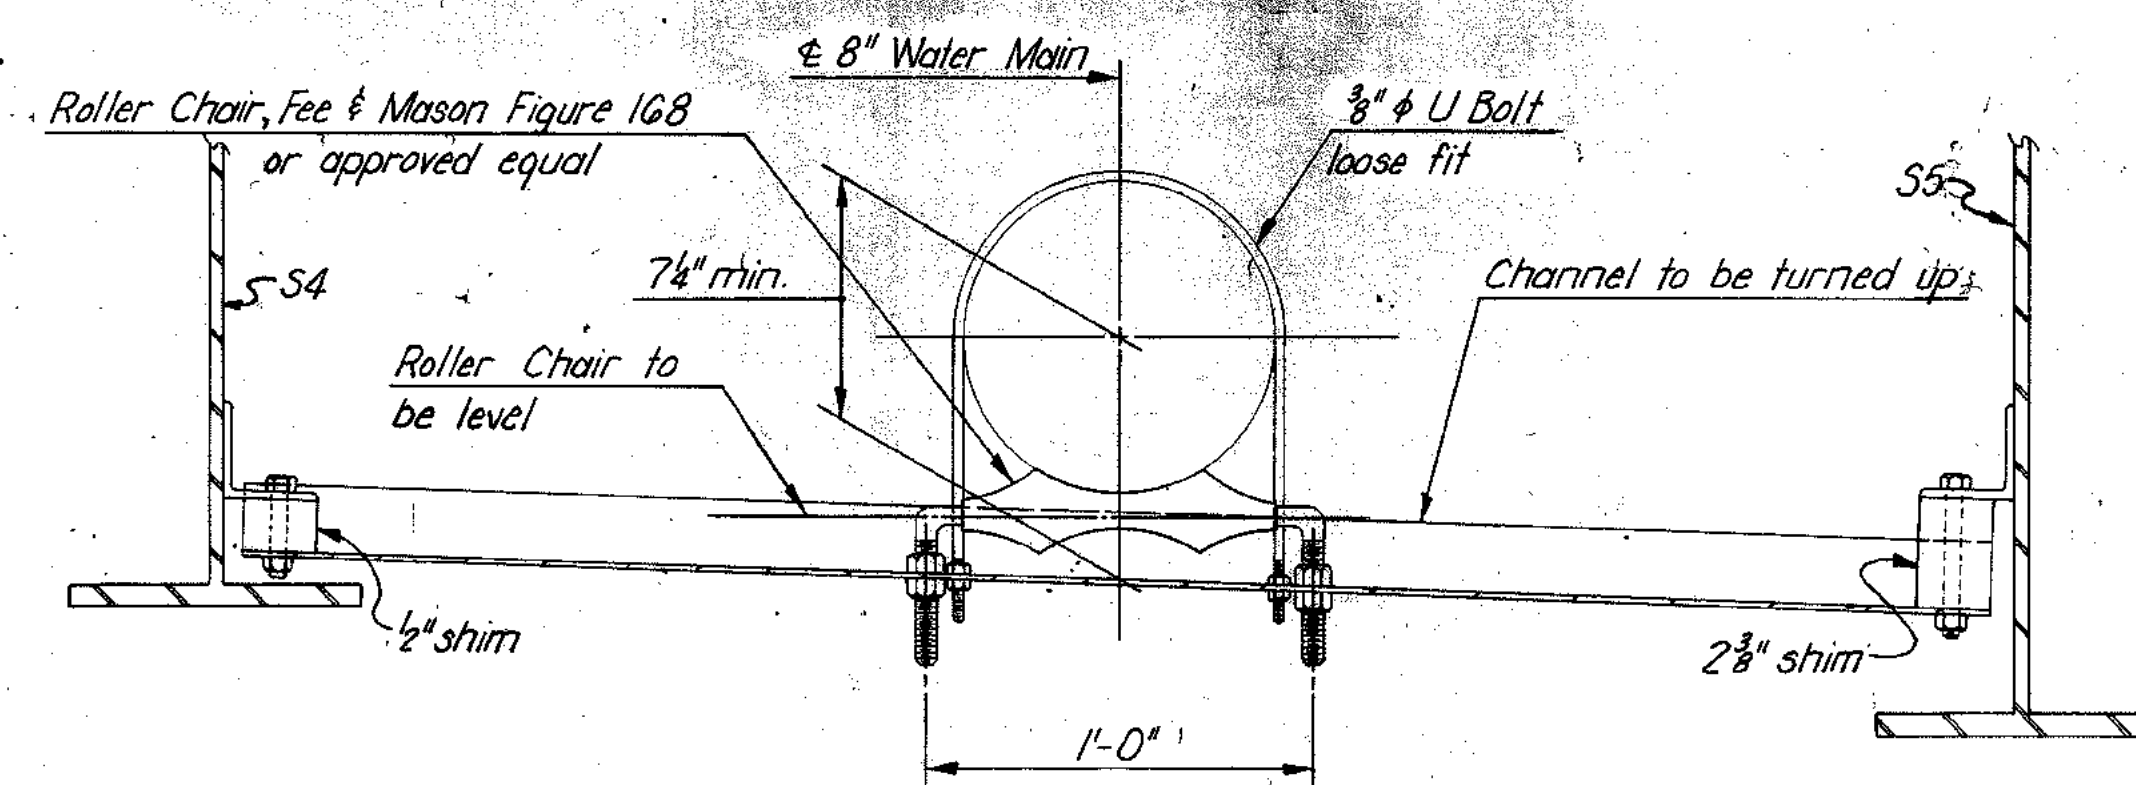

**ELEVATION**  
Scale: 1/2" = 1'-0"

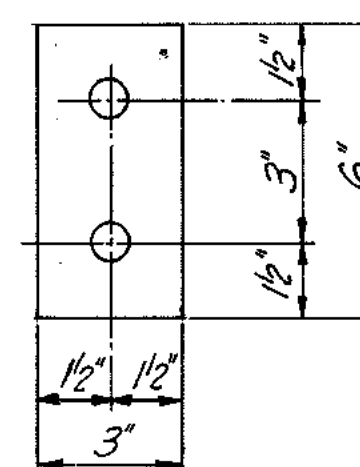

**SHIM DETAIL**  
Scale: 3" = 1'-0"

MADE	CHECKED	IN CHARGE	BY	DATE

**AS BUILT**

**RICHMOND METROPOLITAN AUTHORITY**  
**RICHMOND EXPRESSWAY SYSTEM**

**BRIDGE NO. 13**  
**DOUGLASDALE ROAD OVER**  
**BELTLINE EXPRESSWAY AND R.F. & P.R.R.**  
**WATER MAIN SUPPORT DIAPHRAGMS**  
**UNITS 1 & 6**

SCALE: **AS SHOWN**

CONTRACT NO.: **4**

HOWARD, NEEDLES, TAMMEN & BERGENDOFF  
General Consultants

SHEET NO. **8A** OF **12**











## **Bridge 17**

**Northbound Powhite Parkway (VA-76) Ramp to Floyd Ave. and Cary Street  
Over**

**Northbound I-195 and the Ramp from Northbound I-195 to Floyd Avenue**

**Record Set Plans**





[illegible]

Str. Stl. High Strength lbs. A588	Struct. Excav. Cu. Yds.	Concrete (a) Cu. Yds.	Reinf. Steel Lbs.	Str. Stl. Mild Carbon Lbs.	Aluminum railing (1-Rail) Lin. Ft.	Porous Backfill Cu. Yds.	Under- drain 6" Dia. Pipe Lin. Ft.	Con. Slab Sl. Prot. Sq. Yds.	Asphalt damp- proofing Sq. Yds.	Approach Slab Conc. (a) Cu. Yds.	Steel Piles 10BP42 Lin. Ft.	Parapet Junct. Box Complete Each	Metal Conduit 3" Dia. Lin. Ft.	Metal Conduit 1 1/2" Dia. Lin. Ft.
1,561.2	Superstructure	-	335.98(b)	94,764	342,021.5	687	-	-	-	-	-	2	290	56
	South Abutment	179	87.81	26,326	-	-	7	68	-	31	62.91	654.3	-	-
	Pier 1	67	67.39	7,653	-	-	-	-	-	-	413.4	-	-	-
	Pier 2	90	99.35	12,167	-	-	-	-	-	-	432.1	-	-	-
	Pier 3	156	112.588	15,056	-	-	-	-	-	-	493.8	-	-	-
	N-Abut. S-Cory	143	79.26	21,016	-	-	5	56	-	25	52.85	621.7	-	-
	N-Abut. S-Floyd	180	88.22	29,400	-	-	6	80	-	28	73.48	802.1	-	-
	Total	815	335.98(b) 534.91	206,382	342,021.5	687	18	204	-	84	189.24	3,417.4	2	290

**PROFILE GRADE & RAMP S-CARY**

Boring, denotes 2 1/2" Cased Hole

Measured Along @ Ramp S-Floyd  
Front Face of Backwall Sta 2+31.89

Measured Along @ Ramp S-Cary

Front Face of Backwall  
Sta 8+15.62

Existing Ground Line

Finished Ground Line

Elev 214.25 W. Wingwall  
Elev 212.75 E. Wingwall  
Ave. Pile Tip Elev 168.26

2% (Normal)

14'-11 1/4" Vertical C.I.

22'-0" Roadway

8% (Normal)

2% (Normal)

Match Line @ Pier 3

Front Face Sta 10+34

Elev 202.50

Ave. Pile Tip Elev 174.14

Ramp E-Floyd  
Profile Grade Line

Elev 200.25

Proposed 24" Sewer Invert Elev 199.69

Elev 201.00

Ave. Pile Tip Elev 175.00

**CURVE DATA**

**@ RAMP S-CARY**

P.I. = Sta. 3+96.91  
 $\Delta = 15^\circ 45' 34''$   
 $D = 2^\circ 00' 00''$   
 $T = 396.91'$   
 $L = 788.31'$   
 $R = 2864.79'$

**@ RAMP S-FLOYD**

P.I. = Sta. 3+15.96  
 $\Delta = 6^\circ 21' 39''$   
 $D = 2^\circ 00' 00''$   
 $T = 159.19'$   
 $L = 318.05'$   
 $R = 2864.79'$

**@ RAMP S-FLOYD**

P.I. = Sta. 5+60.34  
 $\Delta = 20^\circ 18' 32''$   
 $D = 12^\circ 00' 00''$   
 $T = 85.52'$   
 $L = 169.24'$   
 $R = 477.46'$

**@ E-N ROADWAY**

P.I. = Sta. 12+49.94  
 $\Delta = 59^\circ 15' 01''$   
 $D = 7^\circ 30' 00''$   
 $T = 434.42'$   
 $L = 790.00'$   
 $R = 763.94'$

**PROFILE GRADE & RAMP S-FLOYD**

PVI Sta 5+00  
Elev 233.03  
+1.24%  
-6.12%

230' V.C.

**PROFILE GRADE & E-N ROADWAY**

350' V.C.

-2.911%

+1.50%

PVI Sta 12+00  
Elev 204.10

**LAYOUT SKETCH**

8' Brg. S. Abut.

@ Pier 1

@ Ramp S-Floyd  
PC Sta 1+56.77

PT Sta 7+88.81

@ Ramp S-Cary

50' 53' 22"

50' 53' 22"

45' 46' 37"

36'-0"

63'-0"

**TABLE**

Drawn By	R.H.	2-5-73	4	Profile Grade - E-N Roadway	L.B.P.	4-70
BY	DATE	3	Parapet	E.V.R.	12-70	
G.C.C.	1-2-68	2	General	J.G.V.	10-70	
L.J.R.	3-7-68	1	General Revision	A.M.H.	5-13-68	
CHARGE	F.K.D.	NO.	REVISION	BY	DATE	

# AS BUILT

### LIMITS OF STRUCTURE EXCAVATION

# RICHMOND METROPOLITAN AUTHORITY RICHMOND EXPRESSWAY SYSTEM


## BELTLINE EXPRESSWAY

### BRIDGE NO. 17 RAMP S-CARY OVER EAST-NORTH ROADWAY

## GENERAL PLAN AND ELEVATION


	INDEX	Sheet
GENERAL PLAN AND ELEVATION	1	1
SOUTH ABUTMENT	2	2
NORTH ABUTMENT S-CAP	3	3
NORTH ABUTMENT S-FLOYD	4	4
ABUTMENT DETAILS	5	5
PIER	6	6
PIERS 2 AND 3	7	7
FRAMING PLAN	8	8
DECK PLAN	9	9
DECK DETAILS	10	10
JOINT DETAILS	11	11
JOINT DETAILS	12	12
APPROACH SLAB AND SLOPE PROTECTION DETAILS	13	13
BORING LOGS	14	14
STANDARD SHOE DETAILS	15	15
STANDARD ALUMINUM RAILING DETAILS	52	52
STANDARD ELECTRICITY DETAILS	55	55
SECTIONAL DETAILS	56	56



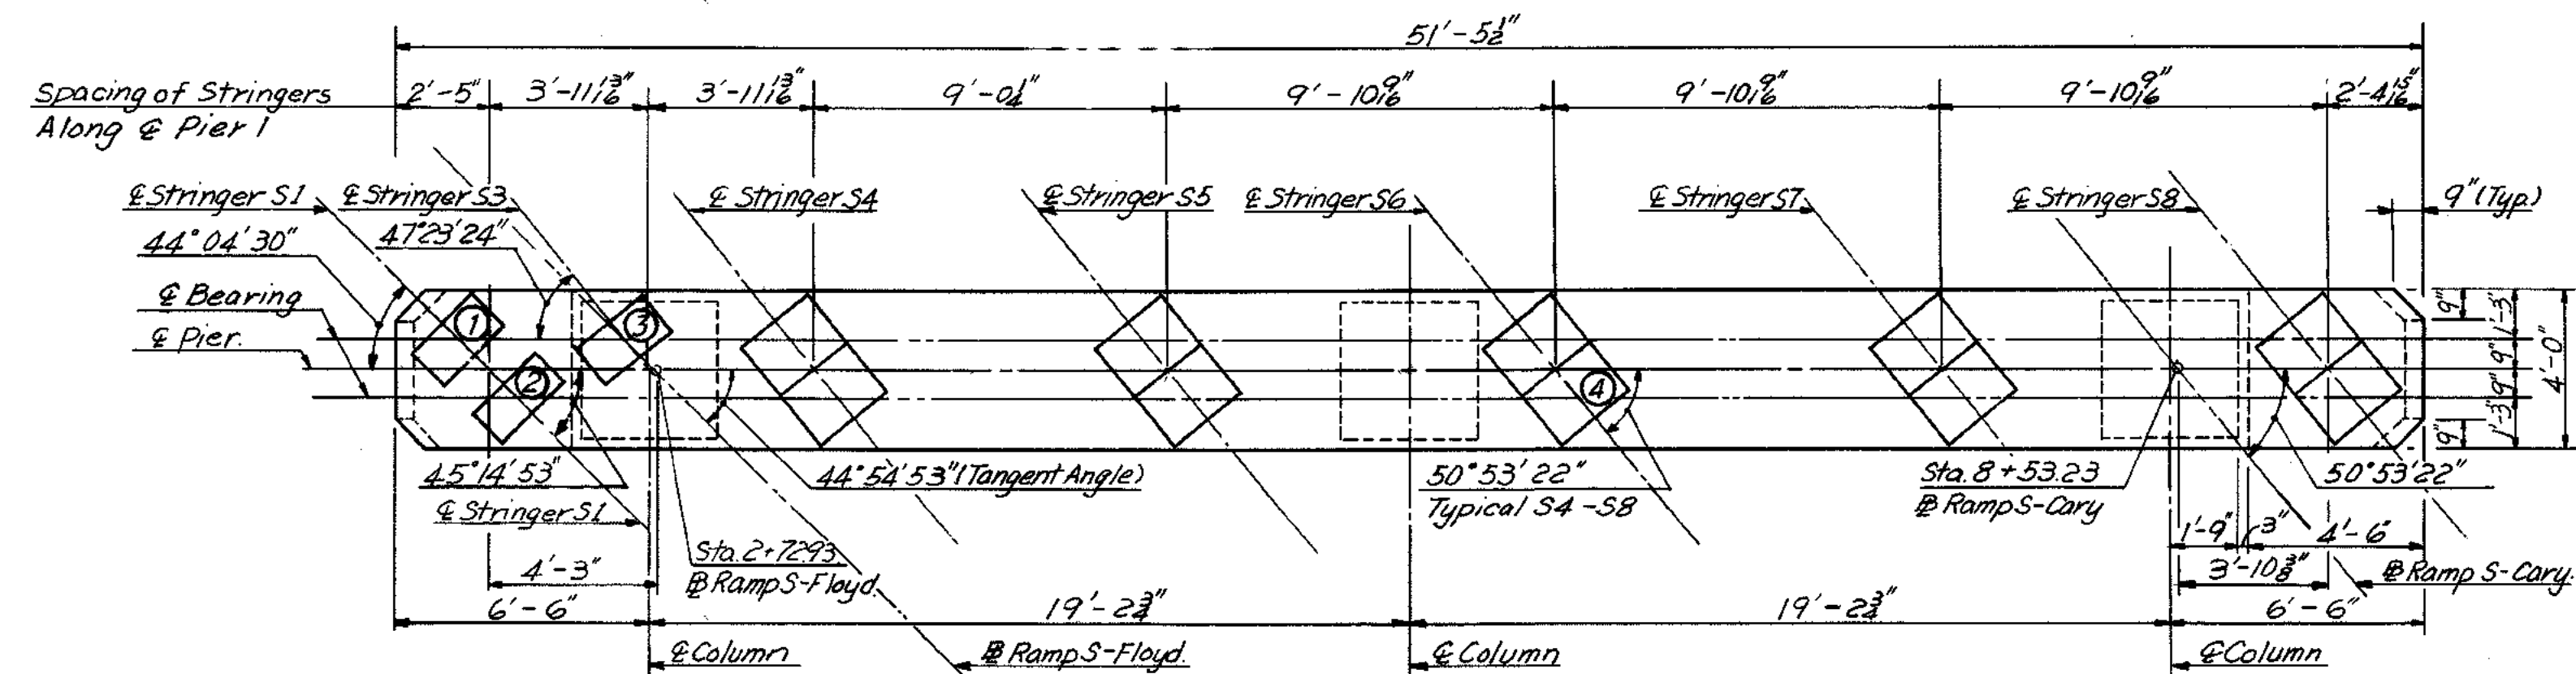


Note:  
③ Indicates case of Anchor bolt setting plan, see table.


PLAN  
Scale 1/4" = 1'-0"

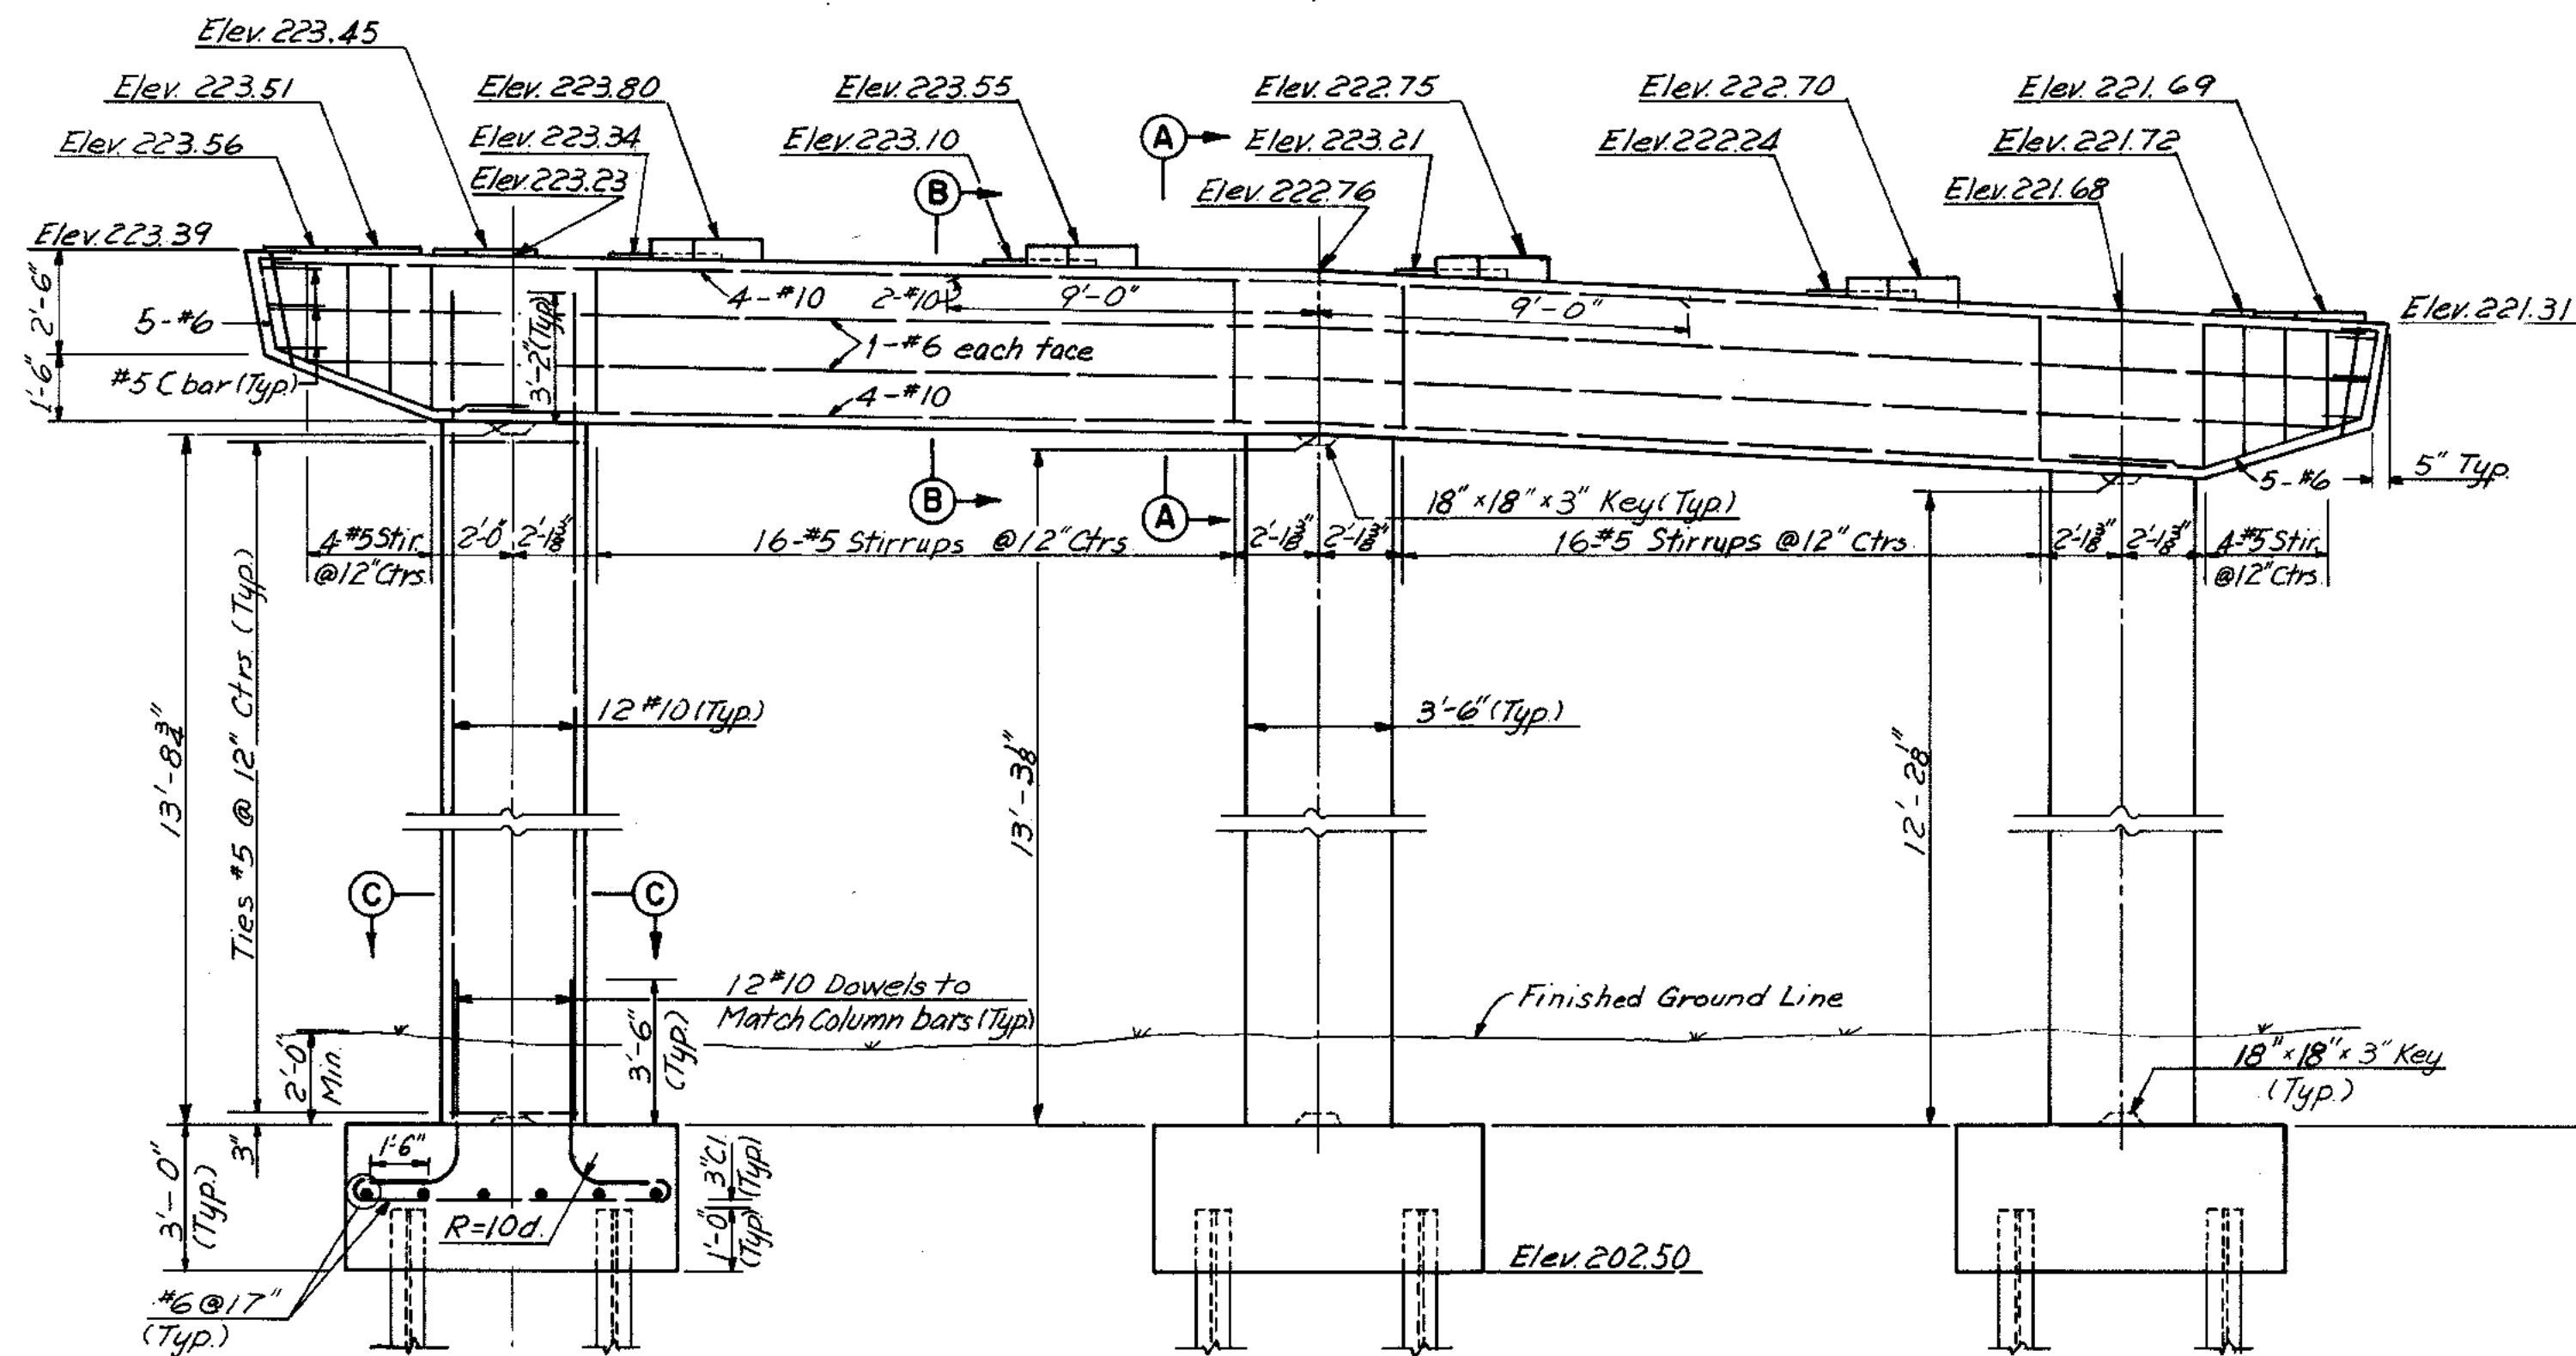


ELEVATION  
Scale 1/4" = 1'-0"

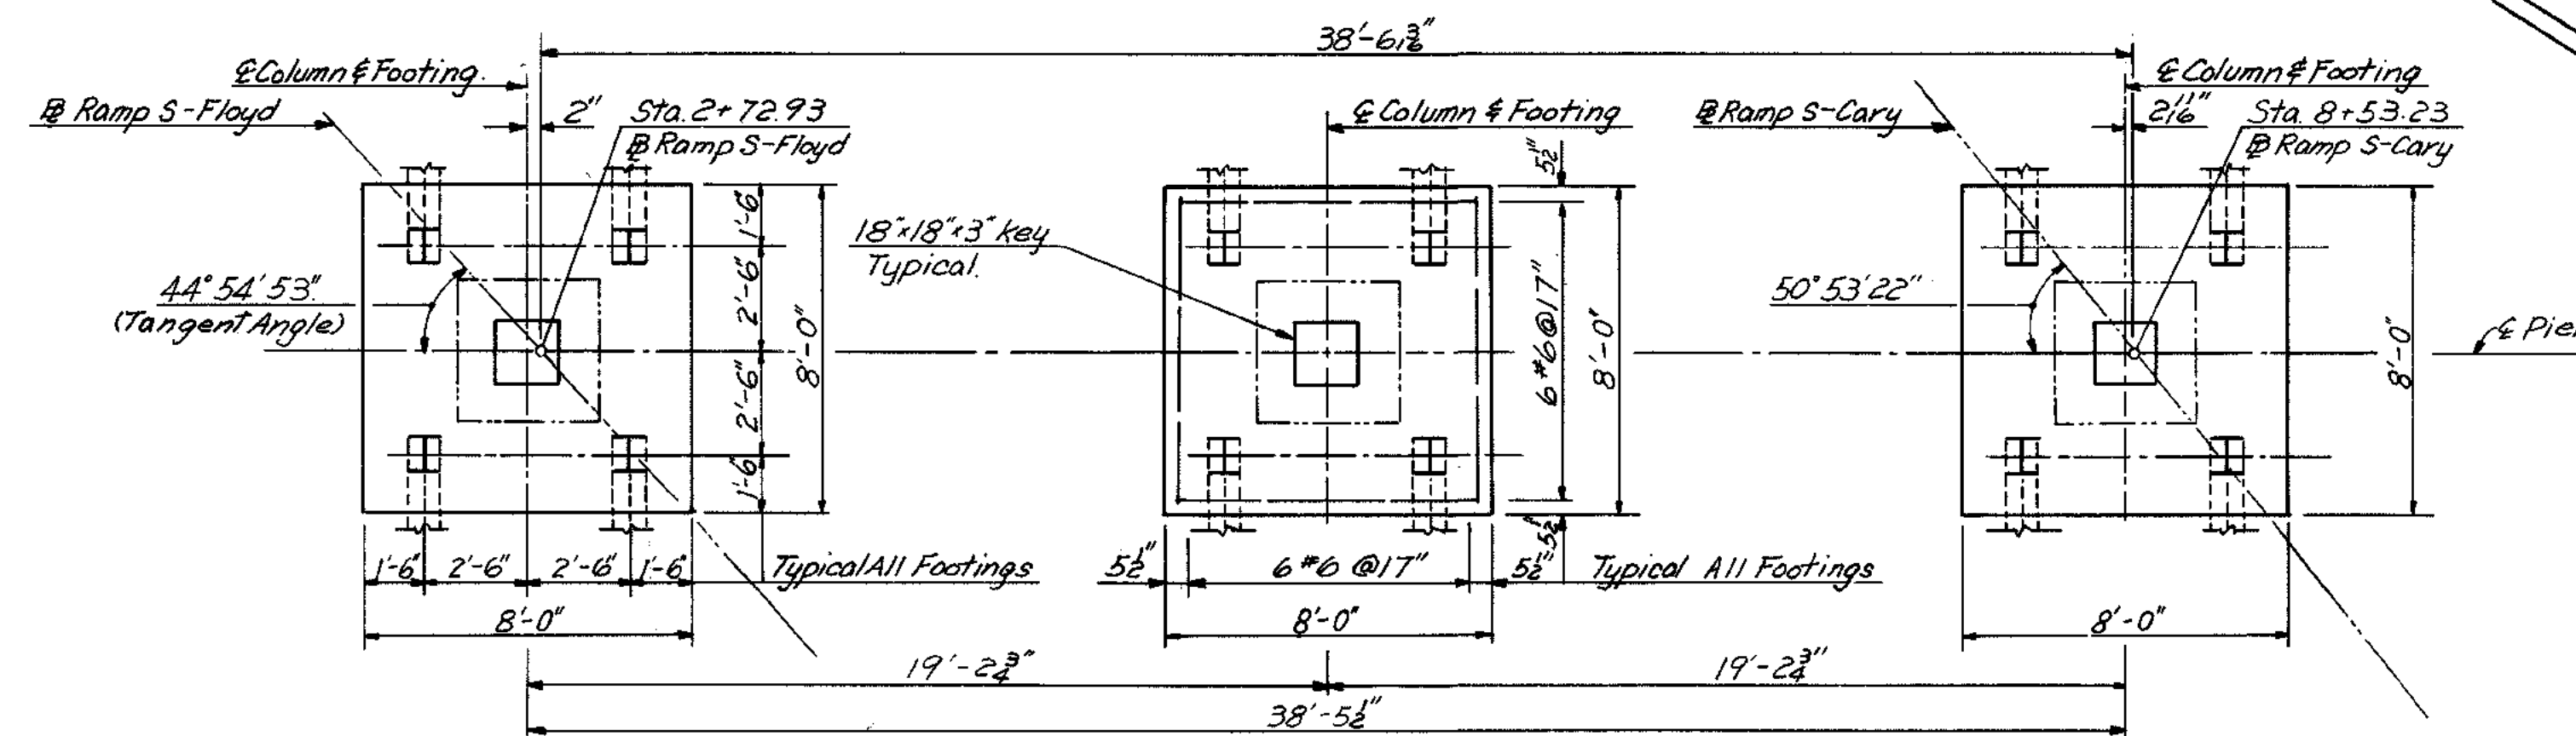



FOOTING PLAN  
Scale 1/4" = 1'-0"

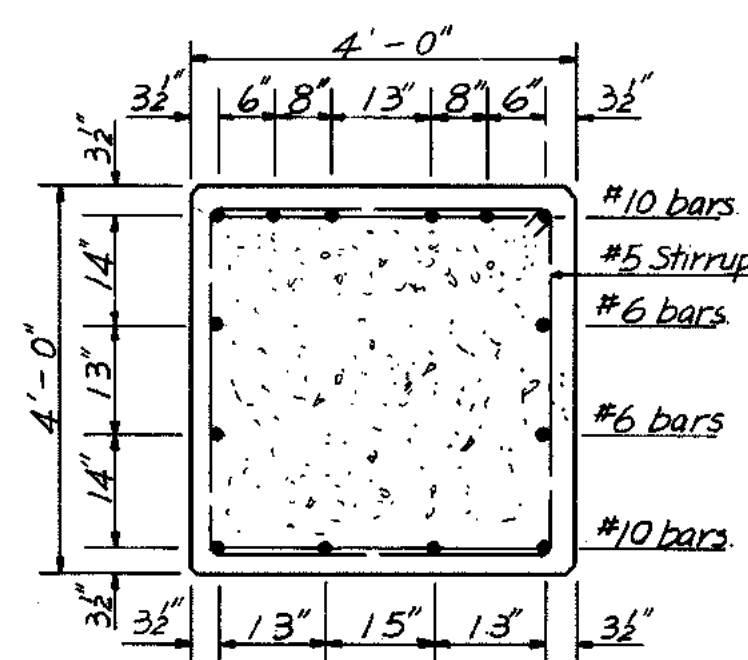

SECTION A-A  
Scale 1/2" = 1'-0"

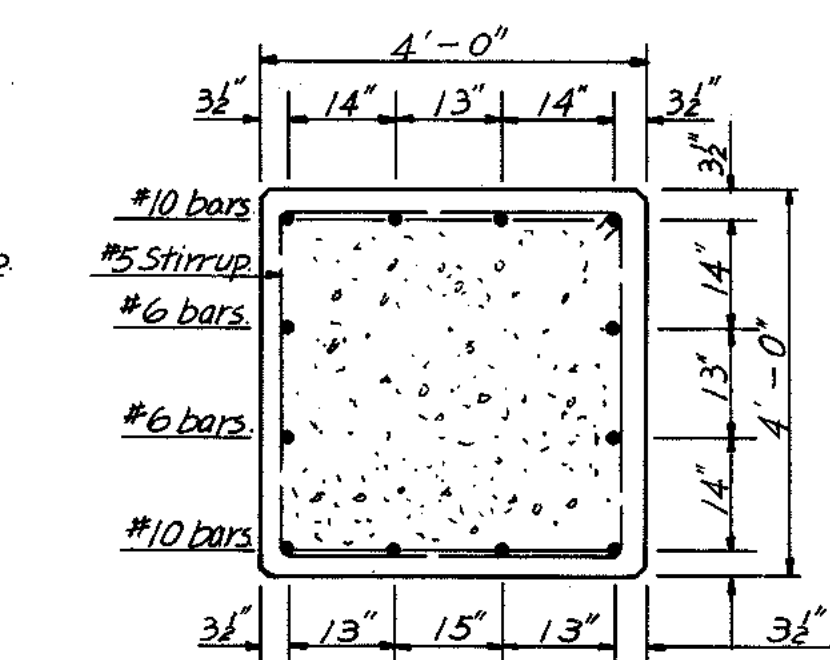

SECTION B-B  
Scale 1/2" = 1'-0"

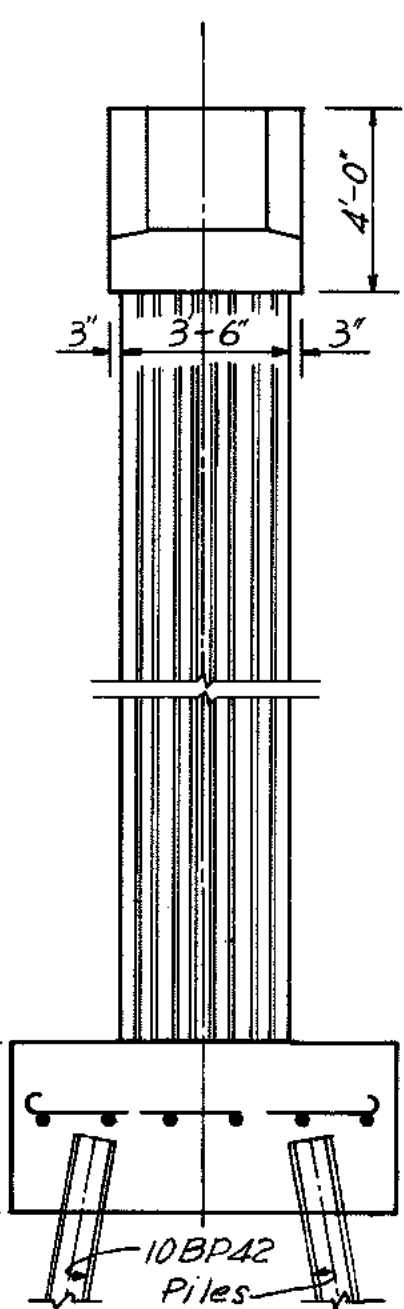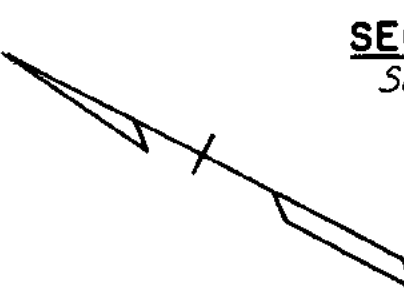

ANCHOR BOLT SETTING PLAN DIMENSIONS															
Case	Angle W	A	B	C	D	E	F	G	H	I	J	K	L	M	N
1	44°04'30"	10	4 1/4	14 1/4	28 1/2	9 1/2	4 3/8	14 3/8	28 3/8	10 1/4	8	8 1/4	5 1/8	5 3/8	9 1/8
2	45°14'53"	9 1/2	4 1/4	14 3/8	28 3/8	9 1/8	4 1/4	14 1/4	28 1/4	10 1/2	7 1/2	8	5 1/8	5 1/8	8 1/8
3	47°23'24"	9 1/2	5	14 1/2	29	10 1/4	3 7/8	14 1/8	28 1/8	10 1/4	8	8 1/4	5 1/8	6 1/8	8 1/4


(Dimensions are in inches)

Case ①, ② & ③


ANCHOR BOLT SETTING PLAN  
No Scale

Note:  
Footing elevations are approximate only and may be varied to suit field conditions as directed by the Engineer. Vertical shaft reinforcing shall not be cut until these elevations are established. Where elevations change more than 2 ft. redesign will be required.


Note:  
All piles shall be 10BP42 Steel Piles (Design capacity = 45 tons).  
Batter all piles 2" per foot where shown.  
For Standard Shoe details see Sheet S1.  
For Framing Plan see Sheet 8.  
For Steel Pile details see Sheet 12.

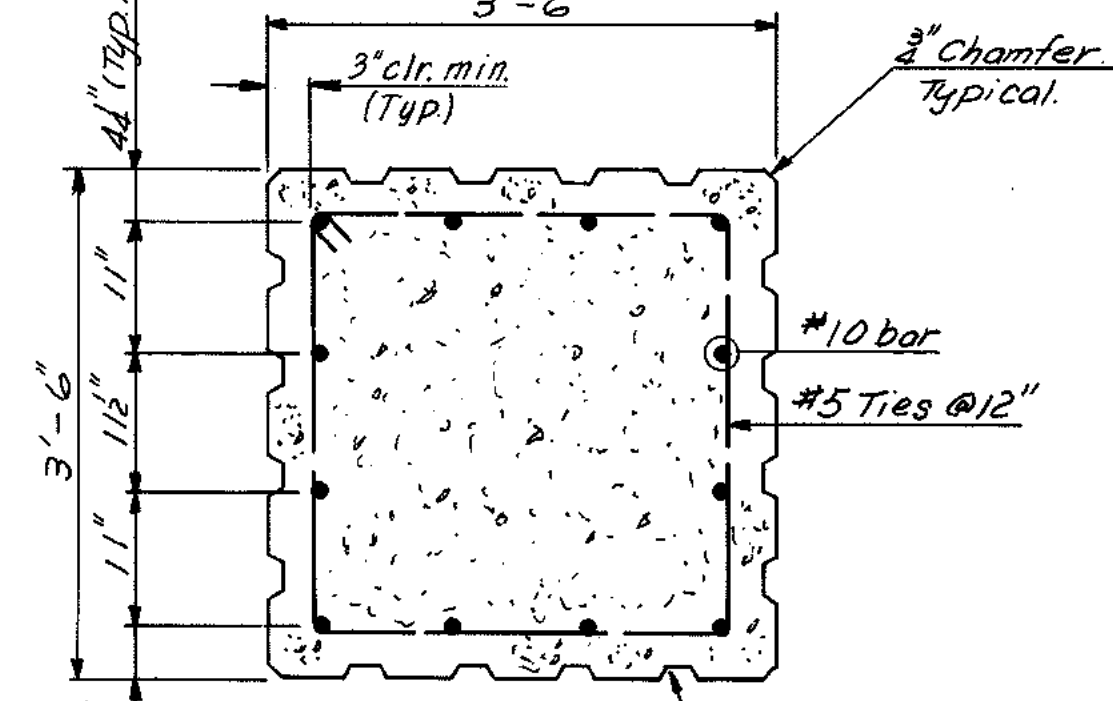

SECTION C-C  
Scale 1/2" = 1'-0"

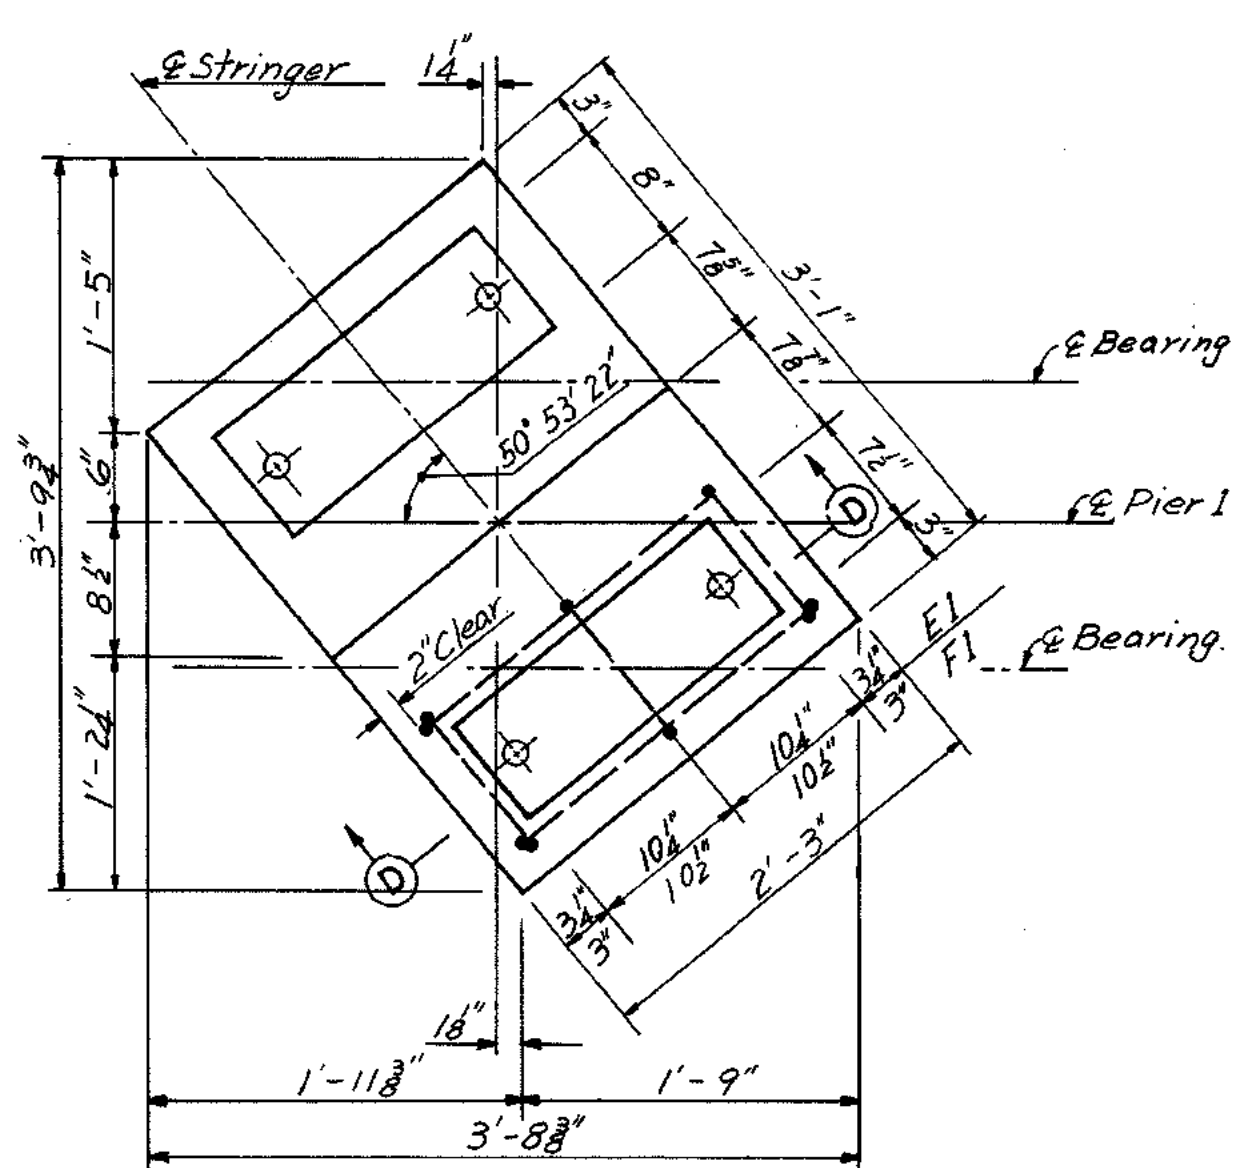

Case ②

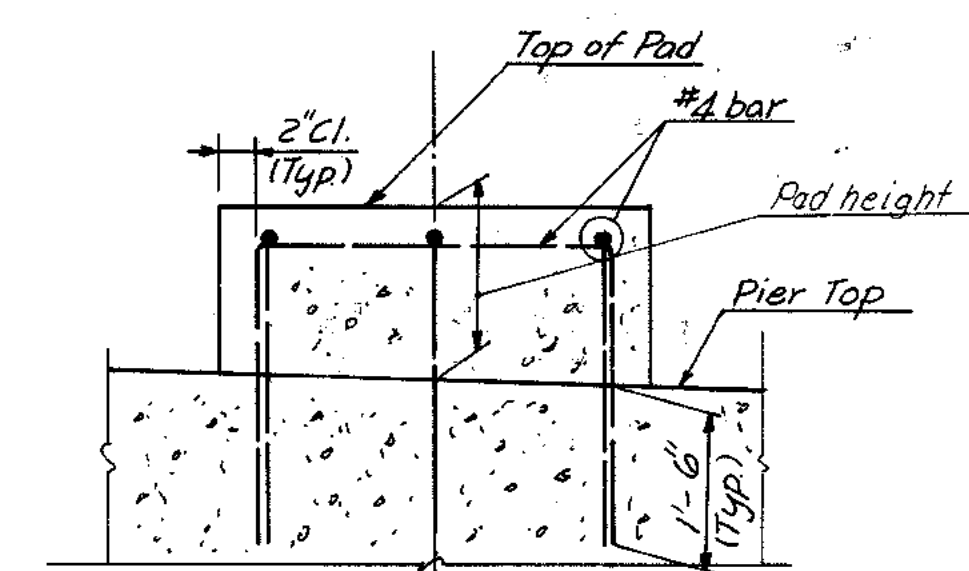

SECTION D-D  
No Scale

Note:  
No reinforcing steel required for pad height less than 4".

RICHMOND METROPOLITAN AUTHORITY  
RICHMOND EXPRESSWAY SYSTEM  
BELTLINE EXPRESSWAY  
BRIDGE NO. 17  
RAMP S-CARY OVER  
EAST-NORTH ROADWAY  
PIER 1



HOWARD, NEEDLES, TAMMEN & BERGENDOFF  
consulting engineers  
NEW YORK ALEXANDRIA KANSAS CITY  
SCALE: As noted  
CONTRACT NO. 4  
SHEET NO. 6 OF 14

AS BUILT

BY	DATE	REVISION	BY	DATE
MADE	G.C.C. 11-3-67	2	As Built	R.H. 2-5-73
CHECKED	AMH 5-7-68	1	General Revision	RLM 5-15-68
IN CHARGE	FKD			





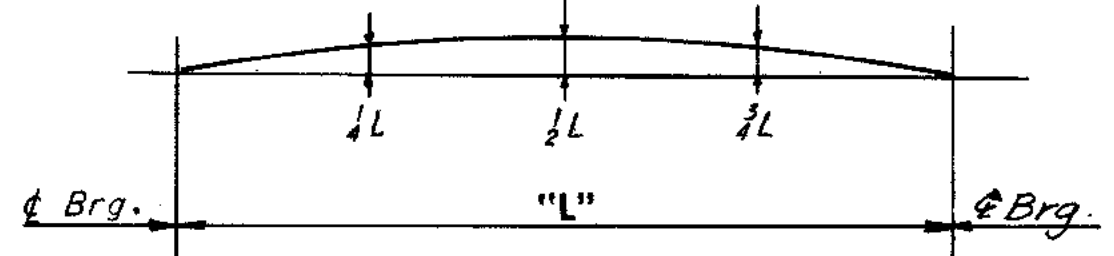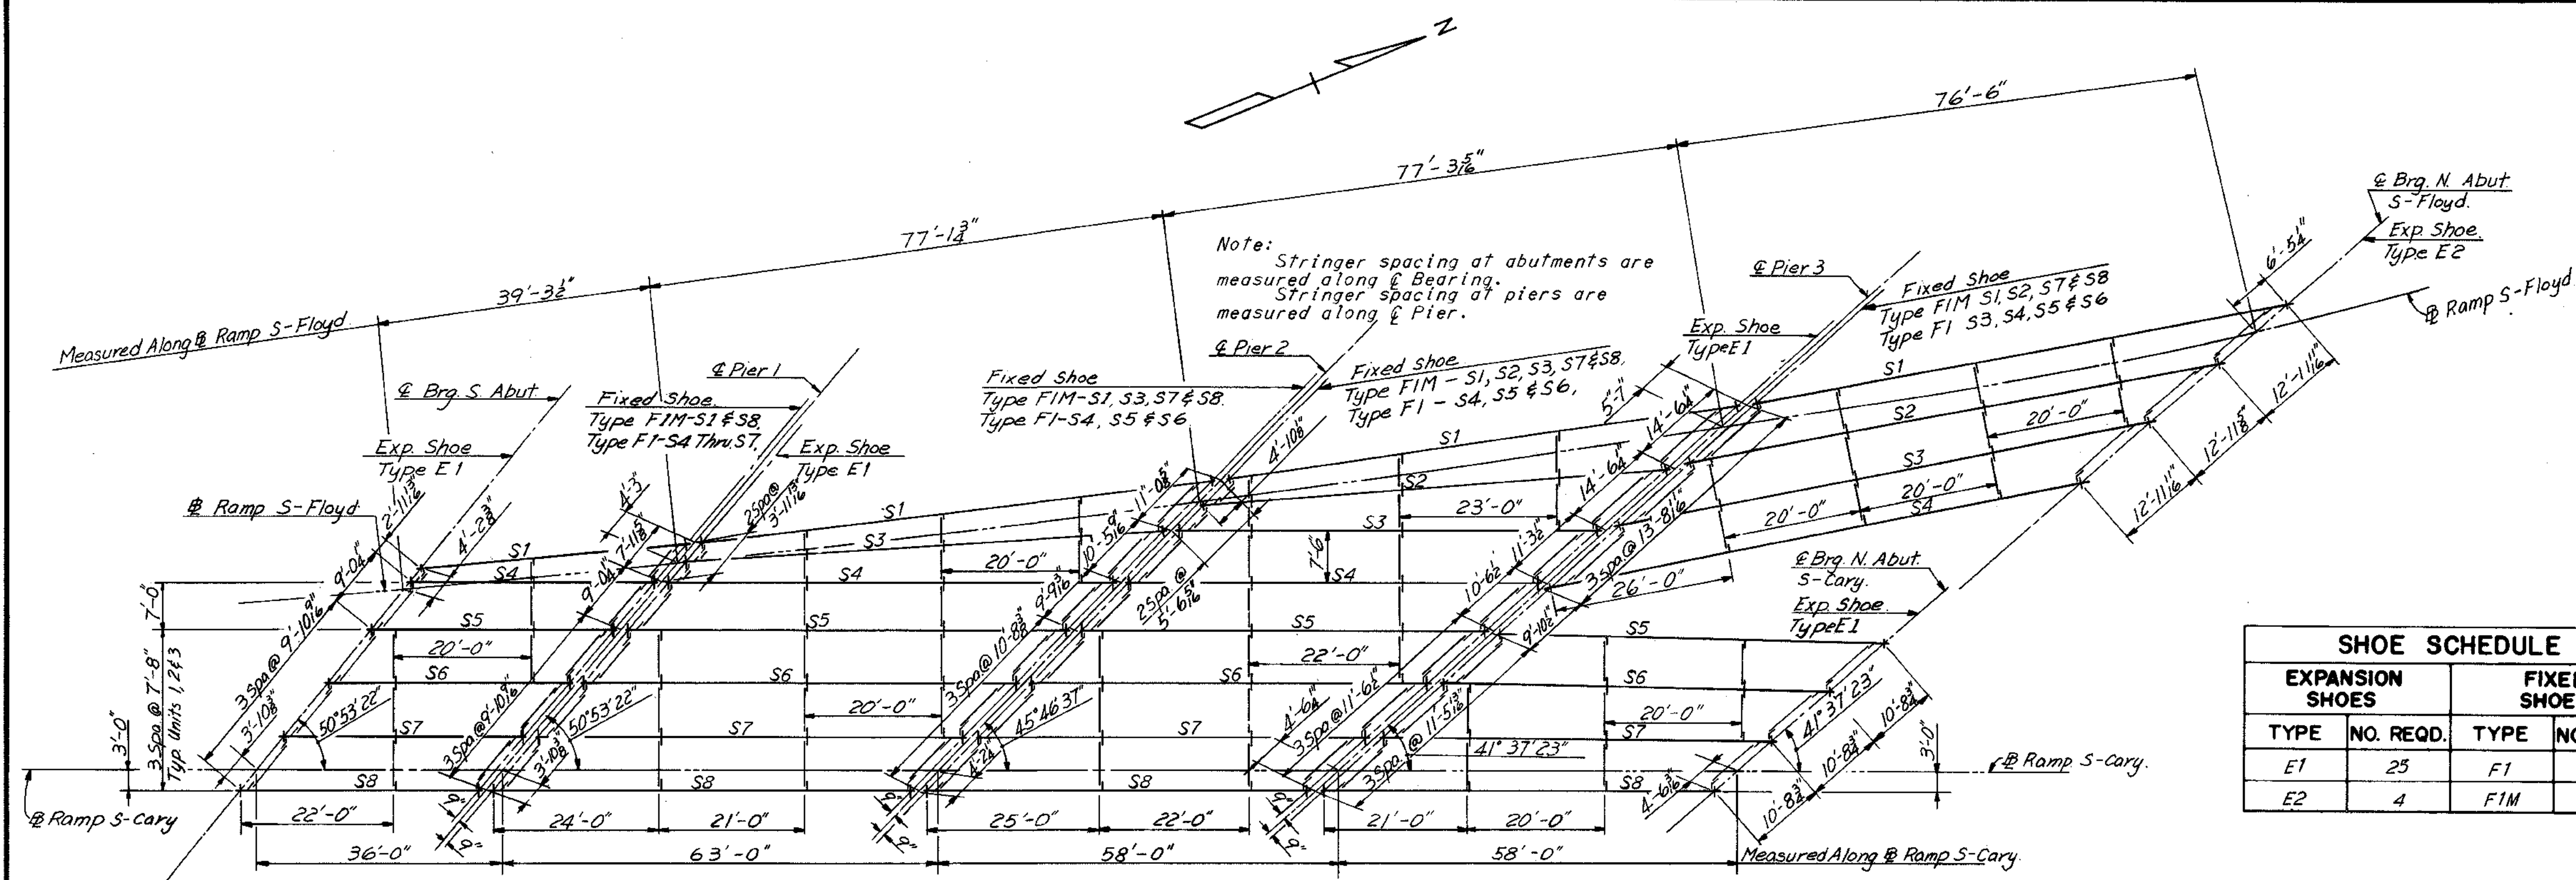

CAMBER DIAGRAM


No Scale

NOTE TO FABRICATOR

Stringers shall be fabricated with an upward camber amounting to the tabulated value. This will provide approximate compensation for deflection under full dead load and for conformity with finished grade. Stringers having a total camber of less than 1" are not required to be shop cambered, but should be turned so that any mill tolerance deviation from straightness will be in the direction shown by the Camber diagram. If stringers are not cambered, distance top of stringers to top of slab will vary along the stringer in accordance with the offset dimensions shown in the Camber diagram, and with a minimum distance as shown in cross-section on Sheet 9.


SHOE SCHEDULE			
EXPANSION SHOES		FIXED SHOES	
TYPE	NO. REQD.	TYPE	NO. REQD.
E1	25	F1	14
E2	4	F1M	15

AS BUILT

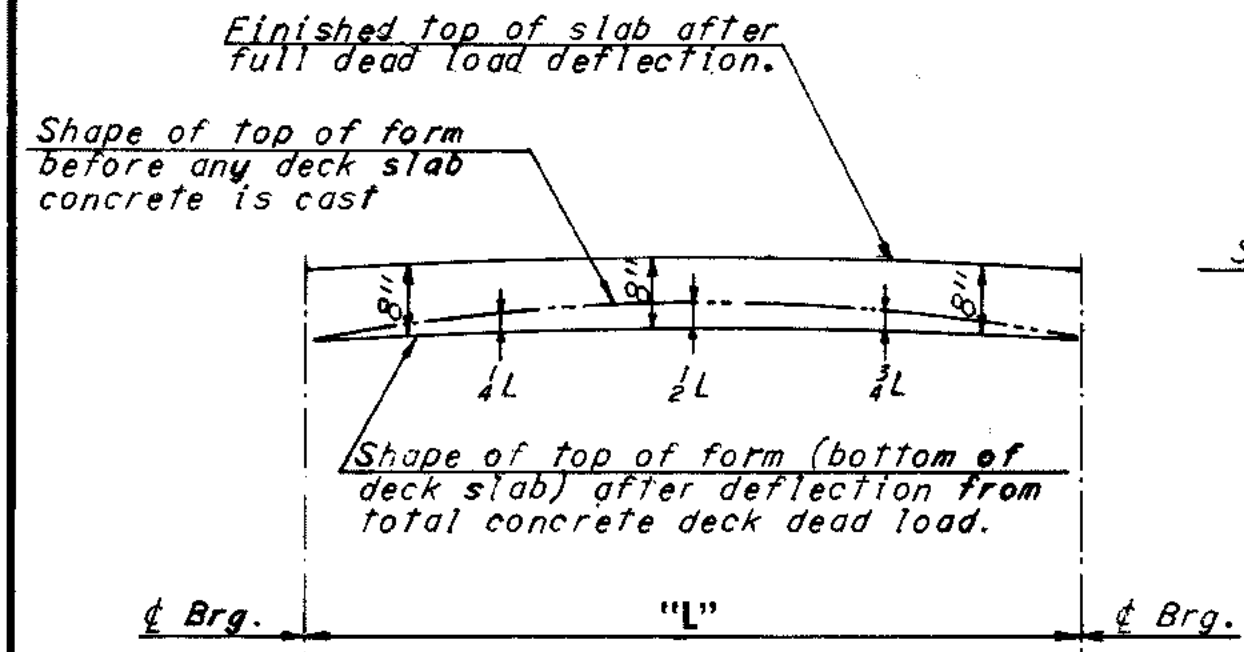


DEAD LOAD DEFLECTION DIAGRAM

No Scale

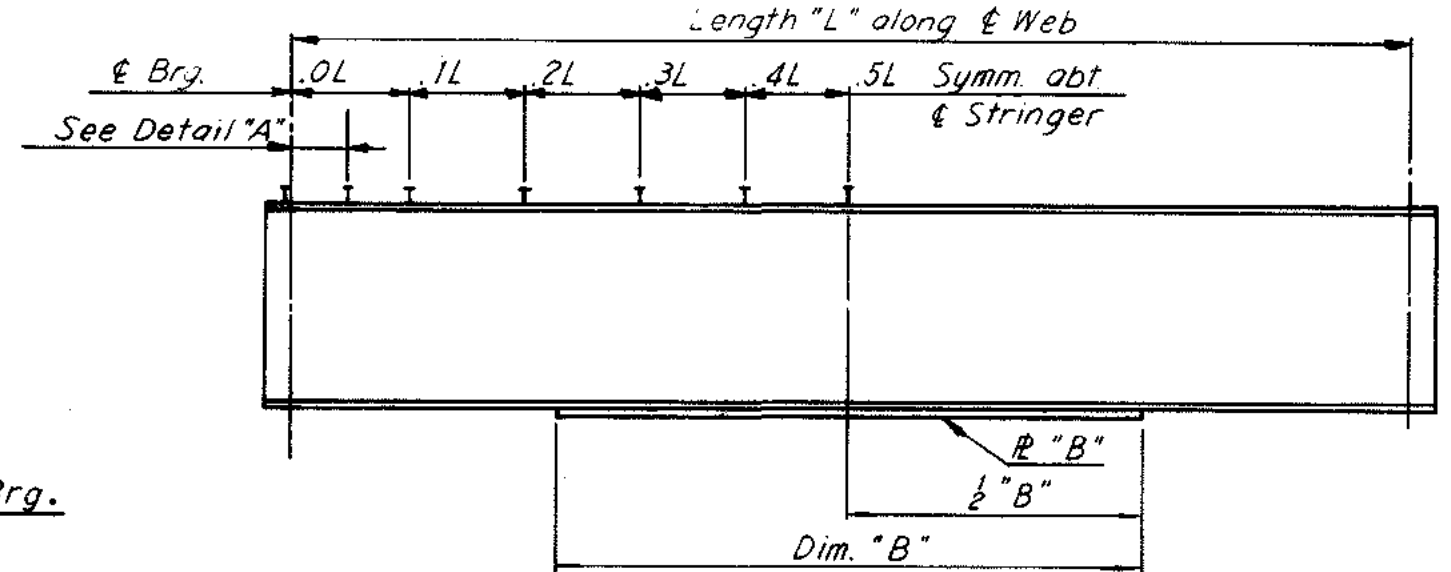


STRINGER ELEVATION

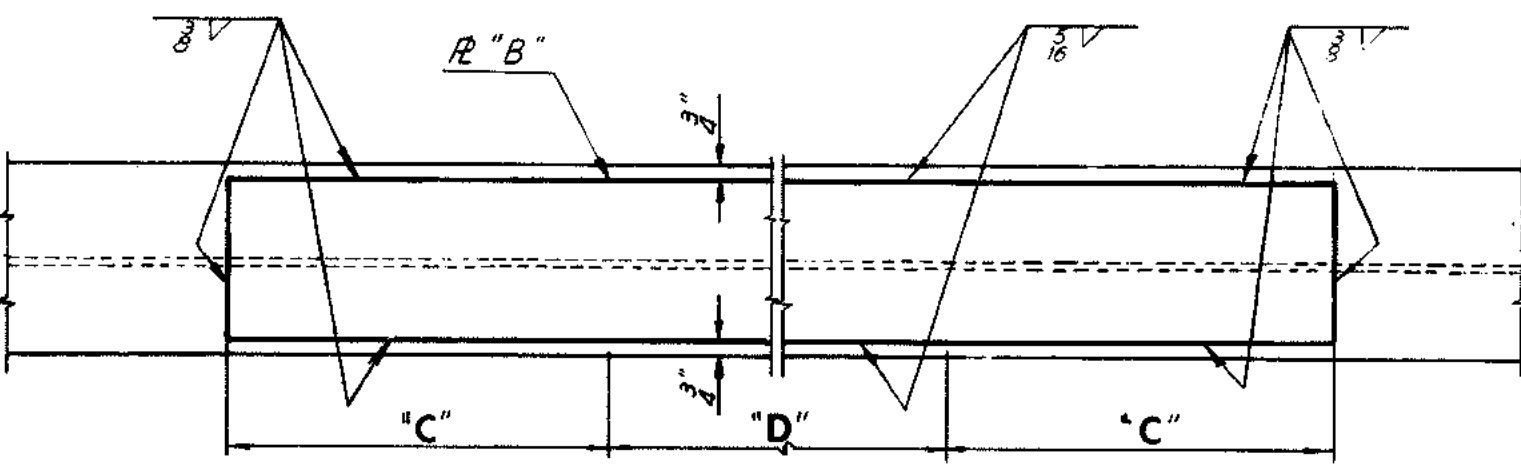


COVER PLATE DETAIL

Note: Beam Ends, Bearing Stiffeners and Diaphragm Connections shall be plumb.

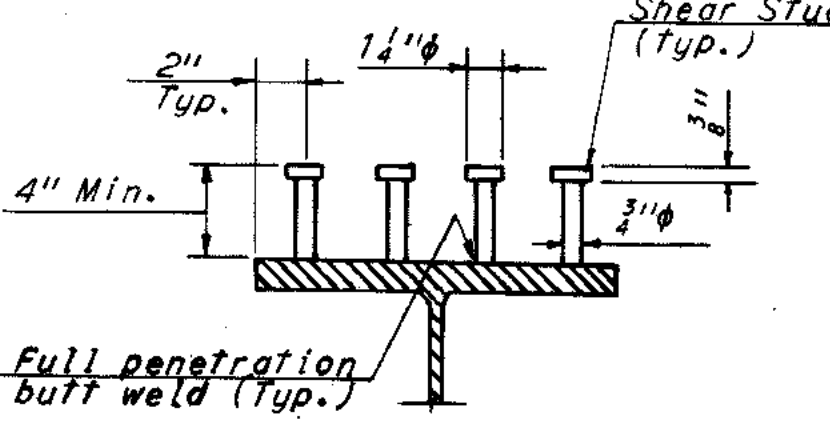

SHEAR STUD DETAIL

No Scale

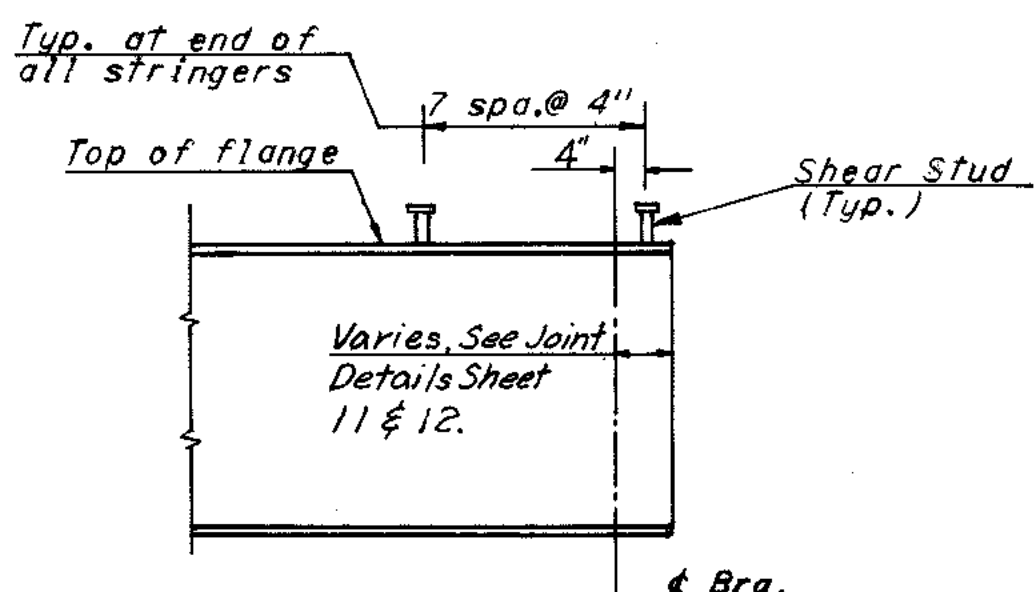

DETAIL A

No Scale

SHEAR STUD NOTE

Capacity = 3,400 lbs. per stud. The contractor may, if he elects, use three 1/2" diameter studs at the same longitudinal spacing in lieu of the four 1/2" diameter studs shown. Stud rows shall be placed parallel to the main deck reinforcing. Shear stud spacing shown is maximum spacing.

\* Spacing begins at termination of 7 spaces @ 4" as shown in Detail A.

Note: For Superstructure Structural steel quantities see Sheet 1. For Standard Shoe details see Sheet 51. For Framing details see Sheet 9. For Joint details see Sheets 11 and 12. This sheet must be worked with sheets 2, 3, 4, 6, & 7.

DEAD LOAD DEFLECTION SCHEDULE												
STRINGER	UNIT 1			UNIT 2			UNIT 3			UNIT 4		
	¼L	½L	¾L	¼L	½L	¾L	¼L	½L	¾L	¼L	½L	¾L
S1	1⁄8"		1⁄8"	1⁄8"	2⁄8"	1⁄8"	1⁄8"	1⁄8"	1⁄8"	1⁄4"	3⁄8"	1⁄4"
S2	—	—	—	—	—	—	7⁄8"	1⁄8"	7⁄8"	1⁄4"	2"	1⁄4"
S3	—	—	—	1⁄8"	1⁄4"	1⁄8"	3⁄8"	1⁄8"	3⁄8"	1⁄8"	2 1⁄8"	1⁄8"
S4	3⁄8"	1⁄4"	3⁄8"	1⁄8"	1⁄4"	1⁄8"	1⁄8"	1⁄8"	1⁄8"	1⁄8"	2 1⁄8"	1⁄8"
S5	1⁄8"	1⁄4"	1⁄8"	2"	1⁄8"	3"	5"	1⁄8"	5"	1⁄2"	11"	2"
S6	3⁄8"	1⁄4"	3⁄8"	1⁄8"	1⁄8"	1⁄8"	9"	3⁄8"	9"	2"	2"	2"
S7	3⁄8"	1⁄4"	3⁄8"	5"	1⁄8"	5"	1⁄2"	1⁄8"	1⁄2"	1⁄2"	13"	1⁄2"
S8	1⁄8"	1⁄8"	1⁄8"	9"	1⁄8"	9"	1⁄2"	1⁄2"	1⁄2"	1⁄2"	3"	1⁄2"

NOTE TO CONTRACTOR

Deflections given are those anticipated to occur in the stringer upon placement of the total concrete deck dead load. In practice, the stringers in place are not likely to have the exact camber to compensate for these deflections during construction. The residual amounts shall be provided by adjusting forms to vary the thickness of the concrete haunch between the bottom of the slab and the top of stringer, without altering the slab thickness.


STRINGER SCHEDULE															
UNIT	STRINGER	STRINGER LENGTH	STRINGER SIZE	R B	DIM "B"	DIM "C"	DIM "D"	MAX SHEAR STUD SPACING					CAMBER SCHEDULE		
								.0L-.1L *	.1L-.2L	.2L-.3L	.3L-.4L	.4L-.5L	1/4L	1/2L	3/4L
1	S1	38'-3 3/8"	36 W 135	---	---	---	---	15 1/2"	17"	20"	23"	24"	1/8"	1/4"	1/8"
	S4-S7	35'-0 3/8"	30 W 99	---	---	---	---	7 1/2"	8 1/2"	9 1/2"	11 1/2"	13 1/2"	3/16"	5/16"	1/8"
	S8	35'-0 3/8"	36 W 135	---	---	---	---	10 1/2"	11 1/2"	13"	15 1/2"	18 1/2"	1/8"	1/4"	1/4"
2	S1	75'-7 1/8"	36 W 150	10 1/2 x 2	57'-0"	2'-6"	52'-0"	11 1/2"	13"	16"	19"	23 1/2"	3/4"	5/8"	3/8"
	S3	70'-1 1/2"	36 W 150	10 1/2 x 8	42'-0"	2'-0"	38'-0"	8"	9"	11"	13"	15 1/2"	2 5/8"	4"	2 5/8"
	S4	65'-3 3/8"	36 W 150	10 1/2 x 8	48'-0"	2'-0"	44'-0"	8"	9"	11"	13"	15 1/2"	2 5/8"	3 3/8"	2 5/8"
	S5	64'-2 3/8"	36 W 150	10 1/2 x 8	48'-0"	2'-0"	44'-0"	8"	9"	11"	13"	15 1/2"	2 5/8"	3 5/8"	2 1/2"
	S6	62'-11 1/8"	36 W 150	10 1/2 x 8	48'-0"	2'-0"	44'-0"	8"	9"	11"	13"	15 1/2"	2 5/8"	3 1/2"	2 5/8"
	S7	61'-8 1/8"	36 W 150	10 1/2 x 8	48'-0"	2'-0"	44'-0"	8"	9"	11"	13"	15 1/2"	1 5/8"	2 3/4"	2 1/8"
	S8	60'-6 1/8"	36 W 150	10 1/2 x 8	44'-0"	2'-0"	40'-0"	9"	10"	12"	14"	17"	1 5/8"	2 3/4"	1 5/8"
	S1	75'-5 1/8"	36 W 150	10 1/2 x 1	62'-0"	2'-6"	57'-0"	10"	11 1/2"	14"	16 1/2"	20"	3/4"	4 5/8"	3 1/4"
3	S2	68'-1 1/8"	36 W 150	10 1/2 x 8	54'-0"	2'-6"	49'-0"	8 1/2"	10"	12 1/2"	14 1/2"	17 1/2"	2 5/8"	4"	2 3/4"
	S3	61'-0 3/8"	36 W 135	10 1/2 x 2	44'-0"	2'-0"	40'-0"	7"	8"	10"	12"	14 1/2"	2"	2 5/8"	1 1/2"
	S4	59'-11 3/8"	36 W 135	10 1/2 x 2	44'-0"	2'-0"	40'-0"	7"	8"	10"	12"	14 1/2"	2 5/8"	2 5/8"	1 5/8"
	S5	58'-10 7/8"	36 W 135	10 1/2 x 2	44'-0"	2'-0"	40'-0"	7"	8"	10"	12"	14 1/2"	2 5/8"	3 1/8"	2 1/8"
	S6	57'-8 7/8"	36 W 135	10 1/2 x 2	44'-0"	2'-0"	40'-0"	7"	8"	10"	12"	14 1/2"	1 5/8"	2 5/8"	1 5/8"
	S7	56'-6 7/8"	36 W 135	10 1/2 x 2	44'-0"	2'-0"	40'-0"	7"	8"	10"	12"	14 1/2"	1 5/8"	2 1/2"	1 5/8"
4	S8	55'-4 7/8"	36 W 150	---	---	---	---	9"	10 1/2"	12"	14"	17"	1 3/4"	2 5/8"	1 1/4"
	S1	75'-9 1/4"	36 W 160	10 1/2 x 1 1/2	65'-0"	3'-0"	59'-0"	8 1/2"	9 1/2"	12"	14 1/2"	18"	3 5/8"	4 5/8"	3 1/2"
	S2	76'-4 1/8"	36 W 160	10 1/2 x 1 1/2	65'-0"	3'-0"	59'-0"	7 1/2"	8 1/2"	10 1/2"	13"	16"	3 5/8"	4 5/8"	3 1/2"
	S3	77'-0 3/8"	36 W 160	10 1/2 x 1 1/2	65'-0"	3'-0"	59'-0"	7 1/2"	8 1/2"	10 1/2"	13"	16"	3 5/8"	5 5/8"	4 1/2"
	S4	77'-8"	36 W 160	10 1/2 x 1 1/2	63'-0"	3'-0"	57'-0"	8 1/2"	9 1/2"	12"	14 1/2"	18"	4"	5 1/2"	1 5/8"
	S5	55'-2 1/8"	36 W 150	---	---	---	---	9"	10 1/2"	12"	14"	17"	1 3/8"	1 1/2"	5/16"
	S6	55'-9 3/8"	36 W 135	10 1/2 x 2	44'-0"	2'-0"	40'-0"	7"	8"	10"	12"	14 1/2"	1 5/8"	2"	1 1/4"
	S7	56'-3 3/8"	36 W 135	10 1/2 x 2	44'-0"	2'-0"	40'-0"	7"	8"	10"	12"	14 1/2"	1 1/2"	2 5/8"	1 5/8"
S8	56'-10 3/8"	36 W 150	---	---	---	---	9"	10 1/2"	12"	14"	17"	1 3/8"	2 1/4"	1 3/8"	

RICHMOND METROPOLITAN AUTHORITY  
RICHMOND EXPRESSWAY SYSTEM  
BELTLINE EXPRESSWAY  
BRIDGE NO. 17  
RAMP S-CARY OVER  
EAST-NORTH ROADWAY  
FRAMING PLAN

BY	DATE	3	As Built	R.H.	2-5-73
MADE	G.C.C.	11-3-67	2 General	P.S.	10-70
CHECKED	AMH	2-26-68	1 General Revision	AMH	5-15-68
IN CHARGE	FKD	NO.	REVISION	BY	DATE


HOWARD, NEEDLES, TAMMEN & BERGENDOFF  
consulting engineers  
NEW YORK ALEXANDRIA KANSAS CITY  
SCALE: As noted  
CONTRACT NO. 4  
SHEET NO. 8 OF 14



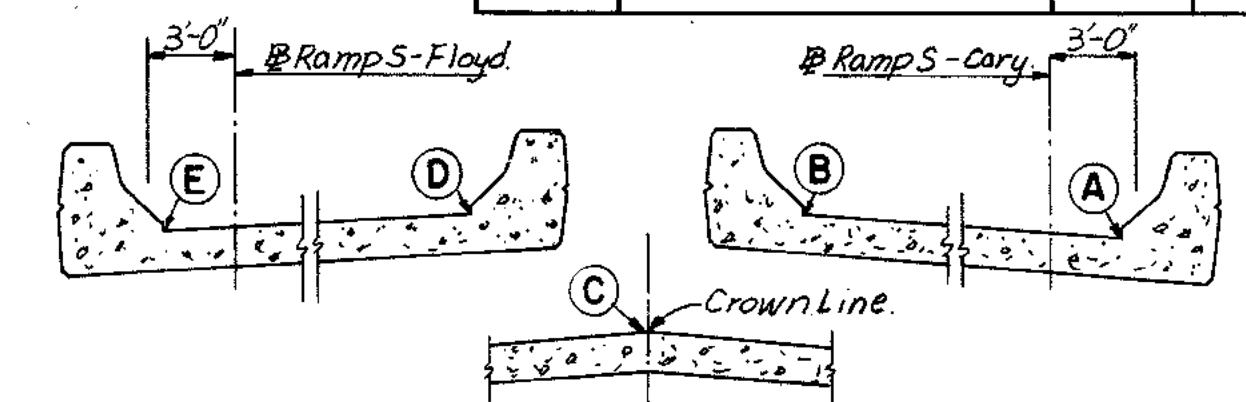


**GUTTERLINE ELEVATION DIAGRAM**  
No Scale


GUTTERLINE ELEVATIONS						
STATION	ELEV. A	ELEV. B	ELEV. C	ELEV. D	ELEV. E	STATION
8+00	223.00	-	223.31	-	223.02	1+94.25
8+10	223.58	-	223.89	-	223.59	2+04.18
8+12.77	223.73	-	-	-	-	-
8+20	224.16	-	224.48	-	224.16	2+14.13
8+30	224.74	-	225.07	-	224.75	2+24.10
8+40	225.32	-	225.66	-	225.33	2+34.07
-	-	-	-	-	225.41	2+35.31
8+50	225.90	-	226.25	-	225.92	2+44.03
8+50.38	225.93	-	-	-	-	-
8+60	226.48	-	226.84	-	226.50	2+53.99
8+70	227.06	-	227.43	-	227.08	2+63.95
8+80	227.64	-	228.02	-	227.66	2+73.91
-	-	-	-	-	227.80	2+76.45
8+90	228.18	-	228.58	-	228.21	2+83.86
9+00	228.70	-	229.10	-	228.72	2+93.81
9+10	229.18	-	229.59	-	229.20	3+03.76
9+12.83	229.31	-	-	-	-	-
9+20	229.62	-	230.05	-	229.65	3+13.70
9+30	230.03	-	230.47	-	230.06	3+23.63
9+40	230.41	-	230.86	-	230.44	3+33.57
9+50	230.76	-	231.22	-	230.78	3+43.49
9+60	231.07	-	231.55	-	231.06	3+53.42
-	-	-	-	-	231.08	3+54.53
9+70	231.35	-	231.84	-	231.24	3+63.33
9+70.29	231.36	-	-	-	-	-
9+80	231.60	-	232.09	-	231.37	3+73.25
9+90	231.81	-	232.32	-	231.47	3+83.15
9+92.22	-	232.33	-	232.31	-	3+85.35
9+97.17	-	232.42	-	232.39	231.53	3+90
-	-	-	-	232.51	-	3+96.70
10+00	231.99	232.46	-	232.54	231.61	4+00
10+10	232.13	232.60	-	232.66	231.66	4+10
10+20	232.24	232.71	-	232.74	231.68	4+20
10+30	232.32	232.78	-	232.79	231.65	4+30
10+30.18	232.33	-	-	-	231.65	4+32.86
10+40	232.40	232.86	-	232.80	231.60	4+40
10+50	232.48	232.93	-	232.78	231.52	4+50
10+55.27	-	232.96	-	232.72	231.41	4+60
10+60	232.56	233.00	-	232.64	231.27	4+70
10+70	232.64	233.08	-	232.53	-	4+77.68
10+80	232.71	233.14	-	232.48	231.10	4+80
-	-	-	-	232.29	230.90	4+90
-	-	-	-	232.07	230.67	5+00
-	-	-	-	231.80	230.41	5+10
-	-	-	-	-	230.31	5+13.34
-	-	-	-	231.51	230.12	5+20
-	-	-	-	231.19	229.80	5+30

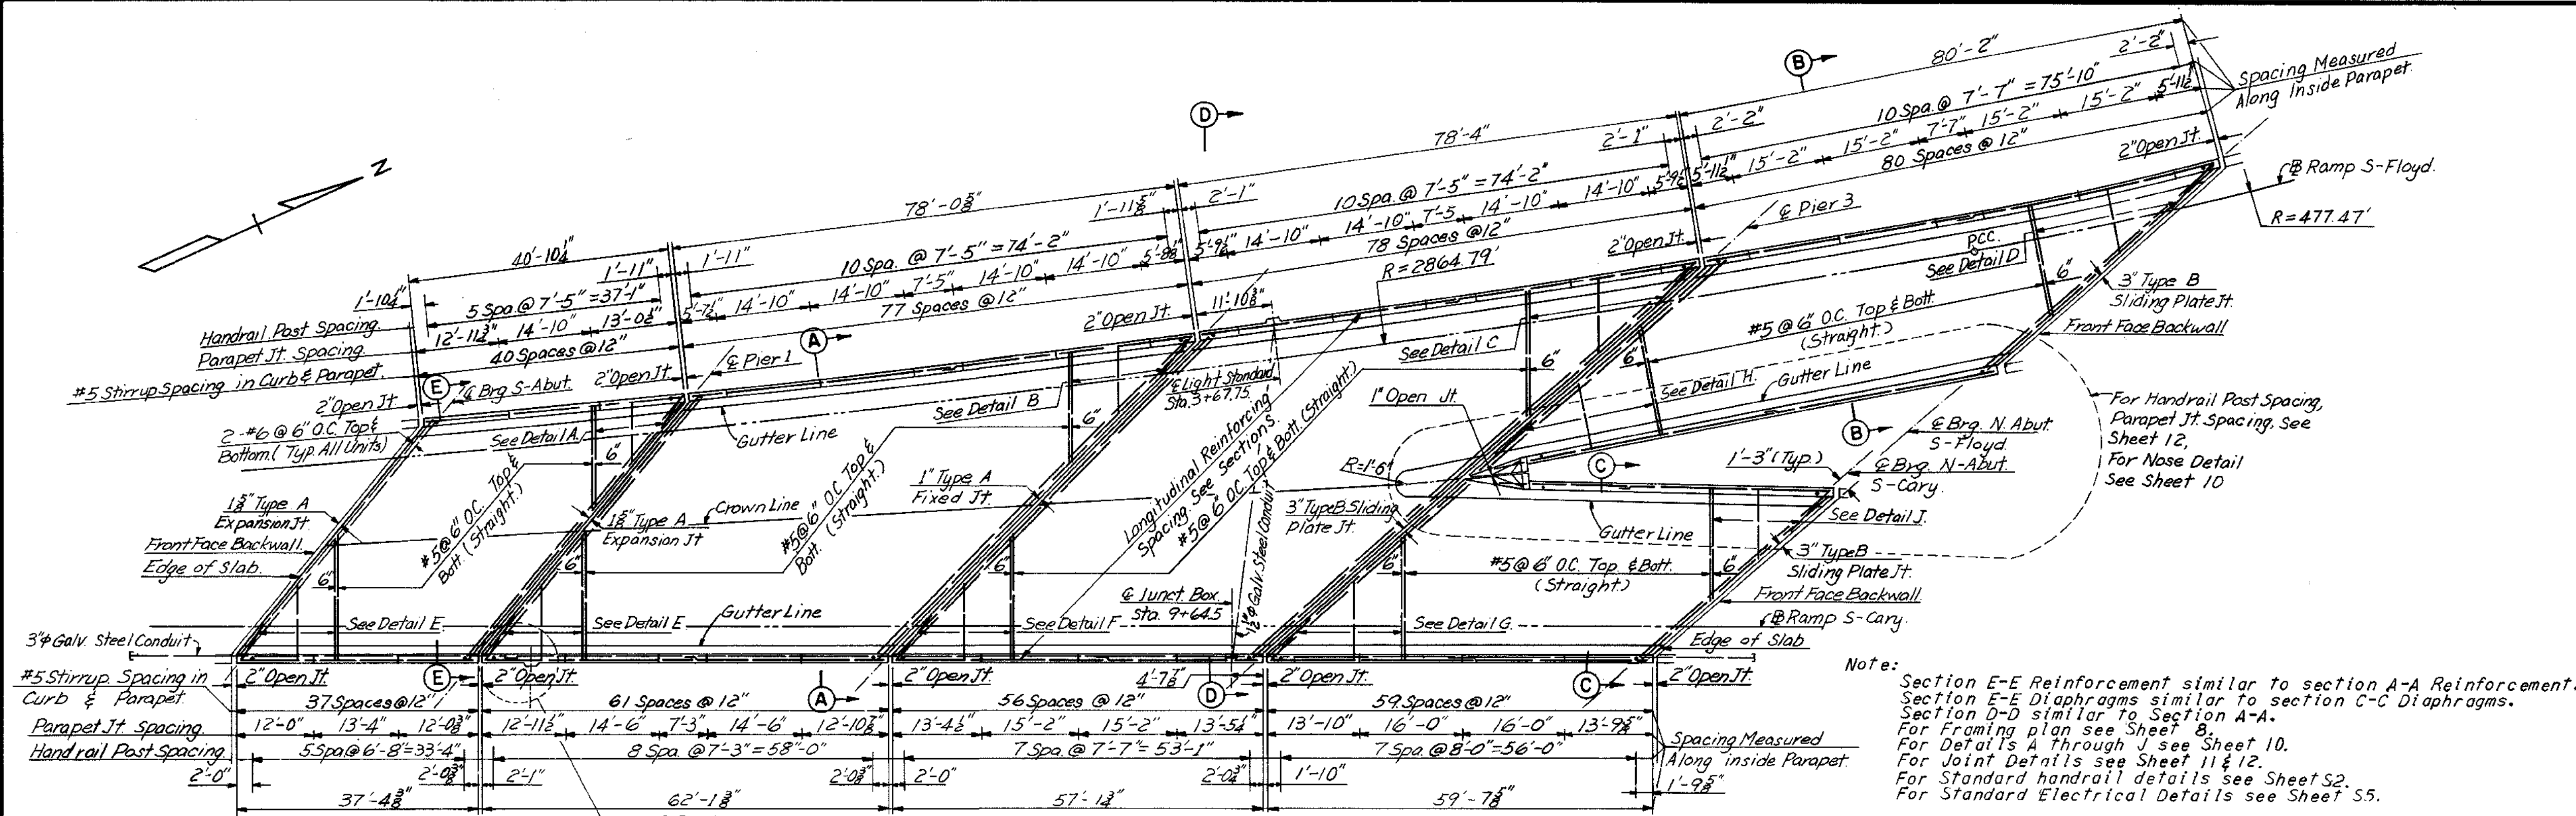


**DECK PLAN**  
Scale 1"=15'-0"

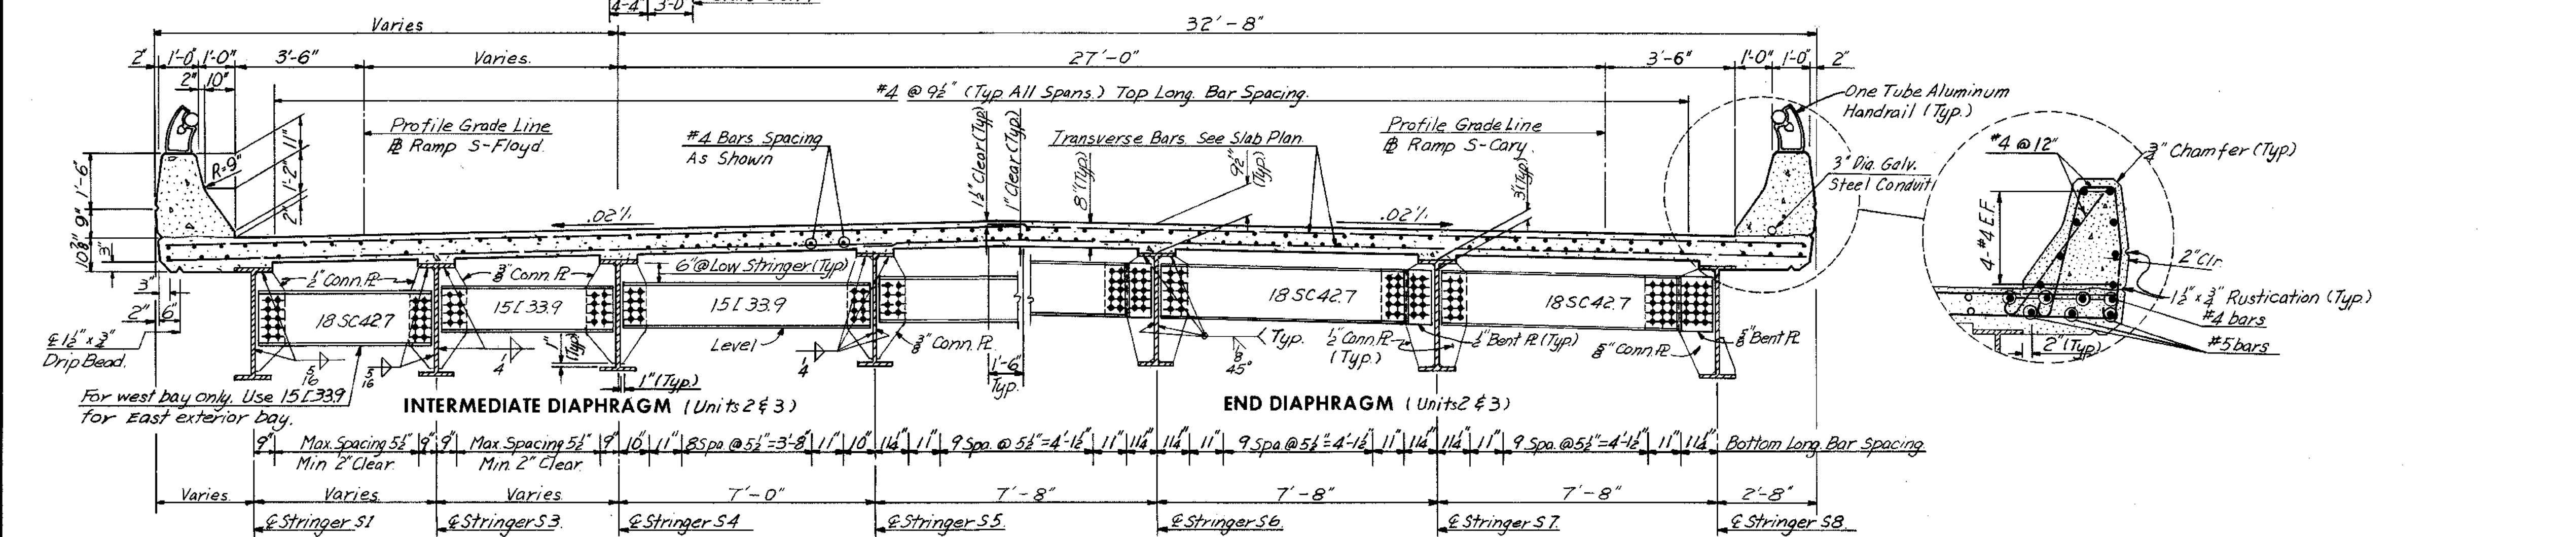

**SECTION A-A**  
Scale 3/8"=1'-0"

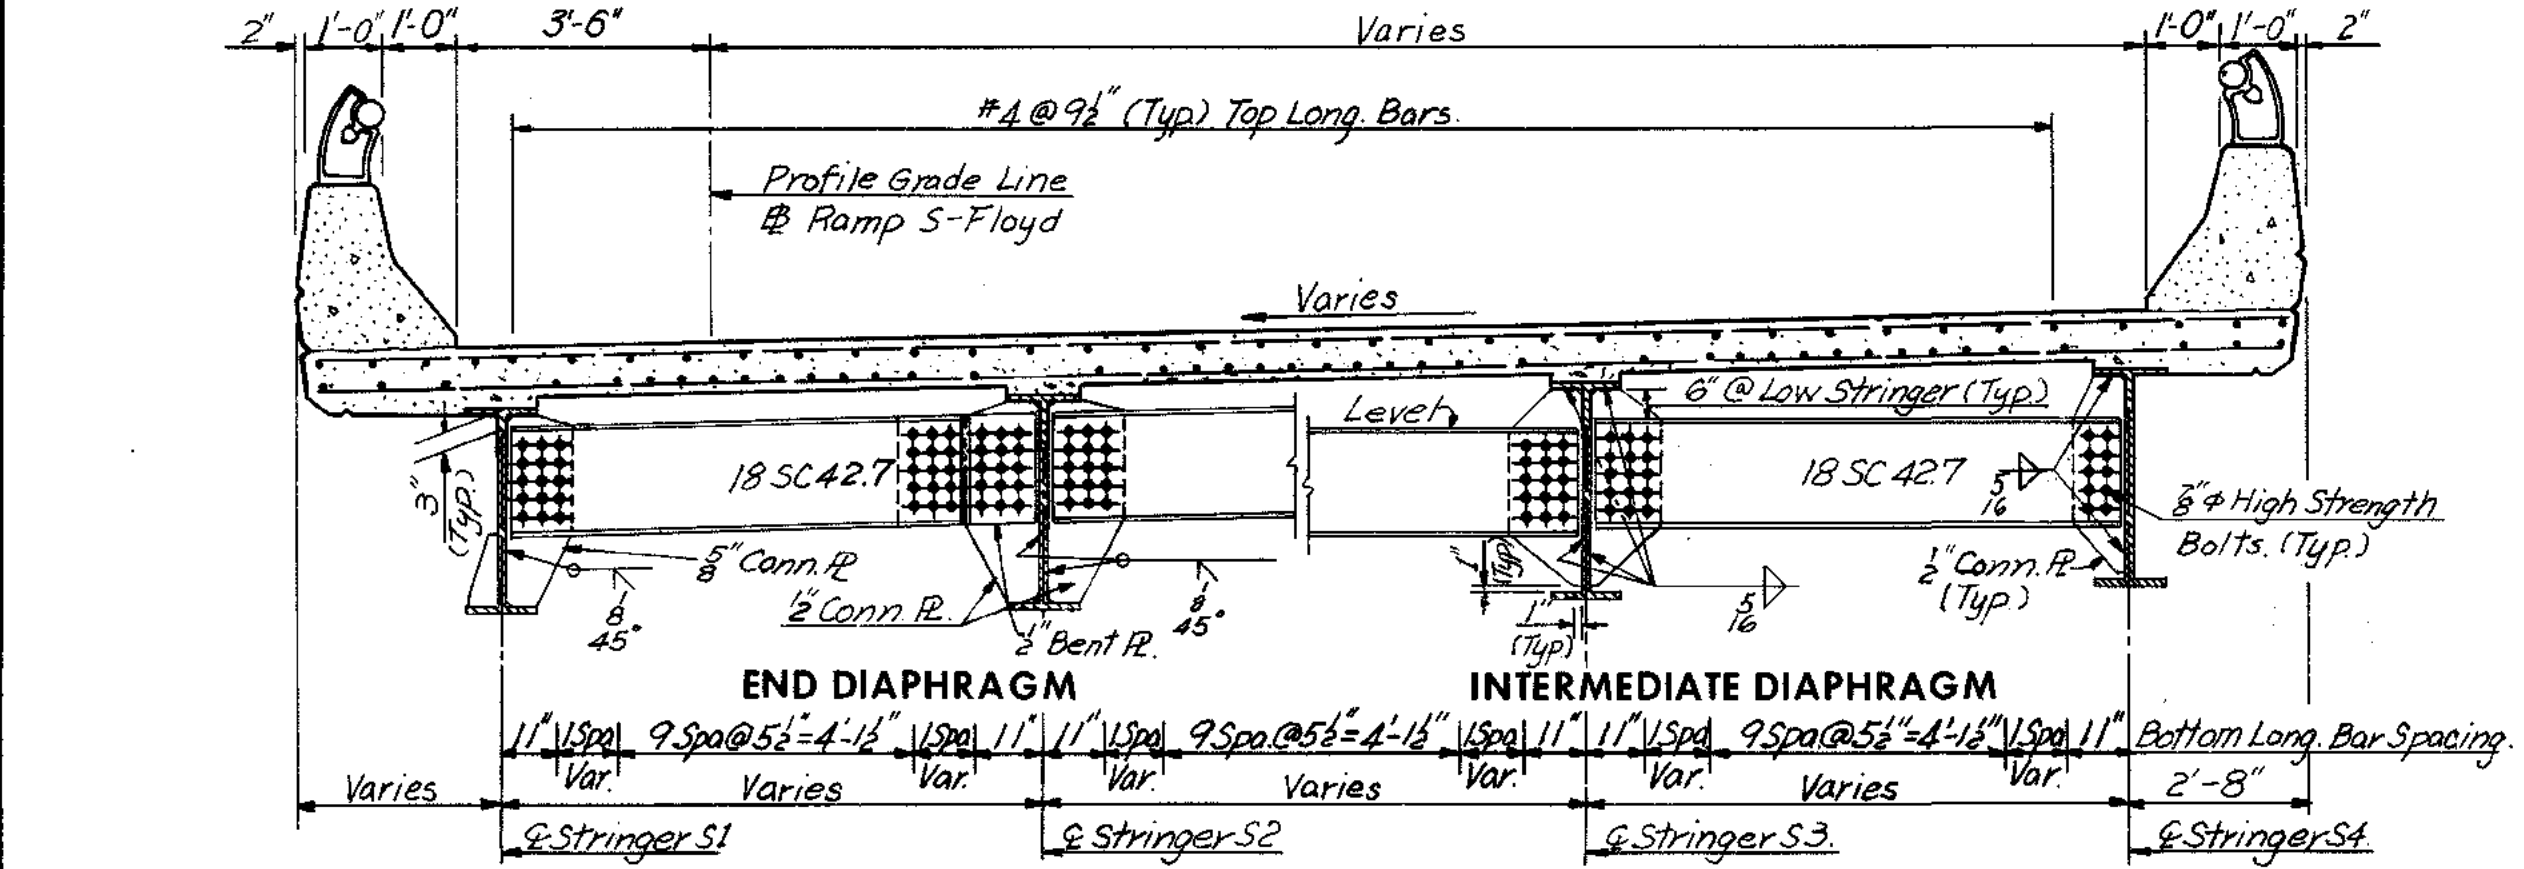

**SECTION B-B**  
Scale 3/8"=1'-0"

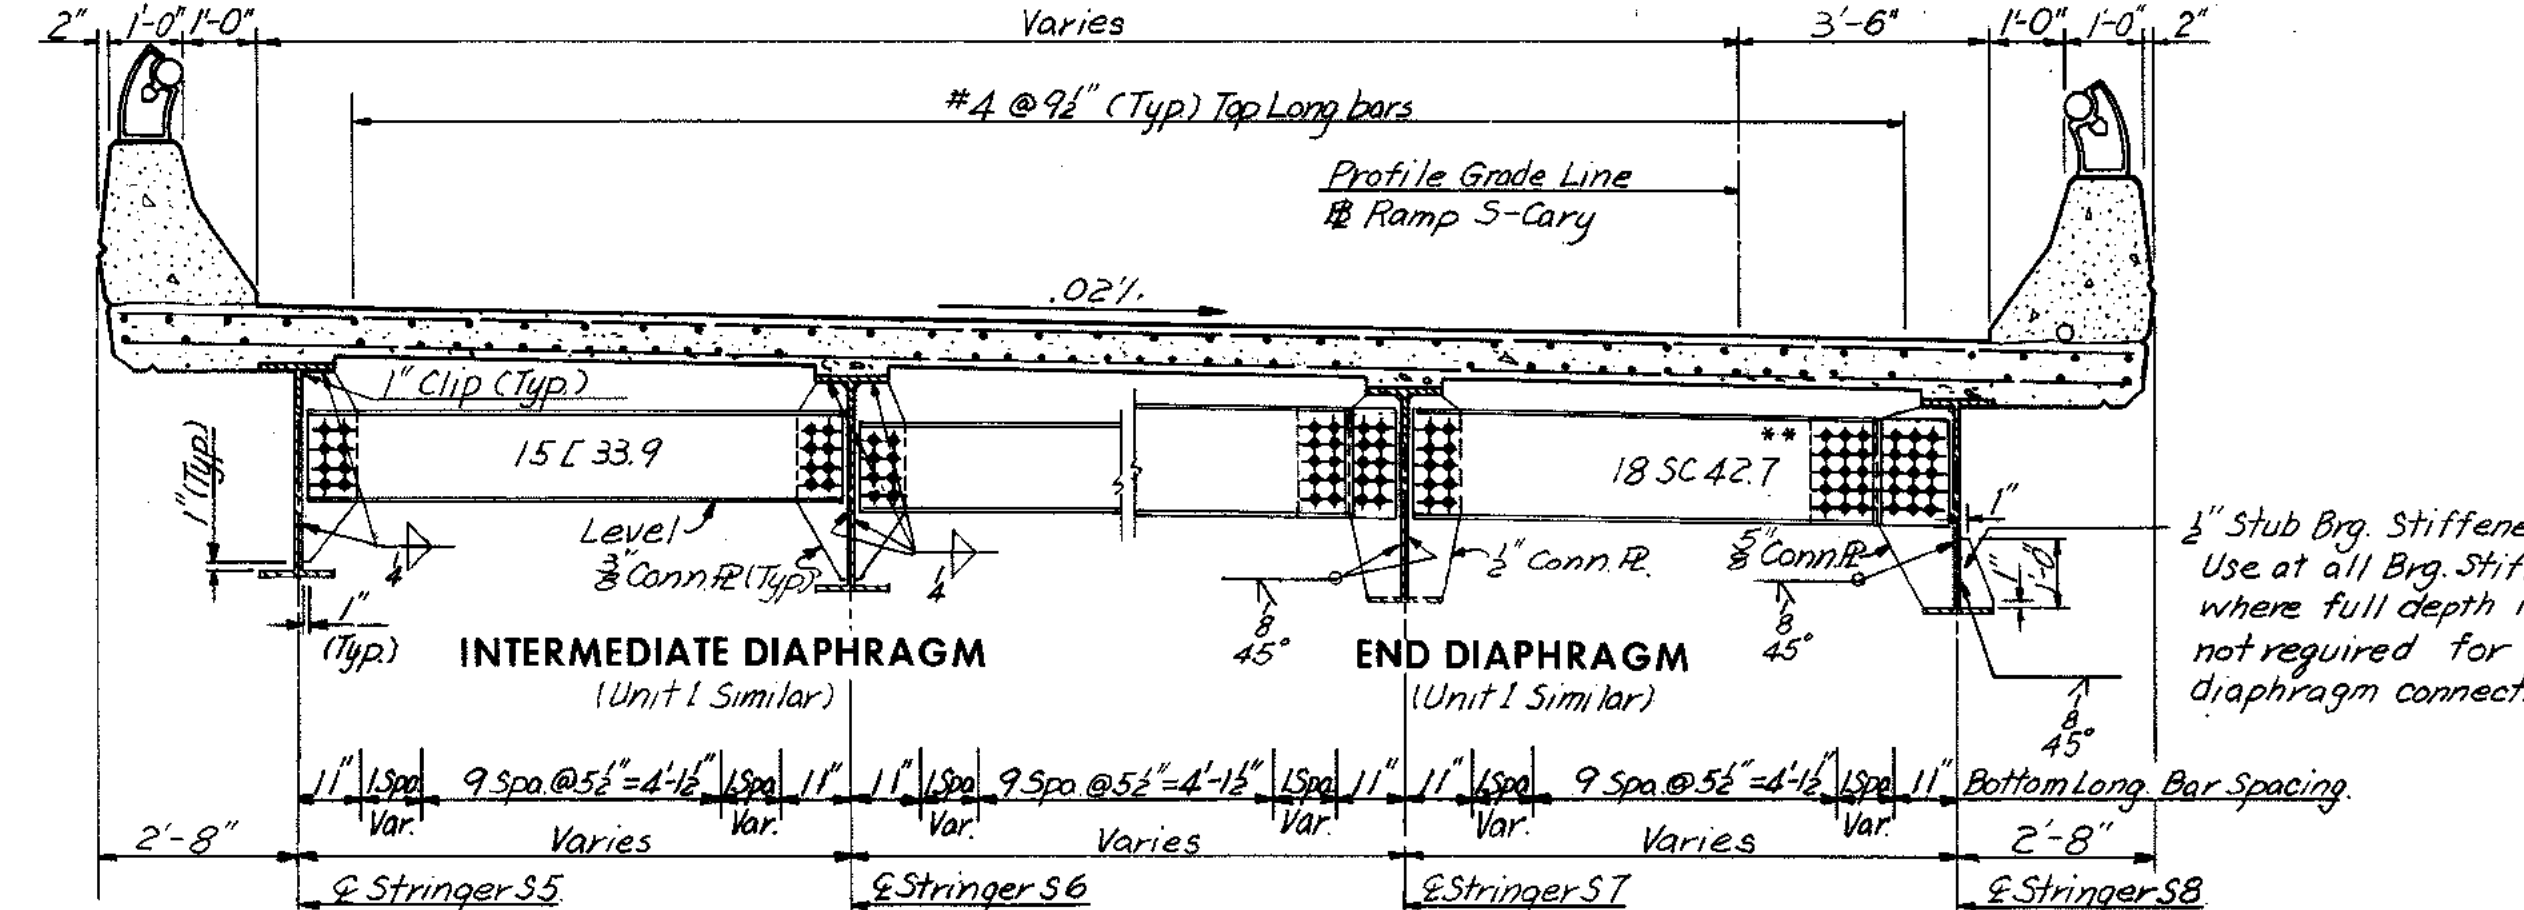

**SECTION C-C**  
Scale 3/8"=1'-0"

	BY	DATE	3	As Built	R.H.	2-5-73
MADE	G.C.C.	11-23-67	2	Parapet	J.G.V.	12-70
CHECKED	AMH	2-28-68	1	General Revision	AMH	5-13-68
IN CHARGE	FKD		NO.	REVISION	BY	DATE


**AS BUILT**

**RICHMOND METROPOLITAN AUTHORITY**  
**RICHMOND EXPRESSWAY SYSTEM**  
**BELTLINE EXPRESSWAY**  
**BRIDGE NO. 17**  
**RAMP S-CARY OVER**  
**EAST-NORTH ROADWAY**  
**DECK PLAN**


HOWARD, NEEDLES, TAMMEN & BERGENDOFF  
consulting engineers  
NEW YORK ALEXANDRIA KANSAS CITY  
SCALE: As noted  
CONTRACT NO. 4  
SHEET NO. 9 OF 14

\*\*For Unit 1 use two rows of bolts


RICHMOND EXPRESSWAY SYSTEM			
SECTION	PROJECT	SHEET NO.	TOTAL SHEETS
4	BELTLINE EXPRESSWAY	139	155

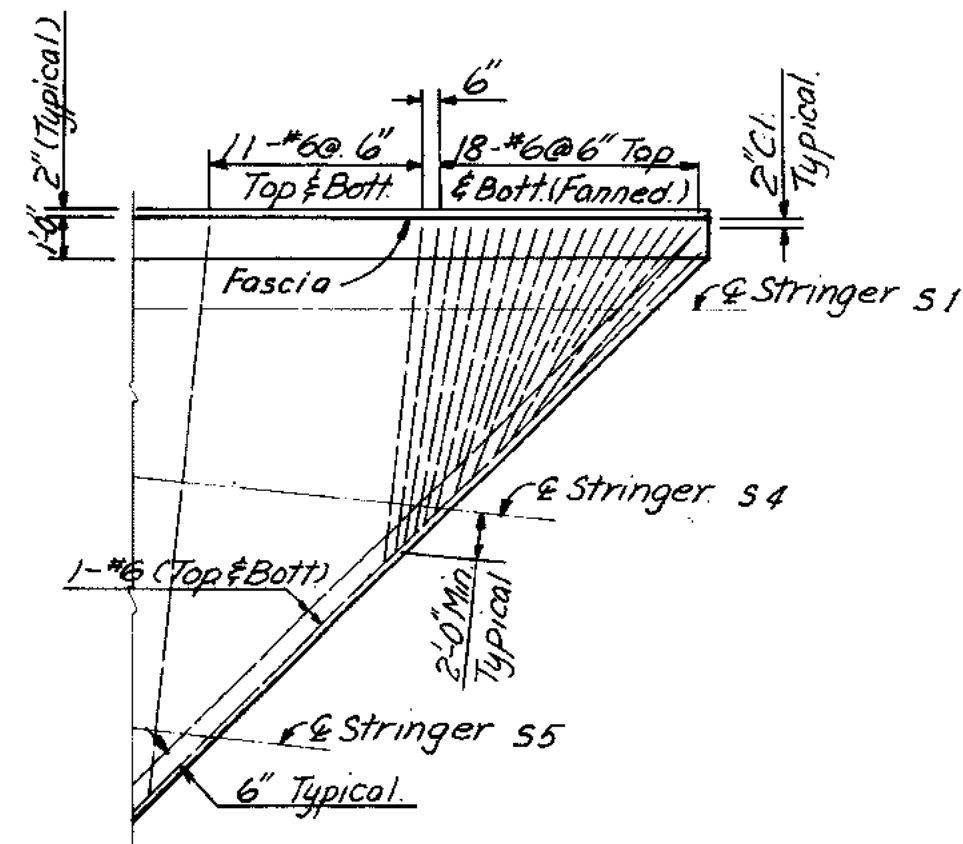


**DETAIL A**  
No Scale

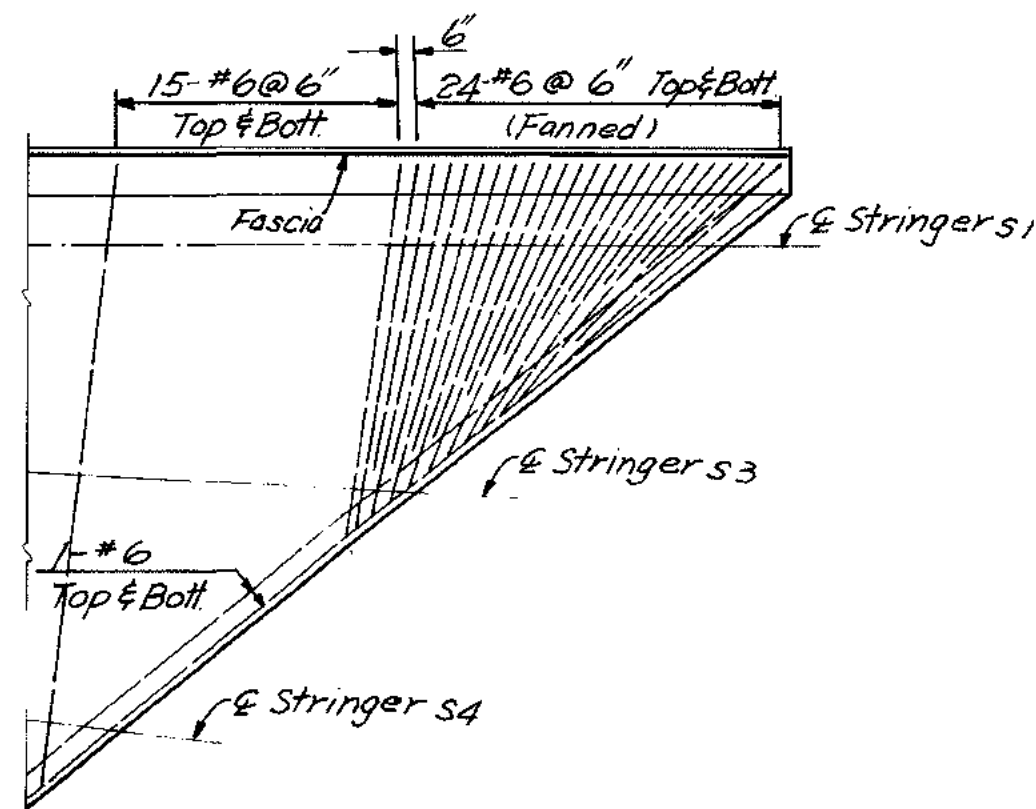


**DETAIL B**  
No Scale

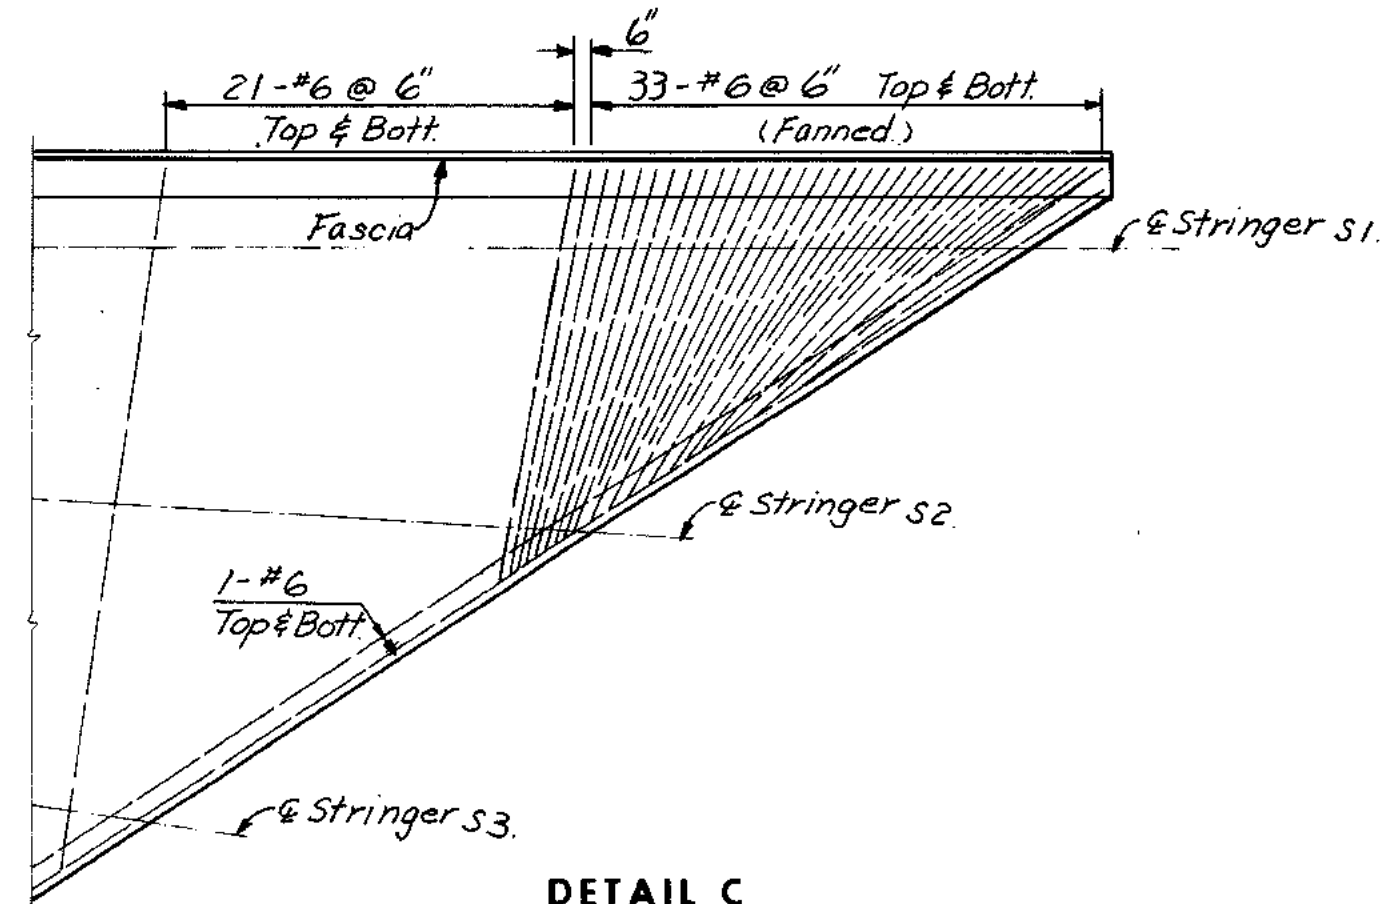


**DETAIL C**  
No Scale

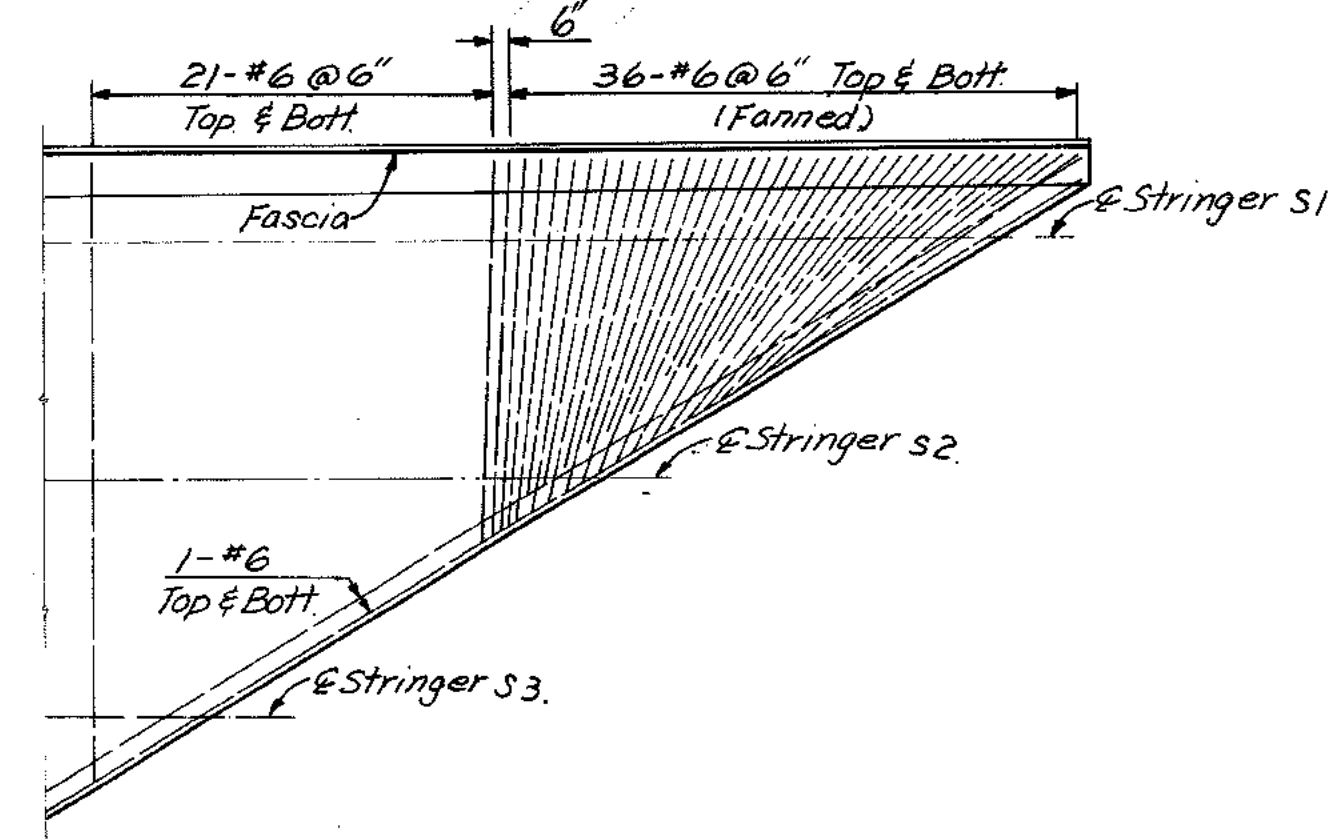


**DETAIL D**  
No Scale

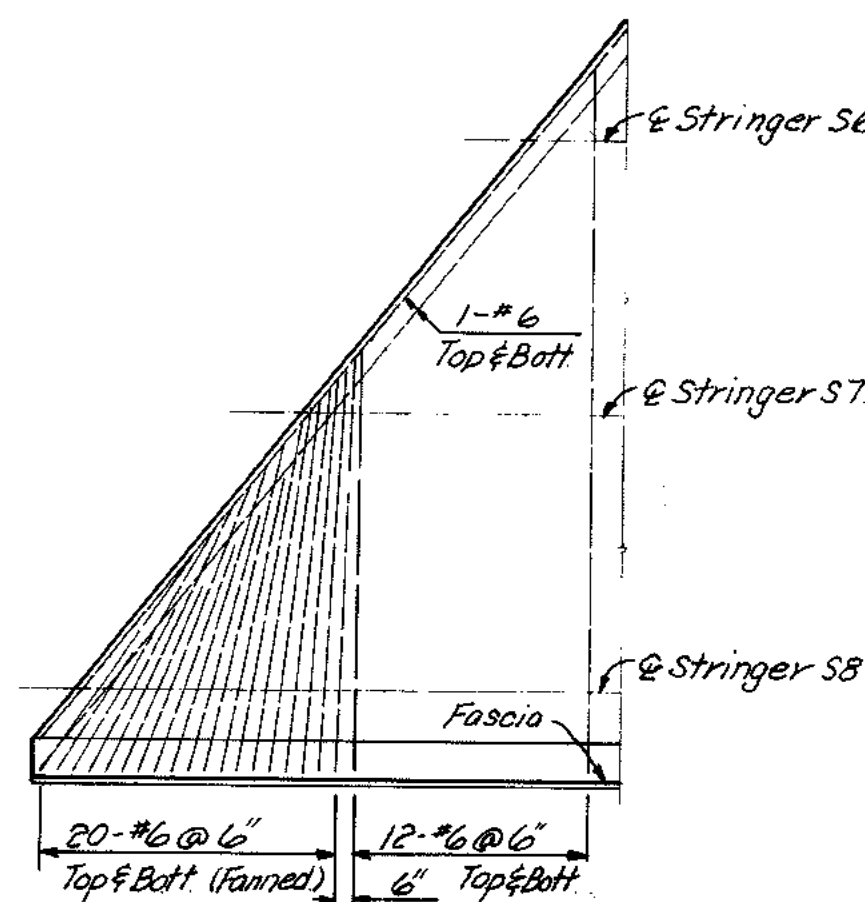


**DETAIL E**  
No Scale

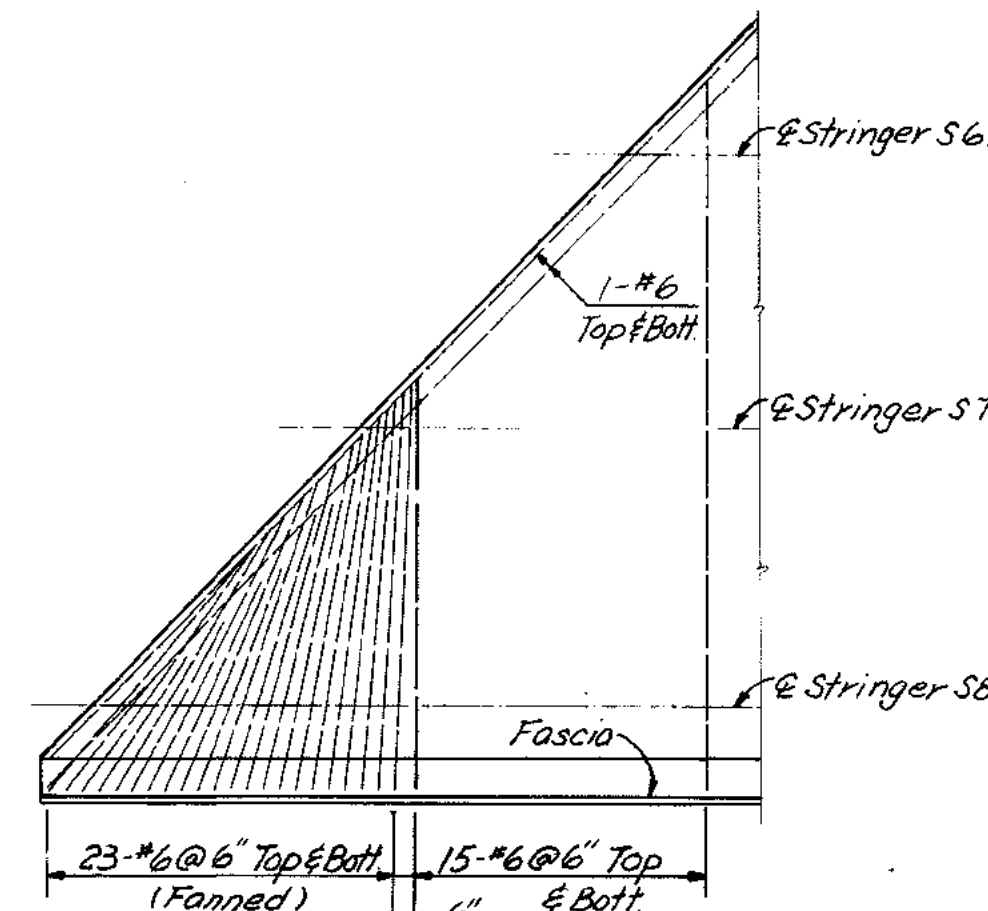


**DETAIL F**  
No Scale

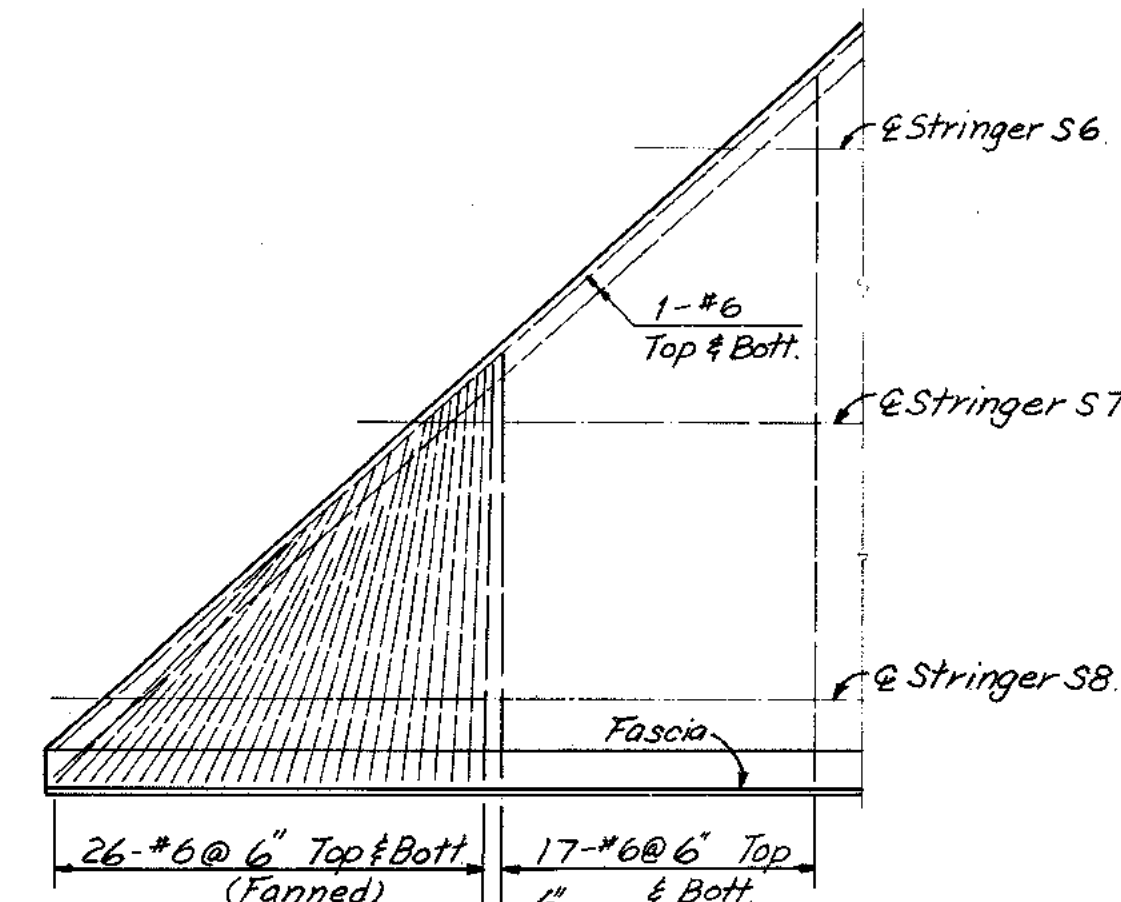


**DETAIL G**  
No Scale

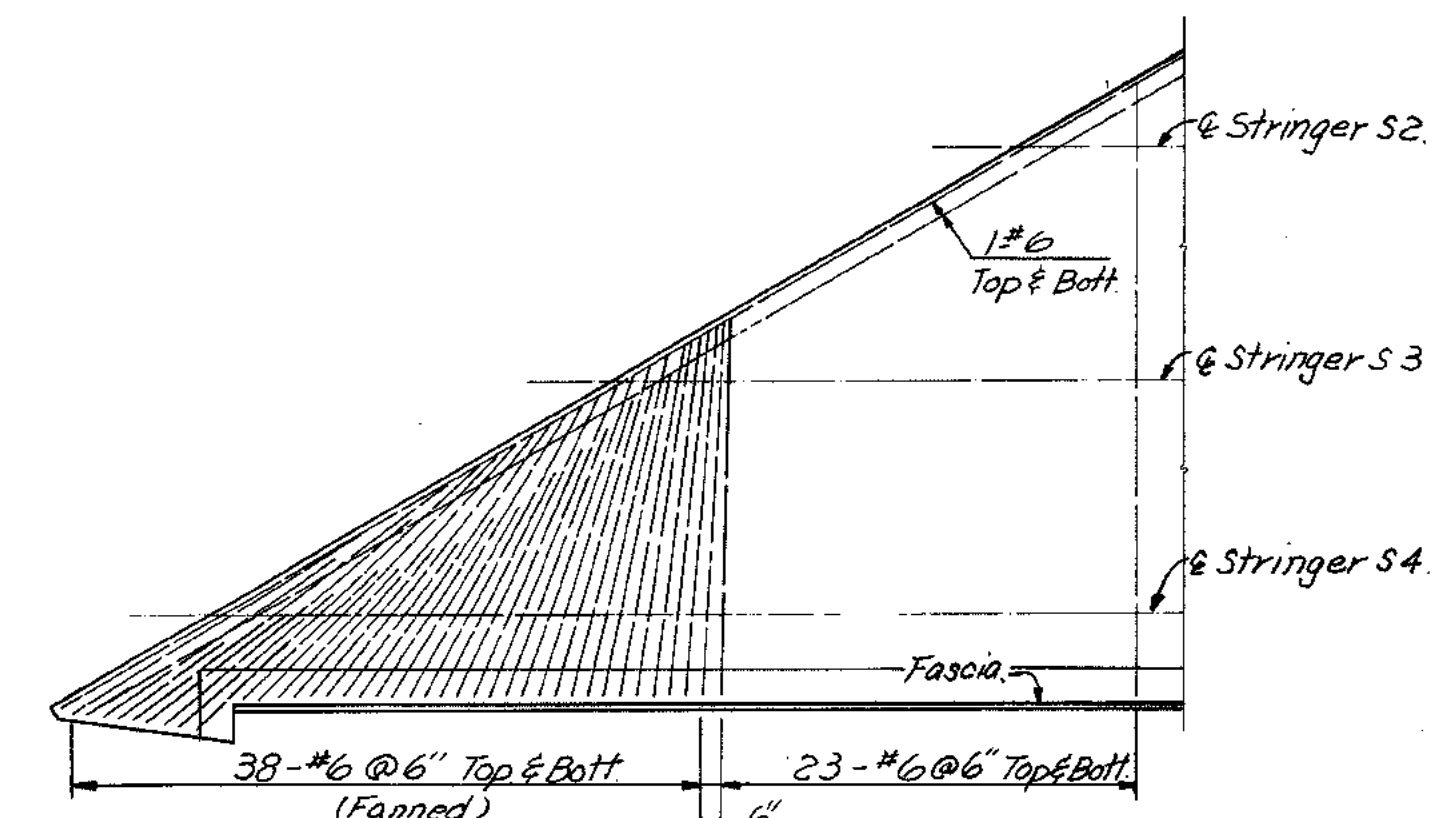


**DETAIL H**  
No Scale

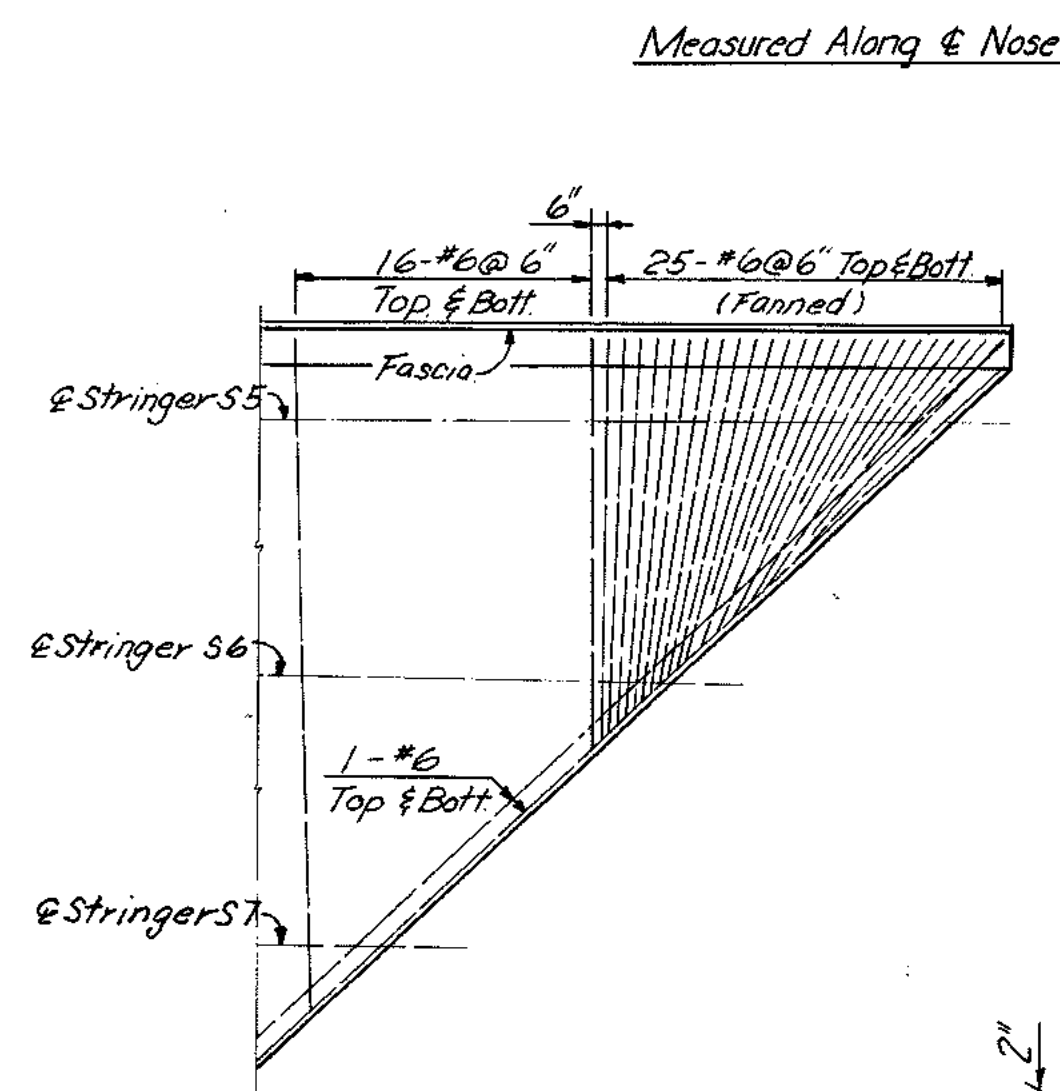


**DETAIL I**  
No Scale

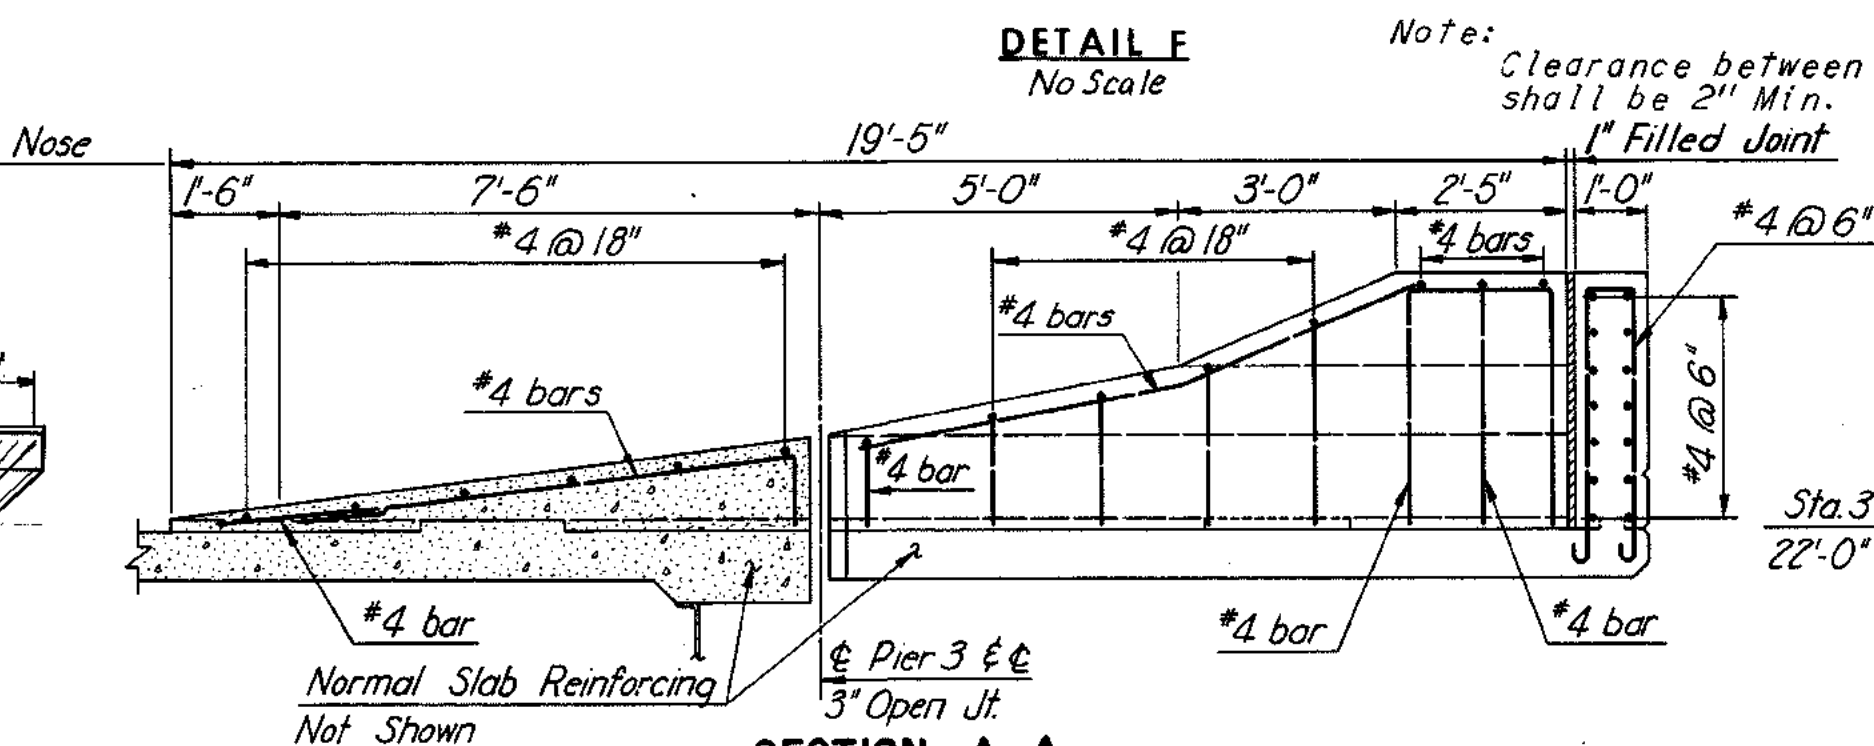


**SECTION A-A**  
Scale:  $\frac{3}{8}$ "=1'-0"

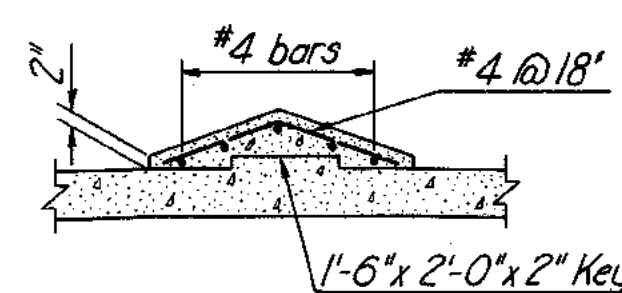

**SECTION B-B**  
Scale:  $\frac{3}{8}$ "=1'-0"

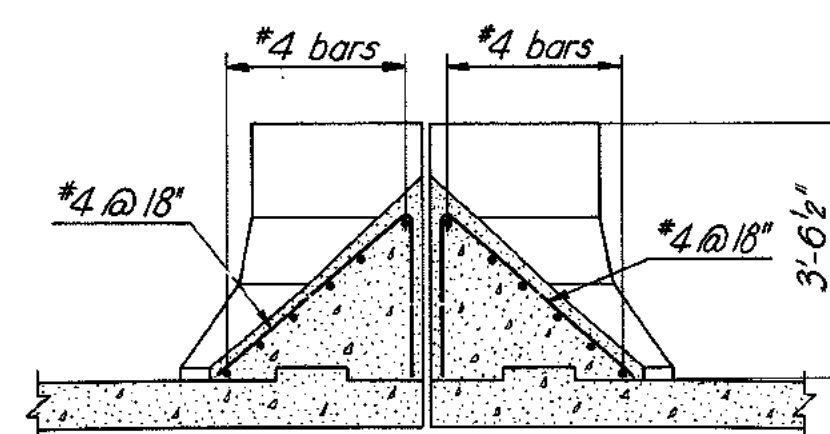

**SECTION C-C**  
Scale:  $\frac{3}{8}$ "=1'-0"

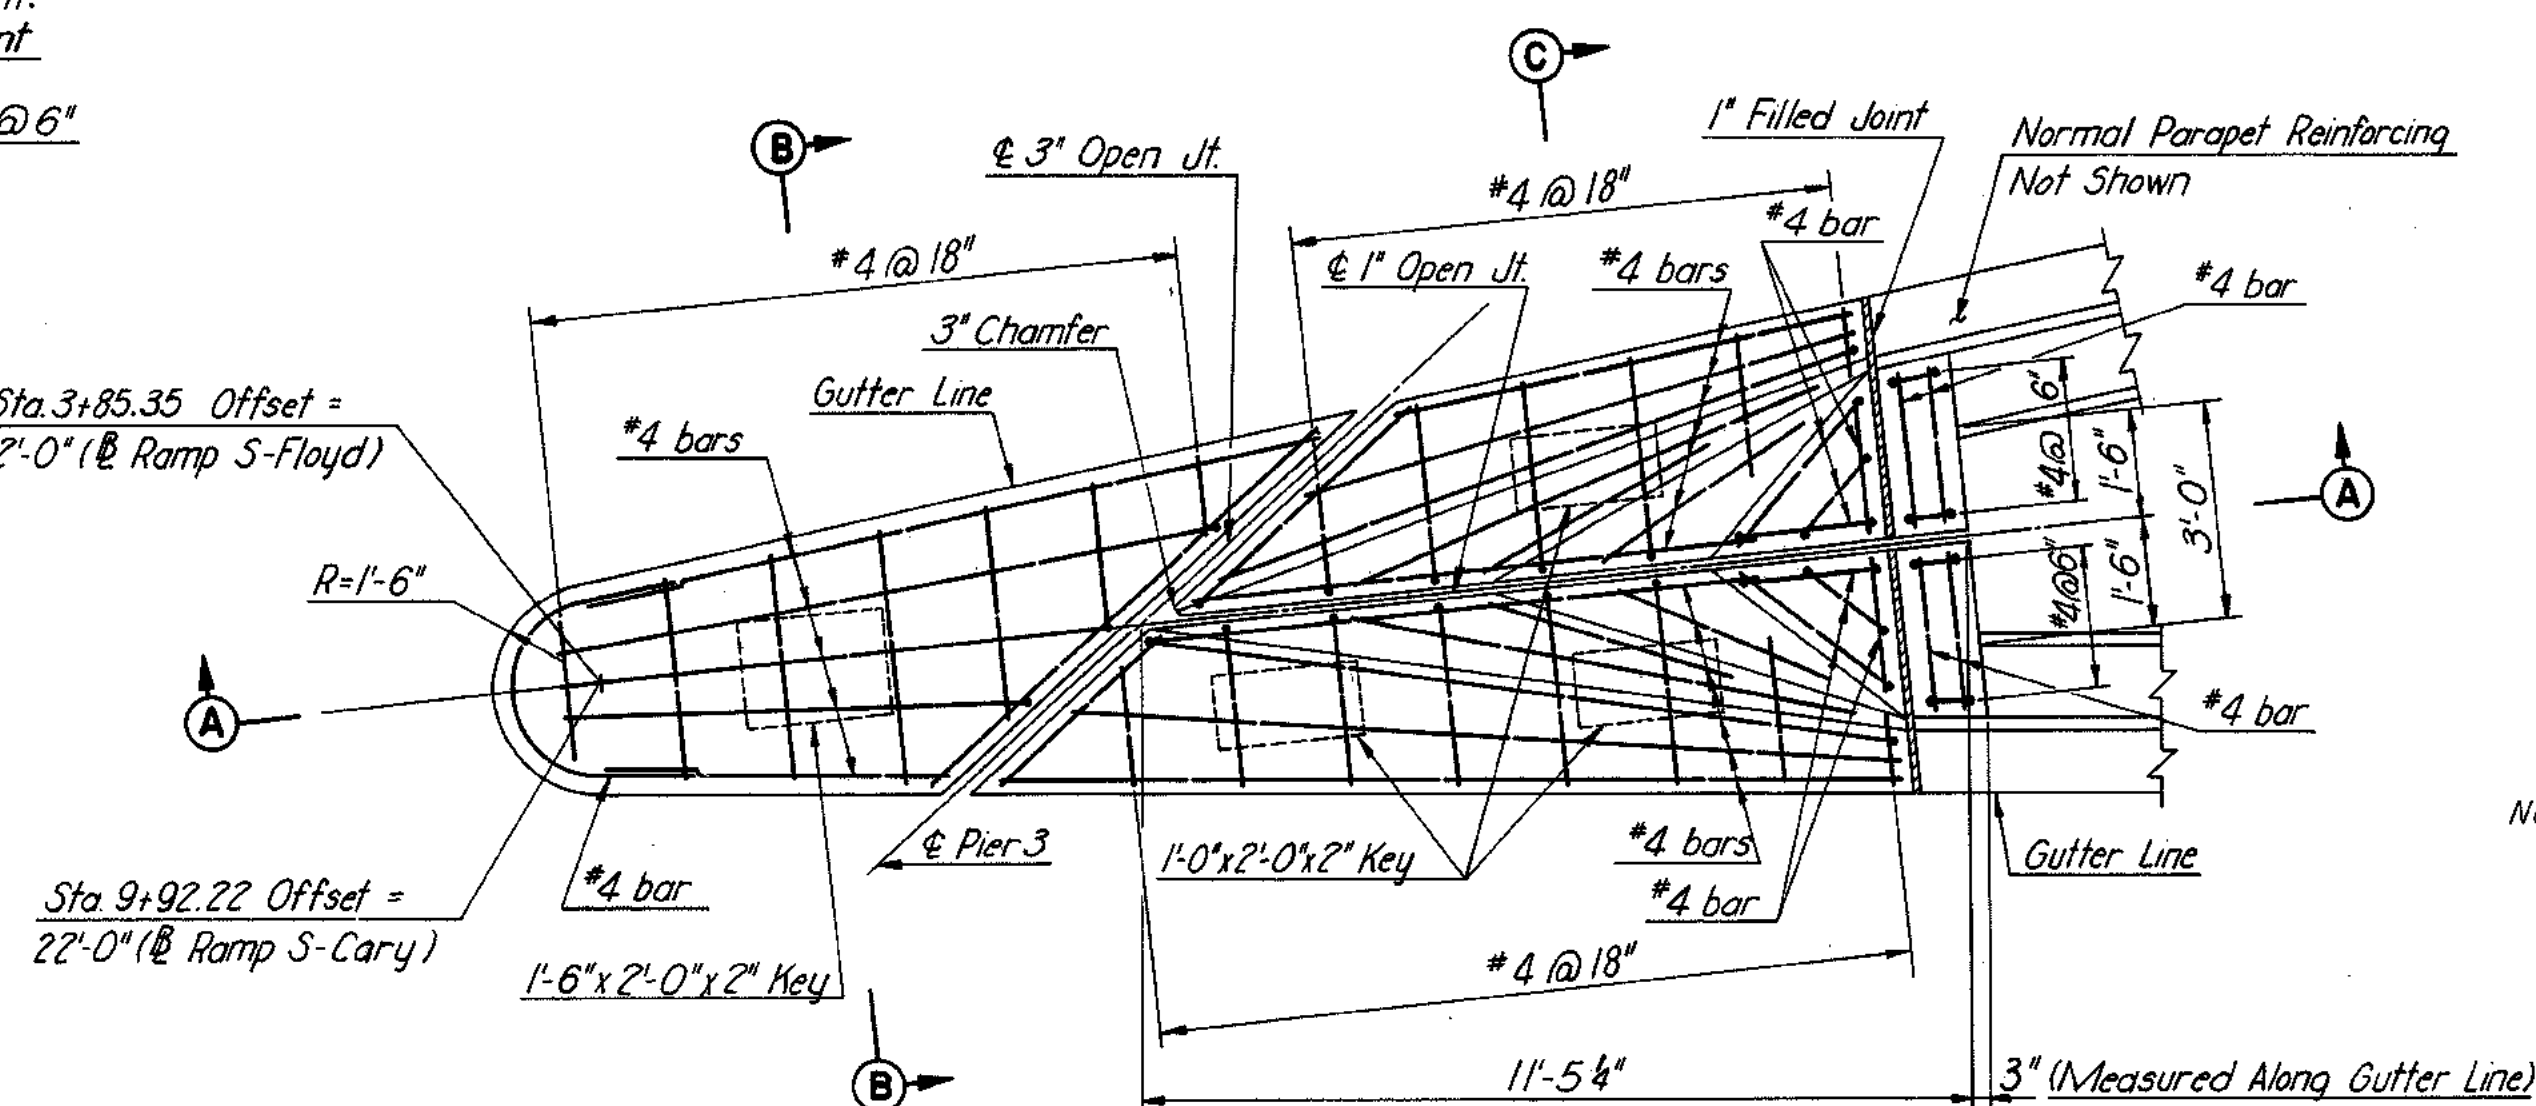

**NOSE DETAIL**  
Scale:  $\frac{3}{8}$ "=1'-0"

**AS BUILT**

Note:  
For Joint details see Sheets 11 and 12  
For Deck Plan see Sheet 9.  
For Framing Plan see Sheet 8.  
For location of Details see Sheet 9.

**RICHMOND METROPOLITAN AUTHORITY**  
**RICHMOND EXPRESSWAY SYSTEM**  
**BELTLINE EXPRESSWAY**  
**BRIDGE NO. 17**  
**RAMP S-CARY OVER**  
**EAST-NORTH ROADWAY**  
**DECK DETAILS**

HOWARD, NEEDLES, TAMMEN & BERGENDOFF  
consulting engineers  
NEW YORK ALEXANDRIA KANSAS CITY

SCALE: *As noted*  
CONTRACT NO.: **4**  
SHEET NO. **10** OF **14**

BY	DATE				
MADE	G.C.C.	12-15-67			
CHECKED	S.S.W.	3-19-68	1	As Built	R.H. 2-5-73
IN CHARGE	FKD		NO.	REVISION	BY DATE

# **Bridge 36**

**Maplewood Avenue**

**Over**


**The Connector to Downtown Expressway (VA 146)**

**Record Set Plans**





RICHMOND EXPRESSWAY SYSTEM			
SECTION	PROJECT	SHEET NO.	TOTAL SHEETS
7	DOWNTOWN EXPRESSWAY	96	

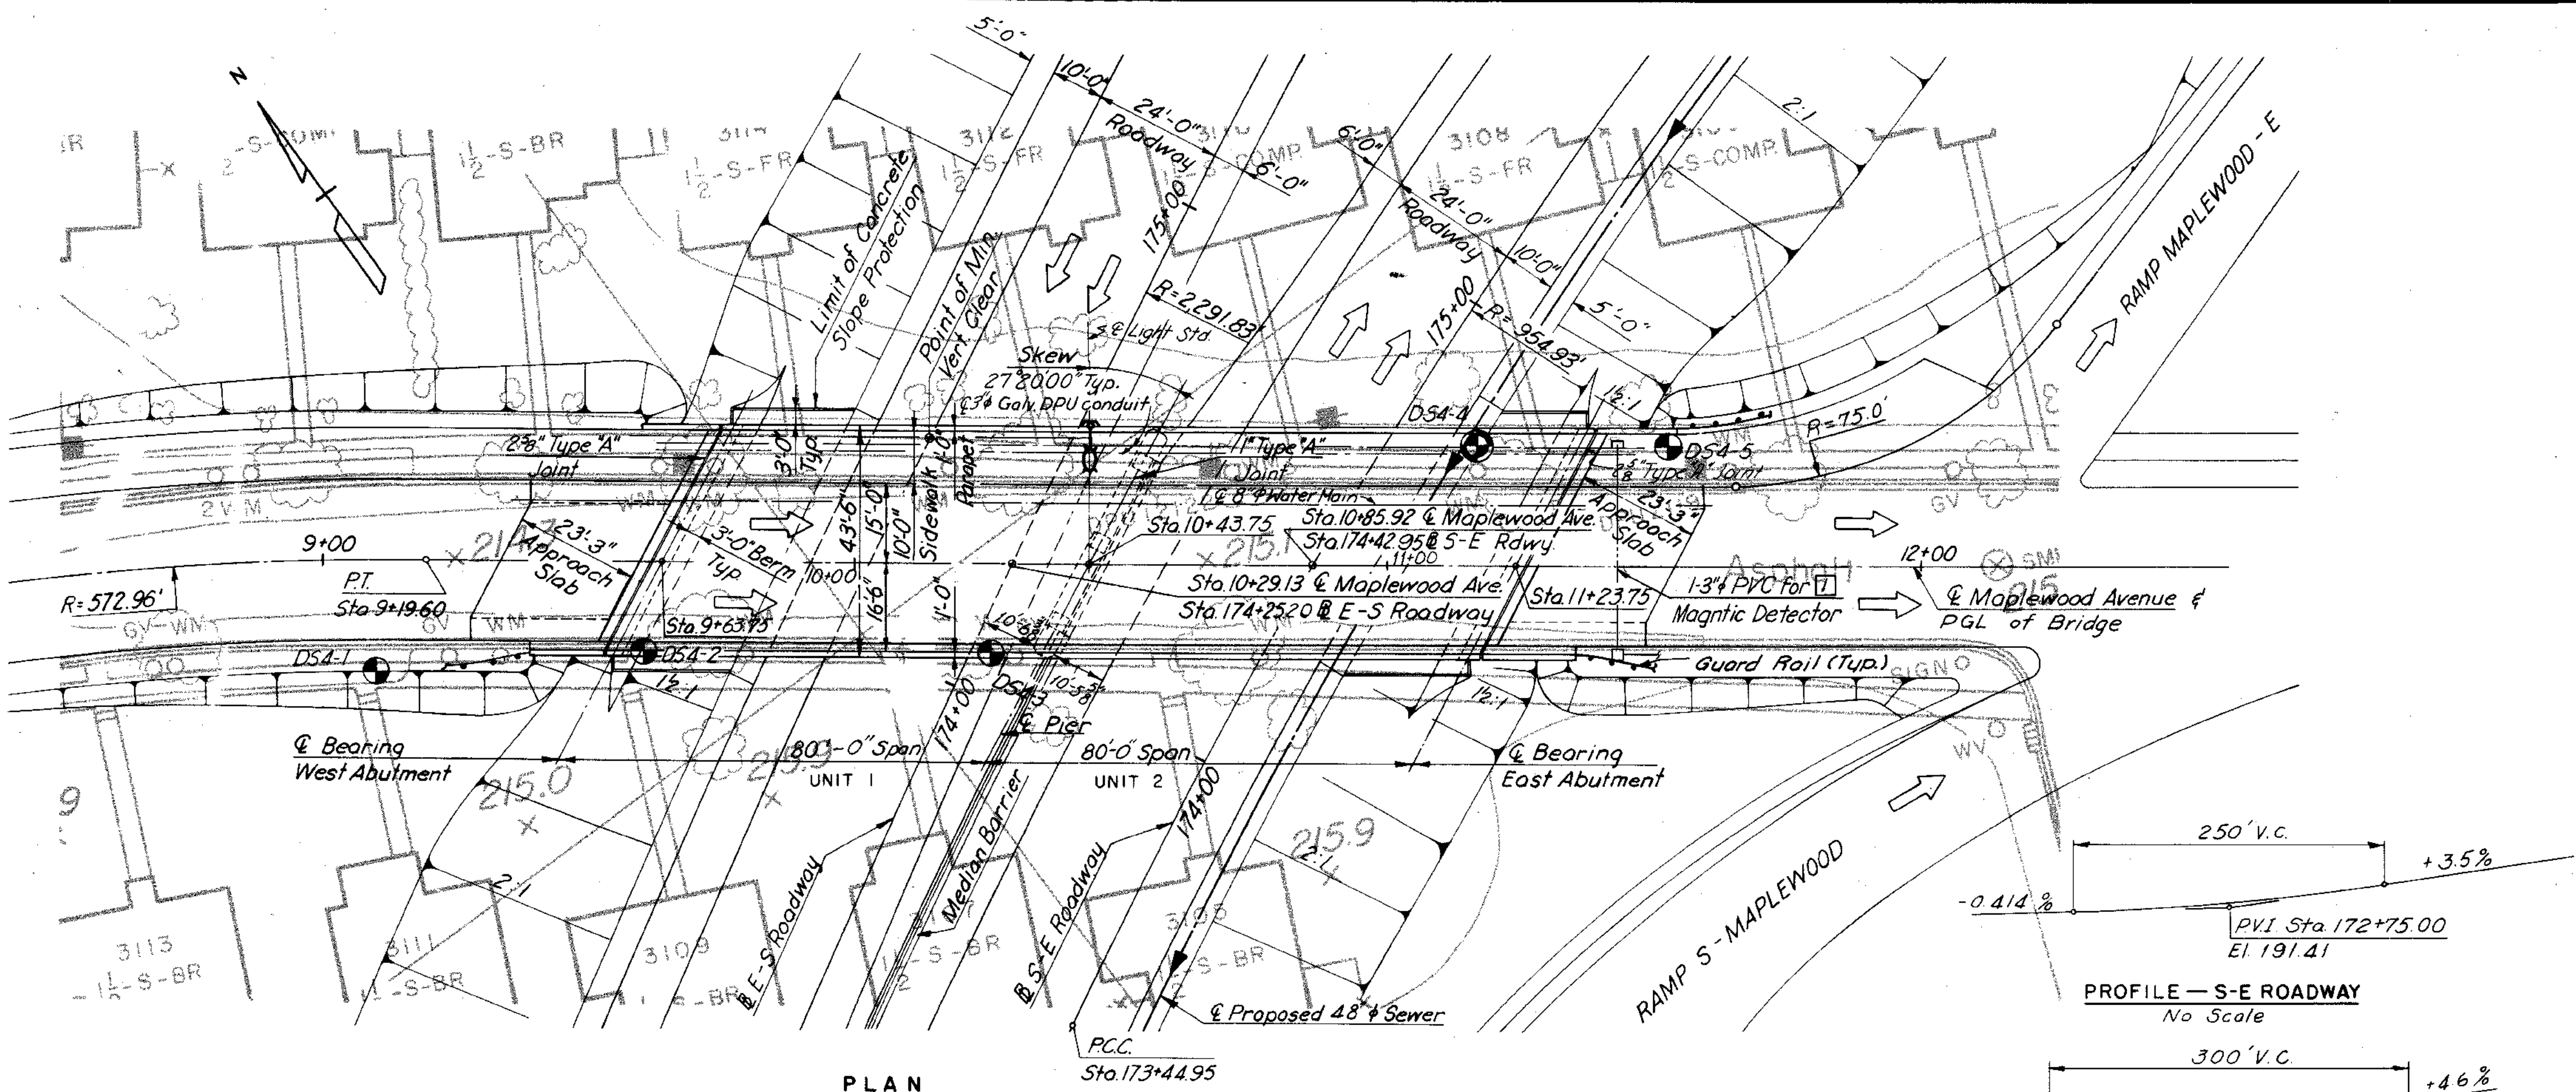

**GENERAL NOTES**

**ROADWAY:** 36' Face of rail to edge of sidewalk.

**CAPACITY:** Dead Load-Includes 15 lbs. per sq. ft. for future wearing surface. Live Loads-HS20-44 loading and B.P.R. modified for military vehicles.

**SPECIFICATIONS:** GENERAL-Virginia Department of Highway Road and Bridge Specifications, 1970. DESIGN-A.A.S.H.O. Standard Specifications for Highway Bridges, 1969 and 1970-72 Interim Specifications, modified by Special Design Provisions. WELDING: 1972 Structural Welding Code of the American Welding Society.

**CONTRACT SPECIAL PROVISIONS**

Specifications and Contract Special Provisions referred to above are necessary to make these plans complete.

**DATUM:** CITY OF RICHMOND

**TEMPERATURE:** The normal temperature referred to on the plan is 60° F. The temperature range for movement is 0° F. to 120° F.

**DIMENSIONS:** All dimensions are measured horizontally and vertically unless otherwise noted.

**EXCAVATION:** Excavation below subgrade and cut slope template shall be classified as Structure Excavation. All excavation above these limits shall be classified as Regular Excavation and is not included in the Structural Quantities.

**FOUNDATIONS:** Footings shall rest on firm material. Found. mat'l. shall be kept dry & special attn. is called to Sec. 401.05 of the Gen. Specs. & to the Contract Special Prov. concerning preparation of found. for ftgs.

**CONCRETE NOTES:**

Concrete in superstructure shall be Class A4. All other concrete shall be Class A3. All exposed edges and corners shall have a 2" chamfer or fillet unless otherwise noted. Care in the method of vibration, the use of low-slump concrete, and/or other means shall be employed to prevent downgrade movement of newly placed slab concrete. (When gradient is over 2%).

Finishing concrete surfaces: See the Standard Architectural Detail Sheets and the Contract Special Provisions for types and details.

All reinforcing steel shall be intermediate grade. All reinforcing bar dimensions on the detailed drawings are to centers of bars unless otherwise noted. Clear distance between reinforcing steel and face of concrete shall be as noted on the plans. All bar laps shall be 30 diameters of the smaller diameter bar unless otherwise noted.


**STEEL NOTES:** Structural steel shall conform to A.S.T.M. Specification A36 except as noted.

All field connections shall be made with high strength bolts. High strength bolts shall be 7/8" diameter unless otherwise noted and shall conform to A.S.T.M. Specification A-325.

**BENCH MARK:** C-11. Copper Weld Rod, South side of Maplewood Ave. of Belmont Ave. Elev. 215.37.

Indicates 2"  $\phi$  cased hole boring.

Indicates 4"  $\phi$  cased hole boring.

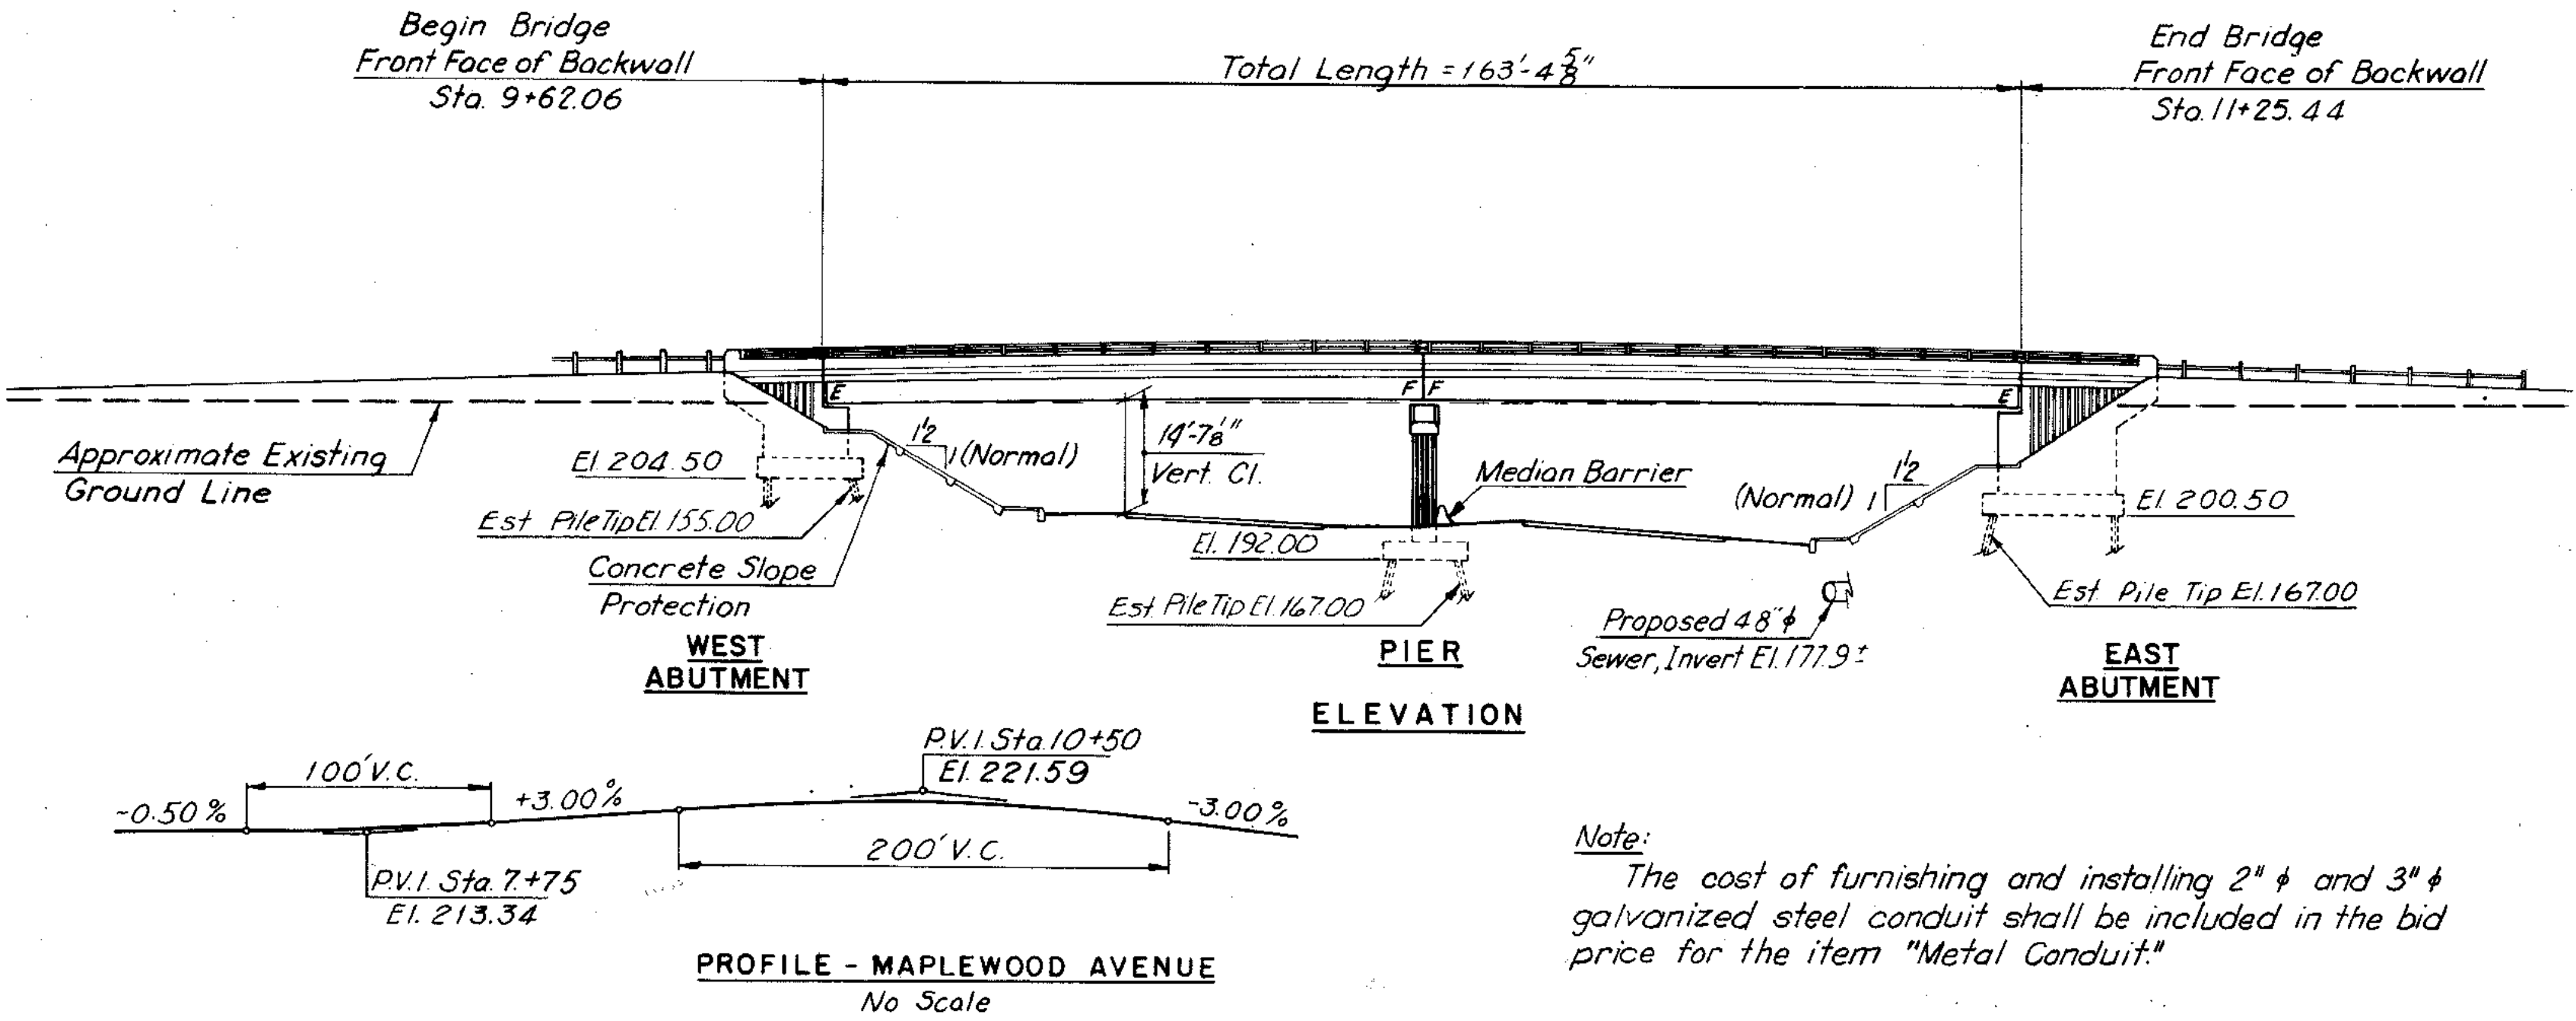

INDEX	
NO.	DESCRIPTION
1	GENERAL PLAN AND ELEVATION
2	WEST ABUTMENT
3	EAST ABUTMENT
4	ABUTMENT DETAILS
5	PIER
6	FRAMING PLAN
7	DECK PLAN AND CROSS SECTION
8	JOINT DETAILS
9	APPROACH SLAB & SLOPE PROTECTION DETAILS
10	BORING LOGS
S1	STANDARD SHOE DETAILS
S3	STANDARD ALUMINUM RAILING DETAILS (2 RAILS)
S4	STANDARD ELECTRICAL DETAILS
S7 TO S9	STANDARD ARCHITECTURAL DETAILS
S11	STANDARD GAS AND WATER MAIN SUPPORT DETAILS
S13	LIMITS OF EXCAVATION AND BACKFILL

**Note:**

The cost of furnishing and installing 2"  $\phi$  and 3"  $\phi$  galvanized steel conduit shall be included in the bid price for the item "Metal Conduit."

ESTIMATE OF QUANTITIES													
	STRUCTURE EXCAVATION	CONCRETE			STRUCTURAL STEEL	ALUMINUM BR. RAILING (2 RAIL)	POROUS BACKFILL	REINFORCING STEEL	STEEL PILES IOBP 42	CONC. SLAB SLOPE PROT.	ASPHALT DAMPROOFING	UNDERDRAIN 6" $\phi$ PIPE	WATER MAIN 6" $\phi$
	C.Y.	CLASS A4 C.Y.	CLASS A3 C.Y.	CLASS A3 APPR. SLABS C.Y.	LBS.	L.F.	C.Y.	LBS.	L.F.	S.Y.	S.Y.	L.F.	L.F.
SUPERSTRUCTURE		276.2			270,749	32.7		53,067					213
WEST ABUTMENT	218.6		143.0			23	12.3	7,081	864.2	150.2	57	57	
EAST ABUTMENT	454.0		215.0			31.4	43	13,320	1,291.4	133.1	107	60	
PIER	131.4		82.7					12,264	480.2				
APPROACH SLABS				86				22,420					
TOTAL	804.0	276.2	440.7	86	270,749	381.4	55.3	108,152	2,635.8	283.3	164	117	1,176

MADE	BY	DATE	NO.	REVISION	BY	DATE
LCC	TCY	1-3-68	2	As Built	TEM	9-75
TCY	TCY	3-12-68	1	Add PVC Cond.	TEM	1-31-74
AGC						

AS BUILT


RICHMOND METROPOLITAN AUTHORITY  
RICHMOND EXPRESSWAY SYSTEM  
DOWNTOWN EXPRESSWAY

BRIDGE NO. 36  
MAPLEWOOD AVENUE OVER  
DOWNTOWN EXPRESSWAY  
GENERAL PLAN AND ELEVATION


HOWARD, NEEDLES, TAMMEN & BERGENDOFF  
consulting engineers  
NEW YORKALEXANDRIAKANSAS CITY

SCALE: 1"=20' UNLESS NOTED  
CONTRACT NO.: 7  
SHEET NO.: 1 OF 10


RICHMOND EXPRESSWAY SYSTEM			
SECTION	PROJECT	SHEET NO.	TOTAL SHEETS
7	DOWNTOWN EXPRESSWAY	100	

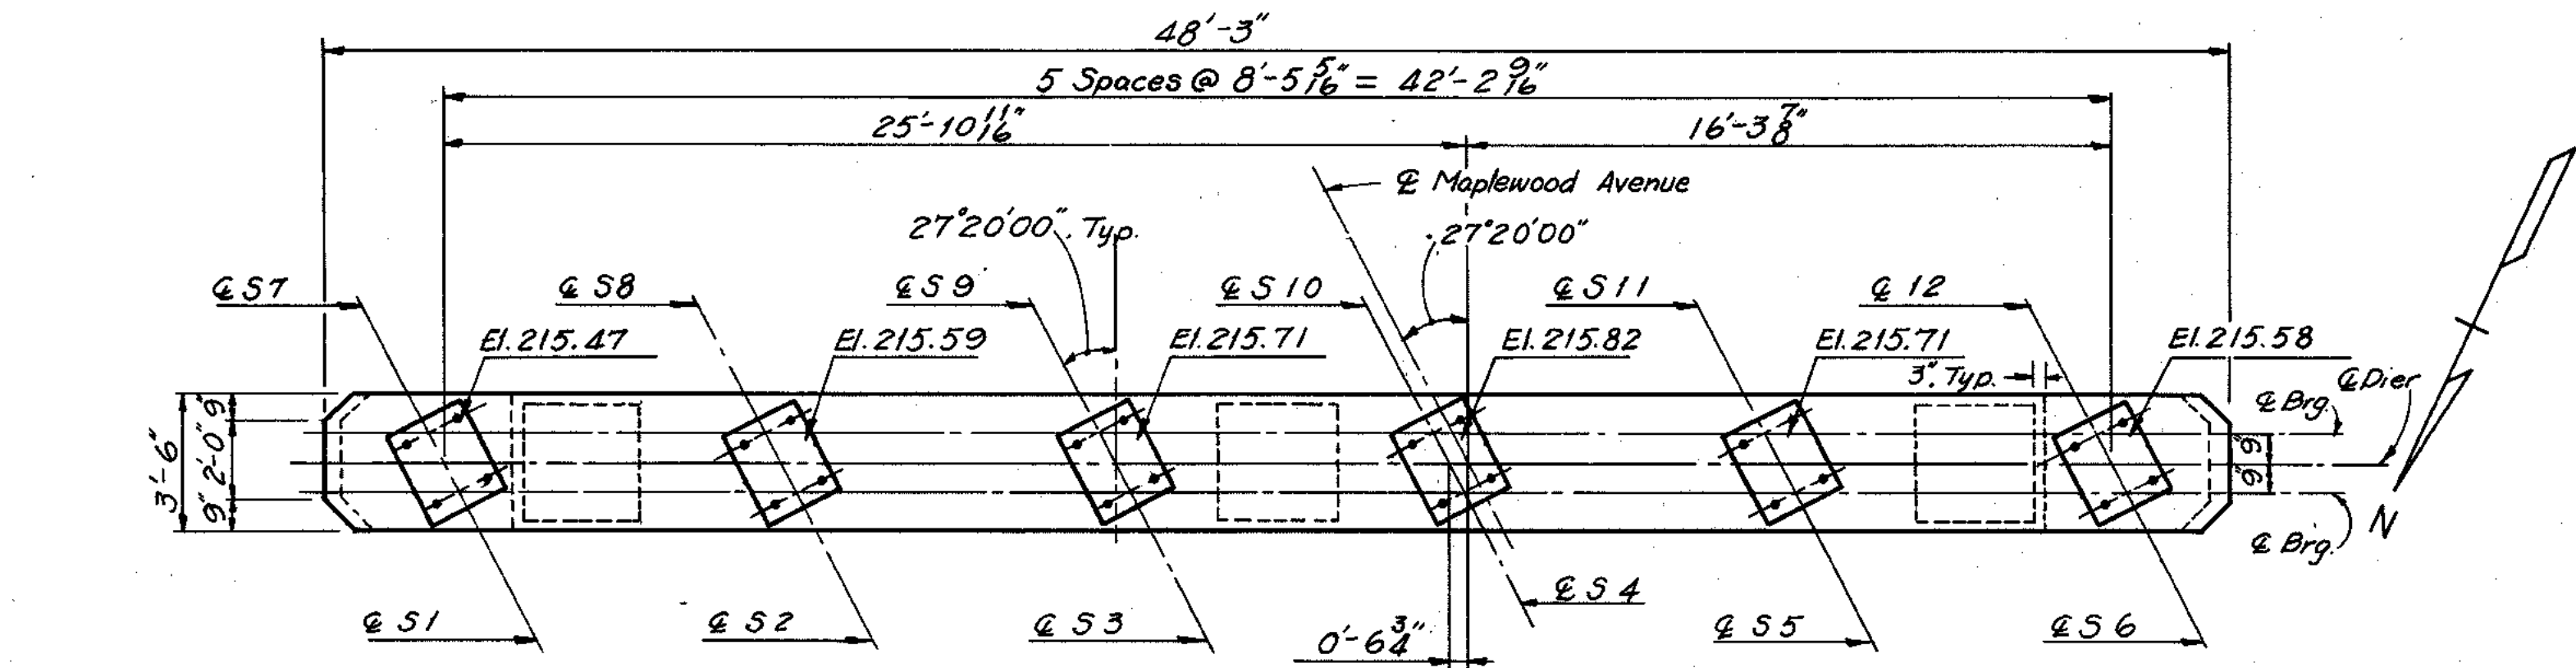


PLAN  
Scale: 1/4" = 1'-0"

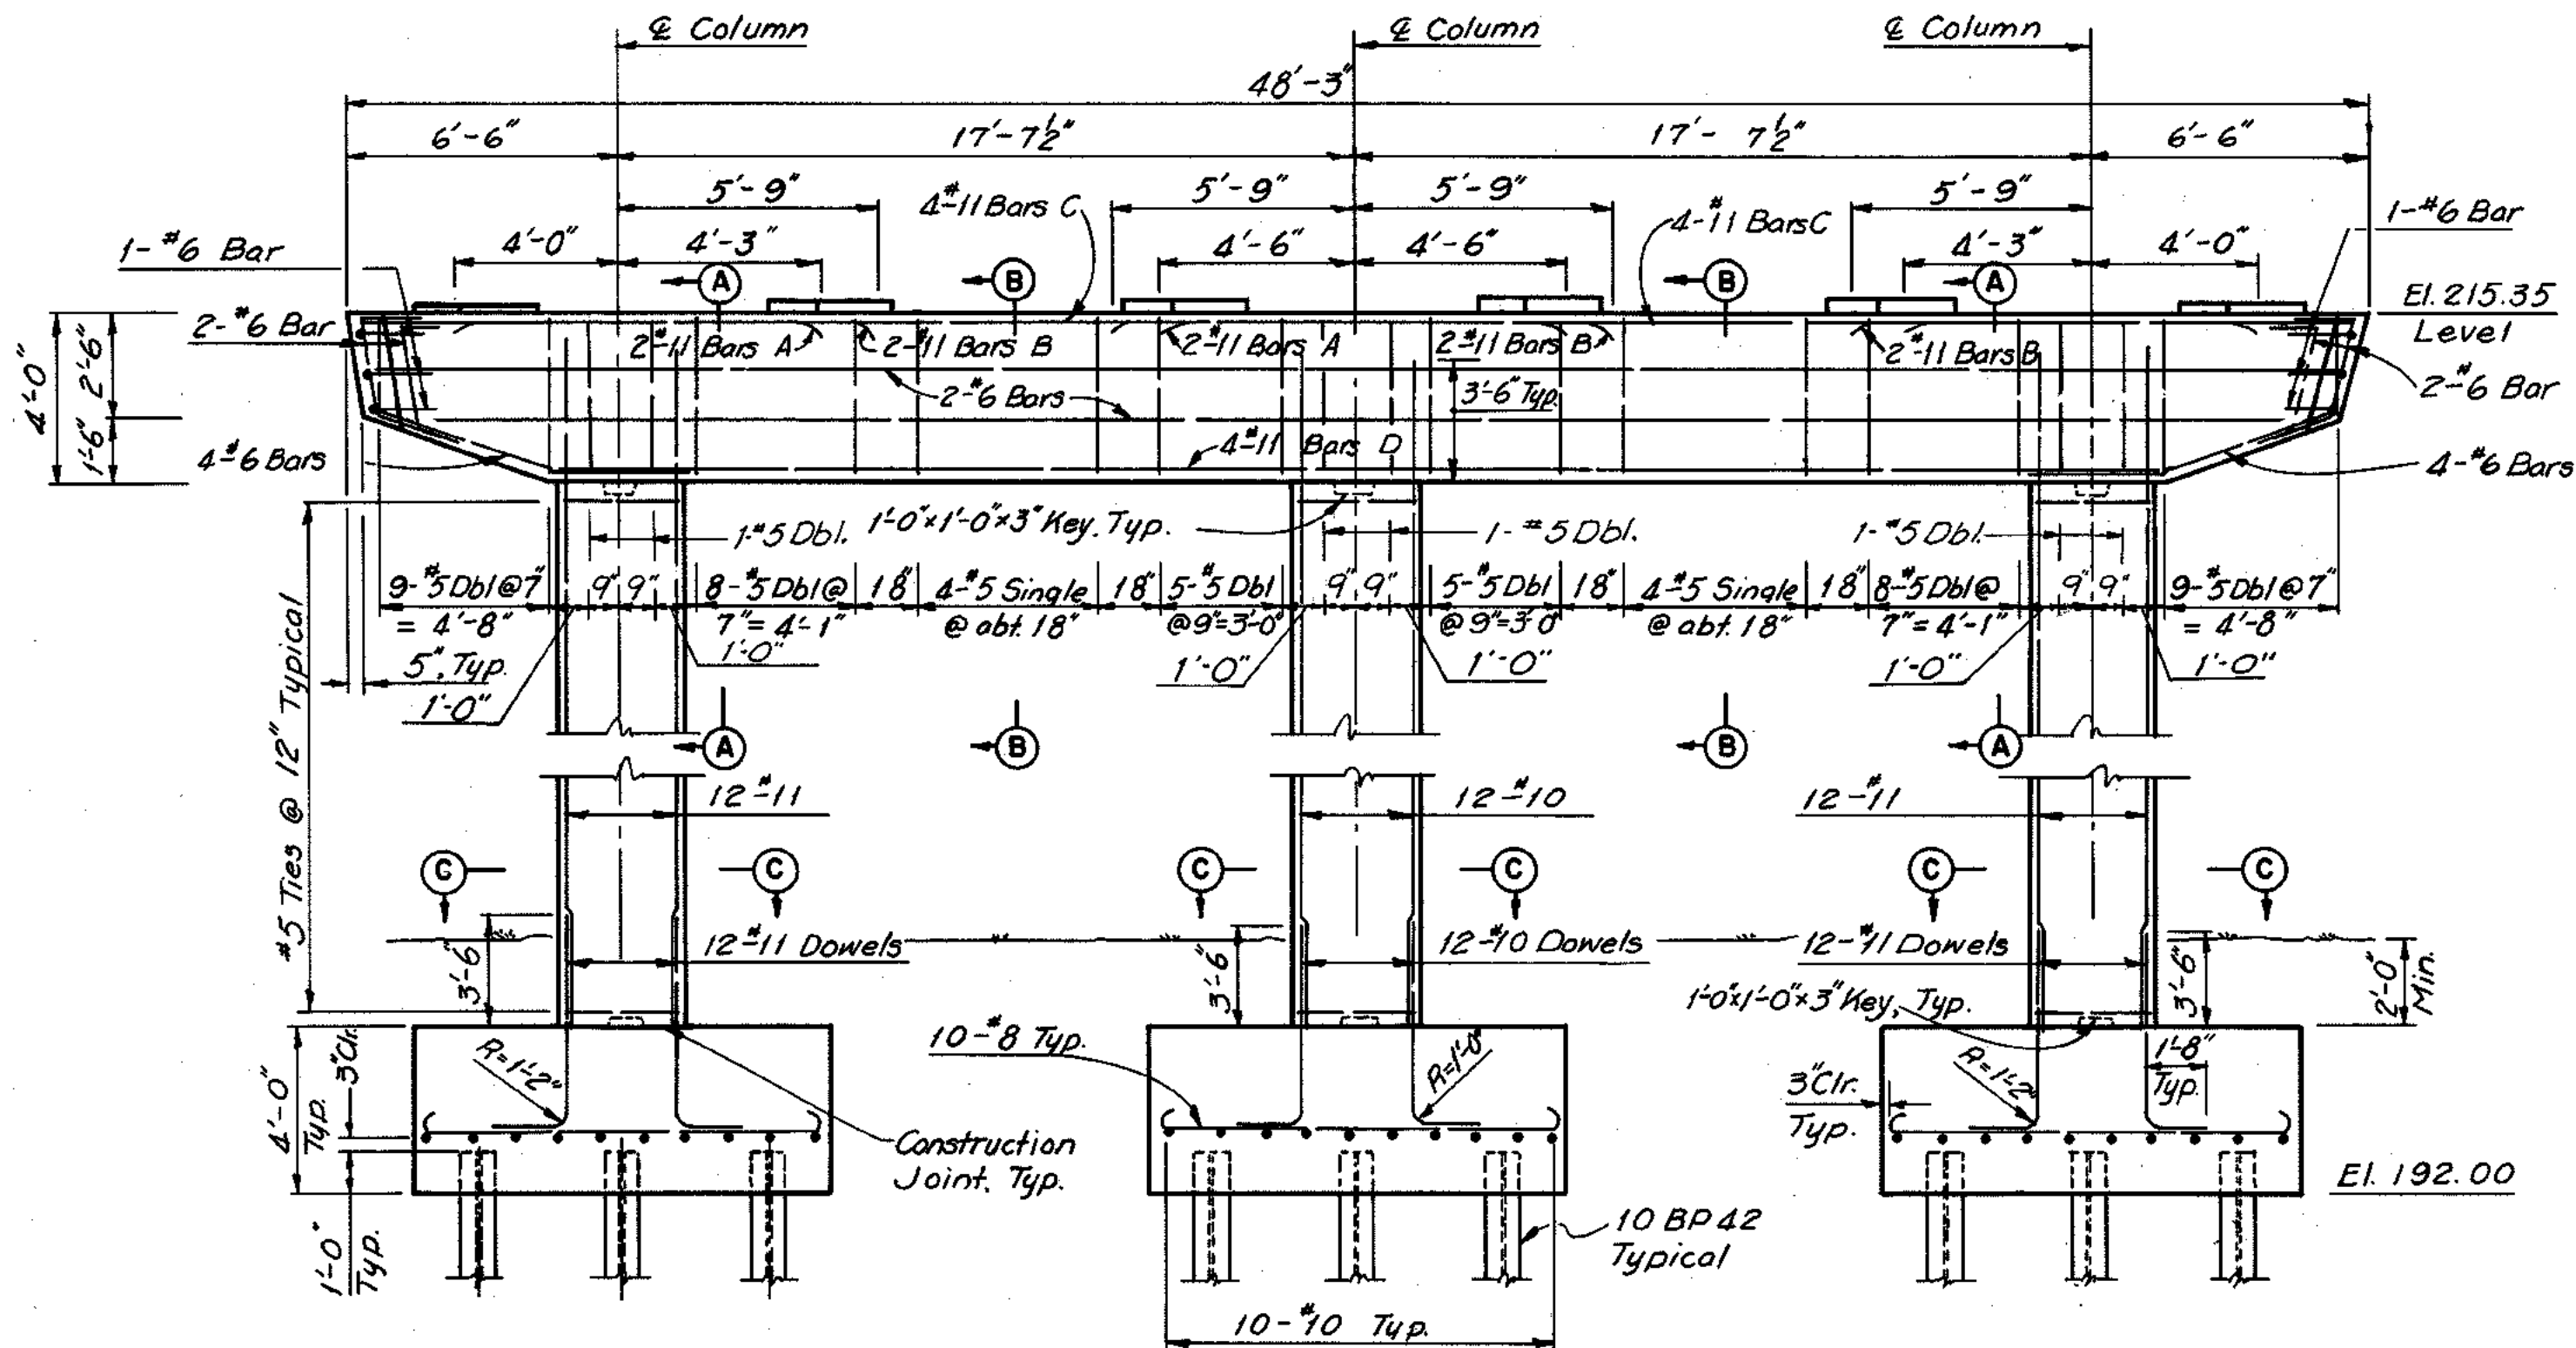

FRONT ELEVATION  
Scale: 1/4" = 1'-0"

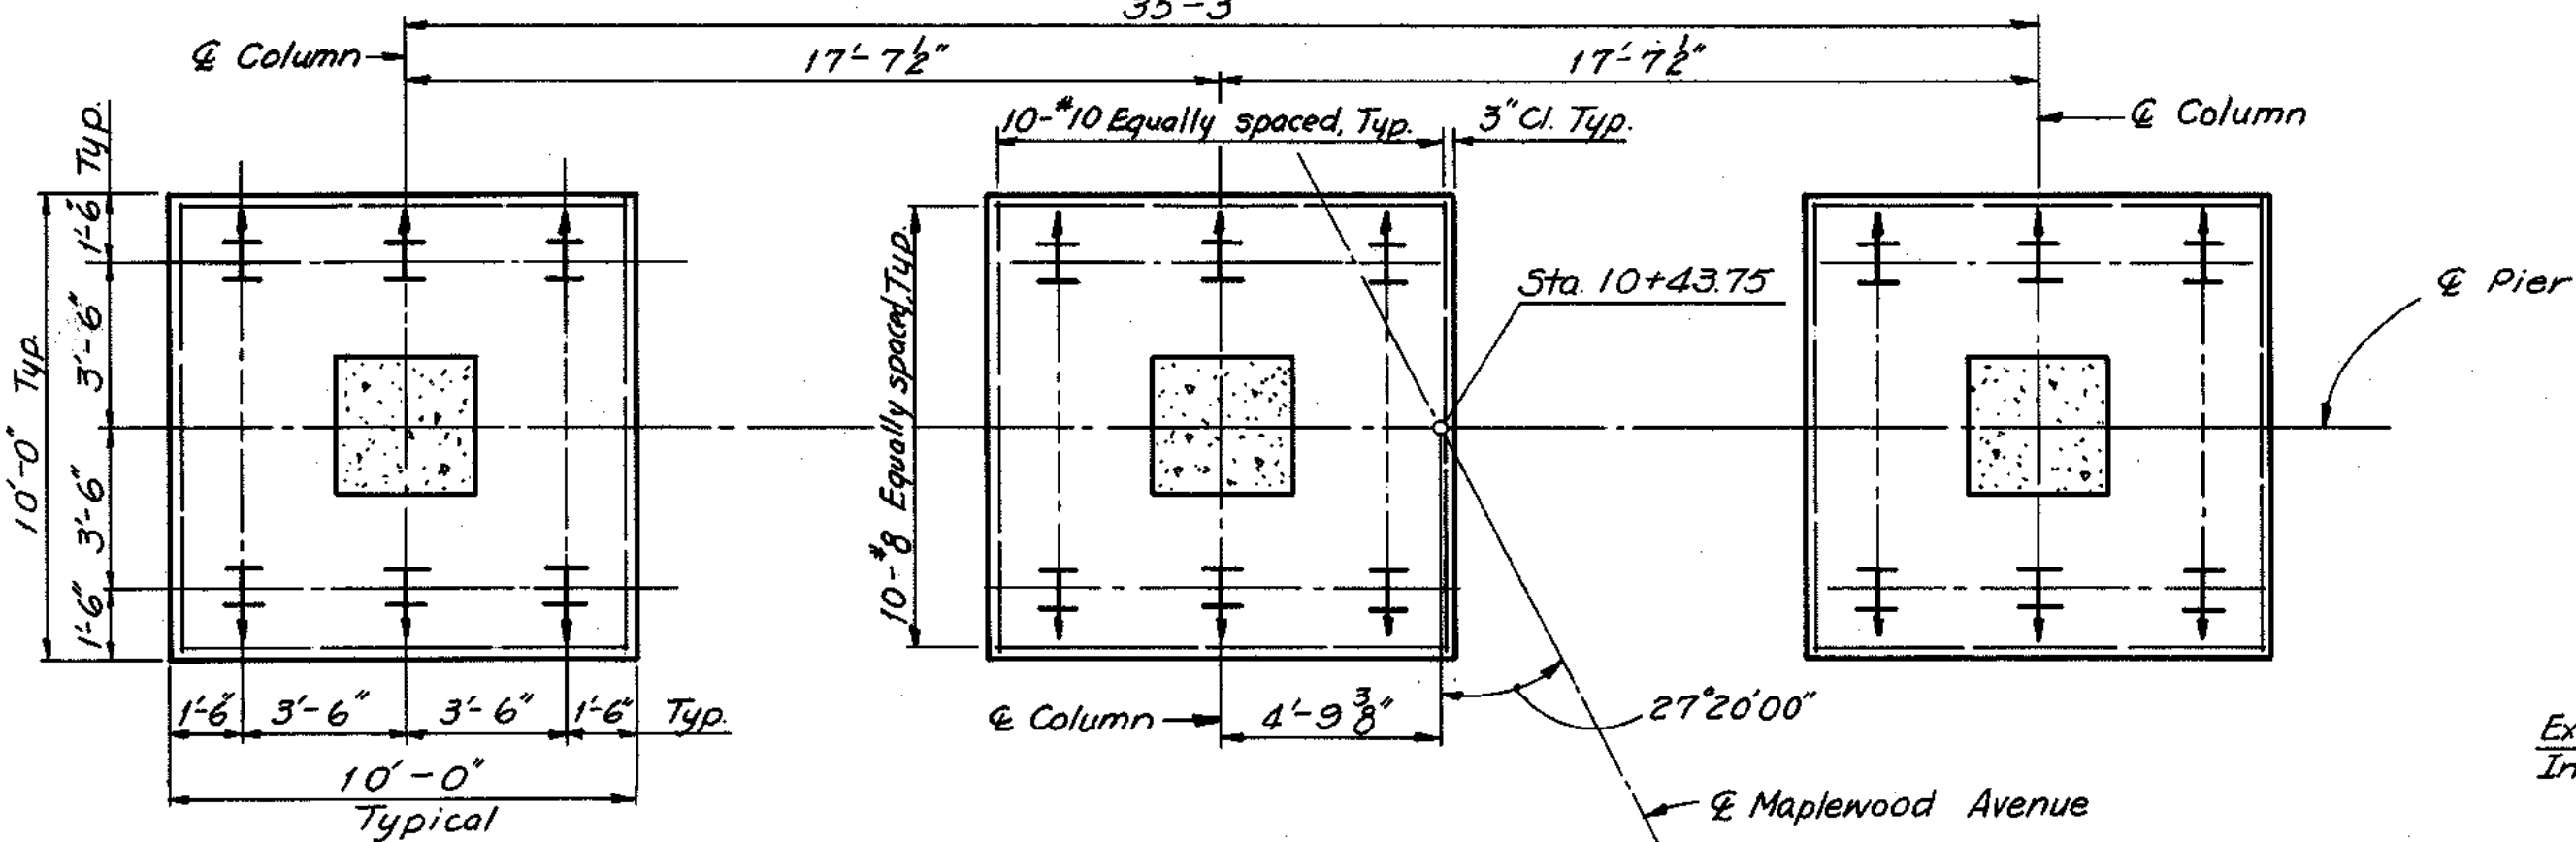


FOOTING PLAN  
Scale: 1/4" = 1'-0"

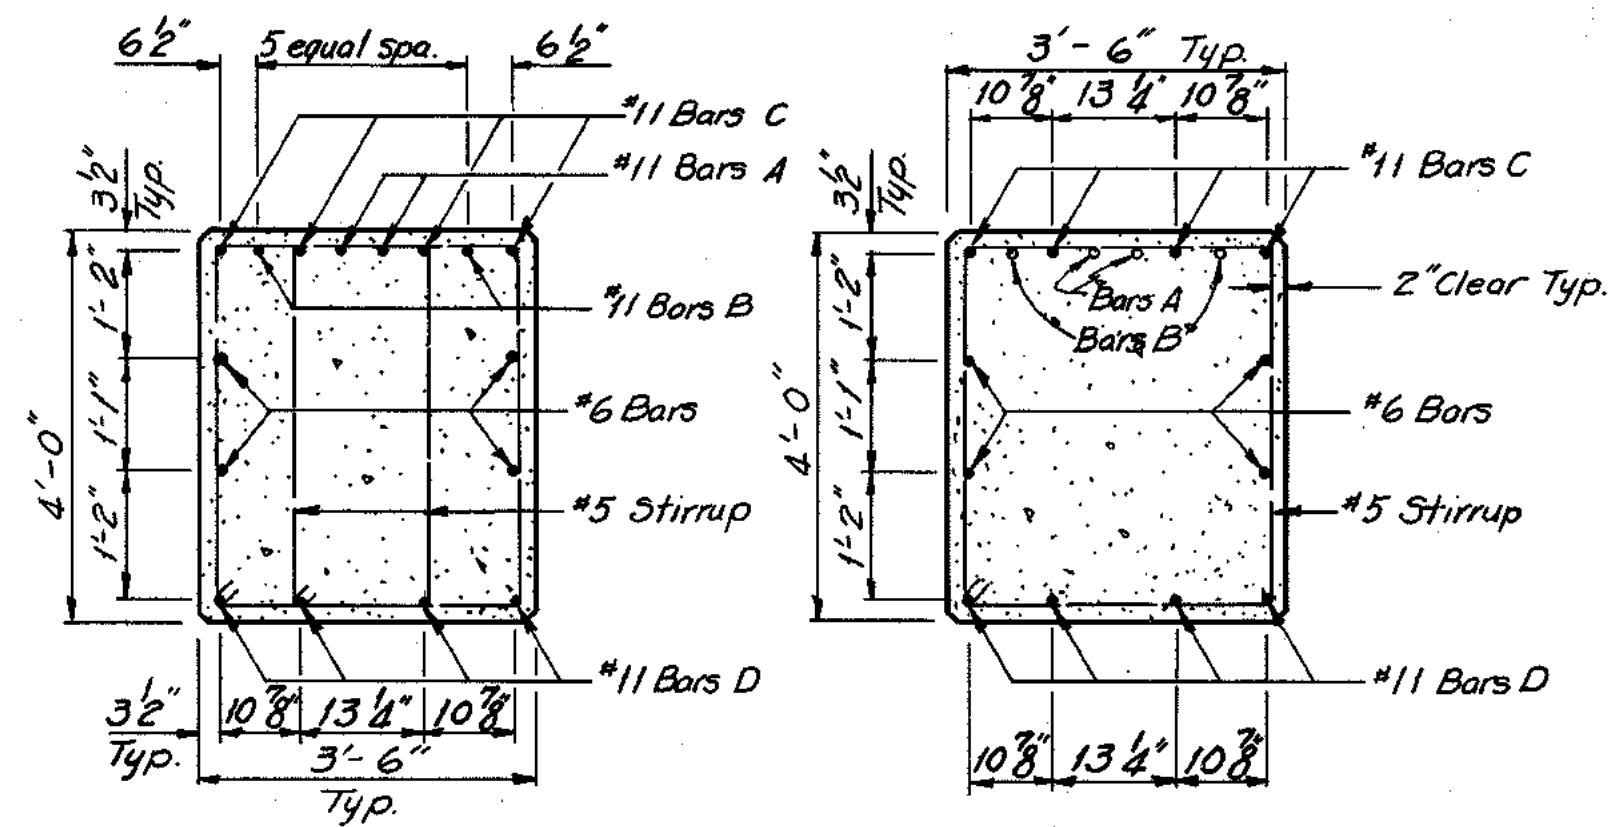


SECTION A-A  
Scale: 1/2" = 1'-0"

SECTION B-B  
Scale: 1/2" = 1'-0"

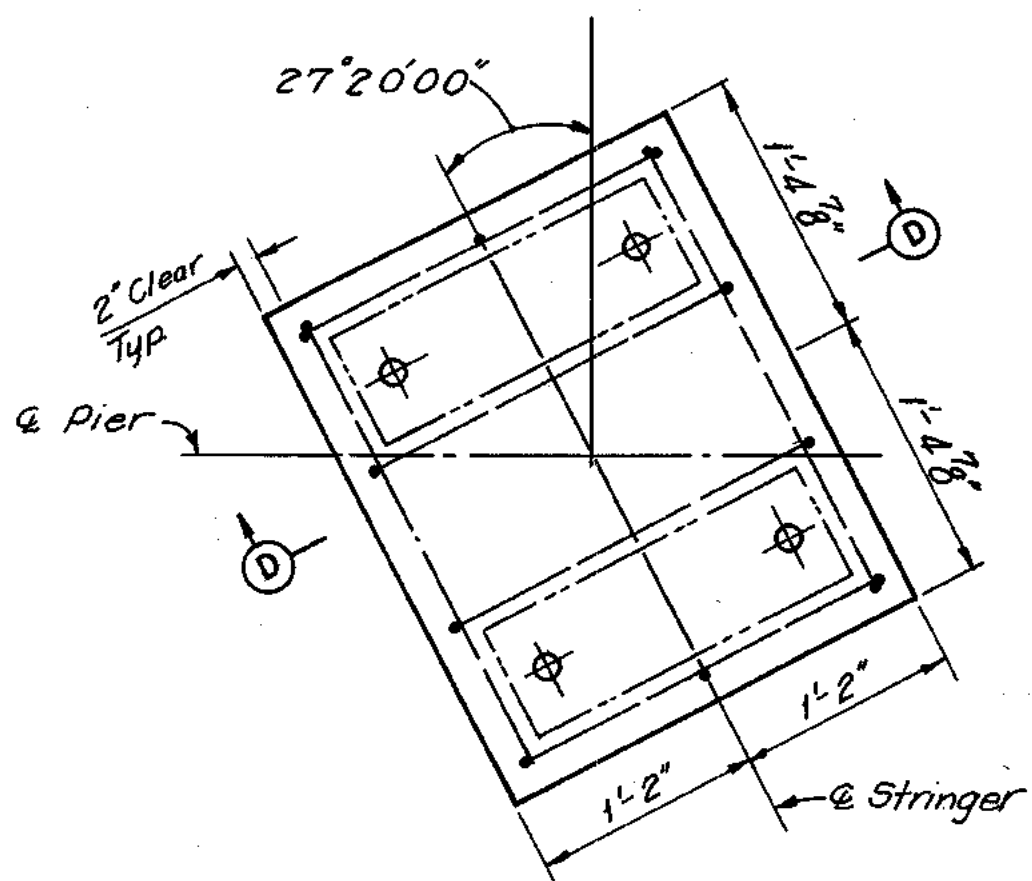


PAD REINFORCING DETAIL  
Scale: 1" = 1'-0"

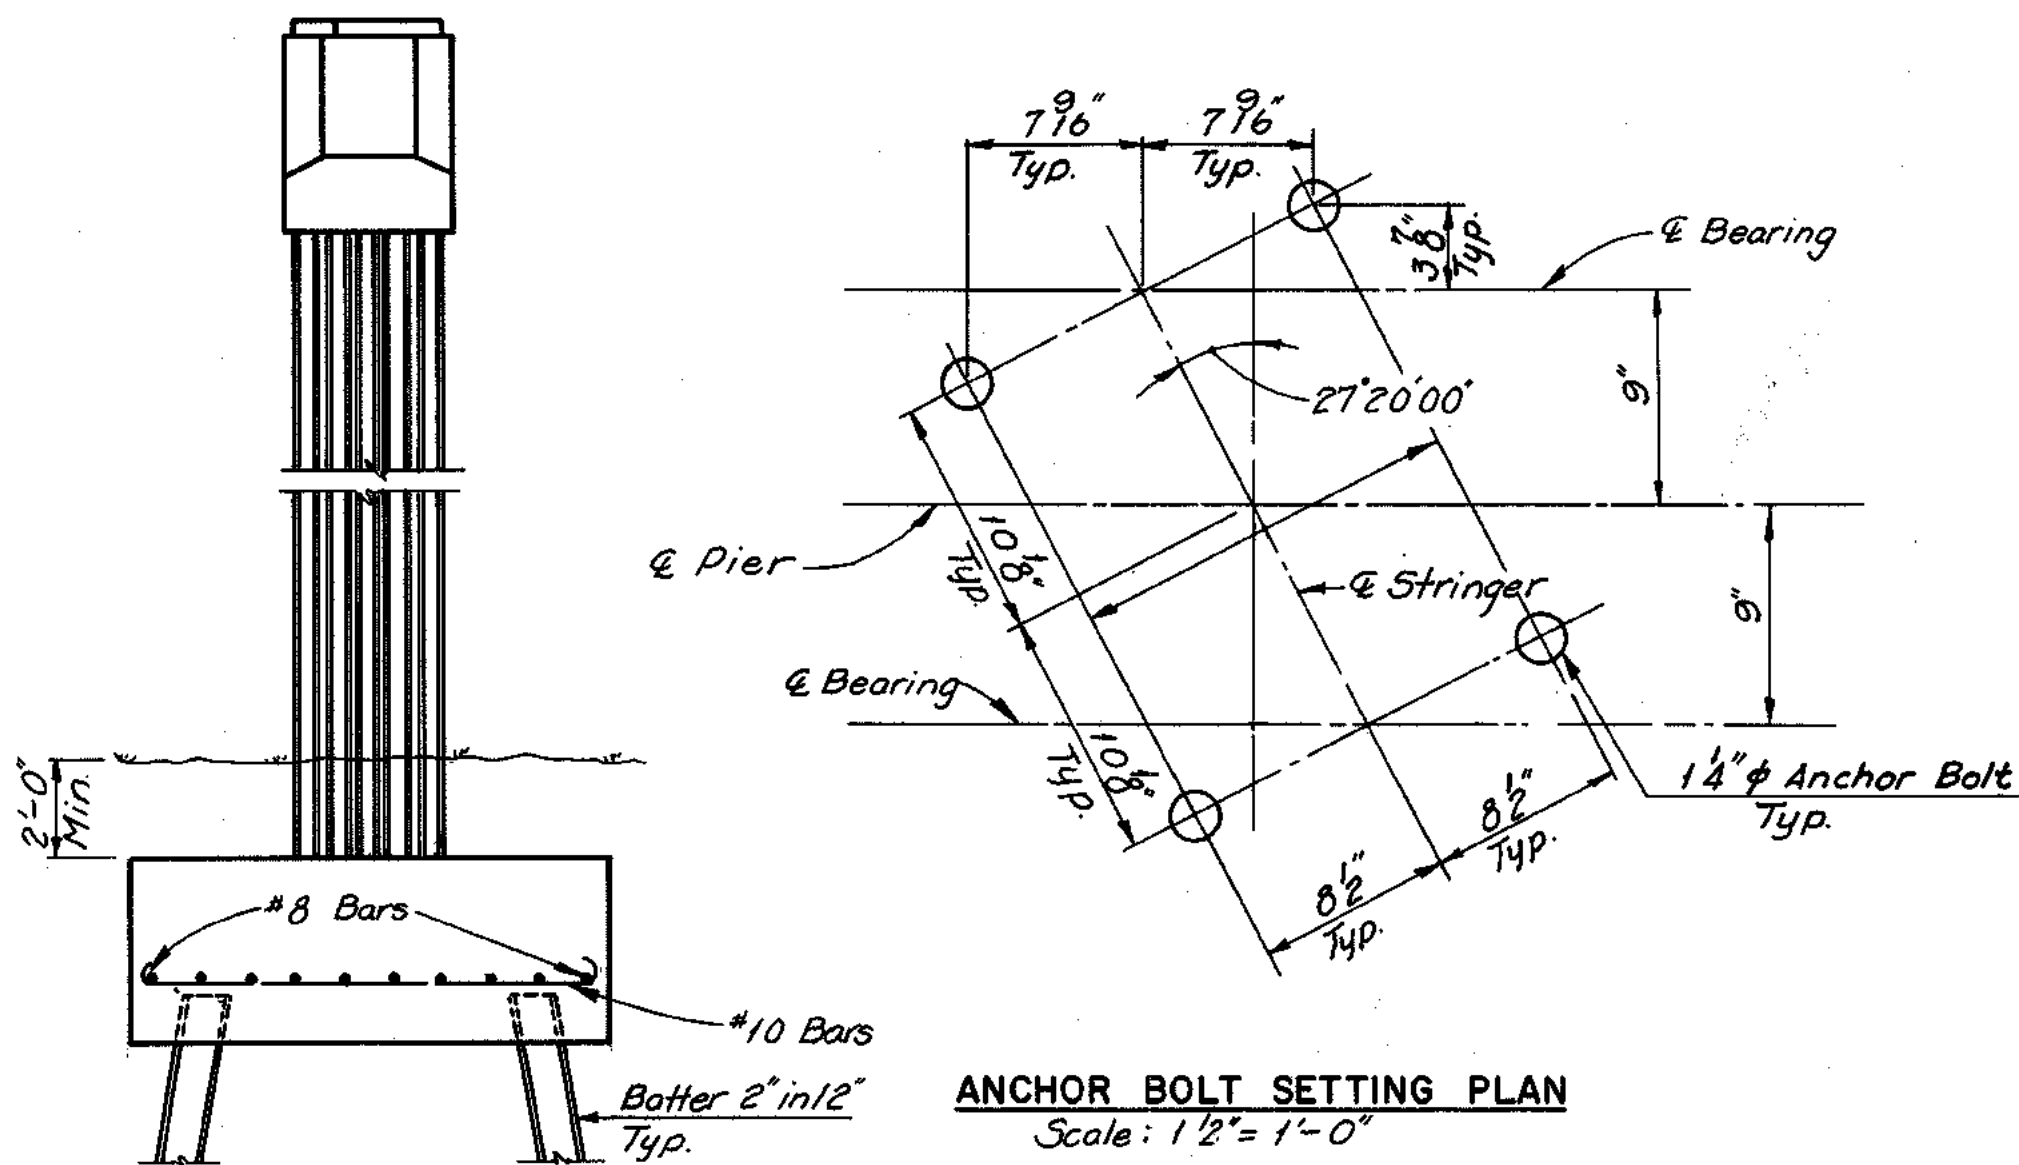


ANCHOR BOLT SETTING PLAN  
Scale: 1/2" = 1'-0"

END ELEVATION  
Scale: 1/4" = 1'-0"

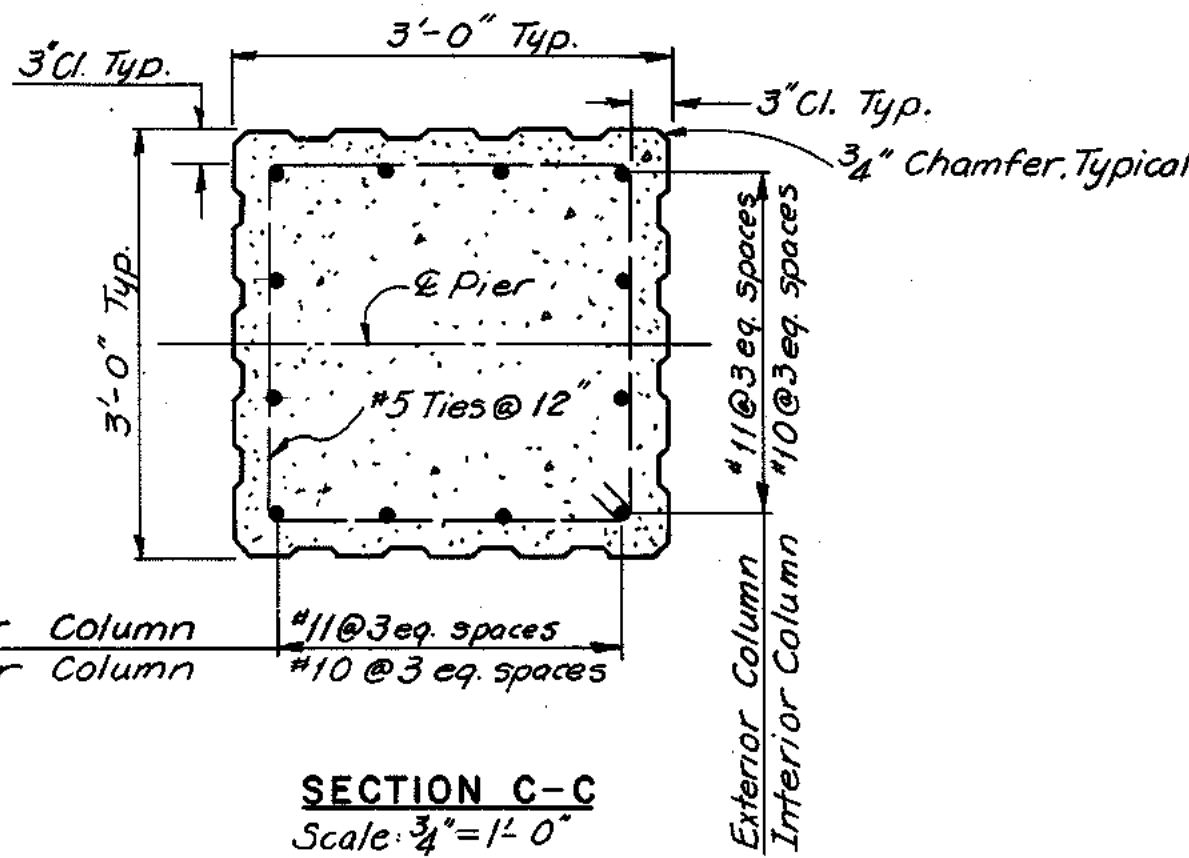

SECTION C-C  
Scale: 1/4" = 1'-0"

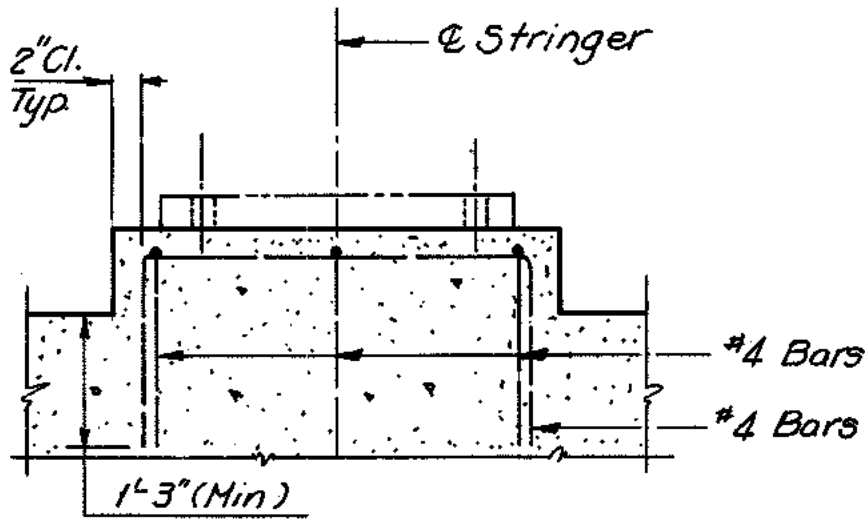

SECTION D-D  
Scale: 1" = 1'-0"

Notes:  
Footing elevations are approximate only and may be varied to suit field conditions as directed by the Engineer. Vertical shaft reinforcing shall not be cut until these elevations are established. Where elevations change more than 2 ft, redesign will be required. All piles shall be 10 BP42 (Des. cap. 45 T.).  
Pad reinforcing is required in S3 through S5 and S9 through S11 only.



MADE	BY	DATE	NO.	REVISION	BY	DATE
CHECKED	LCC	1-2-68				
IN CHARGE	AM	2-8-68				
	R. G. C.					

RICHMOND METROPOLITAN AUTHORITY			
RICHMOND EXPRESSWAY SYSTEM			
DOWNTOWN EXPRESSWAY			
BRIDGE NO. 36			
MAPLEWOOD AVENUE OVER			
DOWNTOWN EXPRESSWAY			
PIER			
HOWARD, NEEDLES, TAMMEN & BERGENDOFF			
consulting engineers			
NEW YORK ALEXANDRIA KANSAS CITY			
SCALE: As Noted			
CONTRACT NO. 7			
SHEET NO. 5 OF 10			


AS BUILT



RICHMOND EXPRESSWAY SYSTEM			
SECTION	PROJECT	SHEET NO.	TOTAL SHEETS
7	DOWNTOWN EXPRESSWAY	101	

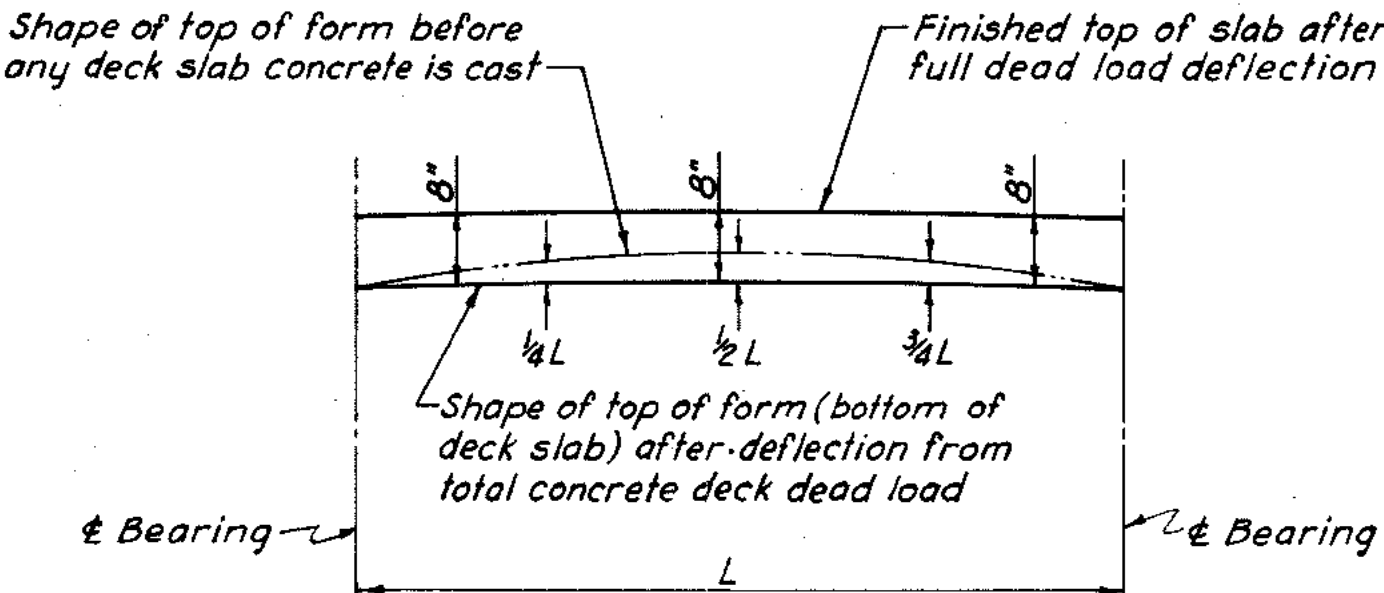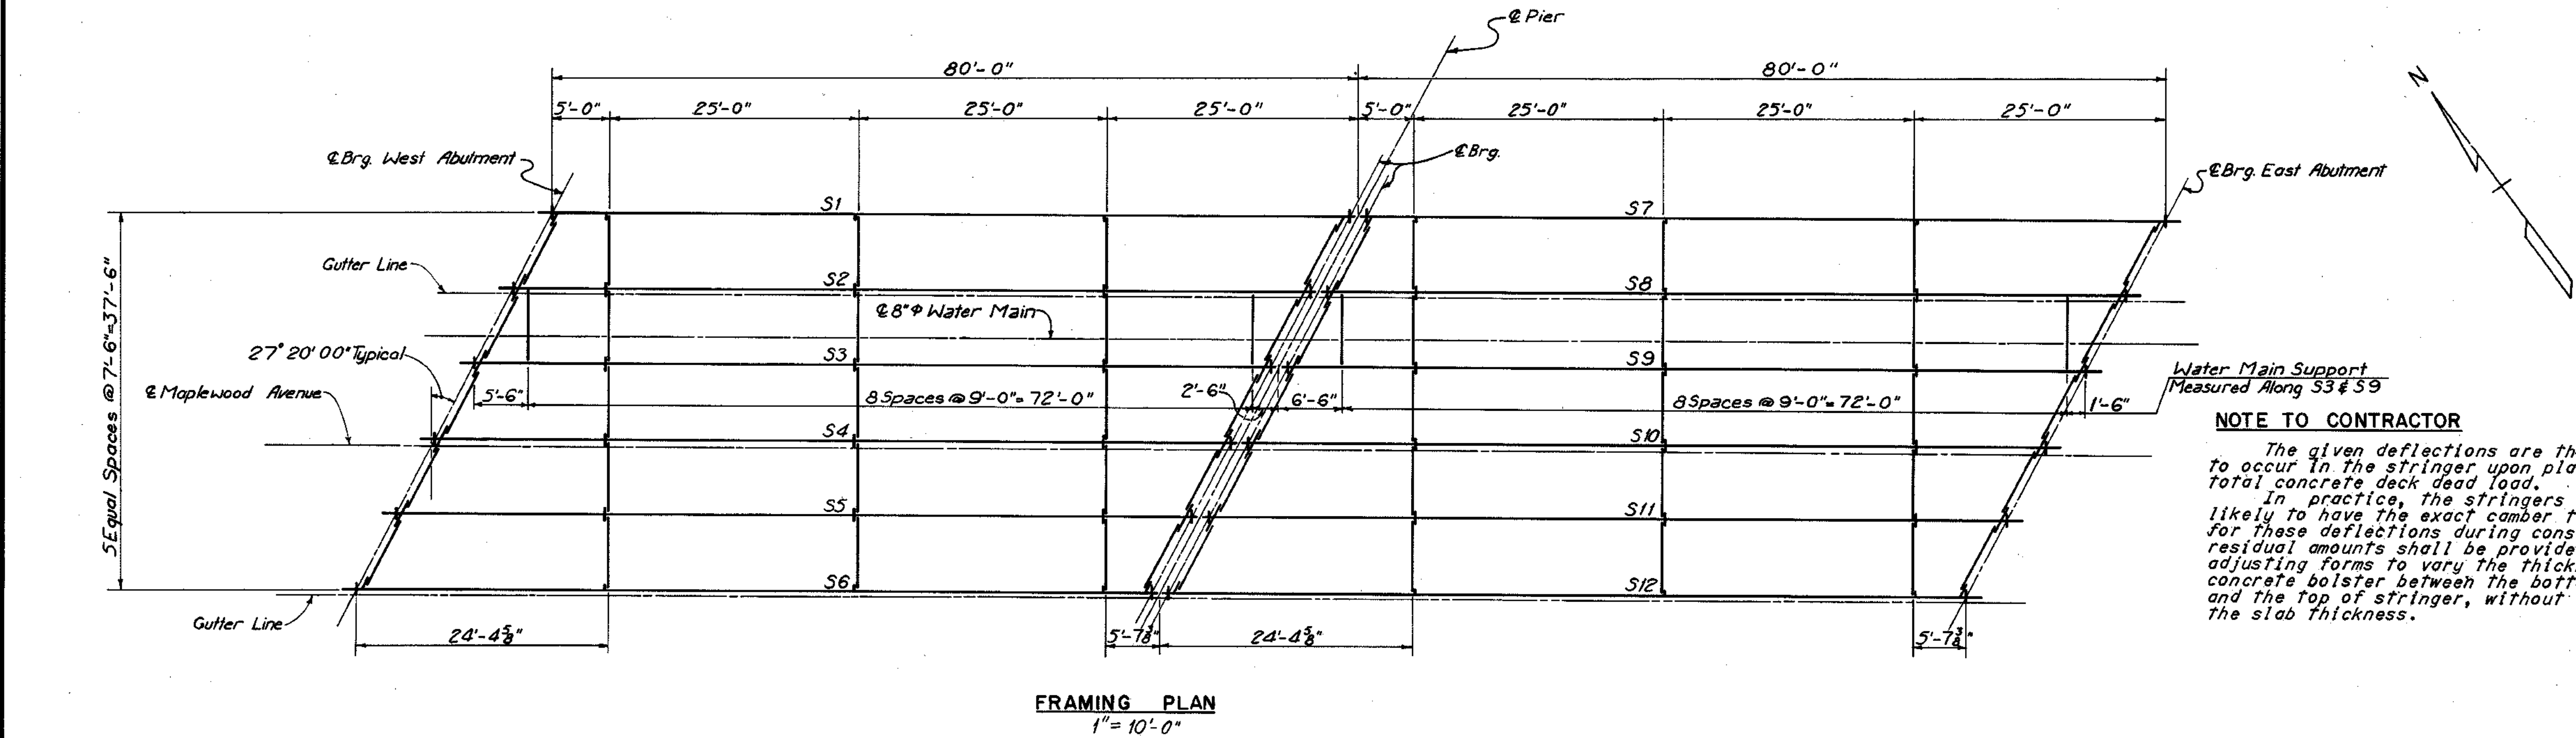

DEFLECTION SCHEDULE		
STRINGER	$\frac{1}{4}L$ & $\frac{3}{4}L$	$\frac{1}{2}L$
S1	1 9/16"	2 1/8"
S2	1 9/16"	1 9/16"
S3, S4 & S5	1 1/4"	1 3/4"
S6	1 3/8"	1 9/16"
S7	1 9/16"	2 1/8"
S8	1 9/16"	1 9/16"
S9, S10 & S11	1 1/4"	1 3/4"
S12	1 3/8"	1 9/16"






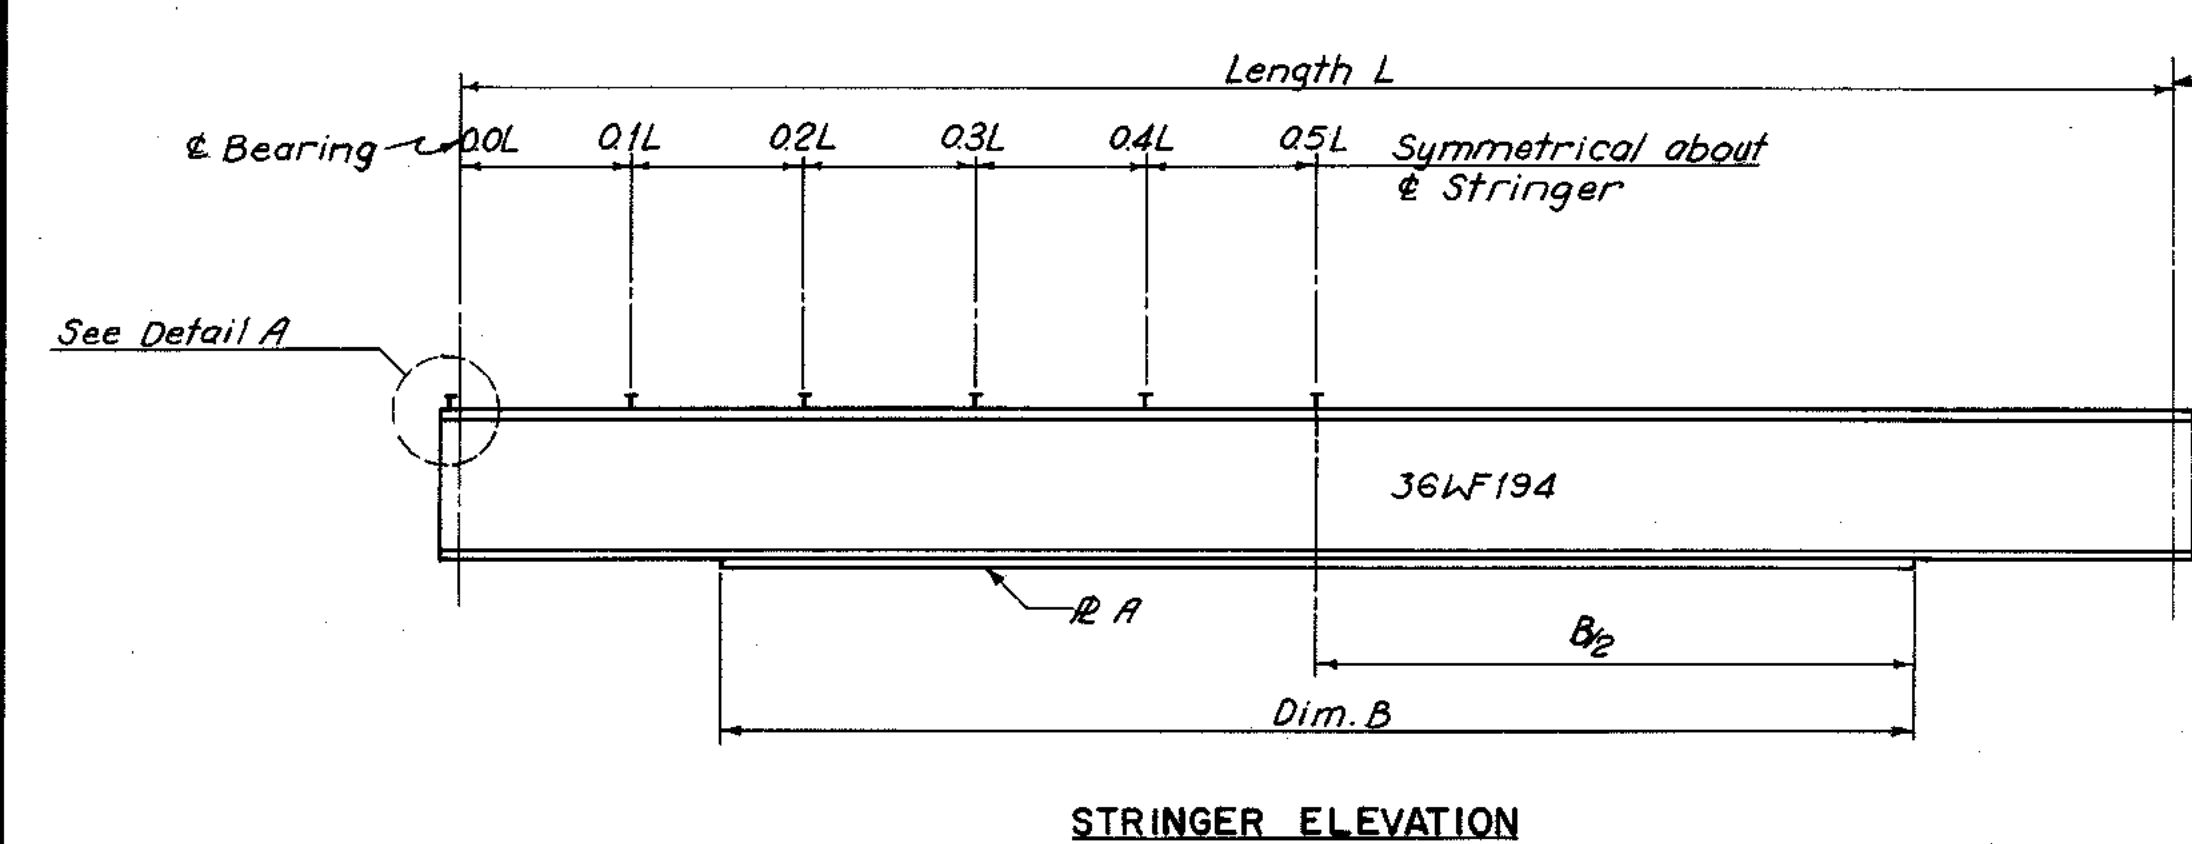


STRINGER SCHEDULE									
STRINGER	LENGTH @ BRG. TO @ BRG.	R A	DIM. B	SHEAR STUD SPACING					SHOE TYPE LT. END RT. END
S1	79'-1 1/8"	10 1/2" x 1 5/8"	60'	12"	15"	20"	24"	24"	E3 F12M
S2	79'-1 1/8"	10 1/2" x 2"	68'	8"	9"	11"	14"	18"	E3 F12
S3, S4 & S5	79'-1 1/8"	10 1/2" x 1 5/8"	64'	9"	11"	13"	15"	20"	E3 F12
S6	79'-1 1/8"	10 1/2" x 1 5/8"	64'	9"	11"	13"	15"	20"	E3 F12M
S7	79'-1 1/8"	10 1/2" x 1 5/8"	60'	12"	15"	20"	24"	24"	F12M E3
S8	79'-1 1/8"	10 1/2" x 2"	68'	8"	9"	11"	14"	18"	F12 E3
S9, S10 & S11	79'-1 1/8"	10 1/2" x 1 5/8"	64'	9"	11"	13"	15"	20"	F12 E3
S12	79'-1 1/8"	10 1/2" x 1 5/8"	64'	9"	11"	13"	15"	20"	F12M E3

\* Denotes spacing which begins at termination of 5 spaces at 6".

#### SHEAR STUD NOTES

Stud rows shall be placed parallel to the main deck reinforcing. Shear stud spacing shown is maximum spacing.

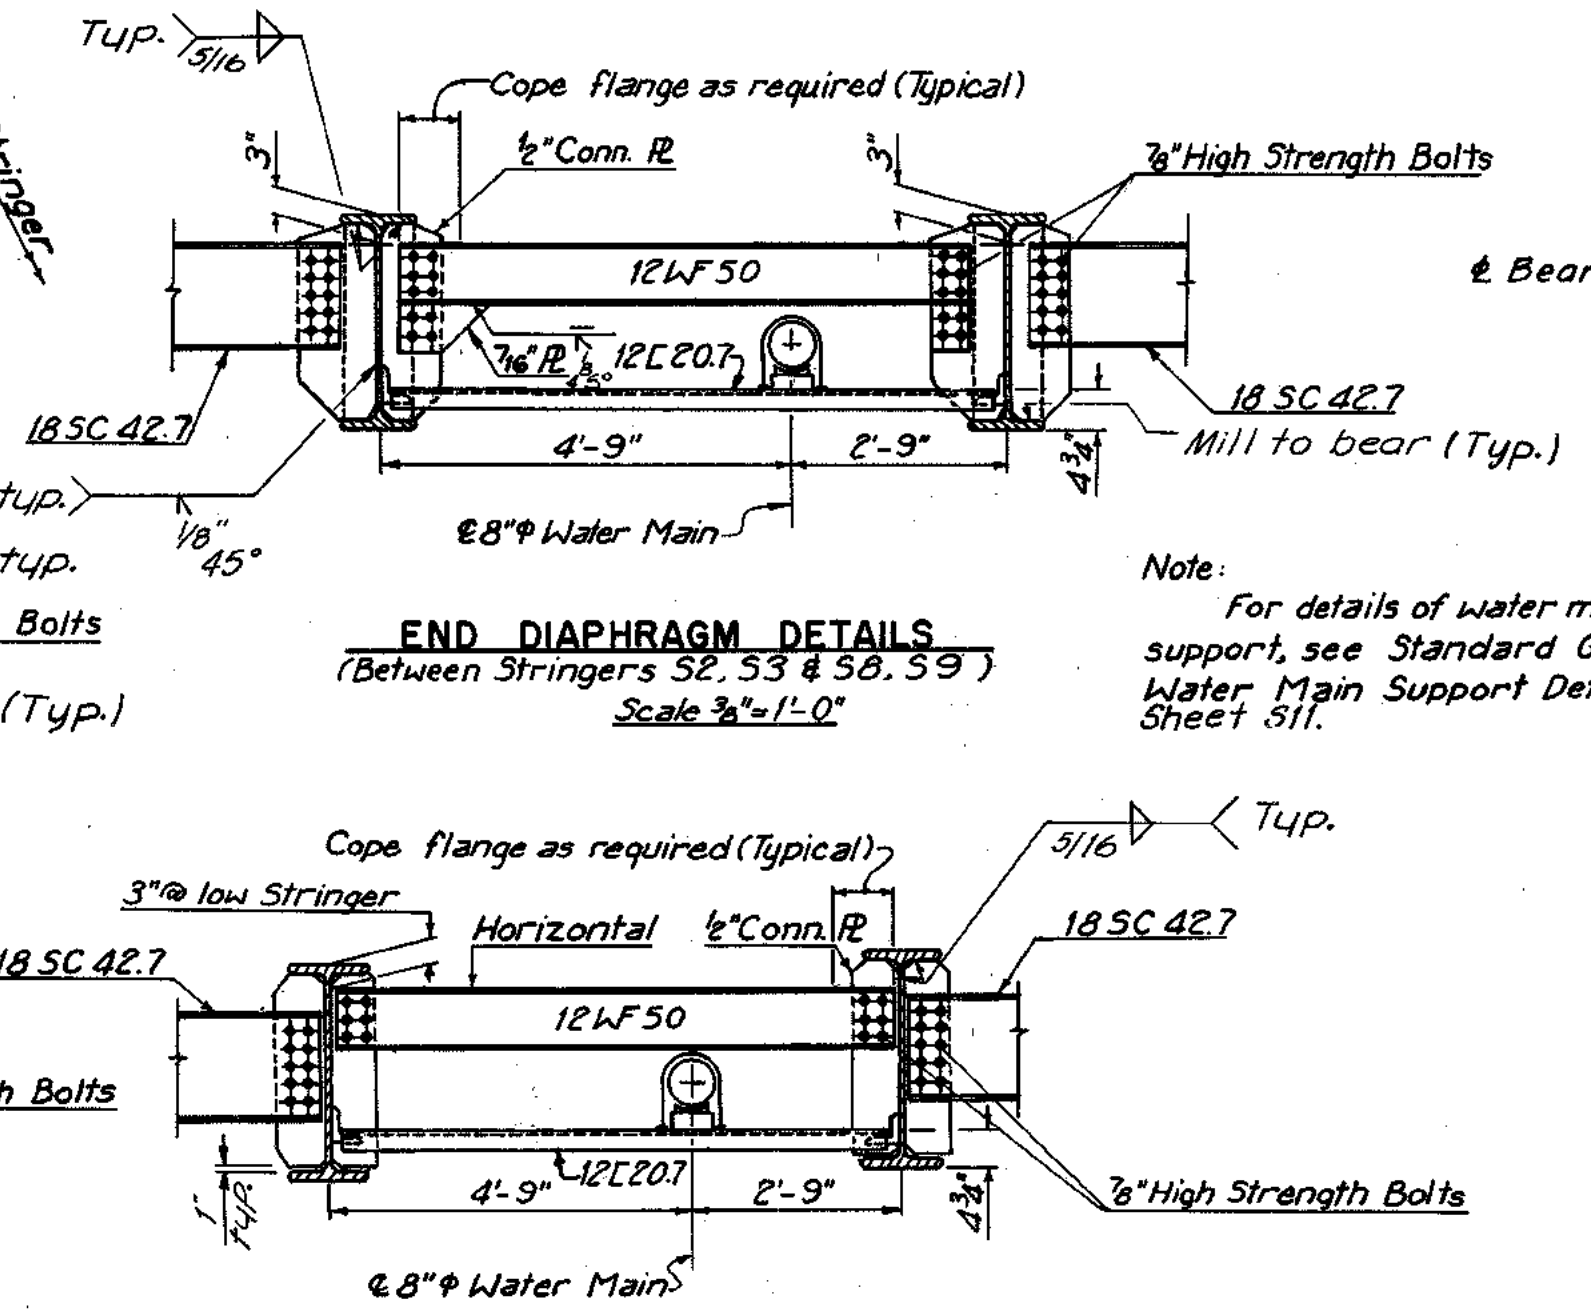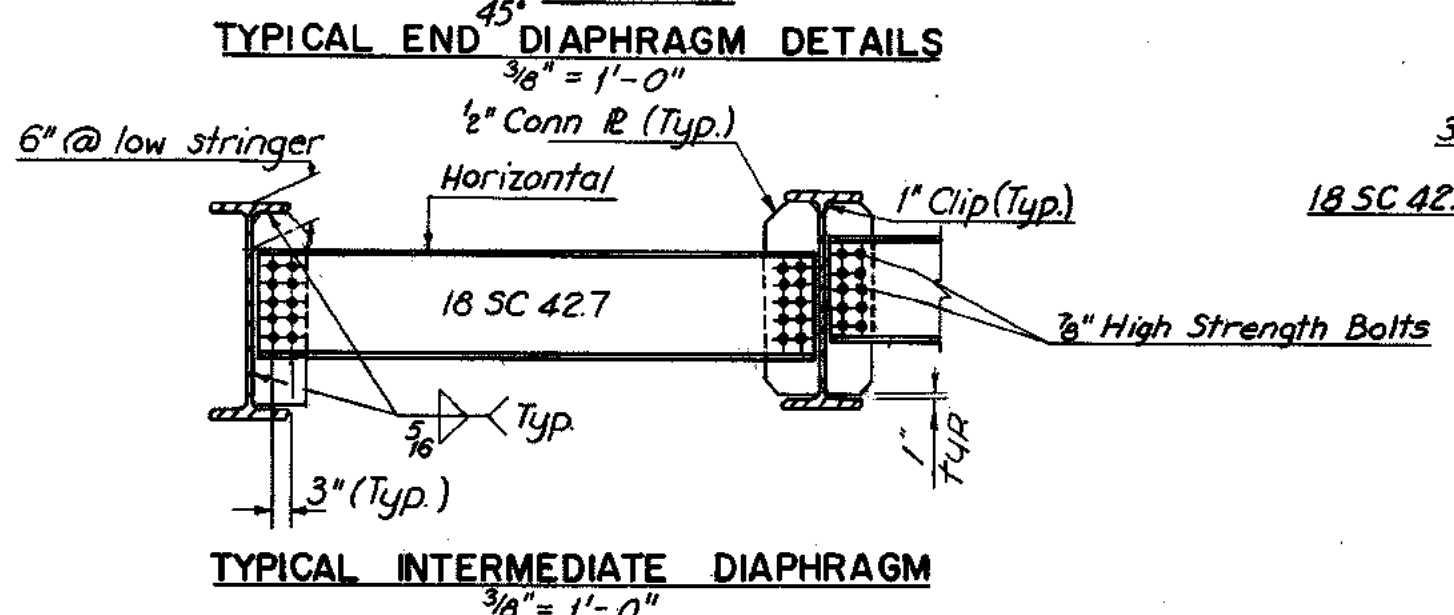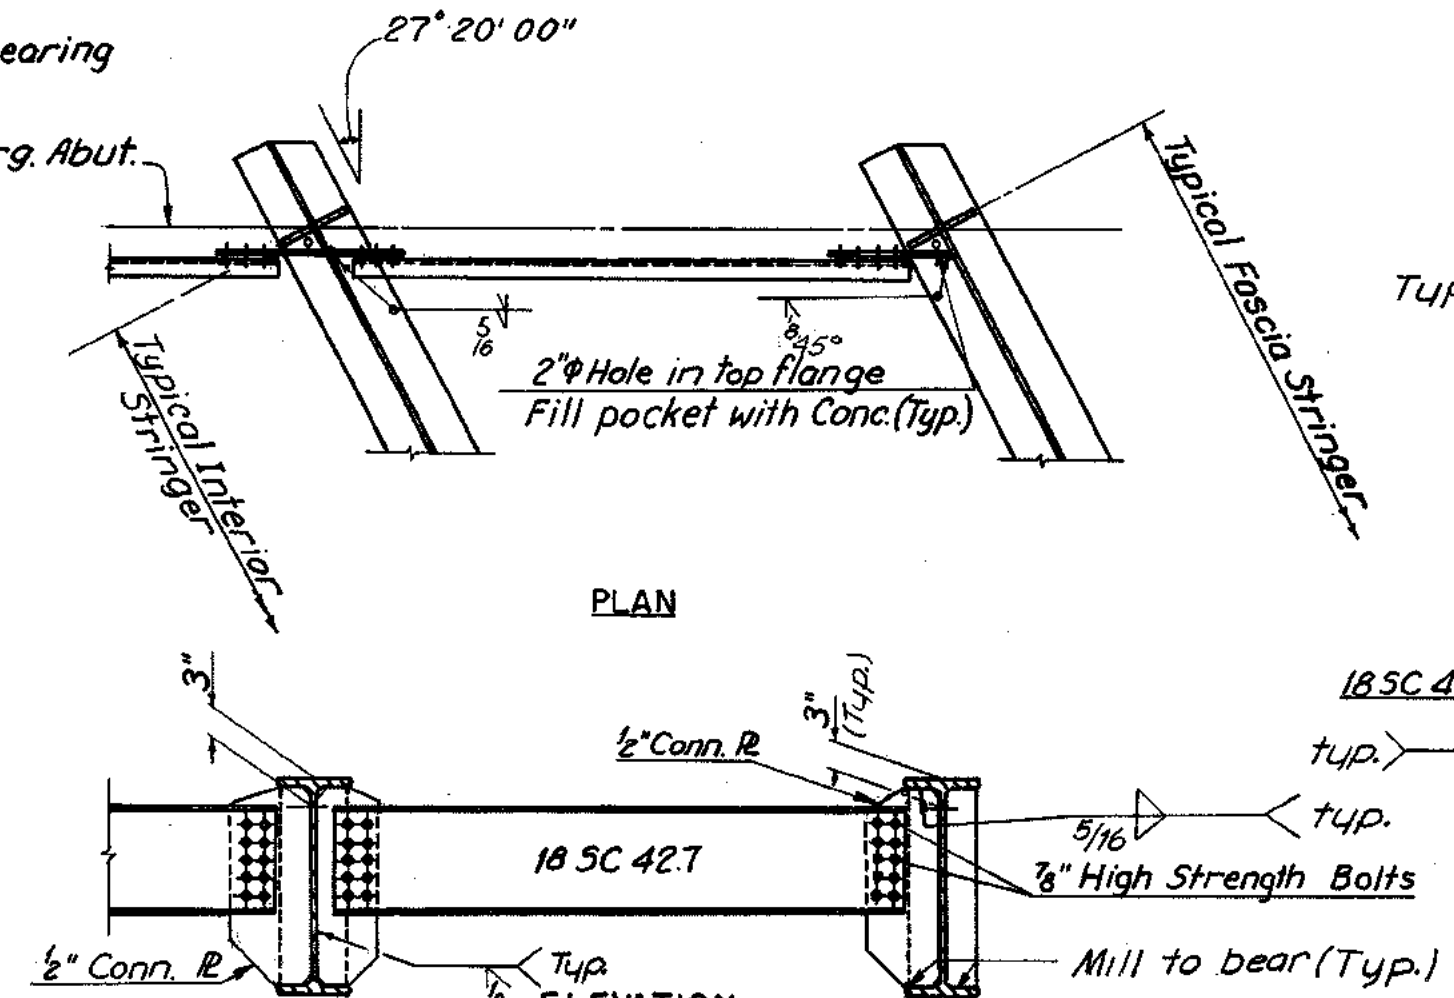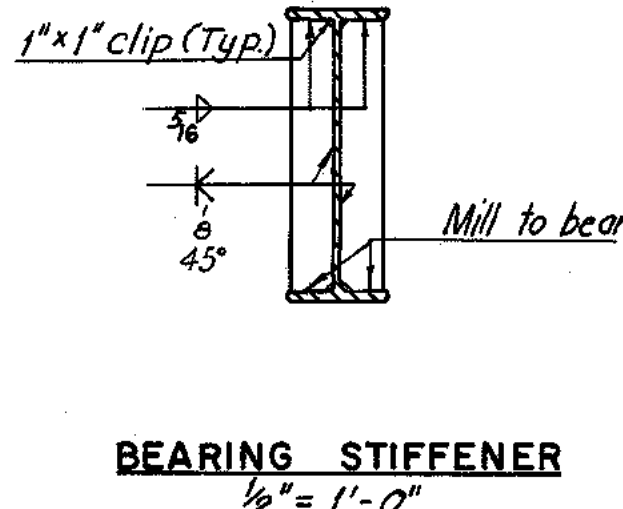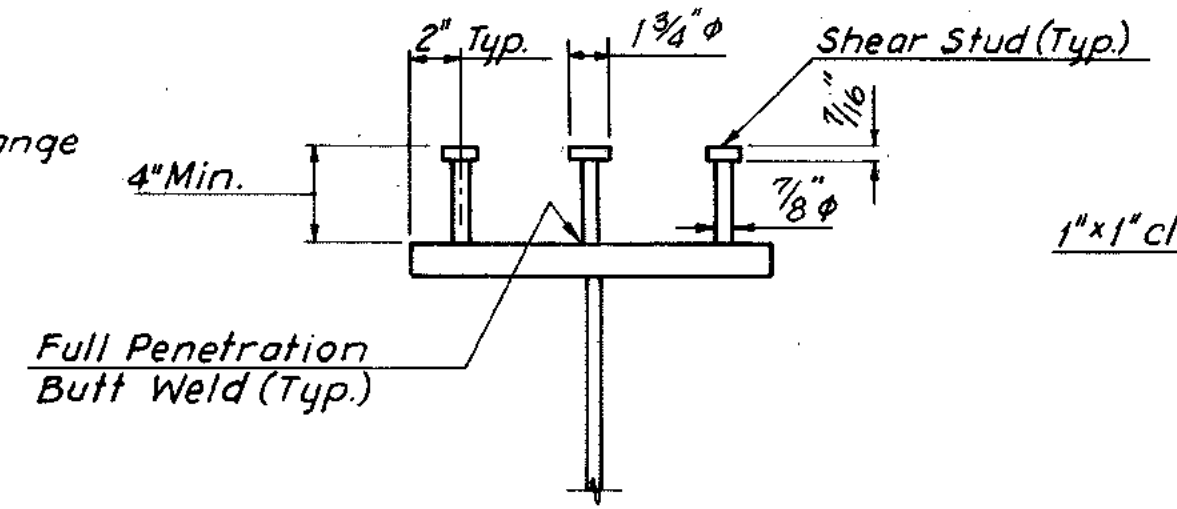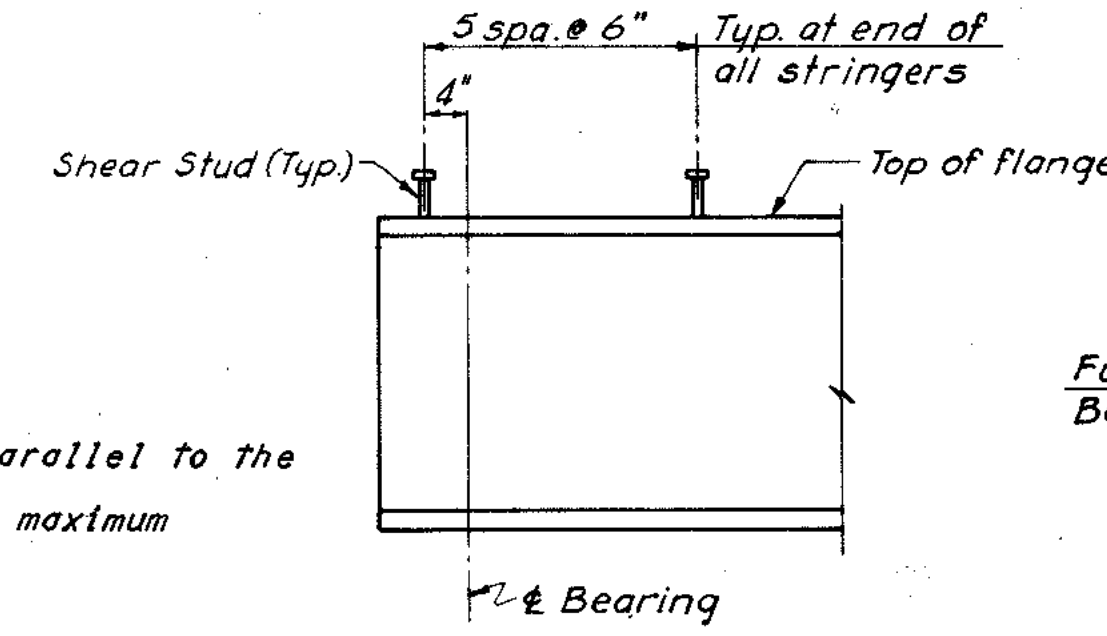

CAMBER SCHEDULE		
STRINGER	$\frac{1}{4}L$ & $\frac{3}{4}L$	$\frac{1}{2}L$
S1	2 1/8"	2 3/8"
S2	1 3/8"	2 9/16"
S3, S4 & S5	1 9/16"	2 11/16"
S6	1 5/16"	2 11/16"
S7	2 1/8"	2 3/8"
S8	1 3/8"	2 9/16"
S9, S10 & S11	1 9/16"	2 11/16"
S12	1 5/16"	2 11/16"

**NOTE TO FABRICATOR**  
The above stringers shall be fabricated with an upward camber amounting to the tabulated value. This will provide approximate compensation for deflection under full dead load and for conformity with finished grade. Dimensions are in inches.


**RICHMOND METROPOLITAN AUTHORITY**  
**RICHMOND EXPRESSWAY SYSTEM**  
**DOWNTOWN EXPRESSWAY**  
**BRIDGE NO. 36**  
**MAPLEWOOD AVENUE OVER**  
**DOWNTOWN EXPRESSWAY**  
**FRAMING PLAN**

HOWARD, NEEDLES, TAMMEN & BERGENDOFF  
consulting engineers  
NEW YORK ALEXANDRIA KANSAS CITY

SCALE: As Shown  
CONTRACT NO.: 7  
SHEET NO.: 6 OF 10


**AS BUILT**

RICHMOND EXPRESSWAY SYSTEM			
SECTION	PROJECT	SHEET NO.	TOTAL SHEETS
7	DOWNTOWN EXPRESSWAY	102	

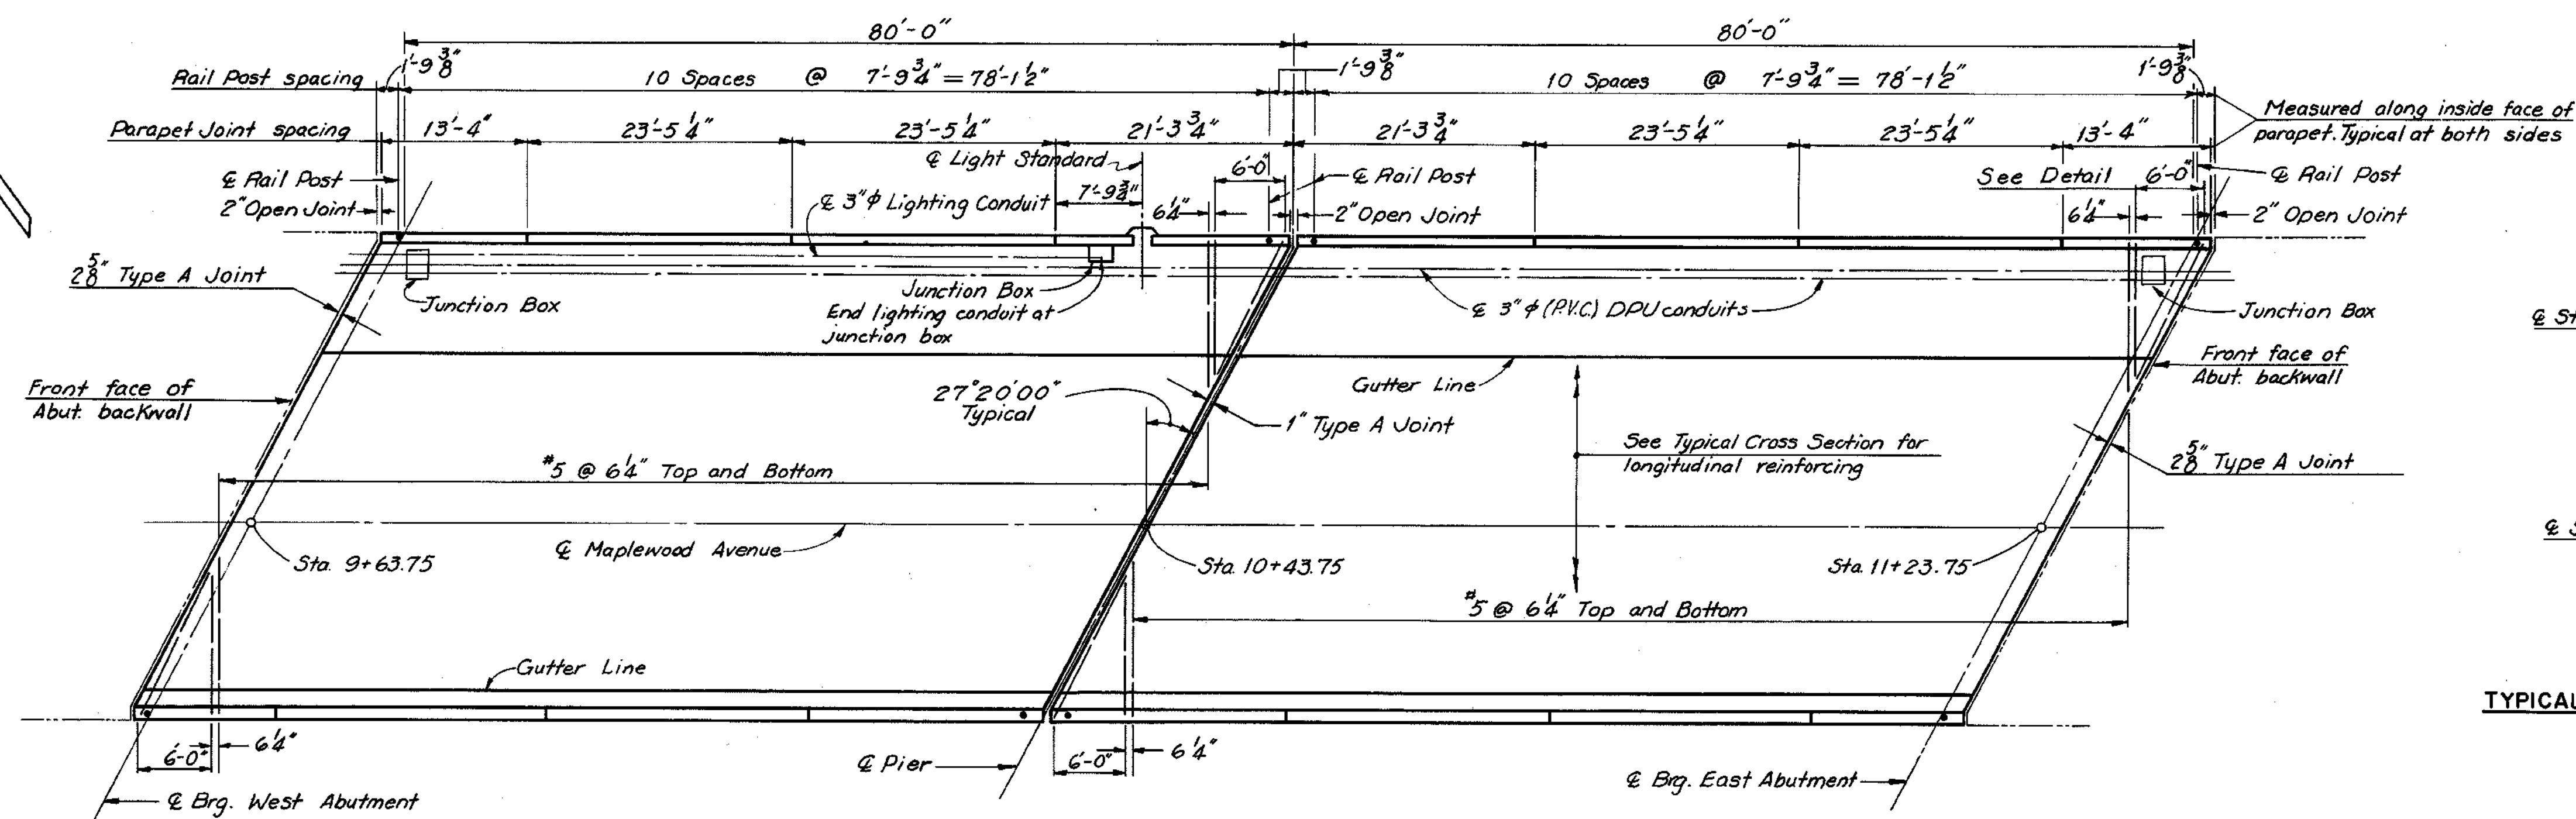


DECK PLAN  
1" = 10'


3 Junction Boxes  
2 each 2'-0" x 1'-11"  
1 each 2'-0" x 1'-1 1/2"

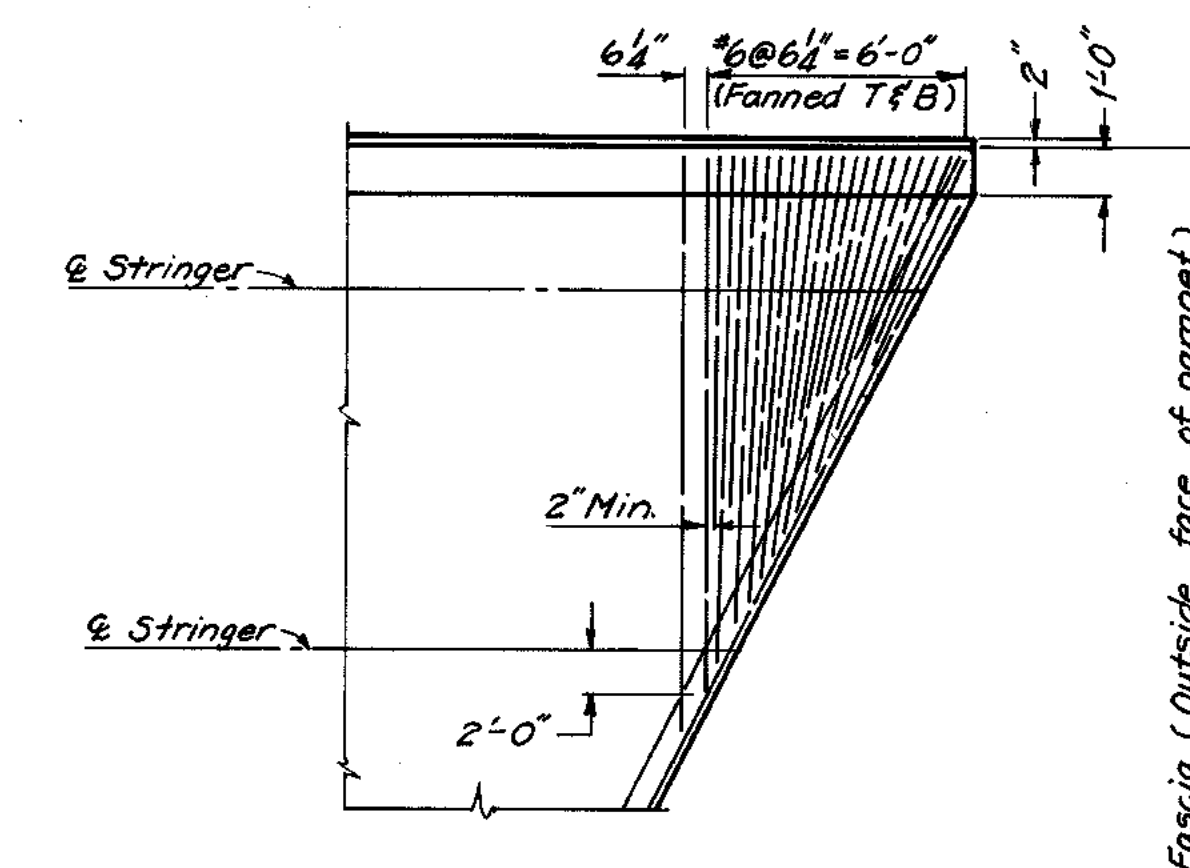

TYPICAL ACUTE CORNER REINFORCING DETAIL  
No Scale

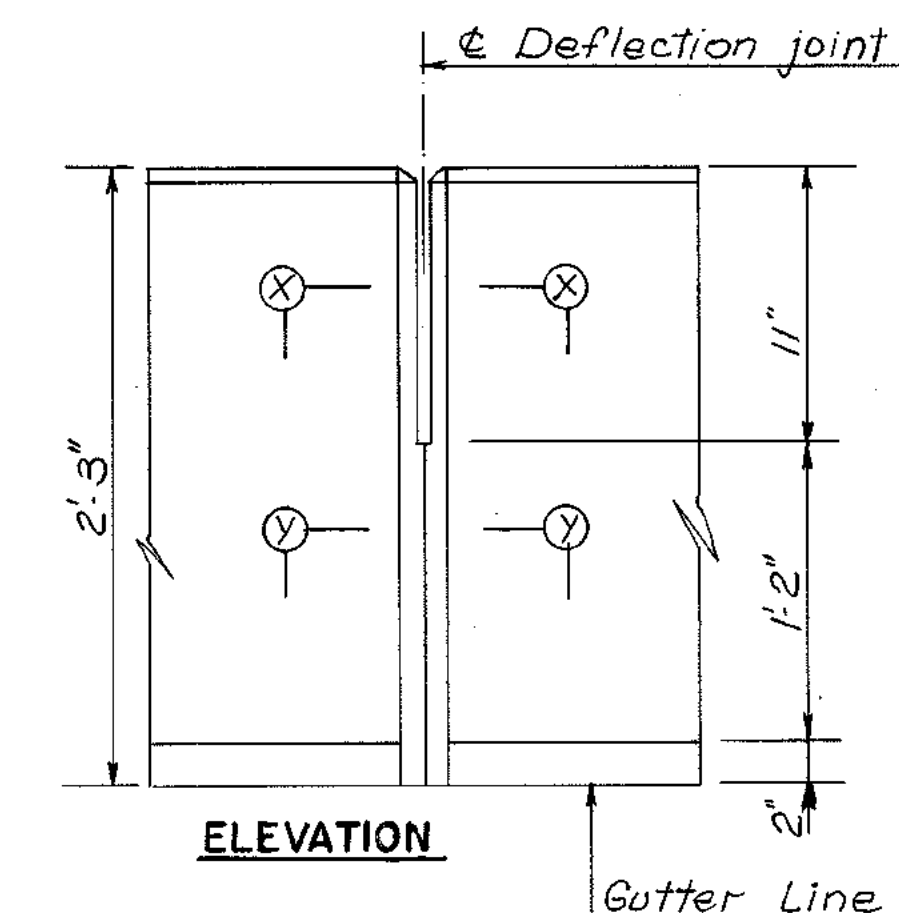


ELEVATION

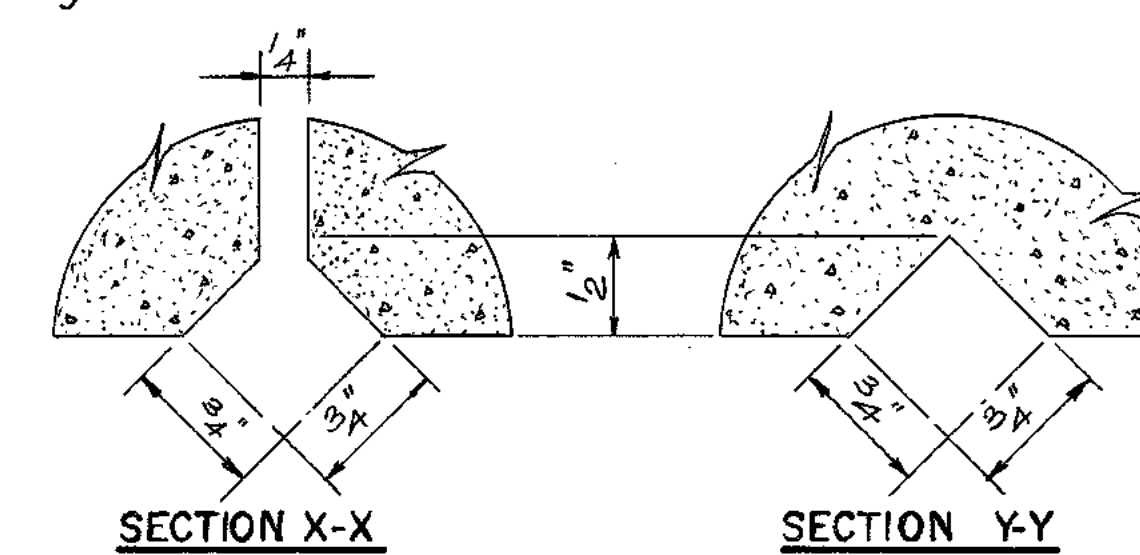

PARAPET DEFLECTION JOINT DETAILS

ROADWAY ELEVATIONS			
LOCATION	ELEV. A	ELEV. B	ELEV. C
Front Face W. Abut. BKwall	218.89	218.93	218.47
1/4 Point	219.32	219.41	219.00
1/2 Point	219.62	219.76	219.40
3/4 Point	219.80	219.98	219.67
Center Line Pier	219.86	220.08	219.82
1/4 Point	219.78	220.06	219.84
1/2 Point	219.59	219.91	219.74
3/4 Point	219.27	219.64	219.51
Front Face E. Abut. BKwall	218.82	219.24	219.16

Notes:  
Minimum splice length for #4 bar is 1'-3" and #5 bar is 1'-7".  
For details of water main support, see Standard Gas and Water Main Support Details Sheet S11.  
For Lighting details and DPU conduit details, see Standard Electrical Details (Bridge Carrying City Street) Sheet S4.

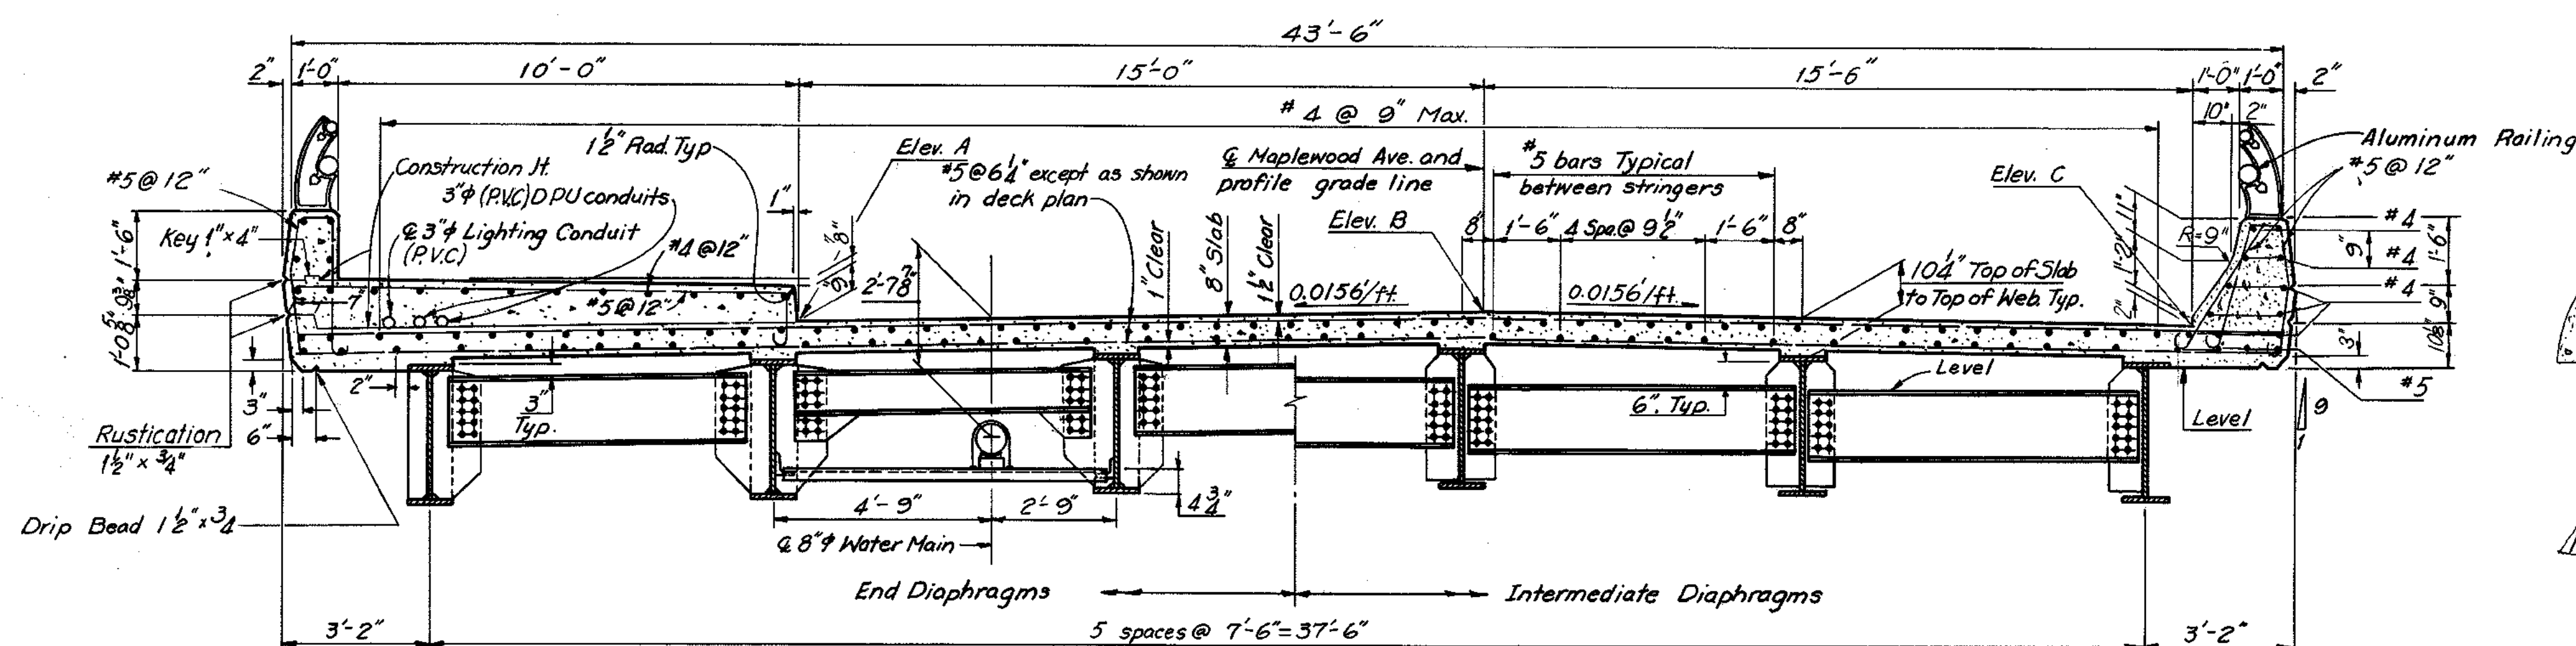

TYPICAL CROSS SECTION  
3/8" = 1'-0"

BY	DATE	REVISION	BY	DATE
MADE	LCC 11-14-67	2	As Built	TEM 9-75
CHECKED	Q.M. 2-9-68	1	PARAPET JOINT ADDED	TEM 7-74
IN CHARGE	R. G. C.			

RICHMOND METROPOLITAN AUTHORITY  
RICHMOND EXPRESSWAY SYSTEM  
DOWNTOWN EXPRESSWAY

BRIDGE NO. 36  
MAPLEWOOD AVENUE OVER  
DOWNTOWN EXPRESSWAY

DECK PLAN AND CROSS SECTION

HOWARD, NEEDLES, TAMMEN & BERGENDOFF  
consulting engineers  
NEW YORK ALEXANDRIA KANSAS CITY  
SCALE: As Noted  
CONTRACT NO. 7  
SHEET NO. 7 OF 10

AS BUILT



**Bridge 37**


**Grant Street  
Over**

**The Connector to Downtown Expressway (VA 146)**


**Record Set Plans**



RICHMOND EXPRESSWAY SYSTEM			
SECTION	PROJECT	SHEET NO.	TOTAL SHEETS
7	DOWNTOWN EXPRESSWAY	106	

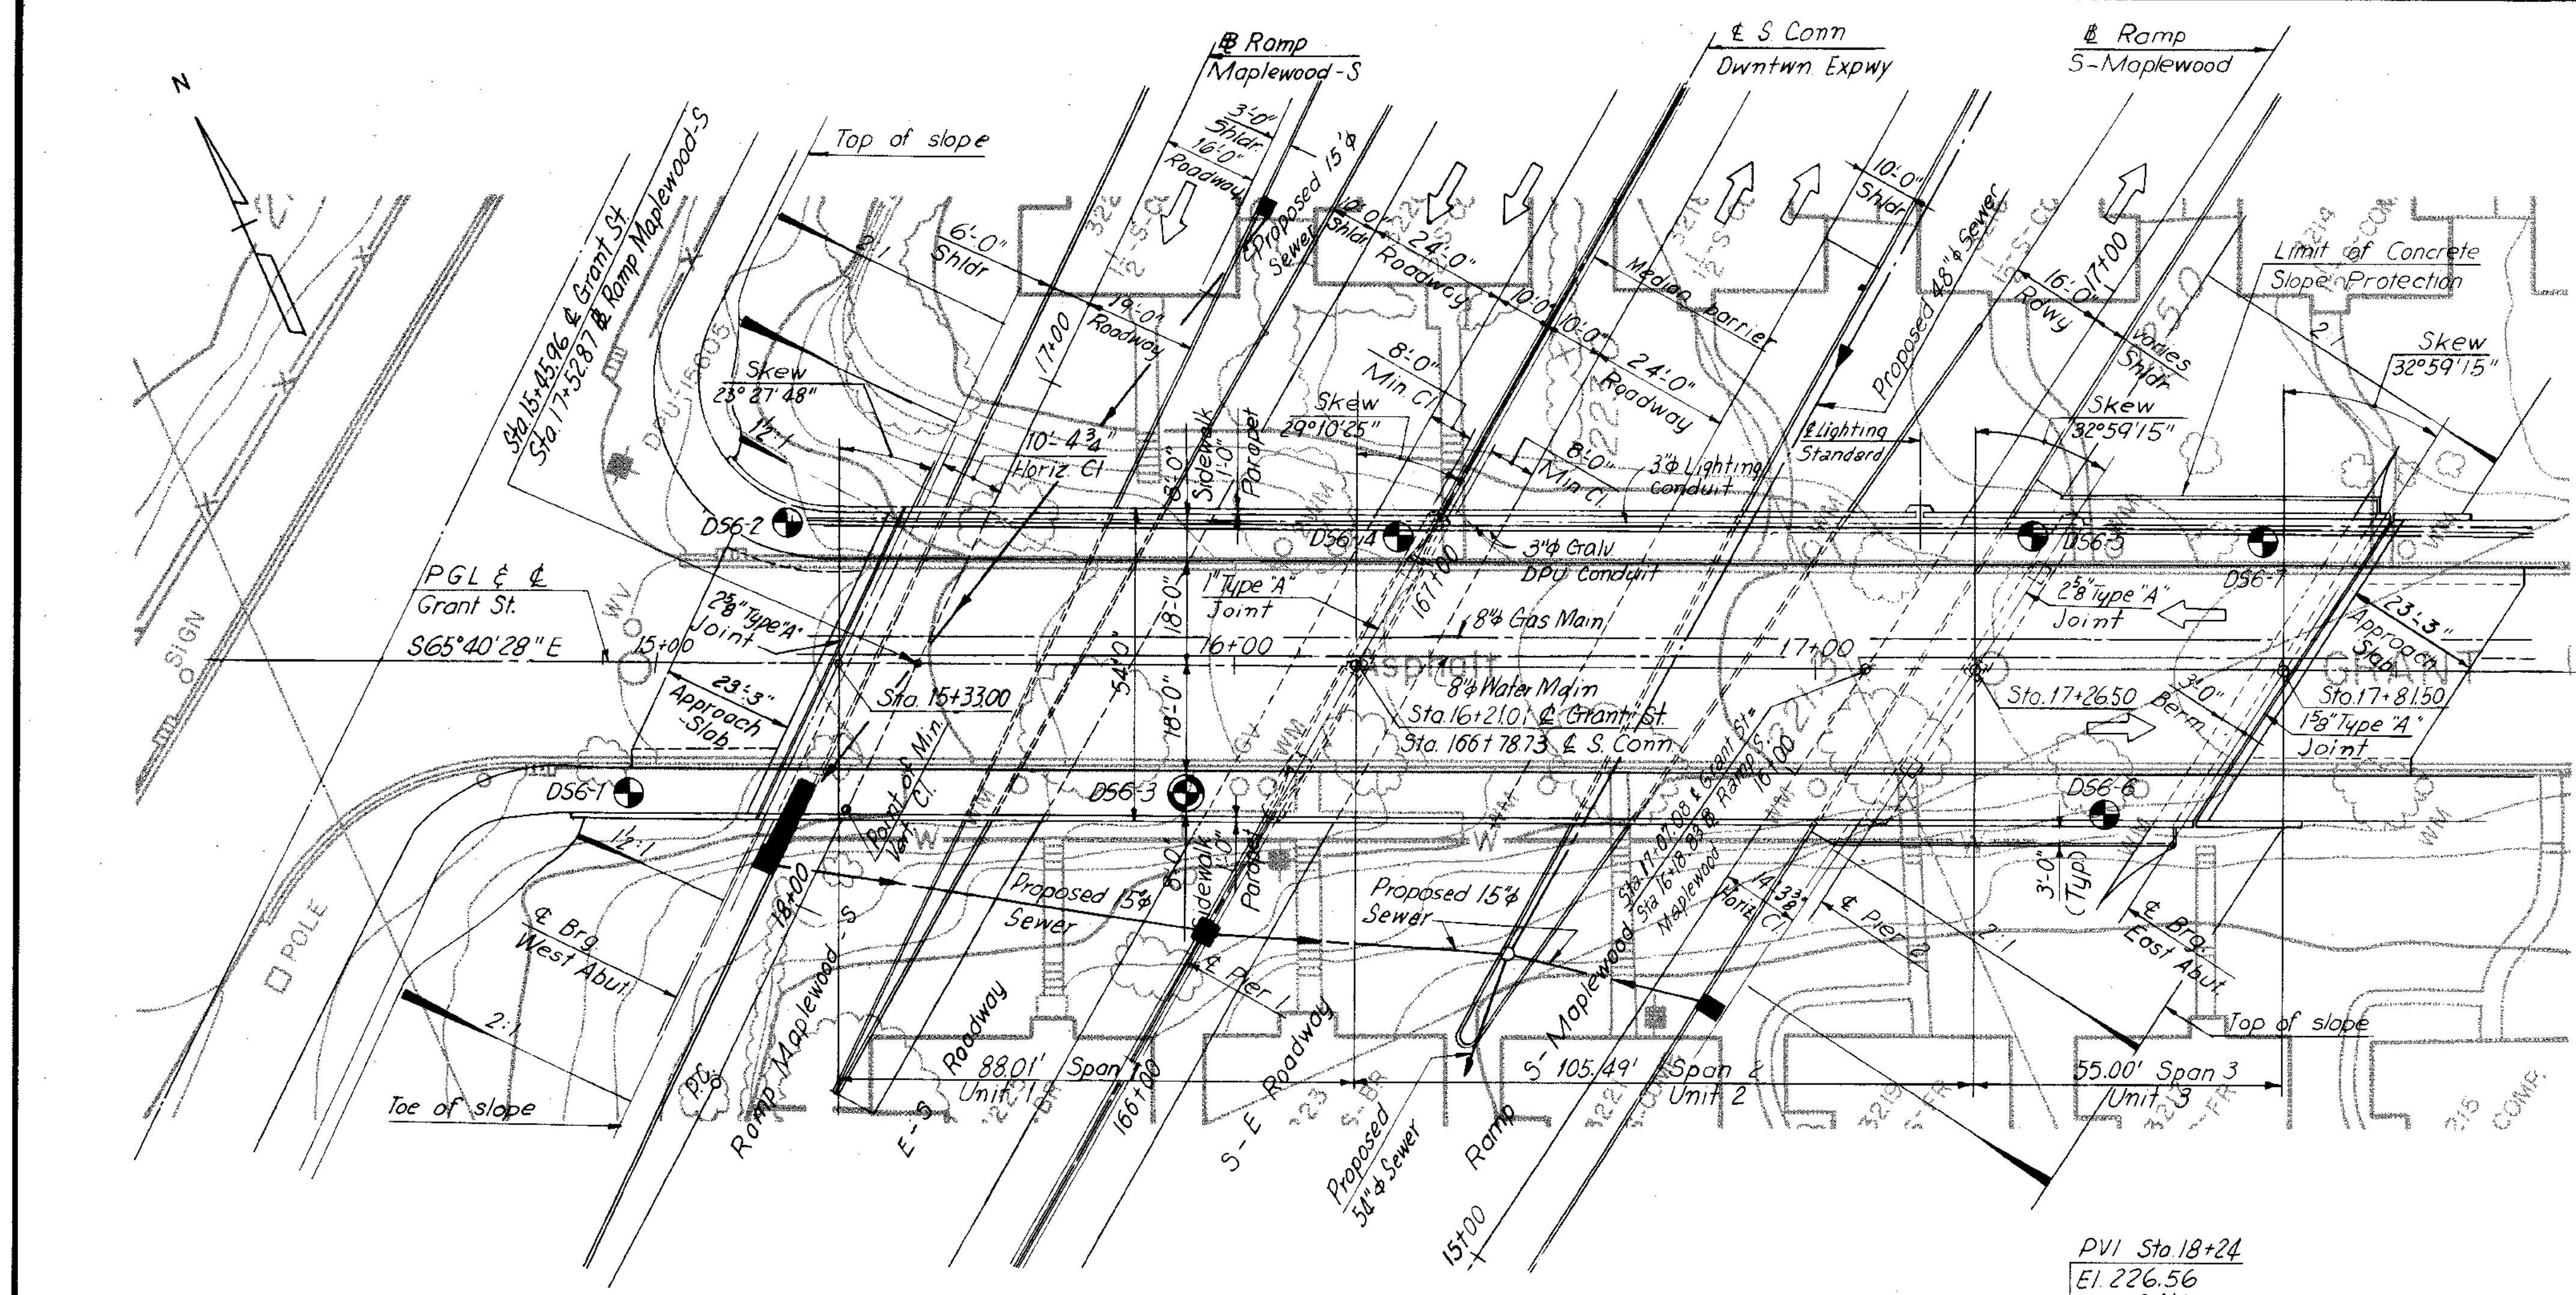

- GENERAL NOTES**
- ROADWAY:** One 36'-0" Clear roadway. Two 8'-0" sidewalks.
- CAPACITY:** Dead Load-Includes 15 lbs. per sq. ft. for future wearing surface. Live Loads-HS20-44 loading and B.P.R. modified for military vehicles.
- SPECIFICATIONS:**  
 GENERAL-Virginia Department of Highway Road and Bridge Specifications, 1970.  
 DESIGN-A.A.S.H.O. Standard Specifications for Highway Bridges, 1969 and 1970-72 Interim Specifications, modified by Special Provision.  
 WELDING-1972 Structural Welding Code of the American Welding Society
- CONTRACT SPECIAL PROVISIONS**  
 Specifications and Contract Special Provisions referred to above are necessary to make these plans complete.
- DATUM:** CITY OF RICHMOND
- TEMPERATURE:** The normal temperature referred to on the plan is 60° F. The temperature range for movement is 0° F. to 120° F.
- DIMENSIONS:** All dimensions are measured horizontally and vertically unless otherwise noted.
- EXCAVATION:** Excavation below subgrade and cut slope template shall be classified as Structure Excavation. All excavation above these limits shall be classified as Regular Excavation and is not included in the Structural Quantities.
- FOUNDATIONS:** Footings shall rest on firm material. Found. mat'l. shall be kept dry & special attn. is called to Sec. 401.05 of the Gen. Specs. & to the Contract Special Prov. concerning preparation of found. for ftgs.
- CONCRETE NOTES:**  
 Concrete in superstructure shall be Class A4. All other concrete shall be Class A3. All exposed edges and corners shall have a 3" chamfer or fillet unless otherwise noted. Care in the method of vibration, the use of low-slump concrete, and/or other means shall be employed to prevent downgrade movement of newly placed slab concrete. (When gradient is over 2%).
- Finishing concrete surfaces: See The Standard Architectural Detail Sheets and the Contract Special Provisions for types and details.
- STEEL**  
 All reinforcing steel shall be intermediate grade. All reinforcing bar dimensions on the detailed drawings are to centers of bars unless otherwise noted. Clear distance between reinforcing steel and face of concrete shall be as noted on the plans. All bar laps shall be 30 diameters of the smaller diameter bar unless otherwise noted.
- NOTES:** Structural steel shall conform to A.S.T.M. Specification A36 except as noted.
- All field connections shall be made with high strength bolts. High strength bolts shall be 7/8" diameter unless otherwise noted and shall conform to A.S.T.M. Specification A-325. All shop welded web splices, flange splices and web to flange welds shall be made by the submerged arc process.
- BENCH MARK:**  
 B-13. Copper Weld Rod, N.E. corner of McCloy and Grant St. Elev. 204.98.  
 ⊕ Indicates 2 1/2" ø cased hole boring.  
 ⊗ Indicates 4" ø cased hole boring.

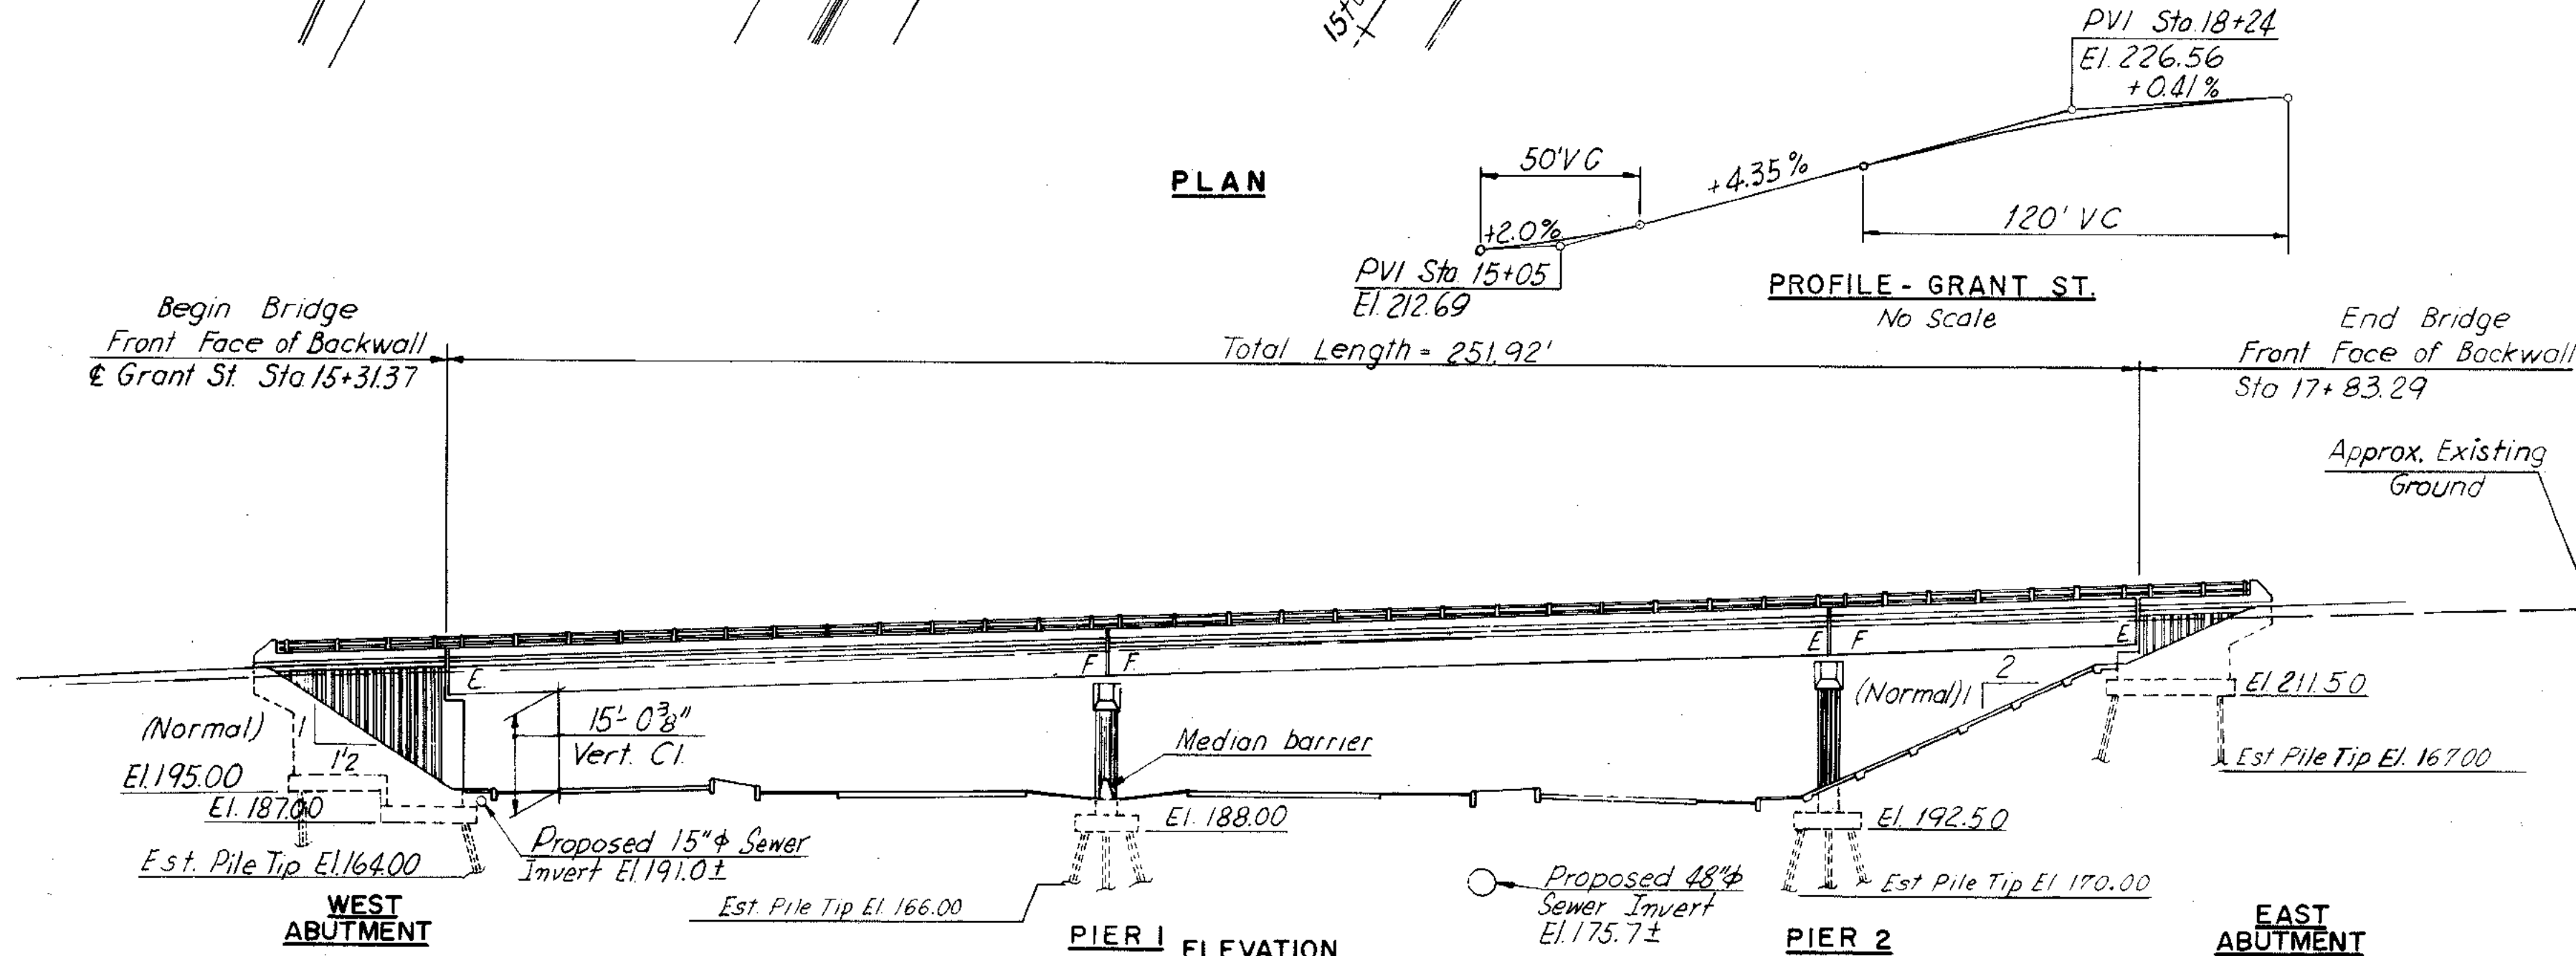

INDEX	
NO	DESCRIPTION
1	GENERAL PLAN AND ELEVATION
2 & 3	WEST ABUTMENT
4	EAST ABUTMENT
5	ABUTMENT DETAILS
6	PIER 1
7	PIER 2
8	FRAMING PLAN
9	DECK PLAN AND CROSS SECTION
10	JOINT DETAILS
11	APPROACH SLAB & SLOPE PROTECTION DETAILS
12 & 13	BORING LOGS
S1	STANDARD SHOE DETAILS
S3	STANDARD ALUMINUM RAILING DETAILS (2 RAIL)
S4	STANDARD ELECTRICAL DETAILS
S7-S9	STANDARD ARCHITECTURAL DETAILS
S11	STANDARD GAS & WATER MAIN SUPPORT DETAILS
S13	LIMITS OF EXCAVATION & BACKFILL

ESTIMATE OF QUANTITIES															
	STRUCTURE EXCAVATION C.Y.	CONCRETE			STRUCTURAL STEEL LBS.	ALUMINUM BR RAILING (2 RAIL ) L.F.	POROUS BACKFILL C.Y.	REINFORCING STEEL LBS.	STEEL PILES 10 BP 42 L.F.	CONC. SLAB SLOPE PROT. S.Y.	ASPHALT DAMP PROOFING S.Y.	UNDER DRAIN 6" PIPE L.F.	GAS MAIN 8" Ø L.F.	WATER MAIN 8" Ø L.F.	METAL CONDUIT L.F.
		CLASS A4 C.Y.	CLASS A3 C.Y.	CLASS A3 APPR. SLAB C.Y.											
SUPERSTRUCTURE		538.6			490,258	504		102,177					312	316	837
WEST ABUTMENT	777.4		395.0			60	130	82,554	1390.7	10.2	226	127			
EAST ABUTMENT	319.7		152.0			25	19	8,107	894.8	439.3	75	90			
PIER 1	131.7		123.2					24,147	561.6						
PIER 2	51.4		92.5					20,668	633.4						
APPROACH SLABS				97				28,426							
TOTAL	1280.2	538.6	762.7	97	490,258	589	149	216,079	3480.5	449.5	301	217	312	316	837

Notes:  
 The cost of furnishing and installing 2" ø and 3" ø galvanized steel conduit shall be included in the bid price for the item, Metal Conduit.

BY	DATE				
MADE	TCY 2/6/68				
CHECKED	ICH 2/29/68	As Built	TEM	9-75	
IN CHARGE	RGC	NO.	REVISION	BY	DATE

RICHMOND METROPOLITAN AUTHORITY  
RICHMOND EXPRESSWAY SYSTEM  
DOWNTOWN EXPRESSWAY

BRIDGE NO. 37  
GRANT STREET OVER SOUTH CONNECTION DOWNTOWN EXPRESSWAY  
GENERAL PLAN AND ELEVATION

HOWARD, NEEDLES, TAMMEN & BERGENDOFF  
consulting engineers  
NEW YORK ALEXANDRIA KANSAS CITY

SCALE: 1"=20'  
CONTRACT NO. 7  
SHEET NO. 1 OF 13


**AS BUILT**








RICHMOND EXPRESSWAY SYSTEM			
SECTION	PROJECT	SHEET NO.	TOTAL SHEETS
7	DOWNTOWN EXPRESSWAY	112	

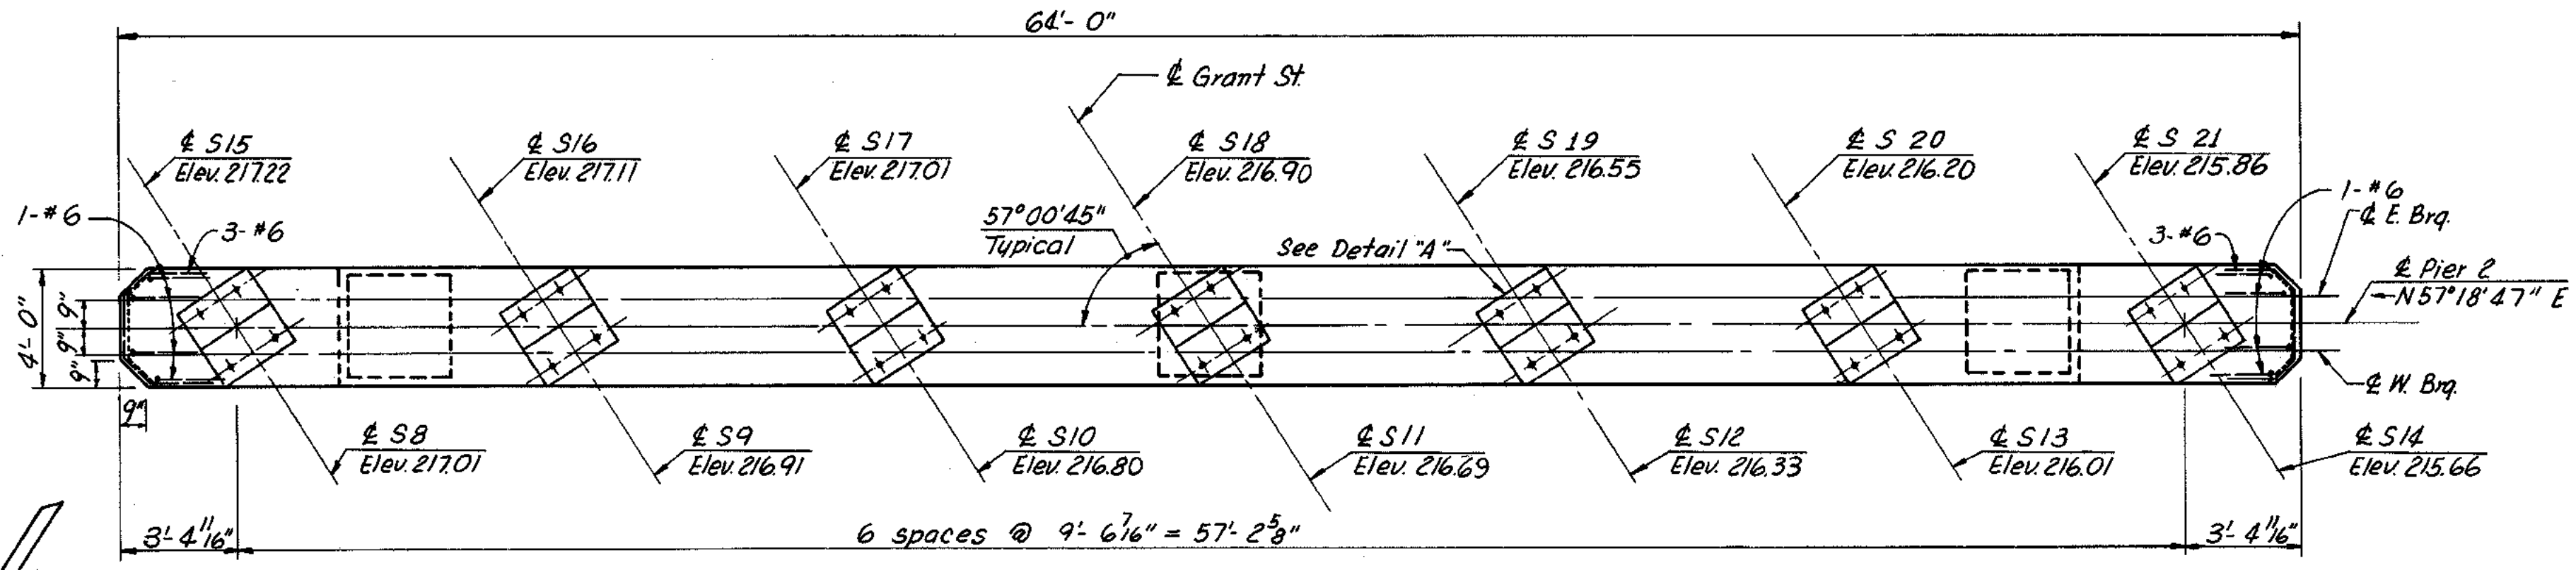


PLAN  
Scale: 1/4" = 1'-0"

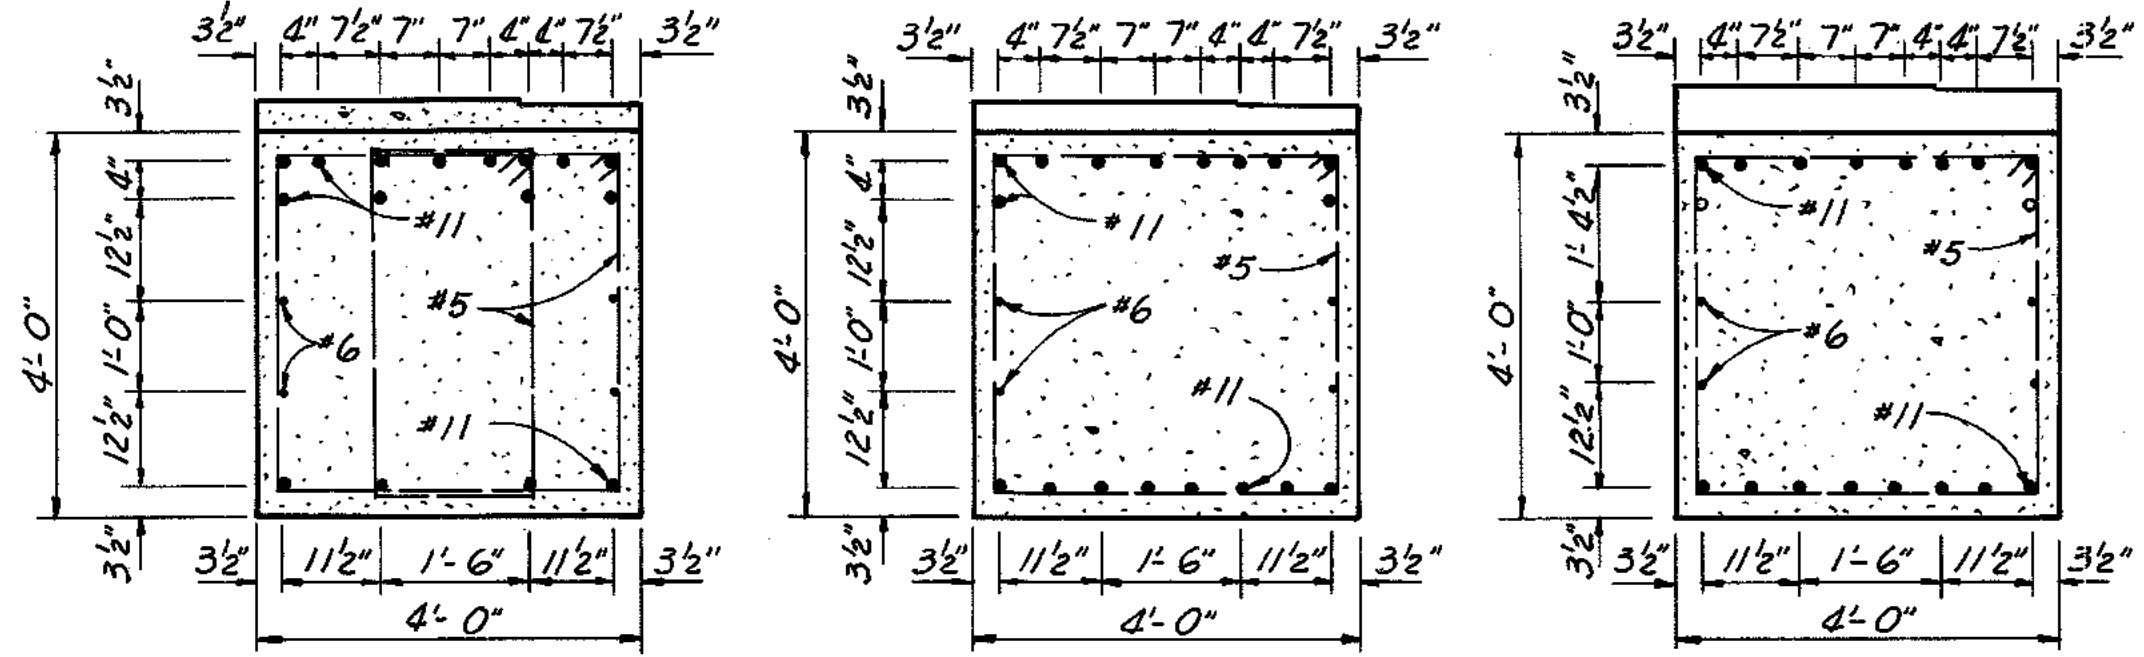


SECTION C-C  
Scale: 1/2" = 1'-0"

SECTION D-D  
Scale: 1/2" = 1'-0"


SECTION E-E  
Scale: 1/2" = 1'-0"

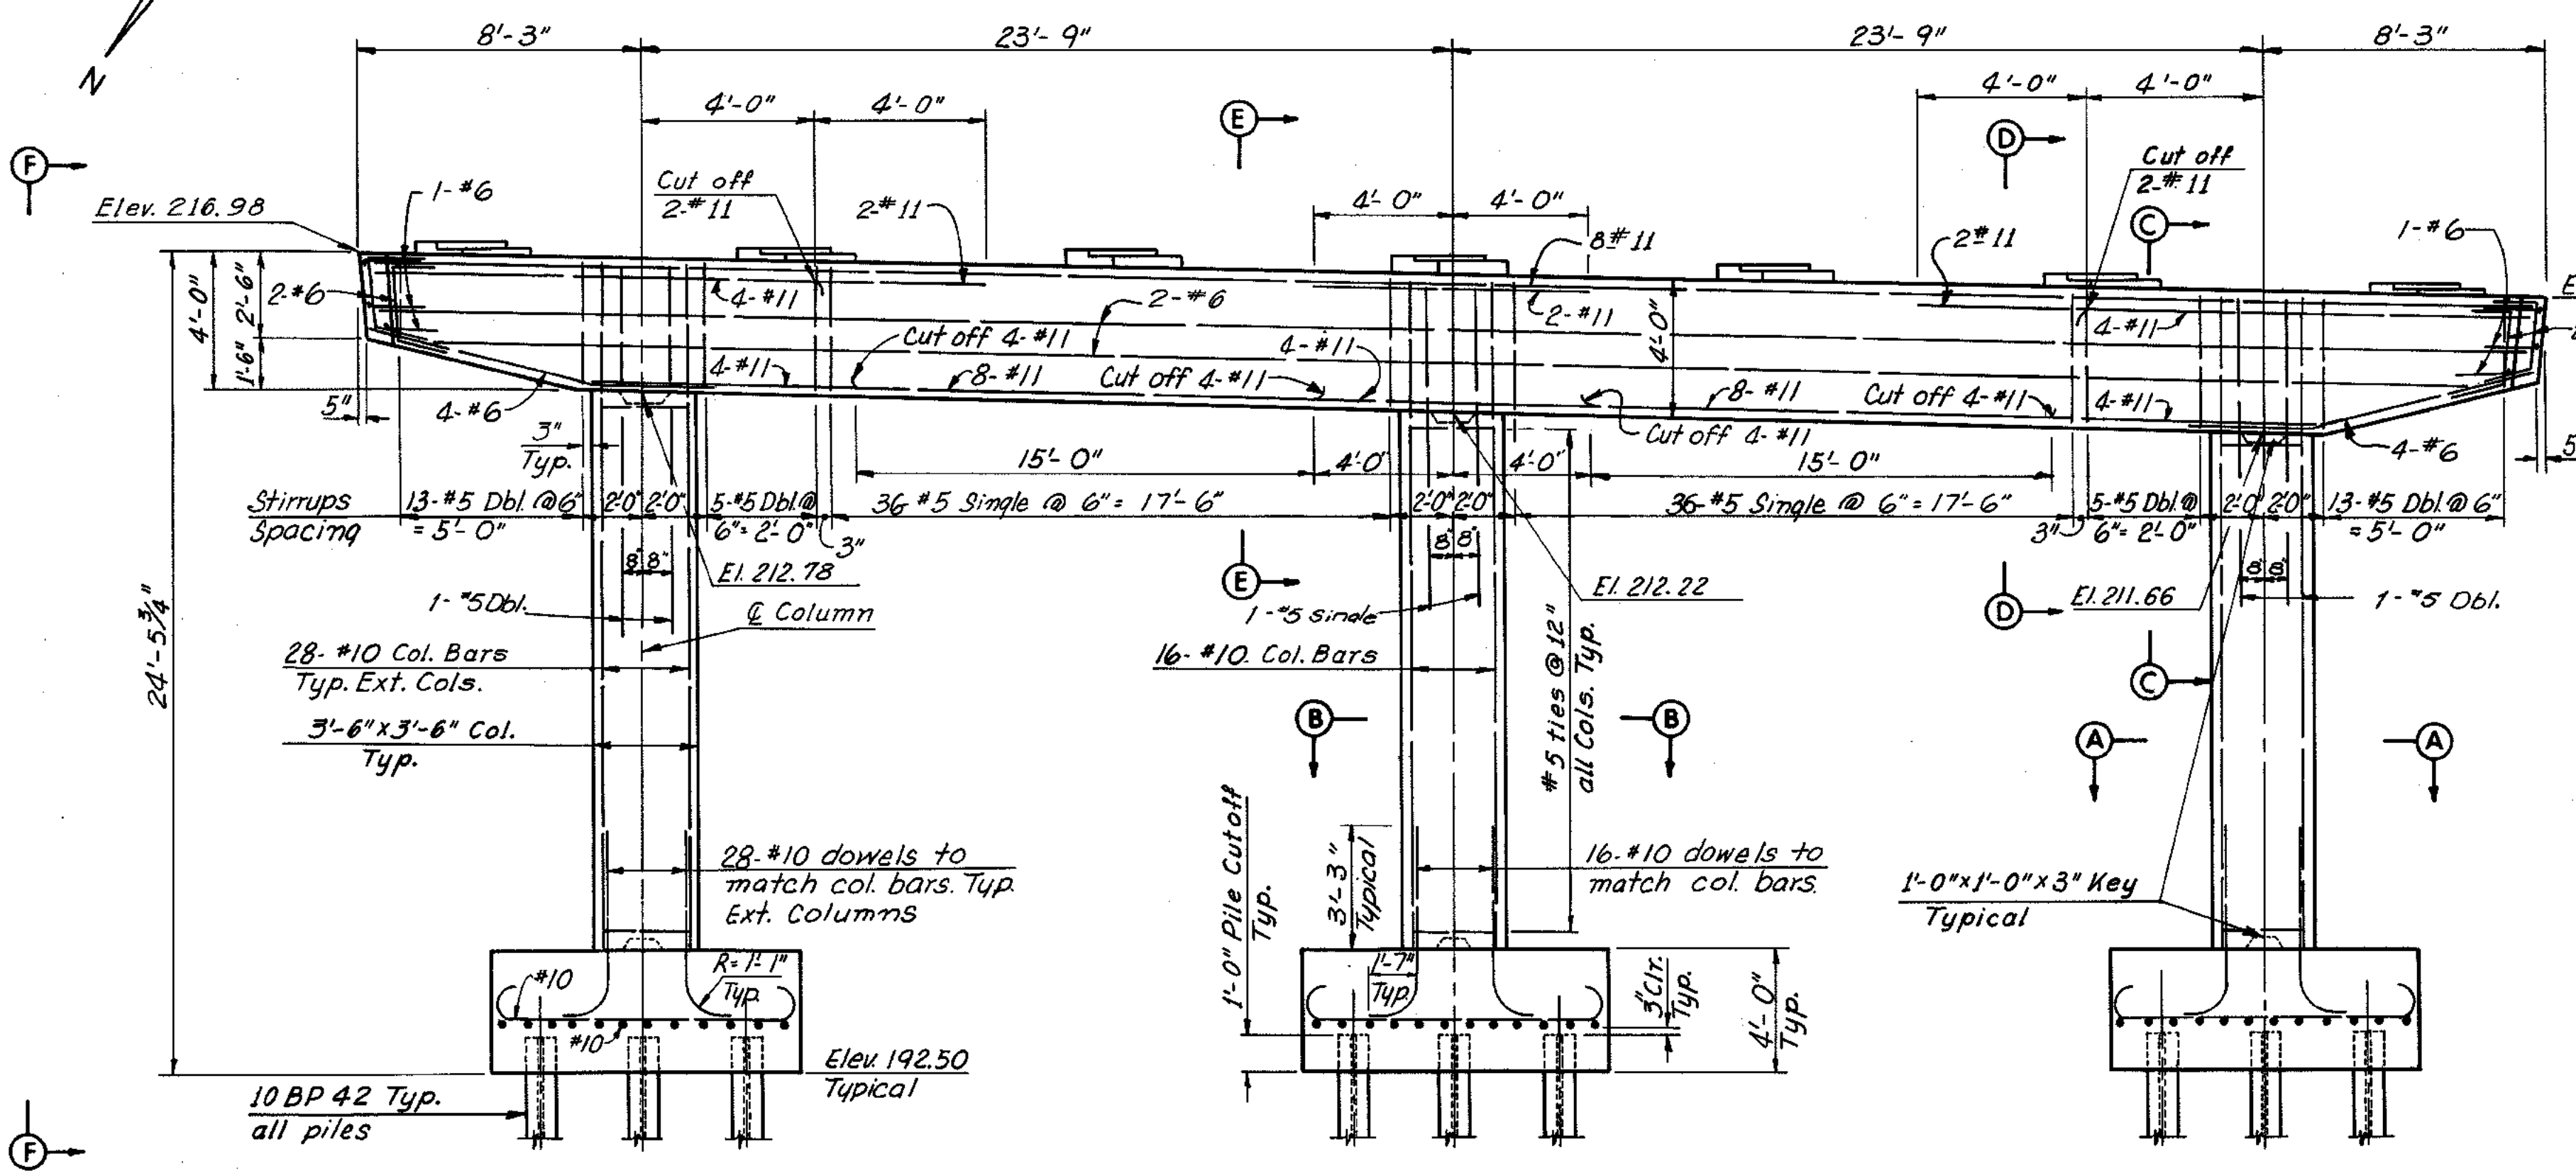


ELEVATION  
Scale: 1/4" = 1'-0"

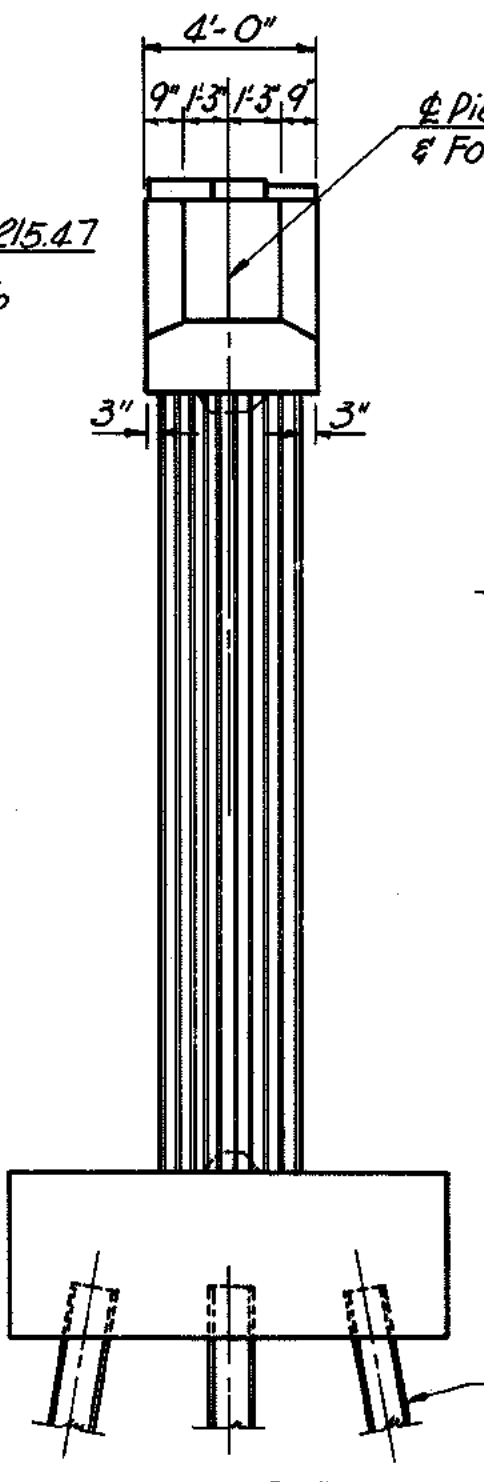

VIEW F-F  
Scale: 1/4" = 1'-0"

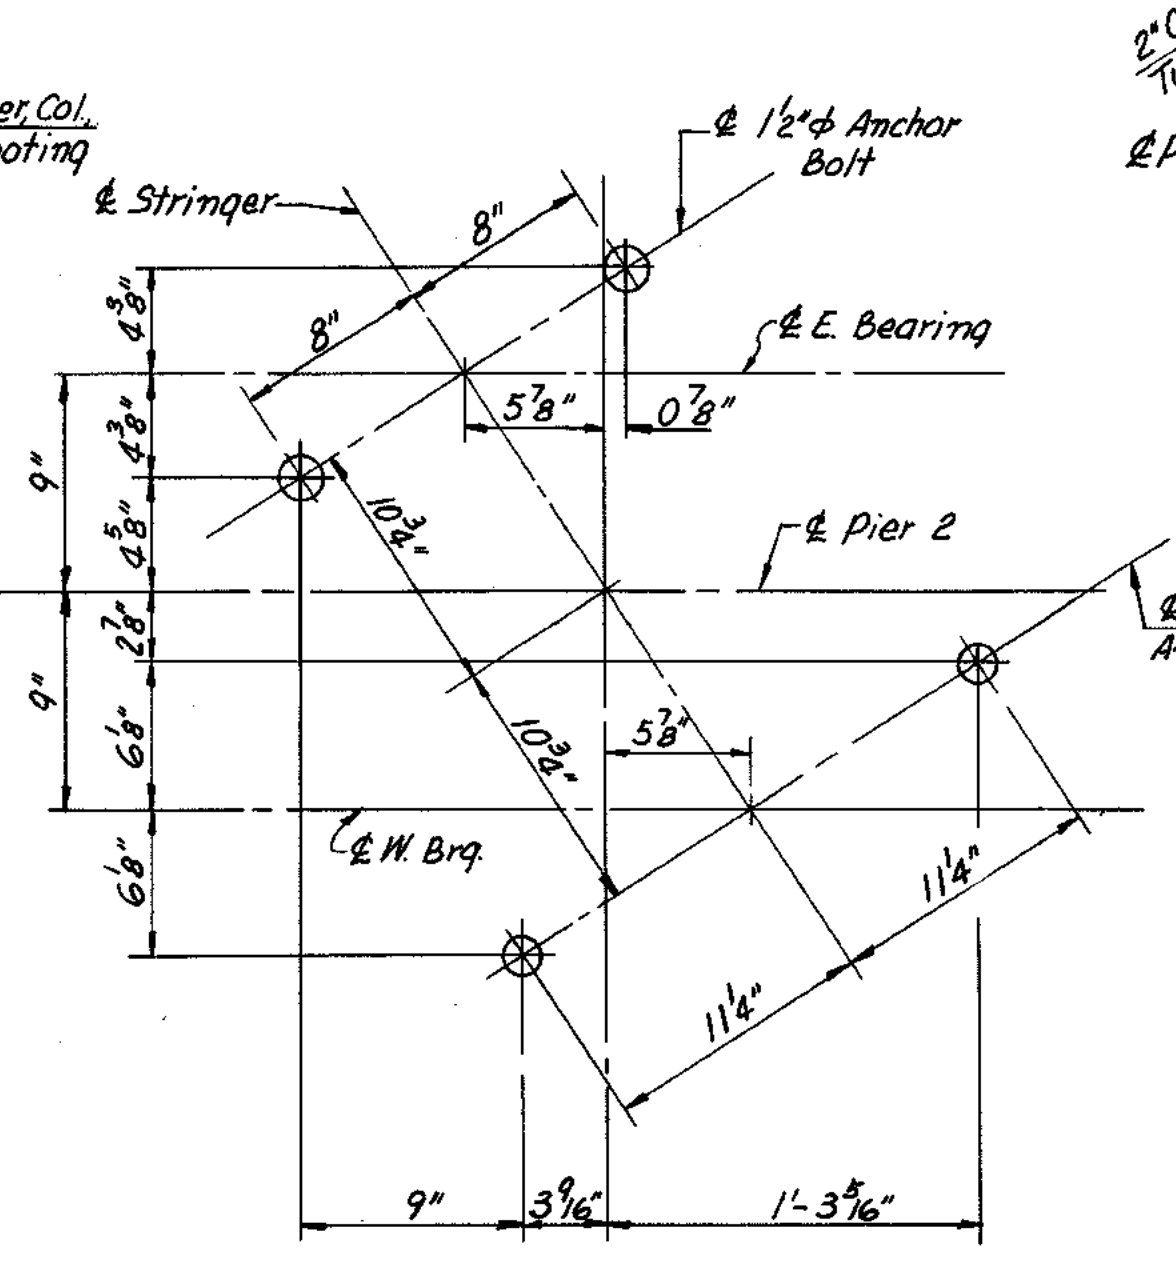


LOCATION OF ANCHOR BOLTS  
Scale: 1/2" = 1'-0"

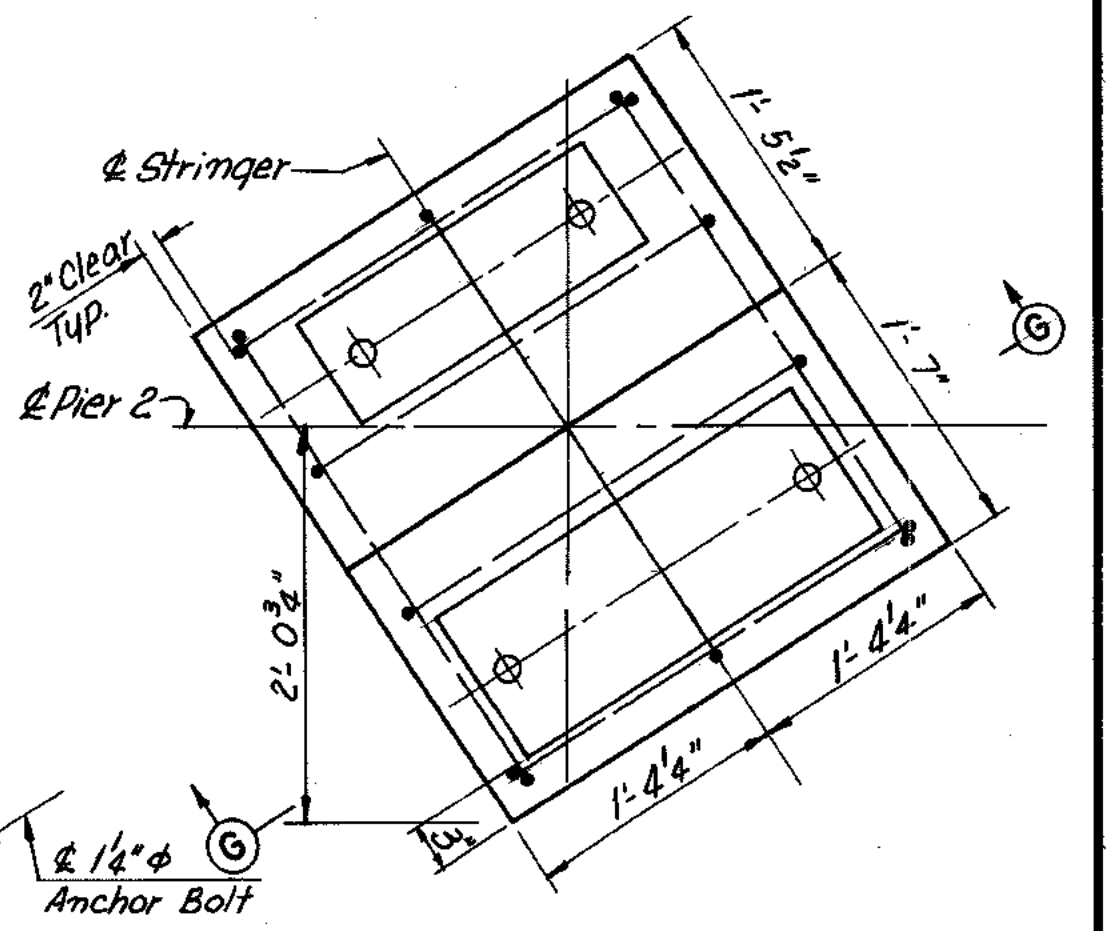


DETAIL "A"  
Scale: 1" = 1'-0"

Note: Pad reinforcement required in Pads S10, S11 & S12 only.

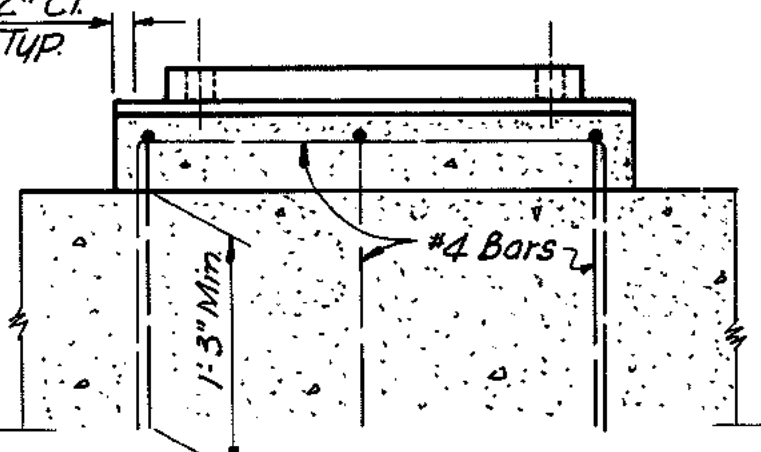


SECTION G-G  
Scale: 1" = 1'-0"

Notes:  
Footing elevations are approximate only and may be varied to suit field conditions as directed by the Engineer. Vertical shaft reinforcing shall not be cut until these elevations are established. Where elevations are more than 2 ft., redesign will be required.  
All piles shall be 10 BP 42 Steel Piles (Design Capacity = 45 tons).  
⌞ Denotes pile battered 2 in 12 in direction of arrow.

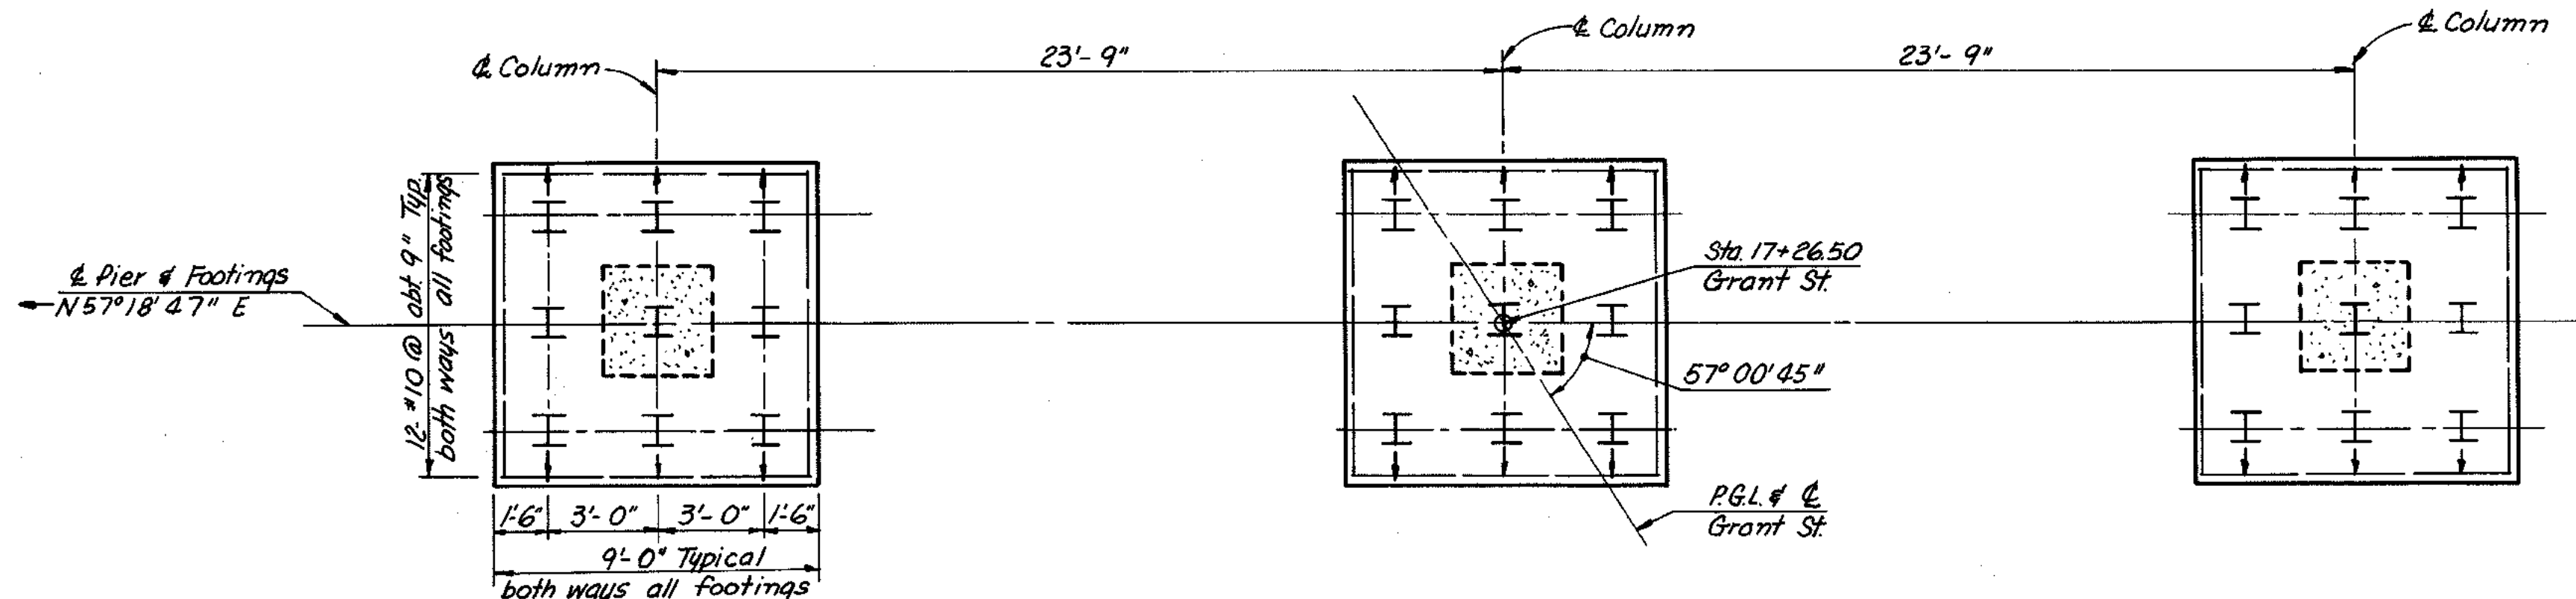

FOOTING PLAN  
Scale: 1/4" = 1'-0"

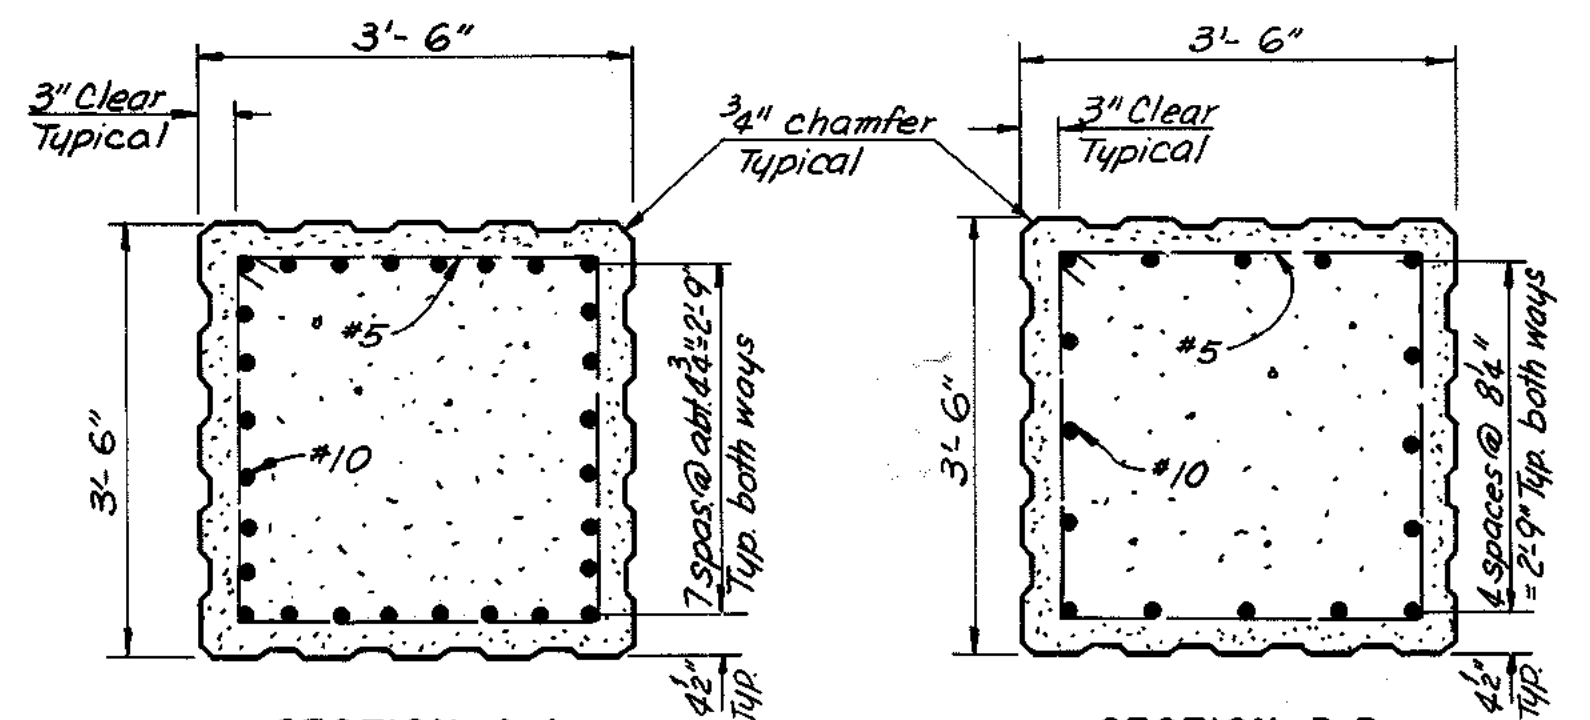

SECTION A-A  
Scale: 3/4" = 1'-0"



SECTION B-B  
Scale: 3/4" = 1'-0"

AS BUILT

MADE	BY	DATE	NO.	REVISION	BY	DATE
TCY	131-68					
ICB	2-20-68	1	As Built	TEM	9-75	
R. G. C.						

RICHMOND METROPOLITAN AUTHORITY			
RICHMOND EXPRESSWAY SYSTEM			
DOWNTOWN EXPRESSWAY			
BRIDGE NO. 37			
GRANT STREET OVER SOUTH CONNECTION DOWNTOWN EXPRESSWAY			
PIER 2			
HOWARD, NEEDLES, TAMMEN & BERGENDOFF consulting engineers NEW YORK ALEXANDRIA KANSAS CITY		SCALE: As Shown CONTRACT NO.: 7 SHEET NO. 7 OF 13	

RICHMOND EXPRESSWAY SYSTEM			
SECTION	PROJECT	SHEET NO.	TOTAL SHEETS
7	DOWNTOWN EXPRESSWAY	113	

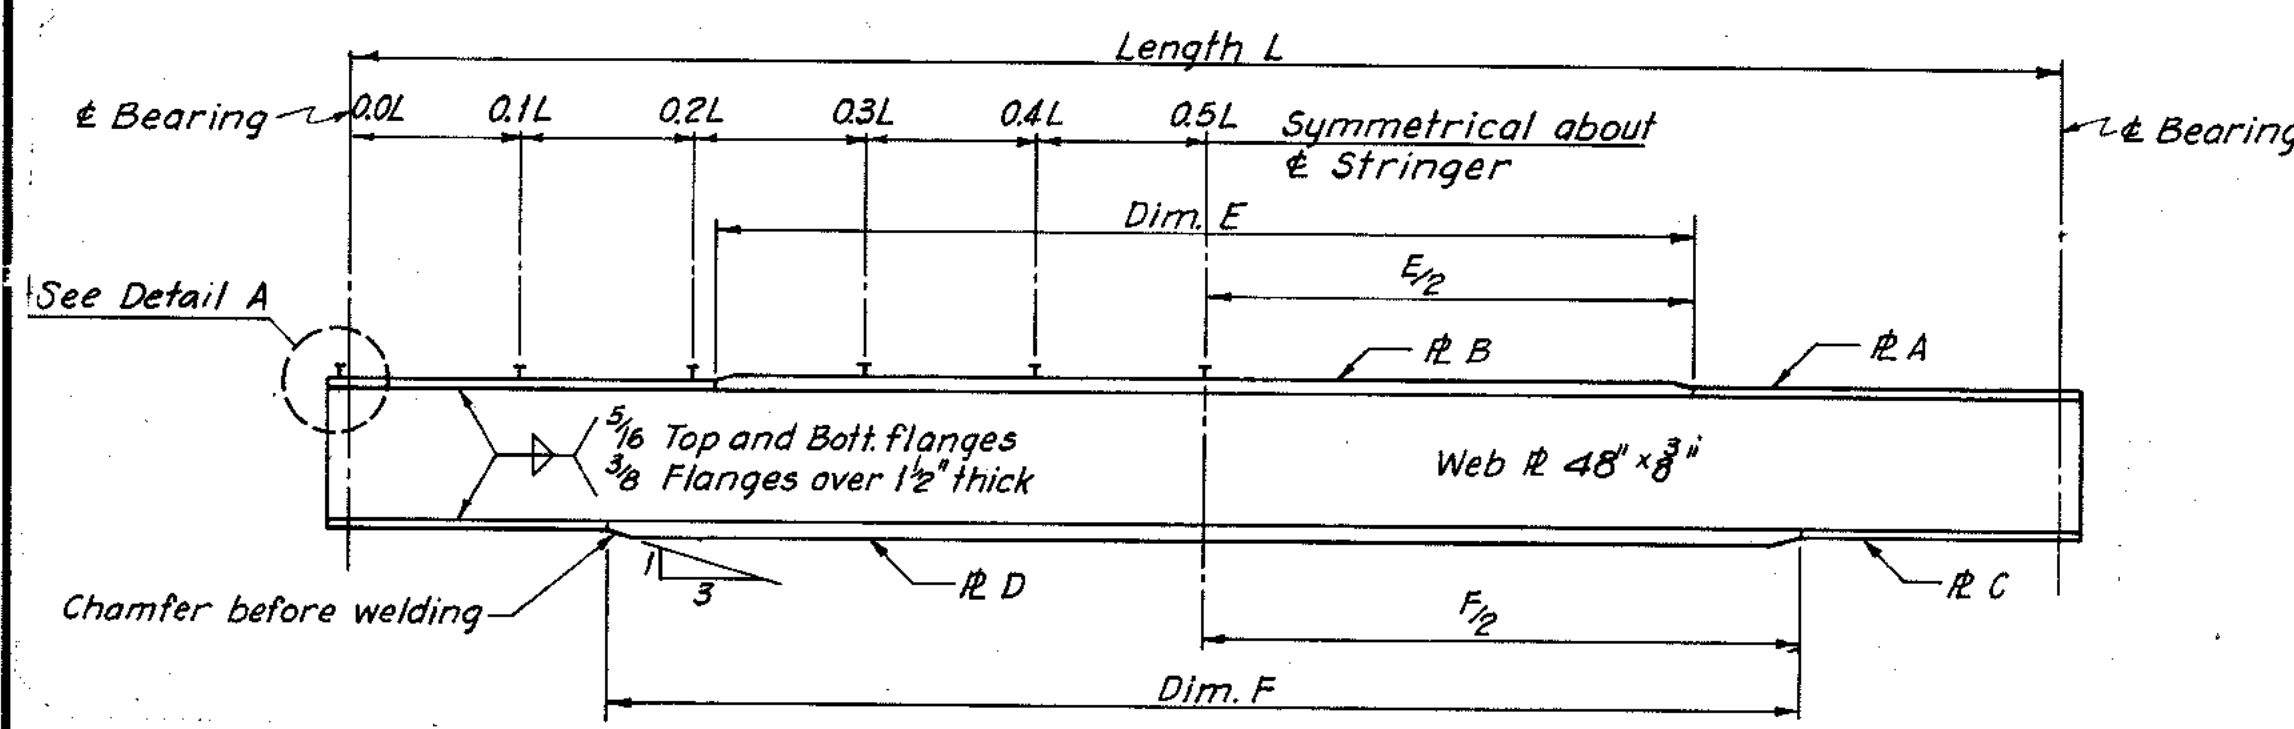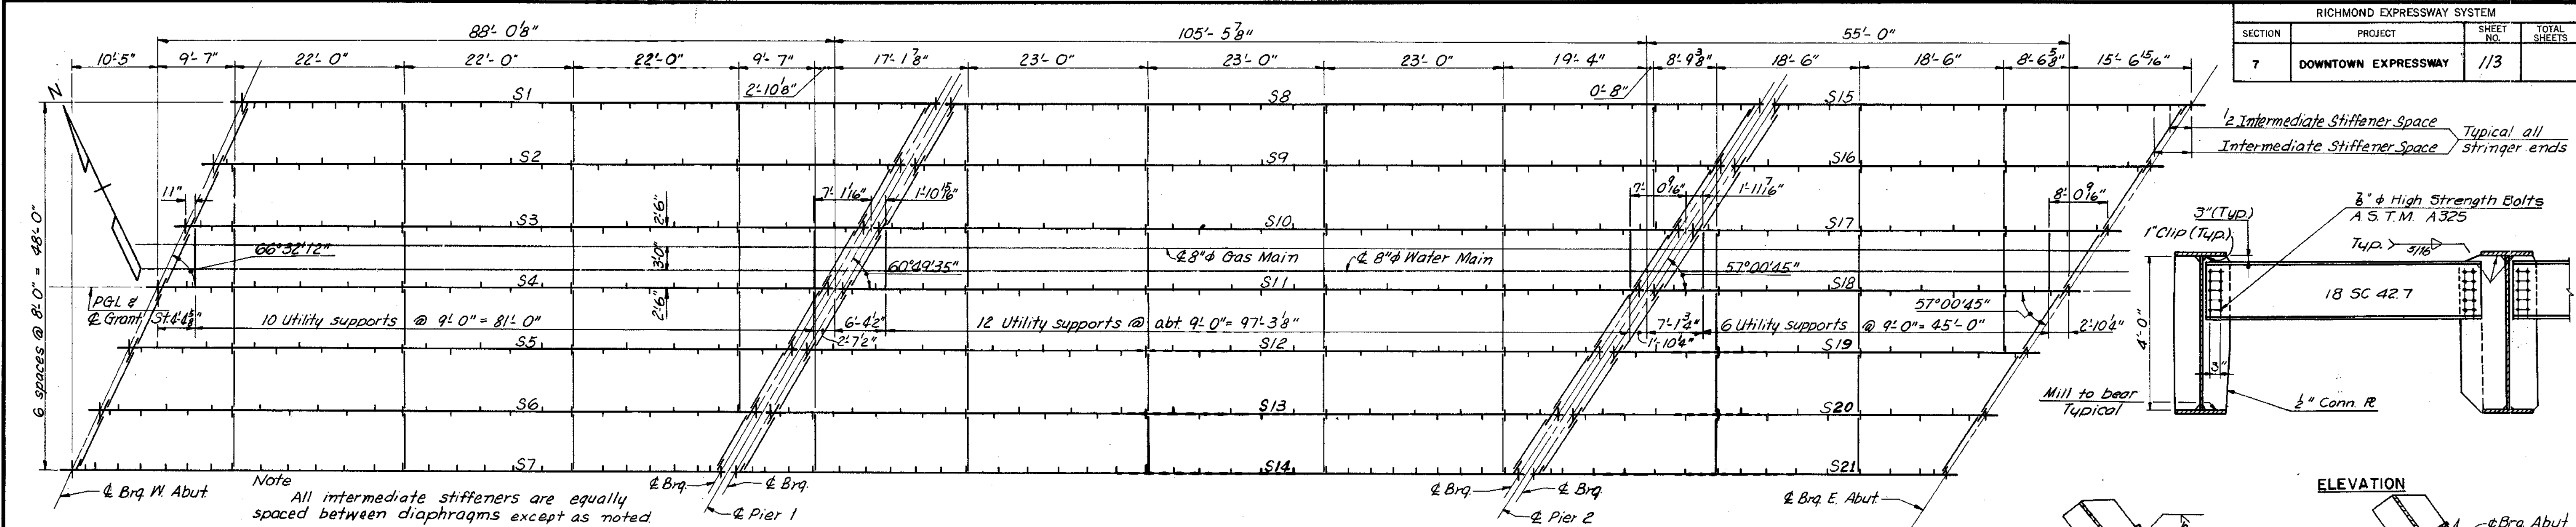

STRINGER ELEVATION



STRINGER SCHEDULE															
STRINGER	LENGTH C BRG. TO C BRG.	R A	R B	R C	R D	DIM. E	DIM. F	SHEAR STUD SPACING					BEARING STIFFENER	SHOE TYPE	
								0L-1L	1L-2L	2L-3L	3L-4L	4L-5L		LT. END	RT. END
S1	90'-1 <sup>3</sup> / <sub>8</sub> "	16×1 <sup>1</sup> / <sub>4</sub>	16×1 <sup>1</sup> / <sub>4</sub>	18×1 <sup>1</sup> / <sub>4</sub>	18×1 <sup>3</sup> / <sub>4</sub>	—	56'-6"	12"	15"	20"	24"	24"	2-7× <sup>1</sup> / <sub>2</sub>	E6	F4M
S2	89'-1 <sup>1</sup> / <sub>16</sub> "	16×1 <sup>1</sup> / <sub>4</sub>	16×1 <sup>1</sup> / <sub>4</sub>	18×1 <sup>1</sup> / <sub>4</sub>	18×1 <sup>3</sup> / <sub>4</sub>	—	55'-3"	11 <sup>1</sup> / <sub>2</sub> "	13 <sup>1</sup> / <sub>2</sub> "	16"	19 <sup>1</sup> / <sub>2</sub> "	24"	2-7× <sup>1</sup> / <sub>2</sub>	E6	F4
S3	88'-1 <sup>3</sup> / <sub>8</sub> "	16×1 <sup>1</sup> / <sub>4</sub>	16×1 <sup>1</sup> / <sub>4</sub>	18×1 <sup>1</sup> / <sub>4</sub>	18×1 <sup>3</sup> / <sub>4</sub>	—	54'-8"	11 <sup>1</sup> / <sub>2</sub> "	13 <sup>1</sup> / <sub>2</sub> "	16"	19 <sup>1</sup> / <sub>2</sub> "	24"	2-7× <sup>1</sup> / <sub>2</sub>	E6	F4
S4	87'-1 <sup>1</sup> / <sub>16</sub> "	16×1 <sup>1</sup> / <sub>4</sub>	16×1 <sup>1</sup> / <sub>4</sub>	18×1 <sup>1</sup> / <sub>4</sub>	18×1 <sup>3</sup> / <sub>4</sub>	—	54'-0"	11 <sup>1</sup> / <sub>2</sub> "	13 <sup>1</sup> / <sub>2</sub> "	16"	19 <sup>1</sup> / <sub>2</sub> "	24"	2-7× <sup>1</sup> / <sub>2</sub>	E6	F4
S5	86'-1 <sup>1</sup> / <sub>16</sub> "	16×1 <sup>1</sup> / <sub>4</sub>	16×1 <sup>1</sup> / <sub>4</sub>	18×1 <sup>1</sup> / <sub>4</sub>	18×1 <sup>3</sup> / <sub>4</sub>	—	53'-5"	11 <sup>1</sup> / <sub>2</sub> "	13 <sup>1</sup> / <sub>2</sub> "	16"	19 <sup>1</sup> / <sub>2</sub> "	24"	2-7× <sup>1</sup> / <sub>2</sub>	E6	F4
S15, S21	54'-1 <sup>1</sup> / <sub>4</sub> "	12× <sup>7</sup> / <sub>8</sub>	12× <sup>7</sup> / <sub>8</sub>	12× <sup>7</sup> / <sub>8</sub>	12× <sup>7</sup> / <sub>8</sub>	—	—	16 <sup>1</sup> / <sub>2</sub> "	20 <sup>1</sup> / <sub>2</sub> "	24"	24"	24"	2-5× <sup>1</sup> / <sub>2</sub>	F1M	E1
S16 to S20	54'-1 <sup>1</sup> / <sub>4</sub> "	12× <sup>7</sup> / <sub>8</sub>	12× <sup>7</sup> / <sub>8</sub>	12× <sup>7</sup> / <sub>8</sub>	12× <sup>7</sup> / <sub>8</sub>	—	—	11 <sup>1</sup> / <sub>2</sub> "	13"	15 <sup>1</sup> / <sub>2</sub> "	19"	24"	2-5× <sup>1</sup> / <sub>2</sub>	F1	E1

\* Denotes spacing which begins at termination of 5 spaces at 6"

SHEAR STUD NOTE

Stud rows shall be placed parallel to the main deck reinforcing.  
Shear stud spacing shown in maximum spacing.

BY	DATE				
MADE	TCY	1-9-68			
CHECKED	ICH	2-21-68	As Built		
IN CHARGE	R. G. C.			BY	DATE

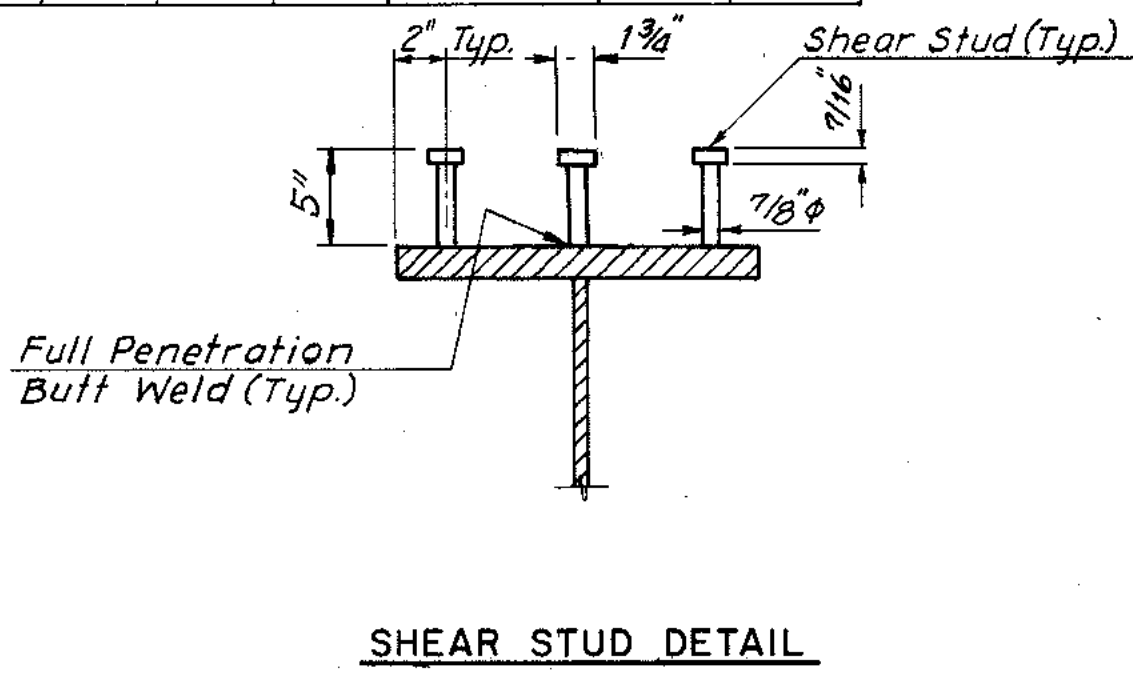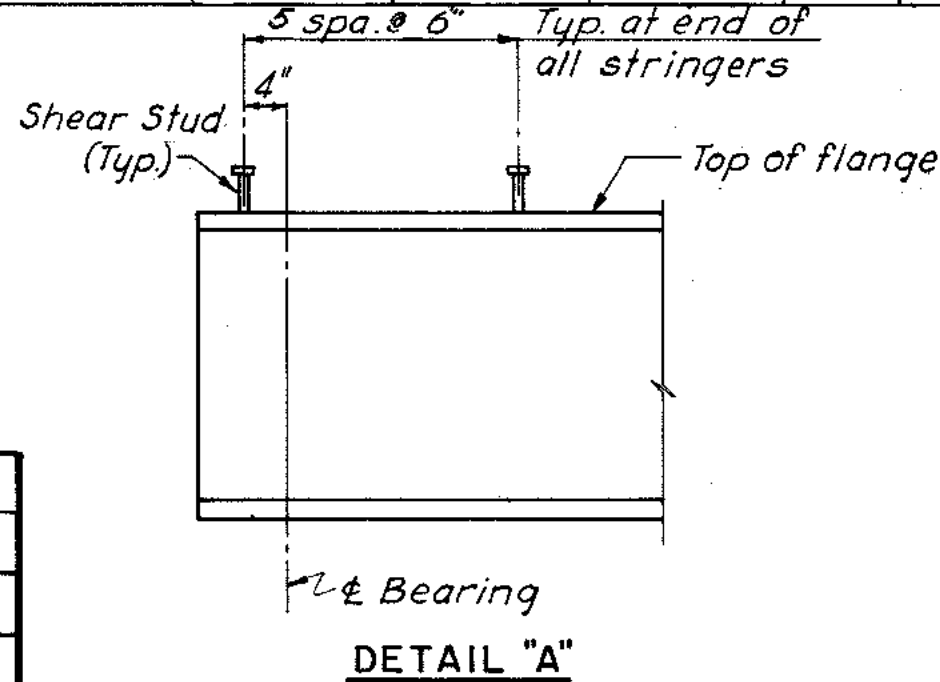

DEAD LOAD DEFLECTION DIAGRAM

DEFLECTION SCHEDULE										
STR.	1/4 L	1/2 L	3/4 L	1/4 L	1/2 L	3/4 L	1/4 L	1/2 L	3/4 L	1/4 L
S1	1 3/4"	2 1/8"	1 3/4"	1 3/4"	2 1/8"	1 3/4"	1 3/4"	2 1/8"	1 3/4"	1 3/4"
S2	1 1/6"	2 1/8"	1 1/6"	1 1/6"	2 1/8"	1 1/6"	1 1/6"	2 1/8"	1 1/6"	1 1/6"
S3	1 1/6"	2"	1 1/6"	1 1/6"	2"	1 1/6"	1 1/6"	2"	1 1/6"	1 1/6"
S4	1 1/4"	1 3/4"	1 1/4"	1 1/4"	1 3/4"	1 1/4"	1 1/4"	1 3/4"	1 1/4"	1 1/4"
S5	1 1/6"	1 1/8"	1 1/6"	1 1/6"	1 1/8"	1 1/6"	1 1/6"	1 1/8"	1 1/6"	1 1/6"
S6	1 1/6"	1 1/8"	1 1/6"	1 1/6"	1 1/8"	1 1/6"	1 1/6"	1 1/8"	1 1/6"	1 1/6"
S7	1 1/6"	1 1/8"	1 1/6"	1 1/6"	1 1/8"	1 1/6"	1 1/6"	1 1/8"	1 1/6"	1 1/6"
S8	2 1/6"	3 1/4"	2 1/6"	2 1/6"	3 1/4"	2 1/6"	2 1/6"	3 1/4"	2 1/6"	2 1/6"
S9	2 1/6"	3 1/6"	2 1/6"	2 1/6"	3 1/6"	2 1/6"	2 1/6"	3 1/6"	2 1/6"	2 1/6"
S10	2 1/6"	2 3/8"	2 1/6"	2 1/6"	2 3/8"	2 1/6"	2 1/6"	2 3/8"	2 1/6"	2 1/6"
S11	1 1/8"	2 3/8"	1 1/8"	1 1/8"	2 3/8"	1 1/8"	1 1/8"	2 3/8"	1 1/8"	1 1/8"
S12	2"	2 3/4"	2"	2"	2 3/4"	2"	2"	2 3/4"	2"	2"
S13	2"	2 3/4"	2"	2"	2 3/4"	2"	2"	2 3/4"	2"	2"
S14	2"	2 3/4"	2"	2"	2 3/4"	2"	2"	2 3/4"	2"	2"
S15, S21	7/16"	5/8"	7/16"	7/16"	5/8"	7/16"	7/16"	5/8"	7/16"	7/16"
S16, S20	3/8"	9/16"	3/8"	3/8"	9/16"	3/8"	3/8"	9/16"	3/8"	3/8"
S17, S19	3/8"	9/16"	3/8"	3/8"	9/16"	3/8"	3/8"	9/16"	3/8"	3/8"
S18	3/8"	1/2"	3/8"	3/8"	1/2"	3/8"	3/8"	1/2"	3/8"	3/8"



NOTE TO CONTRACTOR

The above deflections are those anticipated to occur in the stringer upon placement of the total concrete deck dead load.  
In practice, the stringers in place are not likely to have the exact camber to compensate for these deflections during construction. The residual amounts shall be provided for by adjusting forms to vary the thickness of the concrete between the bottom of the slab and the top of stringer, without alteration of the slab thickness.

NOTE TO FABRICATOR

The above stringers shall be fabricated with an upward camber amounting to the tabulated value.  
This will provide approximate compensation for deflection under full dead load and for conformity with finished grade.  
Dimensions are in inches.

Note:  
For Gas and Water support details see Standard Sheet S11.

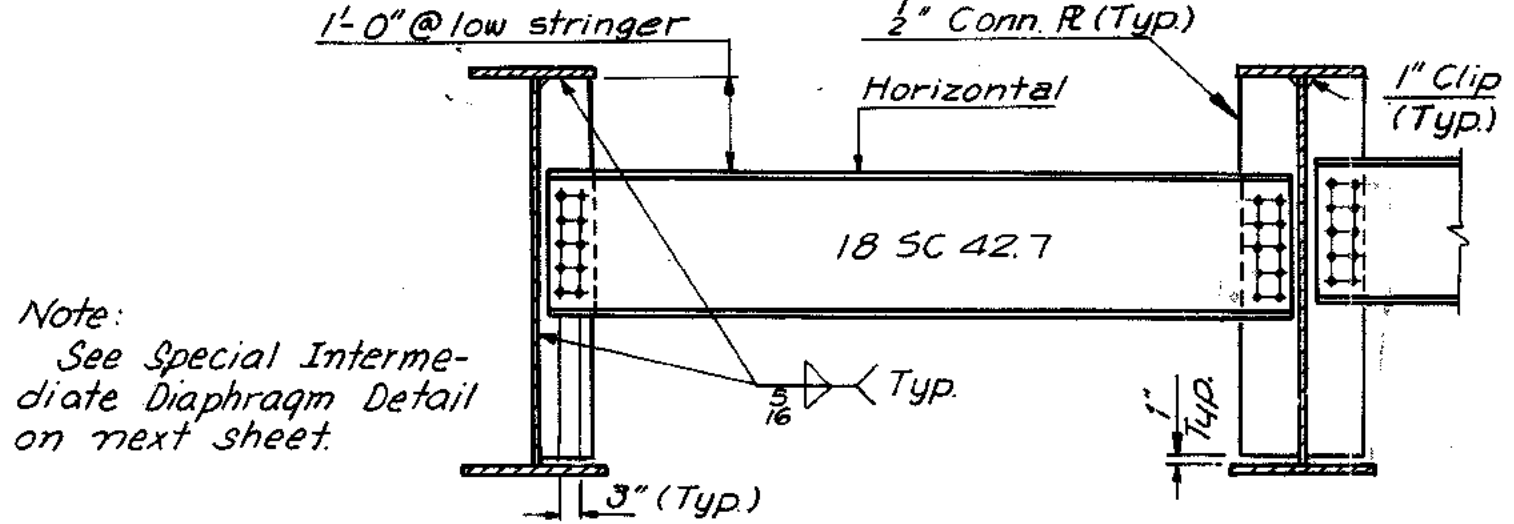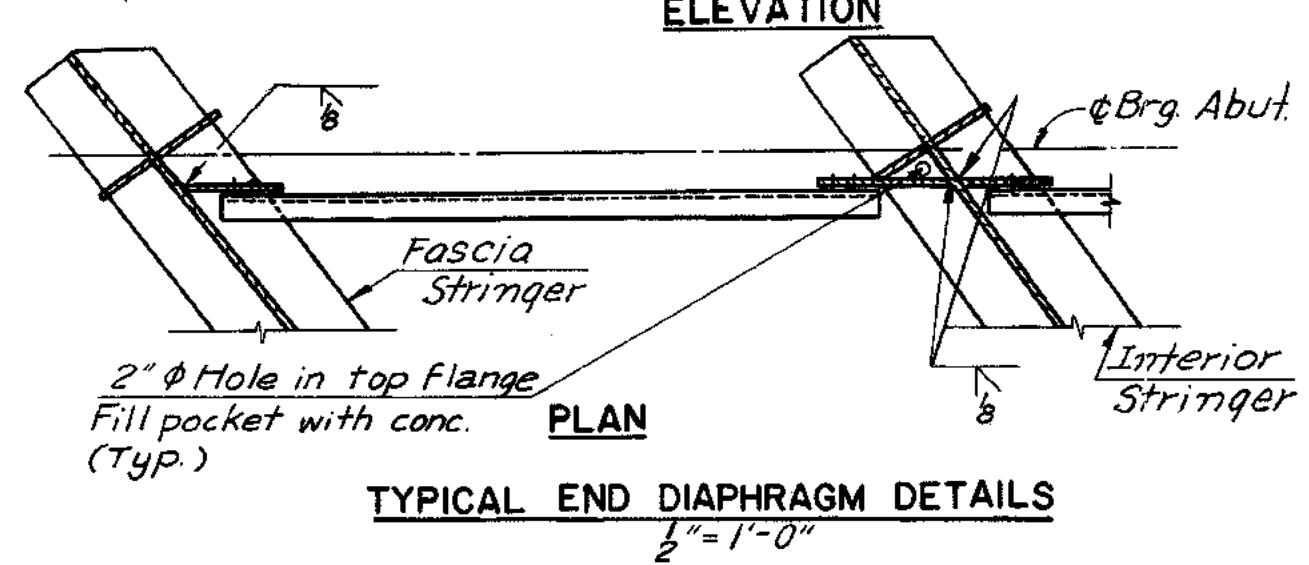

BEARING STIFFENER

INTERMEDIATE STIFFENER

AS BUILT

RICHMOND METROPOLITAN AUTHORITY RICHMOND EXPRESSWAY SYSTEM DOWNTOWN EXPRESSWAY			
BRIDGE NO. 37 GRANT STREET OVER SOUTH CONNECTION DOWNTOWN EXPRESSWAY FRAMING PLAN			
HOWARD, NEEDLES, TAMMEN & BERGENDOFF consulting engineers NEW YORK ALEXANDRIA KANSAS CITY		SCALE: As Shown CONTRACT NO.: 7 SHEET NO. 8 OF 13	









**Bridge 50**

**South Laurel Street  
Over**

**Downtown Expressway (VA 195)**

**Record Set Plans**



RICHMOND EXPRESSWAY SYSTEM			
SECTION	PROJECT	SHEET NO.	TOTAL SHEETS
8	DOWNTOWN EXPRESSWAY	222	

**GENERAL NOTES:**  
**ROADWAY:** One 30'-0" Clear roadway. Two 8'-0" sidewalks.  
**CAPACITY:** Dead Load - Includes 15 lbs. per sq. ft. for future wearing surface.  
 Live Loads - HS20-44 loading and B.P.R. modified for military vehicles.

**SPECIFICATIONS:**  
**GENERAL** - Virginia Department of Highway Road and Bridge Specifications 1970  
**DESIGN** - AASHTO Standard Specifications for Highway Bridges, 1961 modified by Special Design Provisions.  
**WELDING** - 1969 Standard Specifications for welded Highway and Railway Bridges of the American Welding Society.

**CONTRACT SPECIAL PROVISIONS:**  
 Specifications and Contract Special Provisions referred to above are necessary to make these plans complete.

**DATUM:** CITY OF RICHMOND  
**TEMPERATURE:** The normal temperature referred to on the plan is 60 °F. The temperature range for movement is 0 °F. to 120 °F.

**DIMENSIONS:** All dimensions are measured horizontally and vertically unless otherwise noted.

**EXCAVATION:** Excavation below subgrade and cut slope template shall be classified as Structure Excavation. All excavation above these limits shall be classified as Regular Excavation and is not included in the Structural Quantities.

**FOUNDATIONS:** Footings shall rest on firm material. Foundation material shall be kept dry and special attention is called to Section 401.05 of the General Specifications, and to the Contract Special Provisions, concerning preparation of foundations for footings.

**CONCRETE NOTES:**  
 Concrete in superstructure shall be Class A4. All other concrete shall be Class A3. All exposed edges and corners shall have a 3/4" chamfer or fillet unless otherwise noted. Care in the method of vibration, the use of low slump concrete and/or other means shall be employed to prevent downgrade movement of newly placed slab concrete. (When gradient is over 2%)  
 Finishing concrete surfaces: See the Standard Architectural Detail Sheets and the Contract Special Provisions for types and details.

All reinforcing steel shall conform to ASTM A615 Grade 40. All reinforcing bar dimensions on the detailed drawings are to centers of bars unless otherwise noted. Clear distance between reinforcing steel and face of concrete shall be as noted on the plans. All bar laps shall be 30 diameters of the smaller diameter bar unless otherwise noted.



**STEEL NOTES:** Structural steel shall conform to A.S.T.M. Specification A36 except as noted.  
 All field connections shall be made with high strength bolts. High strength bolts shall be 3/4" diameter unless otherwise noted and shall conform to A.S.T.M. Specification A-325.

**BENCH MARK:** C-38. Monument located in walk N.E. Corner Cumberland and South Laurel. Elev. 176.83.

**NOTES:**  
 Top of Pavement Elevations at ends of Deck along P.G.L. are given on Plan. Remaining Pavement Elevations are given on Sheet 7.  
 • Indicates 2 1/2" Cased Hole Boring.  
 • Indicates 4" Cased Hole Boring.

INDEX	
No.	DESCRIPTION
1	General Plan and Elevation
2	South Abutment
3	North Abutment
4	Pier Details
5	Framing Plan
6	Cross Section & Utility Details
7	Deck Plan & Joint Details
8	Approach Slabs
9	Boring Logs
51	Standard Shoe Details
53	Standard Aluminum Railing Details
54	Standard Electrical Details
57	Standard Architectural Details
510	Standard Elect. and Tele. Cond. Details
511	Standard Utility Support details @ Abut.

ESTIMATED QUANTITIES															
	STRUCTURE EXCAVATION	CONCRETE CLASS A4	CONCRETE CLASS A3	REINFORCING STEEL	STRUCTURAL STEEL-A36	ALUMINUM BRIDGE RAILING	ASPHALT DAMP-PROOFING	6 INCH PIPE UNDERDRAIN	POROUS BACKFILL	CONC. SLAB SLOPE PROTECTION	GAS MAIN 12" Ø	GAS MAIN 8" Ø	WATER MAIN 12" Ø	CONDUITS 6" Ø WEPKO	CONDUITS 4" Ø TEL.
	C.Y.	C.Y.	C.Y.	LBS.	LBS.	L.F.	S.Y.	L.F.	C.Y.	S.Y.	L.F.	L.F.	L.F.	L.F.	L.F.
Superstructure		364.21	88.24	68,195	382,078.4	408	43	57	14	232.6	226	217.3	208	481	1442
South Abutment	134			4873											
Pier 1	241		92.65	16,300											
Pier 2	272		97.54	19,411											
North Abutment	268.12		242.29	12,341			119	55	72						
Approach Slabs			7660	17,263											
Total	916.12	364.21	597.32	138,383	382,078.4	408	162	112	86	232.6	226	217.3	208	481	1442

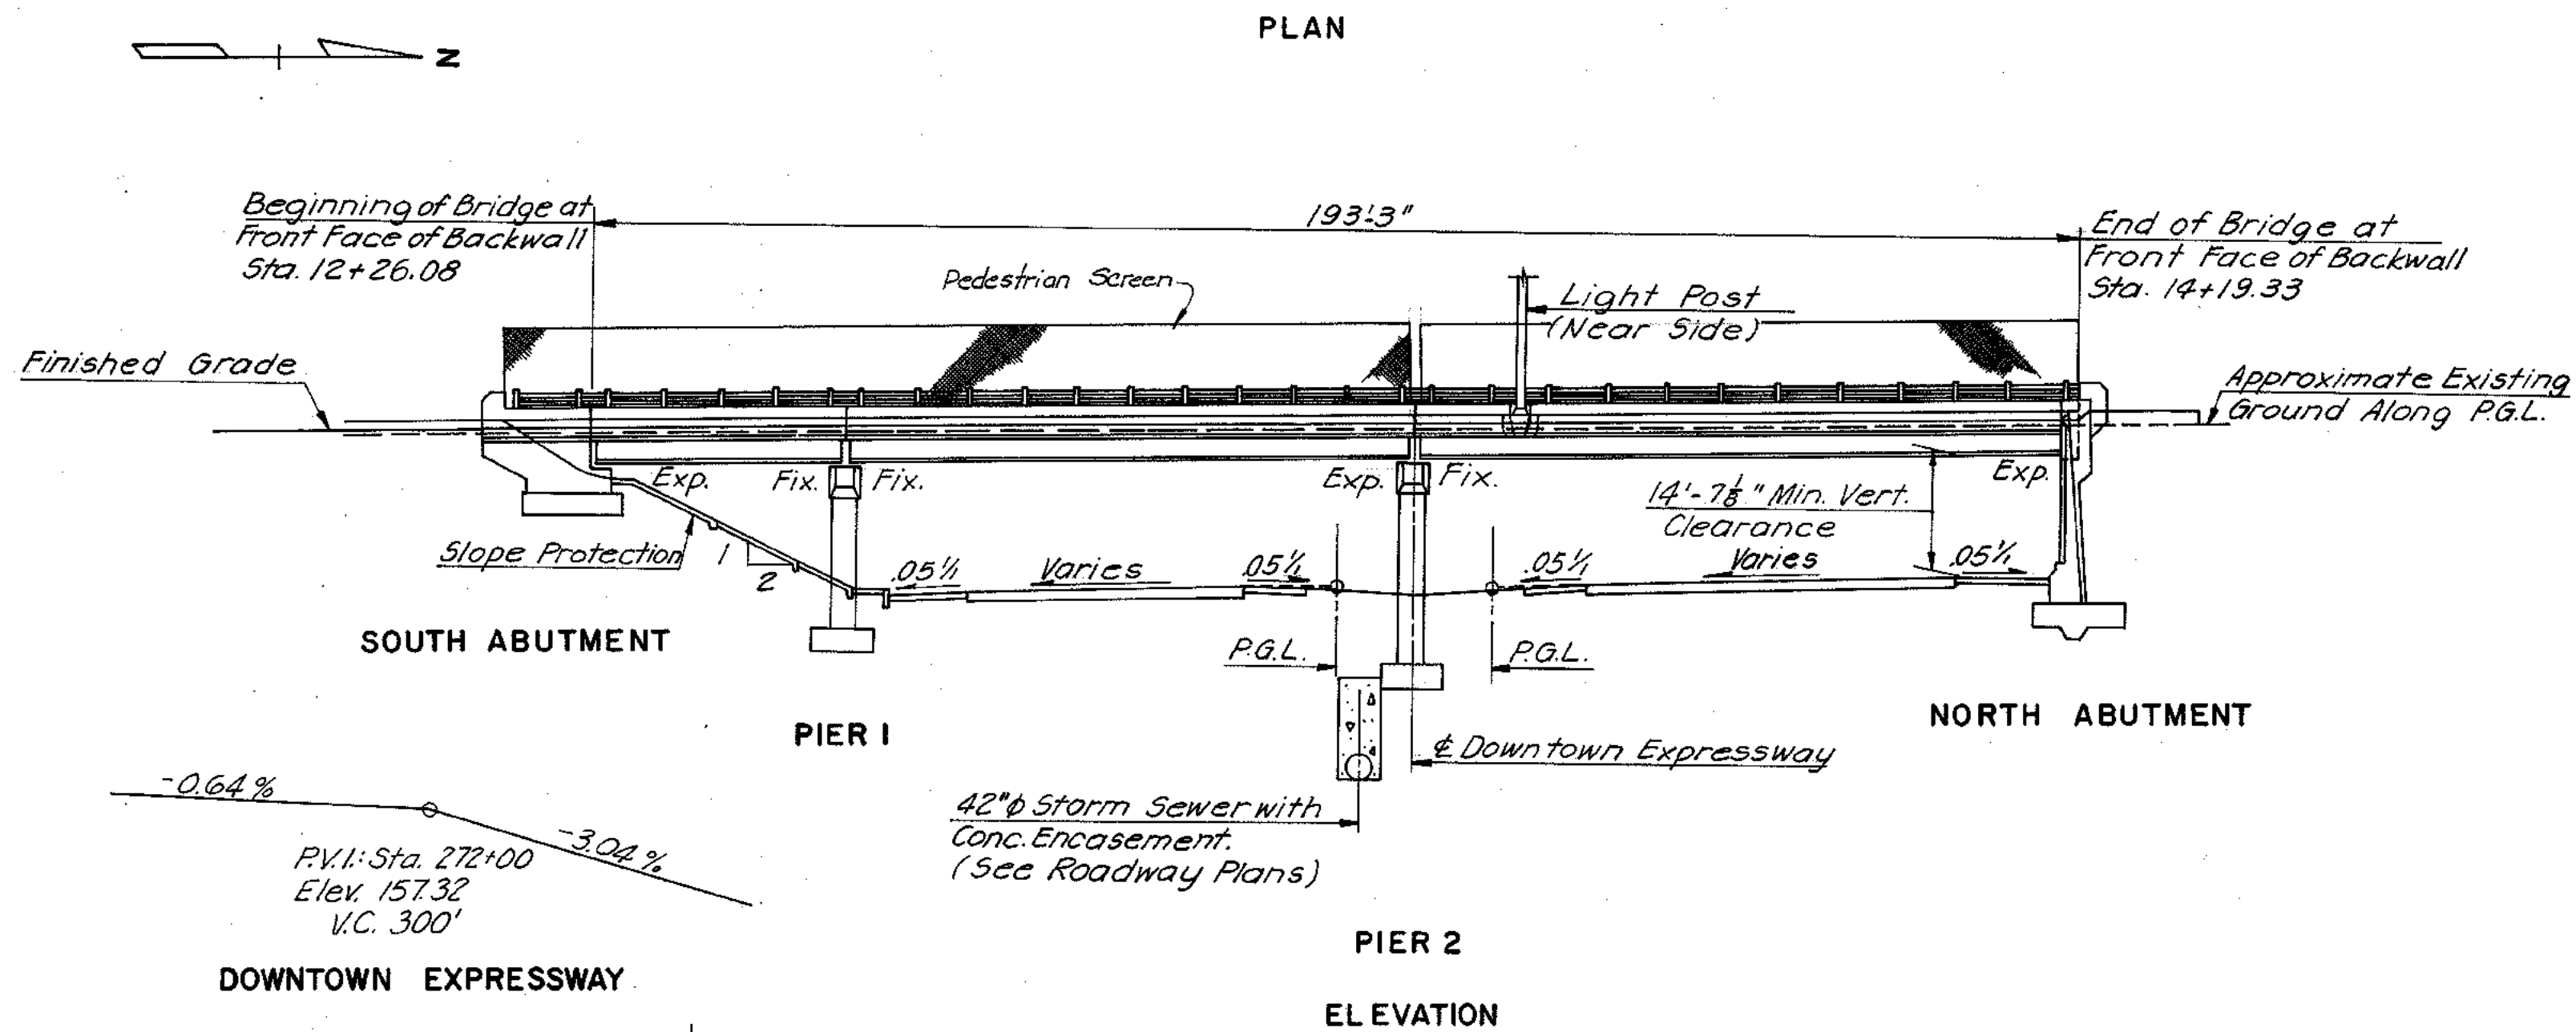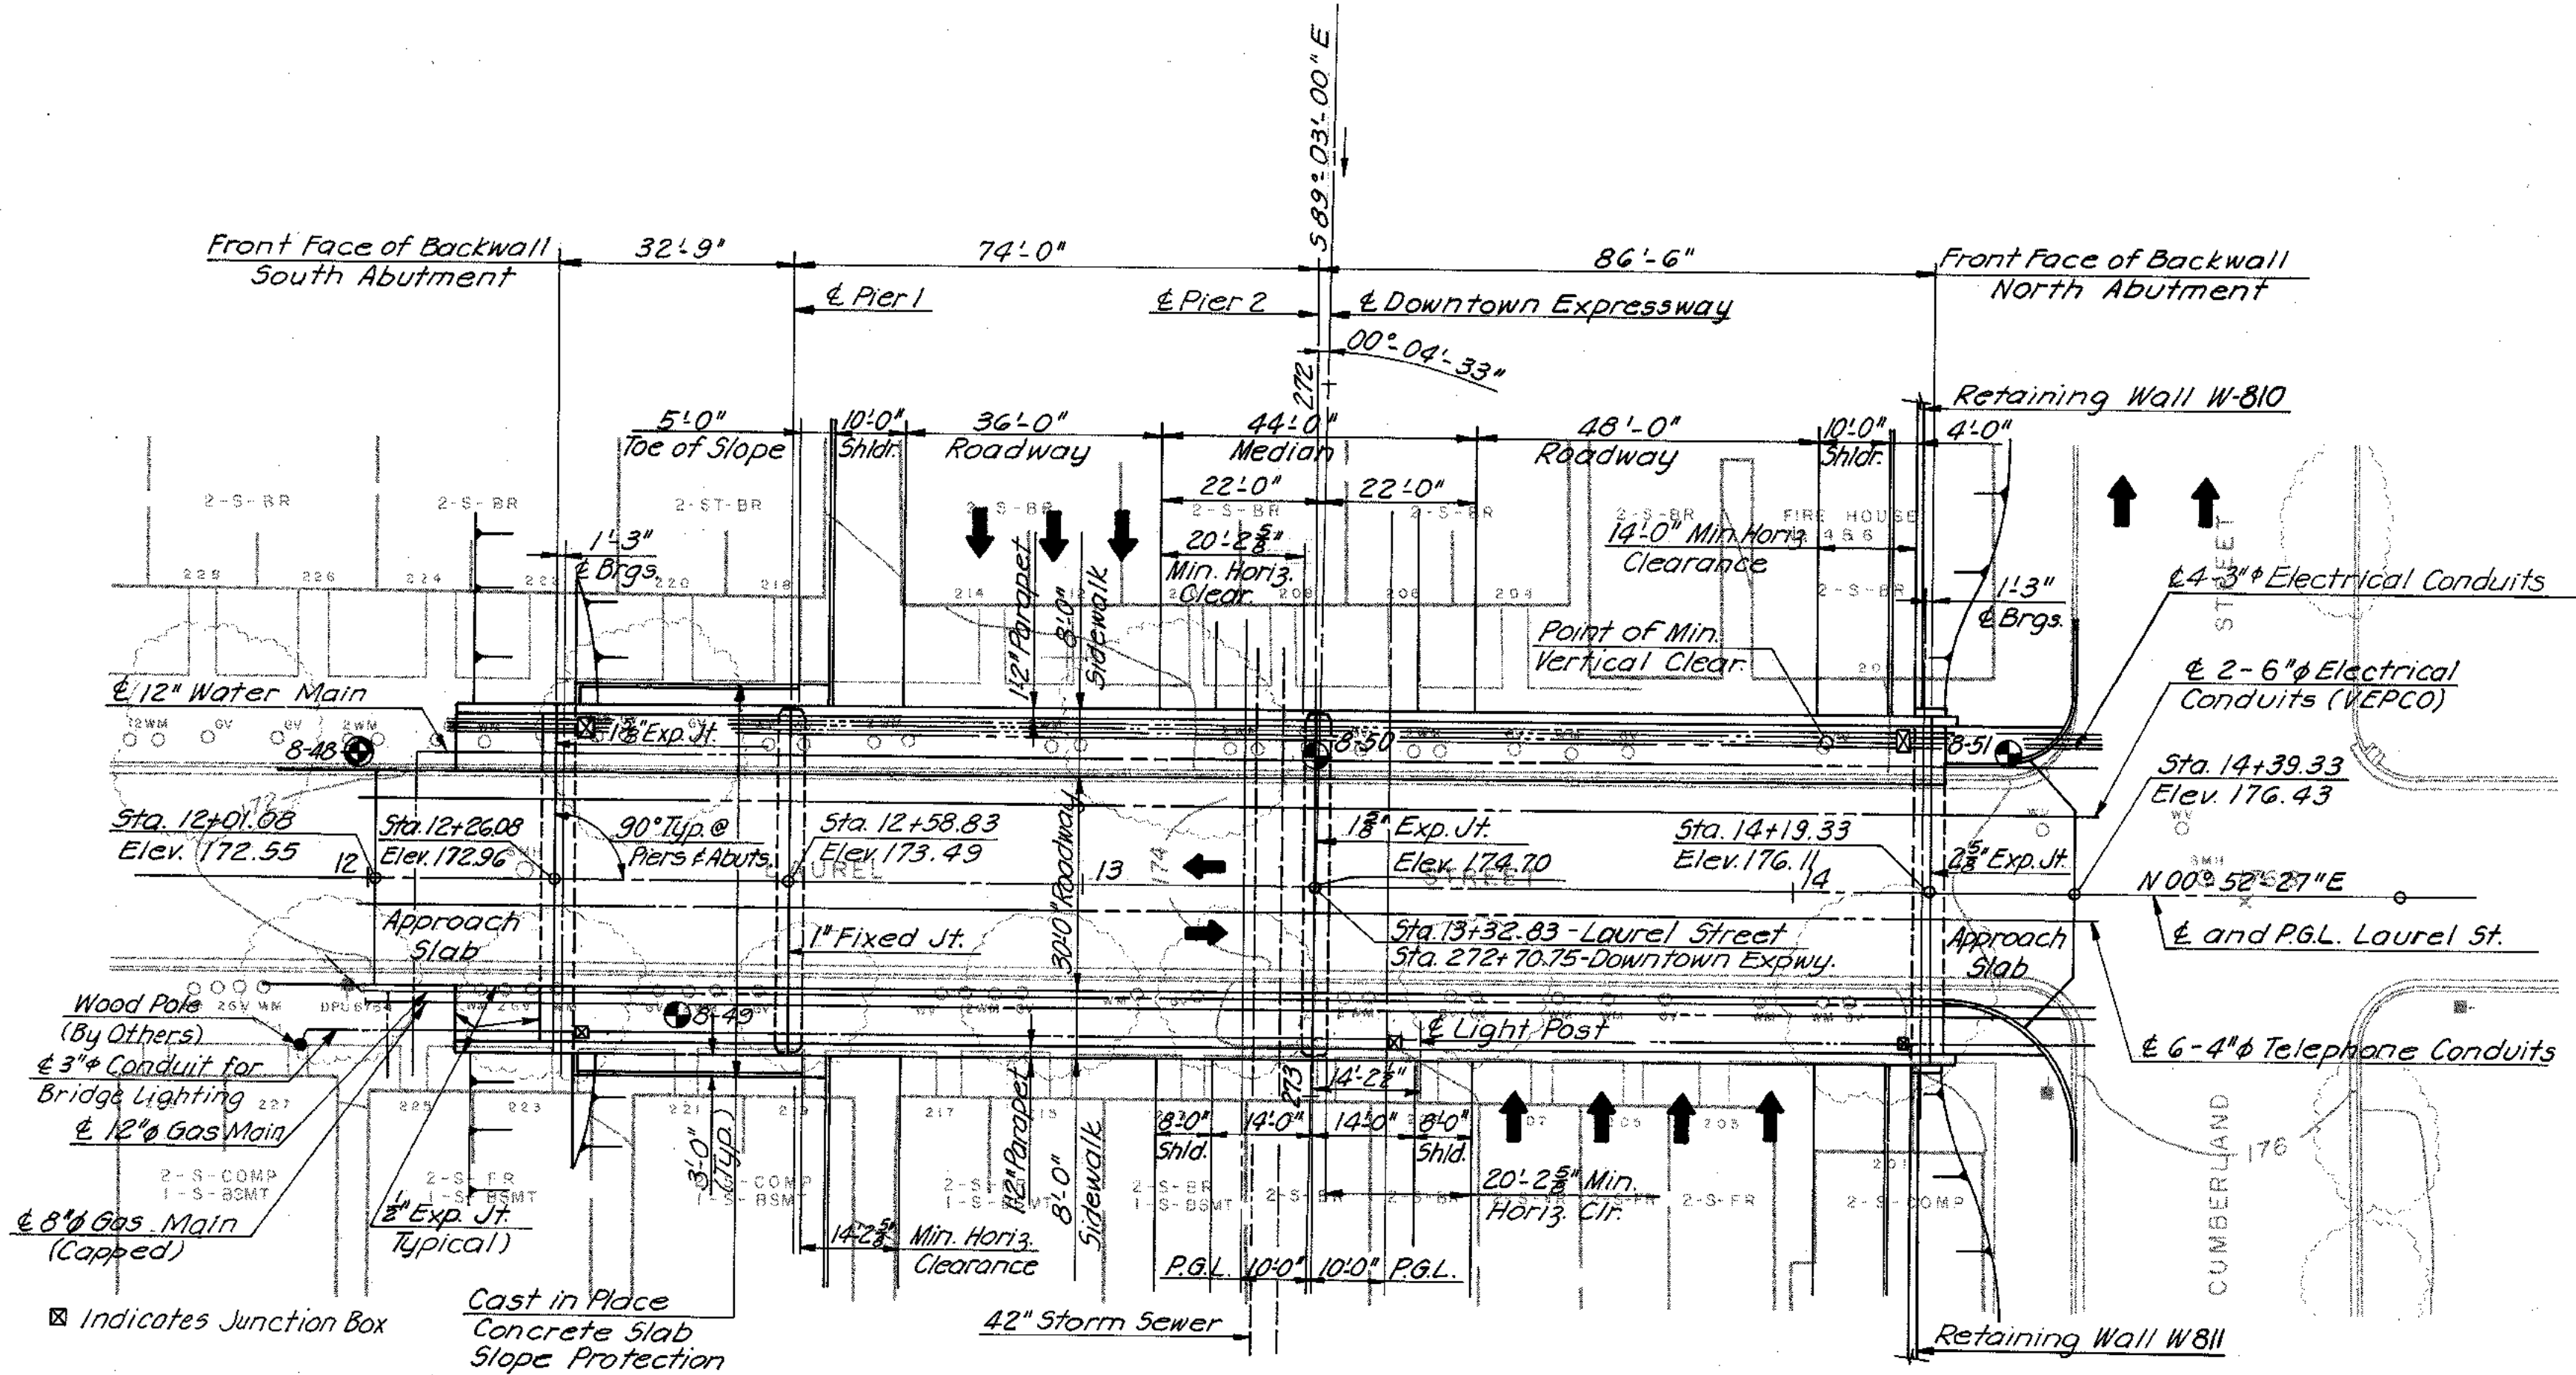

LAUREL STREET PROFILE DATA				
Sta. 11+00	Elev. 170.90			
Sta. 12+00	Elev. 172.55			
Sta. 13+00	Elev. 174.10			
Sta. 14+00	Elev. 175.65			
Sta. 14+33	Elev. 176.43			

MADE	BY	DATE	NO.	REVISION	BY	DATE
W.E.O.	W.D.U.	8-67				
W.E.O.	W.E.O.	10-67		AS BUILT	H.M.W.	4-76
W.E.O.	W.E.O.					

RICHMOND METROPOLITAN AUTHORITY  
RICHMOND EXPRESSWAY SYSTEM  
DOWNTOWN EXPRESSWAY



STRUCTURE B 50  
LAUREL STREET OVER  
DOWNTOWN EXPRESSWAY  
GENERAL PLAN AND ELEVATION

AMERICAN ENGINEERS  
Richmond, Virginia  
HOWARD, NEEDLES, TAMMEN & BERGENDOFF  
General Consultants


SCALE: 1" = 20'  
CONTRACT NO.: 8  
SHEET NO. 1 OF 9



RICHMOND EXPRESSWAY SYSTEM			
SECTION	PROJECT	SHEET NO.	TOTAL SHEETS
8	DOWNTOWN EXPRESSWAY	225	

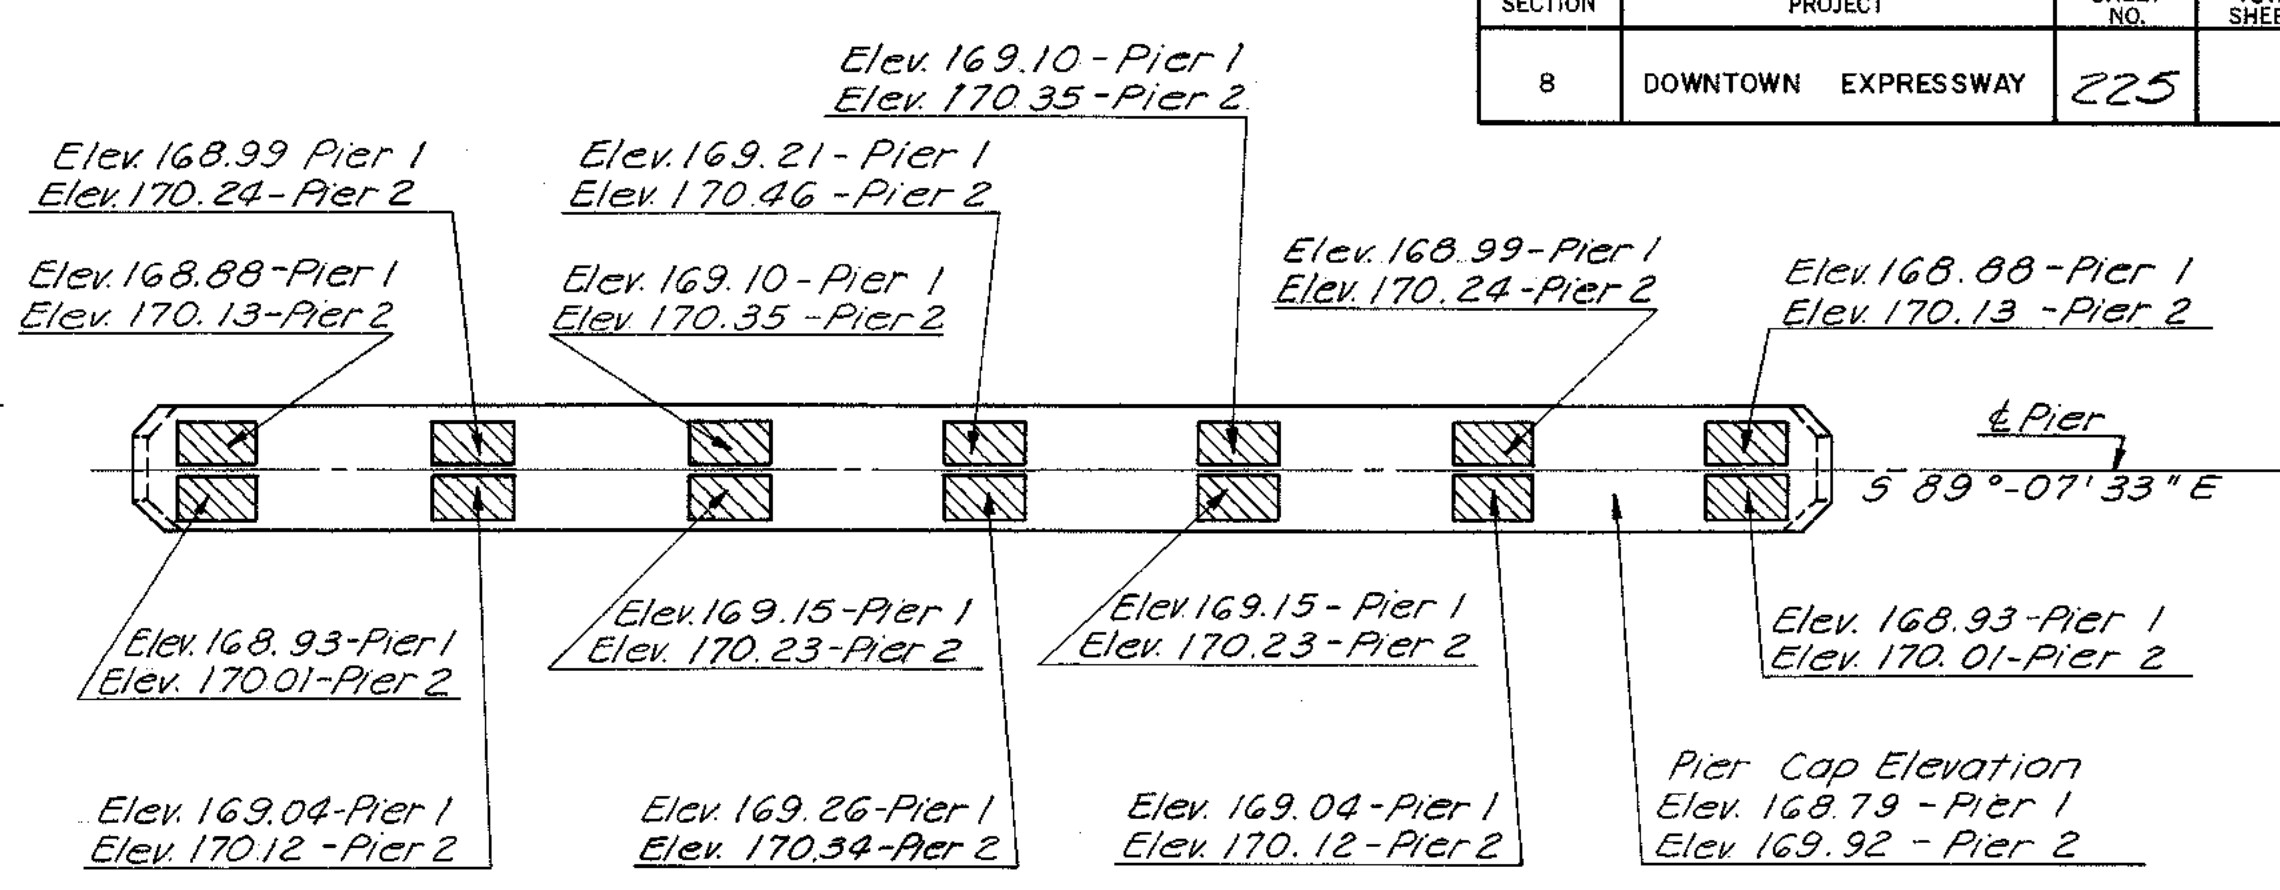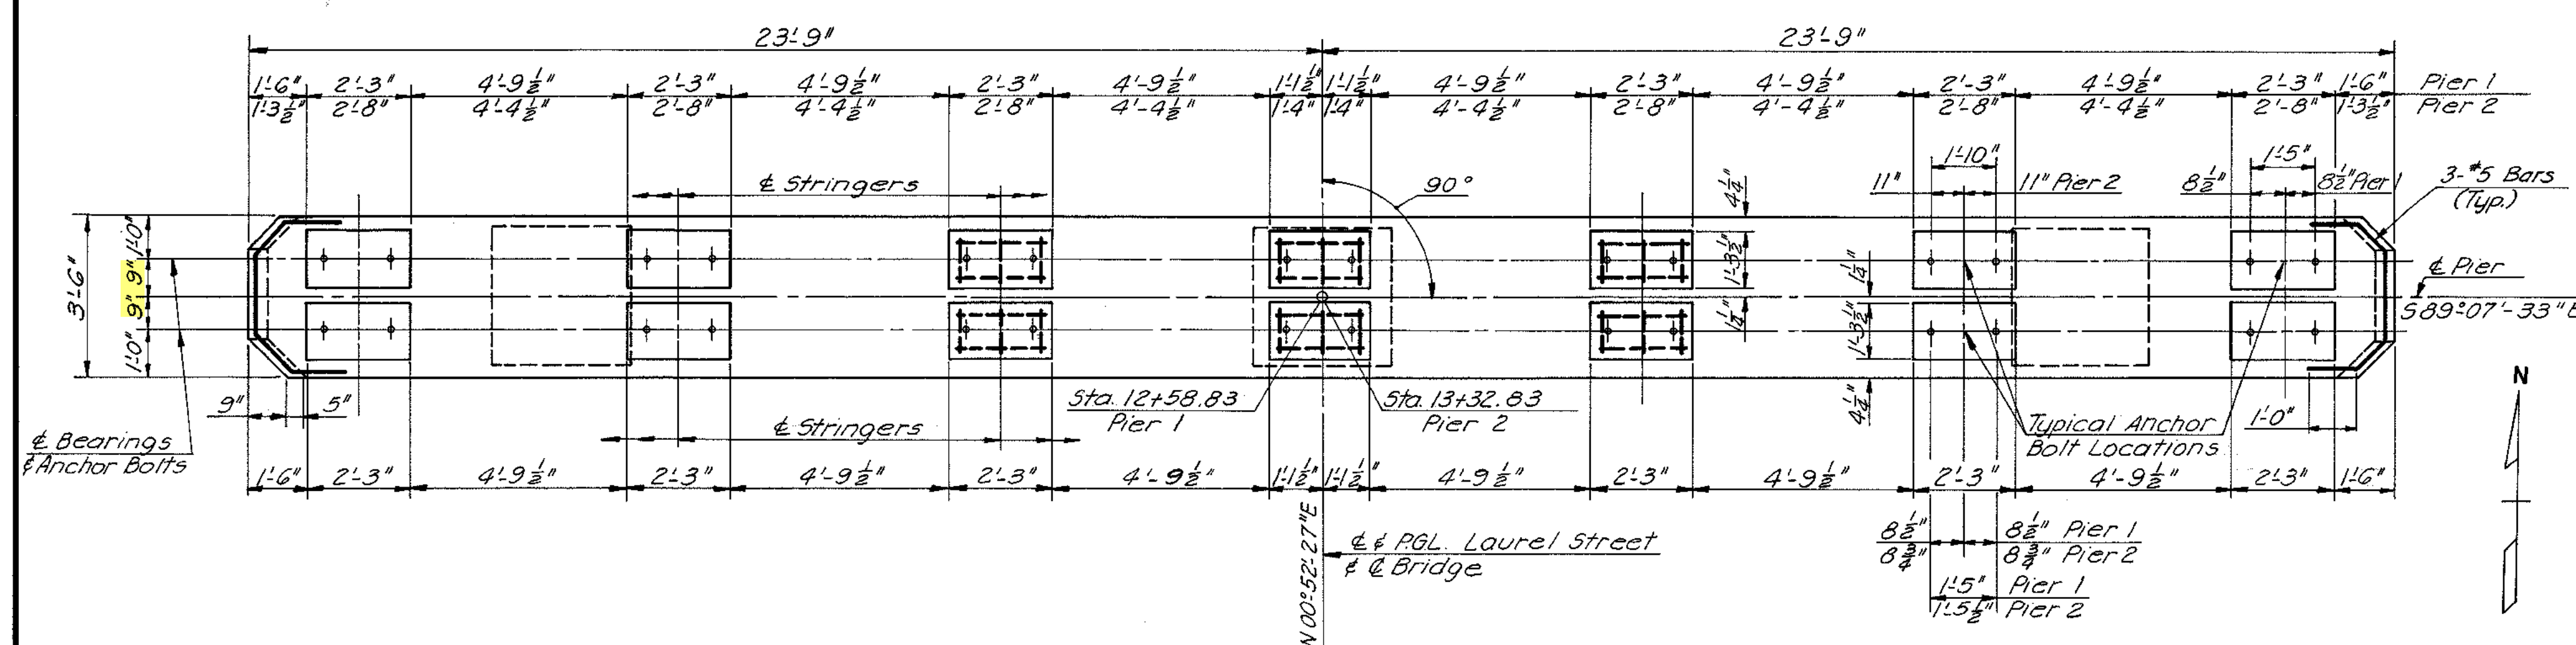


PAD ELEVATIONS  
Scale: 1/8" = 1'-0"

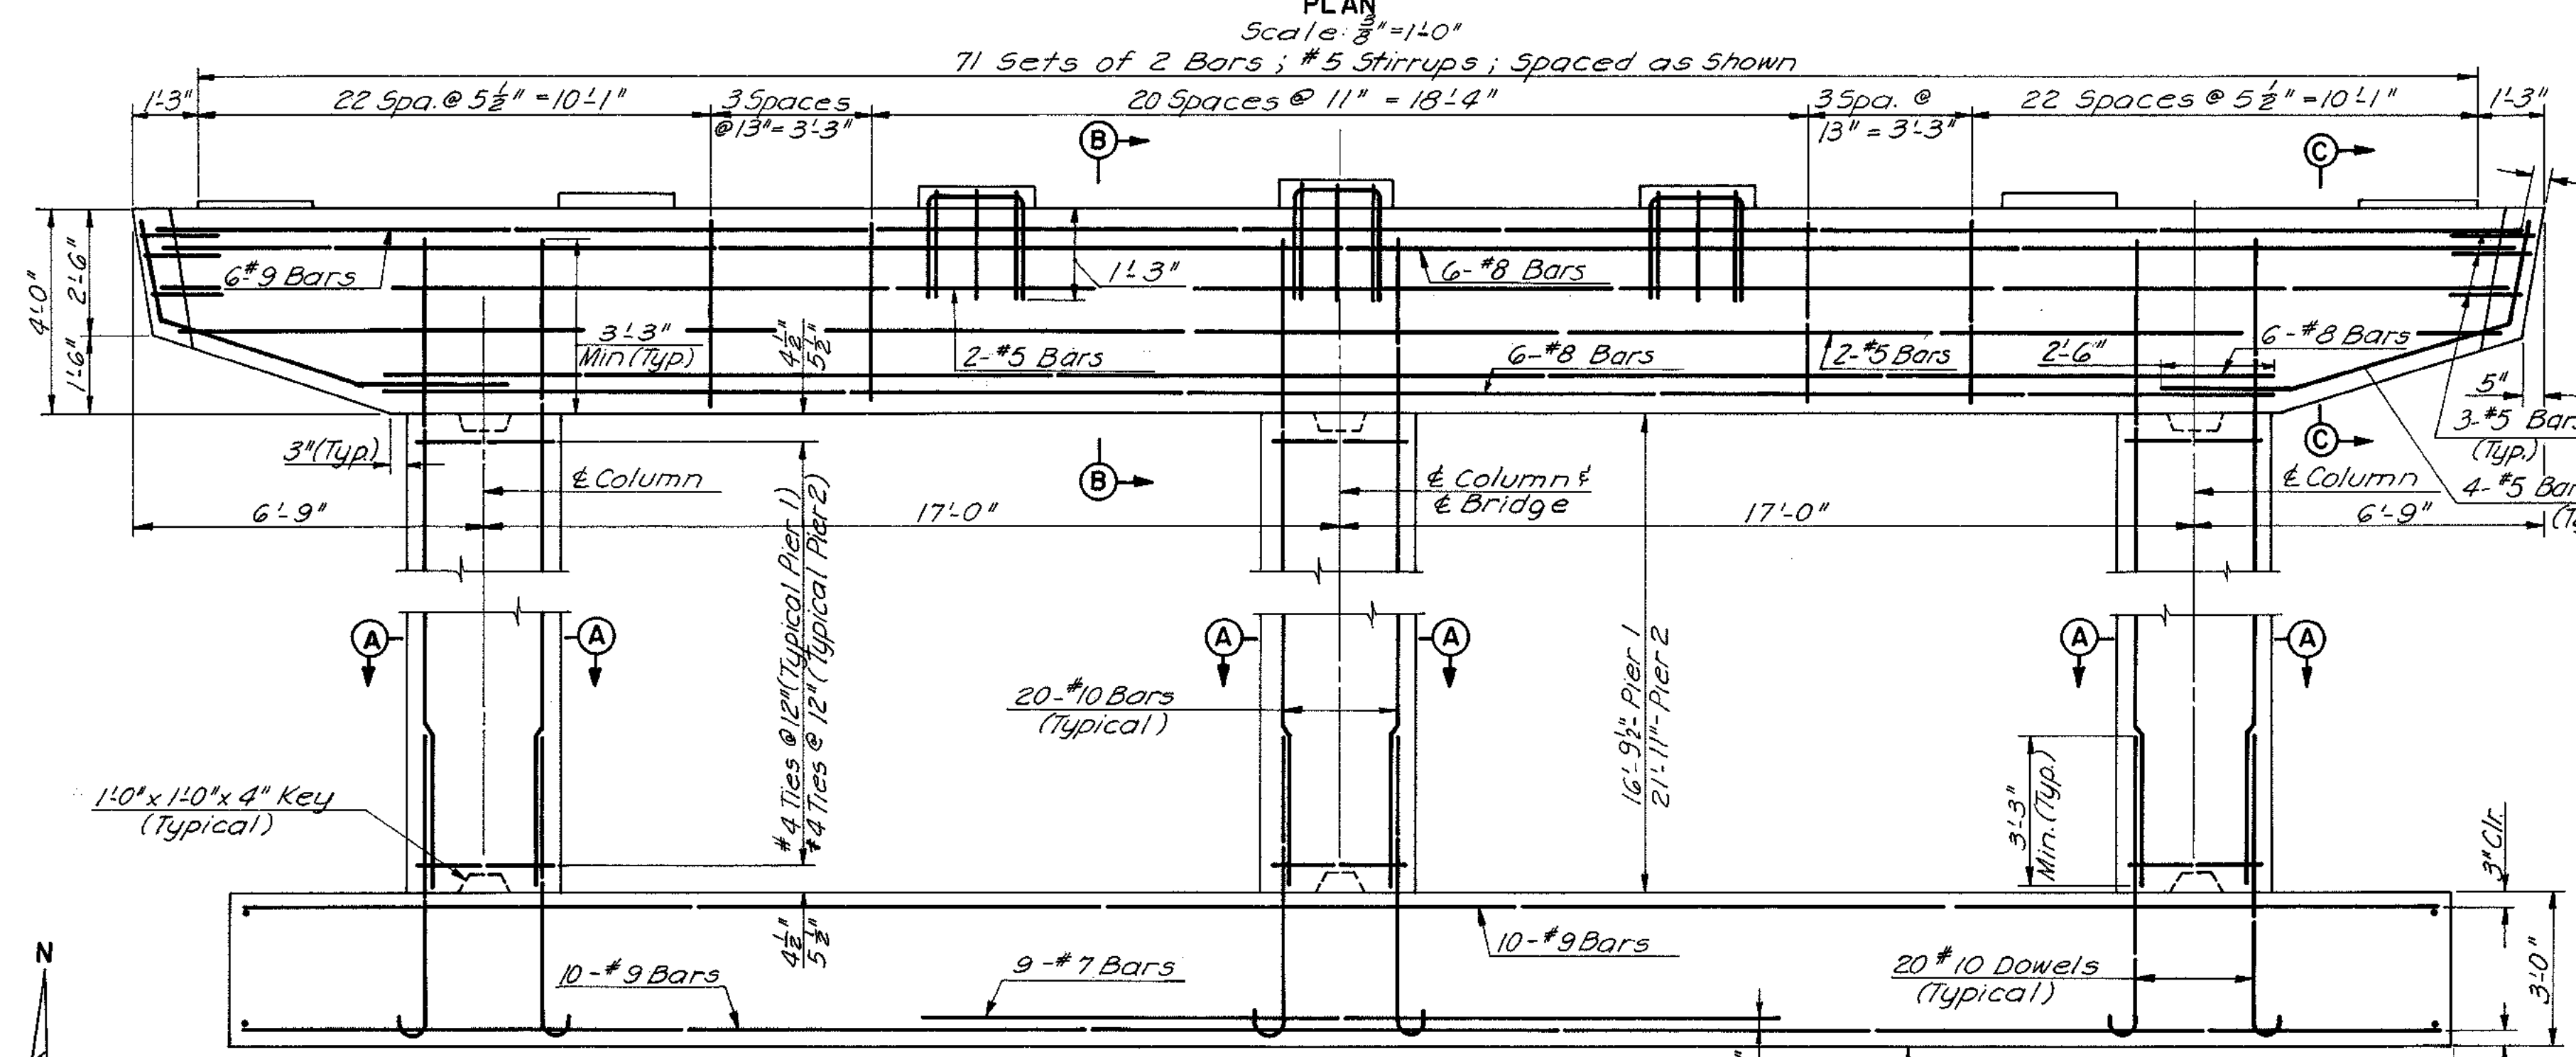

ELEVATION  
Scale: 3/8" = 1'-0"


Footing Elevations  
Elev. 145.00 - Pier 1  
Elev. 141.00 - Pier 2

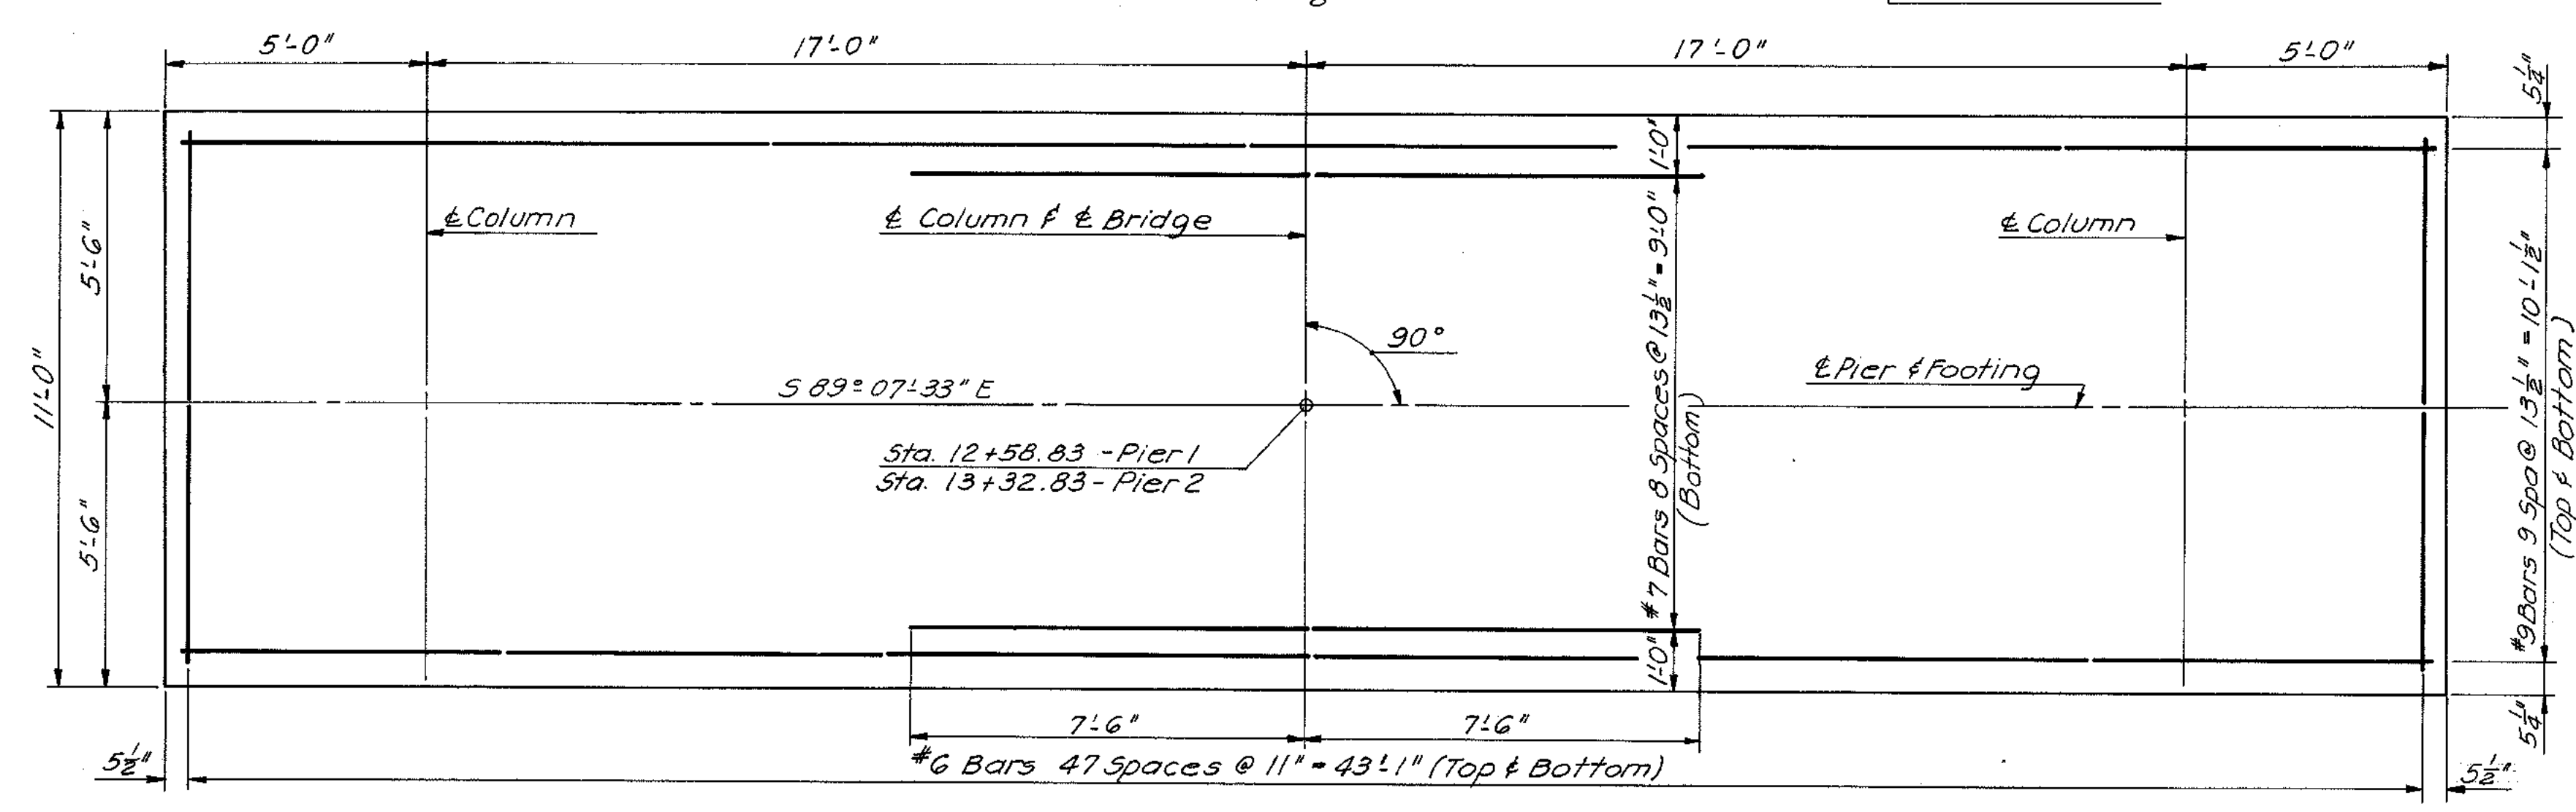


FOOTING PLAN  
Scale: 3/8" = 1'-0"

2" Clearance (Typ.)  
All Pier Cap Steel.


TYPICAL PAD DETAIL  
Scale: 3/8" = 1'-0"  
Reinforcement required only  
in pads showing reinforcing bars.

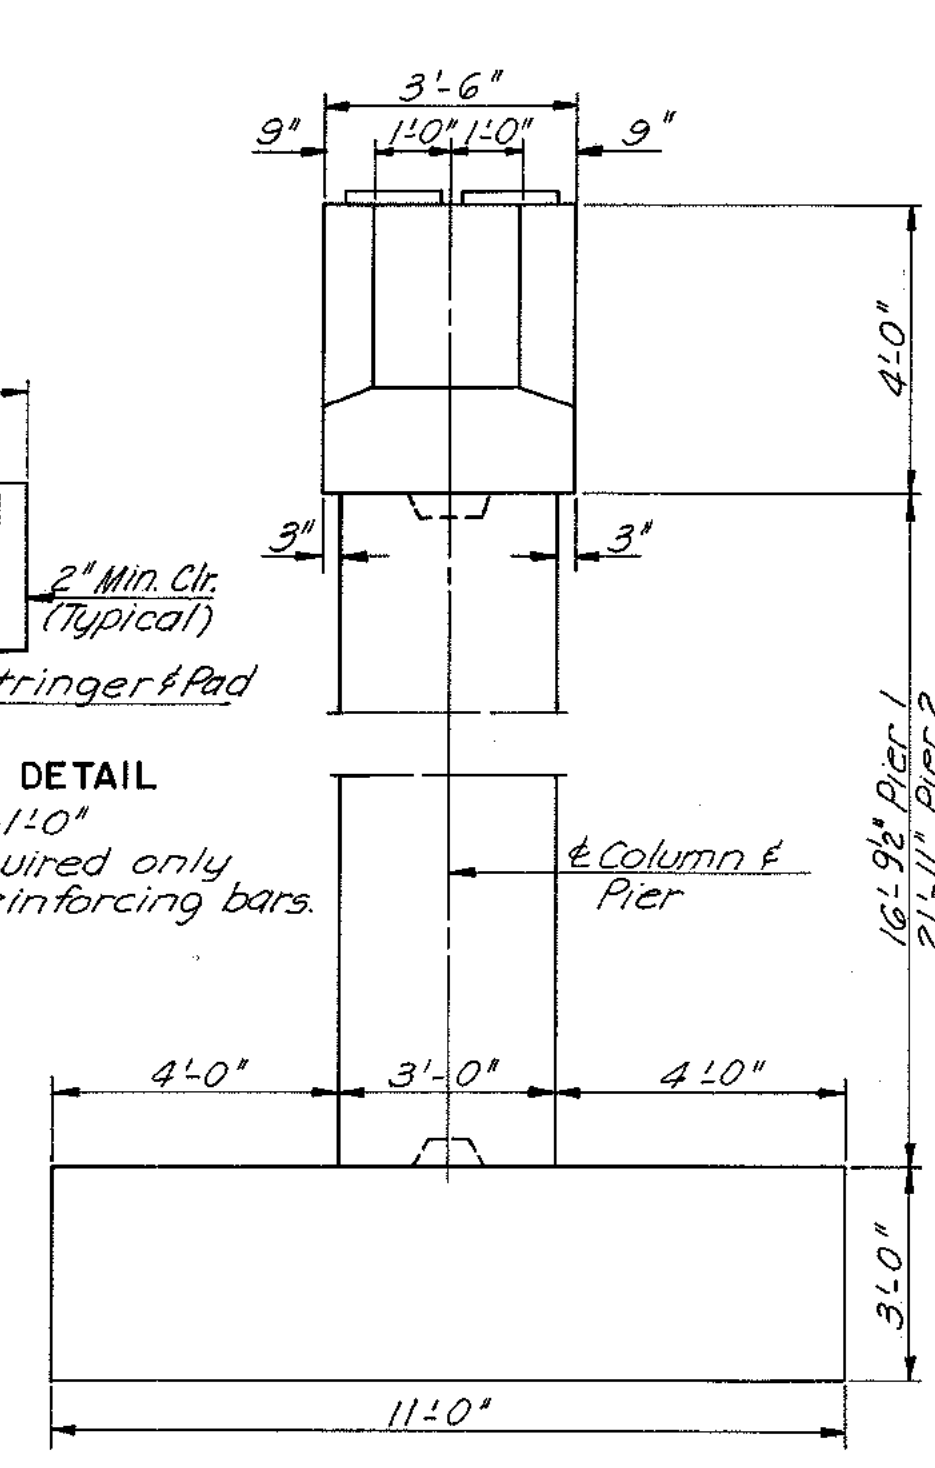

END VIEW  
Scale: 3/8" = 1'-0"

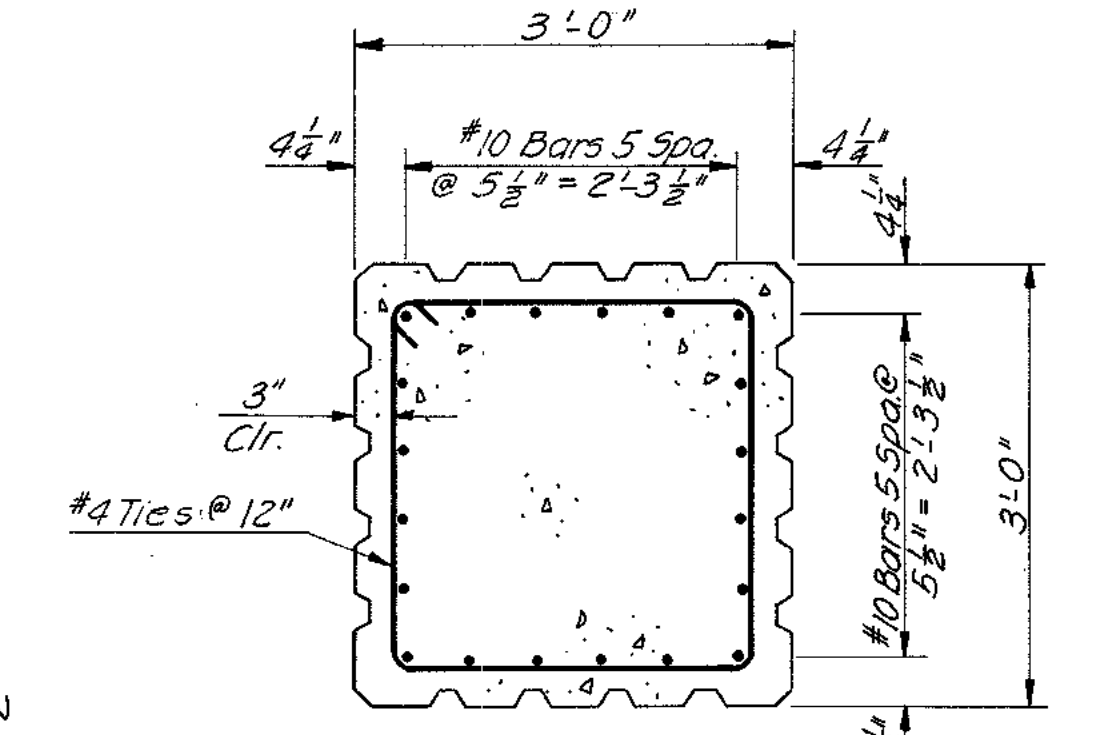

SECTION A-A  
Scale: 3/8" = 1'-0"

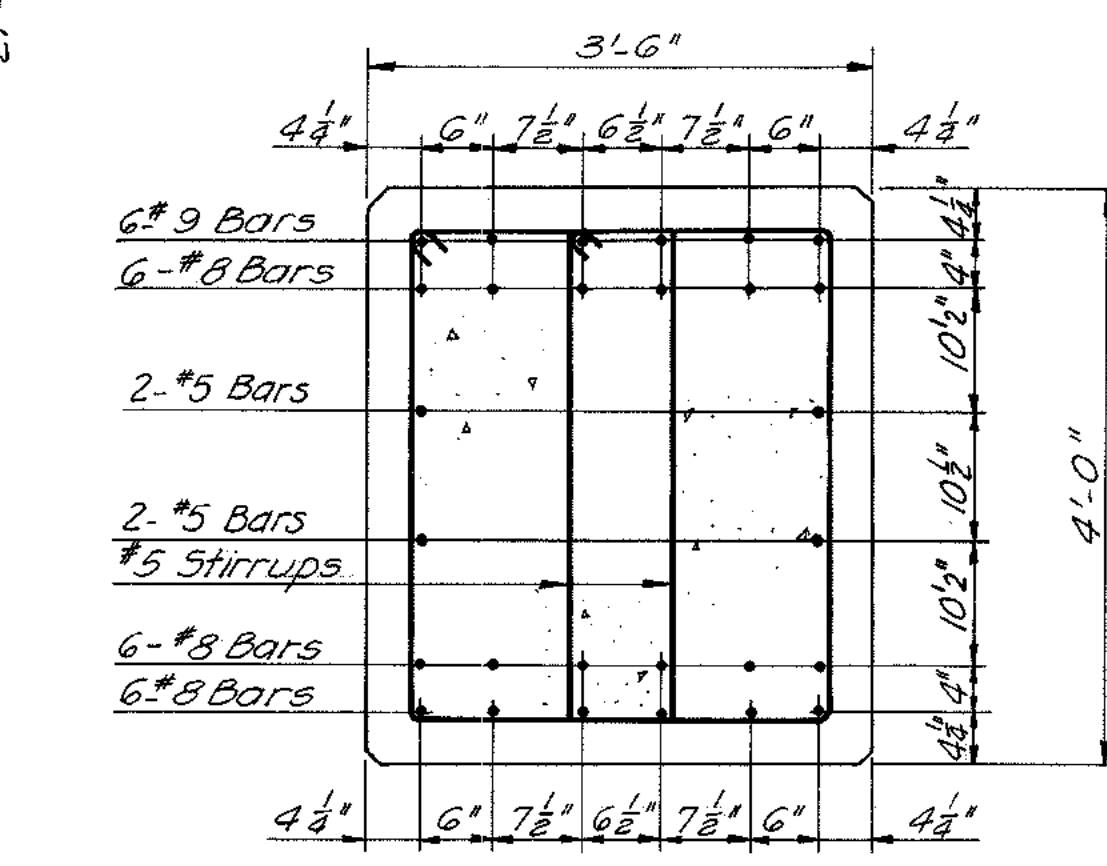

SECTION B-B  
Scale: 3/8" = 1'-0"

**AS BUILT**

NOTES:  
For Framing Plan see Sheet 5.  
For Bearing Details see Sheet 51.  
For General Notes see Sheet 1.  
For Architectural Treatment see Sheet 57 to 59.

Foundation Note:  
Foundation Elevations are approximate only and may be varied to suit field conditions as directed by the Engineer. Vertical Column reinforcing shall not be cut until these elevations are established.  
Where elevations change by more than 2 feet, redesign will be required.  
Pier Foundation is designed for an allowable Bearing Pressure of 2 tons per sq. foot.

RICHMOND METROPOLITAN AUTHORITY	
RICHMOND EXPRESSWAY SYSTEM	
DOWNTOWN EXPRESSWAY	
STRUCTURE B 50	
LAUREL STREET OVER	
DOWNTOWN EXPRESSWAY	
PIER DETAILS	
AMERICAN ENGINEERS Richmond, Virginia	SCALE: AS NOTED
HOWARD, NEEDLES, TAMMEN & BERGENOFF General Consultants	CONTRACT NO.: 8
	SHEET NO. 4 OF 9

BY	DATE				
MADE	T.D.J.	9-67			
CHECKED	W.E.O.	9-67			
IN CHARGE	W.E.O.		NO.	REVISION	BY DATE













RICHMOND EXPRESSWAY SYSTEM			
SECTION	PROJECT	SHEET NO.	TOTAL SHEETS
8	DOWNTOWN EXPRESSWAY	228	

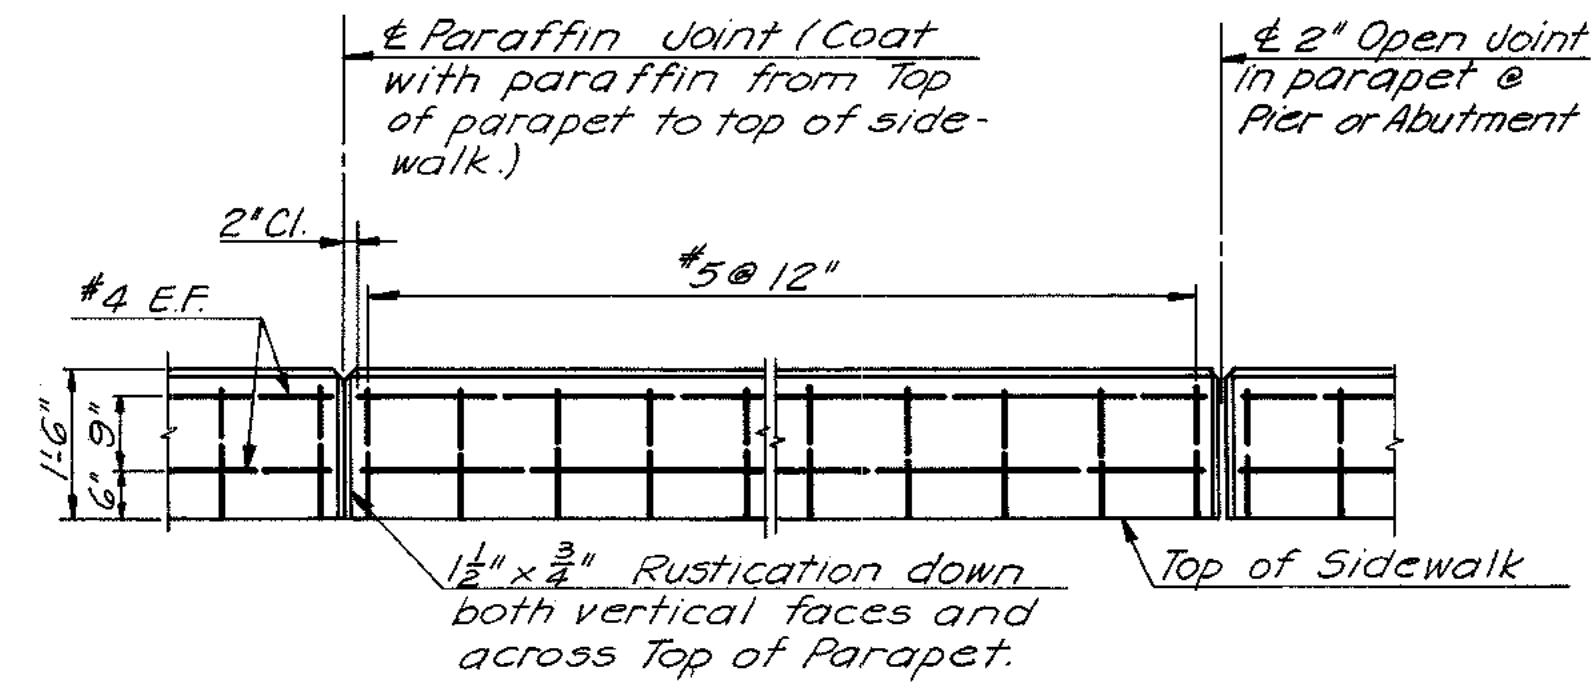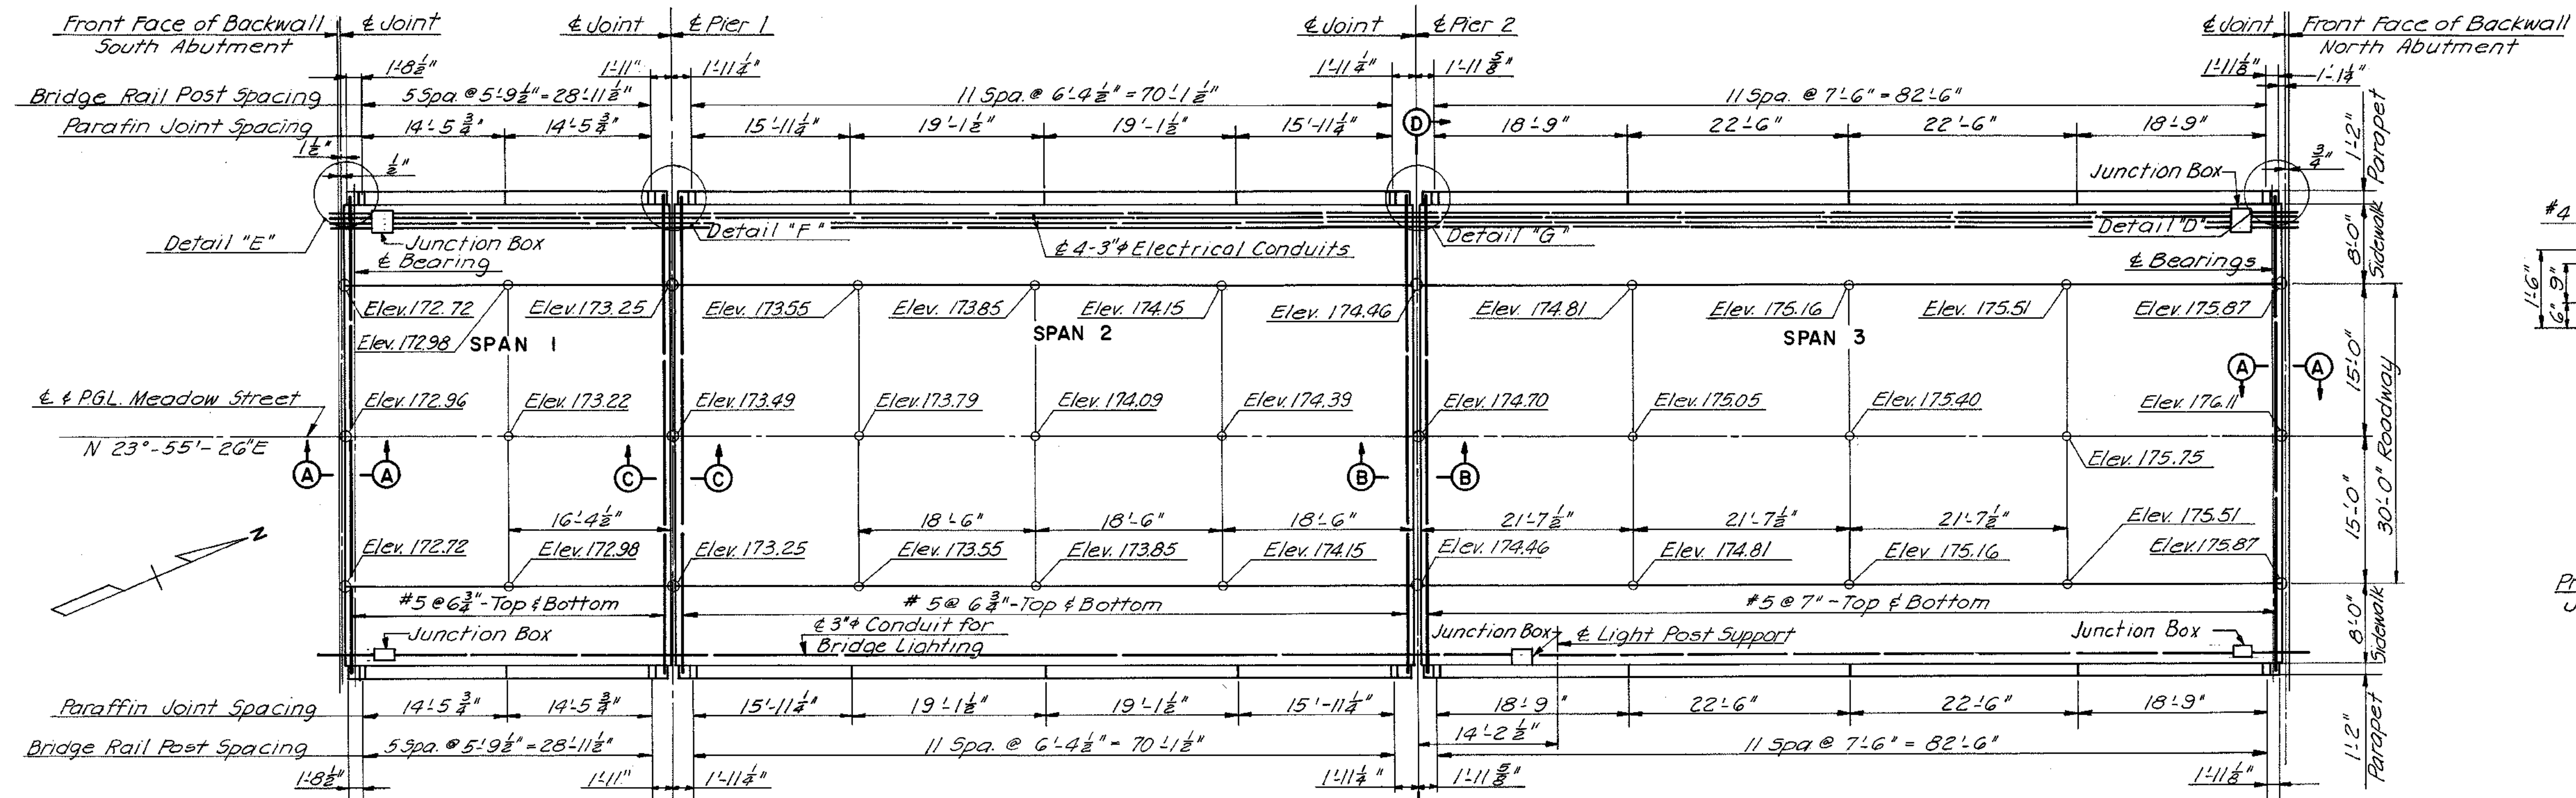


TYPICAL PARAPET ELEVATION  
Scale: 1/2" = 1'-0"

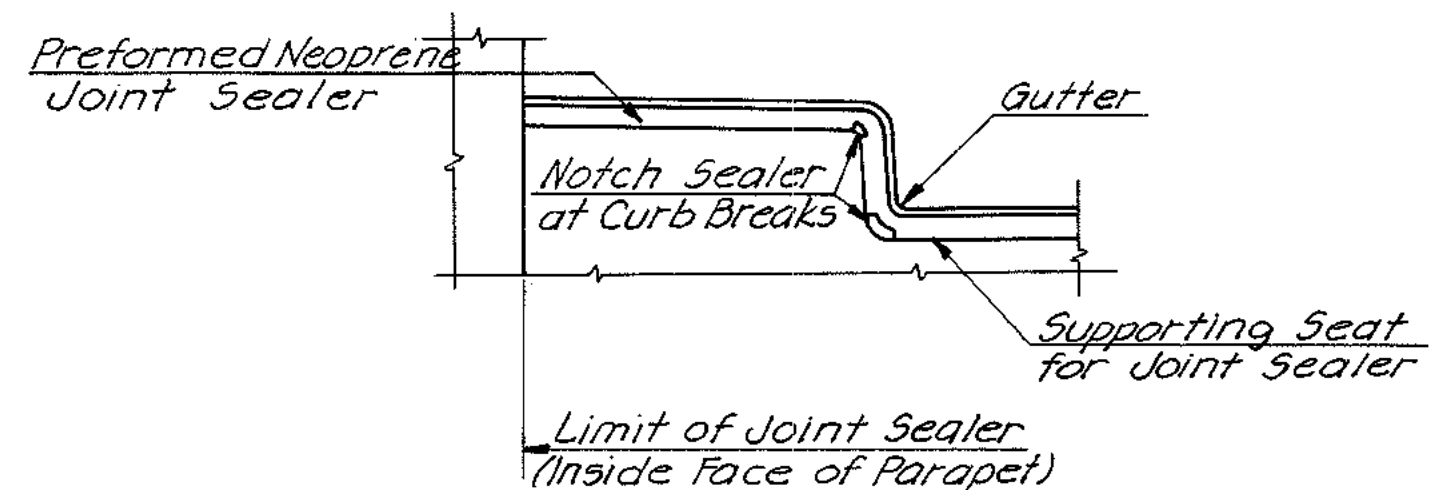


TREATMENT OF JOINT AT CURB  
No Scale

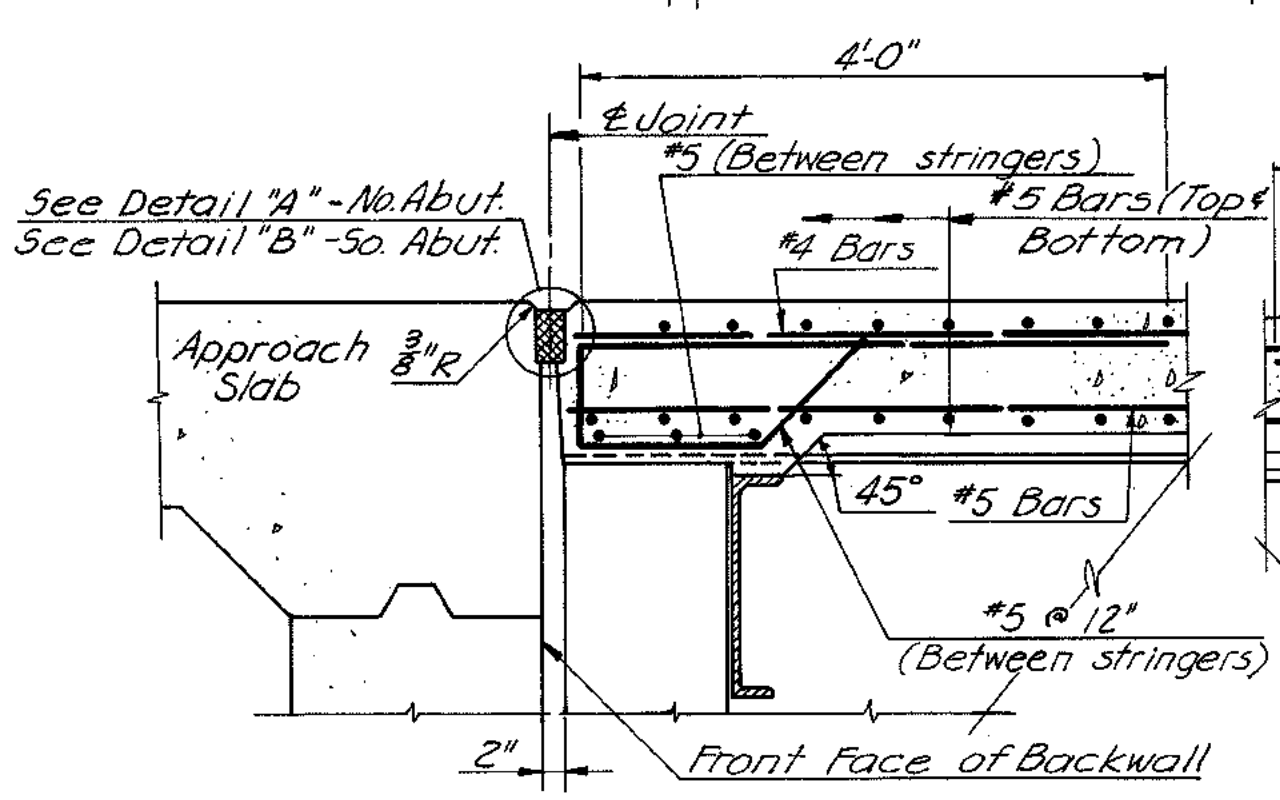


SECTION A-A  
Scale: 3/4" = 1'-0"

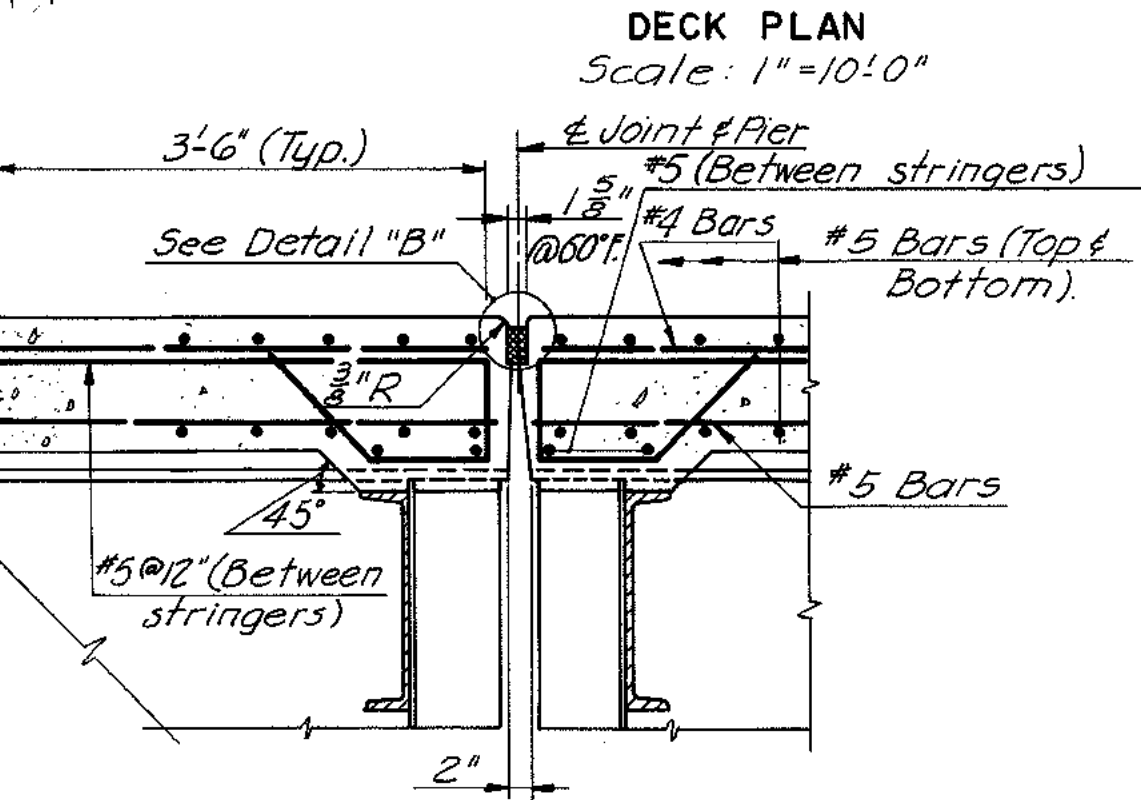


SECTION B-B  
Scale: 3/4" = 1'-0"

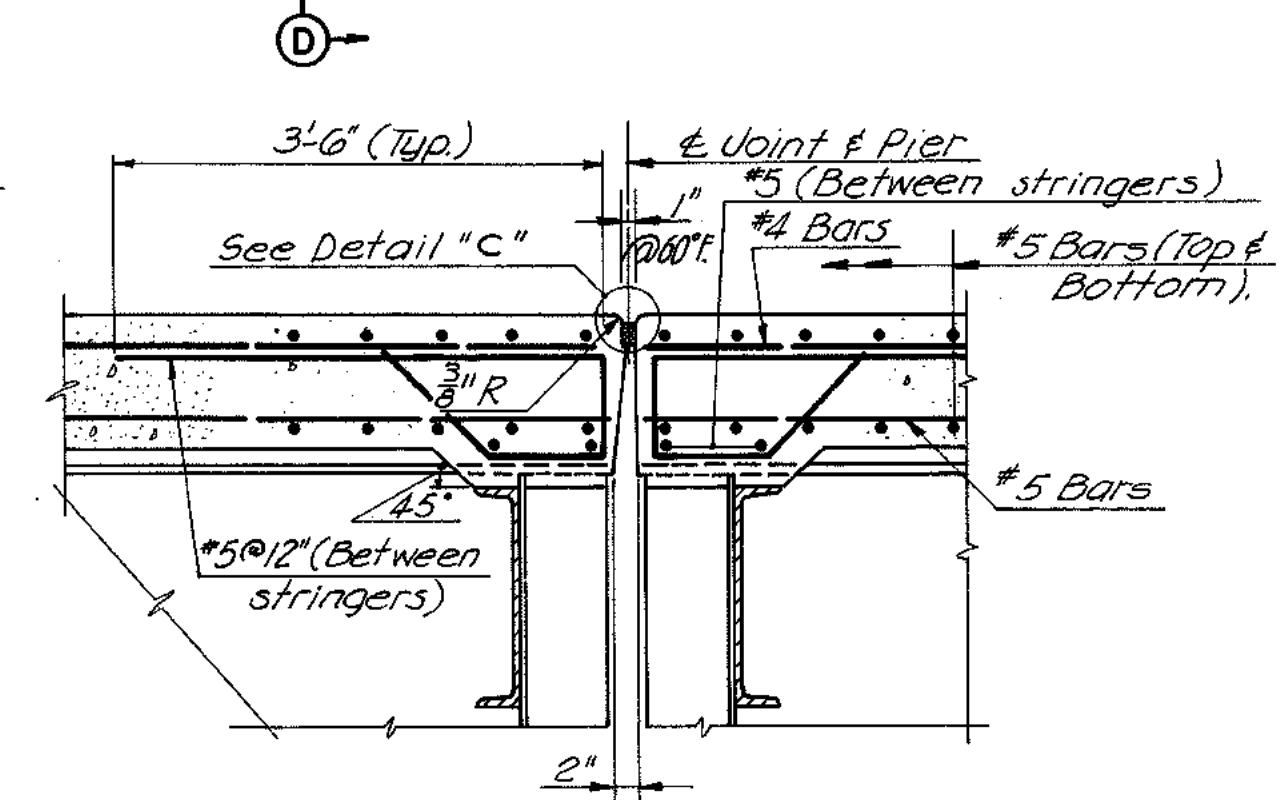

SECTION C-C  
Scale: 3/4" = 1'-0"

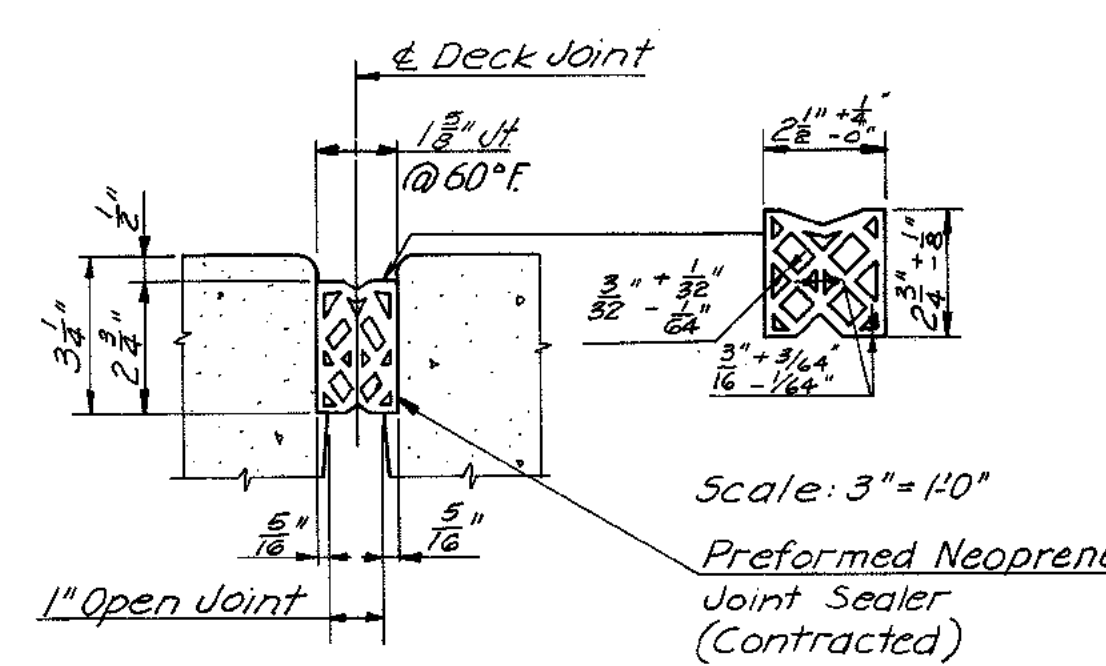

DETAIL "B"  
Scale: 3" = 1'-0"

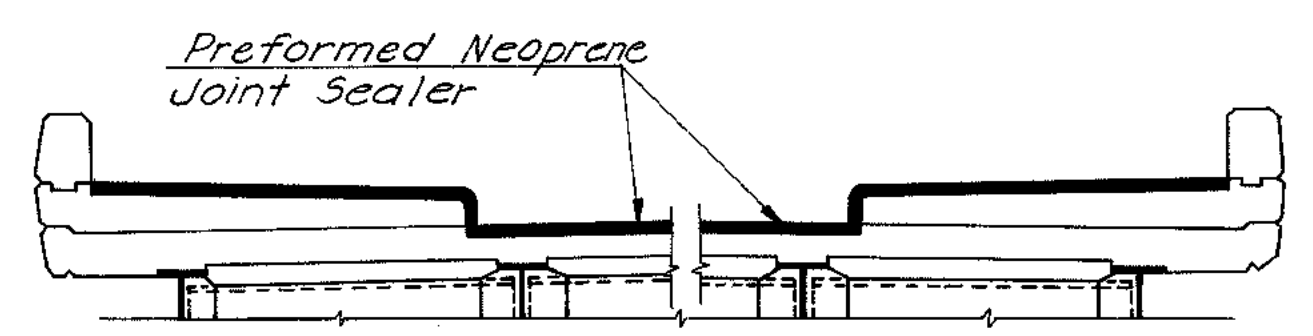

SECTION D-D  
Scale: 1/4" = 1'-0"

NOTES:  
For Typical Deck Cross Section, see Sheet 6.  
For General Notes, see Sheet 1.  
For Framing Plan, see Sheet 5.  
For Railing Details, see Sheet 53.  
For Light Post Support Details, see Sheet 54.

**AS BUILT**

RICHMOND METROPOLITAN AUTHORITY  
RICHMOND EXPRESSWAY SYSTEM  
DOWNTOWN EXPRESSWAY

STRUCTURE B50  
LAUREL STREET OVER  
DOWNTOWN EXPRESSWAY  
DECK PLAN AND JOINT DETAILS

AMERICAN ENGINEERS Richmond, Virginia	SCALE: AS NOTED
HOWARD, NEEDLES, TAMMEN & BERGENDOFF General Consultants	CONTRACT NO. 8
	SHEET NO. 7 OF 9

BY	DATE				
MADE	RPR	8-67			
CHECKED	WEO	9-67			
IN CHARGE	WEO		NO.	REVISION	BY DATE

Note to Contractor:  
It is absolutely essential that the openings for the preformed neoprene joint sealers be accurately formed and constructed to smooth, straight lines. The size of the opening shall be adjusted to allow for anticipated dead load rotation of the ends of the slab and for the temperature at the time of construction.






# **Bridge 51**

**Belvidere Street (US 1 and US 301)  
Over  
Downtown Expressway (VA 195)**

**Record Set Plans**




RICHMOND EXPRESSWAY SYSTEM			
SECTION	PROJECT	SHEET NO.	TOTAL SHEETS
8	DOWNTOWN EXPRESSWAY	231	

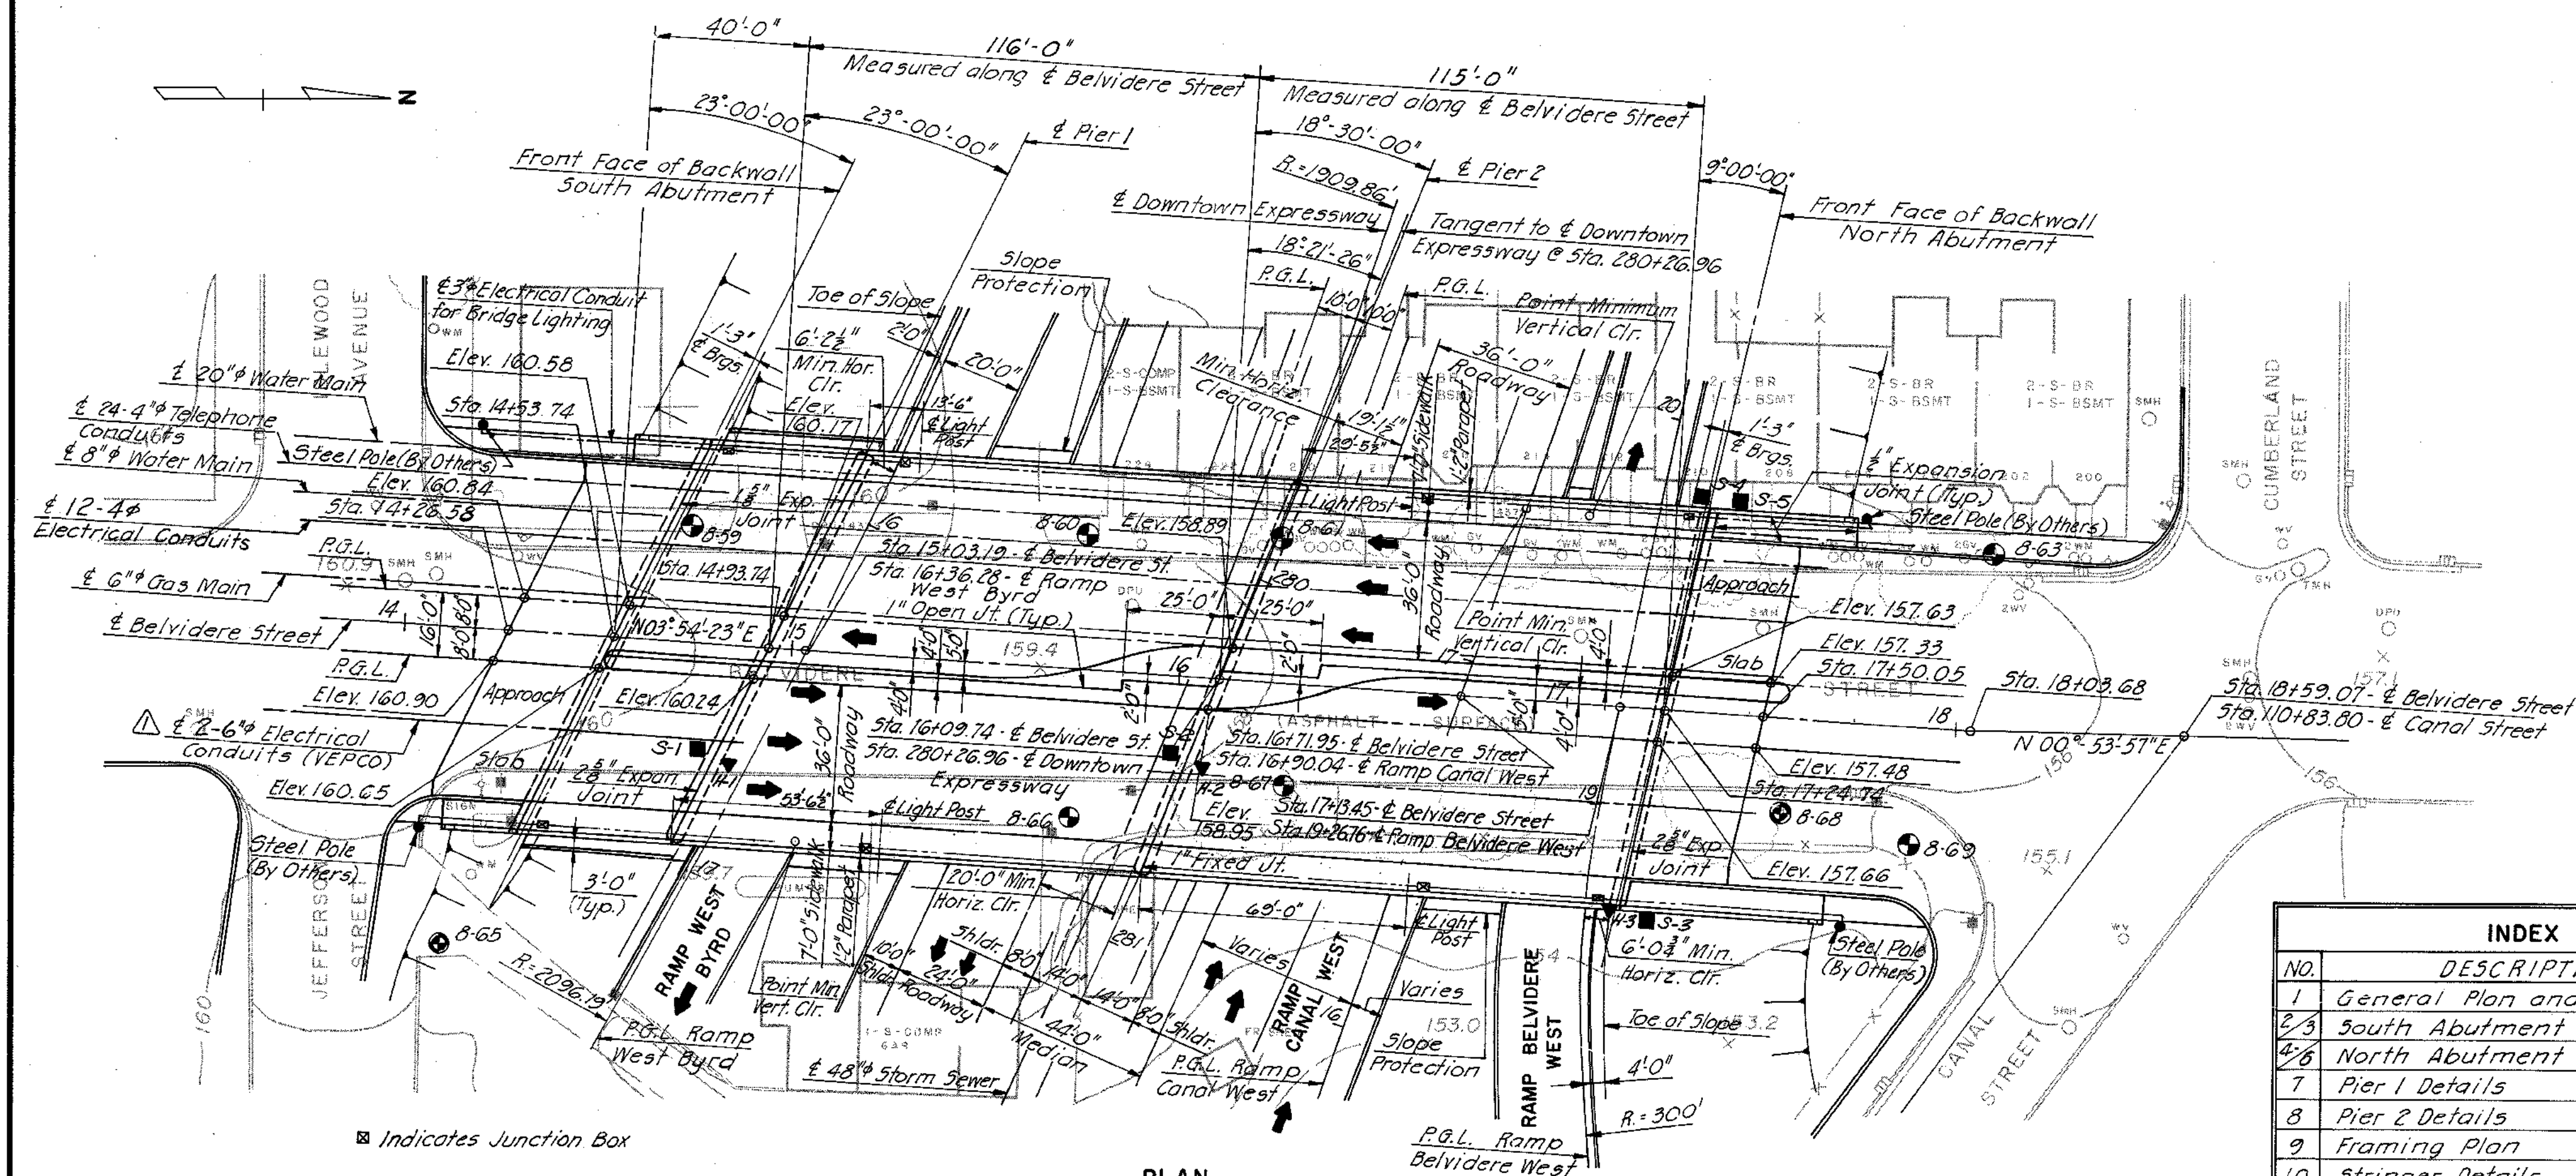

- GENERAL NOTES:**
- ROADWAY:** Two 36'-0" Clear roadways. Two 7'-0" Sidewalks. One variable median.
- CAPACITY:** Dead Load - includes 15 lbs. per sq. ft. for future wearing surface. Live Loads - HS20-44 loading and B.P.R. modified for military vehicles.
- SPECIFICATIONS:** GENERAL - Virginia Department of Highway Road and Bridge Specifications 1970. DESIGN - A.A.S.H.O. Standard Specifications for Highway Bridges, 1961 modified by Special Design Provisions. WELDING - 1969 Standard Specifications for welded Highway and Railway Bridges of the American Welding Society.
- CONTRACT SPECIAL PROVISIONS:** Specifications and Contract Special Provisions referred to above are necessary to make these Plans complete.
- DATUM:** CITY OF RICHMOND
- TEMPERATURE:** The normal temperature referred to on the plan is 60°F. The temperature range for movement is 0°F to 120°F.
- DIMENSIONS:** All dimensions are measured horizontally and vertically unless otherwise noted.
- EXCAVATION:** Excavation below subgrade and cut slope template shall be classified as Structure Excavation. All excavation above these limits shall be classified as Regular Excavation and is not included in the Structural Quantities.
- FOUNDATIONS:** Footings shall rest on firm material. Foundation material shall be kept dry and special attention is called to Section 401.05 of the General Specifications, and to the Contract Special Provisions, concerning preparation of foundations for footings.

INDEX	
NO.	DESCRIPTION
1	General Plan and Elevation
2/3	South Abutment
4/6	North Abutment
7	Pier 1 Details
8	Pier 2 Details
9	Framing Plan
10	Stringer Details
11	Cross Section
12	Diaphragm Details
13	Utility Details
14	Deck Plan
15	Joint Details
16	Approach Slab - South Abutment
17	Approach Slab - North Abutment
18	Slope Protection Details
19/21	Boring Logs
51	Standard Shoe Details
53	Standard Aluminum Railing Details
54	Standard Electrical Details
55/28	Standard Architectural Details
510	Standard Elect and Tele Cond Details
511	Standard Utility Support details @ Abut.

- CONCRETE NOTES:**
- Concrete in superstructure shall be Class A4. All other concrete shall be Class A3. All exposed edges and corners shall have a 3/8" chamfer or fillet unless otherwise noted. Care in the method of vibration, the use of low-slump concrete and/or other means shall be employed to prevent downgrade movement of newly placed slab concrete. (When gradient is over 2%).
- Finishing concrete surfaces: See the Standard Architectural Detail Sheets and the Contract Special Provisions for types and details.
- All reinforcing steel shall conform to ASTM A615 Grade 40. All reinforcing bar dimensions on the detailed drawings are to centers of bars unless otherwise noted. Clear distance between reinforcing steel and face of concrete shall be as noted on the plans. All bar laps shall be 30 diameters of the smaller diameter bar unless otherwise noted.
- STEEL NOTES:**
- Structural steel shall conform to A.S.T.M. Specification A36 except as noted. All field connections shall be made with high strength bolts. High strength bolts shall be 3/4" unless otherwise noted and shall conform to A.S.T.M. Specification A-325.
- BENCH MARK:** C-40 Monument located at S.E. corner Idlewood Avenue and Belvidere Street. Elev. 160.76.

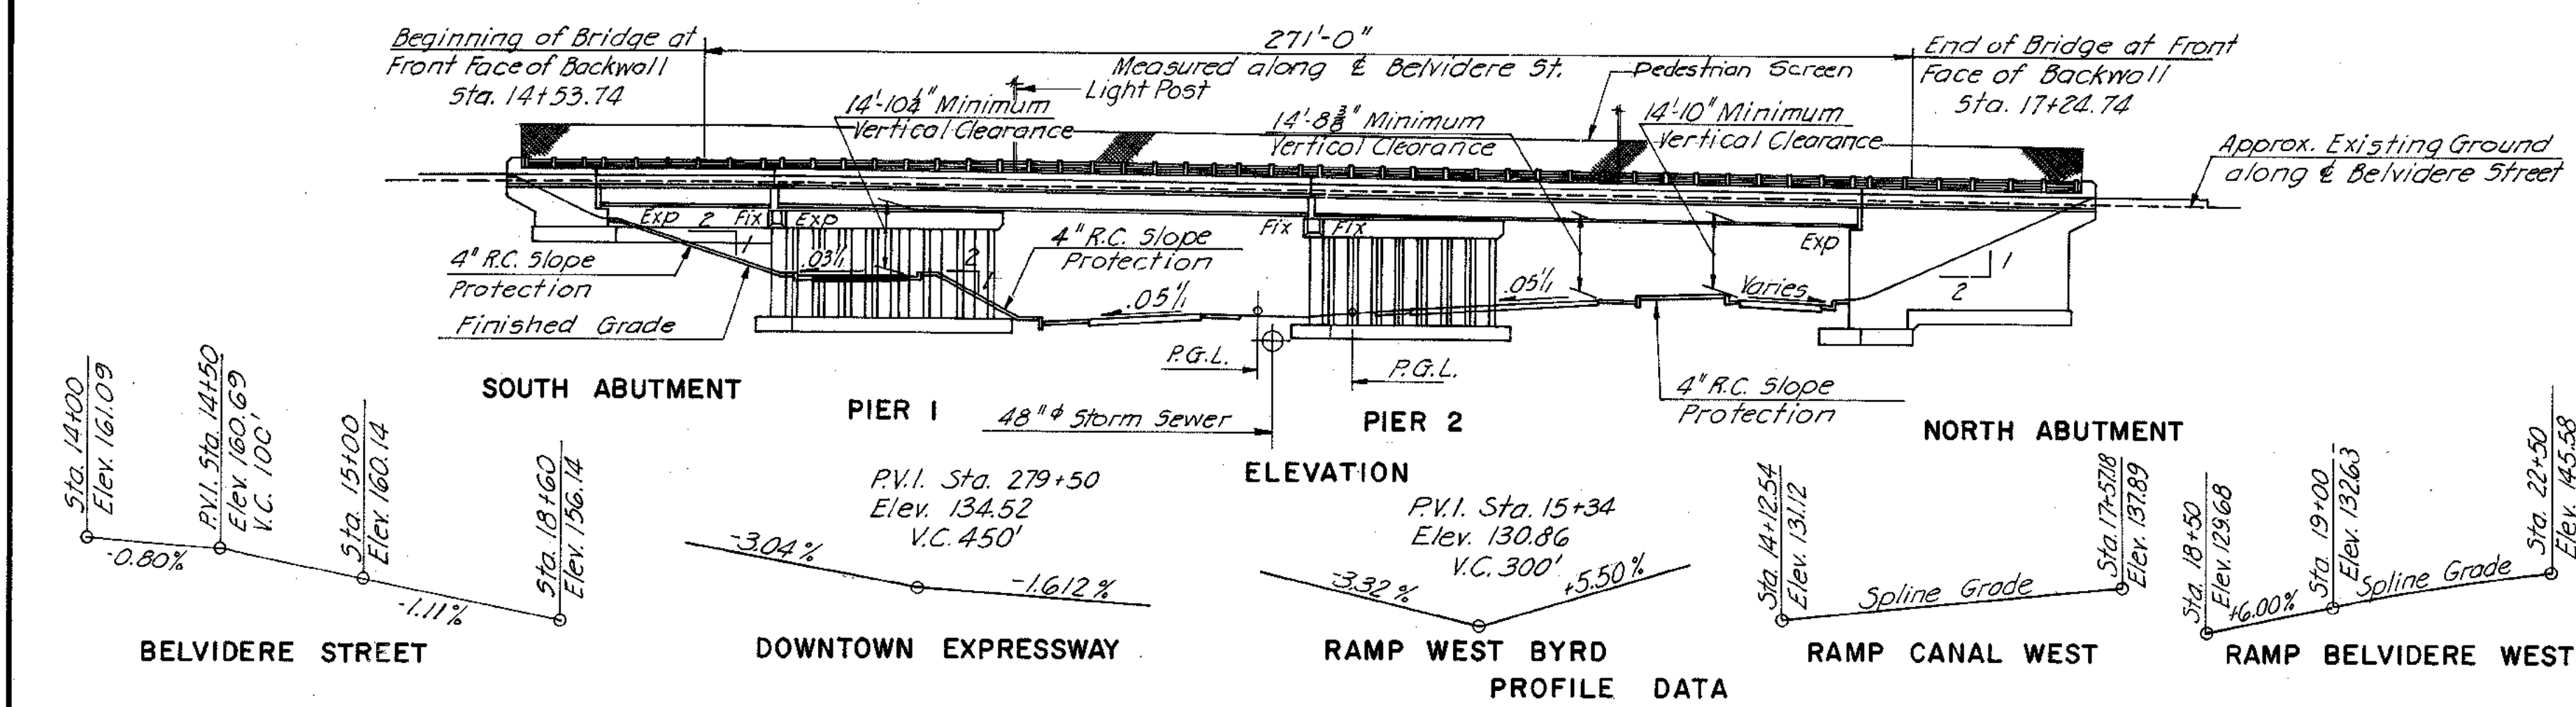

ESTIMATED QUANTITIES														
	STRUCTURE EXCAVATION	CONCRETE CLASS A4	CONCRETE CLASS A5	REINFORCING STEEL	STRUCTURAL STEEL	ALUMINUM BRIDGE RAILING	CONCRETE SLAB SLOPE PROTECTION	ASPHALT DAMP-PROOFING	6" INCH PIPE UNDERDRAIN	POROUS BACKFILL	GAS MAIN 6" Ø	WATER MAIN 20" Ø	WATER MAIN 8" Ø	CONDUIT 6" Ø VEP
	C.Y.	C.Y.	C.Y.	LBS.	LBS.	L.F.	S.Y.	S.Y.	L.F.	C.Y.	L.F.	L.F.	L.F.	L.F.
Superstructure		962.16		224,141	1,324,511.8	658					323	247	313	664
South Abutment	475		234.47	11,589			564.9	228	126	76				6,504
Pier 1	598		258.89	50,865			295.1							665
Pier 2	318		258.71	48,366										3,252
North Abutment	1,194		891.55	75,607			131.2	468	170	289				570
Approach Slabs			258.08	58,162										16
Total	2,585	962.16	1,901.70	468,730	1,324,511.8	658	991.2	696	296	365	323	247	313	664

BY	DATE	AS BUILT	HMW	4-76
MADE	WDO 10-67	REV. VEP	DGT	11-274
CHECKED	WEO 12-67	NO.	REVISION	BY
IN CHARGE	WEO	NO.	REVISION	BY

NOTES: Top of Pavement Elevations at ends of Deck along P.G.L.'s are given on Plan; Remaining Pavement Elevations are given on Sheet 14.

● Indicates 2" Cased Hole Boring.

○ Indicates 4" Cased Hole Boring.

▼ Indicates Geonor Heave Points

■ Indicates Settlement Points

# AS BUILT

**RICHMOND METROPOLITAN AUTHORITY**  
**RICHMOND EXPRESSWAY SYSTEM**  
DOWNTOWN EXPRESSWAY

**STRUCTURE B 51**  
**BELVIDERE STREET OVER**  
**DOWNTOWN EXPRESSWAY**

**GENERAL PLAN AND ELEVATION**

AMERICAN ENGINEERS  
Richmond, Virginia

HOWARD, NEEDLES, TAMMEN & BERGENDOFF  
General Consultants


SCALE: 1"=30'-0"

CONTRACT NO.: 8

SHEET NO. 1 OF 21



RICHMOND EXPRESSWAY SYSTEM			
SECTION	PROJECT	SHEET NO.	TOTAL SHEETS
8	DOWNTOWN EXPRESSWAY	237	

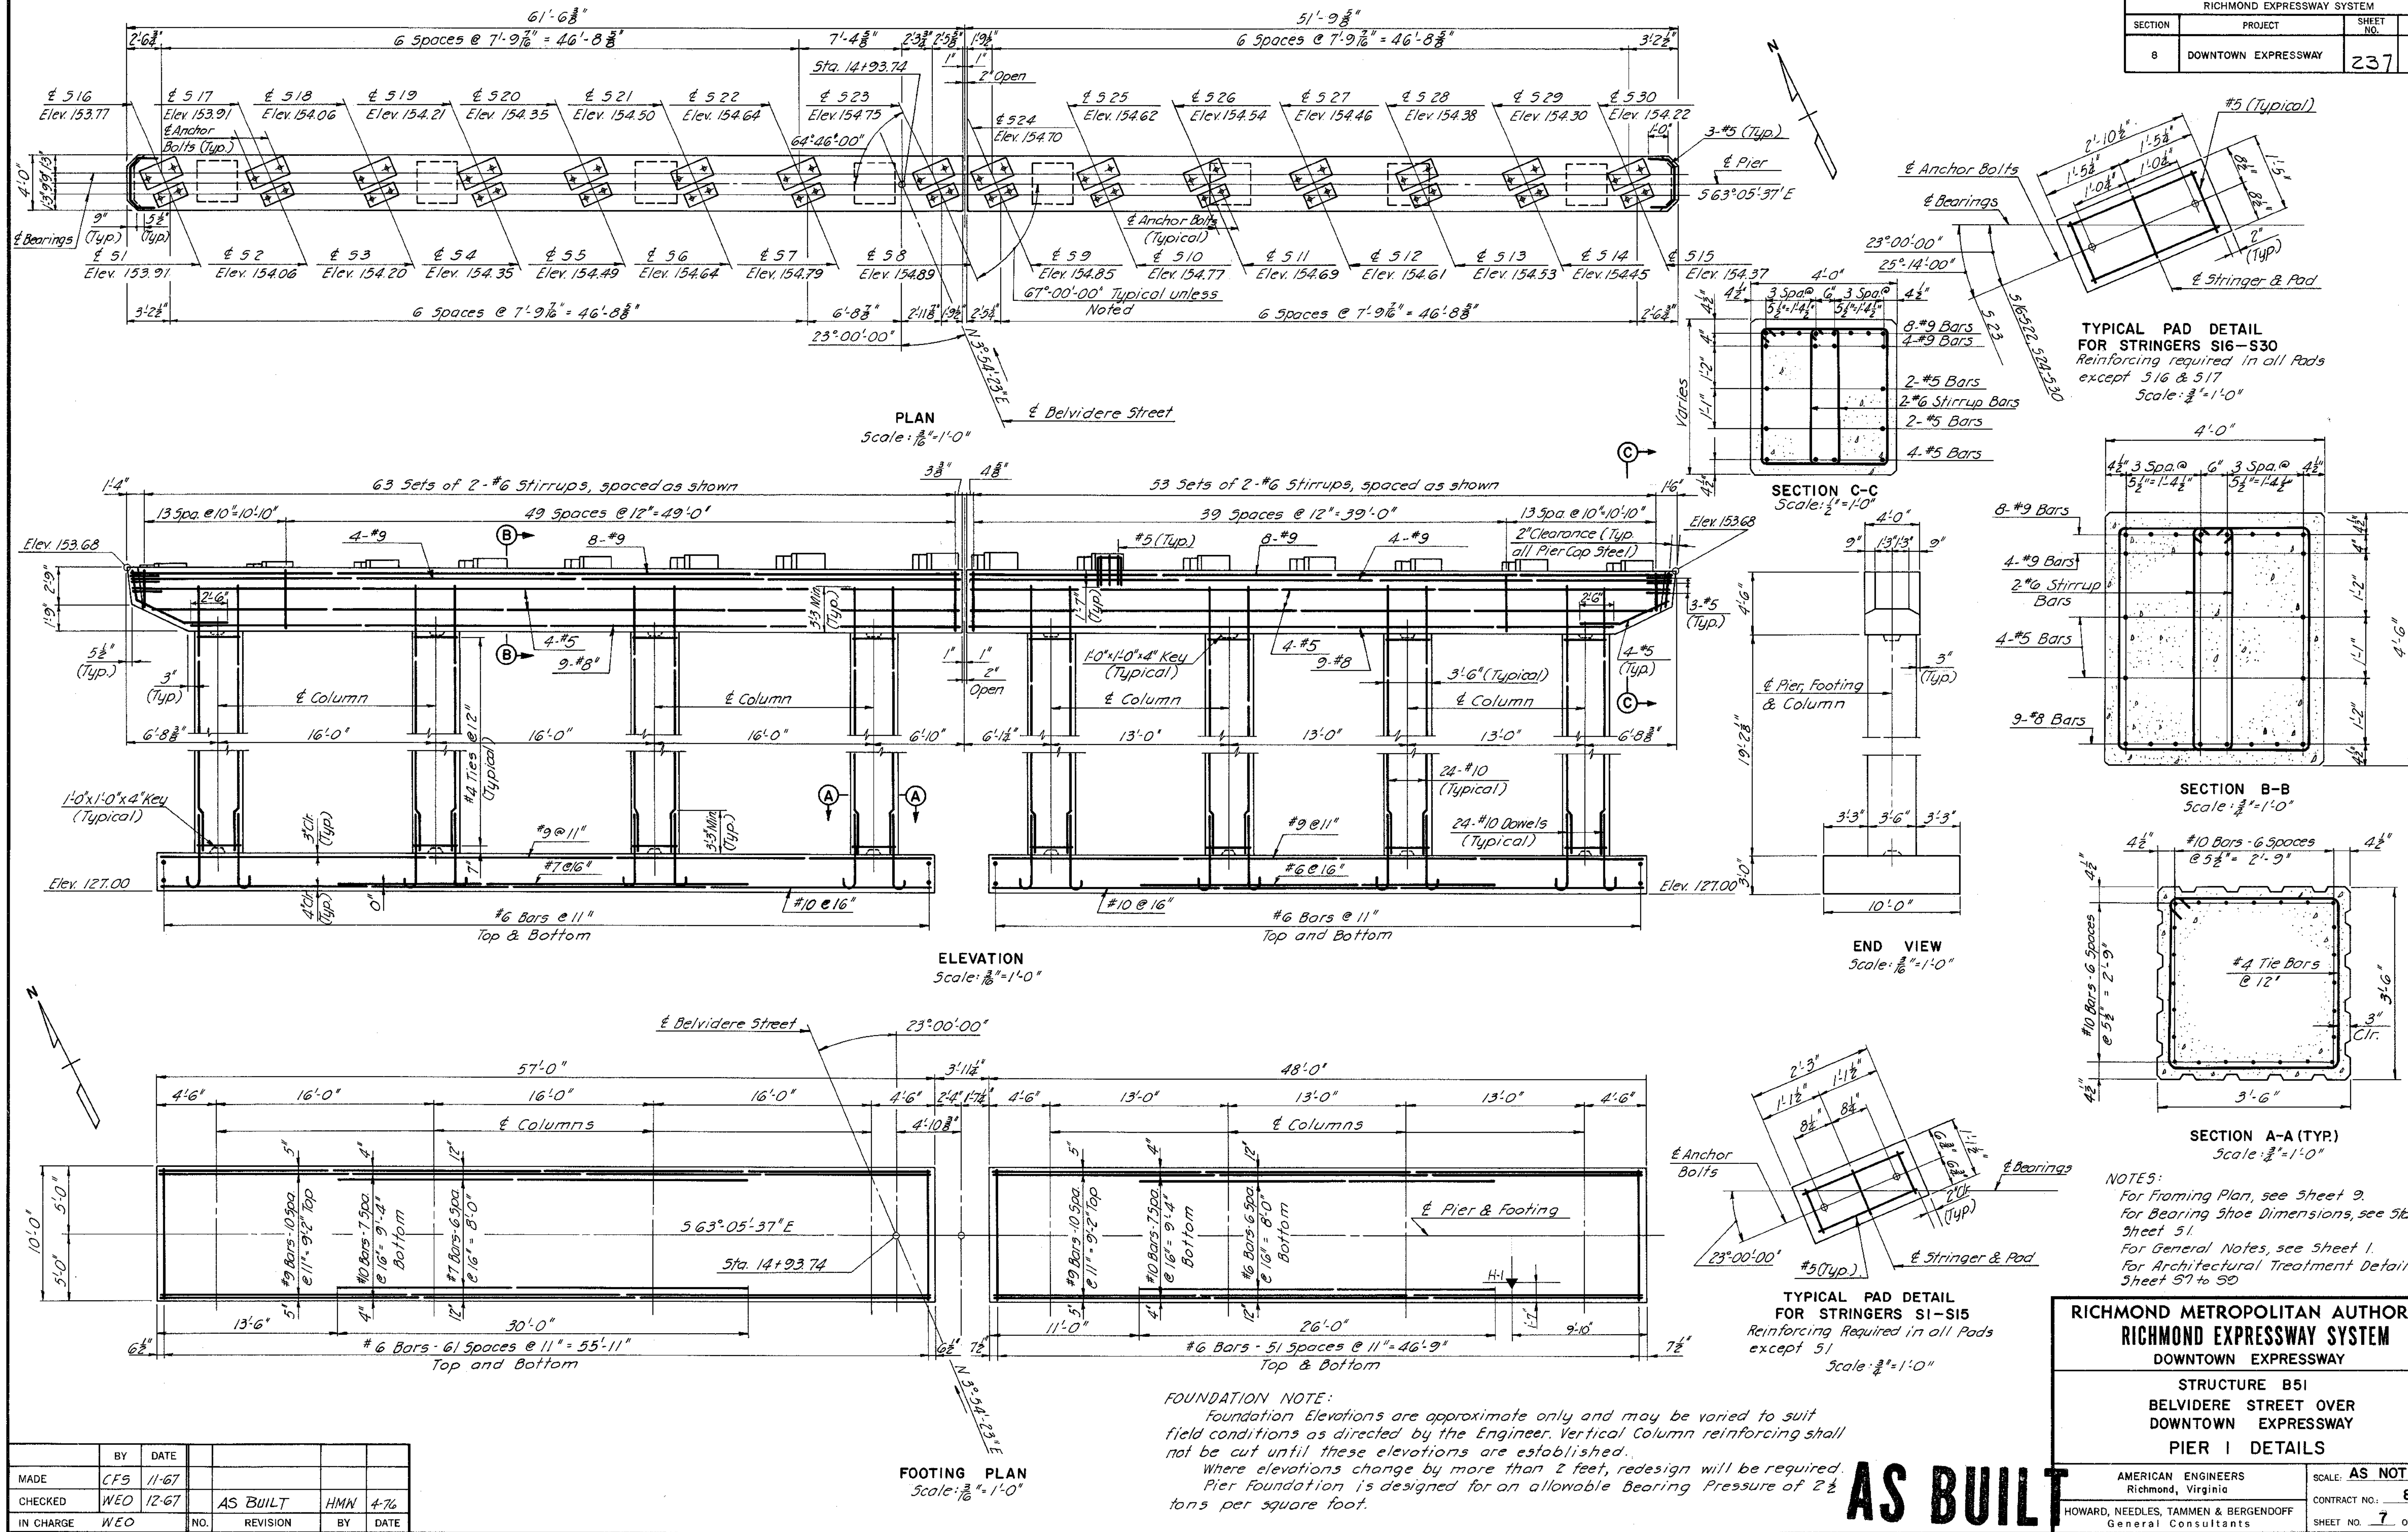


MADE	BY	DATE	NO.	REVISION	BY	DATE
CFS	WEO	11-67				
CHECKED	WEO	12-67				
IN CHARGE	WEO					


RICHMOND METROPOLITAN AUTHORITY		RICHMOND EXPRESSWAY SYSTEM	
DOWNTOWN EXPRESSWAY		STRUCTURE B51	
		BELVIDERE STREET OVER DOWNTOWN EXPRESSWAY	
		PIER 1 DETAILS	
AMERICAN ENGINEERS		SCALE: AS NOTED	
Richmond, Virginia		CONTRACT NO. 8	
HOWARD, NEEDLES, TAMMEN & BERGENDOFF		SHEET NO. 7 OF 21	
General Consultants			




RICHMOND EXPRESSWAY SYSTEM			
SECTION	PROJECT	SHEET NO.	TOTAL SHEETS
8	DOWNTOWN EXPRESSWAY	238	

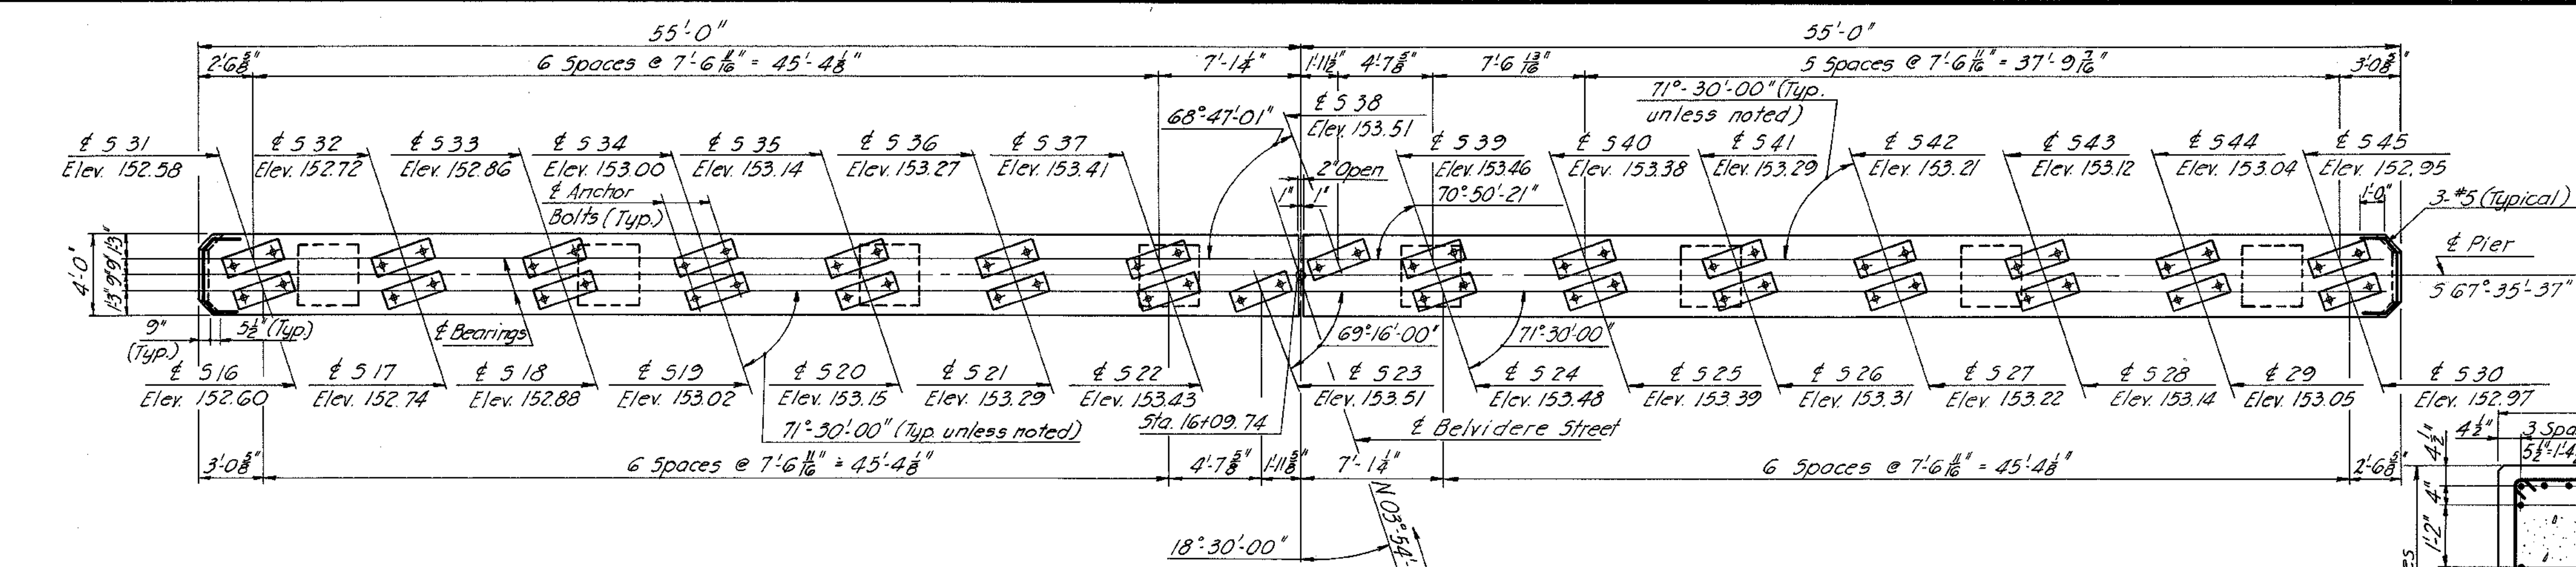


PLAN  
Scale:  $\frac{1}{8}$ " = 1'-0"

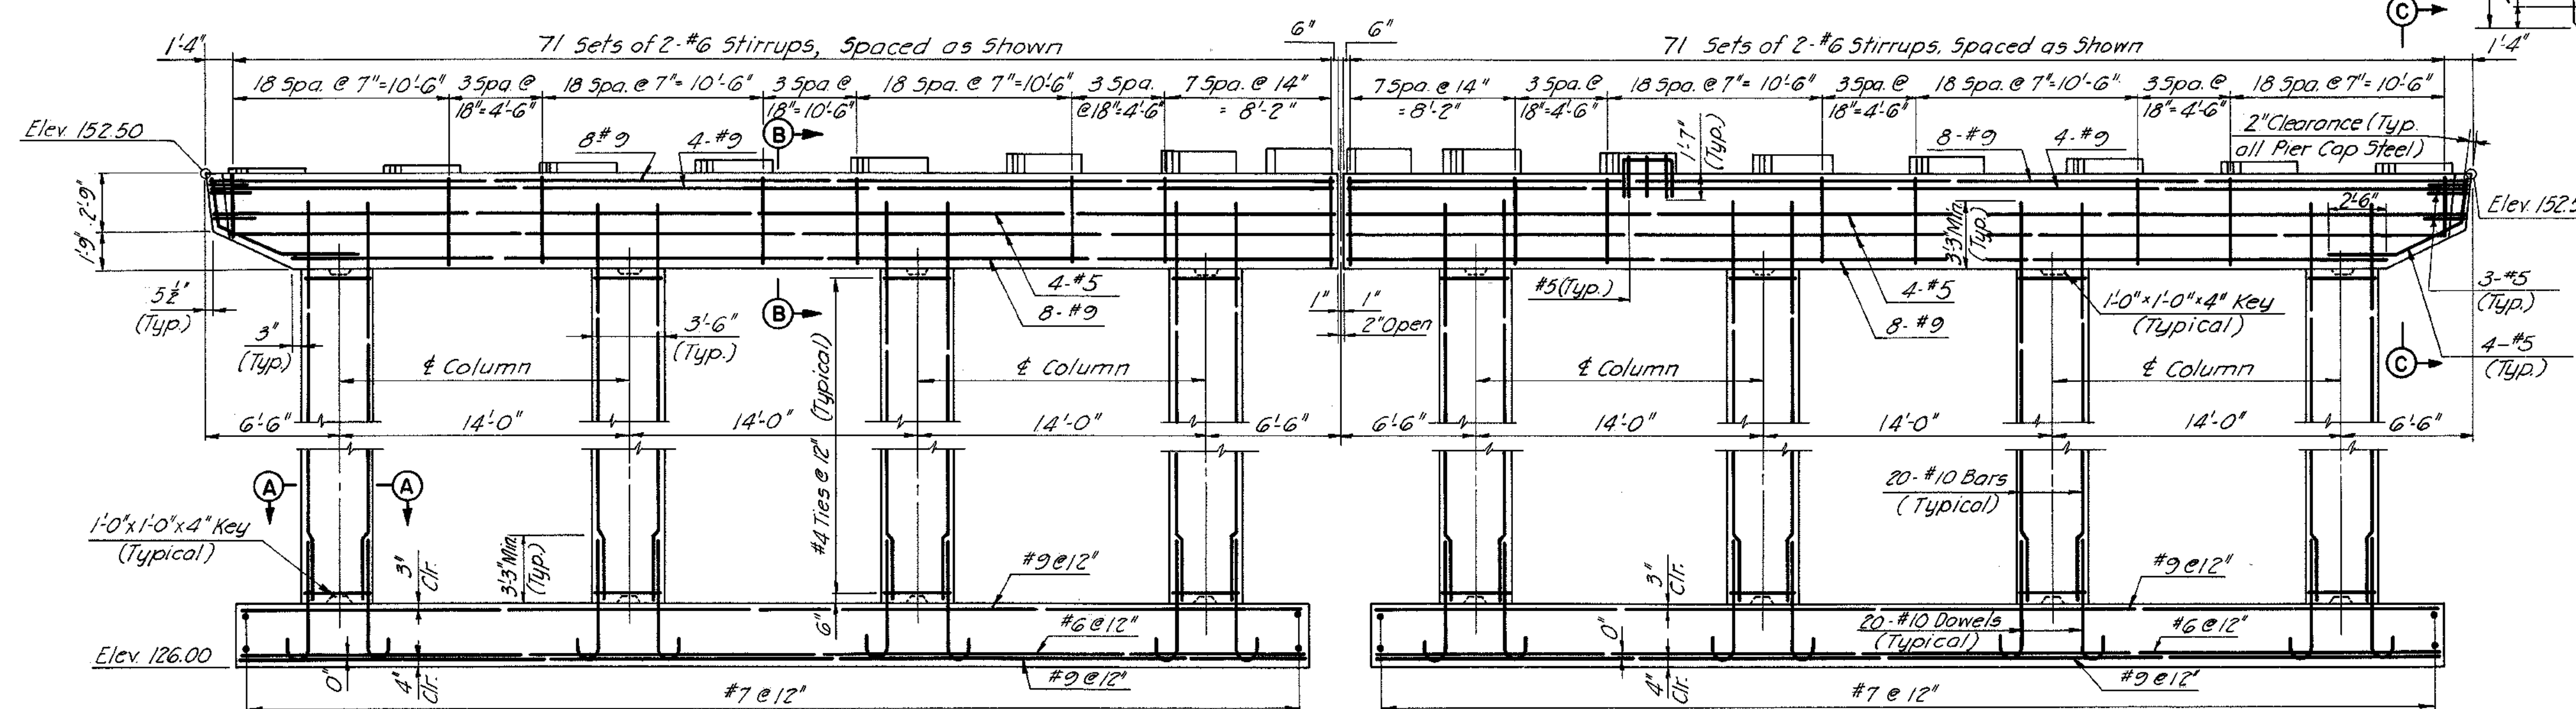

ELEVATION  
Scale:  $\frac{1}{8}$ " = 1'-0"

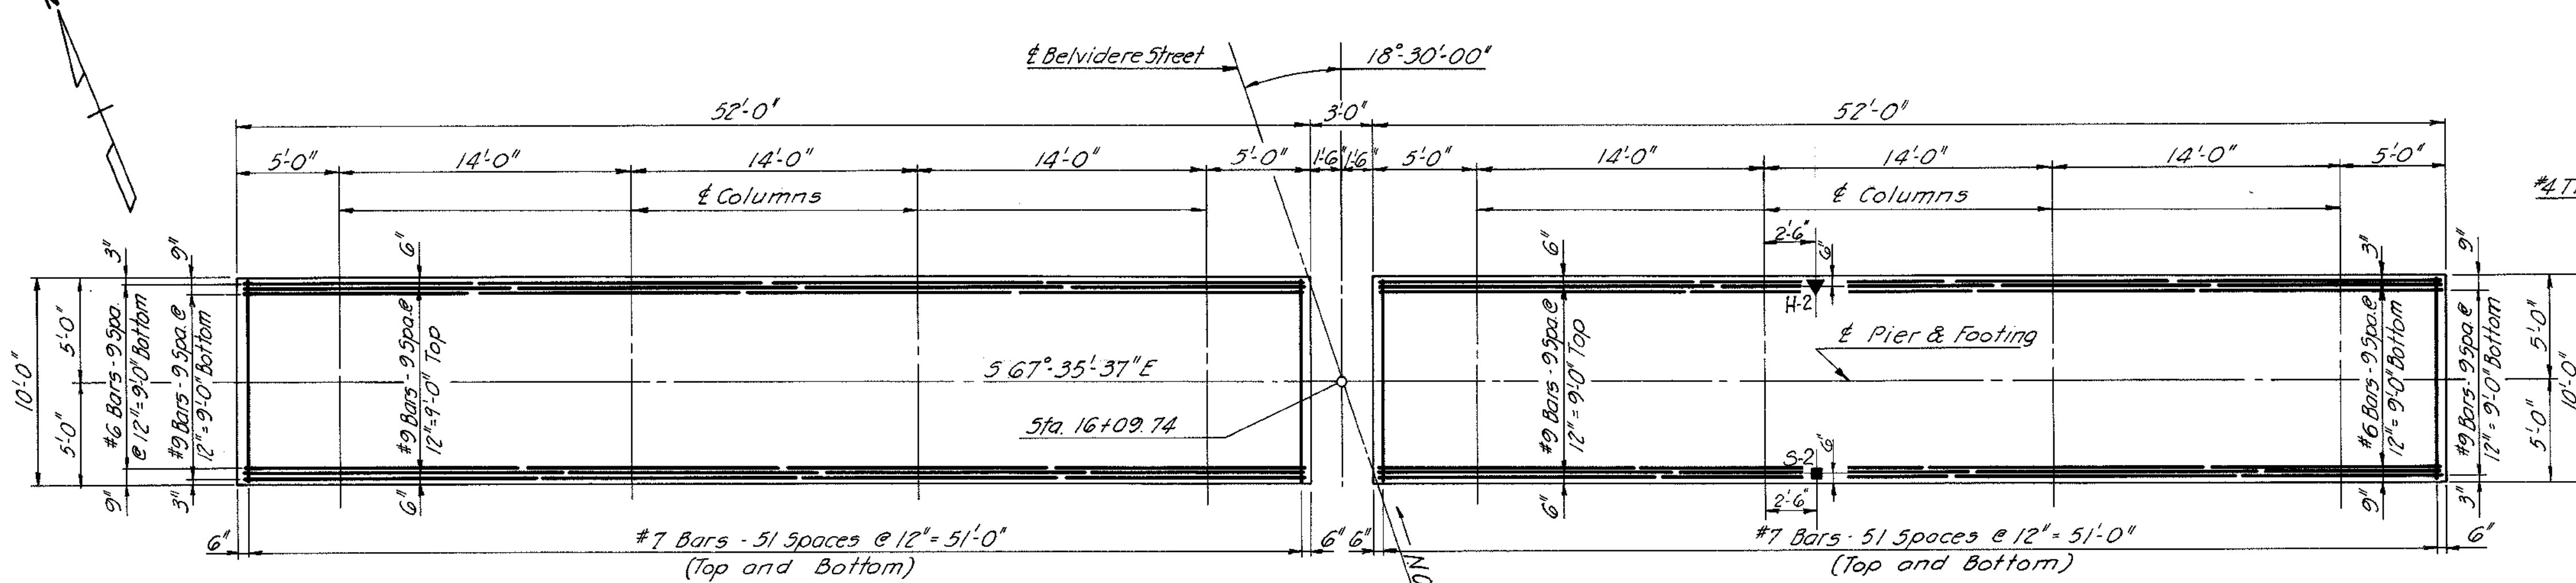


FOOTING PLAN  
Scale:  $\frac{1}{8}$ " = 1'-0"

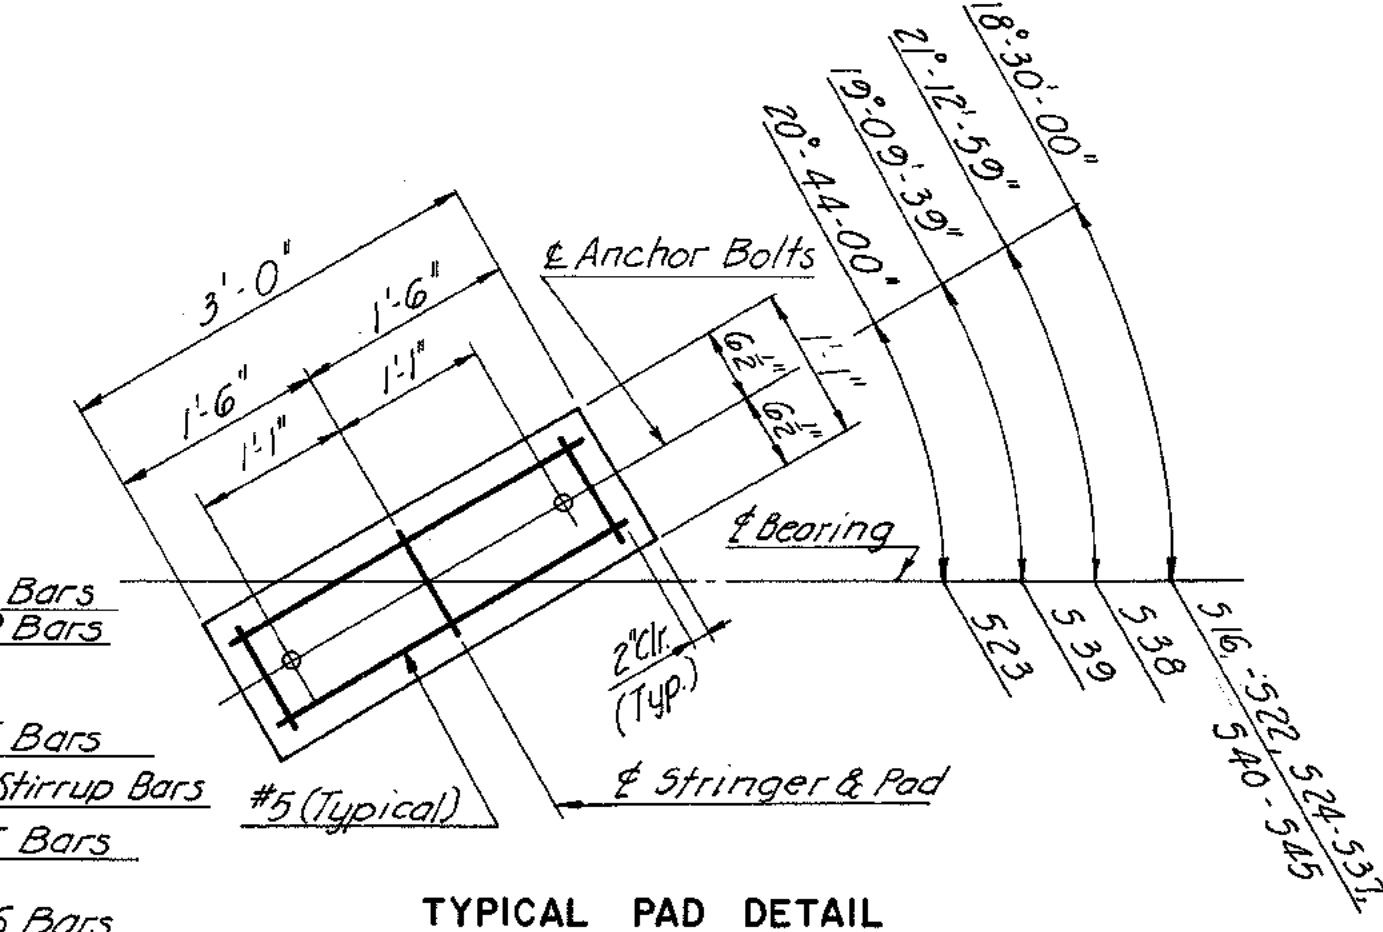


TYPICAL PAD DETAIL  
Scale:  $\frac{1}{8}$ " = 1'-0"  
(Reinforcing Required in all Pads except 516, 517, 531 & 532)


SECTION C-C  
Scale:  $\frac{1}{8}$ " = 1'-0"

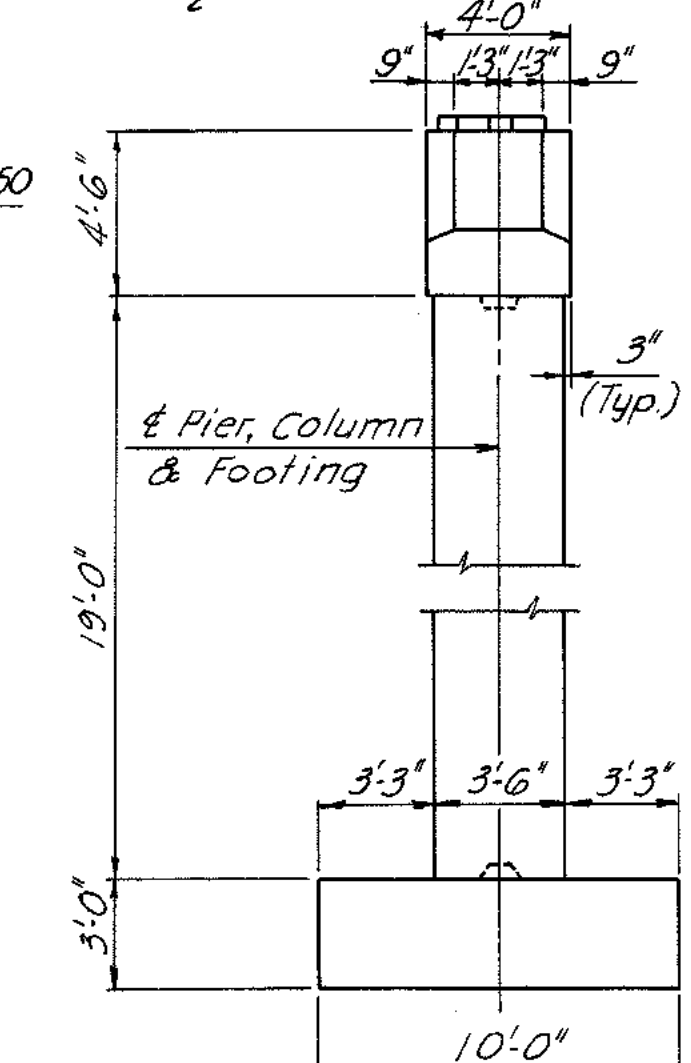

END VIEW  
Scale:  $\frac{1}{8}$ " = 1'-0"

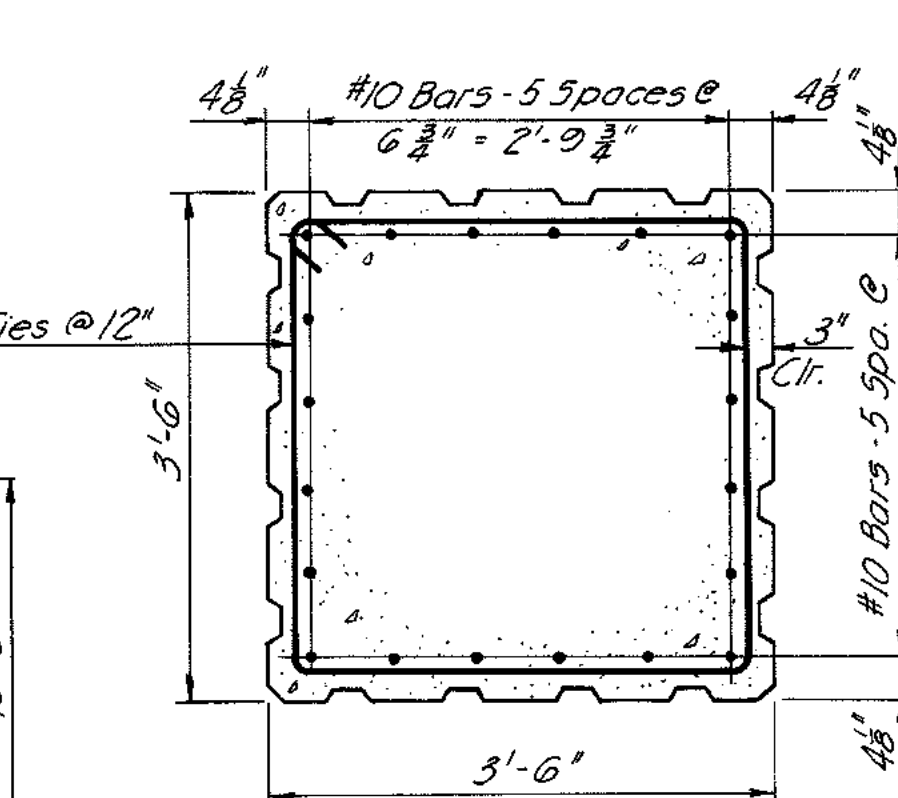

SECTION A-A (TYP.)  
Scale:  $\frac{1}{8}$ " = 1'-0"

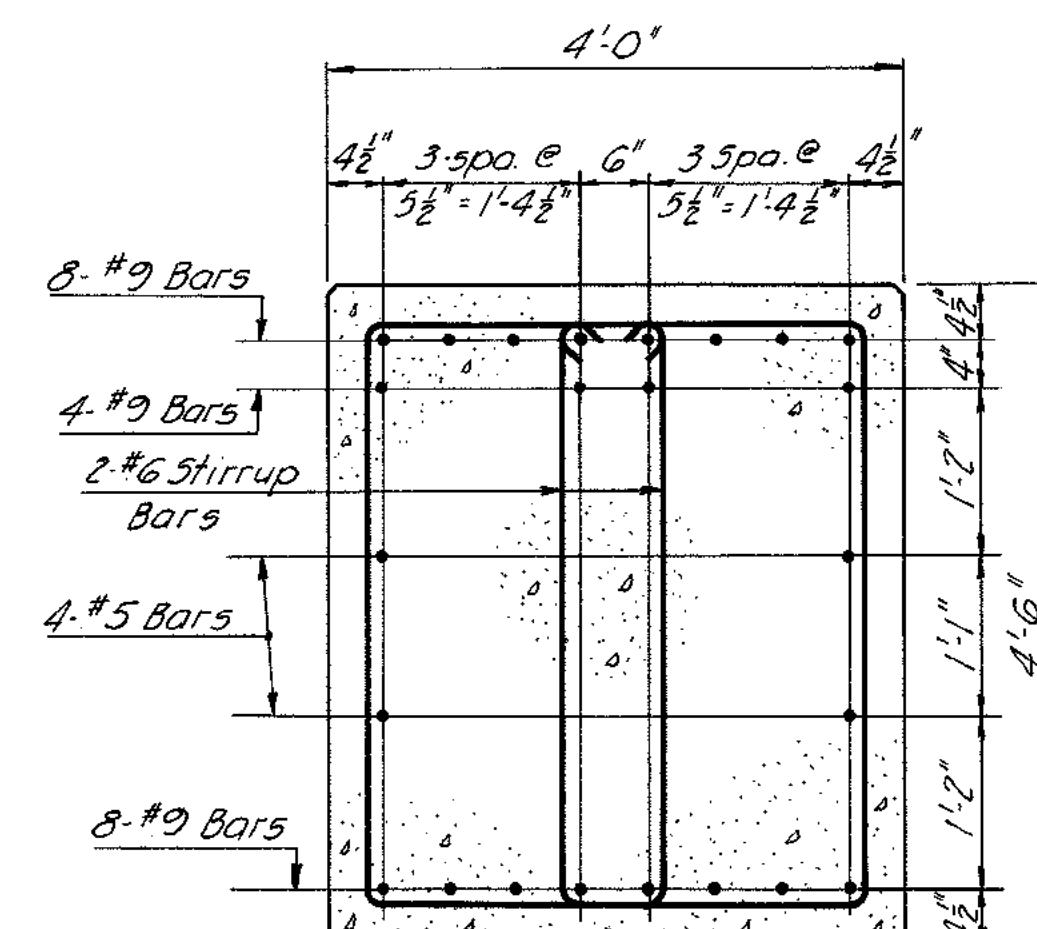

SECTION B-B  
Scale:  $\frac{1}{8}$ " = 1'-0"

# AS BUILT


NOTE 5:  
For Framing Plan, see Sheet 9  
For Bearing Shoe Dimensions, see Stand-  
and Sheet 51.  
For General Notes, see Sheet 1.  
For Architectural Treatment Details,  
see Sheet 57 to 59

FOUNDATION NOTE:  
Foundation Elevations are approximate only and may be varied to suit  
field conditions as directed by the Engineer. Vertical Column reinforcing  
shall not be cut until these elevations are established.  
Where elevations change by more than 2 feet, redesign will be required.  
Pier foundation is designed for an allowable Bearing Pressure of  
2 1/2 tons per square foot.

BY	DATE	REVISION	BY	DATE
MADE	CF5	11-67		
CHECKED	WEO	12-67	AS BUILT	HMN
IN CHARGE	WEO			4-76

RICHMOND METROPOLITAN AUTHORITY RICHMOND EXPRESSWAY SYSTEM DOWNTOWN EXPRESSWAY			
STRUCTURE B51 BELVIDERE STREET OVER DOWNTOWN EXPRESSWAY PIER 2 DETAILS			
AMERICAN ENGINEERS Richmond, Virginia	SCALE: AS NOTED	CONTRACT NO. 8	
HOWARD, NEEDLES, TAMMEN & BERGENDOFF General Consultants		SHEET NO. 8	OF 21

RICHMOND EXPRESSWAY SYSTEM			
SECTION	PROJECT	SHEET NO.	TOTAL SHEETS
8	DOWNTOWN EXPRESSWAY	239	

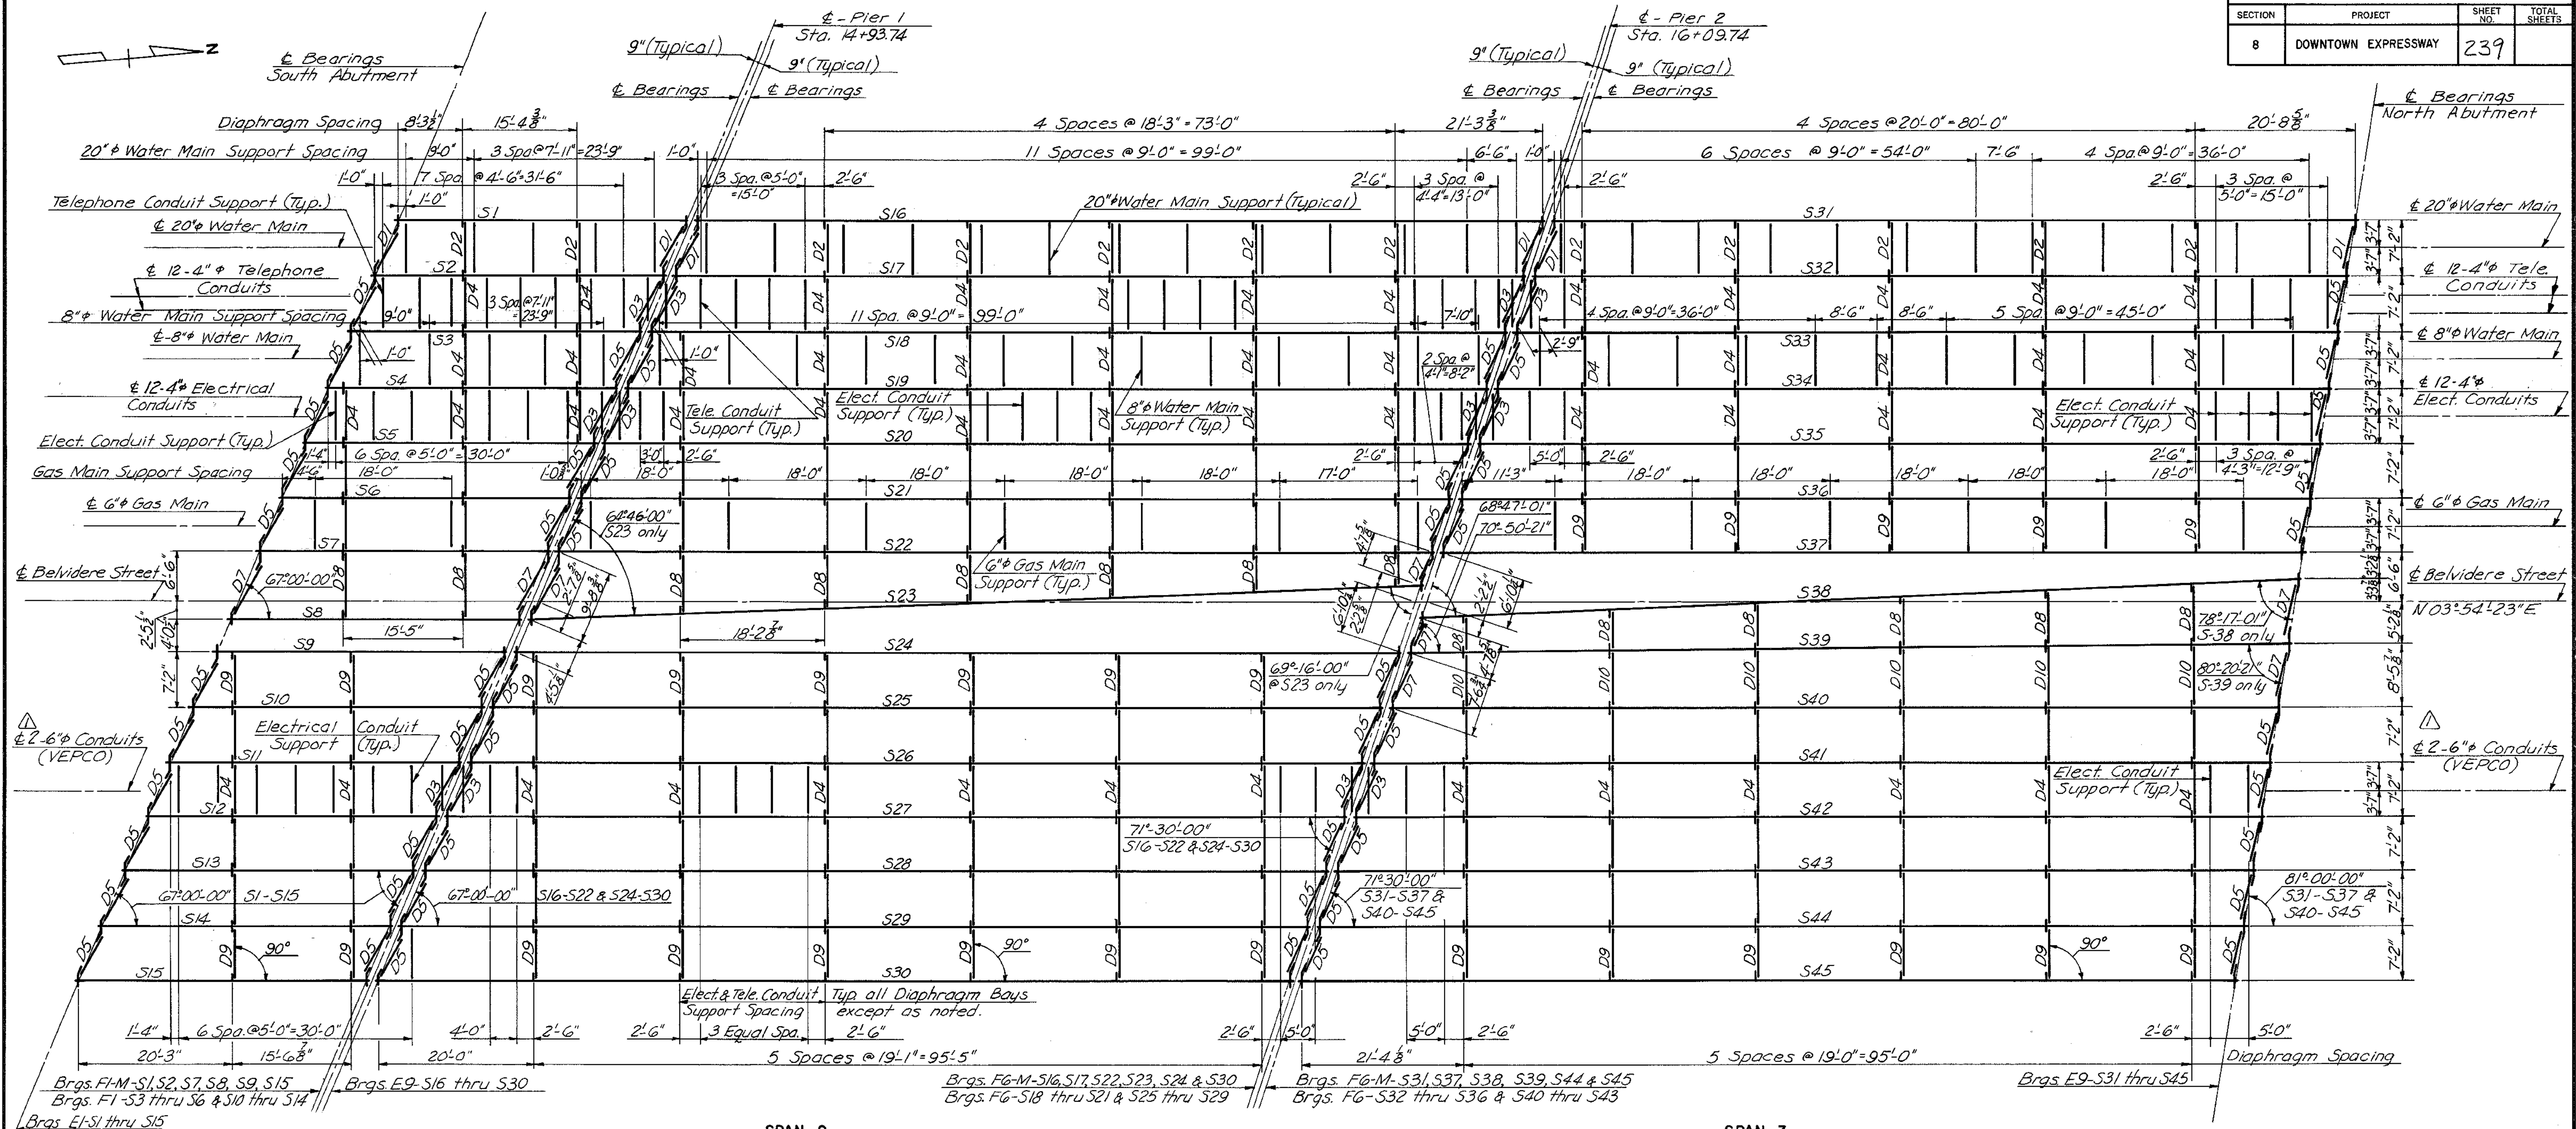

SPAN 1  
Non-Composite

SPAN 2

FRAMING PLAN  
Scale: 1"=10'-0"

SPAN 3

NOTE:  
All Intermediate Diaphragms are D6 unless otherwise noted.  
Intermediate Stiffeners shall be located on inside face of stringers S1, S15, S16, S30, S31 & S45. They shall be located on alternate sides along the remaining stringers.

NOTES:  
Structural Steel Shall Conform to ASTM Specifications A-36 (Latest Revision).  
For General Notes see Sheet 11.  
For Superstructure Cross Section see Sheet 11.  
For Diaphragm Details see Sheet 12.  
For Utility Support Details see Sheet 13.  
For Bearing Shoe Dimensions see Sheet 11.  
For Stringer Details see Sheet 10.  
For Stiffener Details see Sheet 10.

Bearing Type	No. Required
F1	9
F1-M	6
F6	18
F6-M	12
E1	15
E9	30

Stringer Lengths & Brg. to & Brg.							
S1 thru S15	37'-9 $\frac{3}{8}$ "	S22	113'-9 $\frac{3}{8}$ "	S30	118'-10 $\frac{1}{8}$ "	S38	114'-3 $\frac{3}{8}$ "
		S23	116'-2 $\frac{3}{8}$ "	S31	104'-2 $\frac{3}{8}$ "	S39	114'-3 $\frac{3}{8}$ "
S16	109'-11 $\frac{3}{8}$ "	S24	114'-11 $\frac{3}{8}$ "	S32	105'-5 $\frac{3}{8}$ "	S40	115'-4 $\frac{3}{8}$ "
S17	110'-7 $\frac{3}{8}$ "	S25	115'-7 $\frac{3}{8}$ "	S33	106'-9"	S41	116'-7 $\frac{3}{8}$ "
S18	111'-2 $\frac{3}{8}$ "	S26	116'-3 $\frac{3}{8}$ "	S34	108'-0 $\frac{3}{8}$ "	S42	117'-10 $\frac{3}{8}$ "
S19	111'-10 $\frac{3}{8}$ "	S27	116'-10 $\frac{3}{8}$ "	S35	109'-3 $\frac{3}{8}$ "	S43	119'-1 $\frac{3}{8}$ "
S20	112'-6 $\frac{3}{8}$ "	S28	117'-6 $\frac{3}{8}$ "	S36	110'-6 $\frac{3}{8}$ "	S44	120'-4 $\frac{3}{8}$ "
S21	113'-2"	S29	118'-2 $\frac{3}{8}$ "	S37	111'-9 $\frac{3}{8}$ "	S45	121'-8"

INTERMEDIATE STIFFENER SPACING (MAXIMUM)

Stringer	1st 2 Spaces	1L	2L	3L	4L	5L
S1 thru S15	2'-0"	4'-0"	4'-0"	4'-0"	4'-0"	4'-0"
S16 thru S45	1'-9"	3'-6"	3'-10"	4'-0"	4'-0"	4'-0"

BY	DATE				
MADE	D.L.A.	9-67			
CHECKED	W.E.O.	12-67	Rev. No. VEPCO Conduits	DGT	11-12-74
IN CHARGE	W.E.O.		REVISION	BY	DATE

RICHMOND METROPOLITAN AUTHORITY  
RICHMOND EXPRESSWAY SYSTEM  
DOWNTOWN EXPRESSWAY


STRUCTURE B51  
BELVIDERE STREET OVER  
DOWNTOWN EXPRESSWAY  
FRAMING PLAN

AMERICAN ENGINEERS Richmond, Virginia	SCALE: AS NOTED
HOWARD, NEEDLES, TAMMEN & BERGENOFF General Consultants	CONTRACT NO.: 8 SHEET NO.: 9 OF 21


AS BUILT




RICHMOND EXPRESSWAY SYSTEM			
SECTION	PROJECT	SHEET NO.	TOTAL SHEETS
8	DOWNTOWN EXPRESSWAY	240	

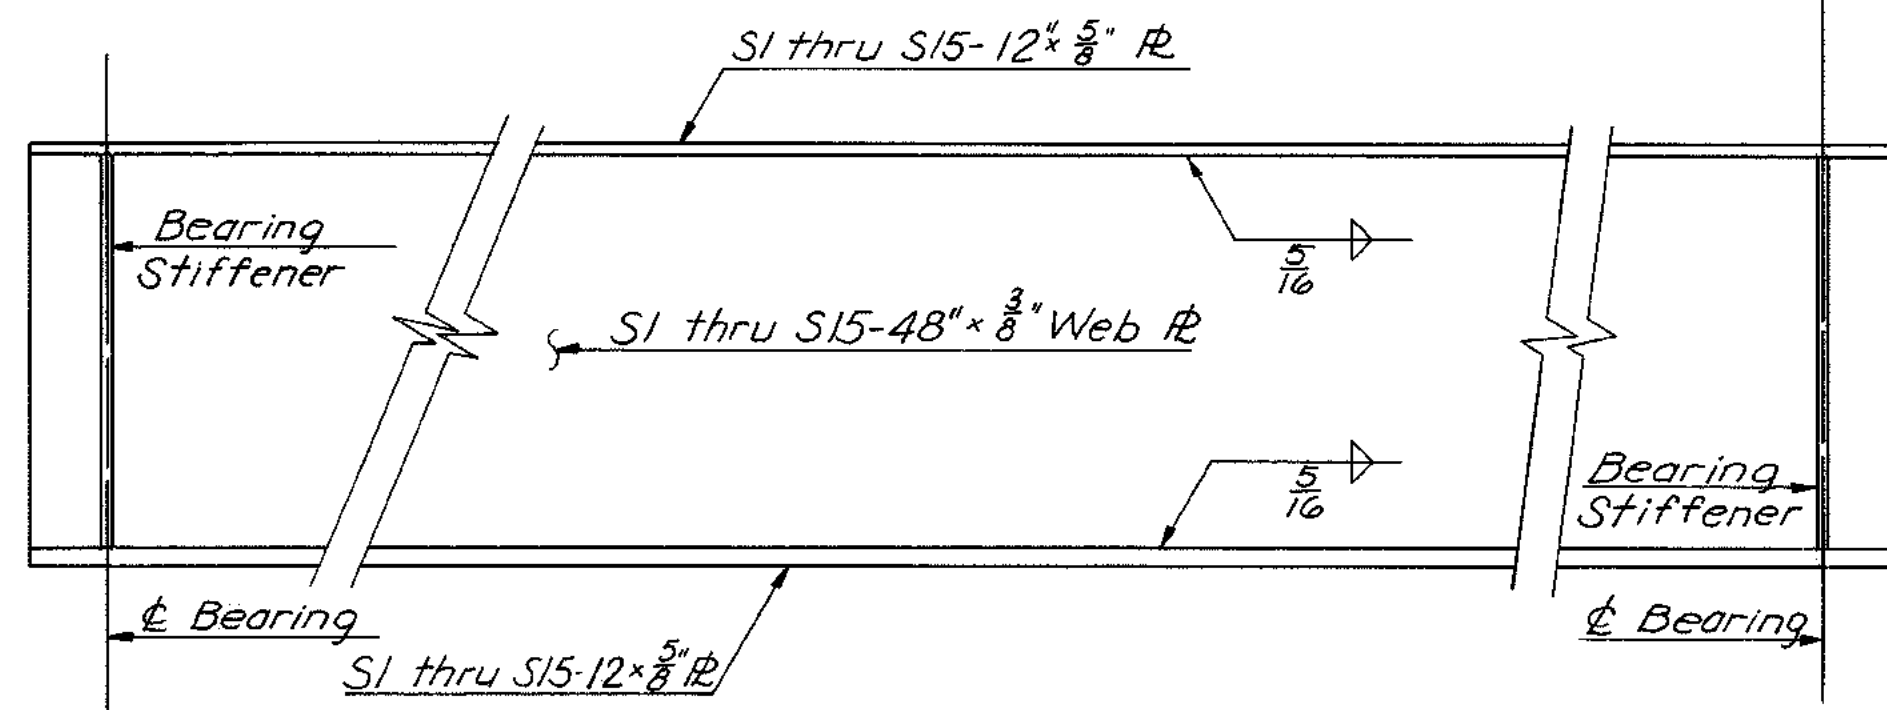


STRINGER DETAILS SPAN 1

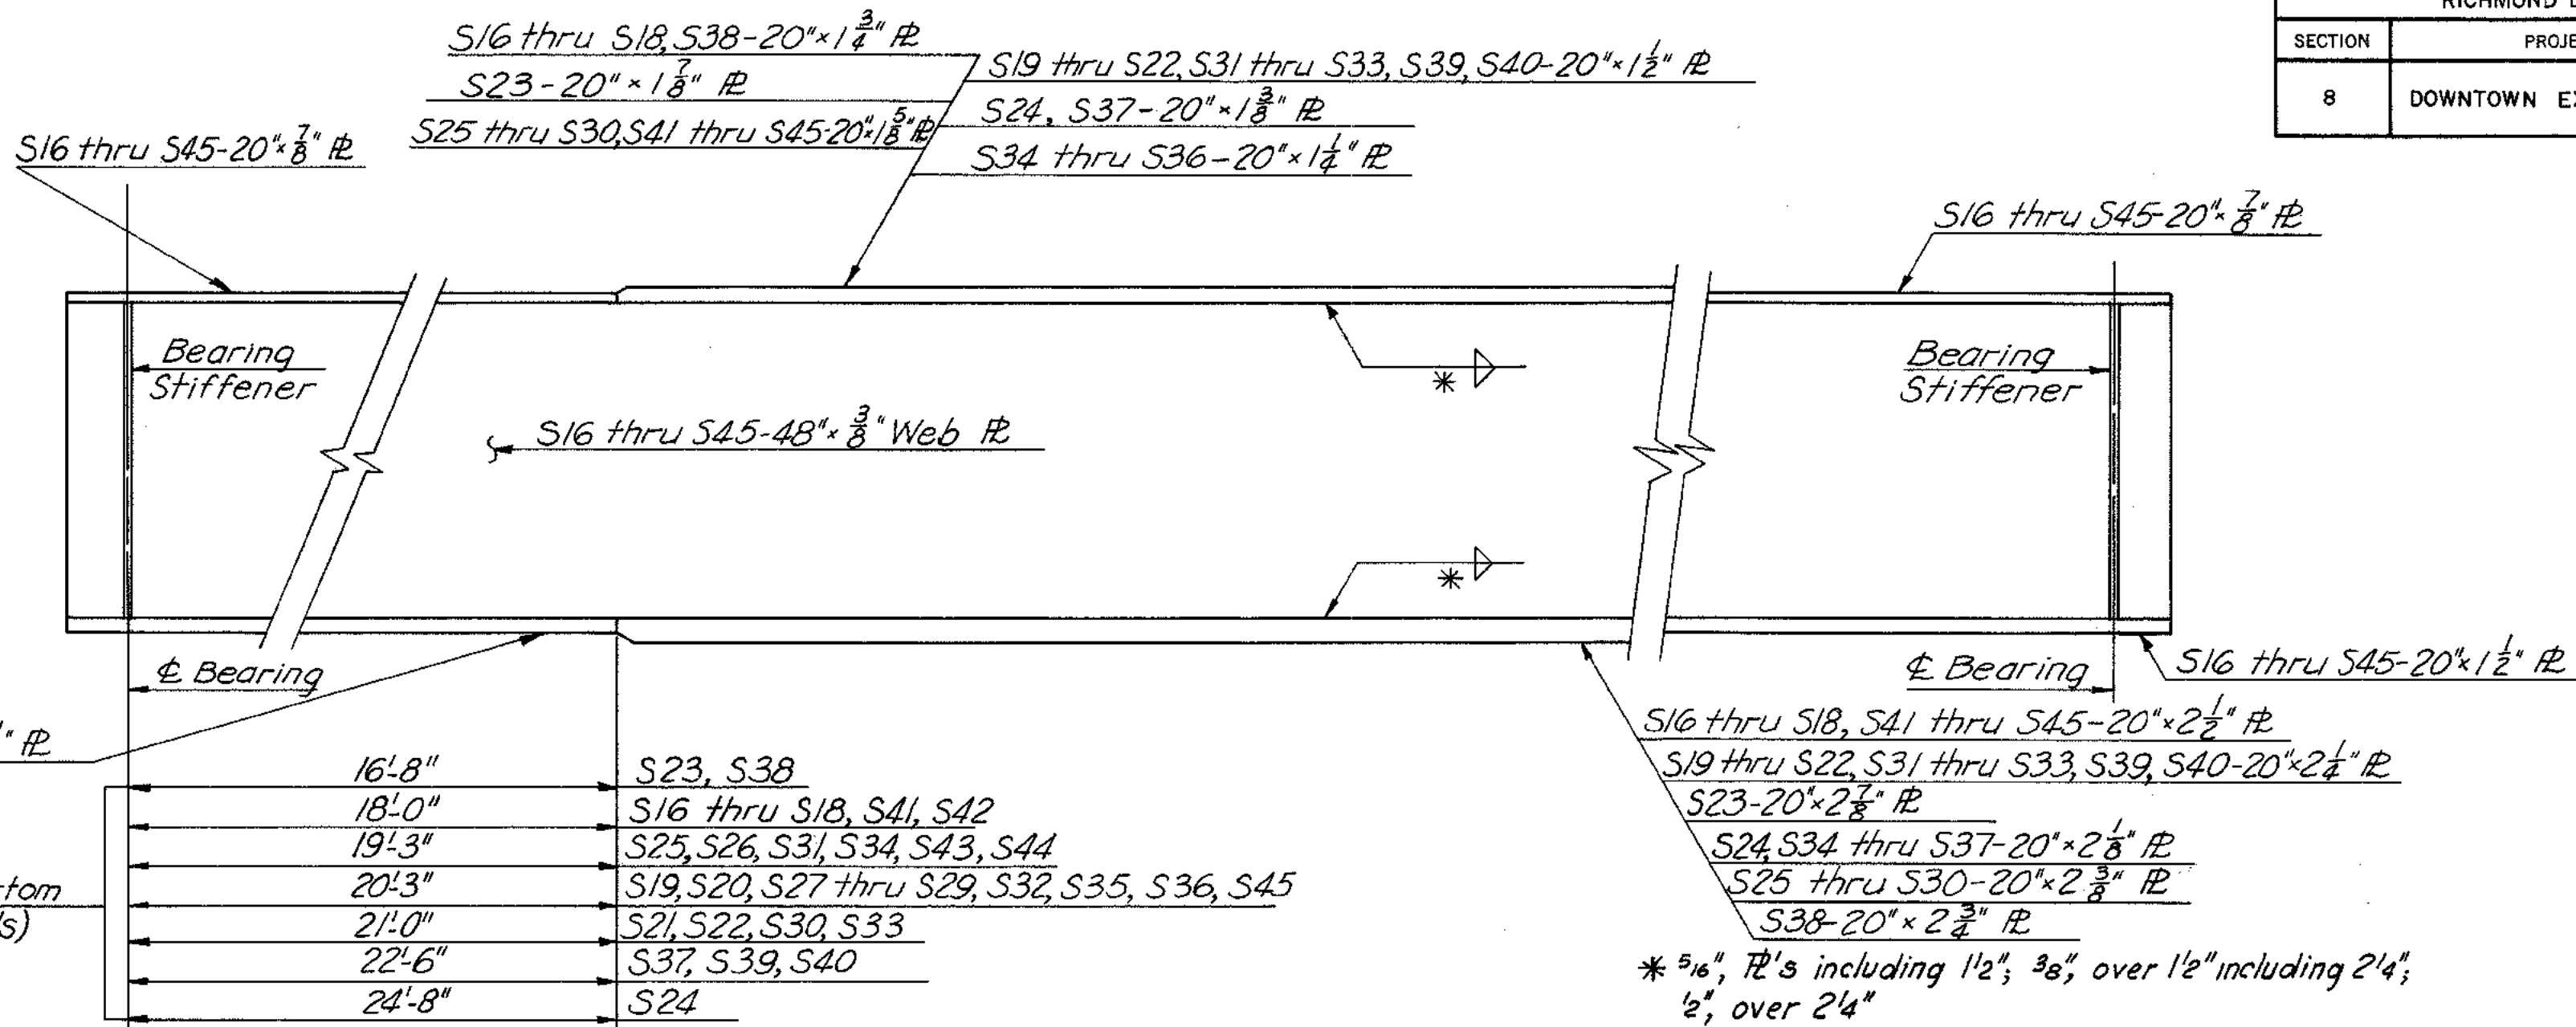

STRINGER DETAILS SPANS 2 & 3

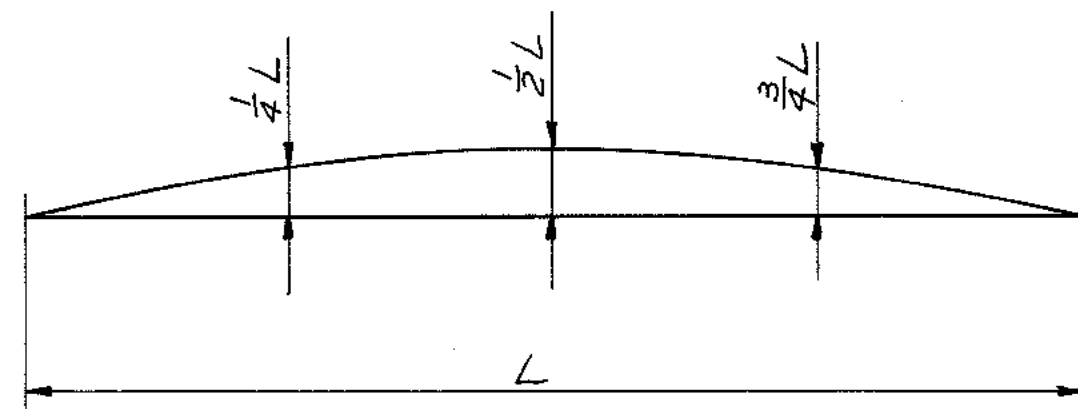

CAMBER DIAGRAM  
No Scale

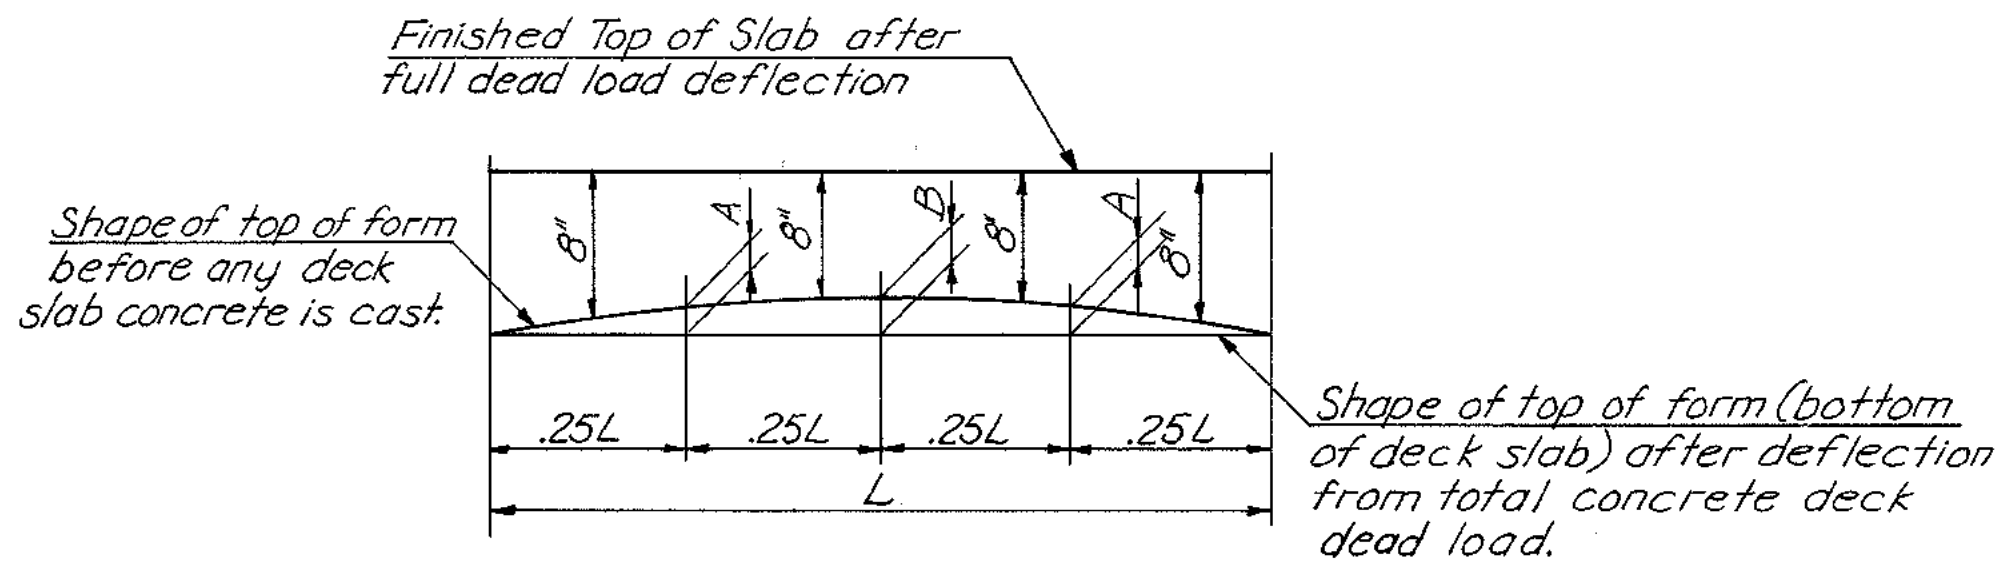

DEAD LOAD DEFLECTION DIAGRAM  
No Scale


Stringers	1/4 L	1/2 L	3/4 L
S1 thru S15	1/8"	1/8"	1/8"
S16, S18, S24, S34, S37, S38	2 3/8"	3 1/4"	2 3/8"
S17, S19 thru S23, S25, S33, S36	2 1/8"	3 1/8"	2 1/8"
S26 thru S29, S40 thru S43	2 3/8"	3 1/8"	2 3/8"
S30, S44	2 1/8"	4 1/8"	2 1/8"
S31 thru S33	2 1/8"	3"	2 1/8"
S39	2 1/8"	3 1/8"	2 1/8"
S45	3 1/8"	4 1/8"	3 1/8"

**NOTE TO FABRICATOR:**


The above stringers shall be fabricated with an upward camber amounting to (see table). This will provide approximate compensation for deflection under full dead load and for conformity with finished grade.

**NOTE TO CONTRACTOR:**


The above deflections are those anticipated to occur in the stringer upon placement of the total concrete deck load. In practice, the stringers in place, are not likely to have the exact camber to compensate for these deflections during construction. The residual amounts shall be provided for by adjusting forms to vary the thickness of the concrete bolster between the bottom of the slab and the top of the stringer, without alteration of the slab thickness.

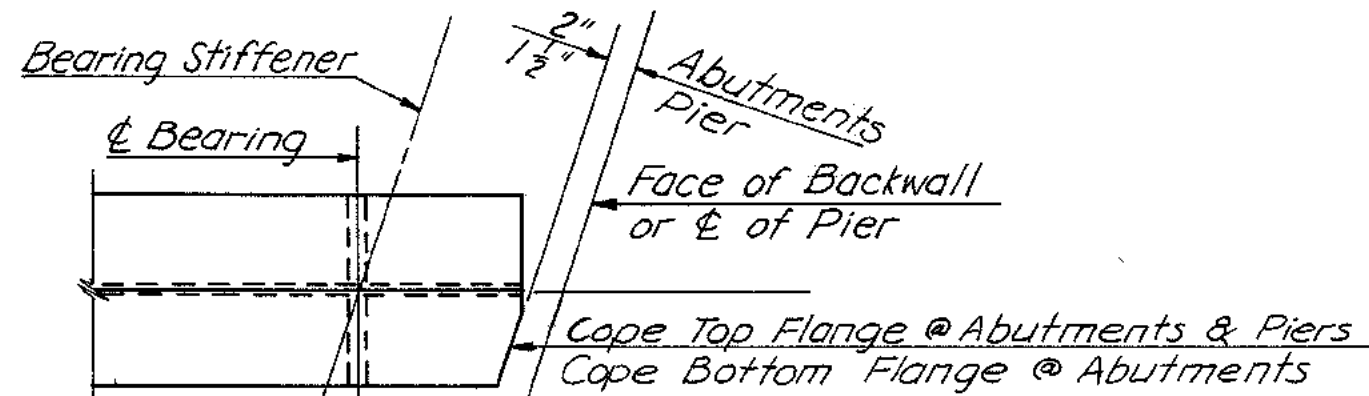

TYPICAL DETAIL-ENDS OF STRINGERS  
No Scale

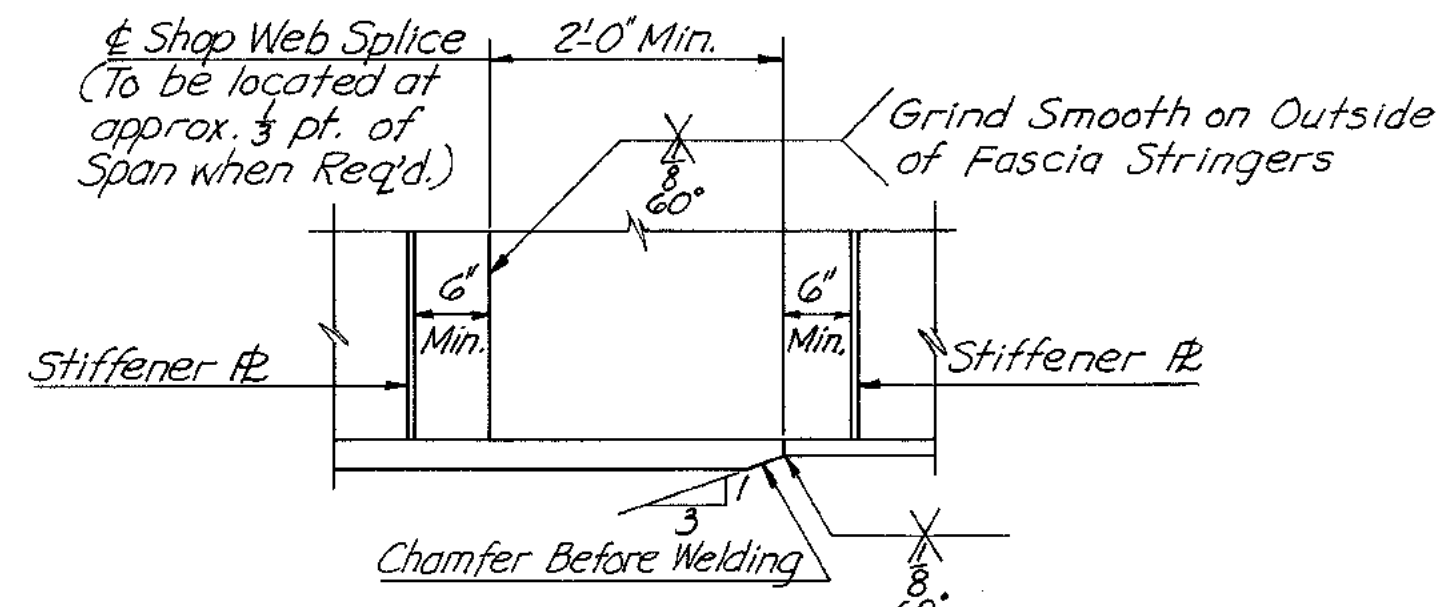


SHOP SPLICE DETAIL  
No Scale

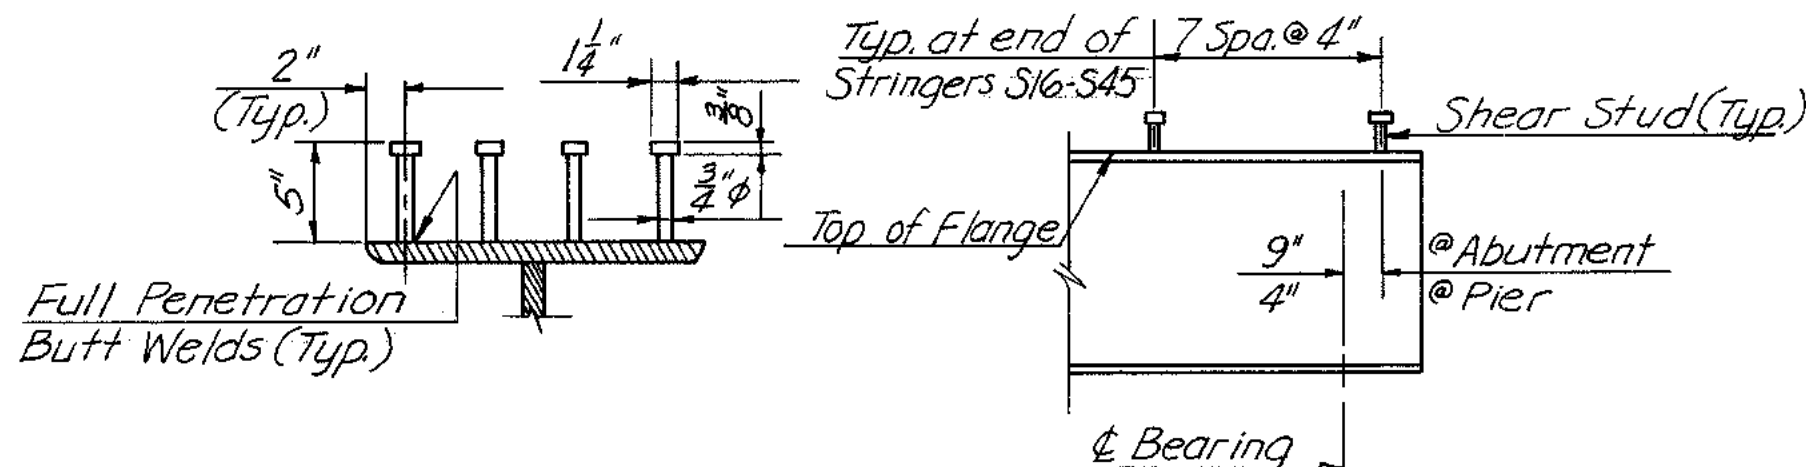

SHEAR STUD DETAIL  
No Scale

DETAIL "A"  
No Scale

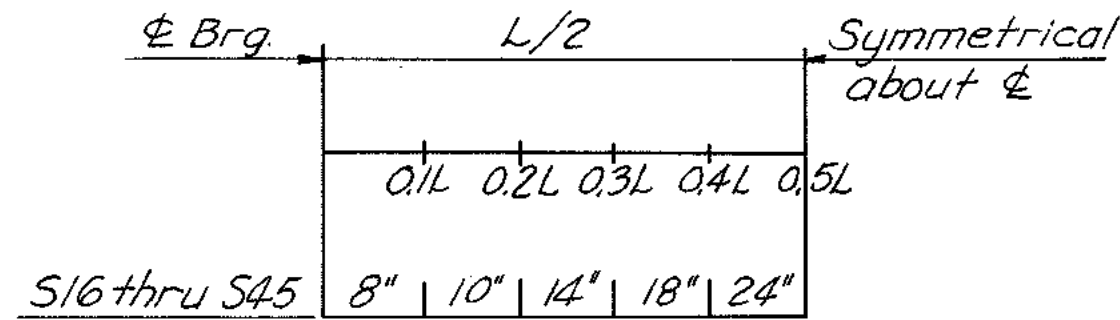

SHEAR STUD SPACING  
No Scale

**SHEAR STUD NOTES:**  
Capacity=3,400 lbs per stud.  
Three 3/8" #3 studs may be substituted at the same longitudinal spacing as shown for 4-3/8" #3 studs.  
Stud Rows to be placed Parallel to main deck reinf.  
For End Condition see Detail "A"

**NOTES:**  
Structural Steel Shall Conform to ASTM Specifications A-36 (Latest Revision).  
For General Notes see Sheet 1.  
For Superstructure Cross Section see Sheet 11.  
For Diaphragm Details see Sheet 12.  
For Utility Support Details see Sheet 13.  
For Framing Plan see Sheet 9.  
For Stiffener Spacing see Sheet 9.

**AS BUILT**

**RICHMOND METROPOLITAN AUTHORITY  
RICHMOND EXPRESSWAY SYSTEM  
DOWNTOWN EXPRESSWAY**








**STRUCTURE B51  
BELVIDERE STREET OVER  
DOWNTOWN EXPRESSWAY  
STRINGER DETAILS**

AMERICAN ENGINEERS Richmond, Virginia	SCALE: <b>AS NOTED</b>
HOWARD, NEEDLES, TAMMEN & BERGENDOFF General Consultants	CONTRACT NO.: <b>8</b> SHEET NO. <b>10</b> OF <b>21</b>



MADE	BY	DATE	CHECKED	DATE	IN CHARGE	NO.	REVISION	BY	DATE
	T.D.J.	11-67							
	W.E.O.	12-67							
	W.E.O.								






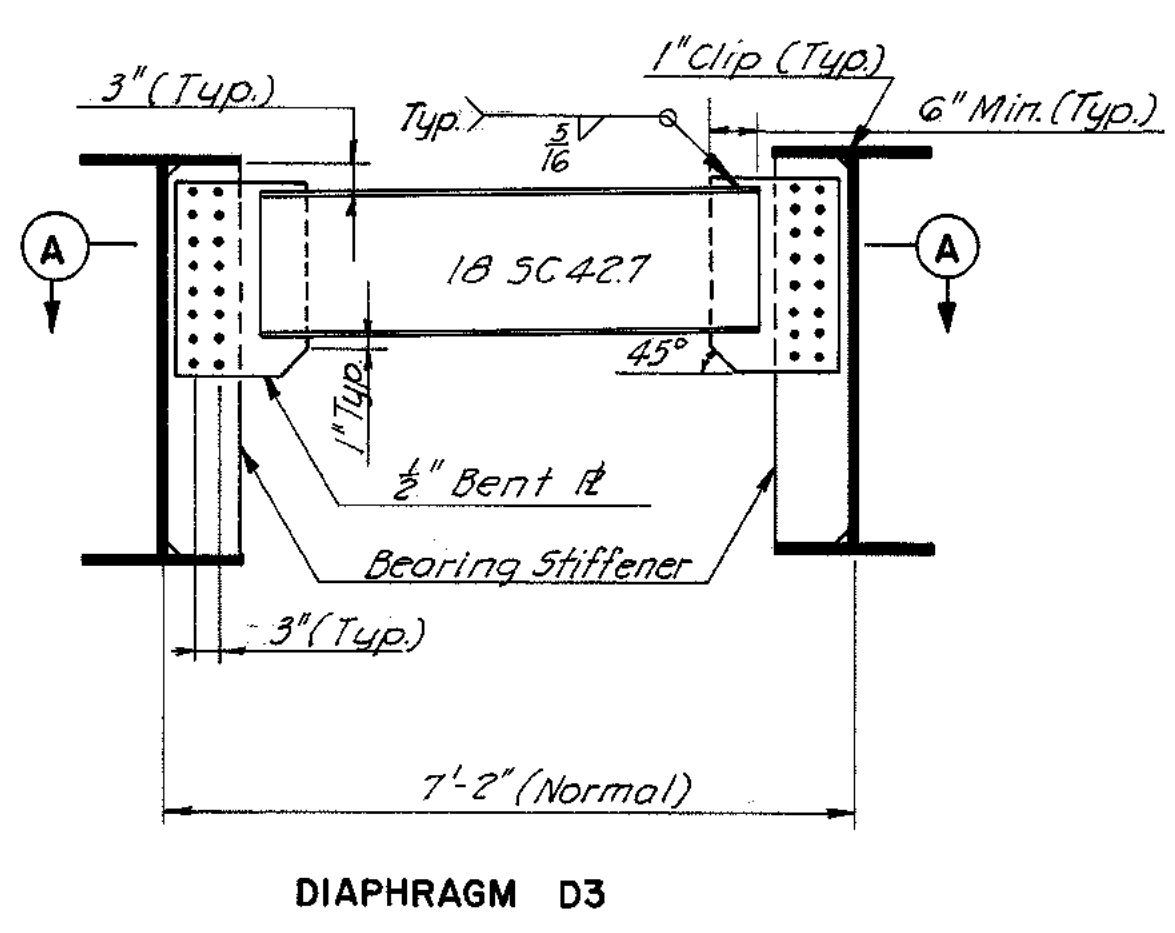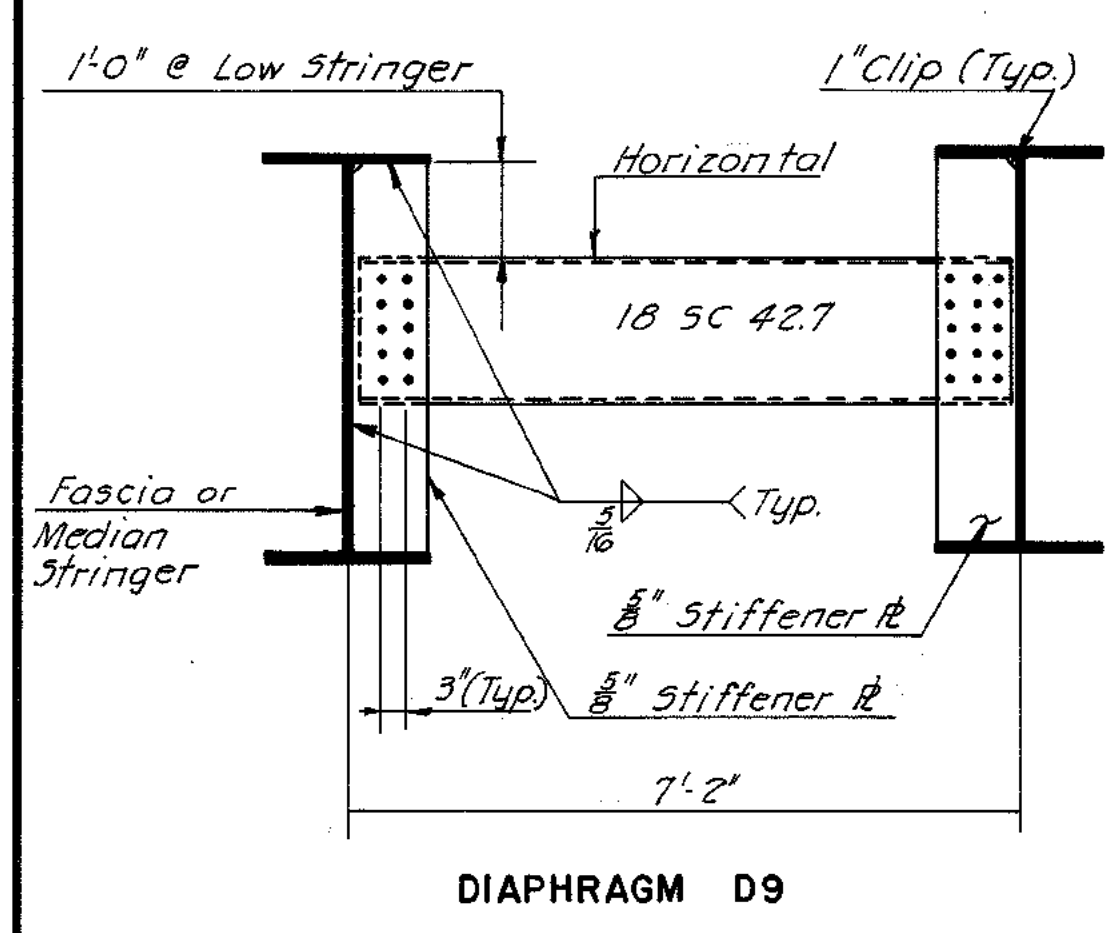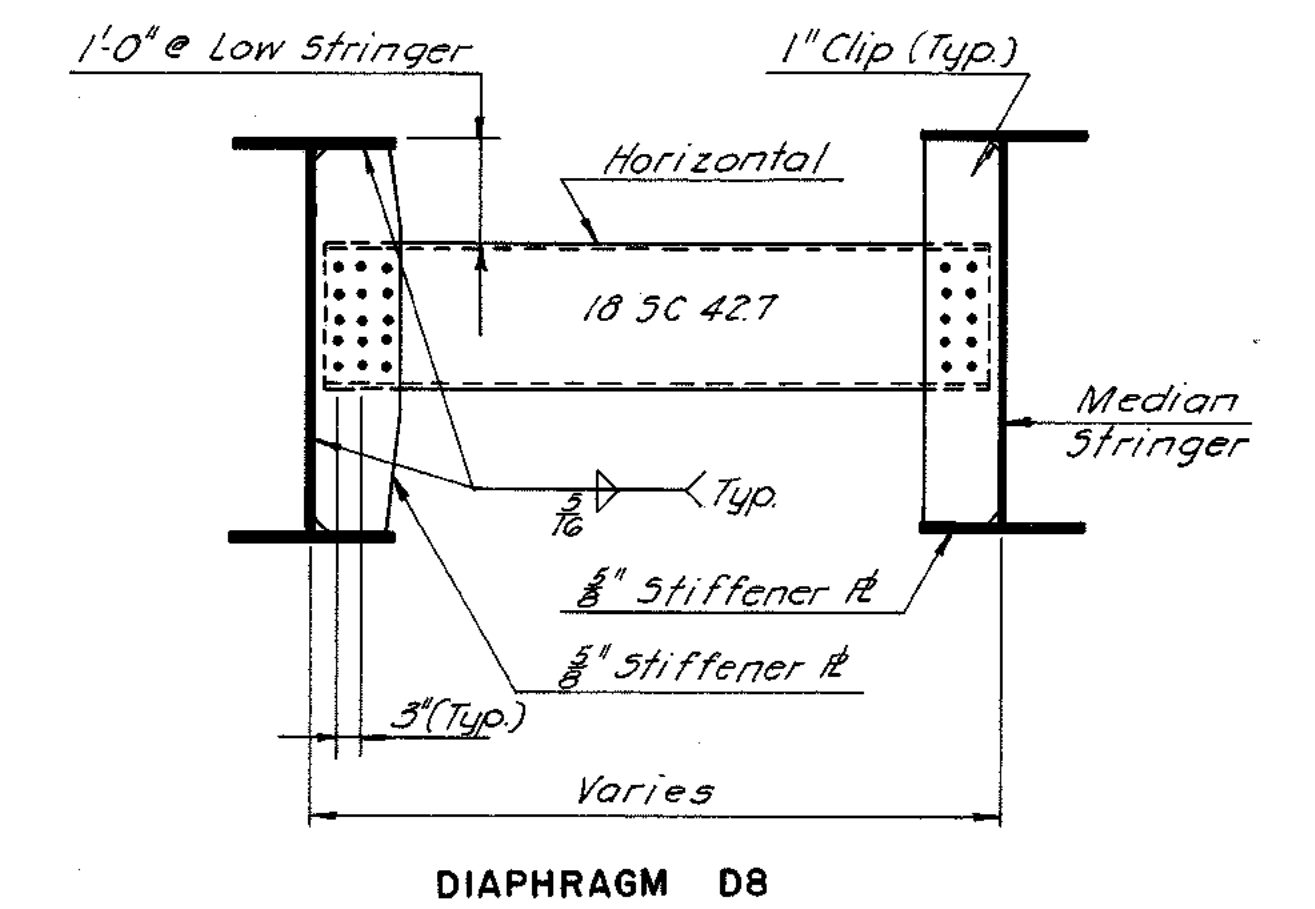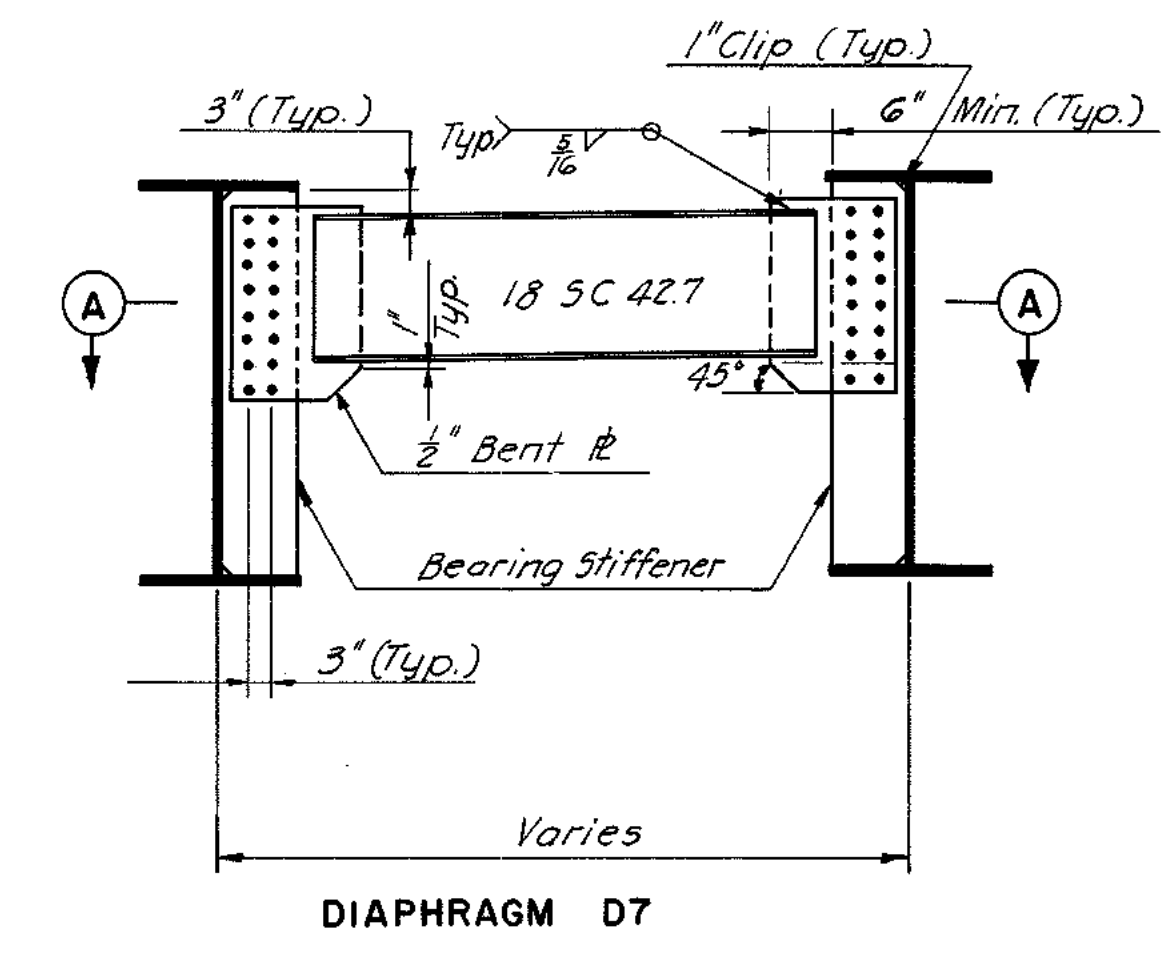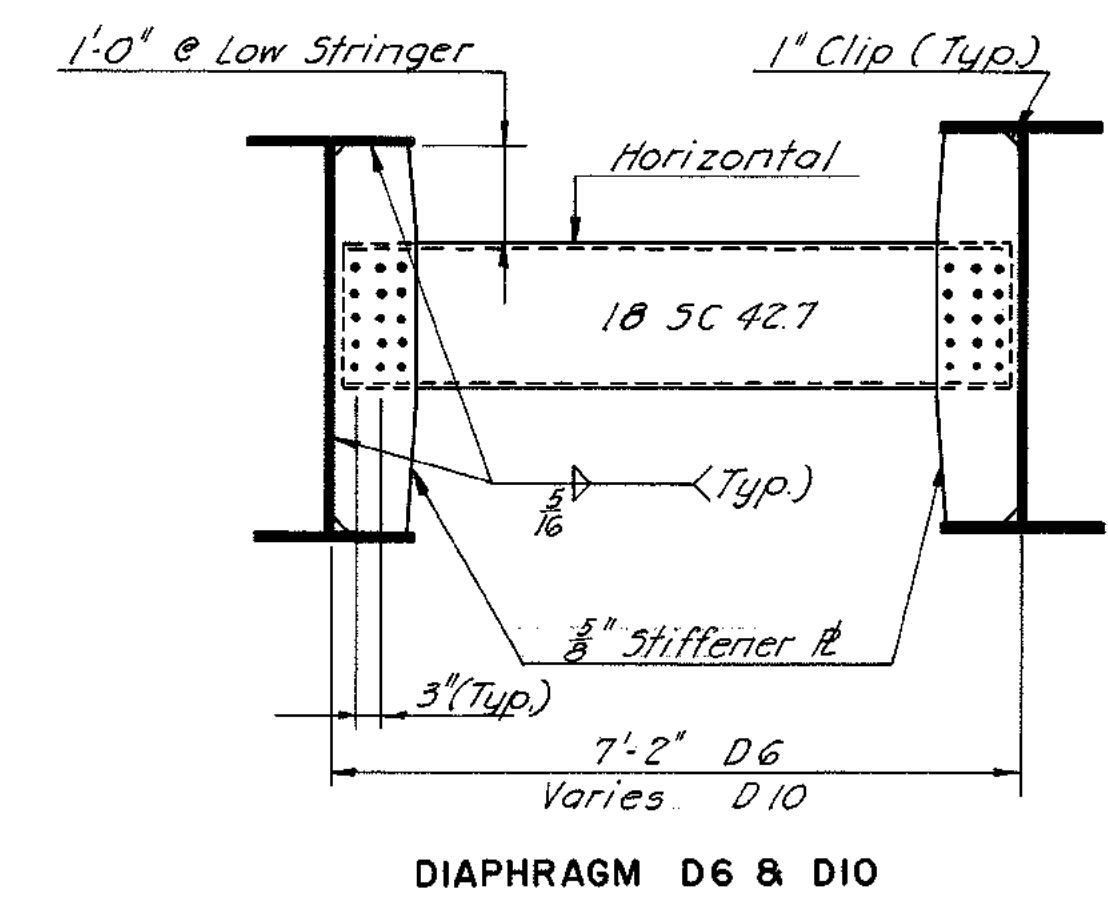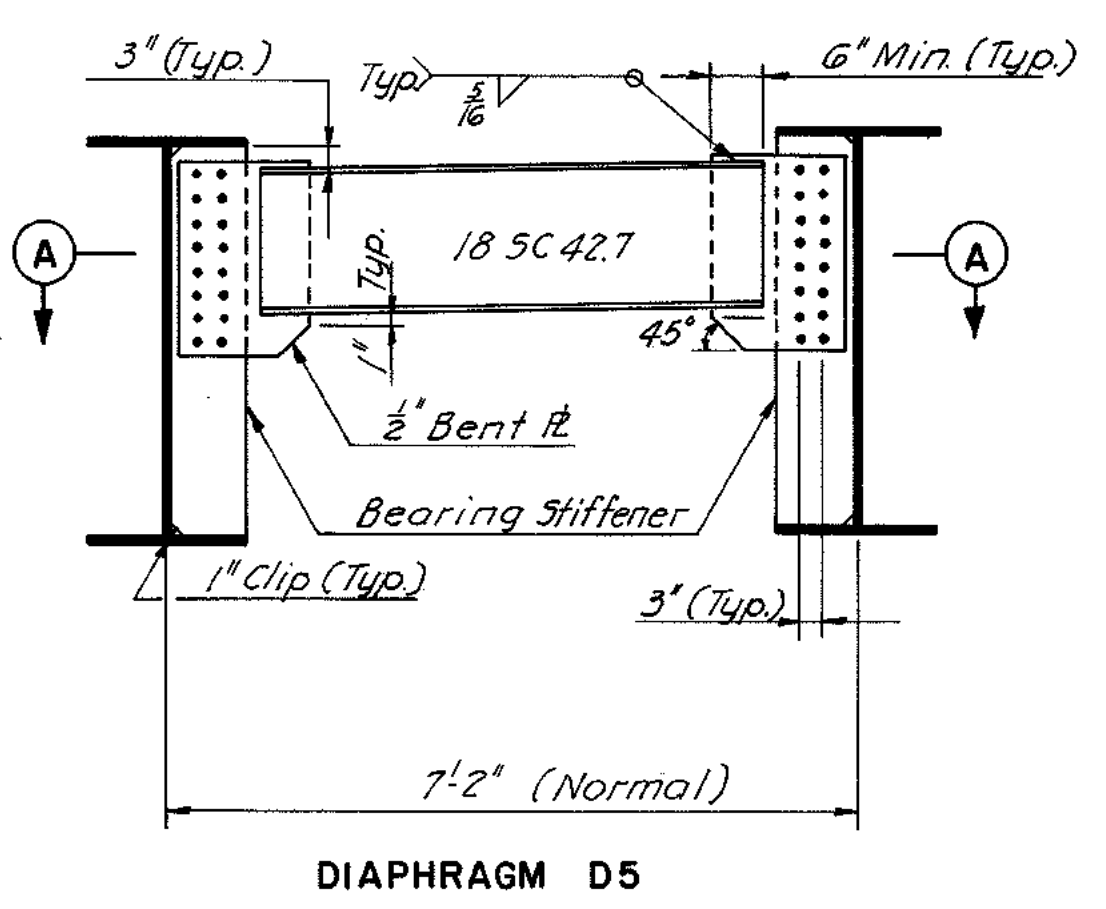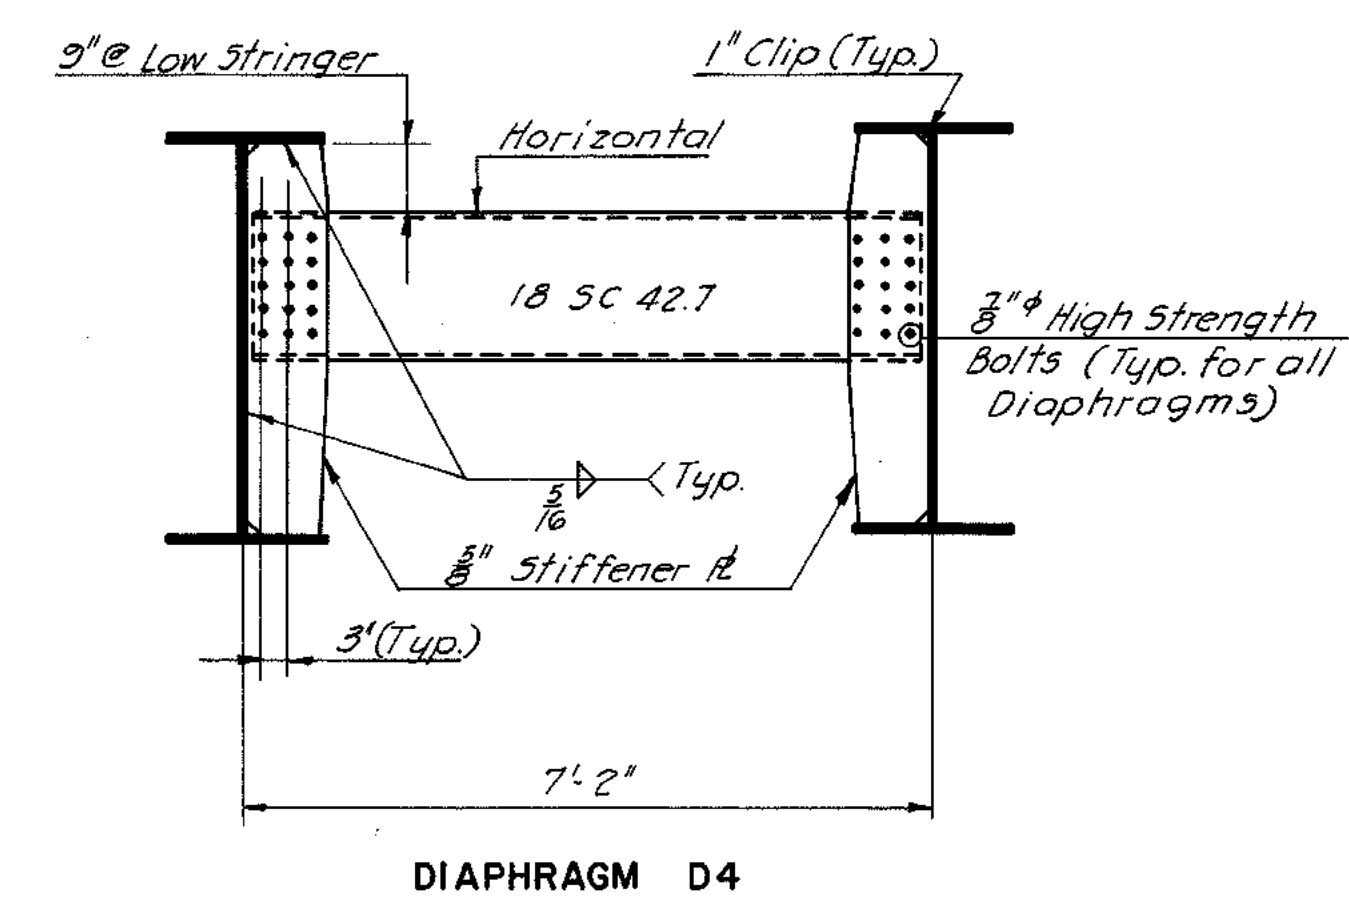

DIAPHRAGM DETAILS  
Scale: 1/2" = 1'-0"

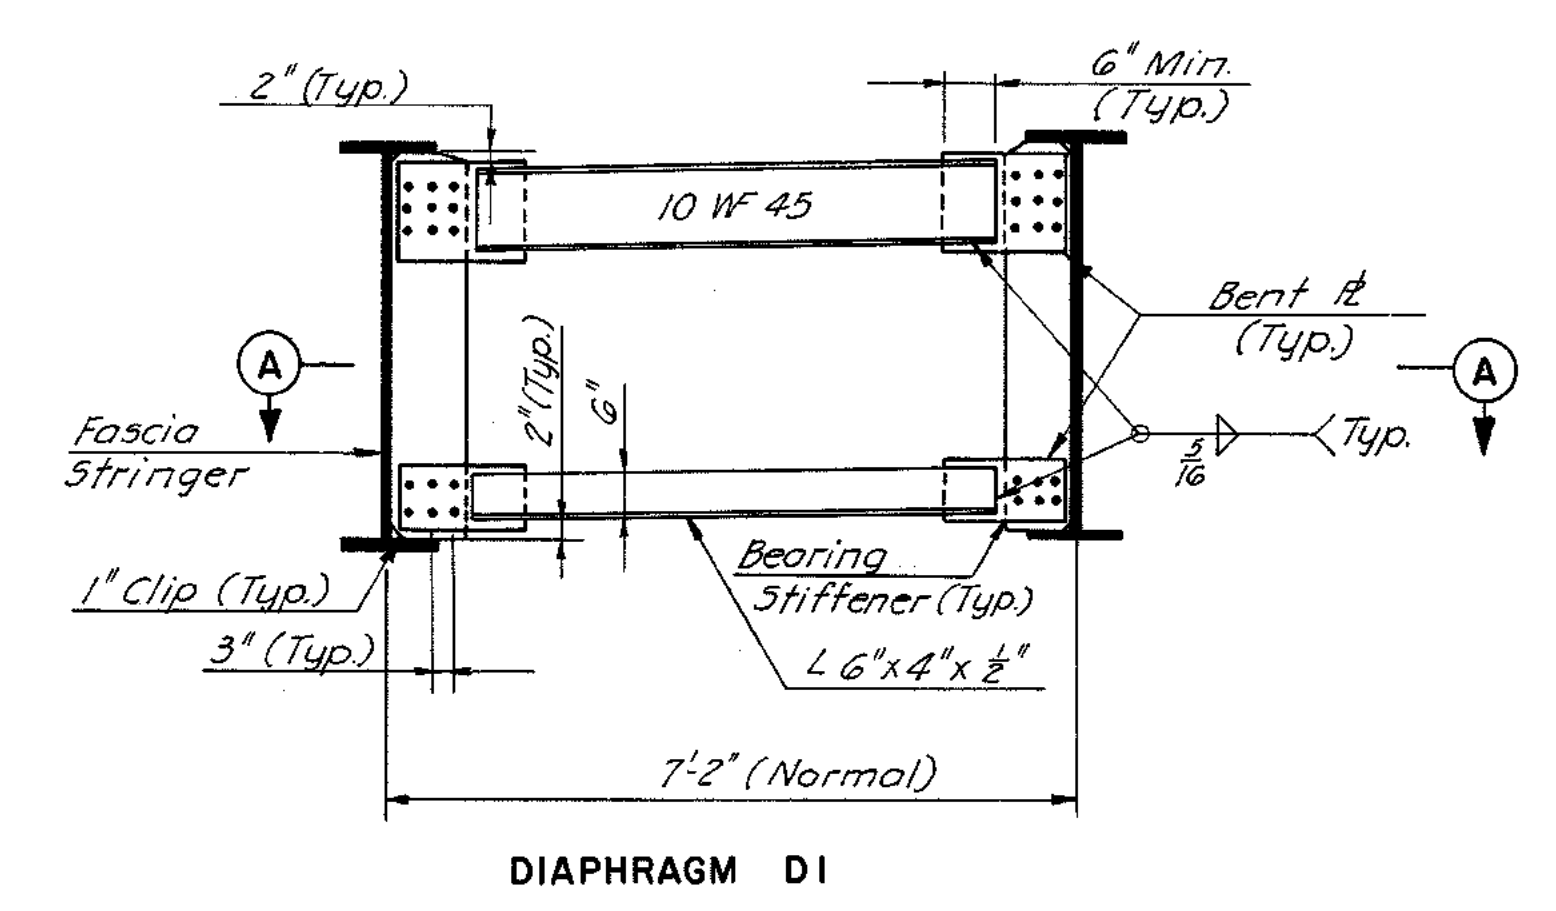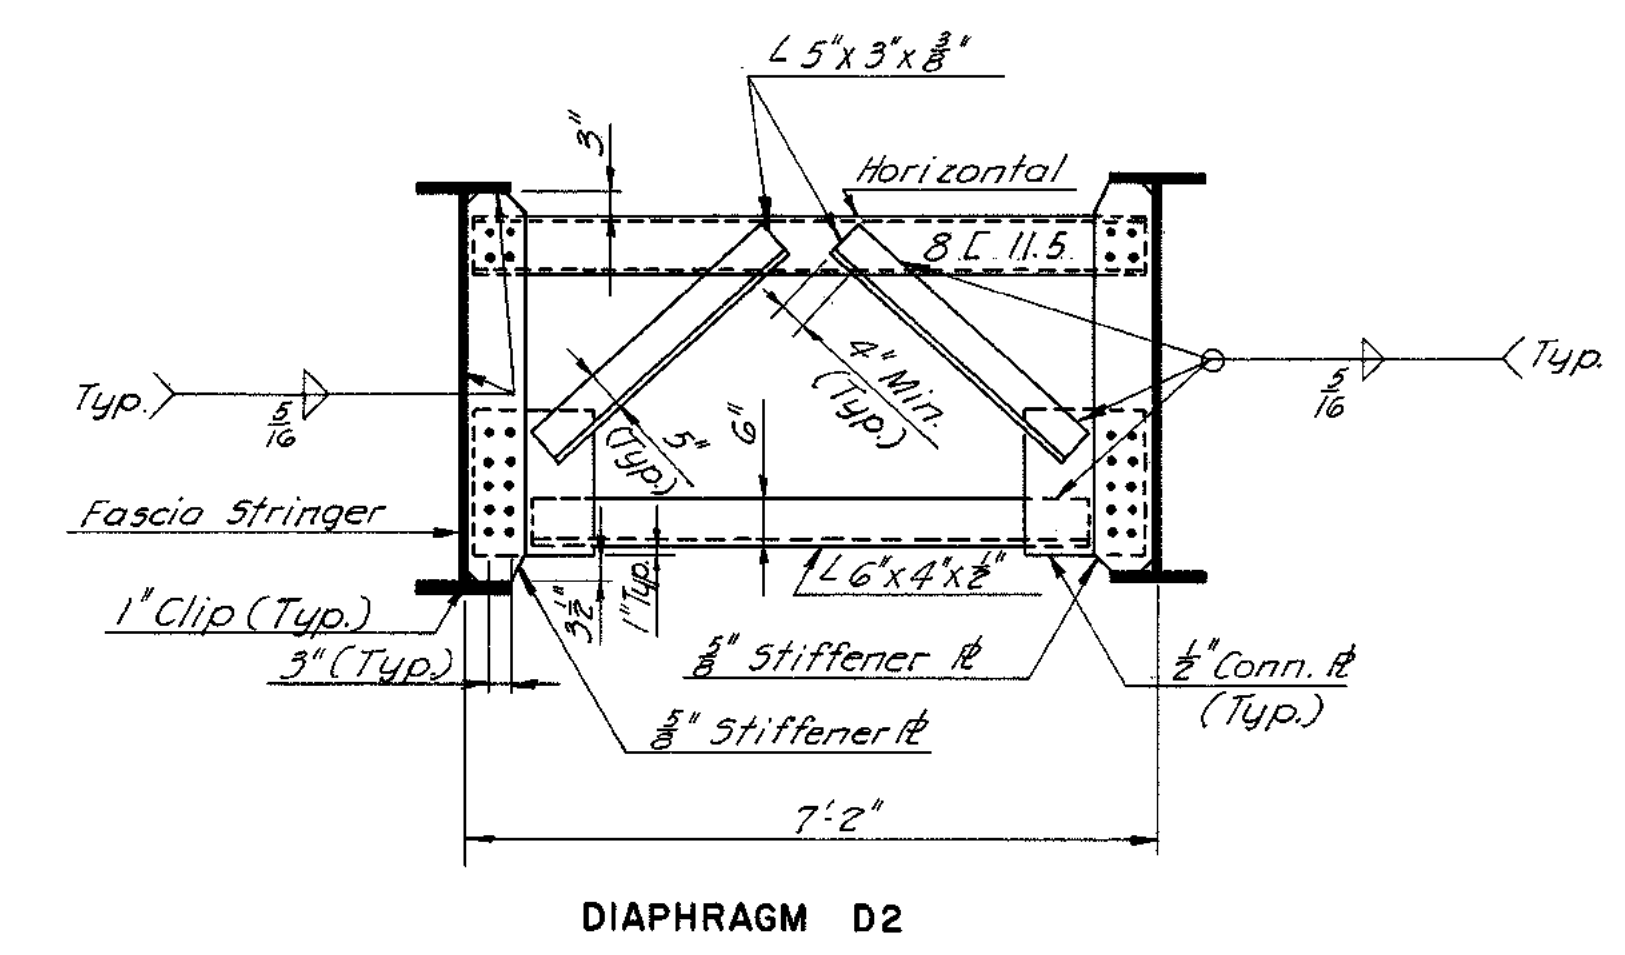

UTILITY	SUPPORT	A	B
Telephone	6 L 8.2	4'-11"	2'-5 1/2"
Elect. - City	6 L 8.2	2'-7"	1'-3 1/2"
Elect. - VEPCO	6 L 8.2	1'-7"	0'-9 1/2"

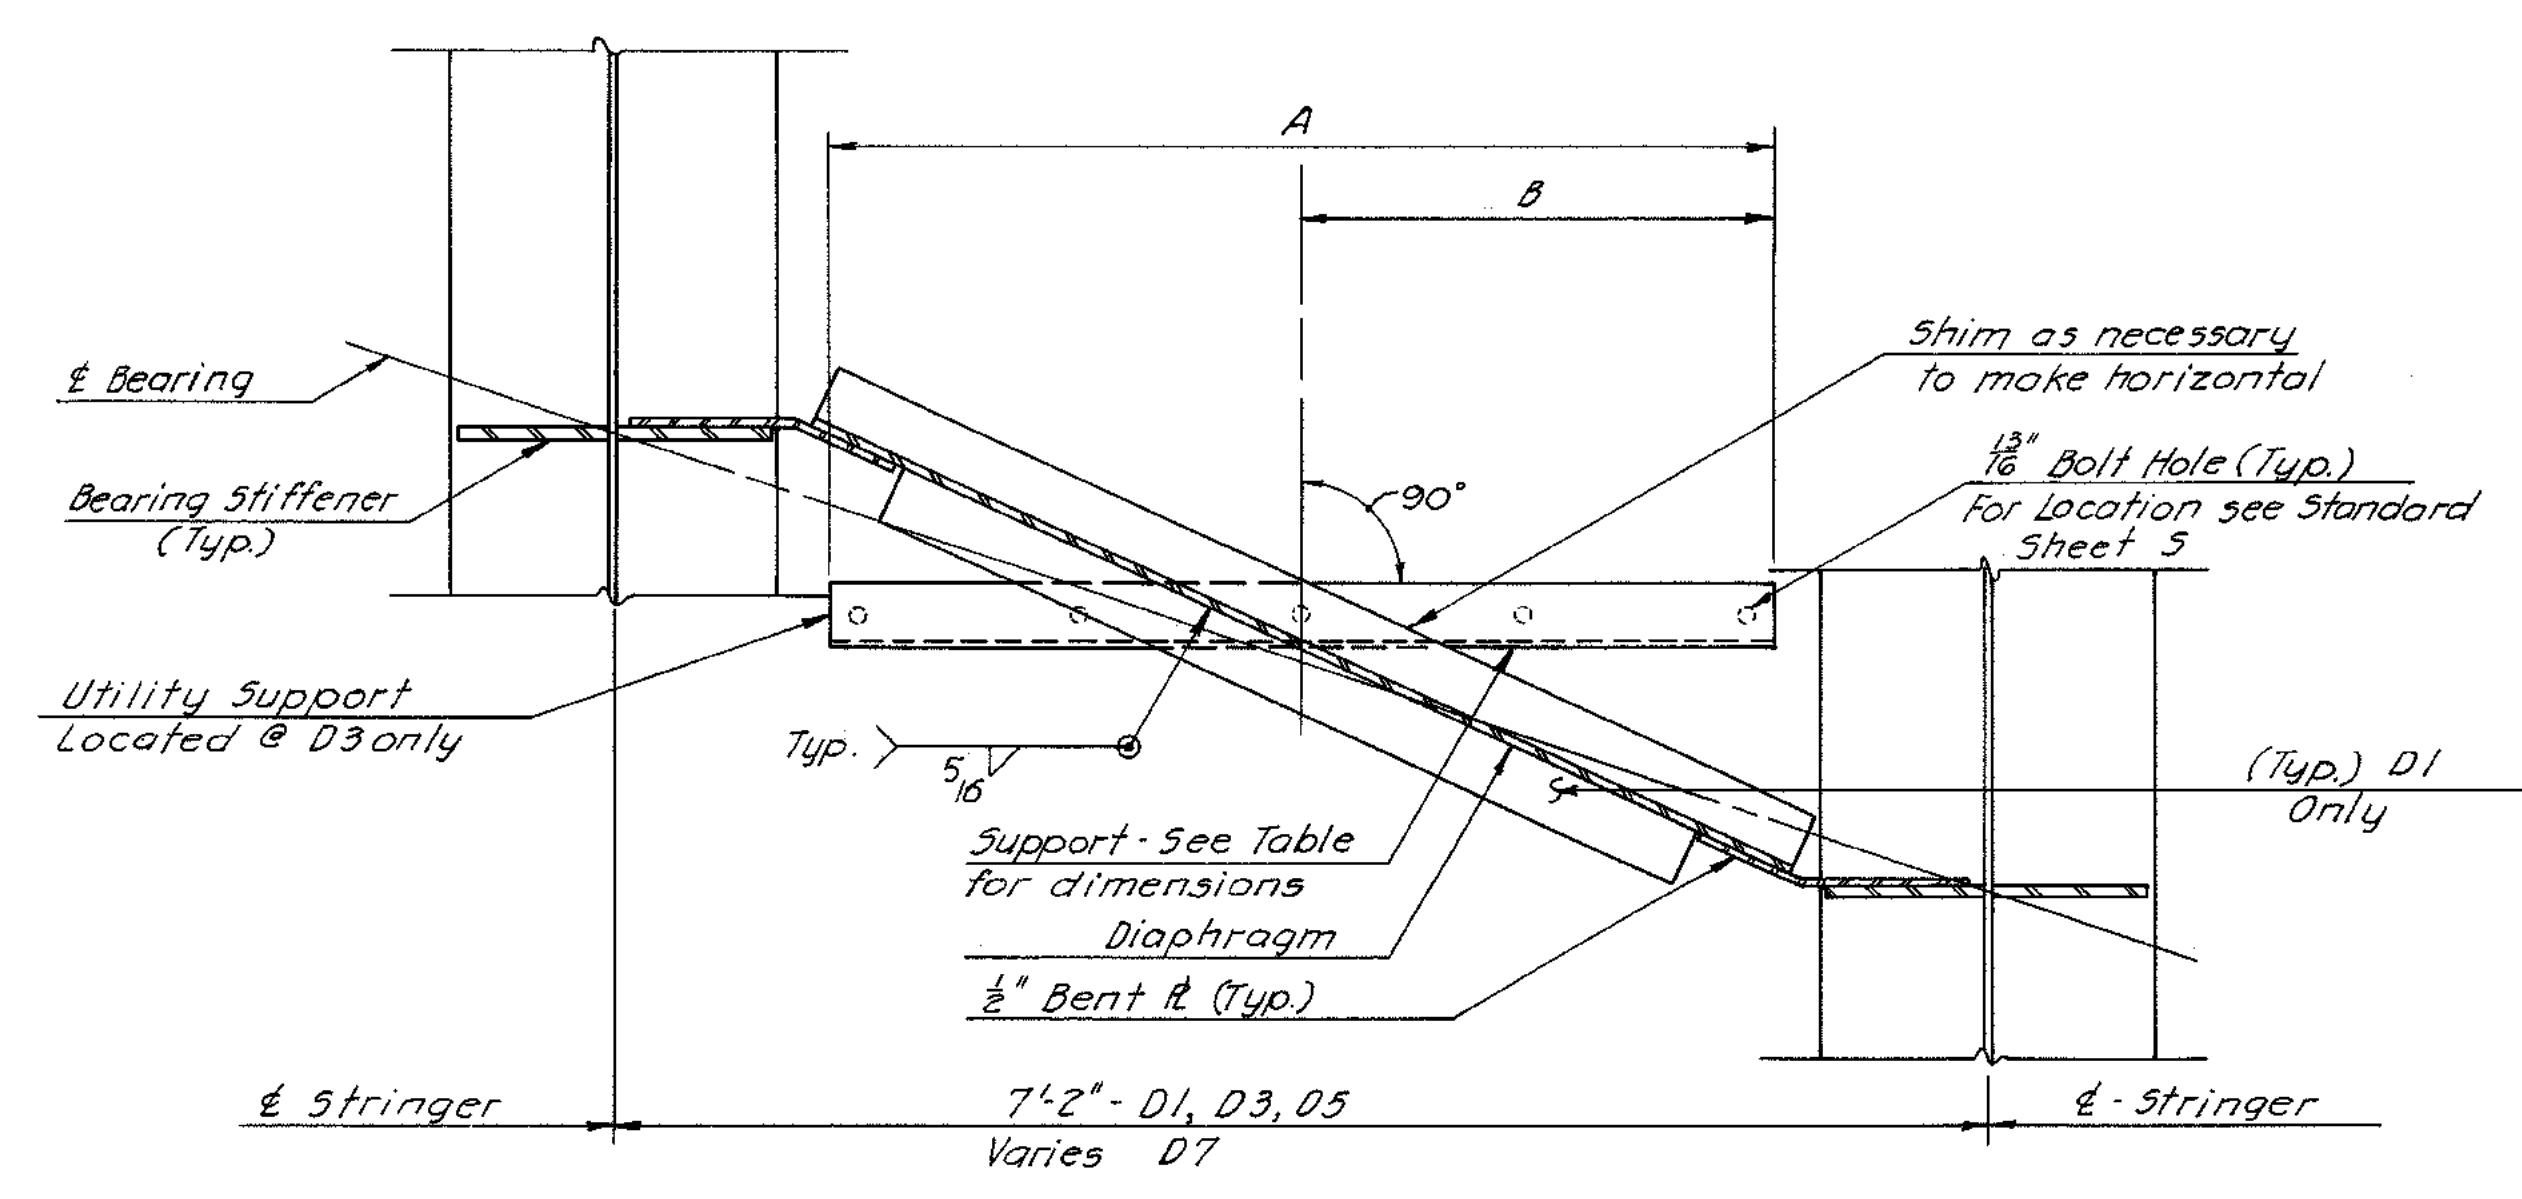


NOTES:  
For General Notes, see Sheet 1  
For Framing Plan, see Sheet 3  
For Stiffener Details, see Sheet 10

**AS BUILT**


RICHMOND METROPOLITAN AUTHORITY RICHMOND EXPRESSWAY SYSTEM DOWNTOWN EXPRESSWAY	
STRUCTURE B51 BELVIDERE STREET OVER DOWNTOWN EXPRESSWAY DIAPHRAGM DETAILS	
AMERICAN ENGINEERS Richmond, Virginia	SCALE: AS NOTED
HOWARD, NEEDLES, TAMMEN & BERGENDOFF General Consultants	CONTRACT NO. 8 SHEET NO. 12 OF 21

BY	DATE				
MADE	DLA 10-67				
CHECKED	WEO 12-67				
IN CHARGE	WEO	NO.	REVISION	BY	DATE


RICHMOND EXPRESSWAY SYSTEM			
SECTION	PROJECT	SHEET NO.	TOTAL SHEETS
8	DOWNTOWN EXPRESSWAY	244	

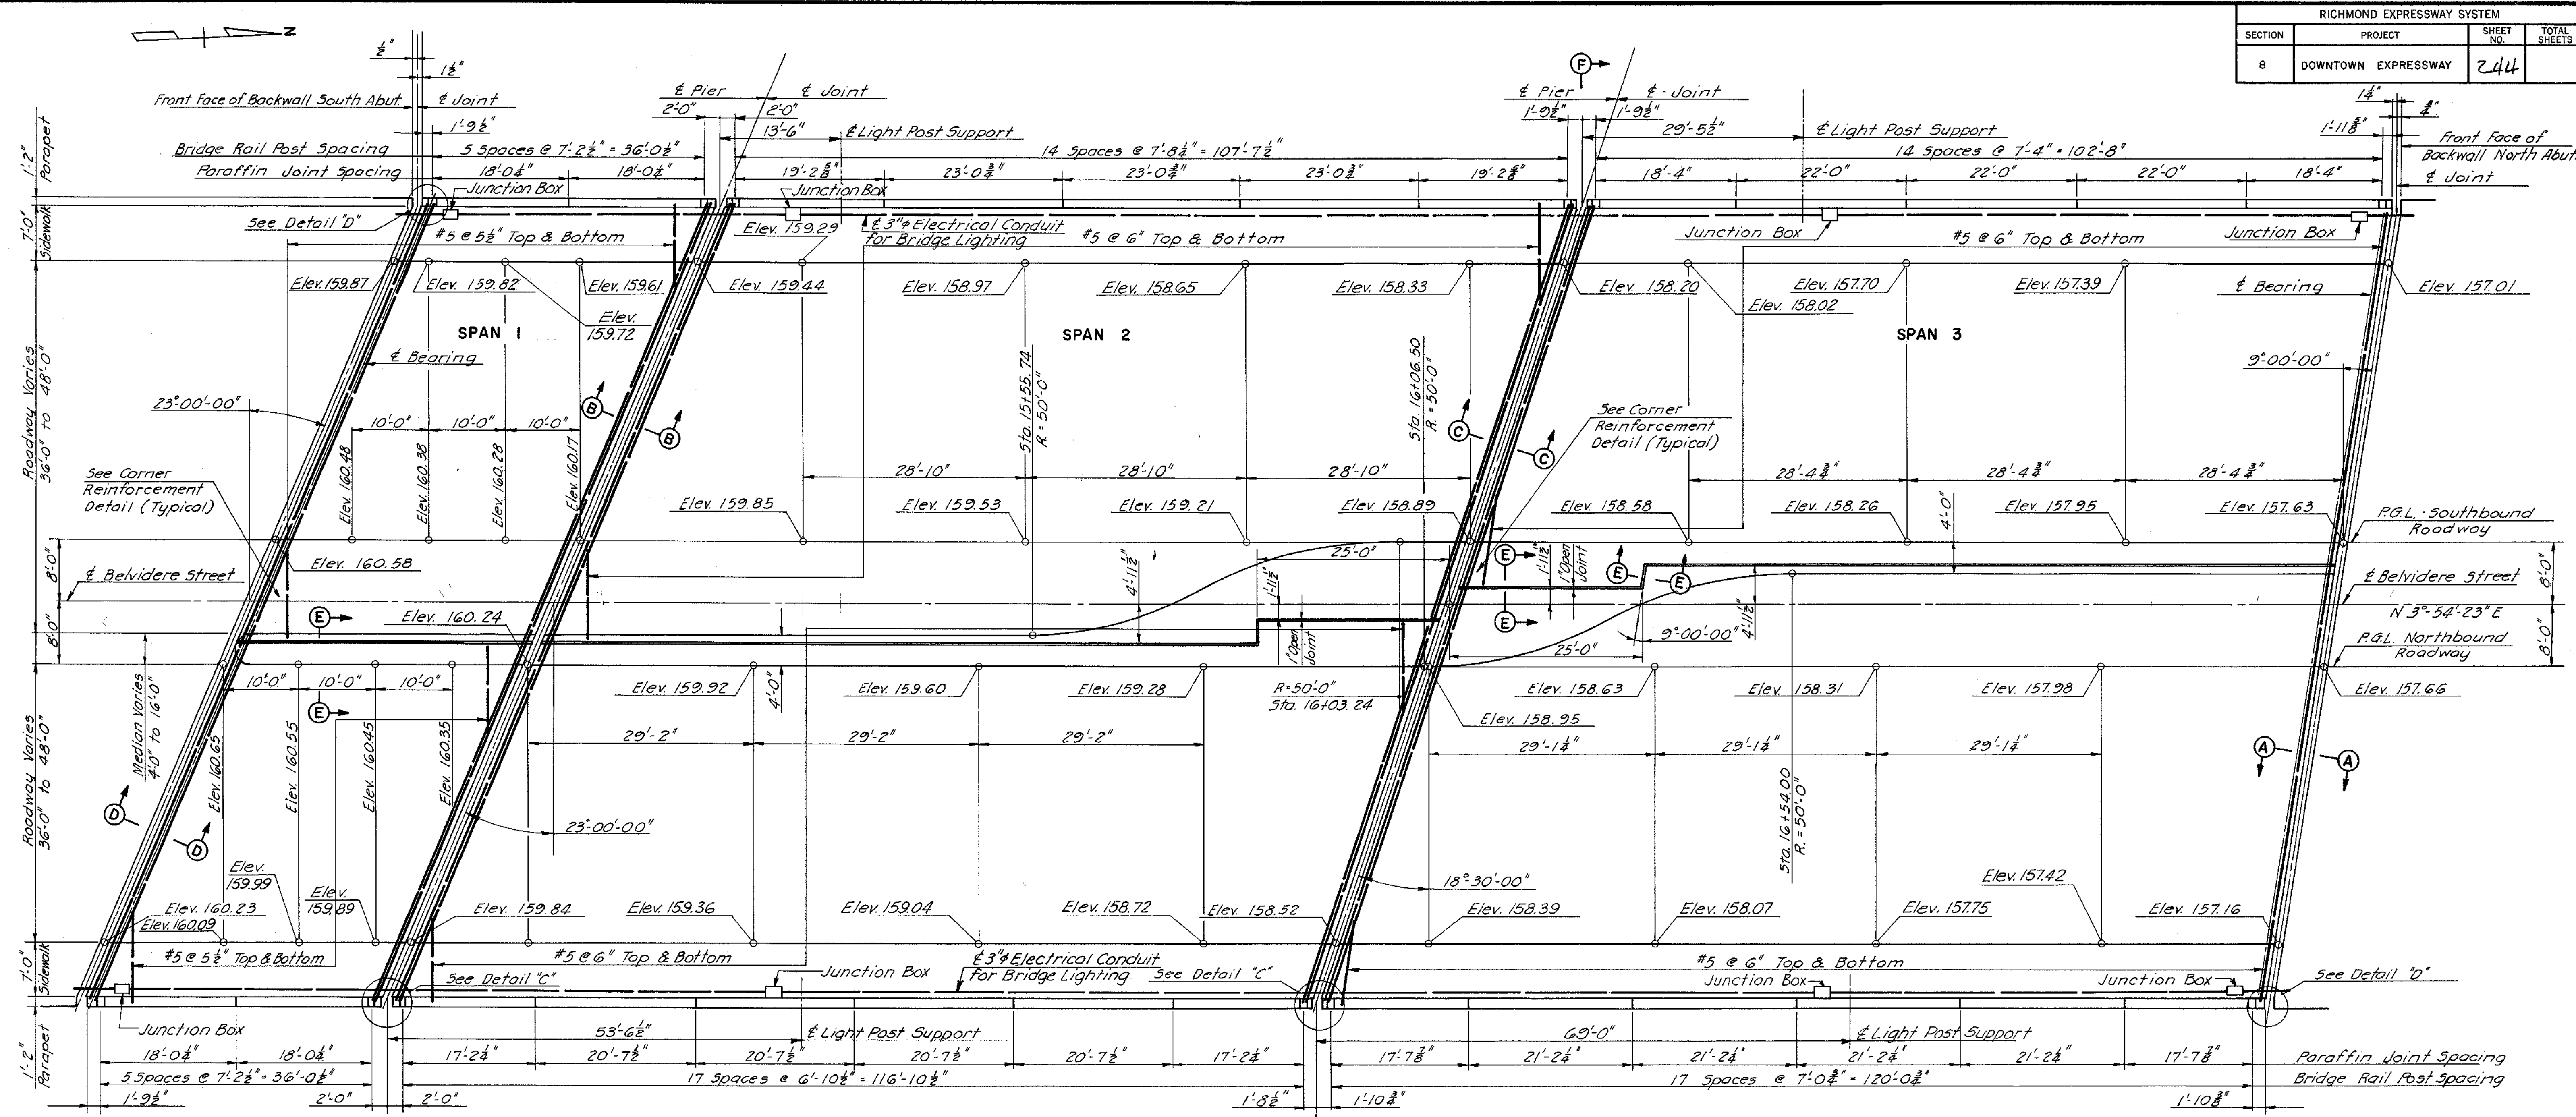

DECK PLAN  
Scale: 1"=10'-0"

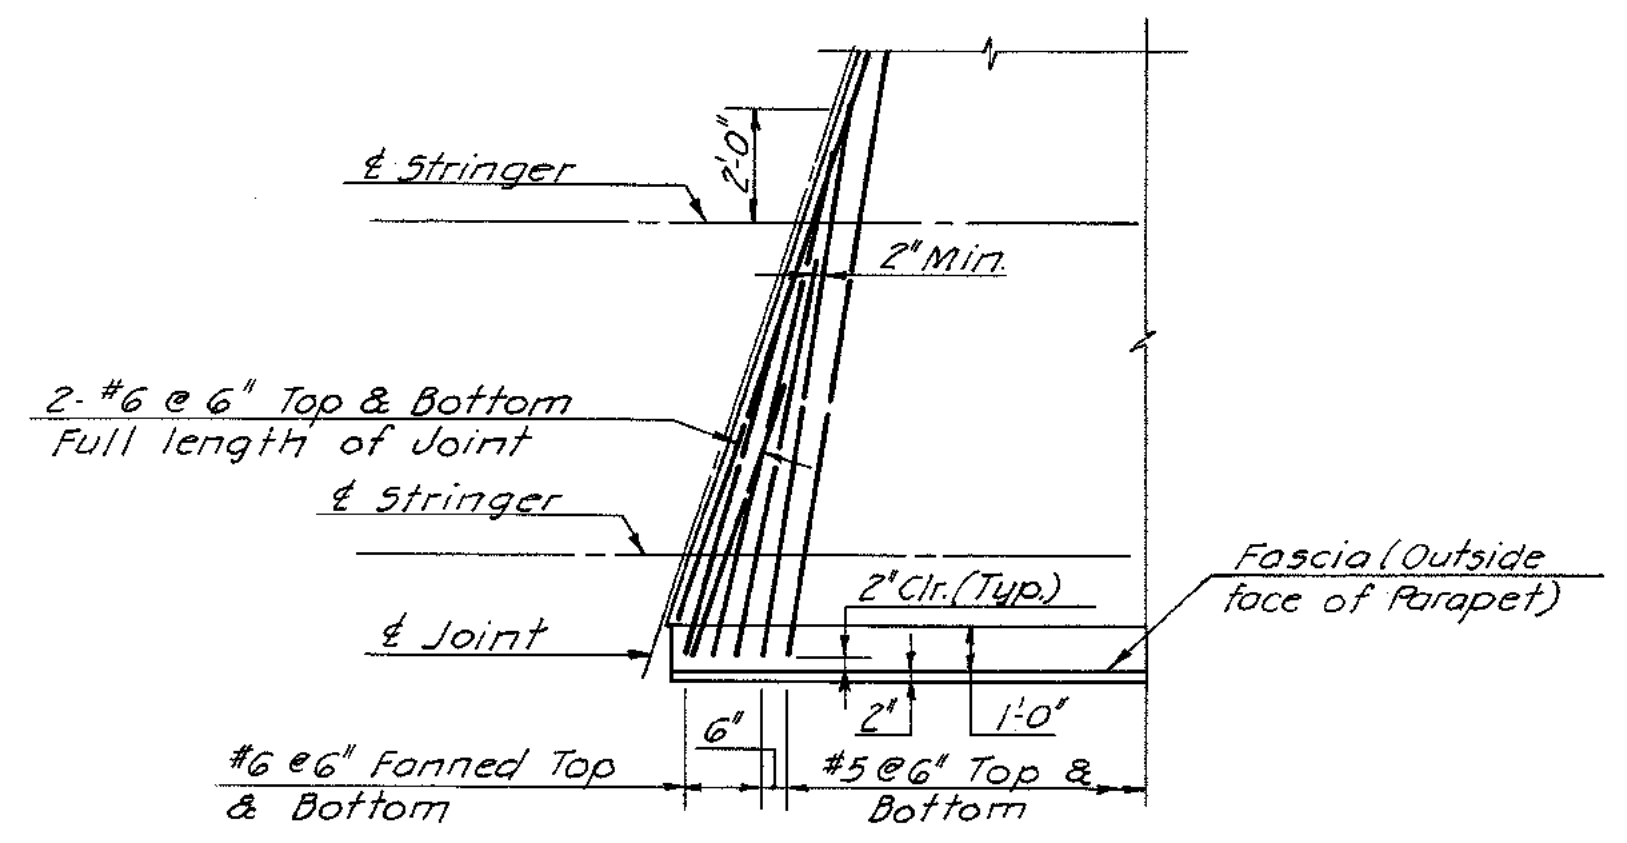

TYPICAL CORNER REINFORCEMENT DETAIL  
(Pier 2 - Span 3)  
Outside Face of Parapet Shown (Median Joint Similar)  
Scale: 1/4"=1'-0"

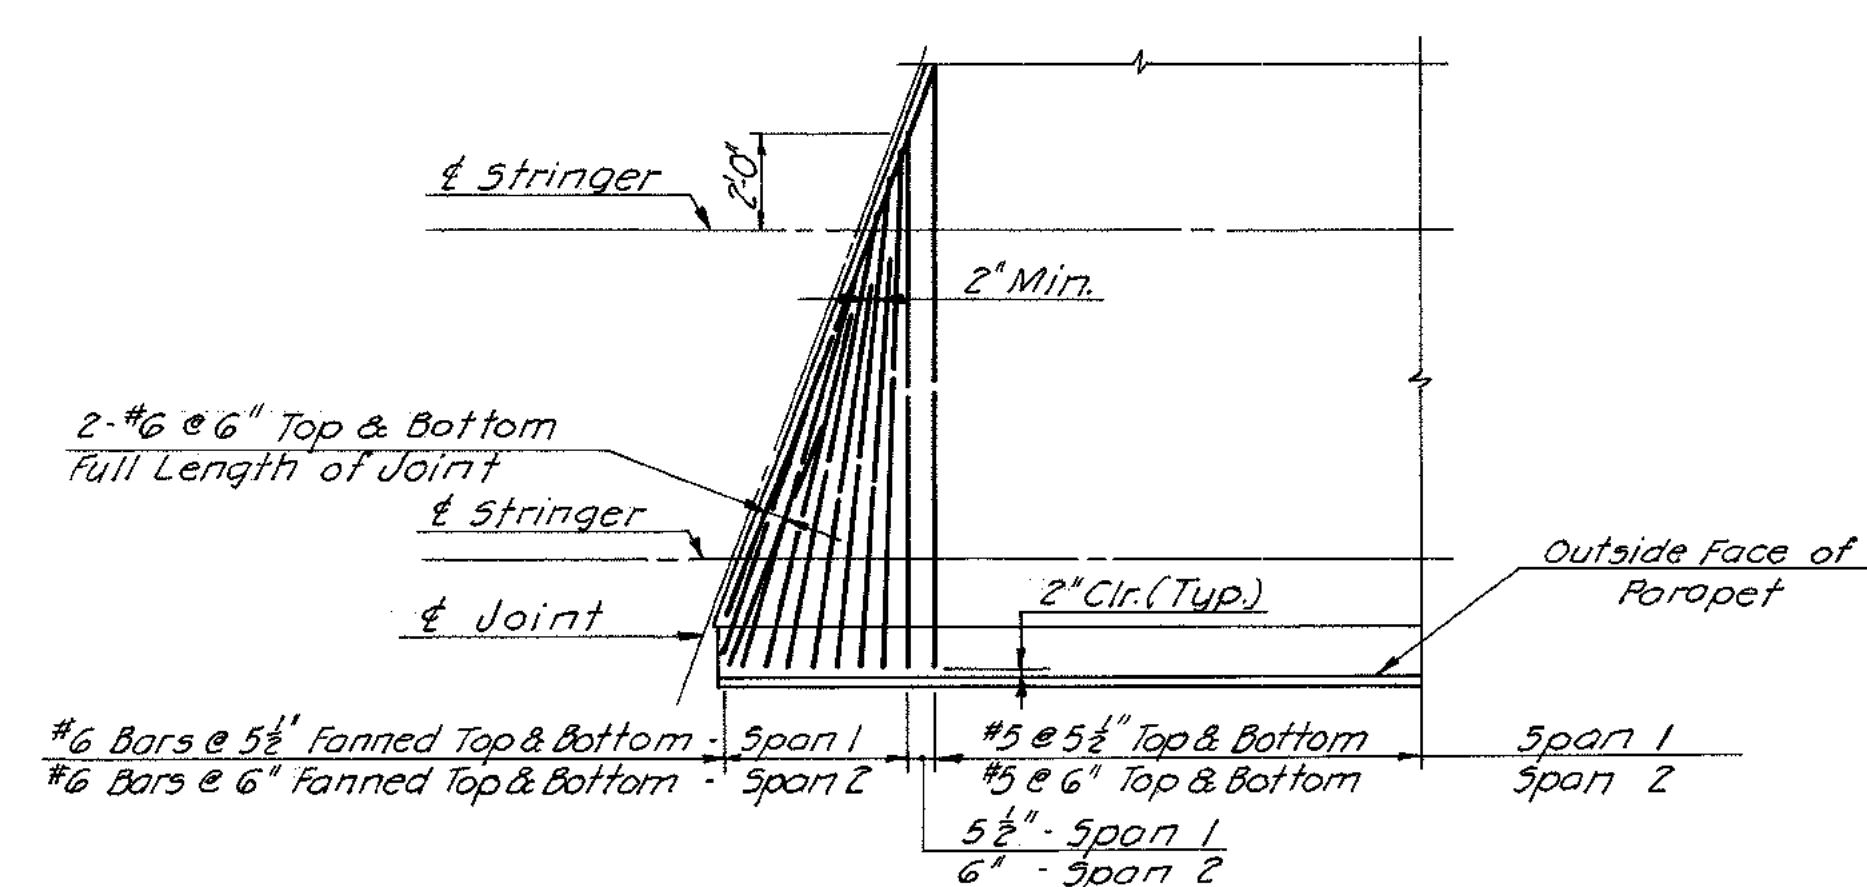

TYPICAL CORNER REINFORCEMENT DETAIL  
(Spans 1 & 2)  
Outside Face of Parapet Shown (Median Joint Similar)  
Scale: 1/4"=1'-0"


NOTES:  
For General Notes, see Sheet 1  
For Typical Deck Cross Section, see Sheet 11.  
For Joint Details, see Sheet 15.  
For Sections and Details, see Sheet 15.  
For Typical Parapet Elevation, see Sheet 15.

# AS BUILT


RICHMOND METROPOLITAN AUTHORITY	
RICHMOND EXPRESSWAY SYSTEM	
DOWNTOWN EXPRESSWAY	
STRUCTURE B51	
BELVIDERE STREET OVER	
DOWNTOWN EXPRESSWAY	
DECK PLAN	
AMERICAN ENGINEERS Richmond, Virginia	SCALE: AS NOTED
HOWARD, NEEDLES, TAMMEN & BERGENDOFF General Consultants	CONTRACT NO.: 8
	SHEET NO. 14 OF 21

MADE	BY	DATE	NO.	REVISION	BY	DATE
DLA	WEO	9-67				
CHECKED	WEO	12-67				
IN CHARGE	WEO					


RICHMOND EXPRESSWAY SYSTEM			
SECTION	PROJECT	SHEET NO.	TOTAL SHEETS
8	DOWNTOWN EXPRESSWAY	264	

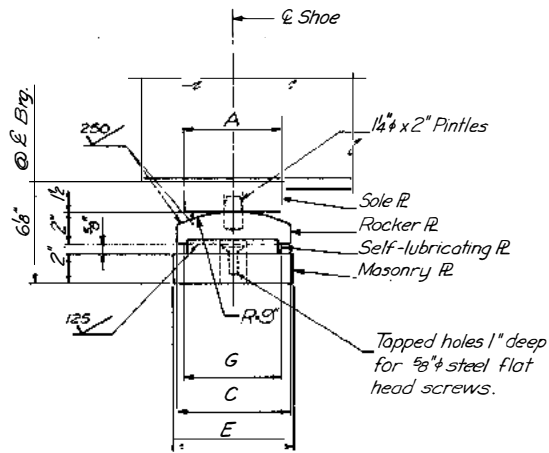


SIDE ELEVATION

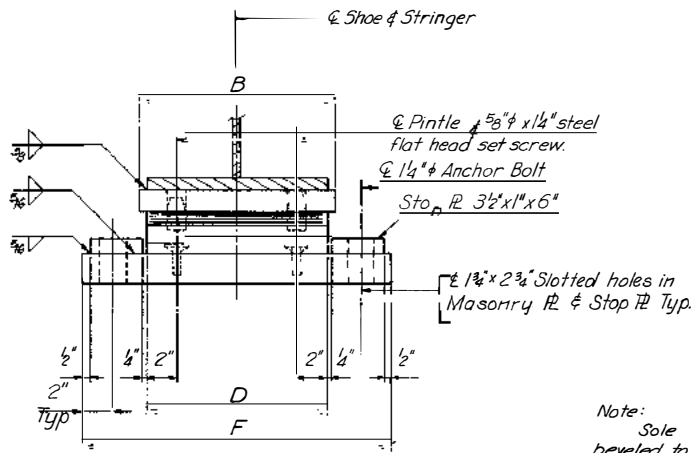


END ELEVATION

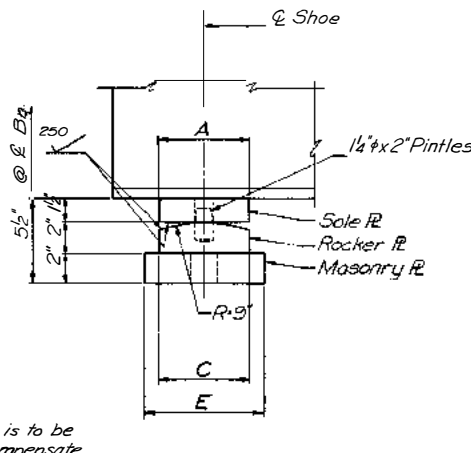

SIDE ELEVATION

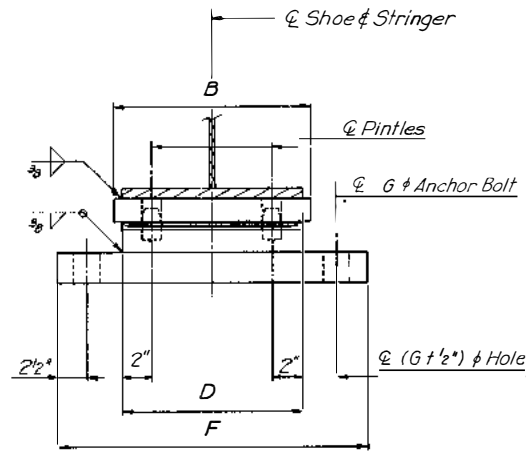


END ELEVATION

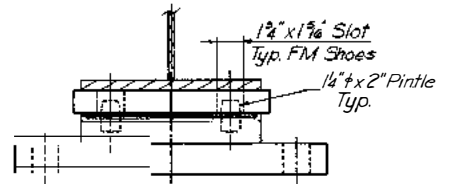


END ELEVATION

Note:  
Fixed Modified Shoes same as  
Fixed Shoes except as shown.

EXPANSION SHOE  
No Scale

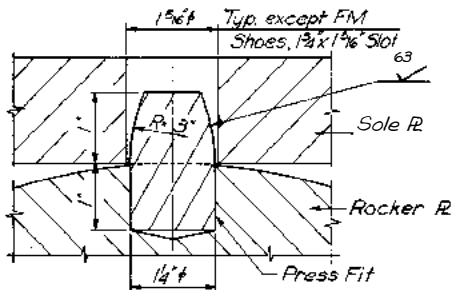


PINTLE DETAIL  
Scale: 3/4\"/>

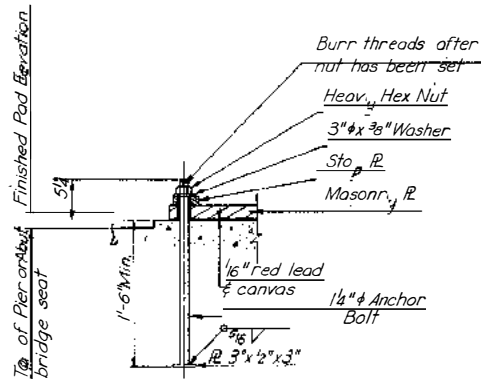

EXPANSION SHOE

ANCHOR BOLT DETAIL  
No Scale

FIXED SHOE  
No Scale

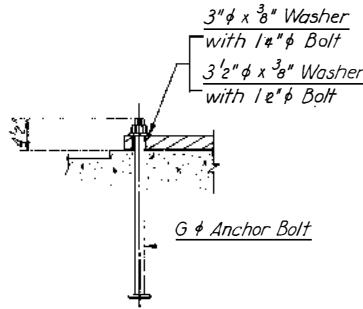

FIXED SHOE

Note:  
Anchor Bolt for Fixed Shoes  
same as Anchor Bolt for Exp. Shoes  
except as shown.

#### Shoe Notes

Material for shoes (exclusive of self-lubricating plates) shall be high strength low alloy structural steel conforming to ASTM specification A-588.  
Material for self-lubricating plates shall be Leaded Tin Bronze conforming to ASTM specification B22, Alloy D modified to the extent that 1.5 to 2.5 percent lead is allowable.  
Shoes shall be included with structural steel item for payment.  
Top of masonry plates, bottom of sole plates and top and bottom of sole plates shall be planed, straightened or otherwise treated to secure true plane surfaces.  
Contact surfaces noted on the plans with finish symbols shall be finished in accordance with the American Standards Association surface roughness requirement as defined in ASA B45.1 Surface Roughness, Waviness and Lay, Part I.  
The plates comprising the expansion shoes shall be set so as to be truly centered under full dead load at a temperature of 60 °F.  
Concrete pads shall be formed integral with abutment or pier and not less than 1/8" or more than 1/4" above finished elevation. Dress down pads by rubbing, grinding or as otherwise approved by the Engineer, to true level surfaces at the finished elevation.  
Anchor bolt assemblies shall conform to A.S.T.M. A-307 and shall be hot-dip galvanized conforming to A.S.T.M. A-153.  
Templates shall be used to accurately set the anchor bolts.

SHOE DIMENSIONS																	
EXPANSION SHOES								FIXED SHOES									
TYPE	NO. REQD.	A	B	C	D	E	F	G	TYPE	NO. REQD.	A	B	C	D	E	F	G
E 1	29	6"	1'-1"	7½"	1'-0"	8"	1'-8½"	6"	F 1	39	6"	1'-1"	6"	1'-0"	7½"	1'-9"	1¼" φ
E 2	7	6"	1'-1"	8½"	1'-0"	9"	1'-8½"	6½"	F 1M	18	6"	1'-1"	6"	1'-0"	7½"	1'-9"	1¼" φ
E 3	21	6"	1'-1"	9"	1'-1"	9½"	1'-9½"	7"	F 2	9	6"	1'-5½"	6"	1'-4½"	7"	2'-2"	1¼" φ
E 4	14	6"	1'-5½"	8"	1'-4½"	8½"	2'-1"	7"	F 2M	6	6"	1'-5½"	6"	1'-4½"	7"	2'-2"	1¼" φ
E 5	1	6"	1'-5½"	9"	1'-4½"	9½"	2'-1"	7"	F 4	11	6"	1'-7"	6"	1'-6"	7"	2'-4"	1½" φ
E 7	20	6"	1'-7"	9½"	1'-6"	10½"	2'-2½"	7½"	F 4M	7	6"	1'-7"	6"	1'-6"	7"	2'-4"	1½" φ
E 9	40	6"	1'-9"	10"	1'-8"	11"	2'-4½"	7½"	F 6	18	6"	1'-9"	6"	1'-8"	7"	2'-6"	1½" φ
									F 6M	12	6"	1'-9"	6"	1'-8"	7"	2'-6"	1½" φ
									F 7	10	6"	1'-9"	6"	1'-8"	8"	2'-6"	1½" φ
									F 5	1	6"	1'-7"	6"	1'-6"	8"	2'-4"	1½" φ
									F 5M	1	6"	1'-7"	6"	1'-6"	8"	2'-4"	1½" φ

AS BUILT

RICHMOND METROPOLITAN AUTHORITY  
RICHMOND EXPRESSWAY SYSTEM

STANDARD  
SHOE DETAILS  
Bridges 50, 51

HOWARD, NEEDLES, TAMMEN & BERGENDOFF  
consulting engineers  
NEW YORK ALEXANDRIA KANSAS CITY

SCALE: AS SHOWN  
CONTRACT NO.: 8  
SHEET NO. S1 OF

BY	DATE				
MADE	J.M.S.	10-67			
CHECKED	M.E.O.	10-67			
IN CHARGE	M.E.O.		NO.	REVISION	BY DATE





**Bridge 54**

**2<sup>nd</sup> Street**

**Over**

**Downtown Expressway (VA 195)**



**Record Set Plans**






RICHMOND EXPRESSWAY SYSTEM			
SECTION	PROJECT	SHEET NO.	TOTAL SHEETS
9	DOWNTOWN EXPRESSWAY	119	

INDEX	
NO.	DESCRIPTION
1	General Plan and Elevation
2	General Notes and Quantities
3	Support For Exist. Tel. Ducts
4	North Abutment
5	North Abutment Details
6	South Abutment
7	South Abutment Details (1)
8	South Abutment Details (2)
9	Pier 1
10	Pier 2
11	Framing Plan (1)
12	Framing Plan (2)
13	Cross Section (1)
14	Cross Section (2)
15	Deck Plan 1
16	Deck Plan 2
17	Joint Details
18	Approach Slabs and Slope Protection
19	Boring Logs
20	Boring Logs
5A	Retaining Wall North Abutment
S1	Standard Shoe Details
S3	Standard Aluminum Railing Details (2 Rails)
S4	Standard Electrical Details (Bridges Carrying City Streets)
S7	Standard Architectural Details
S8	Standard Architectural Details
S9	Standard Architectural Details
S10	Standard Conduit Installation Details
S11	Standard Utility Support Details at Bridge Abutments

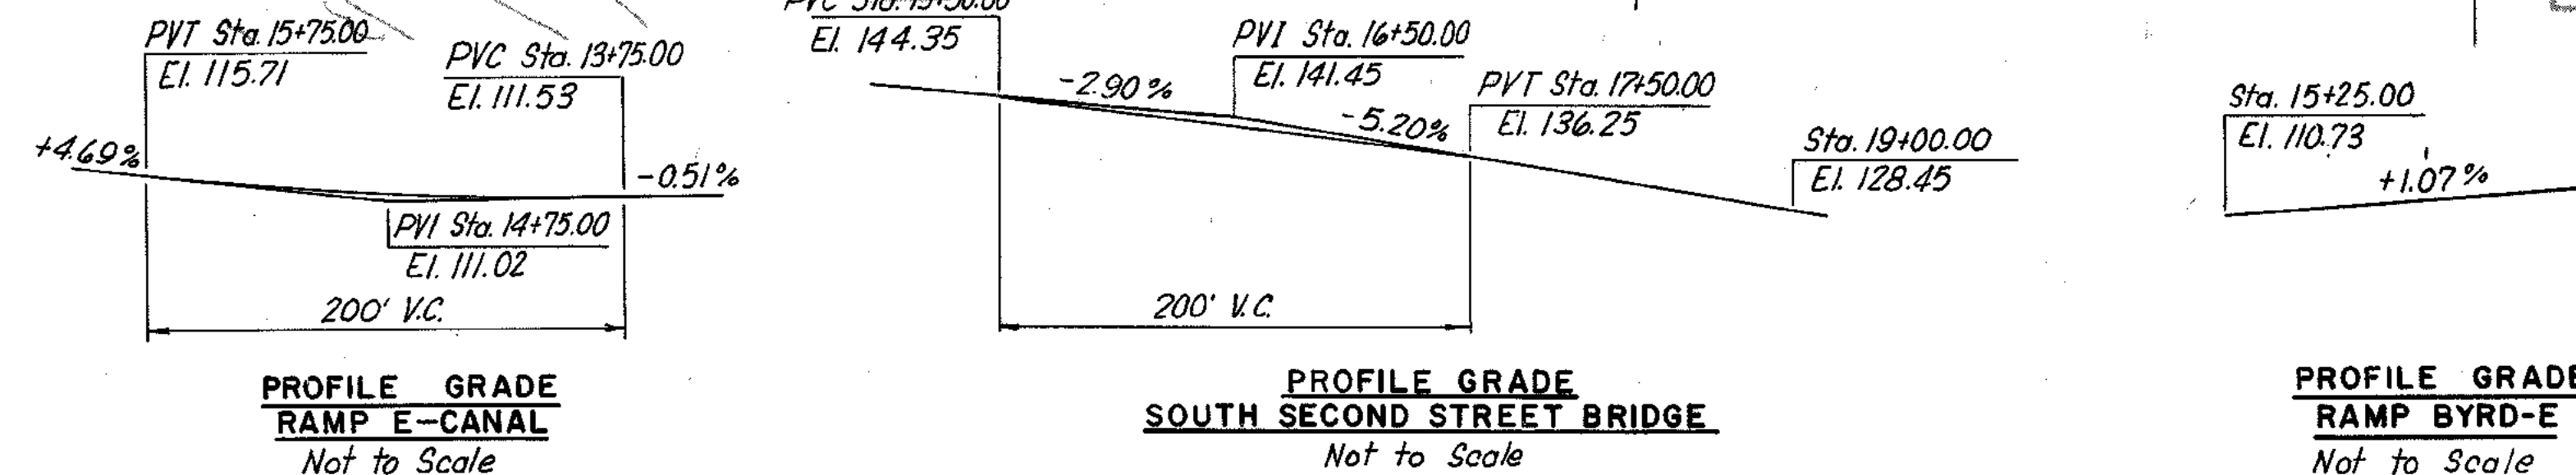
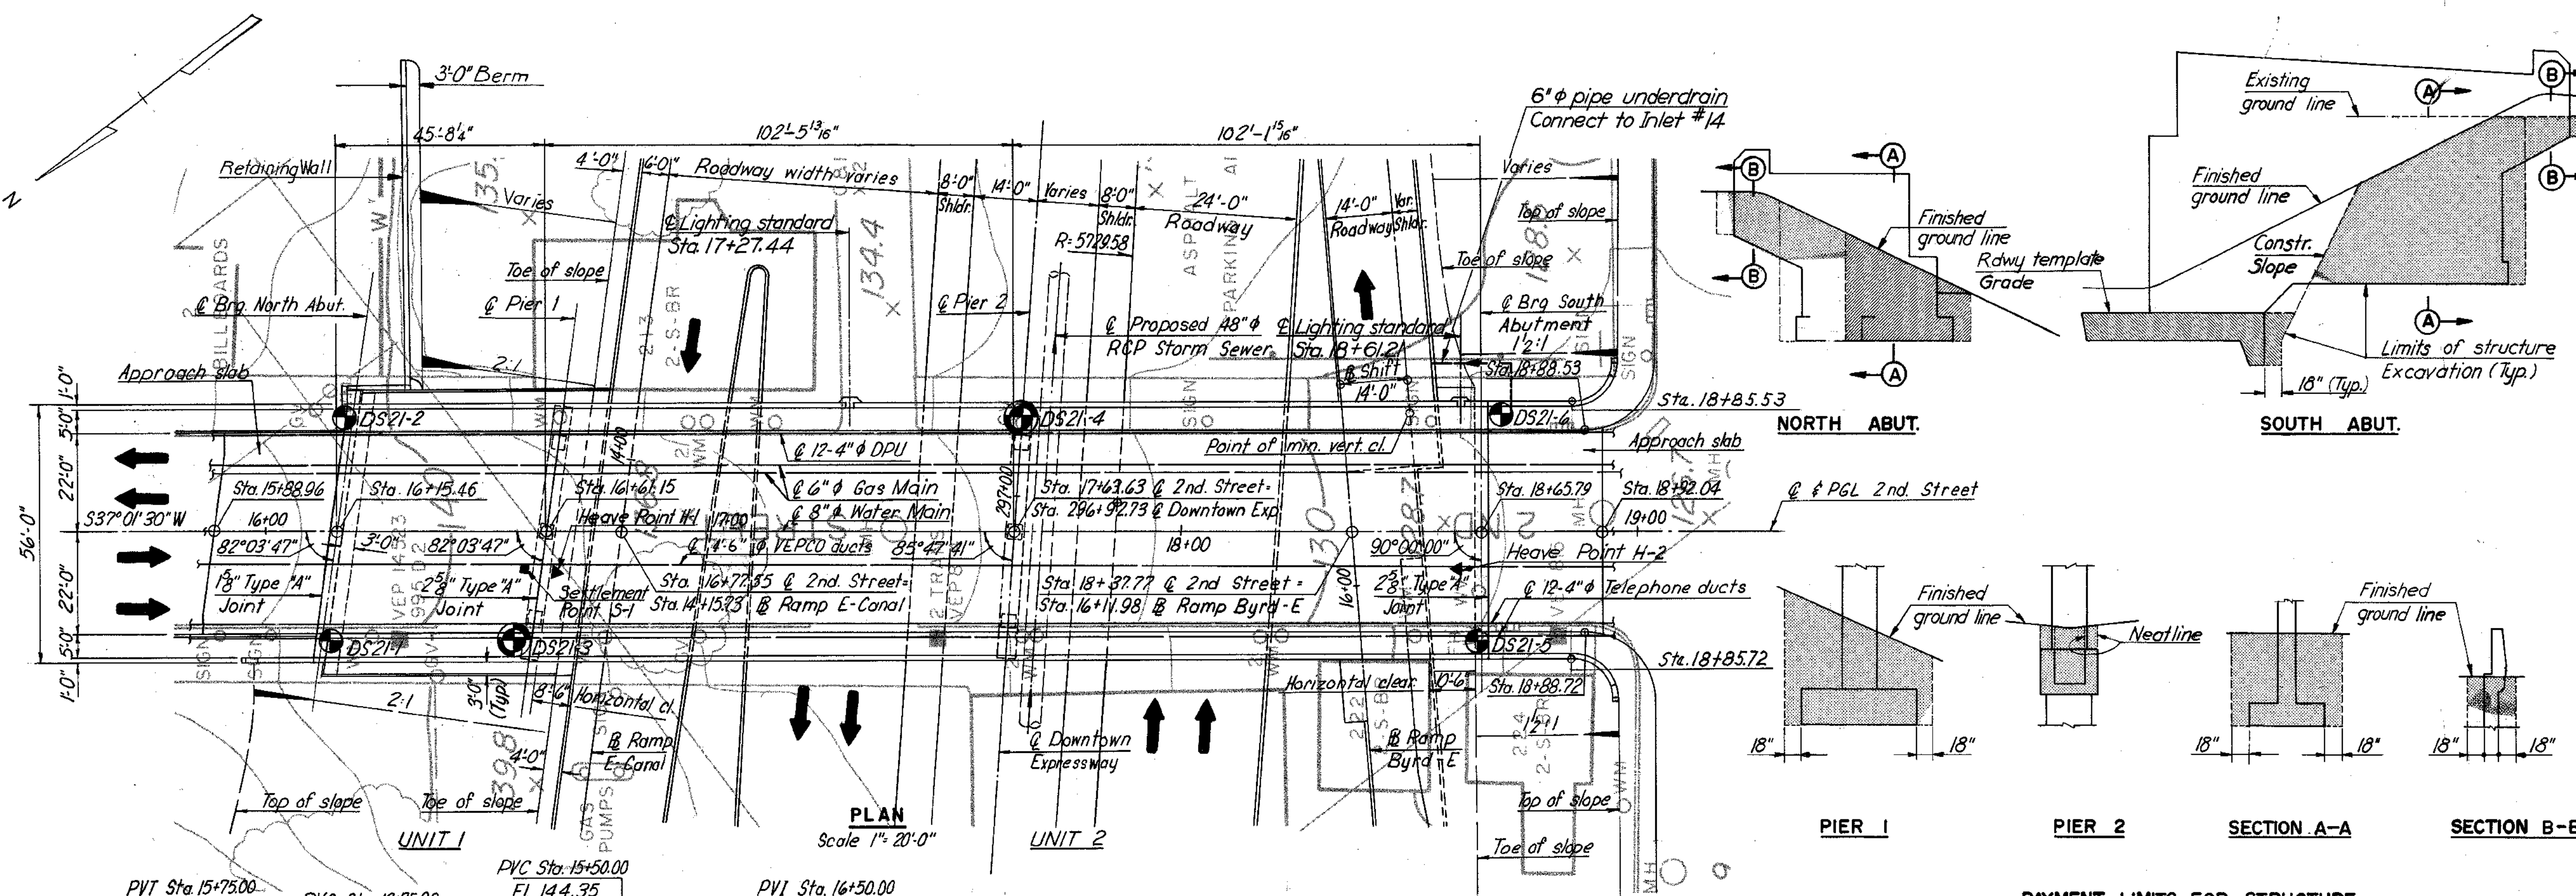


**PAYMENT LIMITS FOR STRUCTURE EXCAVATIONS**  
No Scale

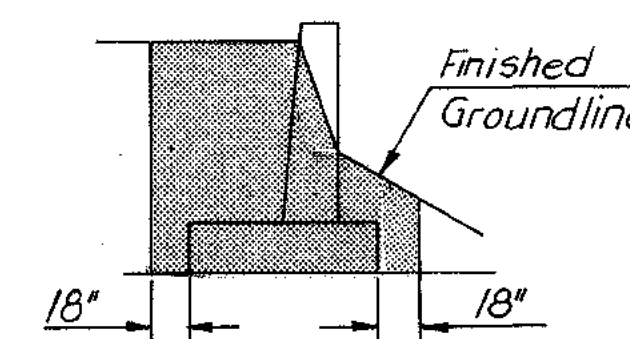

**RETAINING WALL AT NORTH ABUTMENT**

**INSTRUMENTATION:**  
 \* Indicates location of Heave Point.  
 \* Indicates location of Settlement Point.  
**BORINGS:**  
 \* Indicates location of 2 1/2" cased hole boring.  
 \* Indicates location of 4" cased hole boring.  
 For boring data, see Boring Logs sheet.  
**NOTE:**  
 For General Notes and Quantities, see next sheet.

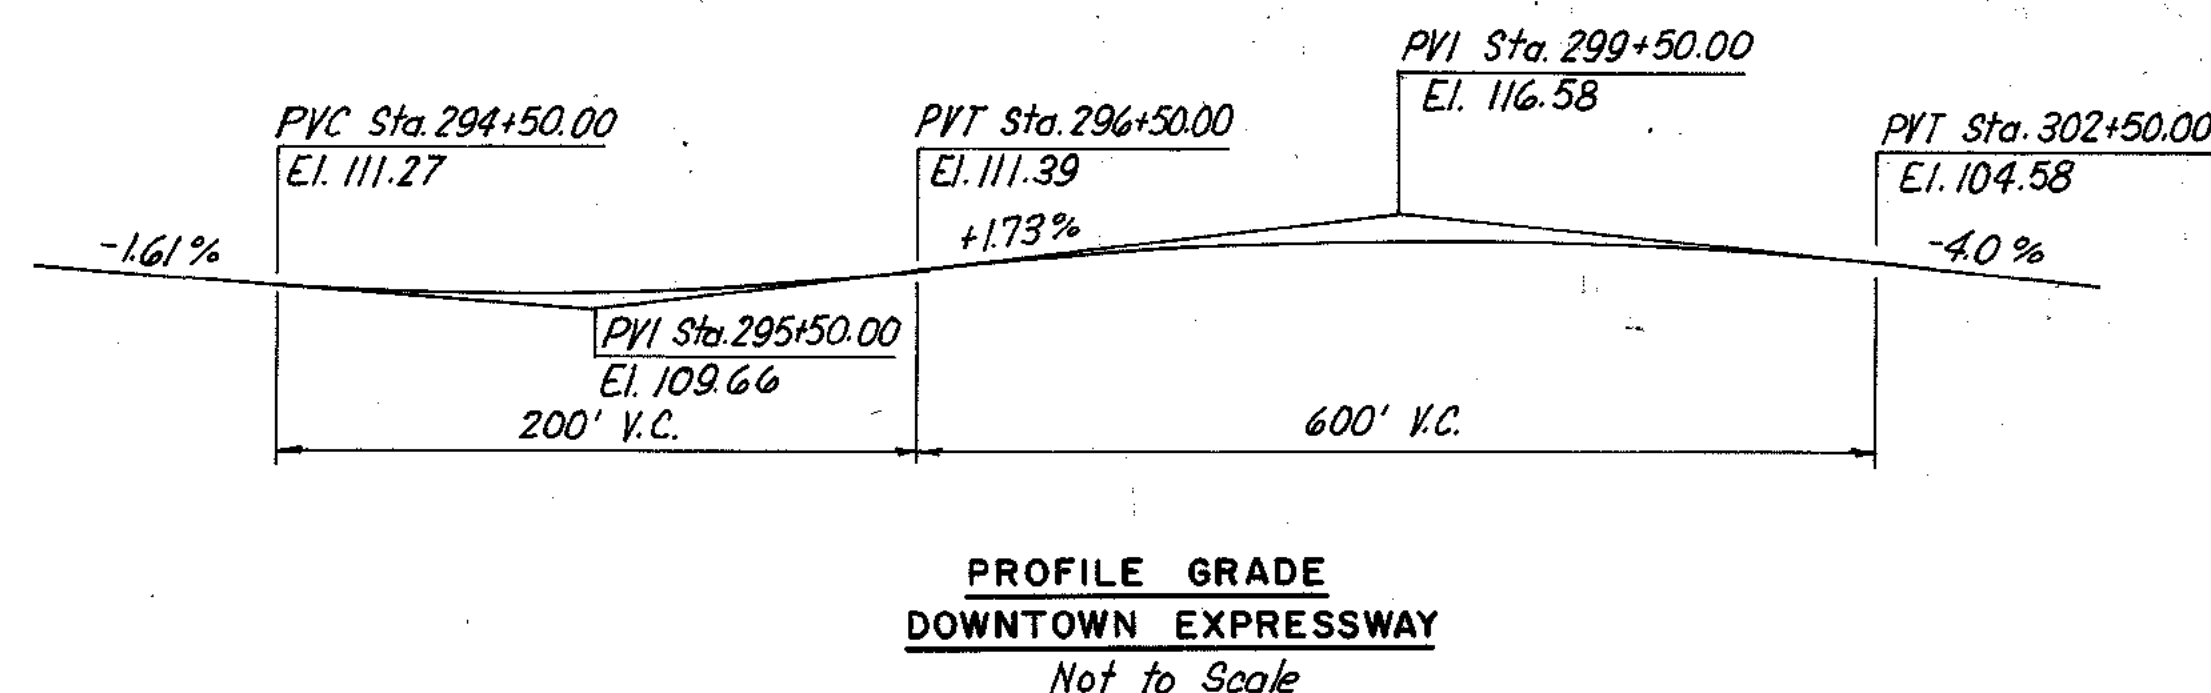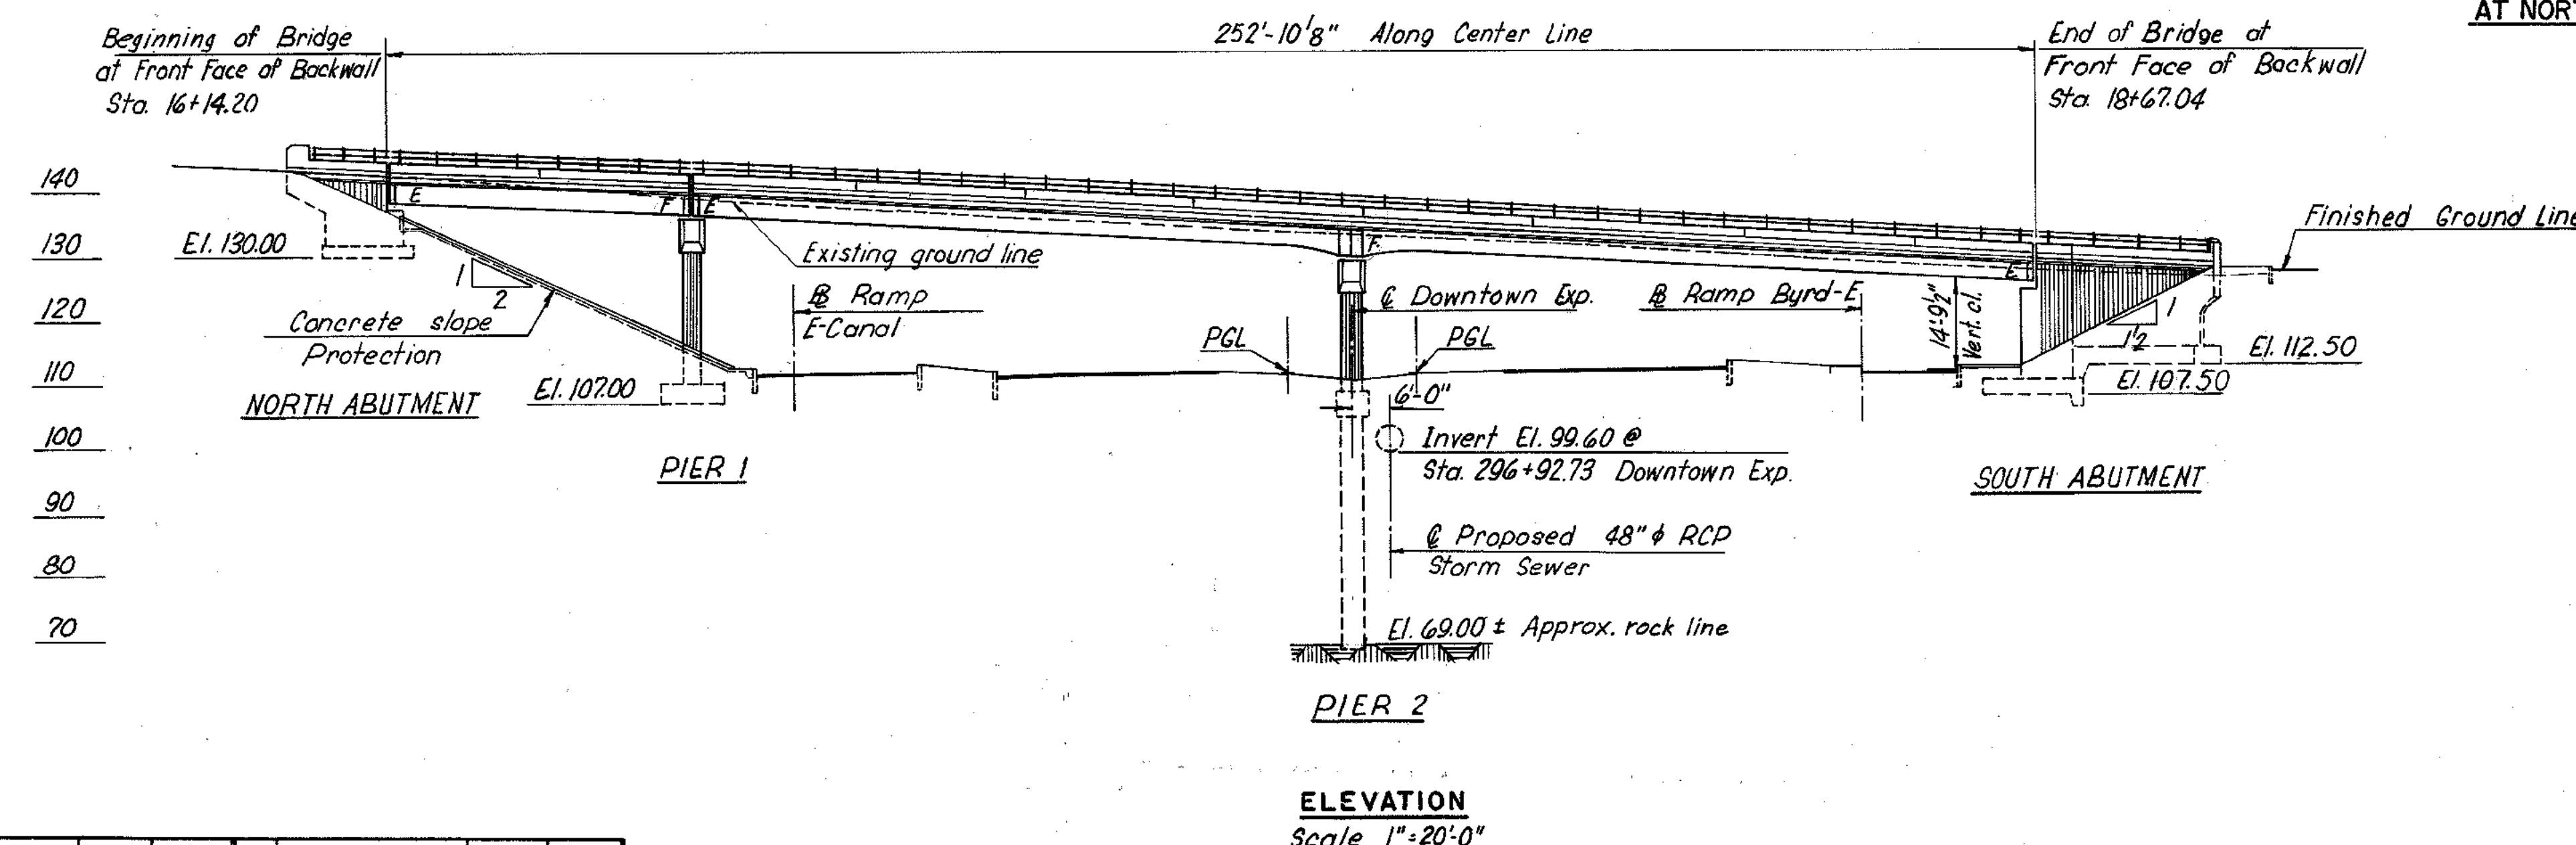

**PROFILE GRADE DOWNTOWN EXPRESSWAY**  
Not to Scale

MADE	BY	DATE	REVISION	BY	DATE
EF	6-67	2	As Built	TEM	6-77
DSB	5-68	1	Retaining Wall Added		
PRY					

**RICHMOND METROPOLITAN AUTHORITY**  
**RICHMOND EXPRESSWAY SYSTEM**  
 DOWNTOWN EXPRESSWAY  
 BRIDGE B-54  
 2ND STREET OVER  
 DOWNTOWN EXPRESSWAY  
**GENERAL PLAN AND ELEVATION**

HOWARD, NEEDLES, TAMMEN & BERGENDOFF  
 consulting engineers  
 NEW YORK ALEXANDRIA KANSAS CITY

SCALE: AS SHOWN  
 CONTRACT NO. 9  
 SHEET NO. 119 OF 20

AS BUILT



GENERAL NOTES

RICHMOND EXPRESSWAY SYSTEM			
SECTION	PROJECT	SHEET NO.	TOTAL SHEETS
5	DOWNTOWN EXPRESSWAY	120	

ROADWAY CAPACITY:	One 42'-0" clear roadway. Two 5'0" sidewalks. Dead Load-Includes 15 lbs. per sq.ft. for future wearing surface. Live Loads-HS20-44 loading and B.P.R. modified for military vehicles.
SPECIFICATIONS:	GENERAL-Virginia Department of Highway Road and Bridge Specifications, 1970. DESIGN-A.A.S.H.O. Standard Specifications for Highway Bridges, 1961, modified by Special Design Provisions. WELDING-1969 Standard Specifications for Welded Highway and Railway Bridges of the American Welding Society.  CONTRACT SPECIAL PROVISIONS  Specifications and Contract Special Provisions referred to above are necessary to make these plans complete.  DATUM: CITY OF RICHMOND  TEMPERATURE: The normal temperature referred to on the plan is 60°F. The temperature range for movement is 0°F to 120°F.  DIMENSIONS: All dimensions are measured horizontally and vertically unless otherwise noted.  EXCAVATION: Excavation below subgrade and cut slope template shall be classified as Structural Excavation. All excavation above these limits shall be classified as Regular Excavation and is not included in the Structural Quantities.  FOUNDATIONS: Footings shall rest on firm material. Foundation material shall be kept dry and special attention is called to Sections 401.05 and 401.06 of the General Specifications and to the Contract Special Provisions concerning preparation of foundations for footings.

CONCRETE NOTES:	Concrete in superstructure shall be Class A4. All other concrete shall be Class A3. All exposed edges and corners shall have a 3/4" chamfer or fillet unless otherwise noted. Care in the method of vibration, the use of low-slump concrete, and/or other means shall be employed to prevent downgrade movement of newly placed slab concrete (when gradient is over 2%).  Finishing Concrete Surfaces: See the Standard Architectural Details sheets and the Contract Special Provisions for types and details.  All reinforcing steel shall conform to ASTM A615 Grade 40. All reinforcing bar dimensions on the detailed drawings are to centers of bars unless otherwise noted. Clear distance between reinforcing steel and face of concrete shall be as noted on the plans. All bar laps shall be 30 diameters of the smaller diameter bar unless otherwise noted.  STEEL NOTES: Structural steel shall conform to A.S.T.M. Specification A36 except as noted. All field connections shall be made with high strength bolts. High strength bolts shall be 7/8" diameter unless otherwise noted and shall conform to A.S.T.M. Specifications A325.  BENCH MARKS: See Reference Ties and Field Control Data sheet in highway plans.  C-44 Plug, corner E. Canal St. and S. 2nd St., Elev. 143.46 C-45 Plug, corner Byrd St. and S. 2nd St., Elev. 126.16
-----------------	--

FINAL QUANTITIES

FINAL QUANTITIES																					
	STRUCTURE EXCAVATION C.Y.	CONCRETE CLASS A3 C.Y.	CONCRETE CLASS A3 BR. APPR. SLABS C.Y.	CONCRETE CLASS A4 C.Y.	REINFORCING STEEL LBS.	STRUCTURAL STEEL LBS.	ALUMINUM BR. RAILING (2 RAILS) L.F.	DRILLED HOLES FOR CAISSONS 4" Ø L.F.	POROUS BACKFILL C.Y.	CONC. SLAB SLOPE PROTECTION S.Y.	DAMP- PROOFING S.Y.	UNDERDRAIN 6" Ø L.F.	GAS MAIN 6" Ø L.F.	WATER MAIN 8" Ø L.F.	CONDUIT 6" Ø VEPCO L.F.	CONDUIT 4" Ø TELEPHONE L.F. **	CONDUIT 4" Ø D.P.U. L.F.	METAL CONDUIT 3" Ø L.F.	STEEL PILES 10BP42 L.F.		MAINT. & SUP. EXISTING TEL. CABLES L.S.
SUPERSTRUCTURE				503.23	101,330	565,498	506						612	308	1224	4621	3625	717			
NORTH ABUTMENT	652	234.45			13,647		12		60	360.83	159	174								1432.9	
PIER 1	151	109.19			26,845																
PIER 2	38	113.26			22,500			80.3													
SOUTH ABUTMENT	329.43	321.55			28,511		63		95		194	132									
APPROACH SLABS			121.95		26,710																
TOTAL	1170.43	778.45	121.95	503.23	219,543	565,498	581	80.3	155	360.83	353	306	612	308	1224	4621	3625	717	1432.9		L.S.

\*\* Does not include existing 9-duct bank to be maintained in service










MADE	BY	DATE			
BY	EVR		2	As Built	TEM 6-77
CHECKED	ABP	5-68	1	Quant N. Abut	RBH 6-74
IN CHARGE	P.R.Y.		NO.	REVISION	BY DATE

RICHMOND METROPOLITAN AUTHORITY	
RICHMOND EXPRESSWAY SYSTEM	
DOWNTOWN EXPRESSWAY	
BRIDGE B-54	
2ND STREET OVER DOWNTOWN EXPRESSWAY	
GENERAL NOTES AND QUANTITIES	
HOWARD, NEEDLES, TAMMEN & BERGENDOFF consulting engineers NEW YORK ALEXANDRIA KANSAS CITY	SCALE AS SHOWN CONTRACT NO. 2 SHEET NO. 2 OF 20

AS BUILT.



RICHMOND EXPRESSWAY SYSTEM			
SECTION	PROJECT	SHEET NO.	TOTAL SHEETS
DOWNTOWN EXPRESSWAY		127	

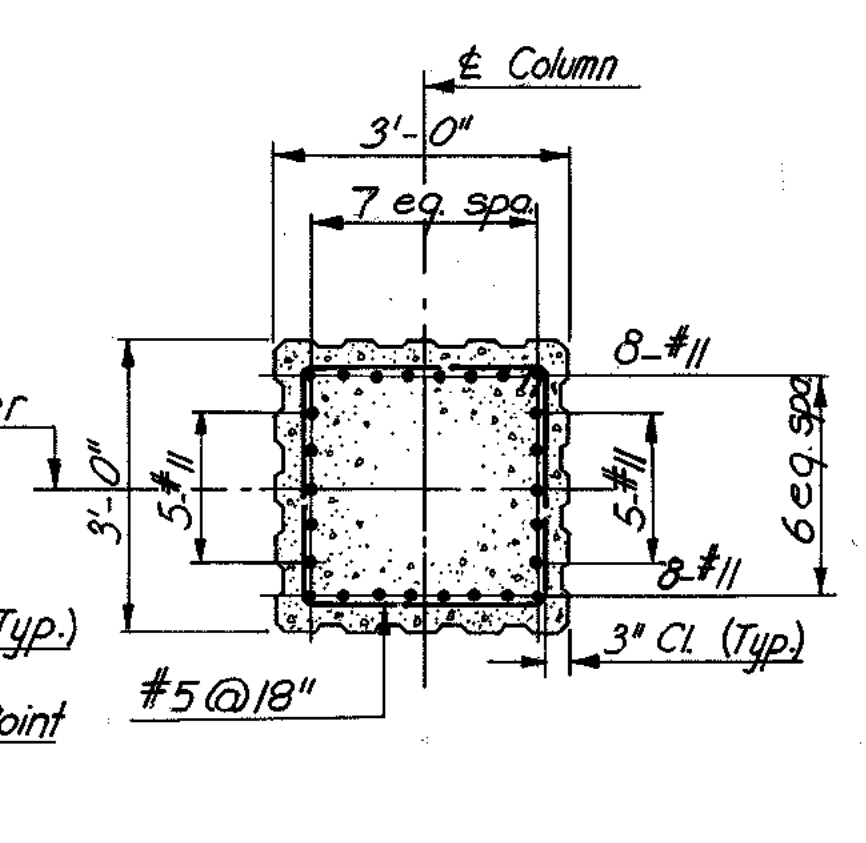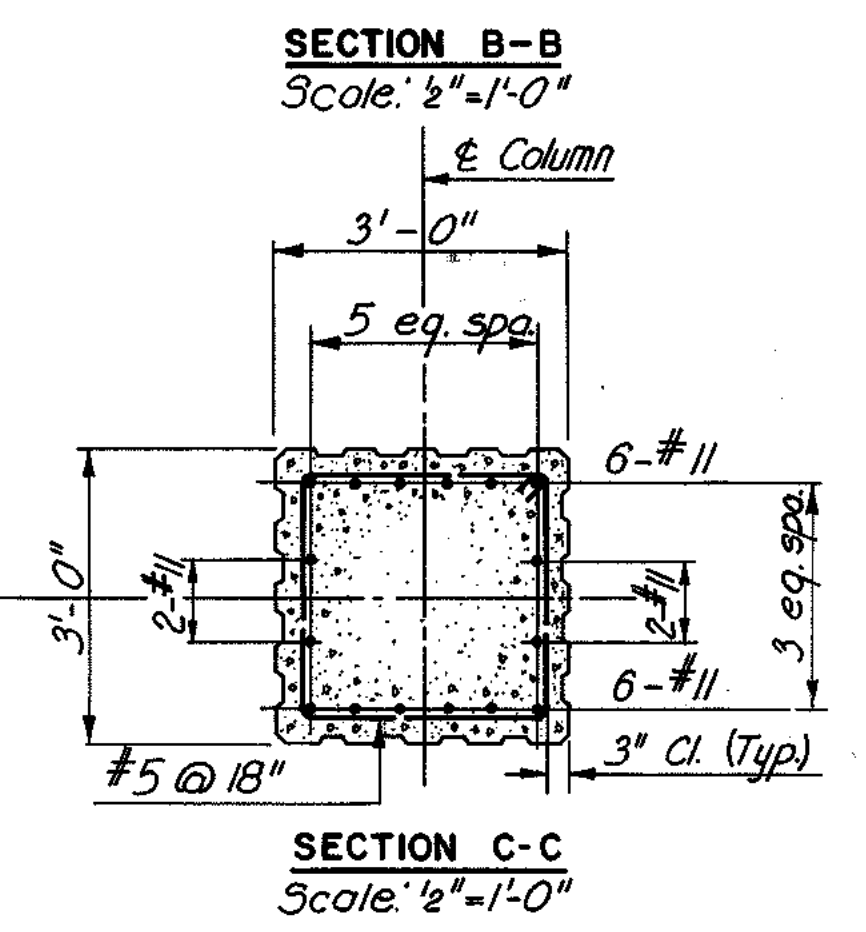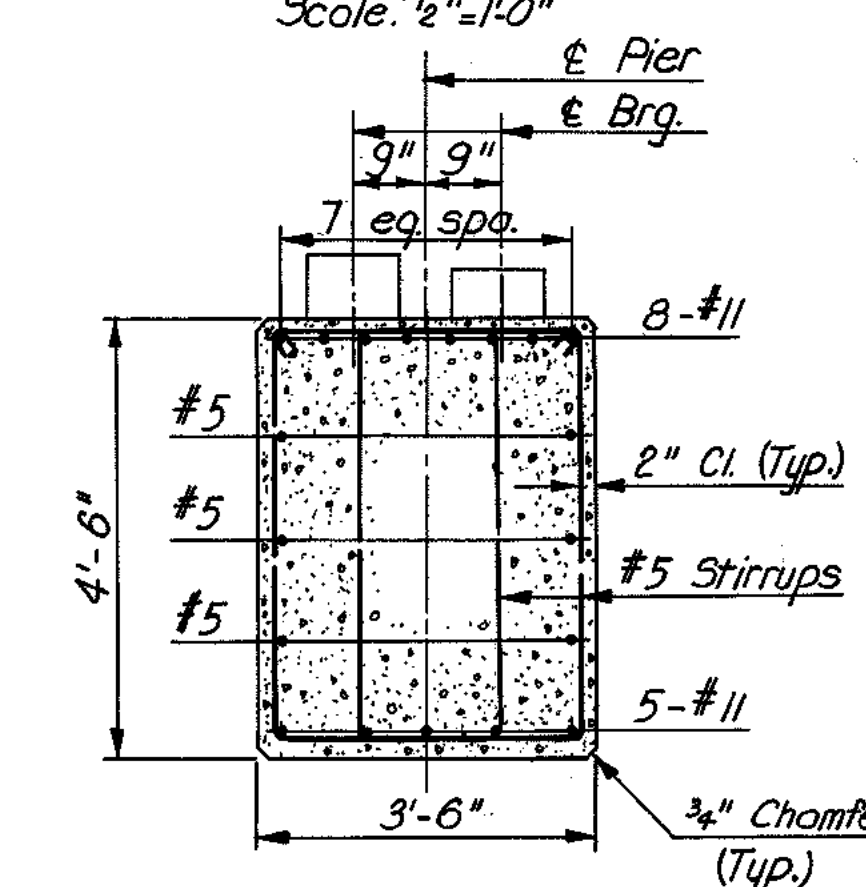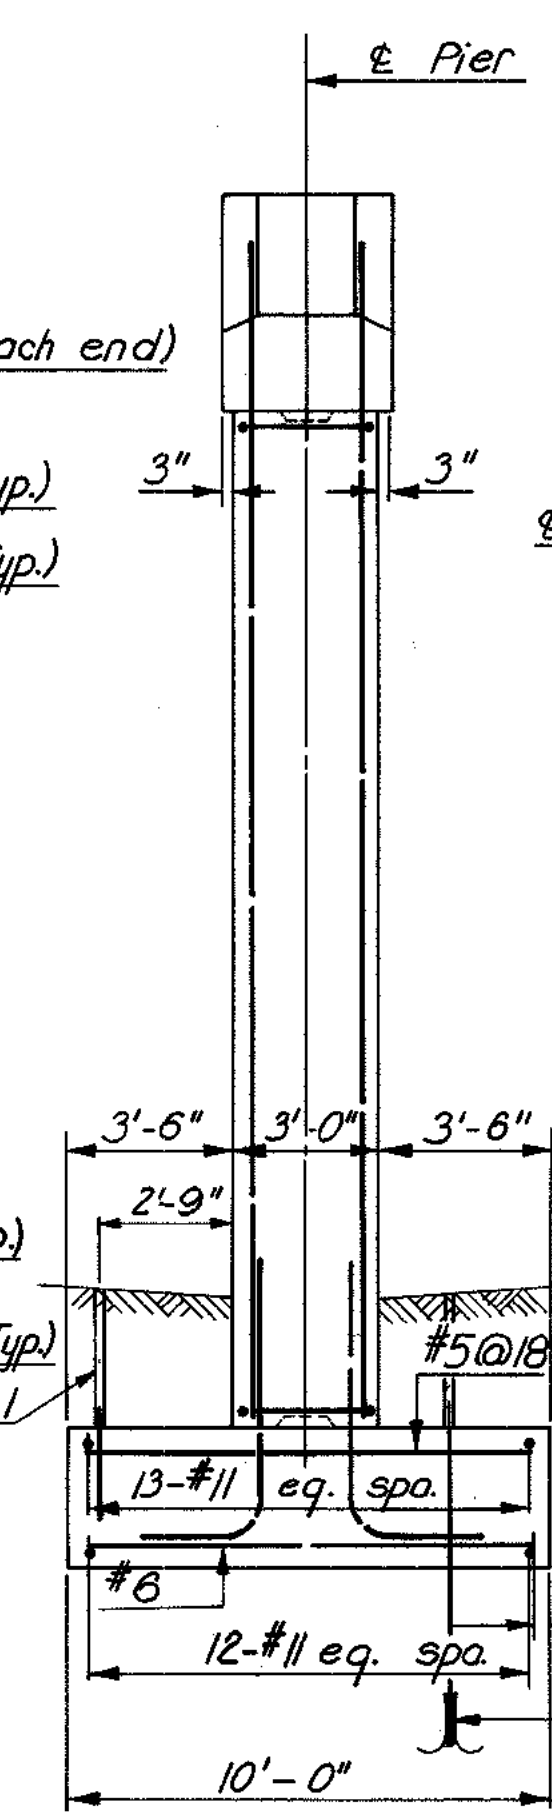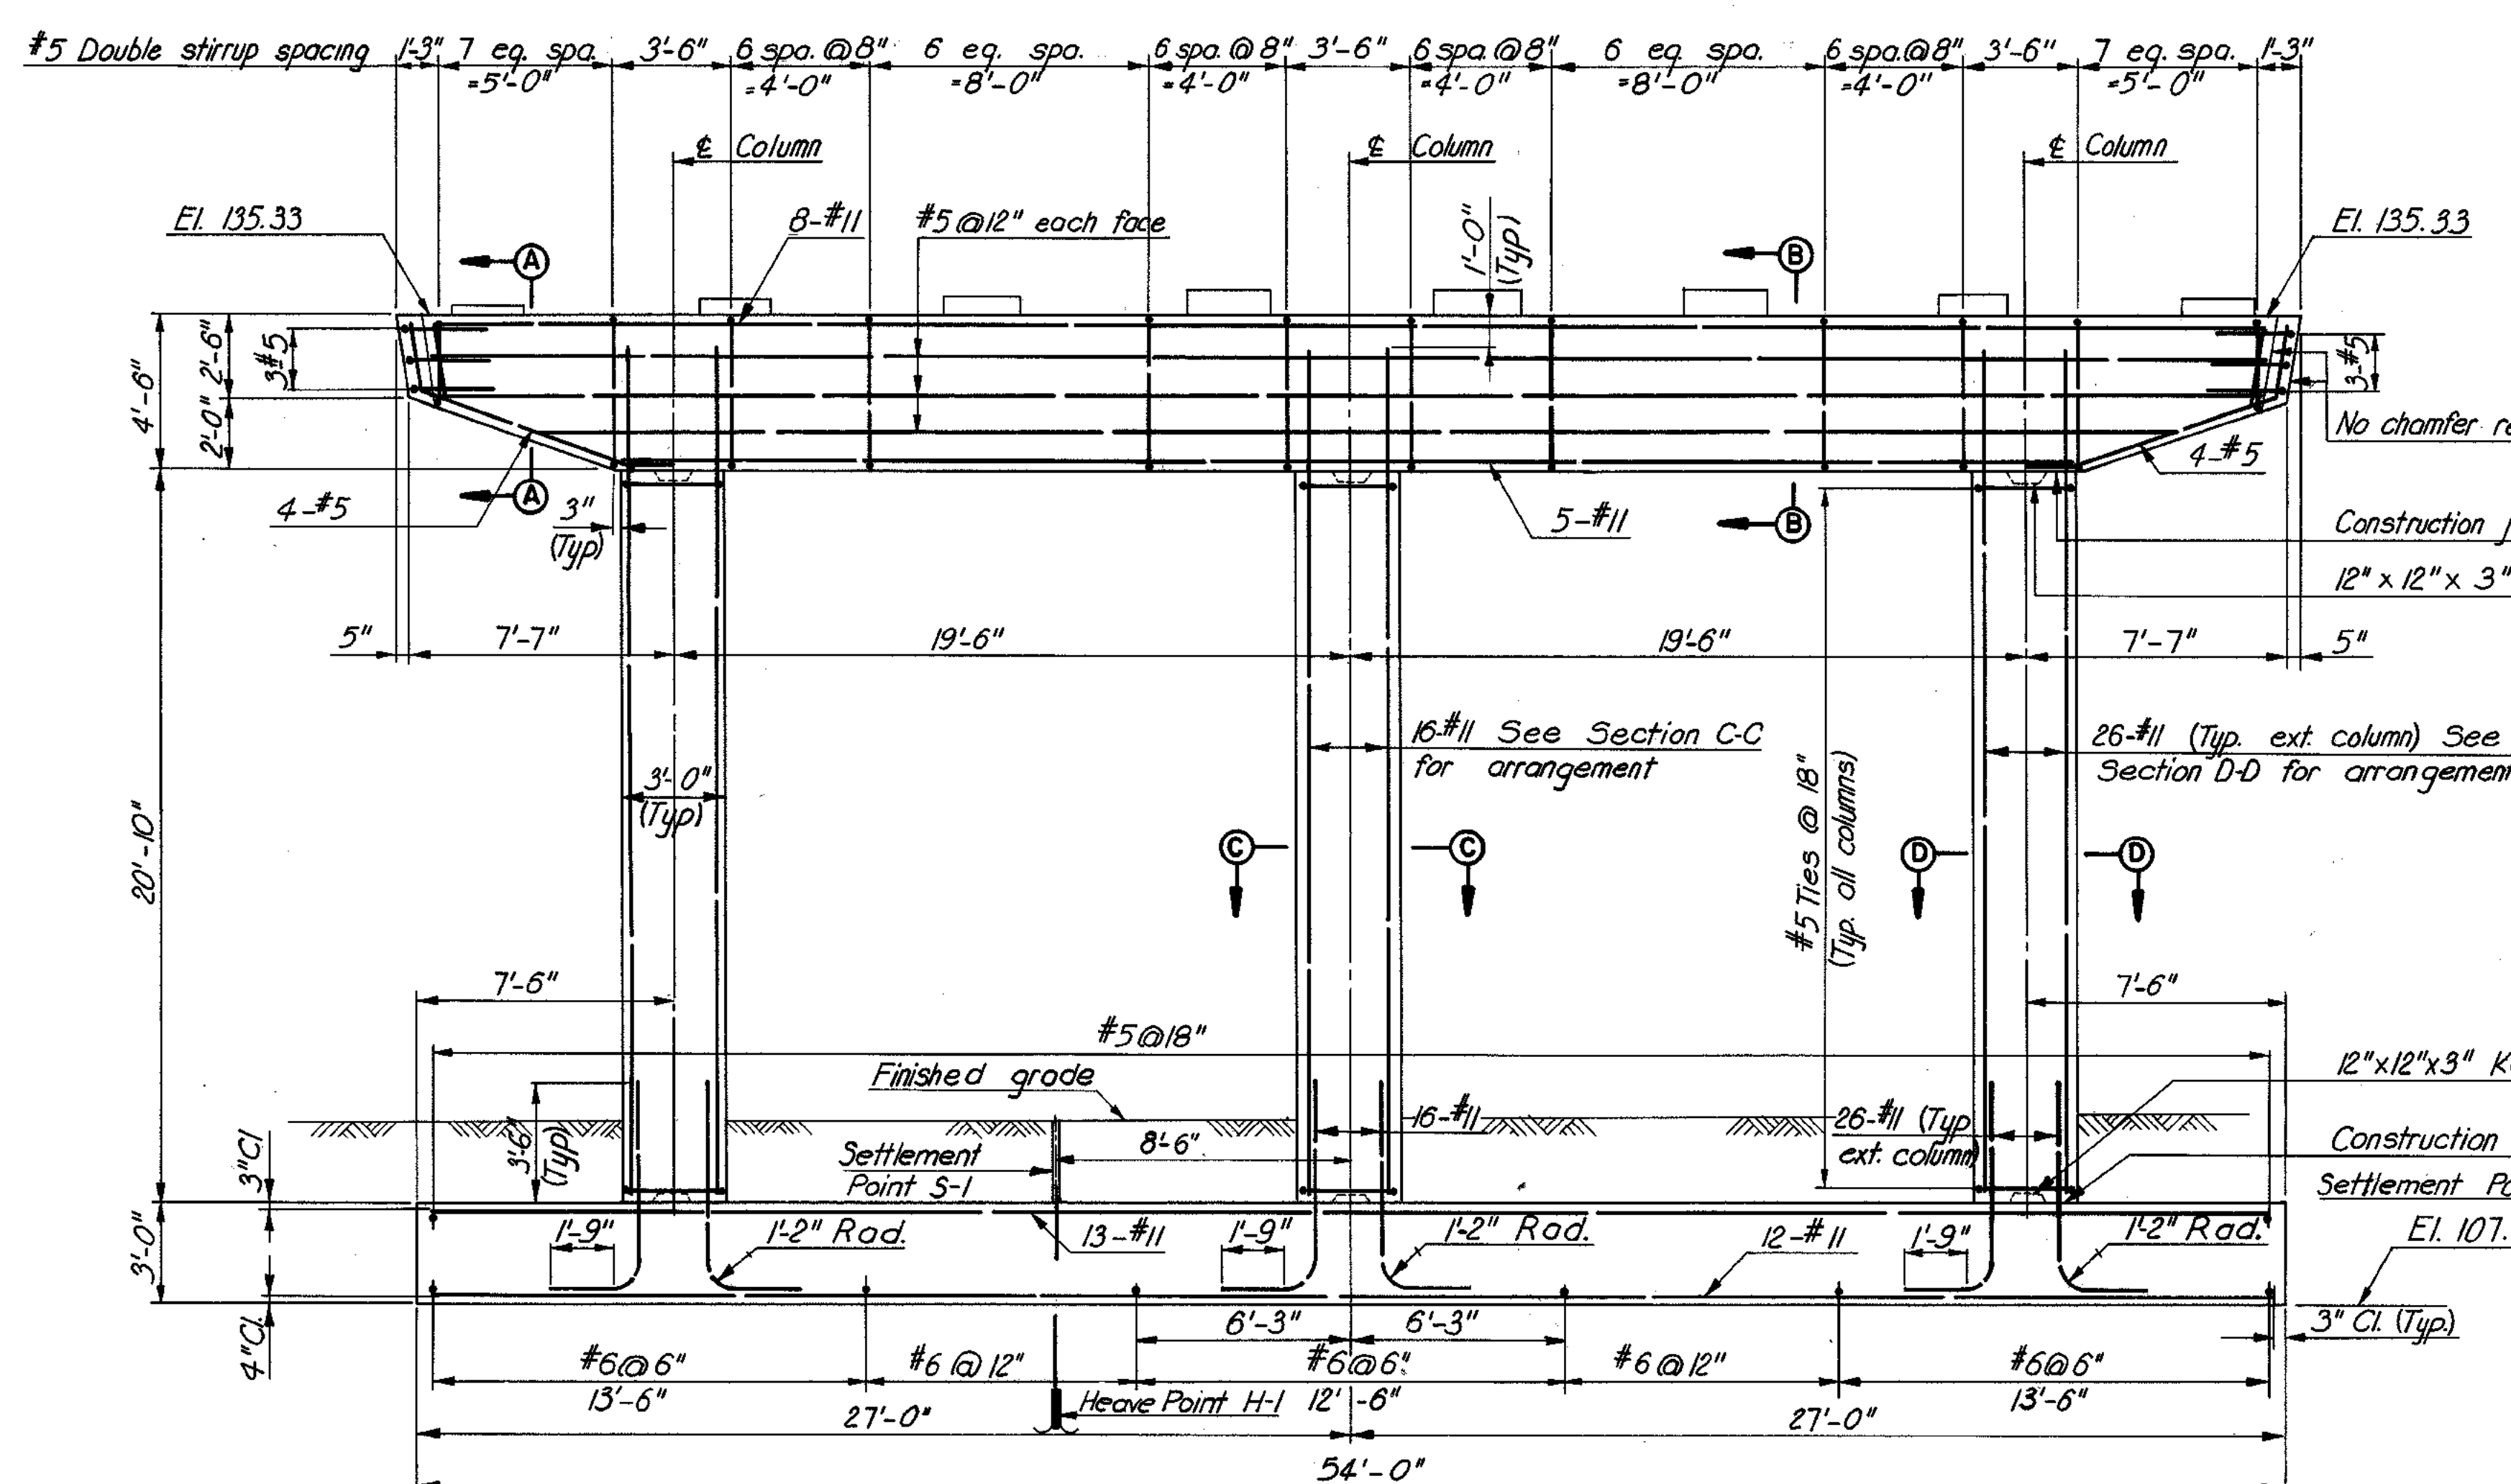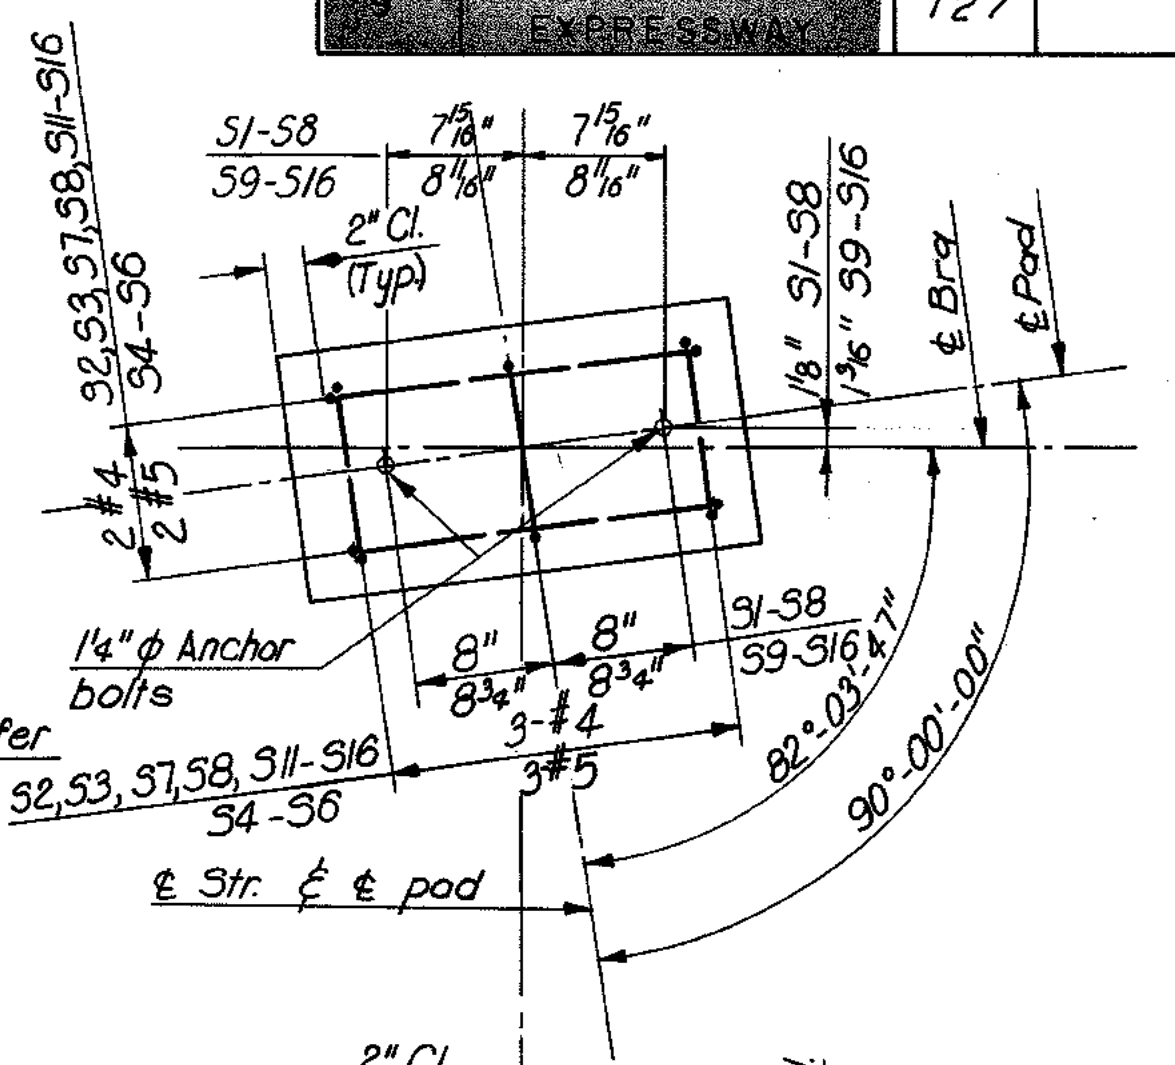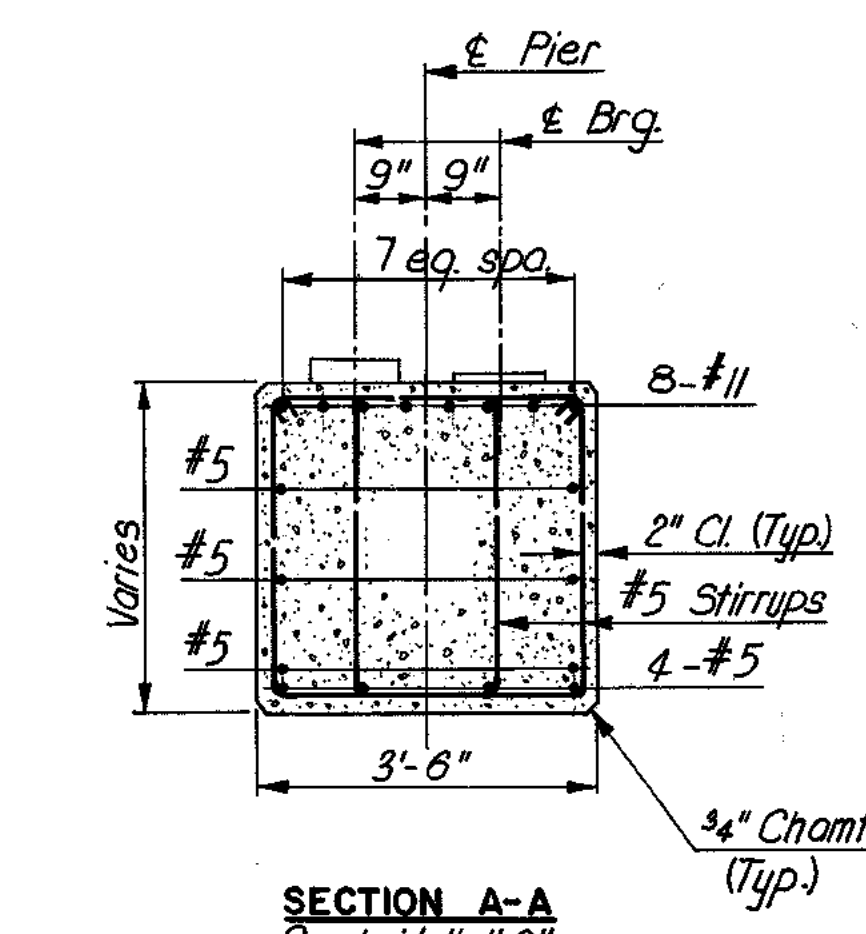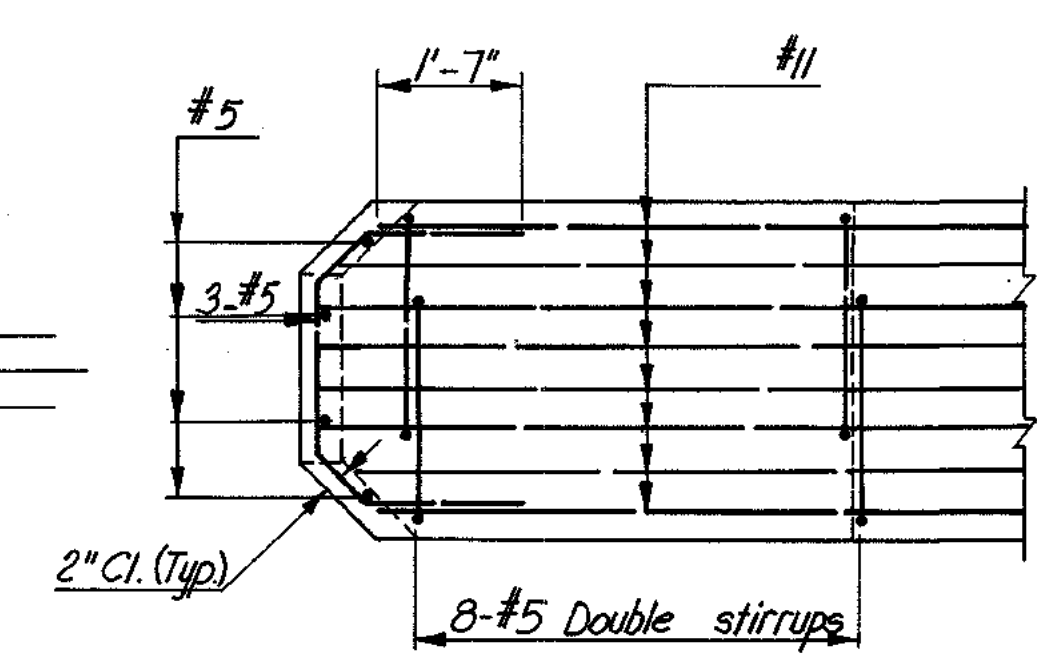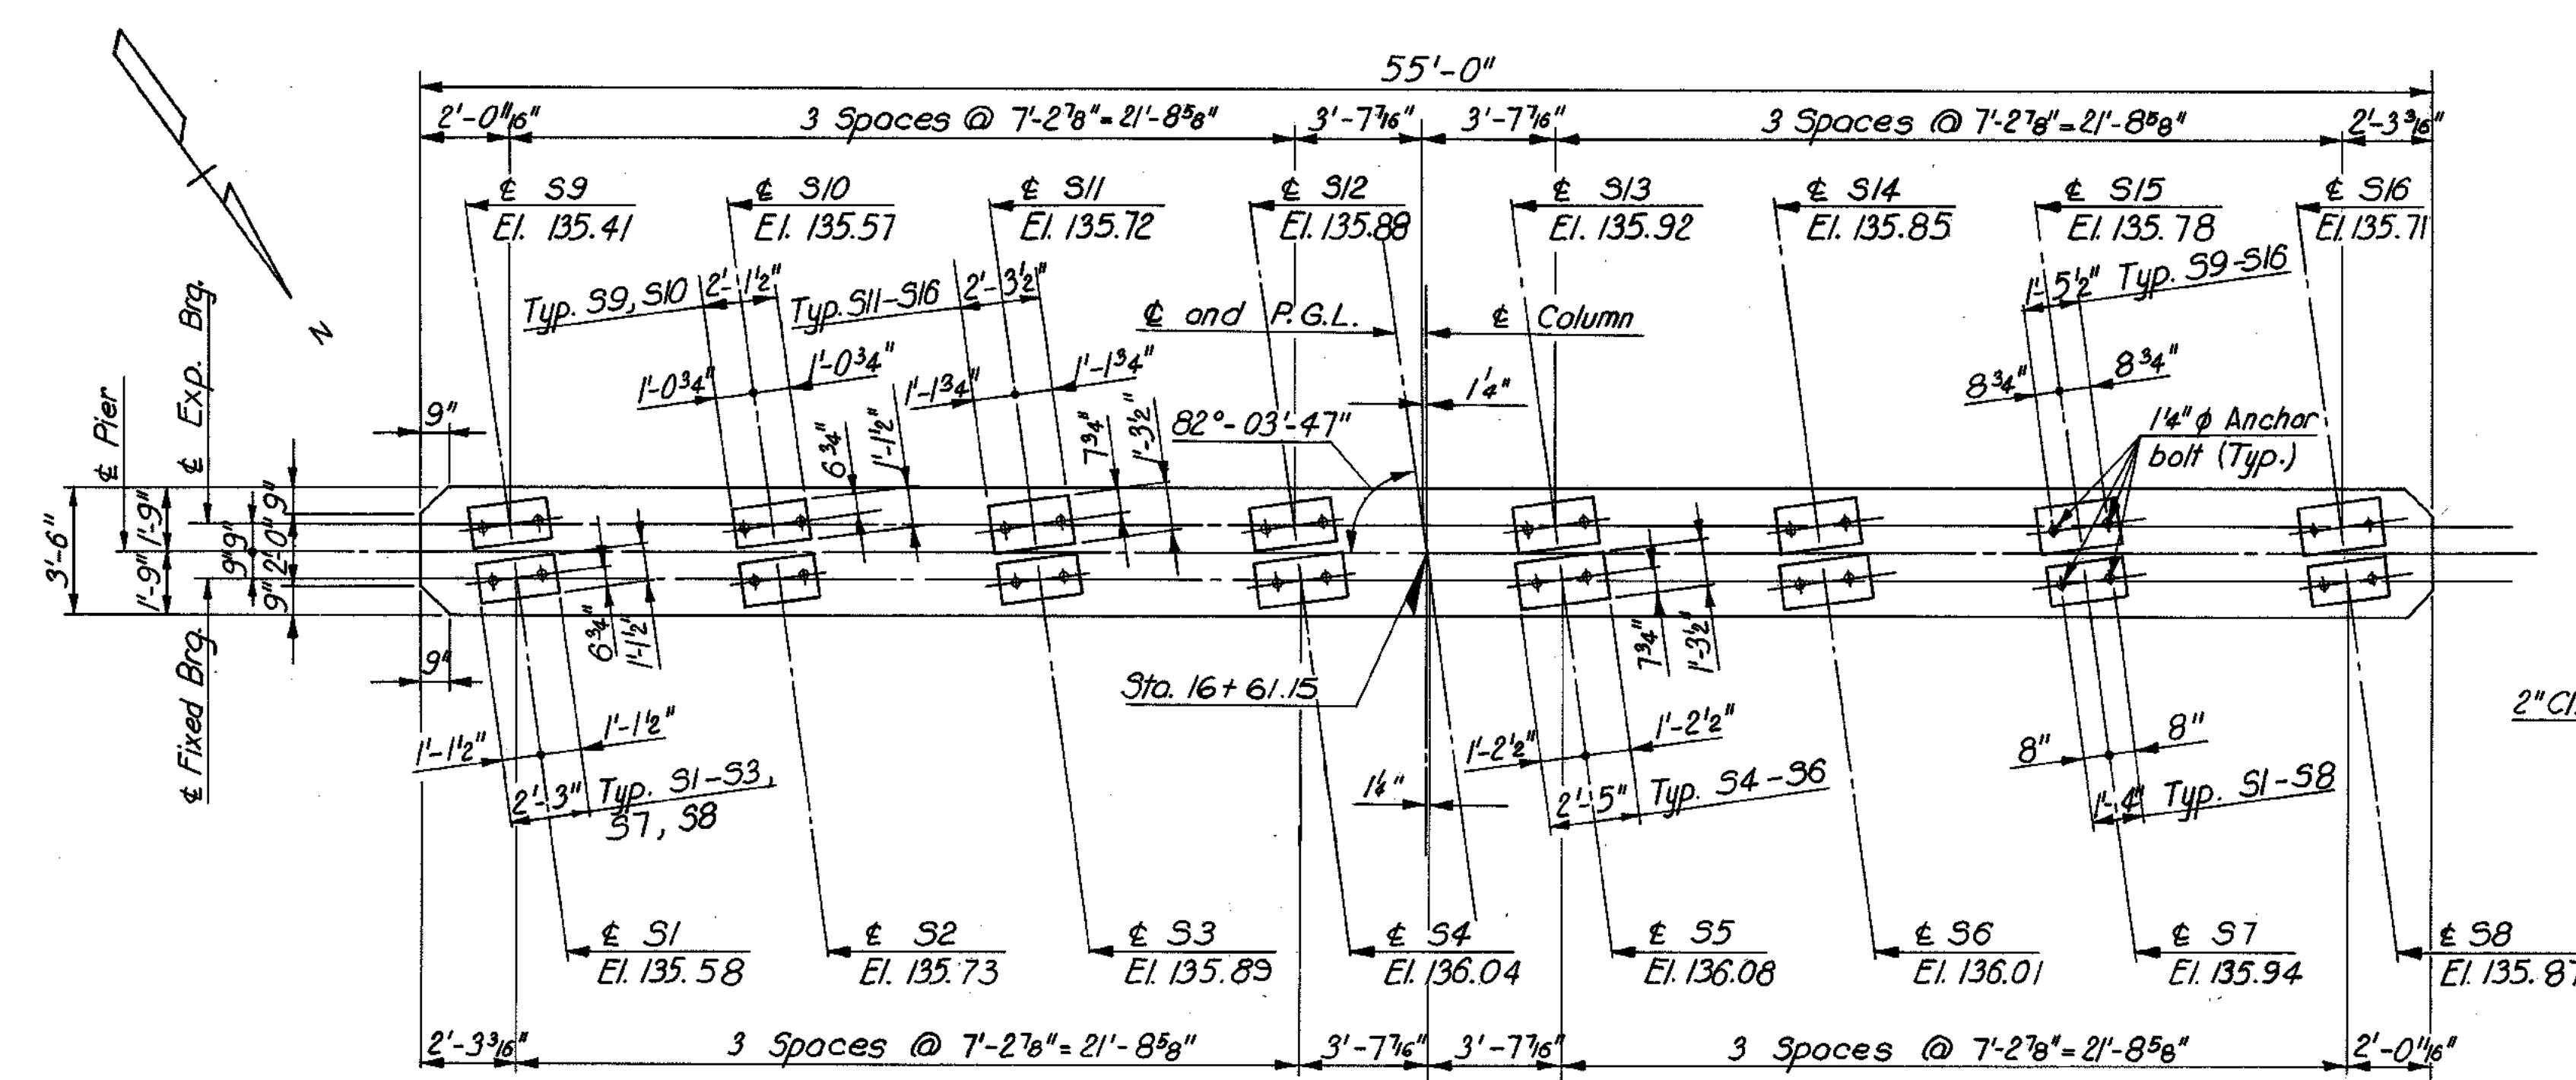

**FOUNDATION NOTES:**  
Foundation elevation is approximate and may be varied to suit field conditions as directed by the Engineer. Vertical column reinforcing shall not be cut until this elevation is established.  
Where elevation changes by more than two feet, redesign will be required.  
Pier foundation is designed for an allowable bearing pressure of 2 1/2 tons per square foot.

**NOTES:**  
For anchor bolt details and treatment of pads, see Standard Shoe Details sheet.  
For details of architectural treatment of piers, see Standard Architectural Details sheet.

BY	DATE			
MADE	elm	1-68		
CHECKED	A.B.P.	3-68	I As Built	TEM 6-77
IN CHARGE	P.R.Y.			

**NOTE:**  
Installation procedures for settlement points are described in the Special Provisions to the Specifications. Typical Installation Details and 18. Misc. Detail of Highway Plans.



RICHMOND METROPOLITAN AUTHORITY			
RICHMOND EXPRESSWAY SYSTEM			
DOWNTOWN EXPRESSWAY			
BRIDGE B-54			
2ND STREET OVER			
DOWNTOWN EXPRESSWAY			
PIER 1			
HOWARD, NEEDLES, TAMMEN & BERGENDOFF consulting engineers NEW YORK ALEXANDRIA KANSAS CITY		SCALE: AS SHOWN CONTRACT NO. 9 SHEET NO. 9 OF 20	

AS BUILT









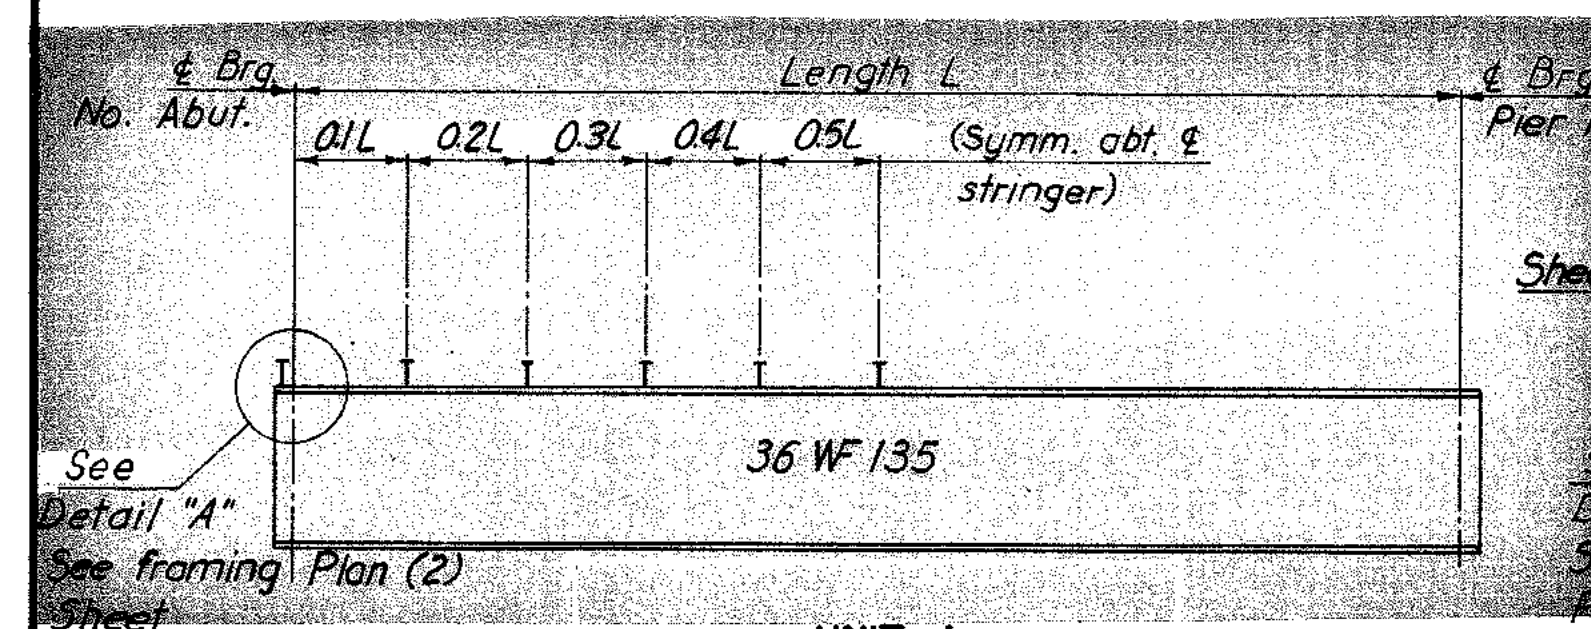
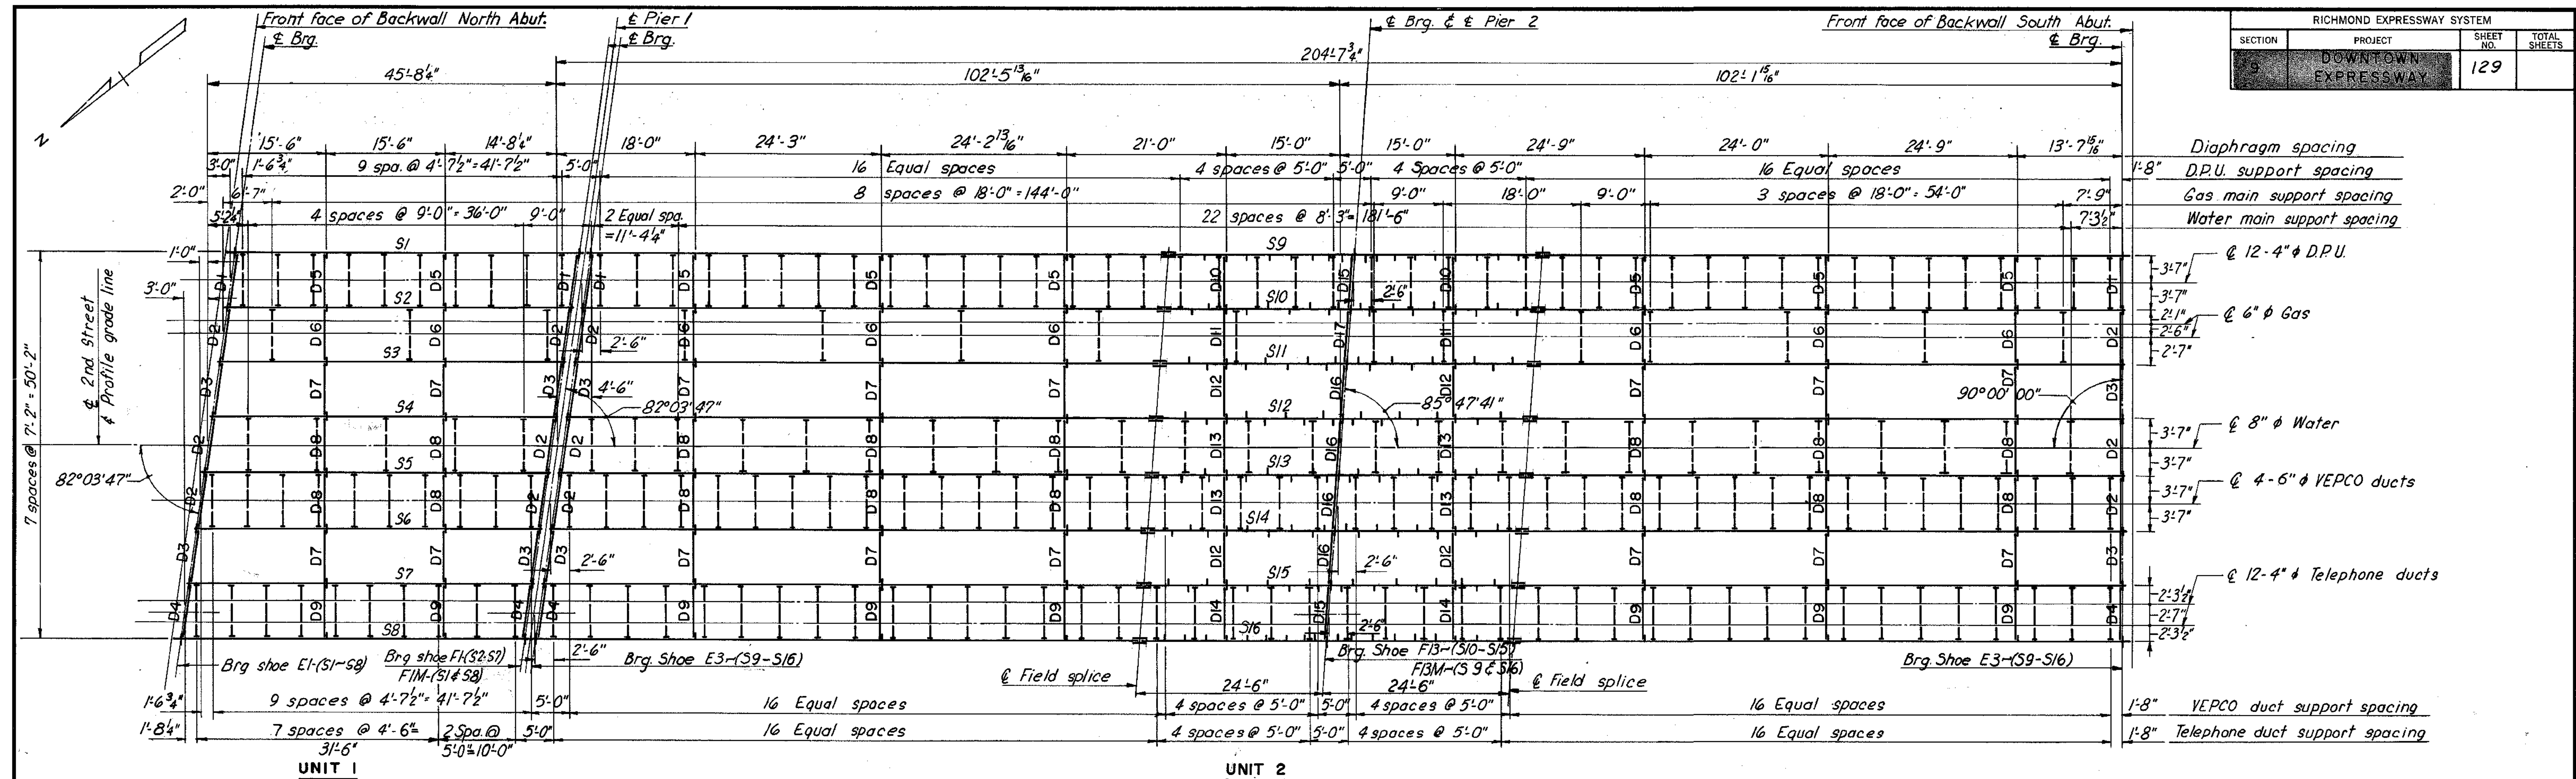


UNIT 1 STRINGER SCHEDULE					
STRINGER	LENGTH & BRG. TO & BRG.	0.1L	0.2L	0.3L	0.4L 0.5L
S1-S8	44'-11 3/16"	8 1/2	9 1/2	11 1/2	14 1/2 16

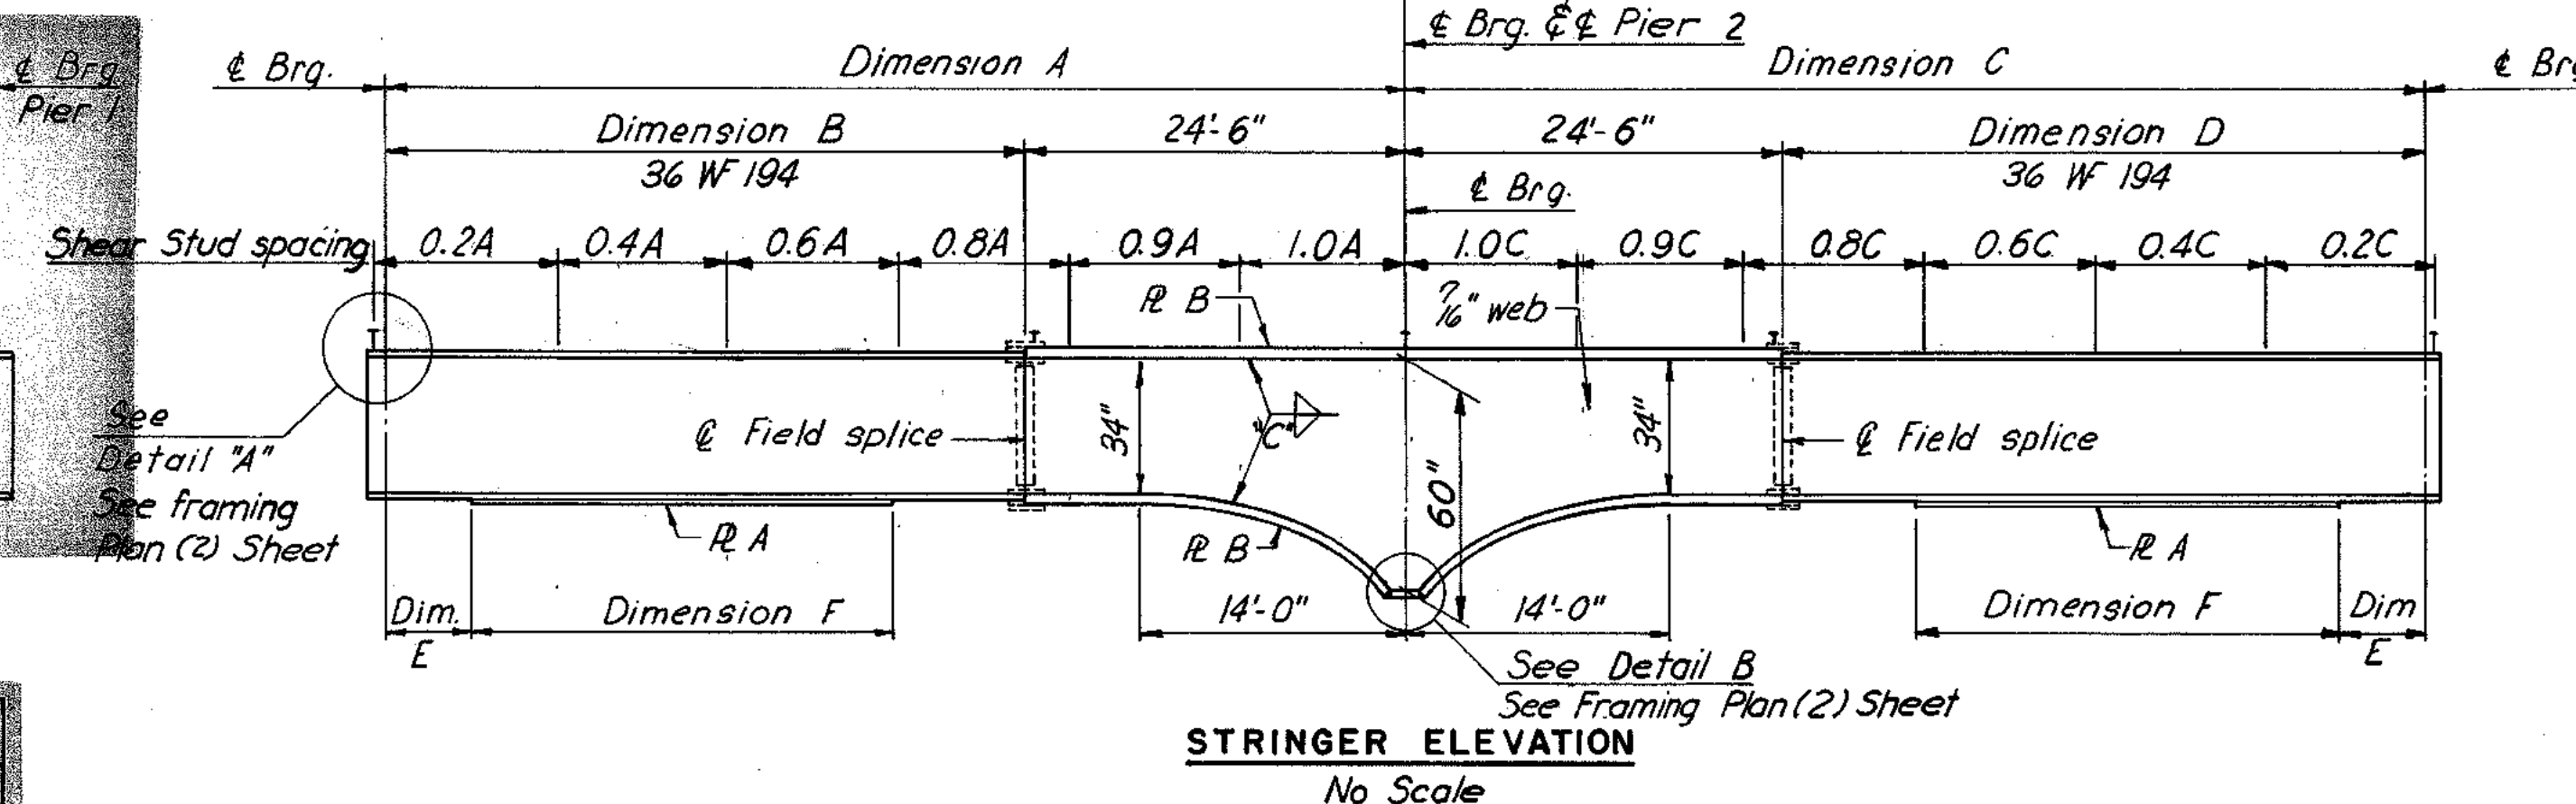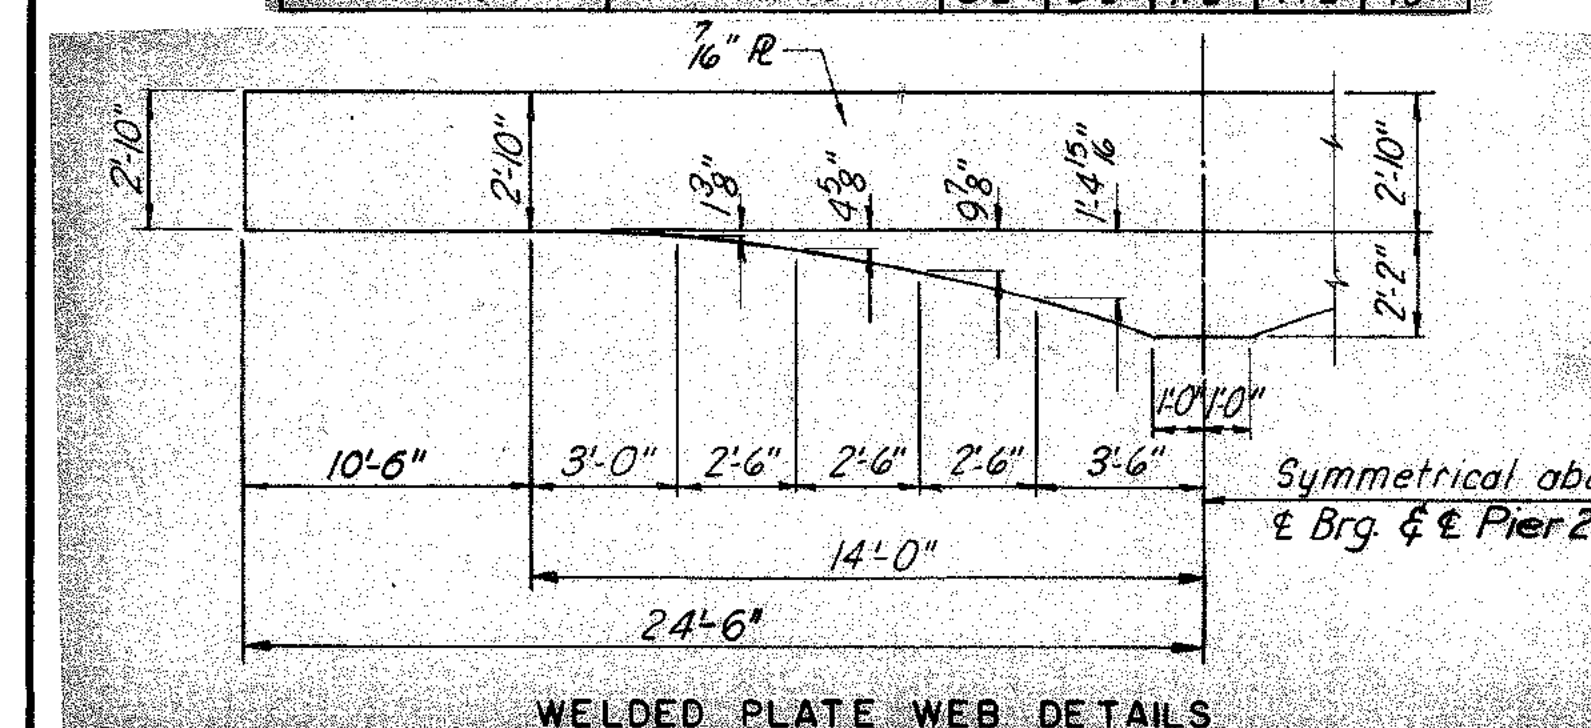

UNIT 2 STRINGER SCHEDULE																		
STRINGER	DIM. A	DIM. B	DIM. C	DIM. D	DIM. E	R. A					R. B		SHEAR STUD SPACING *					
						DIM. F	SIZE	"L"	"a"	"b"	SIZE	"c"	0.2"	0.4"	0.6"	0.8"	0.9"	1.0"
S9	100'-0 <sup>1/2</sup> "	75'-6 <sup>5/8</sup> "	100'-3 <sup>3/4</sup> "	75'-9 <sup>3/4</sup> "	9'-3"	61'-0"	10 <sup>1/2</sup> x 1 <sup>5/8</sup>	2'-3"	5 <sup>5/8</sup> "	3 <sup>3/8</sup> "	18 x 1 <sup>3/8</sup>	5 <sup>16</sup>	7"	10"	11"	7"	18"	24"
S10	100'-6 <sup>9/16</sup> "	76'-0 <sup>9/16</sup> "	100'-10 <sup>1/16</sup> "	76'-4 <sup>1/16</sup> "	10'-3"	59'-6"	10 <sup>1/2</sup> x 1 <sup>5/8</sup>	↑		↑	18 x 1 <sup>1/2</sup>	↑	8"	11"	12"	8"	↑	↑
S11	101'-0 <sup>1/4</sup> "	76'-6 <sup>1/4</sup> "	101'-4 <sup>1/4</sup> "	76'-10 <sup>1/4</sup> "	11'-6"	57'-6"	10 <sup>1/2</sup> x 1 <sup>1/2</sup>				18 x 1 <sup>1/4</sup>		↑	↑	↑	↑	↑	↑
S12	101'-5 <sup>15/16</sup> "	76'-11 <sup>15/16</sup> "	101'-10 <sup>3/4</sup> "	77'-4 <sup>3/4</sup> "	10'-3"	60'-6"	10 <sup>1/2</sup> x 1 <sup>5/8</sup>				18 x 1 <sup>1/2</sup>							
S13	101'-11 <sup>1/16</sup> "	77'-5 <sup>3/16</sup> "	102'-5 <sup>1/16</sup> "	77'-11 <sup>1/16</sup> "	↑	61'-0"	10 <sup>1/2</sup> x 1 <sup>5/8</sup>				18 x 1 <sup>1/2</sup>							
S14	102'-5 <sup>1/4</sup> "	77'-11 <sup>1/4</sup> "	102'-11 <sup>1/4</sup> "	78'-5 <sup>1/4</sup> "	↑	61'-6"	10 <sup>1/2</sup> x 1 <sup>5/8</sup>				18 x 1 <sup>1/2</sup>							
S15	102'-10 <sup>1/8</sup> "	78'-4 <sup>1/8</sup> "	103'-5 <sup>1/8</sup> "	78'-11 <sup>1/8</sup> "	10'-3"	62'-0"	10 <sup>1/2</sup> x 1 <sup>5/8</sup>	↓	↓	↓	18 x 1 <sup>1/2</sup>	5 <sup>16</sup>	8"	11"	12"	8"		
S16	103'-4 <sup>1/8</sup> "	78'-10 <sup>1/8</sup> "	104'-0"	79'-6"	9'-0"	64'-0"	10 <sup>1/2</sup> x 1 <sup>5/8</sup>	2'-3"	5 <sup>5/8</sup> "	3 <sup>3/8</sup> "	18 x 1 <sup>3/8</sup>	3 <sup>8</sup>	7"	10"	11"	7"	18"	24"

\* To be applied to either A or C dimension.  
\*\* Shear stud spacing shown is maximum spacing.

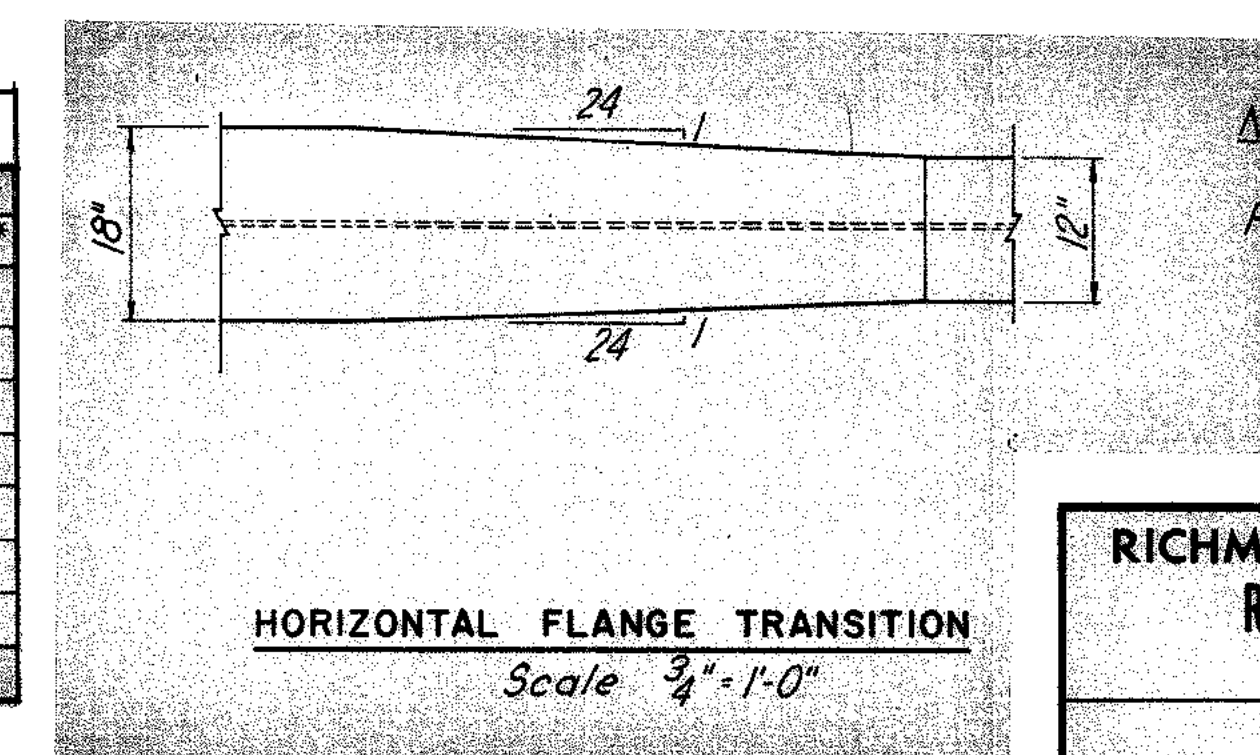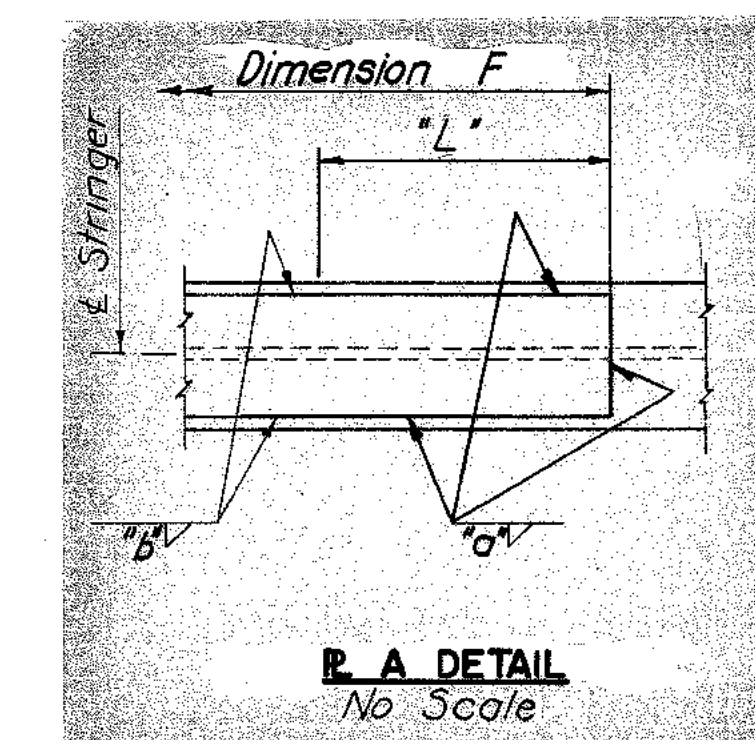

Note: For additional details see Framing Plan (2) Sheet.

BY	DATE				
MADE	EVR	3-68			
CHECKED	DSB	5-68	1	As Built	TEM 6-77
IN CHARGE	P.R.Y.		NO.	REVISION	BY

AS BUILT

RICHMOND METROPOLITAN AUTHORITY  
RICHMOND EXPRESSWAY SYSTEM  
DOWNTOWN EXPRESSWAY


BRIDGE B-54  
2ND STREET OVER  
DOWNTOWN EXPRESSWAY

FRAMING PLAN (1)

HOWARD, NEEDLES, TAMMEN & BERGENDOFF  
consulting engineers  
NEW YORK ALEXANDRIA KANSAS CITY

SCALE: AS SHOWN  
CONTRACT NO.: 9  
SHEET NO. 11 OF 20



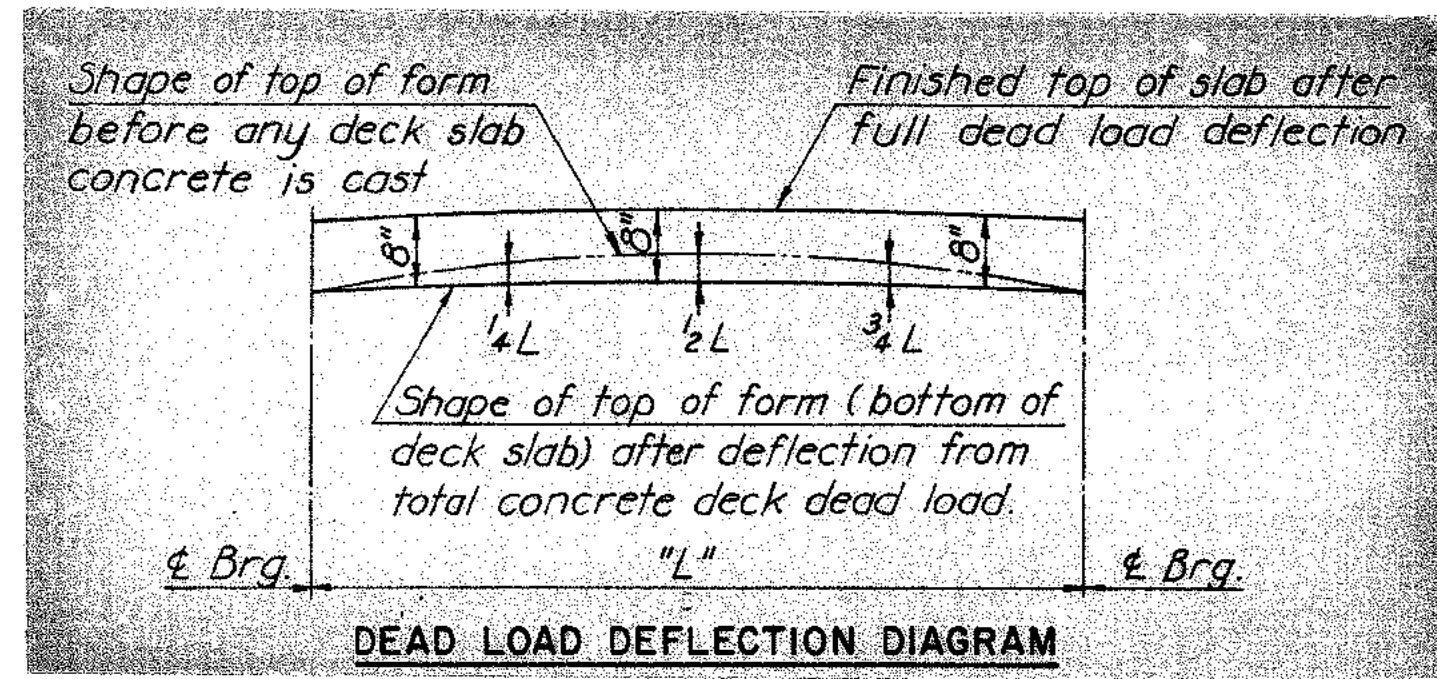


UNIT 1

DEFLECTION SCHEDULE		
STR.	1/4L	1/2L
S1-S8	1/4"	3/8"


**NOTE TO CONTRACTOR:**

The above deflections are those anticipated to occur in the stringer upon placement of the total concrete deck dead load. In practice, the stringers in place are not likely to have the exact camber to compensate for these deflections during construction. The residual amounts shall be provided for by adjusting forms to vary the thickness of the concrete bolster between the bottom of the slab and the top of stringer, without alteration of the slab thickness.

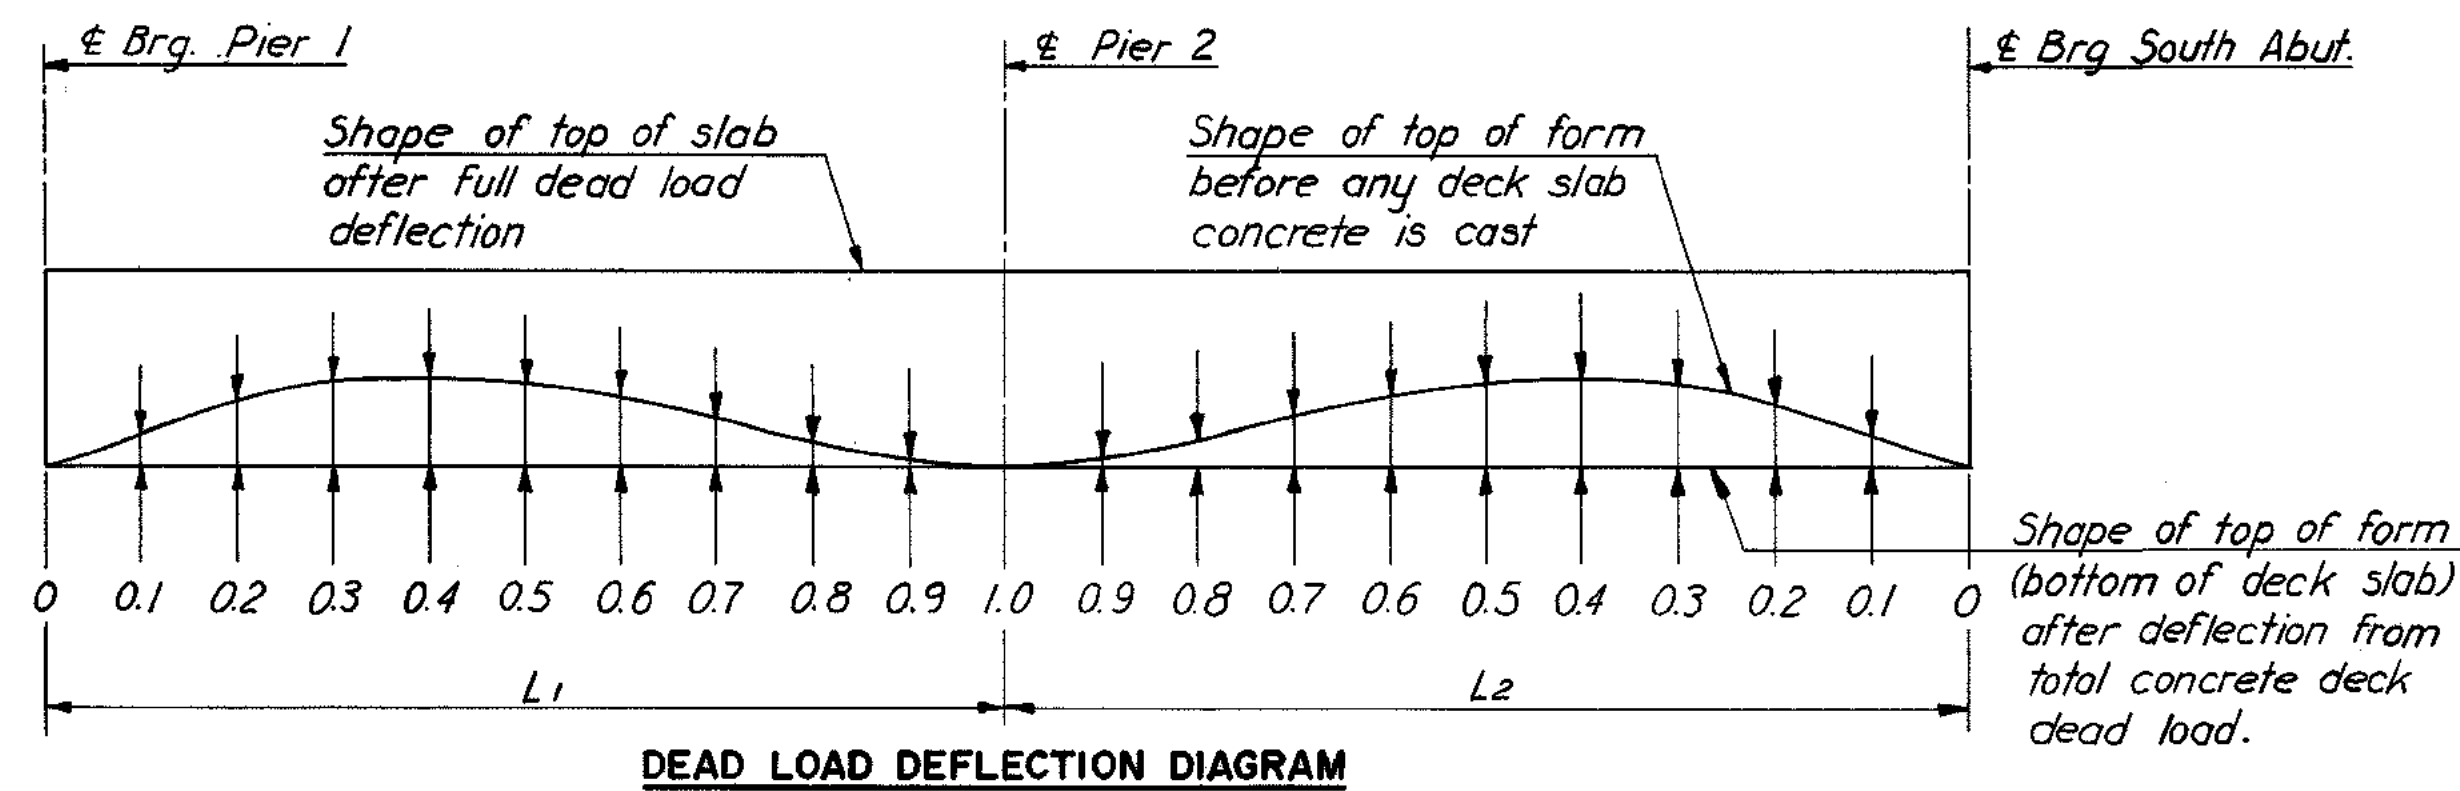

UNIT 2

DEFLECTION SCHEDULE										
STR.	0.1L1	0.2L1	0.3L1	0.4L1	0.5L1	0.6L1	0.7L1	0.8L1	0.9L1	1.0
S9	1/16"	1/4"	1/8"	1/32"	1/16"	1/16"	1"	1/2"	1/8"	0"
S10-S12	5/8"	1/8"	1/2"	1/8"	1/2"	1/4"	7/8"	7/16"	1/8"	0"
S13-S15	3/4"	1/4"	1/16"	1/16"	1/16"	1/16"	1"	1/2"	1/8"	0"
S16	3/4"	1/8"	1/16"	2"	1/8"	1/16"	1/16"	9/16"	3/16"	0"

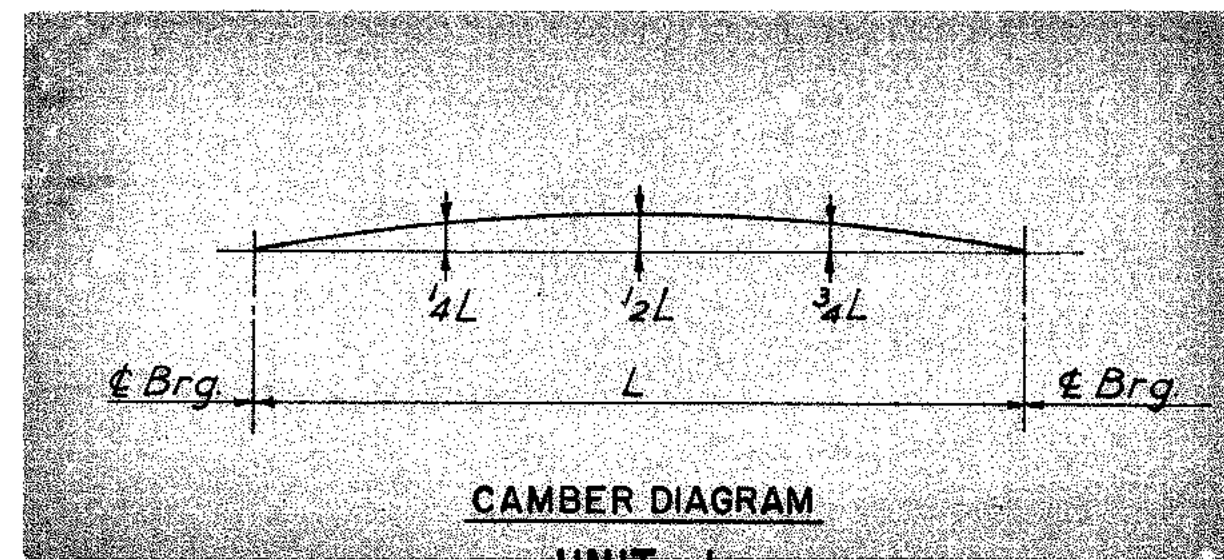


UNIT 1

CAMBER SCHEDULE		
STR.	1/4L	1/2L
S8	5/8"	1"

**NOTE TO FABRICATOR:**

The above stringers shall be fabricated with an upward camber amounting to the tabulated value. This will provide approximate compensation for deflection under full dead load and for conformity with finished grade. Stringers which are not required to be shop cambered shall be turned so that any mill tolerance deviation from straightness will be in the direction shown by the camber diagram above. Dimensions are in inches.

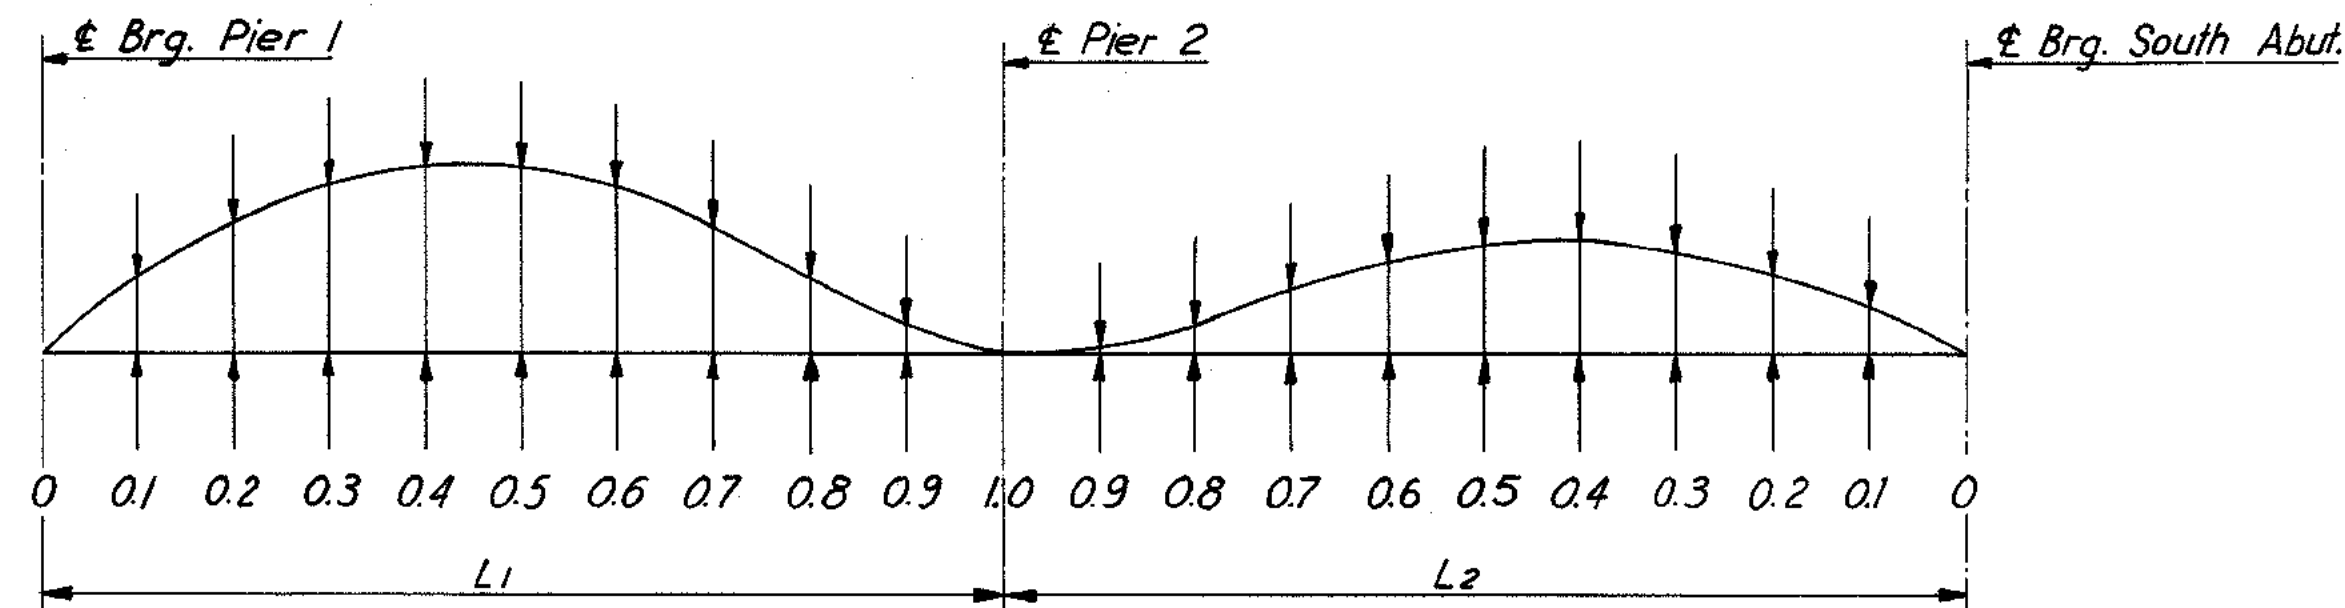

UNIT 2




CAMBER SCHEDULE																				
STR.	0.1L1	0.2L1	0.3L1	0.4L1	0.5L1	0.6L1	0.7L1	0.8L1	0.9L1	1.0	0.9L2	0.8L2	0.7L2	0.6L2	0.5L2	0.4L2	0.3L2	0.2L2	0.1L2	
S9	1/2"	2 1/16"	3 1/2"	3 3/8"	3 3/8"	2 3/8"	1 5/8"	1 1/8"	0"	3 1/16"	5 3/8"	1 1/4"	1 1/16"	2 3/16"	2 1/4"	2 1/8"	1 3/8"	1 3/8"		
S10-S12	1 1/2"	2 5/8"	3 3/8"	3 3/4"	3 1/8"	3 1/4"	2 1/2"	1 3/8"	1 1/8"	0"	3 1/16"	9 1/8"	1 1/8"	1 5/8"	2"	2 1/8"	2"	1 1/2"	7/8"	
S13-S15	1 1/16"	2 13/16"	3 1/16"	4 1/16"	4"	3 1/2"	2 3/4"	1 1/16"	3/4"	0"	3 1/16"	5 3/8"	1 1/4"	1 1/16"	2 3/16"	2 5/16"	2 3/8"	1 1/16"	1 3/16"	
S16	1 1/16"	3"	3 1/16"	4 1/4"	4 3/16"	3 1/16"	2 3/8"	1 1/16"	3/4"	0"	3 1/16"	1 3/8"	1 3/8"	2"	2 3/8"	2 1/2"	2 5/16"	1 3/16"	1	

FILL PLATE THICKNESS

STR.	"d"
S9	1/8"
S10	1/4"
S12-S15	1/4"
S16	3/8"


**STRINGER SPlice NOTE**

Web splice plates shall have horizontal rolled or mill sheared edges. Vertical edges may be shop sheared or flame cut. For S9 and S16 place heads of H.S. bolts on outside face of web splices. For all stringers place heads down for flange splices.

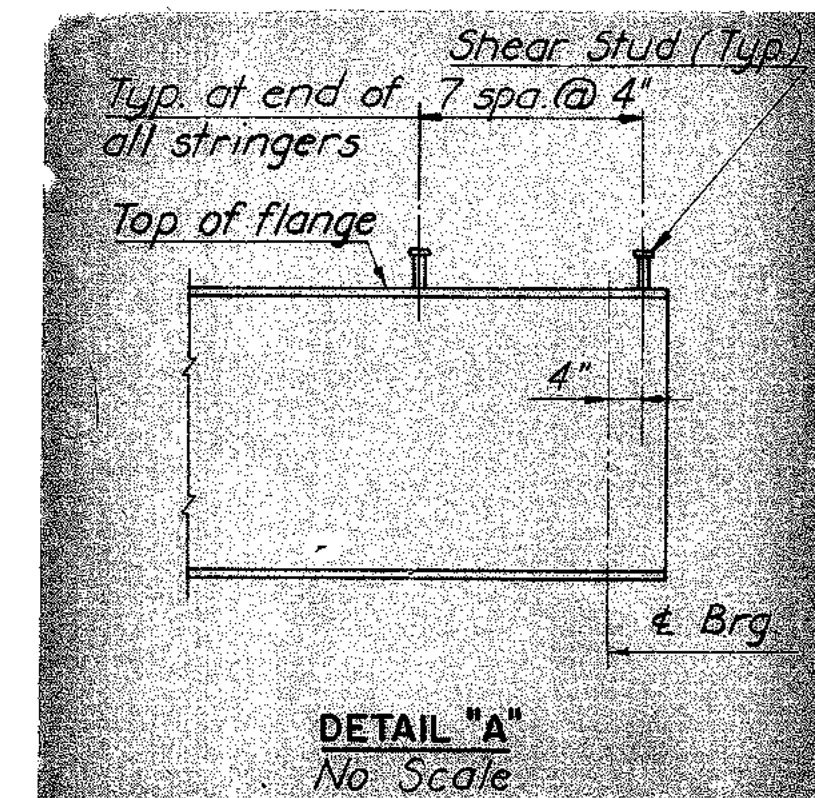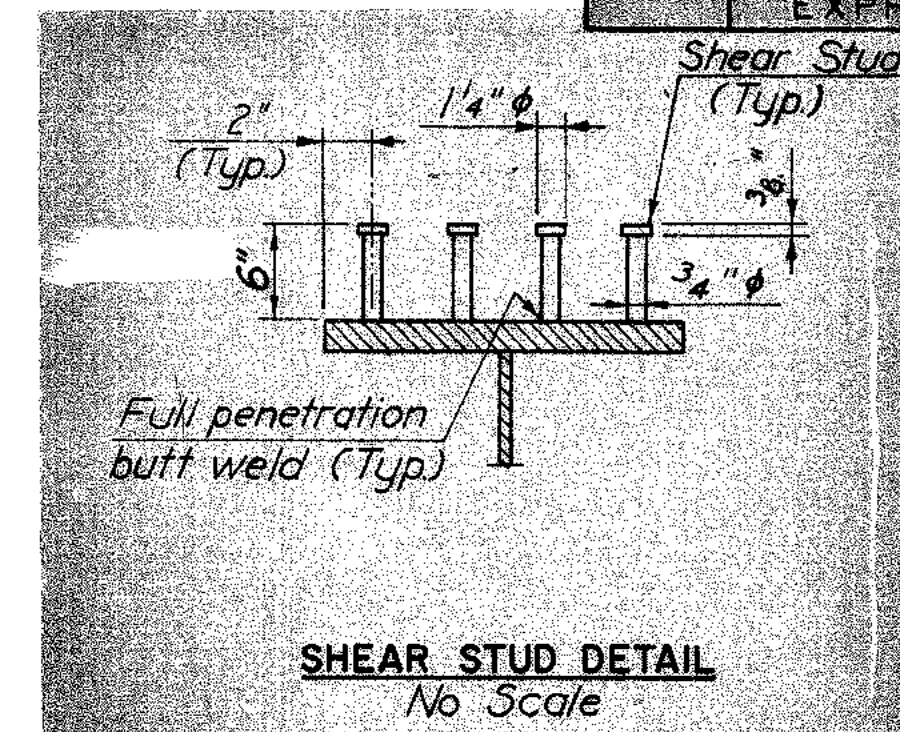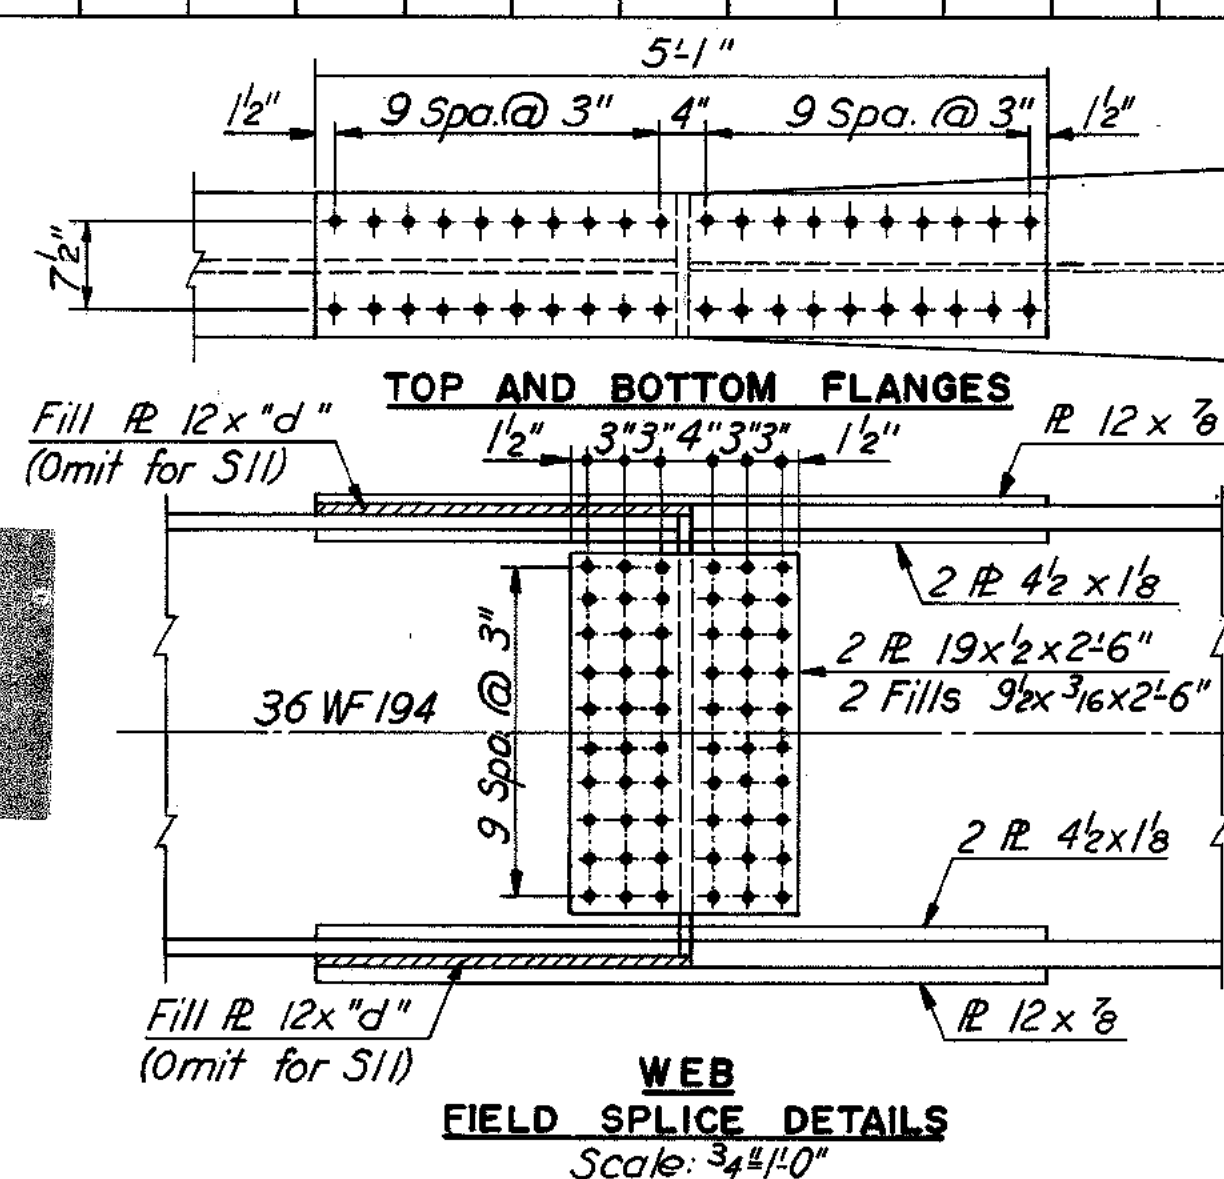

**SHEAR STUD NOTE:**

Capacity = 3,400 lbs. per stud. The contractor may, if he elects, use three 1/2" diameter studs at the same longitudinal spacing in lieu of the four 1/2" diameter studs shown. Stud rows shall be placed parallel to the shear deck reinforcement.

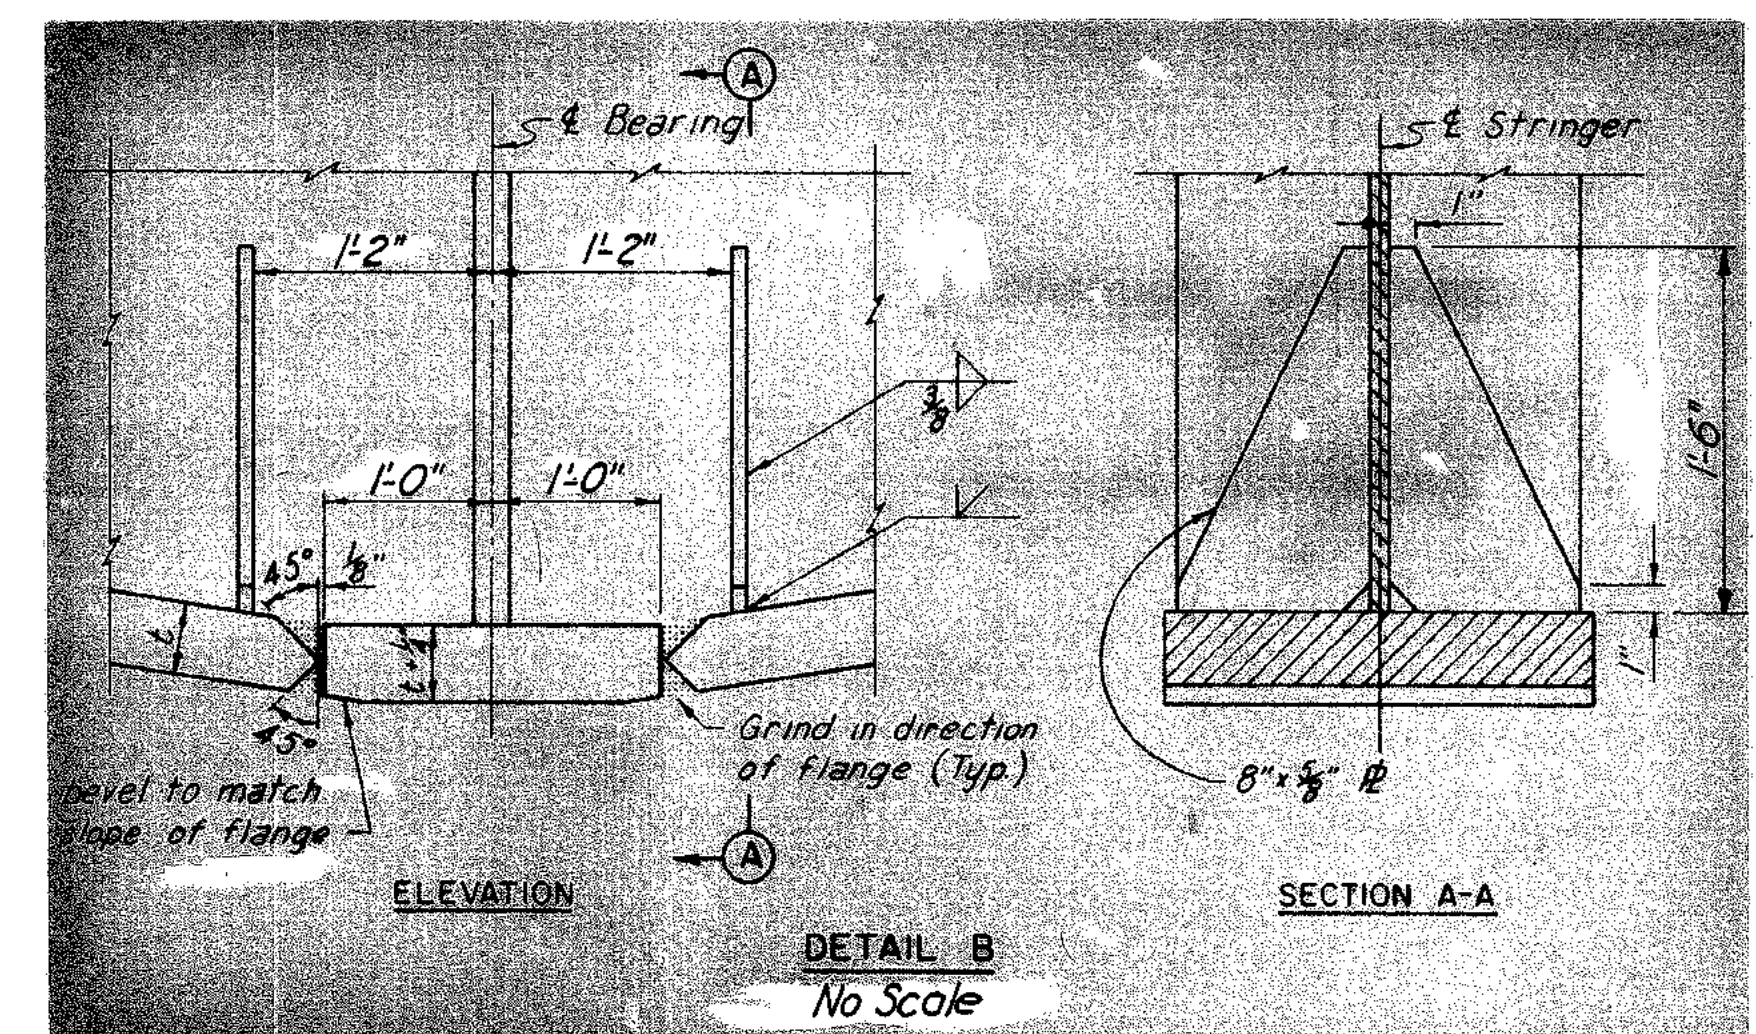

AS BUILT



BY	DATE				
MADE	EVR	3-68			
CHECKED	AJS	3-68	1	As Built	T&M 6-77
IN CHARGE	PRY		NO.	REVISION	BY






RICHMOND EXPRESSWAY SYSTEM			
SECTION	PROJECT	SHEET NO.	TOTAL SHEETS
9	DOWNTOWN EXPRESSWAY	131	

TABLE A	
STRINGER	DIM "A"
S1-S8	10 3/8"
S9-S16	10 1/2"





**NOTE "A":**  
Dimension shown is measured from top of stringer to top of slab at the intersection of the centerline of stringer and the centerline of bearing. At exterior stringers this is measured to the cross slope extended. This dimension may be varied between bearings as required to care for variation in camber, except that no portion of the stringer flange may fall within the 8" slab.

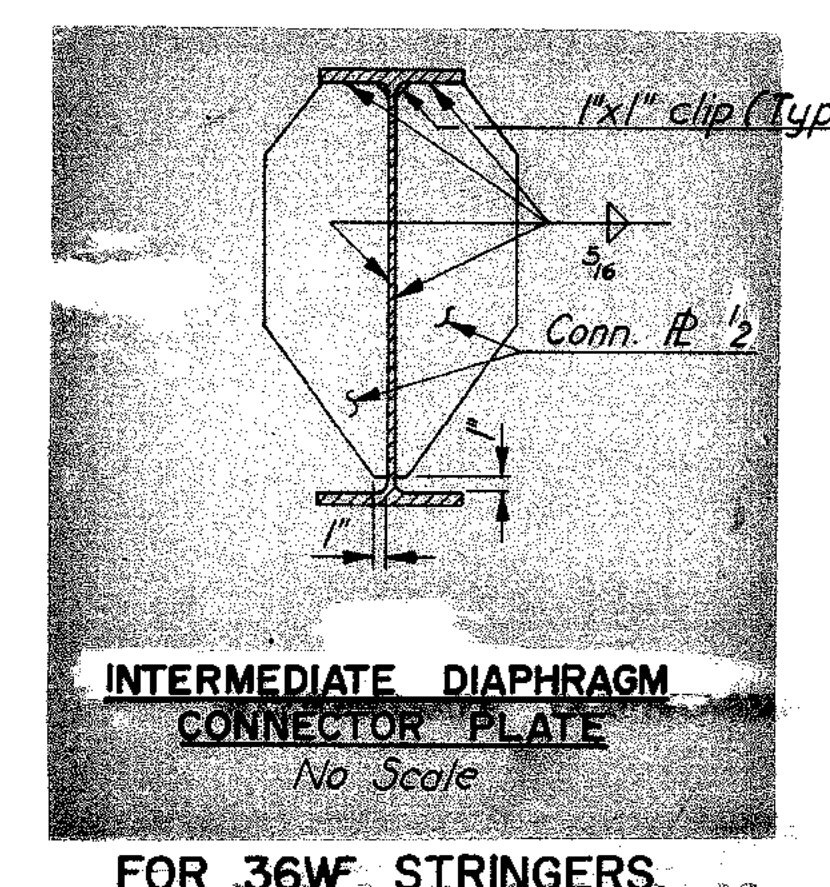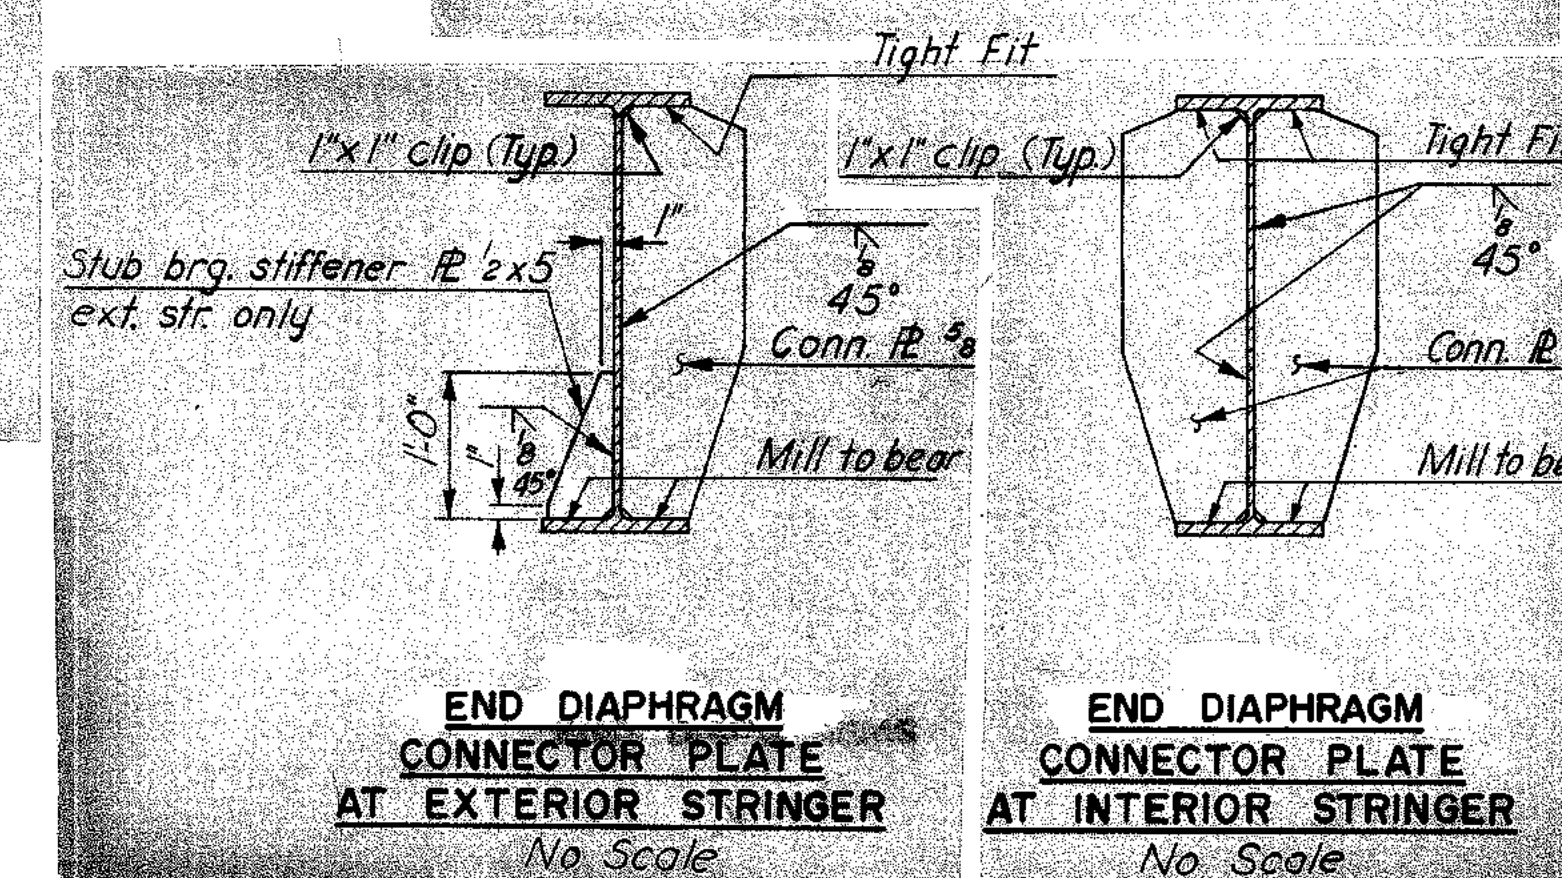

**NOTES:**  
For spacing and location of utility supports and diaphragms, see Framing Plan (1) sheet.  
For Basic Attachment Details for cement asbestos conduit, see Standard Conduit Installation Details sheet.  
For details showing gas and water mains thru abutments, see Standard Utility Support Details At Bridge Abutments sheet.

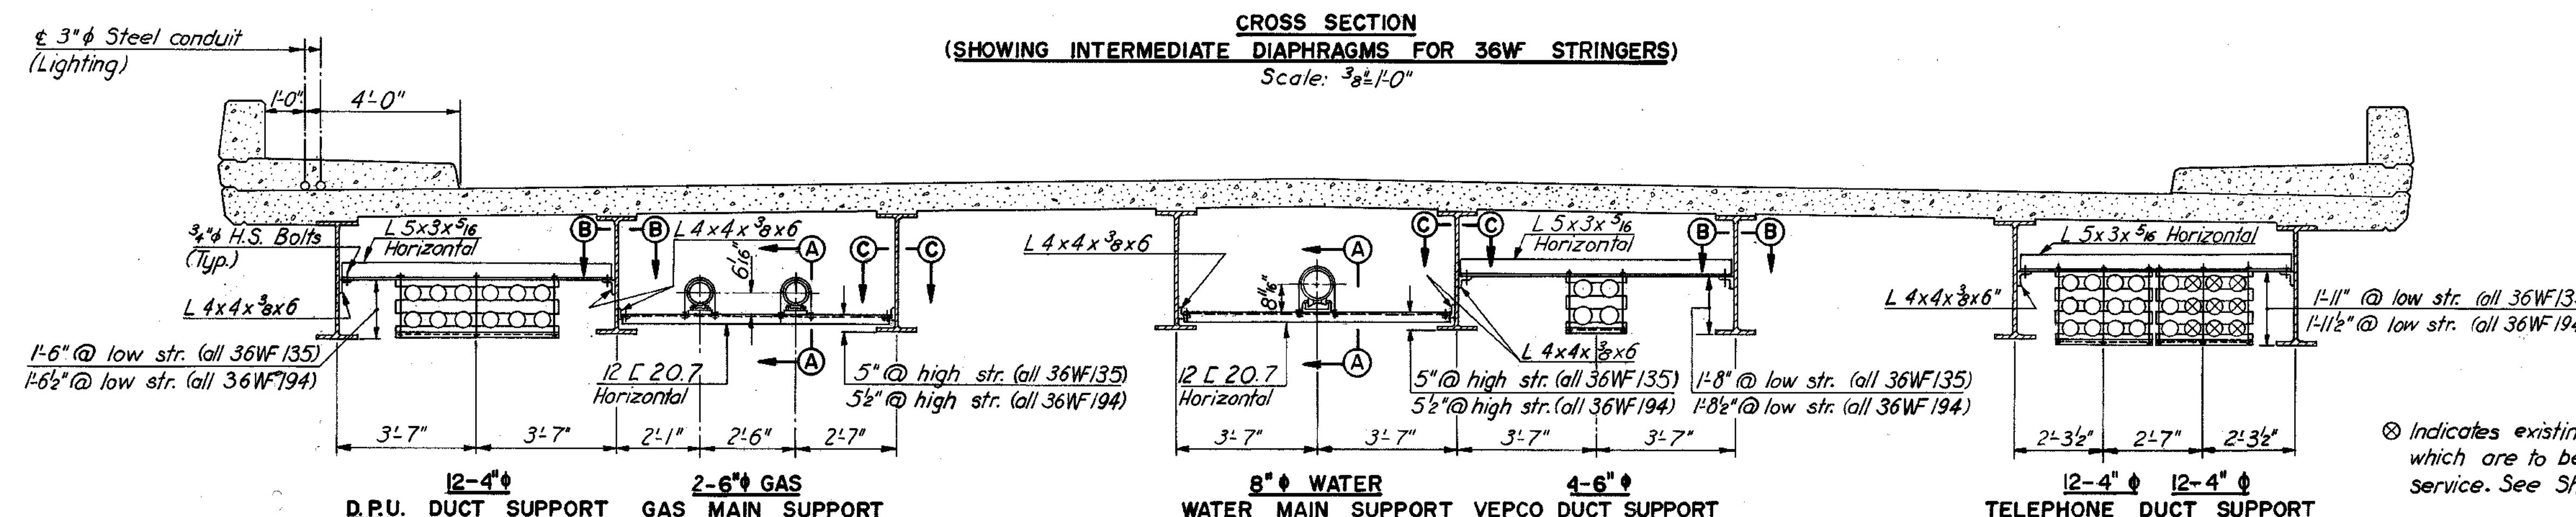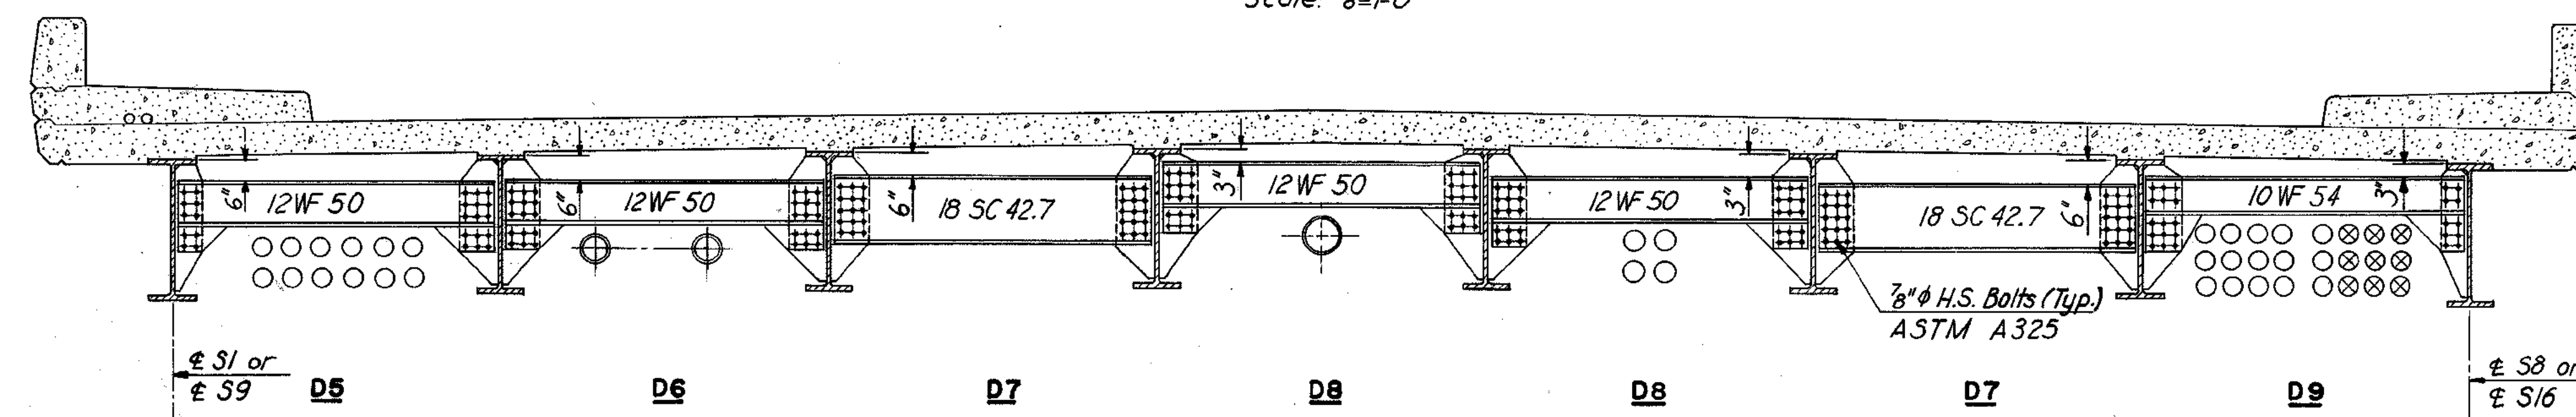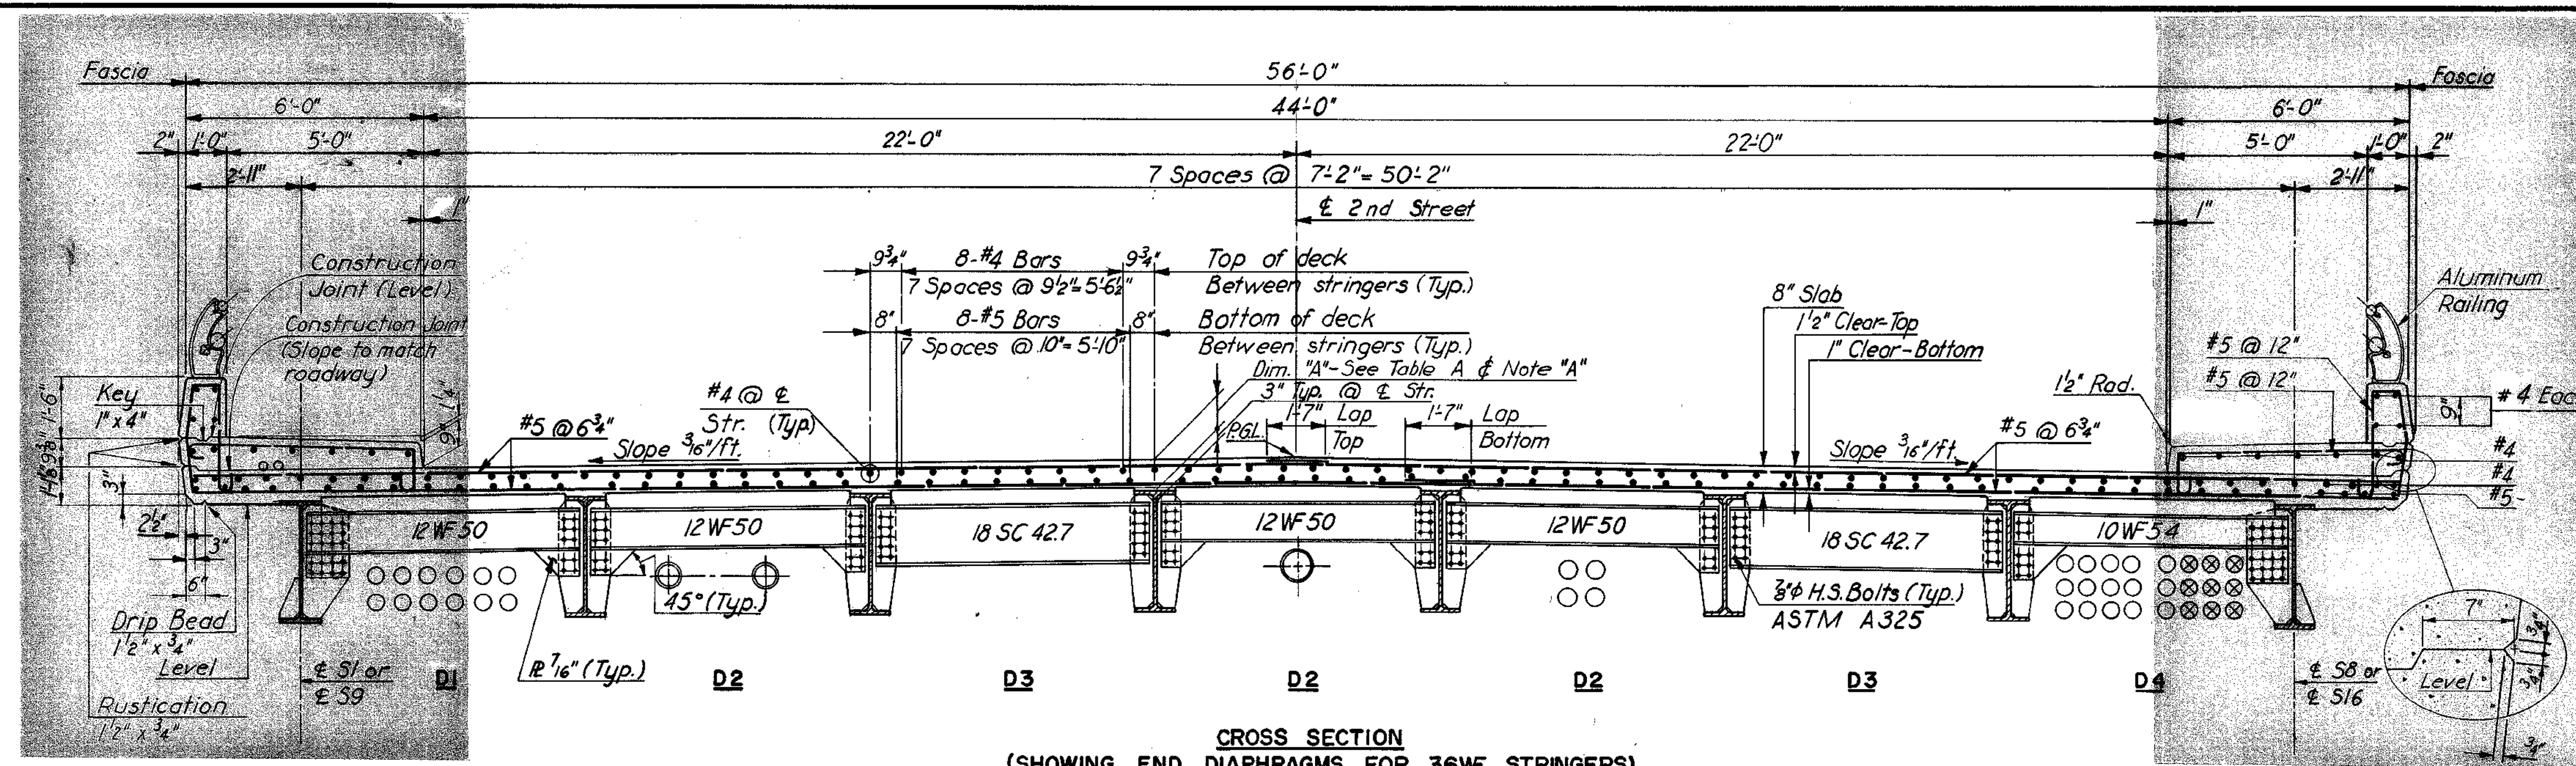

⊗ Indicates existing telephone ducts which are to be maintained in service. See Sheet 3.

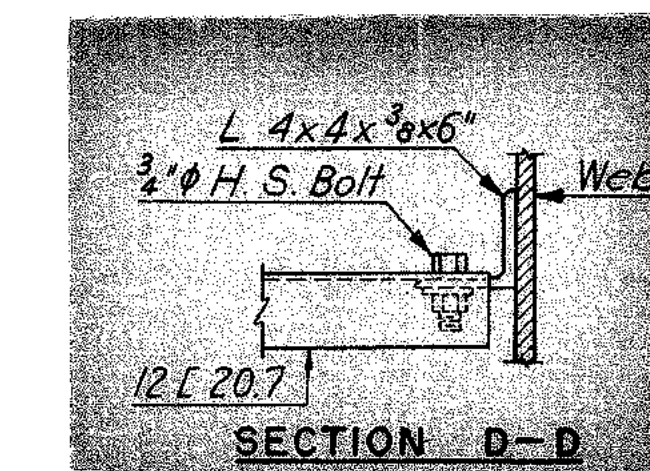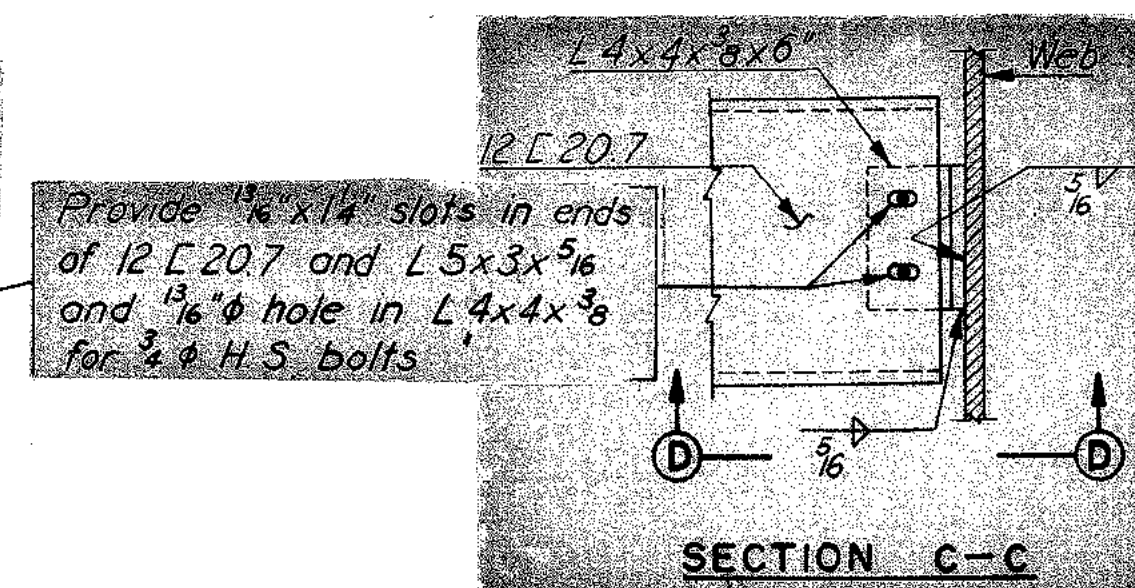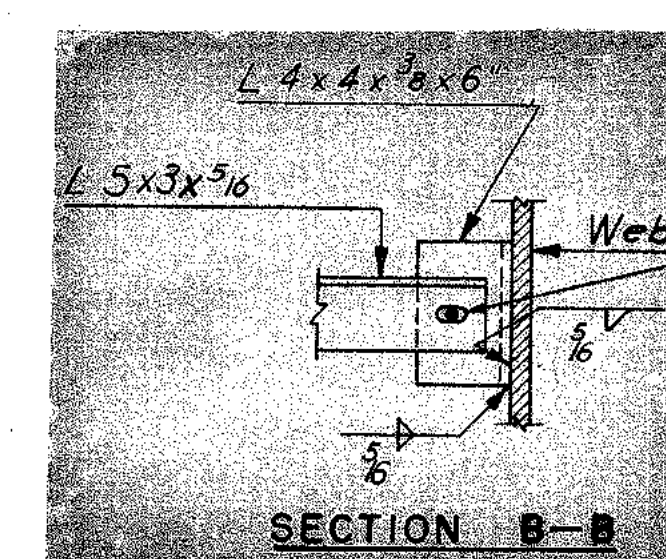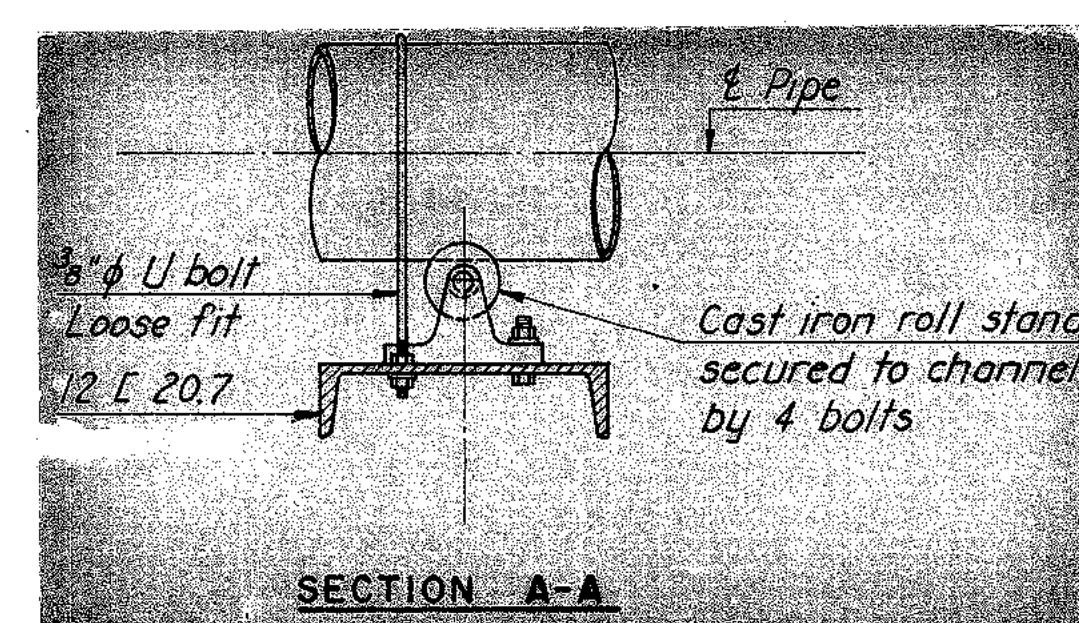

MADE	BY	DATE			
CHECKED	DSB	5-68	1	As Built	TEM 6-77
IN CHARGE	PRV				


RICHMOND METROPOLITAN AUTHORITY	
RICHMOND EXPRESSWAY SYSTEM	
DOWNTOWN EXPRESSWAY	
BRIDGE B-54	
2ND STREET OVER DOWNTOWN EXPRESSWAY	
CROSS SECTION (1)	
HOWARD, NEEDLES, TAMMEN & BERGENDOFF	SCALE: AS SHOWN
consulting engineers	CONTRACT NO. 9
NEW YORK ALEXANDRIA KANSAS CITY	SHEET NO. 13 OF 20

AS BUILT









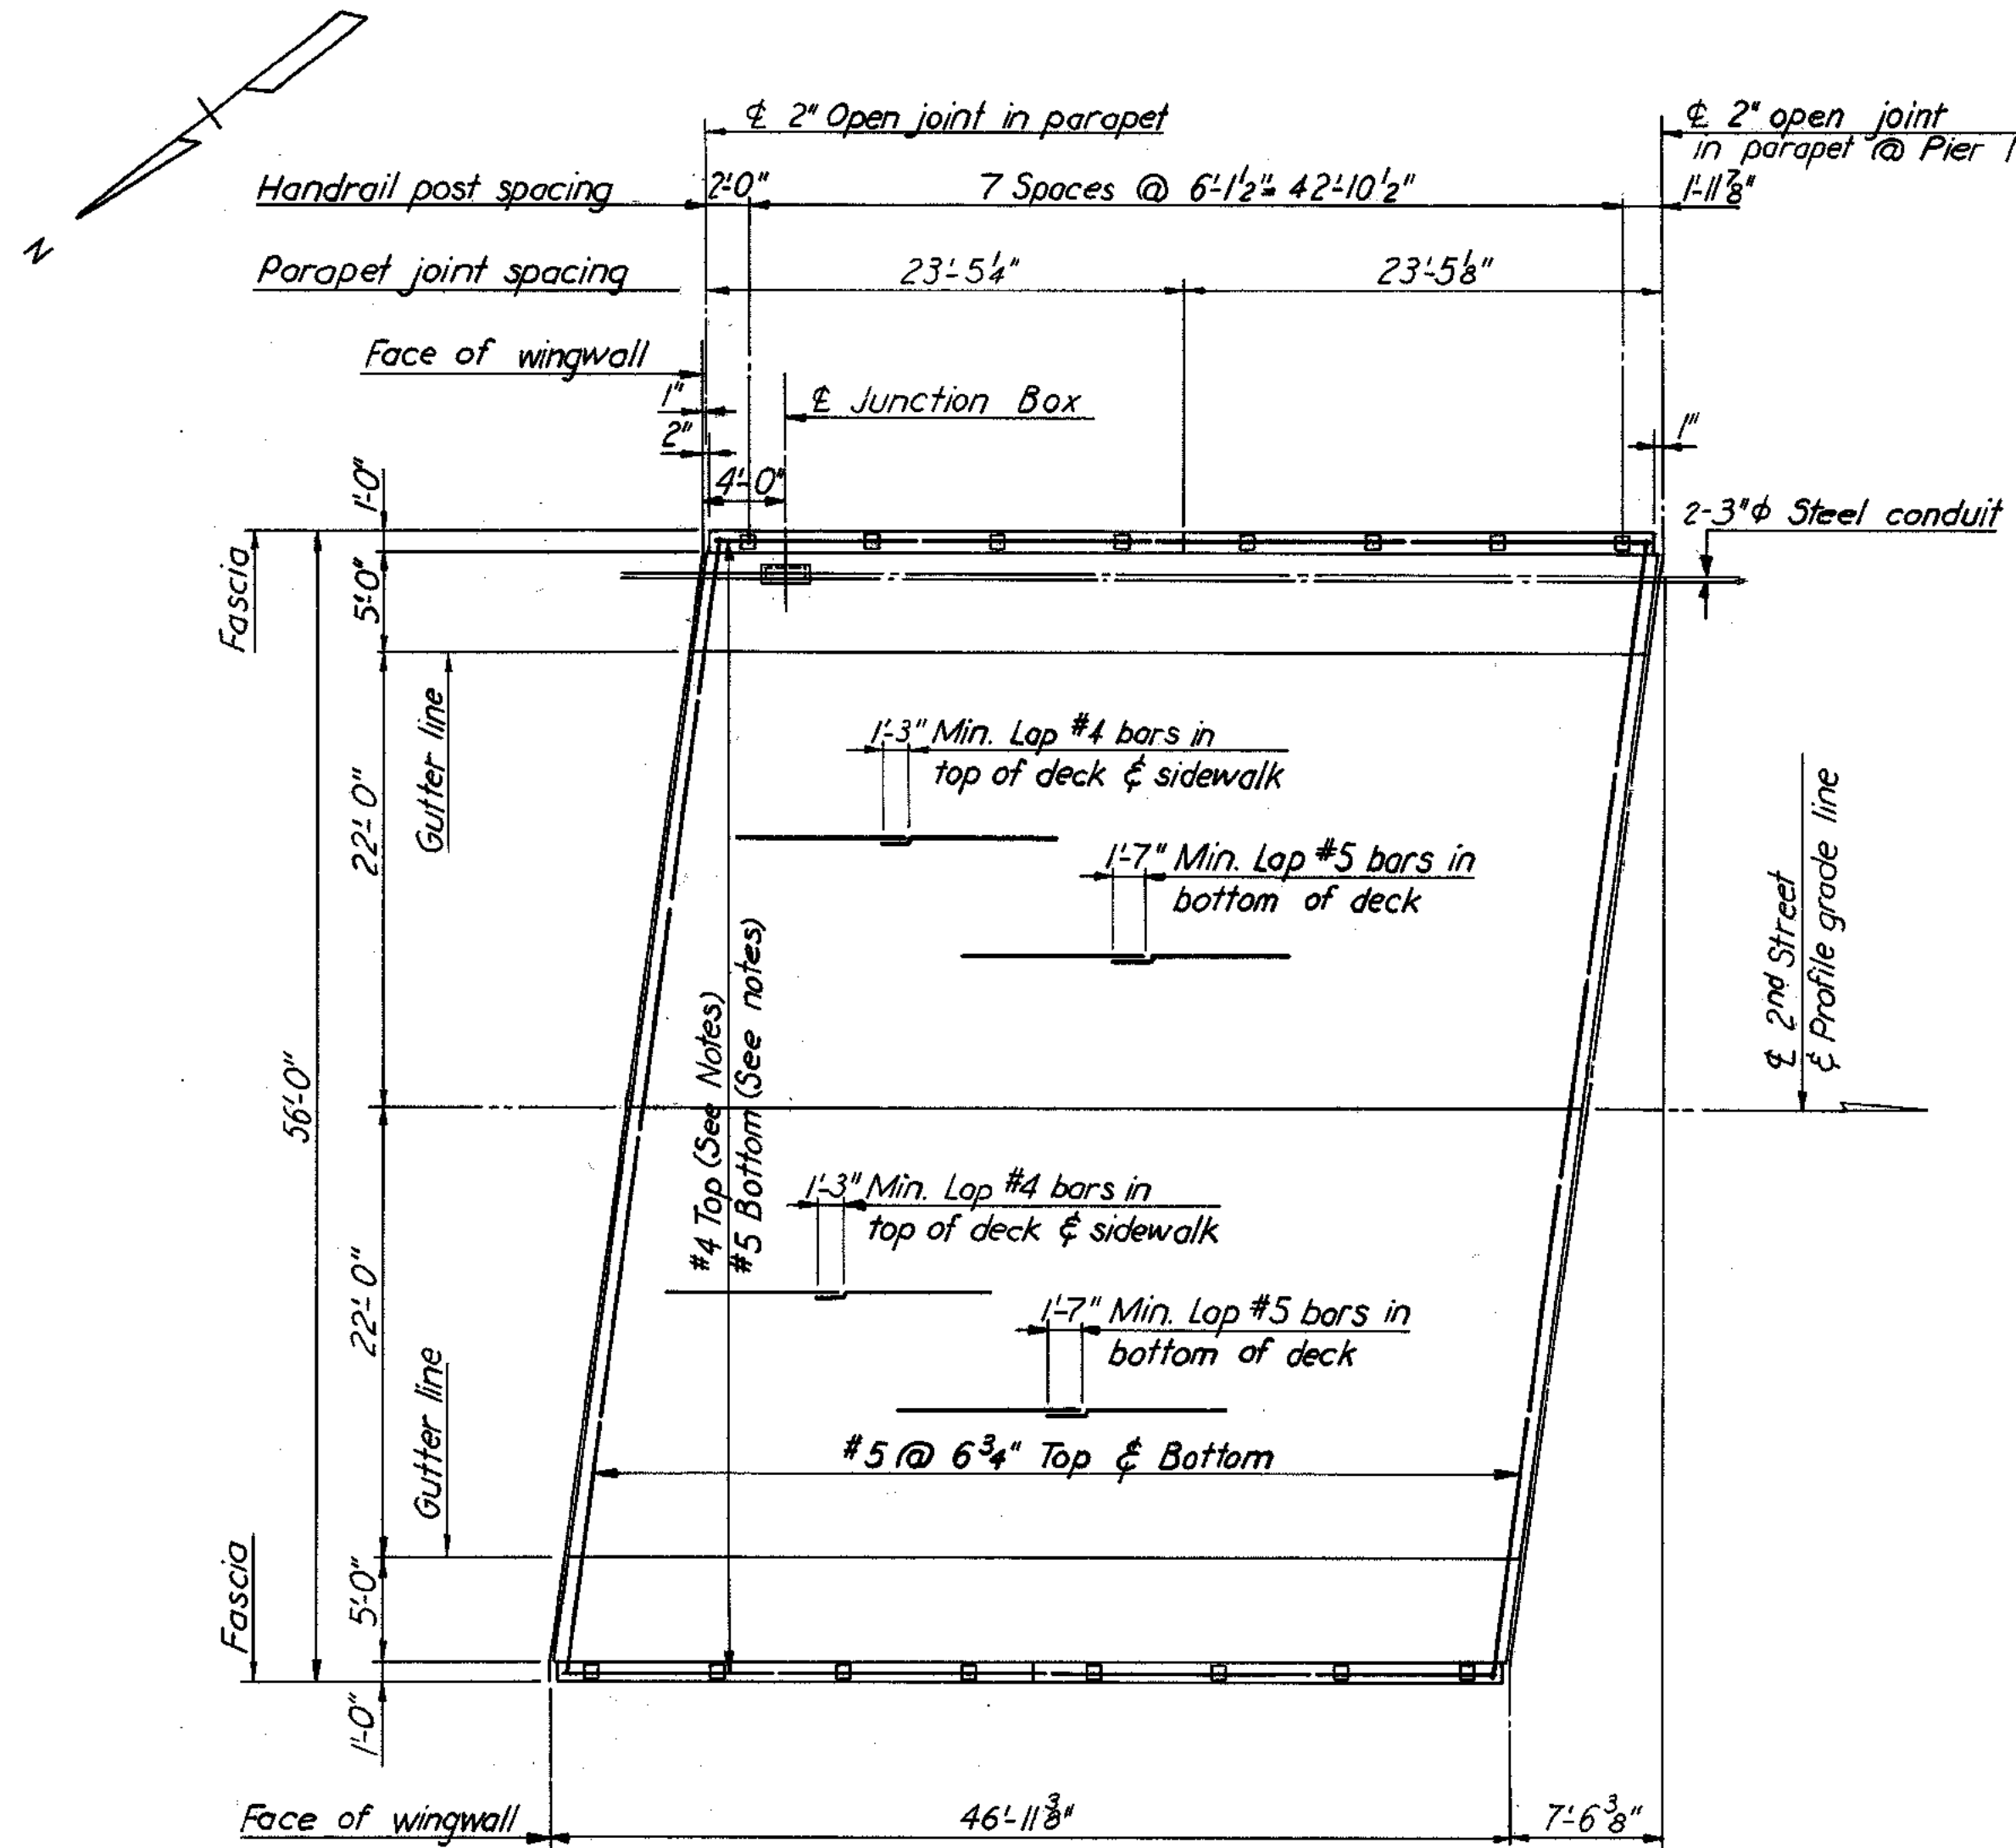

PLAN - UNIT 1  
Scale: 1/8" = 1'-0"

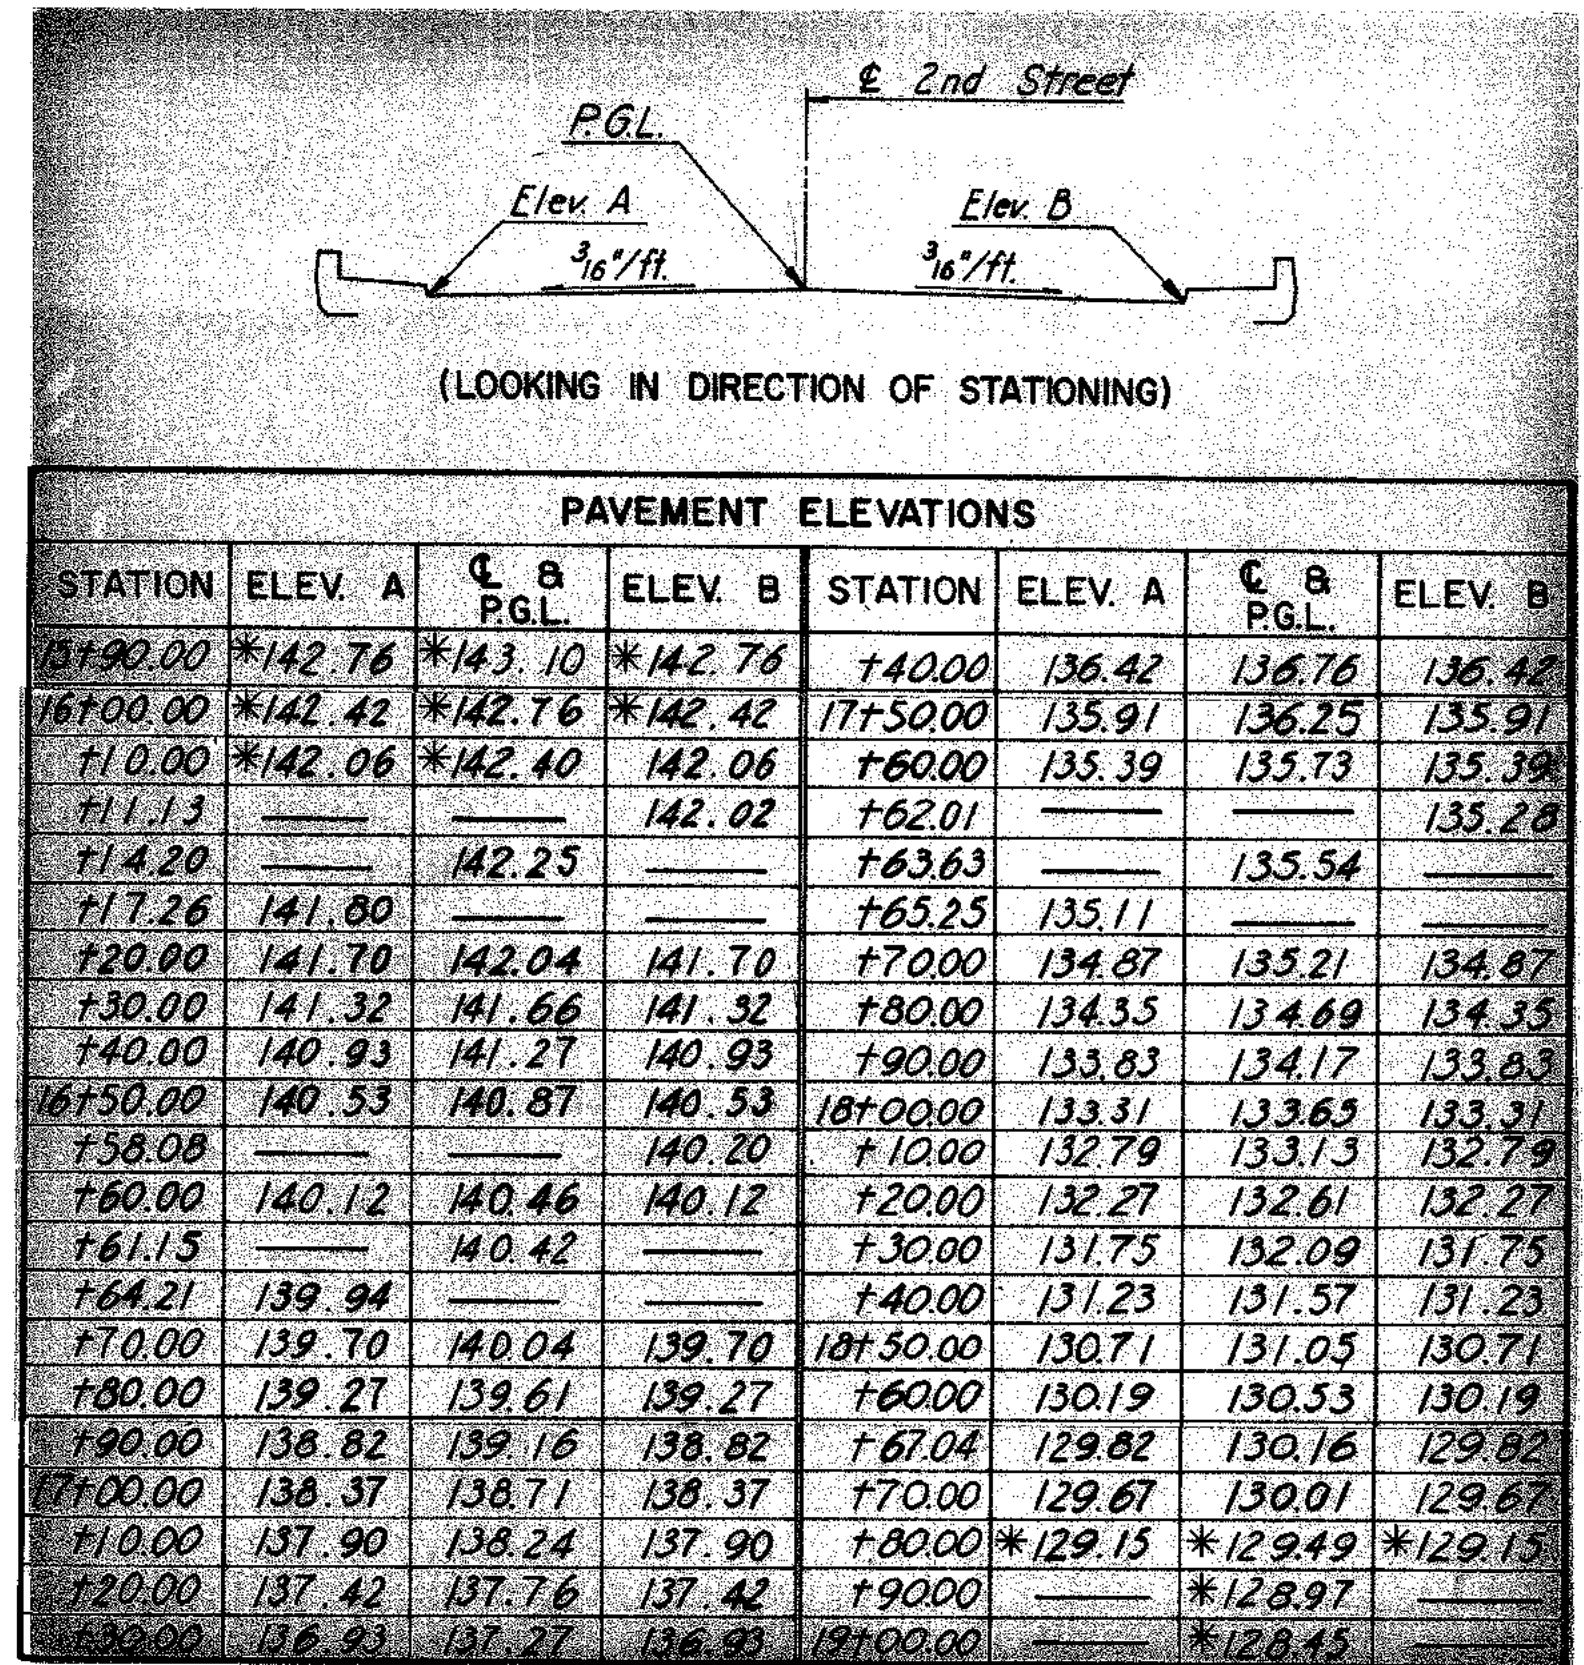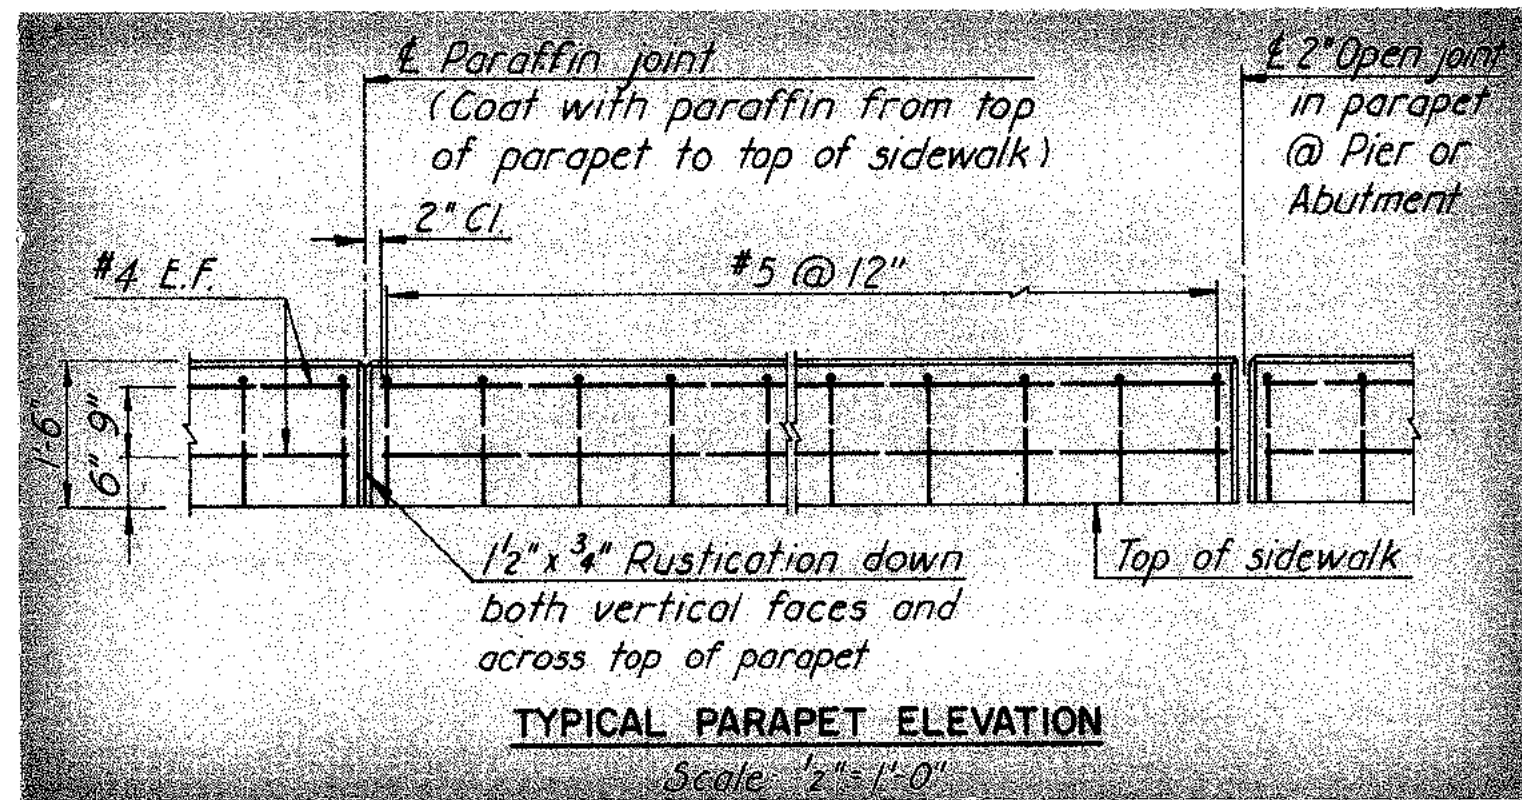

\* Elevations shown are given to top of bituminous surfacing.

NOTES:  
For location and spacing of deck, parapet and sidewalk reinforcing, see Cross Section (1) sheet.  
For location and spacing of reinforcing in haunch over end diaphragms, see Joint Details sheet.  
For lighting standard base, junction box details and additional reinforcing, see Standard Electrical Details sheet S4.


BY	DATE				
MADE	EVR	3-68			
CHECKED	DSB	5-68	1	As Built	TEM 6-77
IN CHARGE	PRY.		NO.	REVISION	BY DATE

AS BUILT


RICHMOND METROPOLITAN AUTHORITY	
RICHMOND EXPRESSWAY SYSTEM	
DOWNTOWN EXPRESSWAY	
BRIDGE B-54	
2ND STREET OVER	
DOWNTOWN EXPRESSWAY	
DECK PLAN 1	
HOWARD, NEEDLES, TAMMEN & BERGENDOFF consulting engineers NEW YORK ALEXANDRIA KANSAS CITY	SCALE: AS SHOWN CONTRACT NO. 9 SHEET NO. 15 OF 20



RICHMOND EXPRESSWAY SYSTEM			
SECTION	PROJECT	SHEET NO.	TOTAL SHEETS
3	DOWNTOWN EXPRESSWAY	134	

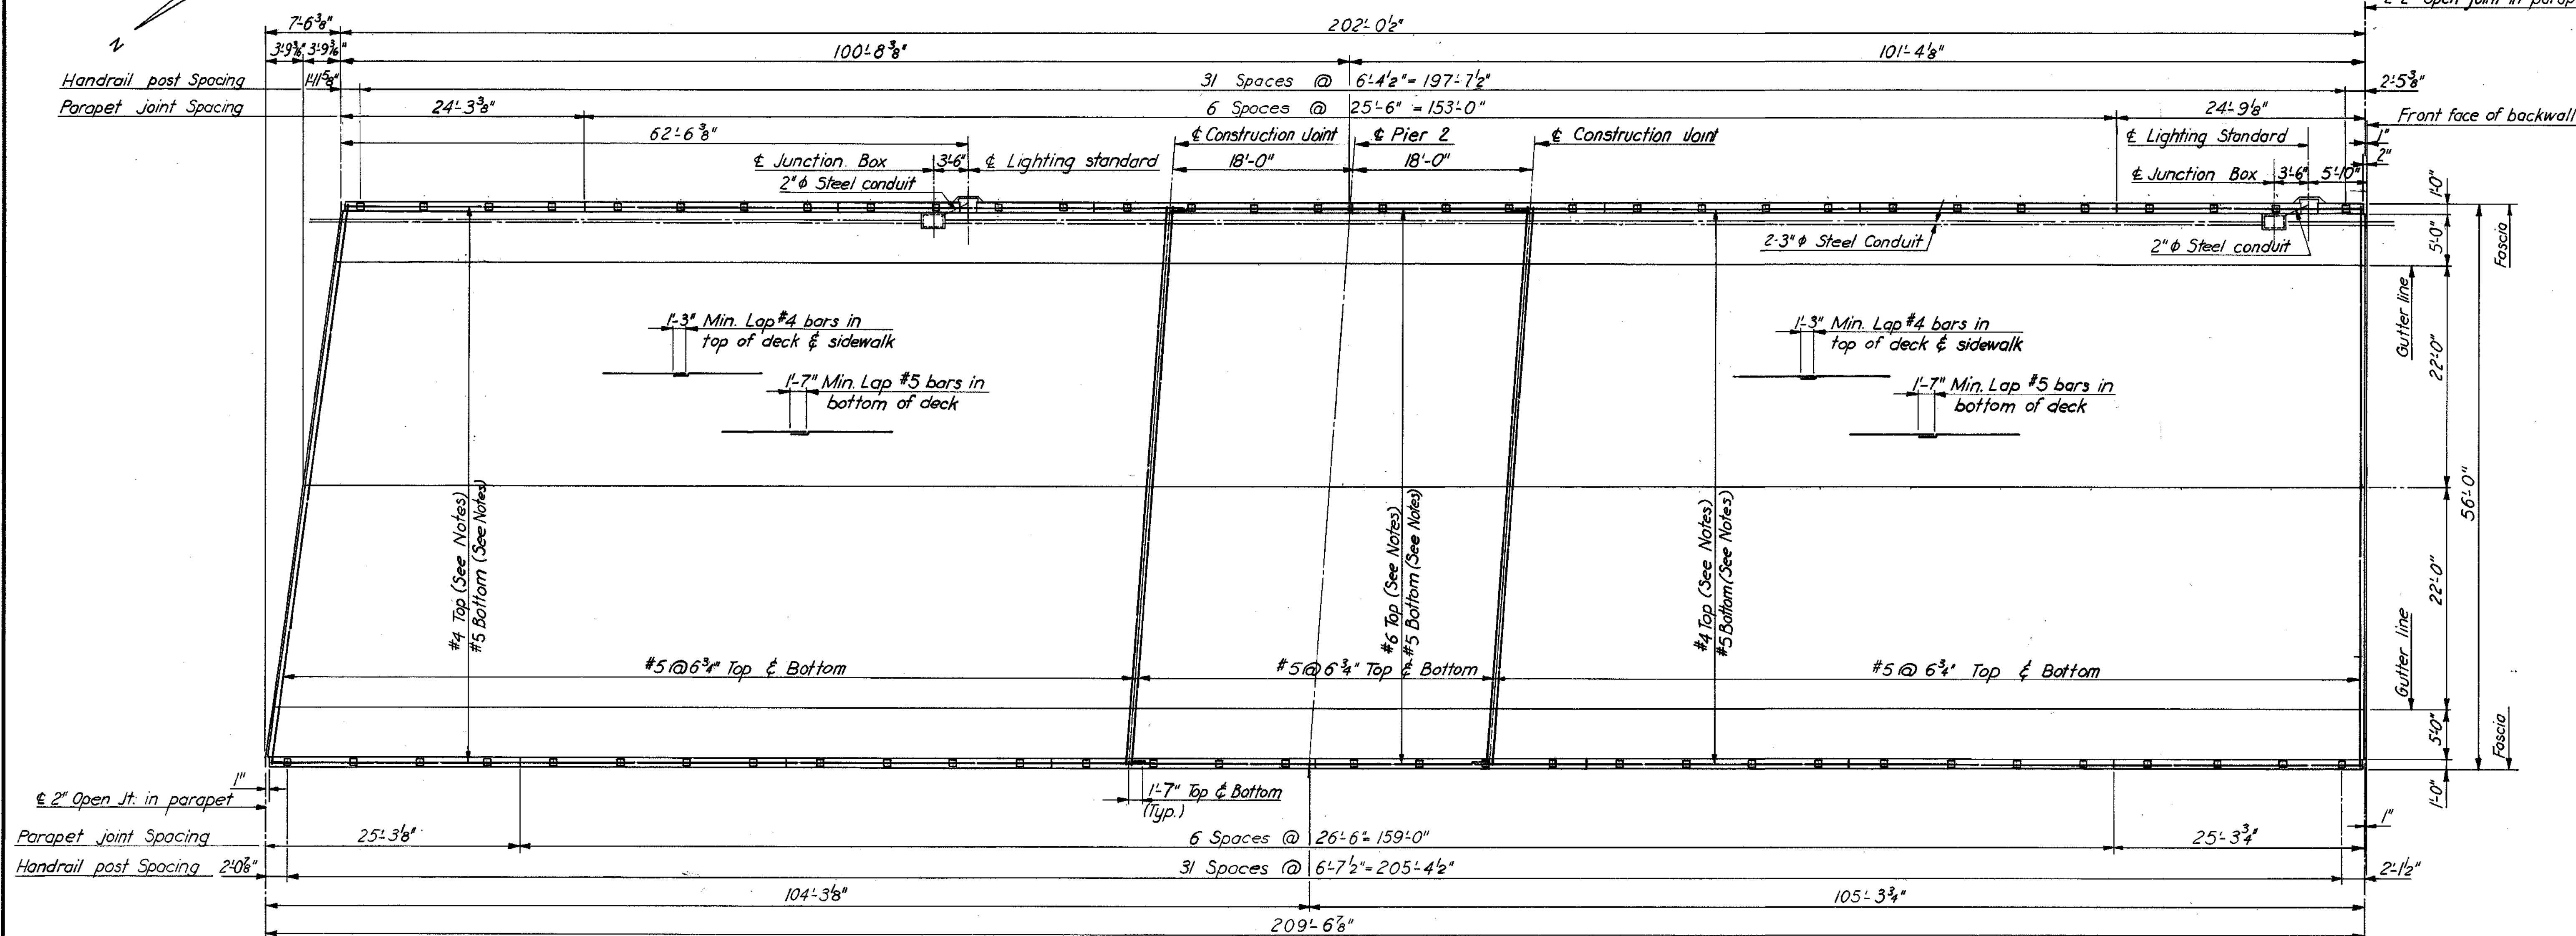


PLAN - UNIT 2  
Scale: 1/4" = 1'-0"

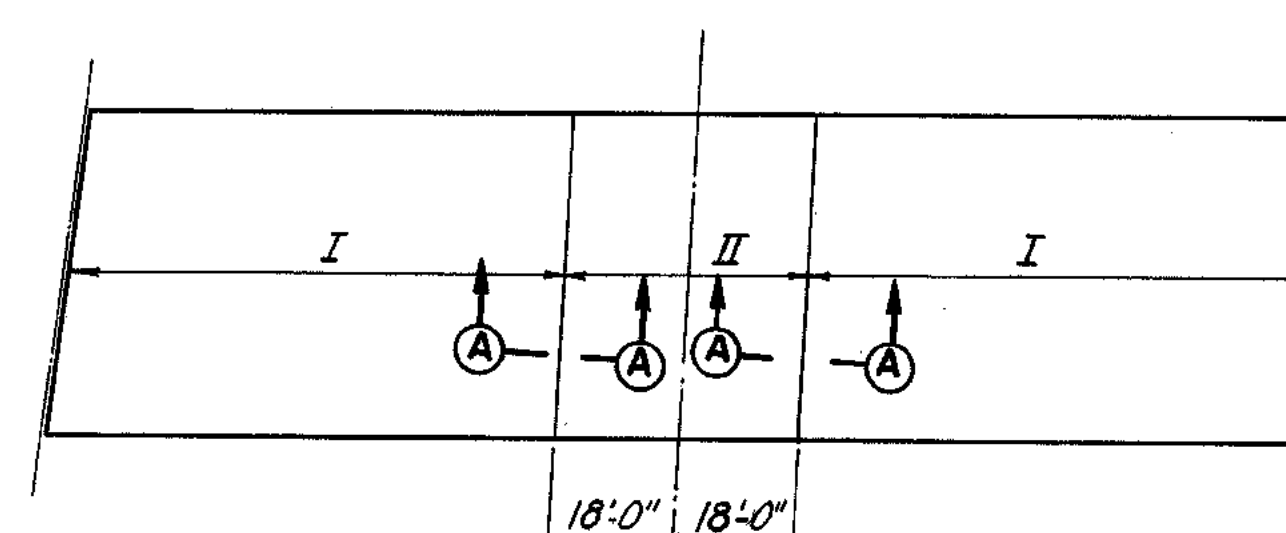

OPTIONAL  
DECK POURING SEQUENCE  
No Scale

Area marked I indicates first pour.  
Area marked II indicates second pour.

Note:  
Unit 2 was poured  
in one pour.

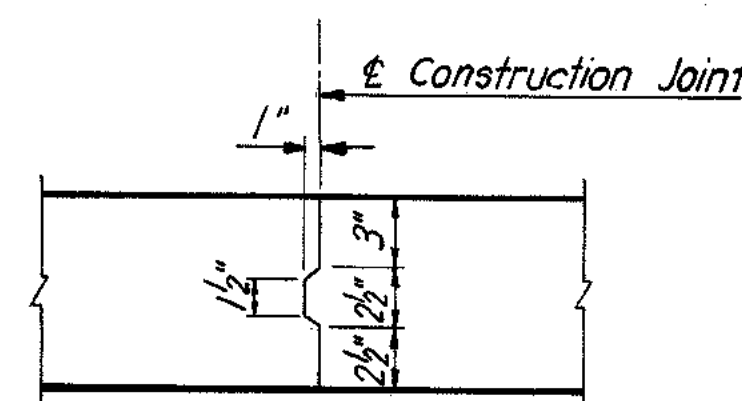

SECTION A-A  
No Scale

For location and spacing of deck, parapet and sidewalk reinforcement see Cross Section (1) Sheet for end portion and Section (2) Sheet for Pier 2.

For location and spacing of reinforcing in haunch over end diaphragms, see Joint Details sheet.


For lighting standard base, junction box details and additional reinforcing, see Standard Electrical Details sheet S4.

<b>RICHMOND METROPOLITAN AUTHORITY</b> <b>RICHMOND EXPRESSWAY SYSTEM</b> DOWNTOWN EXPRESSWAY	
BRIDGE B-54 2ND STREET OVER DOWNTOWN EXPRESSWAY <b>DECK PLAN 2</b>	
HOWARD, NEEDLES, TAMMEN & BERGENDOFF consulting engineers NEW YORK ALEXANDRIA KANSAS CITY	SCALE: AS SHOWN CONTRACT NO. 9 SHEET NO. 16 OF 20


AS BUILT

BY	DATE				
MADE	EVR	3-68			
CHECKED	DSB	5-68	1	As Built	TEM 6-77
IN CHARGE	PRY		NO.	REVISION	BY DATE


RICHMOND EXPRESSWAY SYSTEM			
SECTION	PROJECT	SHEET NO.	TOTAL SHEETS
9	DOWNTOWN EXPRESSWAY	242	

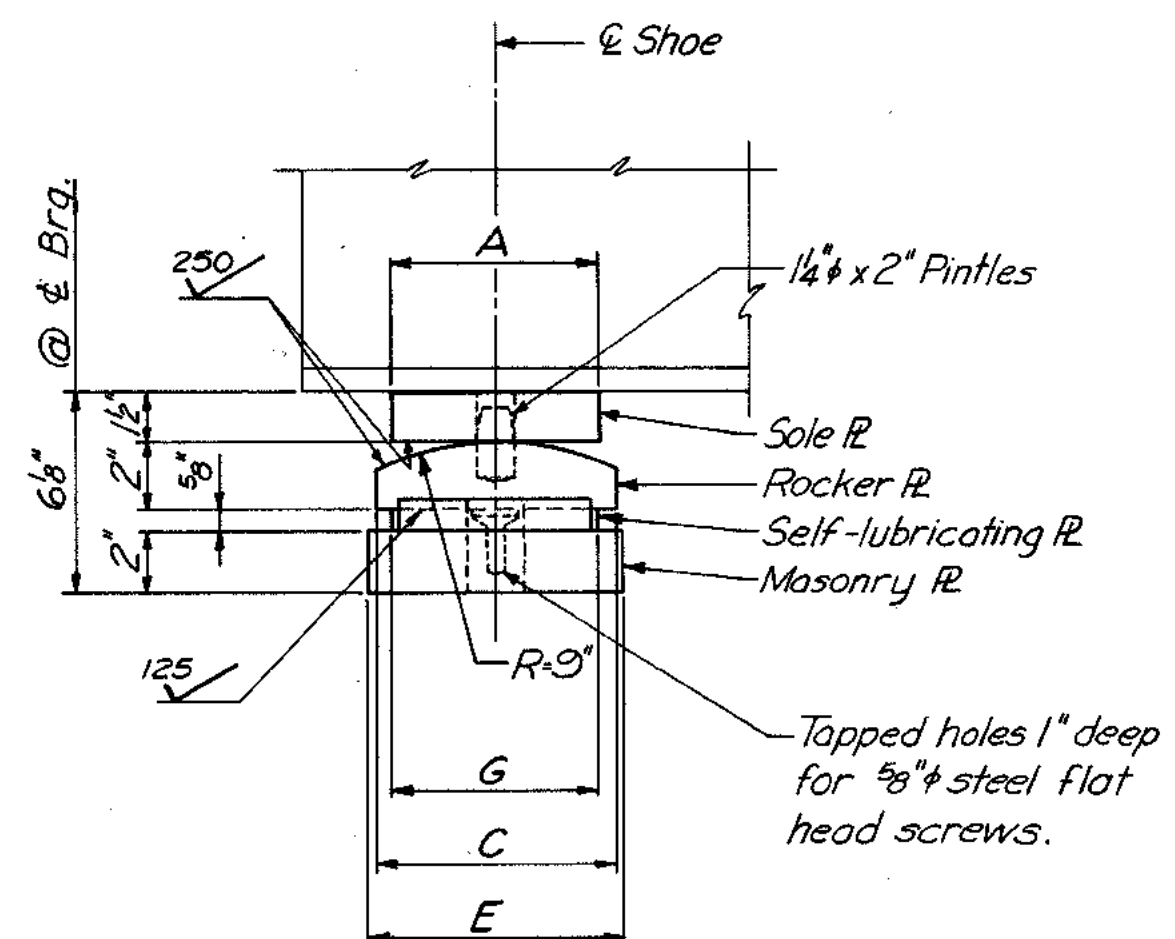


SIDE ELEVATION

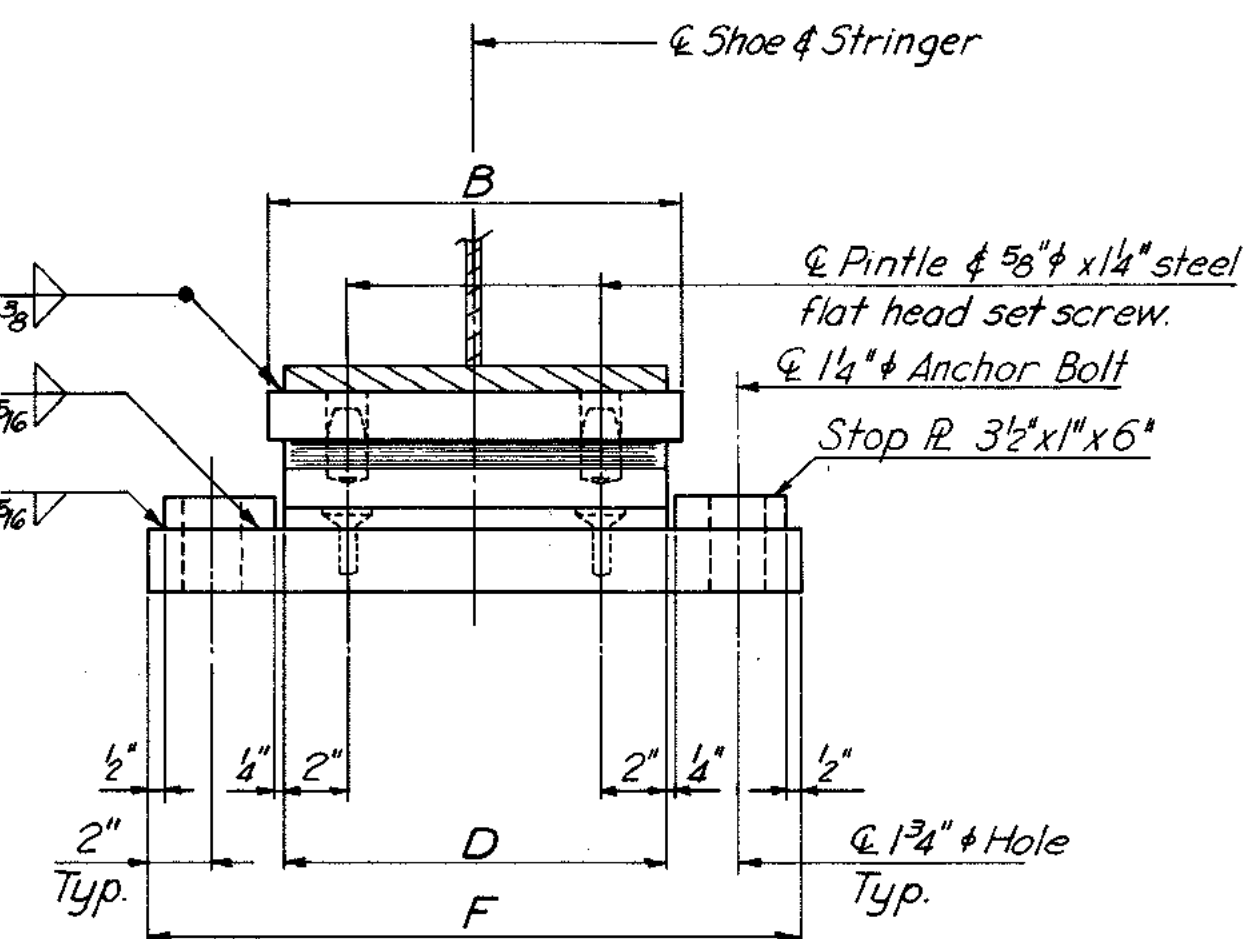


END ELEVATION

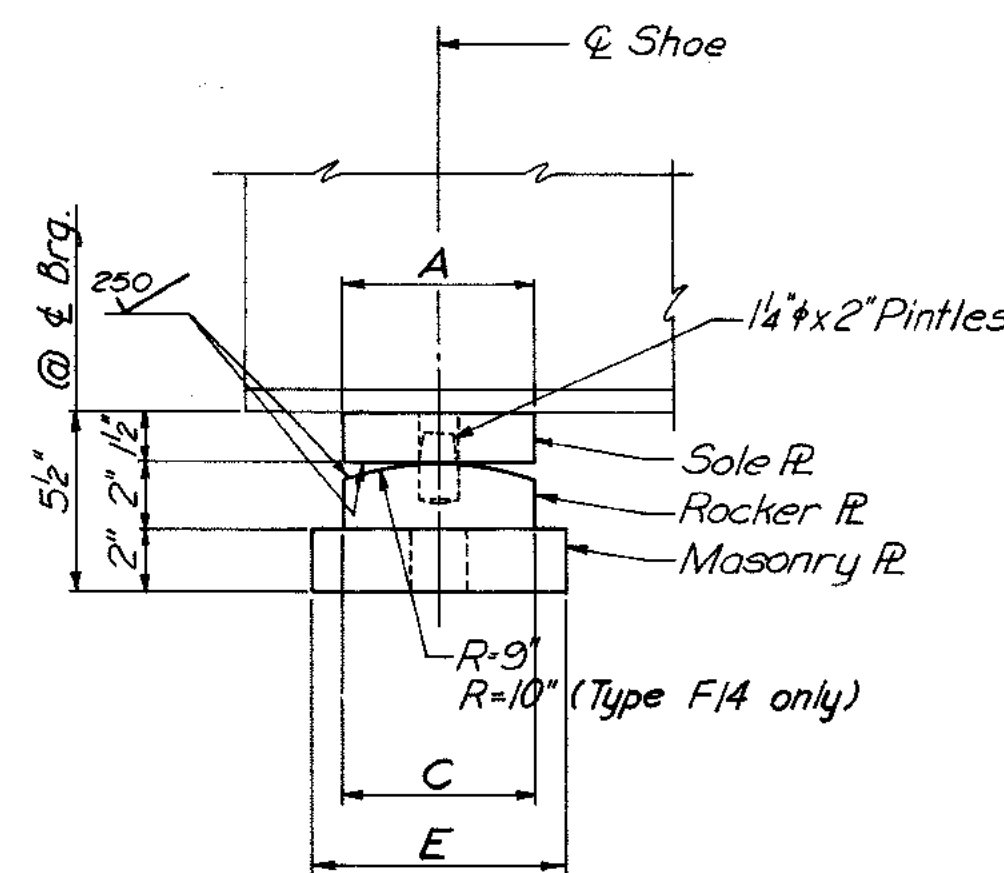

SIDE ELEVATION

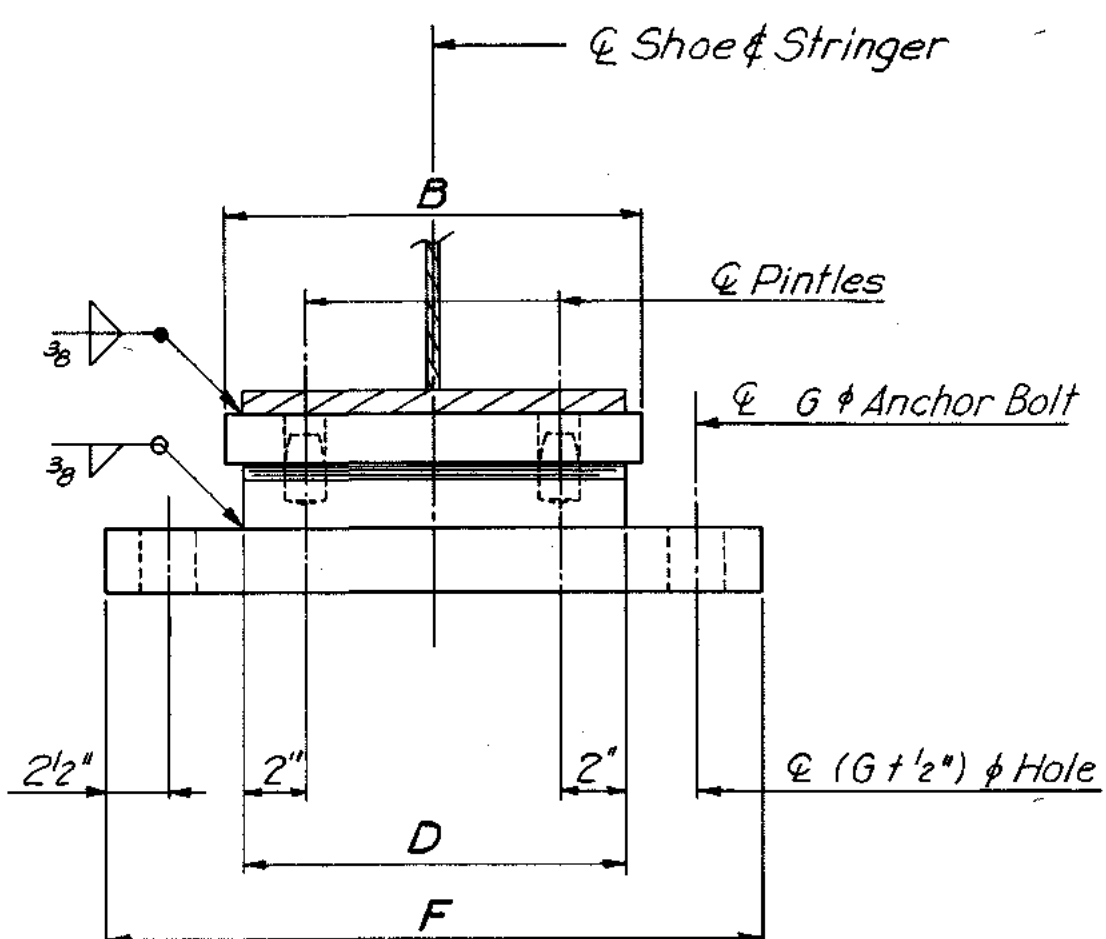


END ELEVATION

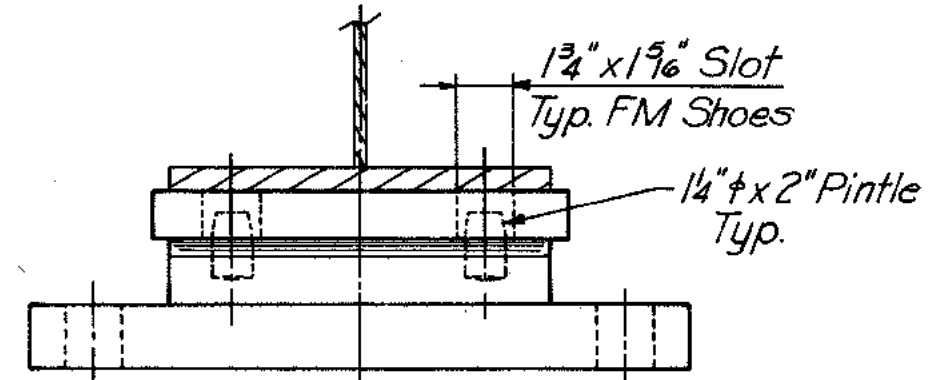


END ELEVATION

EXPANSION SHOE  
No Scale

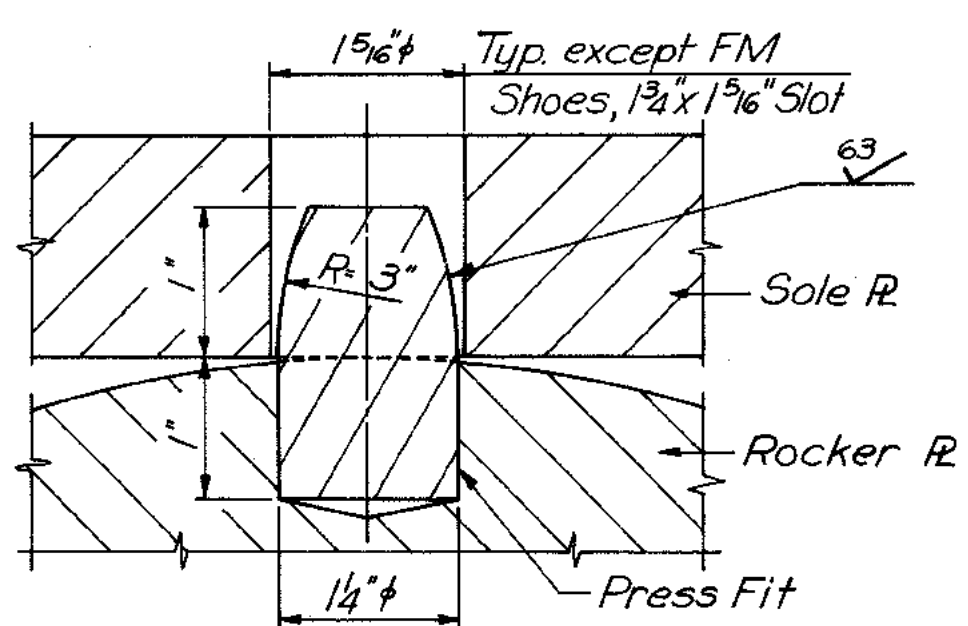


PINTLE DETAIL  
Scale: 3/4" = 1"

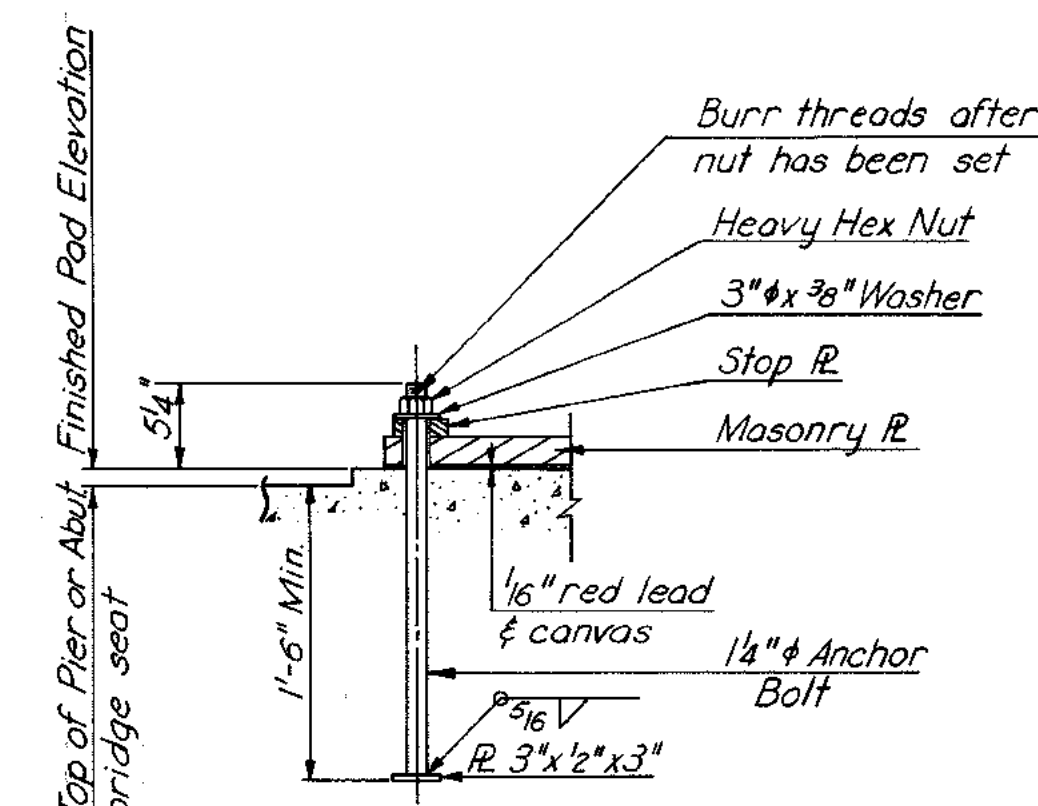

EXPANSION SHOE

ANCHOR BOLT DETAIL  
No Scale


FIXED SHOE  
No Scale

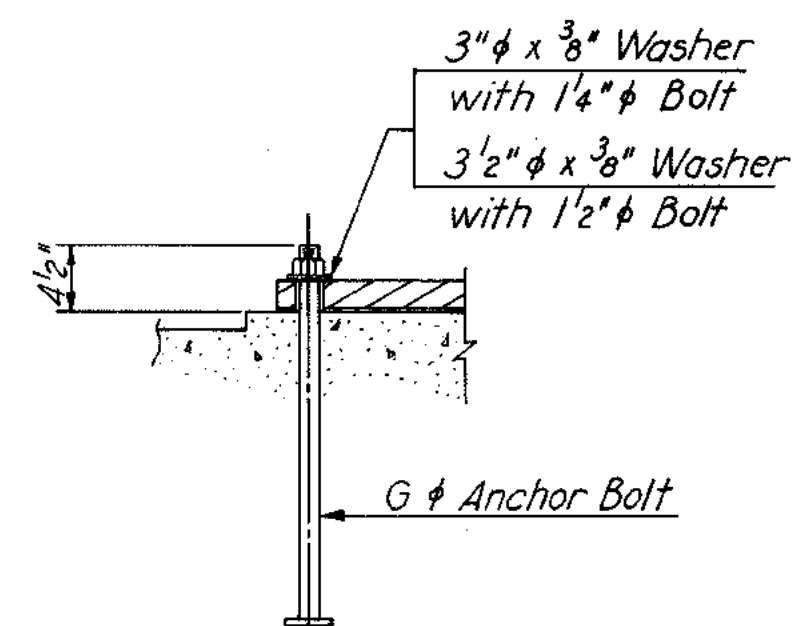

FIXED SHOE

**Shoe Notes:**  
Material for shoes (exclusive of self-lubricating plates) shall be structural carbon steel conforming to requirements of A.S.T.M. Specifications A242-66T and shall have a corrosion resistance equal to a minimum of four times that of A.S.T.M. A7 steel as determined by a salt spray test conforming to A.S.T.M. Method B287-62.  
Top of masonry plates, bottom of rocker plates and top and bottom of sole plates shall be planed, straightened or otherwise treated to secure true plane surfaces.  
Contact surfaces noted on the plans with finish symbols shall be finished in accordance with the American Standards Association surface roughness requirement as defined in ASA B46.1-55, Surface Roughness, Waviness and Lay, Part I.  
The plates comprising the expansion shoes shall be set so as to be truly centered under full dead load at a temperature of 60°F.  
Concrete pads shall be formed integral with abutment or pier and not less than 8" or more than 4" above finished elevation. Dress down pads by rubbing, grinding or as otherwise approved by the Engineer, to true level surfaces at the finished elevation.  
Anchor bolt assemblies shall conform to A.S.T.M. A-307-66 and shall be hot-dip galvanized conforming to A.S.T.M. A-153-66.  
Templates shall be used to accurately set the anchor bolts.

**Note:**  
Anchor Bolt for Fixed Shoes same as Anchor Bolt for Exp. Shoes except as shown.

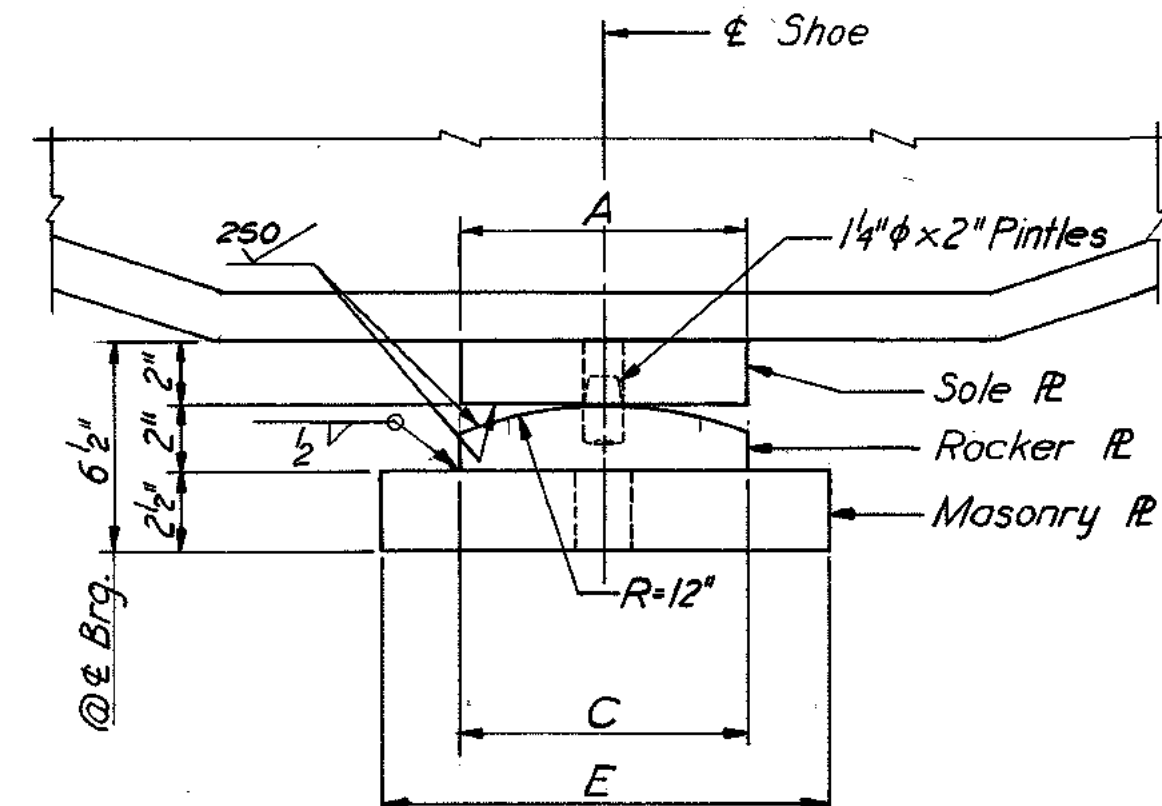

SIDE ELEVATION  
FIXED SHOE TYPE F13  
No Scale

**Note:** For details and dimensions not shown see Fixed Shoe details above.

AS BUILT

SHOE DIMENSIONS															
EXPANSION SHOES								FIXED SHOES							
TYPE	NO. REQD.	A	B	C	D	E	F	TYPE	NO. REQD.	A	B	C	D	E	F
E1	30	6"	1-1/4"	7-1/2"	1-0"	8"	1-8 1/2"	F1	53	6"	1-1/4"	6"	1-0"	7-1/2"	1-9"
E2	29	6"	1-1/4"	8-1/2"	1-0"	9"	1-8 1/2"	F1M	16	6"	1-1/4"	6"	1-0"	7-1/2"	1-9"
E3	51	6"	1-1/4"	9"	1-1/4"	9-1/2"	1-9 1/2"	F3	3	6"	1-3/4"	6"	1-4 1/2"	8"	2-3"
E5	12	6"	1-5/8"	9"	1-4 1/2"	9-1/2"	2-1/4"	F6	20	6"	1-9"	6"	1-8"	7"	2-6"
E8	28	6"	1-9"	9"	1-8"	9-1/2"	2-4 1/2"	F6M	8	6"	1-9"	6"	1-8"	7"	2-6"
E4	6	6"	1-5/8"	8"	1-4 1/2"	8-1/2"	2-1/4"	F12	15	6"	1-1/4"	6"	1-1/4"	7-1/2"	1-10"
								F12M	6	6"	1-1/4"	6"	1-1/4"	7-1/2"	1-10"
								F13	6	9"	1-7"	9"	1-6"	1-2"	2-4"
								F13M	2	9"	1-7"	9"	1-6"	1-2"	2-4"
								F14	1	6"	1-5 1/4"	6"	1-4 1/2"	11"	2-3"
								F2	1	6"	1-5 1/4"	6"	1-4 1/2"	7"	2-2"
								F2M	9	6"	1-5 1/4"	6"	1-4 1/2"	7"	2-2"
								F12M	4	6"	1-1/4"	6"	1-1/4"	7-1/2"	1-10"

BY	DATE				
MADE	A.B.P.	3-68			
CHECKED	A.V.S.	3-68	1	As Built	TEM 7-77
IN CHARGE	P.R.Y.		NO.	REVISION	BY DATE

RICHMOND METROPOLITAN AUTHORITY  
RICHMOND EXPRESSWAY SYSTEM  
DOWNTOWN EXPRESSWAY

STANDARD  
SHOE DETAILS  
Bridges 54, 55, 56, 57, 58, 60

HOWARD, NEEDLES, TAMMEN & BERGENDOFF  
consulting engineers  
NEW YORK ALEXANDRIA KANSAS CITY

SCALE: AS SHOWN  
CONTRACT NO.: 9  
SHEET NO. S1 OF





**Bridge 55**

**3<sup>rd</sup> Street**

**Over**

**Downtown Expressway (VA 195)**

**Record Set Plans**







GENERAL NOTES

RICHMOND EXPRESSWAY SYSTEM			
SECTION	PROJECT	SHEET NO.	TOTAL SHEETS
9	DOWNTOWN EXPRESSWAY	140	

<b>ROADWAY CAPACITY:</b>	One 42'-0" clear roadway. Two 5'-0" sidewalks. Dead Load-Includes 15 lbs. per sq.ft. for future wearing surface. Live Loads-HS20-44 loading and B.P.R. modified for military vehicles.
<b>SPECIFICATIONS:</b>	<b>GENERAL</b> -Virginia Department of Highway Road and Bridge Specifications, 1970. <b>DESIGN</b> -A.A.S.H.O. Standard Specifications for Highway Bridges, 1961, modified by Special Design Provisions. <b>WELDING</b> -1969 Standard Specifications for Welded Highway and Railway Bridges of the American Welding Society.  <b>CONTRACT SPECIAL PROVISIONS</b>  Specifications and Contract Special Provisions referred to above are necessary to make these plans complete.  <b>DATUM:</b> CITY OF RICHMOND  <b>TEMPERATURE:</b> The normal temperature referred to on the plan is 60°F. The temperature range for movement is 0°F to 120°F.  <b>DIMENSIONS:</b> All dimensions are measured horizontally and vertically unless otherwise noted.  <b>EXCAVATION:</b> Excavation below subgrade and cut slope template shall be classified as Structure Excavation. All excavation above these limits shall be classified as Regular Excavation and is not included in the Structural Quantities.  <b>FOUNDATIONS:</b> Footings shall rest on firm material. Foundation material shall be kept dry and special attention is called to Sections 401.05 and 401.06 of the General Specifications and to the Contract Special Provisions concerning preparation of foundations for footings.

<b>CONCRETE NOTES:</b>	Concrete in superstructure shall be Class A4. All other concrete shall be Class A3. All exposed edges and corners shall have a 3/4" chamfer or fillet unless otherwise noted. Care in the method of vibration, the use of low-slump concrete, and/or other means shall be employed to prevent downgrade movement of newly placed slab concrete (when gradient is over 2%).  Finishing Concrete Surfaces: See the Standard Architectural Details sheets and the Contract Special Provisions for types and details.  All reinforcing steel shall conform to ASTM A615 Grade 40. All reinforcing bar dimensions on the detailed drawings are to centers of bars unless otherwise noted. Clear distance between reinforcing steel and face of concrete shall be as noted on the plans. All bar laps shall be 30 diameters of the smaller diameter bar unless otherwise noted.  <b>STEEL NOTES:</b> Structural steel shall conform to A.S.T.M. Specification A36 except as noted. All field connections shall be made with high strength bolts. High strength bolts shall be 7/8" diameter unless otherwise noted and shall conform to A.S.T.M. Specification A325.  <b>BENCH MARKS:</b> See Reference Ties and Field Control Data sheet in highway plans.  C-46 Plug, corner Byrd St. and S. 3rd St., Elev. 149.69 C-47 Plug, corner E. Canal St. and S. 3rd St., Elev. 150.70
------------------------	---

FINAL QUANTITIES








	STRUCTURE EXCAVATION C.Y.	CONCRETE CLASS A3 C.Y.	CONCRETE CLASS A3 BR. APPR. SLABS C.Y.	CONCRETE CLASS A4 C.Y.	REINFORCING STEEL LBS.	STRUCTURAL STEEL LBS.	ALUMINUM BR. RAILING (2 RAILS) L.F.	DRILLED HOLES FOR CAISSONS 4" Ø L.F.	POROUS BACKFILL C.Y.	STEEL PILES I0BP42 L.F.	CONC. SLAB SLOPE PROTECTION S.Y.	DAMP-PROOFING S.Y.	UNDERDRAIN 6" Ø L.F.	GAS MAIN 6" Ø L.F.	WATER MAIN 12" Ø L.F.	CONDUIT 6" Ø VEPCO L.F.	METAL CONDUIT 3" Ø L.F.	
SUPERSTRUCTURE				384.39	84,396	418,496	409.9							251	249	997	1278	
NORTH ABUTMENT	299	175.67			12,201		22.7		29	2134	178.68	111	129					
PIER I	38	140.94			39,985			95.3										
SOUTH ABUTMENT	623	209.43			16,751		28.9		41		246.75	118	90					
APPROACH SLABS			100.37		22,618													
TOTAL	960	526.04	100.37	384.39	175,951	418,496	461.5	95.3	70	2134	425.43	229	219	251	249	997	1278	

	BY	DATE				
MADE	EVR	3-68				
CHECKED	A.B.P.	12-68	1	As Built	TEM	6-77
IN CHARGE	PRY.		NO.	REVISION	BY	DATE

AS BUILT

RICHMOND METROPOLITAN AUTHORITY	
RICHMOND EXPRESSWAY SYSTEM	
DOWNTOWN EXPRESSWAY	
BRIDGE B-55	
3RD STREET OVER DOWNTOWN EXPRESSWAY	
GENERAL NOTES AND QUANTITIES	
HOWARD, NEEDLES, TAMMEN & BERGENDOFF consulting engineers NEW YORK ALEXANDRIA KANSAS CITY	SCALE: AS SHOWN CONTRACT NO. 9 SHEET NO. 2 OF 16



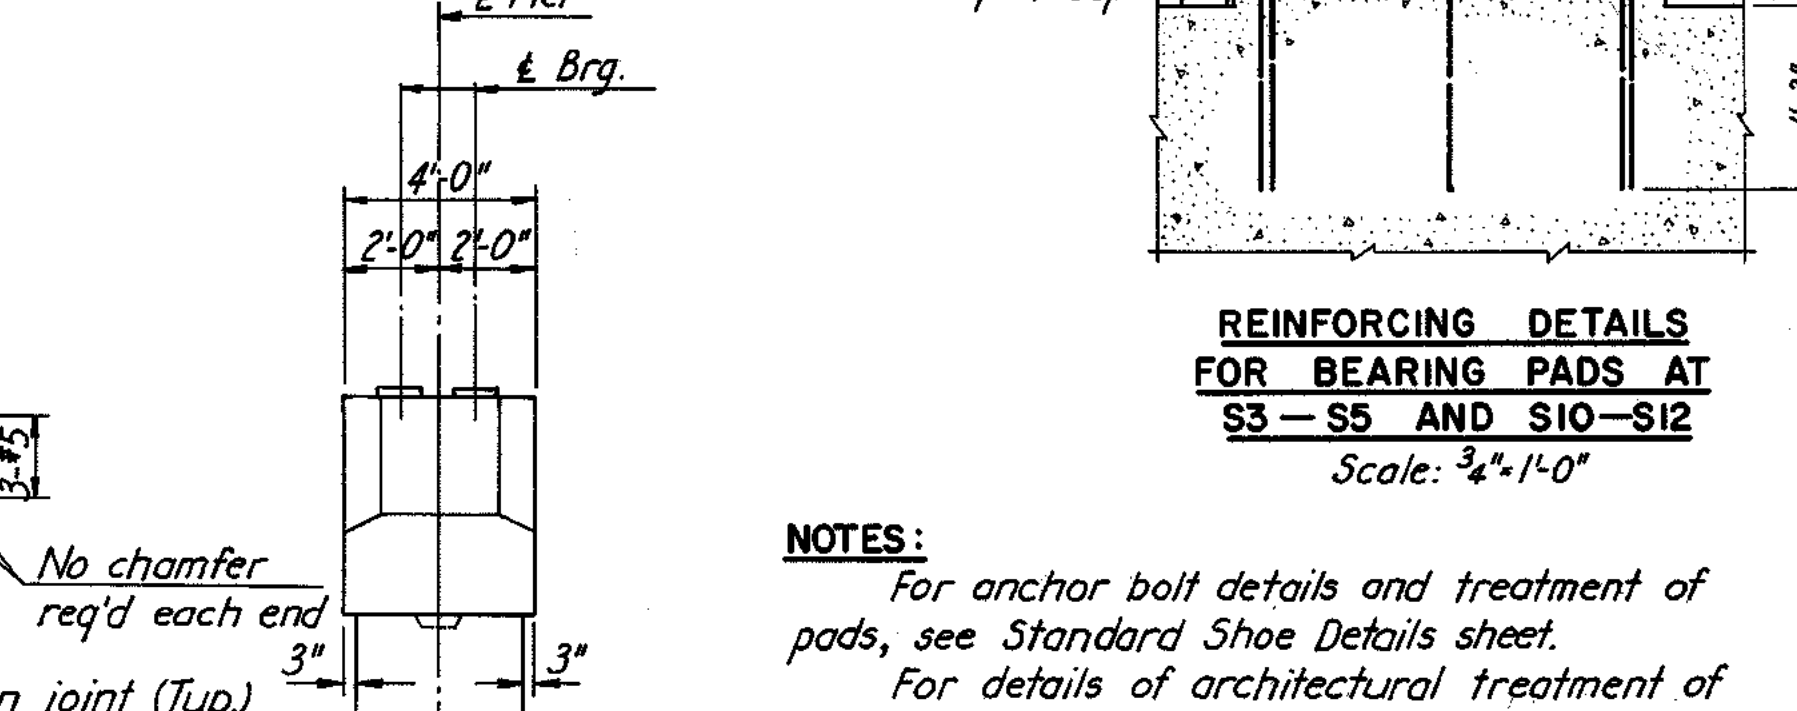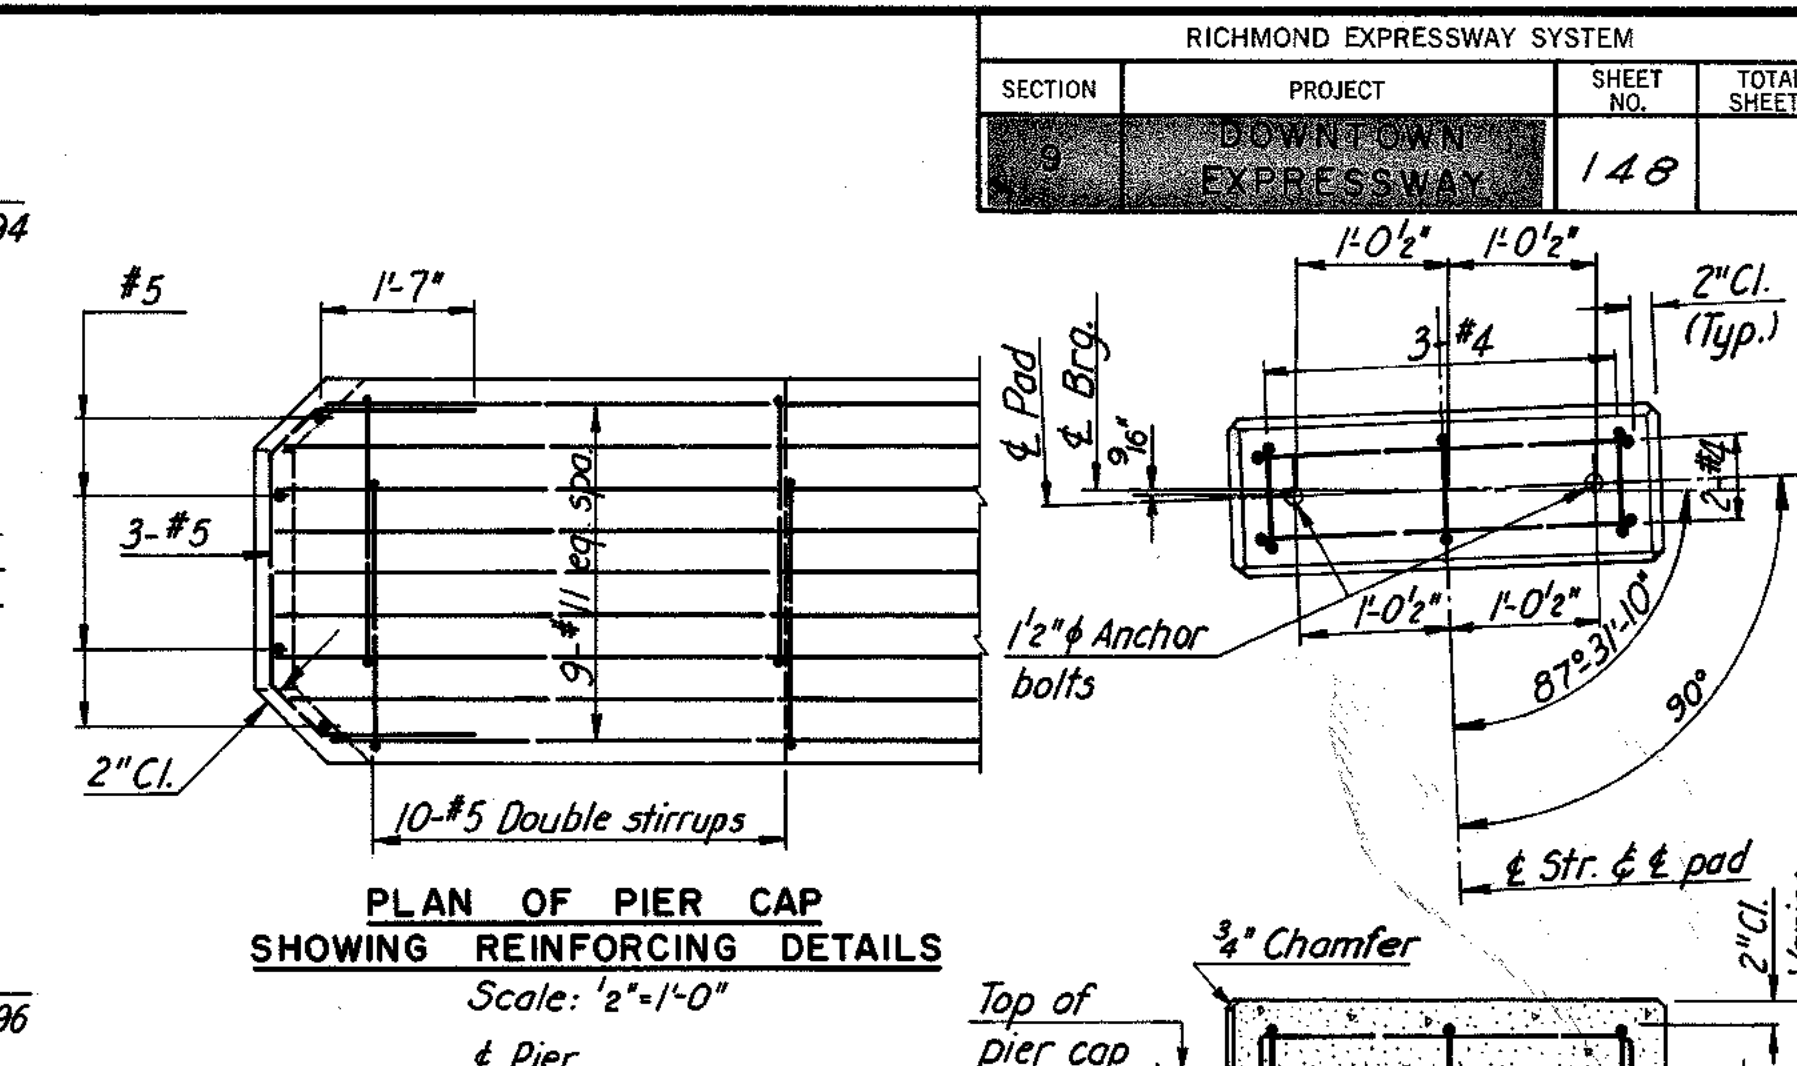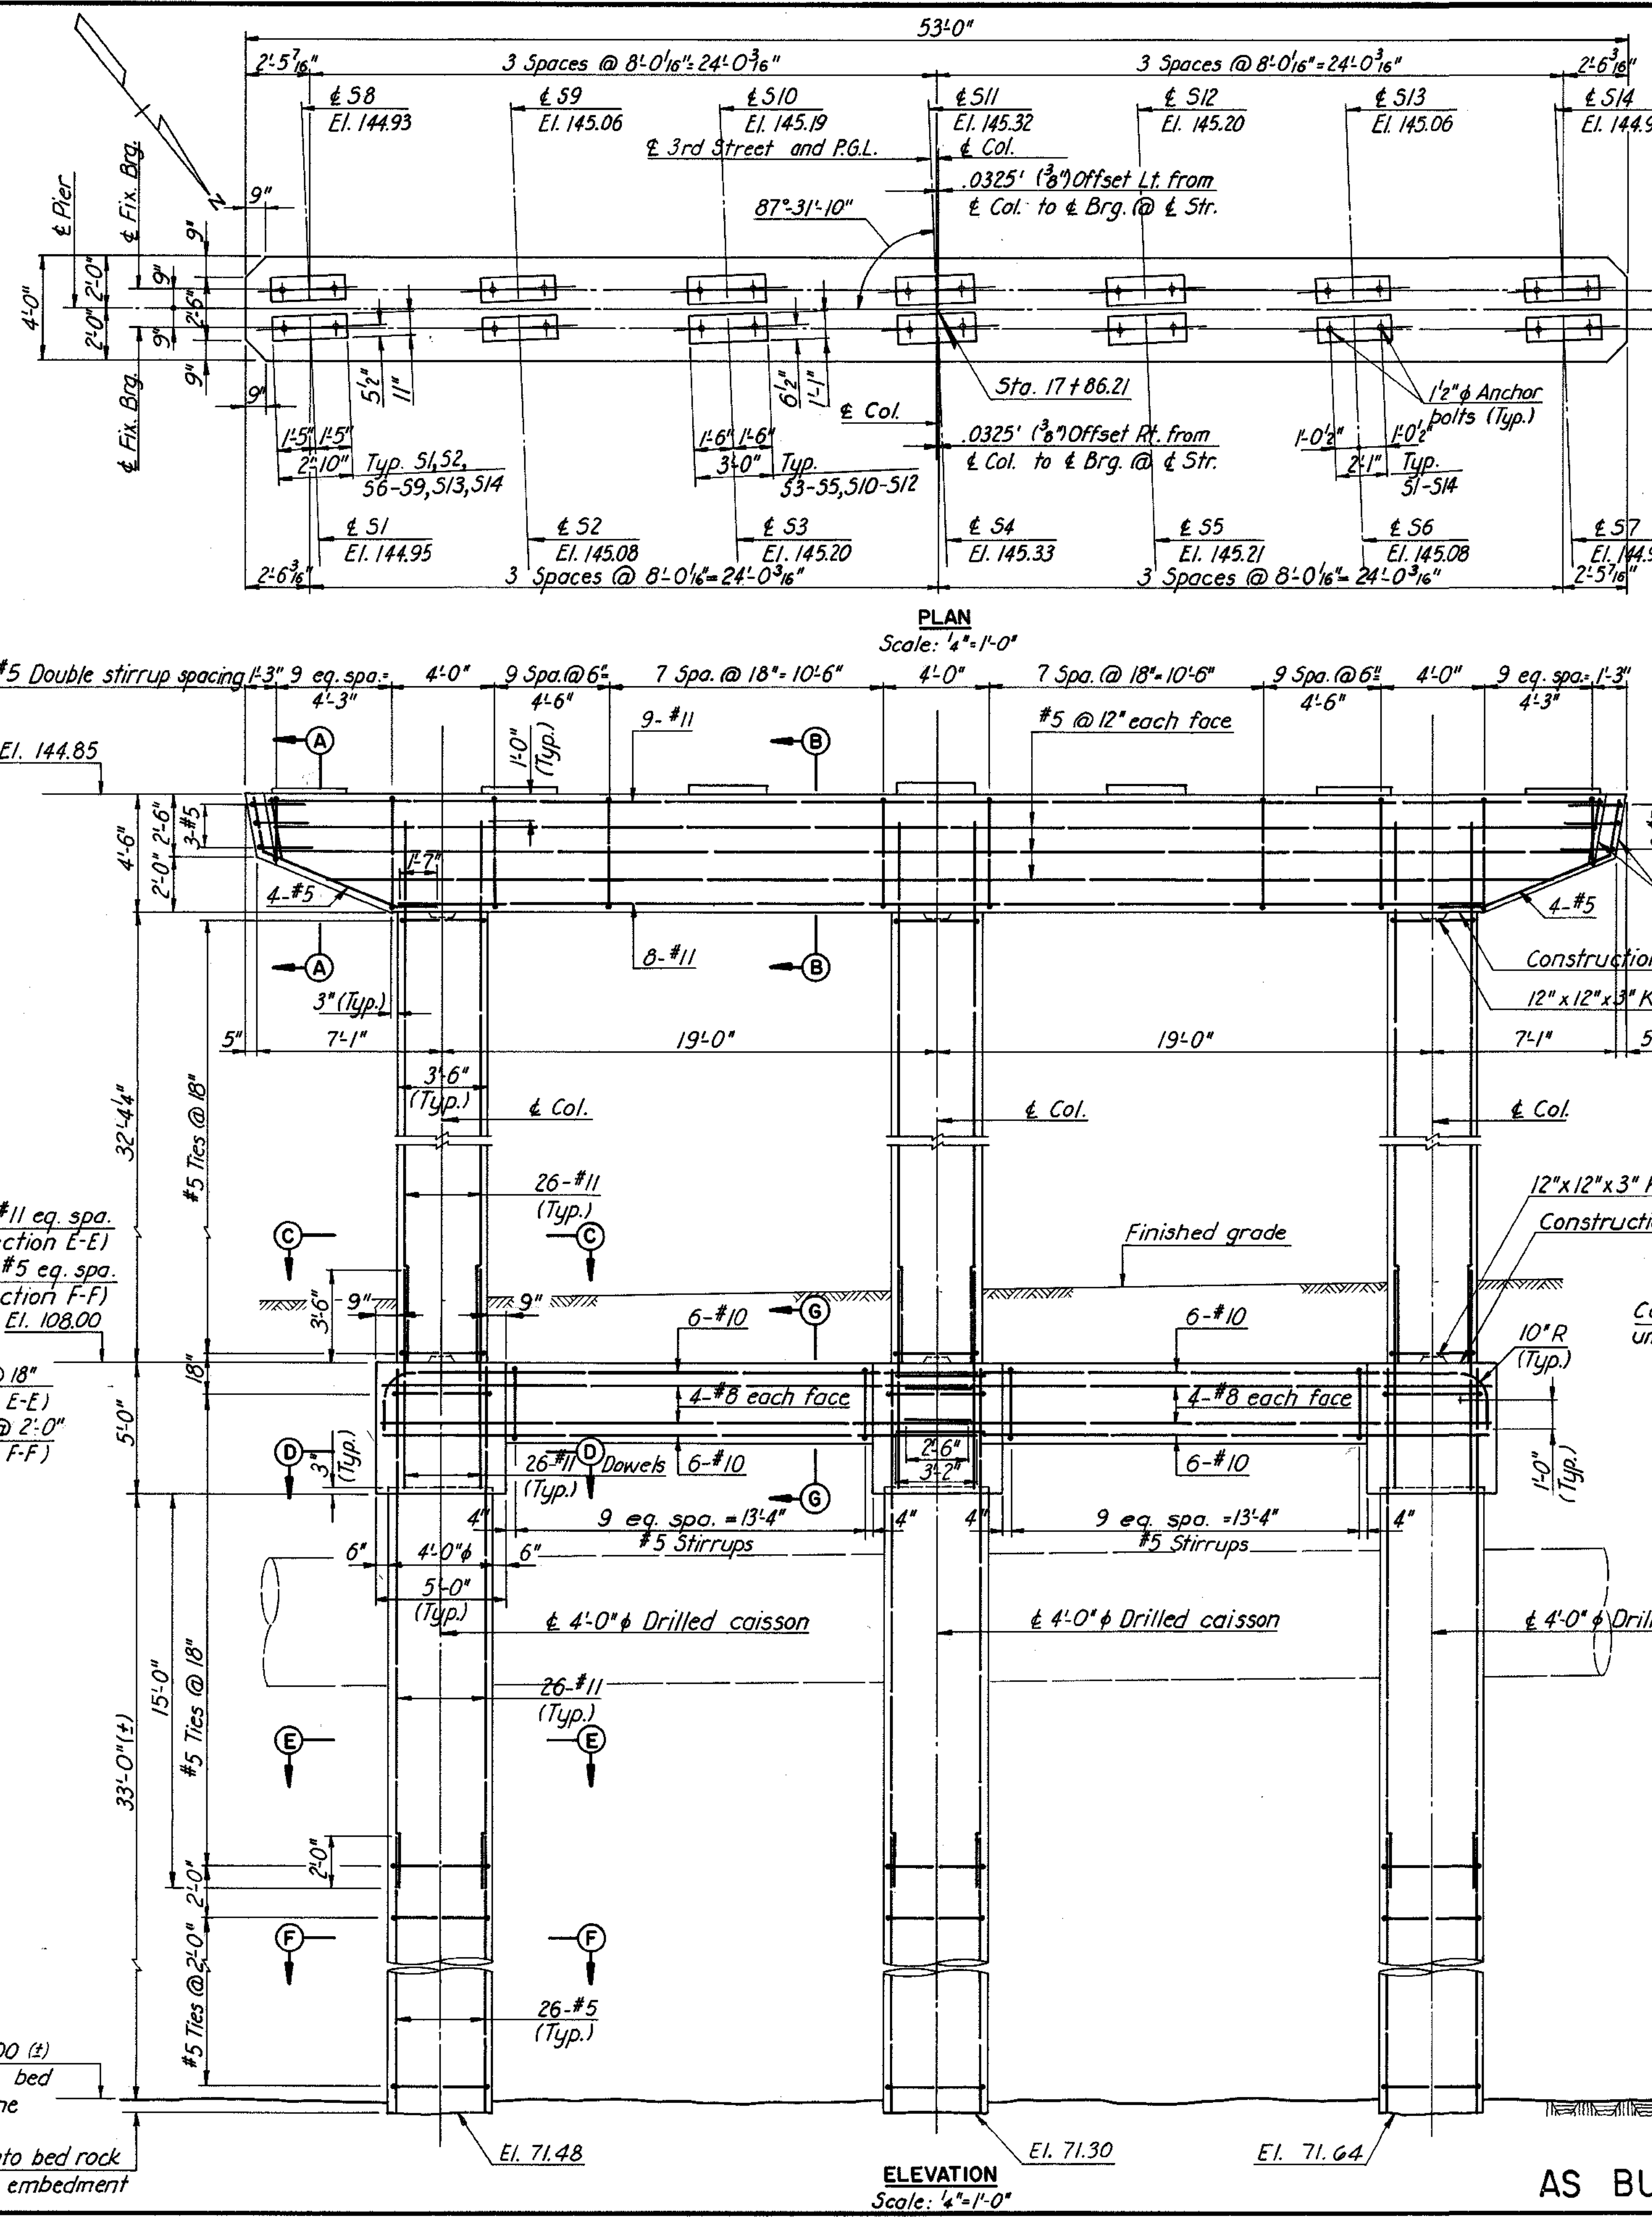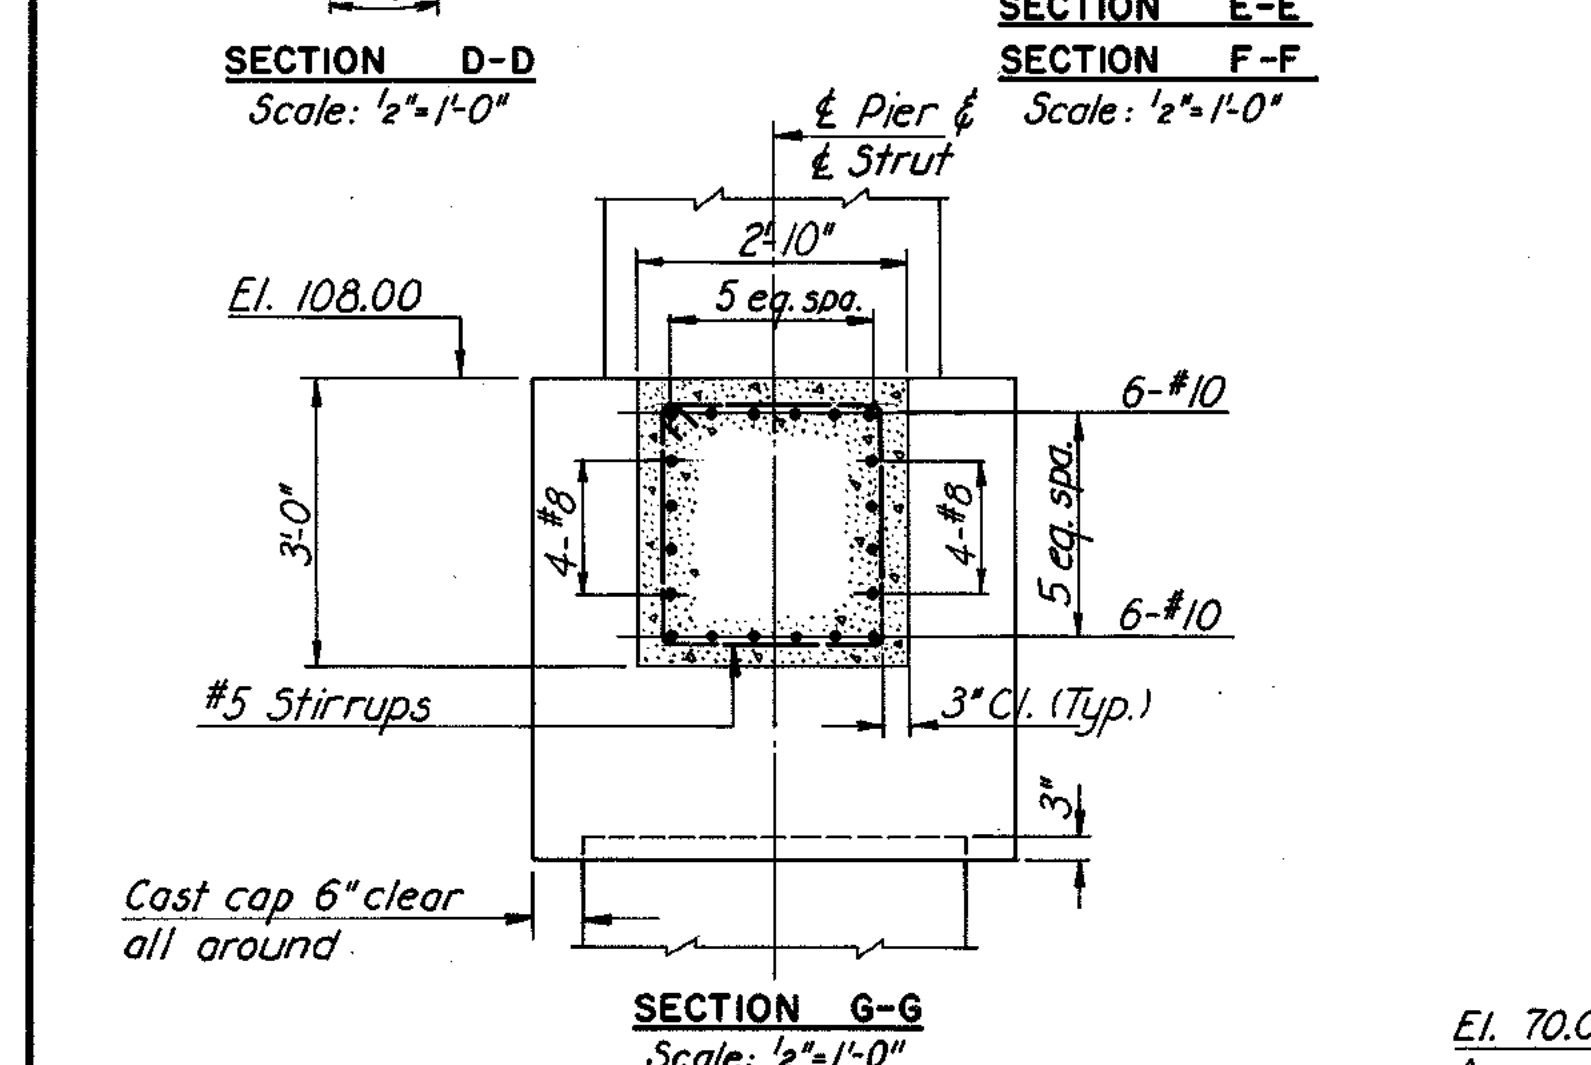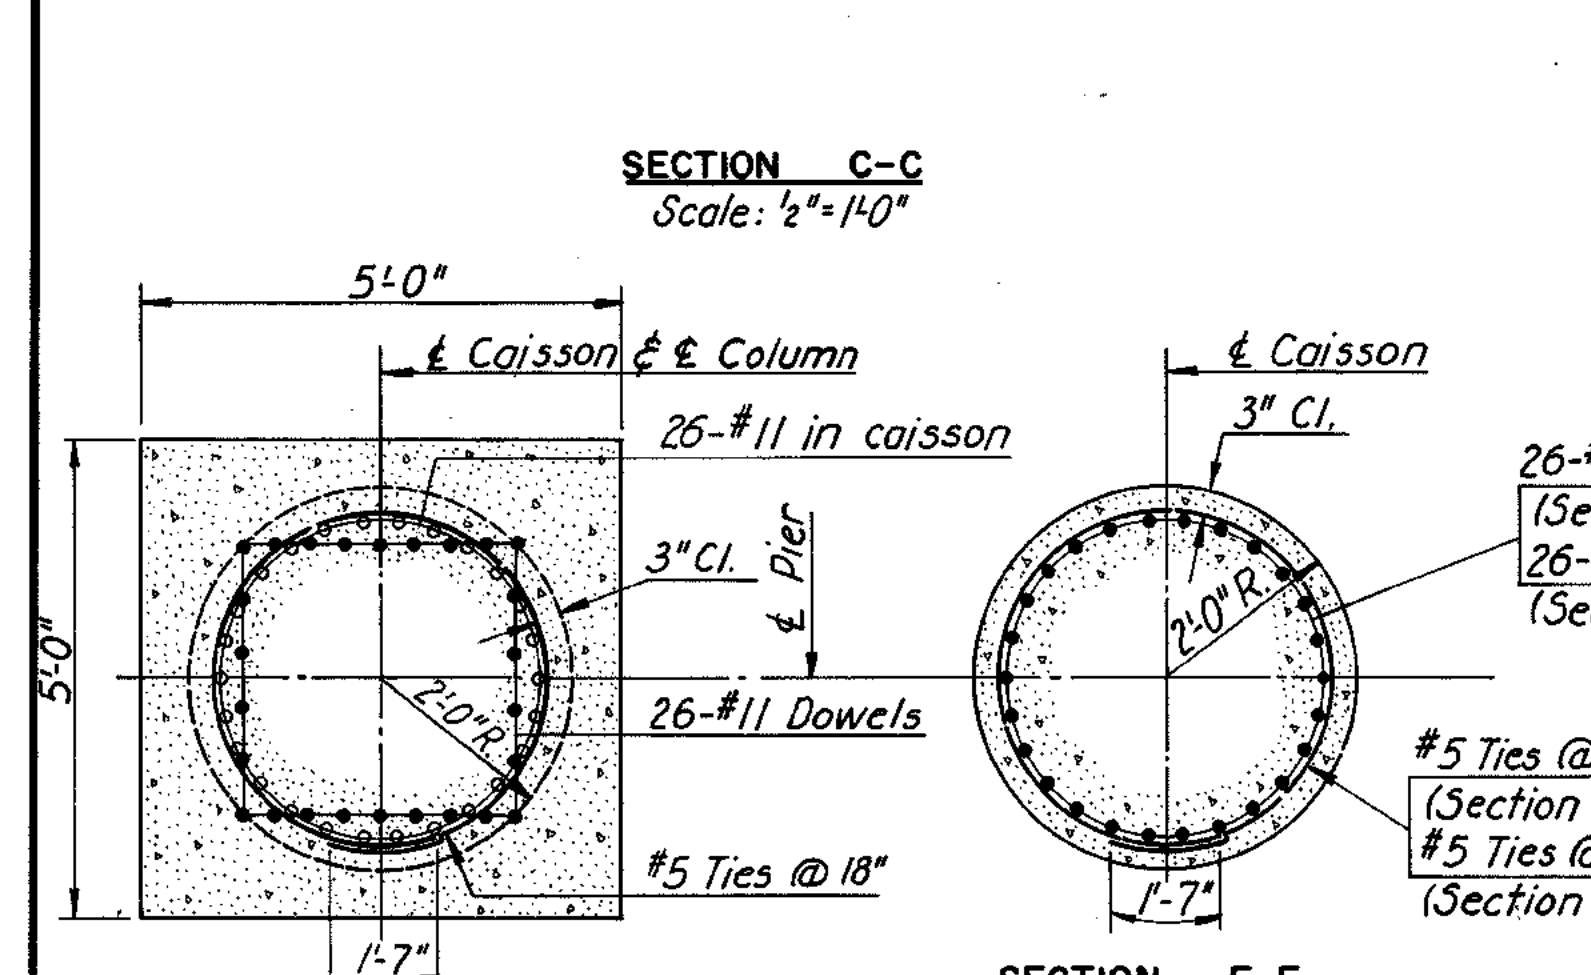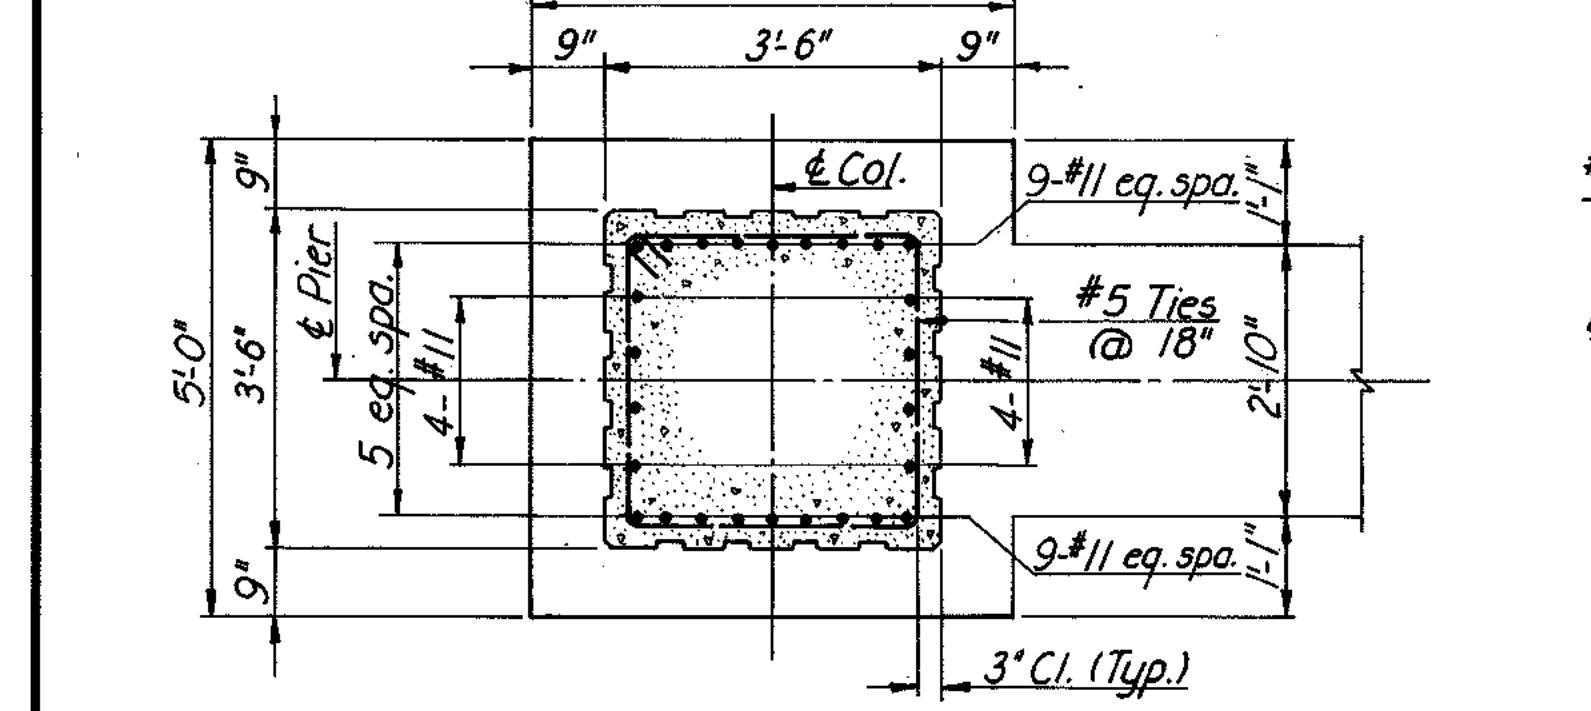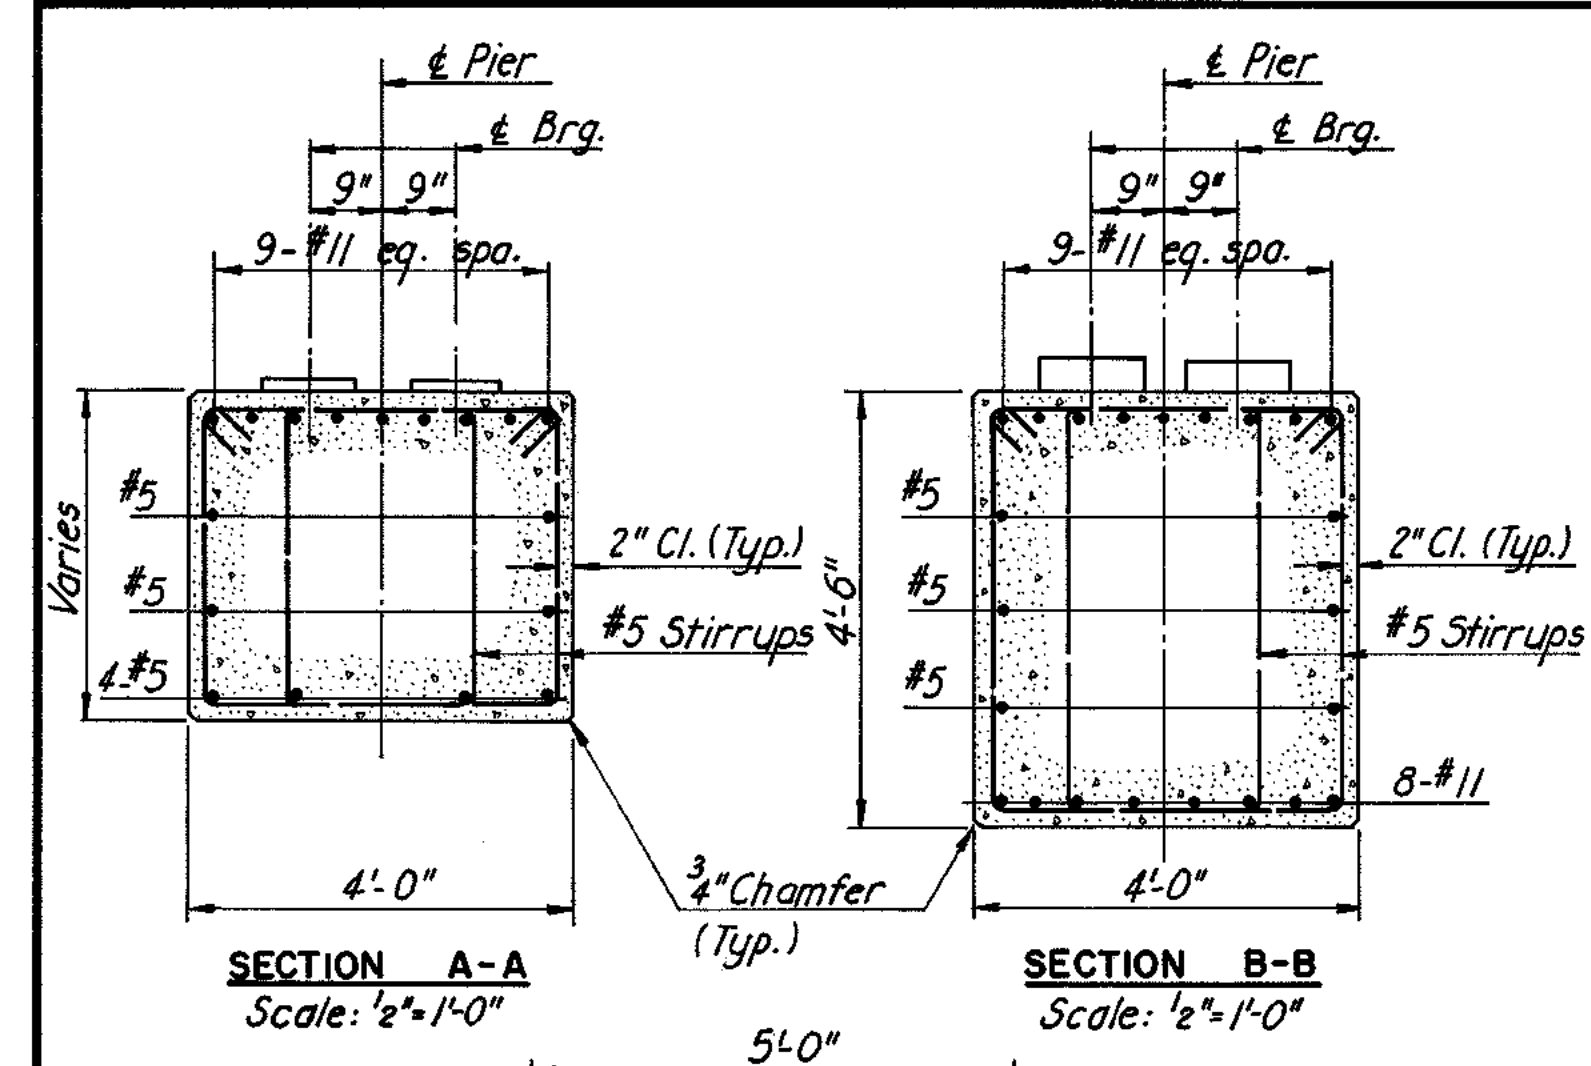

**NOTES:**

For anchor bolt details and treatment of pads, see Standard Shoe Details sheet.

For details of architectural treatment of piers, see Standard Architectural Details sheet.

**FOUNDATION NOTES:**



Maximum misalignment of caissons:  
3" at top in any direction.  
6" at bottom in any direction.

The 3" of concrete caisson embedded in the cap shall be free of earth film and surface laitance.

Bed rock elevation is approximate and may vary. Vertical caisson reinforcing shall not be cut until this elevation is established for each caisson.

Caissons are designed for an allowable rock bearing pressure of 30 tons per square foot.

BY	DATE				
MADE	1-68				
CHECKED	2-68	1	As Built	TEM	6-77
IN CHARGE	P.R.Y.	NO.	REVISION	BY	DATE

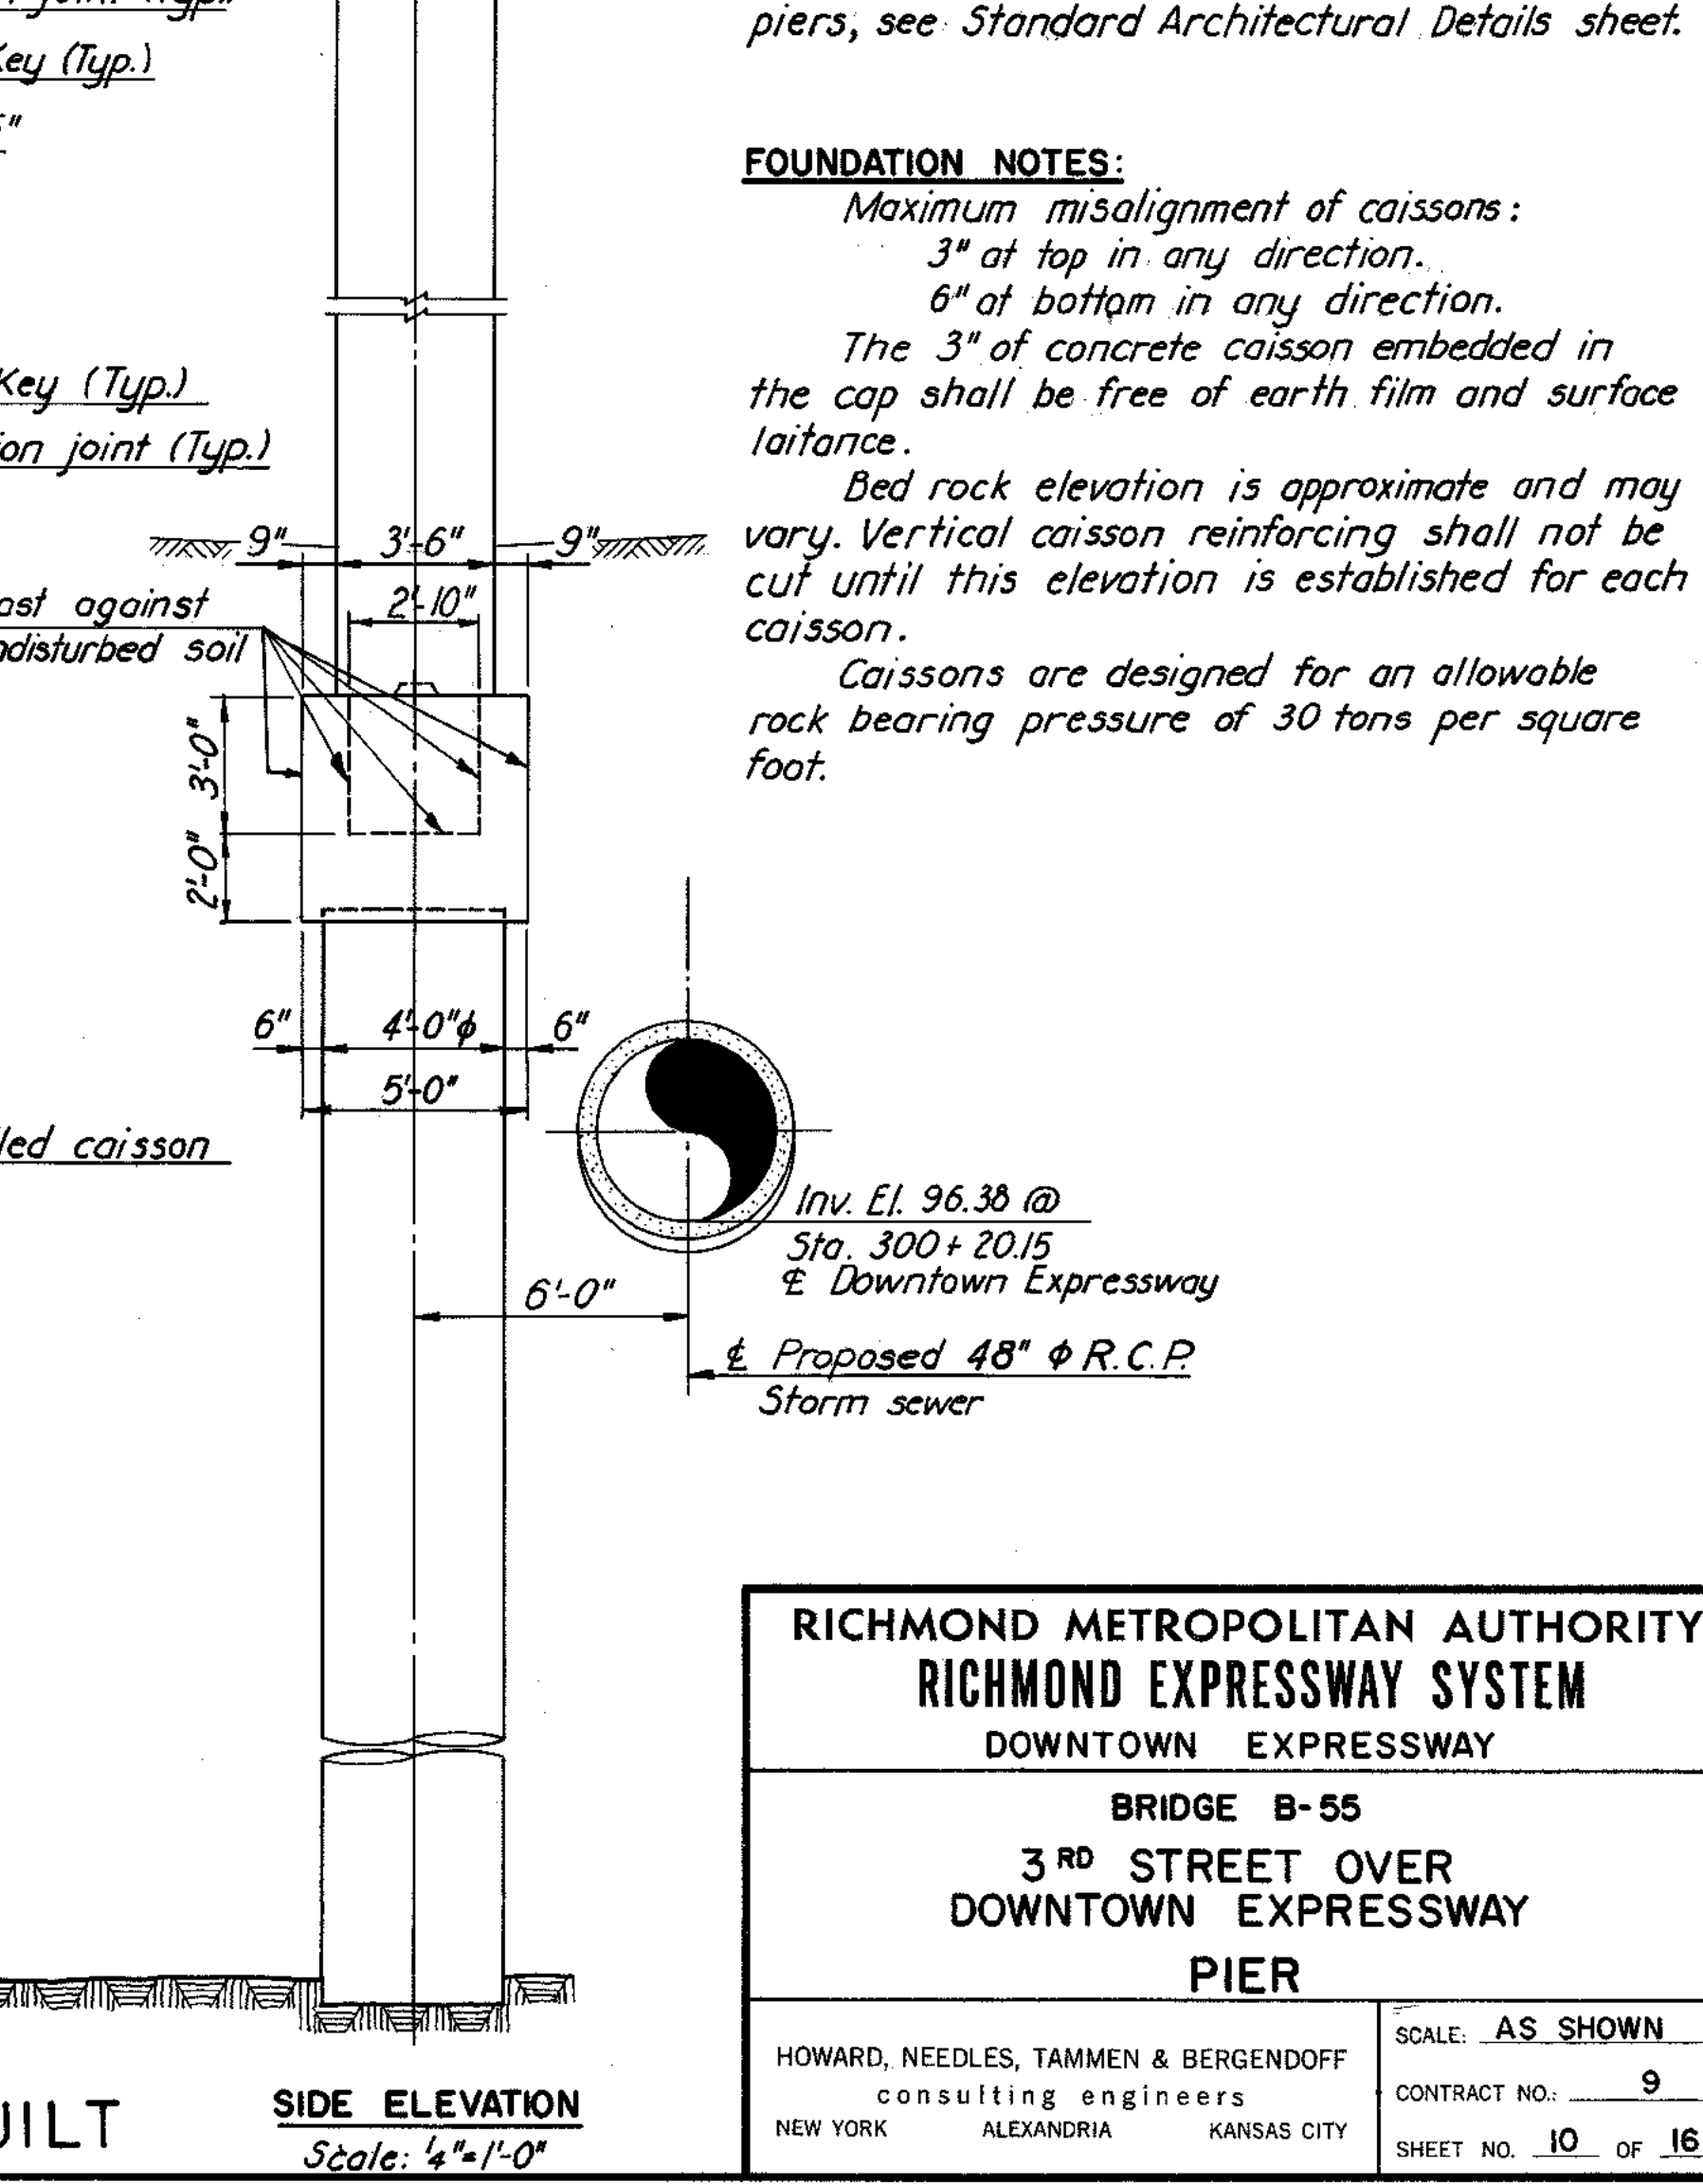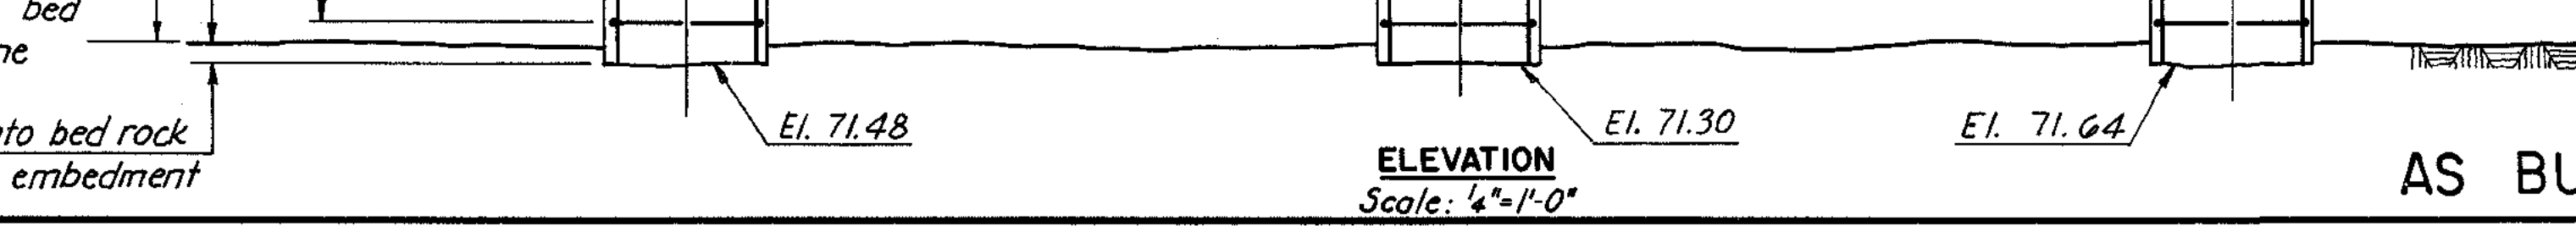


**RICHMOND METROPOLITAN AUTHORITY**  
**RICHMOND EXPRESSWAY SYSTEM**  
DOWNTOWN EXPRESSWAY

**BRIDGE B-55**  
**3RD STREET OVER**  
**DOWNTOWN EXPRESSWAY**  
**PIER**


HOWARD, NEEDLES, TAMMEN & BERGENDOFF  
consulting engineers  
NEW YORK ALEXANDRIA KANSAS CITY

SCALE: AS SHOWN  
CONTRACT NO. 9  
SHEET NO. 10 OF 16



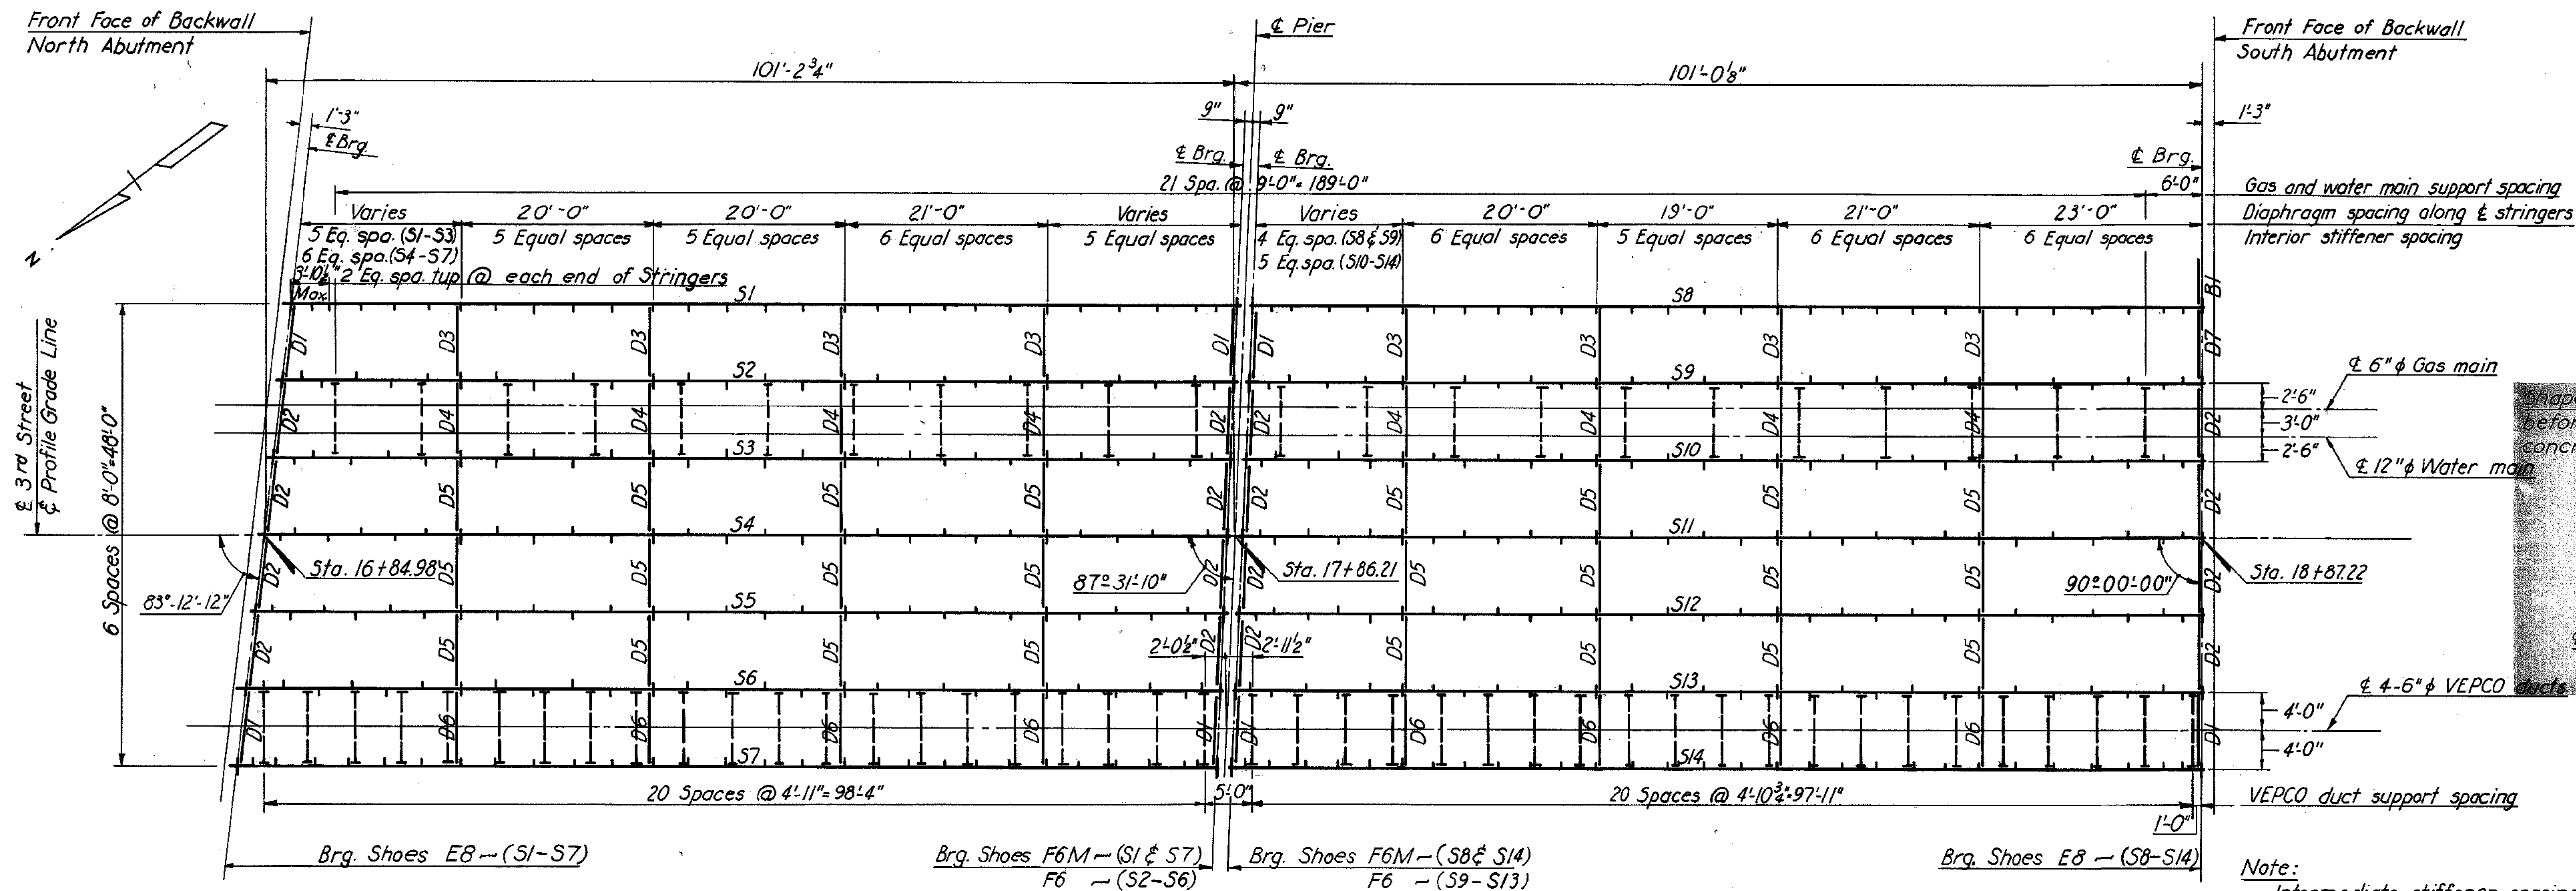


SHOE SCHEDULE			
EXPANSION SHOES		FIXED SHOES	
TYPE	NO. REQD.	TYPE	NO. REQD.
E8	14	F6M	4
		F6	10

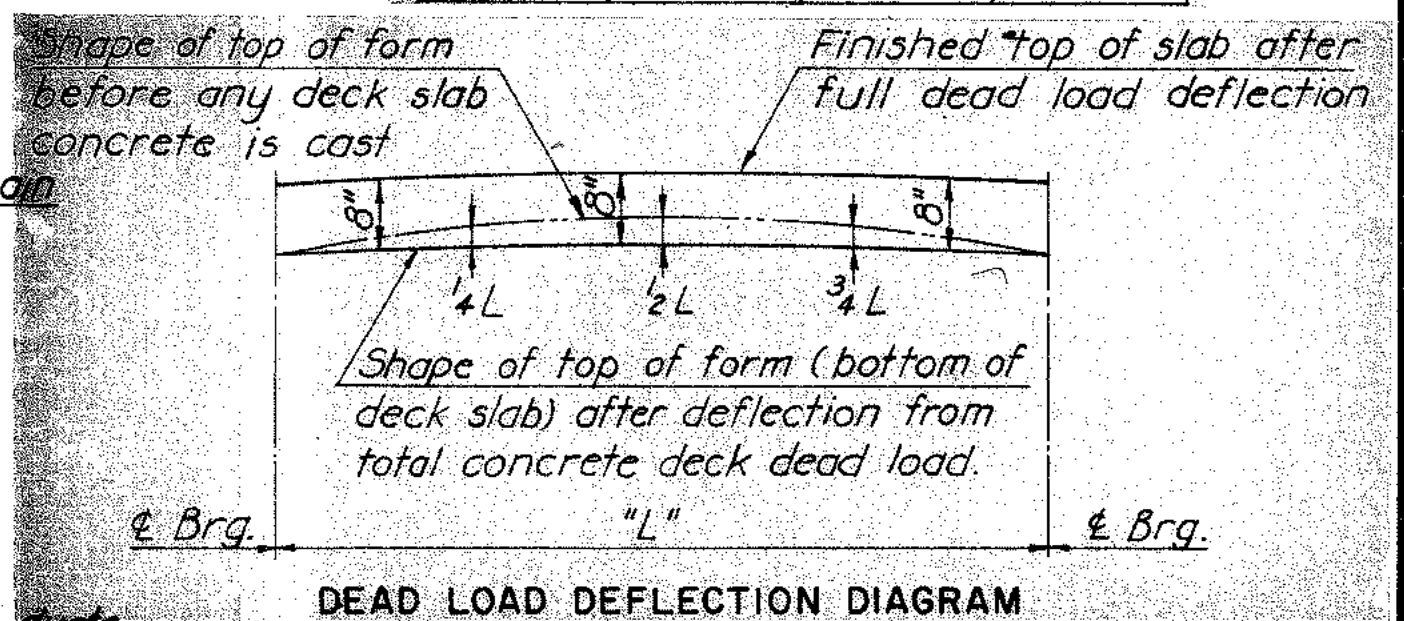


DEFLECTION SCHEDULE					
STR.	1/4 L	1/2 L	STR.	1/4 L	1/2 L
S1, S6, S8	1/4"	1/2"	S2, S3, S9	1/4"	1/2"
S11, S12	1/2"	2/8"	S10, S13	1/2"	2"
S14			S4, S5, S7	1/8"	2/8"

Note:  
Intermediate stiffener spacing along stringers may be varied to clear utility supports.


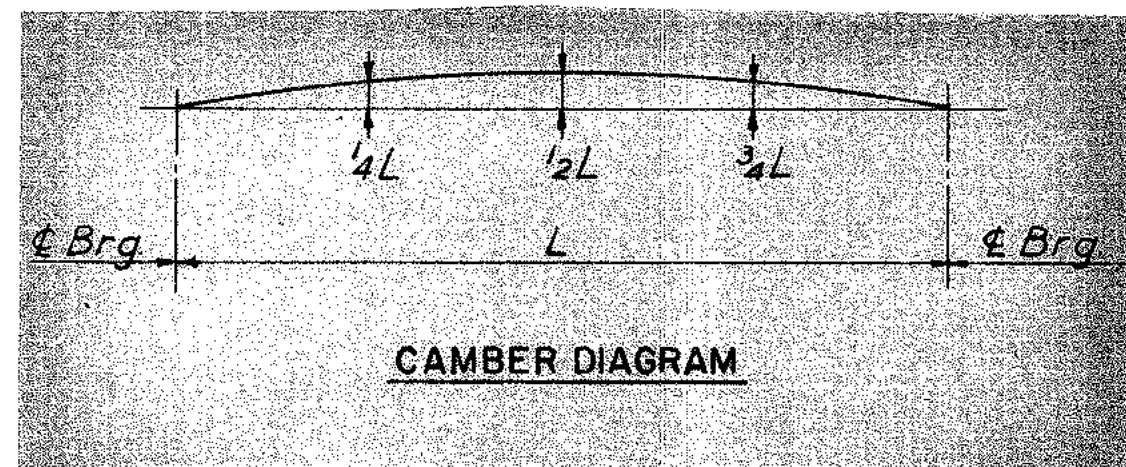


CAMBER SCHEDULE							
STR.	1/4 L	1/2 L	3/4 L	STR.	1/4 L	1/2 L	3/4 L
S1-S3				S4-S5	2"	2 1/2"	2"
S6	2"	2 1/2"	2"	S7		2 1/2"	2"
S8-S14							

NOTE TO FABRICATOR:  
The above stringers shall be fabricated with an upward camber amounting to the tabulated value.  
This will provide approximate compensation for deflection under full dead load and for conformity with finished grade.  
Dimensions are in inches.

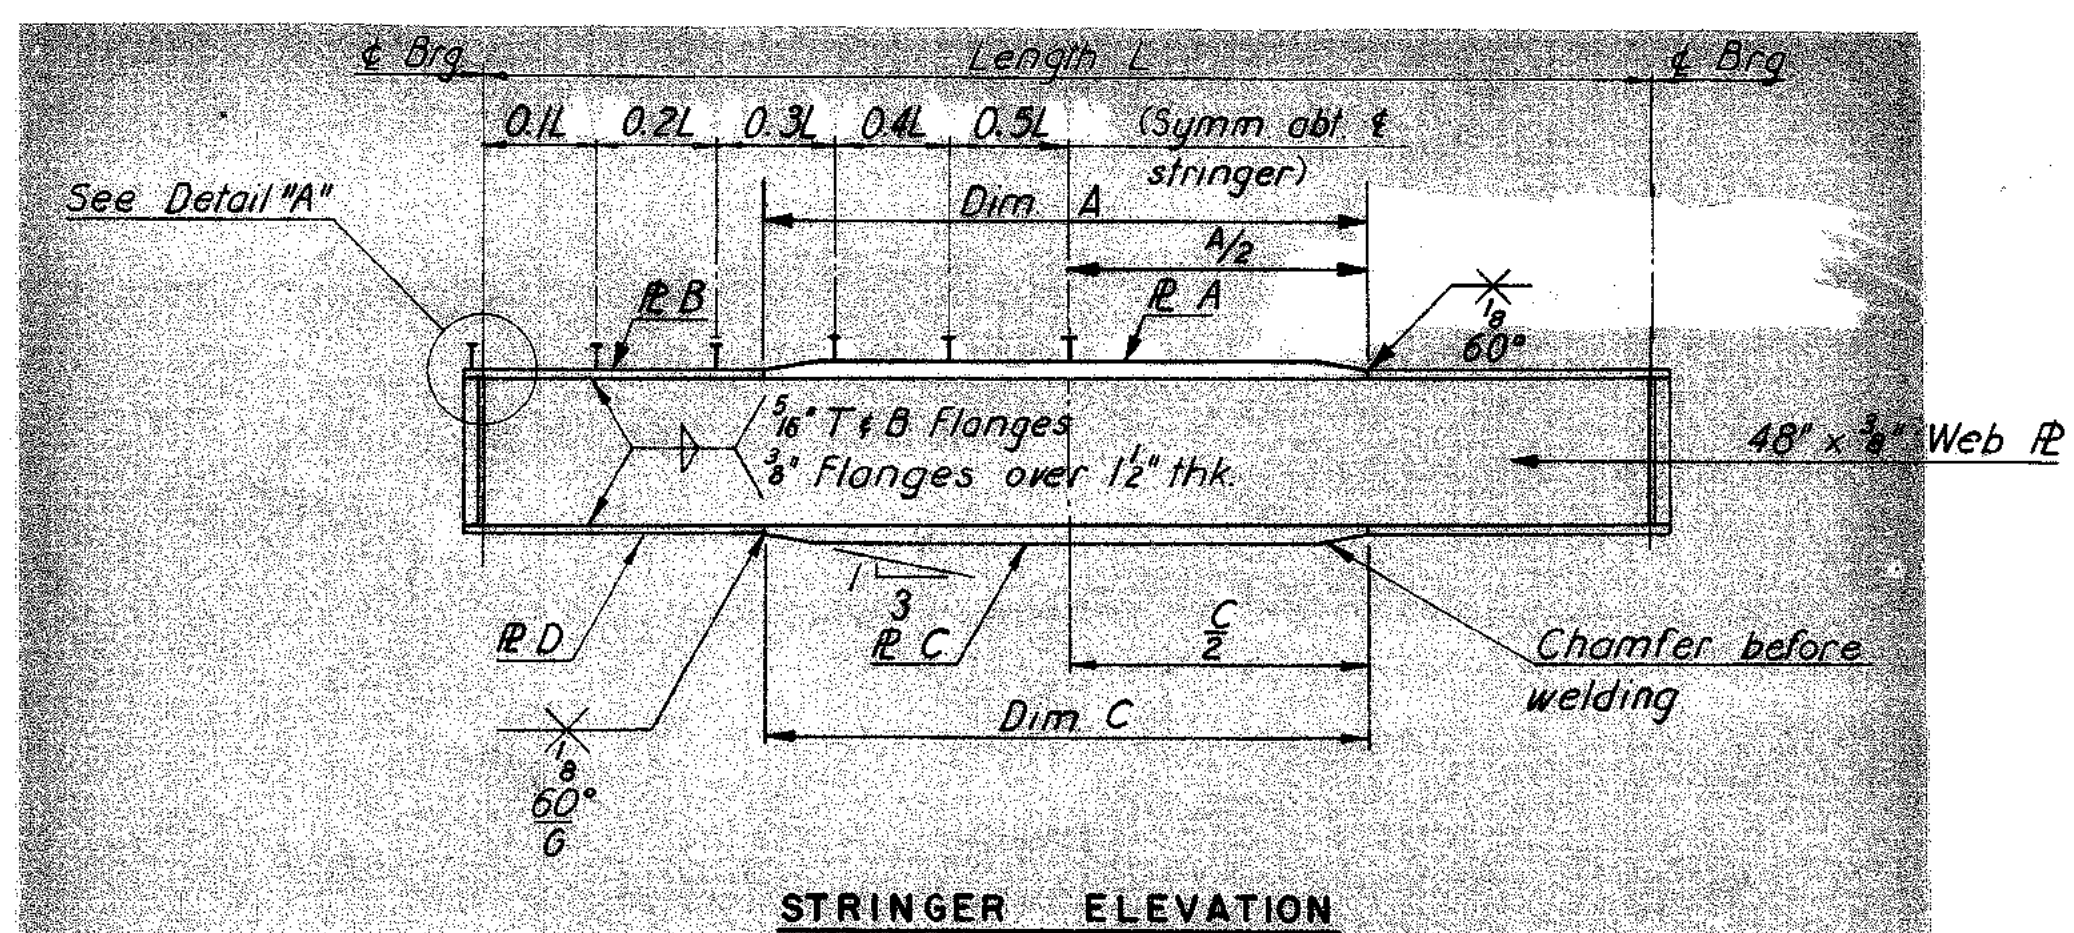


STRINGER SCHEDULE											
STR.	LENGTH Brg. to Brg.	R A	DIM A	R B	R C	DIM C	R D	SHEAR STUD SPACING			
								0.1L	0.2L	0.3L	0.4L 0.5L
S1	98'-7 1/4"	16 x 1 1/4	53'-0"	16 x 7/8	20 x 1 1/2	63'-0"	20 x 1 1/4	9"	10 1/2"	13 1/2"	18" 21"
S2	98'-3 3/8"	16 x 1 3/8	57'-0"			64'-0"		10"	11 1/2"	14"	18" 20"
S3	99'-10 1/2"	16 x 1 3/8	57'-0"								18" 20"
S4	100'-5 3/4"	16 x 1 1/4	53'-0"								17 1/2" 19 1/2"
S5	101'-1 1/8"	16 x 1 1/4	53'-0"		20 x 1 1/2	64'-0"	20 x 1 1/4				17 1/2" 19 1/2"
S6	101'-8 5/16"	16 x 1 3/8	59'-0"	16 x 7/8	20 x 2	62'-0"	20 x 1 3/8	10"	11 1/2"	14"	17 1/2" 20"
S7	102'-3 5/8"	16 x 1 1/2	57'-0"	16 x 1	20 x 2 1/2	66'-0"	20 x 1 3/8	9"	10 1/2"	13 1/2"	18" 22"
S8	99'-2 3/8"	16 x 1 1/4	53'-0"	16 x 3/4	20 x 1 1/2	63'-0"	20 x 1 1/4	9"	10 1/2"	13 1/2"	18" 21"
S9	99'-6 3/16"	16 x 1 3/8	57'-0"			64'-0"		10"	11 1/2"	14"	18" 20"
S10	99'-10 1/16"	16 x 1 3/8	57'-0"			64'-0"					18" 20"
S11	100'-3 5/8"	16 x 1 1/4	52'-0"			63'-0"					17 1/2" 19 1/2"
S12	100'-7 7/8"	16 x 1 1/4	52'-0"		20 x 1 1/2	63'-0"	20 x 1 1/4			14"	17 1/2" 19 1/2"
S13	100'-11 7/16"	16 x 1 3/8	58'-0"	16 x 3/8	20 x 2	61'-0"	20 x 1 3/8	10"	11 1/2"	13 1/2"	18" 20"
S14	101'-3 3/8"	16 x 1 1/2	55'-0"	16 x 1	20 x 2 1/2	65'-0"	20 x 1 3/8	9"	11"	13 1/2"	18" 22"

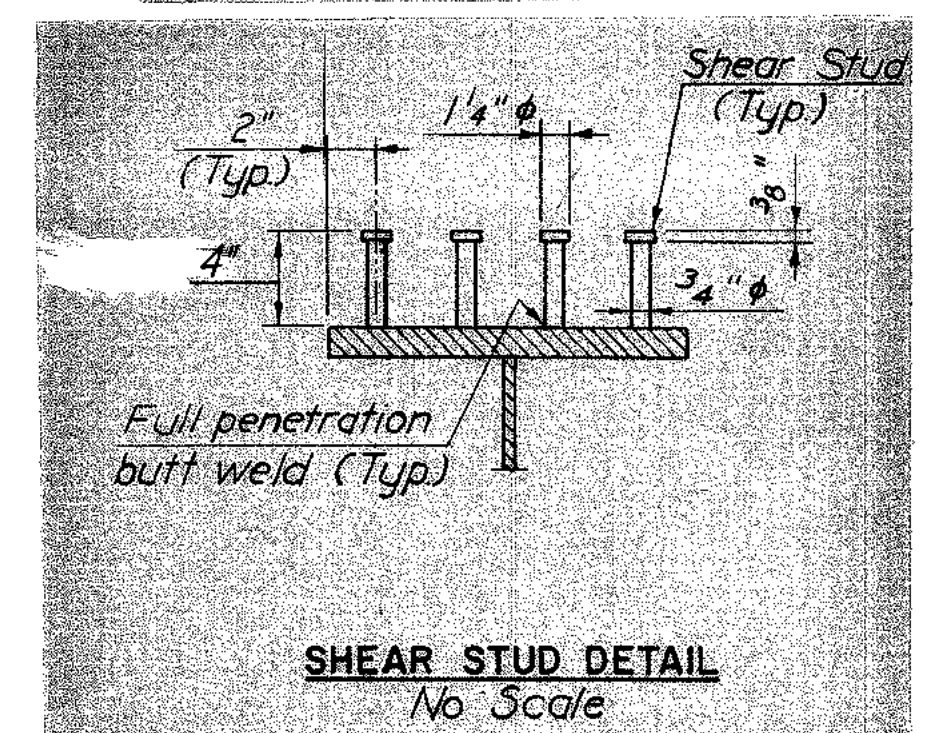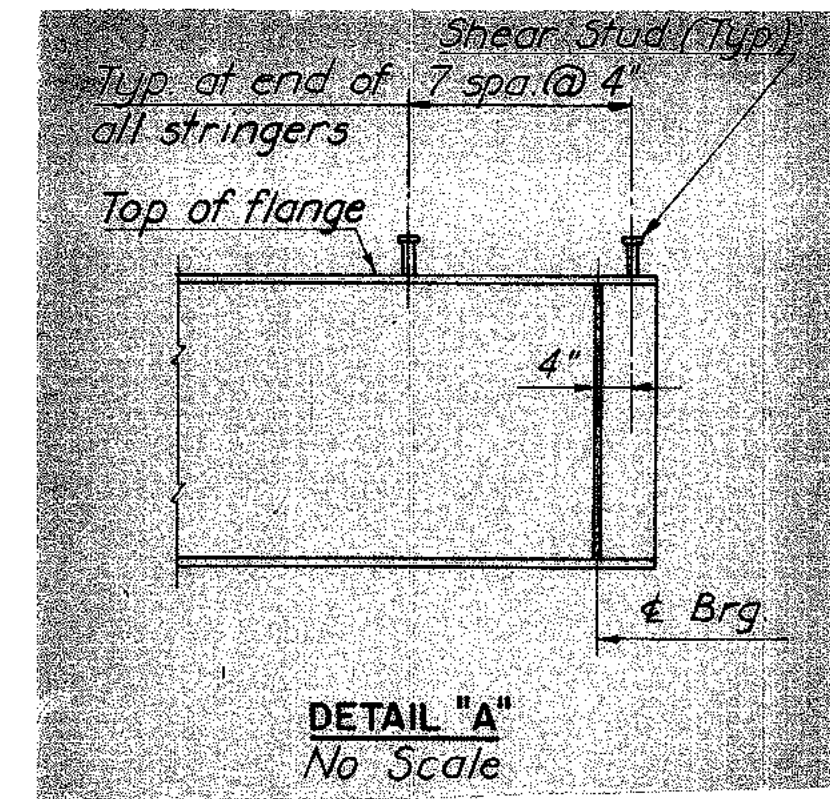

SHEAR STUD NOTE:  
Capacity = 3,400 lbs. per stud.  
The contractor may, if he elects, use three 3/4" diameter studs at the same longitudinal spacing in lieu of the four 3/4" diameter studs shown.  
Stud rows shall be placed parallel to the main deck reinforcing.  
Shear stud spacing shown is maximum spacing.

NOTE TO CONTRACTOR:  
The above deflections are those anticipated to occur in the stringer upon placement of the total concrete deck dead load.  
In practice, the stringers in place are not likely to have the exact camber to compensate for these deflections during construction. The residual amounts shall be provided for by adjusting forms to vary the thickness of the concrete bolter between the bottom of the slab and the top of stringer, without alteration of the slab thickness.

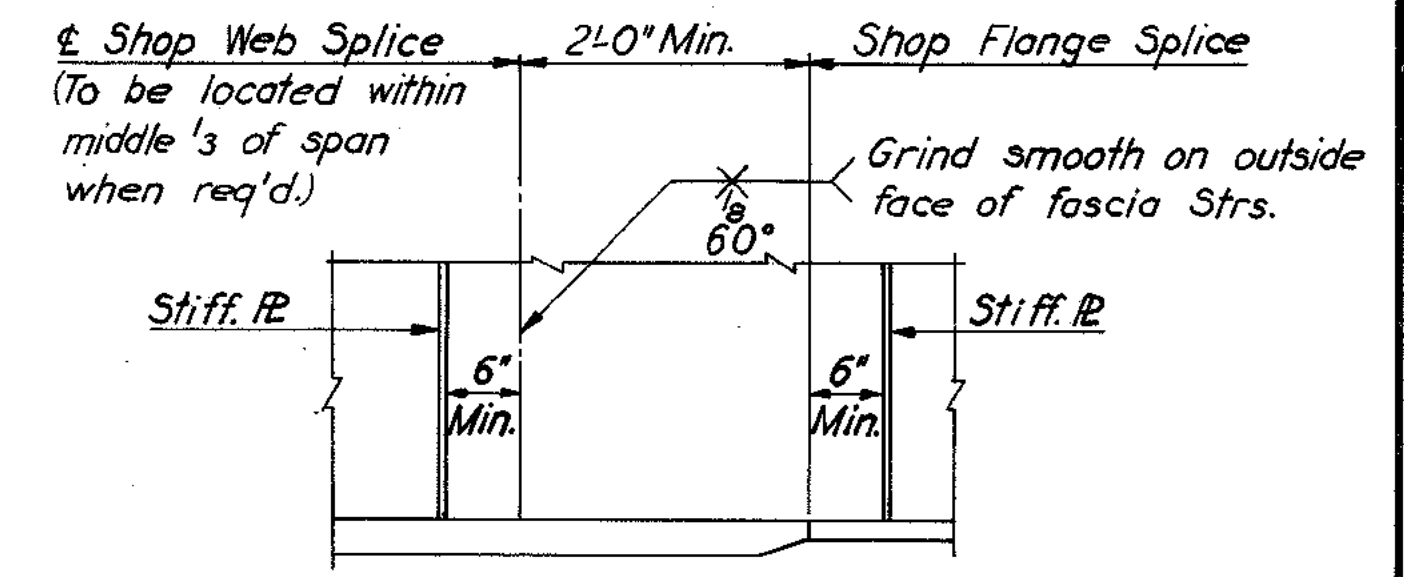

RICHMOND METROPOLITAN AUTHORITY  
RICHMOND EXPRESSWAY SYSTEM  
DOWNTOWN EXPRESSWAY  
BRIDGE B-55  
3RD STREET OVER  
DOWNTOWN EXPRESSWAY  
FRAMING PLAN

HOWARD, NEEDLES, TAMMEN & BERGENDOFF  
consulting engineers  
NEW YORK ALEXANDRIA KANSAS CITY  
SCALE: AS SHOWN  
CONTRACT NO. 9  
SHEET NO. 11 OF 16

AS BUILT

BY	DATE				
MADE	EVR	12-14			
CHECKED	TEM	2-68	1	As Built	TEM 6-77
IN CHARGE	PRY		NO.	REVISION	BY DATE









**Bridge 56**

**4<sup>th</sup> Street**

**Over**

**Downtown Expressway (VA 195)**



**Record Set Plans**







RICHMOND EXPRESSWAY SYSTEM			
SECTION	PROJECT	SHEET NO.	TOTAL SHEETS
9	DOWNTOWN EXPRESSWAY	155	

INDEX	
NO.	DESCRIPTION
1	General Plan and Elevation
2	General Notes and Quantities
3	North Abutment
4	North Abutment Details
5	South Abutment
6	South Abutment Details (1)
7	South Abutment Details (2)
8	South Abutment Details (3)
9	Pier
10	Framing Plan
11	Cross Section and Utility Details
12	Deck Plans
13	Joint Details
14	Approach Slabs and Slope Protection
15	Boring Logs
S1	Standard Shoe Details
S3	Standard Aluminum Railing Details (2 Rails)
S4	Standard Electrical Details (Bridges Carrying City Streets)
S7	Standard Architectural Details
S8	Standard Architectural Details
S9	Standard Architectural Details
S10	Standard Conduit Installation Details
S11	Standard Utility Support Details at Bridge Abutments

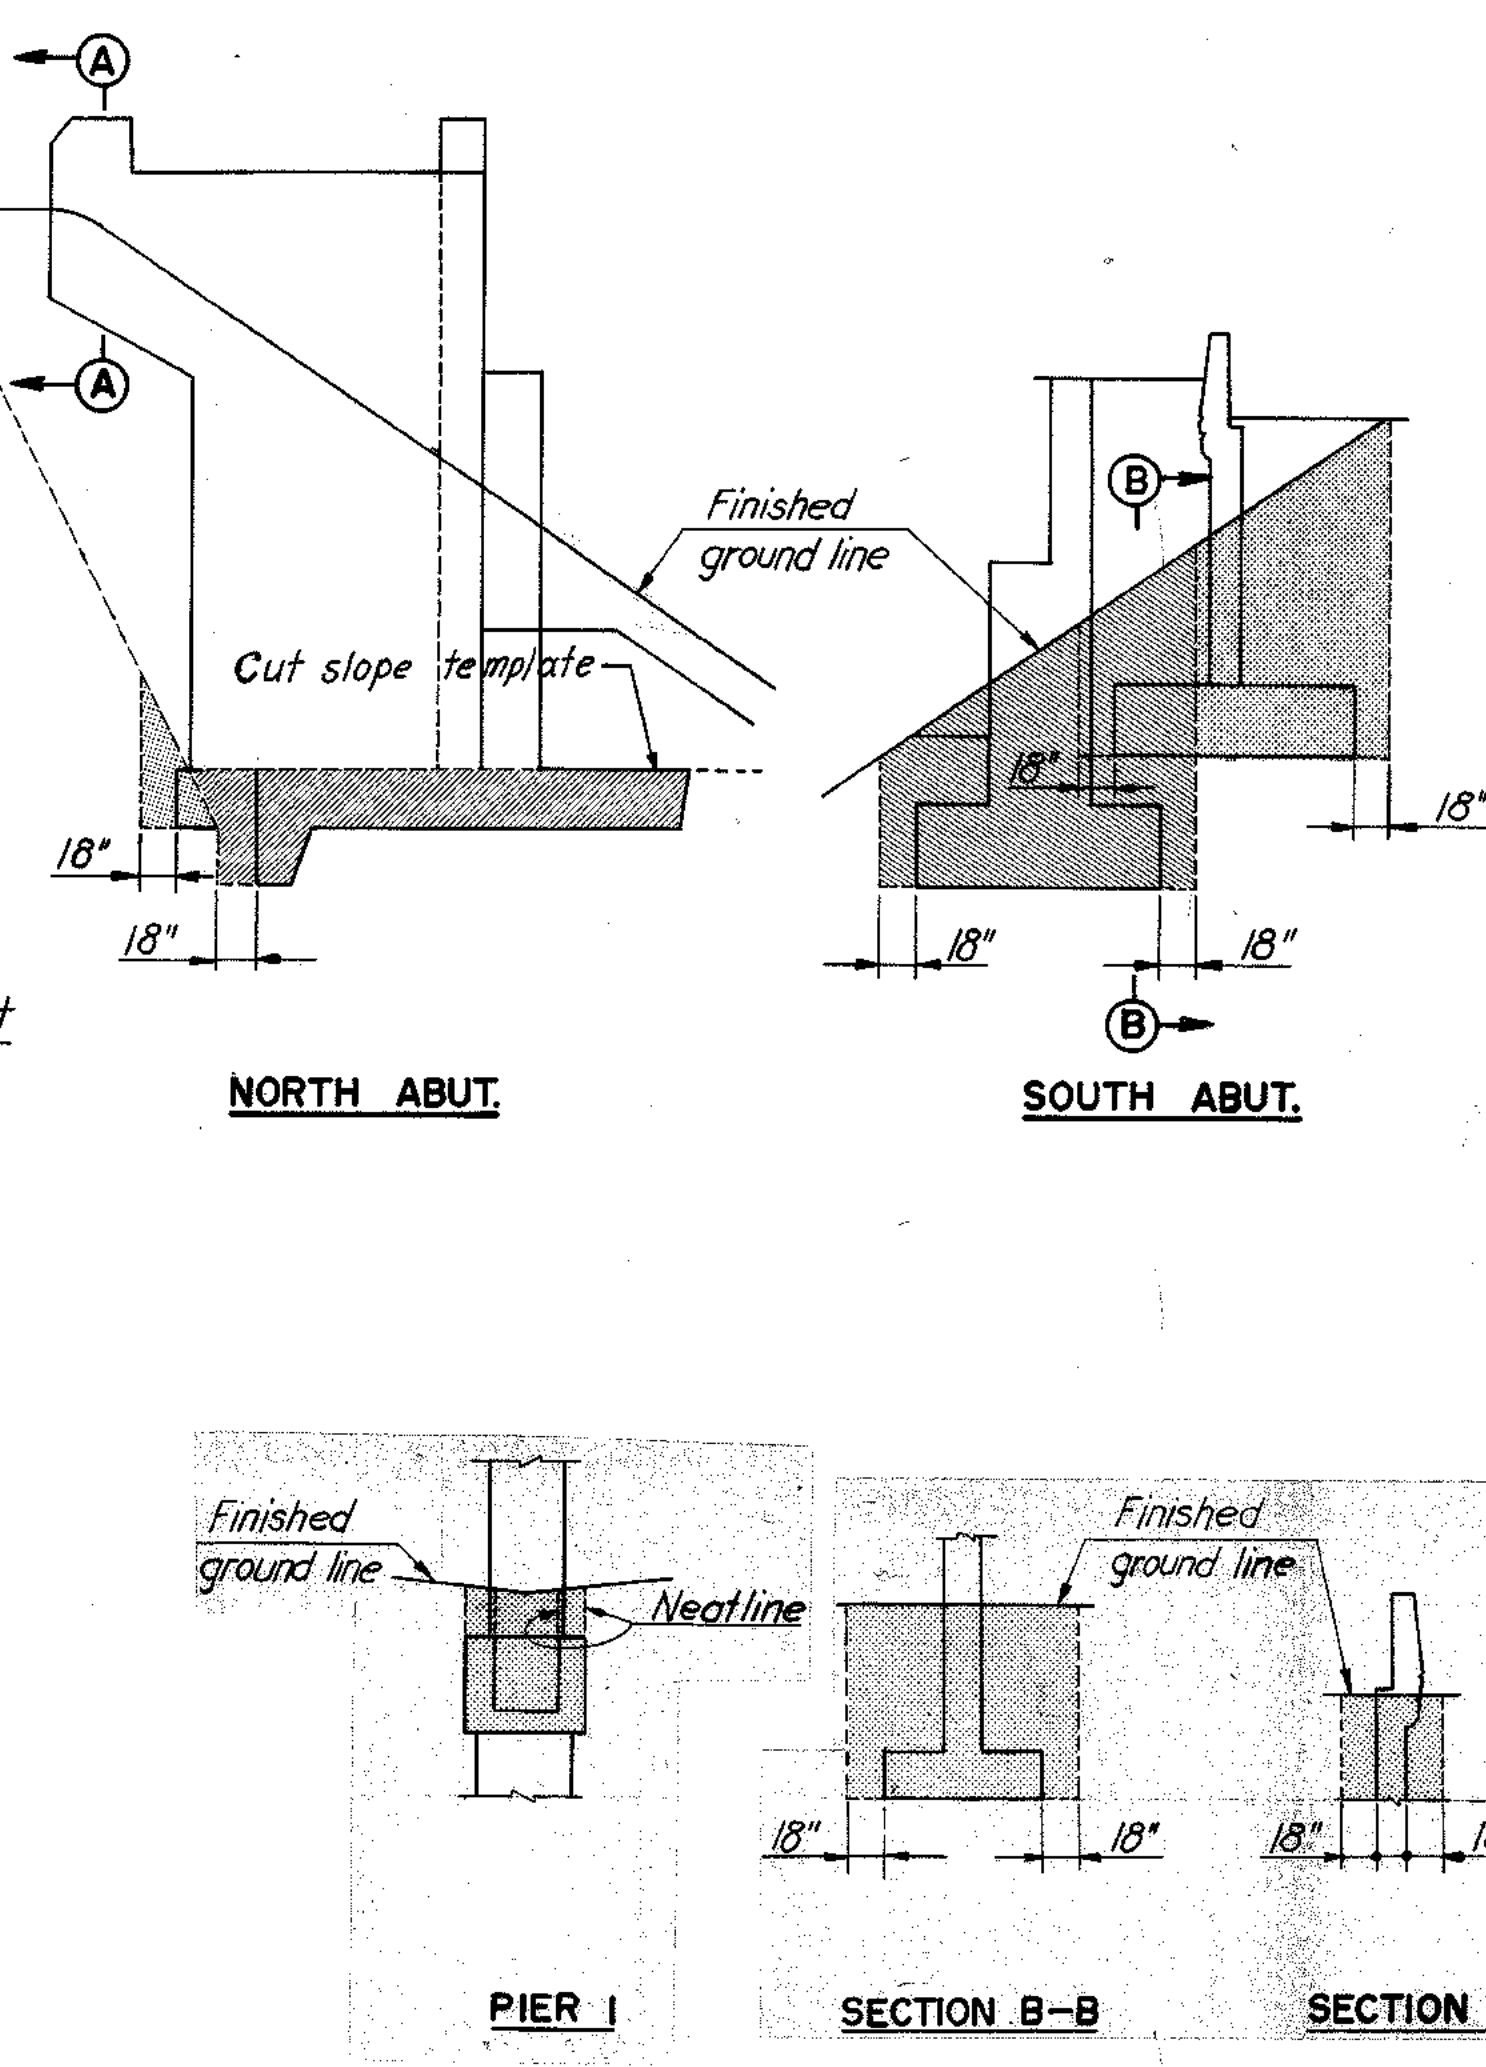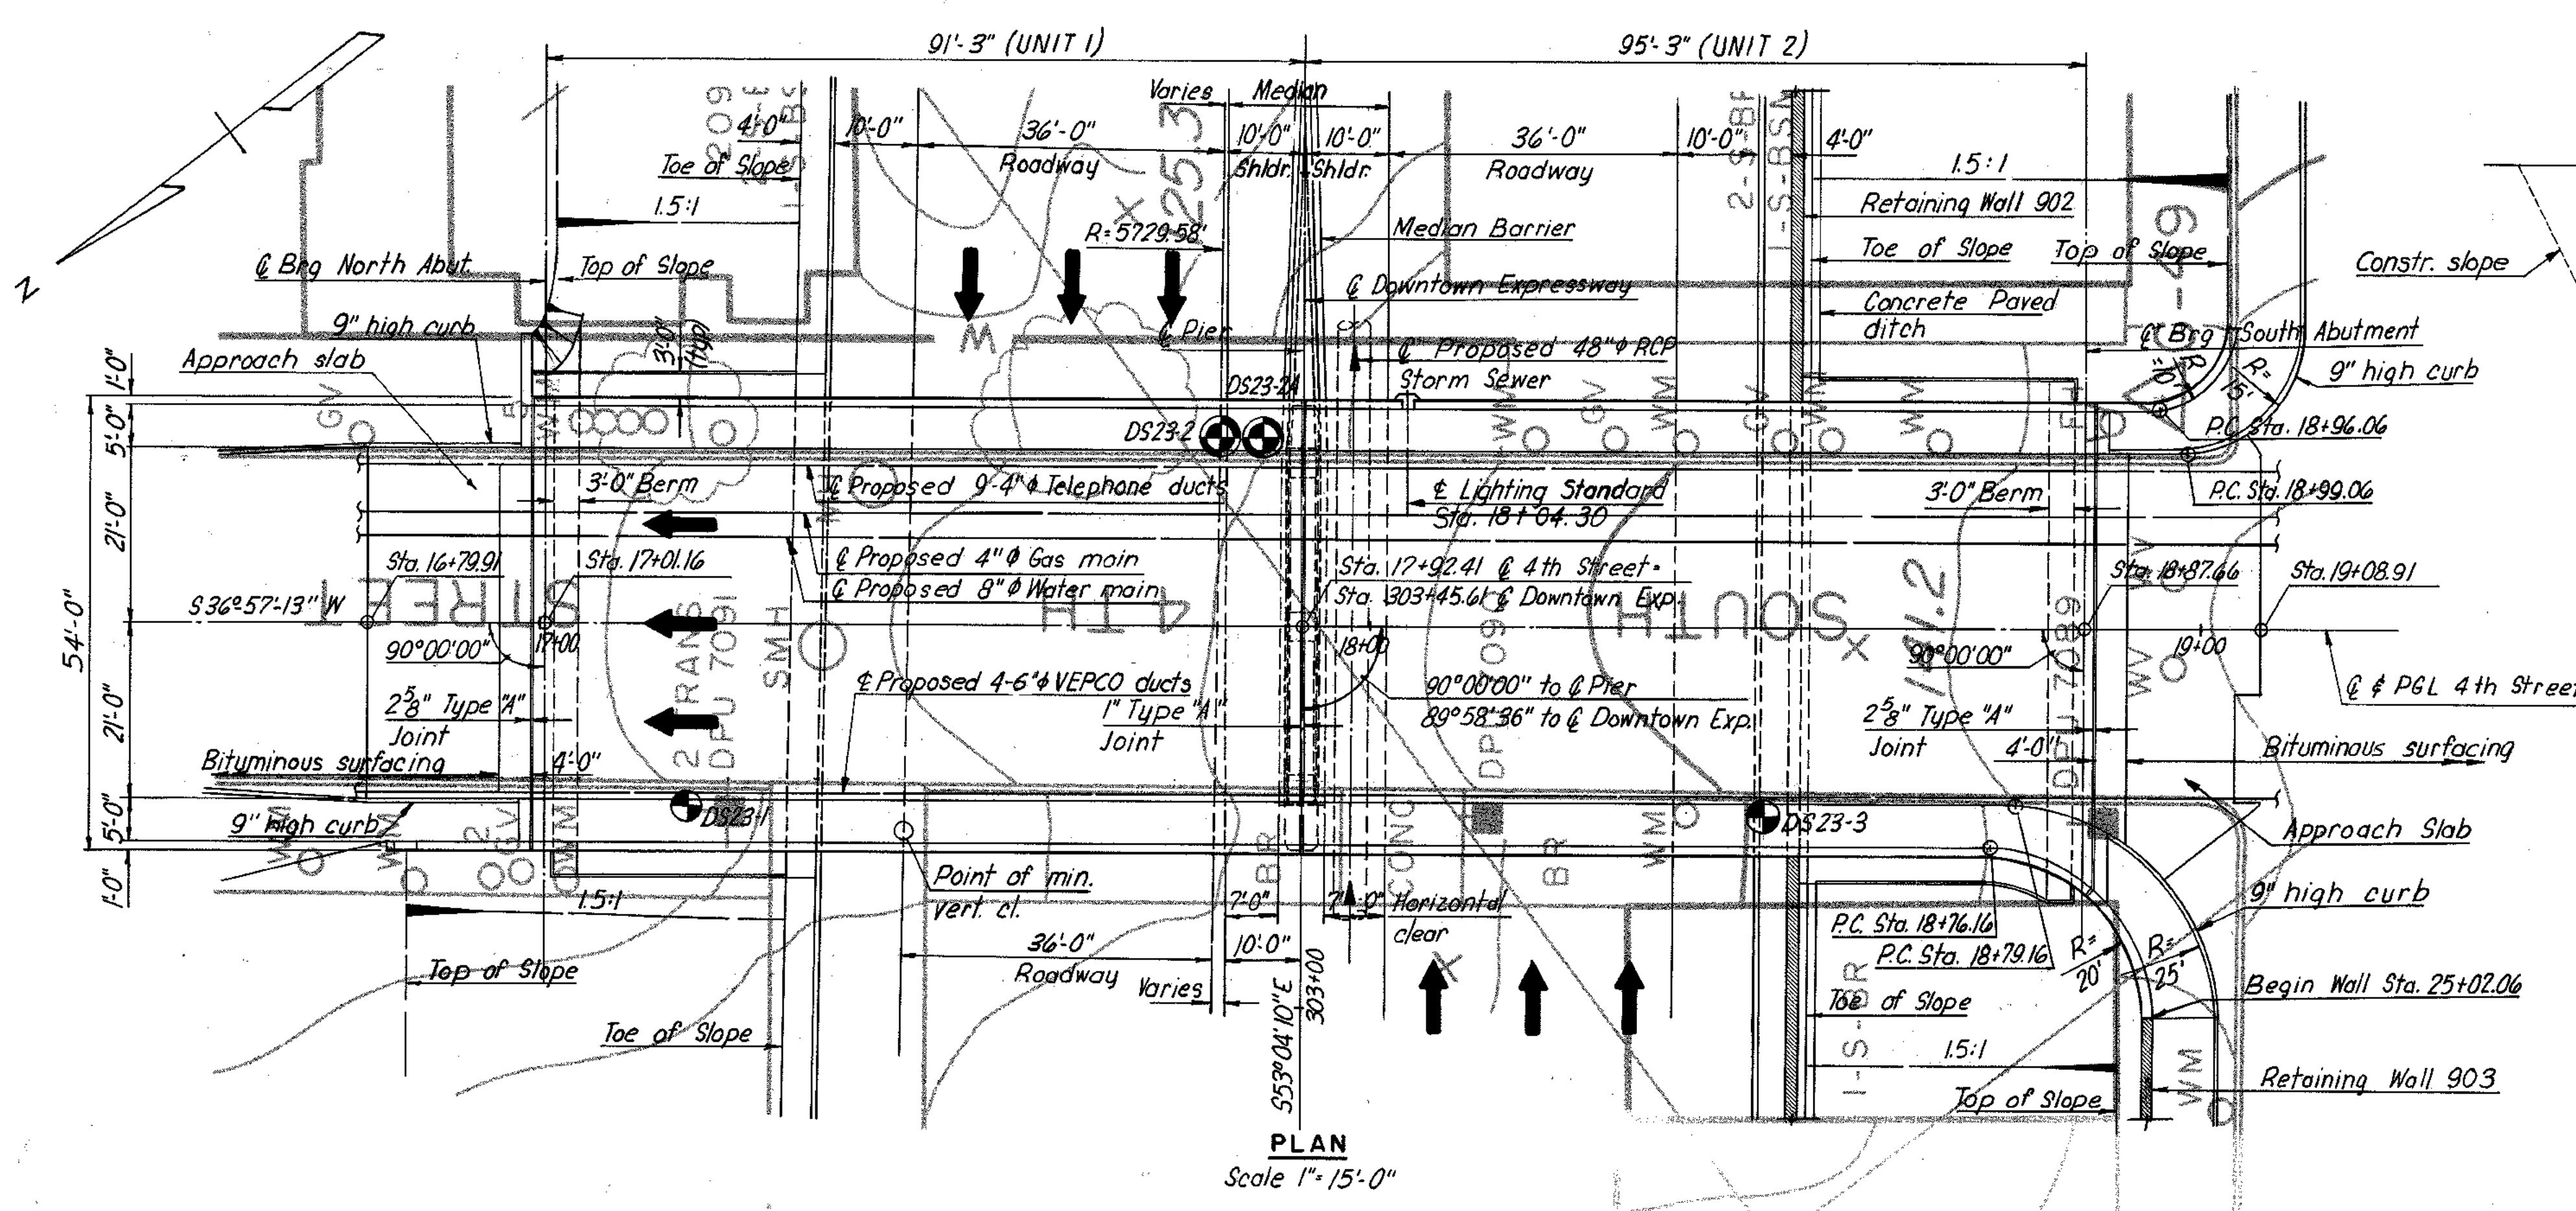

PAYMENT LIMITS FOR STRUCTURE EXCAVATIONS  
No Scale

BORINGS: Indicates location of 2 1/2 inch cased hole boring.  
 Indicates location of 4 inch cased hole boring.  
For boring data, see Boring Logs sheet.  
NOTE: For General Notes and Quantities, see next sheet.

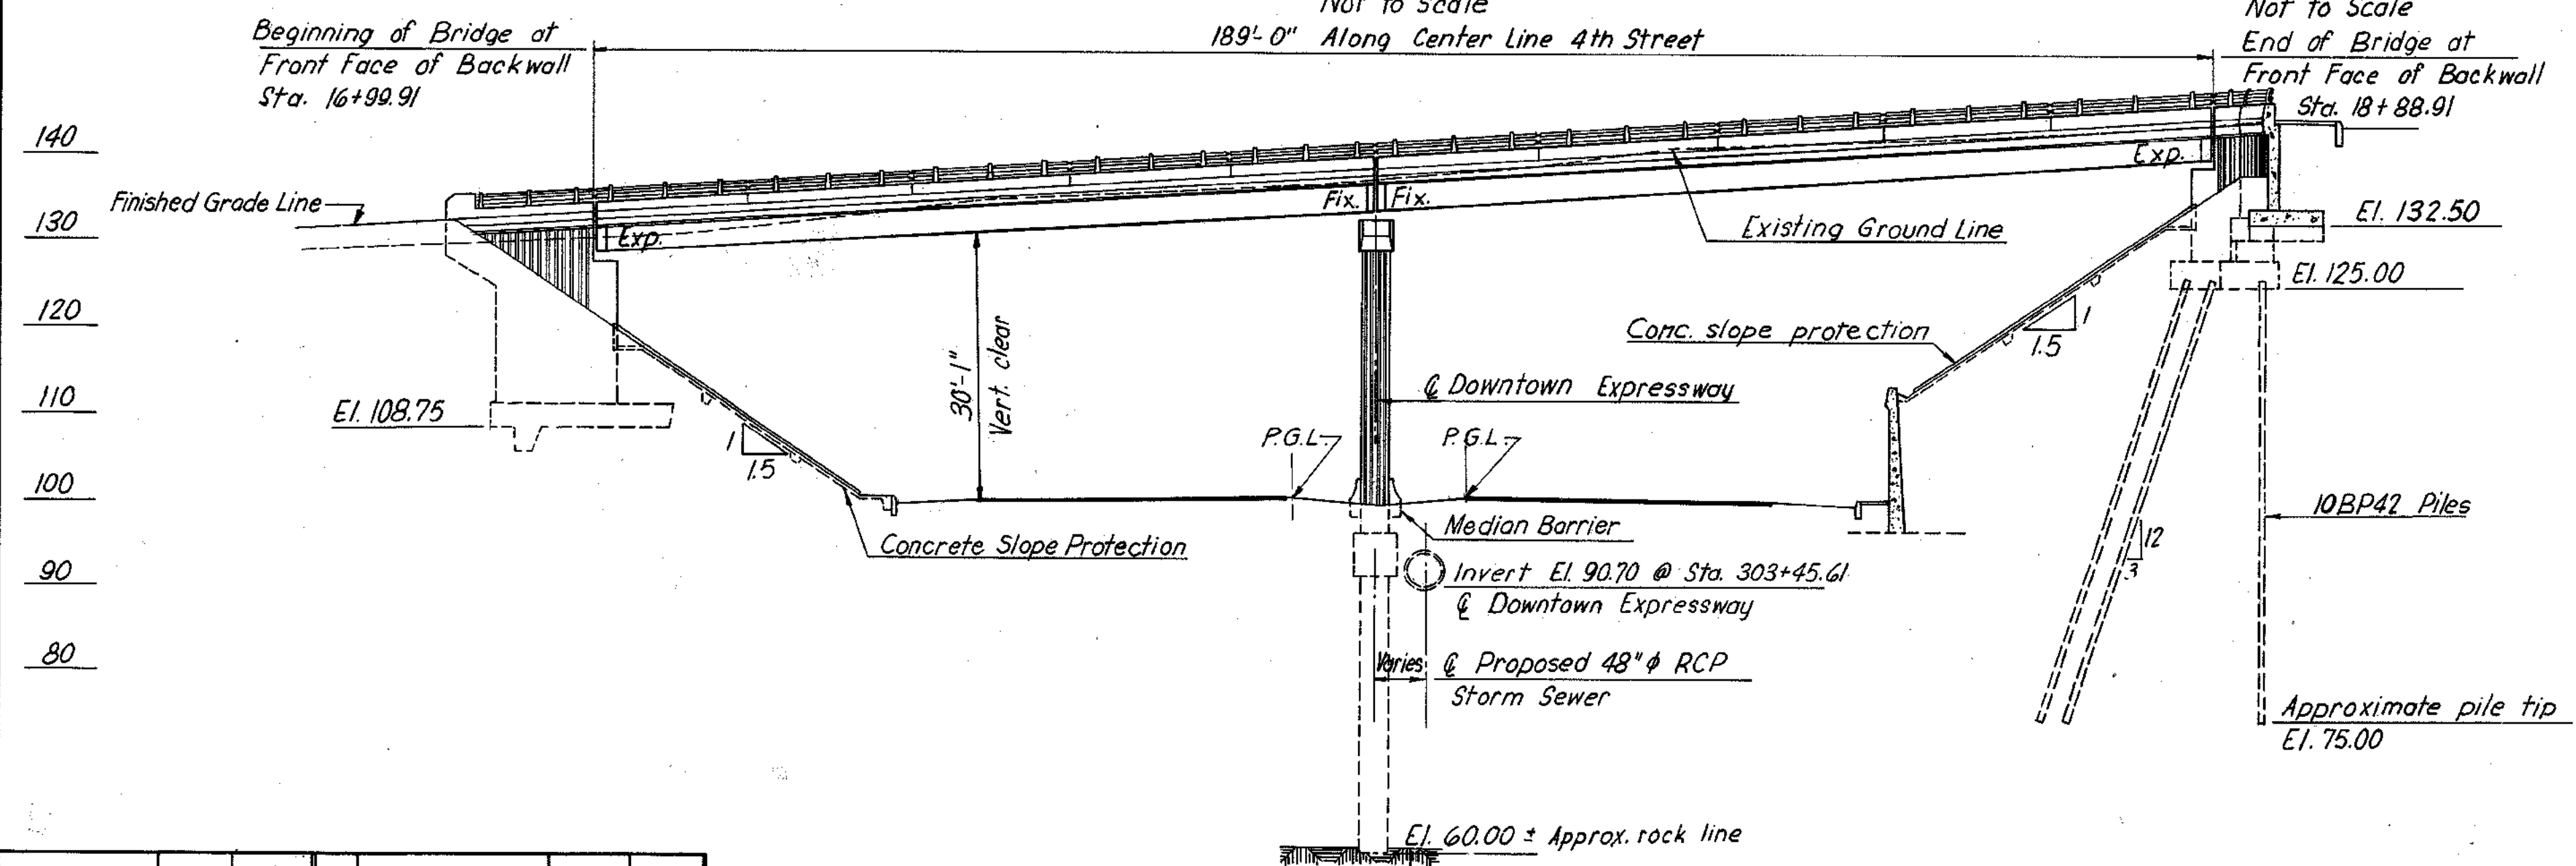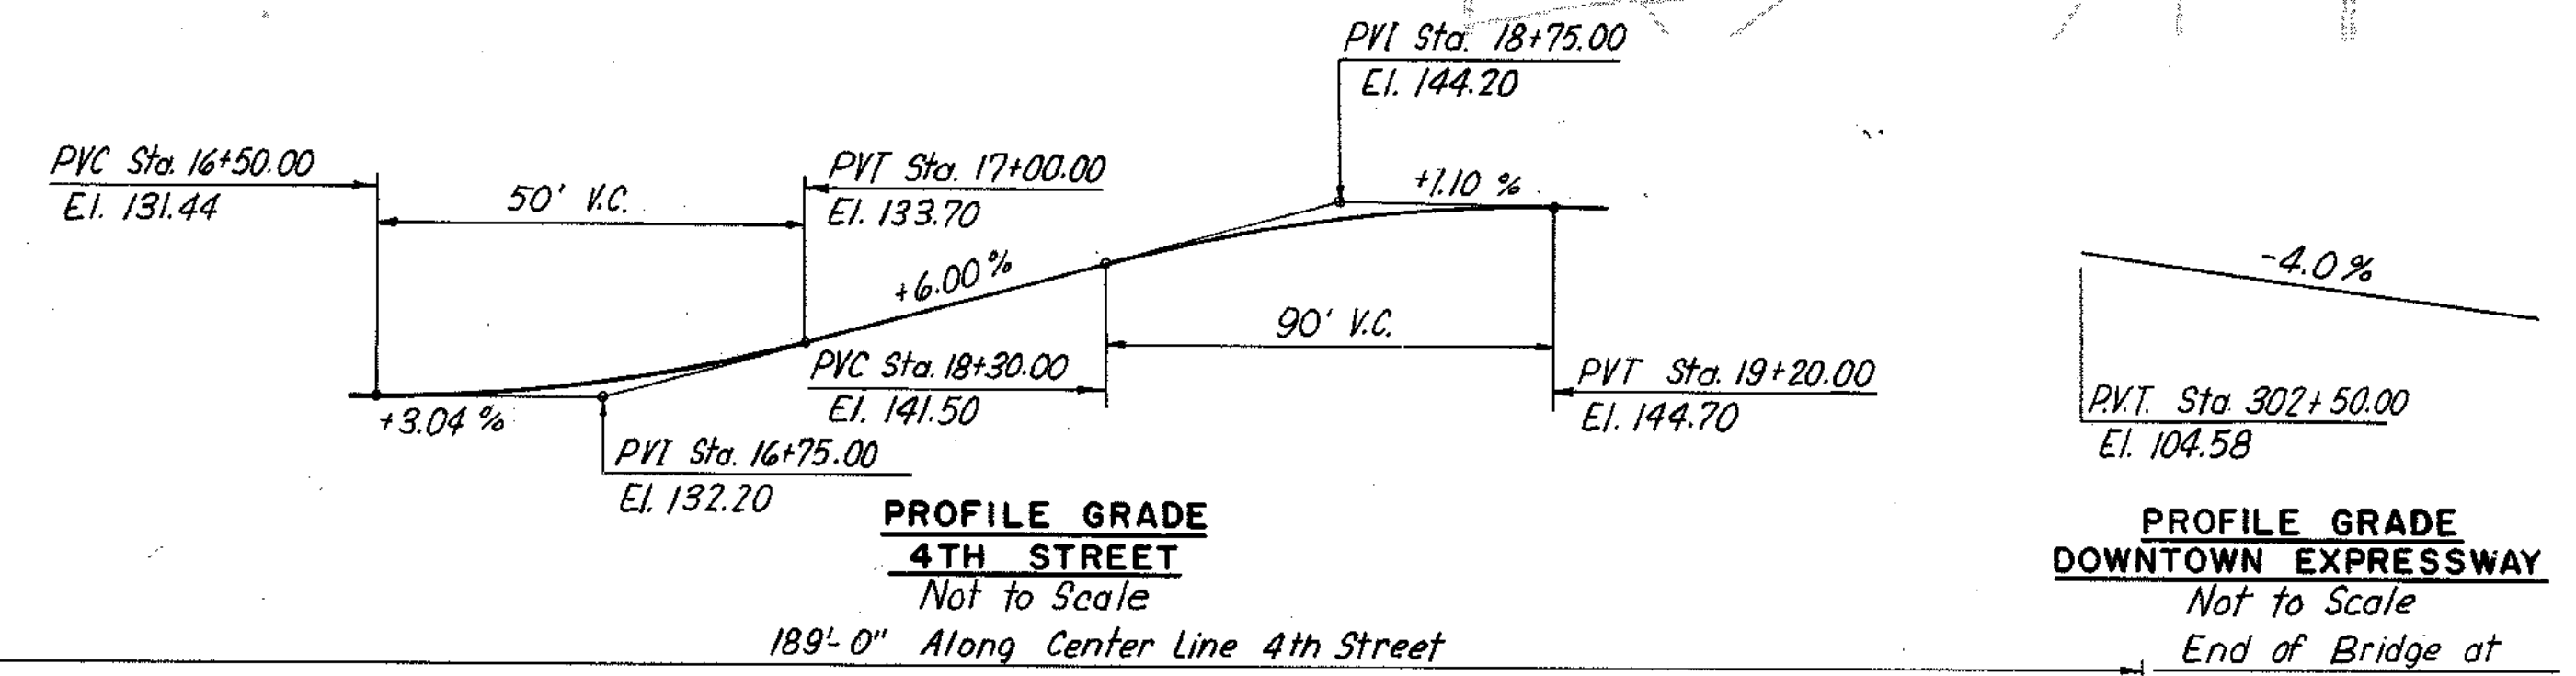

BY	DATE				
MADE	TEM	2-68			
CHECKED	A.B.P.	3-68	1	As Built	TEM 7-77
IN CHARGE	PRY		NO.	REVISION	BY

RICHMOND METROPOLITAN AUTHORITY  
RICHMOND EXPRESSWAY SYSTEM  
DOWNTOWN EXPRESSWAY

BRIDGE B-56  
4TH STREET OVER  
DOWNTOWN EXPRESSWAY  
GENERAL PLAN AND ELEVATION

HOWARD, NEEDLES, TAMMEN & BERGENDOFF  
consulting engineers  
NEW YORK ALEXANDRIA KANSAS CITY

SCALE: AS SHOWN  
CONTRACT NO. 9  
SHEET NO. 1 OF 15

AS BUILT



GENERAL NOTES

RICHMOND EXPRESSWAY SYSTEM			
SECTION	PROJECT	SHEET NO.	TOTAL SHEETS
9	DOWNTOWN EXPRESSWAY	156	

<b>ROADWAY CAPACITY:</b>	One 42'-0" clear roadway. Two 5'-0" sidewalks. Dead Load-Includes 15 lbs. per sq.ft. for future wearing surface. Live Loads-MS20-44 loading and E.P.R. modified for military vehicles.
<b>SPECIFICATIONS:</b>	GENERAL-Virginia Department of Highway Road and Bridge Specifications, 1970. DESIGN-A.A.S.H.O. Standard Specifications for Highway Bridges, 1961, modified by Special Design Provisions. WELDING-1969 Standard Specifications for Welded Highway and Railway Bridges of the American Welding Society.
	<b>CONTRACT SPECIAL PROVISIONS</b>
	Specifications and Contract Special Provisions referred to above are necessary to make these plans complete.
<b>DATUM:</b>	CITY OF RICHMOND
<b>TEMPERATURE:</b>	The normal temperature referred to on the plan is 60°F. The temperature range for movement is 0°F to 120°F.
<b>DIMENSIONS:</b>	All dimensions are measured horizontally and vertically unless otherwise noted.
<b>EXCAVATION:</b>	Excavation below subgrade and cut slope template shall be classified as Structure Excavation. All excavation above these limits shall be classified as Regular Excavation and is not included in the Structural Quantities.
<b>FOUNDATIONS:</b>	Footings shall rest on firm material. Foundation material shall be kept dry and special attention is called to Sections 401.05 and 401.06 of the General Specifications and to the Contract Special Provisions concerning preparation of foundations for footings.

<b>CONCRETE NOTES:</b>	Concrete in superstructure shall be Class A4. All other concrete shall be Class A3. All exposed edges and corners shall have a 3/4" chamfer or fillet unless otherwise noted. Care in the method of vibration, the use of low-slump concrete, and/or other means shall be employed to prevent downgrade movement of newly placed slab concrete (when gradient is over 2%).  Finishing Concrete Surfaces: See the Standard Architectural Details sheets and the Contract Special Provisions for types and details.  All reinforcing steel shall conform to ASTM A615 Grade 40. All reinforcing bar dimensions on the detailed drawings are to centers of bars unless otherwise noted. Clear distance between reinforcing steel and face of concrete shall be as noted on the plans. All bar laps shall be 30 diameters of the smaller diameter bar unless otherwise noted.
<b>STEEL NOTES:</b>	Structural steel shall conform to A.S.T.M. Specification A36 except as noted. All field connections shall be made with high strength bolts. High strength bolts shall be 7/8" diameter unless otherwise noted and shall conform to A.S.T.M. Specifications A325.
<b>BENCH MARKS:</b>	See Reference Ties and Field Control Data sheet in highway plans.  C-48 Copper weld rod, corner E. Canal St. and S. 4th St., Elev. 129.23 C-49 Copper weld rod, corner Byrd St. and S. 4th St., Elev. 143.97

FINAL QUANTITIES


	STRUCTURE EXCAVATION C.Y.	CONCRETE CLASS A3 C.Y.	CONCRETE CLASS A3 BR. APPR. SLABS C.Y.	CONCRETE CLASS A4 C.Y.	REINFORCING STEEL LBS.	STRUCTURAL STEEL LBS.	ALUMINUM BR. RAILING (2 RAILS) L.F.	DRILLED HOLES FOR CAISSONS 4" Ø L.F.	POROUS BACKFILL C.Y.	STEEL PILES 10BP42 L.F.	CONC. SLAB SLOPE PROTECTION S.Y.	DAMP-PROOFING S.Y.	UNDERDRAIN 6" Ø L.F.	GAS MAIN 4" Ø L.F.	WATER MAIN 8" Ø L.F.	CONDUIT 6" Ø VEPCO L.F.	CONDUIT 4" Ø TELEPHONE L.F.	METAL CONDUIT 3" Ø L.F.	
SUPERSTRUCTURE				352.49	78,469	346,311	380.1							237	234	924	2079	1185	
NORTH ABUTMENT	152	263.40			26,390		14.7		83		250.99	151	71						
PIER 1	41	132.70			36,710			76.88											
SOUTH ABUTMENT	526	247.23			17,593		37.6		34	2,666.1	250.92	156	101						
APPROACH SLABS			96.85		22,208														
TOTAL	719	643.33	96.85	352.49	181,370	346,311	432.4	76.88	117	2,666.1	501.91	307	172	237	234	924	2079	1185	

	BY	DATE				
MADE	EVR	3-68				
CHECKED	A.B.P.	12-68	1	As Built	TEM	7-77
IN CHARGE	PRY		NO.	REVISION	BY	DATE

RICHMOND METROPOLITAN AUTHORITY RICHMOND EXPRESSWAY SYSTEM DOWNTOWN EXPRESSWAY	
BRIDGE B-56 4TH STREET OVER DOWNTOWN EXPRESSWAY GENERAL NOTES AND QUANTITIES	
HOWARD, NEEDLES, TAMMEN & BERGENDOFF consulting engineers NEW YORK ALEXANDRIA KANSAS CITY	SCALE: AS SHOWN CONTRACT NO. 9 SHEET NO. 2 OF 15

AS BUILT




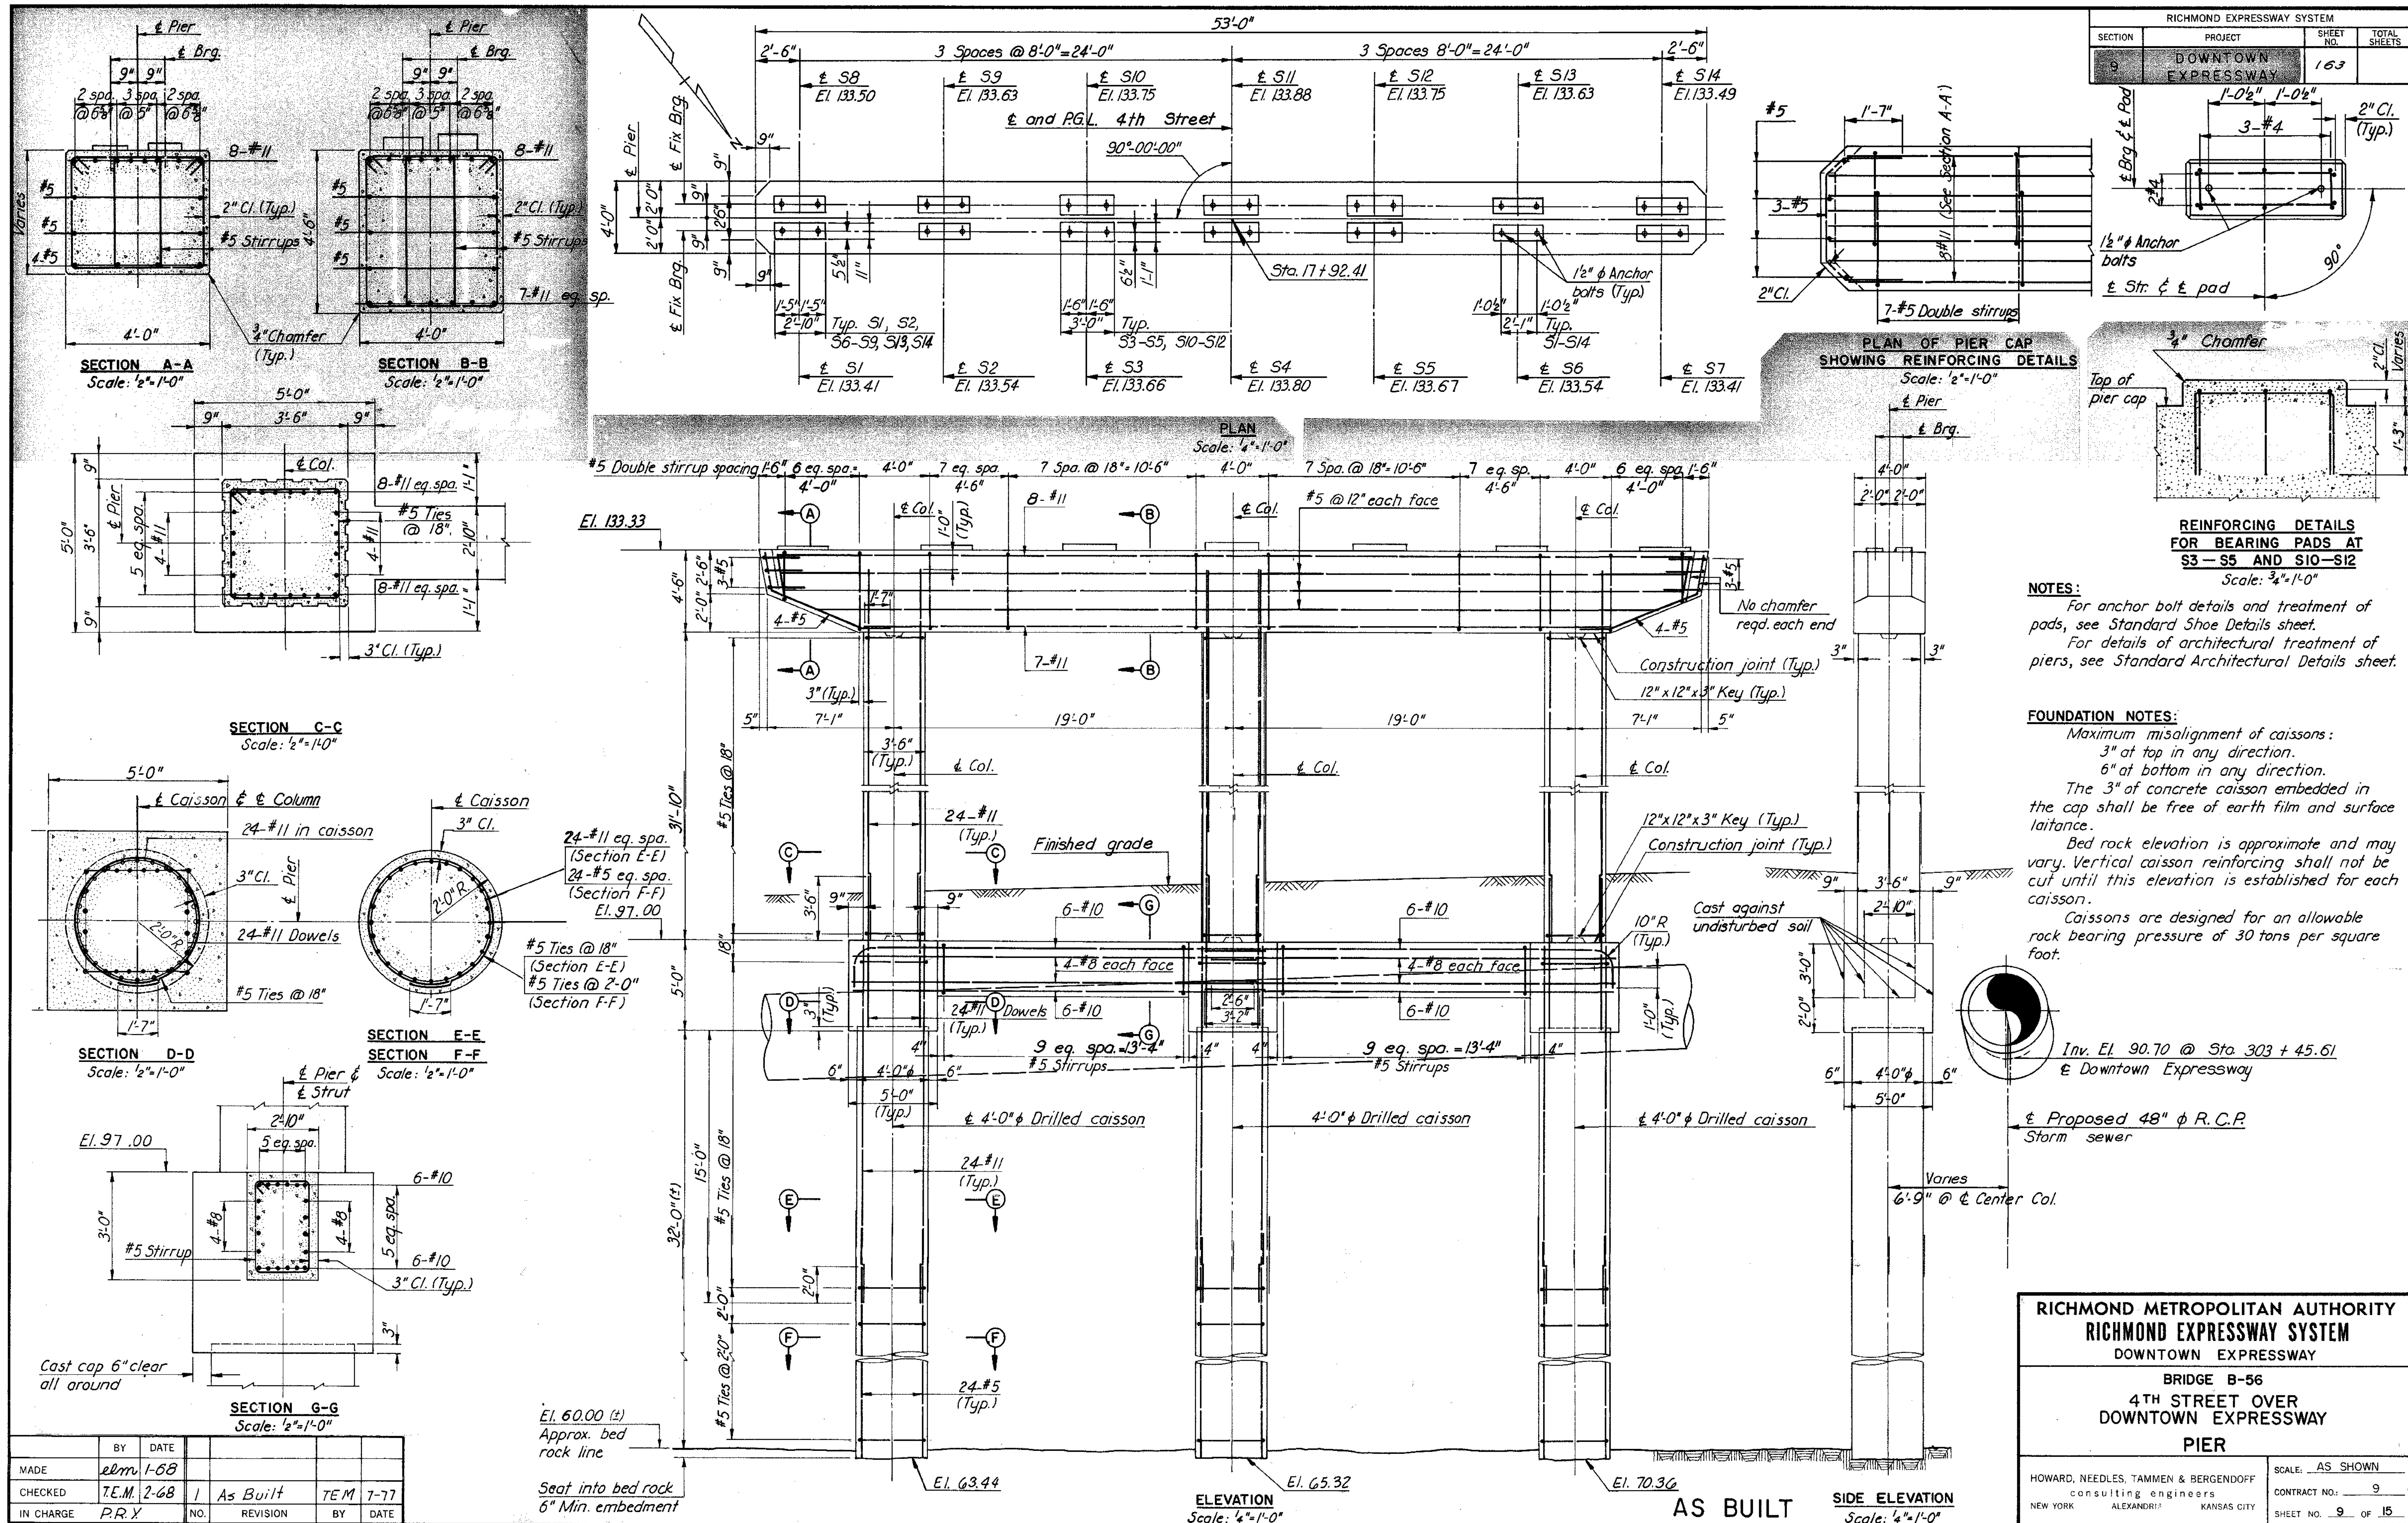



RICHMOND EXPRESSWAY SYSTEM			
SECTION	PROJECT	SHEET NO.	TOTAL SHEETS
9	DOWNTOWN EXPRESSWAY	164	

SHOE SCHEDULE			
EXPANSION SHOES		FIXED SHOES	
TYPE	NO. REQD.	TYPE	NO. REQD.
E8	14	F6	10
		F6M	4

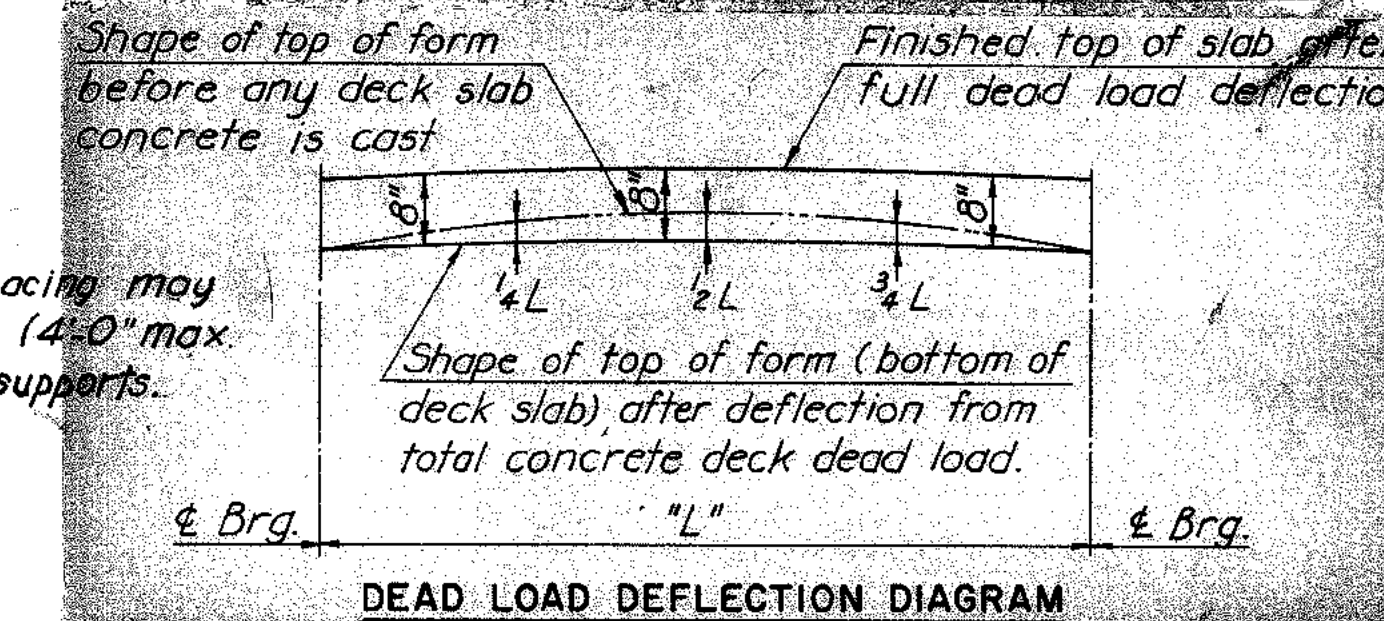


DEFLECTION SCHEDULE			
STR.	$\frac{1}{4}L$	$\frac{1}{2}L$	$\frac{3}{4}L$
S1-S7	$1\frac{1}{2}"$	$1\frac{3}{4}"$	$1\frac{3}{4}"$
S8, S11, S12	$1\frac{1}{2}"$	$2"$	$2"$
S9, S10, S13, S14	$1\frac{1}{2}"$	$1\frac{1}{2}"$	$1\frac{1}{2}"$

**NOTE TO CONTRACTOR:**  
The above deflections are those anticipated to occur in the stringer upon placement of the total concrete deck dead load. In practice, the stringers in place are not likely to have the exact camber to compensate for these deflections during construction. The residual amounts shall be provided for by adjusting forms to vary the thickness of the concrete bolster between the bottom of the slab and the top of stringer, without alteration of the slab thickness.

**RICHMOND METROPOLITAN AUTHORITY**  
**RICHMOND EXPRESSWAY SYSTEM**  
DOWNTOWN EXPRESSWAY  
BRIDGE B-56  
4TH STREET OVER  
DOWNTOWN EXPRESSWAY  
**FRAMING PLAN**

HOWARD, NEEDLES, TAMMEN & BERGENDOFF  
consulting engineers  
NEW YORK ALEXANDRIA KANSAS CITY


SCALE: AS SHOWN  
CONTRACT NO. 9  
SHEET NO. 10 OF 15

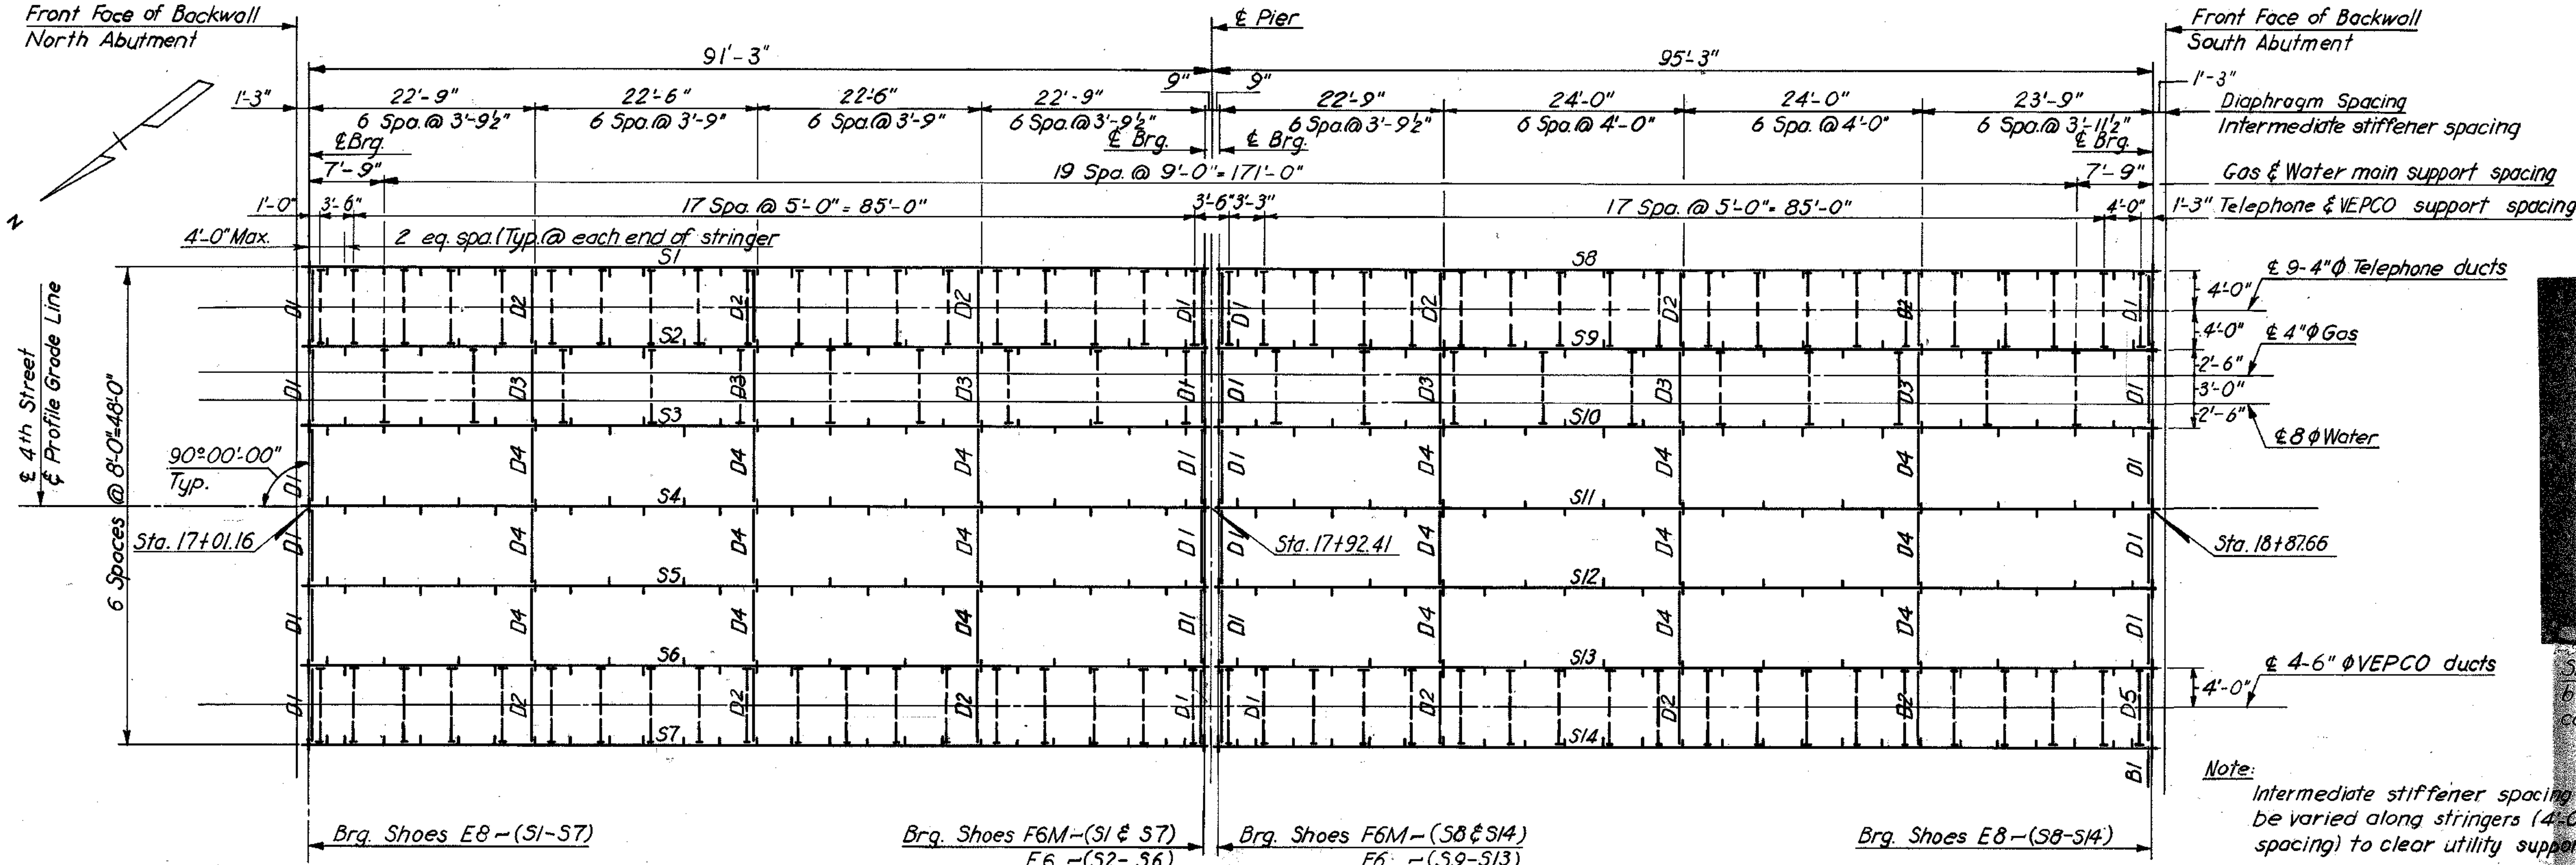

UNIT 1


UNIT 2

**FRAMING PLAN**  
Scale: 1/4" = 1'-0"

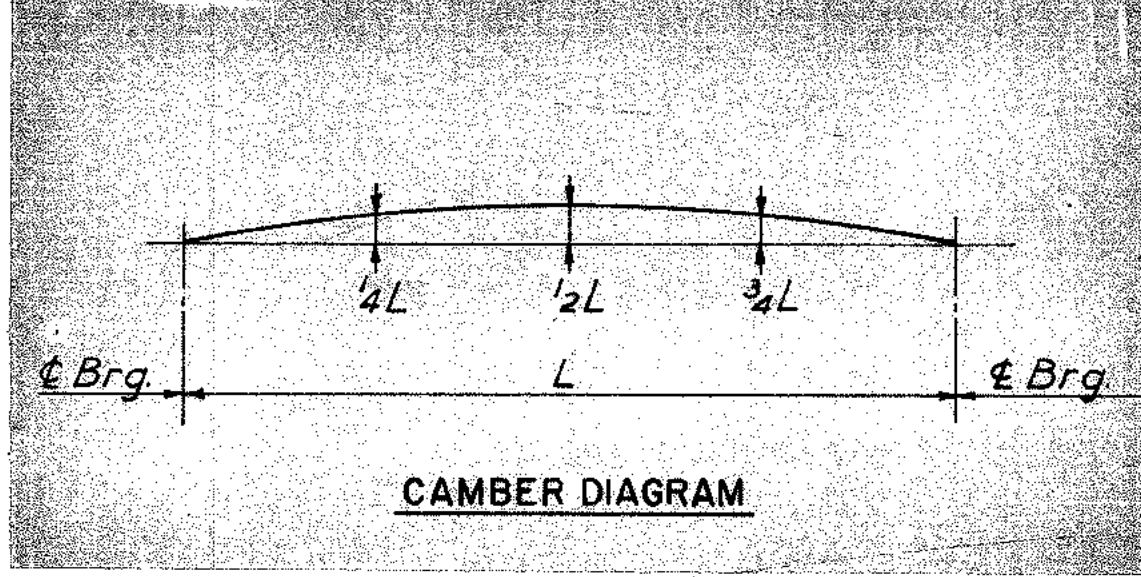

CAMBER SCHEDULE							
STR.	$\frac{1}{4}L$	$\frac{1}{2}L$	$\frac{3}{4}L$	STR.	$\frac{1}{4}L$	$\frac{1}{2}L$	$\frac{3}{4}L$
S1, S2	$1\frac{5}{8}"$	$2\frac{1}{4}"$	$1\frac{5}{8}"$	S8	$4\frac{1}{2}"$	$7\frac{3}{8}"$	$6\frac{1}{8}"$
S4, S5	$1\frac{5}{8}"$	$2\frac{3}{8}"$	$1\frac{5}{8}"$	S11, S12	$4\frac{1}{2}"$	$7\frac{1}{2}"$	$6\frac{1}{8}"$
S3	$1\frac{5}{8}"$	$2\frac{3}{8}"$	$1\frac{5}{8}"$	S9, S10, S13, S14	$4\frac{1}{2}"$	$7\frac{1}{2}"$	$6\frac{1}{8}"$


**NOTE TO FABRICATOR:**  
The above stringers shall be fabricated with an upward camber amounting to the tabulated value. This will provide approximate compensation for deflection under full dead load and for conformity with finished grade. Dimensions are in inches.

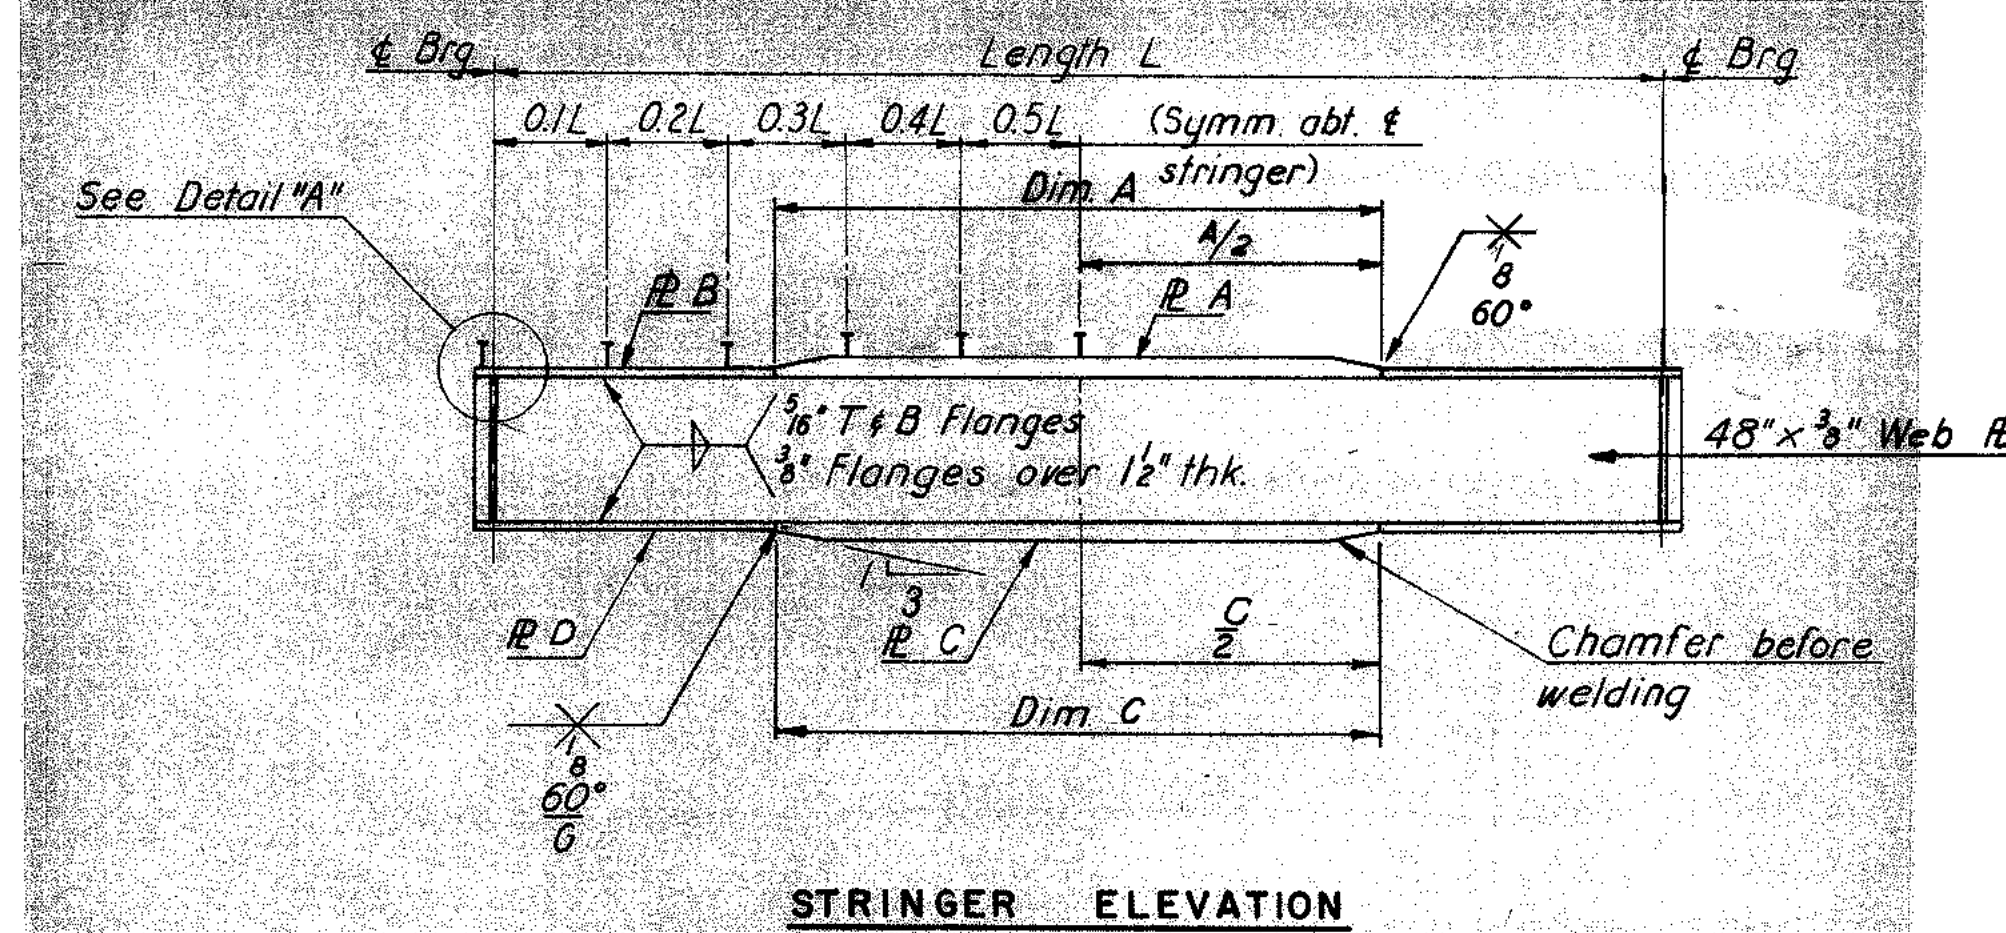


**STRINGER ELEVATION**

STRINGER - SCHEDULE												
STR.	LENGTH ℓ BRG. TO ℓ BRG.	R A	DIM A	R B	R C	DIM C	R D	SHEAR STUD SPACING				
								0.1L	0.2L	0.3L	0.4L	0.5L
S1	90'-6"	16 x 1	42'-0"	16 x 3/4	20 x 1 1/2	55'-0"	20 x 1 1/2	9"	10 1/2"	13 1/2"	17 1/2"	20 1/2"
S2		16 x 1	40'-0"		20 x 1 1/2	53'-0"	20 x 1 1/2	10"	11 1/2"	13 1/2"	17"	19"
S3		16 x 3/4	34'-0"		20 x 1 1/2	53'-0"	20 x 1 1/2	10"	11 1/2"	13 1/2"	16 1/2"	18 1/2"
S4			29'-0"		20 x 1 1/2	57'-0"	20 x 1	9 1/2"	11"	14"		
S5			29'-0"		20 x 1 1/2	57'-0"	20 x 1	9 1/2"	11 1/2"	14"		
S6		16 x 3/4	34'-0"		20 x 1 1/2	53'-0"	20 x 1 1/2	9 1/2"	11"	13 1/2"	16 1/2"	18 1/2"
S7	90'-6"	16 x 1	42'-0"		20 x 1 1/2	55'-0"		9"	10 1/2"	13 1/2"	17 1/2"	20 1/2"
S8	94'-6"	16 x 1 1/2	53'-0"		20 x 1 1/2	62'-0"		9"	10 1/2"	13 1/2"	17"	21"
S9		16 x 1 1/2	52'-0"		20 x 1 1/2	61'-0"		9 1/2"	11"	14"		19 1/2"
S10		16 x 1 1/2	50'-0"		20 x 1 1/2	60'-0"		10"	11 1/2"	17 1/2"	19 1/2"	
S11		16 x 1	44'-0"		20 x 1 1/2	58'-0"		10"	11 1/2"	17"	19"	
S12		16 x 1	44'-0"		20 x 1 1/2	58'-0"		10"	11 1/2"	17"	19"	
S13		16 x 1 1/2	50'-0"		20 x 1 1/2	61'-0"	20 x 1 1/2	9 1/2"	11"	14"	17"	19 1/2"
S14	94'-6"	16 x 1 1/2	53'-0"	16 x 1/4	20 x 1 1/2	58'-0"	20 x 1 1/2	9"	10 1/2"	13 1/2"	17 1/2"	21"

Note: Lengths shown are horizontal distances measured along centerlines of stringers.

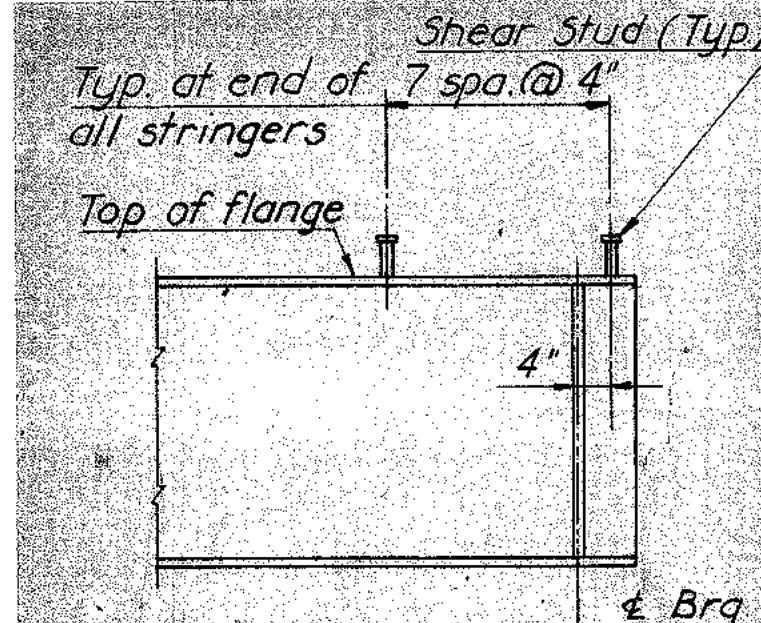

**DETAIL "A"**  
No Scale

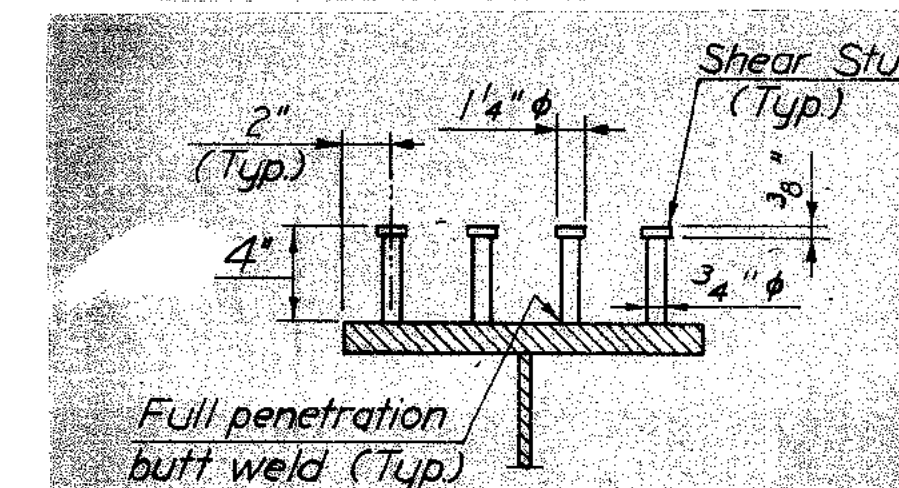

**SHEAR STUD DETAIL**  
No Scale


**SHEAR STUD NOTE:**  
Capacity = 3,400 lbs. per stud. The contractor may, if he elects, use three 1/2" diameter studs at the same longitudinal spacing in lieu of the four 3/4" diameter studs shown. Stud rows shall be placed parallel to the main deck reinforcing. Shear stud spacing shown is maximum spacing.

AS BUILT

BY	DATE				
MADE	EVR	10-20			
CHECKED	T.E.M.	2-68	1	As Built	TEM 7-77
IN CHARGE	P.R.Y.		NO.	REVISION	BY DATE





RICHMOND EXPRESSWAY SYSTEM			
SECTION	PROJECT	SHEET NO.	TOTAL SHEETS
9	DOWNTOWN EXPRESSWAY	165	

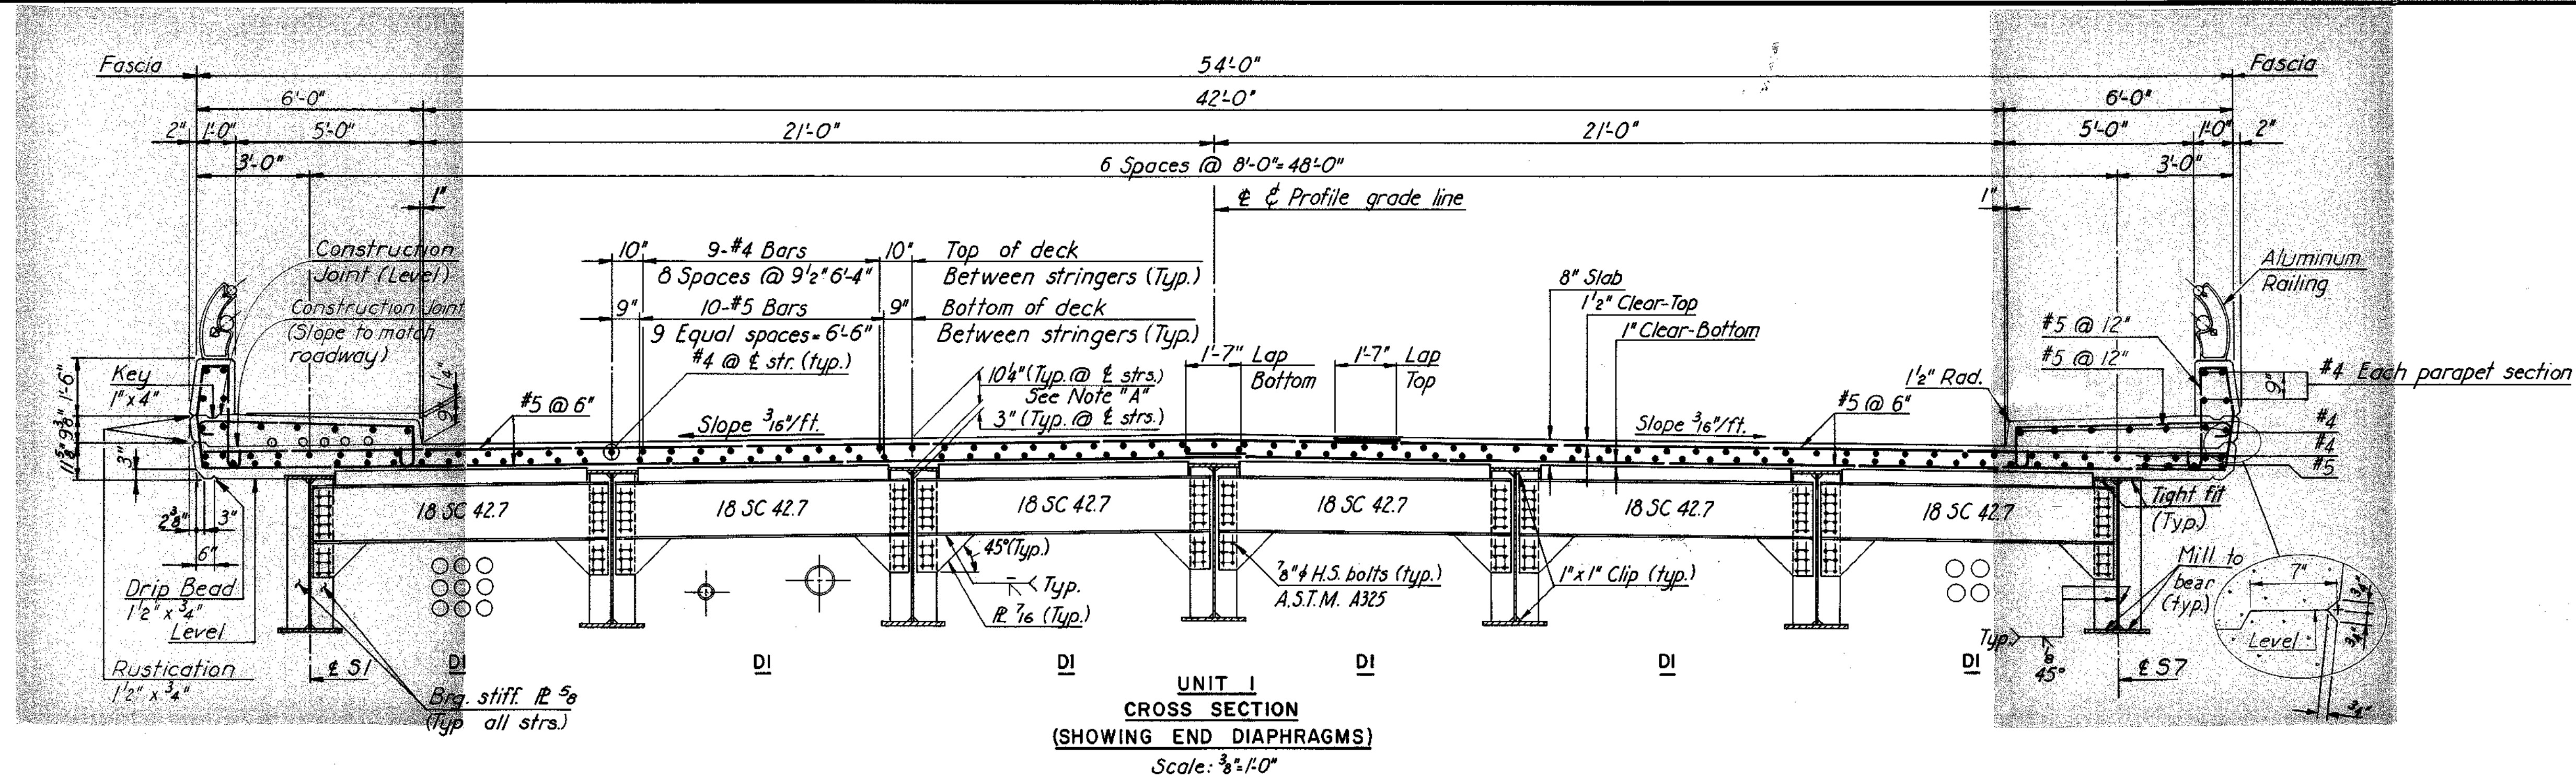



**NOTE "A"**  
 Dimension shown is measured from top of web to top of slab at the intersection of the centerline of stringer and the centerline of bearing. At exterior stringers this is measured to the cross slope extended. This dimension may be varied between bearings as required to care for variation in camber, except that no portion of the stringer flange may fall within the 8" slab.

**NOTES:**  
 For spacing and location of utility supports and diaphragms, see Framing Plan sheet.  
 For Basic Attachment Details for cement asbestos conduit, see Standard Conduit Installation Details sheet.  
 For details showing gas and water mains thru abutments, see Standard Utility Support details At Bridge Abutments sheet.

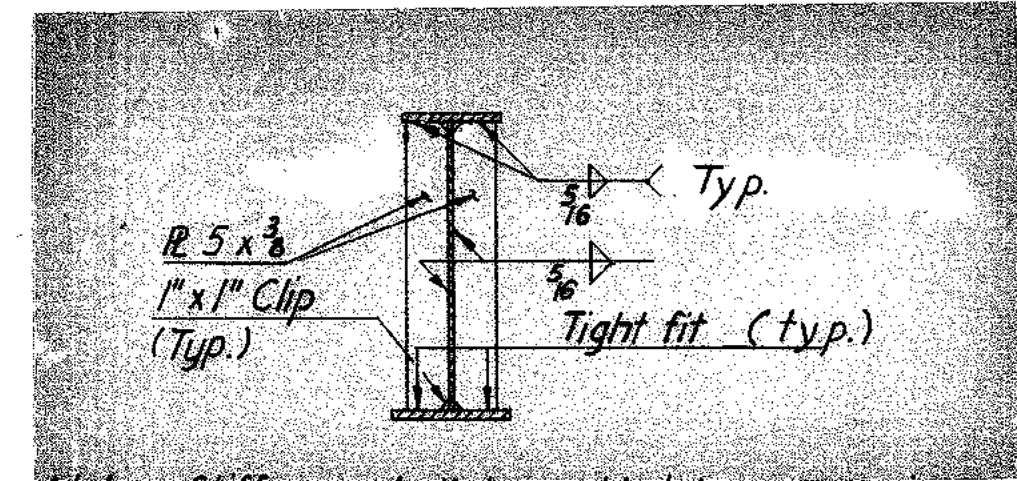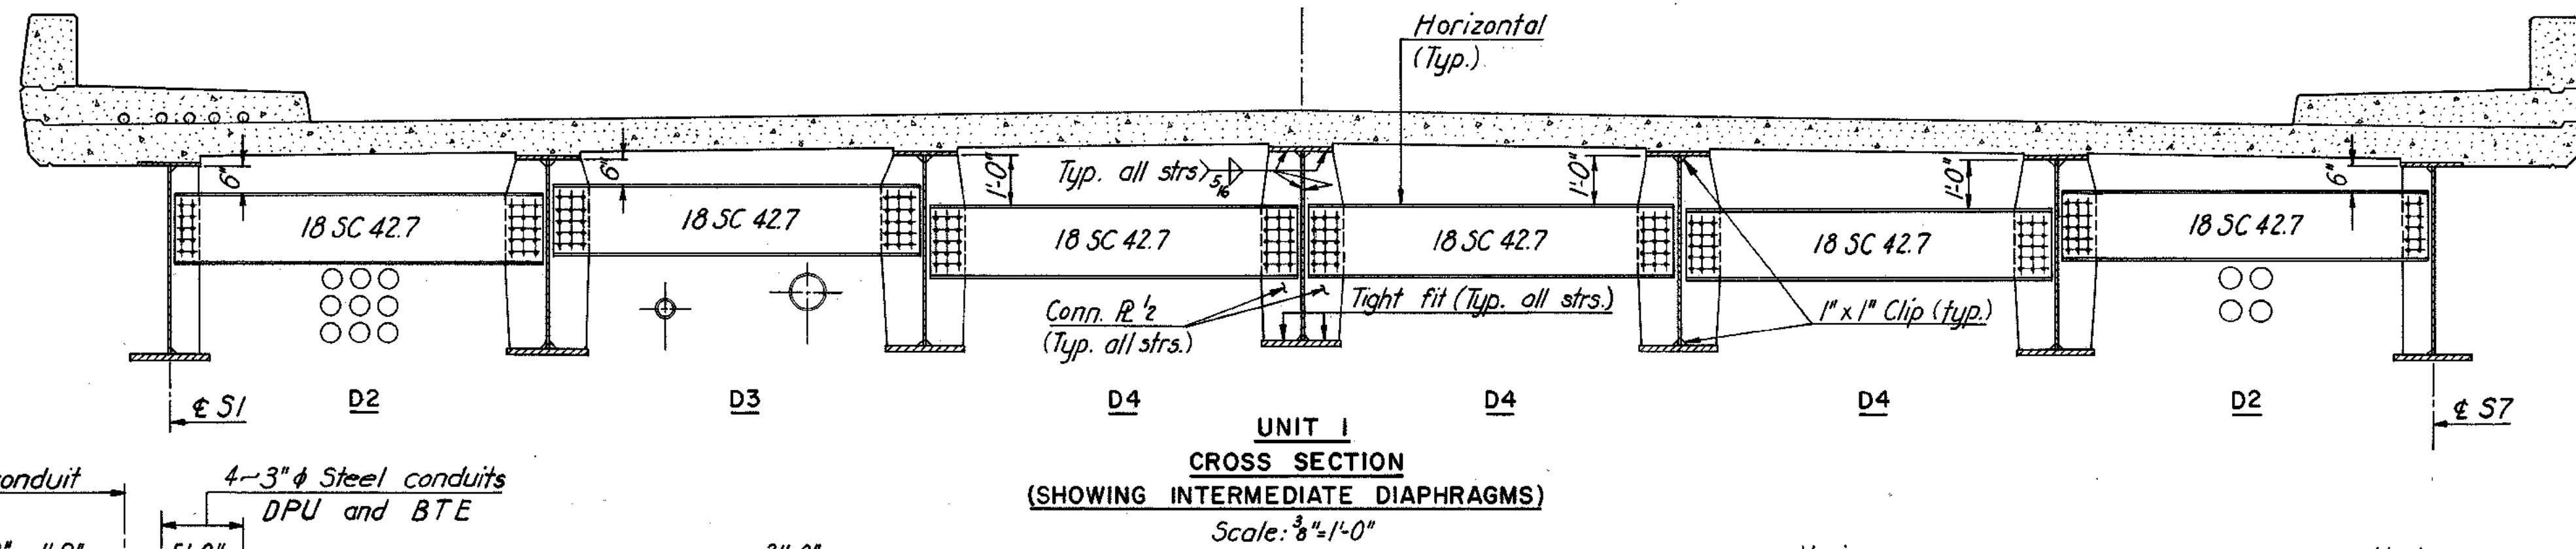


Note: Stiffener shall be welded to compression flange and have a tight fit to the tension flange.

INTERMEDIATE STIFFENER DETAIL

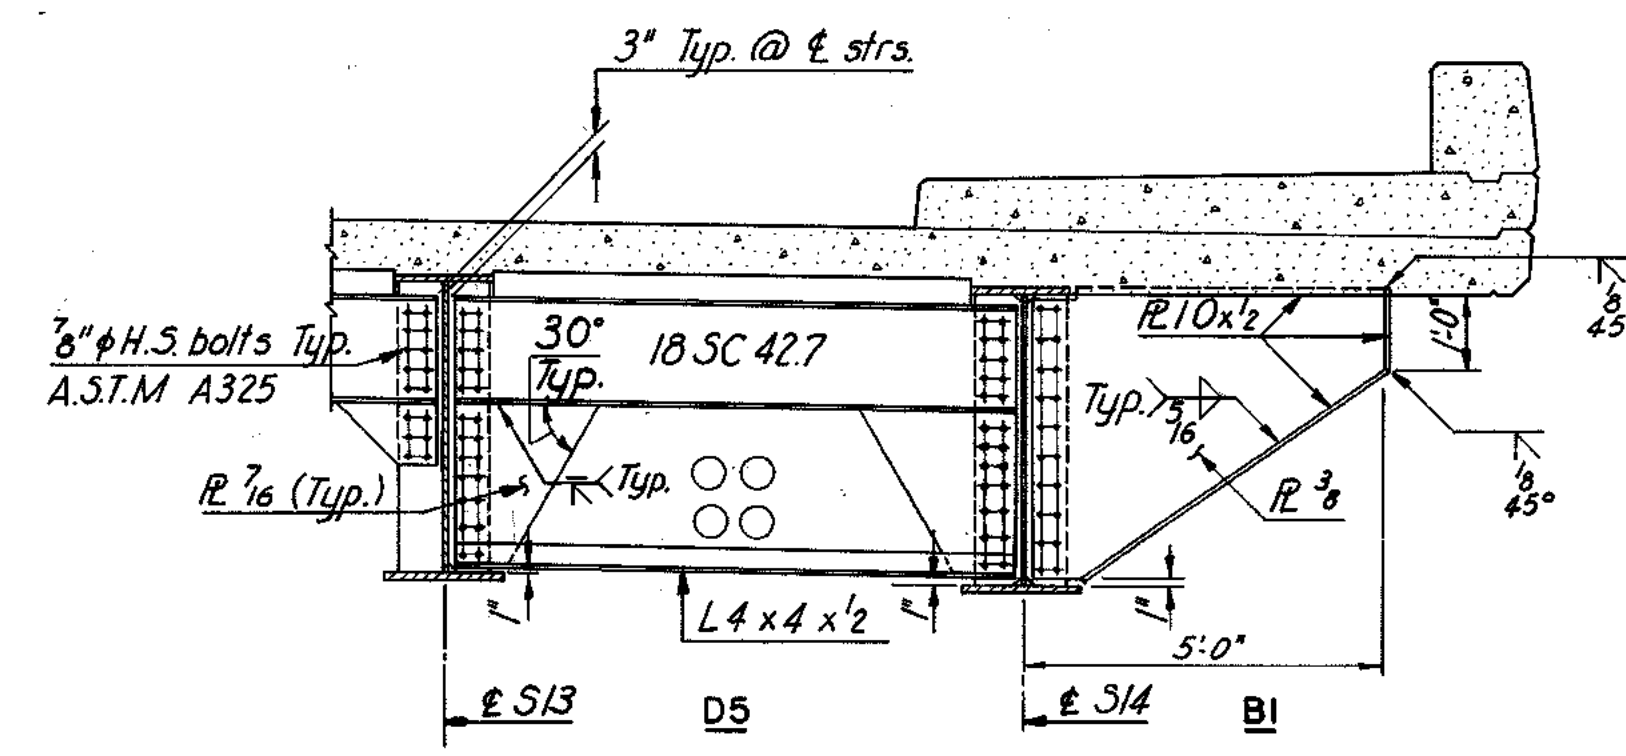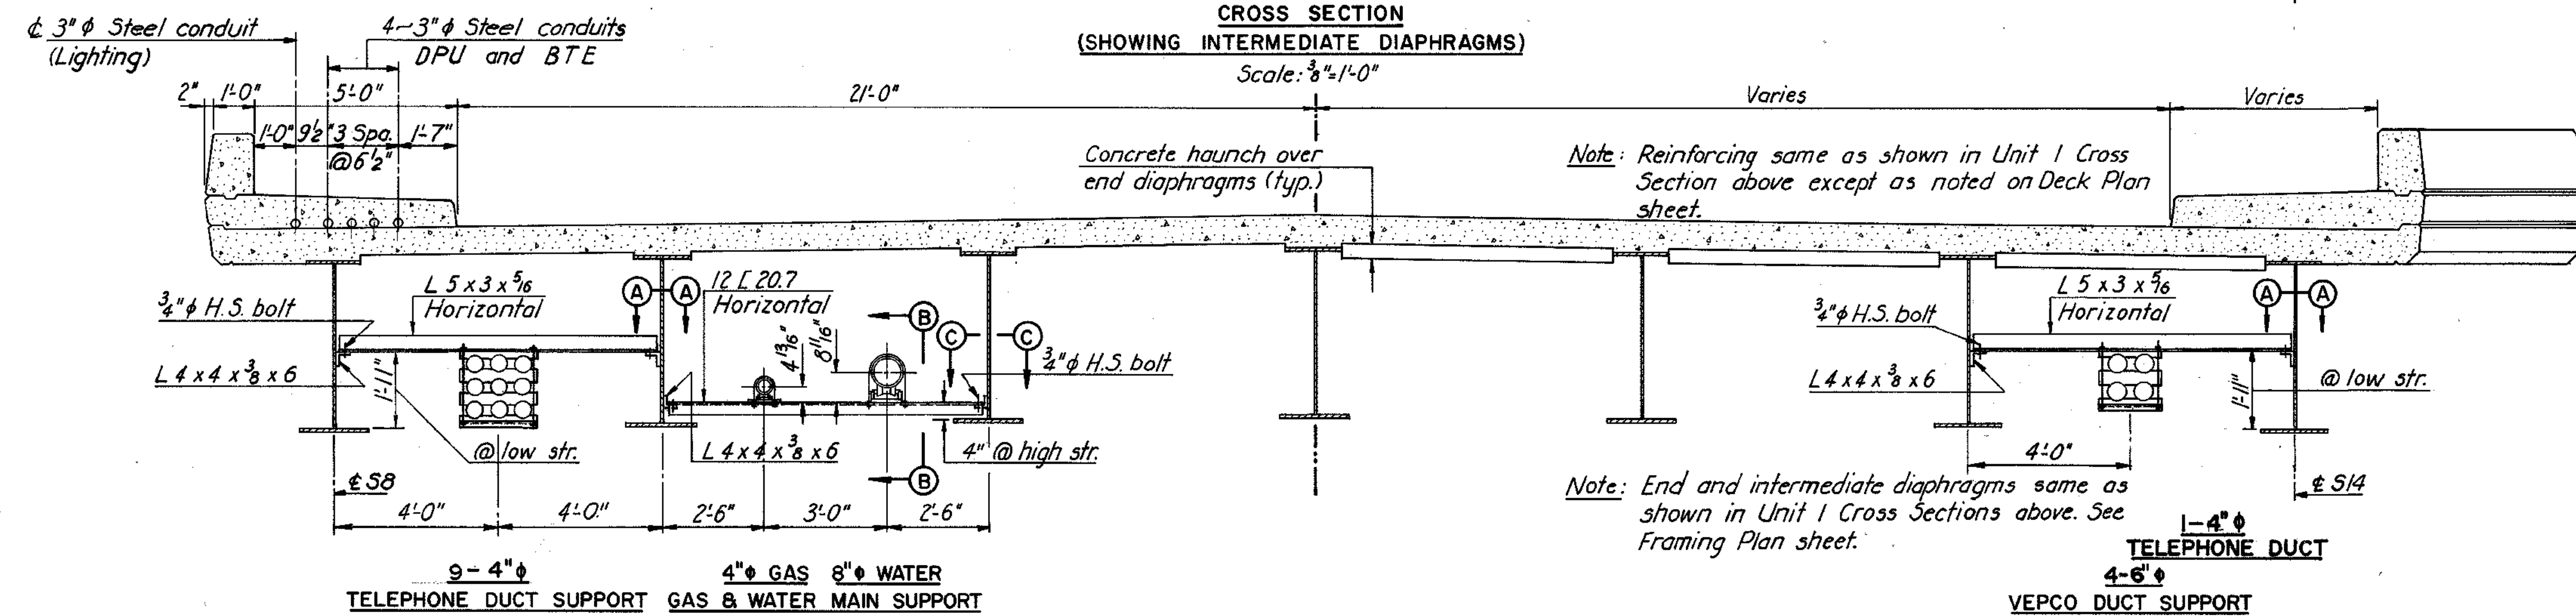


UNIT 2 PARTIAL CROSS SECTION (SHOWING END DIAPHRAGM AT SOUTH ABUTMENT) Scale: 3/8"=1'-0"


UNIT 2 CROSS SECTION (SHOWING UTILITY SUPPORTS ONLY) Scale: 3/8"=1'-0"

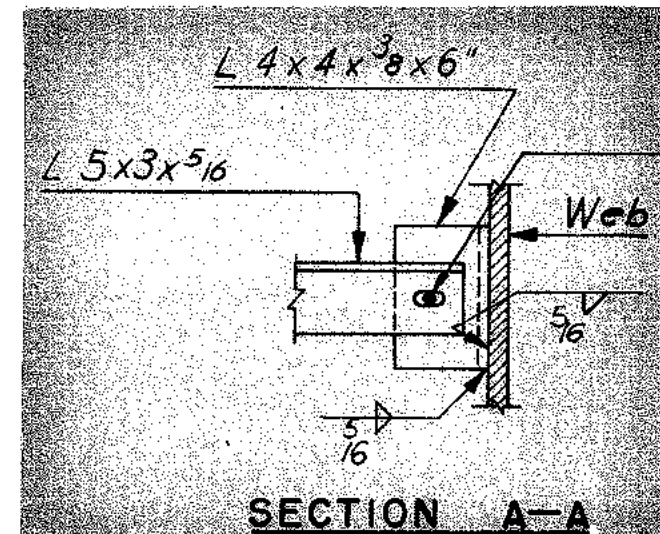


Provide 1 3/8" x 1 1/4" slots in ends of L 5 x 3 x 3/8 and 1 3/8" hole in L 4 x 4 x 3/8 x 6 for 3/4" H.S. bolt.

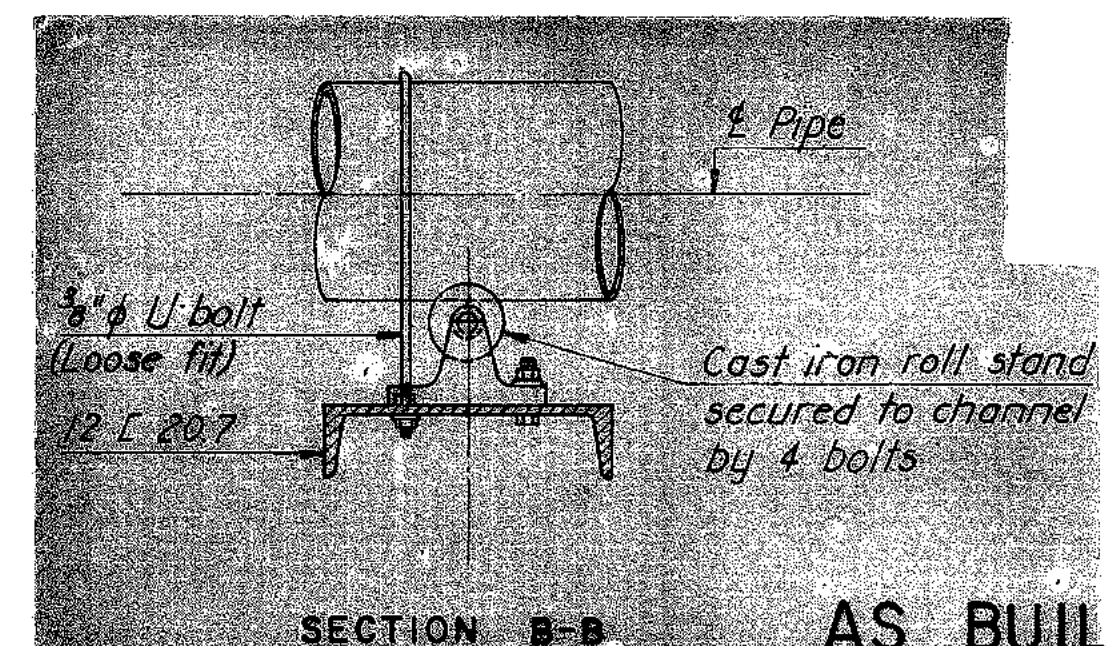

AS BUILT

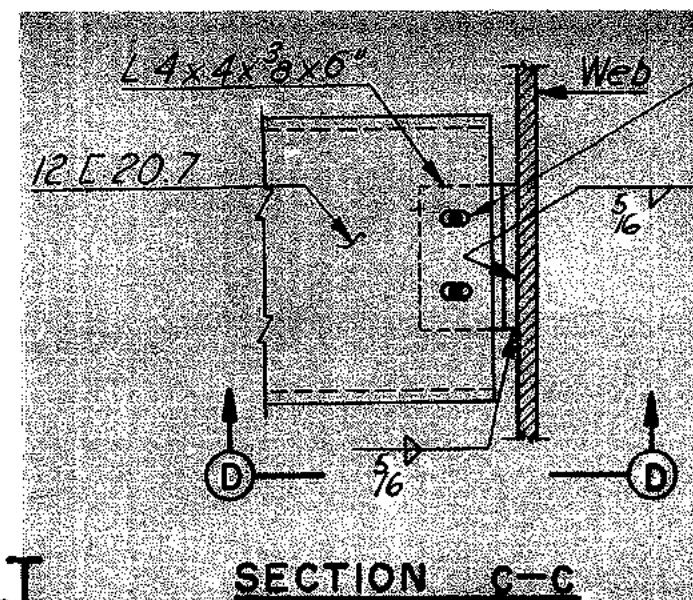

SECTION C-C

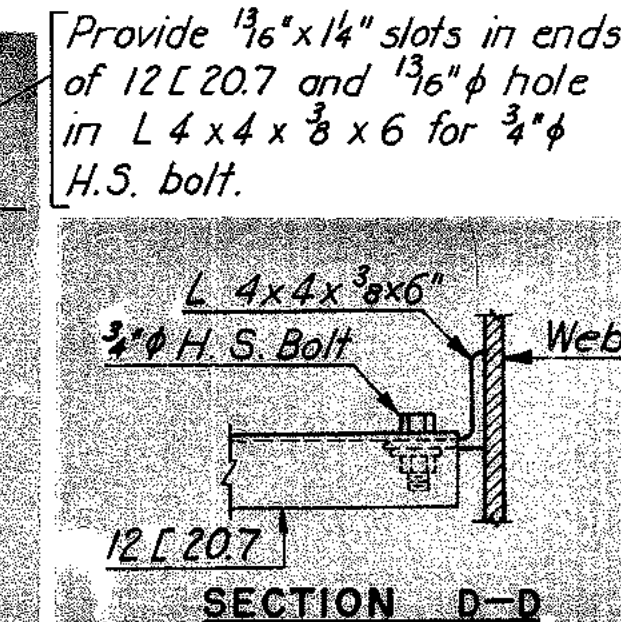

SECTION D-D

**RICHMOND METROPOLITAN AUTHORITY**  
**RICHMOND EXPRESSWAY SYSTEM**  
 DOWNTOWN EXPRESSWAY

**BRIDGE B-56**  
**4TH STREET OVER**  
**DOWNTOWN EXPRESSWAY**




**CROSS SECTION AND UTILITY DETAILS**

HOWARD, NEEDLES, TAMMEN & BERGENDOFF  
 consulting engineers  
 NEW YORK ALEXANDRIA KANSAS CITY


SCALE: AS SHOWN  
 CONTRACT NO. 9  
 SHEET NO. 11 OF 15

BY	DATE			
MADE	A.B.P.	11-67		
CHECKED	T.E.M.	2-68	1 As Built	T.E.M. 7-77
IN CHARGE	P.R.Y.			



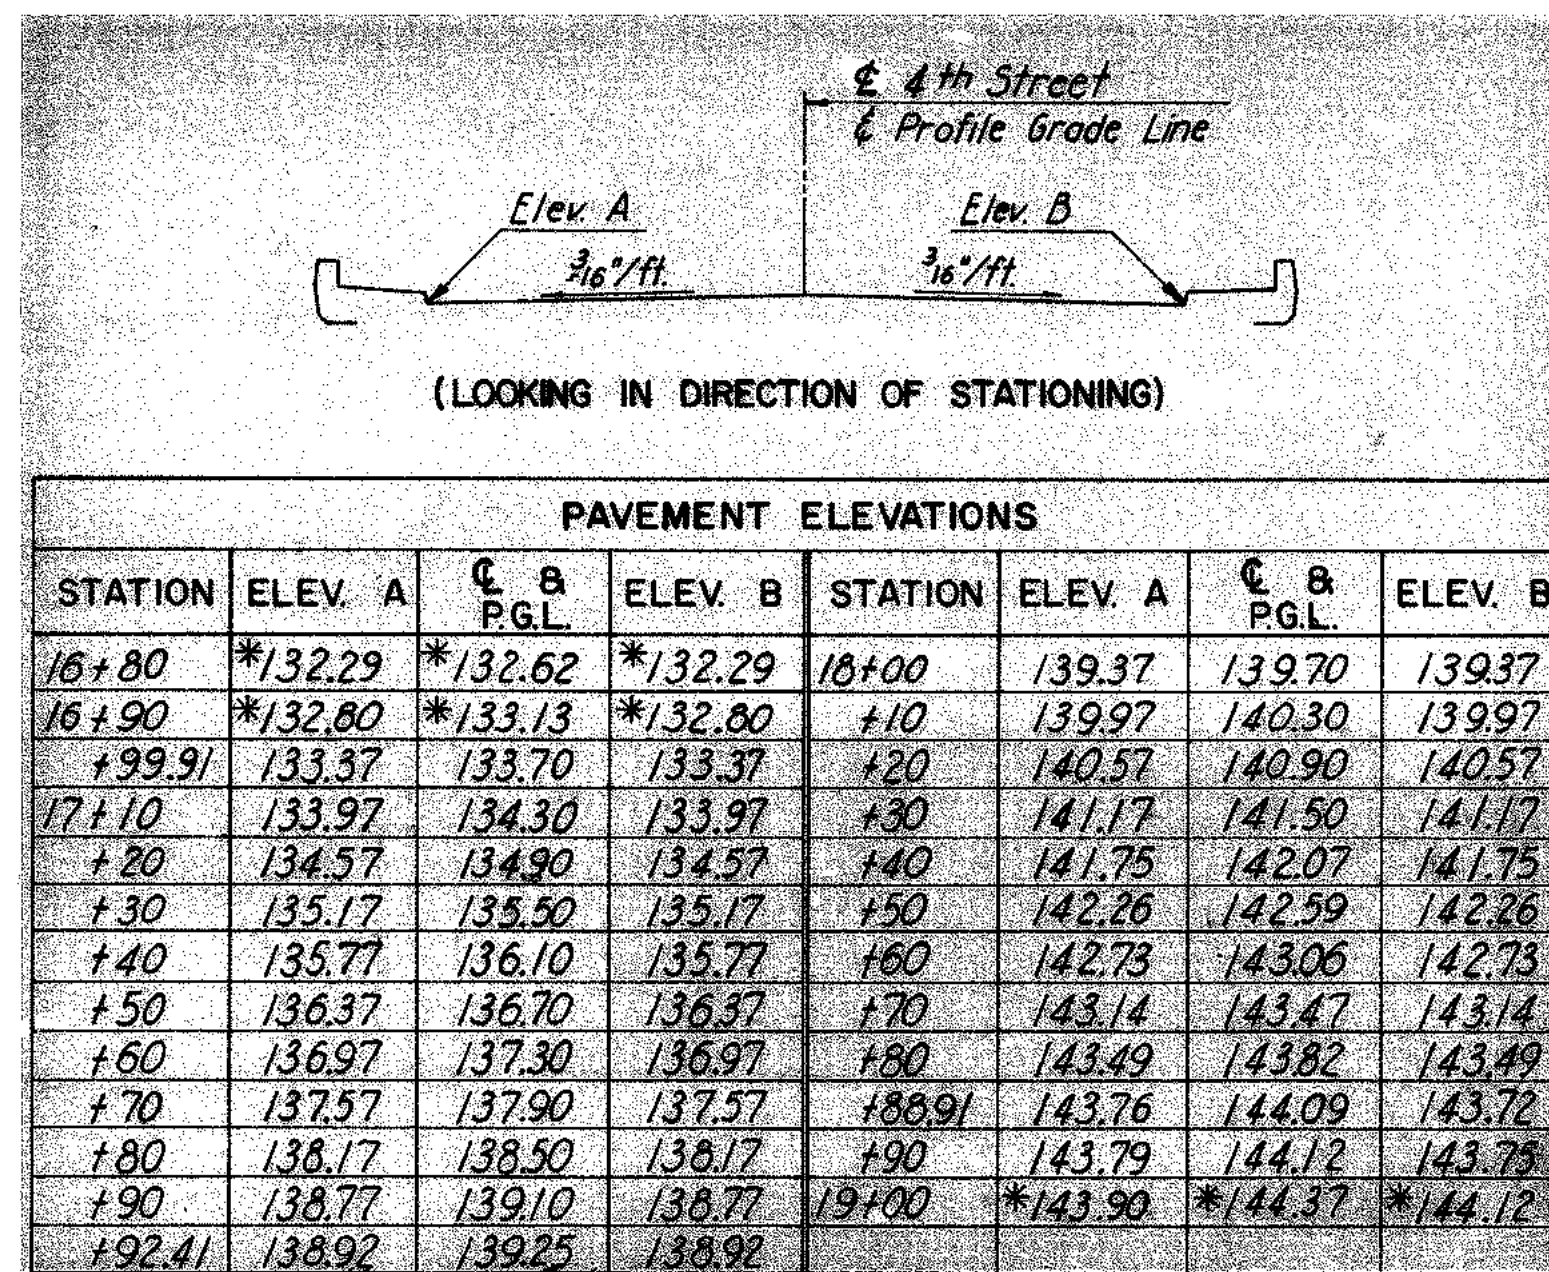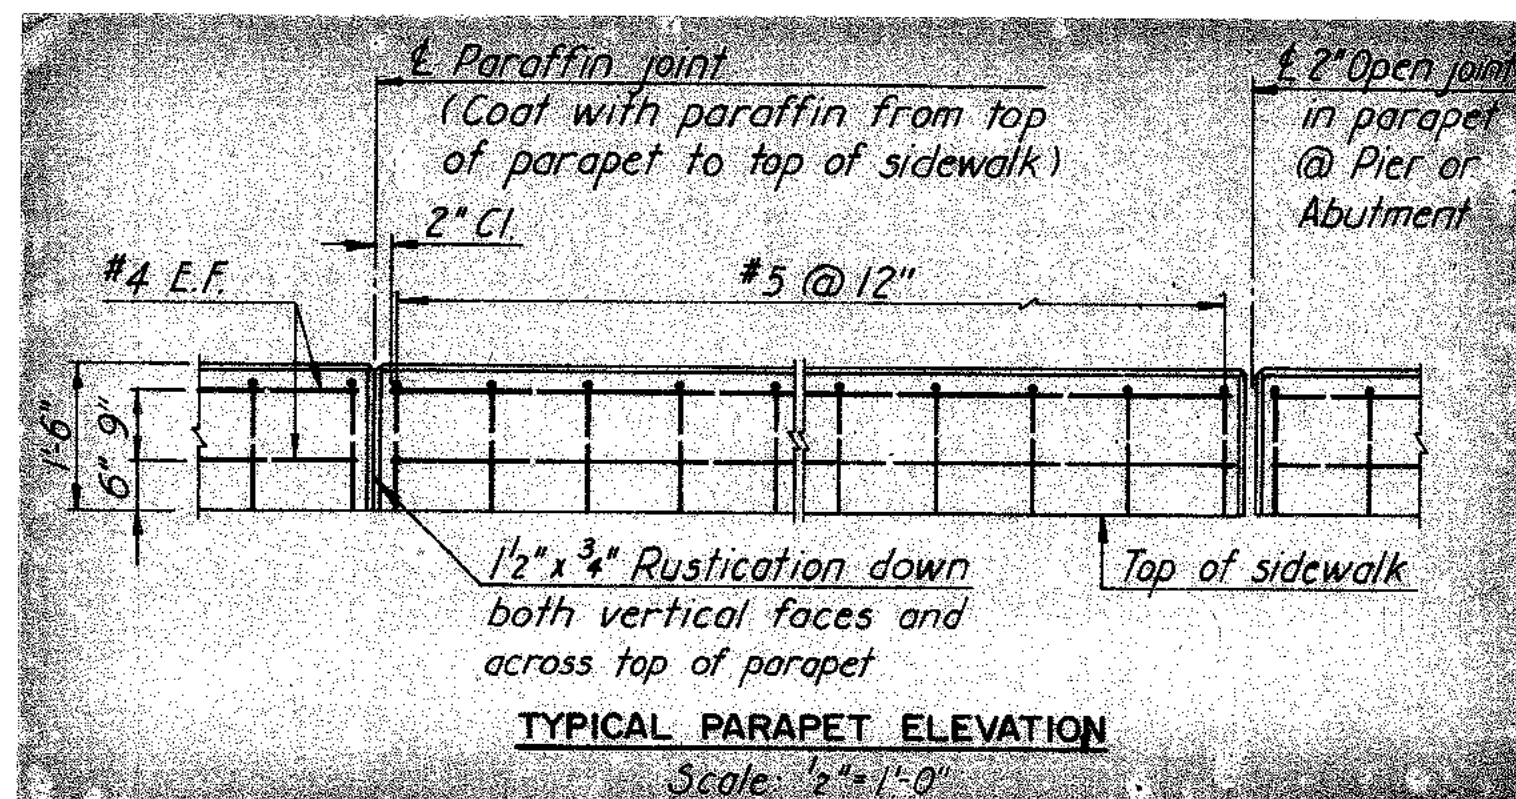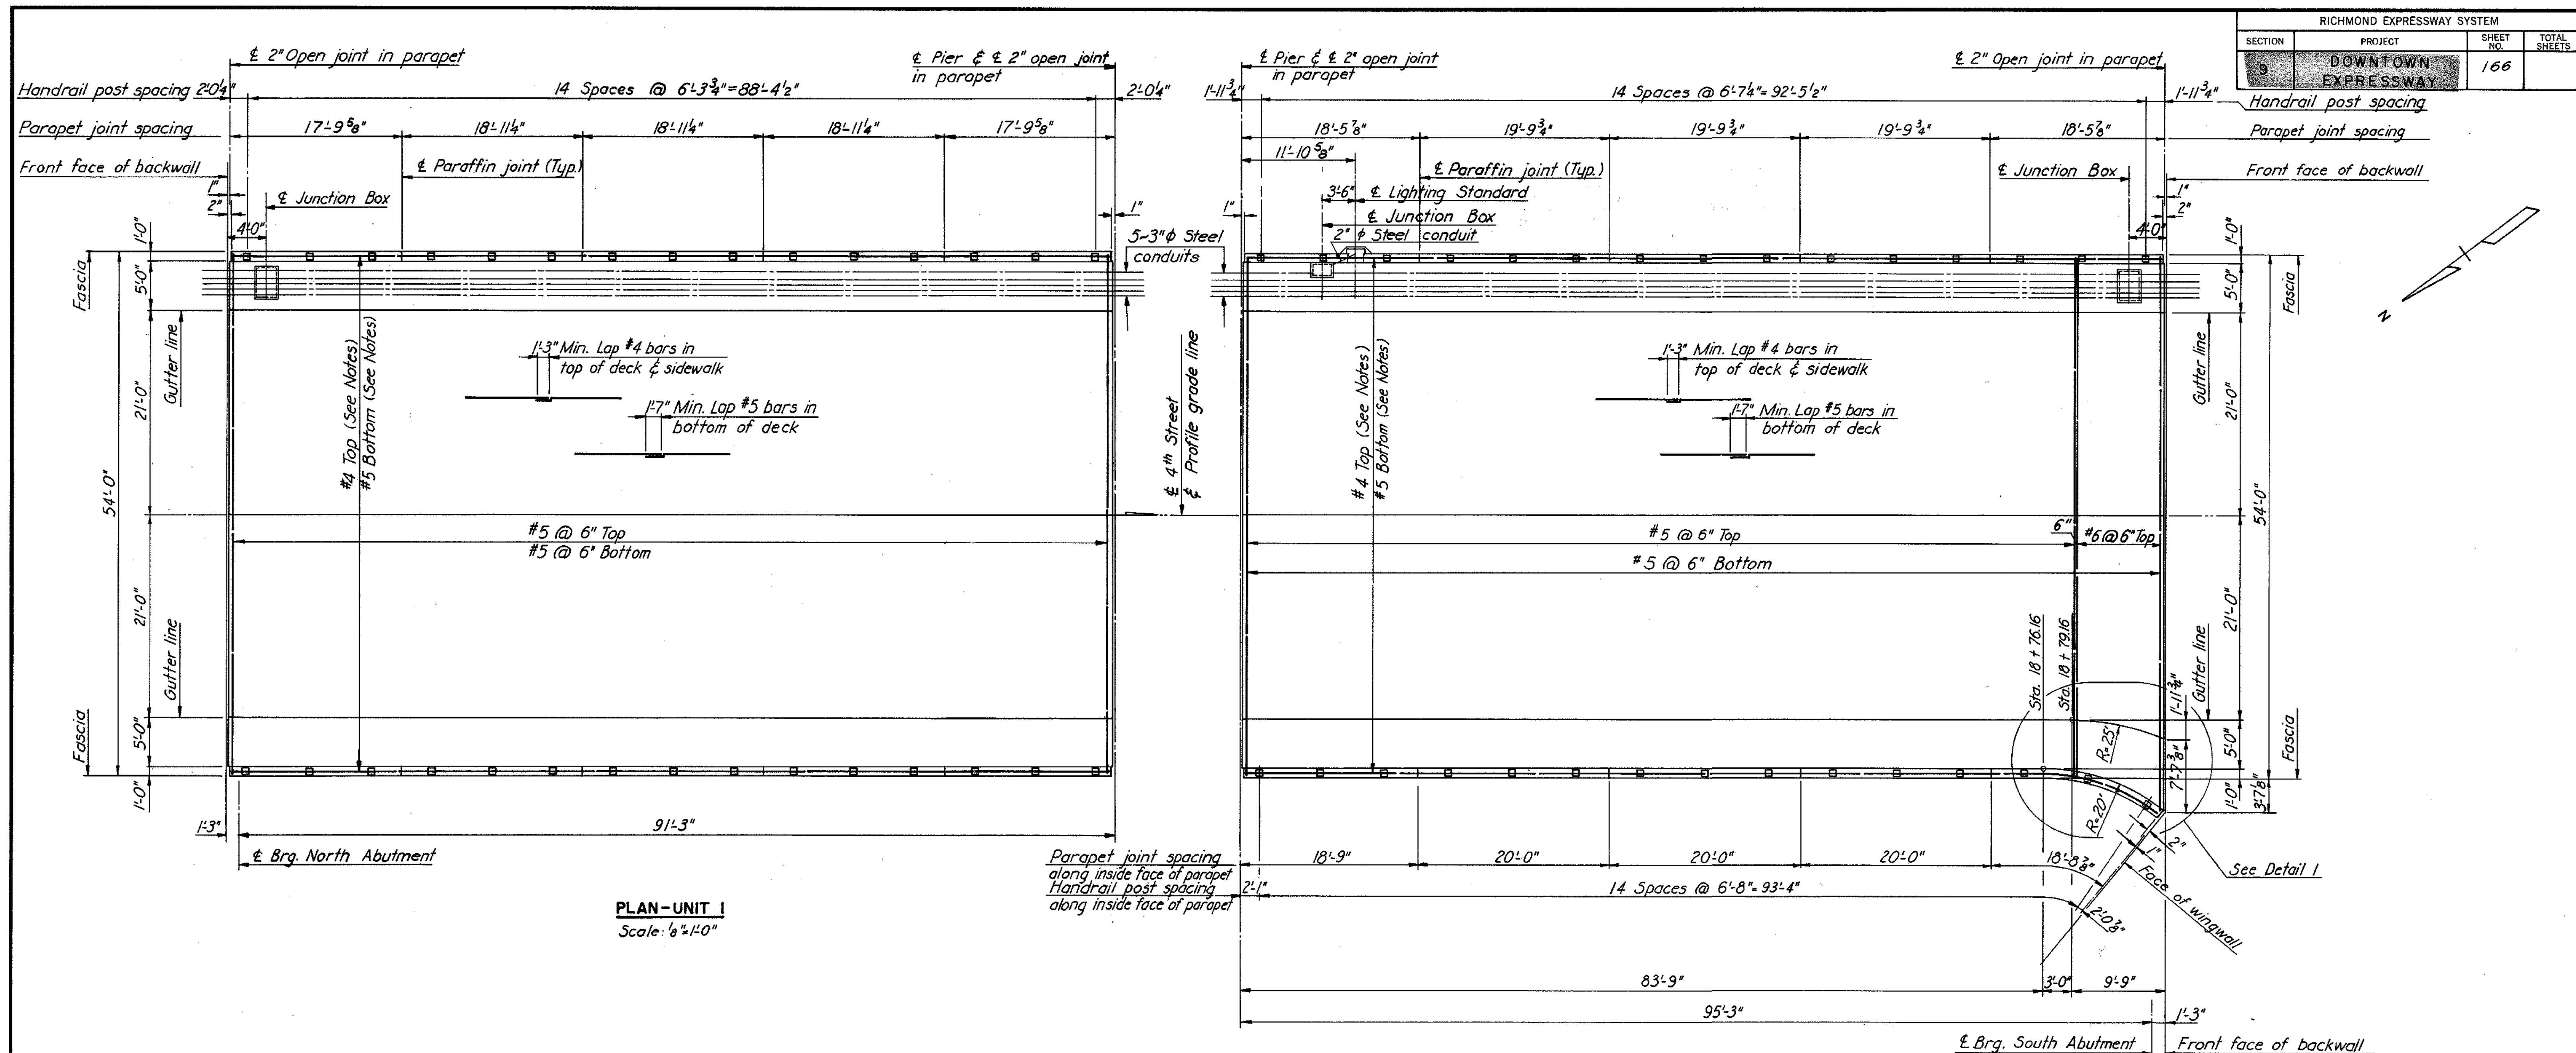

\* Elevations shown are given to top of bituminous surfacing.

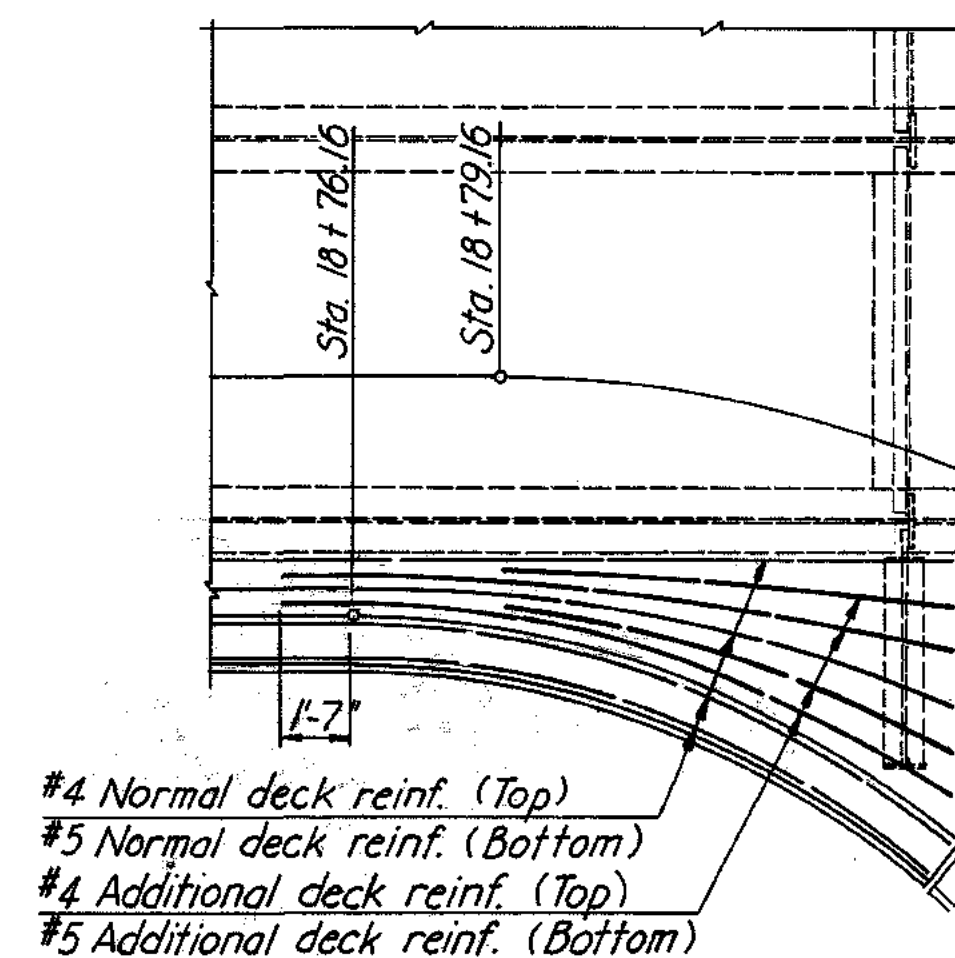

**NOTES:**

For location and spacing of deck, parapet and sidewalk reinforcing, see Cross Section and Utility Details sheet.

For location and spacing of reinforcing in haunch over end diaphragms, see Joint Details sheet.

For lighting standard base, junction box details and additional reinforcing, see Standard Electrical Details sheet S4.

**RICHMOND METROPOLITAN AUTHORITY**  
**RICHMOND EXPRESSWAY SYSTEM**  
 DOWNTOWN EXPRESSWAY  
 BRIDGE B-56  
 4TH STREET OVER  
 DOWNTOWN EXPRESSWAY  
**DECK PLANS**

HOWARD, NEEDLES, TAMMEN & BERGENDOFF  
 consulting engineers  
 NEW YORK ALEXANDRIA KANSAS CITY

SCALE: AS SHOWN  
 CONTRACT NO. 9  
 SHEET NO. 12 OF 15

BY	DATE				
MADE	A.B.P.	9-67			
CHECKED	T.E.M.	2-68	1	As Built	TEM 7-77
IN CHARGE	P.R.Y.		NO.	REVISION	BY DATE

AS BUILT

**Bridge 57**

**5<sup>th</sup> Street**

**Over**

**Downtown Expressway (VA 195)**




**Record Set Plans**





RICHMOND EXPRESSWAY SYSTEM			
SECTION	PROJECT	SHEET NO.	TOTAL SHEETS
9	DOWNTOWN EXPRESSWAY	170	

INDEX	
NO.	DESCRIPTION
1	General Plan and Elevation
2	General Notes and Quantities
3	North Abutment
4	North Abutment Details (1)
5	North Abutment Details (2)
6	South Abutment
7	South Abutment Details (1)
8	South Abutment Details (2)
9	Pier
10	Framing Plan
11	Cross Section and Utility Details
12	Deck Plans
13	Joint Details
14	Approach Slabs and Slope Protection
15	Boring Logs
S1	Standard Shoe Details
S3	Standard Aluminum Railing Details (2 Rails)
S4	Standard Electrical Details (Bridges Carrying City Streets)
S7	Standard Architectural Details
S8	Standard Architectural Details
S9	Standard Architectural Details
S10	Standard Conduit Installation Details
S11	Standard Utility Support Details at Bridge Abutments

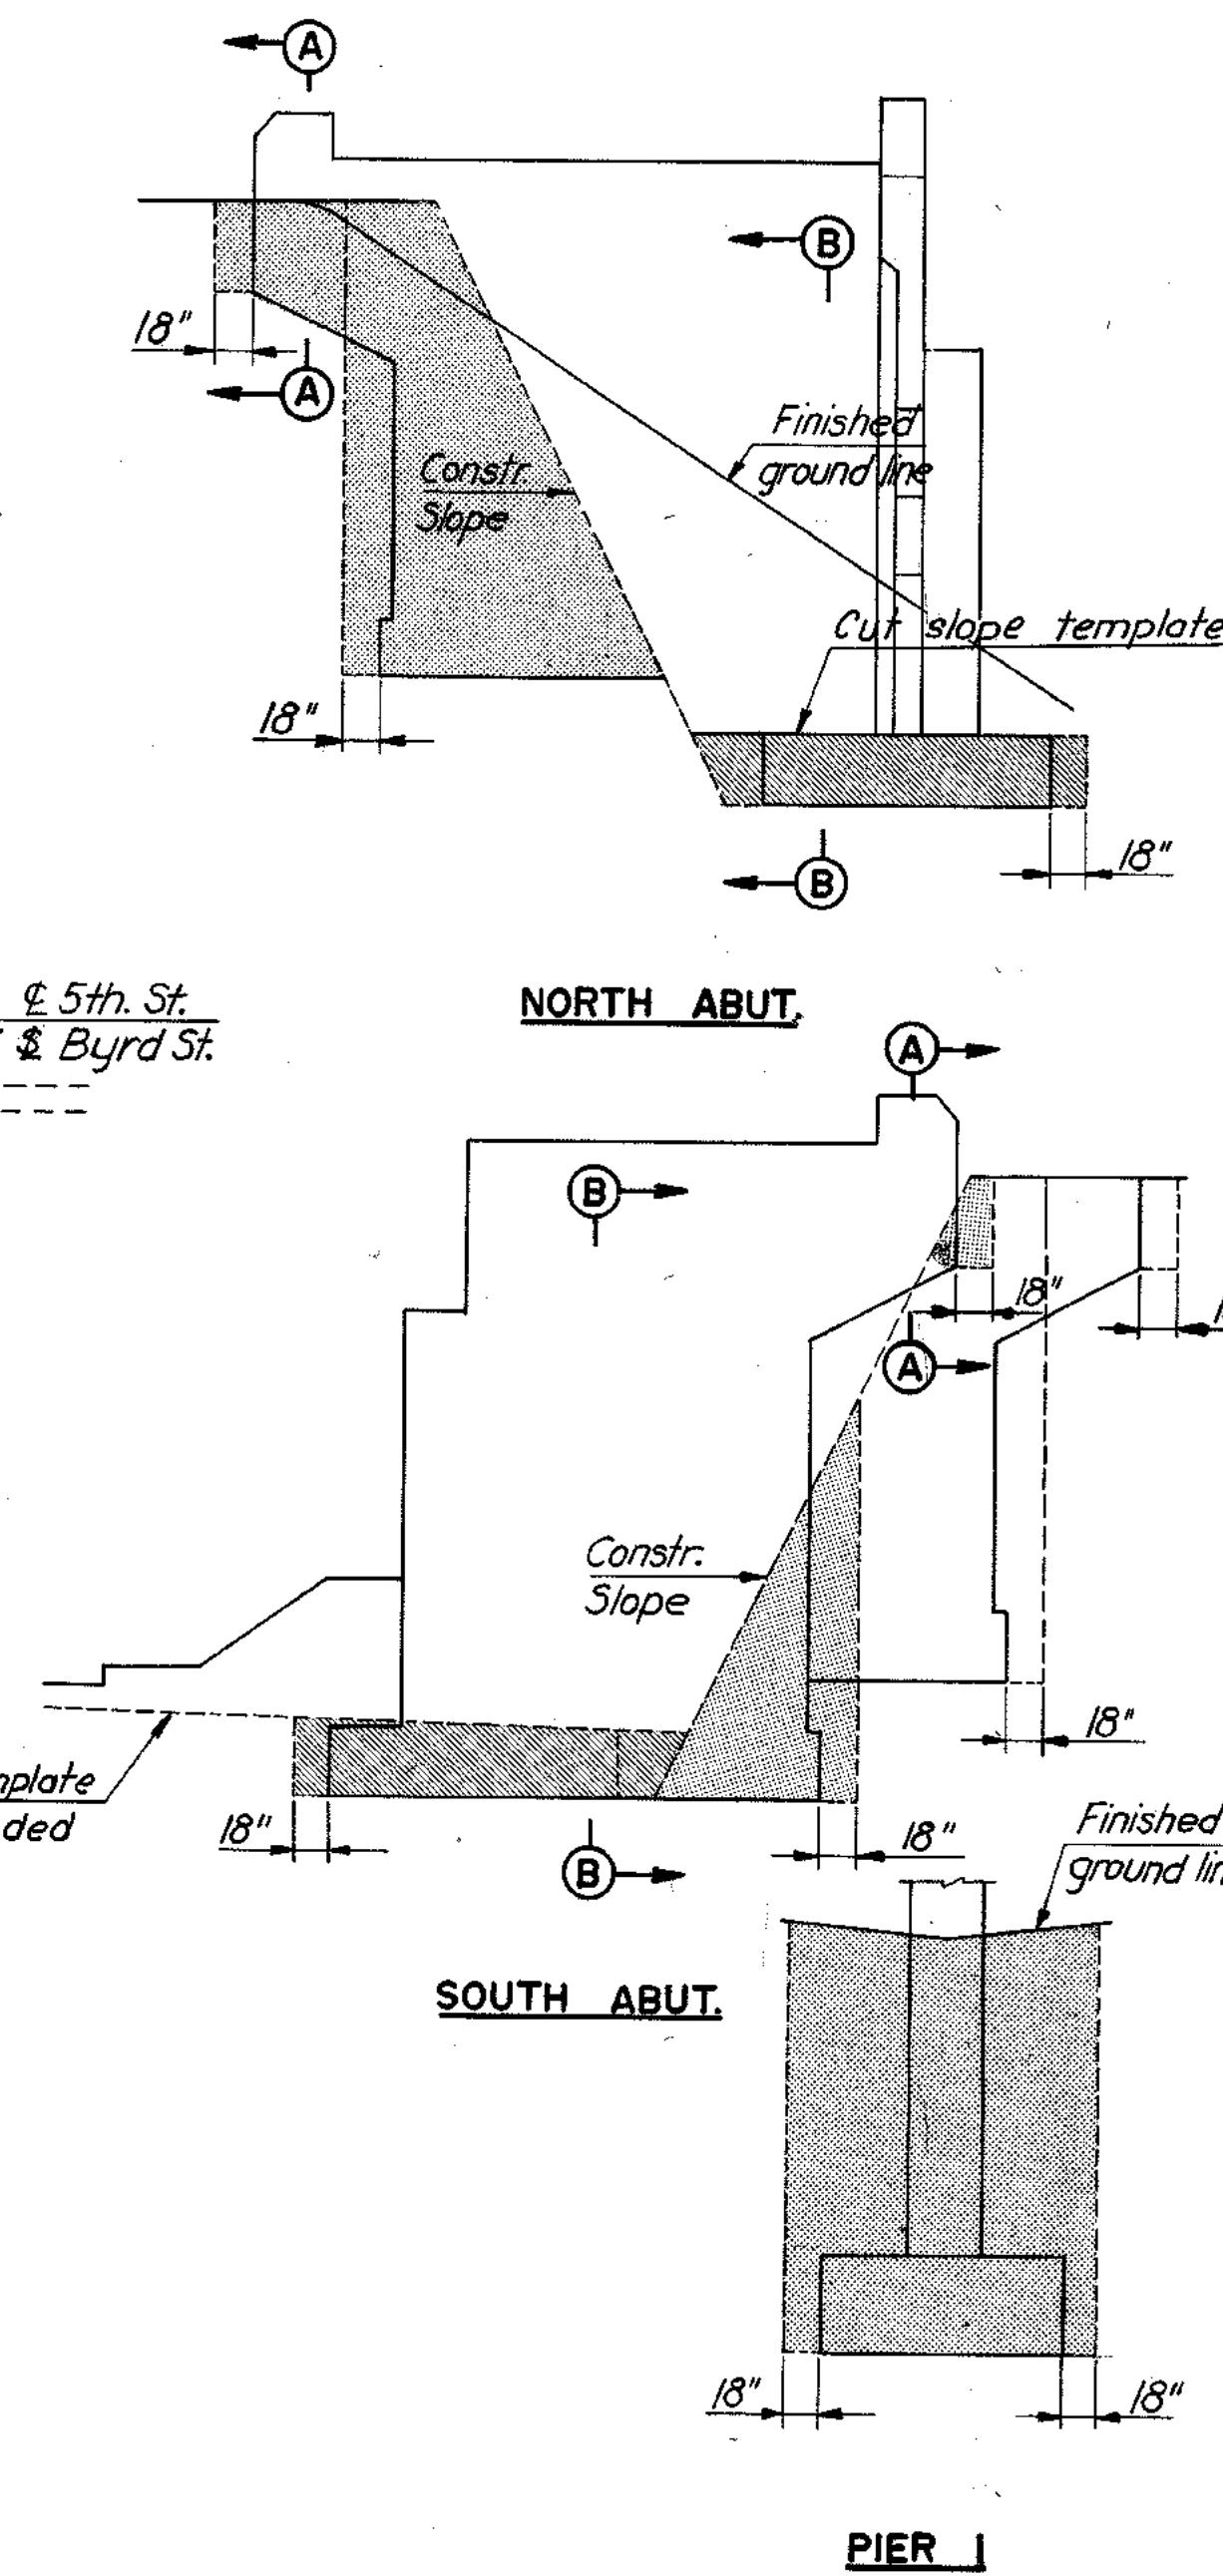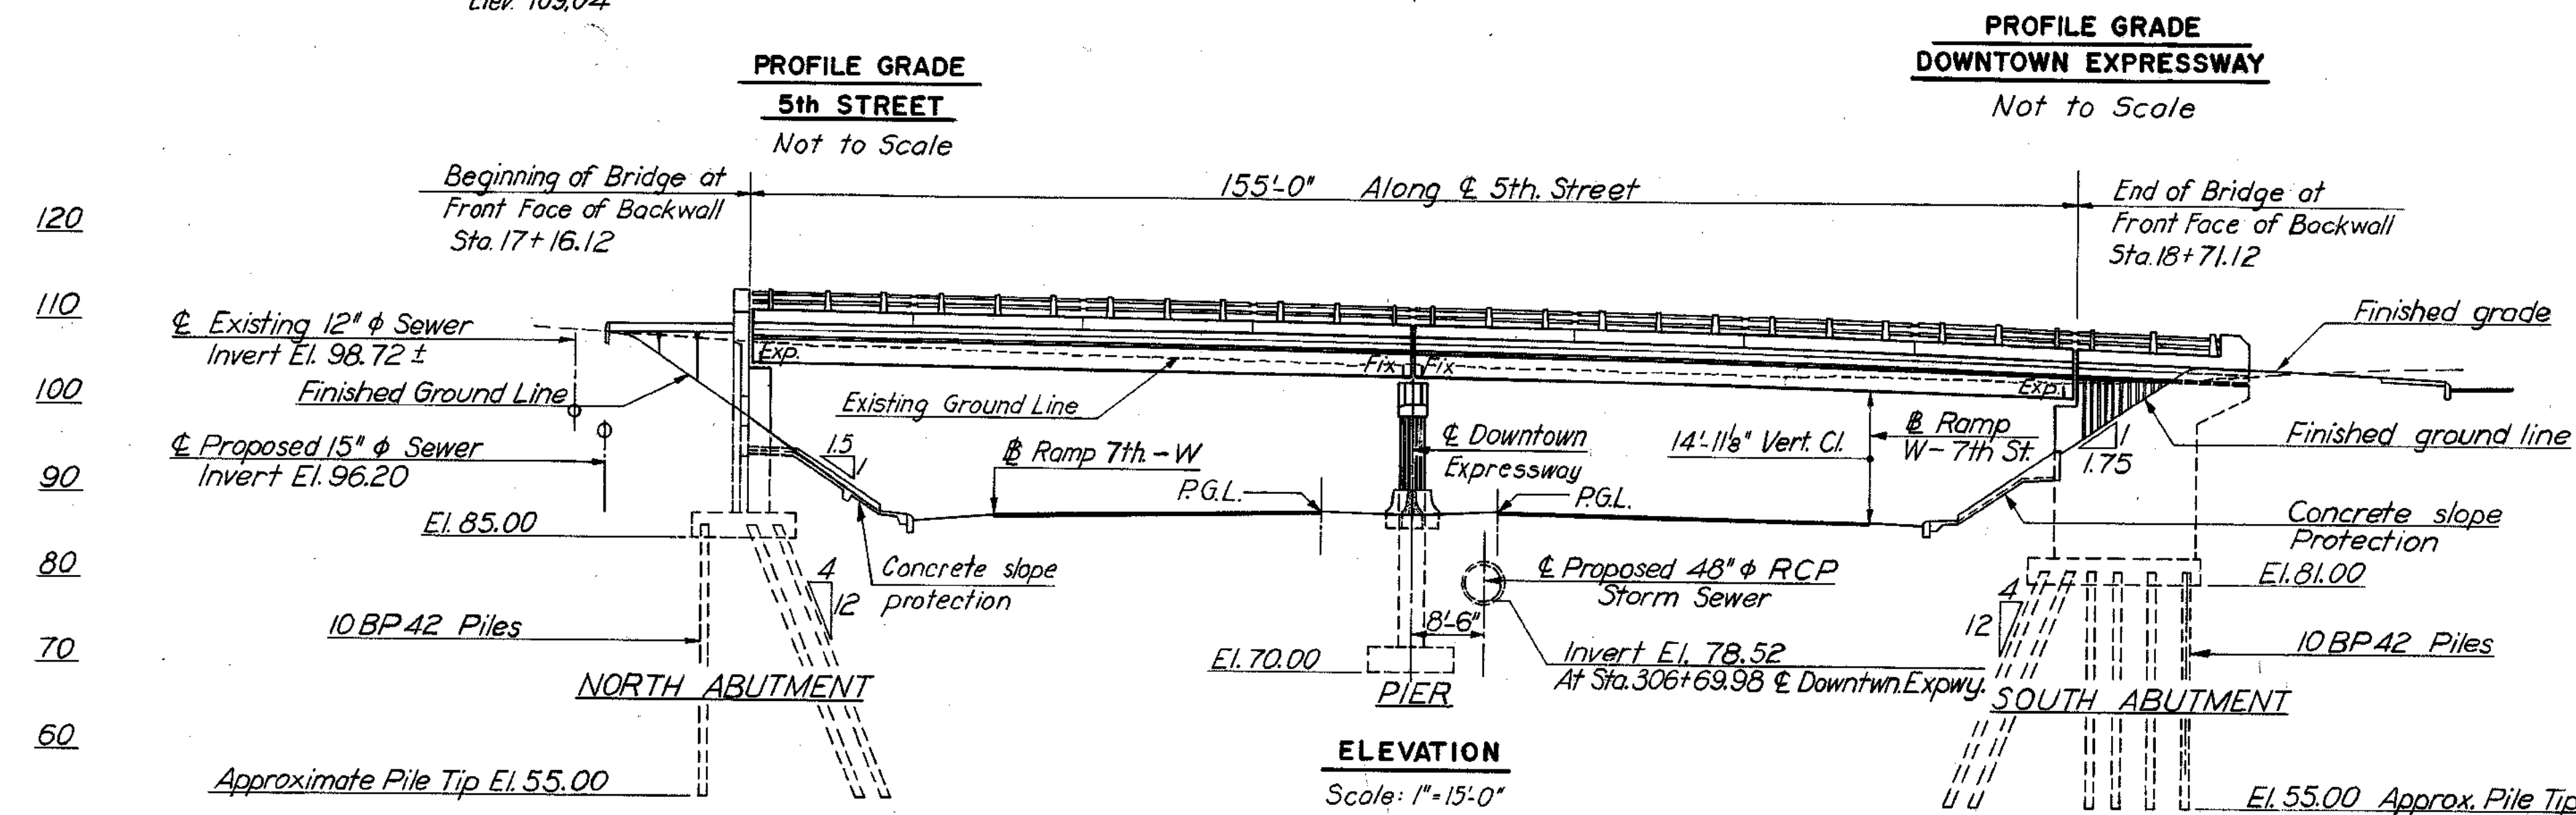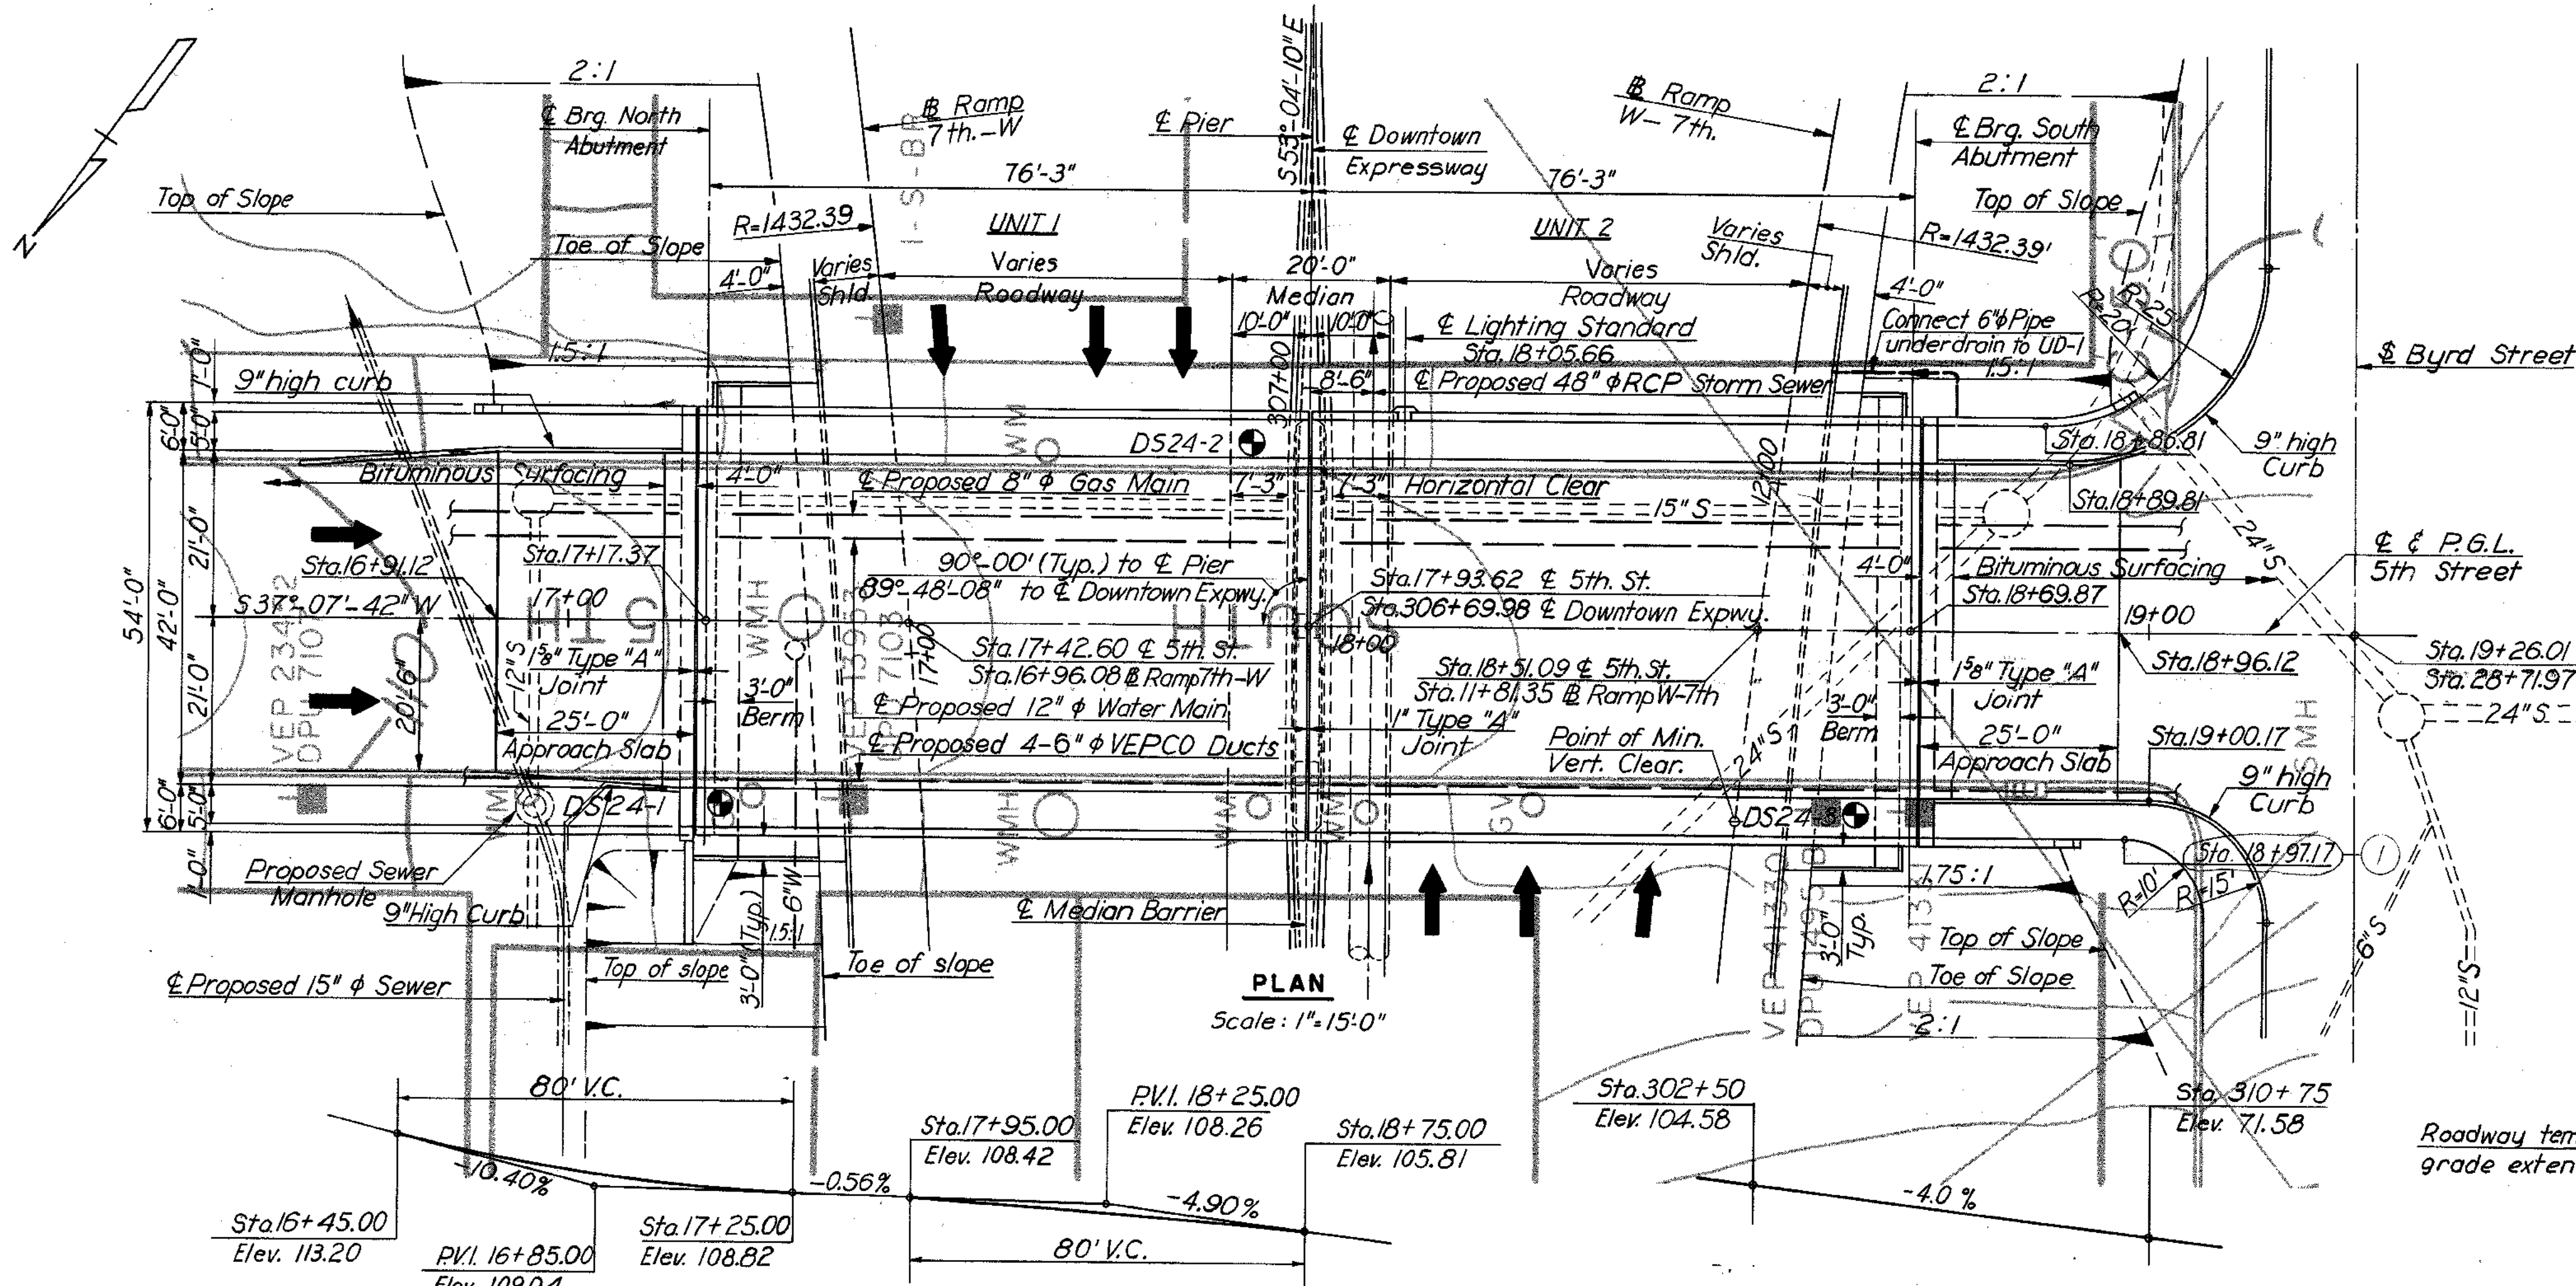

**PAYMENT LIMITS FOR STRUCTURE EXCAVATIONS**  
No Scale

**BORINGS:** Indicates location of 2 1/2" cased hole borings. For boring data, see Boring Logs sheet.  
**NOTE:** For General Notes and Quantities, see next sheet.

**RICHMOND METROPOLITAN AUTHORITY**  
**RICHMOND EXPRESSWAY SYSTEM**  
**DOWNTOWN EXPRESSWAY**  
**BRIDGE B-57**  
**5TH STREET OVER**  
**DOWNTOWN EXPRESSWAY**  
**GENERAL PLAN AND ELEVATION**

HOWARD, NEEDLES, TAMMEN & BERGENDOFF  
consulting engineers  
NEW YORK ALEXANDRIA KANSAS CITY

SCALE: AS SHOWN  
CONTRACT NO. 9  
SHEET NO. 1 OF 15

AS BUILT

BY	DATE				
MADE	JBM	1-68			
CHECKED	TEM	2-68	1	As Built	TEM 7-77
IN CHARGE	PRV		NO.	REVISION	BY



GENERAL NOTES

**ROADWAY CAPACITY:** One 42'-0" clear roadway. Two 5'-0" sidewalks. Dead Load-Includes 15 lbs. per sq.ft. for future wearing surface. Live Loads-HS20-44 loading and B.P.R. modified for military vehicles.

**SPECIFICATIONS:** GENERAL-Virginia Department of Highway Road and Bridge Specifications, 1970. DESIGN-A.S.T.M. Standard Specifications for Highway Bridges, 1961, modified by Special Design Provisions. WELDING-1969 Standard Specifications for Welded Highway and Railway Bridges of the American Welding Society.

**CONTRACT SPECIAL PROVISIONS**

Specifications and Contract Special Provisions referred to above are necessary to make these plans complete.

**DATUM:** CITY OF RICHMOND

**TEMPERATURE:** The normal temperature referred to on the plan is 60°F. The temperature range for movement is 0°F to 120°F.

**DIMENSIONS:** All dimensions are measured horizontally and vertically unless otherwise noted.

**EXCAVATION:** Excavation below subgrade and cut slope template shall be classified as Structure Excavation. All excavation above these limits shall be classified as Regular Excavation and is not included in the Structural Quantities.

**FOUNDATIONS:** Footings shall rest on firm material. Foundation material shall be kept dry and special attention is called to Section 401.05 of the General Specifications and to the Contract Special Provisions concerning preparation of foundations for footings.

**CONCRETE NOTES:** Concrete in superstructure shall be Class A4. All other concrete shall be Class A3. All exposed edges and corners shall have a 3/4" chamfer or fillet unless otherwise noted. Care in the method of vibration, the use of low-slump concrete, and/or other means shall be employed to prevent downgrade movement of newly placed slab concrete (when gradient is over 2%).

Finishing Concrete Surfaces: See the Standard Architectural Details sheets and the Contract Special Provisions for types and details.

All reinforcing steel shall conform to ASTM A615 Grade 40. All reinforcing bar dimensions on the detailed drawings are to centers of bars unless otherwise noted. Clear distance between reinforcing steel and face of concrete shall be as noted on the plans. All bar laps shall be 30 diameters of the smaller diameter bar unless otherwise noted.

**STEEL NOTES:** Structural steel shall conform to A.S.T.M. Specification A36 except as noted. All field connections shall be made with high strength bolts. High strength bolts shall be 7/8" diameter unless otherwise noted and shall conform to A.S.T.M. Specifications A325.

**BENCH MARKS:** See Reference Ties and Field Control Data sheet in highway plans.

C-50 Plug, corner Byrd St. and S. 5th St., Elev. 102.41  
C-51 Copper weld rod, corner E. Canal St. and S. 5th St., Elev. 124.46

FINAL QUANTITIES

	STRUCTURE EXCAVATION C.Y.	CONCRETE CLASS A3 C.Y.	CONCRETE CLASS A3 BR. APPR. SLABS C.Y.	CONCRETE CLASS A4 C.Y.	REINFORCING STEEL LBS.	STRUCTURAL STEEL LBS.	ALUMINUM BR. RAILING (2 RAILS) L.F.	POROUS BACKFILL C.Y.	STEEL PILES 10BP42 L.F.	CONC. SLAB SLOPE PROTECTION S.Y.	DAMP-PROOFING S.Y.	UNDERDRAIN 6" Ø L.F.	GAS MAIN 8" Ø L.F.	WATER MAIN 12" Ø L.F.	CONDUIT 6" Ø VEP CO L.F.	METAL CONDUIT 3" Ø L.F.	
SUPERSTRUCTURE				286.22	63,335	300,021	309.4						213	210	828	1065	
NORTH ABUTMENT	201	251.08			25,224		24.6	76	1,254.2	110.73	148	106					
PIER I	440	123.74			24,376												
SOUTH ABUTMENT	152	280.89			29,631		42.3	92	975.8	87.19	171	113					
APPROACH SLABS			115.3		25,732												
TOTAL	793	655.37	115.3	286.22	168,298	300,021	376.3	168	2,230.0	197.92	319	219	213	210	828	1065	

	BY	DATE				
MADE	EVR	3-68				
CHECKED	A.B.P.	5-68	1	As Built	TEM	7-77
IN CHARGE	PRK		NO.	REVISION	BY	DATE

AS BUILT



RICHMOND METROPOLITAN AUTHORITY RICHMOND EXPRESSWAY SYSTEM DOWNTOWN EXPRESSWAY	
BRIDGE B-57 5TH STREET OVER DOWNTOWN EXPRESSWAY GENERAL NOTES AND QUANTITIES	
HOWARD, NEEDLES, TAMMEN & BERGENDOFF consulting engineers NEW YORK ALEXANDRIA KANSAS CITY	SCALE: AS SHOWN CONTRACT NO. 9 SHEET NO. 2 OF 15








RICHMOND EXPRESSWAY SYSTEM			
SECTION	PROJECT	SHEET NO.	TOTAL SHEETS
9	DOWNTOWN EXPRESSWAY	179	

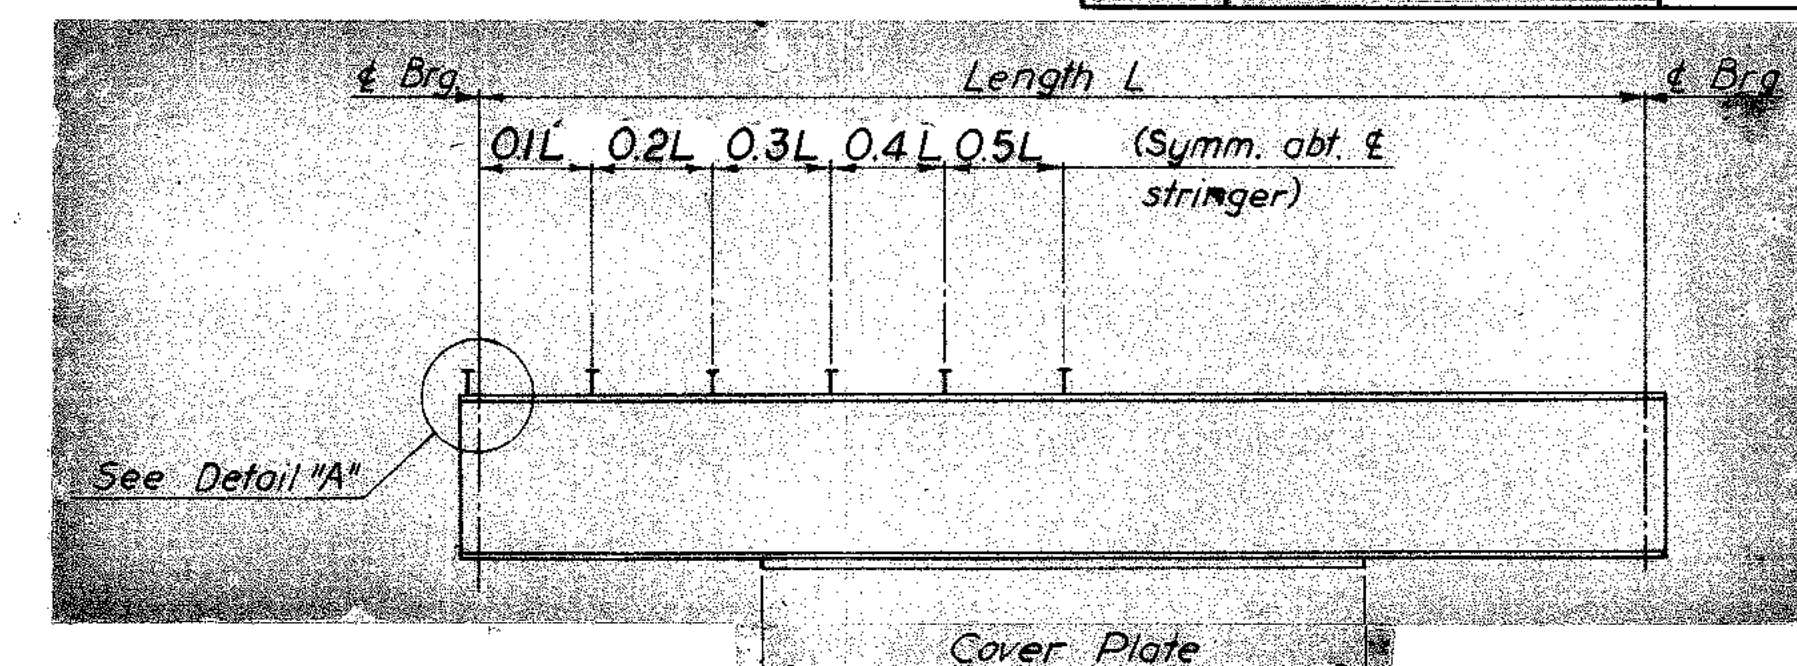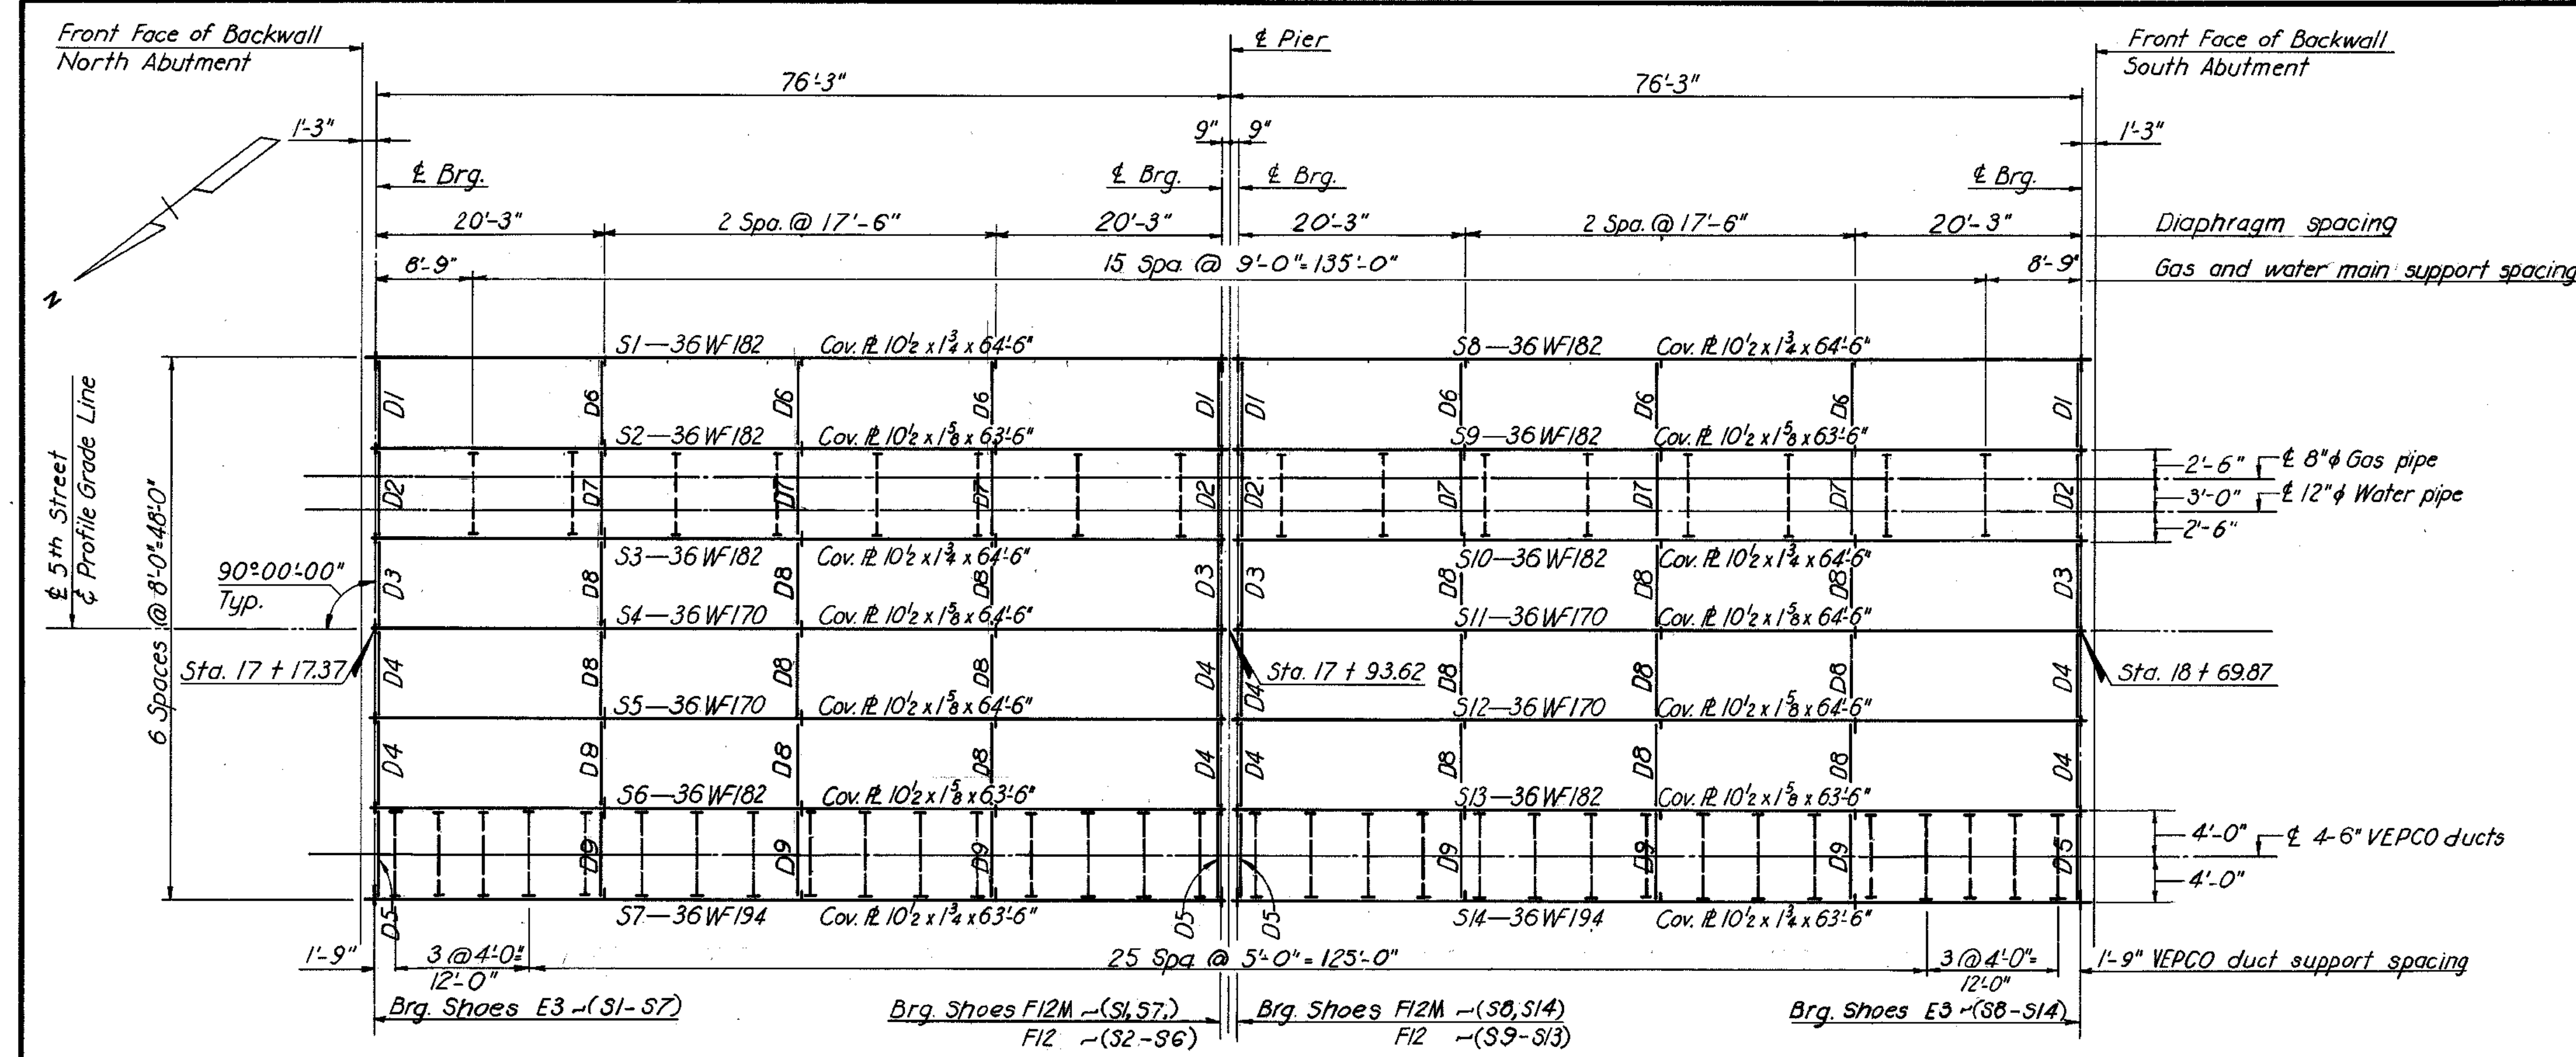


STRINGER SCHEDULE						
STRINGER	LENGTH € BRG. TO € BRG.	SHEAR STUD SPACING				
		0.1L	0.2L	0.3L	0.4L	0.5L
S1, S8	75'-6"	7'	8'	11'	13 1/2'	15 1/2'
S2, S9					13'	14 1/2'
S3, S10					13'	14 1/2'
S4, S11					12 1/2'	14'
S5, S12					12 1/2'	14'
S6, S13					12 1/2'	14 1/2'
S7, S14	75'-6"	7'	8'	11'	13 1/2'	16'

Note: Lengths shown are horizontal distances measured along centerlines of stringers.

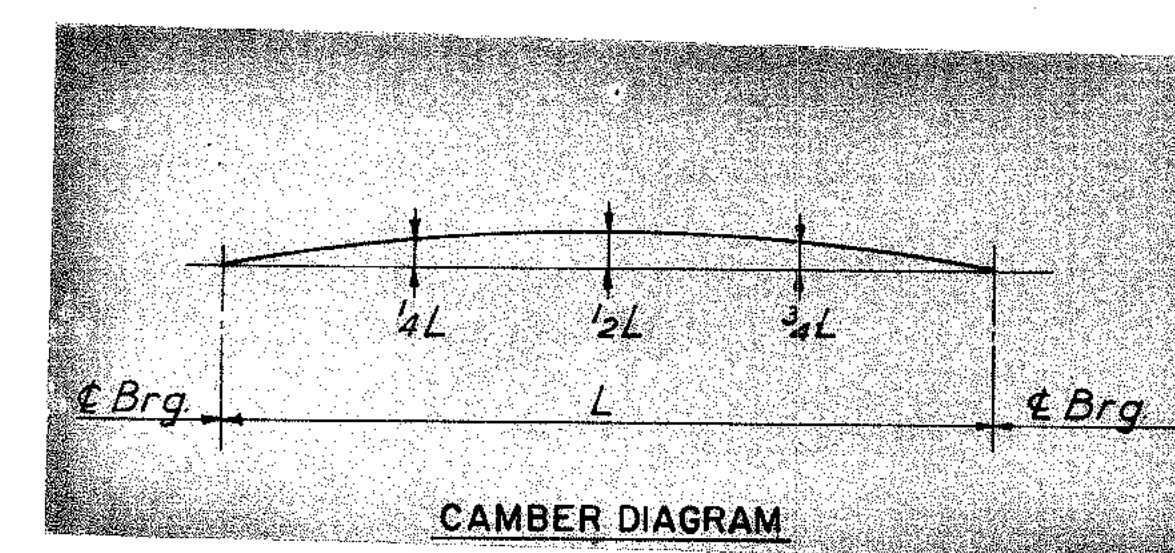



CAMBER SCHEDULE			
STR.	1/4L	1/2L	3/4L
S7	1"	1 5/8"	
S1, S6	1"	1 3/4"	1 1/2"
S2, S5	1 1/8"		
S14	5 1/2"	6 1/2"	
S8, S13	5 1/2"	6 3/8"	4 3/8"
S9, S12	5 3/8"		

NOTE TO FABRICATOR:  
The above stringers shall be fabricated with an upward camber amounting to the tabulated value.  
This will provide approximate compensation for deflection under full dead load and for conformity with finished grade.  
Dimensions are in inches.

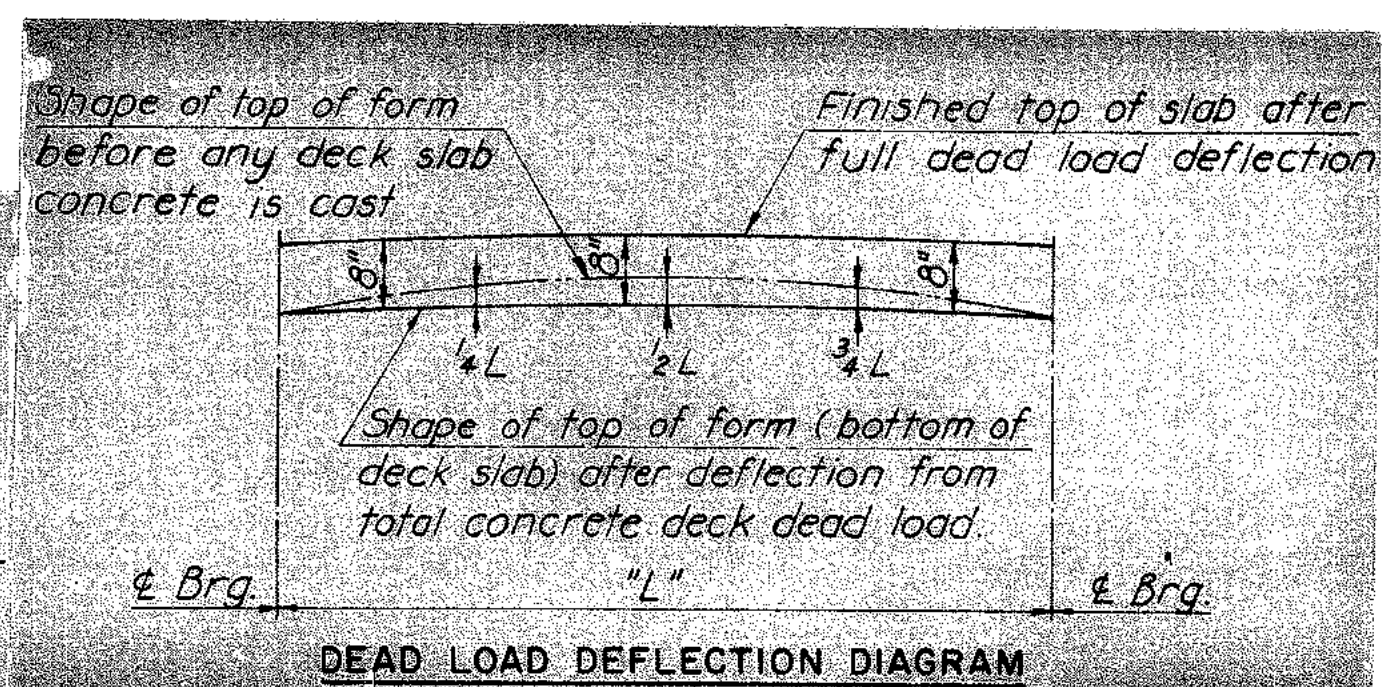


DEFLECTION SCHEDULE			
STR.	1/4L	1/2L	3/4L
S1, S4, S5			
S7, S8, S11	1 1/8"	1 1/2"	
S12, S14			
S2, S3, S6			
S9, S10, S13	1"	1 1/2"	

NOTE TO CONTRACTOR:  
The above deflections are those anticipated to occur in the stringer upon placement of the total concrete deck dead load.  
In practice, the stringers in place are not likely to have the exact camber to compensate for these deflections during construction. The residual amounts shall be provided for by adjusting forms to vary the thickness of the concrete bolster between the bottom of the slab and the top of stringer, without alteration of the slab thickness.

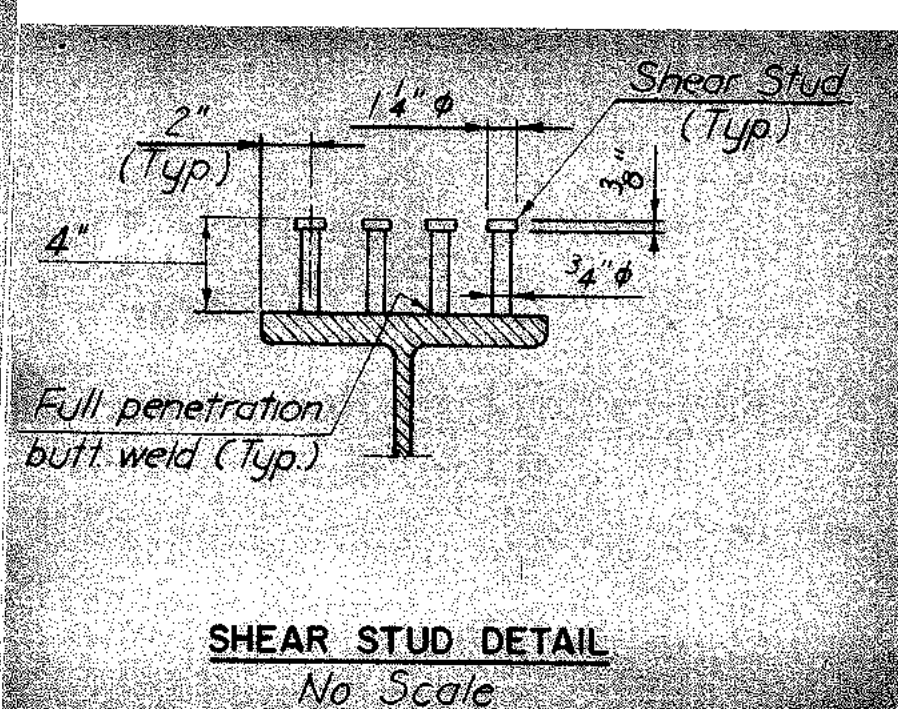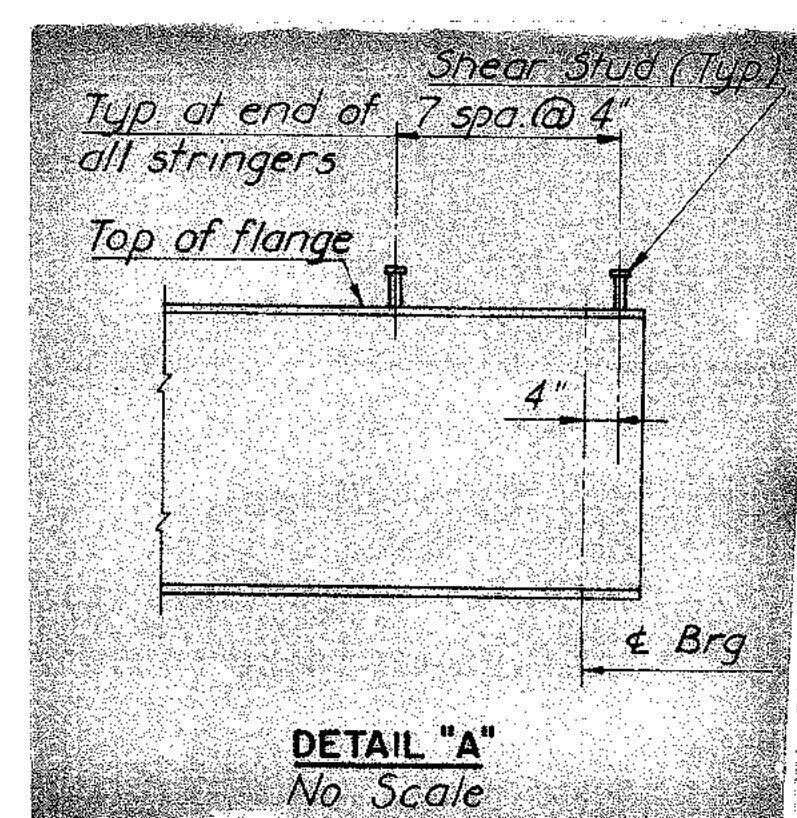

SHEAR STUD NOTE:  
Capacity = 3,400 lbs. per stud.  
The contractor may, if he elects, use three 1/2" diameter studs at the same longitudinal spacing in lieu of the four 1/2" diameter studs shown.  
Stud rows shall be placed parallel to the main deck reinforcing.  
Shear stud spacing shown is maximum spacing.

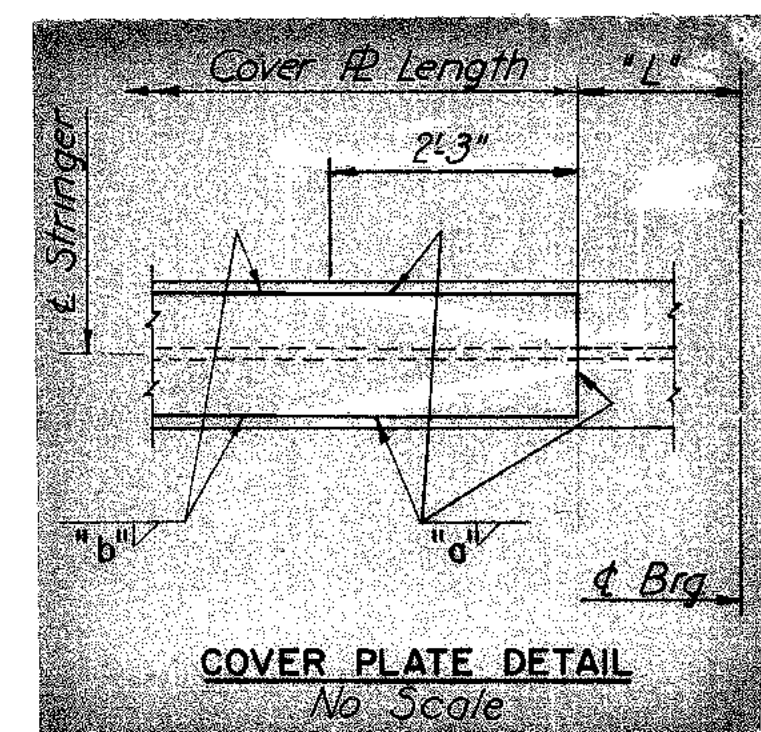

COVER PLATE SCHEDULE				
STR.	COVER R.	"L"	"a"	"b"
S1, S8	10 1/2 x 1 3/4	5'-6"	5/8"	3/8"
S3, S10		5'-6"		
S7, S14	10 1/2 x 1 3/4	6'-0"		
S2, S9	10 1/2 x 1 3/8	6'-0"		
S4, S11		5'-6"		
S5, S12		5'-6"		
S6, S13	10 1/2 x 1 3/8	6'-0"	5/8"	3/8"

SHOE SCHEDULE			
EXPANSION SHOES		FIXED SHOES	
TYPE	NO. REQD.	TYPE	NO. REQD.
E3	14	F12	10
		F12M	4

RICHMOND METROPOLITAN AUTHORITY  
RICHMOND EXPRESSWAY SYSTEM  
DOWNTOWN EXPRESSWAY

BRIDGE B-57  
5TH STREET OVER  
DOWNTOWN EXPRESSWAY

FRAMING PLAN

HOWARD, NEEDLES, TAMMEN & BERGENDOFF  
consulting engineers  
NEW YORK ALEXANDRIA KANSAS CITY

SCALE: AS SHOWN  
CONTRACT NO. 9  
SHEET NO. 10 OF 15

AS BUILT


BY	DATE				
MADE	DLA 12-67				
CHECKED	TEM 2-68	1	As Built	TEM 7-77	
IN CHARGE	PRY	NO.	REVISION	BY	DATE






RICHMOND EXPRESSWAY SYSTEM			
SECTION	PROJECT	SHEET NO.	TOTAL SHEETS
9	DOWNTOWN EXPRESSWAY	180	

TABLE A	
STRINGER	DIM "A"
S1-S6, S8-S13	94"
S7, S14	96"





**NOTE "A"**  
Dimension shown is measured from top of stringer to top of slab at the intersection of the centerline of stringer and the centerline of bearing. At exterior stringers this is measured to the cross slope extended. This dimension may be varied between bearings as required to care for variation in camber, except that no portion of the stringer flange may fall within the 8" slab.

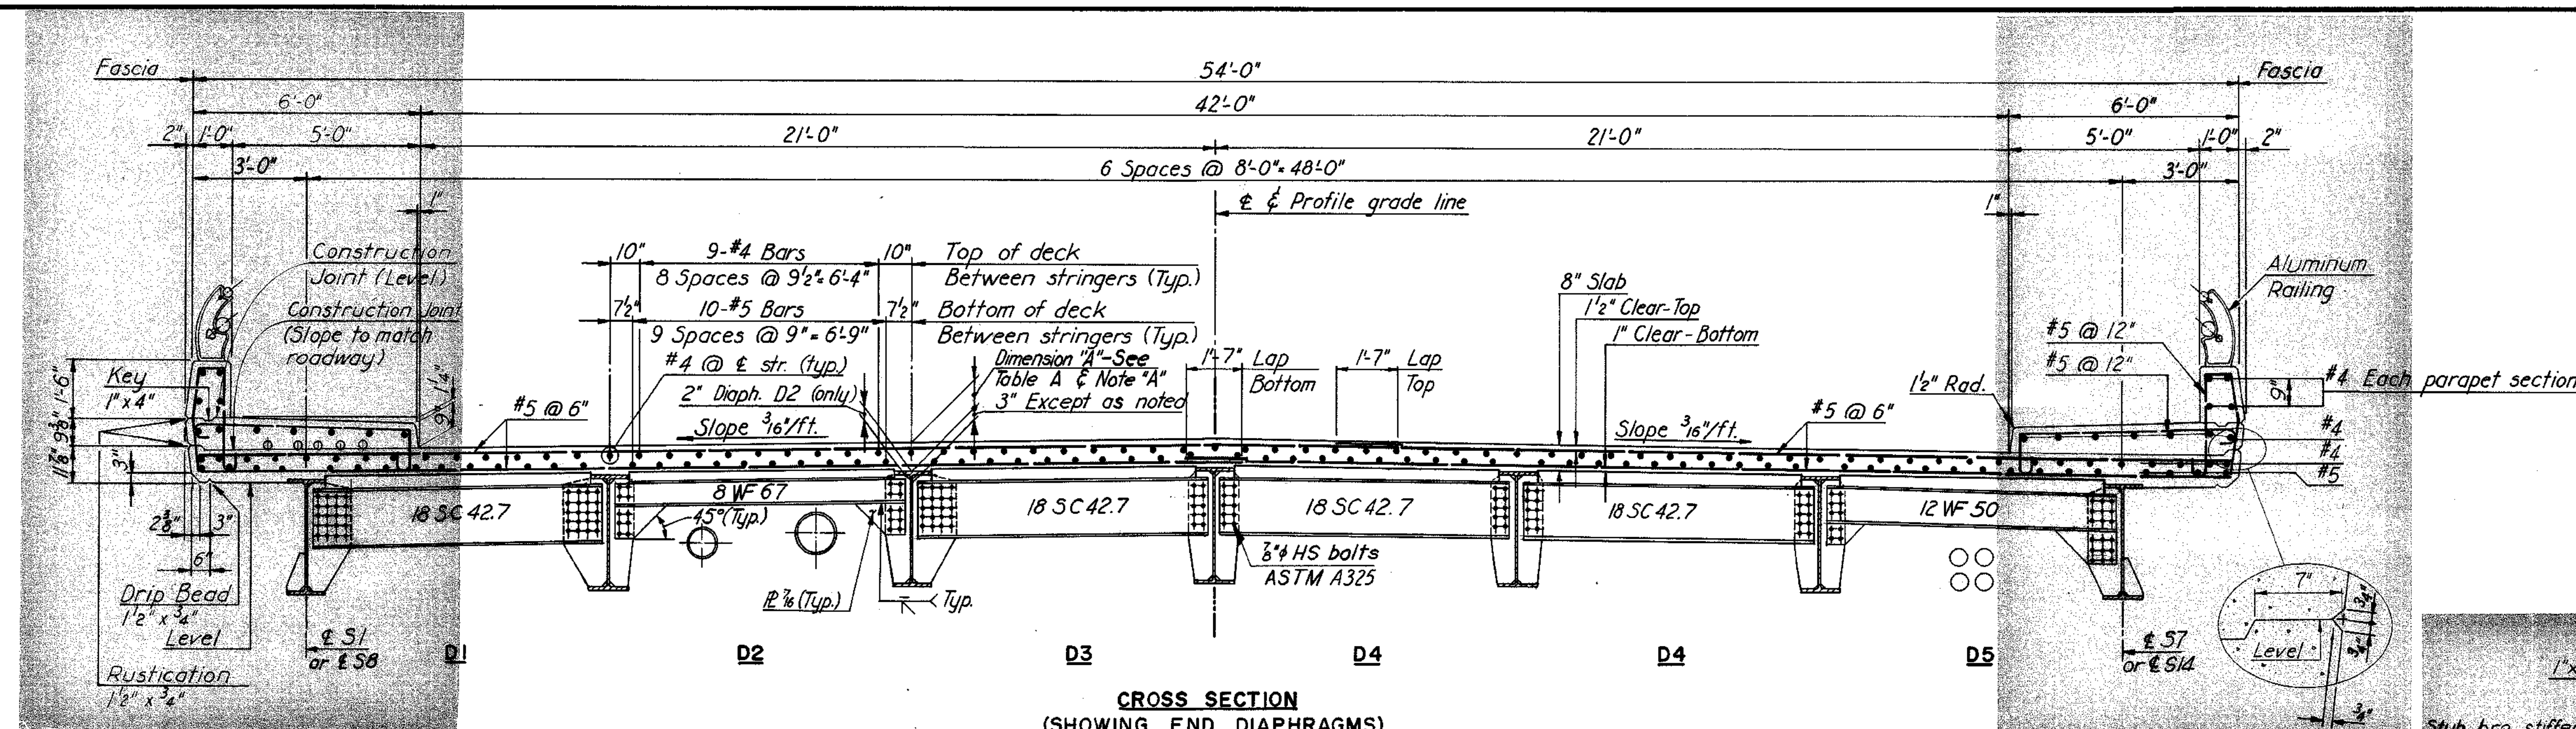

**CROSS SECTION  
(SHOWING END DIAPHRAGMS)**  
Scale: 3/8"=1'-0"

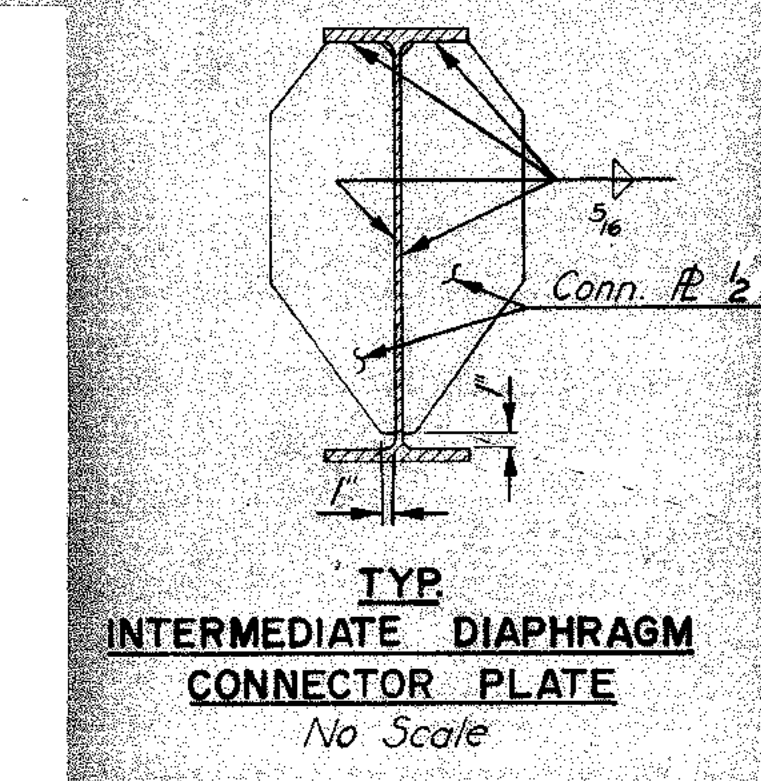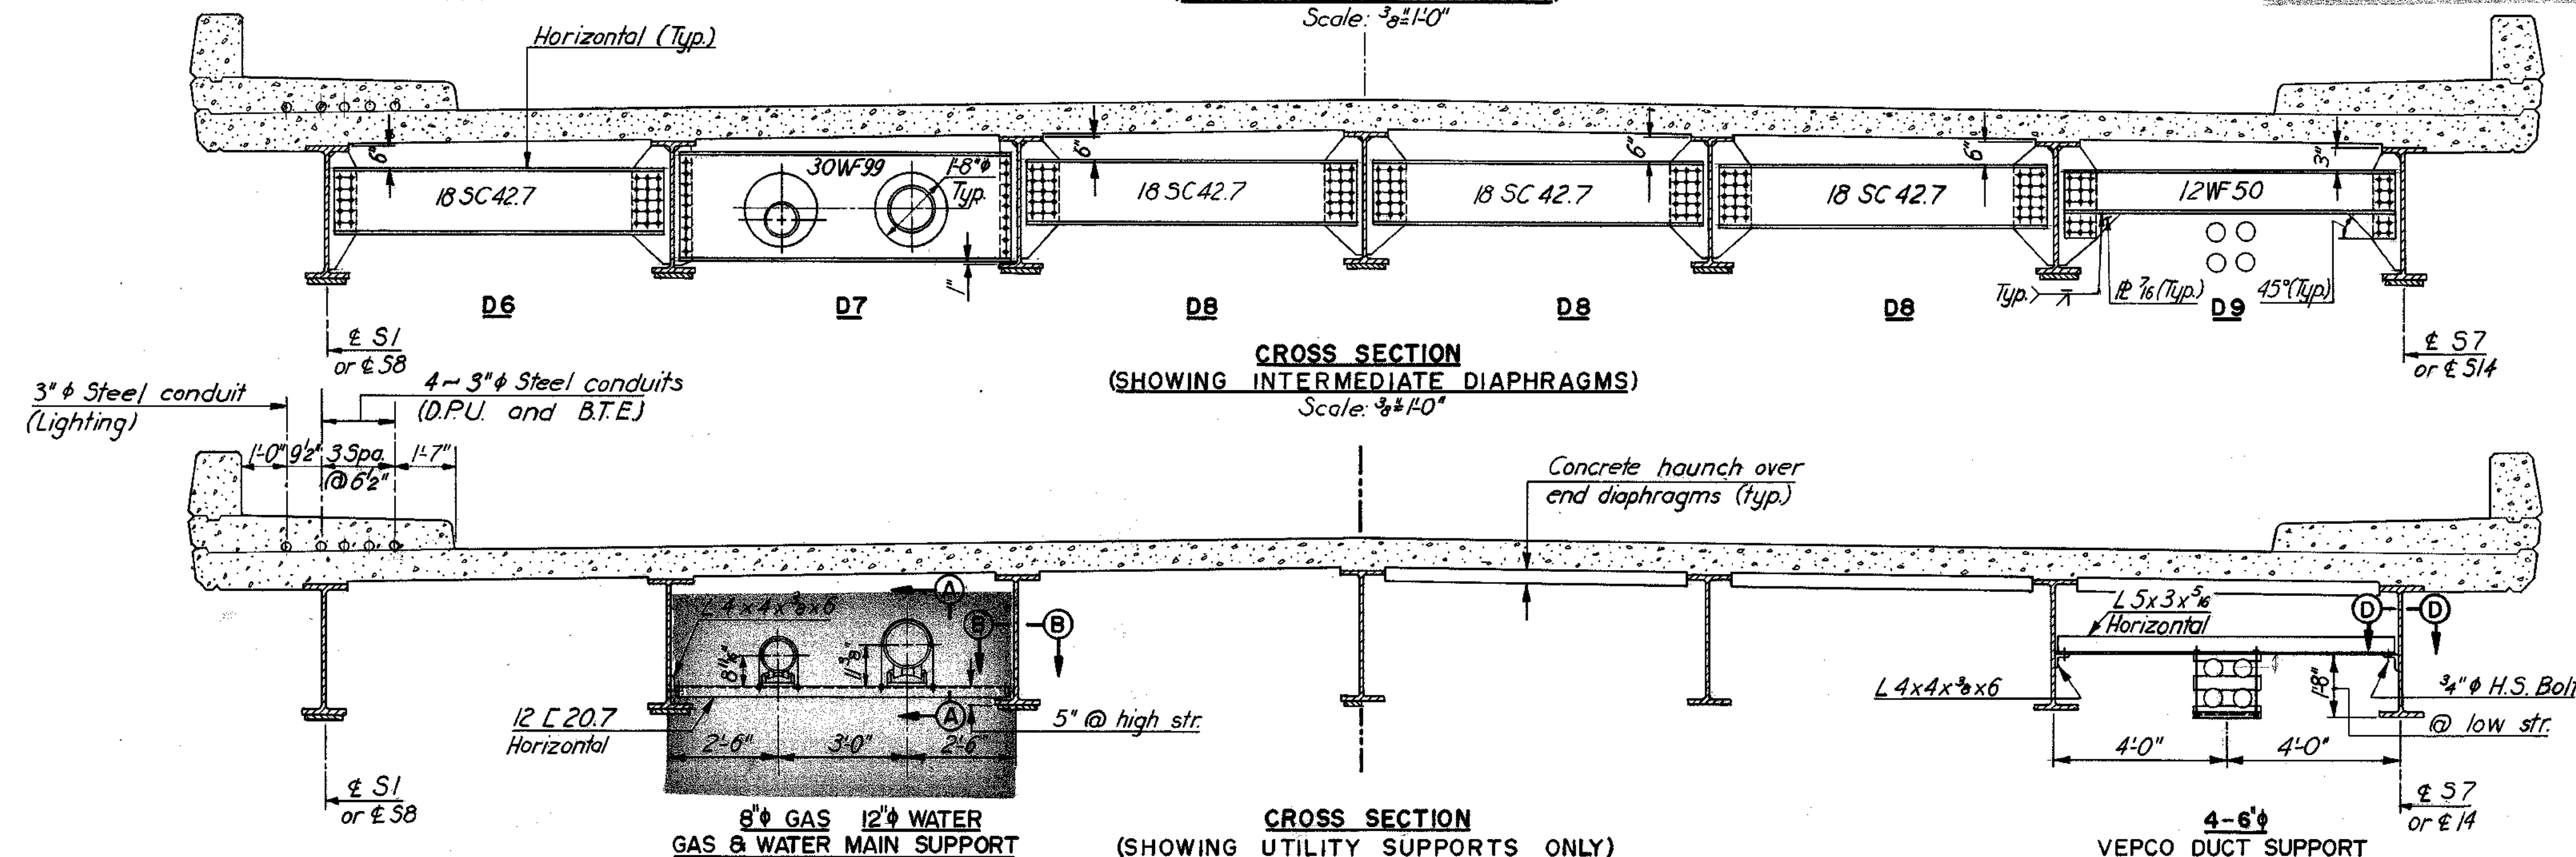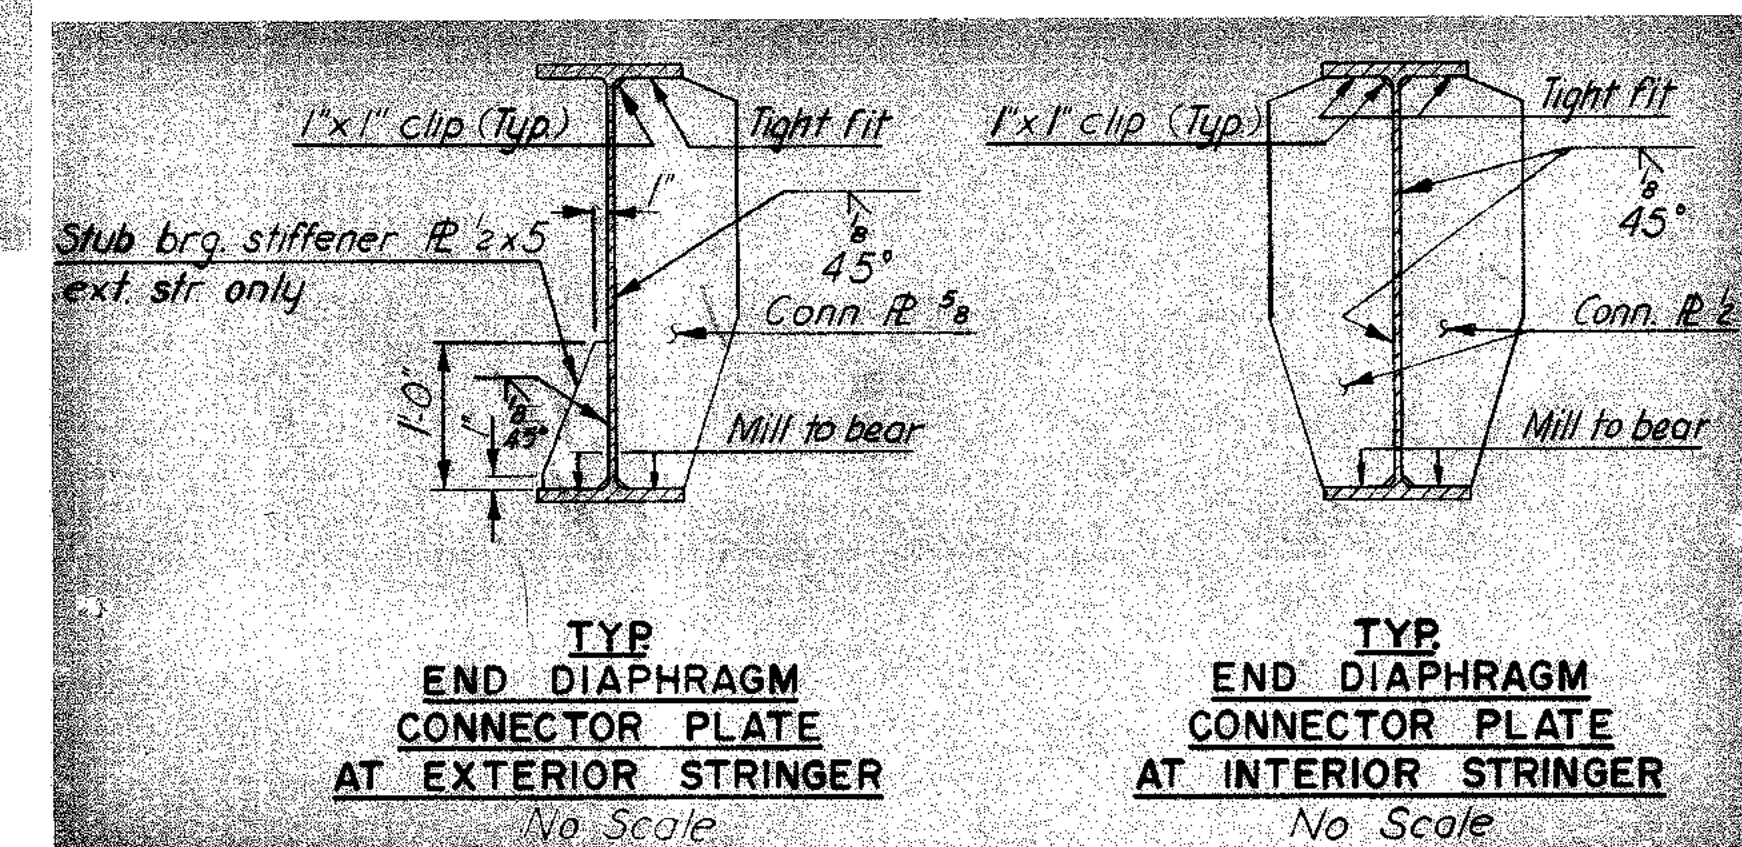

**NOTES:**  
For spacing and location of utility supports and diaphragms, see Framing Plan sheet.  
For Basic Attachment Details for cement asbestos conduit, see Standard Conduit Installation Details sheet.  
For details showing gas and water mains thru abutments, see Standard Utility Support Details At Bridge Abutments sheet.

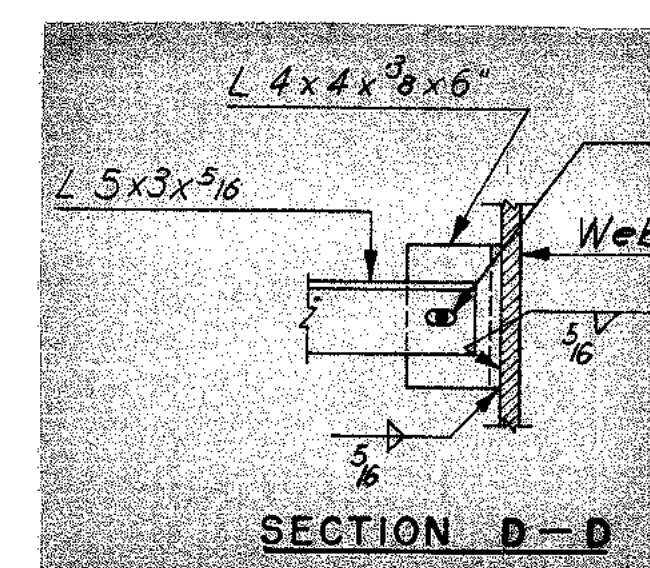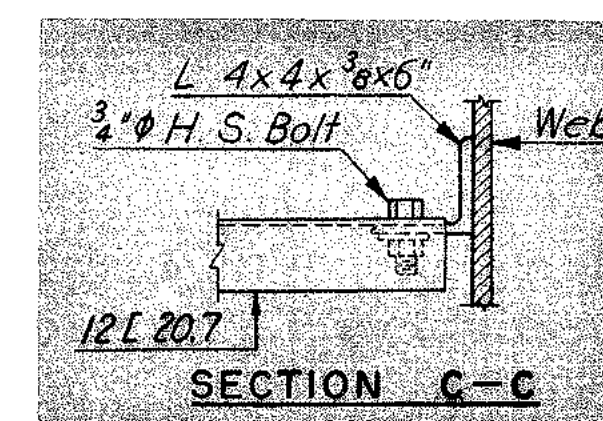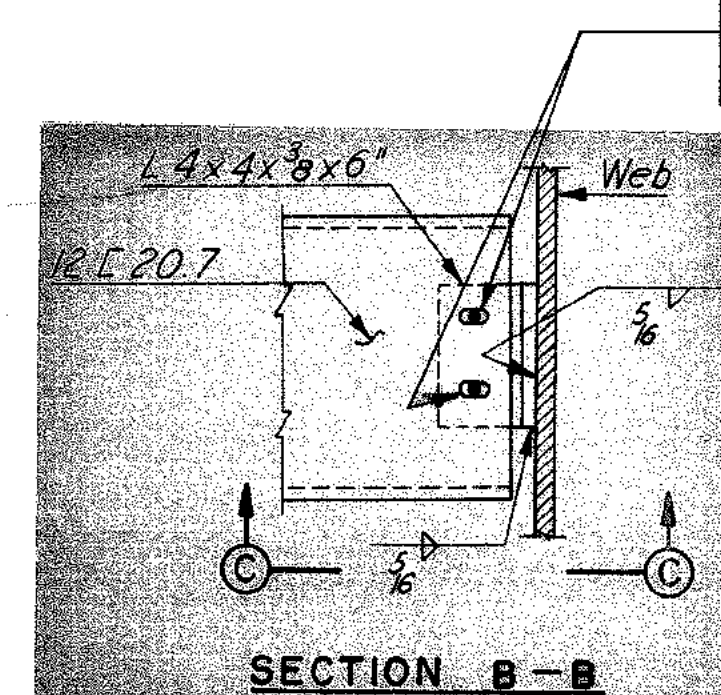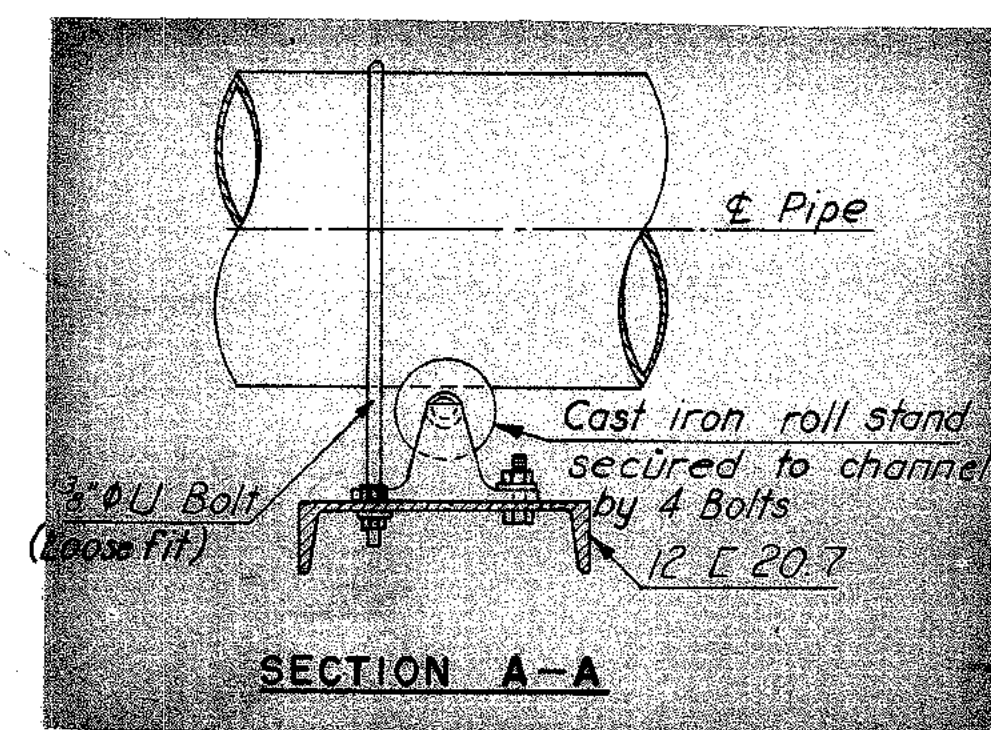


BY	DATE				
MADE	EVR	11-67			
CHECKED	TEM	2-68	1	As Built	TEM 7-77
IN CHARGE	PRY		NO.	REVISION	BY

AS BUILT


RICHMOND METROPOLITAN AUTHORITY	
RICHMOND EXPRESSWAY SYSTEM	
DOWNTOWN EXPRESSWAY	
BRIDGE B-57	
5TH STREET OVER	
DOWNTOWN EXPRESSWAY	
CROSS SECTION AND UTILITY DETAILS	
HOWARD, NEEDLES, TAMMEN & BERGENDOFF consulting engineers NEW YORK ALEXANDRIA KANSAS CITY	SCALE: AS SHOWN CONTRACT NO. 9 SHEET NO. 11 OF 15




RICHMOND EXPRESSWAY SYSTEM			
SECTION	PROJECT	SHEET NO.	TOTAL SHEETS
9	DOWNTOWN EXPRESSWAY	131	

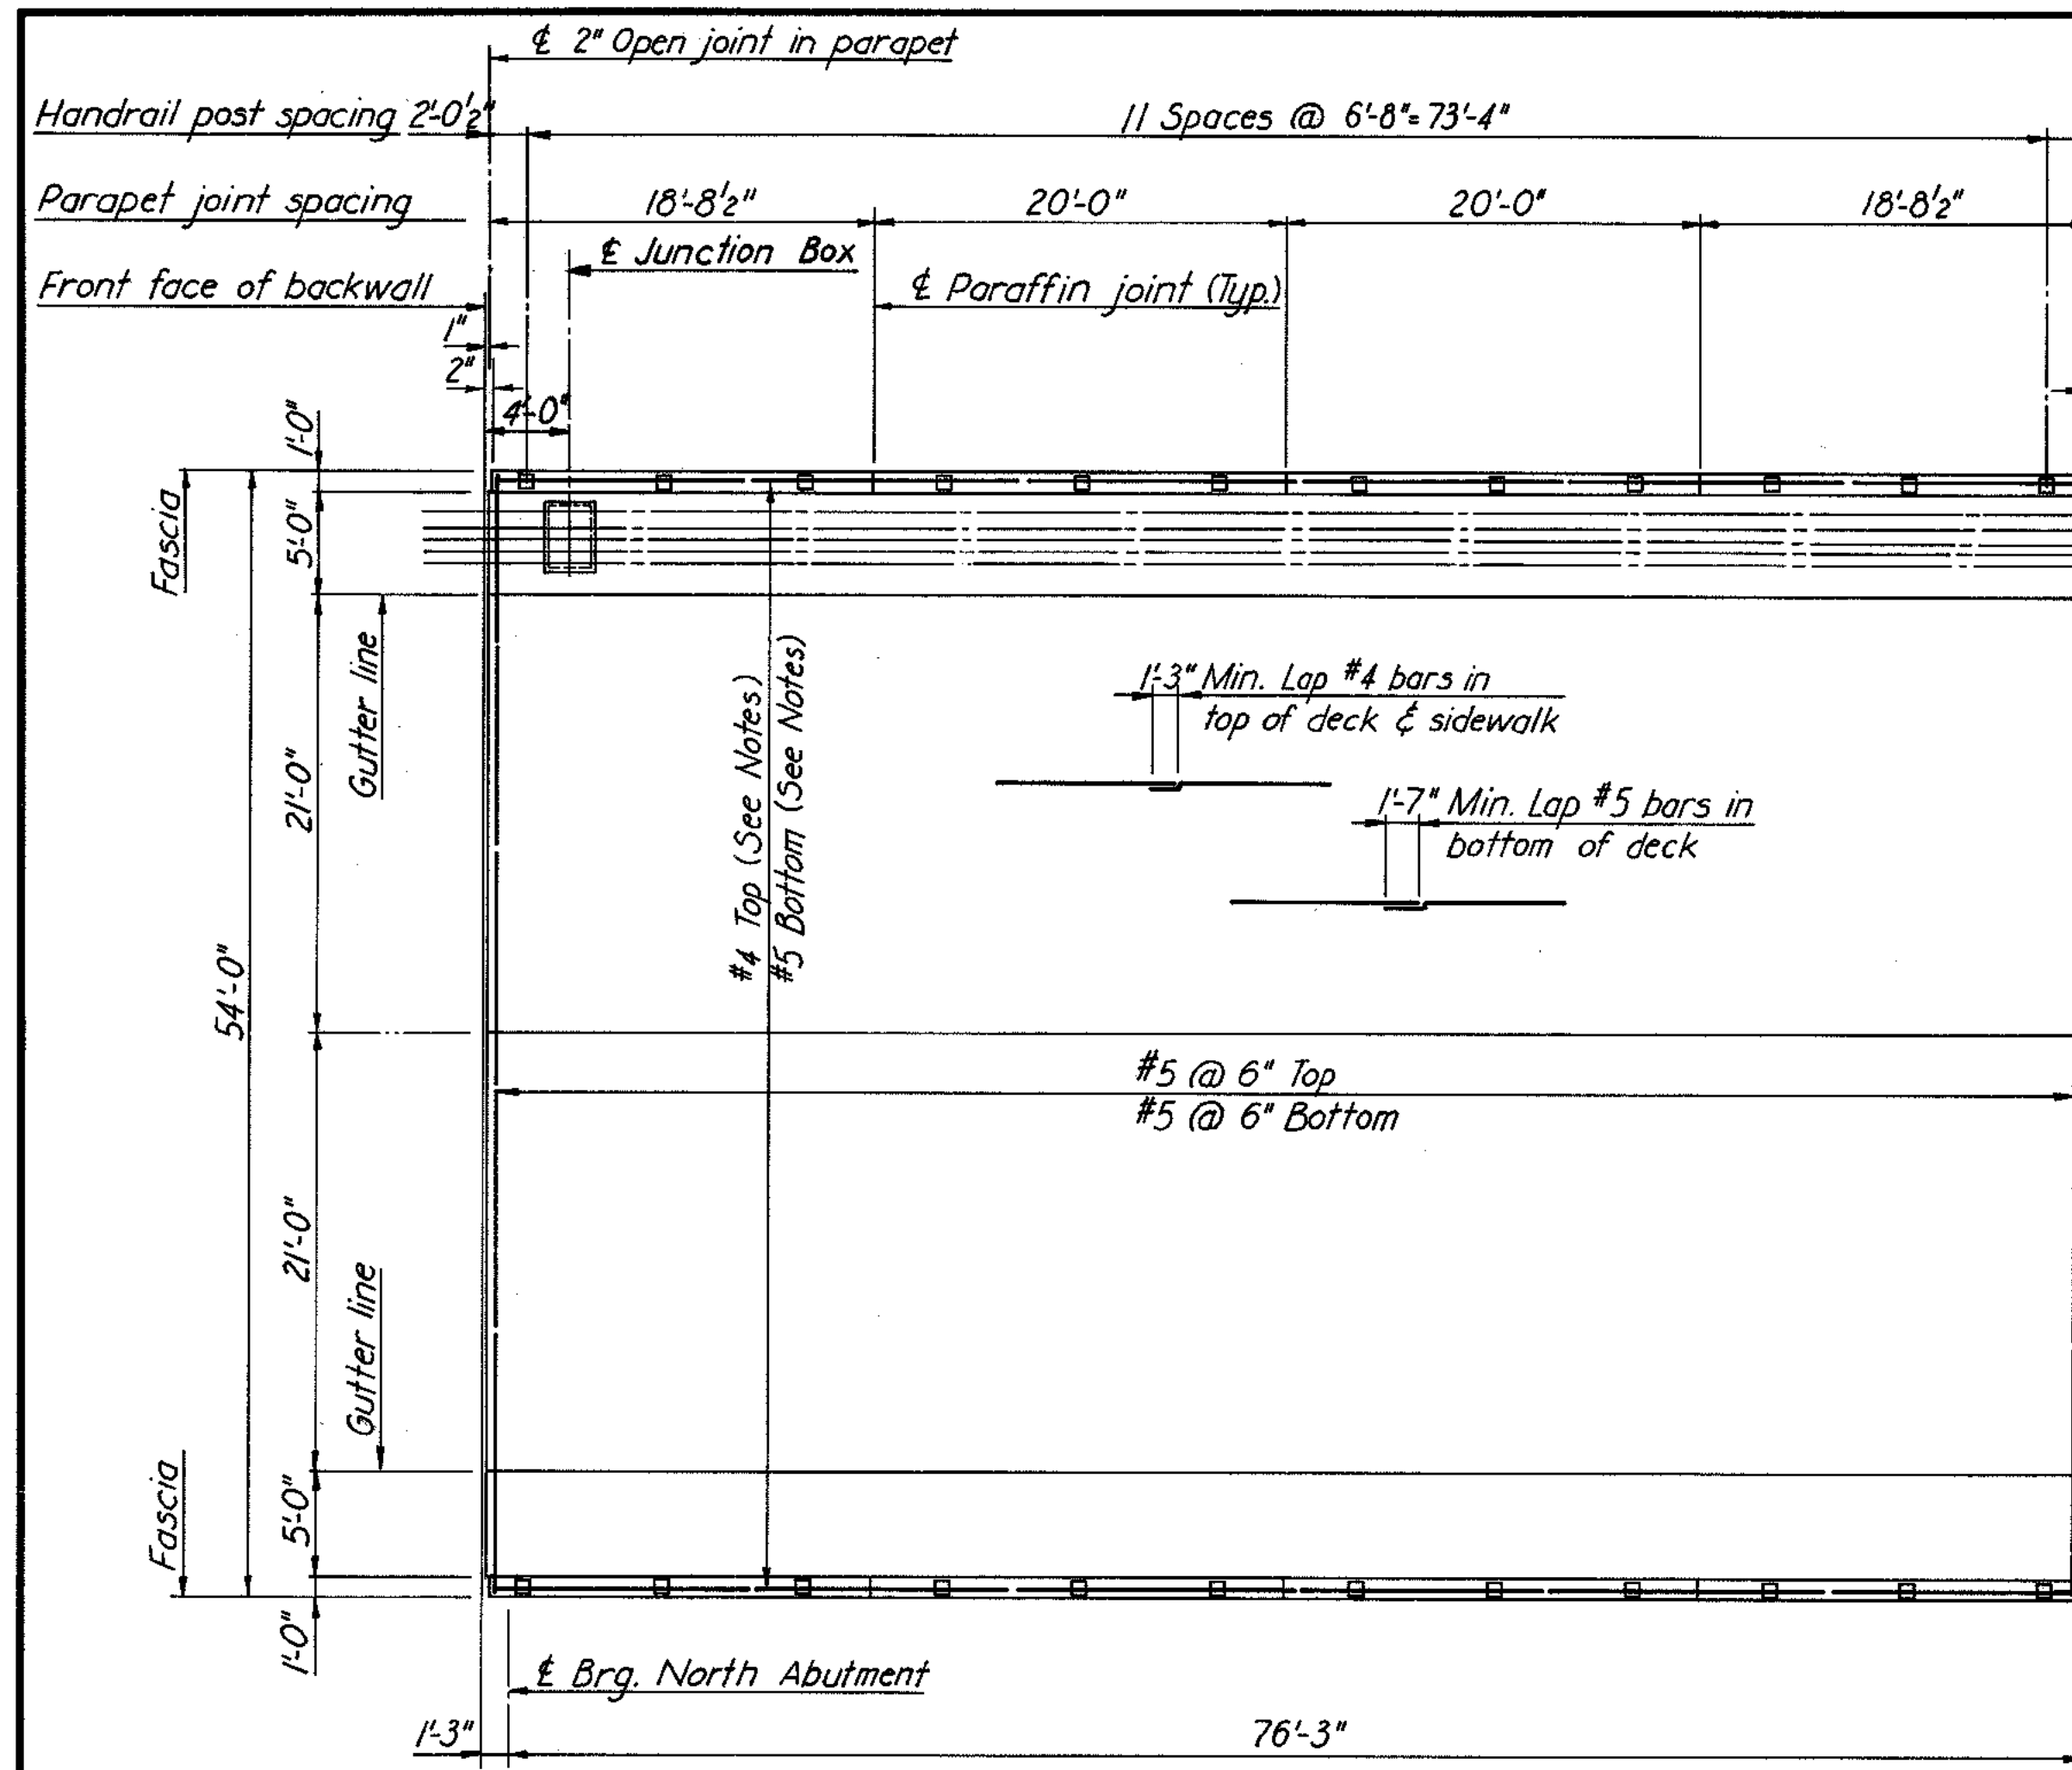


**PLAN-UNIT 1**  
Scale: 1/8"=1'-0"

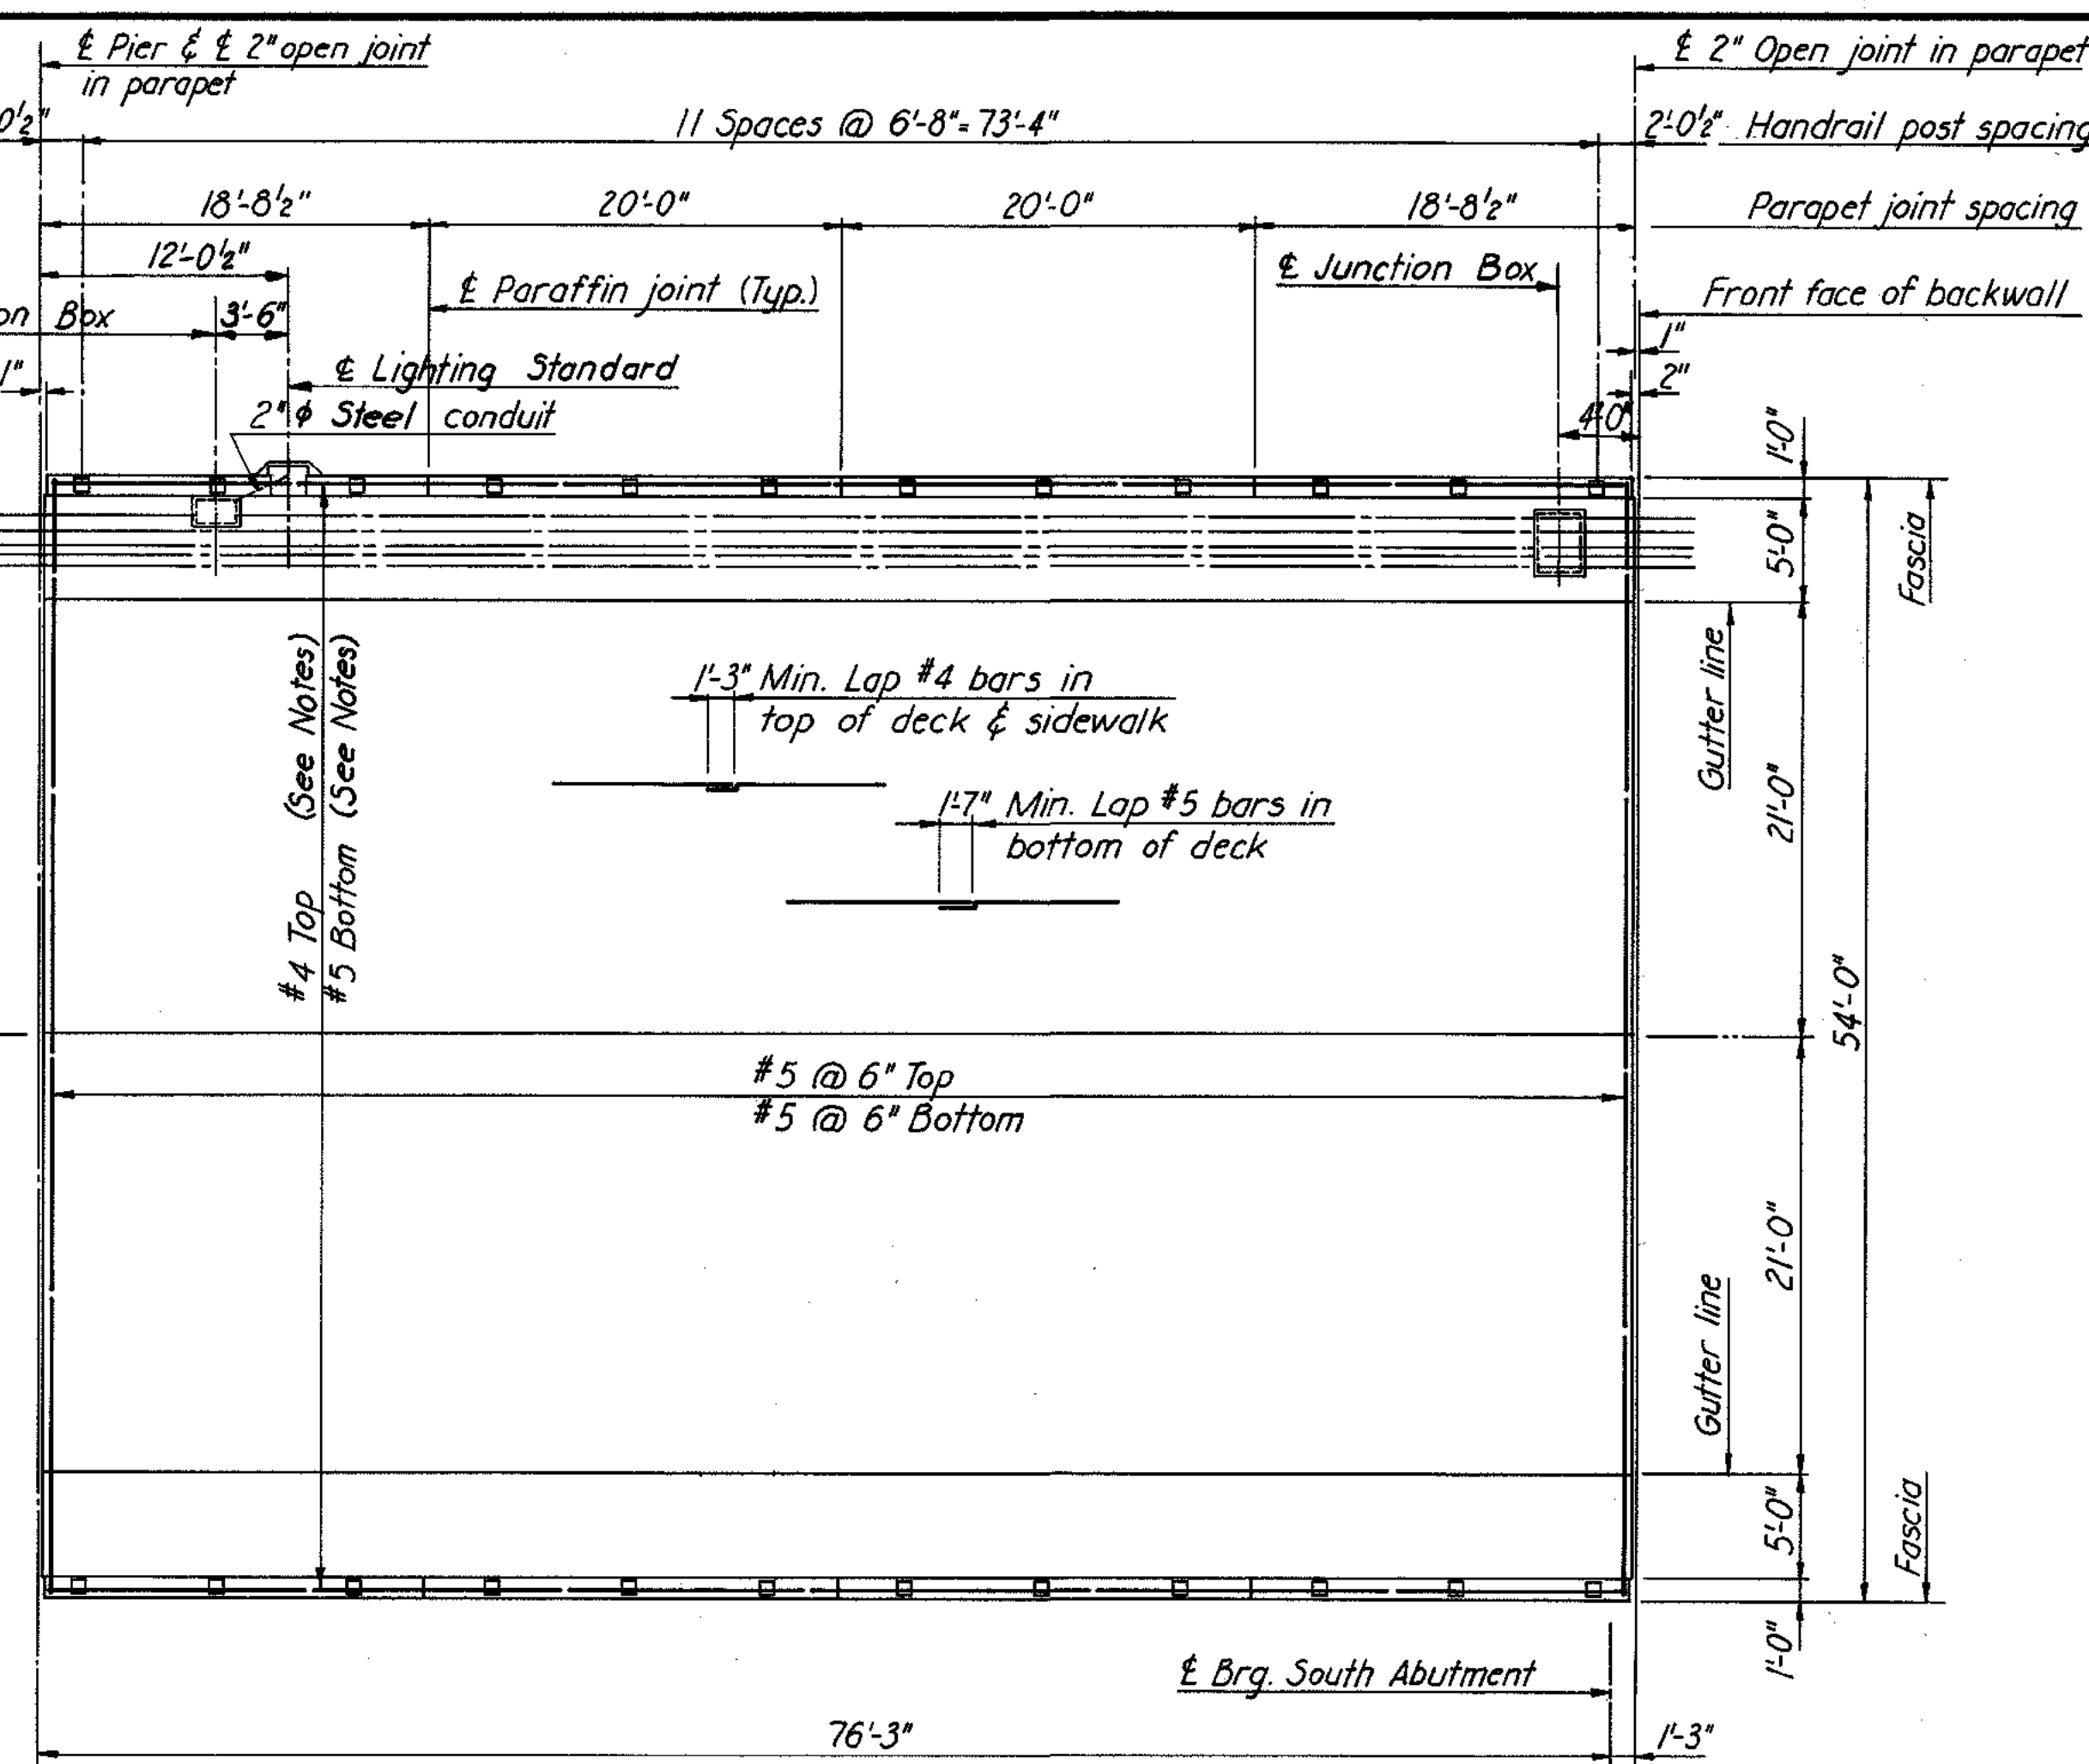

**PLAN-UNIT 2**  
Scale: 1/8"=1'-0"

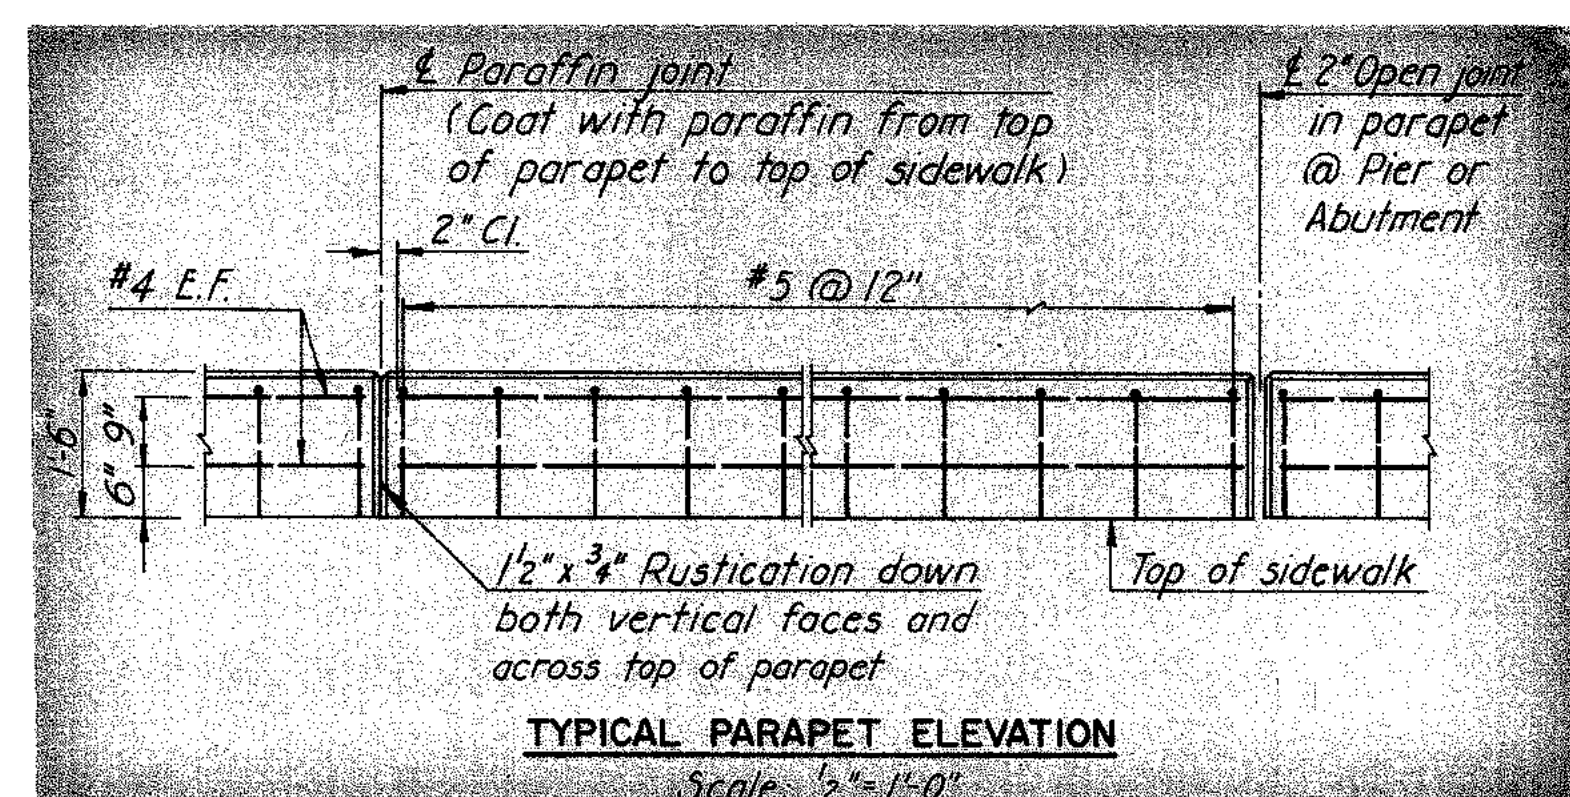

**TYPICAL PARAPET ELEVATION**  
Scale: 1/2"=1'-0"

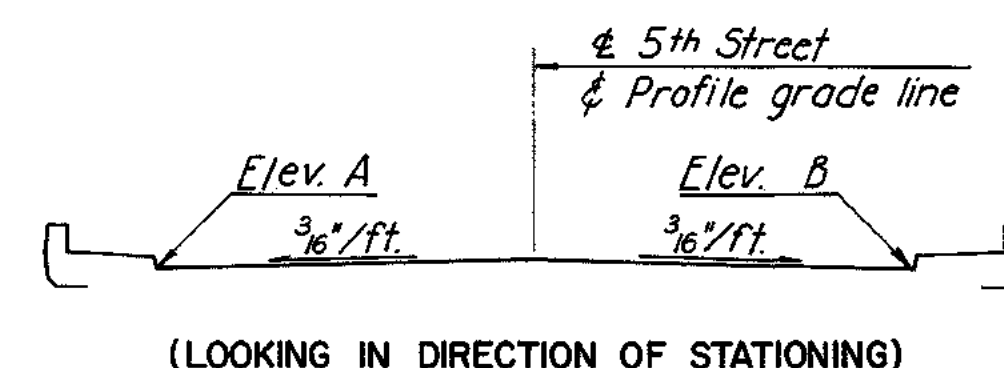

PAVEMENT ELEVATIONS							
STATION	ELEV. A	ELEV. B	STATION	ELEV. A	ELEV. B	STATION	ELEV. A
16+90	—	*109.77	18+00	108.06	108.39	108.06	
17+00	*109.01	*109.34	+10	107.92	108.25	107.92	
+10	*108.71	*109.04	+20	107.69	108.02	107.69	
+16.12	108.59	108.92	+30	107.38	107.71	107.38	
+20	108.53	108.86	+40	107.01	107.34	107.01	
+30	108.46	108.79	+50	106.61	106.94	106.61	
+40	108.40	108.73	+60	106.18	106.51	106.18	
+50	108.35	108.68	+70	105.72	106.05	105.72	
+60	108.29	108.62	+71.12	105.67	105.99	105.67	
+70	108.23	108.56	+80	*105.23	*105.56	*105.25	
+80	108.18	108.51	+90	*104.64	*105.07	*104.72	
+90	108.12	108.45	19+00	—	*104.58	—	
+93.62	108.10	108.43	108.10				

\* Elevations shown are given to top of bituminous surfacing.

**NOTES:**  
For location and spacing of deck, parapet and sidewalk reinforcing, see Cross Section and Utility Details sheet.  
For location and spacing of reinforcing in haunch over end diaphragms, see Joint Details sheet.  
For lighting standard base, junction box details and additional reinforcing, see Standard Electrical Details sheet 54.

BY	DATE				
MADE	A.B.P.	9-67			
CHECKED	TEM	2-68	1	As Built	TEM 1-77
IN CHARGE	PRY		NO.	REVISION	BY DATE

RICHMOND METROPOLITAN AUTHORITY			
RICHMOND EXPRESSWAY SYSTEM			
DOWNTOWN EXPRESSWAY			
BRIDGE B-57			
5TH STREET OVER			
DOWNTOWN EXPRESSWAY			
DECK PLANS			
HOWARD, NEEDLES, TAMMEN & BERGENDOFF			SCALE: AS SHOWN
consulting engineers			CONTRACT NO. 9
NEW YORK ALEXANDRIA KANSAS CITY			SHEET NO. 12 OF 15

AS BUILT



**Bridge 58**

**7<sup>th</sup> Street**

**Over**

**Downtown Expressway (VA 195)**

**Record Set Plans**







GENERAL NOTES

RICHMOND EXPRESSWAY SYSTEM			
SECTION	PROJECT	SHEET NO.	TOTAL SHEETS
5	DOWNTOWN EXPRESSWAY	186	

ROADWAY CAPACITY:	One 42'-0" clear roadway. Two 5'-0" sidewalks. Dead Load-Includes 15 lbs. per sq.ft. for future wearing surface. Live Loads-MS20-44 loading and B.P.R. modified for military vehicles.
SPECIFICATIONS:	GENERAL-Virginia Department of Highway Road and Bridge Specifications, 1970. DESIGN-A.A.S.H.O. Standard Specifications for Highway Bridges, 1961, modified by Special Design Provisions. WELDING-1969 Standard Specifications for Welded Highway and Railway Bridges of the American Welding Society.  CONTRACT SPECIAL PROVISIONS  Specifications and Contract Special Provisions referred to above are necessary to make these plans complete.  DATUM: CITY OF RICHMOND  TEMPERATURE: The normal temperature referred to on the plan is 60°F. The temperature range for movement is 0°F to 120°F.  DIMENSIONS: All dimensions are measured horizontally and vertically unless otherwise noted.  EXCAVATION: Excavation below subgrade and cut slope template shall be classified as Structure Excavation. All excavation above these limits shall be classified as Regular Excavation and is not included in the Structural Quantities.  FOUNDATIONS: Footings shall rest on firm material. Foundation material shall be kept dry and special attention is called to Section 401.05 of the General Specifications and to the Contract Special Provisions concerning preparation of foundations for footings.

CONCRETE NOTES:	Concrete in superstructure shall be Class A4. All other concrete shall be Class A3. All exposed edges and corners shall have a 3/4" chamfer or fillet unless otherwise noted. Care in the method of vibration, the use of low-slump concrete, and/or other means shall be employed to prevent downgrade movement of newly placed slab concrete (when gradient is over 2%).  Finishing Concrete Surfaces: See the Standard Architectural Details sheets and the Contract Special Provisions for types and details.  All reinforcing steel shall conform to ASTM A615 Grade 40. All reinforcing bar dimensions on the detailed drawings are to centers of bars unless otherwise noted. Clear distance between reinforcing steel and face of concrete shall be as noted on the plans. All bar laps shall be 30 diameters of the smaller diameter bar unless otherwise noted.  STEEL NOTES: Structural steel shall conform to A.S.T.M. Specification A36 except as noted. All field connections shall be made with high strength bolts. High strength bolts shall be 7/8" diameter unless otherwise noted and shall conform to A.S.T.M. Specifications A325.  BENCH MARKS: See Reference Ties and Field Control Data sheet in highway plans.  C-52 Plug, corner E. Canal St. and S. 7th St., Elev. 84.90 C-53 Plug, S. 7th St., Elev. 83.83
-----------------	--

FINAL QUANTITIES

	STRUCTURE EXCAVATION C.Y.	CONCRETE CLASS A3 C.Y.	CONCRETE CLASS A3 BR. APPR. SLABS C.Y.	CONCRETE CLASS A4 C.Y.	REINFORCING STEEL LBS.	STRUCTURAL STEEL LBS.	ALUMINUM BR. RAILING (2 RAILS) L.F.	POROUS BACKFILL C.Y.	CONC. SLAB SLOPE PROTECTION S.Y.	DAMP-PROOFING S.Y.	UNDERDRAIN 6" Ø L.F.	GAS MAIN 8" Ø L.F.	WATER MAIN 12" Ø L.F.	CONDUIT 6" Ø VEP CO L.F.	CONDUIT 4" Ø TELEPHONE L.F.	METAL CONDUIT 3" Ø L.F.	STEEL PILES 10BP42 L.F.
SUPERSTRUCTURE				276.41	60,408	270,998	288.5					200.5	197.5	4,668	1,750.5	1,203	
NORTH ABUTMENT	262	111.4			5,818		27.2	13	213.2	54	78						
PIER I	402	121.19			23,306												
SOUTH ABUTMENT	446	353.77			29,430		51.5	96	131.0	205	136						195.3
APPROACH SLABS			112.44		30,322												
TOTAL	1,110	586.36	112.44	276.41	149,284	270,998	367.2	109	344.2	259	214						
												200.5	197.5	4,668	1,750.5	1,203	195.3


	BY	DATE				
MADE	EVR	3-68				
CHECKED	A.B.P.	12-68	1	As Built	TEM	7-77
IN CHARGE	PRV		NO.	REVISION	BY	DATE

RICHMOND METROPOLITAN AUTHORITY RICHMOND EXPRESSWAY SYSTEM DOWNTOWN EXPRESSWAY	
BRIDGE B-58 7TH STREET OVER DOWNTOWN EXPRESSWAY	
GENERAL NOTES AND QUANTITIES	
HOWARD, NEEDLES, TAMMEN & BERGENDOFF consulting engineers NEW YORK ALEXANDRIA KANSAS CITY	SCALE: AS SHOWN CONTRACT NO. 9 SHEET NO. 2 OF 17


AS BUILT




RICHMOND EXPRESSWAY SYSTEM			
SECTION	PROJECT	SHEET NO.	TOTAL SHEETS
	DOWNTOWN EXPRESSWAY	193	

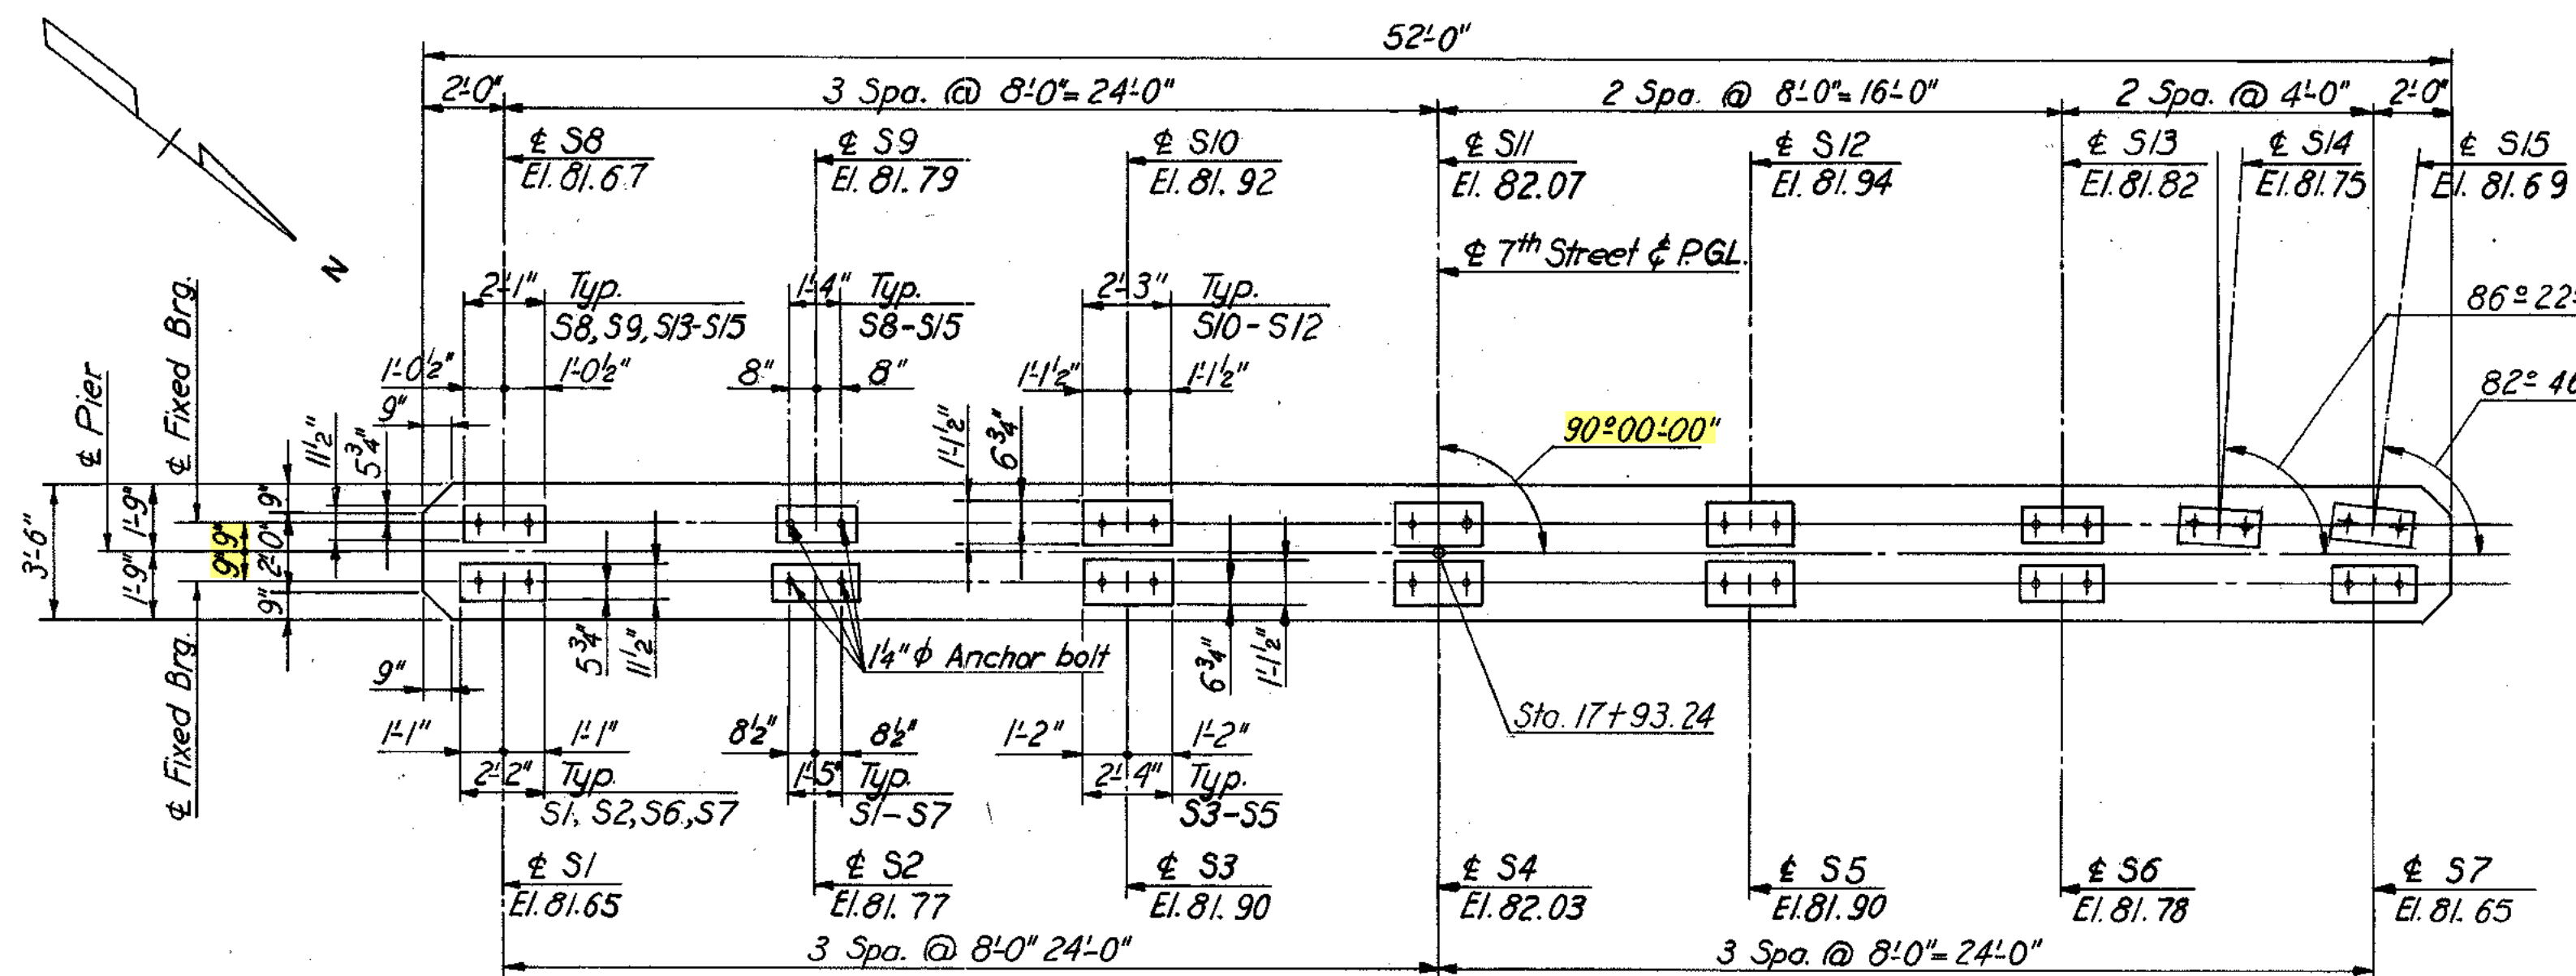


PLAN  
Scale: 4"=1'-0"

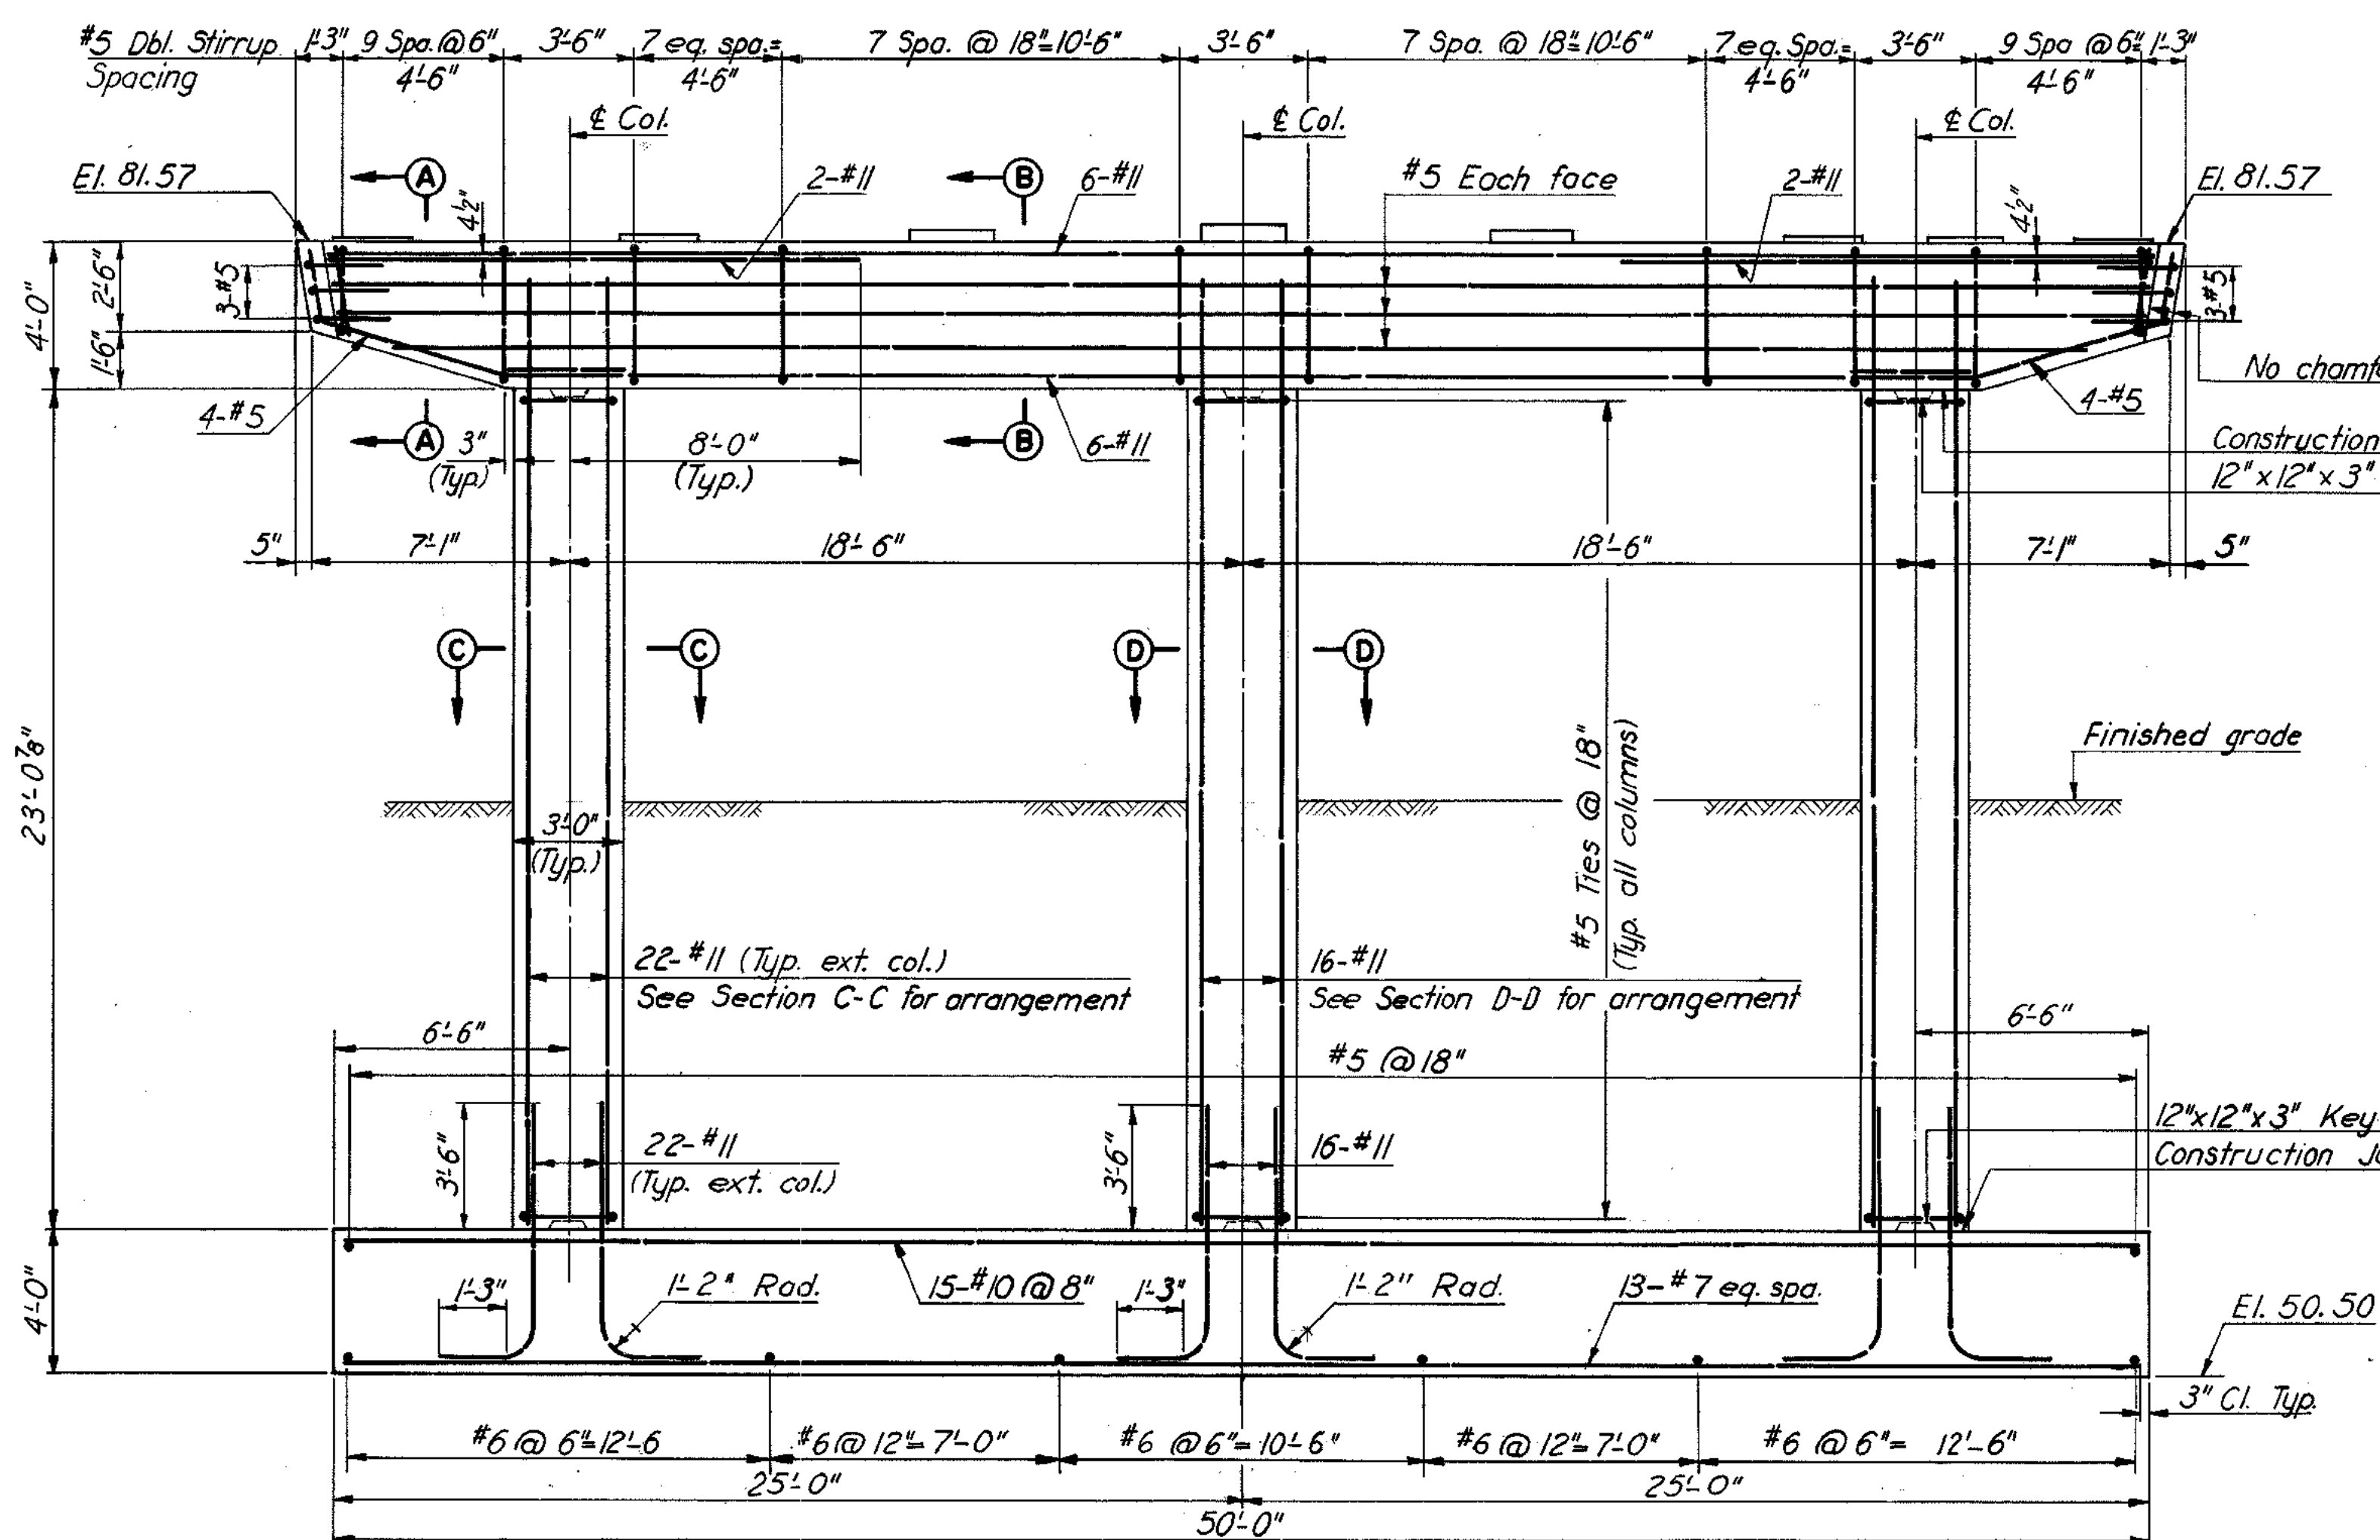


ELEVATION  
Scale: 4"=1'-0"

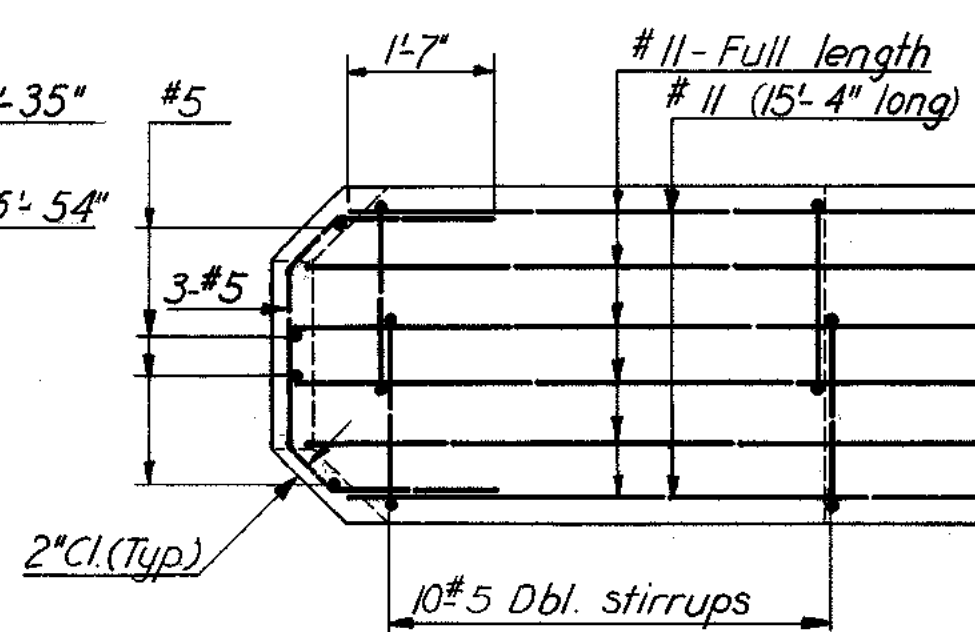

PLAN OF PIER CAP  
SHOWING REINFORCING DETAILS  
Scale: 2"=1'-0"

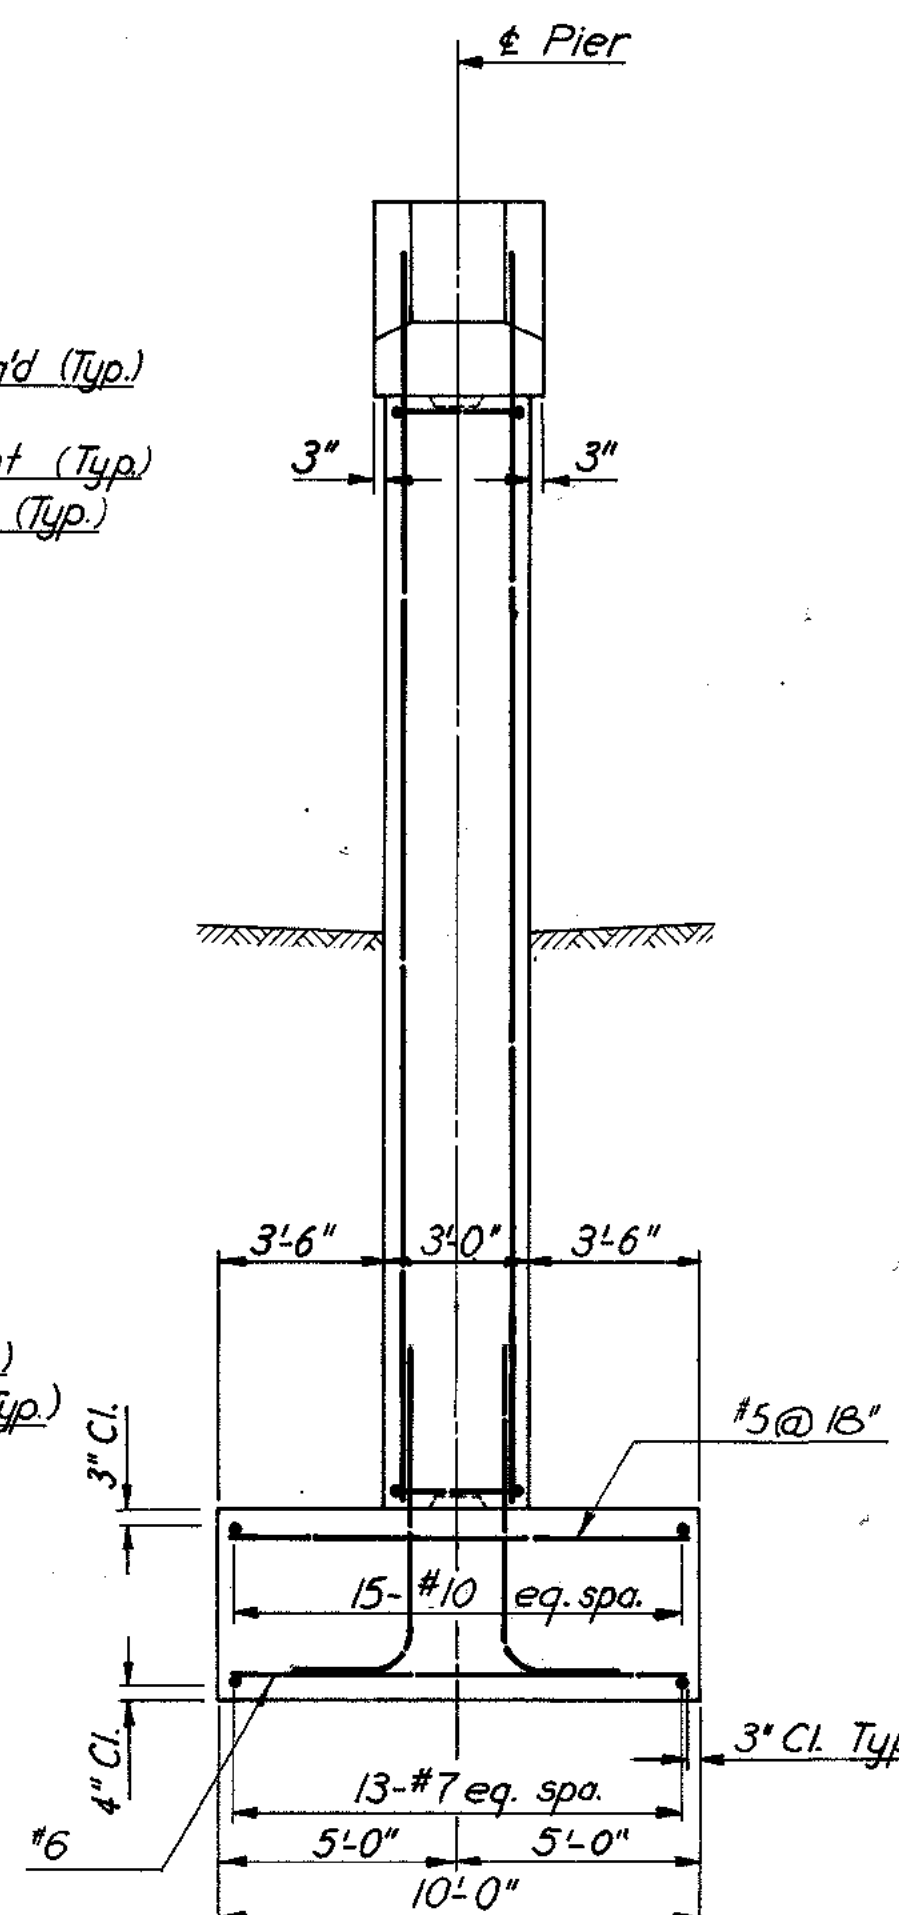


SIDE ELEVATION  
Scale: 4"=1'-0"

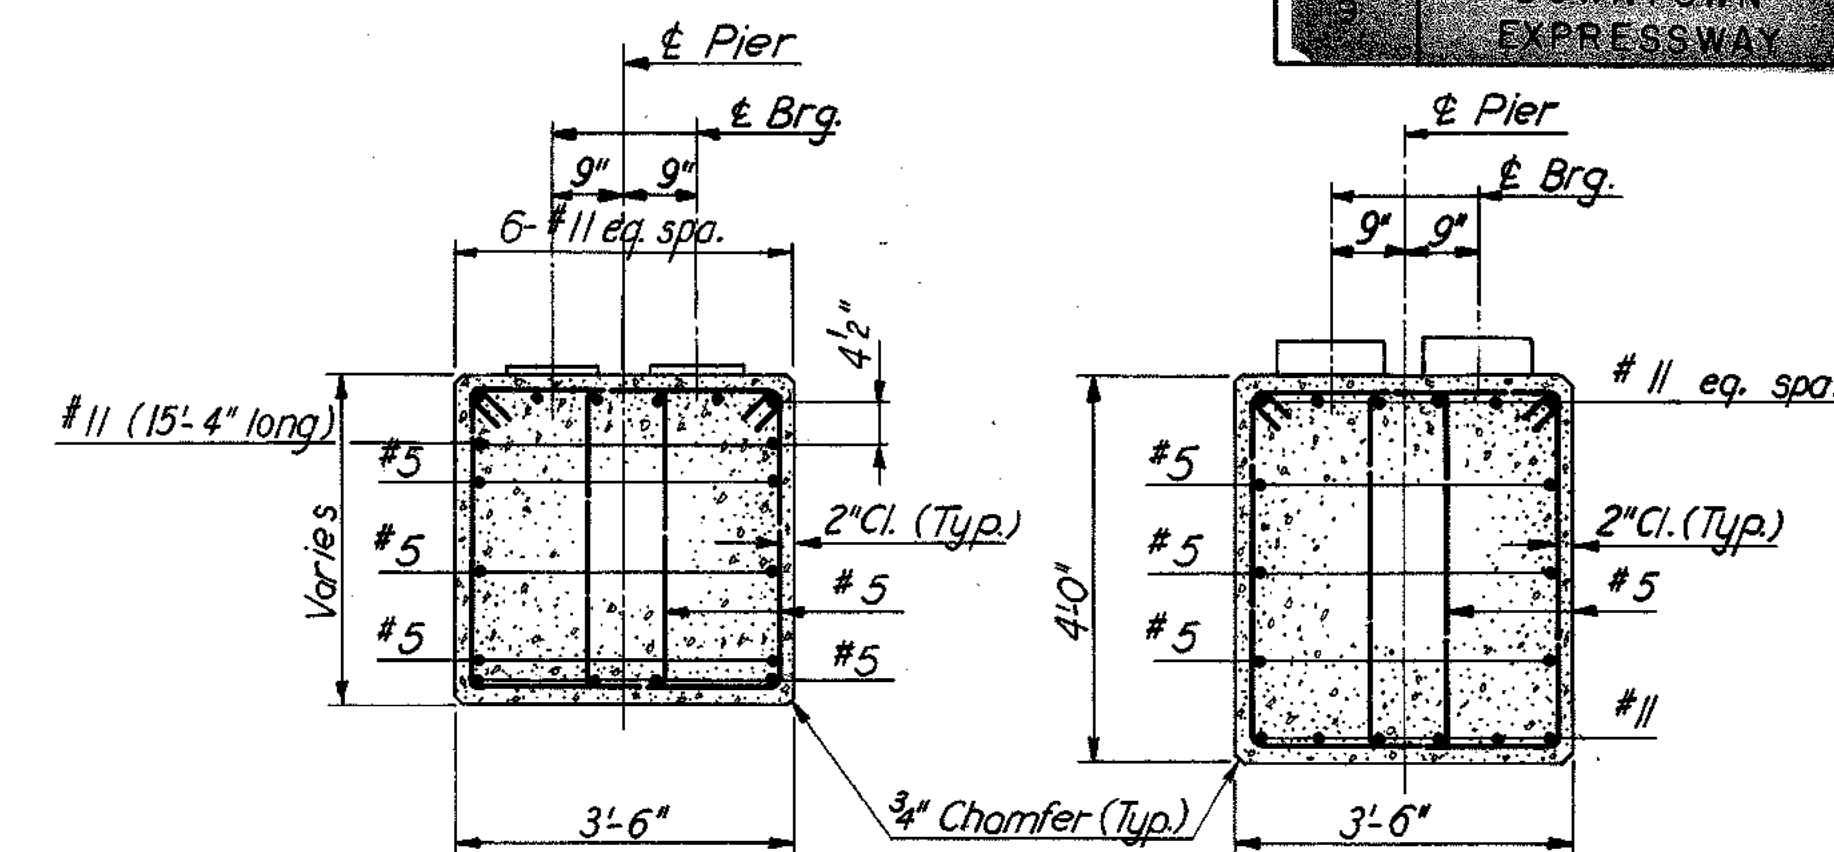


SECTION A-A  
Scale: 2"=1'-0"

SECTION B-B  
Scale: 2"=1'-0"

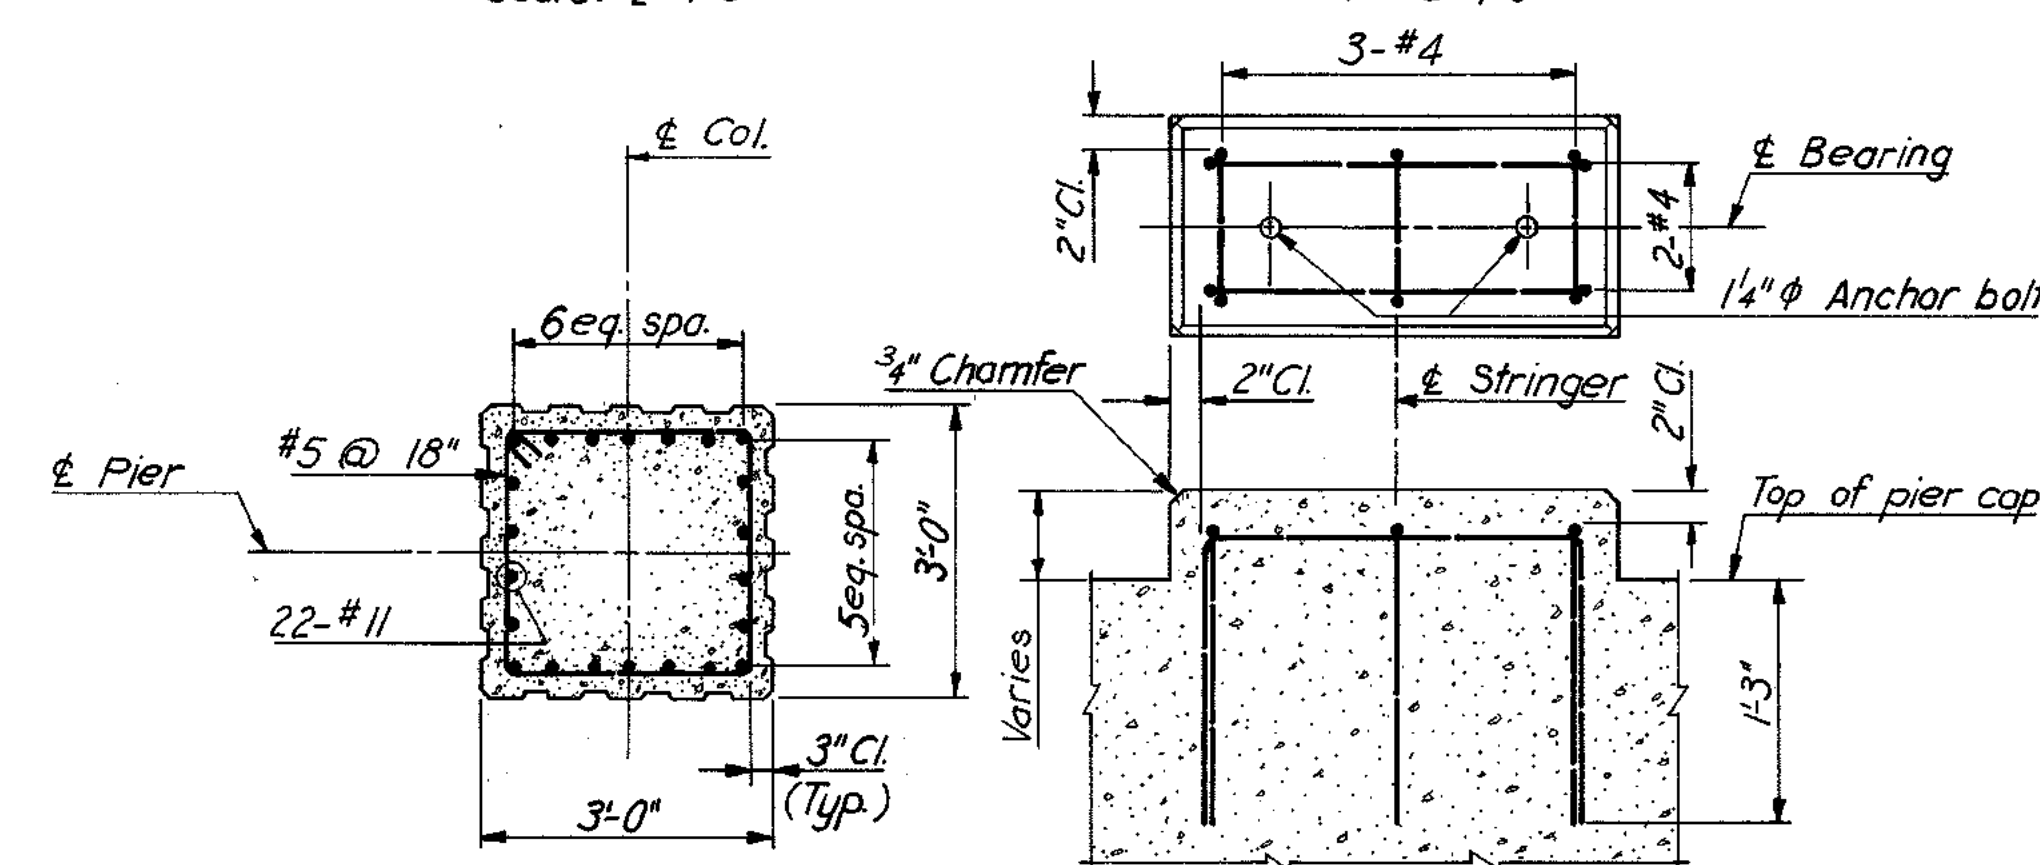


REINFORCING DETAILS  
FOR BEARING PADS AT  
S3-S5 AND S10-S12  
Scale: 1"=1'-0"


SECTION C-C  
Scale: 2"=1'-0"

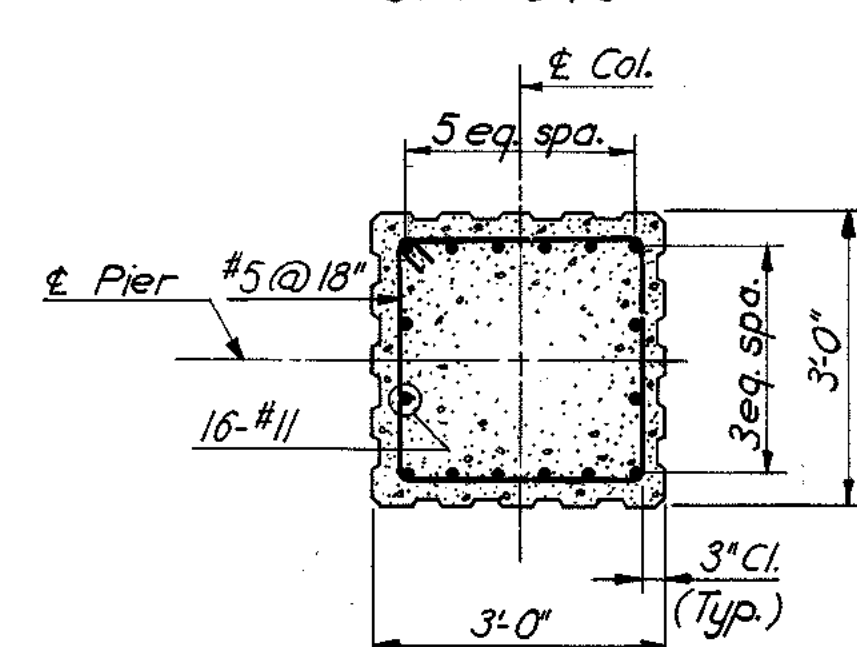

SECTION D-D  
Scale: 2"=1'-0"

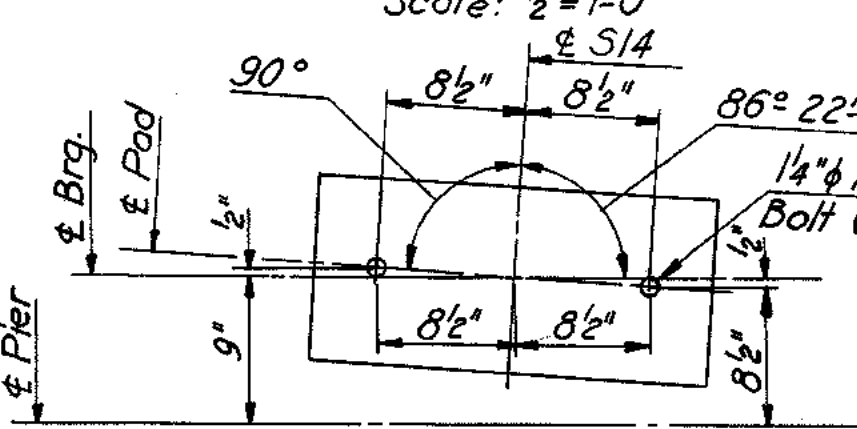

ANCHOR BOLT SETTING PLAN  
S14

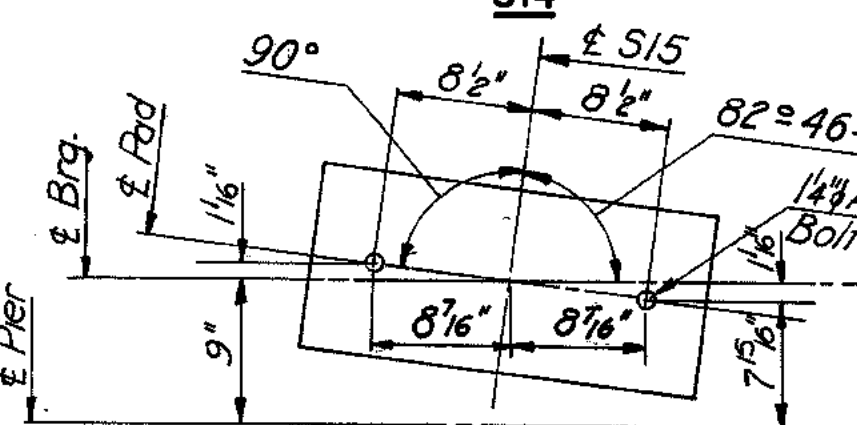

ANCHOR BOLT SETTING PLAN  
S15

**NOTES:**  
For anchor bolt details and treatment of pads, see Standard Shoe Details sheet.  
For details of architectural treatment of piers, see Standard Architectural Details sheet.

**FOUNDATION NOTE:**  
Foundation elevation is approximate and may be varied to suit field conditions as directed by the Engineer. Vertical column reinforcing shall not be cut until this elevation is established.  
Where elevation changes by more than two feet, redesign will be required.  
Pier foundation is designed for on allowable bearing pressure of 3 tons per square foot.


RICHMOND METROPOLITAN AUTHORITY  
RICHMOND EXPRESSWAY SYSTEM  
DOWNTOWN EXPRESSWAY  
BRIDGE B-58  
7 TH STREET OVER  
DOWNTOWN EXPRESSWAY  
PIER

HOWARD, NEEDLES, TAMMEN & BERGENDOFF  
consulting engineers  
NEW YORK ALEXANDRIA KANSAS CITY  
SCALE: AS SHOWN  
CONTRACT NO.: 9  
SHEET NO. 9 OF 17

BY	DATE				
MADE	EVR	1-68			
CHECKED	TEM	2-68	1	As Built	TEM 7-77
IN CHARGE	PRY		NO	REVISION	BY DATE

AS BUILT



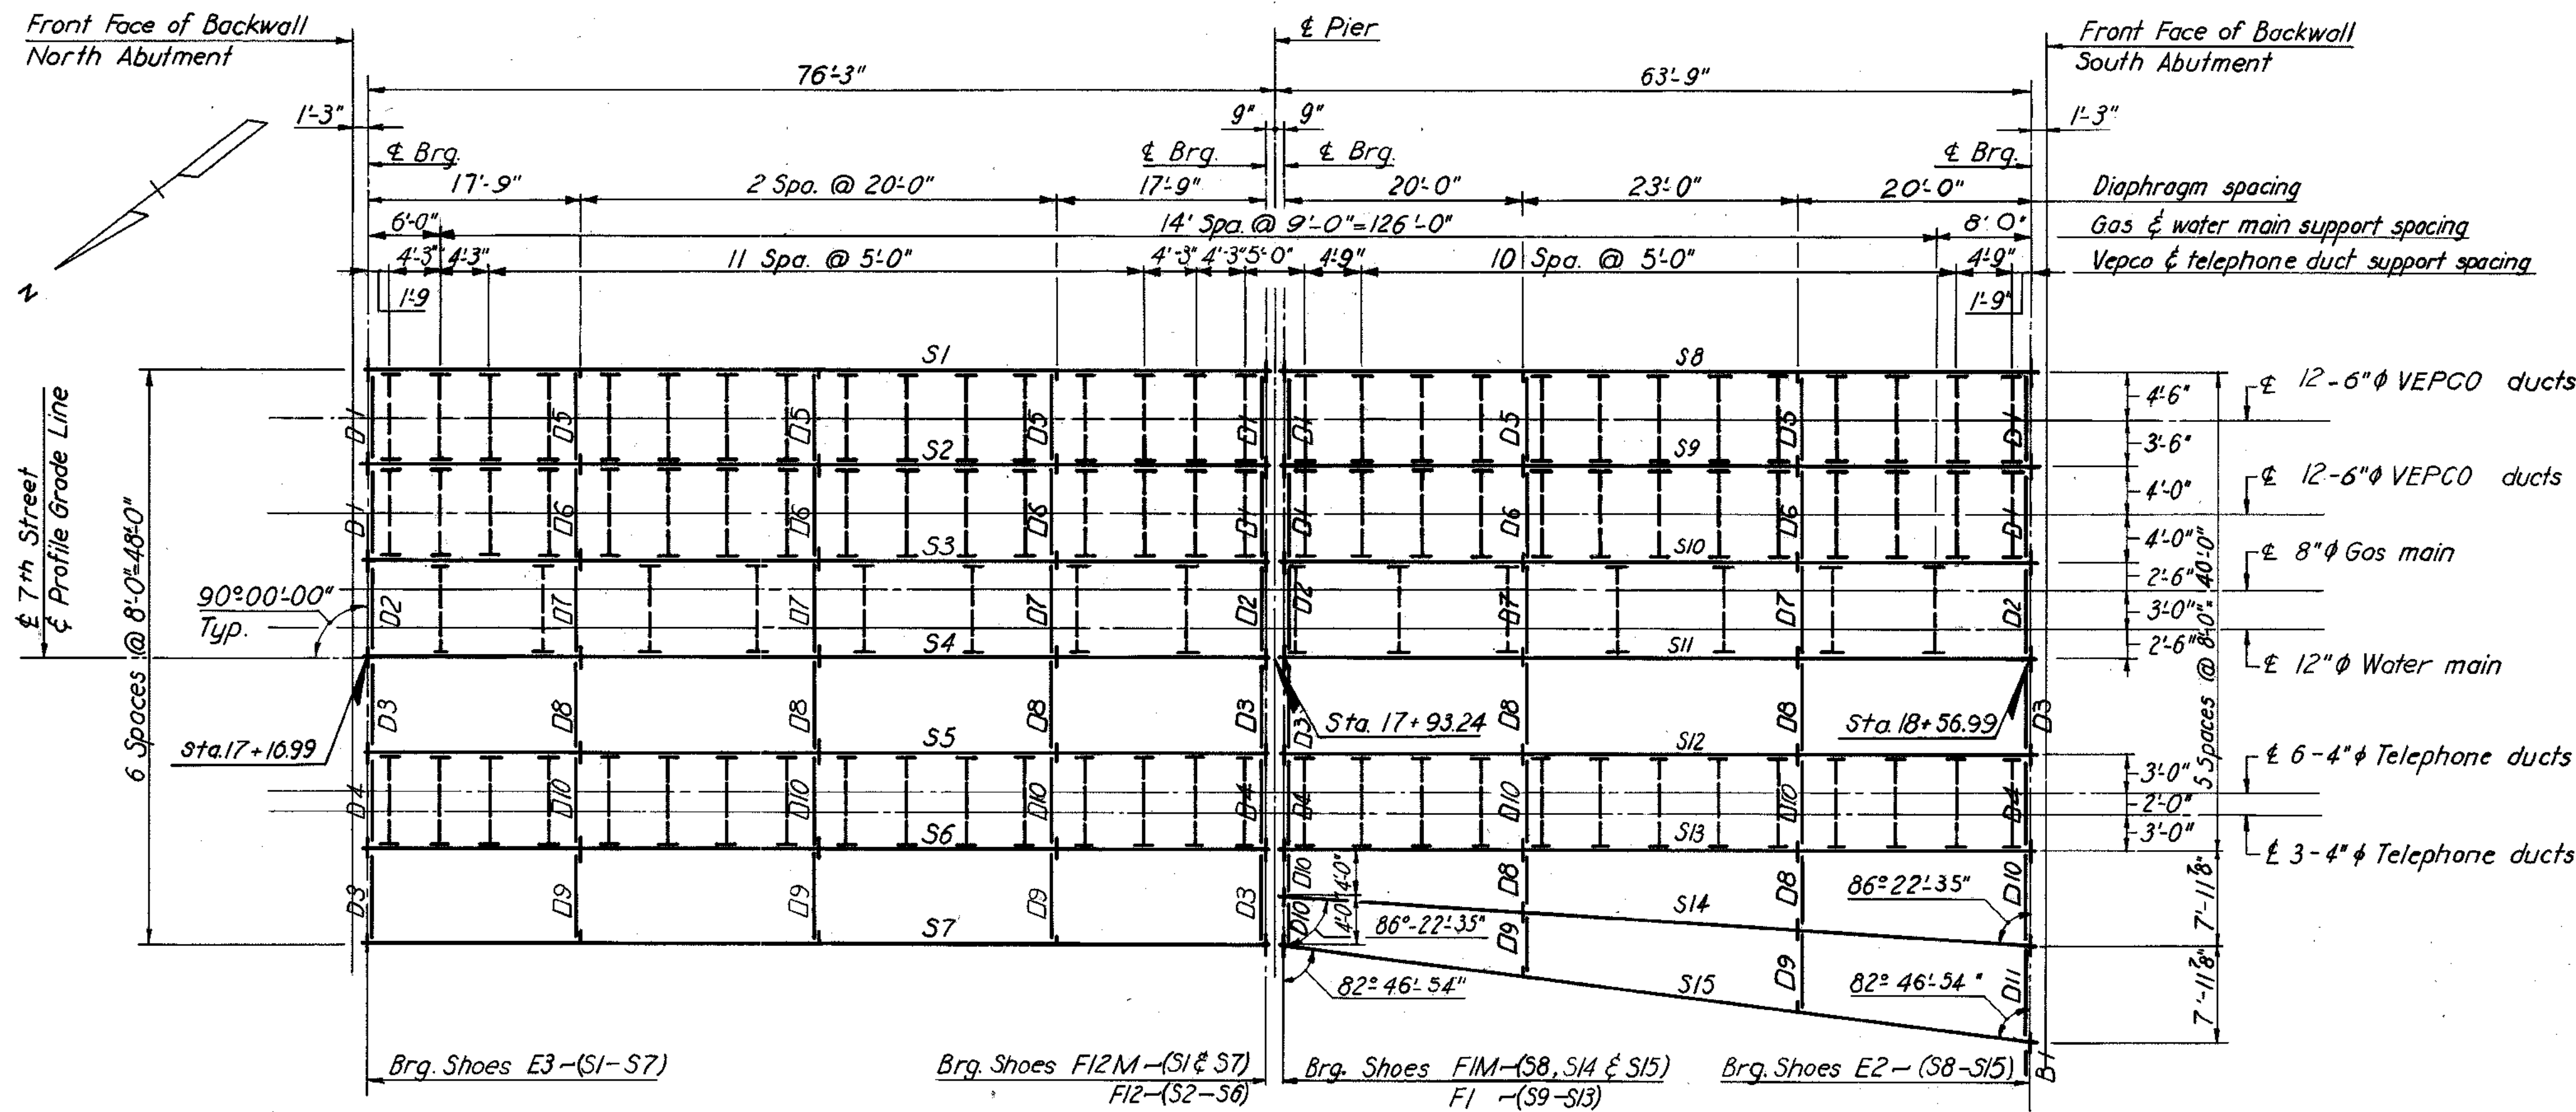


UNIT 1

FRAMING PLAN

Scale: 1"=10'


UNIT 2

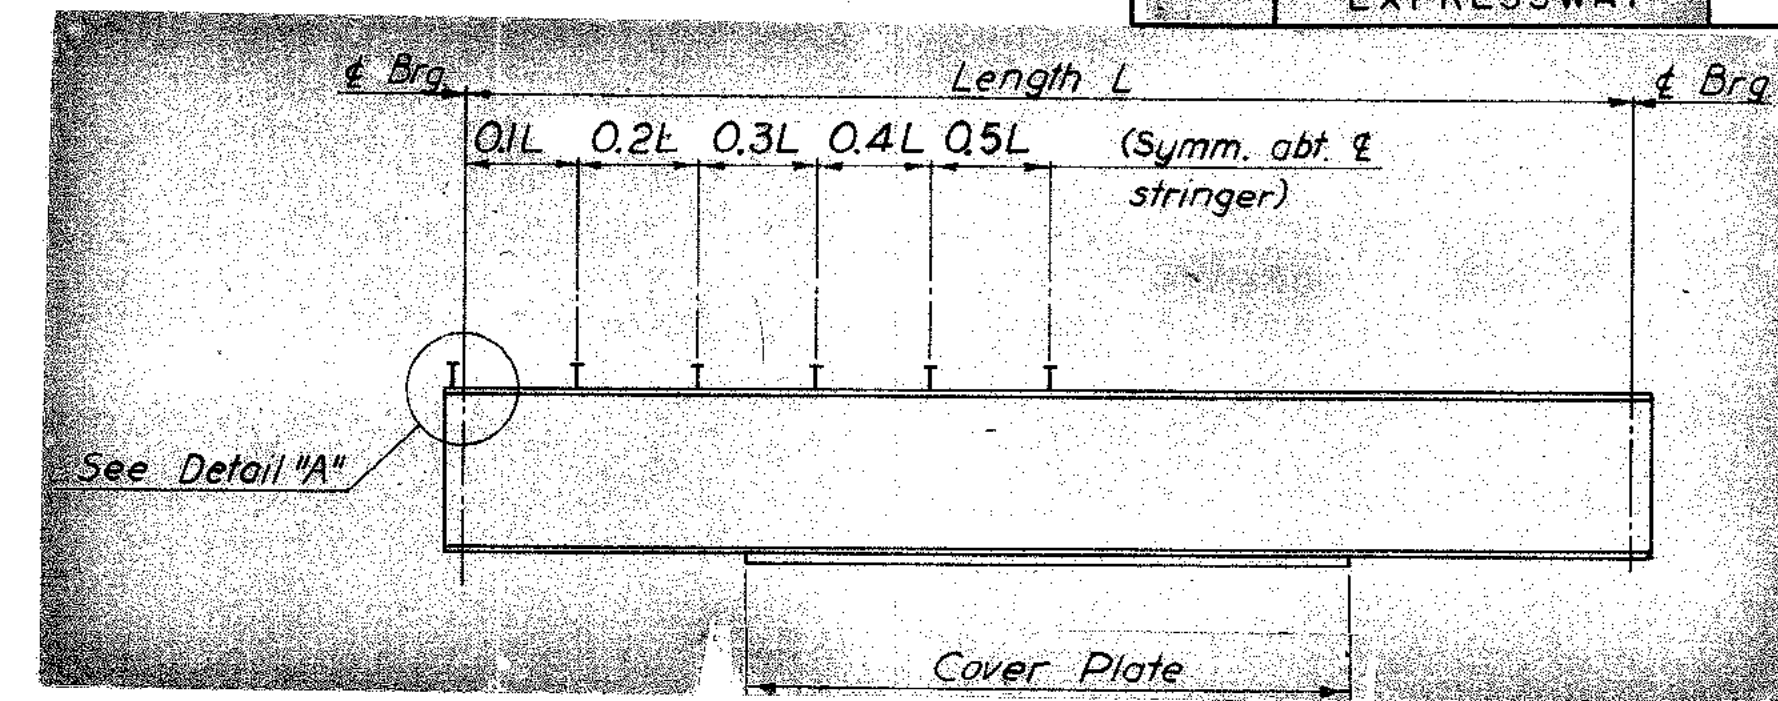

STRINGER ELEVATION


STRINGER SCHEDULE									
STRINGER	LENGTH £ BRG. TO £ BRG.	COVER PLATE	SHEAR STUD SPACING						
			0.1L	0.2L	0.3L	0.4L	0.5L		
S1 - 36 WF 194	75'-6"	10 1/2 x 1 3/4 x 64'-0"	7"	8"	11"	13 1/2"	15 1/2"		
S2 - 36 WF 194		10 1/2 x 1 3/4 x 64'-0"			10 1/2"	13"	14 1/2"		
S3 - 36 WF 182		10 1/2 x 1 3/4 x 65'-0"			11"				
S4 - 36 WF 182		10 1/2 x 1 3/4 x 64'-6"							
S5 - 36 WF 182		10 1/2 x 1 3/4 x 63'-6"							
S6 - 36 WF 182		10 1/2 x 1 3/4 x 63'-6"							
S7 - 36 WF 182	75'-6"	10 1/2 x 1 3/4 x 64'-6"	7"	8"	11"	13 1/2"	15 1/2"		
S8 - 36 WF 150	63'-0"	10 1/2 x 1 x 51'-0"	7"	8"	10 1/2"	13 1/2"	15"		
S9 - 36 WF 150		10 1/2 x 1 x 51'-0"			10 1/2"	12 1/2"	14"		
S10 - 36 WF 150		10 1/2 x 1 x 51'-0"			11"				
S11 - 36 WF 135		10 1/2 x 1 1/2 x 53'-0"			11"				
S12 -		10 1/2 x 1 1/2 x 53'-0"	7"		10 1/2"		14"		
S13 -	63'-0"	10 1/2 x 1 1/2 x 51'-6"	7 1/2"	8"	11 1/2"	12 1/2"	15"		
S14 -	63'-1 3/8"	10 1/2 x 1 1/2 x 48'-6"	9"	10"	13"	15 1/2"	17"		
S15 - 36 WF 135	63'-6 1/8"	10 1/2 x 1 1/2 x 49'-6"	8 1/2"	10"	12 1/2"	16"	18 1/2"		

Note: Lengths shown are horizontal distances measured along centerlines of stringers.

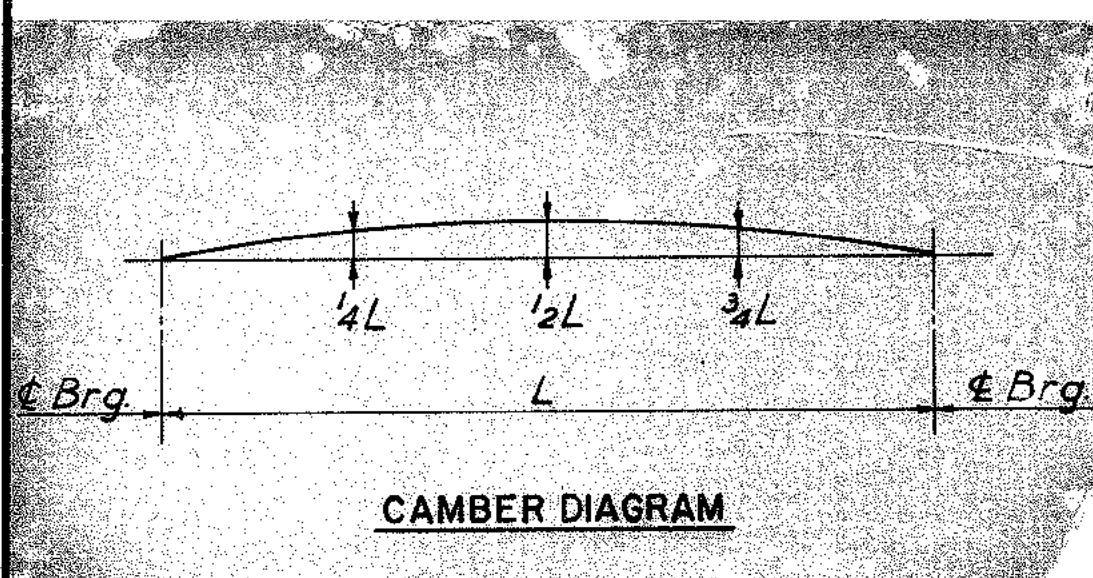


CAMBER DIAGRAM

CAMBER SCHEDULE							
STR.	1/4 L	1/2 L	3/4 L	STR.	1/4 L	1/2 L	3/4 L
S1	4"	5 1/2"		S8-S10	2 1/2"	3 1/2"	2 1/2"
S5-S7		4 1/2"	4 1/2"	S11-S13	2 1/2"	4"	2 1/2"
S2	4"	5 1/2"		S14	3"	4"	3"
S4	4 1/2"	5 1/2"		S15	3 1/2"	4 1/2"	3 1/2"
S3	4 1/2"	5 1/2"	4 1/2"				

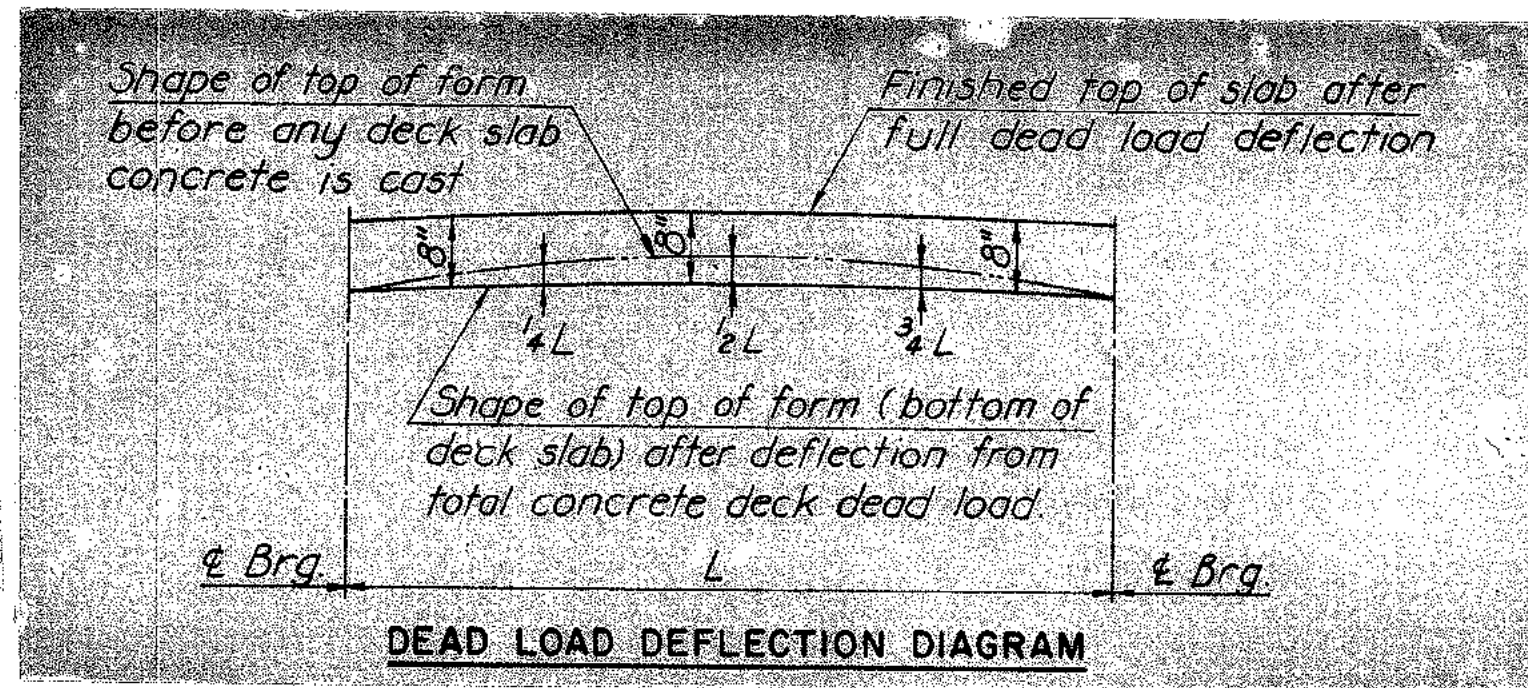


DEAD LOAD DEFLECTION DIAGRAM

DEFLECTION SCHEDULE							
STR.	1/4 L	1/2 L	STR.	1/4 L	1/2 L	STR.	1/4 L
S1, S3, S7	1 1/4"	1 1/2"	S8-S14	3 1/4"	1"		
S2, S4-S6	1"		S15	5 1/8"	7 1/8"		

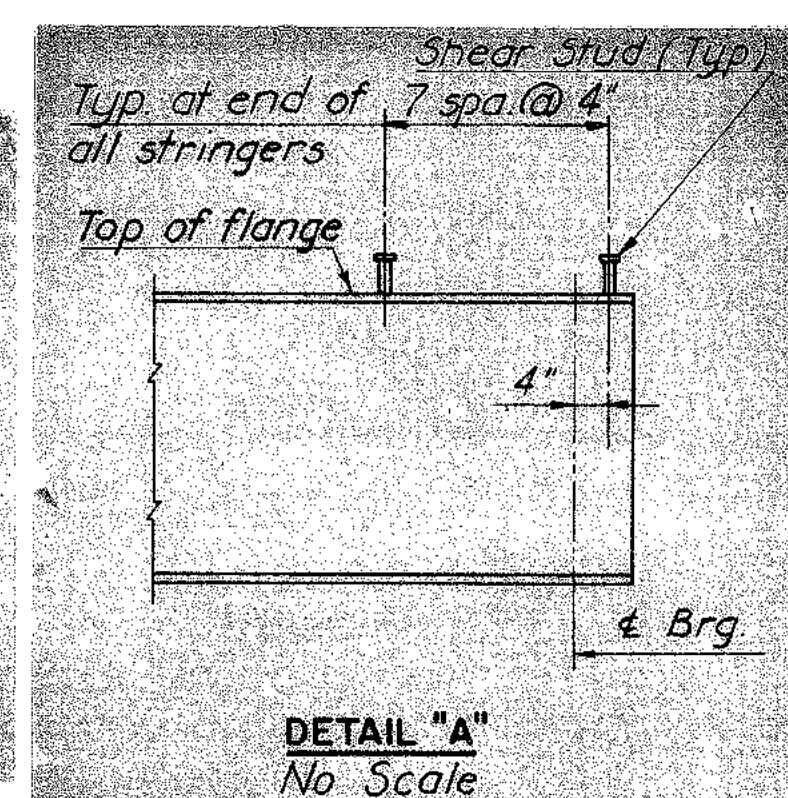

DETAIL "A"

No Scale

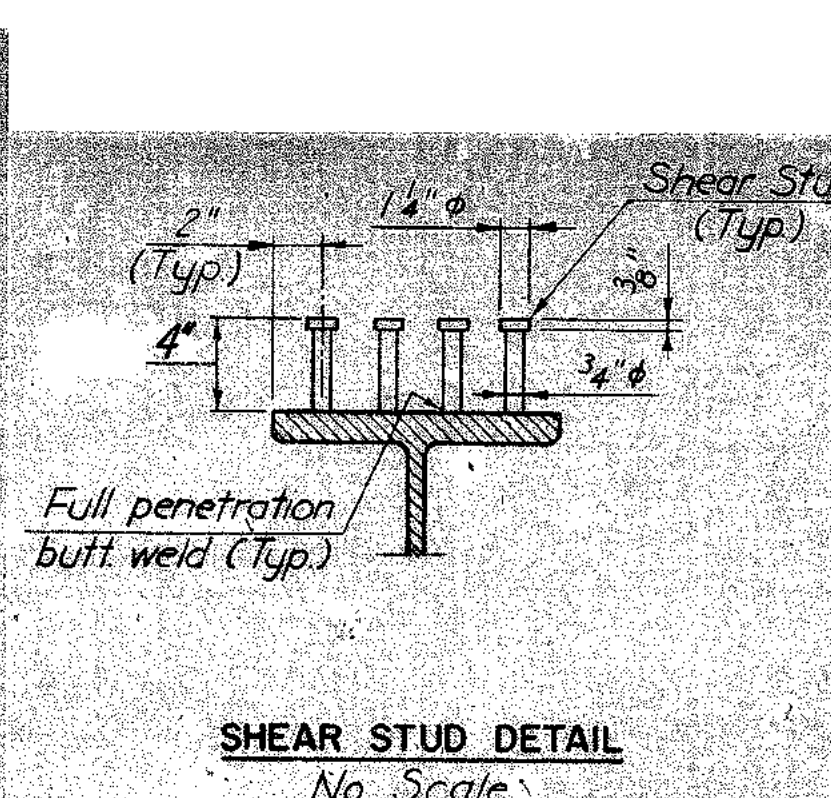


SHEAR STUD DETAIL

No Scale

SHEAR STUD NOTE:

Capacity = 3,400 lbs. per stud.  
The contractor may, if he elects, use three 2" diameter studs at the same longitudinal spacing in lieu of the four 2" diameter studs shown.  
Stud rows shall be placed parallel to the main deck reinforcing.  
Shear stud spacing shown is maximum spacing.

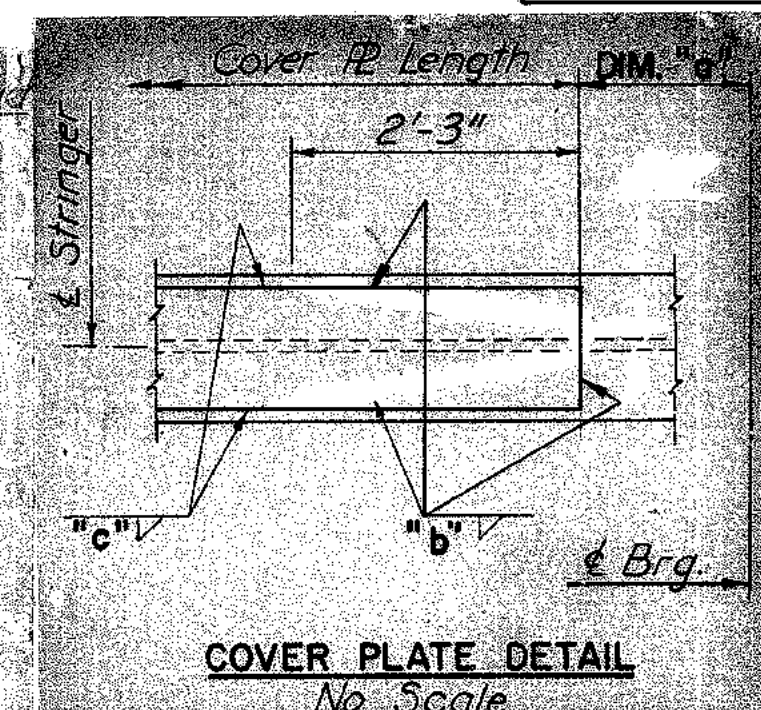

COVER PLATE DETAIL

No Scale

COVER PLATE SCHEDULE				
STR.	DIM. "a"	Cover R.	"b"	"c"
S1&S2	5'-9"			
S3	5'-3"	10 1/2 x 1 3/4		
S4&S7	5'-6"			
S5&S6	6'-0"	10 1/2 x 1 3/4	5 1/2"	3 1/2"
S8-S10	6'-0"	10 1/2 x 1		
S11&S12	5'-0"	10 1/2 x 1 1/2		
S13	5'-9"	10 1/2 x 1 1/2		
S14	7'-3 3/4"	10 1/2 x 1 1/2		
S15	7'-0 1/4"	10 1/2 x 1 3/4		

SHOE SCHEDULE			
EXPANSION SHOES		FIXED SHOES	
TYPE	NO. REQD.	TYPE	NO. REQD.
E2	8	F1	5
E3	7	F1M	3
		F12	5
		F12M	2

NOTE TO FABRICATOR:

The above stringers shall be fabricated with an upward camber amounting to the tabulated value.  
This will provide approximate compensation for deflection under full dead load and for conformity with finished grade.  
Dimensions are in inches.

NOTE TO CONTRACTOR:

The above deflections are those anticipated to occur in the stringer upon placement of the total concrete deck dead load.  
In practice, the stringers in place are not likely to have the exact camber to compensate for these deflections during construction. The residual amounts shall be provided for by adjusting forms to vary the thickness of the concrete balster between the bottom of the slab and the top of stringer, without alteration of the slab thickness.

BY	DATE	REVISION	BY	DATE
MADE	D.L.A. 10-67			
CHECKED	TEM 2-68	1 As Built	TEM	7-77
IN CHARGE	PRY			

AS BUILT


RICHMOND METROPOLITAN AUTHORITY  
RICHMOND EXPRESSWAY SYSTEM  
DOWNTOWN EXPRESSWAY  
BRIDGE B-58  
7TH STREET OVER  
DOWNTOWN EXPRESSWAY  
FRAMING PLAN

HOWARD, NEEDLES, TAMMEN & BERGENDOFF  
consulting engineers  
NEW YORK ALEXANDRIA KANSAS CITY  
SCALE: AS SHOWN  
CONTRACT NO. 9  
SHEET NO. 10 OF 17








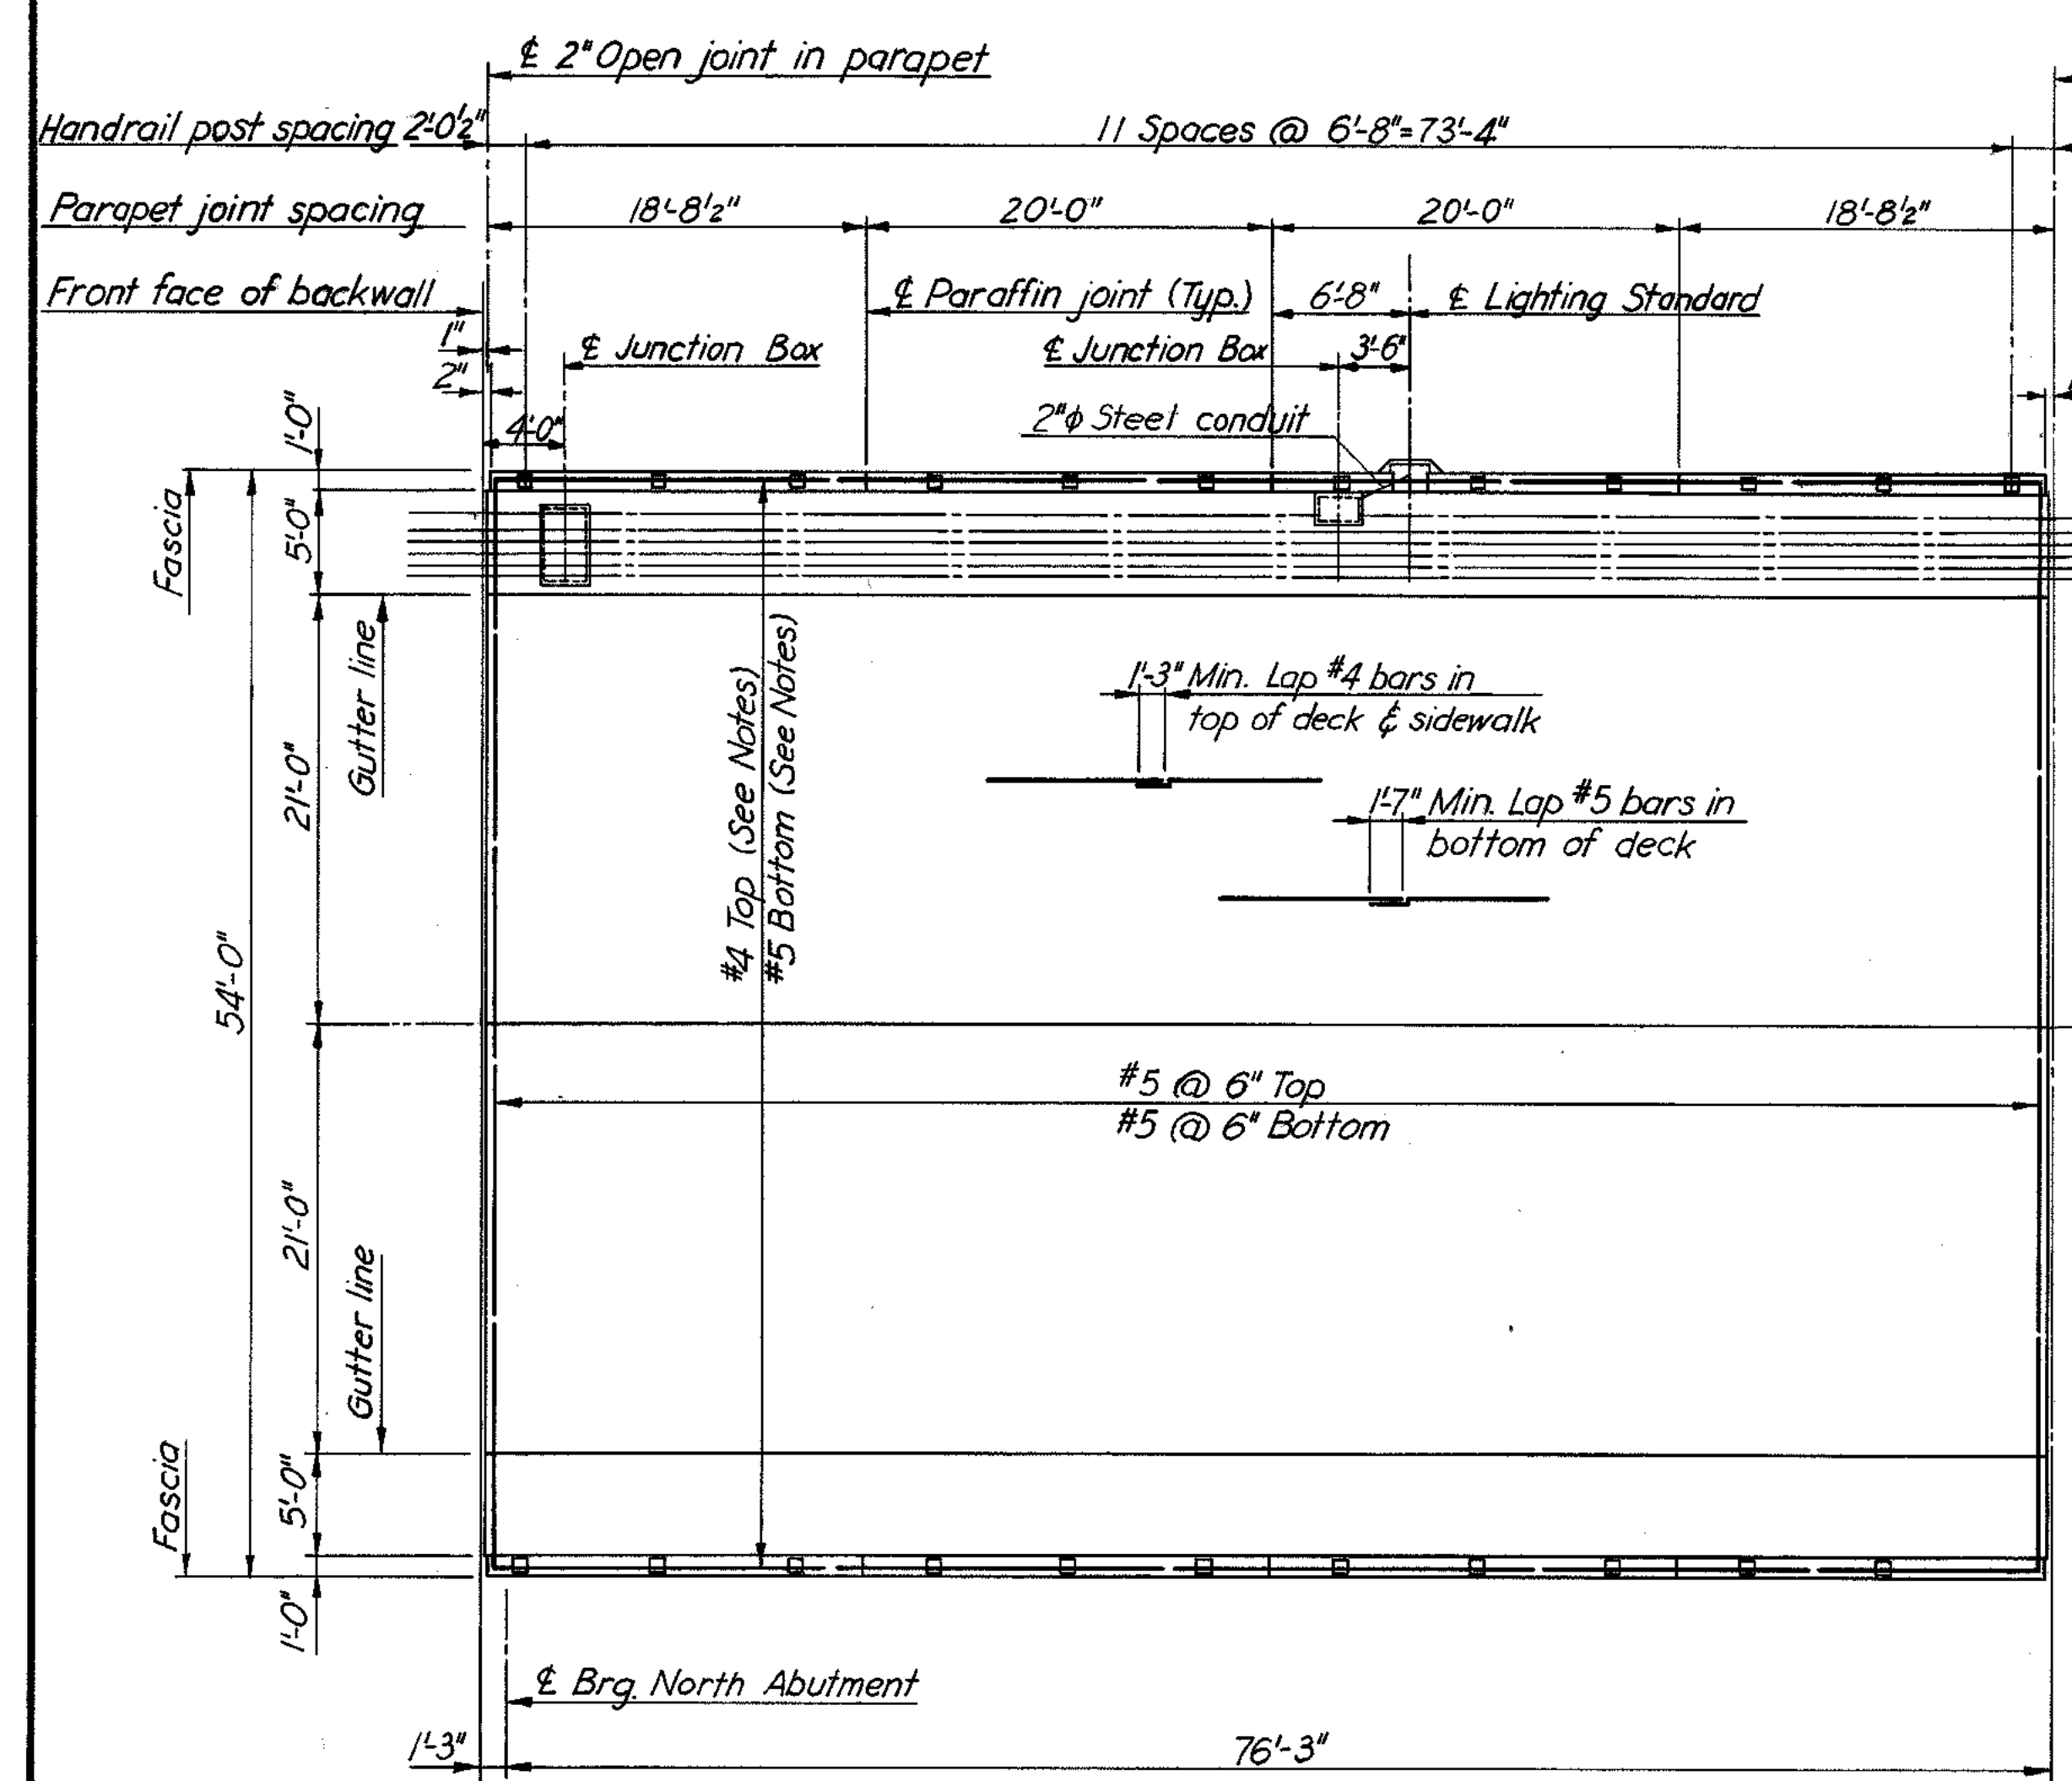


UNIT 1  
Scale: 1/8" = 1'-0"


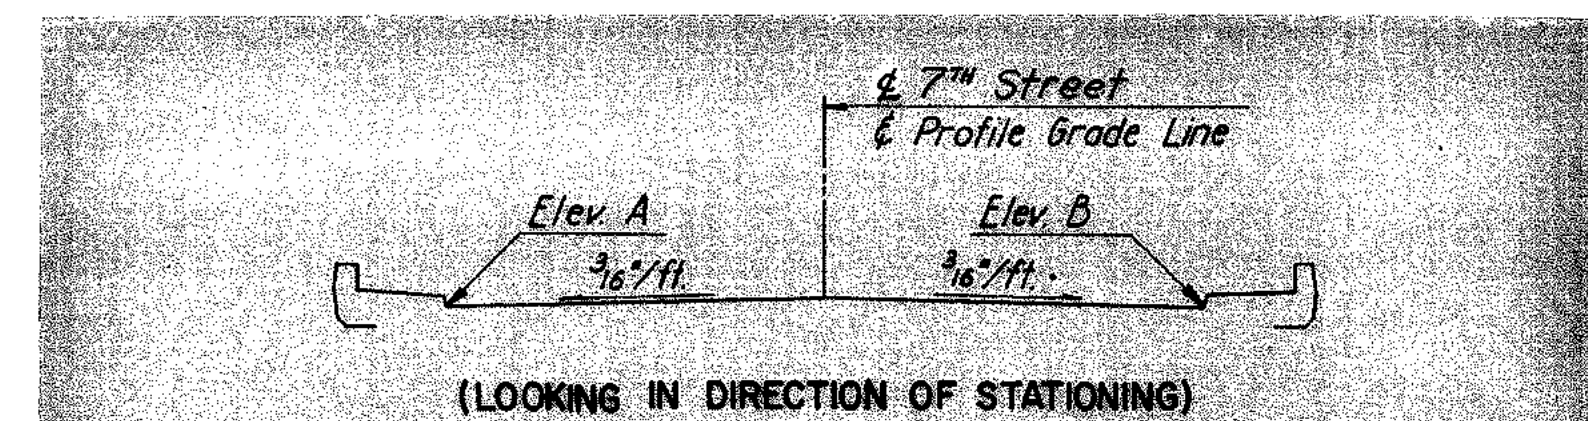


PAVEMENT ELEVATIONS							
STATION	ELEV. A	B & PGL	ELEV. B	STATION	ELEV. A	B & PGL	ELEV. B
16+90	*84.29	*84.02	*84.29	19+24	85.96	86.29	85.96
17+00	*84.47	*84.80	*84.47	18+00	85.94	86.26	85.90
+10	*84.69	*85.02	*84.69	+10	85.86	86.19	85.76
+15.74	84.83	85.16	84.83	+20	85.75	86.08	85.55
+20	84.93	85.26	84.93	+30	85.59	85.92	85.29
+30	85.21	85.54	85.21	+40	85.38	85.71	84.98
+40	85.44	85.77	85.44	+50	85.14	85.46	84.56
+50	85.63	85.96	85.63	158+24	84.89	85.22	84.12
+60	85.78	86.11	85.78	+60	84.84	85.17	84.03
+70	85.89	86.22	85.89	+70	*84.50	*84.83	*83.36
+80	85.95	86.28	85.95	+80	*84.12	*84.46	*83.15
+90	85.96	86.29	85.96				

\*Elevations shown are given to top of bituminous surfacing.

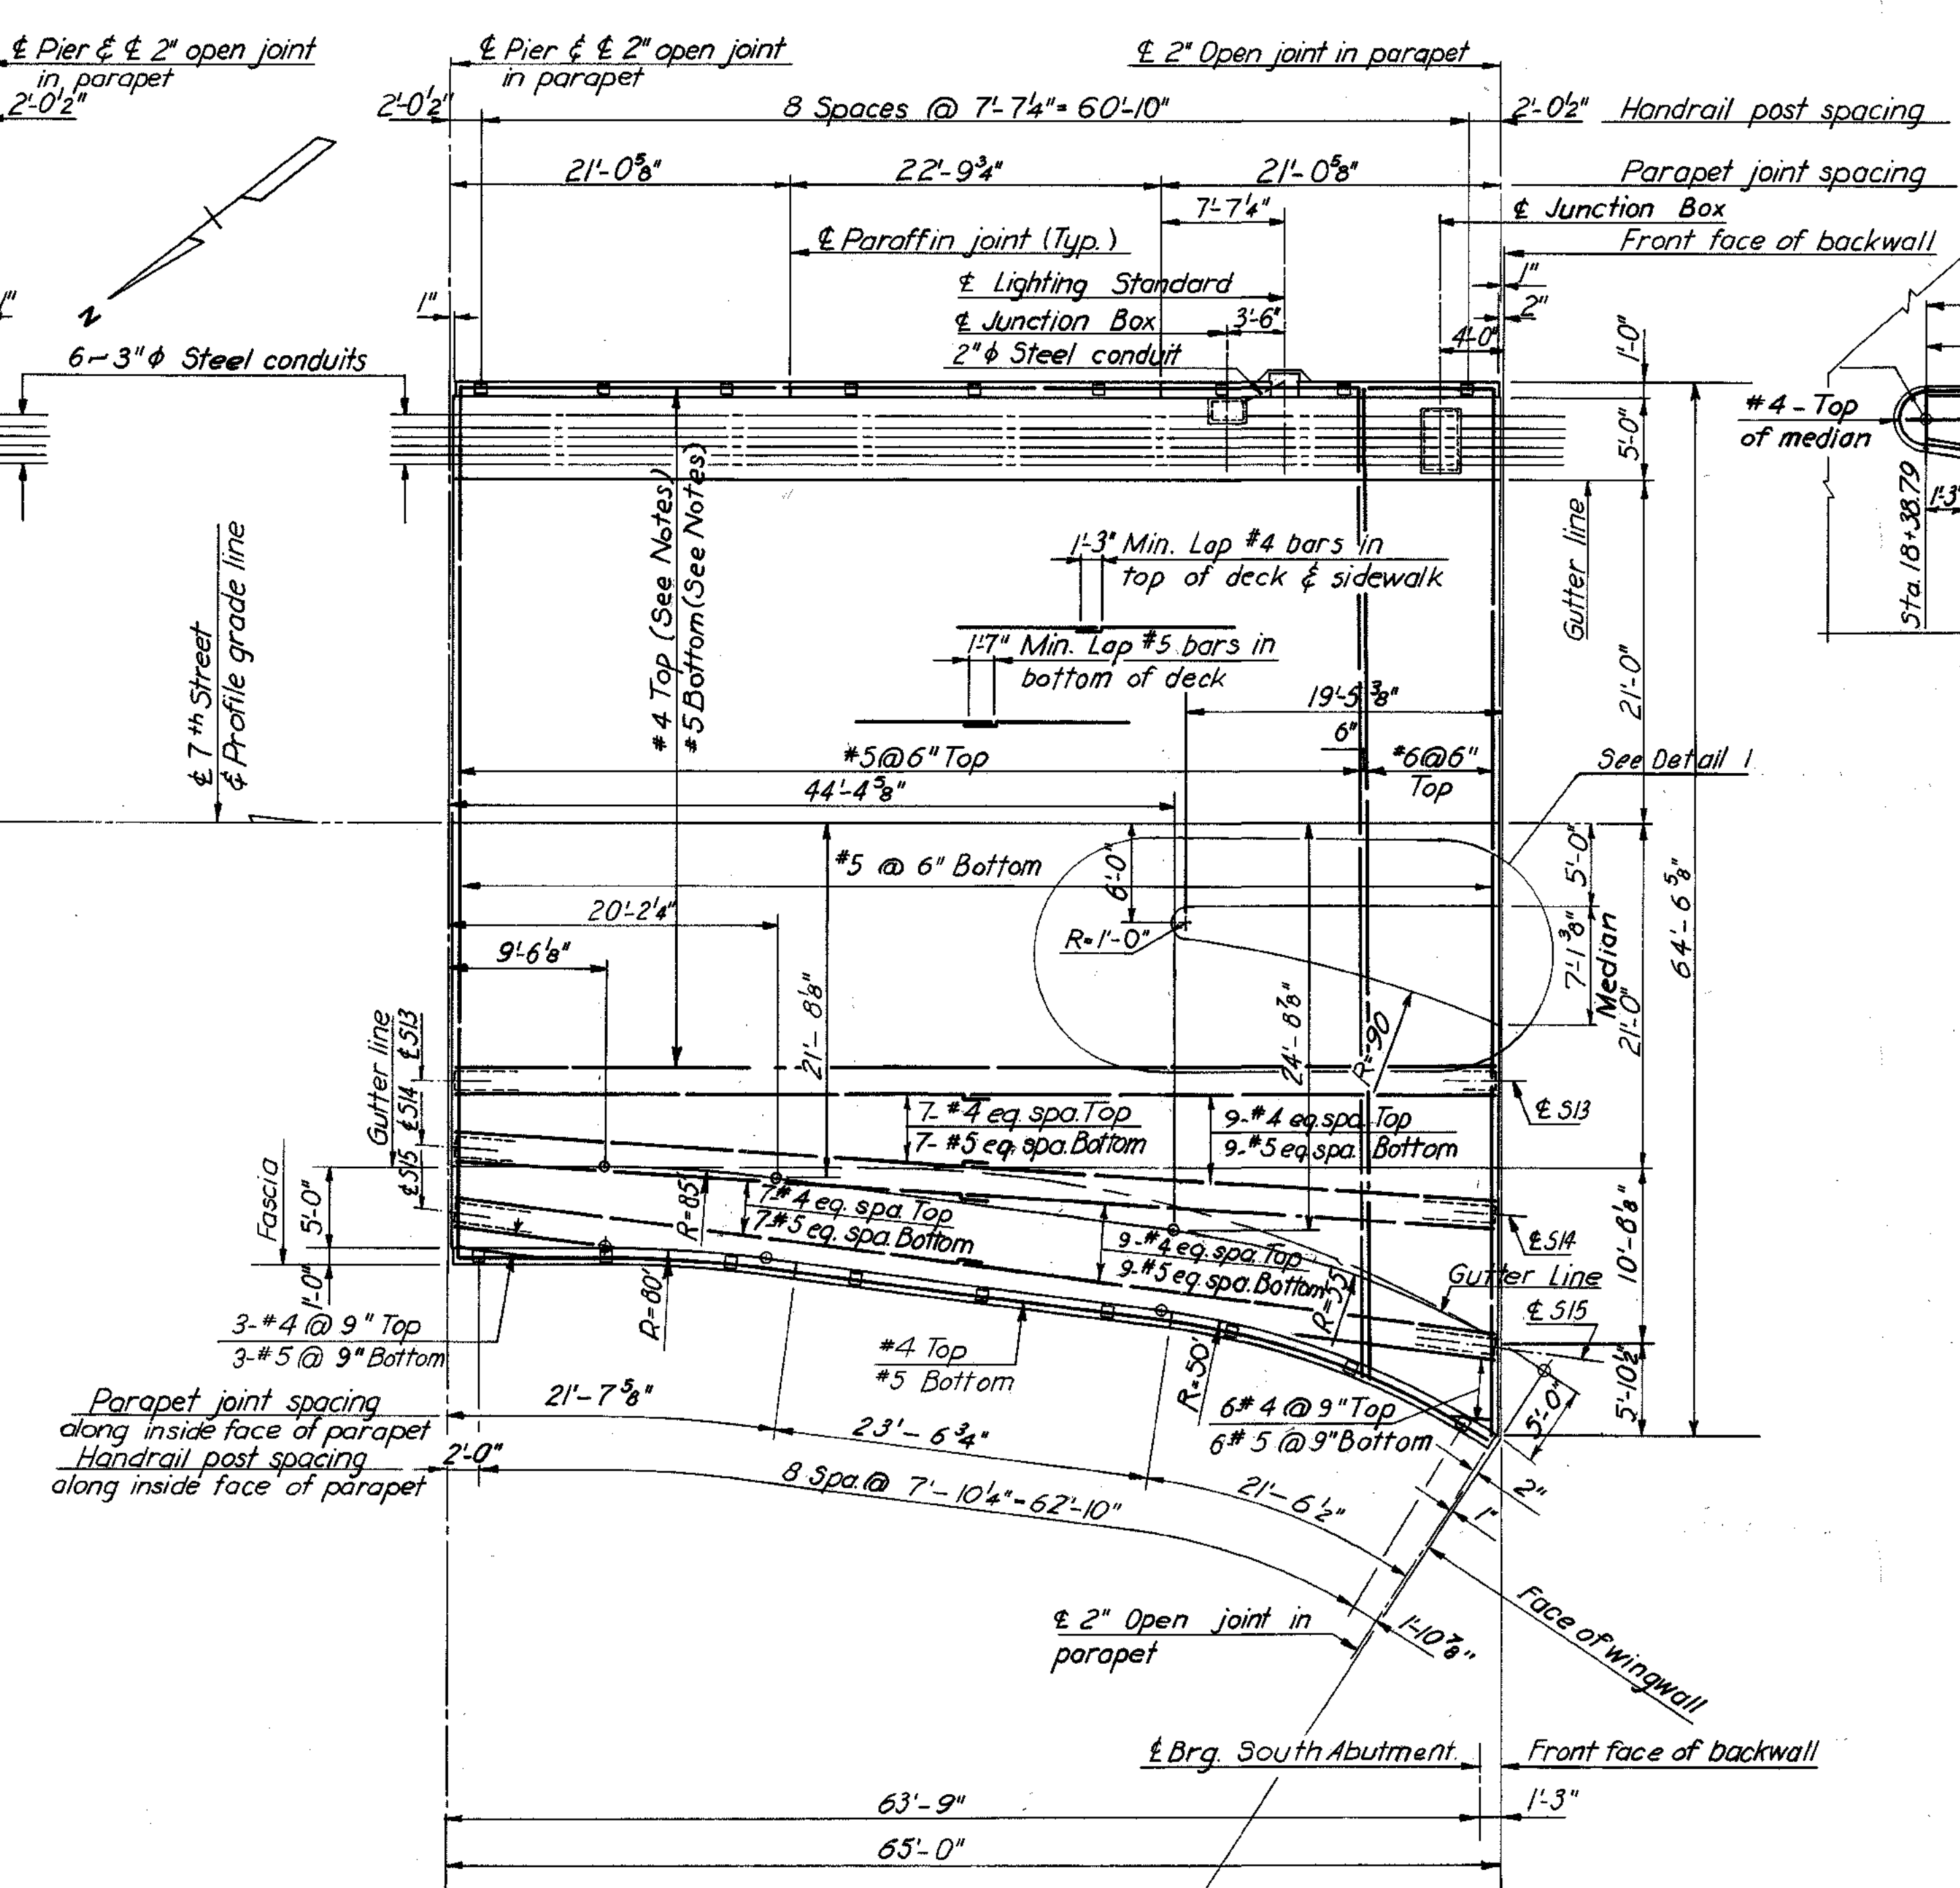

UNIT 2  
Scale: 1/8" = 1'-0"

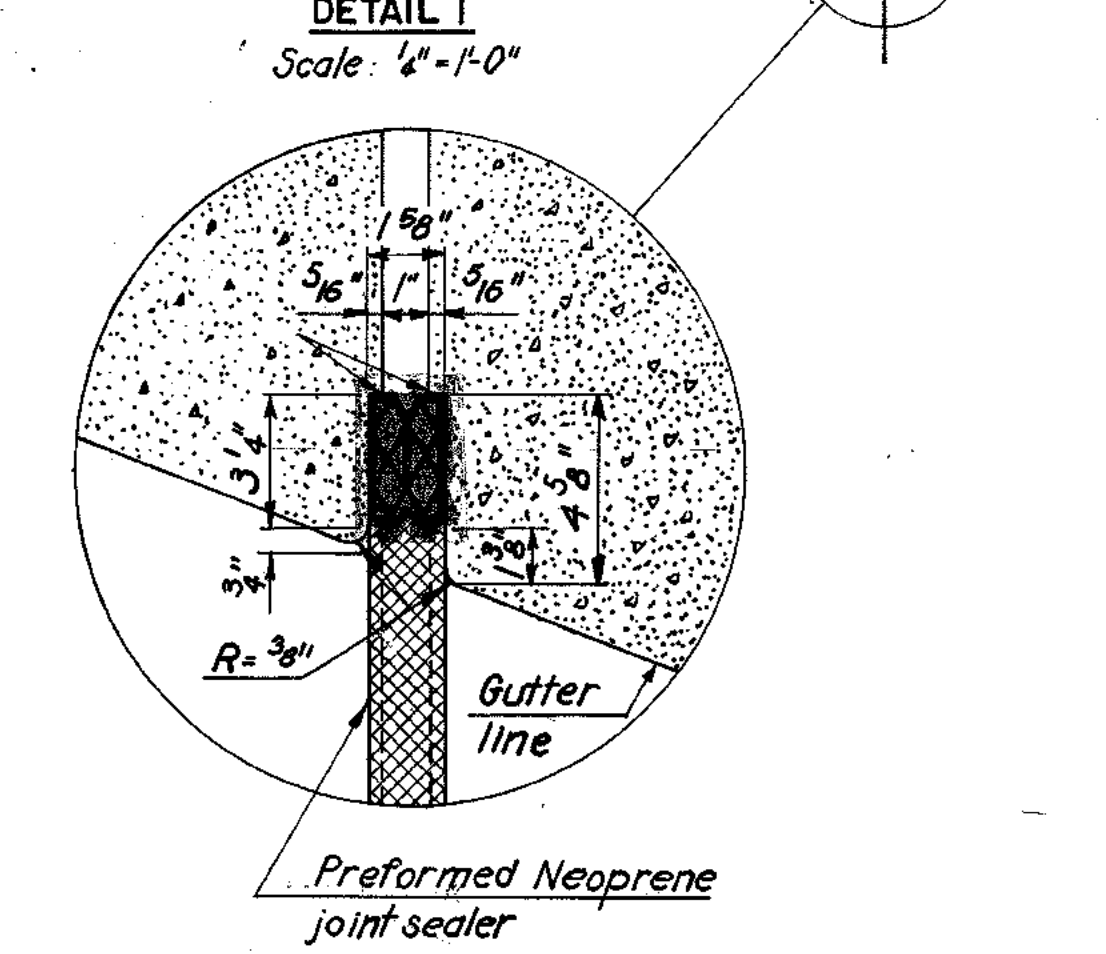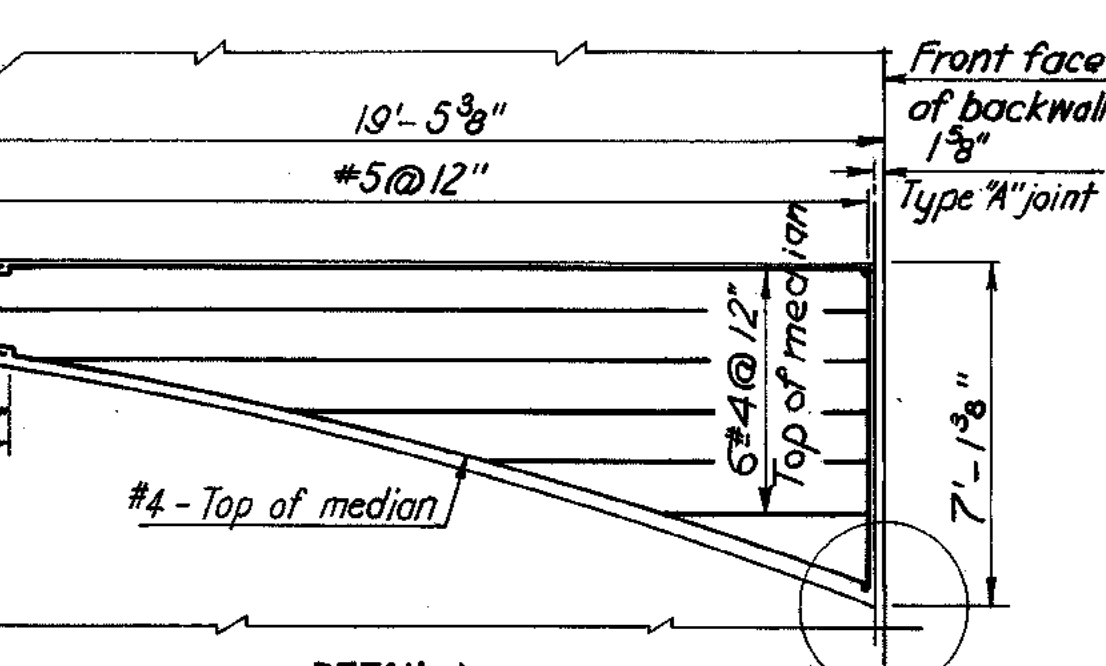


NOTES:

For location and spacing of deck, parapet and sidewalk reinforcing, see Cross Section and Utility Details sheet.

For location and spacing of reinforcing in haunch over end diaphragms, see Joint Details sheet.

For lighting standard base, junction box details and additional reinforcing, see Standard Electrical Details sheet S4.

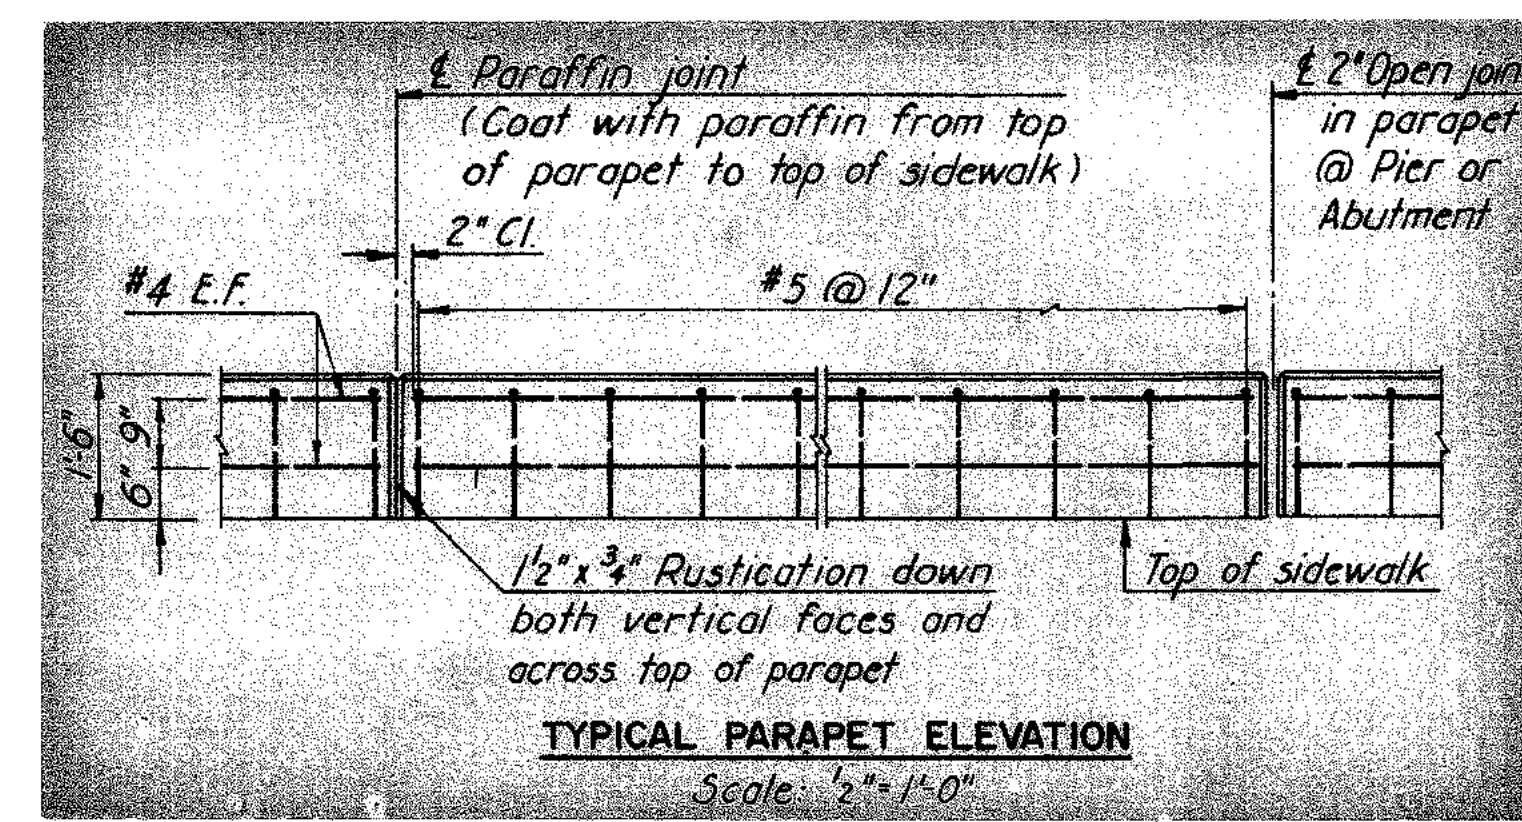

RICHMOND METROPOLITAN AUTHORITY  
RICHMOND EXPRESSWAY SYSTEM  
DOWNTOWN EXPRESSWAY

BRIDGE B-58  
7TH STREET OVER  
DOWNTOWN EXPRESSWAY  
DECK PLANS

HOWARD, NEEDLES, TAMMEN & BERGENDOFF  
consulting engineers  
NEW YORK ALEXANDRIA KANSAS CITY

SCALE: AS SHOWN  
CONTRACT NO. 9  
SHEET NO. 12 OF 17

AS BUILT

**Bridge 60**

**10<sup>th</sup> Street**

**Over**

**Downtown Expressway (VA 195)**




**Record Set Plans**








RICHMOND EXPRESSWAY SYSTEM			
SECTION	PROJECT	SHEET NO.	TOTAL SHEETS
9	DOWNTOWN EXPRESSWAY	204	

INDEX	
NO.	DESCRIPTION
1	General Plan and Elevation
2	General Notes and Quantities
3	North Abutment
4	North Abutment Details (1)
5	North Abutment Details (2)
6	North Abutment Details (3) - Void
7	South Abutment
8	South Abutment Details (1)
9	South Abutment Details (2)
10	South Abutment Details (3)
11	Pier
12	Framing Plan
13	Cross Section and Utility Details
14	Deck Plans
15	Joint Details
16	Approach Slabs
17	Boring Logs
S1	Standard Shoe Details
S3	Standard Aluminum Railing Details (2 Rails)
S4	Standard Electrical Details (Bridges Carrying City Streets)
S7	Standard Architectural Details
S8	Standard Architectural Details
S9	Standard Architectural Details
S10	Standard Conduit Installation Details
S11	Standard Utility Support Details at Bridge Abutments

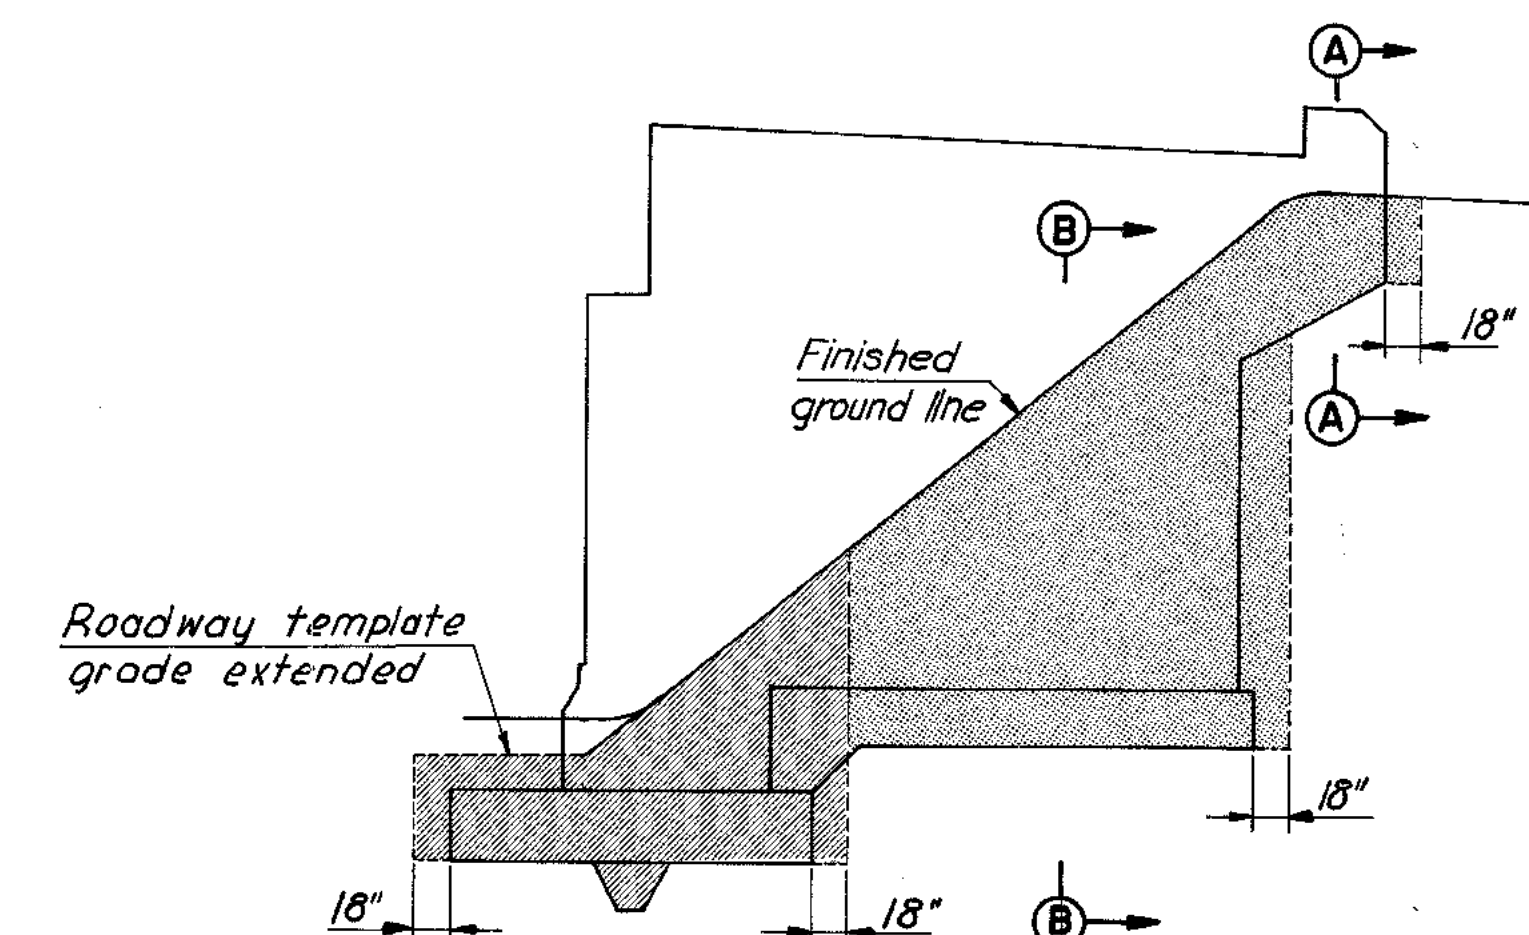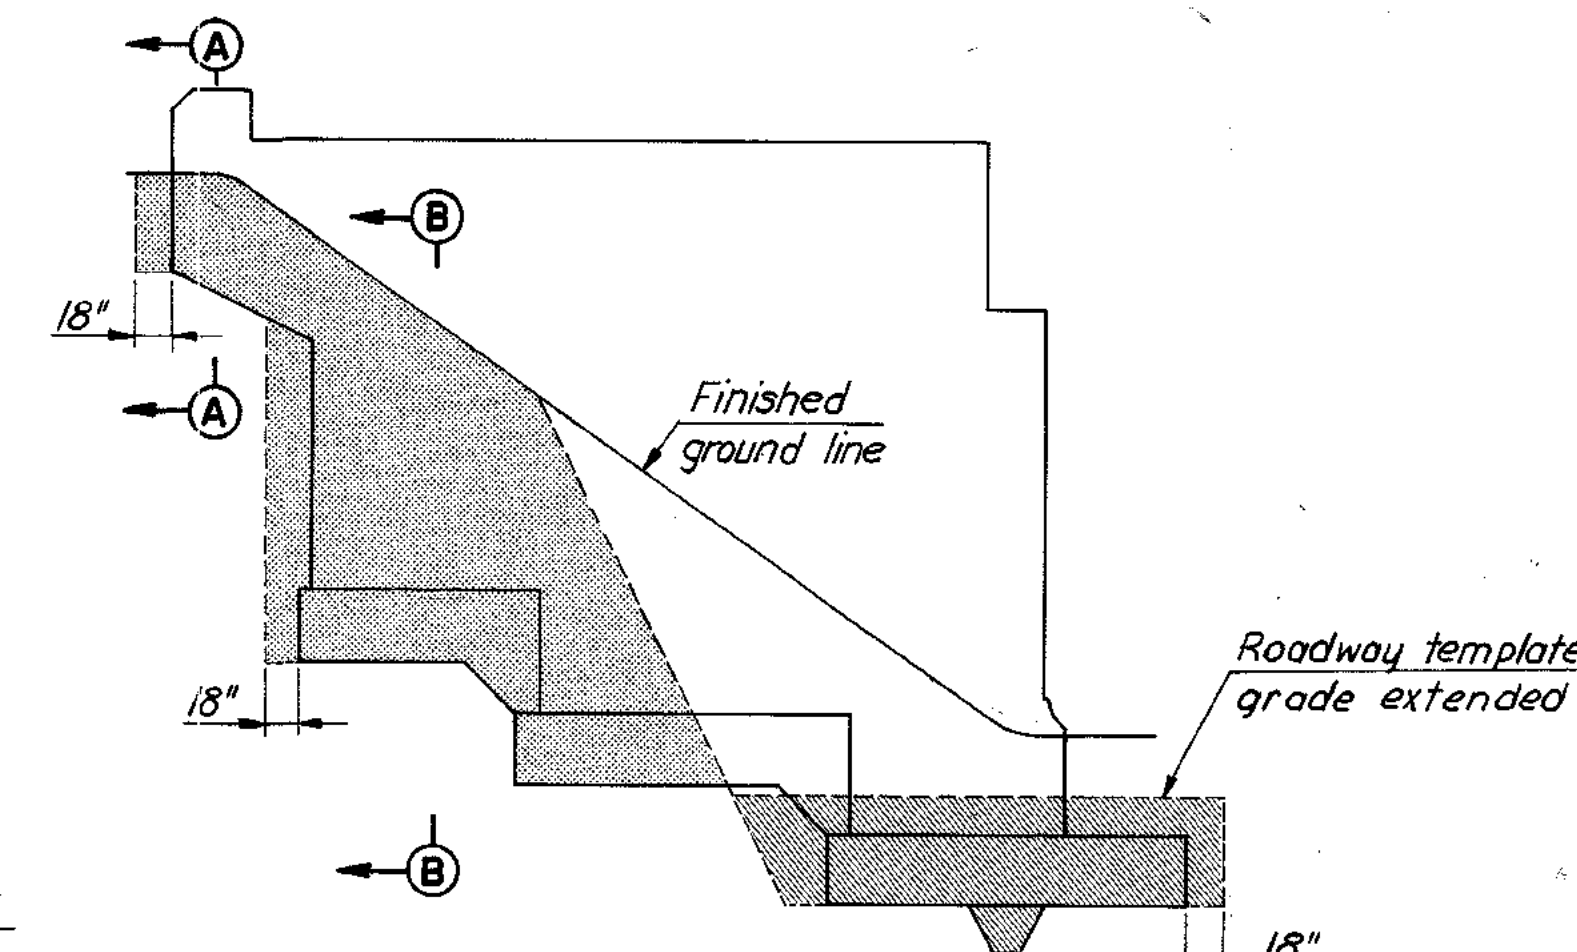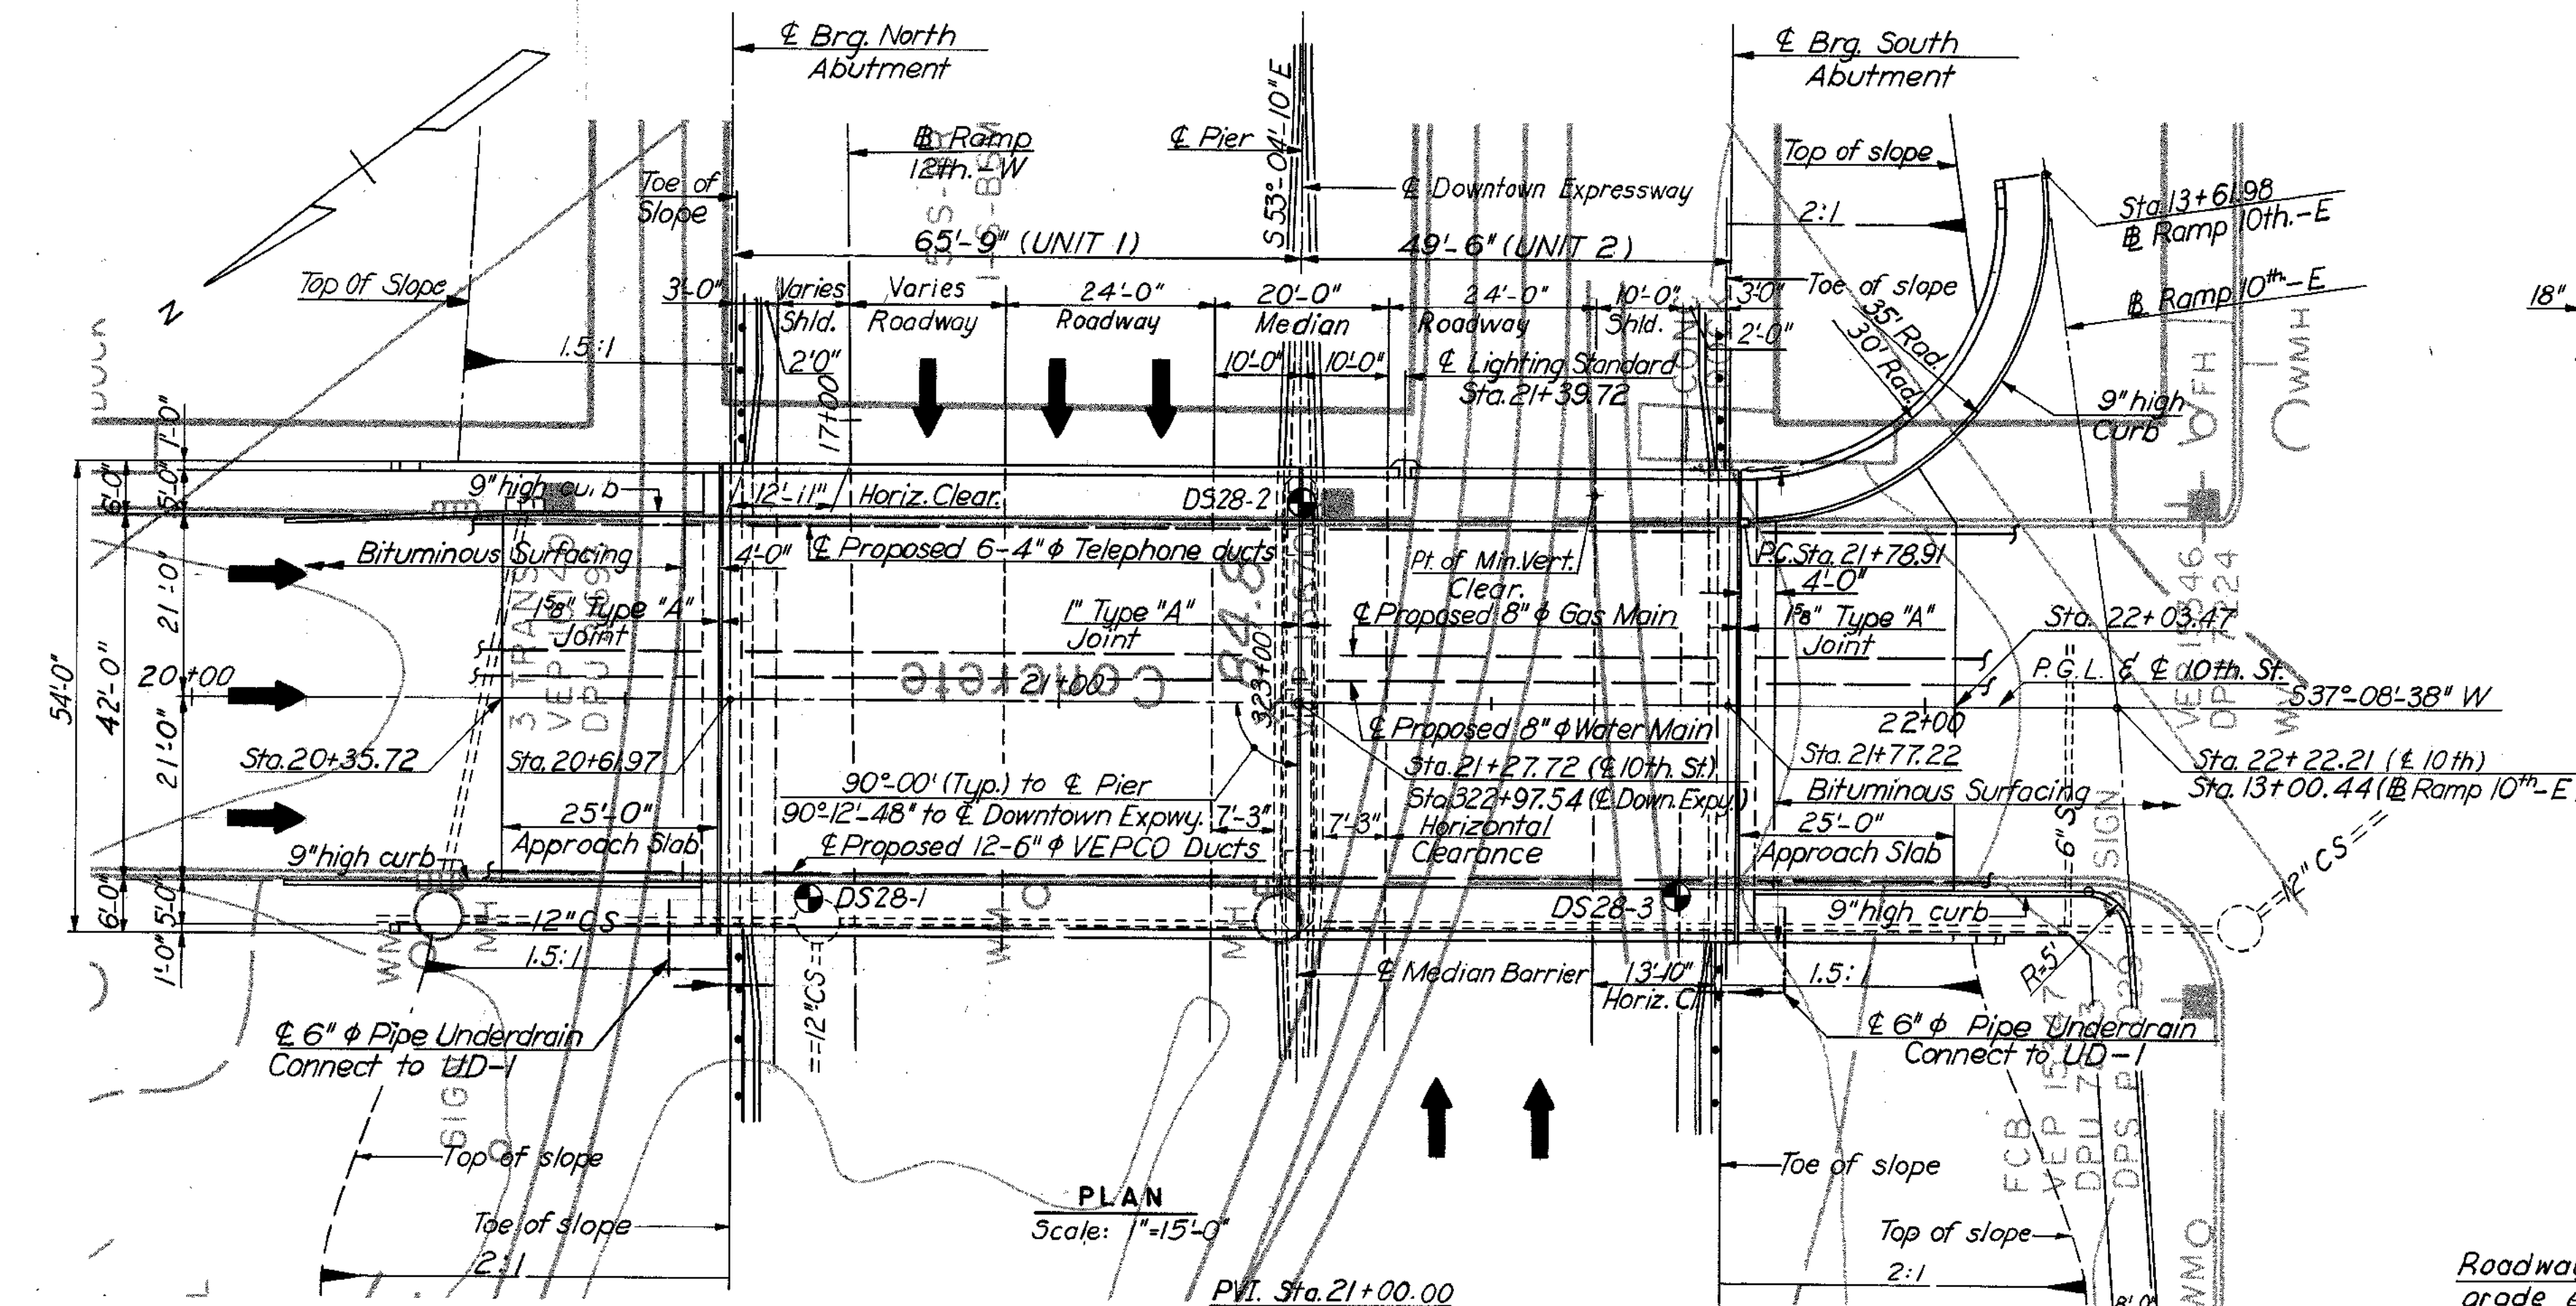

**BORINGS:** Indicates location of 2 1/2" cased hole boring. For boring data, see Boring Logs sheet.

**NOTE:** For General Notes and Quantities, see next sheet.

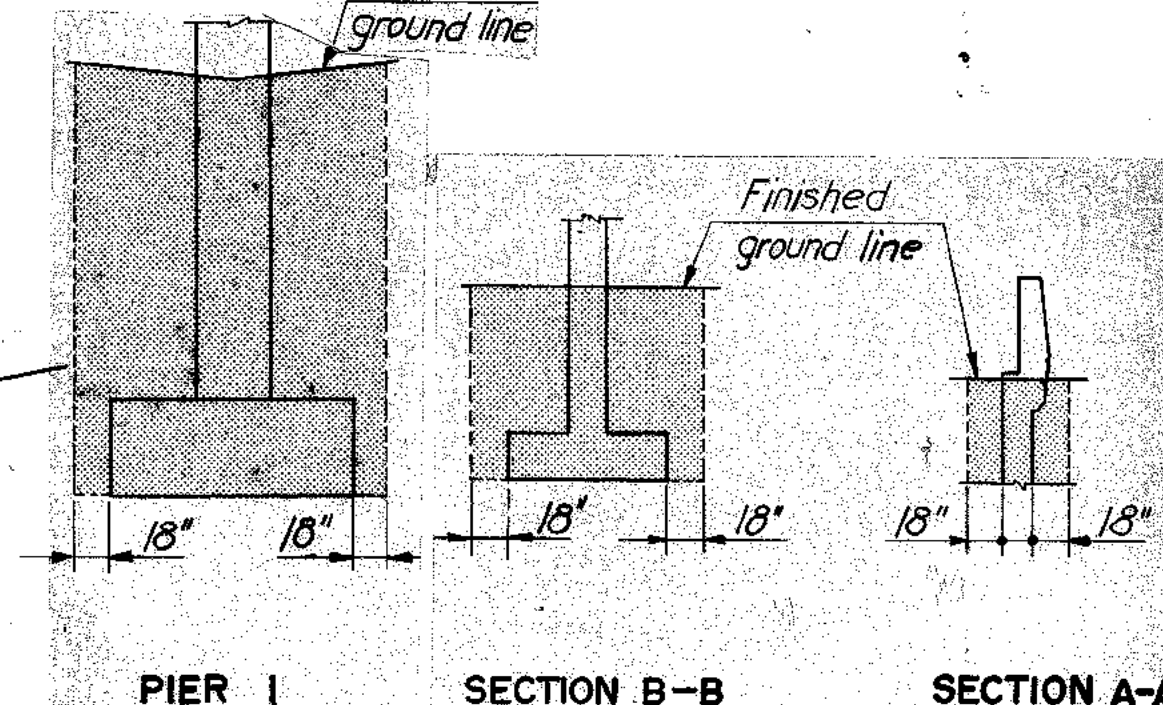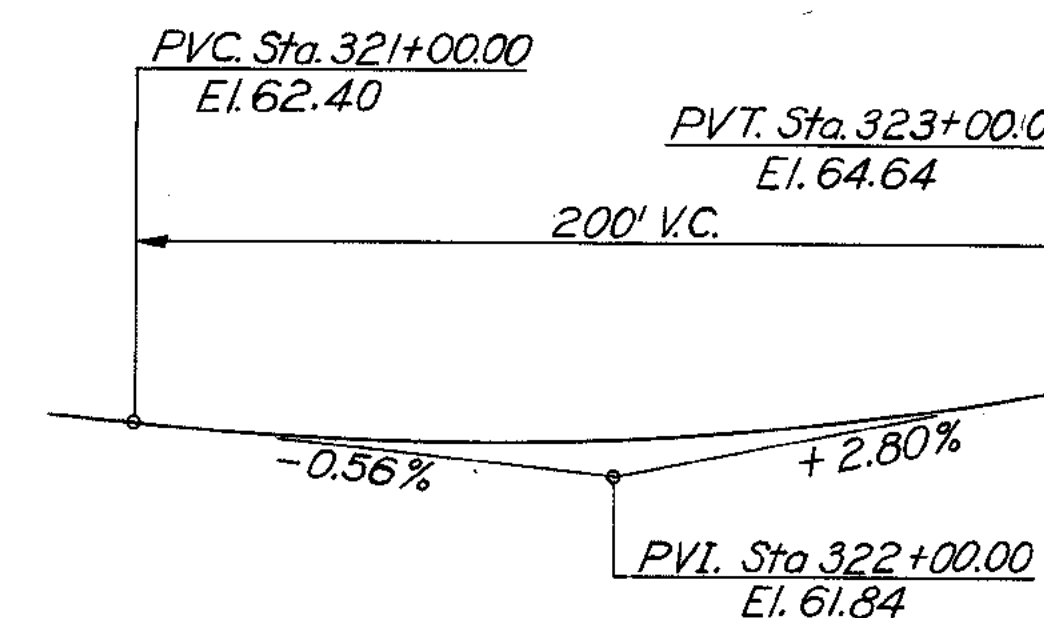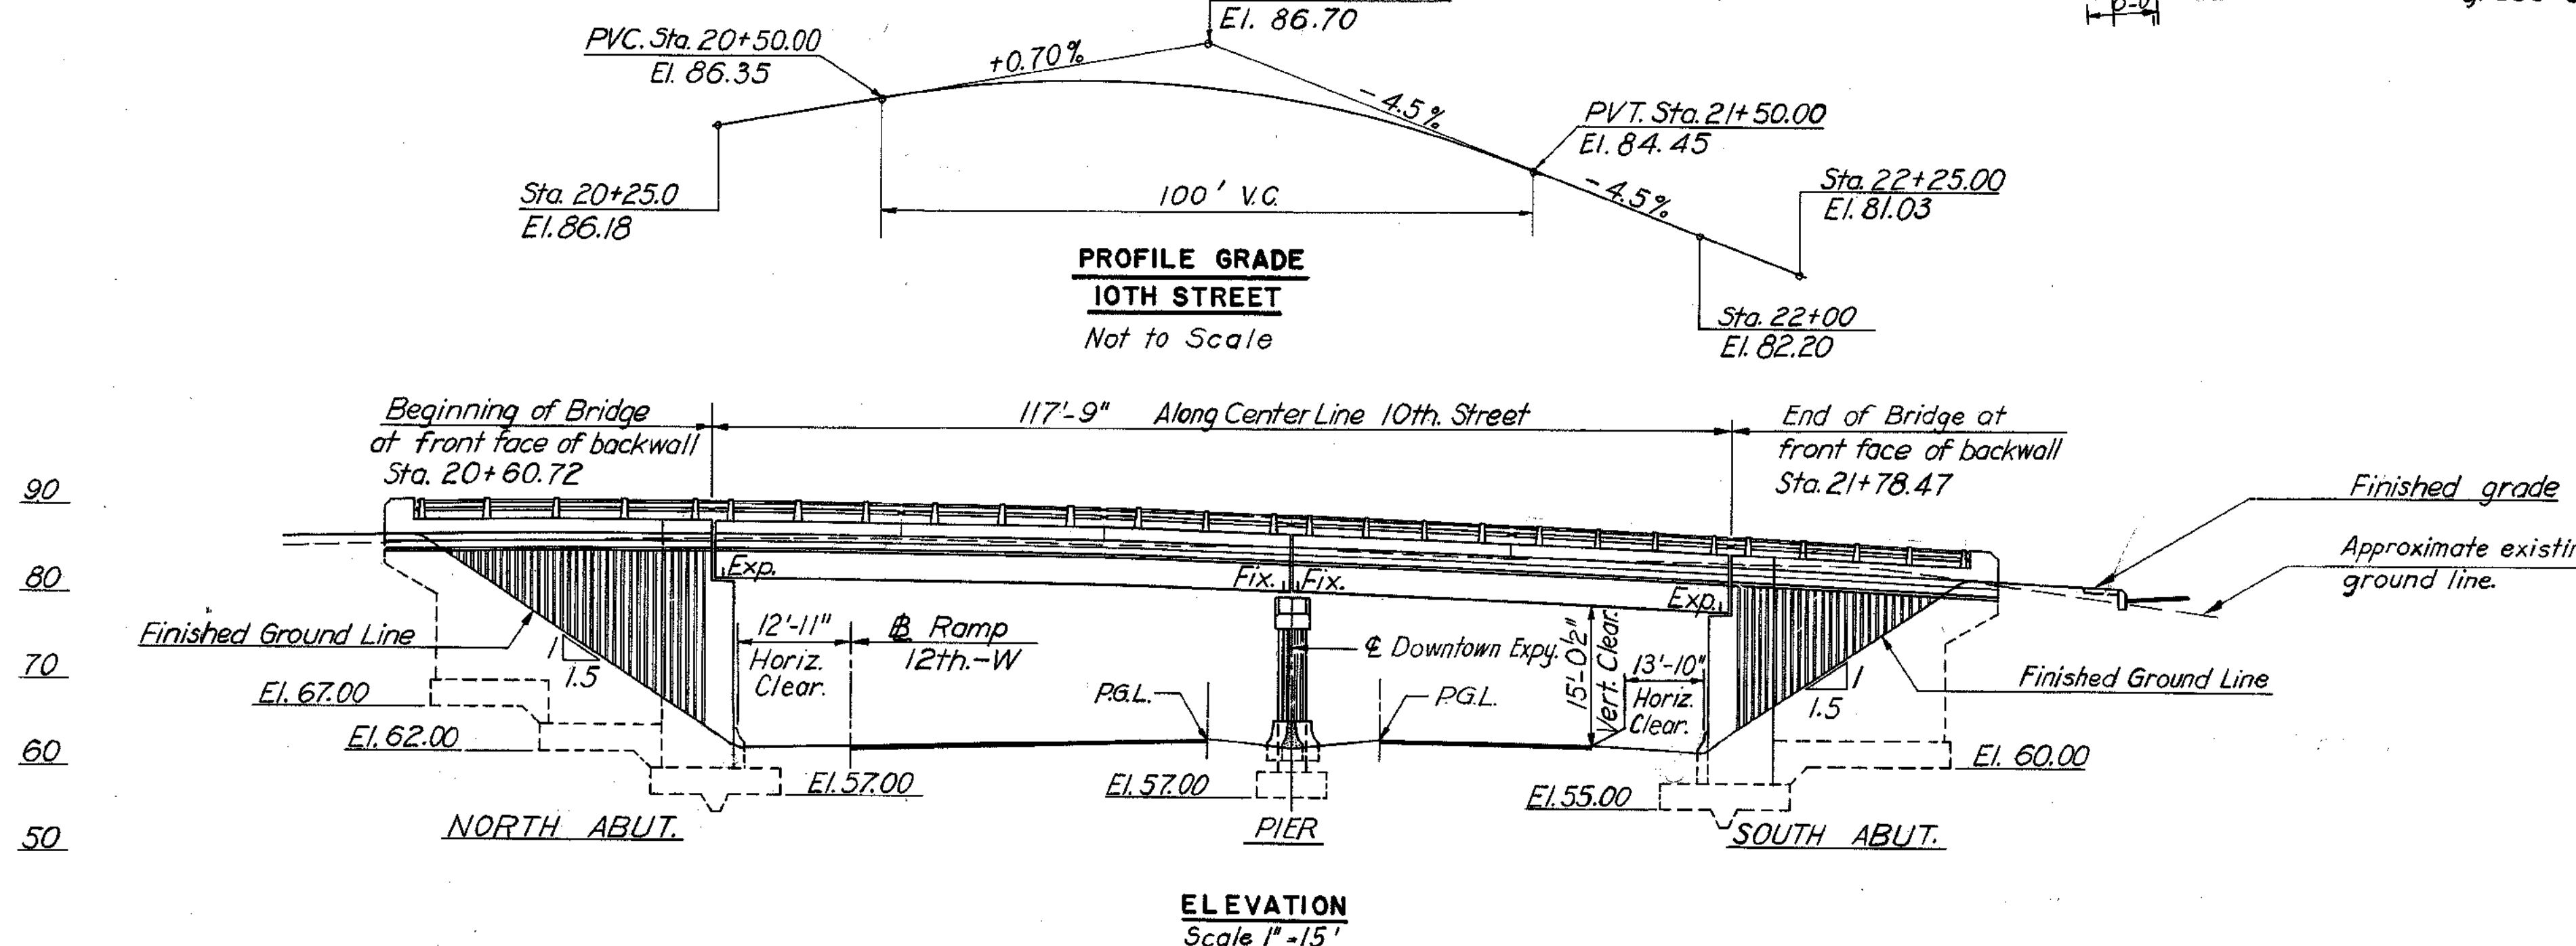

**PAYMENT LIMITS FOR STRUCTURE EXCAVATIONS**  
No Scale

**RICHMOND METROPOLITAN AUTHORITY**  
**RICHMOND EXPRESSWAY SYSTEM**  
DOWNTOWN EXPRESSWAY

**BRIDGE B-60**  
**10TH STREET OVER**  
**DOWNTOWN EXPRESSWAY**

**GENERAL PLAN AND ELEVATION**

HOWARD, NEEDLES, TAMMEN & BERGENDOFF  
consulting engineers  
NEW YORK ALEXANDRIA KANSAS CITY

SCALE: AS SHOWN  
CONTRACT NO.: 9  
SHEET NO. 1 OF 17

AS BUILT



GENERAL NOTES

**ROADWAY CAPACITY:** One 42'-0" clear roadway. Two 5'-0" sidewalks. Dead Load-Includes 15 lbs. per sq.ft. for future wearing surface. Live Loads-HS20-44 loading and B.P.R. modified for military vehicles.

**SPECIFICATIONS:** GENERAL-Virginia Department of Highway Road and Bridge Specifications, 1970. DESIGN-A.A.S.H.O. Standard Specifications for Highway Bridges, 1961, modified by Special Design Provisions. WELDING-1969 Standard Specifications for Welded Highway and Railway Bridges of the American Welding Society.

**CONTRACT SPECIAL PROVISIONS**

Specifications and Contract Special Provisions referred to above are necessary to make these plans complete.

**DATUM:** CITY OF RICHMOND

**TEMPERATURE:** The normal temperature referred to on the plan is 60°F. The temperature range for movement is 0°F to 120°F.

**DIMENSIONS:** All dimensions are measured horizontally and vertically unless otherwise noted.

**EXCAVATION:** Excavation below subgrade and cut slope template shall be classified as Structure Excavation. All excavation above these limits shall be classified as Regular Excavation and is not included in the Structural Quantities.

**FOUNDATIONS:** Footings shall rest on firm material. Foundation material shall be kept dry and special attention is called to Section 401.05 of the General Specifications and to the Contract Special Provisions concerning preparation of foundations for footings.

**CONCRETE NOTES:** Concrete in superstructure shall be Class A4. All other concrete shall be Class A3. All exposed edges and corners shall have a 3/4" chamfer or fillet unless otherwise noted. Care in the method of vibration, the use of low-slump concrete, and/or other means shall be employed to prevent downgrade movement of newly placed slab concrete (when gradient is over 2%).

Finishing Concrete Surfaces: See the Standard Architectural Details sheets and the Contract Special Provisions for types and details.

All reinforcing steel shall conform to ASTM A615 Grade 40. All reinforcing bar dimensions on the detailed drawings are to centers of bars unless otherwise noted. Clear distance between reinforcing steel and face of concrete shall be as noted on the plans. All bar laps shall be 30 diameters of the smaller diameter bar unless otherwise noted.

**STEEL NOTES:** Structural steel shall conform to A.S.T.M. Specification A36 except as noted. All field connections shall be made with high strength bolts. High strength bolts shall be 7/8" diameter unless otherwise noted and shall conform to A.S.T.M. Specifications A325.

**BENCH MARKS:** See Reference Ties and Field Control Data sheet in highway plans.

C-56 Plug, corner E. Cary St. and S. 10th St., Elev. 77.32

RICHMOND EXPRESSWAY SYSTEM			
SECTION	PROJECT	SHEET NO.	TOTAL SHEETS
9	DOWNTOWN EXPRESSWAY	205	

FINAL QUANTITIES

	STRUCTURE EXCAVATION C.Y.	CONCRETE CLASS A3 C.Y.	CONCRETE CLASS A3 BR. APPR. SLABS C.Y.	CONCRETE CLASS A4 C.Y.	REINFORCING STEEL LBS.	STRUCTURAL STEEL LBS.	ALUMINUM BR. RAILING (2 RAILS) L.F.	POROUS BACKFILL C.Y.	DAMP-PROOFING S.Y.	UNDERDRAIN 6" Ø L.F.	GAS MAIN 8" Ø L.F.	WATER MAIN 8" Ø L.F.	CONDUIT 6" Ø VEPCO L.F.	CONDUIT 4" Ø TELEPHONE L.F.	METAL CONDUIT 3" Ø L.F.	
SUPERSTRUCTURE				229.19	48,894	176,516	235.3				171	173	2037	1018.5	879	
NORTH ABUTMENT	1418	445.53			35,711		69.2	129	272	132						
PIER I	194	8547			18,598											
SOUTH ABUTMENT	960	441.36			35,887		75.8	133	280	137						
APPROACH SLABS			118.03		26,018											
TOTAL	2572	972.36	118.03	229.19	165,018	176,516	380.3	262	552	269	171	173	2037	1018.5	879	

	BY	DATE				
MADE	EVR	3-68	2	AS BUILT	HMH	5-76
CHECKED	A.B.P.	12-68	1	N. Abut & total quant	TEM	6-74
IN CHARGE	PRY		NO.	REVISION	BY	DATE

RICHMOND METROPOLITAN AUTHORITY

RICHMOND EXPRESSWAY SYSTEM

DOWNTOWN EXPRESSWAY

BRIDGE B-60

10TH STREET OVER

DOWNTOWN EXPRESSWAY

GENERAL NOTES AND QUANTITIES

HOWARD, NEEDLES, TAMMEN & BERGENDOFF

consulting engineers

NEW YORKALEXANDRIAKANSAS CITY

SCALE: AS SHOWN

CONTRACT NO. 9










SHEET NO. 2 OF 17

AS BUILT

205



RICHMOND EXPRESSWAY SYSTEM			
SECTION	PROJECT	SHEET NO.	TOTAL SHEETS
9	DOWNTOWN EXPRESSWAY	214	

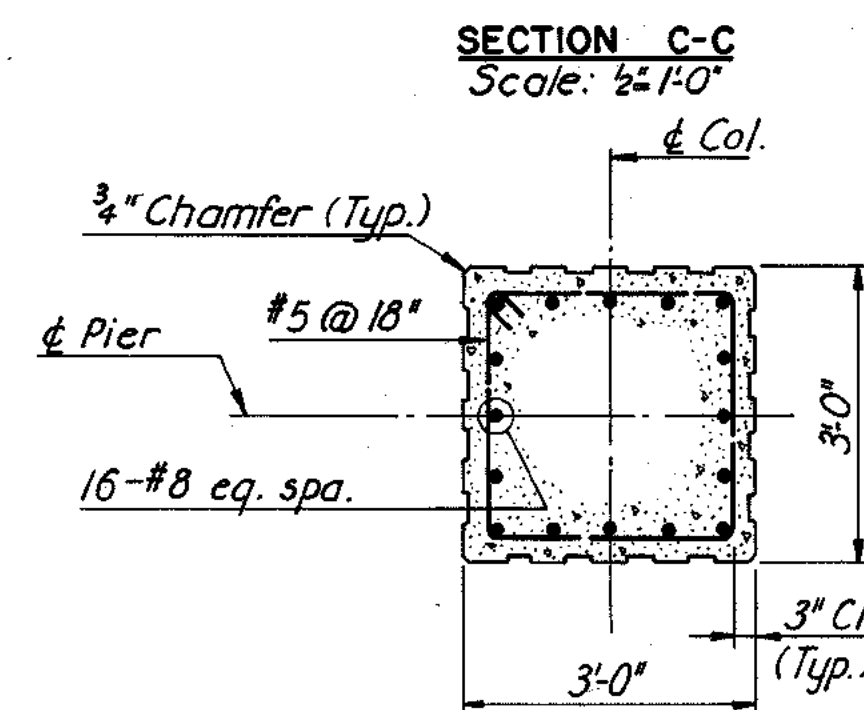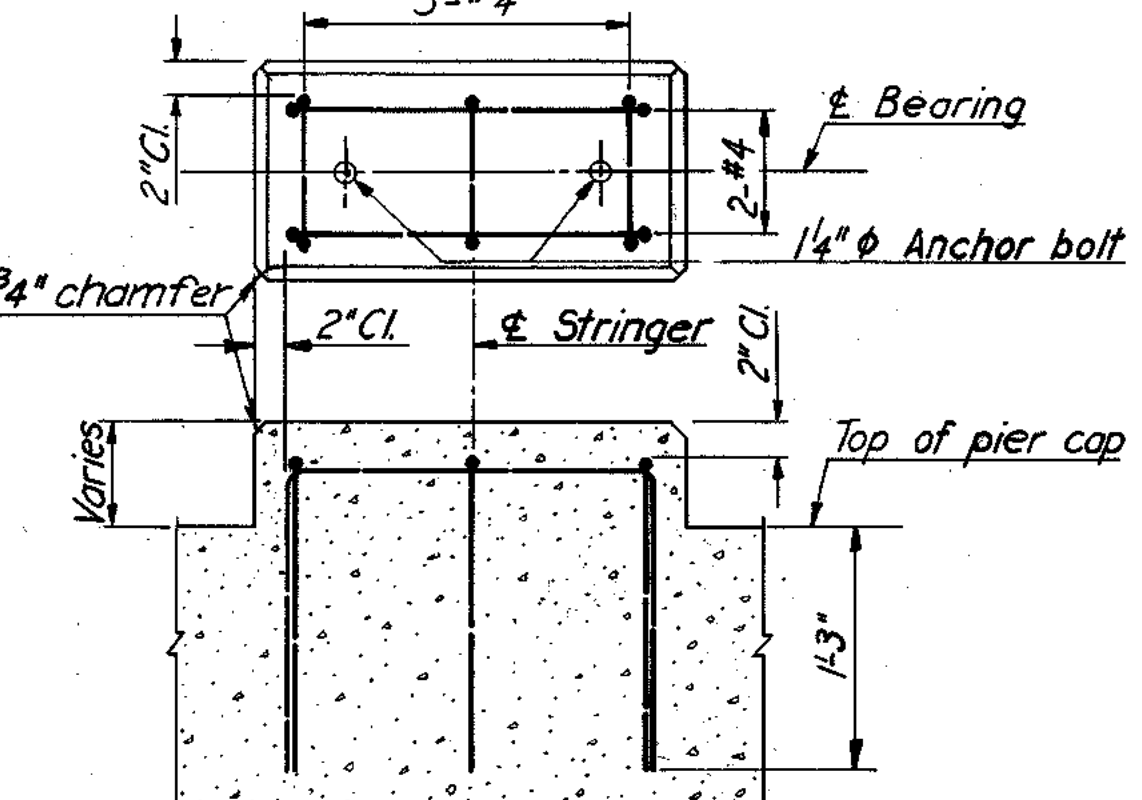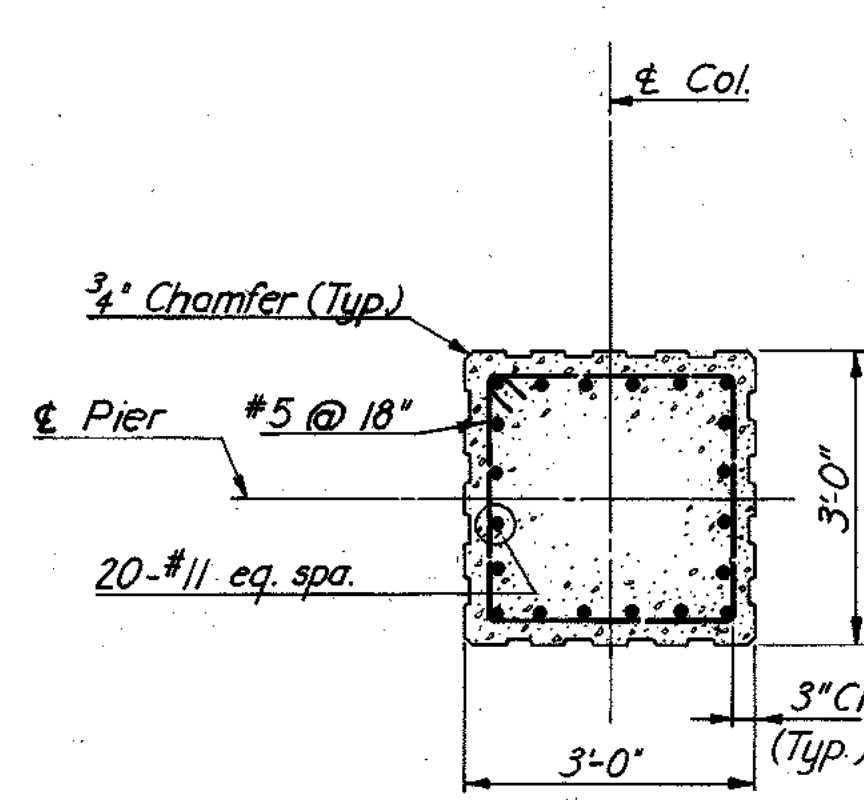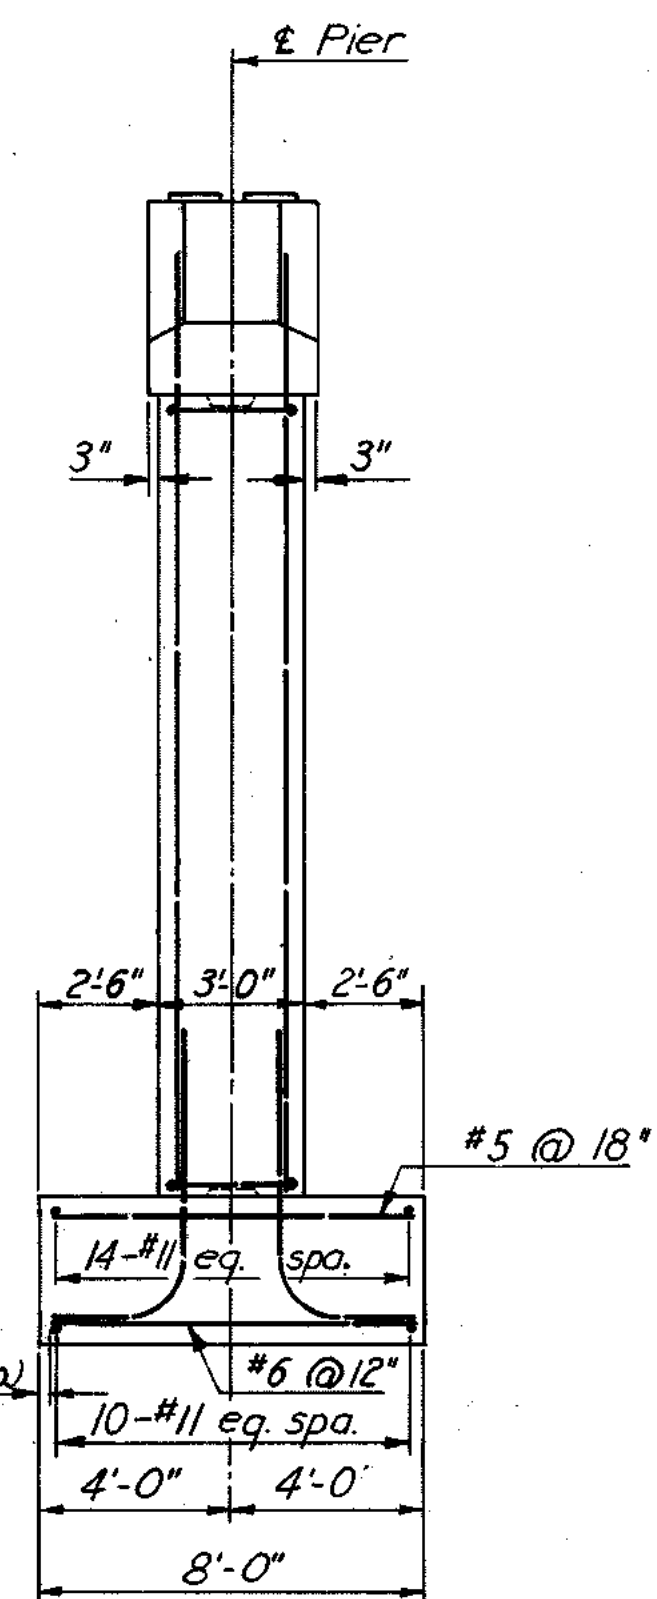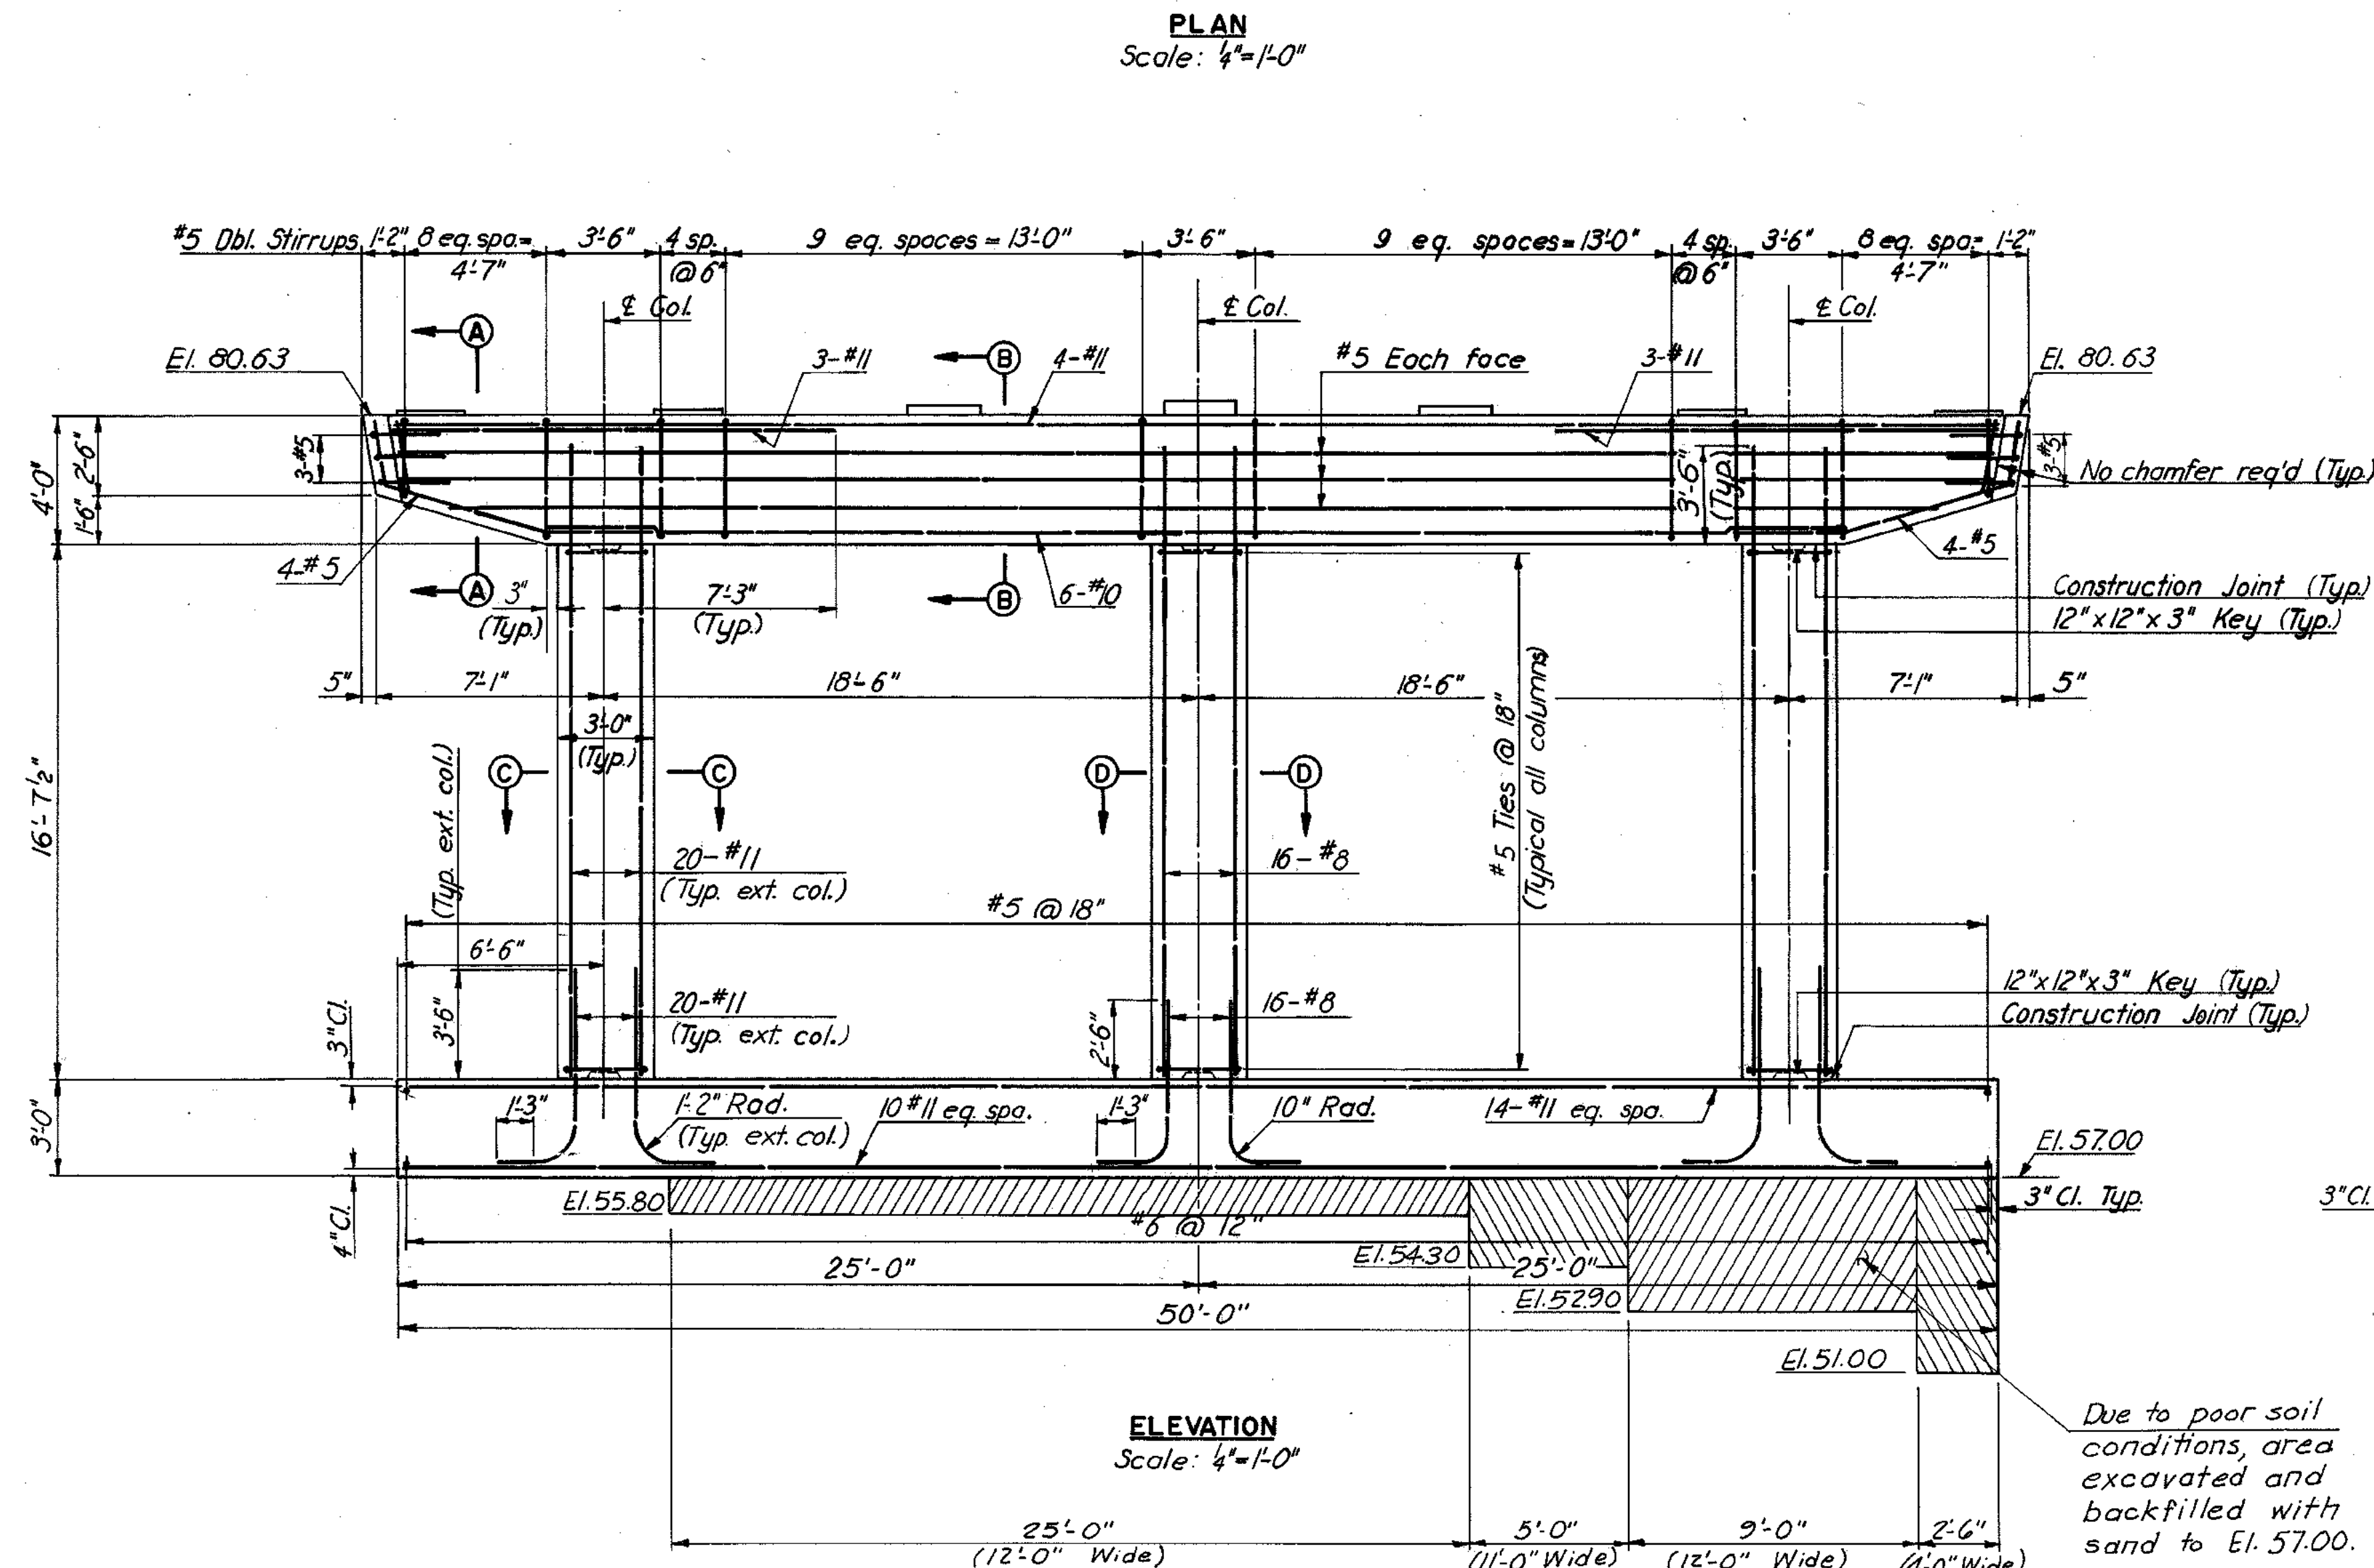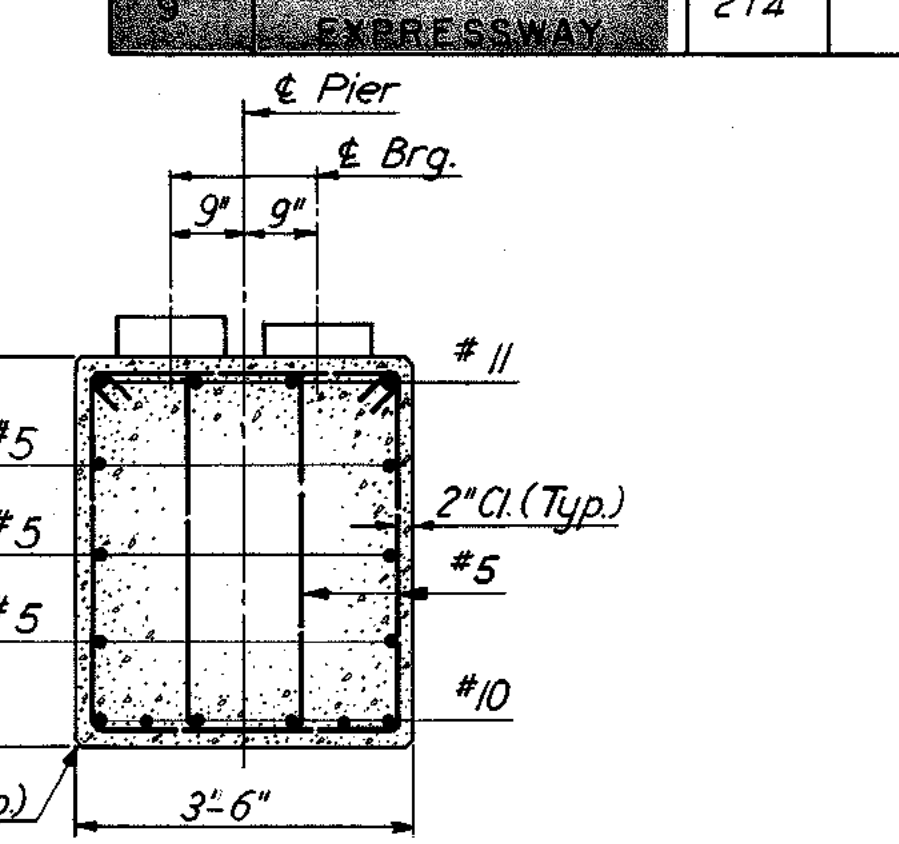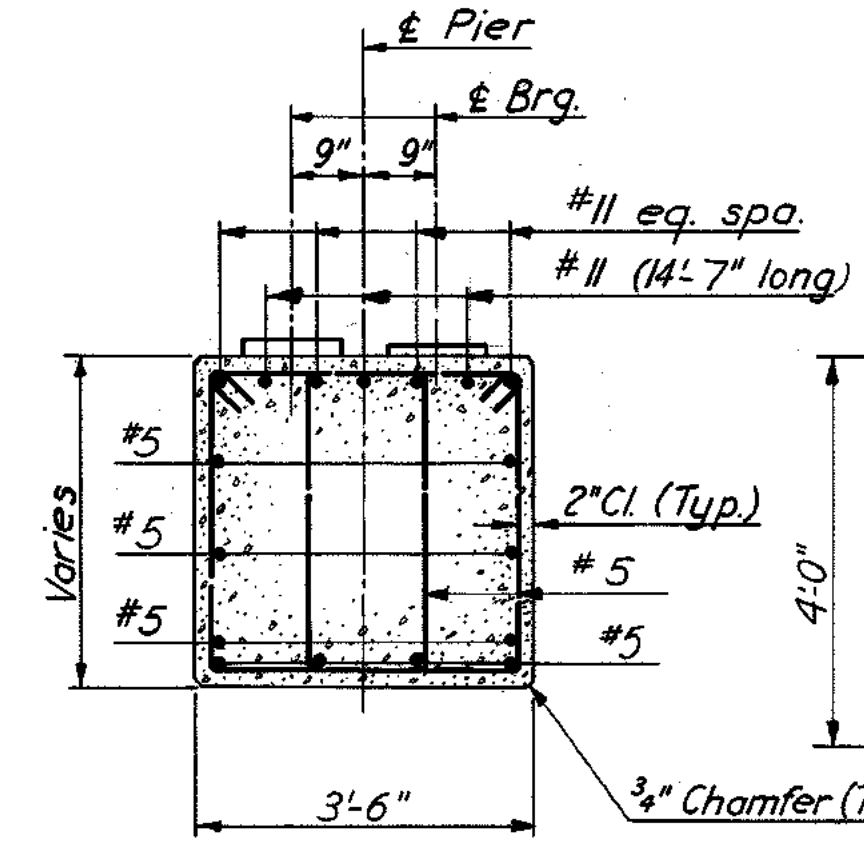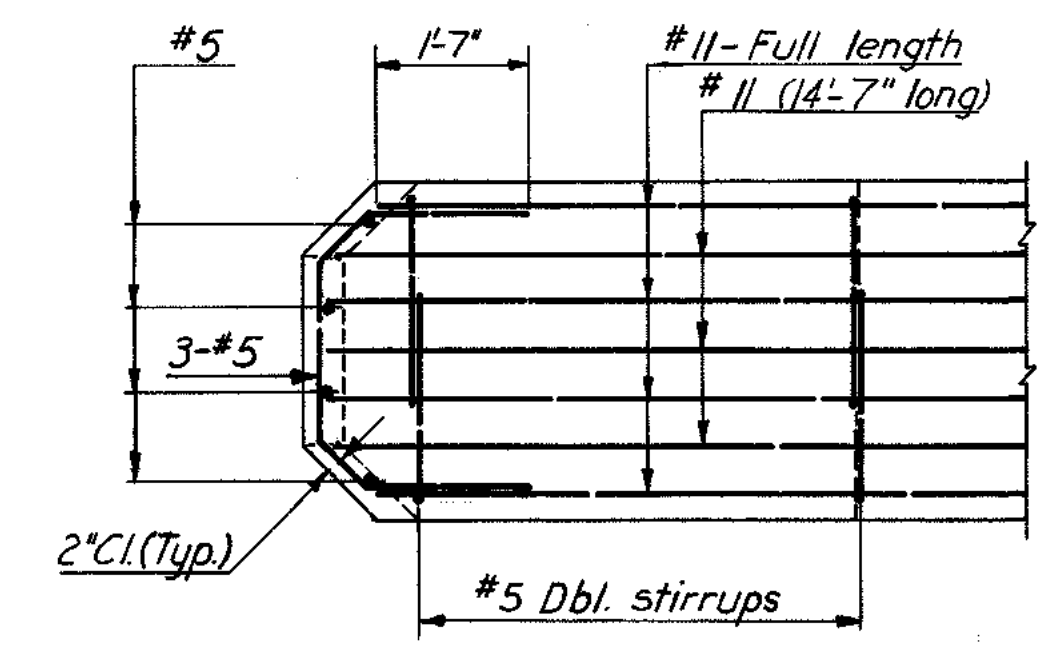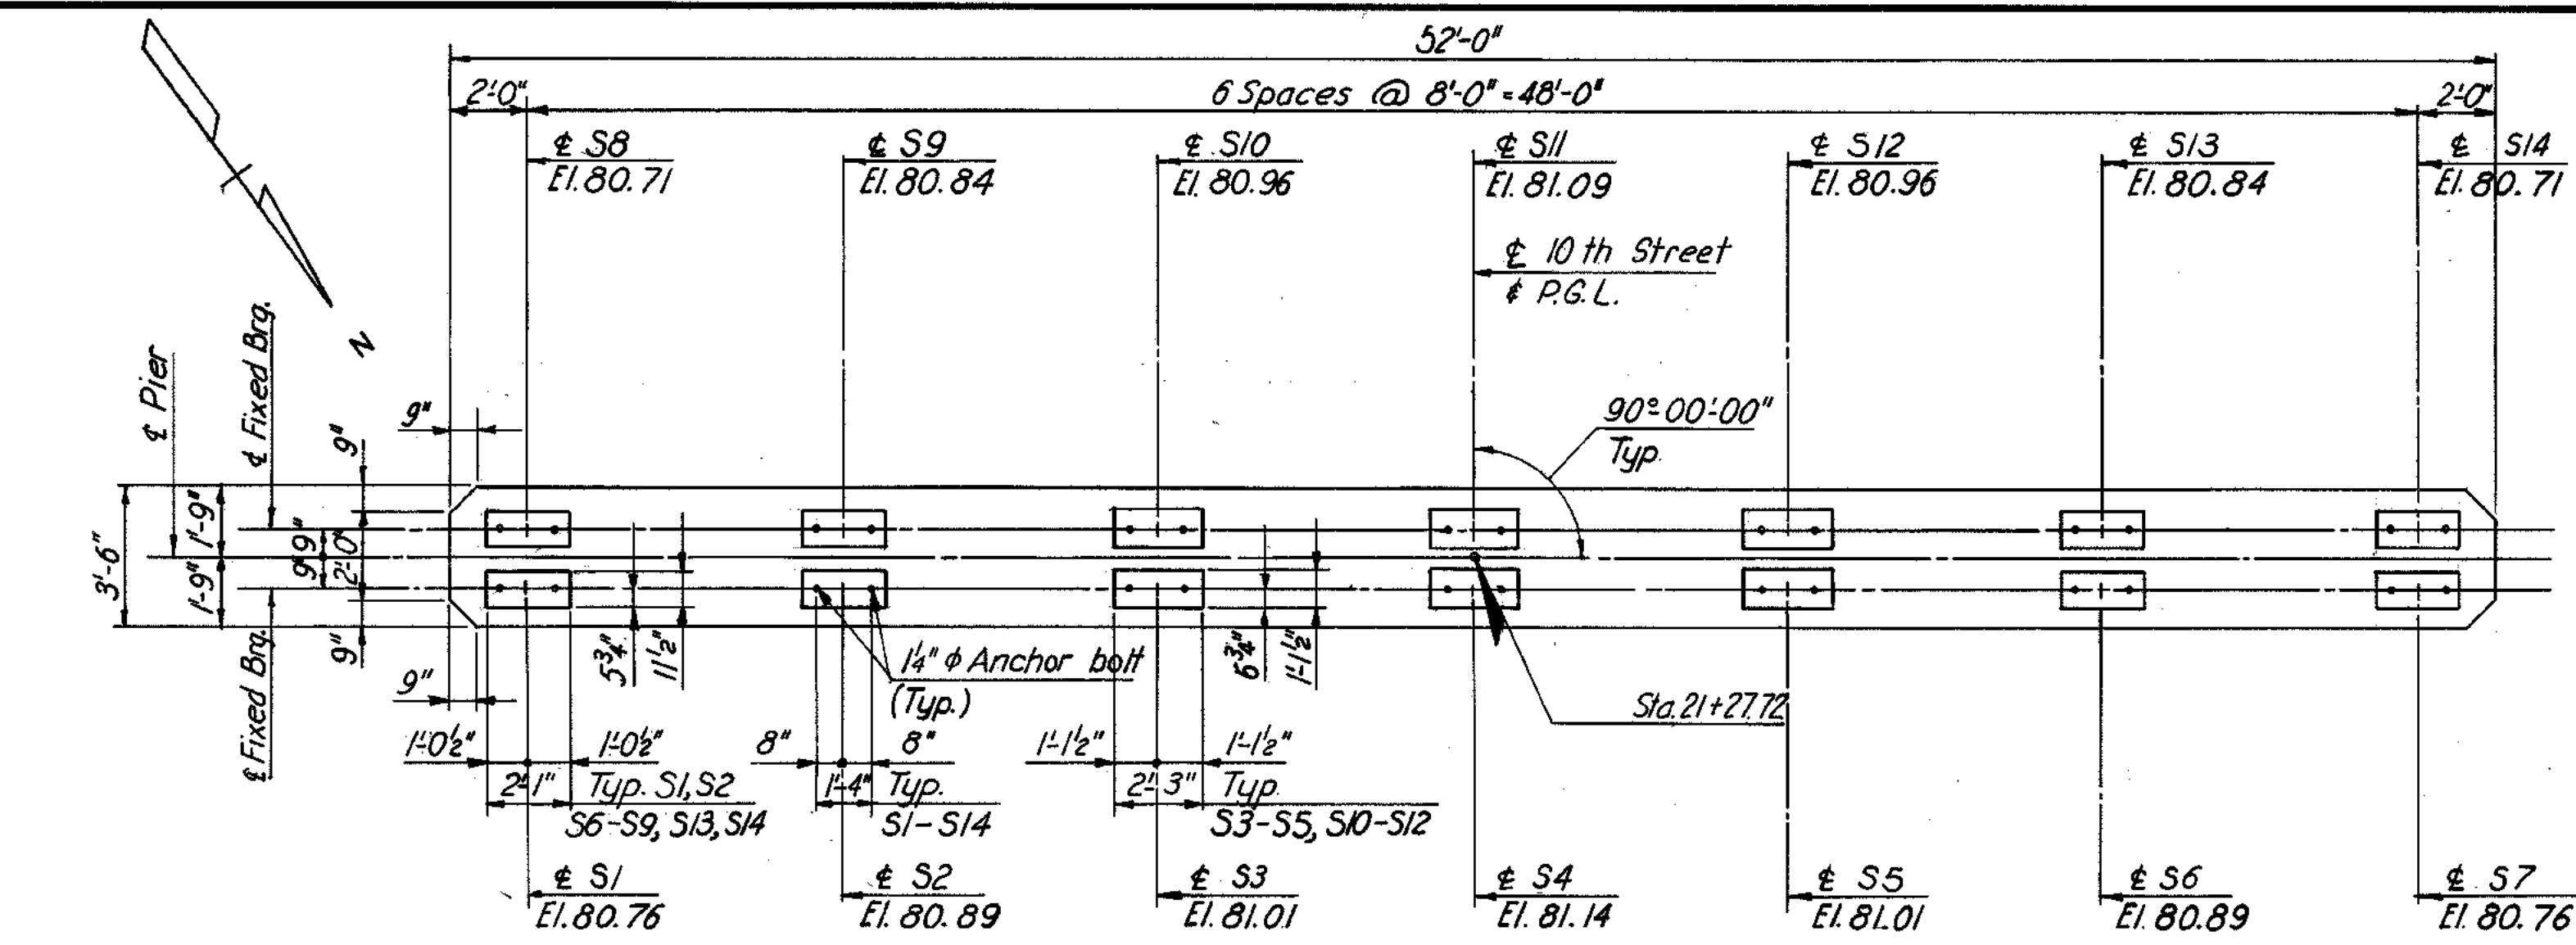

**NOTES:**

For anchor bolt details and treatment of pads, see Standard Shoe Details sheet.

For details of architectural treatment of piers, see Standard Architectural Details sheet.

**FOUNDATION NOTE:**

Foundation elevation is approximate and may be varied to suit field conditions as directed by the Engineer. Vertical column reinforcing shall not be cut until this elevation is established.

Where elevation changes by more than two feet, redesign will be required.

Pier foundation is designed for an allowable bearing pressure of 3 tons per square foot.

BY	DATE				
MADE	EVR 11-67				
CHECKED	TEM 2-68	1	As Built	TEM 7-77	
IN CHARGE	PRY.	NO.	REVISION	BY	DATE

**RICHMOND METROPOLITAN AUTHORITY**  
**RICHMOND EXPRESSWAY SYSTEM**  
 DOWNTOWN EXPRESSWAY


**BRIDGE B-60**  
**10TH STREET OVER**  
**DOWNTOWN EXPRESSWAY**  
**PIER**

HOWARD, NEEDLES, TAMMEN & BERGENDORFF  
 consulting engineers  
 NEW YORK ALEXANDRIA KANSAS CITY

SCALE: AS SHOWN  
 CONTRACT NO. 9  
 SHEET NO. 11 OF 17

AS BUILT



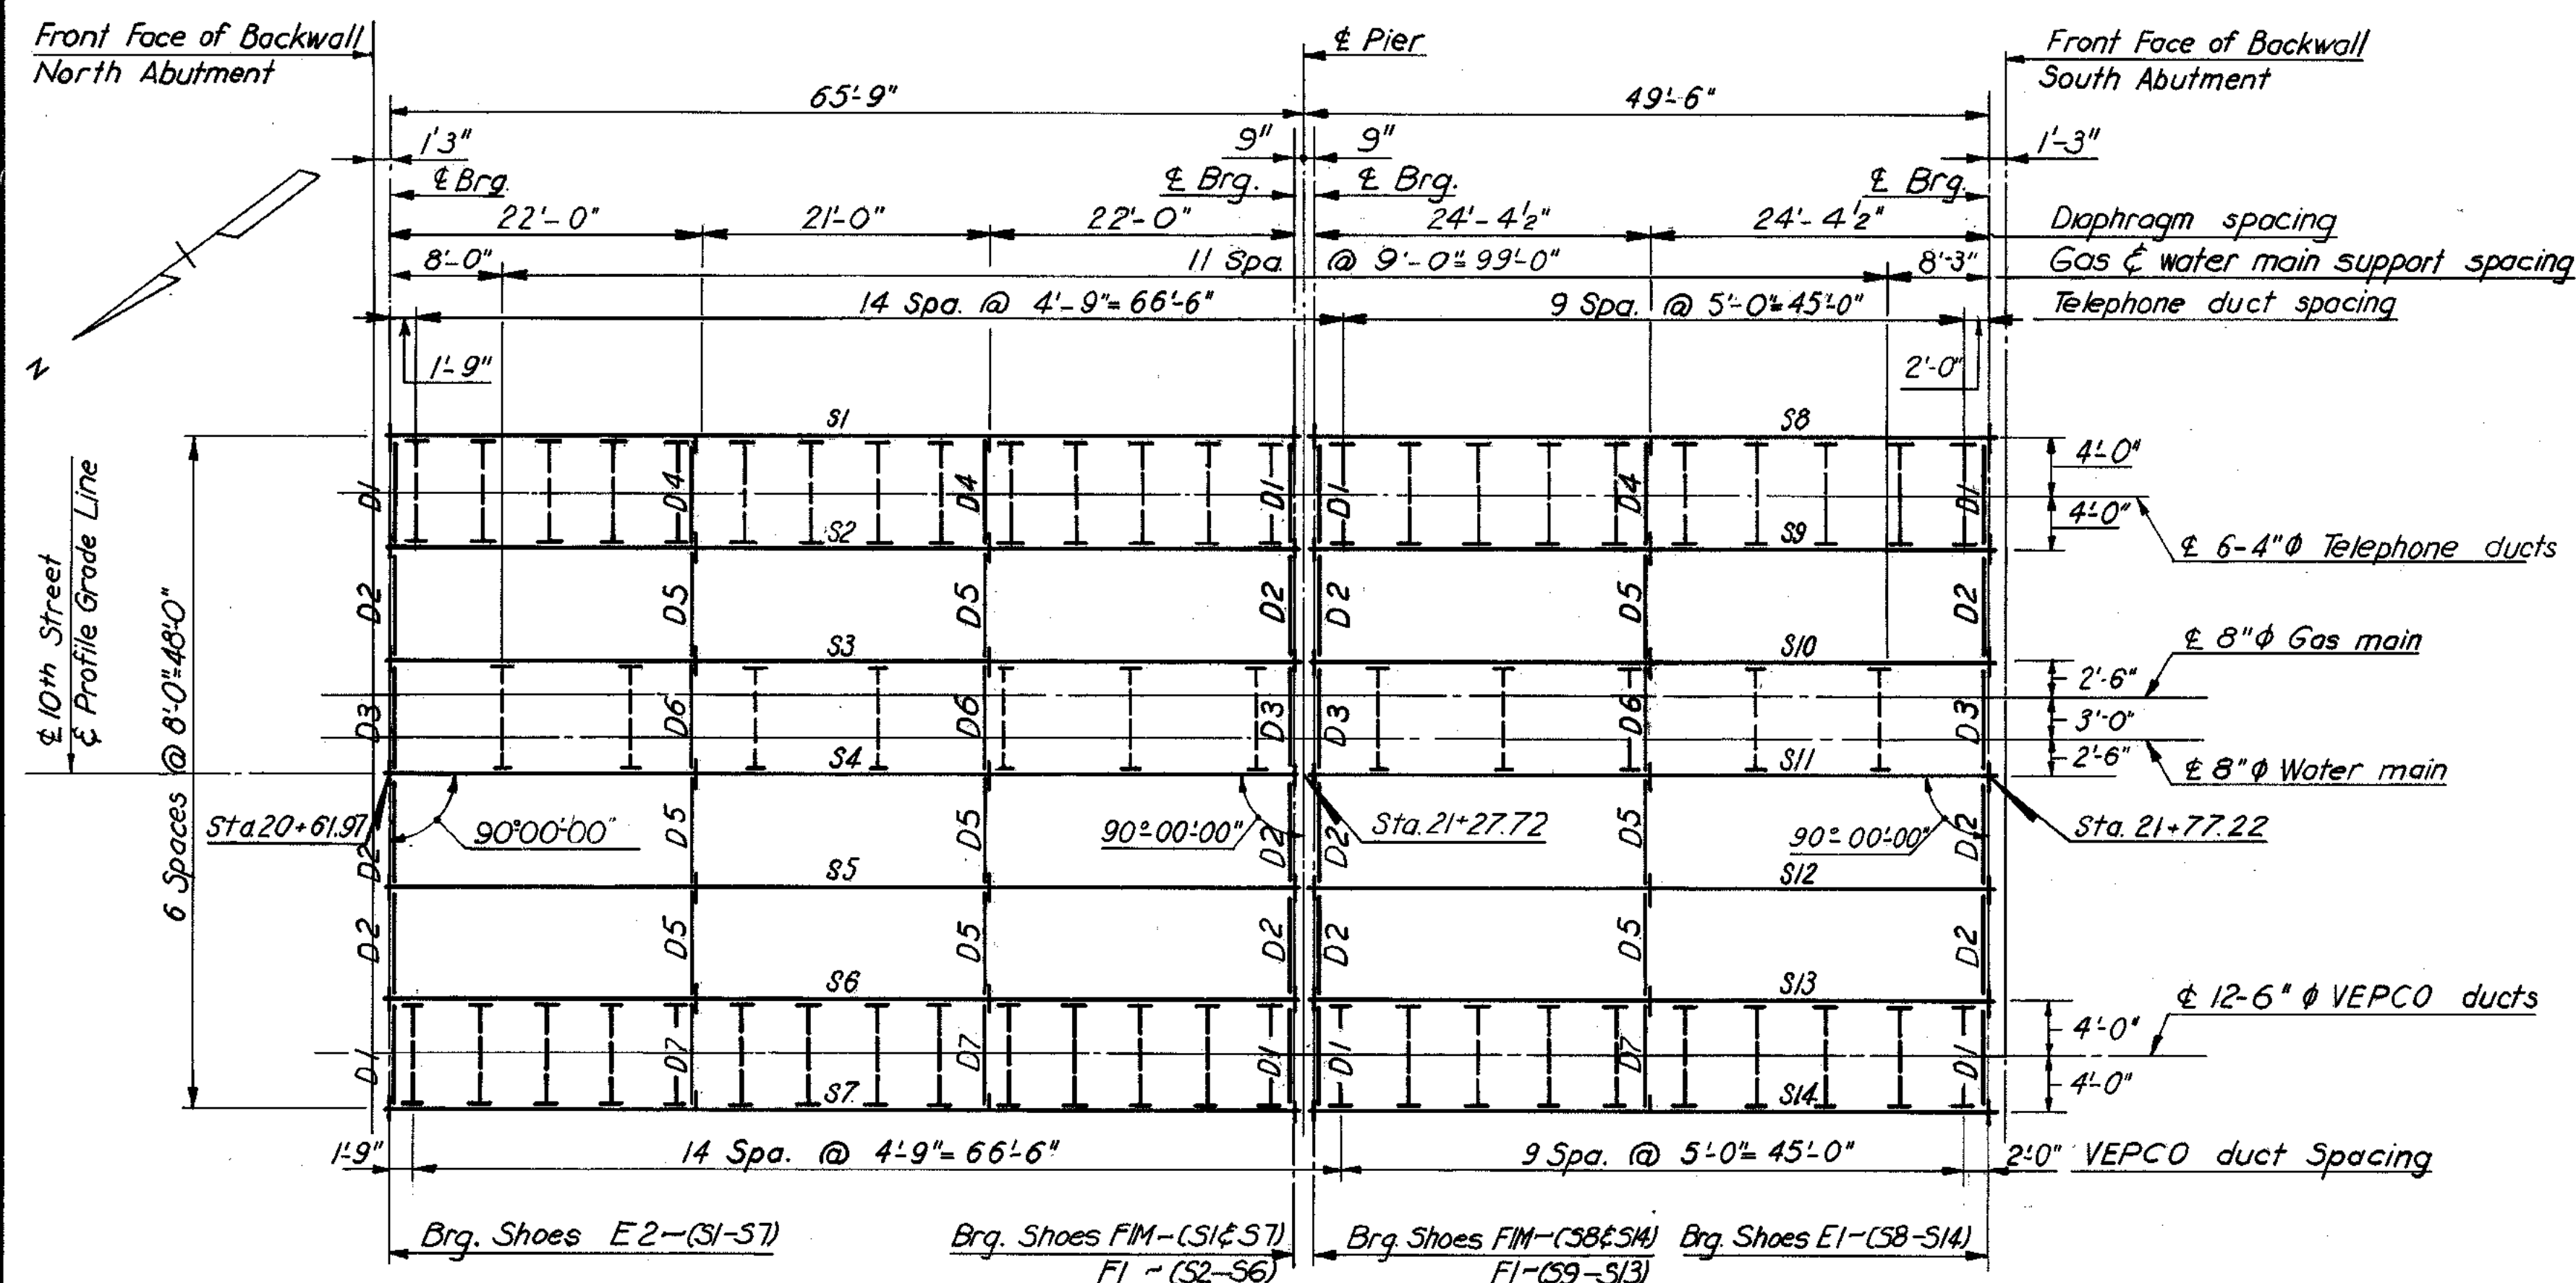


## UNIT I

## UNIT 2

## FRAMING PLAN

Scale: 1" = 10'

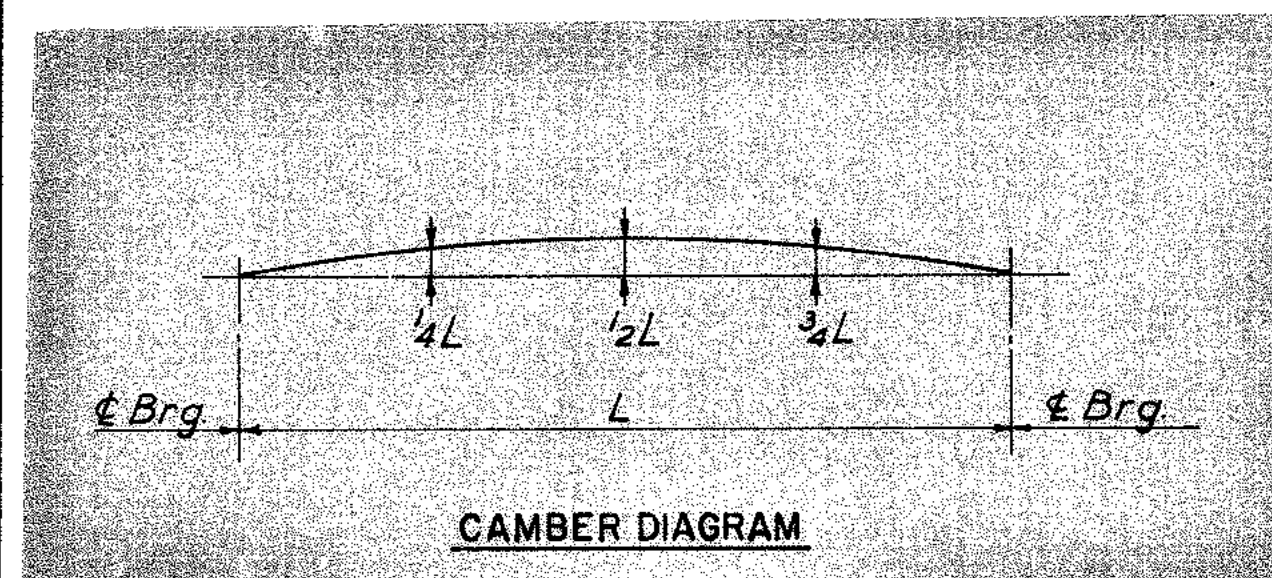

### CAMBER DIAGRAM


CAMBER SCHEDULE			
STR.	1/4 L	1/2 L	3/4 L
52			
54-56	3 3/8"	4 5/8"	3 3/8"
51, 53			
57	3 1/2"	4 5/8"	3 1/2"
5A-54	1 1/2"	1 1/2"	3 1/2"

**NOTE TO FABRICATOR**

The above stringers shall be fabricated with an upward camber amounting to the tabulated value.

This will provide approximate compensation for deflection under full dead load and for conformity with finished grade.

Dimensions are in inches.

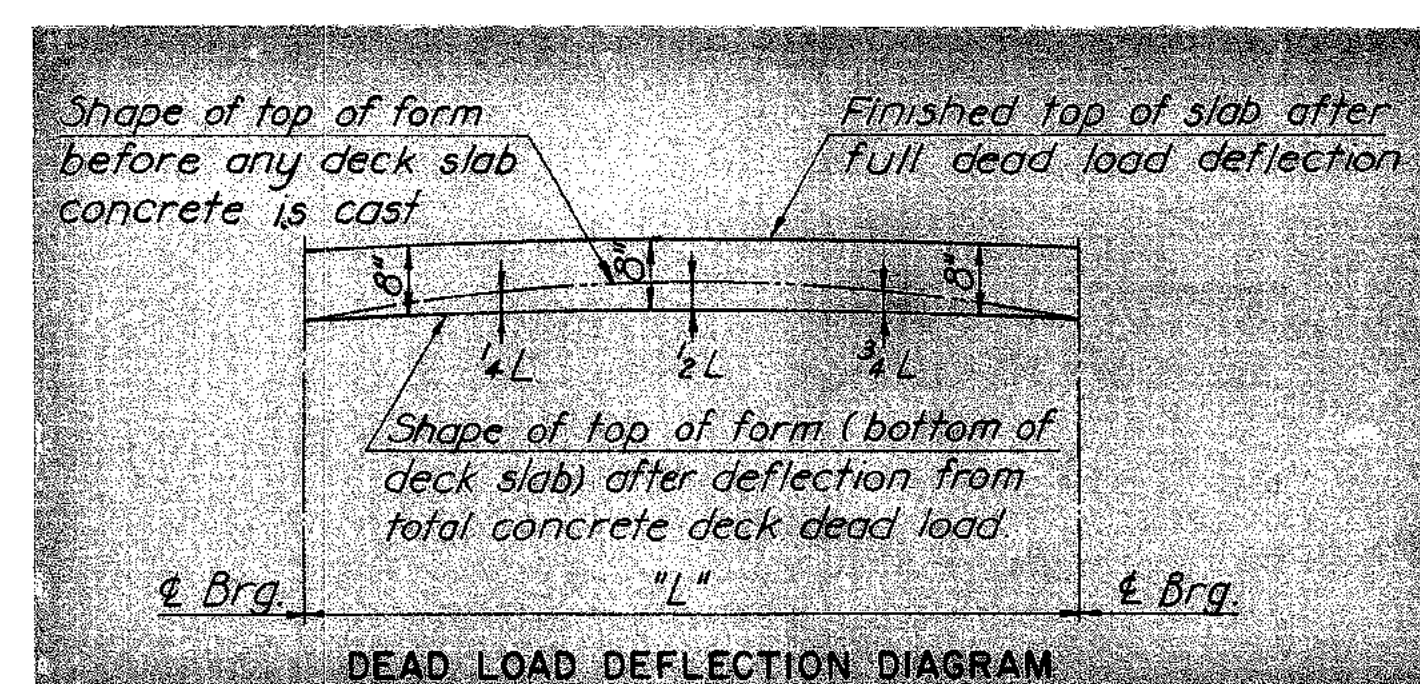


### DEAD LOAD DEFLECTION DIAGRAM

DEFLECTION SCHEDULE		
STR.	$1^4L$ 8 $3^4L$	$1^2L$
31, 53, 55-57	$3\frac{1}{2}''$	$1\frac{1}{8}''$
52, 54	$3\frac{1}{4}''$	$1''$
56, 514	$3\frac{3}{4}''$	$1\frac{1}{2}''$

**NOTE TO CONTRACTOR**


The above deflections are those anticipated to occur in the slabs upon placement of the total concrete deck dead load.

In practice, the stringers in place are not likely to have the exact camber to compensate for these deflections during construction. The residual amounts shall be provided for by adjusting forms to vary the thickness of the concrete slab between the bottom of the slab and the top of stringer, without alteration of the slab thickness.

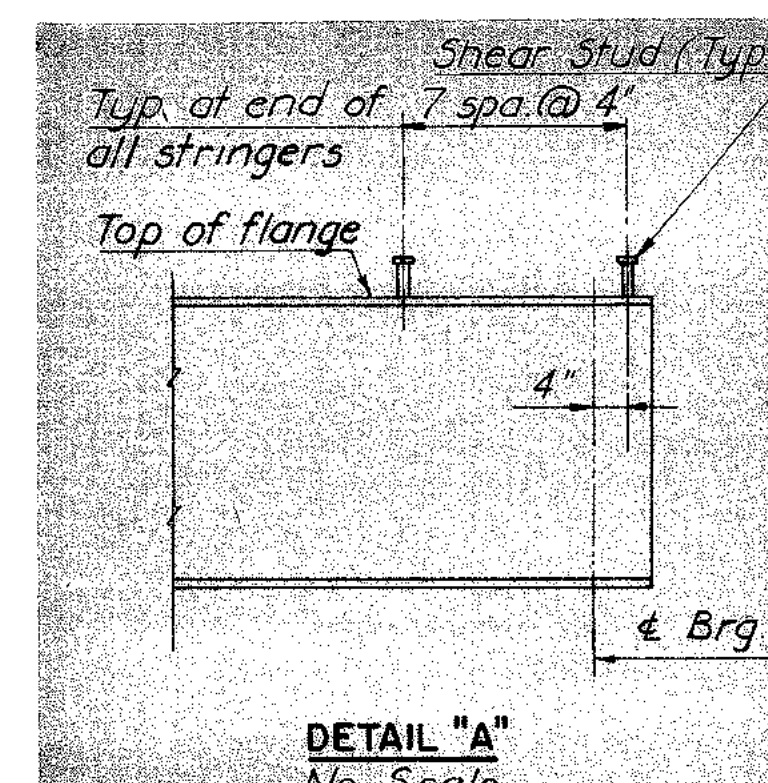

**DETAIL "A"**  
*No Scale*

No Scale

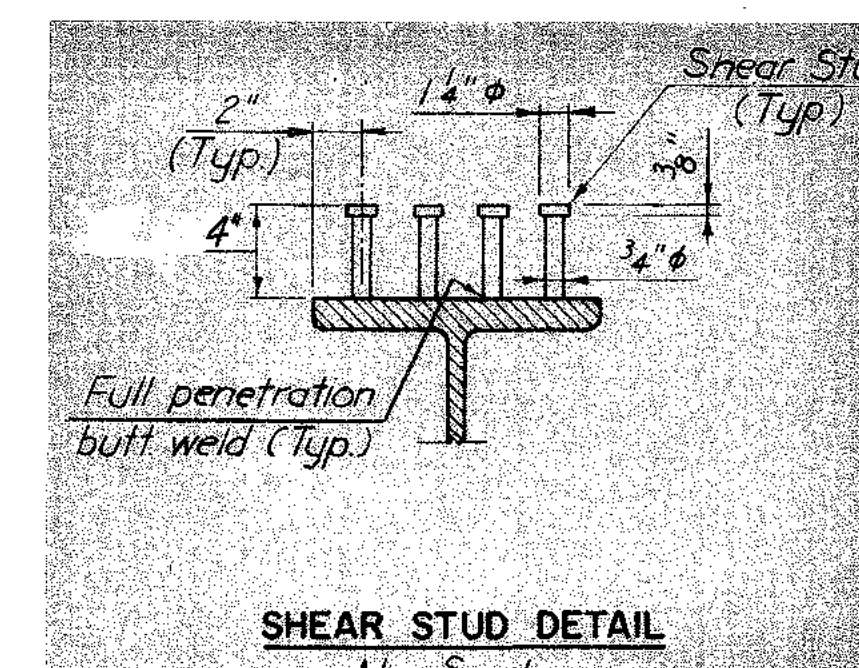


### SHEAR STUD DETAIL

No. Scale

**SHEAR STUD NOTE:**

Capacity = 3,400 lbs. per stud.  
The contractor may, if he elects, use  
three  $\frac{1}{2}$ " diameter studs at the same longitudinal  
spacing in lieu of the four  $\frac{1}{2}$ " diameter  
studs shown.  
Stud rows shall be placed parallel to the  
main deck reinforcing.  
Shear stud spacing shown is maximum  
spacing.

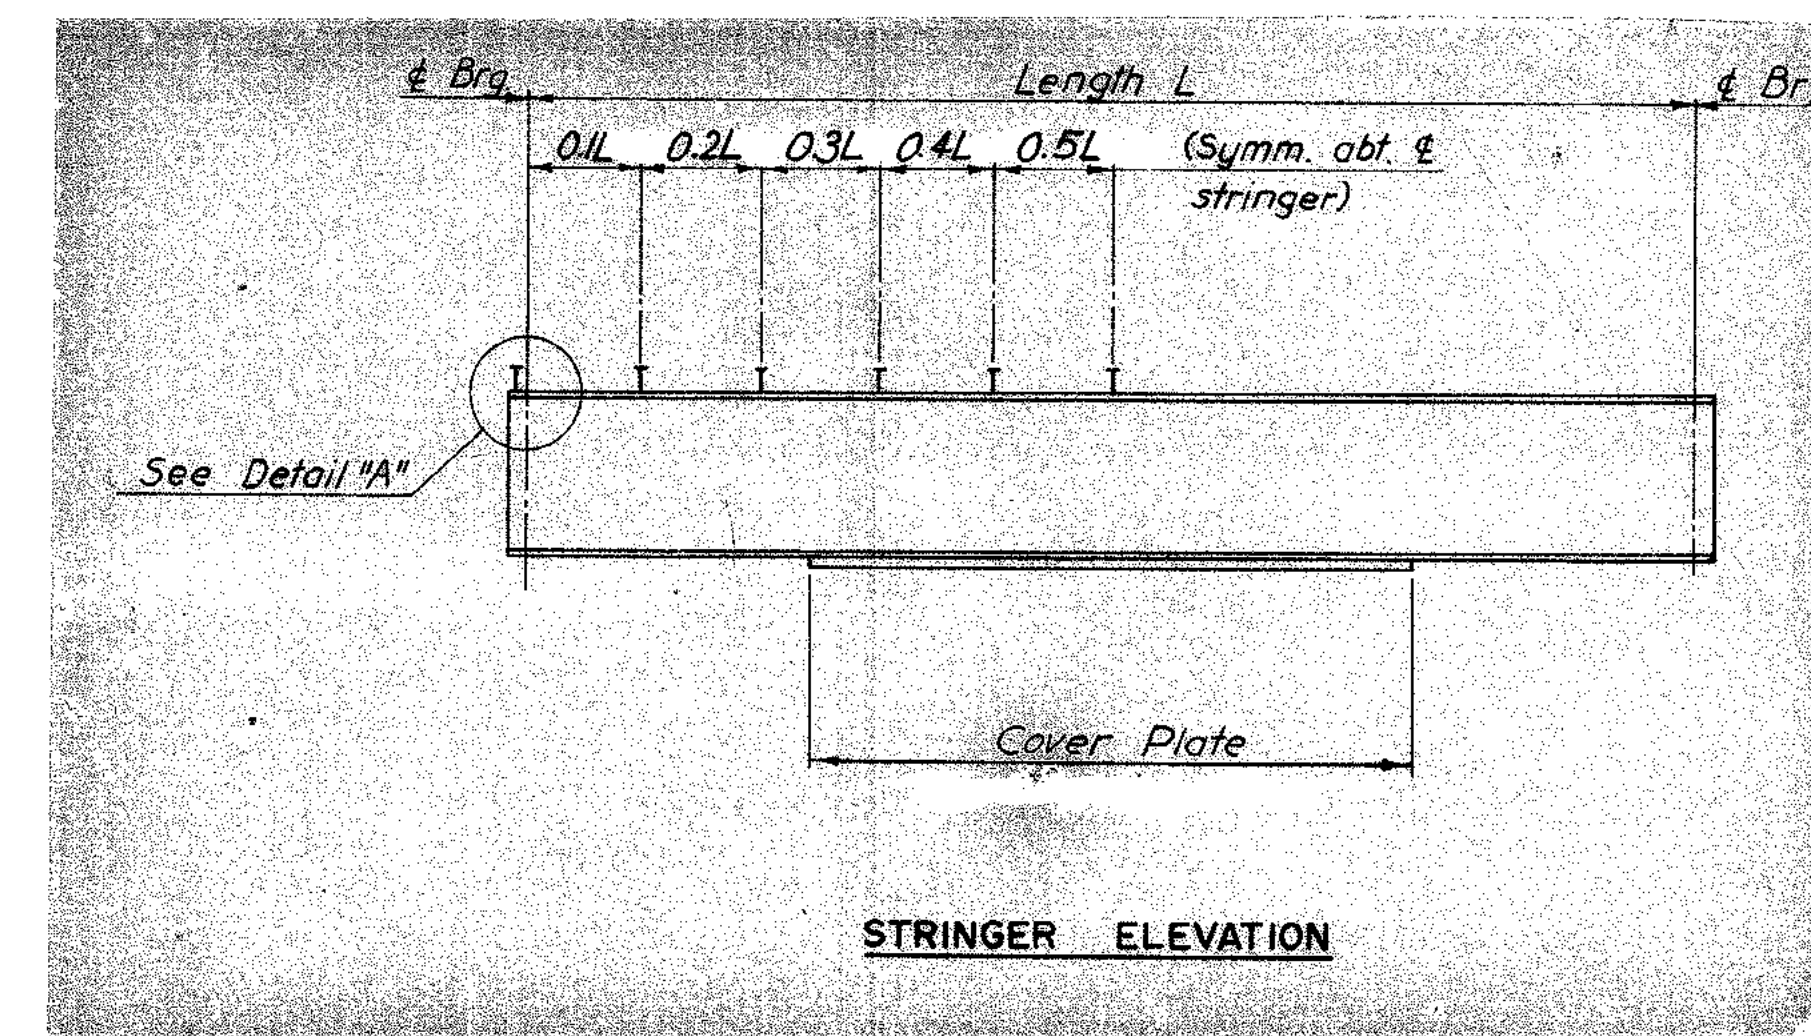

## STRINGER ELEVATION

STRINGER SCHEDULE							
STRINGER	LENGTH £ BRG. TO £ BRG.	COVER PLATE	SHEAR STUD SPACING				
			O.1L	O.2L	O.3L	O.4L	O.5L
S1 ~ 36 WF/50	65'-0"	10½ x ¼ x 54'-6"	6½"	8"	10½"	13"	15"
S2 ~	↑	10½ x ⅛ x 53'-6"	7"	↑	↑	12½"	14"
S3 ~	↑	10½ x ⅛ x 53'-6"	↑	↑	↑	↑	↑
S4 ~	↑	10½ x ⅛ x 53'-6"	↑	↑	↑	↑	↑
S5 ~	↑	10½ x ⅛ x 53'-6"	↓	↓	↓	↓	↓
S6 ~	↓	10½ x ¼ x 54'-6"	7"	↓	↓	12½"	14"
S7 ~	65'-0"	10½ x ¼ x 54'-6"	6½"	8"	10½"	13"	15"
S8 ~	48'-9"	No Cover Plates	7½"	9"	10½"	13½"	15"
S9 ~	↑	↑	↑	↑	↑	12½"	14"
S10 ~	↑	↑	↑	↑	↑	↑	↑
S11 ~	↑	↑	↑	↑	↑	↑	↑
S12 ~	↑	↑	↑	↑	↑	↑	↑
S13 ~	↓	↓	↓	↓	↓	12½"	14"
S14 ~ 36 WF/50	48'-9"	No Cover Plates	7½"	9"	10½"	13½"	15"

Note: Lengths shown are horizontal distances measured along centerlines of stringers.

SHOE SCHEDULE			
EXPANSION SHOES		FIXED SHOES	
TYPE	NO. REQD.	TYPE	NO. REQD.
E1	7	F1	10
E2	7	F1M	4

**RICHMOND METROPOLITAN AUTHORITY**  
**RICHMOND EXPRESSWAY SYSTEM**  
**DOWNTOWN EXPRESSWAY**

## RICHMOND EXPRESSWAY SYSTEM

DOWNTOWN EXPRESSWAY

BRIDGE B-60

10TH STREET OVER  
DOWNTOWN EXPRESSWAY

## FRAMING PLAN

HOWARD, NEEDLES, TAMMEN & BERGENDOFF  
consulting engineers  
NEW YORK      ALEXANDRIA      KANSAS CITY

NEW YORK      ALEXANDRIA      KANSAS CITY

SCALE: AS SHOWN


CONTRACT NO. \_\_\_\_\_

13

AS BUILT




RICHMOND EXPRESSWAY SYSTEM			
SECTION	PROJECT	SHEET NO.	TOTAL SHEETS
9	DOWNTOWN EXPRESSWAY	216	

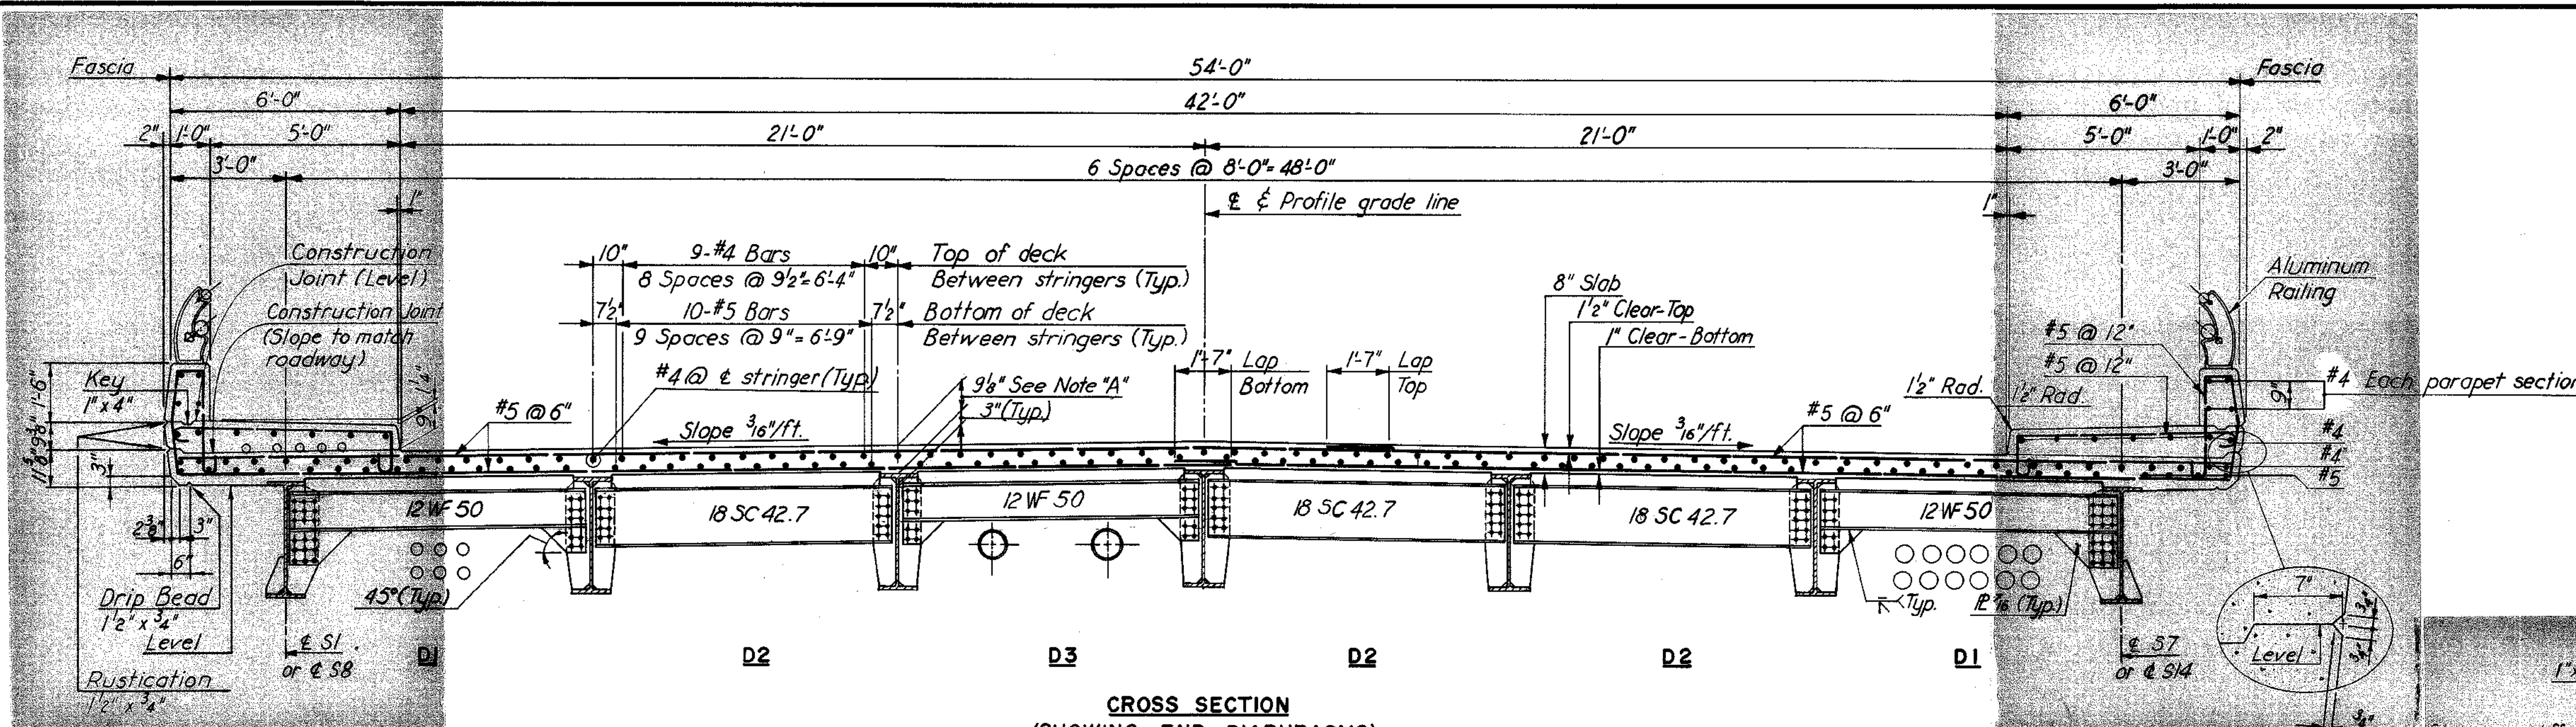


**NOTE "A"**  
Dimension shown is measured from top of stringer to top of slab at the intersection of the centerline of stringer and the centerline of bearing. At exterior stringers this is measured to the cross slope extended. This dimension may be varied between bearings as required to care for variation in camber, except that no portion of the stringer flange may fall within the 8" slab.






**CROSS SECTION  
(SHOWING END DIAPHRAGMS)**  
Scale: 3/8"=1'-0"

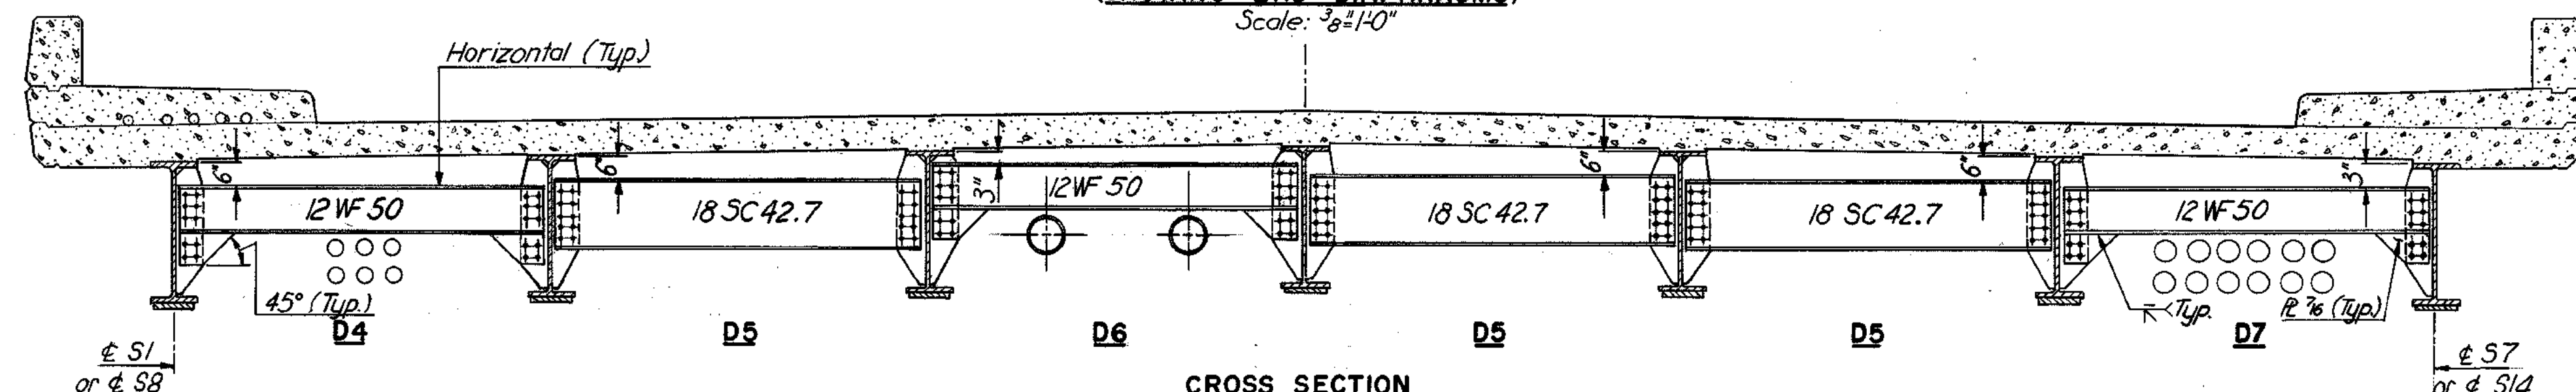


**CROSS SECTION  
(SHOWING INTERMEDIATE DIAPHRAGMS)**  
Scale: 3/8"=1'-0"

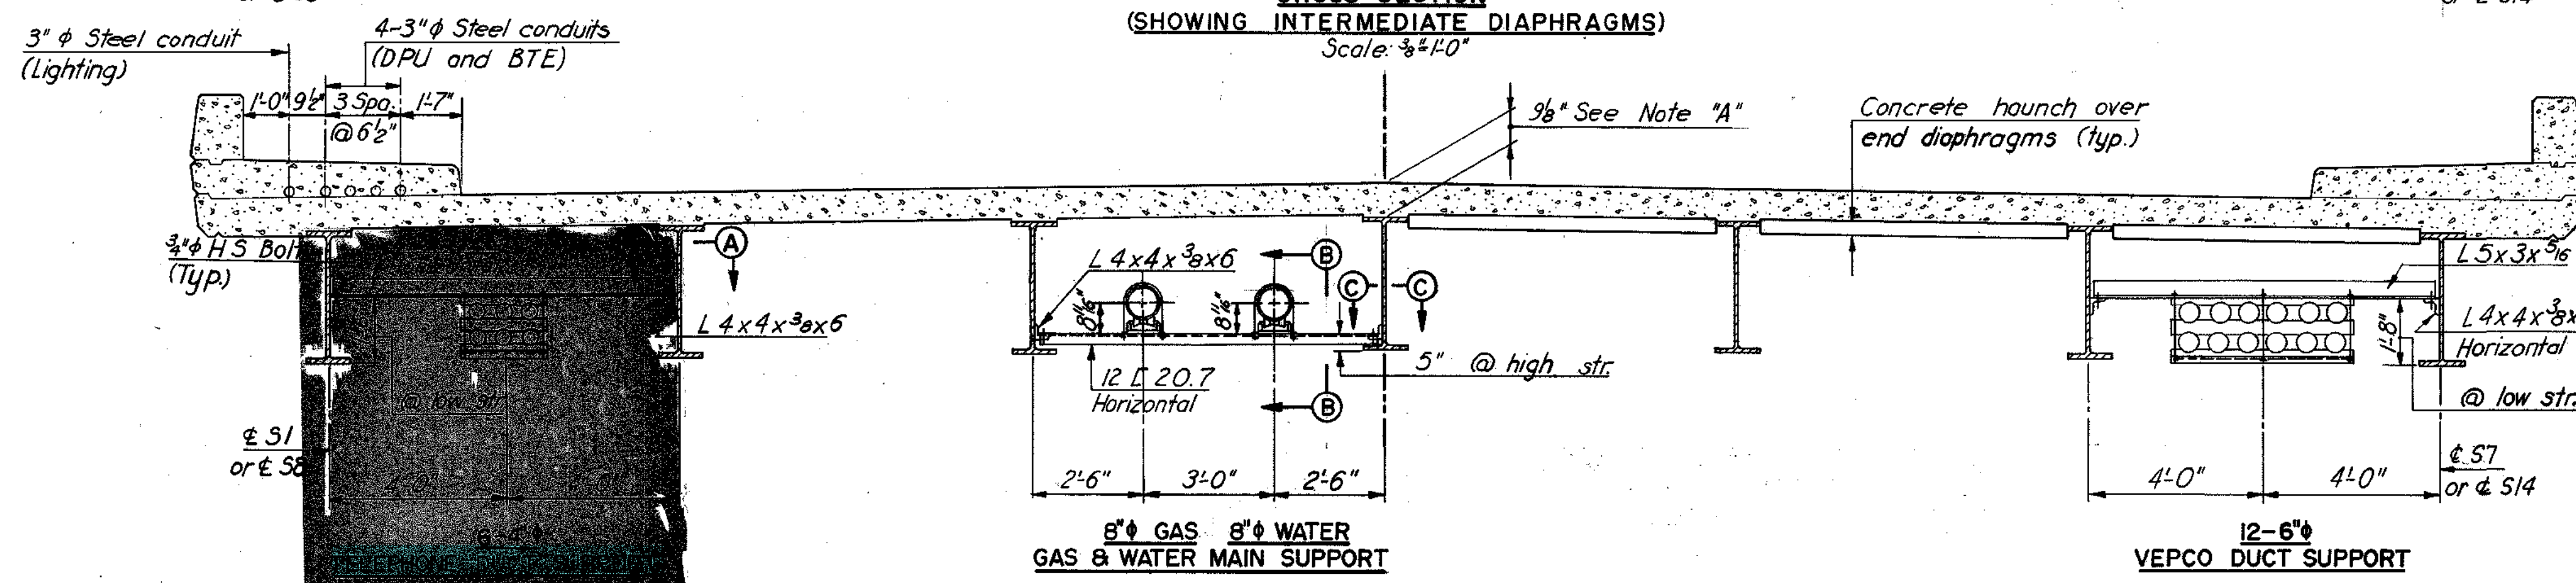

**CROSS SECTION  
(SHOWING UTILITY SUPPORTS ONLY)**  
Scale: 3/8"=1'-0"

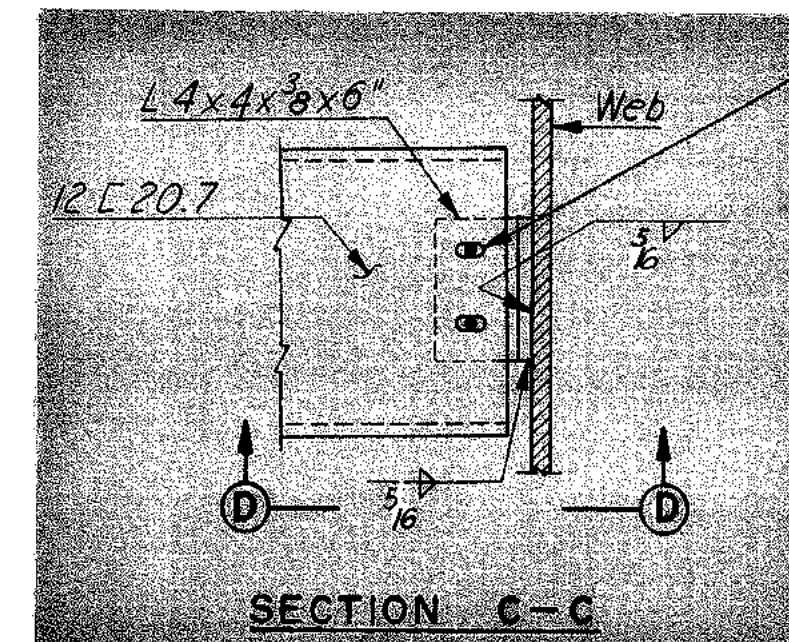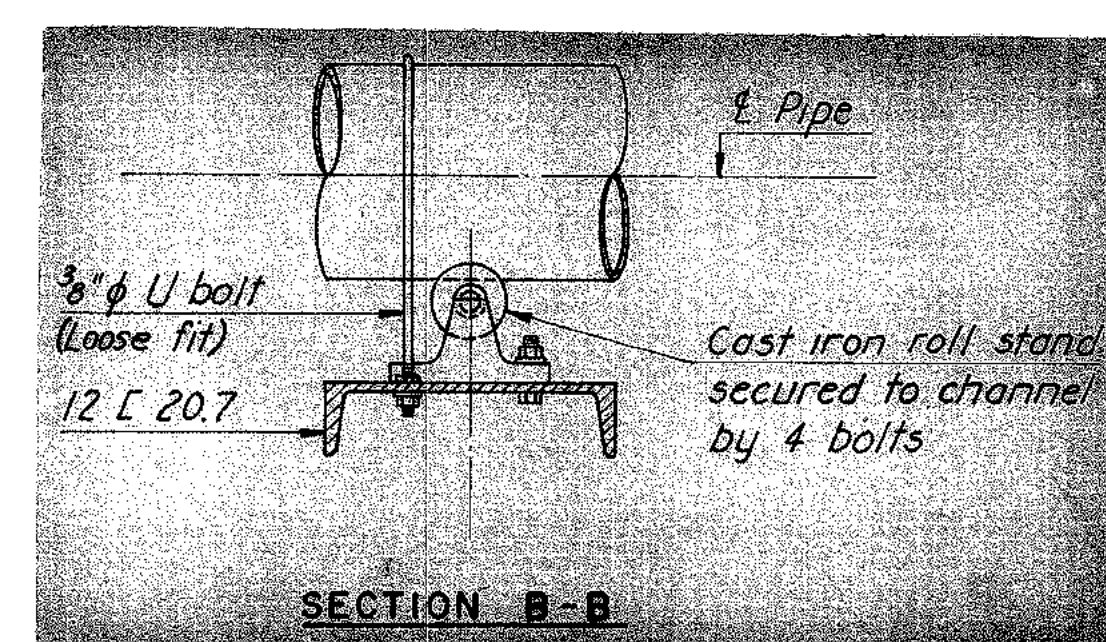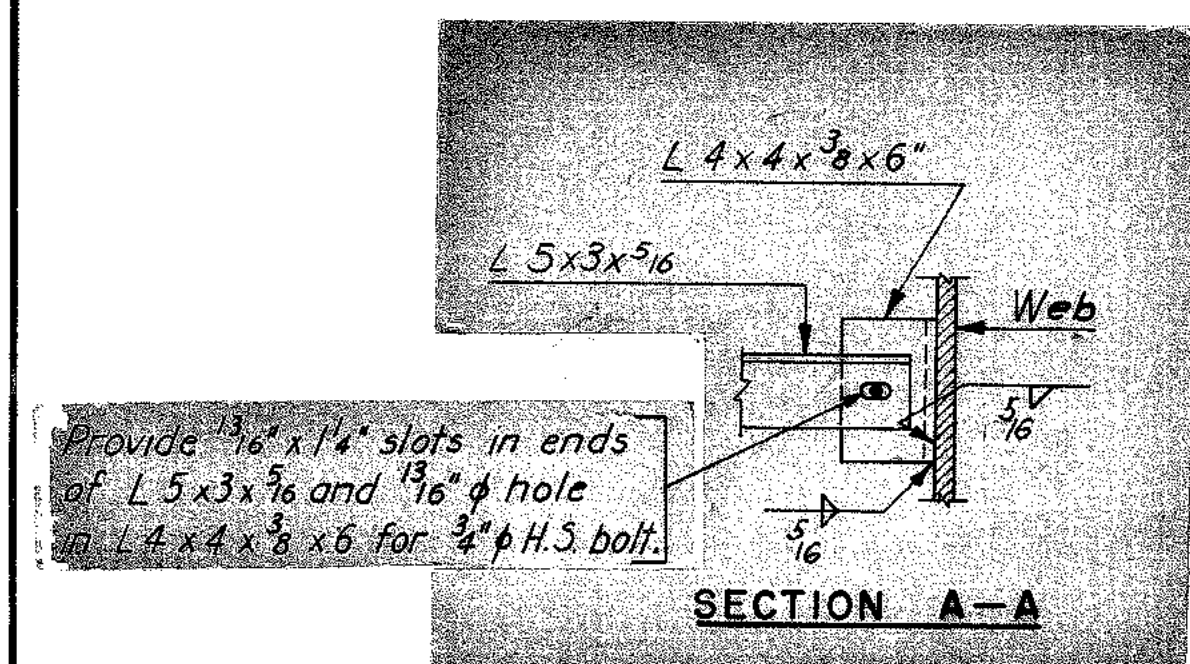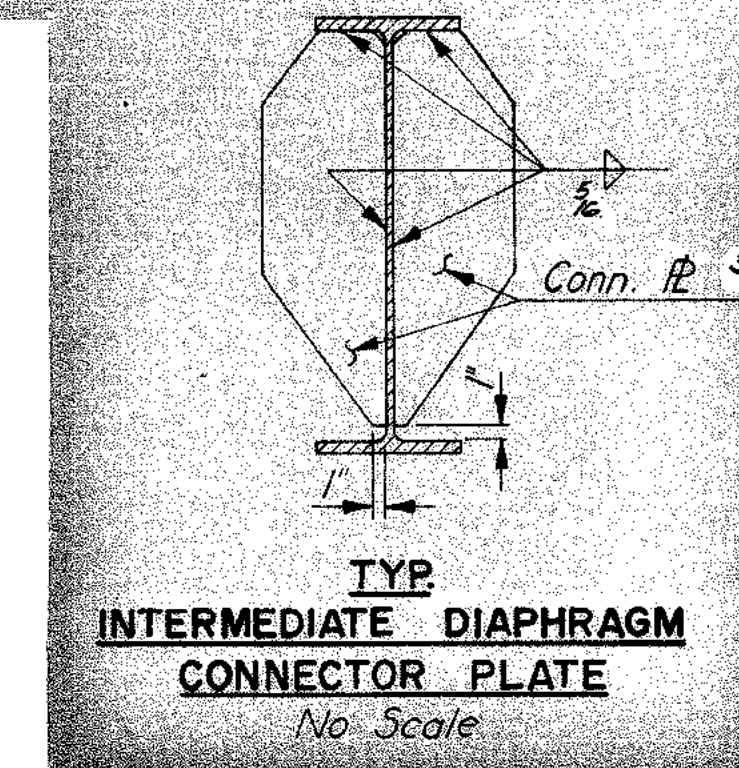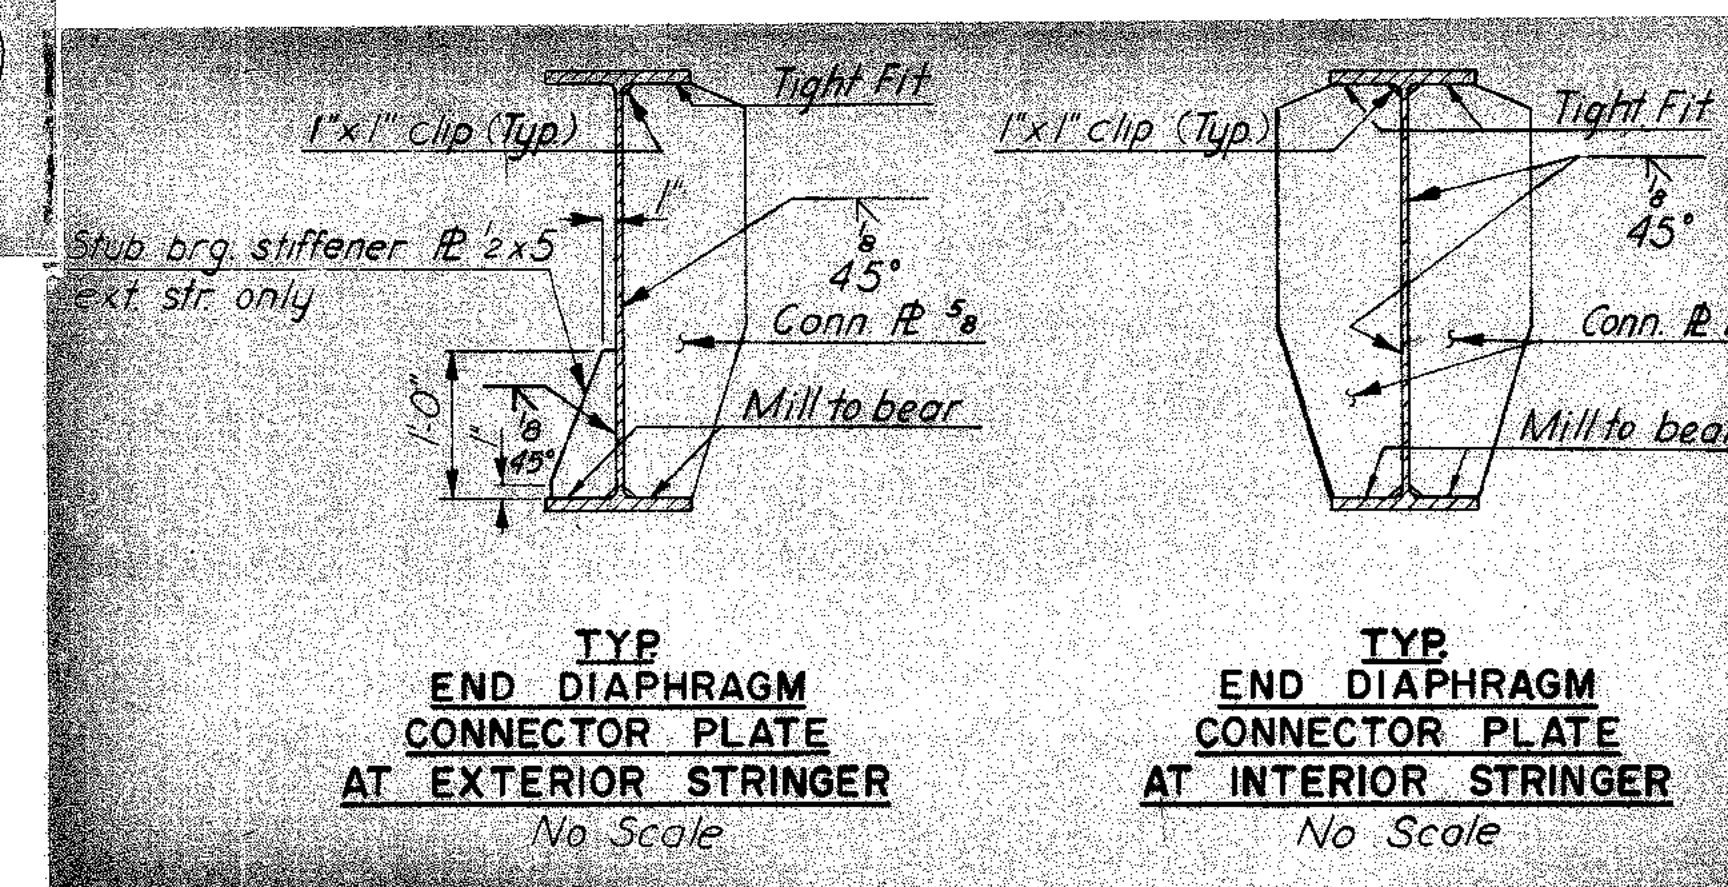

Provide 1/2" x 1/4" slots in ends of 12 L 20.7 and 1/2" hole in L 4 x 4 x 3/8 x 6 for 3/4" H.S. bolt.

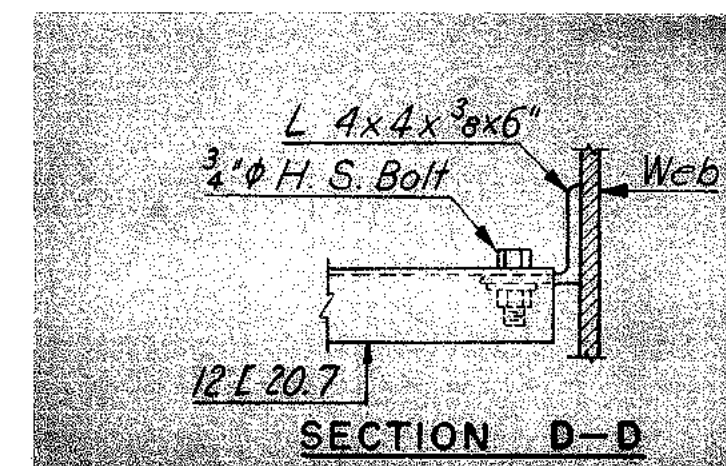




**NOTES:**  
For spacing and location of utility supports and diaphragms, see Framing Plan sheet.  
For Basic Attachment Details for cement asbestos conduit, see Standard Conduit Installation Details sheet.  
For details showing gas and water mains thru abutments, see Standard Utility Support Details At Bridge Abutments sheet.

BY	DATE				
MADE	EVR	10-9			
CHECKED	TEM	2-68	1	As Built	TEM 7-77
IN CHARGE	PRY		NO.	REVISION	BY DATE

RICHMOND METROPOLITAN AUTHORITY	
RICHMOND EXPRESSWAY SYSTEM	
DOWNTOWN EXPRESSWAY	
BRIDGE B-60	
10TH STREET OVER	
DOWNTOWN EXPRESSWAY	
CROSS SECTION AND UTILITY DETAILS	
HOWARD, NEEDLES, TAMMEN & BERGENDOFF consulting engineers NEW YORK ALEXANDRIA KANSAS CITY	SCALE: AS SHOWN CONTRACT NO. 9 SHEET NO. 13 OF 17

AS BUILT



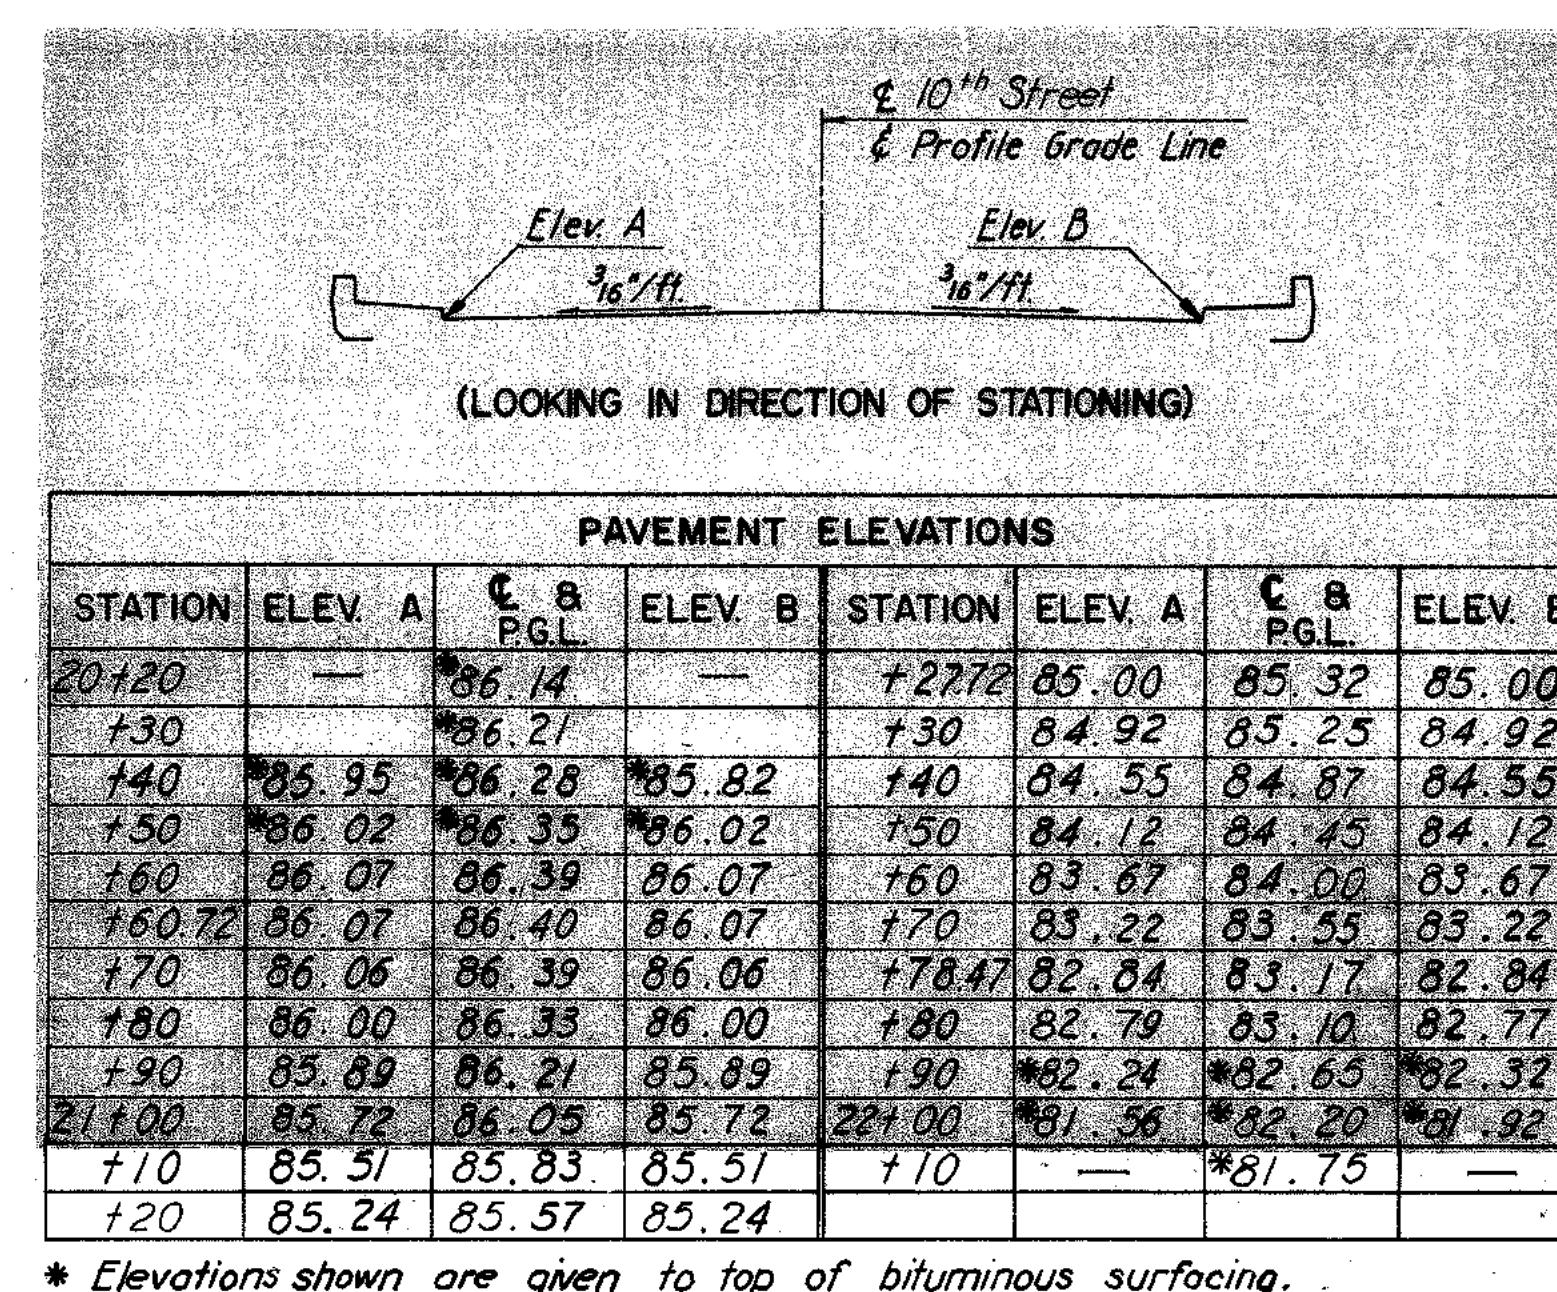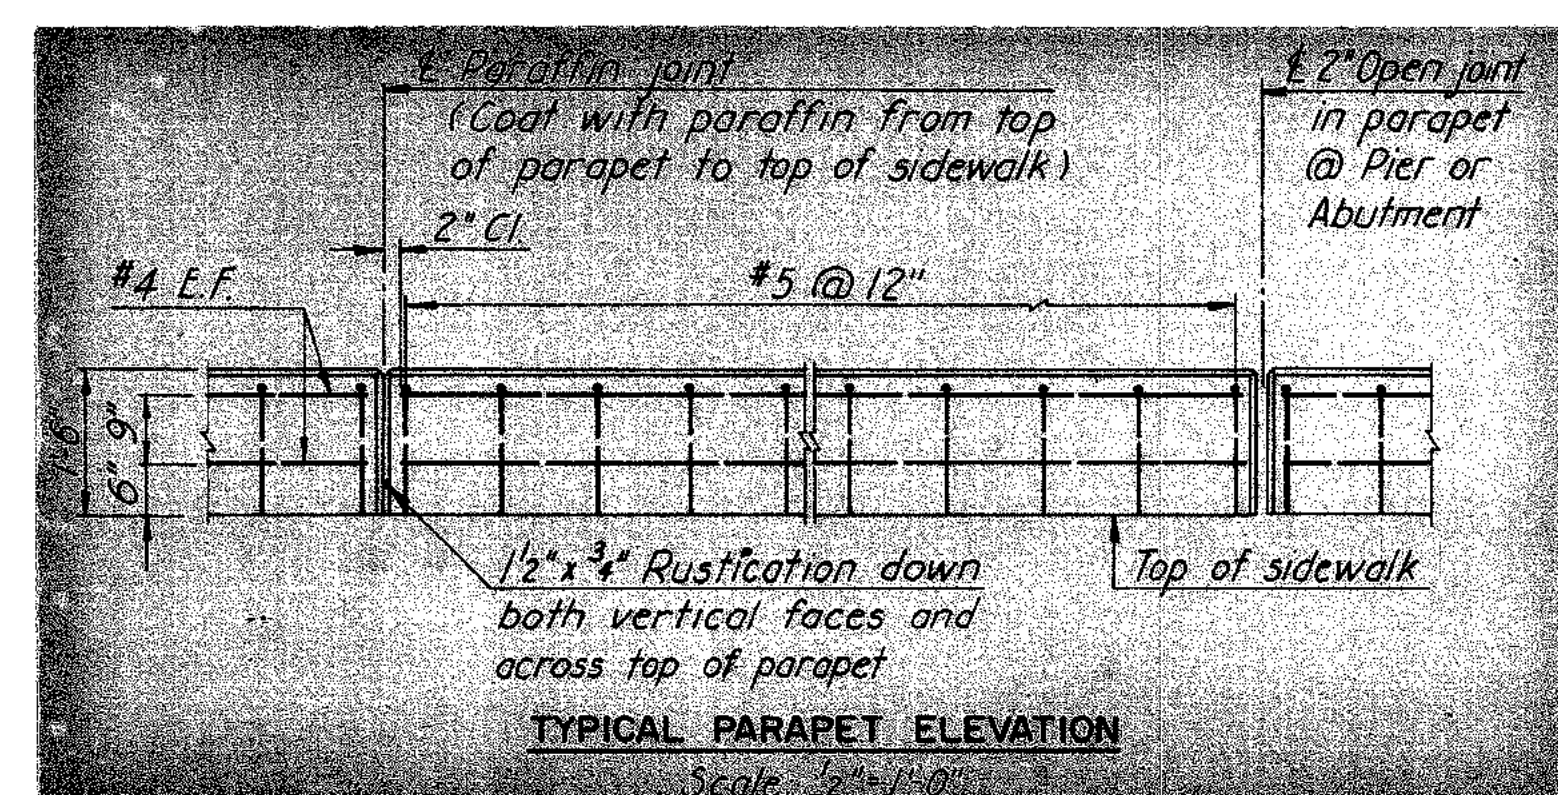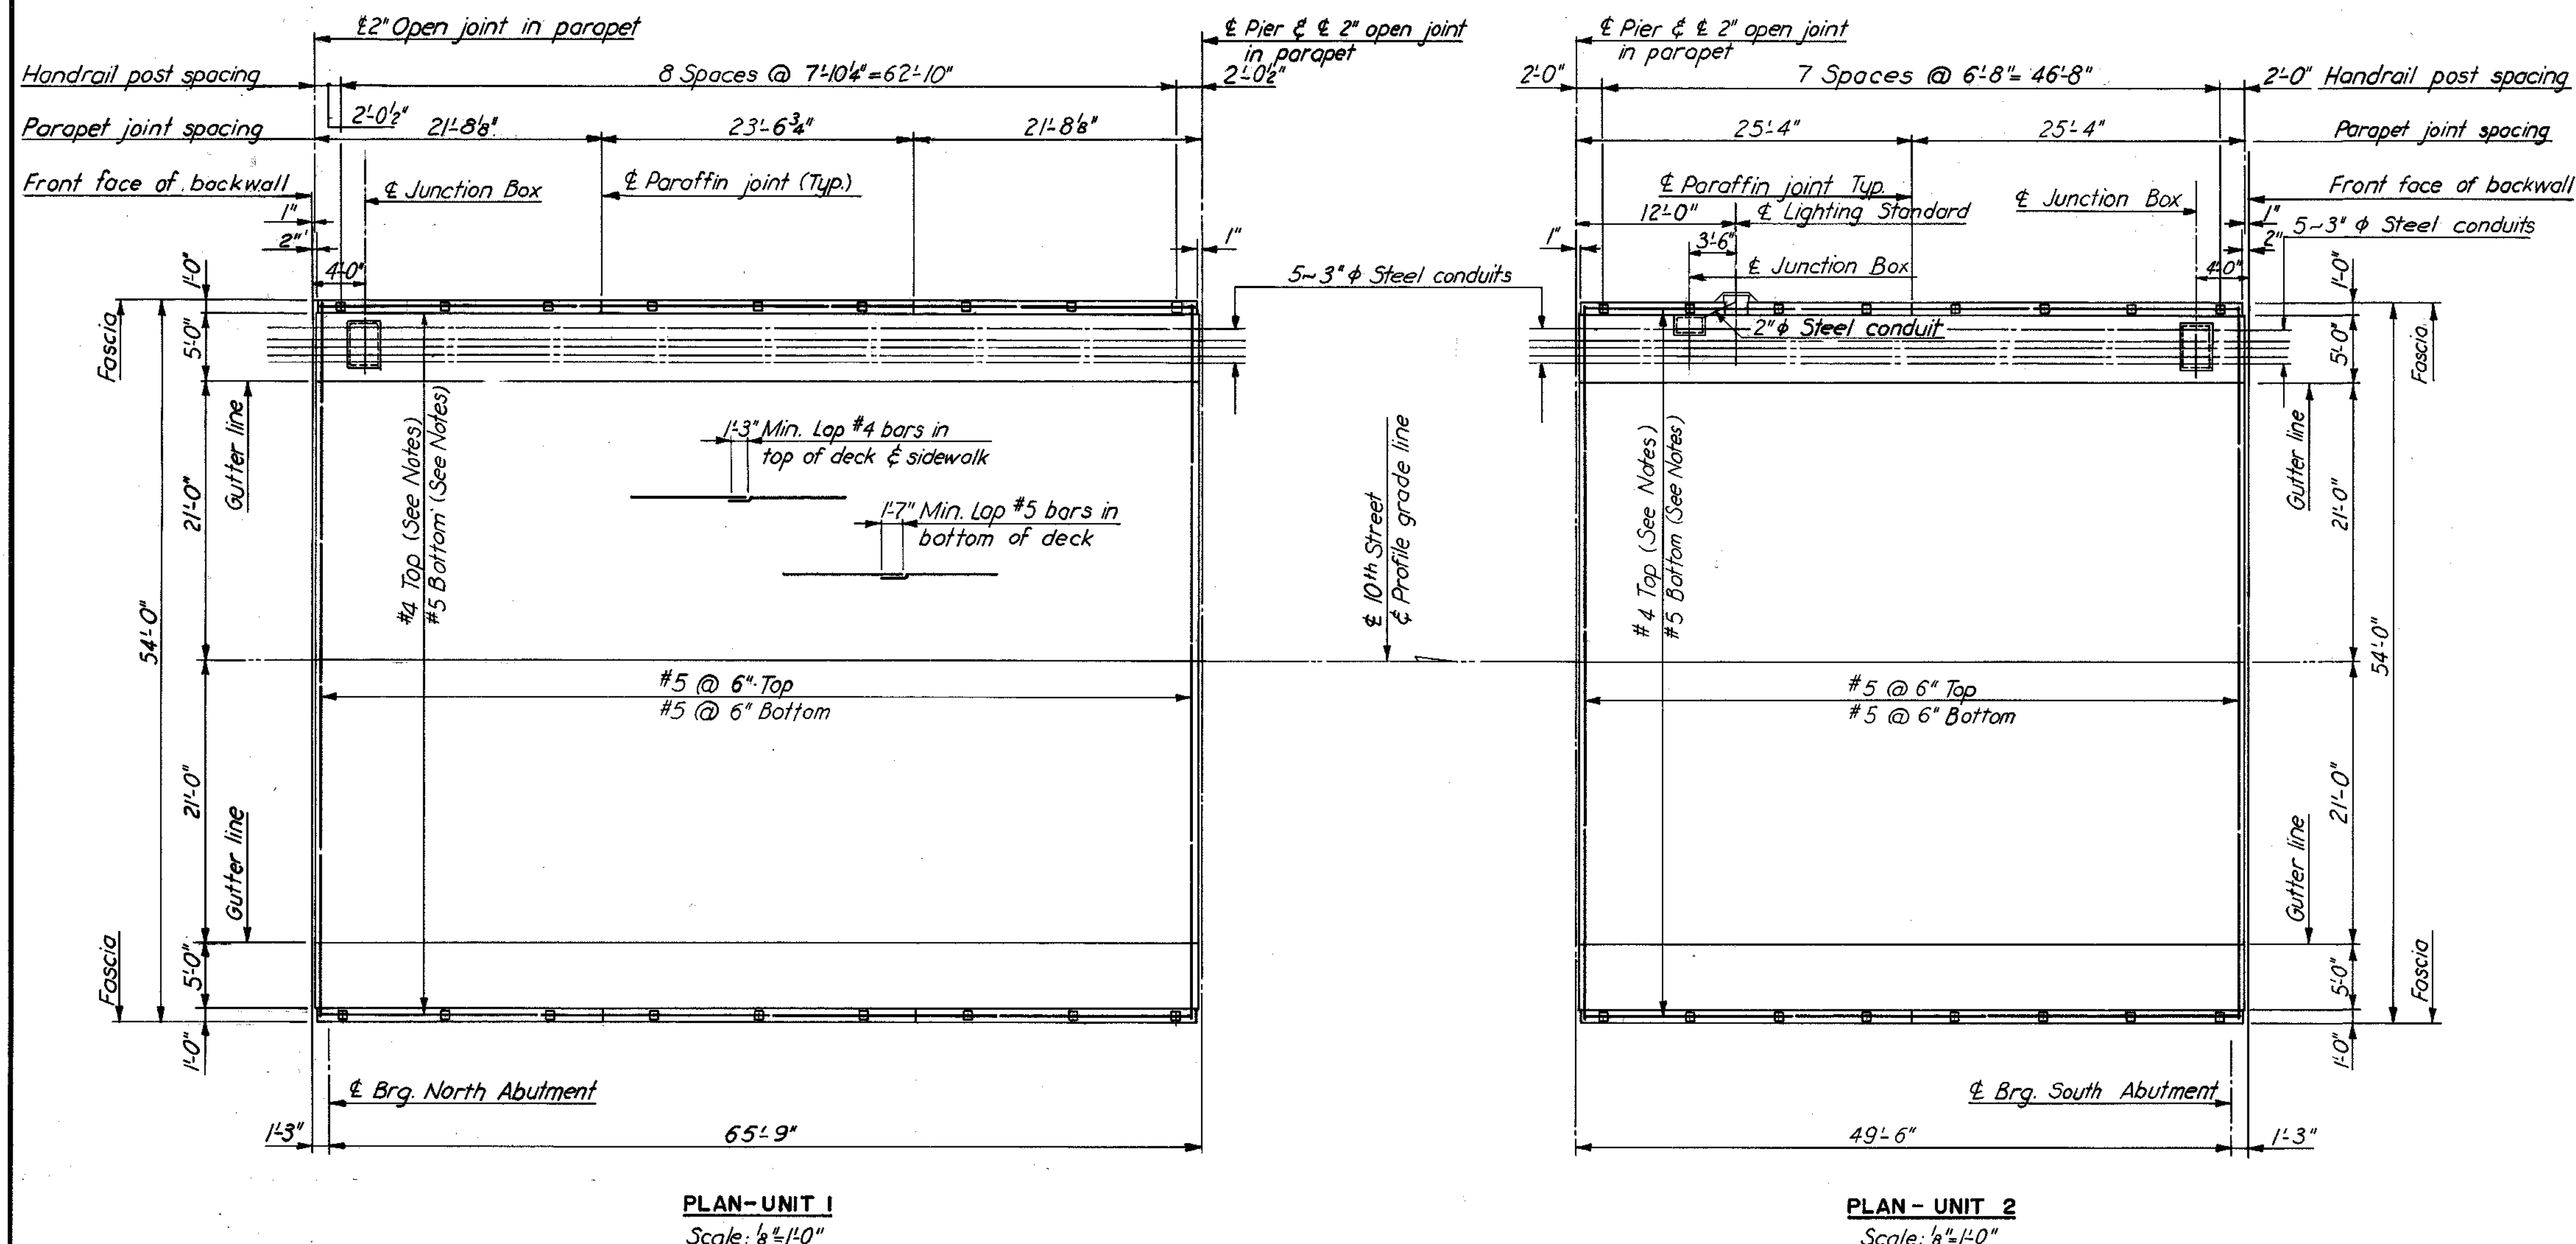

**NOTES:**

- For location and spacing of deck, parapet and sidewalk reinforcing, see Cross Section and Utility Details sheet.
- For location and spacing of reinforcing in haunch over end diaphragms, see Joint Details sheet.
- For lighting standard base, junction box details and additional reinforcing, see Standard Electrical Details sheet S4.

BY	DATE				
MADE	EVR	10-67			
CHECKED	TEM	2-68	1	As Built	TEM 7-77
IN CHARGE	PRY.		NO.	REVISION	BY DATE

AS BUILT

**RICHMOND METROPOLITAN AUTHORITY**  
**RICHMOND EXPRESSWAY SYSTEM**  
 DOWNTOWN EXPRESSWAY

**BRIDGE B-60**  
**10TH STREET OVER**  
**DOWNTOWN EXPRESSWAY**

**DECK PLANS**

SCALE: AS SHOWN

HOWARD, NEEDLES, TAMMEN & BERGENDOFF  
 consulting engineers  
 NEW YORK ALEXANDRIA KANSAS CITY

CONTRACT NO. 9  
 SHEET NO. 14 OF 17