

SP-Y
APPENDIX

RMTA
System Map

RICHMOND EXPRESSWAY SYSTEM

Scale: 0 1000 2000 3000ft.

48 - Bridge Number
RMTA Facilities Shown in Red




RICHMOND

CITY OWNED GRAVEL LOT

APPROXIMATELY 10,500 S.F. RMTA OWNED STAGING AREA

RMTA OWNED ABANDONED RAMP





RMTA OWNED STAGING AREA

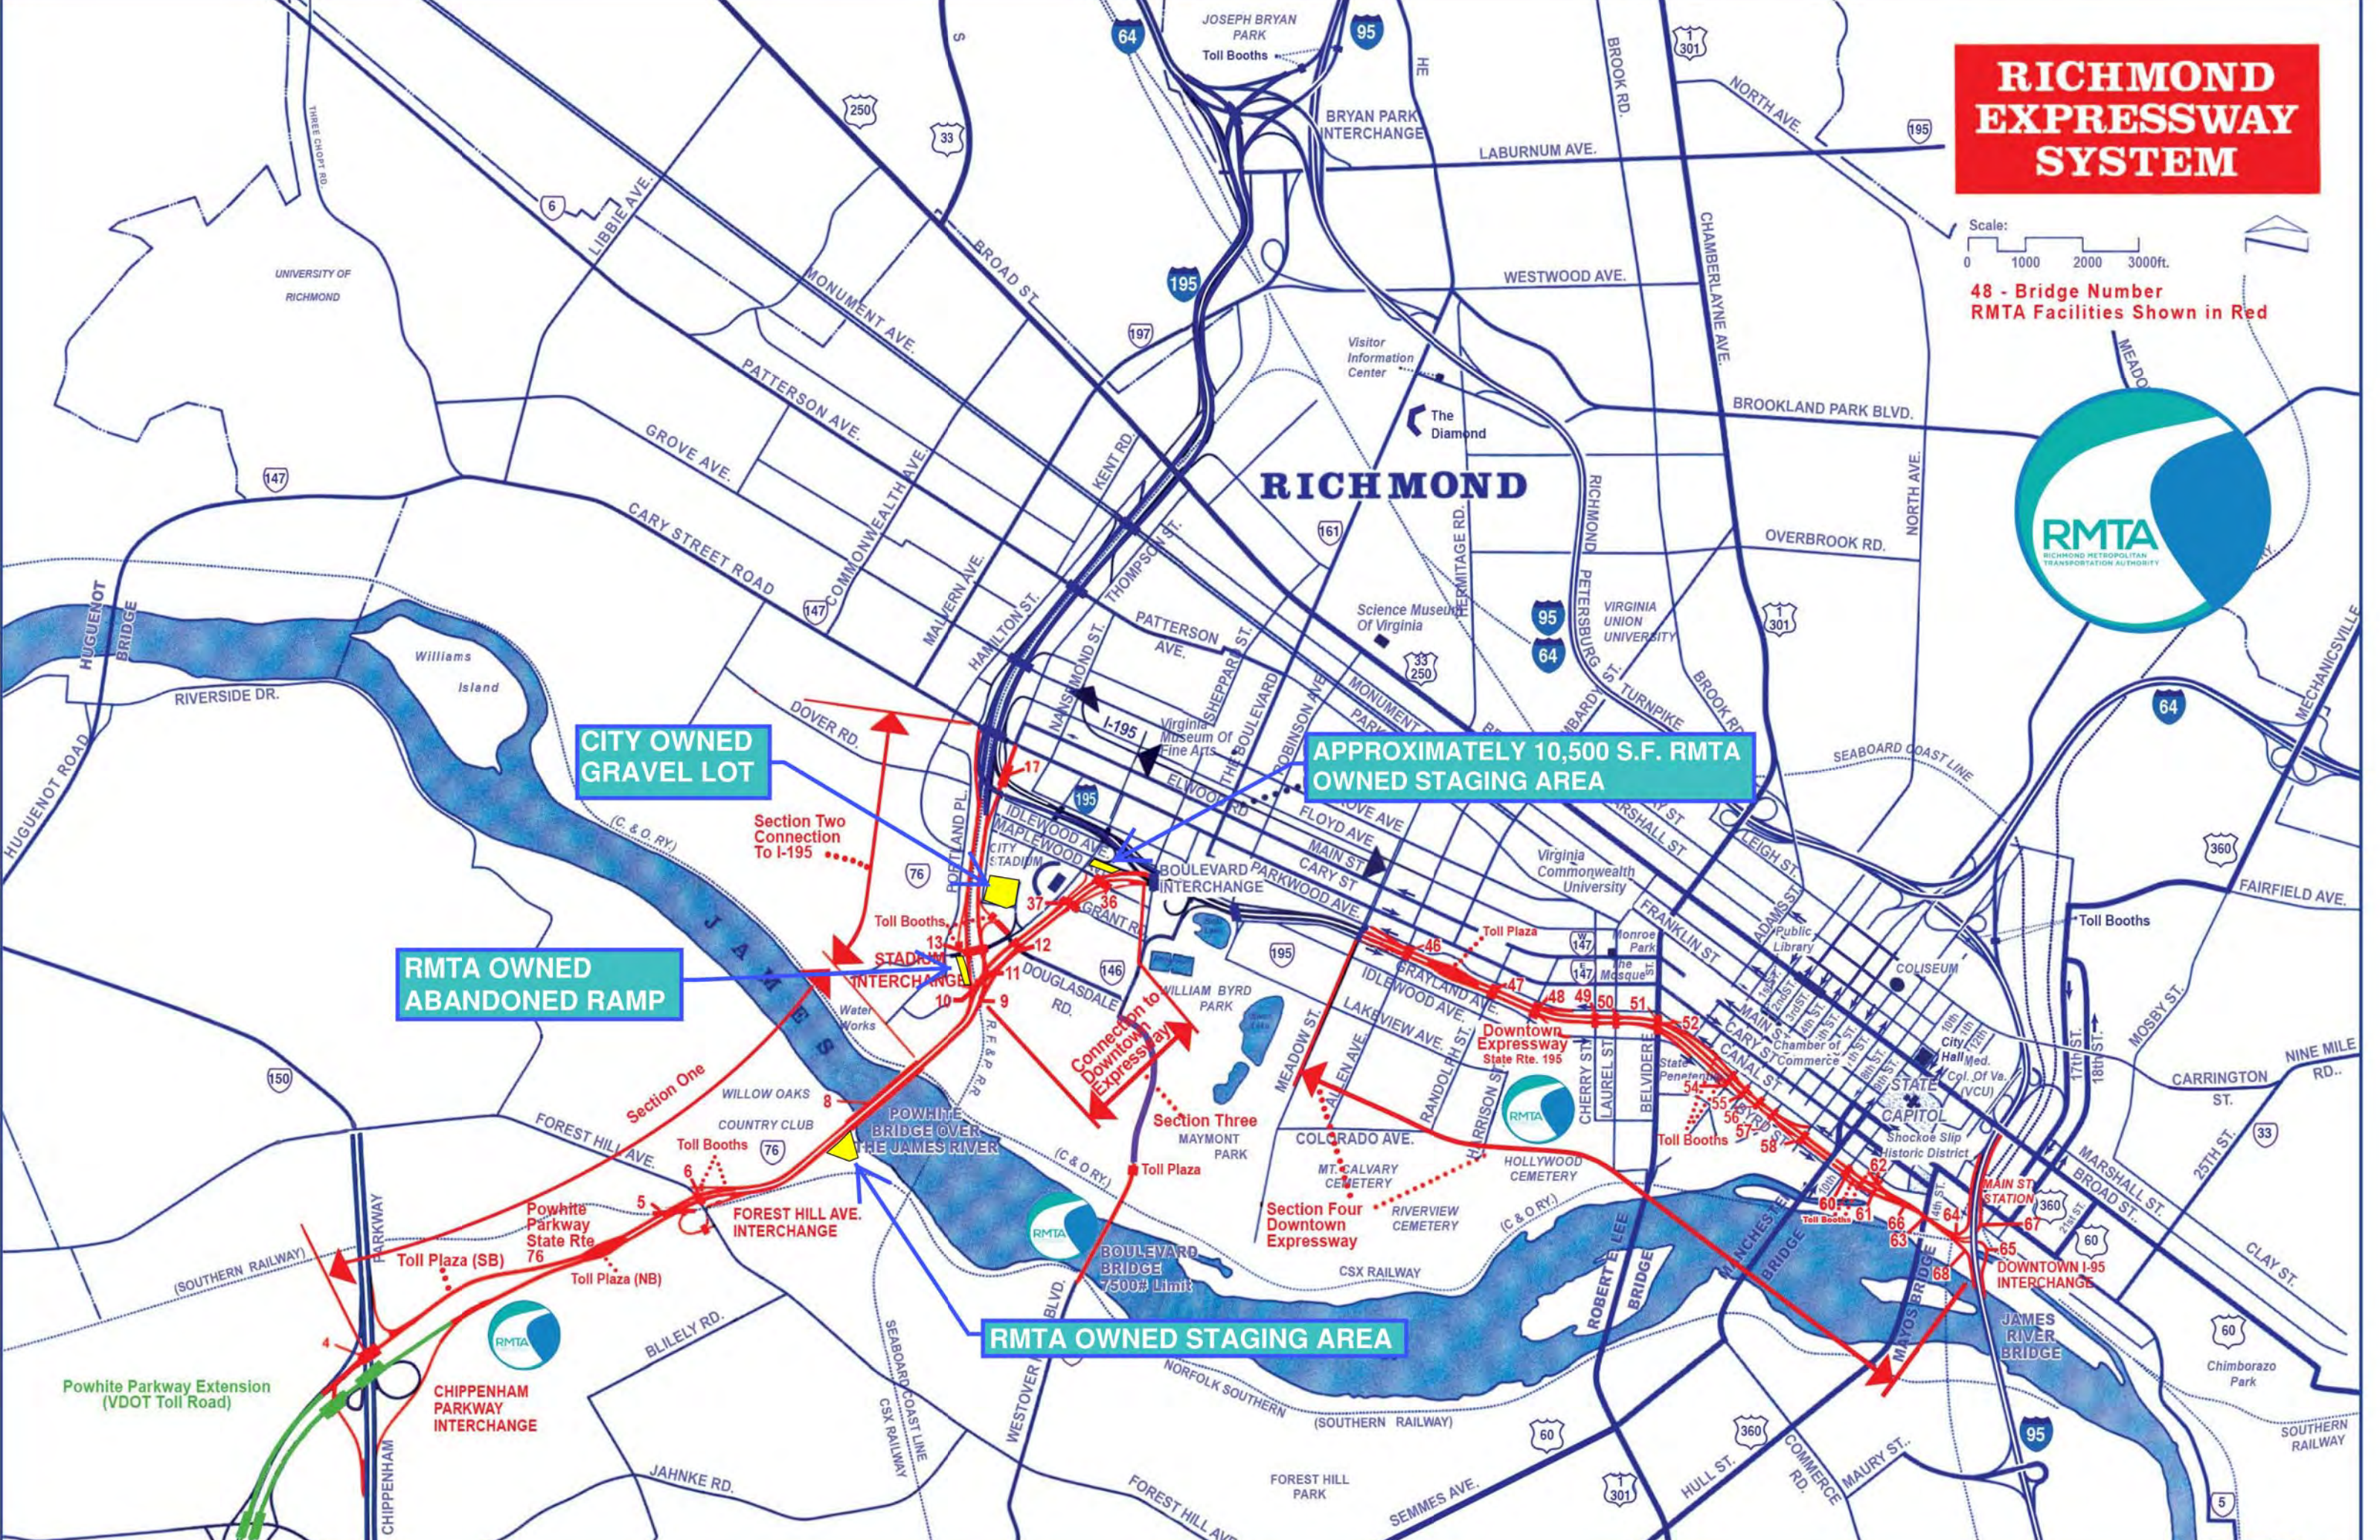

Powhite Parkway Extension (VDOT Toll Road)

CHIPPENHAM PARKWAY INTERCHANGE

DOWNTOWN I-95 INTERCHANGE

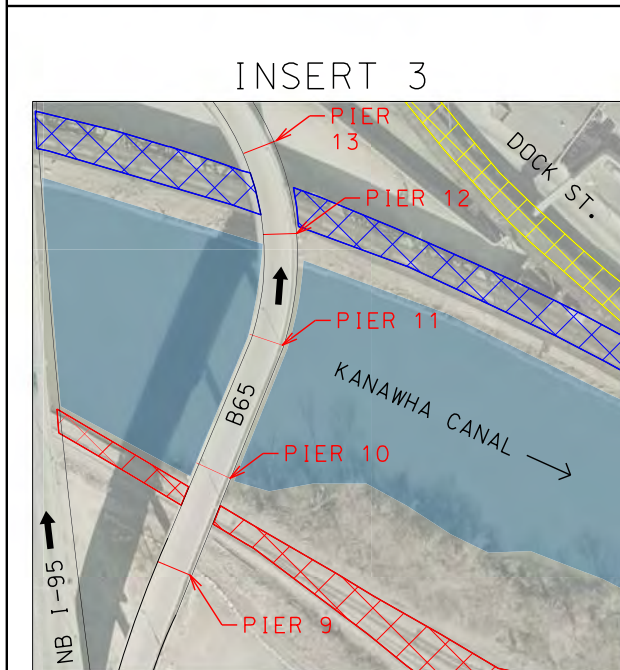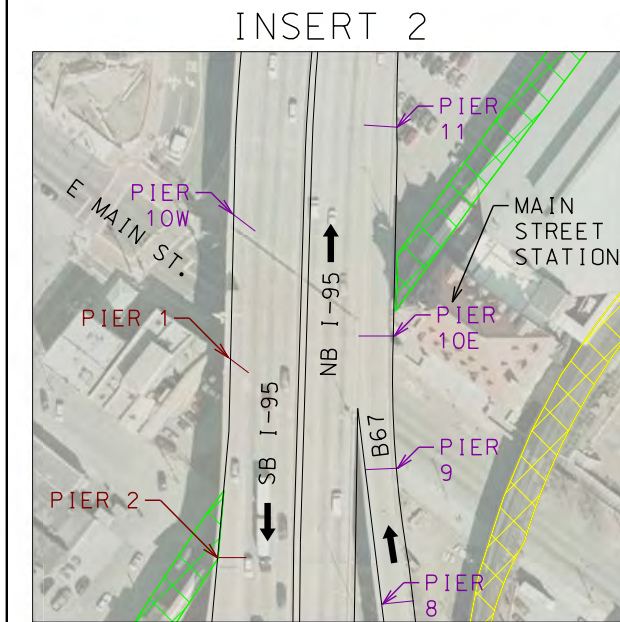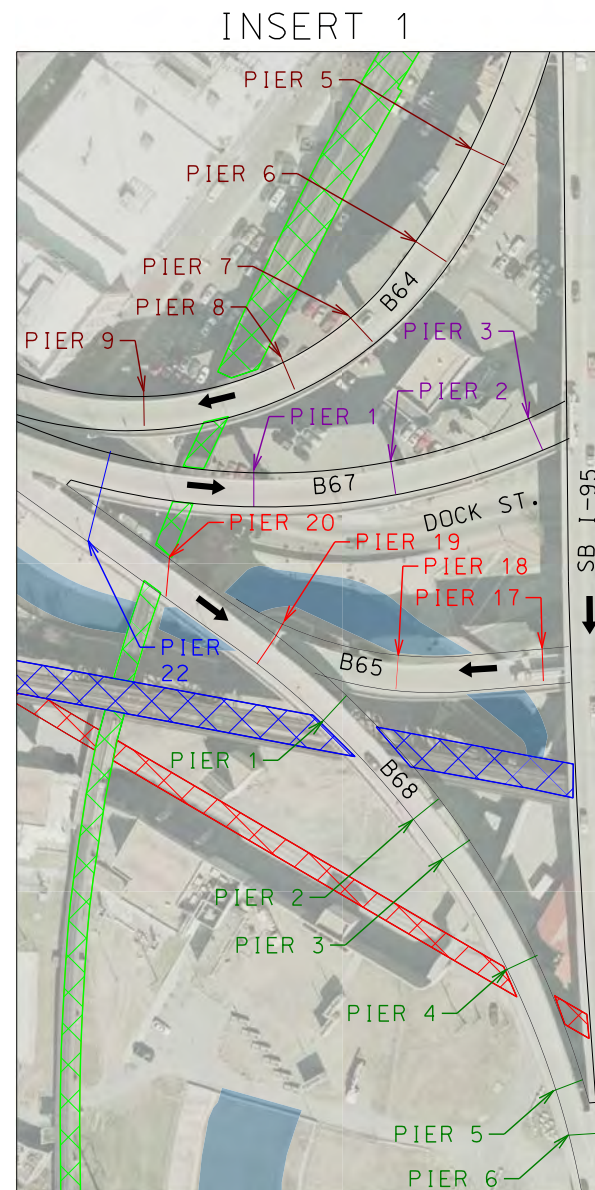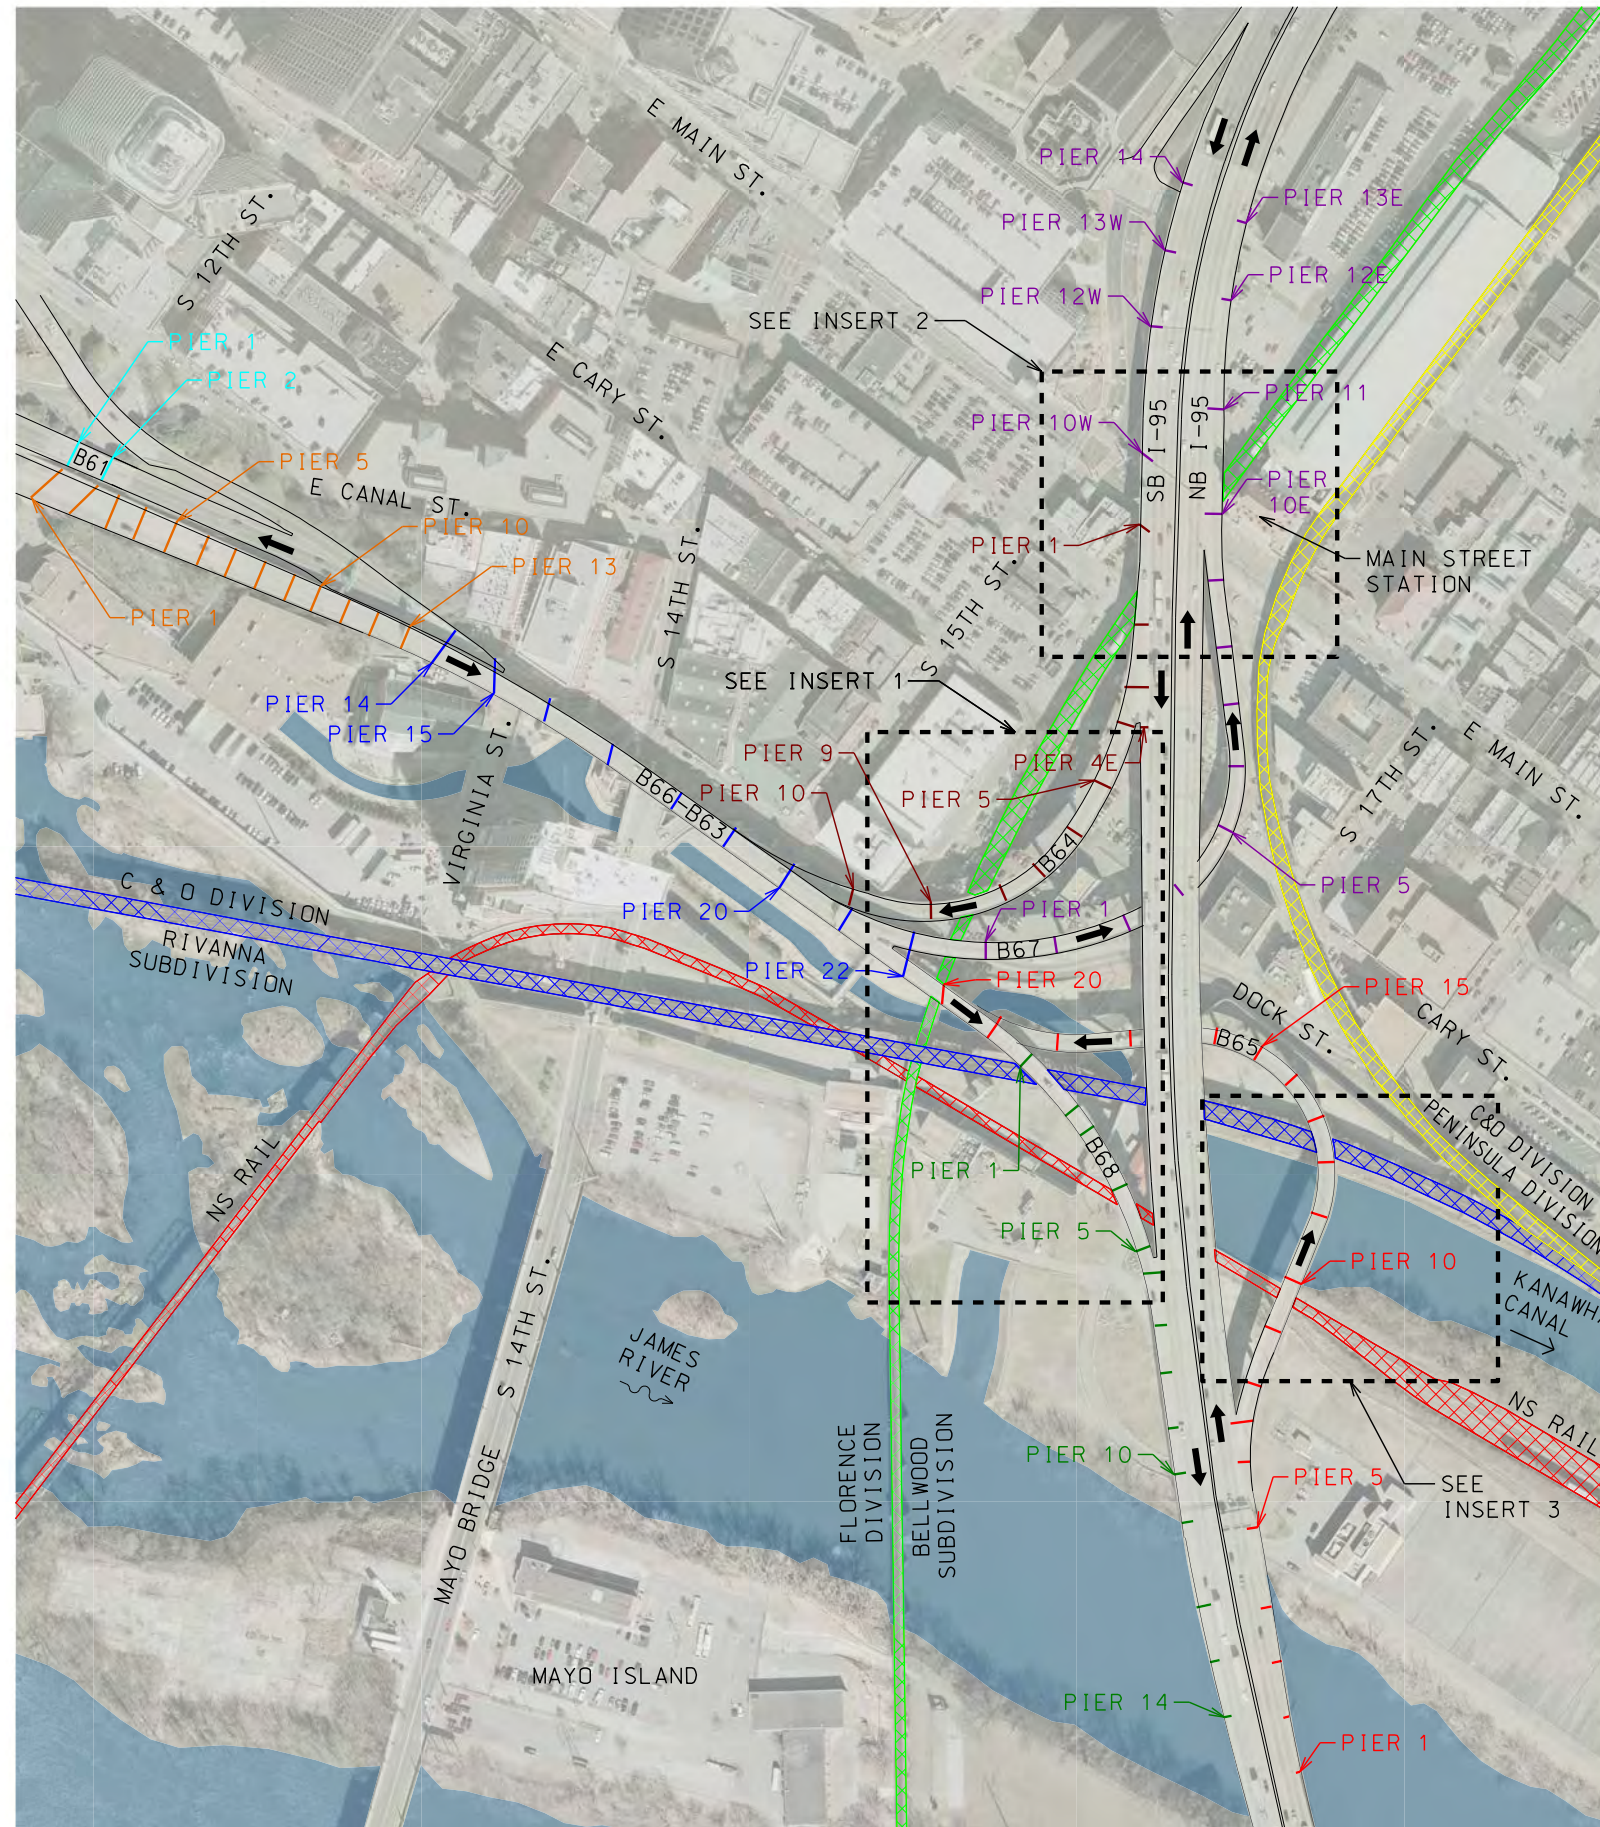

LEGEND:

	BRIDGE 63
	BRIDGE 64
	BRIDGE 65
	BRIDGE 66
	BRIDGE 67
	BRIDGE 68
	N&S RAILROAD
	CSX RAILROAD
	CSX RAILROAD
	CSX RAILROAD

- NOTES:**
- 1) PIER NUMBERS BASED ON AS-BUILT DRAWINGS FROM CONTRACTS C-10 AND C-11.
 - 2) RAILROAD LIMITS AND PIER LOCATIONS BASED ON AERIAL PHOTOGRAPHY.
 - 3) THIS EXHIBIT IS FOR REFERENCE ONLY. REFER TO AS-BUILT DRAWINGS FOR EXACT PIER LOCATIONS.
 - 4) BRIDGE 63 IS ON BOTTOM, BRIDGE 66 IS ON TOP.

RICHMOND METROPOLITAN TRANSPORTATION AUTHORITY






HNTB

I-95 RAMPS PIER LOCATION EXHIBIT

2900 S. QUINCY STREET, SUITE 200
ARLINGTON, VIRGINIA
(703) 824-5100

Scale:	Date:	Contract No.:	Sheet:
N.T.S.	MAY 2015	MR-2015	1 OF 1

INDEX OF SHEETS

SHEET NO.	TITLE
1	COVER SHEET
2-3	GENERAL PLAN AND ELEVATION
4	BRIDGE LAYOUT, GENERAL NOTES AND ESTIMATE OF QUANTITIES
5	PROFILES AND PAVEMENT ELEVATIONS
6	SOUTH ABUTMENT
7	NORTH ABUTMENT
8	ABUTMENT DETAILS
9	PIER 1
10	PIER 2
11	PIER 3
12	(DELETED) 
13	PIER 4
14	(DELETED) 
15	PIER 5
16	PIER 6
17	PIER 7
18	PIER 8
19	PIER 9
20	PIER 10
21	PIER 11
22	PIER 12
23	PIER 13
24	PIER 14
25	PIER 15
26	PIER 16
27	PIER 17
28	FRAMING PLAN - UNITS 1, 2, 3 AND 4
29	FRAMING PLAN - UNITS 5 THRU 12 
30	FRAMING PLAN - UNITS 13, 14 AND 15
31	FRAMING PLAN - UNITS 16, 17 AND 18
32-33	STRUCTURAL STEEL DETAILS
34	SHOES
35	JOINT DETAILS
36	DRAINAGE SCUPPERS
37	DECK PLAN - UNITS 1, 2, 3 AND 4
38	DECK PLAN - UNITS 5 THRU 12 
39	DECK PLAN - UNITS 13, 14 AND 15
40	DECK PLAN - UNITS 16, 17 AND 18
41	DECK DETAILS
42	ALUMINUM RAILING DETAILS
43	(DELETED) 
44	ELECTRICAL DETAILS
45	APPROACH SLABS
46	SLOPE PROTECTION
47-53	BORING LOGS


RICHMOND METROPOLITAN AUTHORITY

PLAN AND PROFILE OF PROPOSED RICHMOND EXPRESSWAY SYSTEM

CHESTERFIELD COUNTY CITY OF RICHMOND

JAMES RIVER BRIDGE

LIMITED ACCESS HIGHWAY			
RICHMOND EXPRESSWAY SYSTEM			
SECTION	PROJECT	SHEET NO.	TOTAL SHEETS
3	JAMES RIVER BRIDGE	1	53

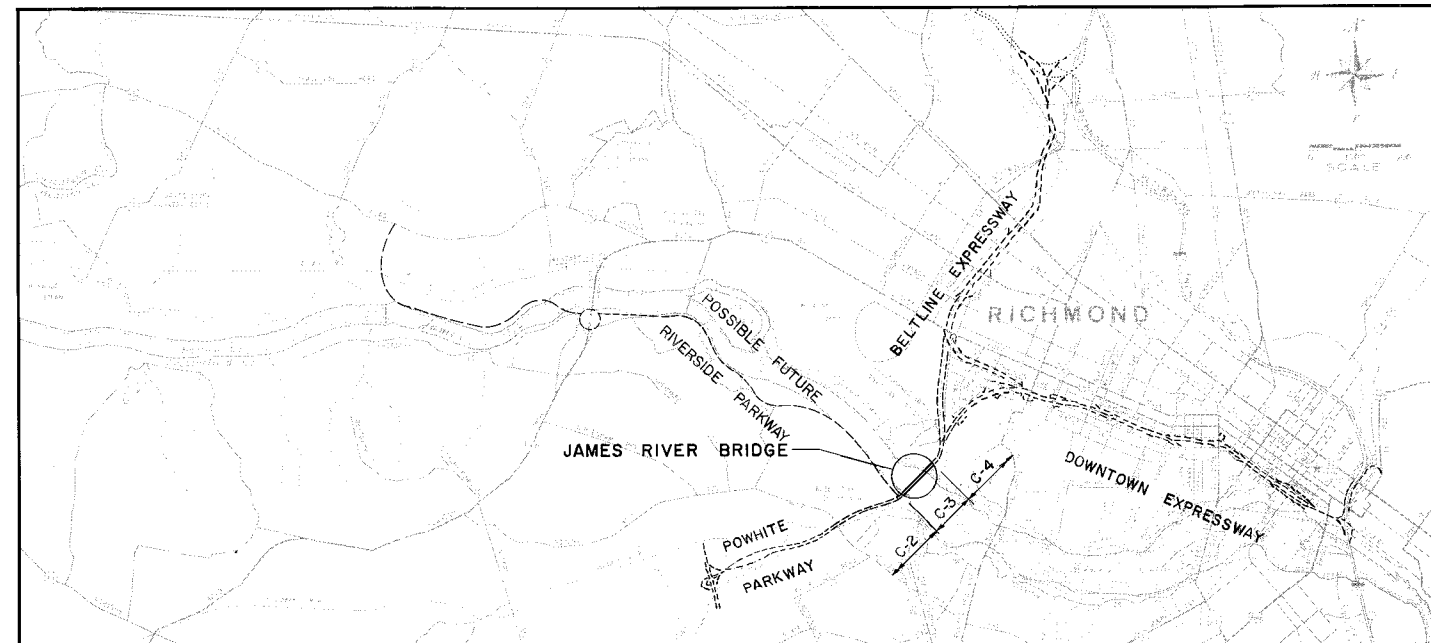

CONTRACT C-3

BRIDGE B-8

CONVENTIONAL SIGNS	
STATE LINE	LEVEE OR EMBANKMENT
COUNTY LINE	BRIDGES
CITY, TOWN OR VILLAGE	CULVERTS
RIGHT OF WAY LINE	DROP INLET
FENCE LINE	TROLLEY POLES
UNFENCED PROPERTY LINE	POWER POLES
FENCED PROPERTY LINE	TELEPHONE OR TELEGRAPH POLES
TRAVELED WAY	MARSH
GUARD RAIL	HEDGE
RETAINING WALL	WOODS
RAILROADS	GROUND ELEVATION
BASE OR SURVEY LINE	GRADE ELEVATION
	POLES WITHIN CONSTRUCTION LIMITS



SUBMITTED BY	
Date	
1-22-71	<i>John P. Fowler</i>
Date	HOWARD, NEEDLES, TAMMEN & BERGENDOFF General Consultant

RECOMMENDED BY	
Date	
1-23-71	<i>Charles A. ...</i>
Date	GENERAL MANAGER, RICHMOND METROPOLITAN AUTHORITY

APPROVED BY	
Date	
1-23-71	<i>Charles A. ...</i>
Date	CHAIRMAN, RICHMOND METROPOLITAN AUTHORITY

Plans Revised			
Sheet No.	Date	Sheet No.	Date
1-6,9-16,28,29	2-20-71		
32-38,41,43,46	2-20-71		
1,2,3,17,37	3-9-71		
38,39,40	3-9-71		
1,4,35,36,44	4-5-71		
21	9-3-71		
23	4-12-72		
45	9-12-72		

RICHMOND EXPRESSWAY SYSTEM			
SECTION	PROJECT	SHEET NO.	TOTAL SHEETS
3	JAMES RIVER BRIDGE	2	53

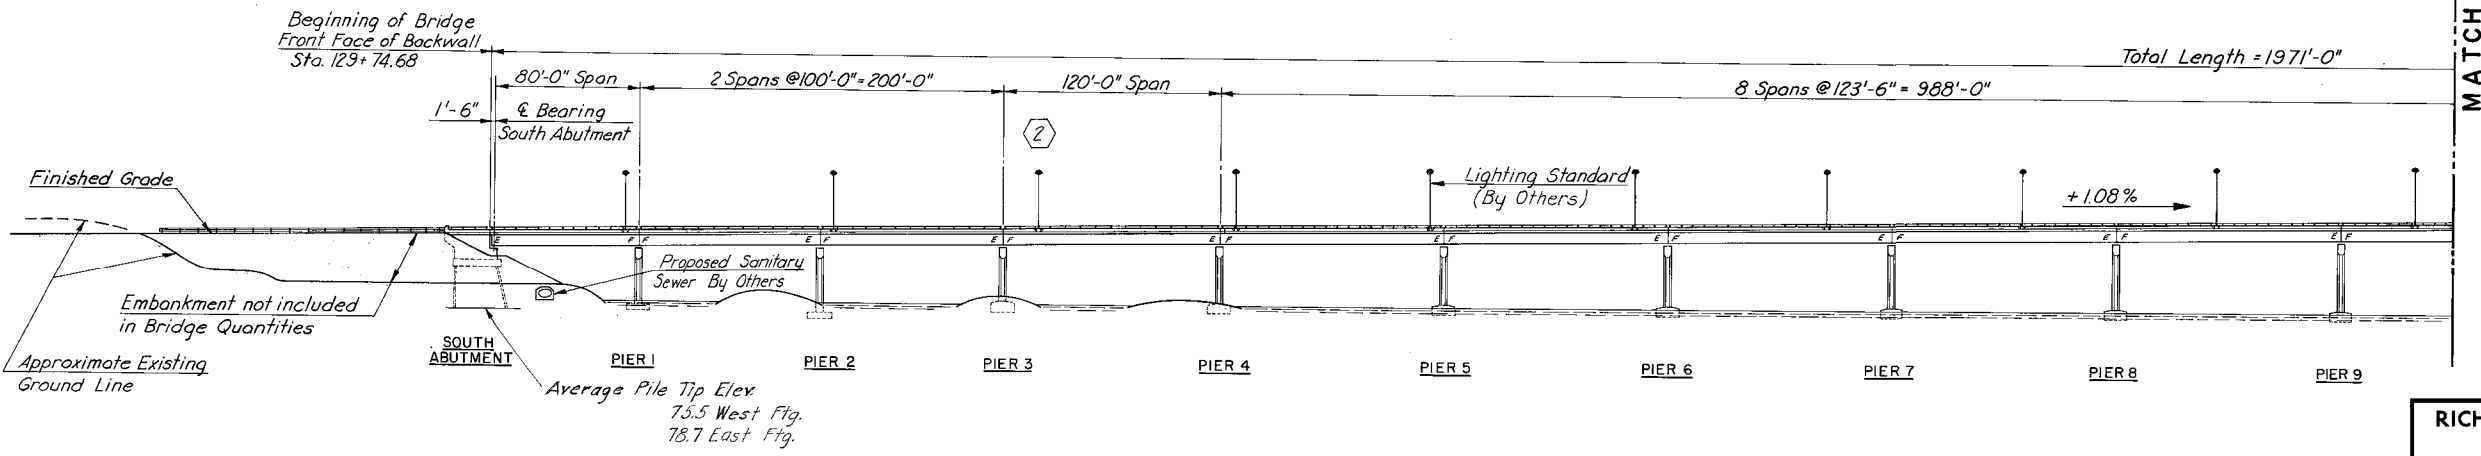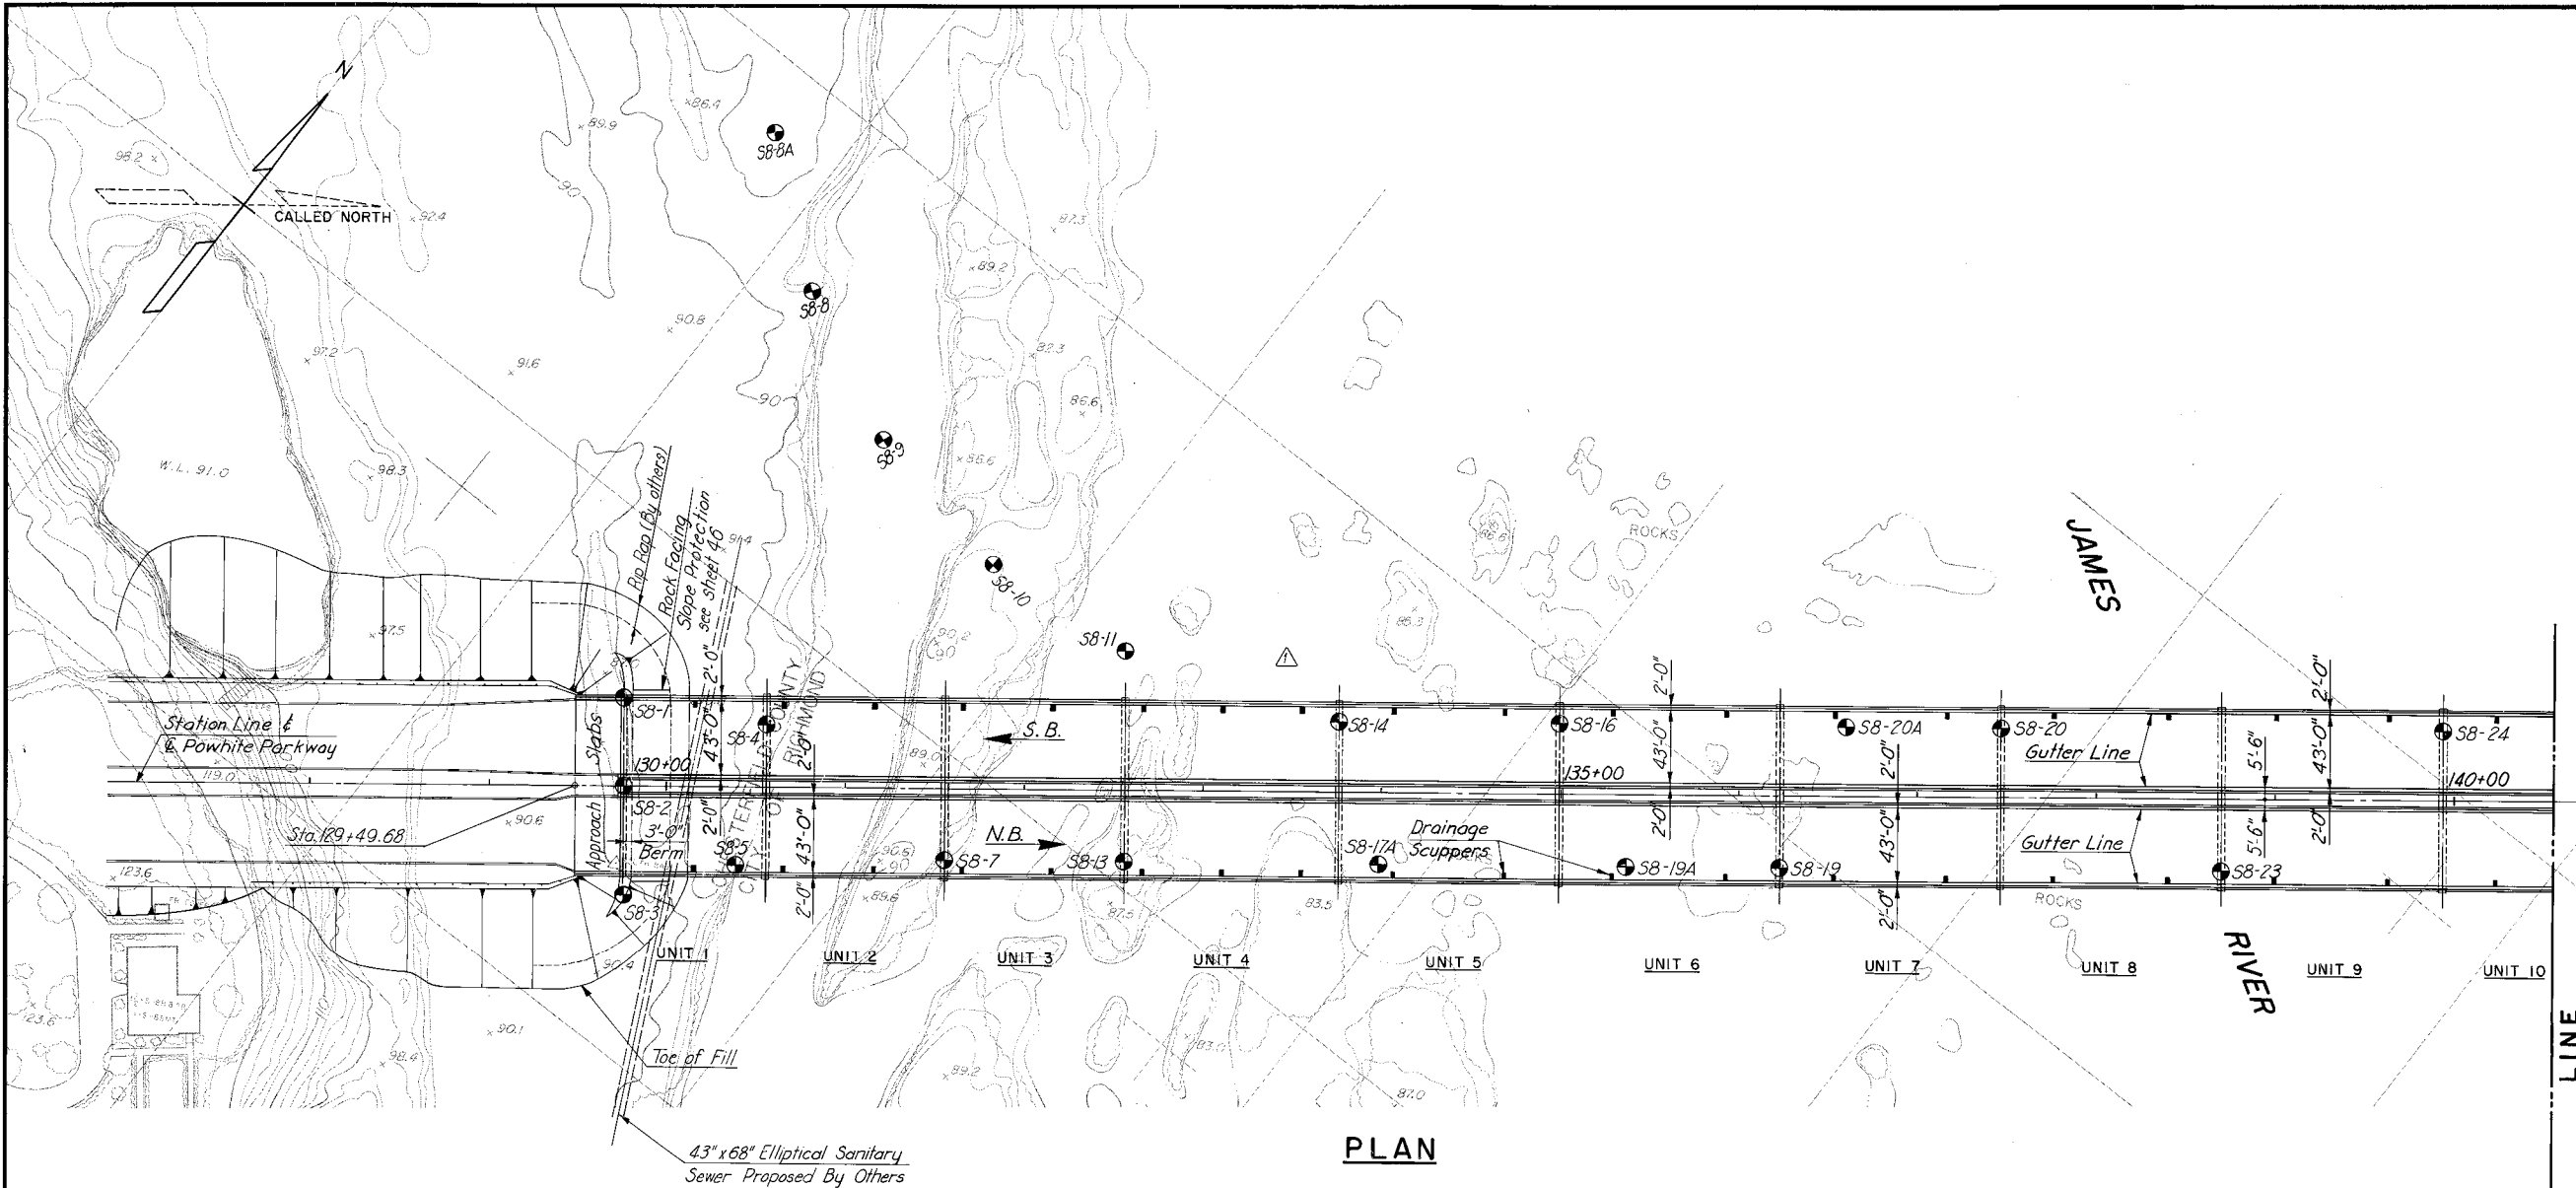

NOTES:
 For Bridge Layout and General Notes see sheet no. 4.
 For Profiles see sheet no. 5.
 ● Indicates 2 1/2" Cased Hole Boring.

BY	DATE	3	AS BUILT	JRC	12-72
MADE	HBW	8-67	Light Std Location	J.G.V.	3/9/71
CHECKED	FXH	2-68	Remove Ramp Taper	H.B.W.	2/20/71
IN CHARGE	FXH				

CURVE NO.	CURVE DATA				SUMMARY				
	Δ	D	R	T	L	BACK TANGENT BEARING	FORWARD TANGENT BEARING	BEGIN CURVE	END CURVE
1	8°00'00"	10°00'00"	572.96'	40.06'	80.00'	S52°46'10.5"W	S60°46'10.5"W	P.C. 10+00.00	P.C.C. 10+80.00
2	61°13'55.5"	33°22'40.4"	310.00'	183.45'	231.50'	S60°46'10.5"W	N57°59'54.0"W	P.C. 10+80.00	P.C.C. 14+11.30
3	30°20'00"	10°00'00"	572.96'	153.52'	300.00'	N57°59'54.0"W	N27°59'54.0"W	P.C.C. 14+11.30	P.T. 17+11.30



RICHMOND METROPOLITAN AUTHORITY
RICHMOND EXPRESSWAY SYSTEM

JAMES RIVER BRIDGE
GENERAL PLAN AND ELEVATION

HOWARD, NEEDLES, TAMMEN & BERGENDOFF
 consulting engineers
 NEW YORK ALEXANDRIA KANSAS CITY

SCALE: 1" = 50'
 CONTRACT NO.: C-3
 SHEET NO. 2 OF 53

RICHMOND EXPRESSWAY SYSTEM			
SECTION	PROJECT	SHEET NO.	TOTAL SHEETS
3	JAMES RIVER BRIDGE	3	53

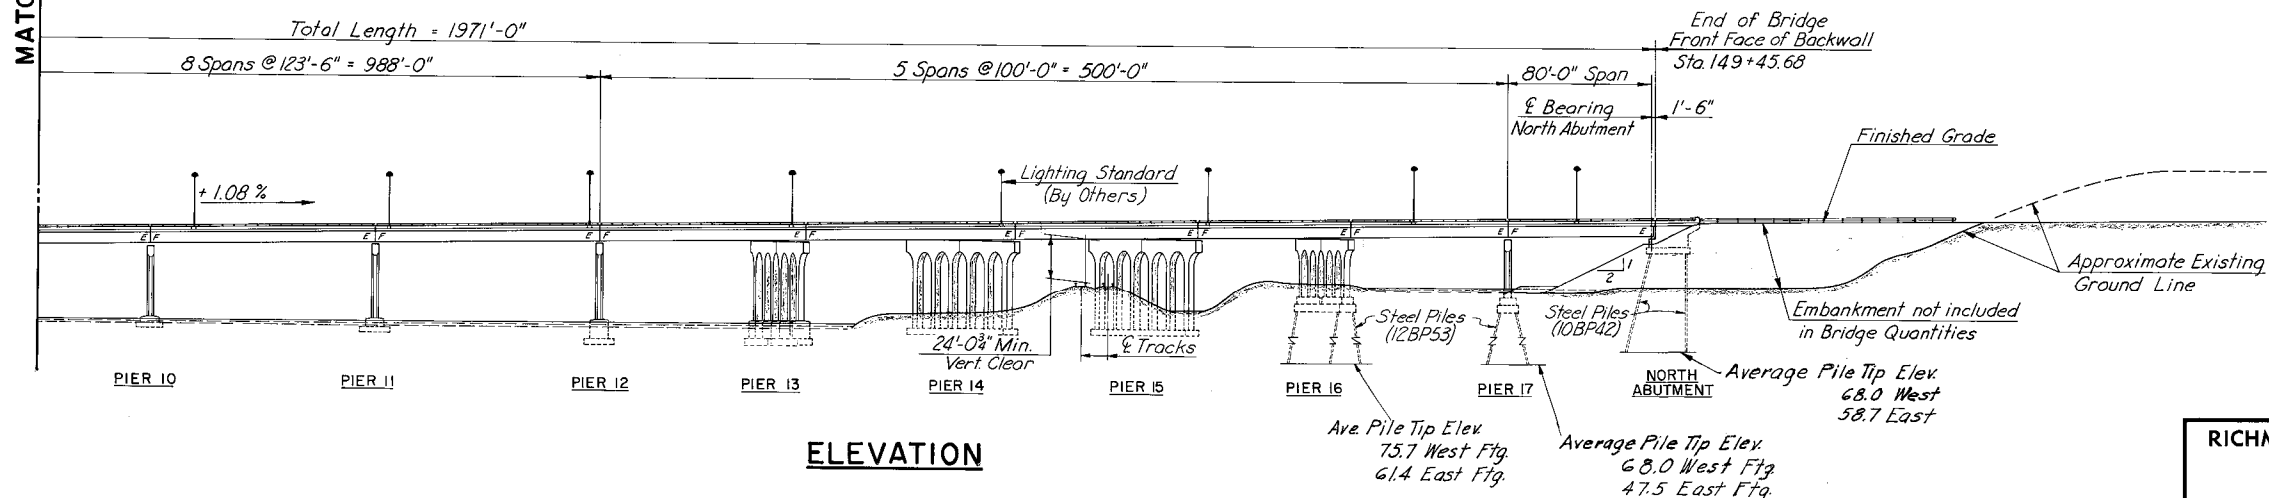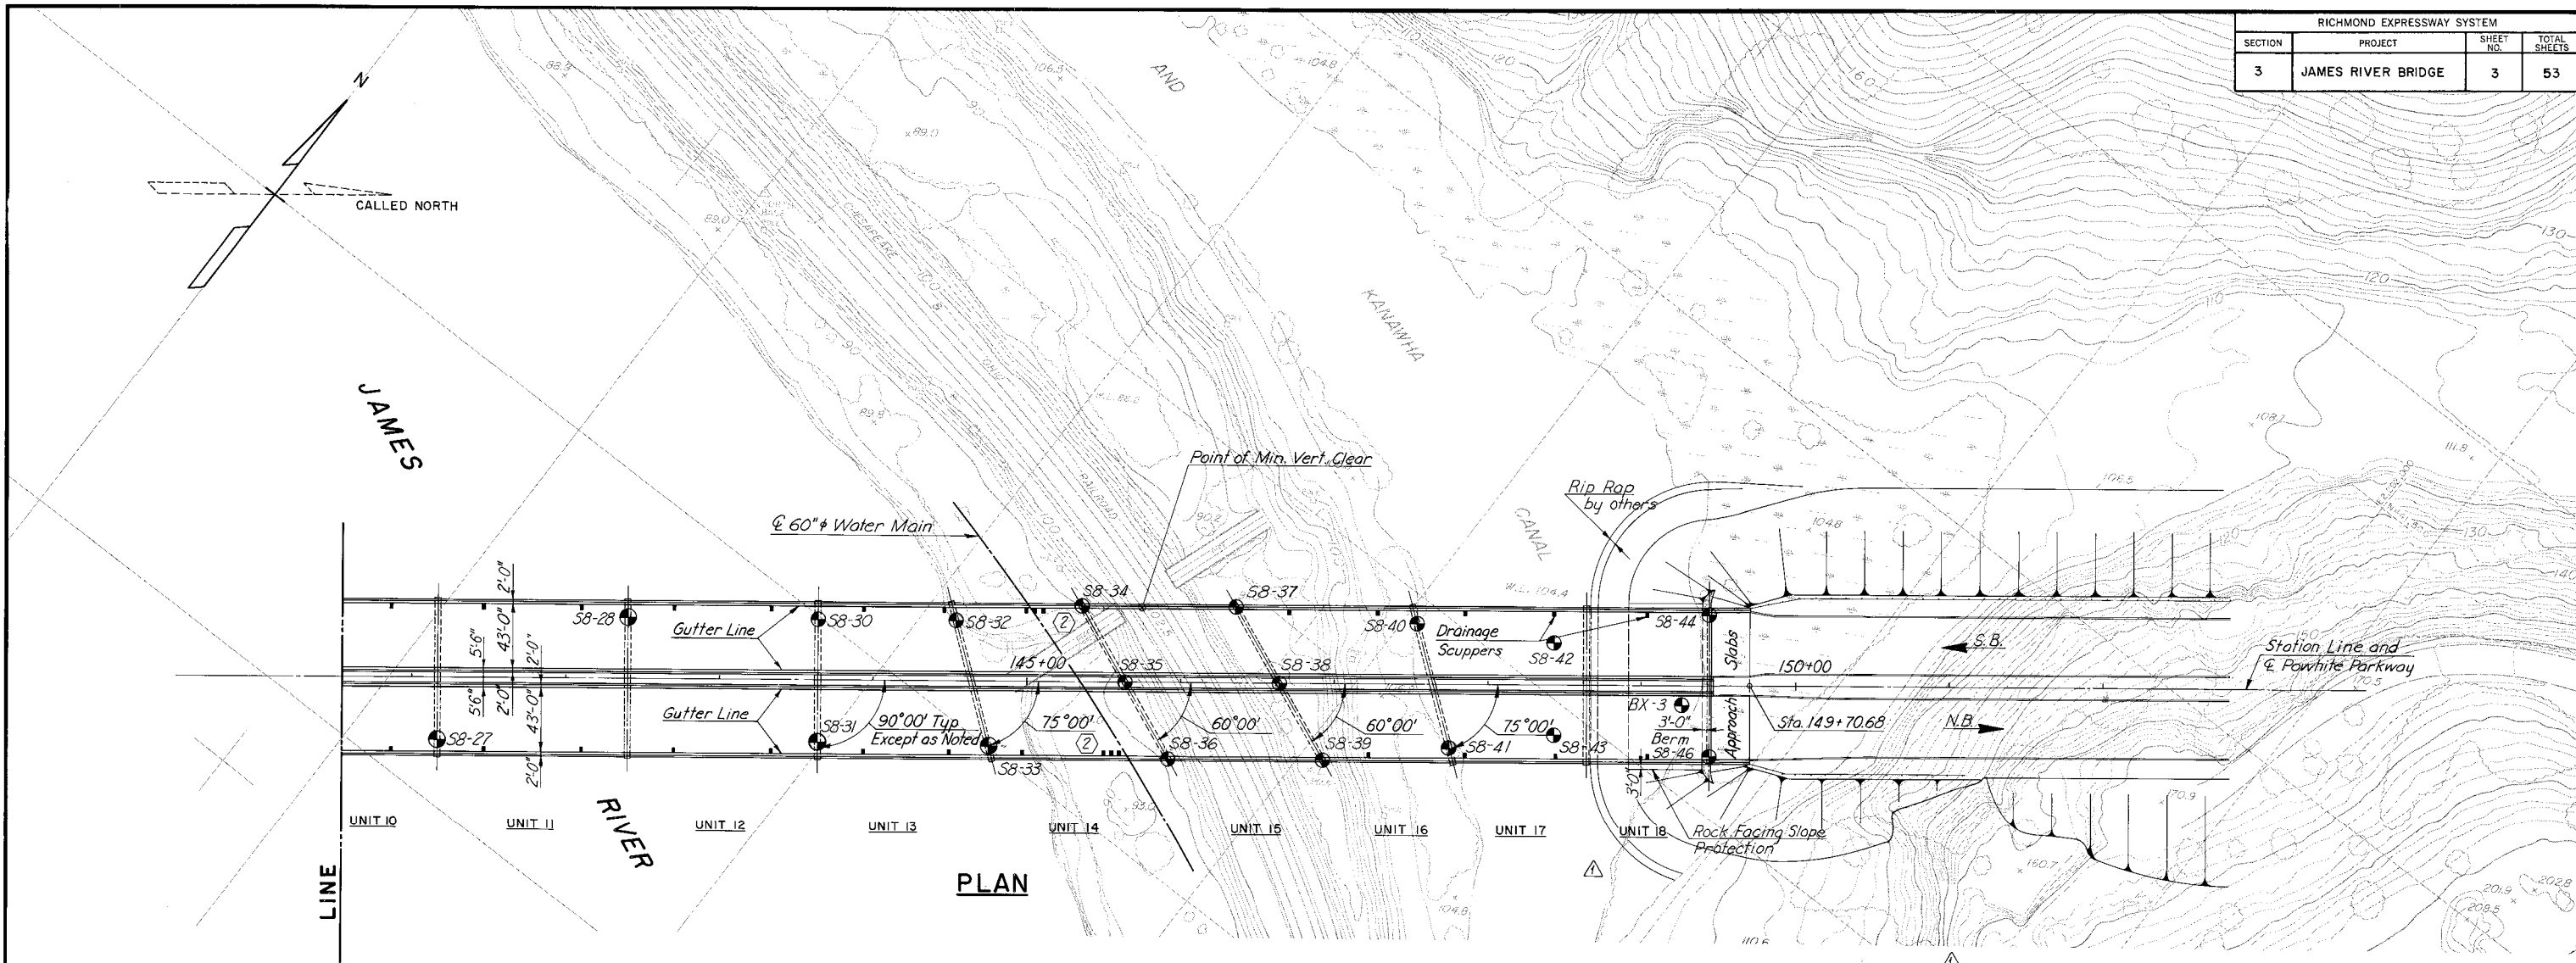

NOTES:
 For Bridge Layout and General Notes see sheet no. 4.
 For Profiles see sheet no. 5.
 ⚠ Indicates 2" Cased Hole Boring.

AS BUILT

**RICHMOND METROPOLITAN AUTHORITY
 RICHMOND EXPRESSWAY SYSTEM**

**JAMES RIVER BRIDGE
 GENERAL PLAN AND ELEVATION**


BY	DATE	NO.	AS BUILT	JRC	DATE
BY	8-67	3	AS BUILT	JRC	12-72
MADE	8-67	2	Scupper Location	J.G.V.	3/9/71
CHECKED	2-68	1	Elim. Disposal Area Add Foot Path	E.V.R.	2/20/71
IN CHARGE					

HOWARD, NEEDLES, TAMMEN & BERGENDOFF
 consulting engineers
 NEW YORK ALEXANDRIA KANSAS CITY


SCALE: 1" = 50'
 CONTRACT NO.: C-3
 SHEET NO. 3 OF 53

ESTIMATE OF QUANTITIES


	Struct. Excav. at Piers 10 To 13 Incl.	Struct. Excav. Except Piers 10 To 13 Incl.	Porous Backfill	Steel Sheet Piling (Left in Place)	Steel Piles 10B-42	Steel Piles 12B-53	Concrete Class A3 Substructure	Concrete Class A3 Appr. Slabs	Concrete Class A4	Concrete Class 13	Reinforcing Steel	Structural Steel	Aluminum Bridge Paving	Dampproofing	6" Pipe Underdrain	Rock Facing Stone Project 8" Thick	Water Barings 4" Cased Holes Incl. Sampling	N.Y. Core Borings in Rock
	C.Y.	C.Y.	C.Y.	S.F.	L.F.	L.F.	C.Y.	C.Y.	C.Y.	C.Y.	Lbs.	Lbs.	L.F.	S.Y.	L.F.	S.Y.	L.F.	L.F.
Superstructure									60598		1345522	6310579	7965					
South Abutment		624	48		1520.8		2950				13465				142	133		170
North Abutment		608	48		3220		286.7				13465				144	136		844
Pier 1		323					270.9				44586							
Pier 2		358					2626				44586							
Pier 3		123					2745				44434							
Pier 4		97					311.8				44435							
Pier 5		156					324.2				44434							
Pier 6		132					293.1				44435							
Pier 7		133					341.8				44434							
Pier 8		105					328.4				44435							
Pier 9		154					318.3				44434							
Pier 10		245					382.7			51.0	56790						1.2	385
Pier 11		705					547.5				74957						12.5	114.6
Pier 12		842					573.5				75469						47.6	41.4
Pier 13		886					596.8				89317						18.7	40.0
Pier 14			845		1469		448.2			28.5	78522							
Pier 15			946		994		483.3			25.0	78522							
Pier 16			656		2260		1465.7			156.7	46374							
Pier 17			478		2197		2048.8			151.3	43678							
Approach Slabs									233.6		51461							
TOTAL	2678	5808	96	7320	5049.8	3314.5	7075.1	238.6	60598	473.7	2361755	6310579	7965	286	269	1014	80	234.5

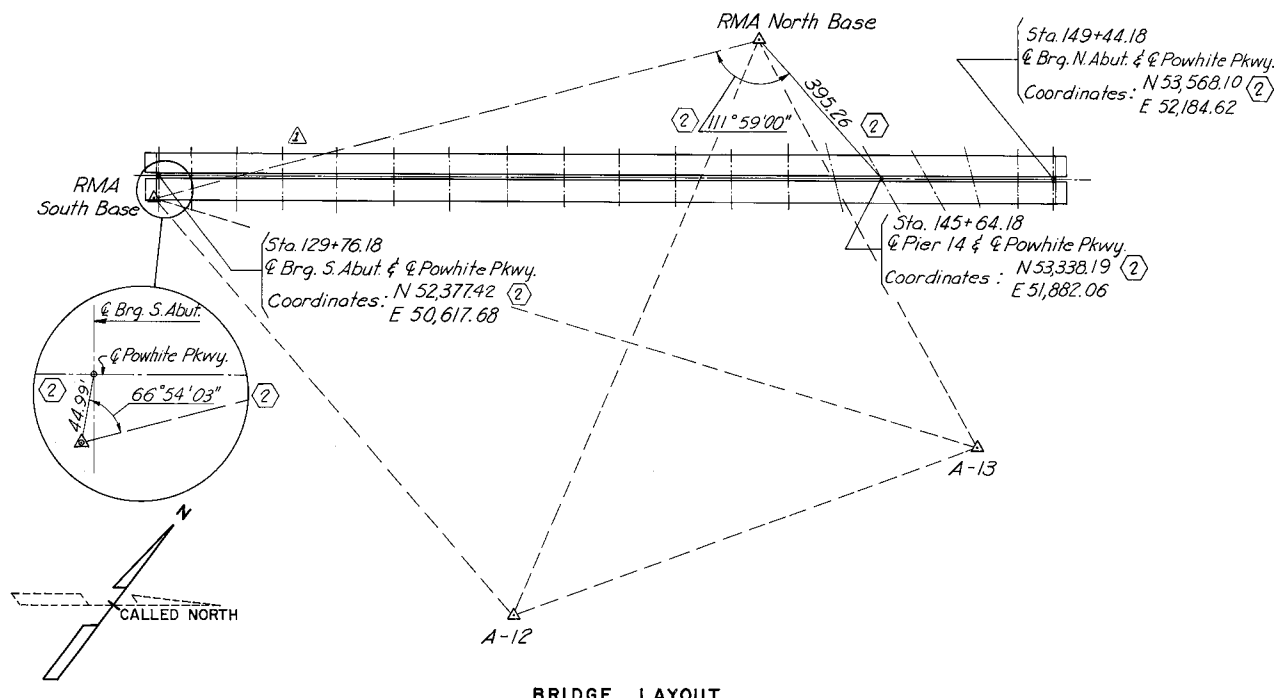


BRIDGE LAYOUT

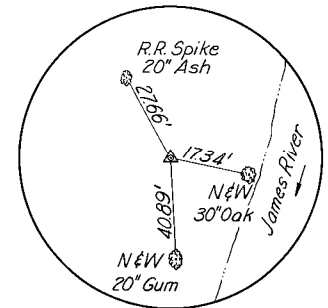


RMA SOUTH BASE
(Conc. Post w/ copper weld rod)
Elevation: 89.9
Coordinates: N 52,338.08
E 50,639.50

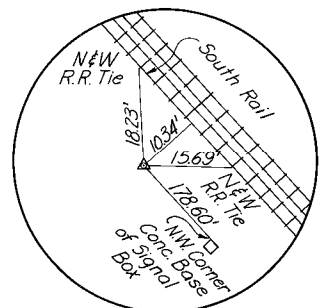

RMA NORTH BASE
(Conc. Post w/ copper weld rod)
Elevation: 103.89
Coordinates: N 53,446.49
E 51,501.93

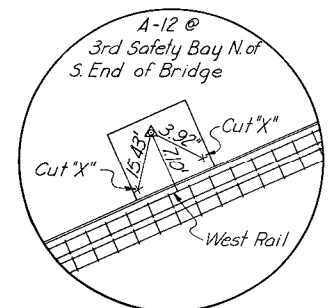

A-12
(58" Plug)
Elevation: 174.45
Coordinates: N 51,816.04
E 52,055.56

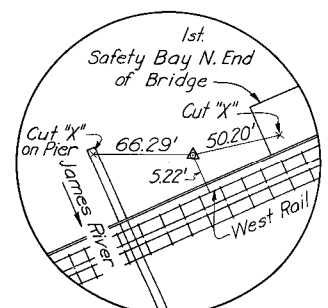

A-13
(58" Plug)
Elevation: 174.20
Coordinates: N 52,797.35
E 52,600.49

GENERAL NOTES:

- ROADWAY** Twin Roadways 43'-0" clear.
- CAPACITY** Dead Load-Includes 15 lbs. per sq. ft. for future wearing surface.
Live Loads-HS20-44 loading and B.P.R. Modified Loading for Military Vehicles.
- SPECIFICATIONS**
GENERAL - Virginia Department of Highway Road and Bridge Specifications, 1970.
DESIGN - A.A.S.H.O. Standard Specifications for Highway Bridges, 1961, modified by Special Design Provisions.
WELDING - 1969 Standard Specifications For Welded Highway and Railway Bridges of the American Welding Society.
ELECTRICAL - National Electrical Code, National Electrical Safety Code.
- CONTRACT SPECIAL PROVISIONS**
Specifications and Contract Special Provisions referred to above are necessary to make these plans complete.
- DATUM** CITY OF RICHMOND
- TEMPERATURE** The normal temperature referred to on the plans is 68°F. The temperature range for movement is 0°F to 120°F.
- DIMENSIONS** All dimensions are measured horizontally and vertically unless otherwise noted.
- FOUNDATIONS** All footing concrete shall be placed in the dry except where Class 13 Concrete is indicated on the plans or approved by the Engineer. Special attention is called to Sections 401.04 and 401.05 of the General Specifications, and to the Contract Special Provisions, concerning preparation of foundations for footings.

CONCRETE NOTES

Concrete in superstructure shall be Class A4. All other concrete (except tremie seal concrete) shall be Class A3. All exposed edges and corners shall have a 3/8" chamfer or fillet unless otherwise noted. Care in the method of vibration, the use of low-slump concrete, and/or other means shall be employed to prevent downgrade movement of newly placed slab concrete when the gradient is over 2%.
All reinforcing steel shall conform to A.S.T.M. A-615, Grade 40. Reinforcing bar dimensions on the detailed drawings are to centers of bars unless otherwise noted. Clear distance between reinforcing steel and face of concrete shall be as noted on the plans. All bar laps shall be as shown on the plans.

STEEL NOTES

Structural steel shall conform to A.S.T.M. Specification A36 except as noted.
All field connections shall be made with 3/4" diameter high strength bolts unless otherwise noted. Bolts shall conform to A.S.T.M. Specification A-325.











Because of the erratic nature of ground conditions at the site, elevations of the bottoms of the footings shown on the plans shall be considered approximate only. Should excavations at the time of construction reveal the foundations to be inadequate, redesign may be required.

RICHMOND METROPOLITAN AUTHORITY
RICHMOND EXPRESSWAY SYSTEM

JAMES RIVER BRIDGE
BRIDGE LAYOUT
GENERAL NOTES
ESTIMATE OF QUANTITIES

HOWARD, NEEDLES, TAMMEN & BERGENDOFF
consulting engineers
NEW YORK ALEXANDRIA KANSAS CITY
SCALE: NO SCALE
CONTRACT NO. C-3
SHEET NO. 4 OF 53

BY	DATE	As Built	JRC	12-72
MADE	HBW	11-67	Bridge Layout	H.B.W. 4/5/71
CHECKED	FXH	2-68	Quantities & Ramp Widening	H.B.W. 2/20/71
IN CHARGE	FXH			

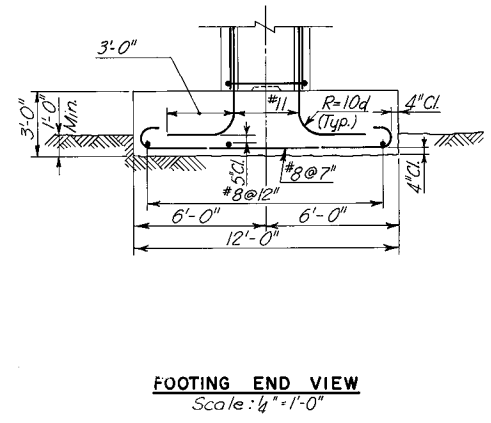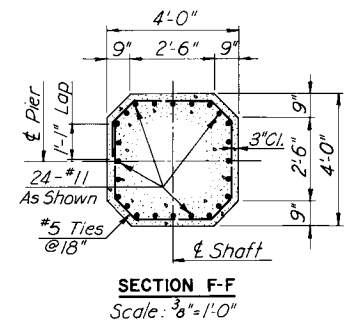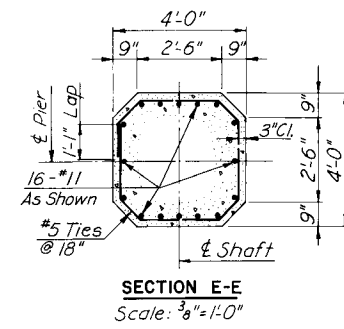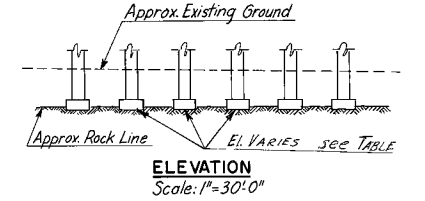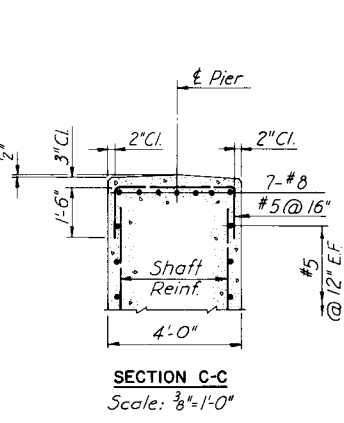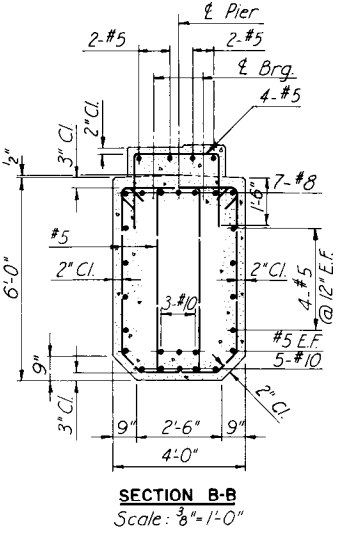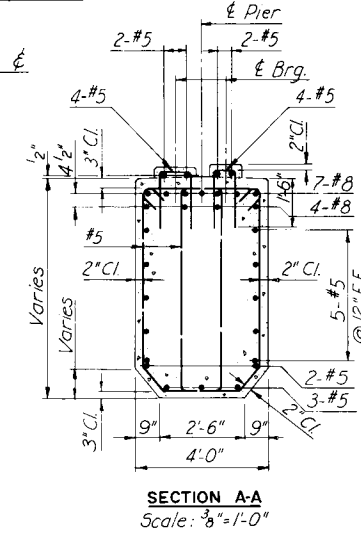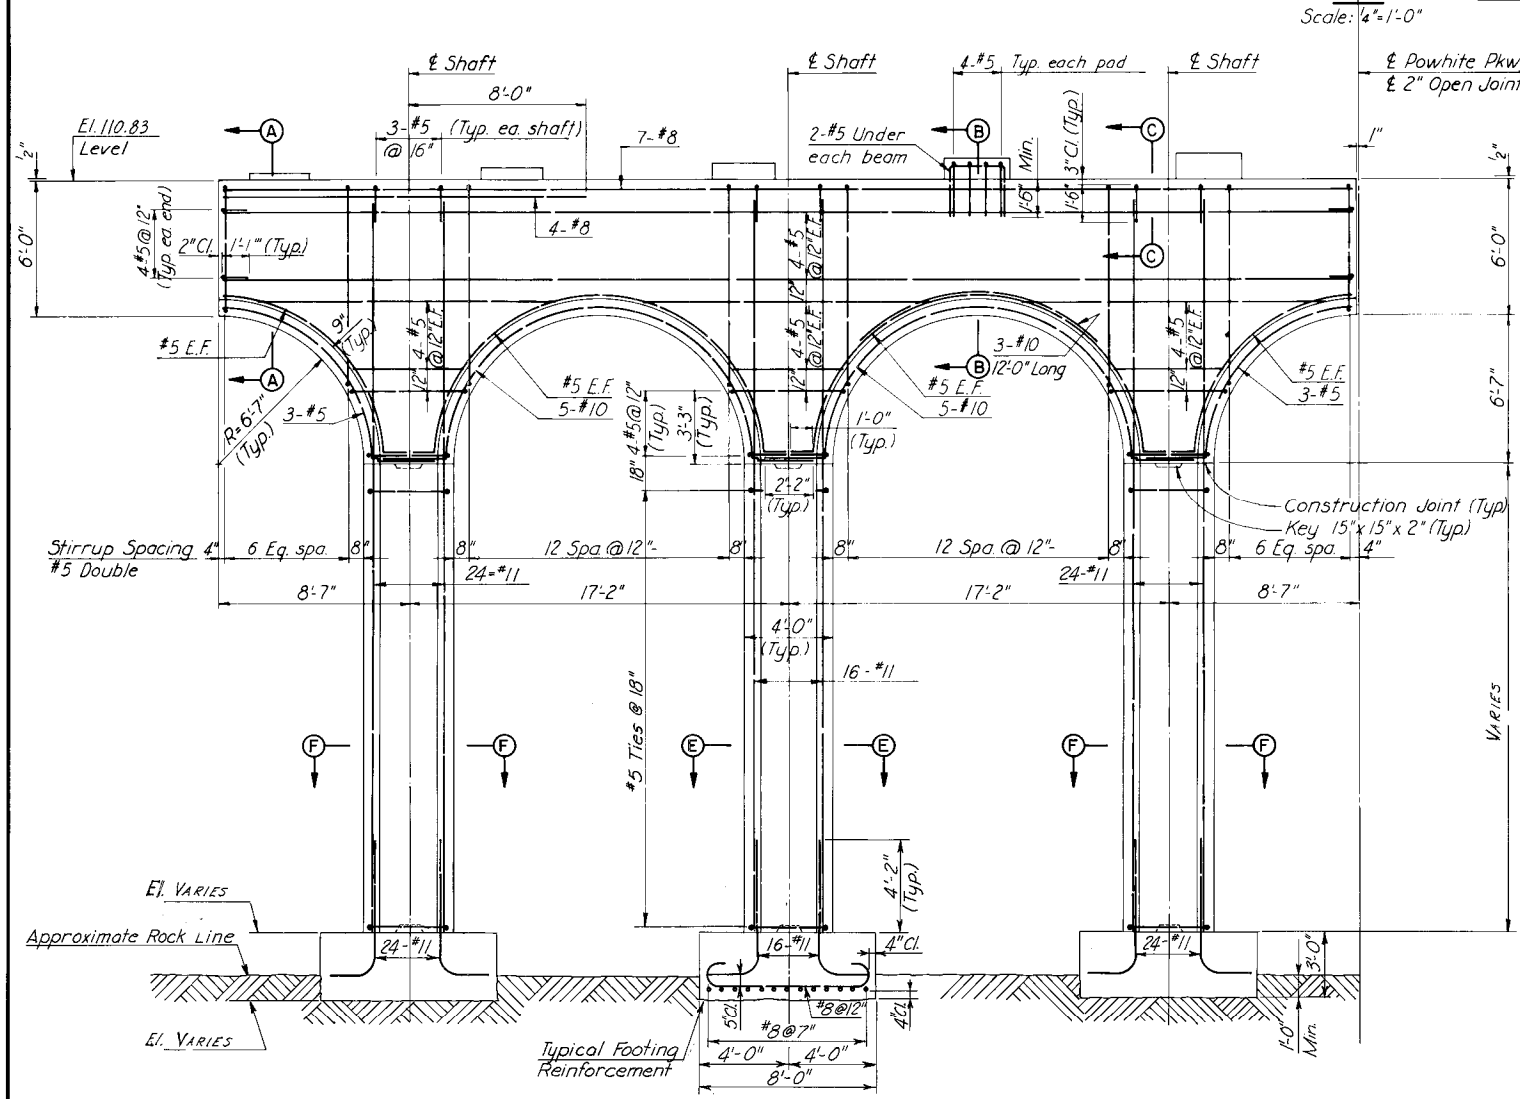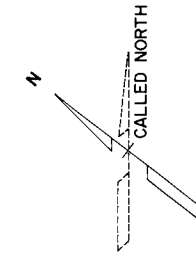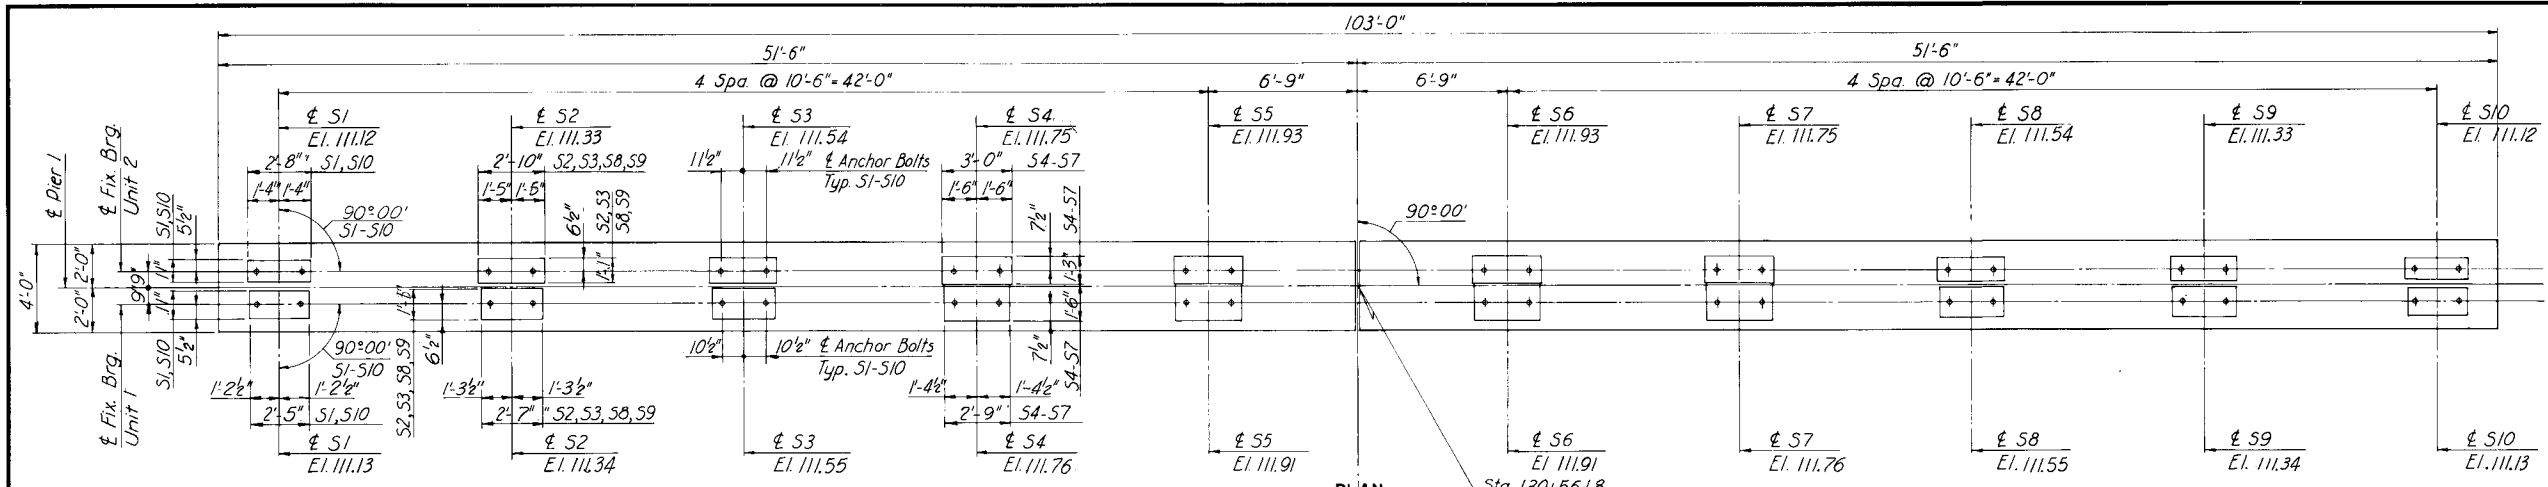

FOOTING NO.	TOP ELEV.	AVE. BOTTOM ELEV.	STEM LENGTH
1 L W	80.36	76.46	17.89
1 C W	79.32	75.58	18.93
1 R W	78.55	75.12	19.70
1 L E	79.43	74.95	18.82
1 C E	80.28	76.59	17.97
1 R E	80.88	77.04	17.37

Note:
Pier symmetrical about
& Powhite Pkwy.

1 = Pier No.
L-C-R = Left - Center - Right
W-E = West - East

NOTES:
AS BUILT
Pier foundations are designed for an allowable bearing pressure of 7 Tons/S.F.









BY	DATE	NO.	REVISION	BY	DATE
MADE	L.B.P. 7-67	2	AS BUILT	JRC	12-72
CHECKED	FXH 2-68	1	Complete	J.G.V.	2-20-71
IN CHARGE	FXH				

RICHMOND METROPOLITAN AUTHORITY
RICHMOND EXPRESSWAY SYSTEM

JAMES RIVER BRIDGE
PIER I

SCALE: AS SHOWN
CONTRACT NO: C-3
SHEET NO. 9 OF 53

HOWARD, NEEDLES, TAMMEN & BERGENDOFF
consulting engineers
NEW YORK ALEXANDRIA KANSAS CITY

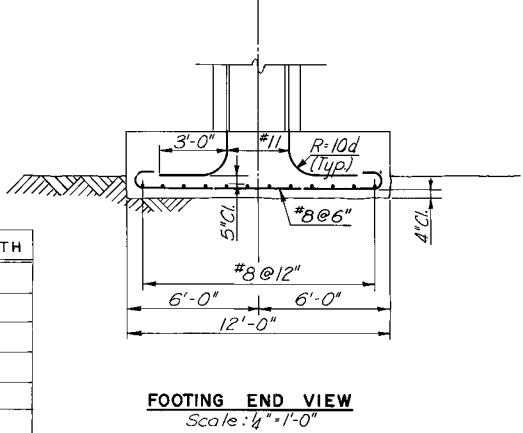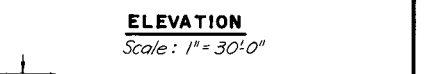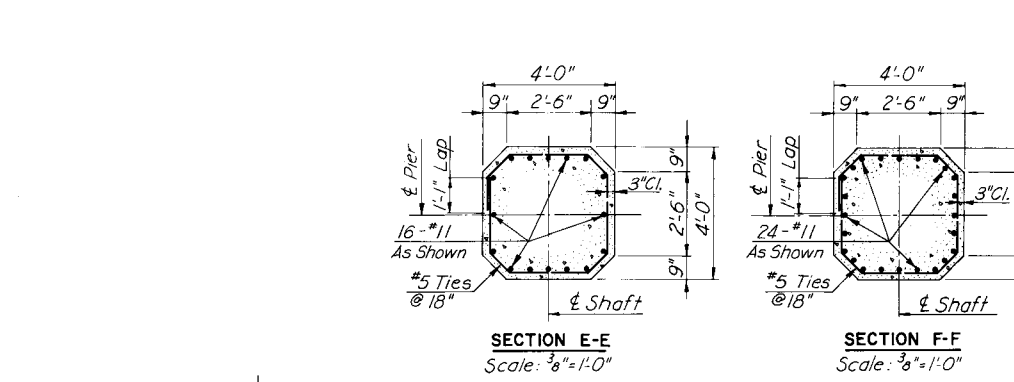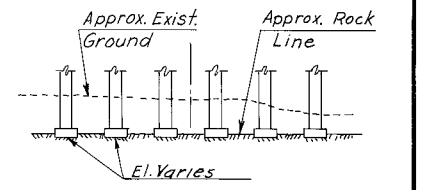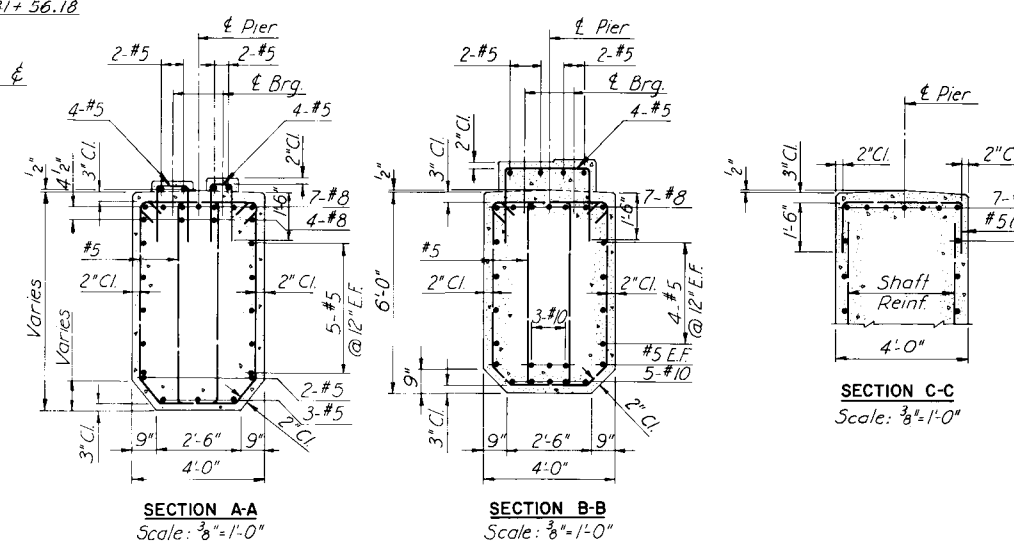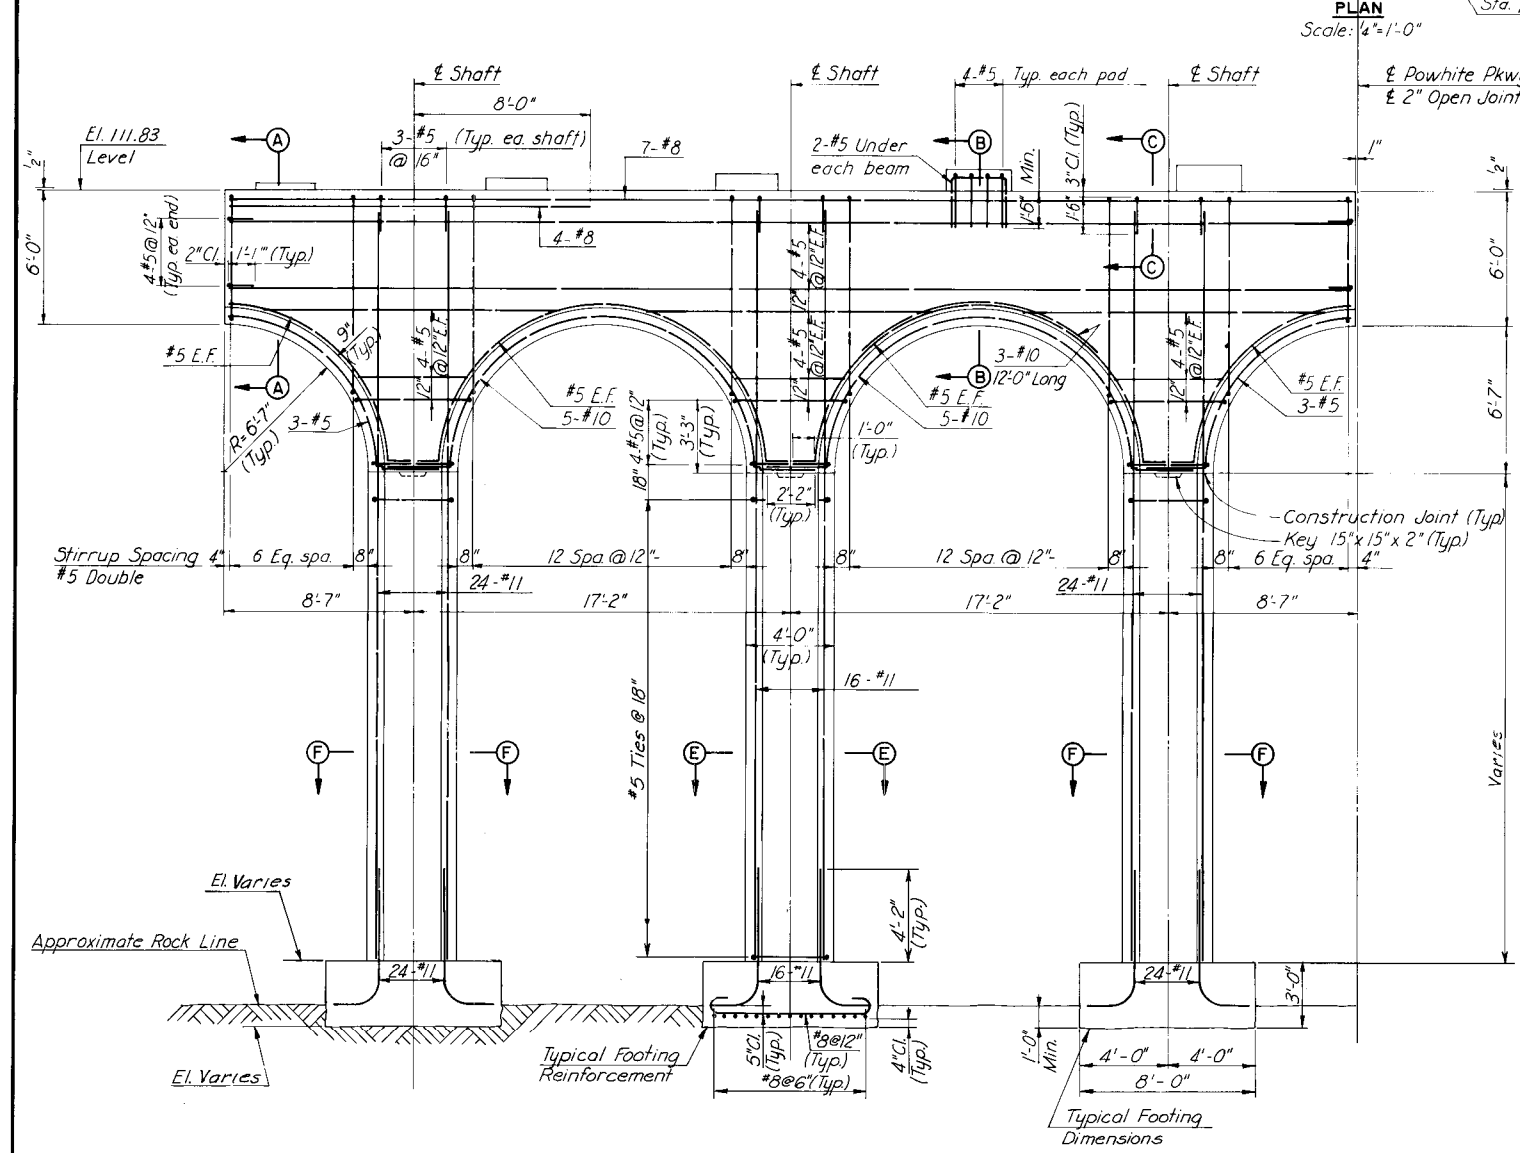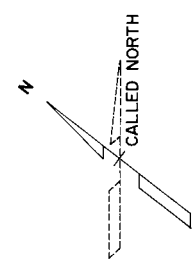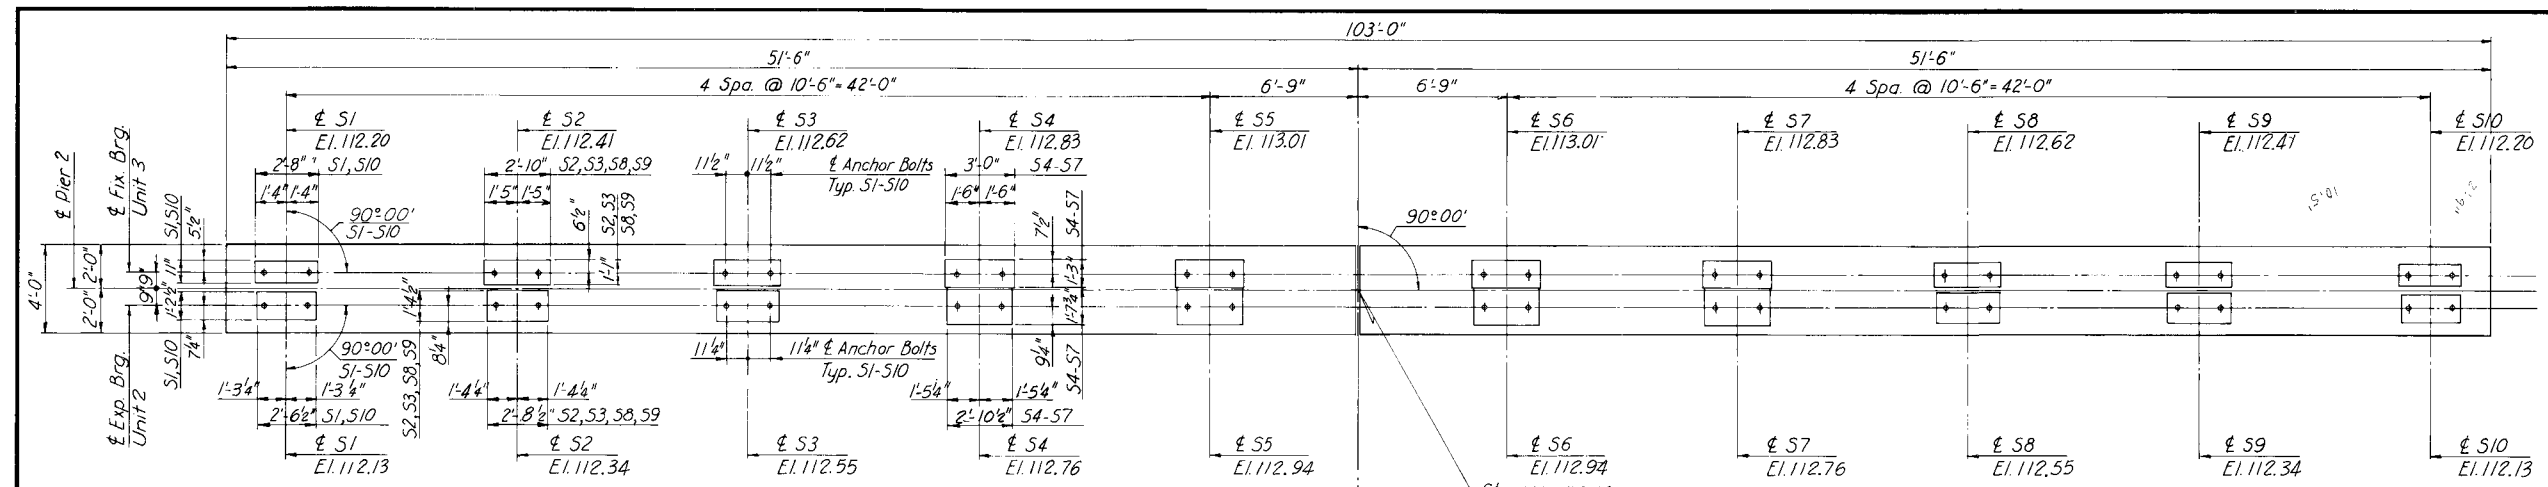

FOOTING NO.	TOP ELEV.	AVE. BOTTOM ELEV.	STEM LENGTH
2 LW	82.81	78.95	16.44
2 CW	84.21	80.62	15.04
2 RW	81.24	77.77	18.01
2 LE	81.81	78.30	17.44
2 CE	81.17	77.33	18.08
2 RE	80.36	76.84	18.89

Note:
Pier symmetrical about
Powhite Pkwy.

NOTES:
Pier foundations are designed for an allowable bearing pressure of 10 Tons/S.F.








BY	DATE	AS BUILT	JRC	12-72
MADE	L.B.P.	7-67	2	AS BUILT
CHECKED	FXH	2-68	Complete	H.B.W.
IN CHARGE	FXH	NO.	REVISION	BY DATE

RICHMOND METROPOLITAN AUTHORITY
RICHMOND EXPRESSWAY SYSTEM





JAMES RIVER BRIDGE
PIER 2

HOWARD, NEEDLES, TAMMEN & BERGENDOFF
consulting engineers
NEW YORK ALEXANDRIA KANSAS CITY

SCALE: AS SHOWN
CONTRACT NO. C-3
SHEET NO. 10 OF 53

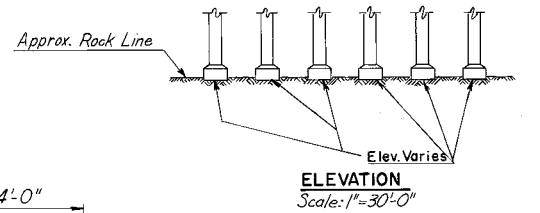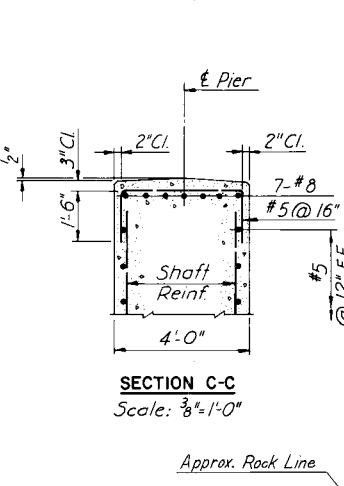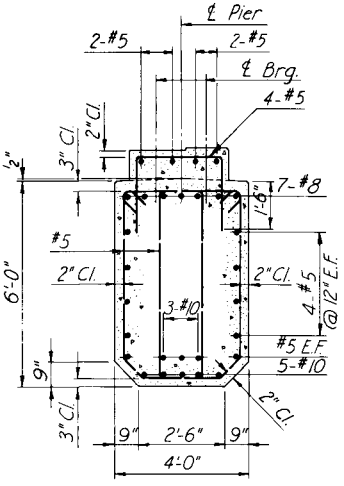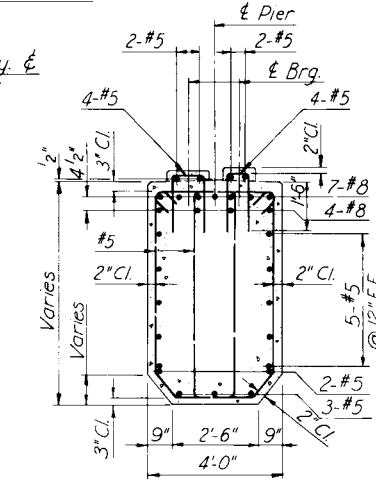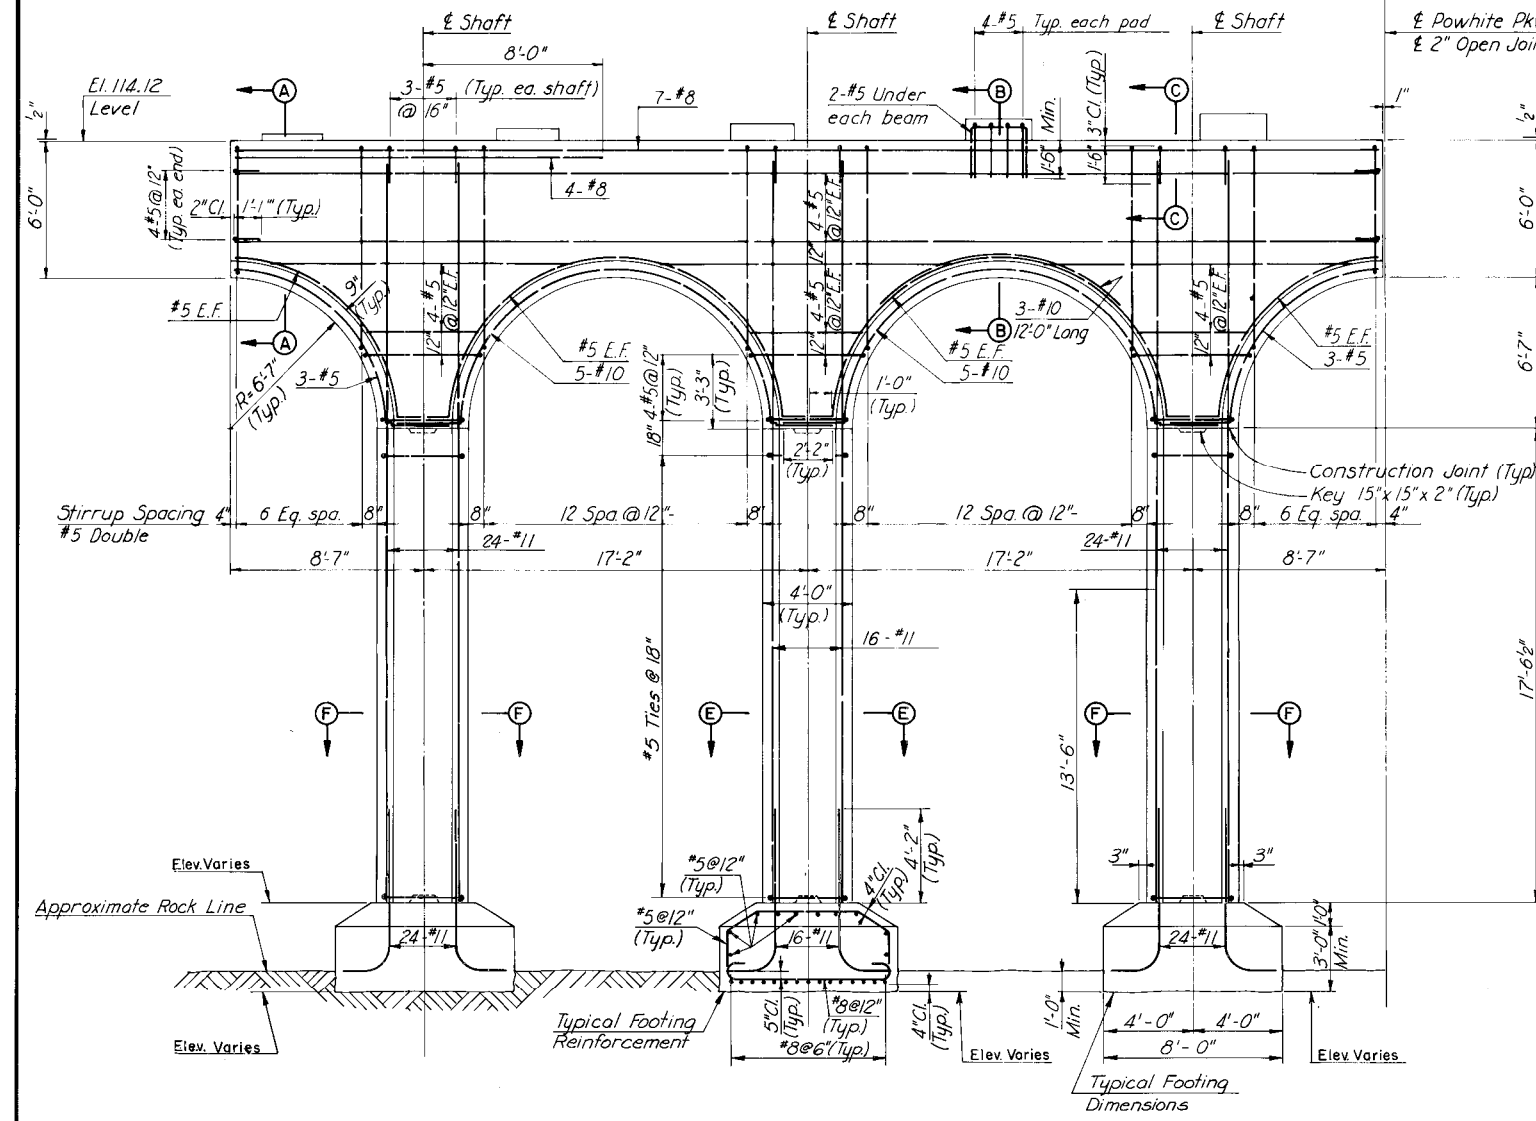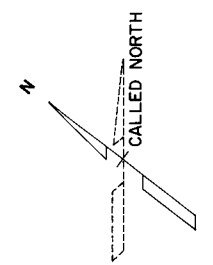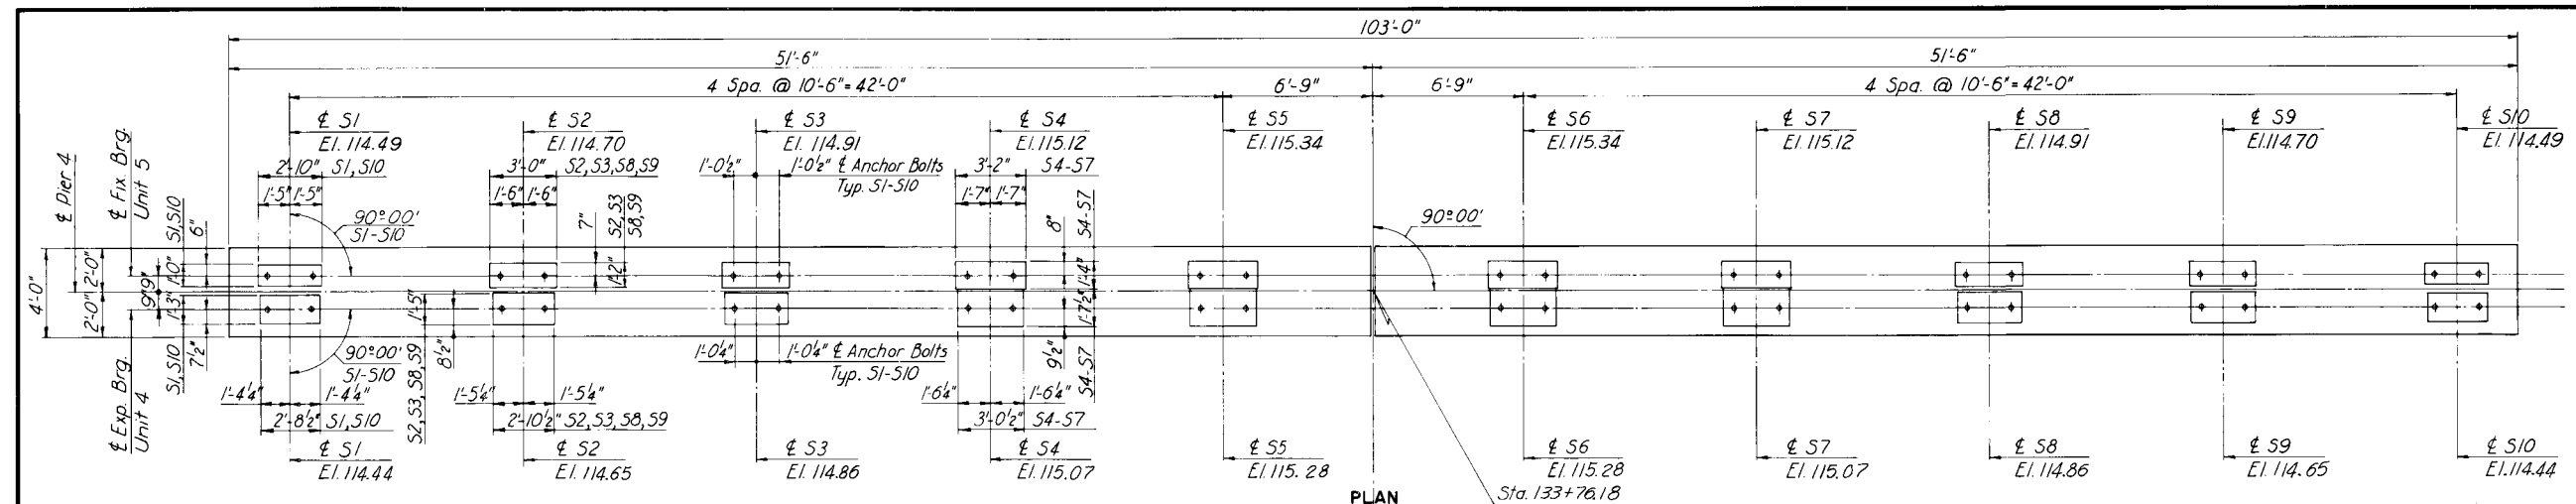

FOOTING NO.	AVE. BOTTOM ELEV.
4 L W	77.83
4 C W	77.24
4 R W	77.57
4 L E	77.86
4 C E	77.79
4 R E	77.93

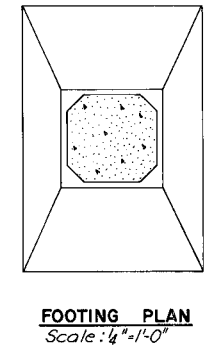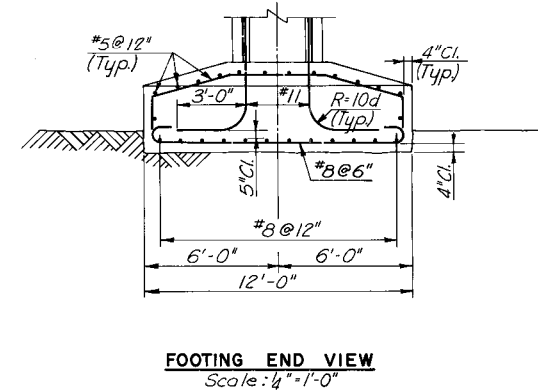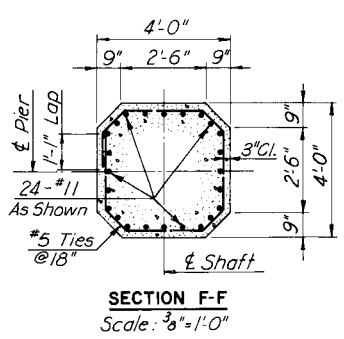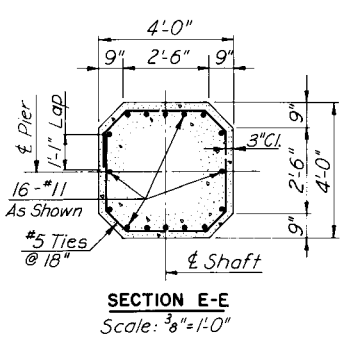

NOTES:

Pier foundations are designed for an allowable bearing pressure of 10 Tons/S.F.


RICHMOND METROPOLITAN AUTHORITY
RICHMOND EXPRESSWAY SYSTEM
JAMES RIVER BRIDGE
PIER 4

HOWARD, NEEDLES, TAMMEN & BERGENDOFF
 consulting engineers
 NEW YORK ALEXANDRIA KANSAS CITY

SCALE: AS SHOWN
 CONTRACT NO.: C-3
 SHEET NO. 13 OF 53

BY	DATE	NO.	REVISION	BY	DATE
MADE	L.B.P. 7-67	2	AS BUILT	JRC	12-72
CHECKED	FXH 2-68	1	Complete	J.G.V.	2-20-71
IN CHARGE	FXH				


Note:
 Pier symmetrical about
 & Powhite Pkwy. except for
 bottom of Footing Elevations.

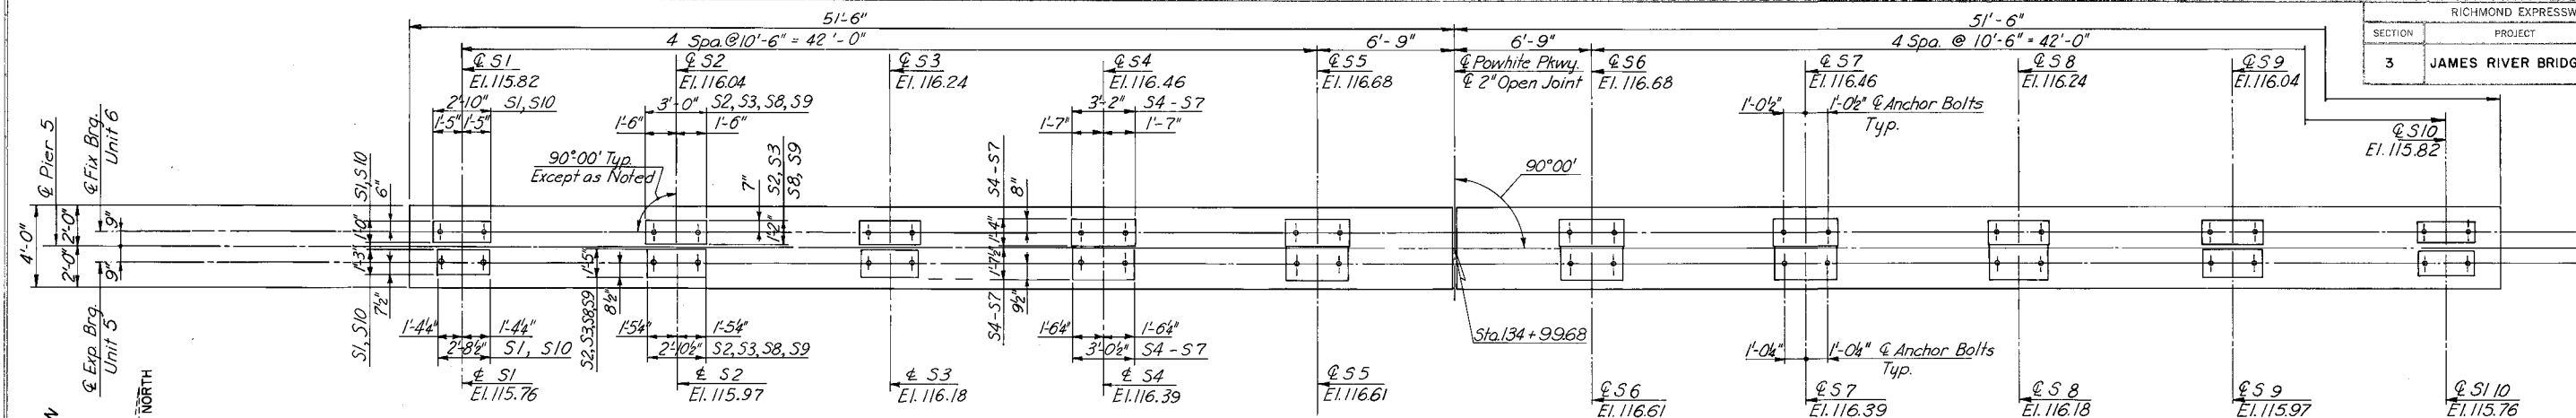



PLAN
Scale: 4"=1'-0"

FOOTING NO.	AVE. BOTTOM ELEV.
5 LW	78.56
5 CW	77.78
5 RW	77.24
5 LE	76.23
5 CE	77.57
5 RE	76.71


Symm. about C-S5 except for bottom of Ftg. Elevations

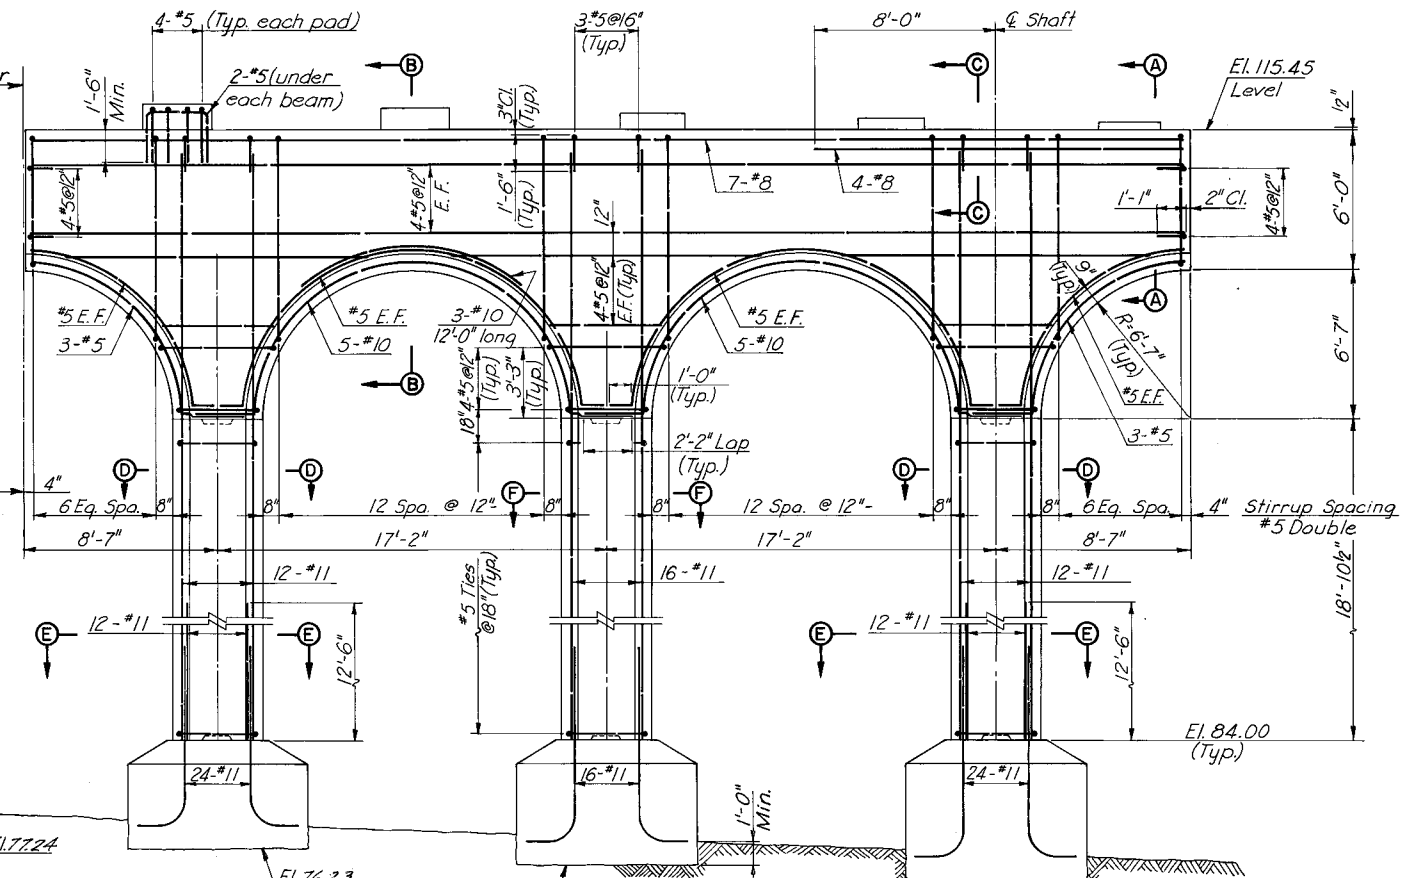


ELEVATION
Scale: 4"=1'-0"

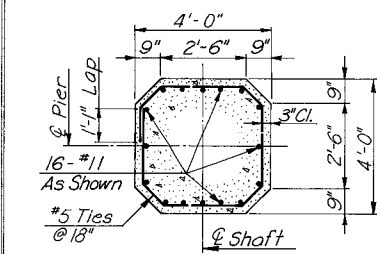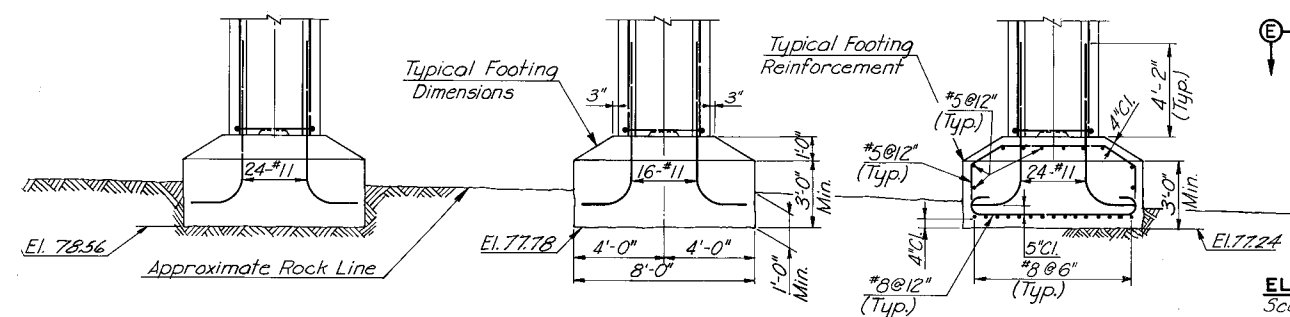


SECTION F-F
Scale: 3/8"=1'-0"

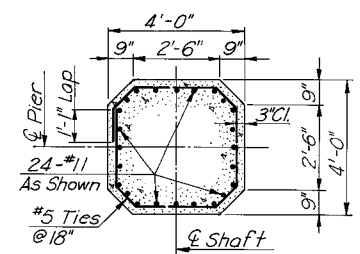


SECTION E-E
Scale: 3/8"=1'-0"

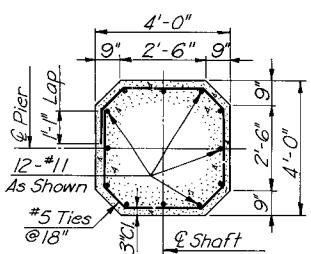


SECTION D-D
Scale: 3/8"=1'-0"

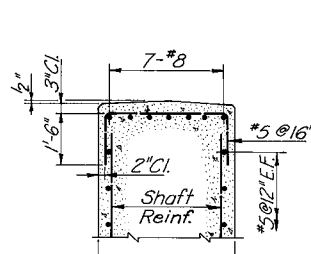


SECTION C-C
Scale: 3/8"=1'-0"

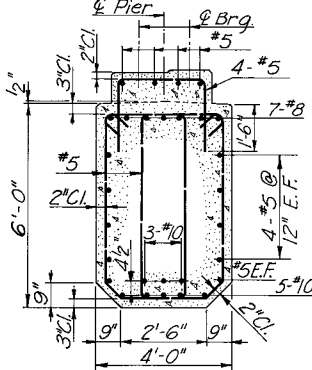

SECTION B-B
Scale: 3/8"=1'-0"

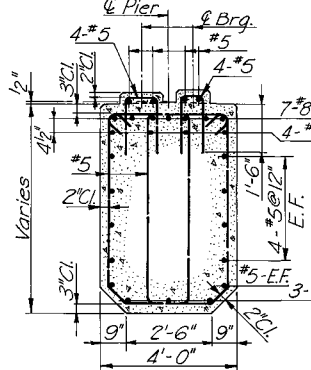

SECTION A-A
Scale: 3/8"=1'-0"

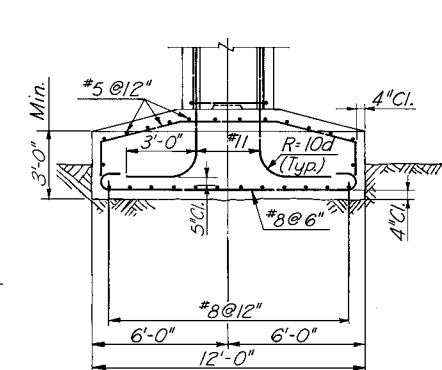

FOOTING END VIEW
Scale: 4"=1'-0"

Pier foundations are designed for an allowable bearing pressure of 10 Tons/S.F.


RICHMOND METROPOLITAN AUTHORITY
RICHMOND EXPRESSWAY SYSTEM

JAMES RIVER BRIDGE
PIER 5

HOWARD, NEEDLES, TAMMEN & BERGENDOFF
consulting engineers
NEW YORK ALEXANDRIA KANSAS CITY


SCALE: AS SHOWN
CONTRACT NO. C-3
SHEET NO. 15 OF 53

BY	DATE	NO.	REVISION	BY	DATE
MADE	HBW 11-67	2	AS BUILT	JRC	12-72
CHECKED	FXH 2-68	1	Pier made Symm. about C	ESB	2/20/71
IN CHARGE	FXH				

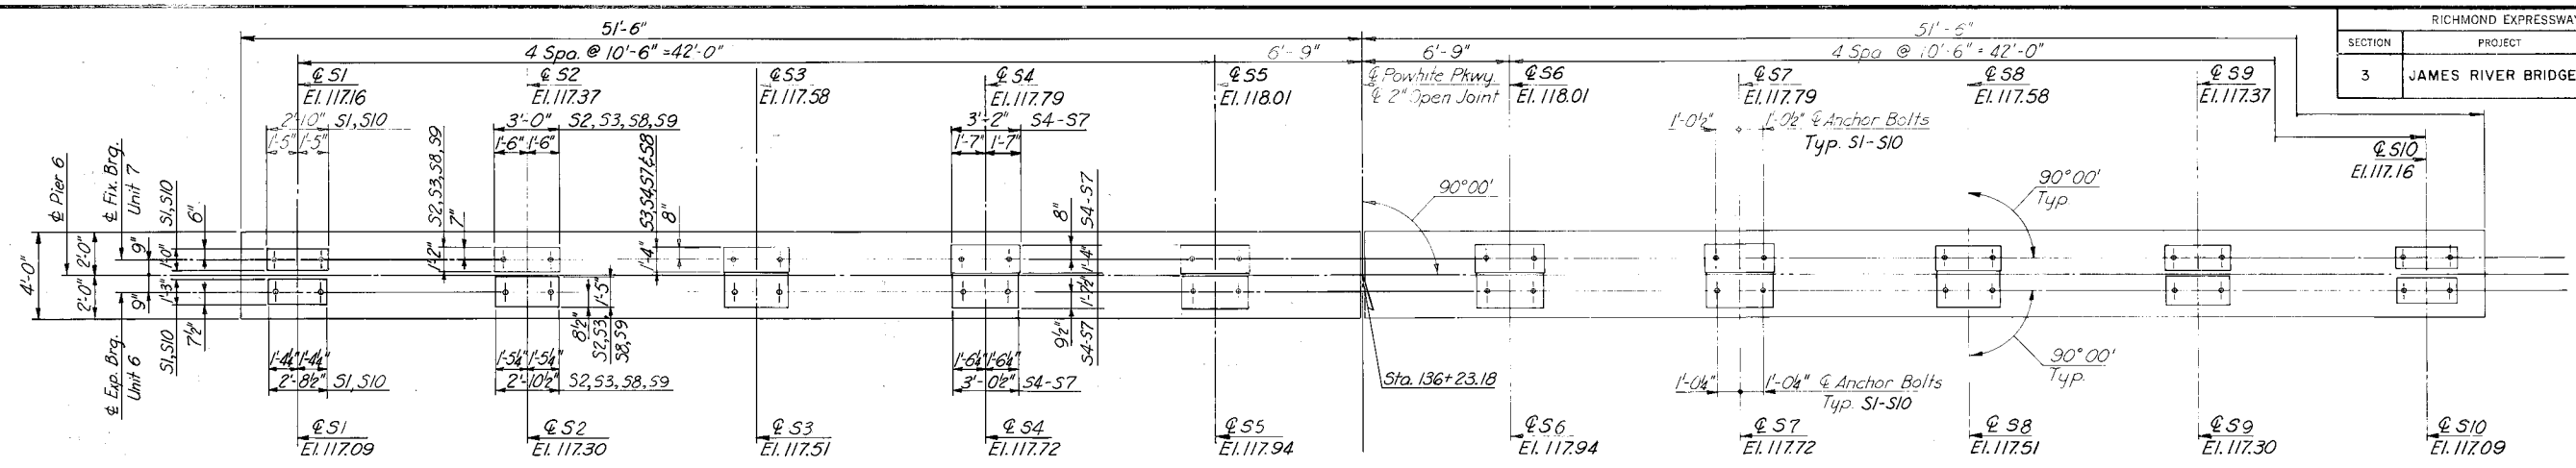

FOOTING NO.	AVE. BOTTOM ELEV.
6 L W	79.30
6 C W	79.05
6 R W	79.90
6 L E	79.02
6 C E	78.36
6 R E	78.36


PLAN
Scale: 1/4"=1'-0"

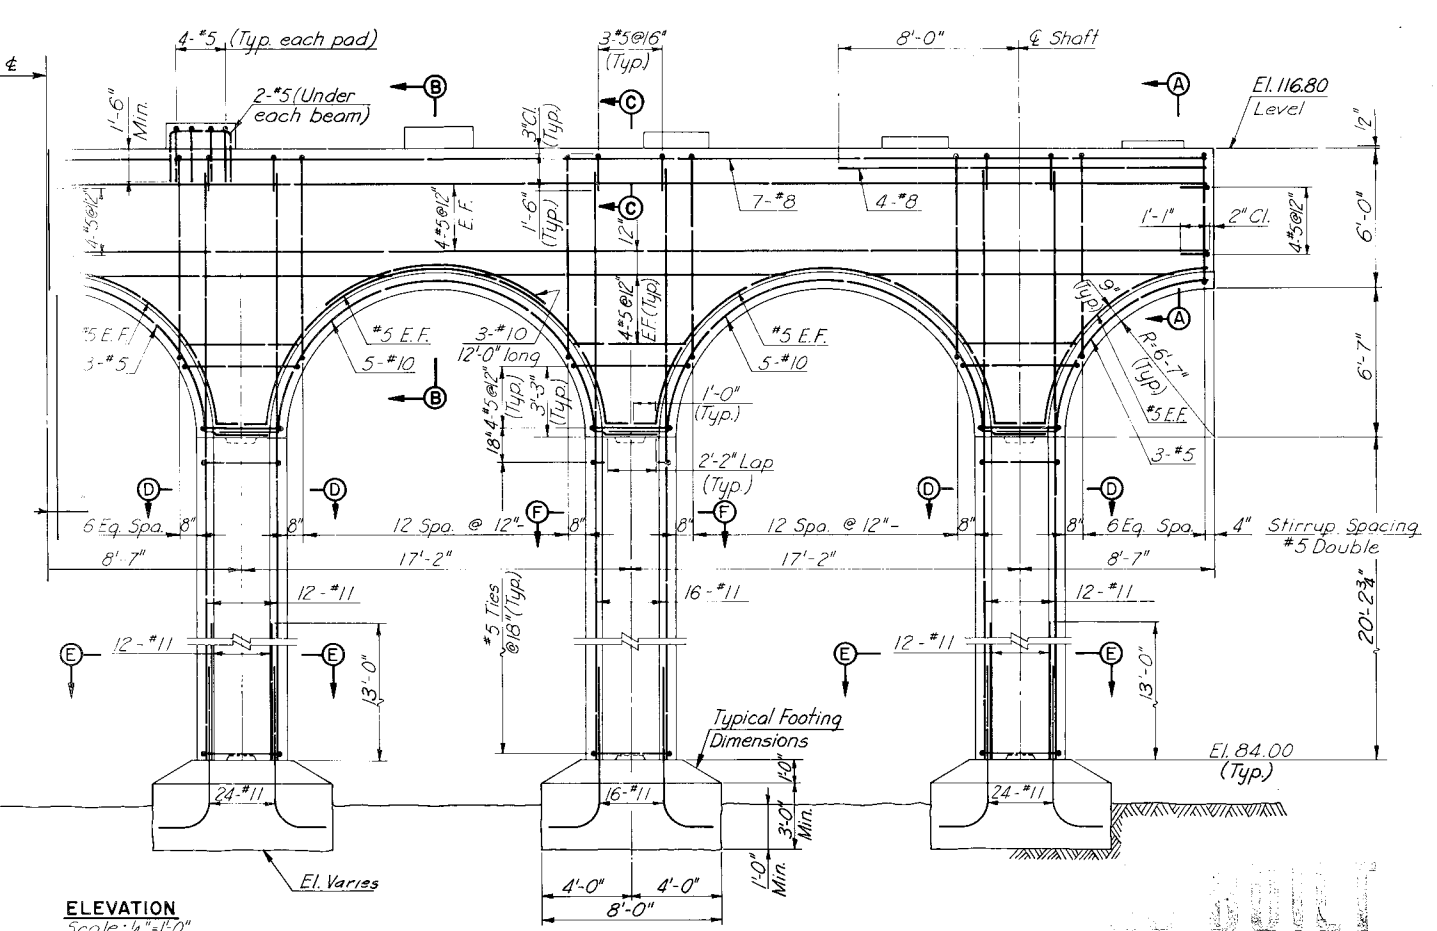


ELEVATION
Scale: 1/4"=1'-0"

NOTES:


Pier foundations are designed for an allowable bearing pressure of 10 Tons/S.F.

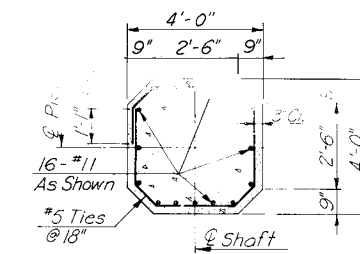


SECTION F-F
Scale: 3/8"=1'-0"

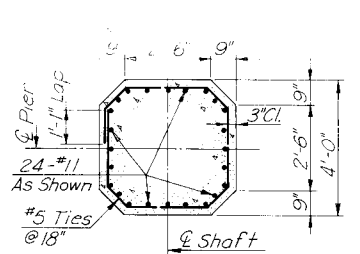


SECTION E-E
Scale: 3/8"=1'-0"

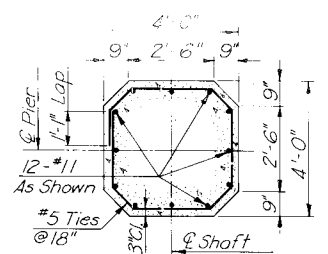


SECTION D-D
Scale: 3/8"=1'-0"

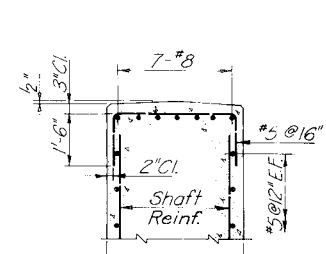


SECTION C-C
Scale: 3/8"=1'-0"

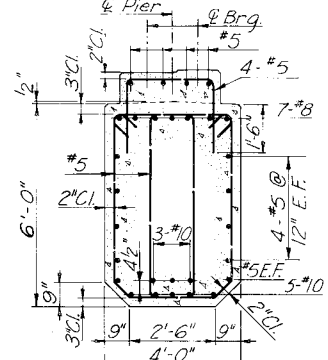

SECTION B-B
Scale: 3/8"=1'-0"

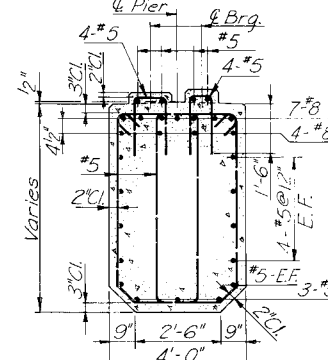

SECTION A-A
Scale: 3/8"=1'-0"

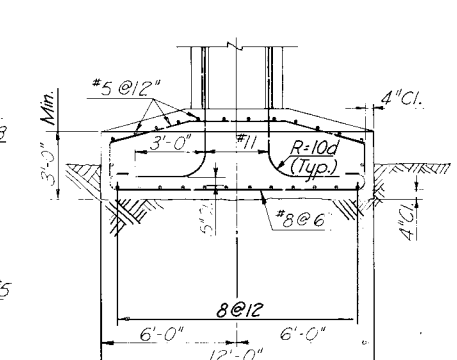

FOOTING END VIEW
Scale: 1/4"=1'-0"

BY	DATE	NO.	REVISION	BY	DATE
MADE	HBW	11-67	2 AS BUILT	JRC	12-72
CHECKED	FXH	2-68	1 Pier Symm. about C	J.G.V.	2-20-71
IN CHARGE	FXH				






RICHMOND METROPOLITAN AUTHORITY
RICHMOND EXPRESSWAY SYSTEM

JAMES RIVER BRIDGE
PIER 6

HOWARD, NEEDLES, TAMMEN & BERGENDOFF
consulting engineers
NEW YORK ALEXANDRIA KANSAS CITY

SCALE: AS SHOWN
CONTRACT NO. C-3
SHEET NO. 16 OF 53

RICHMOND EXPRESSWAY SYSTEM			
SECTION	PROJECT	SHEET NO.	TOTAL SHEETS
3	JAMES RIVER BRIDGE	18	53

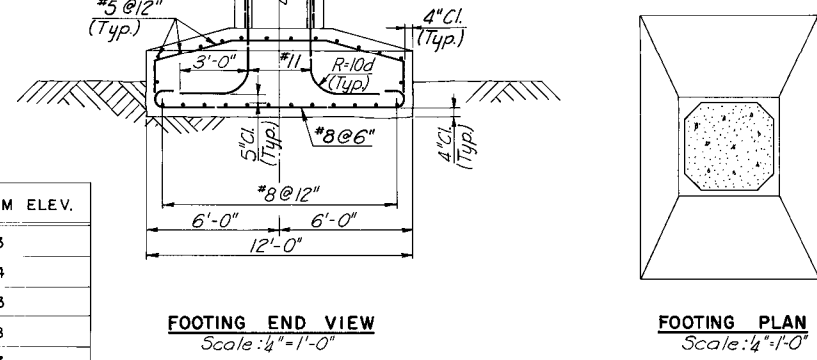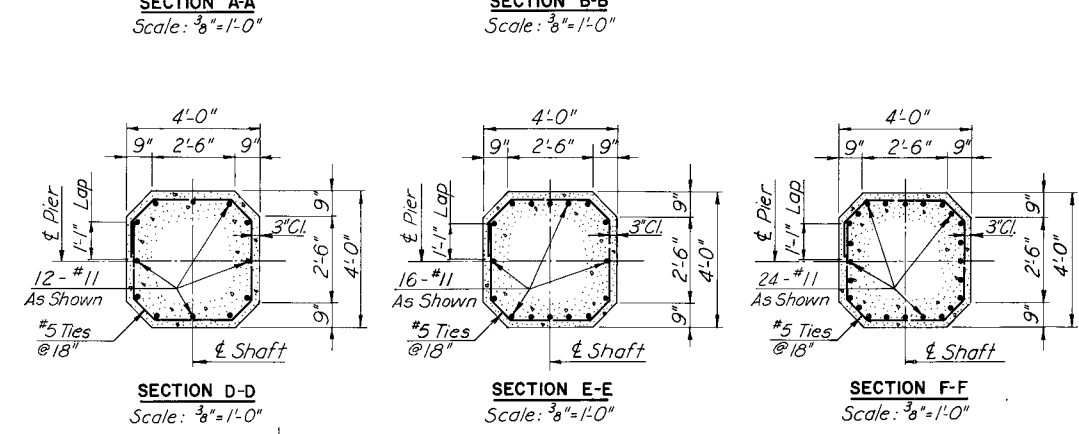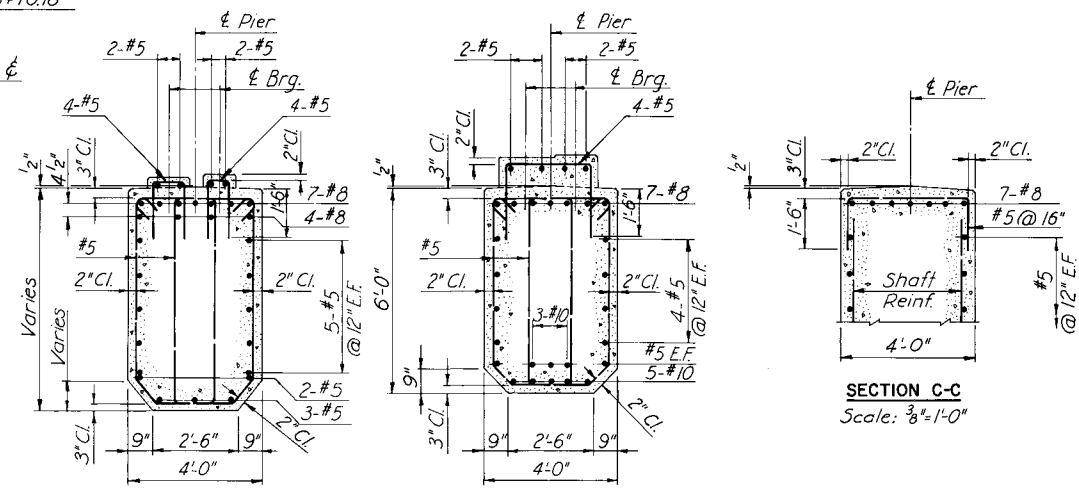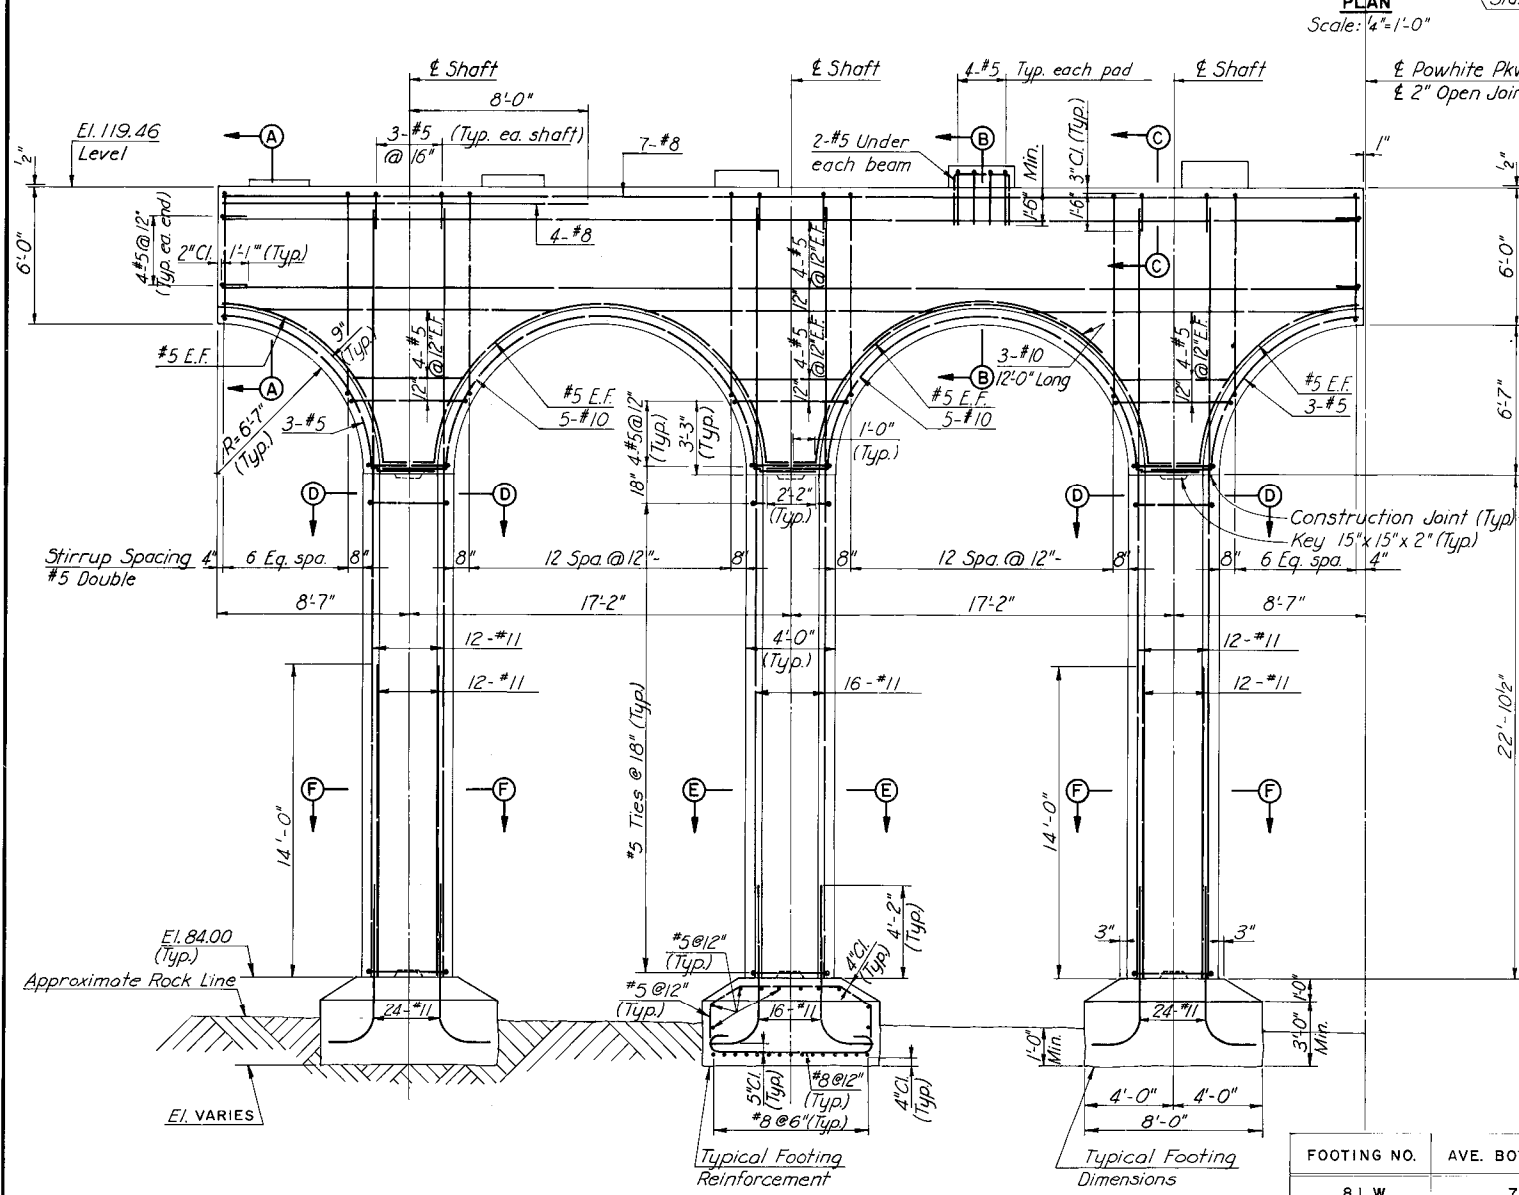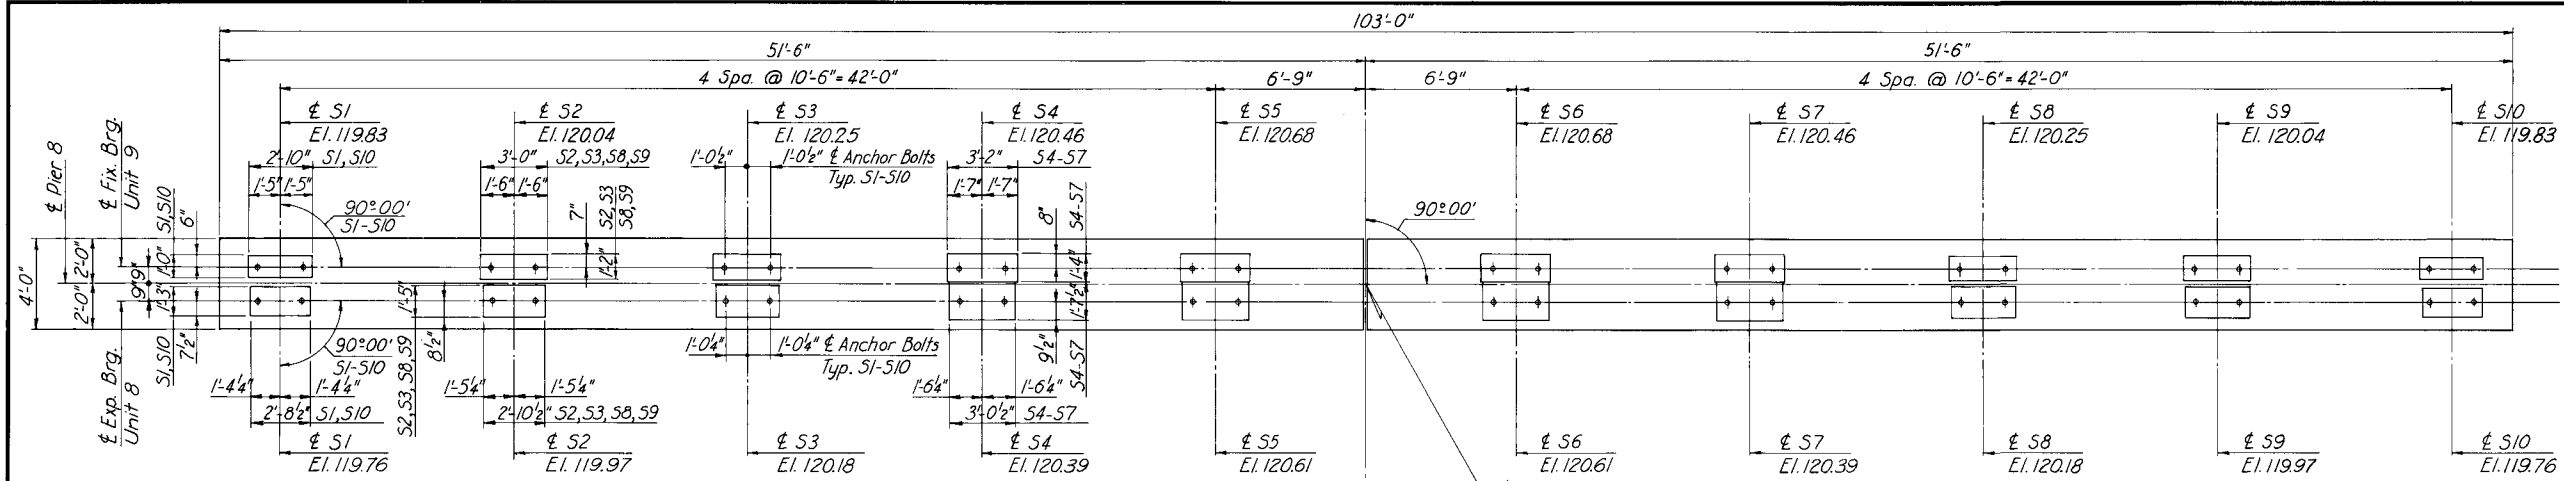

FOOTING NO.	AVE. BOTTOM ELEV.
8LW	79.3
8CW	78.4
8RW	78.3
8LE	76.8
8CE	76.7
8RE	74.4

HALF ELEVATION
Scale: 1/4"=1'-0"

Note:
Pier symmetrical about
Powhite Pkwy.

NOTES:

Pier foundations are designed for an allowable bearing pressure of 10 Tons/5.F.

RICHMOND METROPOLITAN AUTHORITY
RICHMOND EXPRESSWAY SYSTEM





JAMES RIVER BRIDGE
PIER 8

HOWARD, NEEDLES, TAMMEN & BERGENDOFF
consulting engineers
NEW YORK ALEXANDRIA KANSAS CITY



SCALE: AS SHOWN
CONTRACT NO. C-3
SHEET NO. 18 OF 53

MADE	BY	DATE			
CHECKED	FXH	2-68	1	AS BUILT	JRC 12-72
IN CHARGE	FXH		NO.	REVISION	BY DATE

RICHMOND EXPRESSWAY SYSTEM			
SECTION	PROJECT	SHEET NO.	TOTAL SHEETS
3	JAMES RIVER BRIDGE	20	53

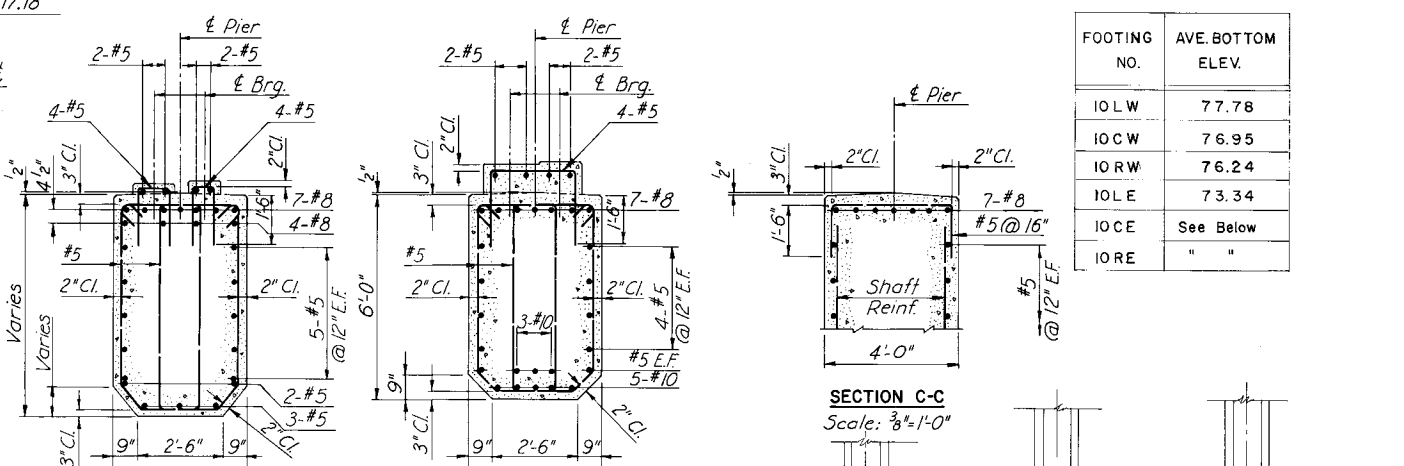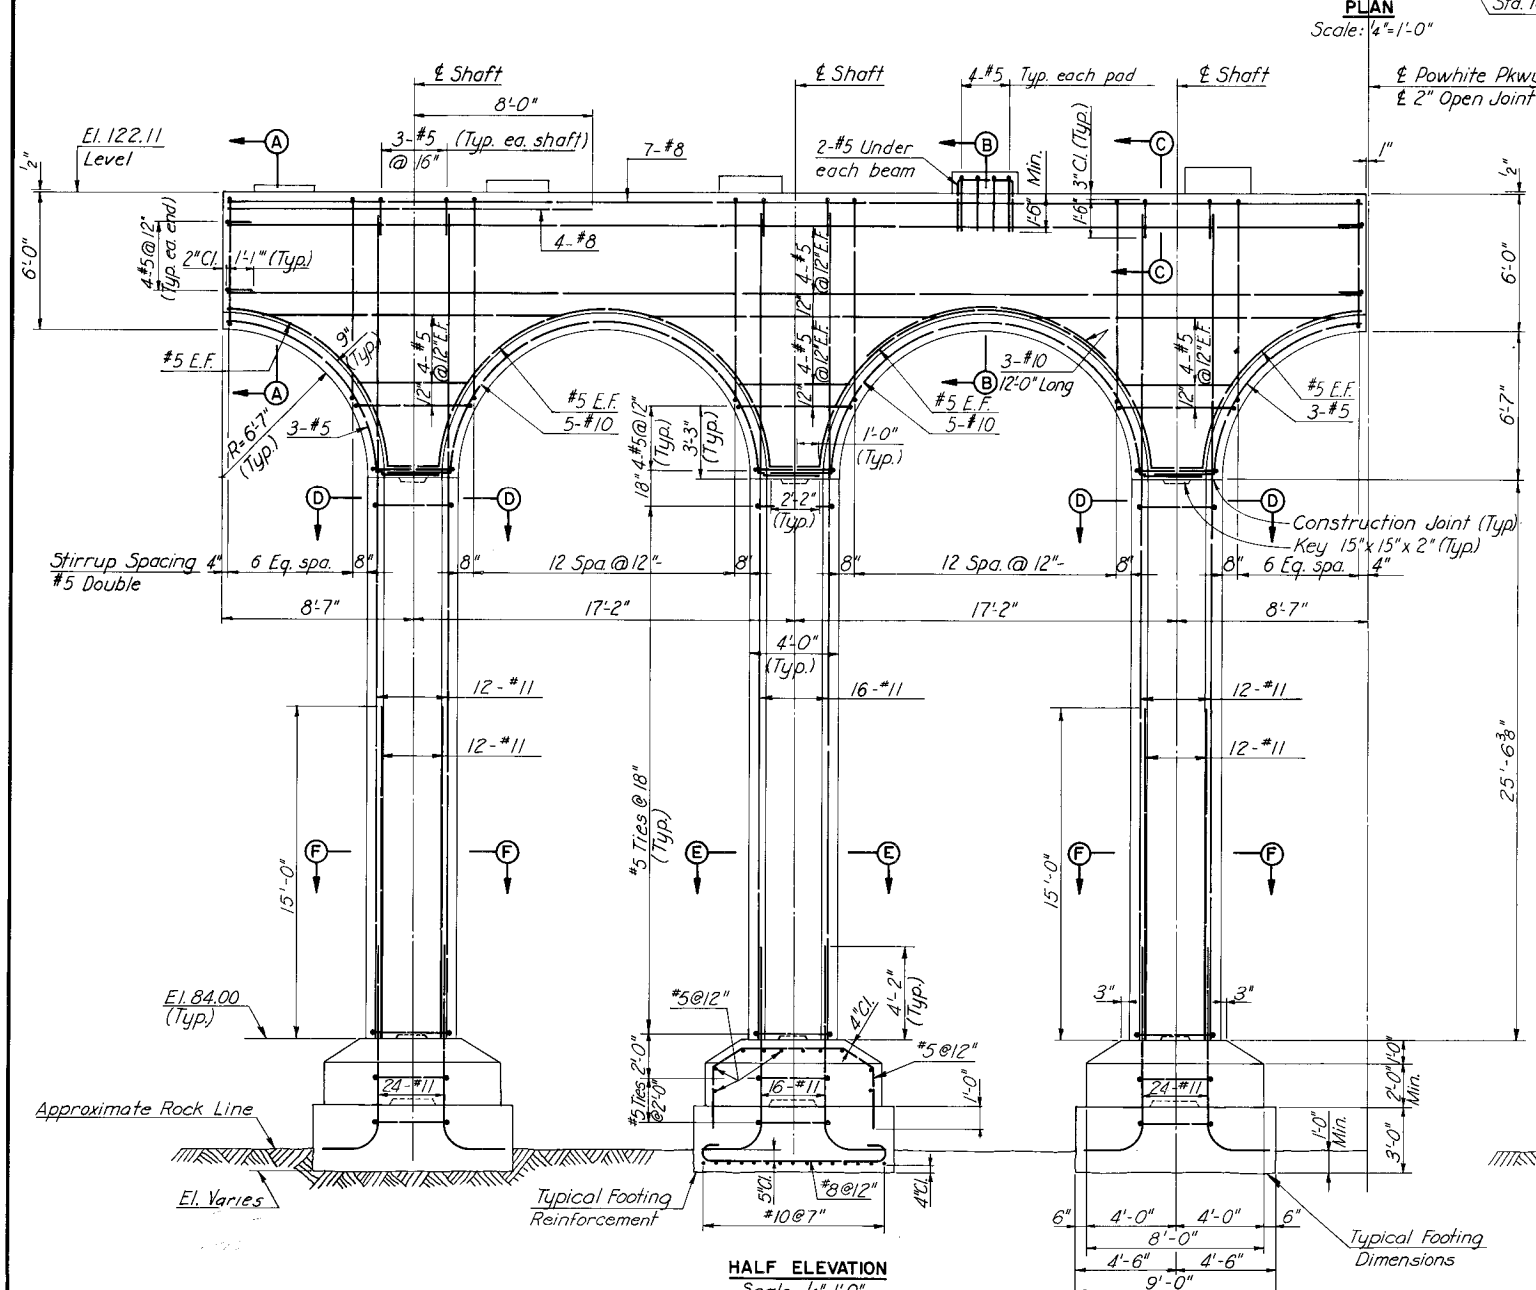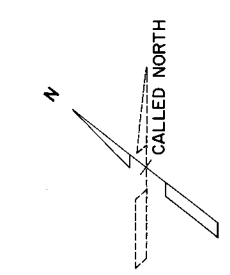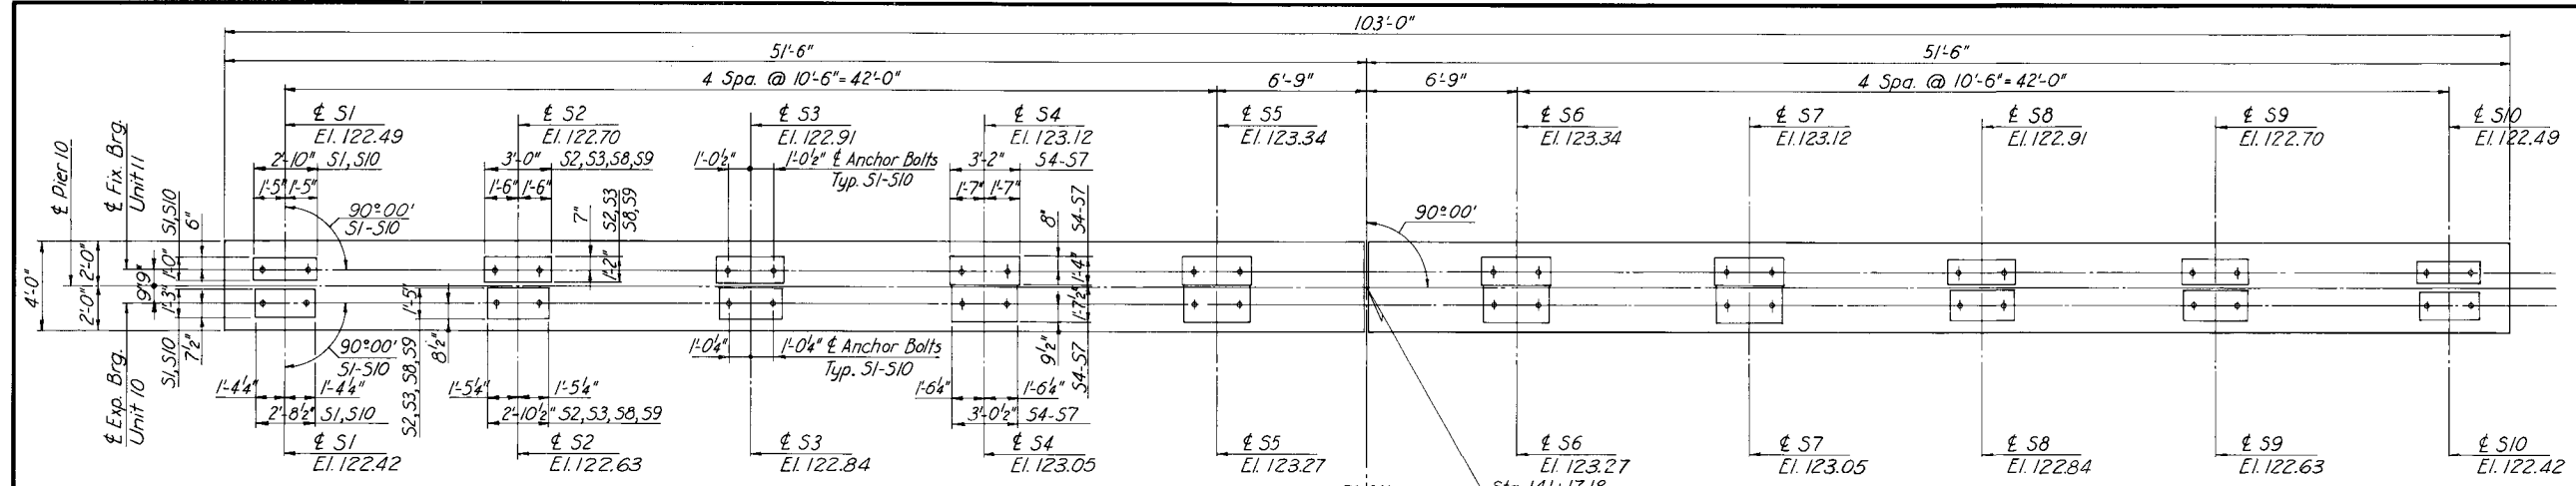

FOOTING NO.	AVE. BOTTOM ELEV.
10LW	77.78
10CW	76.95
10RW	76.24
10LE	73.34
10CE	See Below
10RE	" "

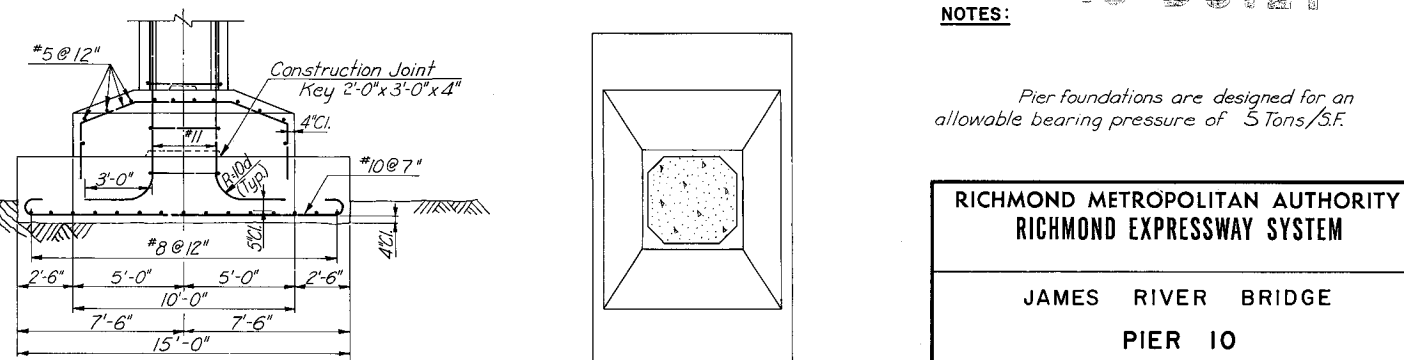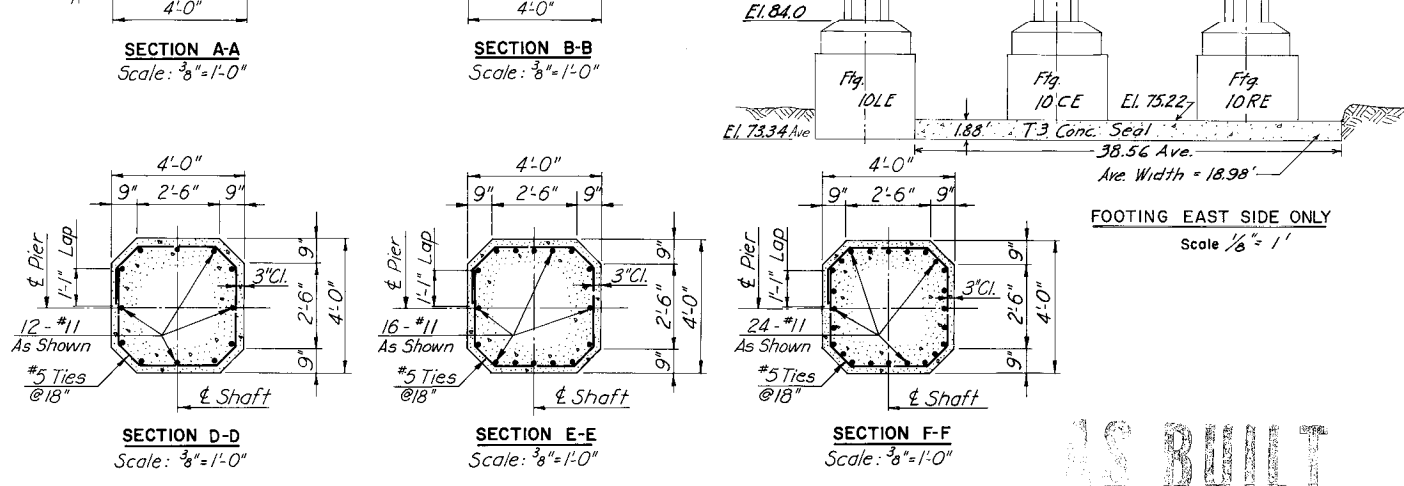

NOTES:
Pier foundations are designed for an allowable bearing pressure of 5 Tons/S.F.

RICHMOND METROPOLITAN AUTHORITY
RICHMOND EXPRESSWAY SYSTEM

JAMES RIVER BRIDGE
PIER 10






HOWARD, NEEDLES, TAMMEN & BERGENDOFF
consulting engineers
NEW YORK ALEXANDRIA KANSAS CITY

SCALE: AS SHOWN
CONTRACT NO.: C-3
SHEET NO. 20 OF 53

BY	DATE	NO.	REVISION	BY	DATE
MADE	HBW	7-67			
CHECKED	FXH	2-68	1	AS BUILT	JRC 12-72
IN CHARGE	FXH				

Note:
Pier symmetrical about & Powhite Pkwy.

RICHMOND EXPRESSWAY SYSTEM			
SECTION	PROJECT	SHEET NO.	TOTAL SHEETS
3	JAMES RIVER BRIDGE	21	53

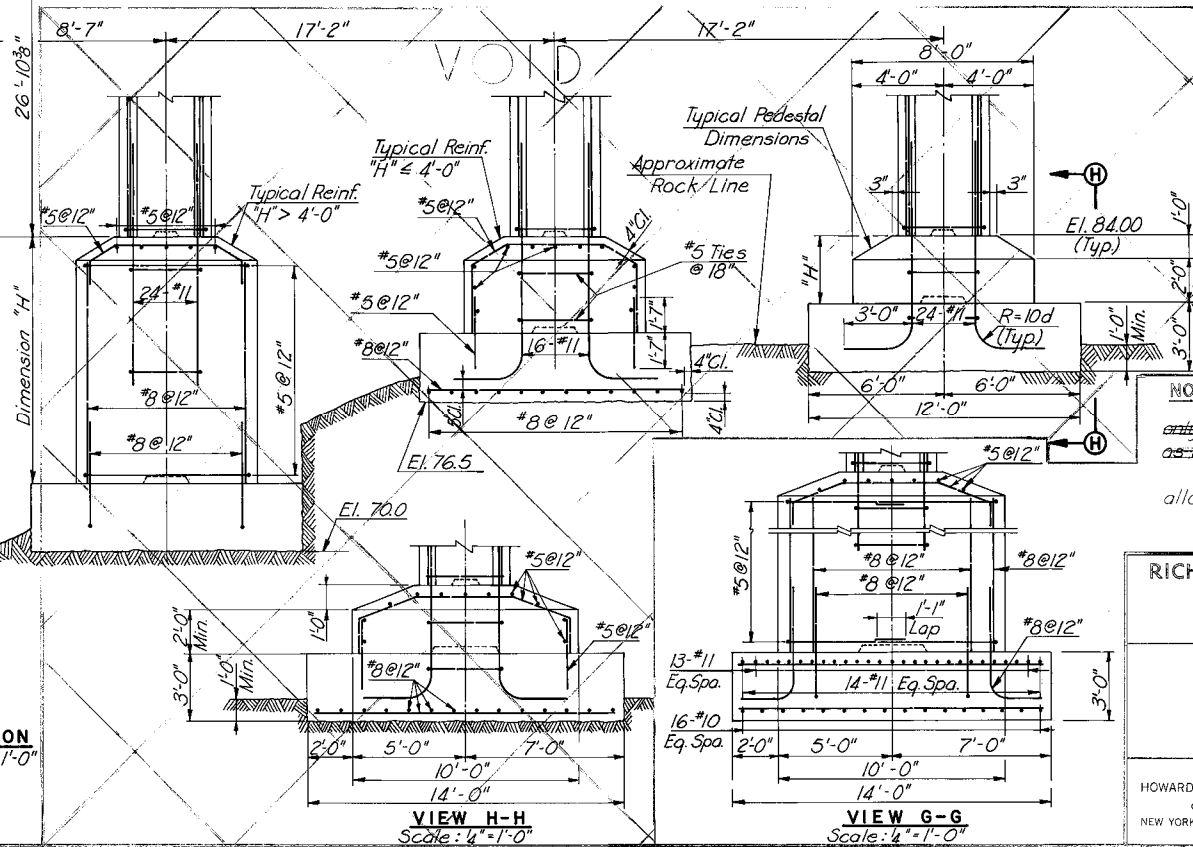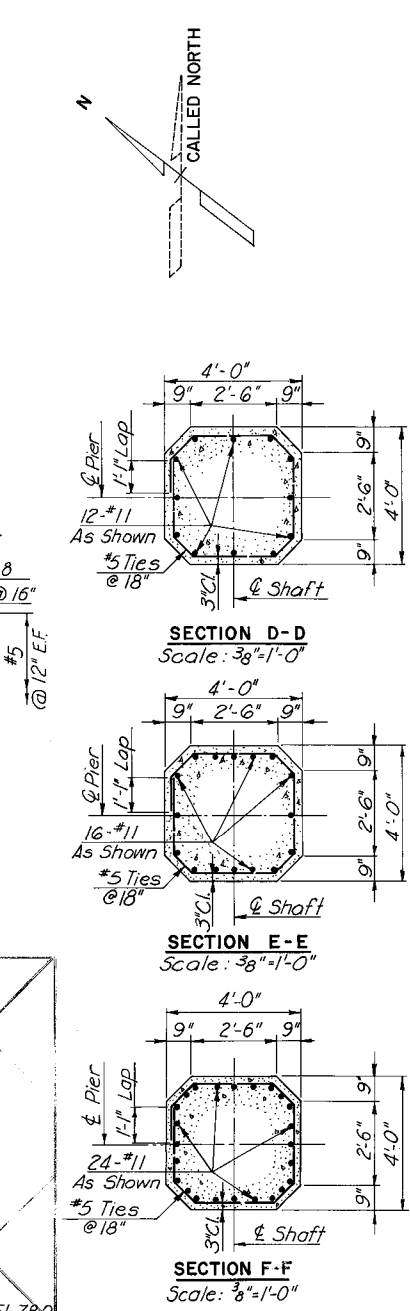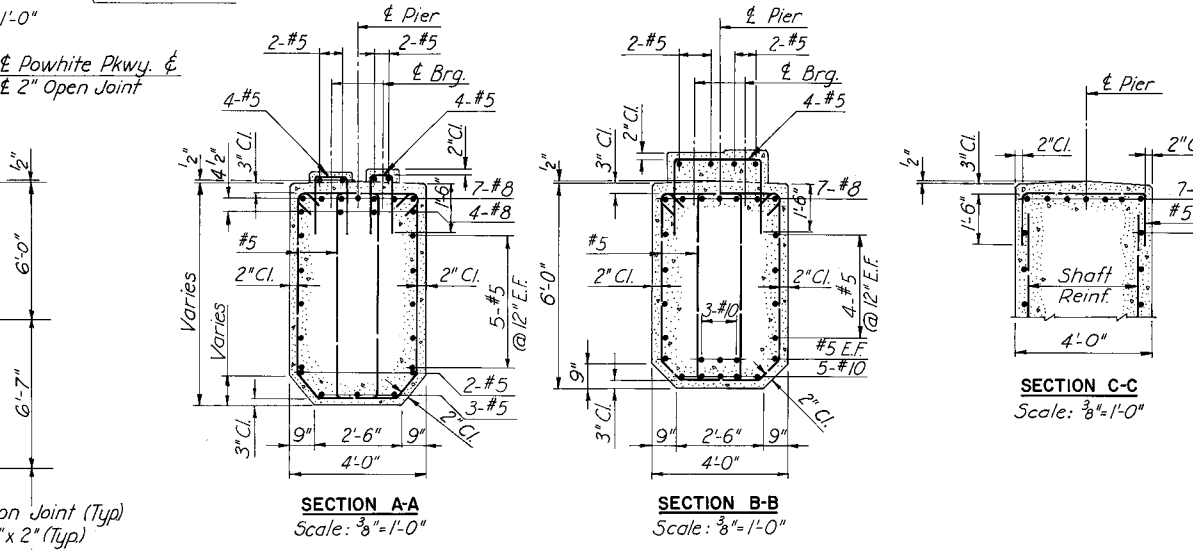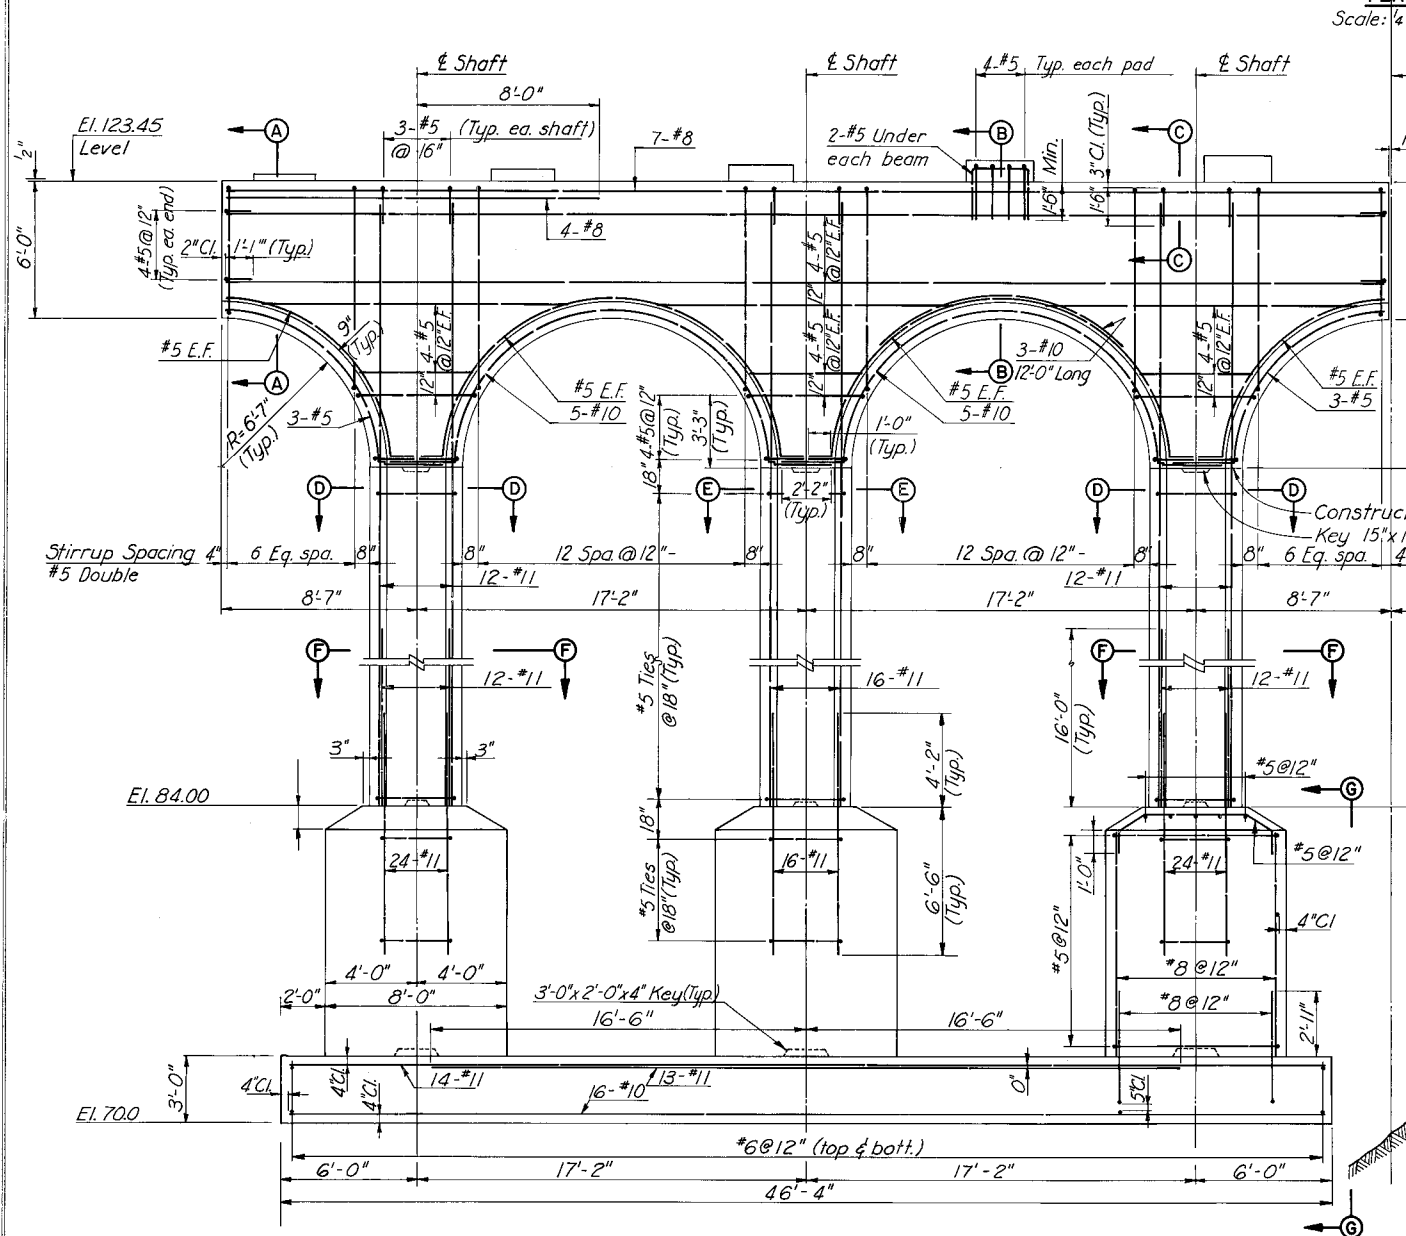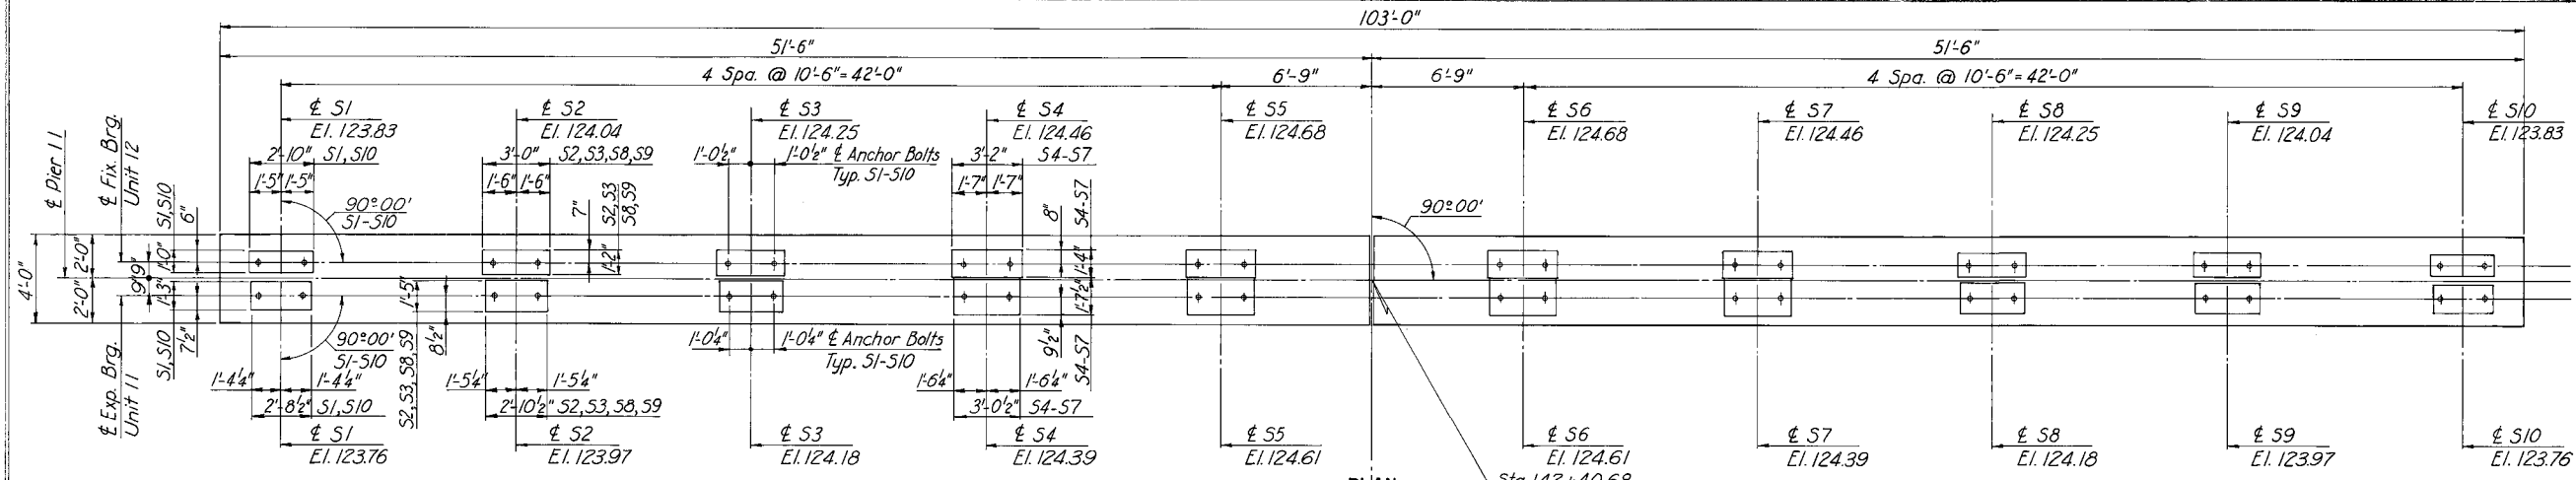

Note:
Pier symmetrical about
& Powhite Pkwy. except as shown.

NOTES:
Foundation elevations are approximate
only and may be varied to suit field conditions
as directed by the Engineer.
Pier foundations are designed for an
allowable bearing pressure of 3.5 Tons/5.F.












RICHMOND METROPOLITAN AUTHORITY
RICHMOND EXPRESSWAY SYSTEM

JAMES RIVER BRIDGE
PIER II

HOWARD, NEEDLES, TAMMEN & BERGENDOFF
consulting engineers
NEW YORK ALEXANDRIA KANSAS CITY
SCALE: AS SHOWN
CONTRACT NO. C-3
SHEET NO. 21 OF 53

BY	DATE				
MADE	L.B.P.	7-67	2	AS BUILT	JRC 12-72
CHECKED	F.X.H.	2-68	1	Elim. Sheet P1g + P1g	JRC 9-3-71
IN CHARGE	F.X.H.			REVISION	BY DATE

RICHMOND EXPRESSWAY SYSTEM			
SECTION	PROJECT	SHEET NO.	TOTAL SHEETS
3	JAMES RIVER BRIDGE	22	53

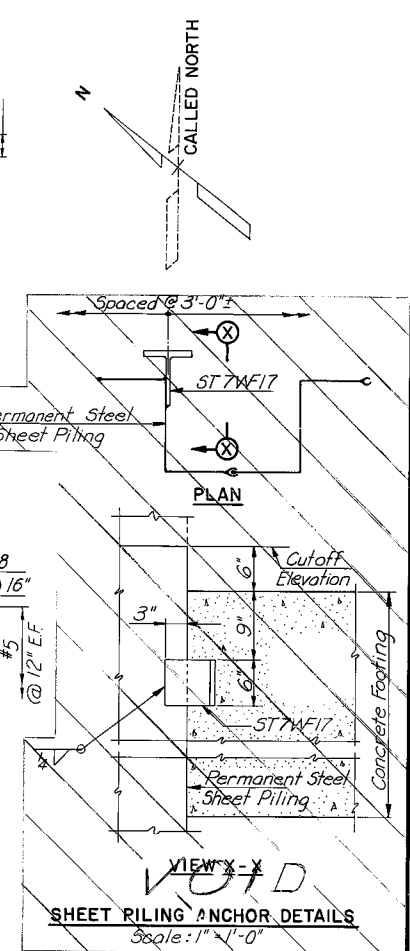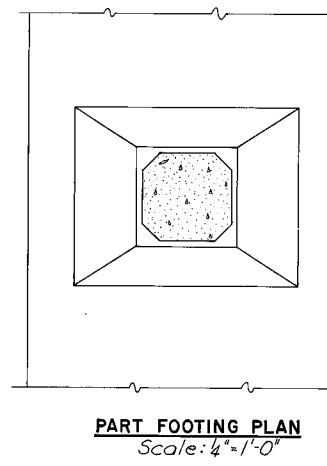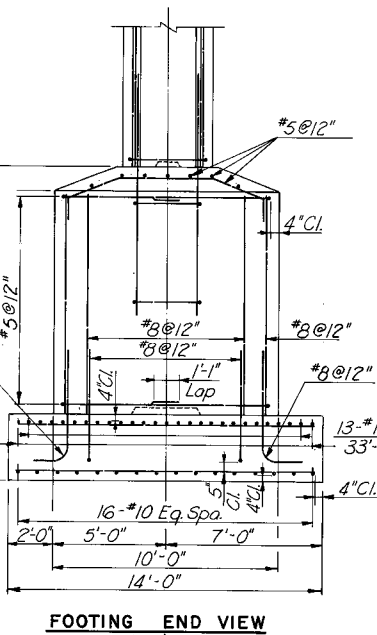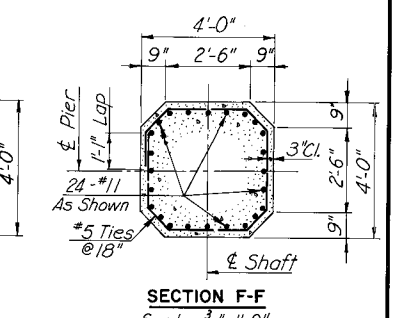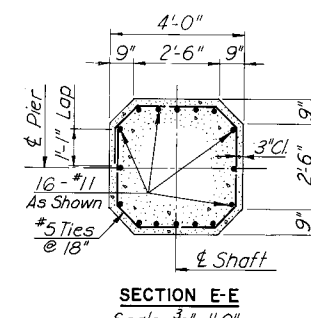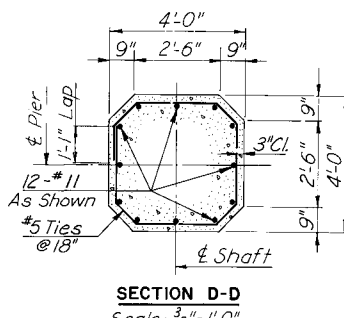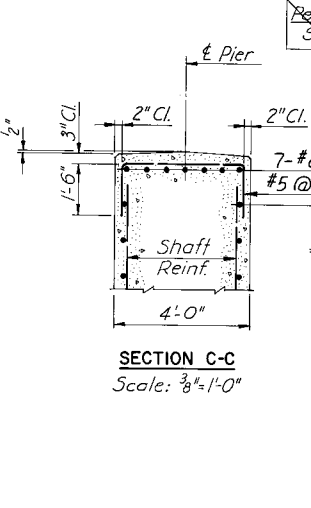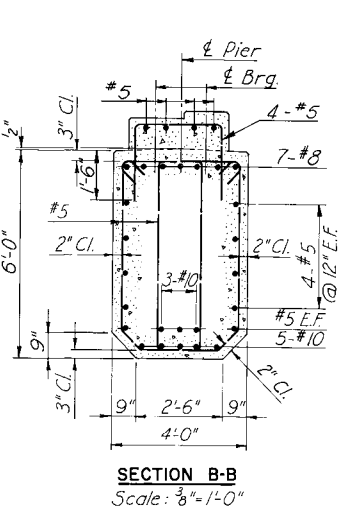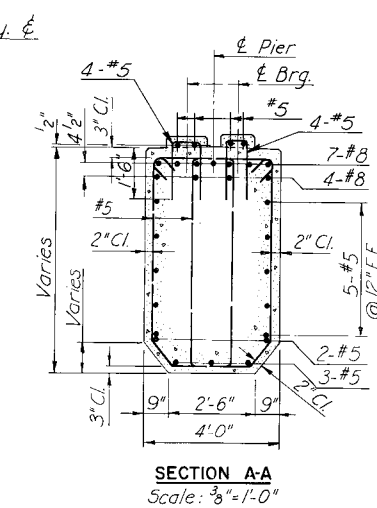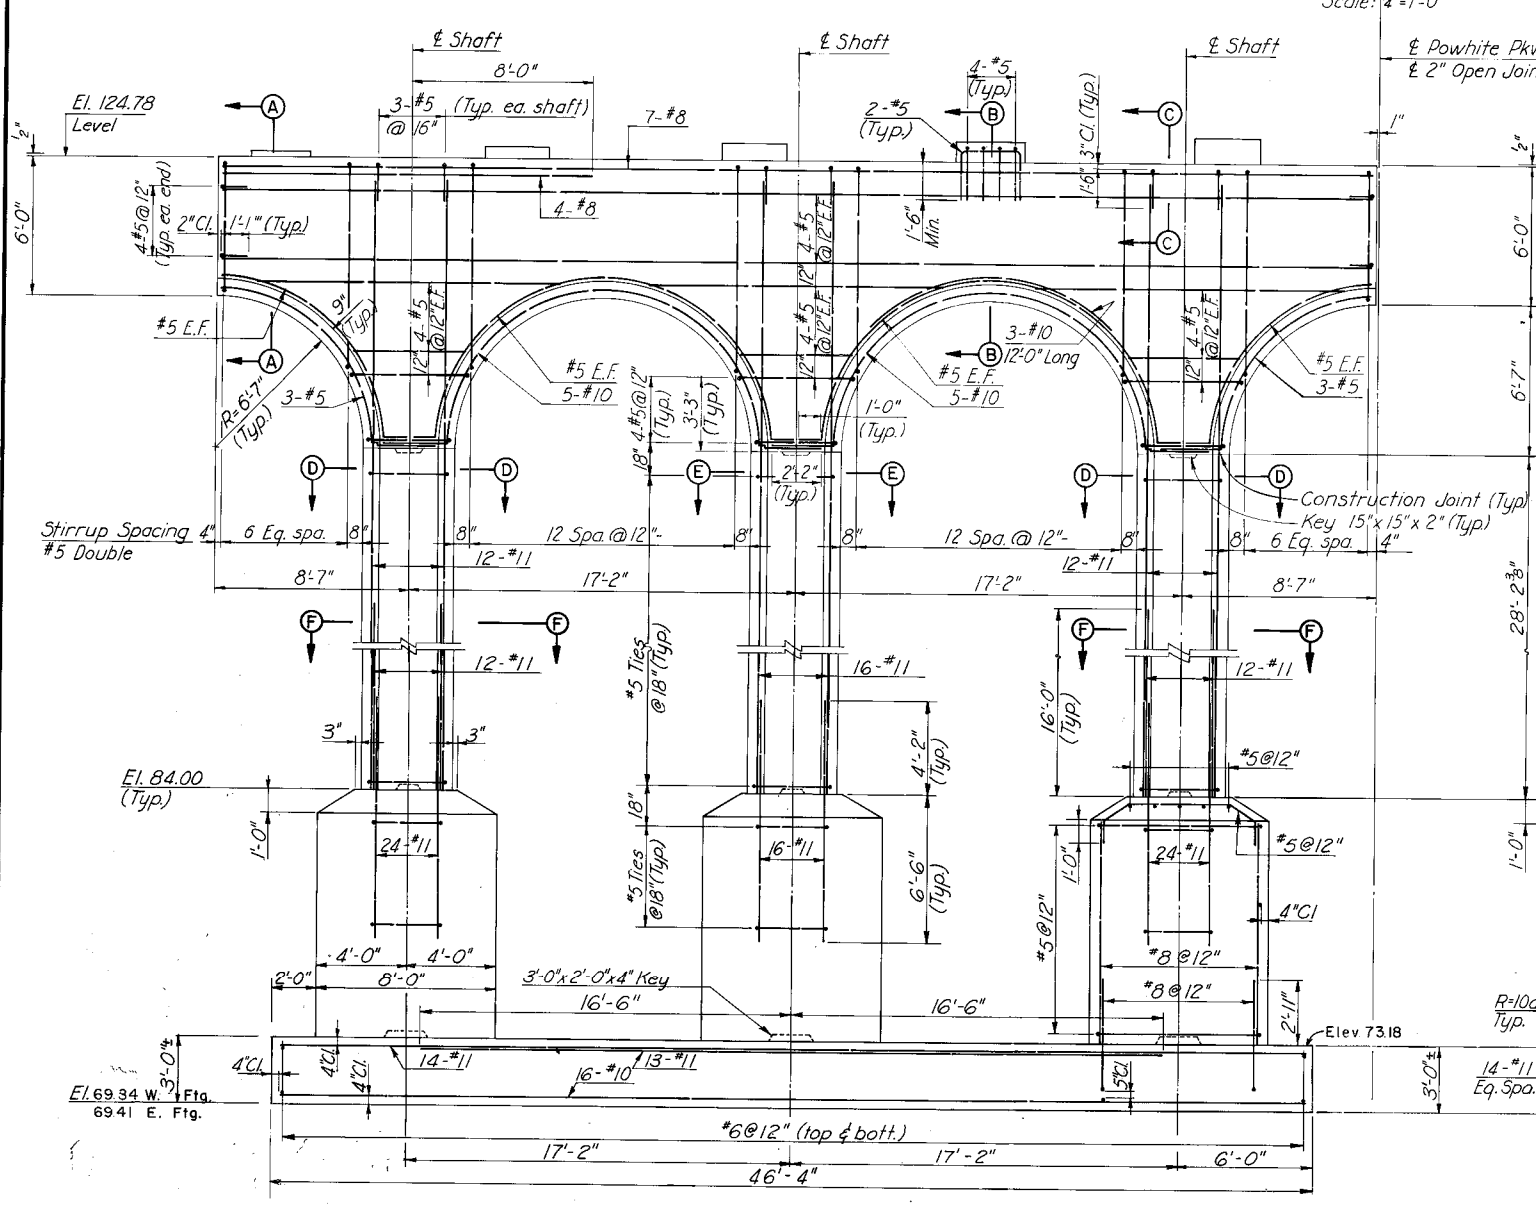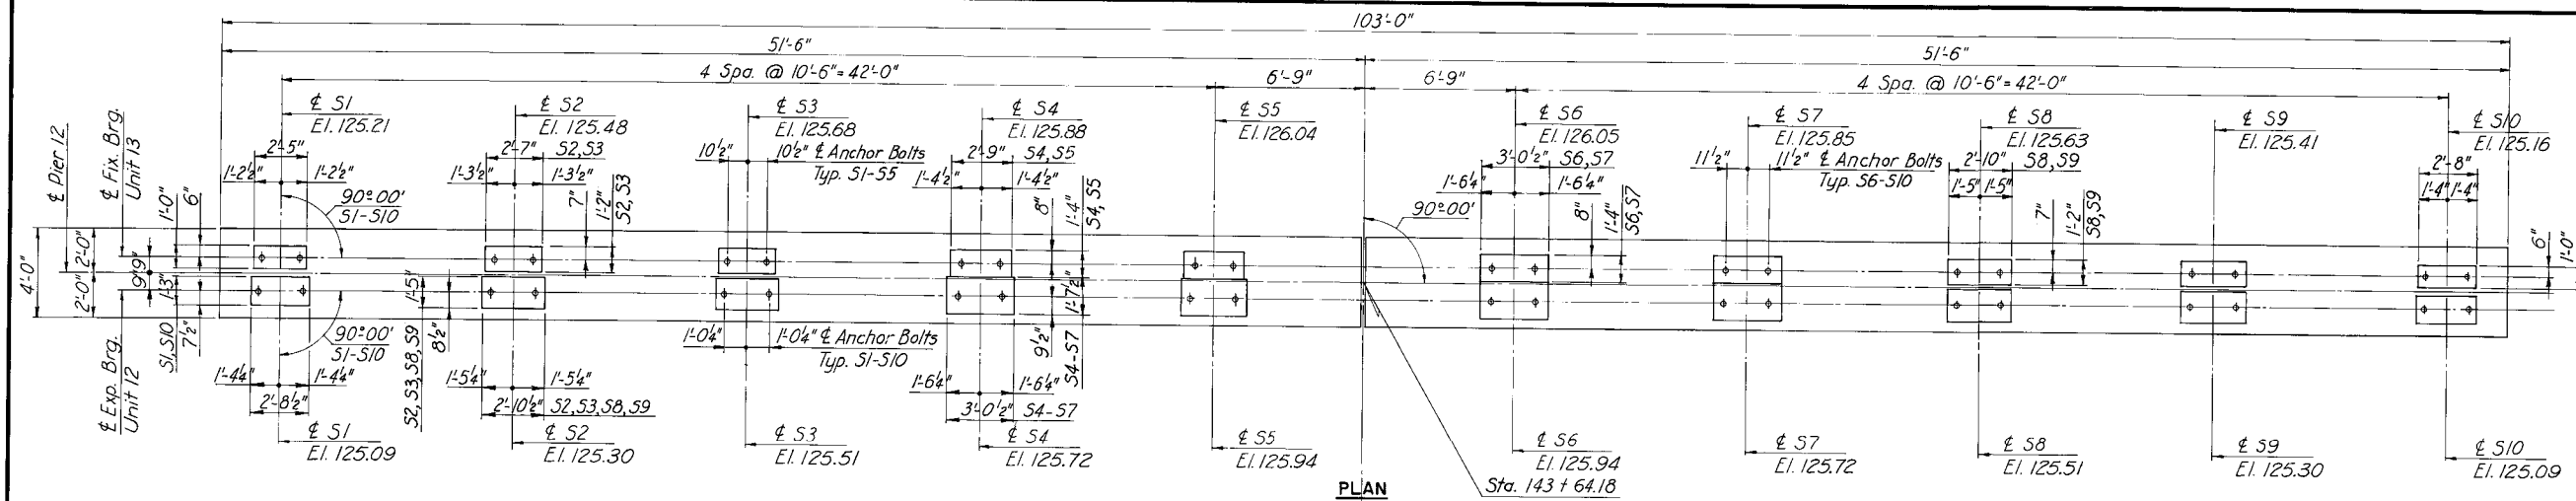

NOTES:

AS BUILT

Pier foundations are designed for an allowable bearing pressure of 3 1/2 Tons/5.F.

RICHMOND METROPOLITAN AUTHORITY
RICHMOND EXPRESSWAY SYSTEM




JAMES RIVER BRIDGE
PIER 12

HOWARD, NEEDLES, TAMMEN & BERGENDOFF
consulting engineers
NEW YORK ALEXANDRIA KANSAS CITY

SCALE: AS SHOWN
CONTRACT NO.: C-3
SHEET NO. 22 OF 53

BY	DATE	NO.	REVISION	BY	DATE
MADE	HBW	7-67			
CHECKED	FXH	3-68	AS BUILT	JRC	12-72
IN CHARGE	FXH.				

Note:
Pier symmetrical about
& Powhite Pkwy.

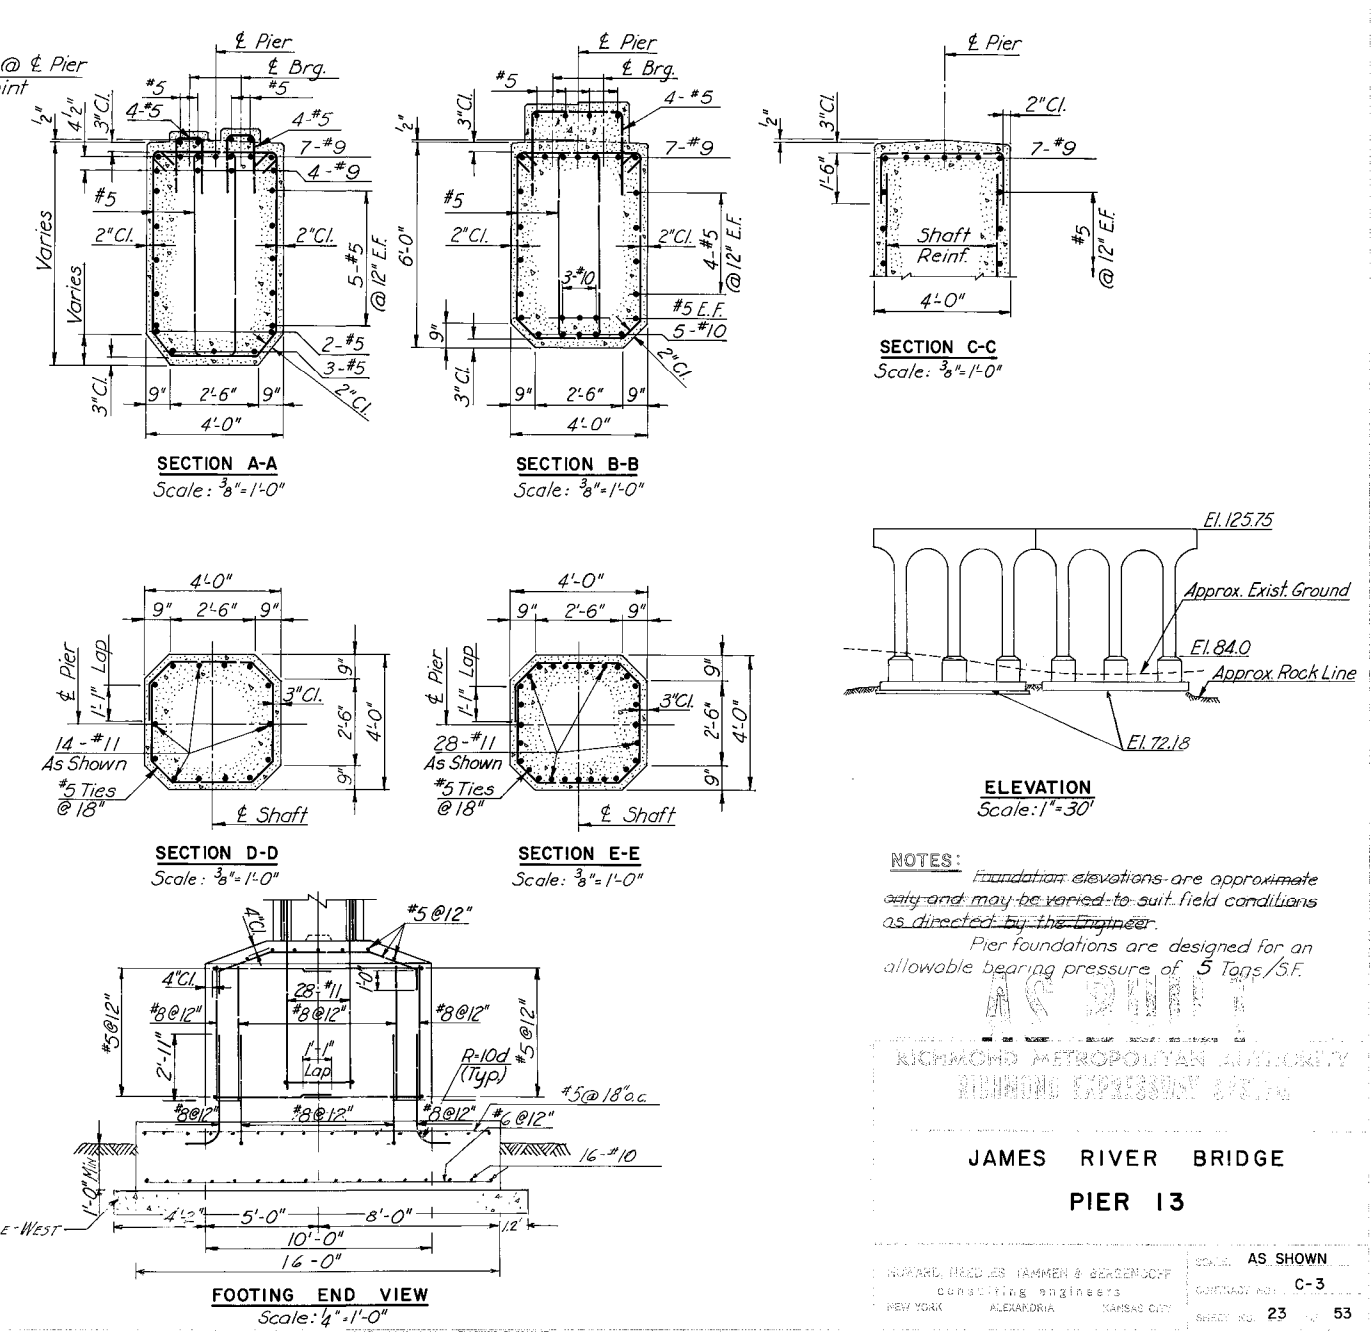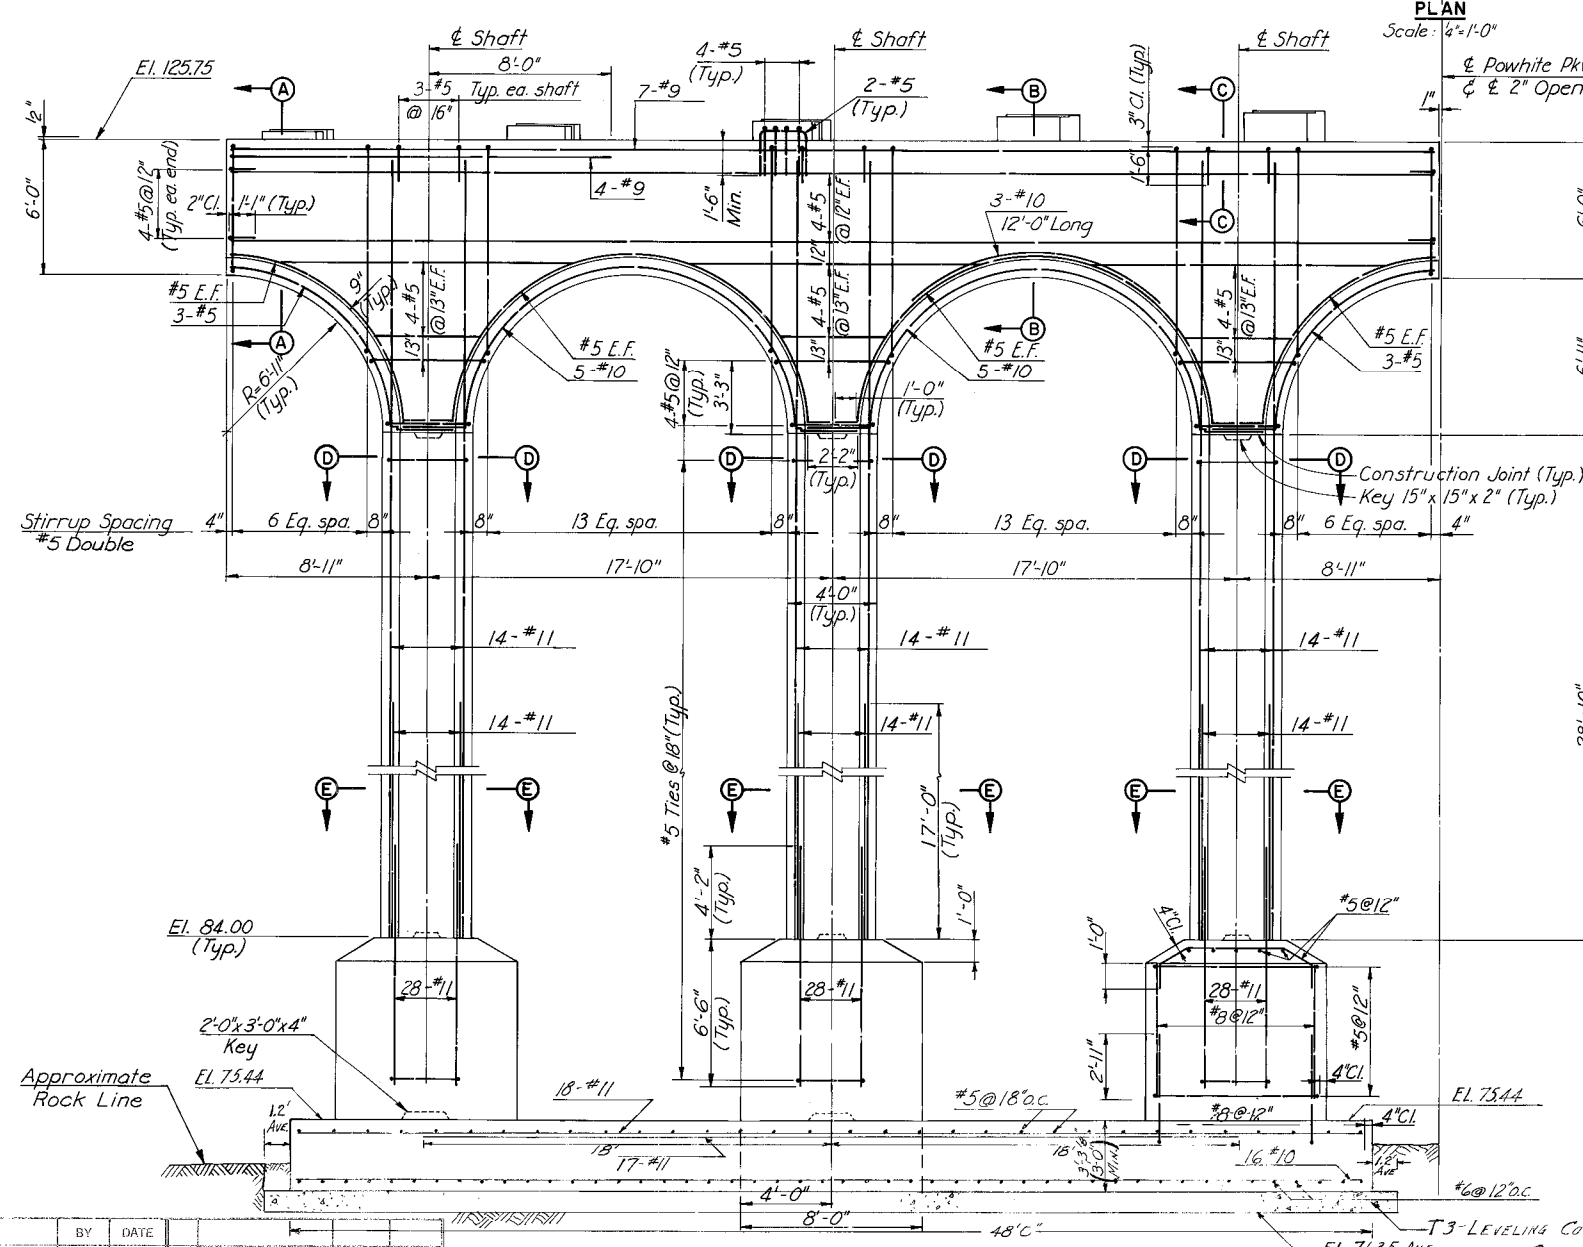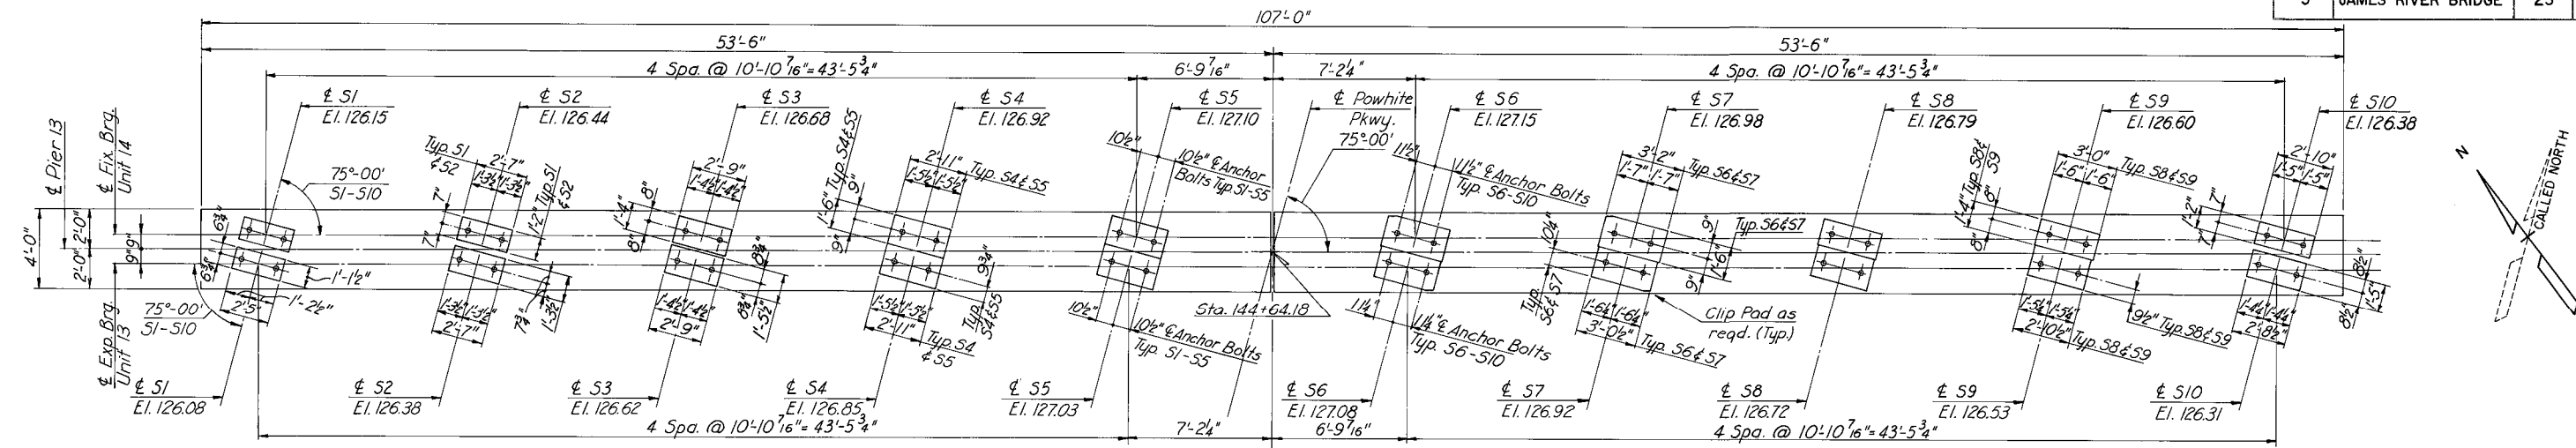

NOTES:
 Foundation elevations are approximate and may be varied to suit field conditions as directed by the Engineer.
 Pier foundations are designed for an allowable bearing pressure of 5 Tons/S.F.



RICHMOND METROPOLITAN AUTHORITY
 RICHMOND EXPRESSWAY SYSTEM

**JAMES RIVER BRIDGE
 PIER 13**


MADE	BY	DATE	NO.	REVISION	BY	DATE
	L.B.P.	7-67	2	AS BUILT	JRC	12-72
CHECKED	FX.H.	3-68	1	Rev. Footings	JRC	4-12-72
IN CHARGE	FX.H.					

HALF ELEVATION
 Scale: 1/4" = 1'-0"
 Note: Pier symmetrical about & 2" Open Joint except as shown.


FOOTING END VIEW
 Scale: 1/4" = 1'-0"

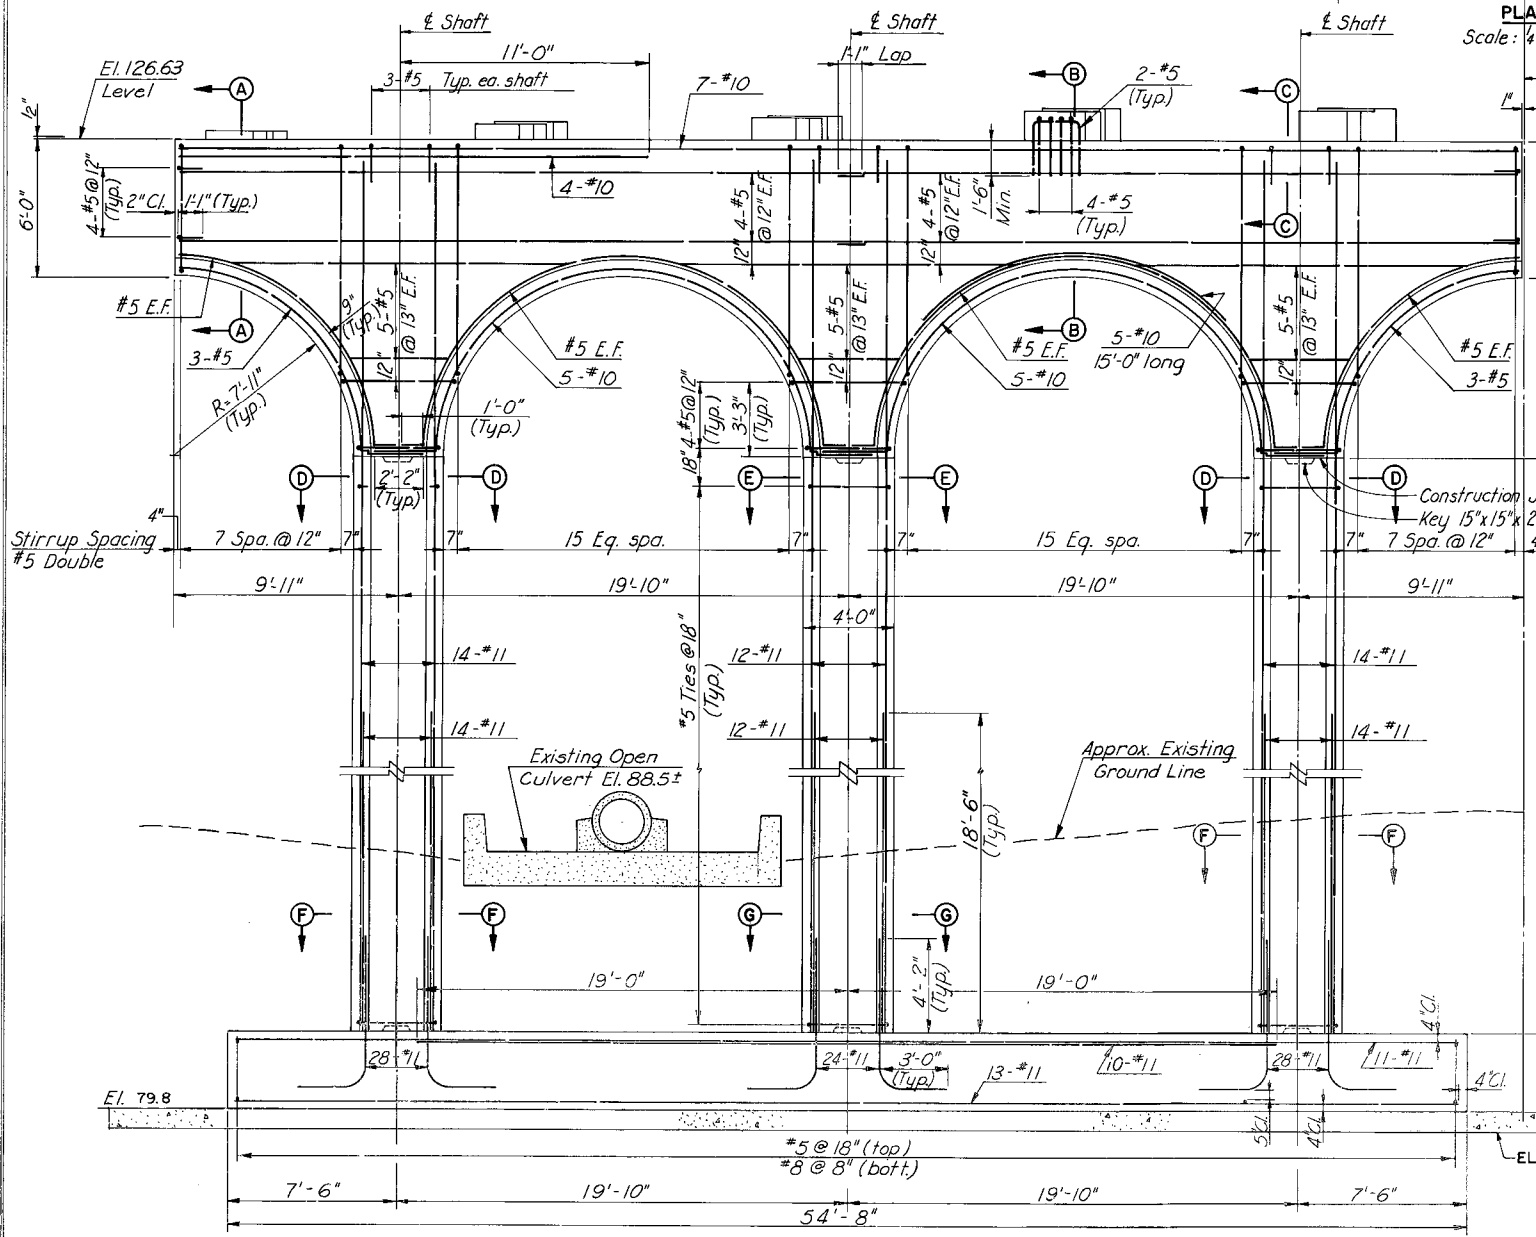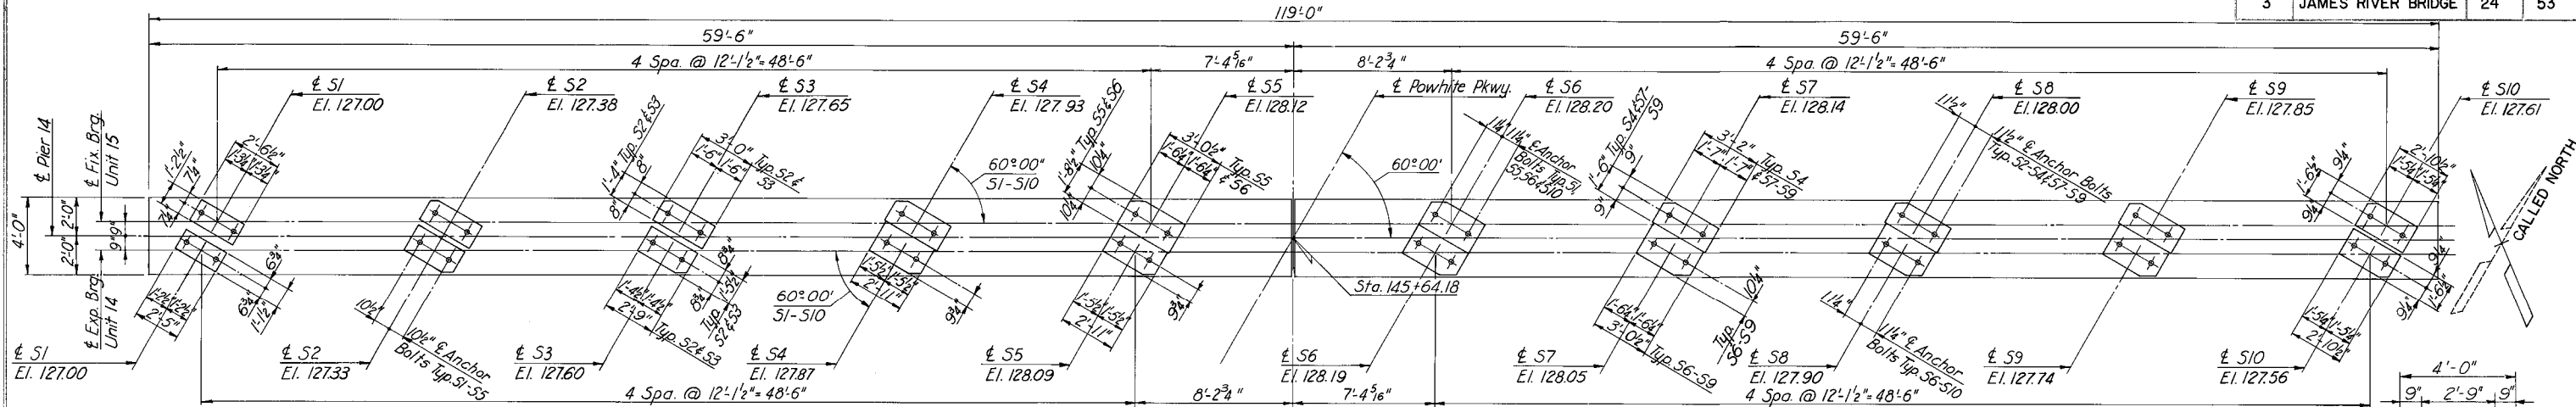


PLAN
Scale: 4"=1'-0"

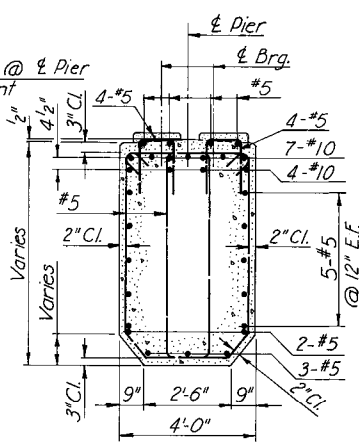


SECTION A-A
Scale: 3/8"=1'-0"

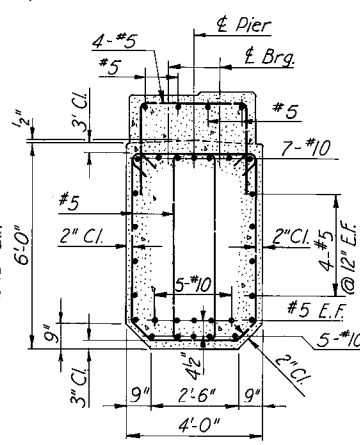


SECTION B-B
Scale: 3/8"=1'-0"

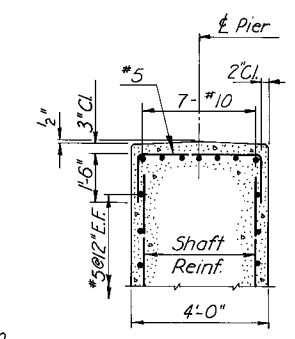


SECTION C-C
Scale: 3/8"=1'-0"

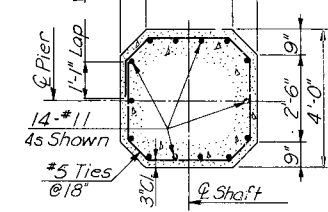


SECTION D-D
Scale: 3/8"=1'-0"

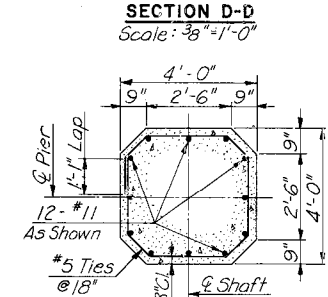


SECTION E-E
Scale: 3/8"=1'-0"

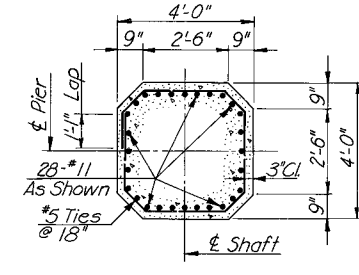


SECTION F-F
Scale: 3/8"=1'-0"

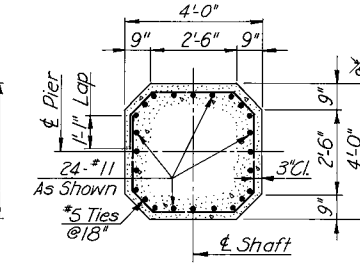

SECTION G-G
Scale: 3/8"=1'-0"

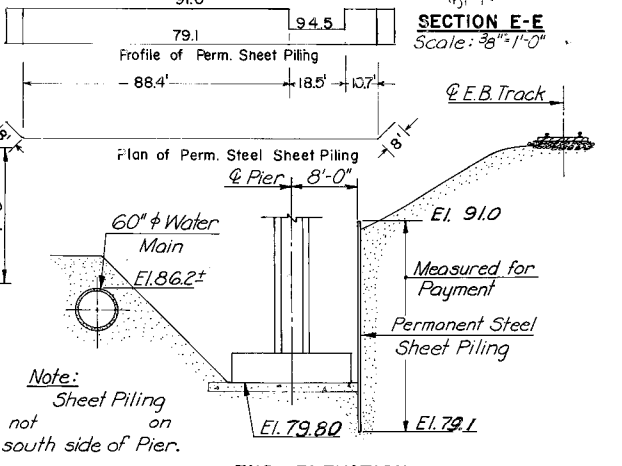


END ELEVATION
NOT TO SCALE

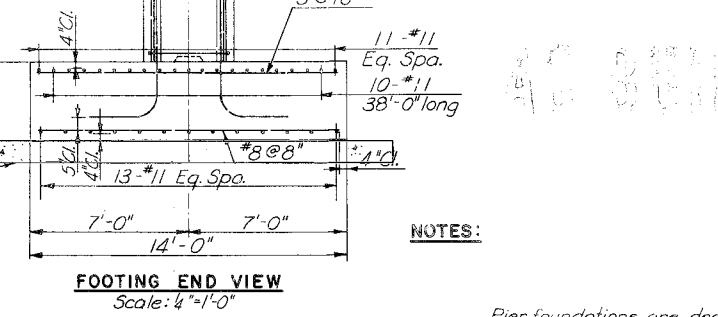

FOOTING END VIEW
Scale: 4"=1'-0"

HALF ELEVATION
Scale: 4"=1'-0"

Note:
Pier symmetrical about
± 2" open joint.

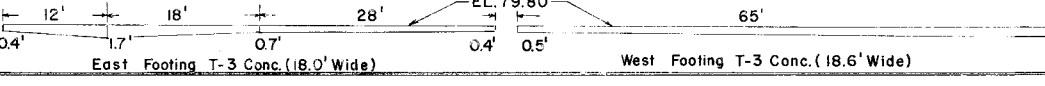

East Footing T-3 Conc. (18.6' Wide)

West Footing T-3 Conc. (65' Wide)

NOTES:

Pier foundations are designed for an allowable bearing pressure of 32 Tons/S.F.







BY	DATE				
MADE	L.B.P.	7-67			
CHECKED	FX.H.	3-68	AS BUILT	JRC	12-72
IN CHARGE	FX.H.		NO.	REVISION	BY
					DATE

RICHMOND METROPOLITAN AUTHORITY
RICHMOND EXPRESSWAY SYSTEM

JAMES RIVER BRIDGE
PIER 14

HOWARD, NEEDLES, TAMMIE & BERGENDOFF
consulting engineers
NEW YORK ALEXANDRIA KANSAS CITY
SCALE: AS SHOWN
CONTRACT NO: C-3
SHEET NO. 24 OF 53

RICHMOND EXPRESSWAY SYSTEM			
SECTION	PROJECT	SHEET NO.	TOTAL SHEETS
3	JAMES RIVER BRIDGE	25	53

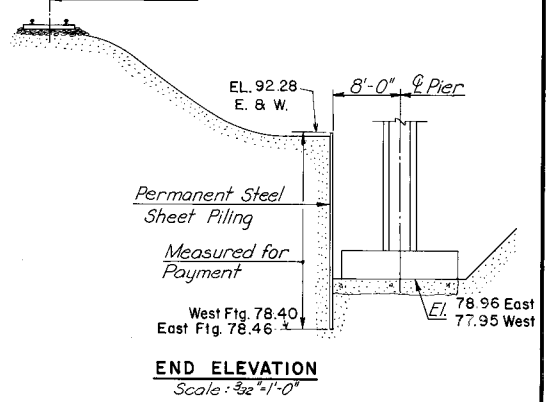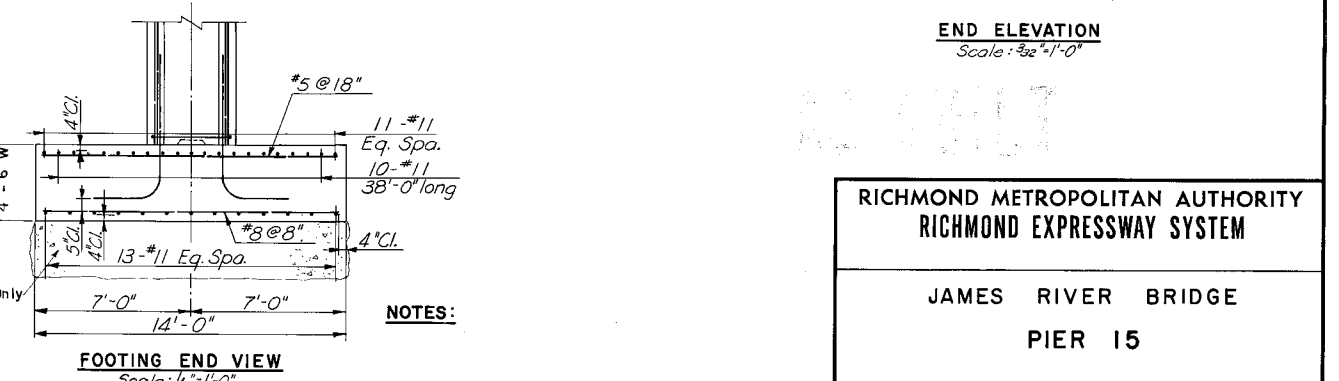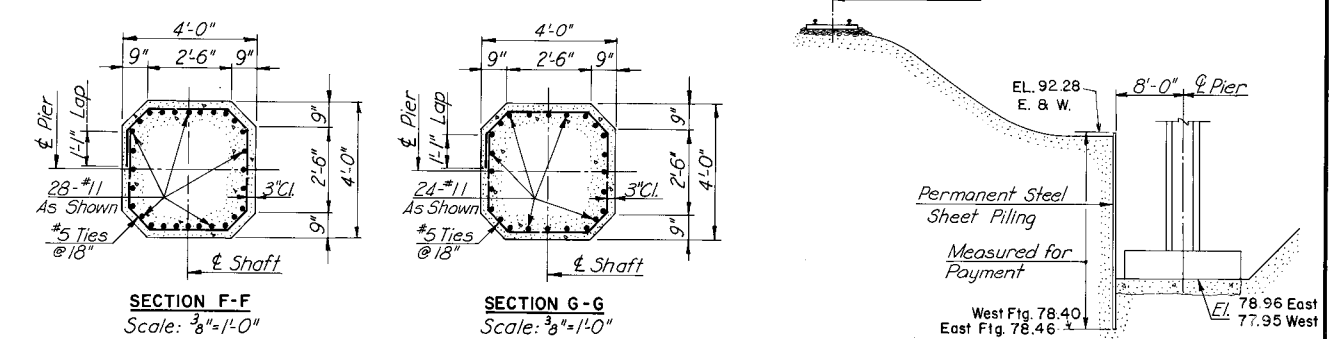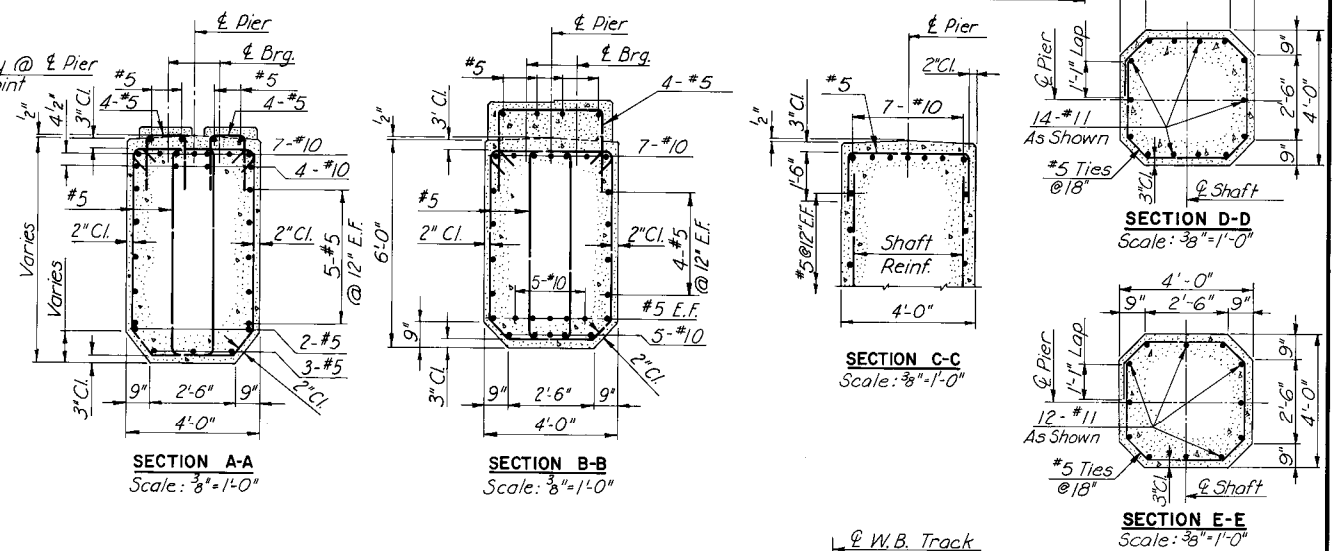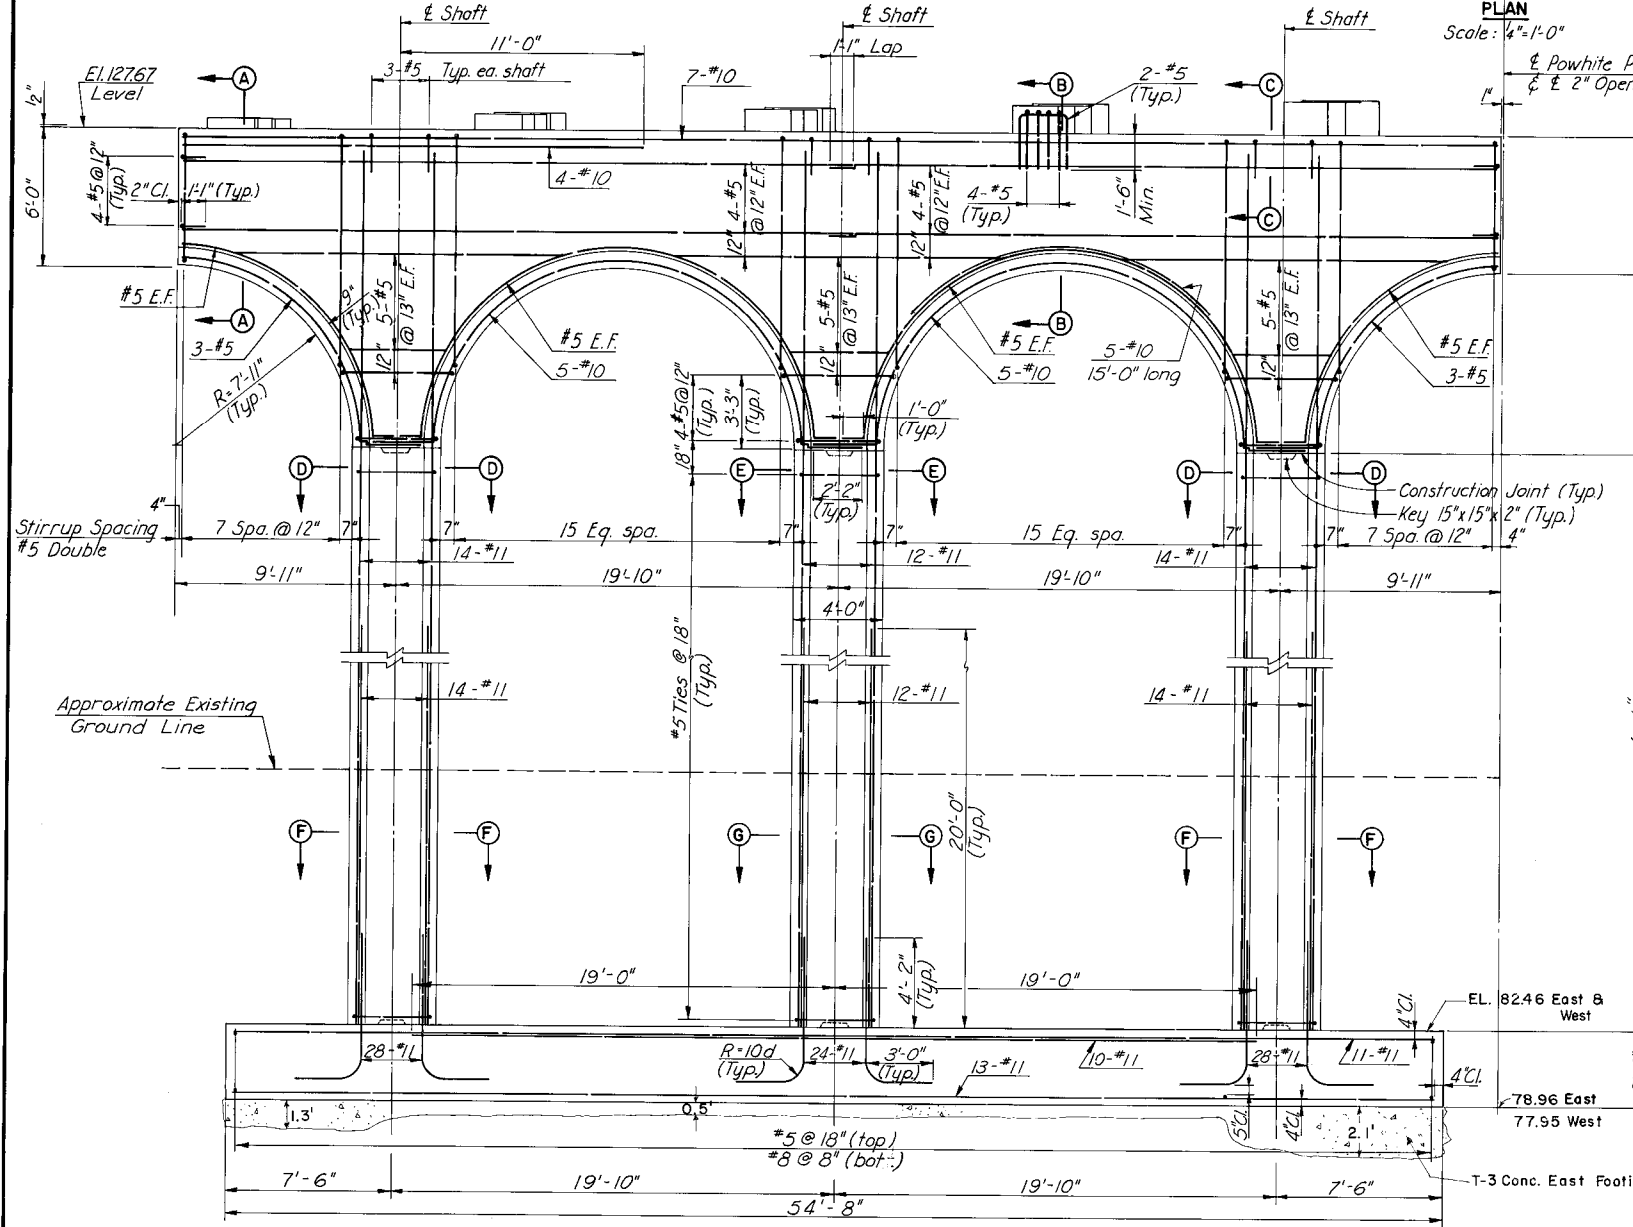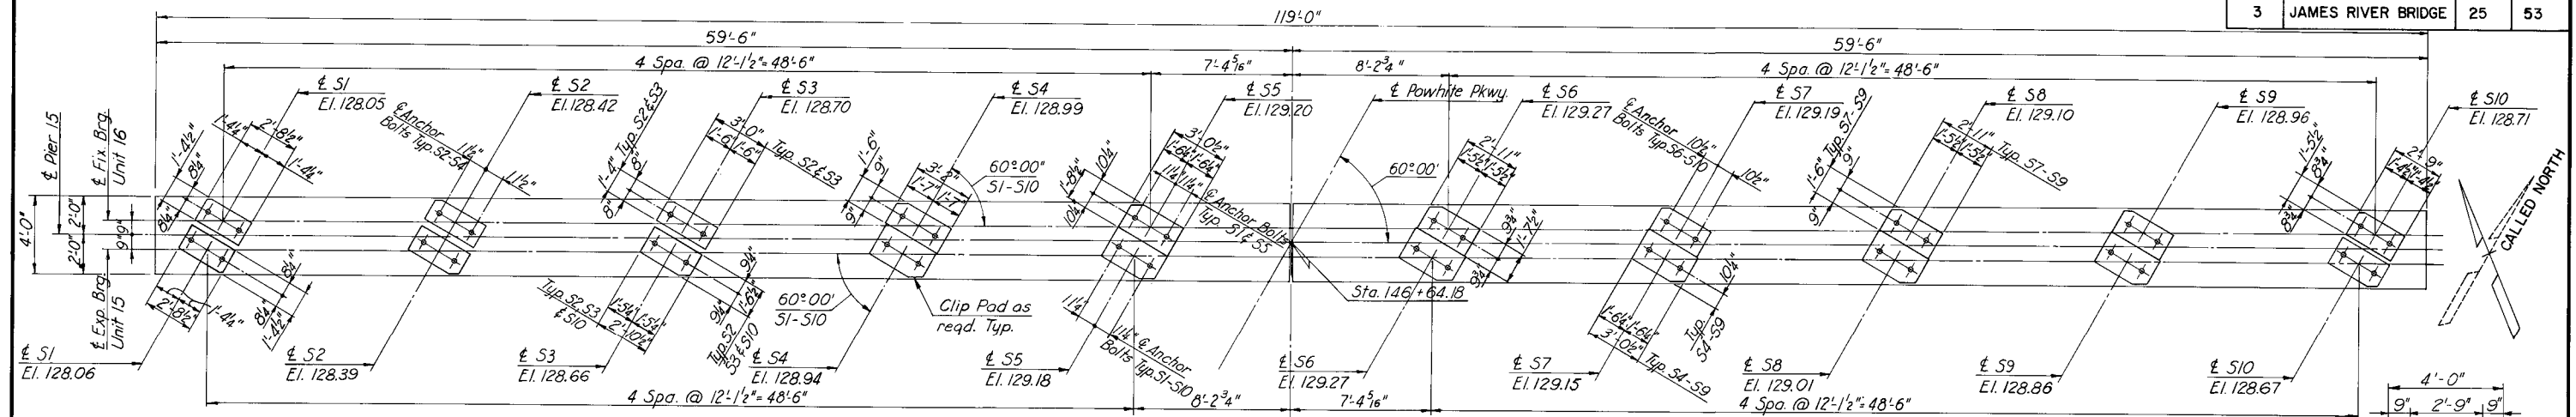

BY	DATE	NO.	REVISION	BY	DATE
MADE	HBW	7-67			
CHECKED	FXH	3-68	AS BUILT	JRC	12-72
IN CHARGE	FXH				

Note:
Pier symmetrical about
£ 2" open joint.

NOTES:
Pier foundations are designed for an allowable bearing pressure of 3 1/2 Tons/5.F.




RICHMOND METROPOLITAN AUTHORITY
RICHMOND EXPRESSWAY SYSTEM

JAMES RIVER BRIDGE
PIER 15

HOWARD, NEEDLES, TAMMEN & BERGENDOFF
consulting engineers
NEW YORK ALEXANDRIA KANSAS CITY

SCALE: AS SHOWN
CONTRACT NO: C-3
SHEET NO. 25 OF 53

RICHMOND EXPRESSWAY SYSTEM			
SECTION	PROJECT	SHEET NO.	TOTAL SHEETS
3	JAMES RIVER BRIDGE	26	53

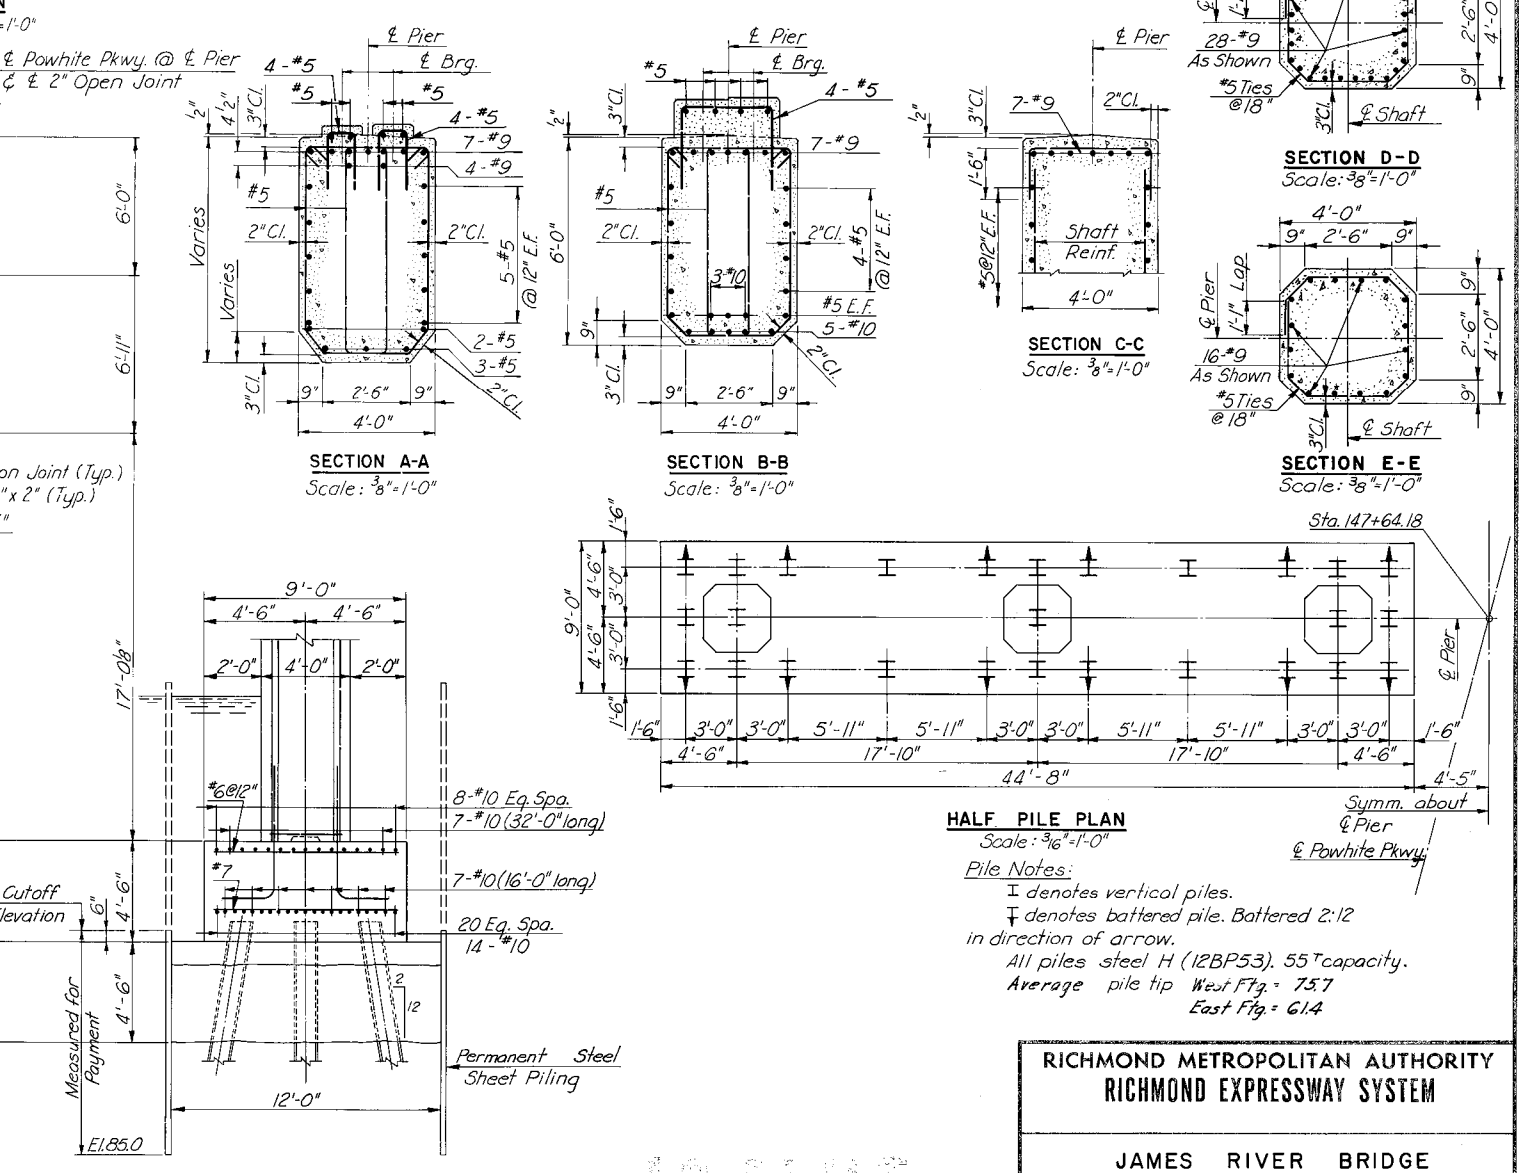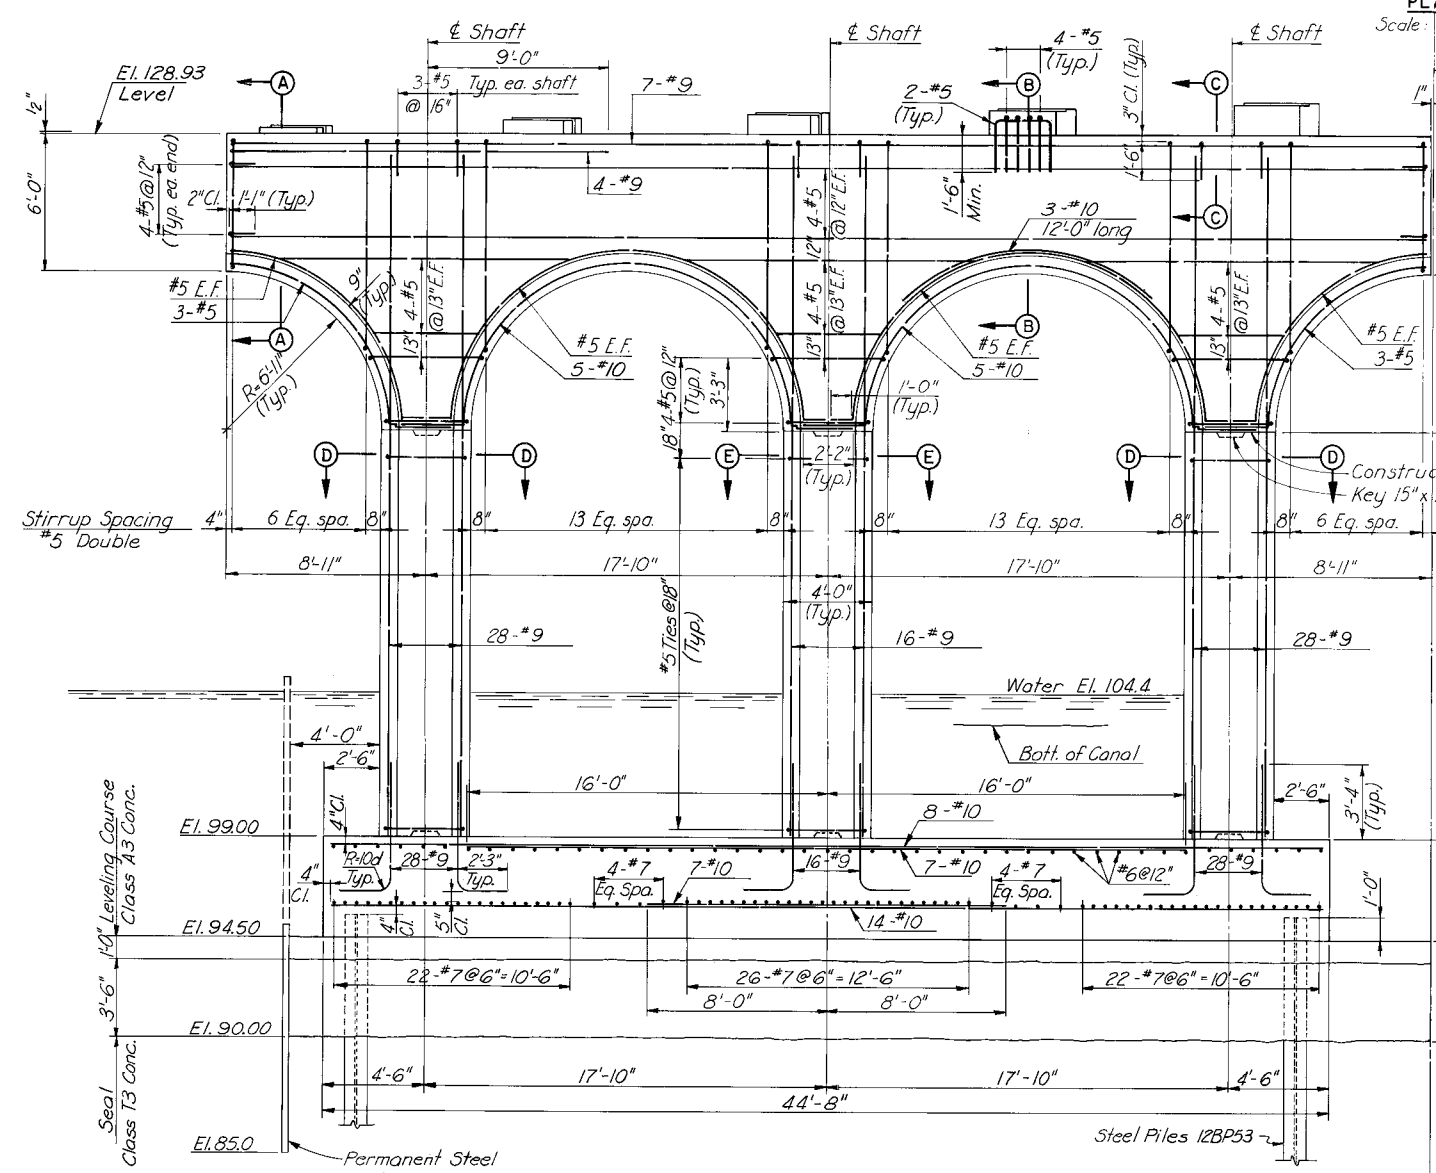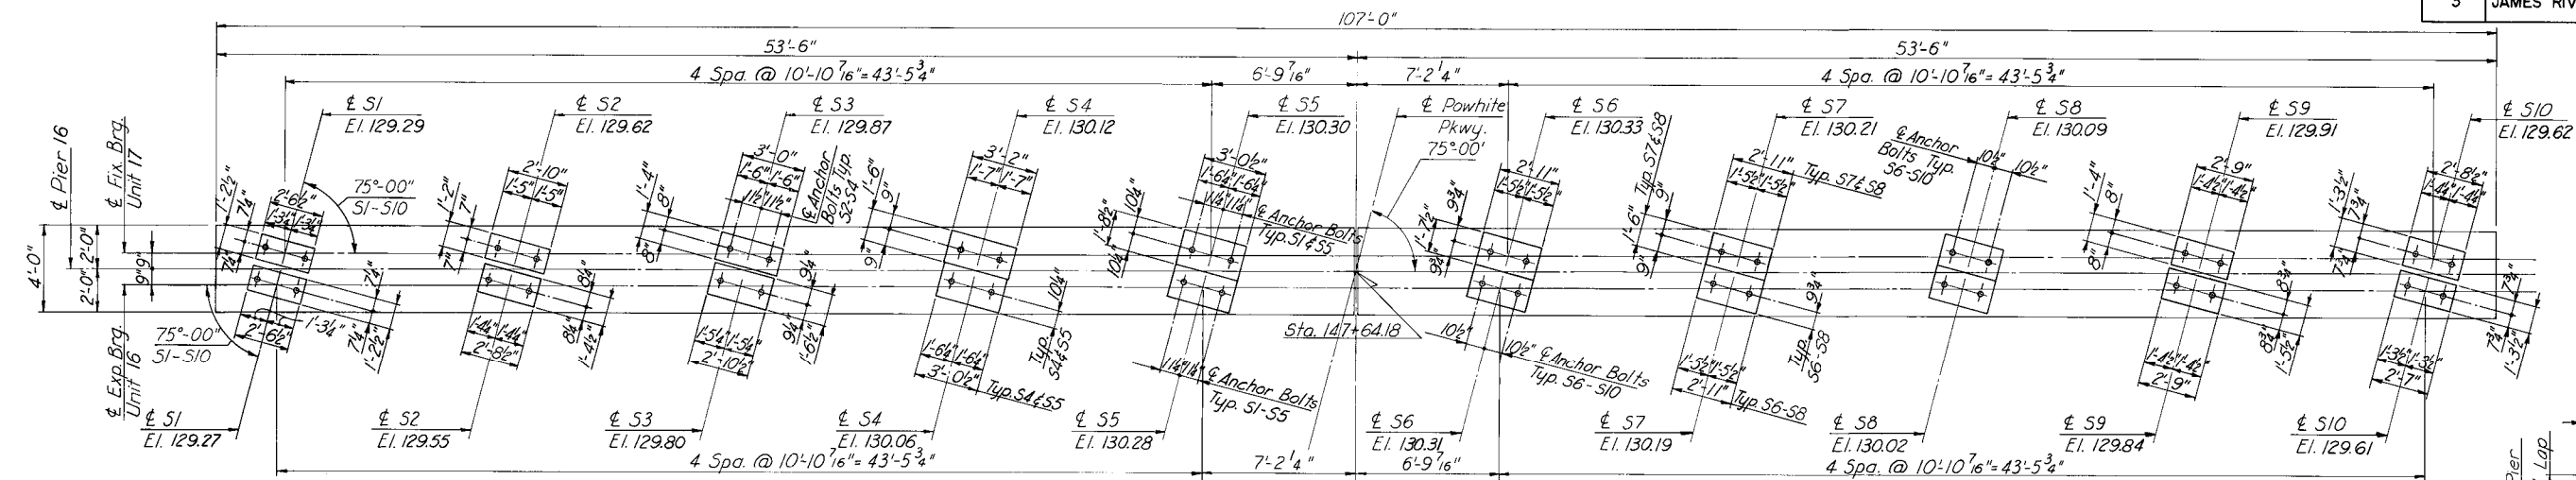

HALF PILE PLAN
Scale: 3/16"=1'-0"
Pile Notes:
I denotes vertical piles.
↓ denotes battered pile. Battered 2:12 in direction of arrow.
All piles steel H (12BP53), 55 capacity.
Average pile tip West Ftg. = 757
East Ftg. = 614

RICHMOND METROPOLITAN AUTHORITY
RICHMOND EXPRESSWAY SYSTEM

JAMES RIVER BRIDGE
PIER 16





HOWARD, NEEDLES, TAMMEN & BERGENDOFF
consulting engineers
NEW YORK ALEXANDRIA KANSAS CITY

SCALE: AS SHOWN
CONTRACT NO. C-3
SHEET NO. 26 OF 53

BY	DATE				
MADE	HBW	7-67			
CHECKED	FXH	3-68	1	AS BUILT	12-72
IN CHARGE	FXH		NO.	REVISION	BY DATE

Note:
Pier symmetrical about
Q 2" Open Joint.

RICHMOND EXPRESSWAY SYSTEM			
SECTION	PROJECT	SHEET NO.	TOTAL SHEETS
3	JAMES RIVER BRIDGE	27	53

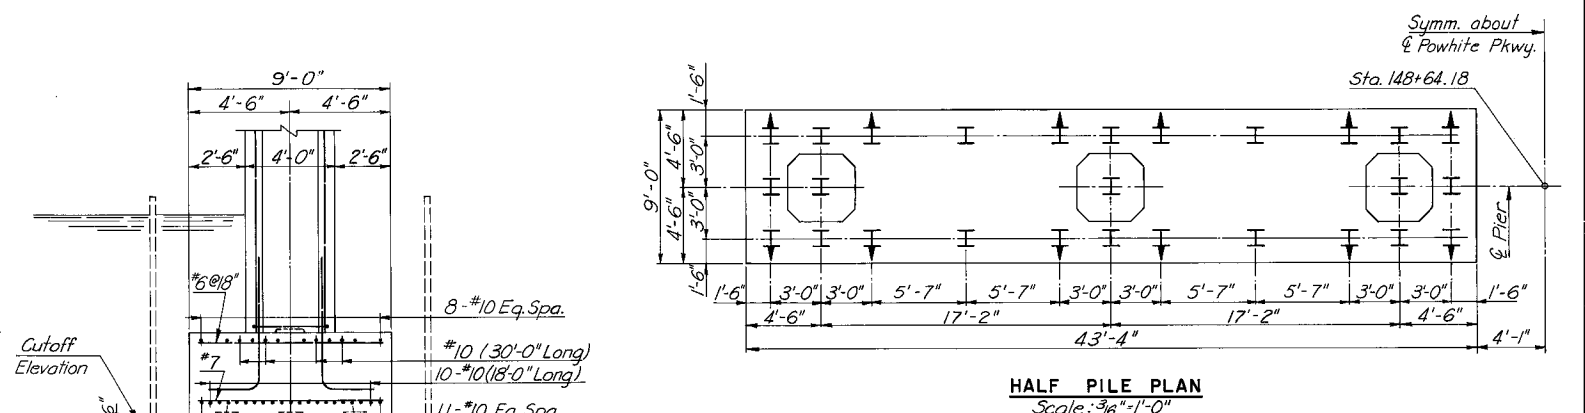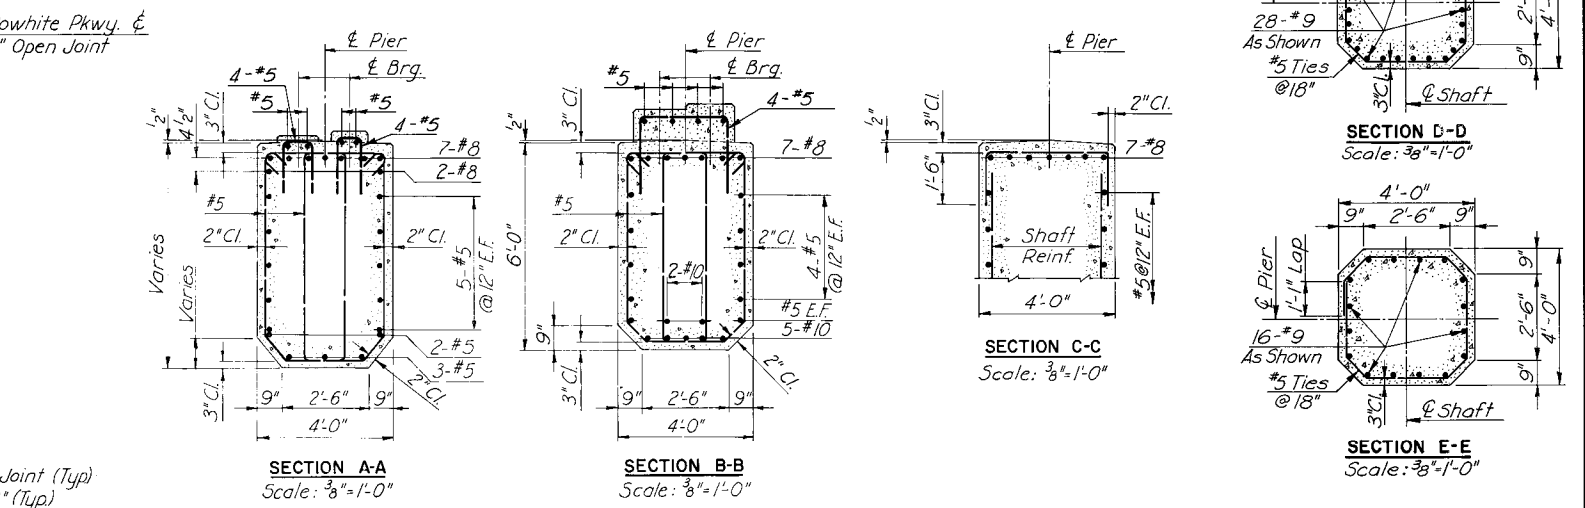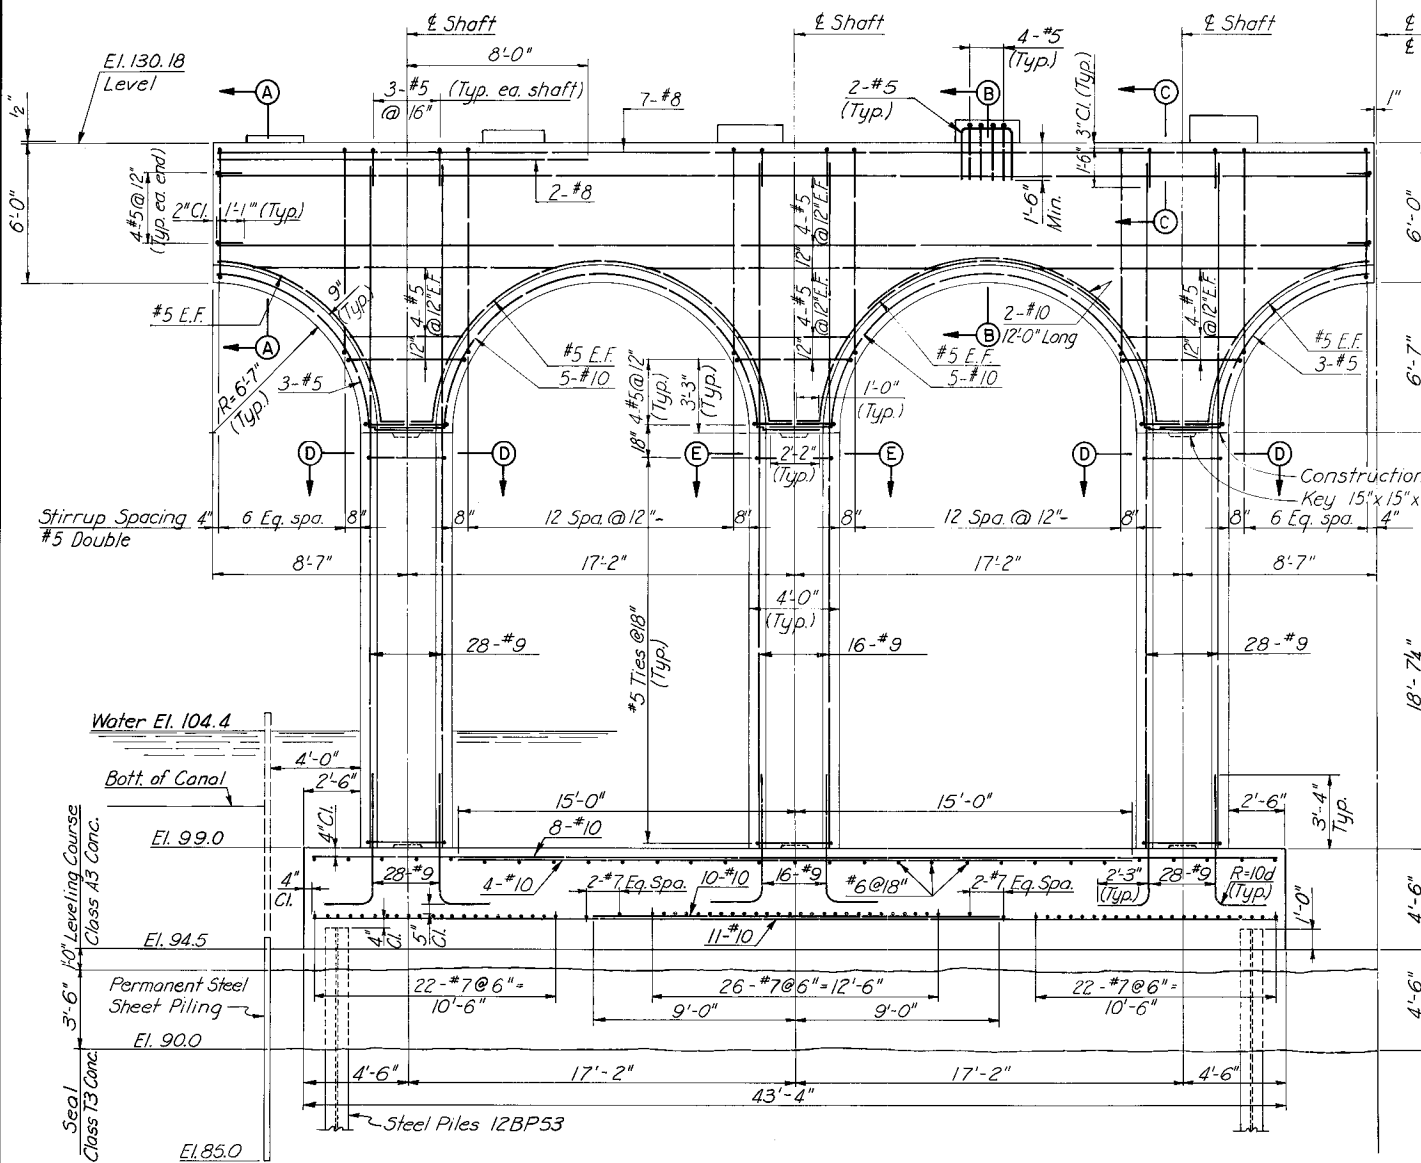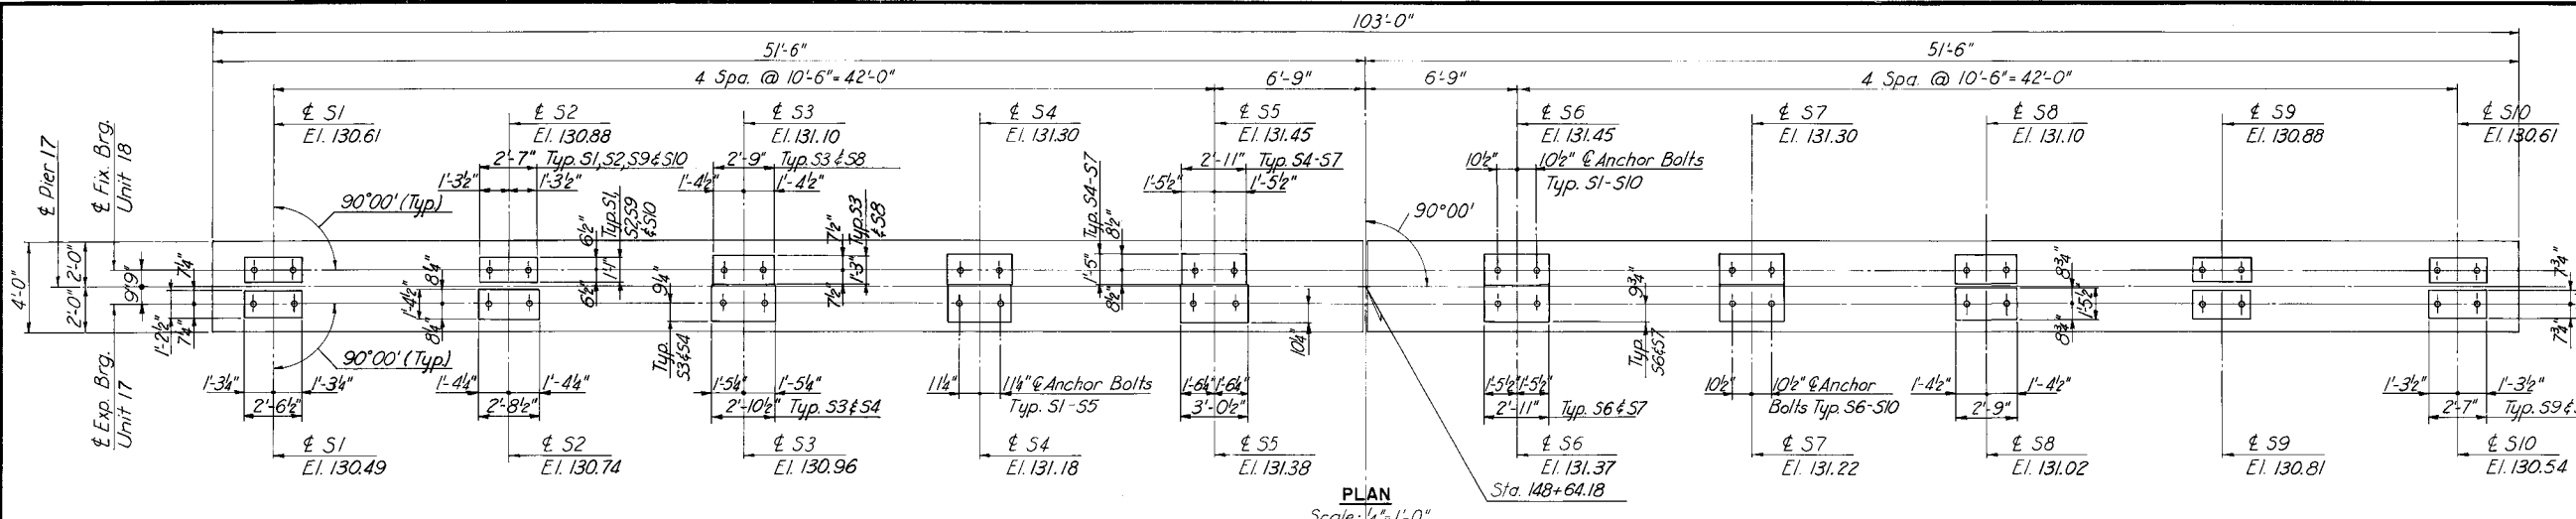

Pile Notes:
 I denotes vertical pile.
 † denotes battered pile. Batter 2:12 in direction of arrow.
 All piles are steel H (12BP53) 55T capacity.
 Average pile tip: El. 47.5 (N.B. Roadway Pier), El. 68.0 (S.B. Roadway Pier)

Note:
Pier symmetrical about & Powhite Pkwy.



BY	DATE	NO.	REVISION	BY	DATE
MADE	HBW	7-67			
CHECKED	FXH	3-68	AS BUILT	JRC	12-72
IN CHARGE	FXH				

RICHMOND METROPOLITAN AUTHORITY
RICHMOND EXPRESSWAY SYSTEM


JAMES RIVER BRIDGE
PIER 17

HOWARD, NEEDLES, TAMMEN & BERGENDOFF
consulting engineers
NEW YORK ALEXANDRIA KANSAS CITY

SCALE: AS SHOWN
CONTRACT NO.: C-3
SHEET NO. 27 OF 53

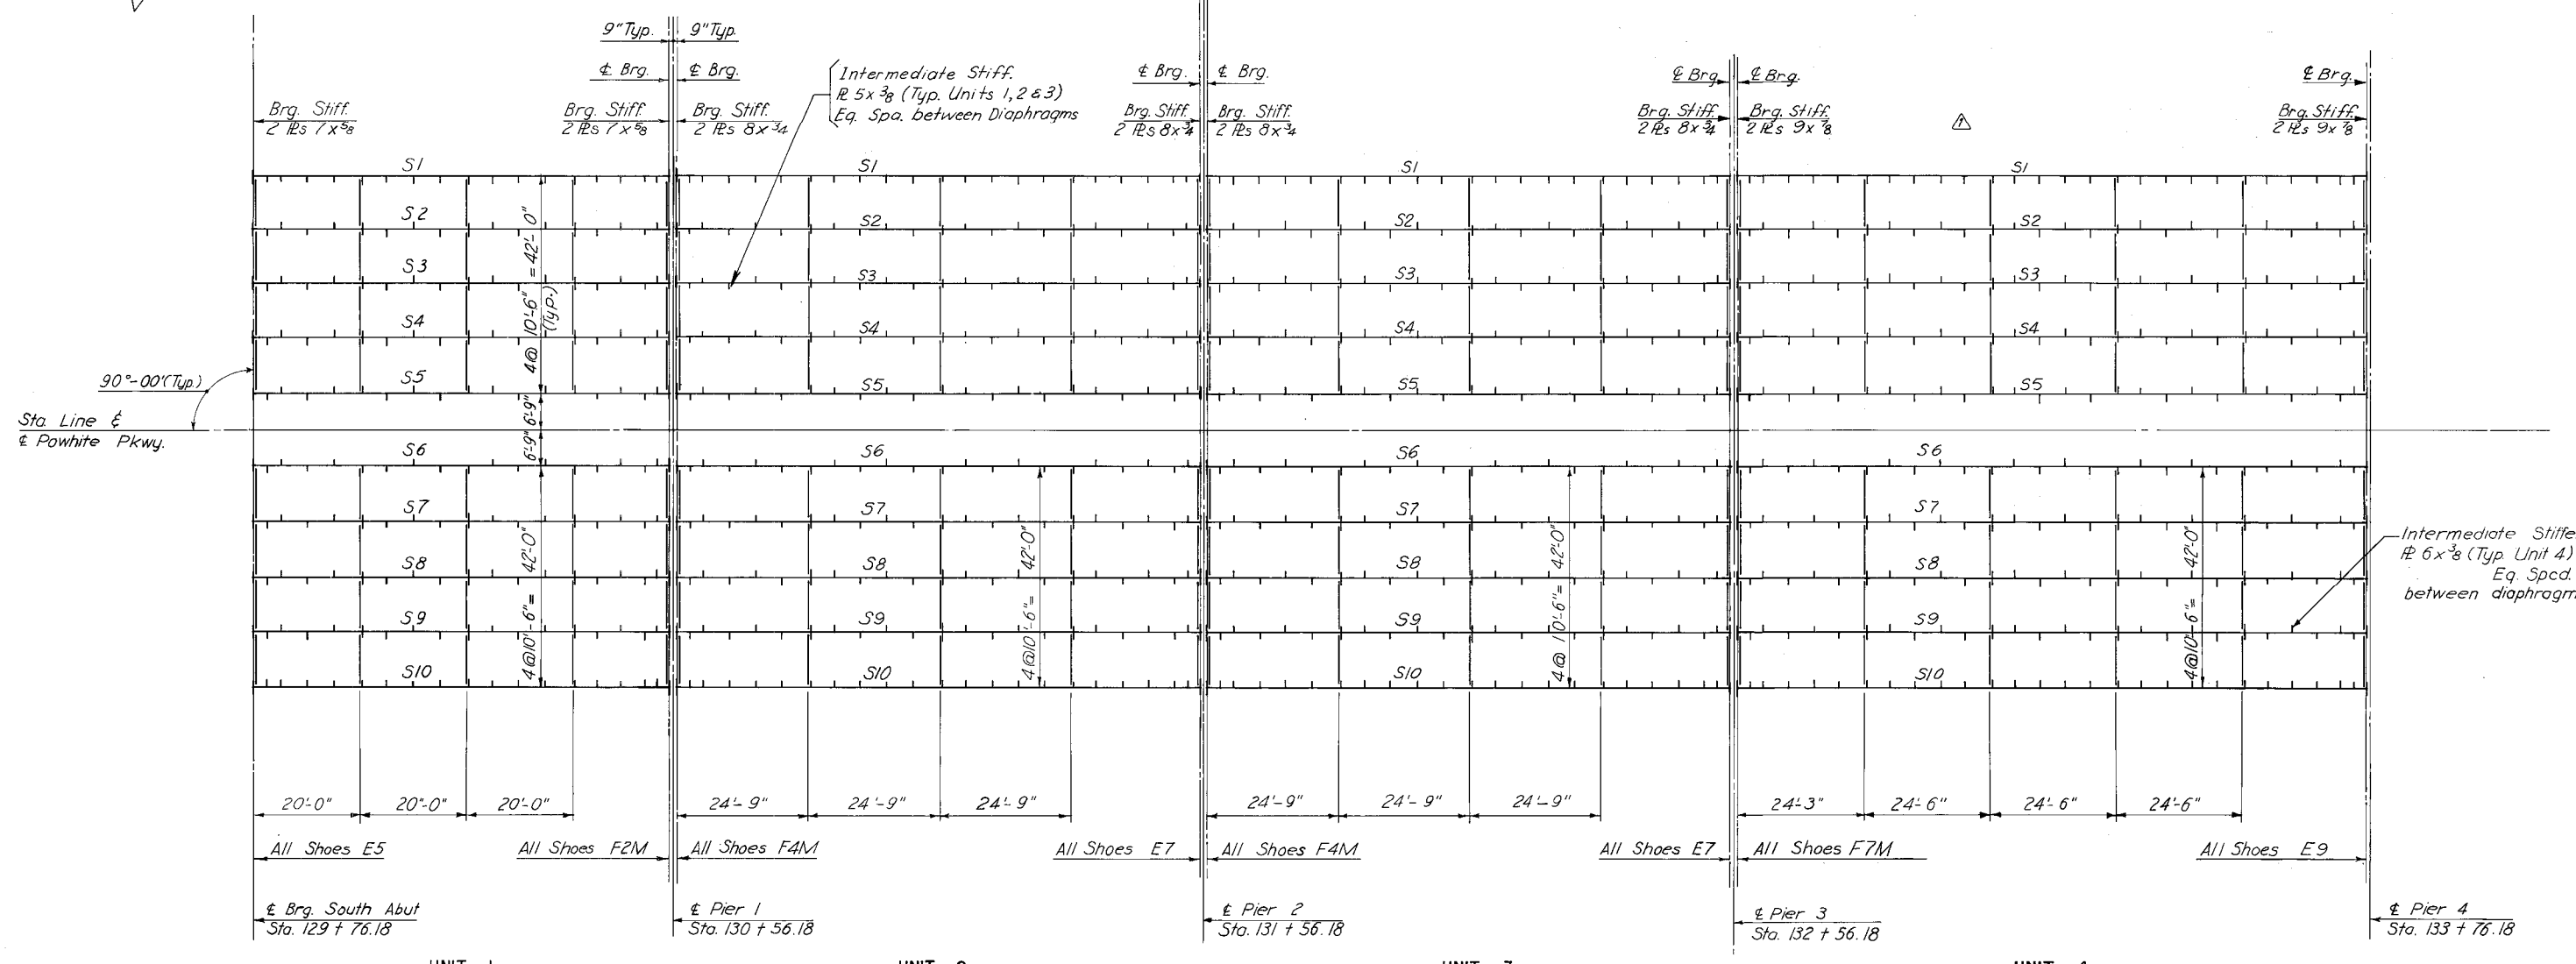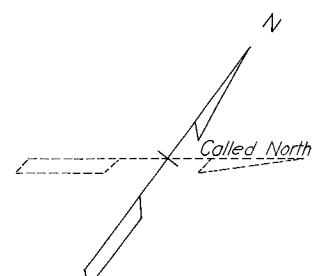

STRINGER LENGTHS (c to c Bearing)					
Unit	Stringer	Length	Unit	Stringer	Length
1	S1-S10	79'-3"	3	S1-S10	98'-6"
2	S1-S10	98'-6"	4	S1-S10	118'-6"

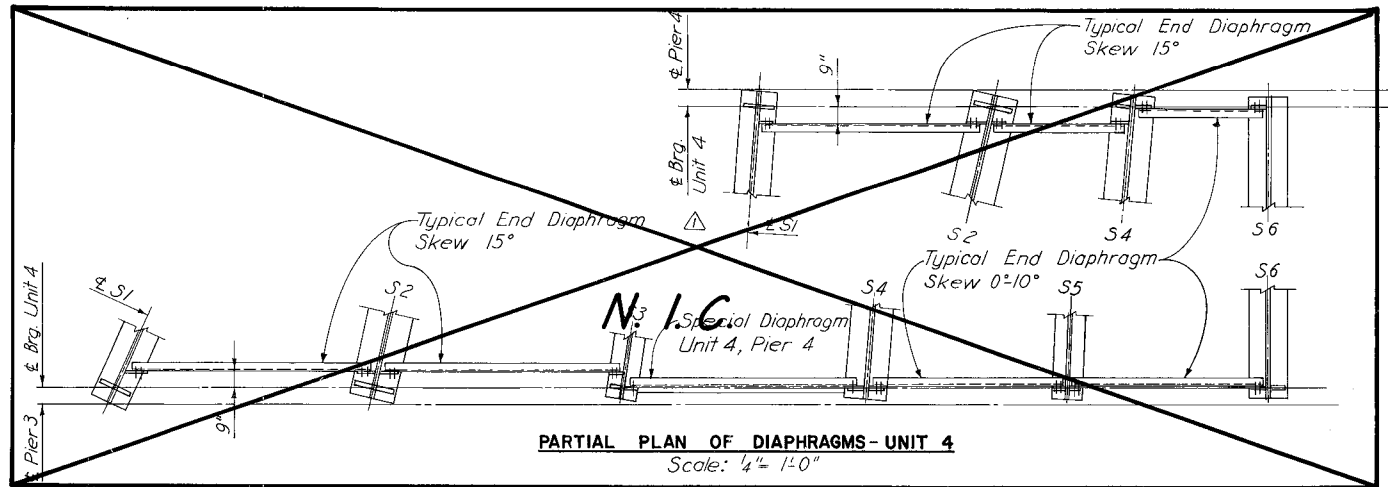


BY	DATE				
MADE	EVR 7-67	2	A S BUILT	JRC 12-72	
CHECKED	FXH 8-67		Remove Ramp Taper	H.B.W. 2/20/71	
IN CHARGE	FXH		NO. REVISION	BY	DATE

RICHMOND METROPOLITAN AUTHORITY
RICHMOND EXPRESSWAY SYSTEM


JAMES RIVER BRIDGE
FRAMING PLAN UNITS 1, 2, 3 & 4

HOWARD, NEEDLES, TAMMEN & BERGENDOFF
consulting engineers
NEW YORK ALEXANDRIA KANSAS CITY

SCALE: 1"=15' (Unless Noted)
CONTRACT NO.: C-3
SHEET NO. 28 OF 53

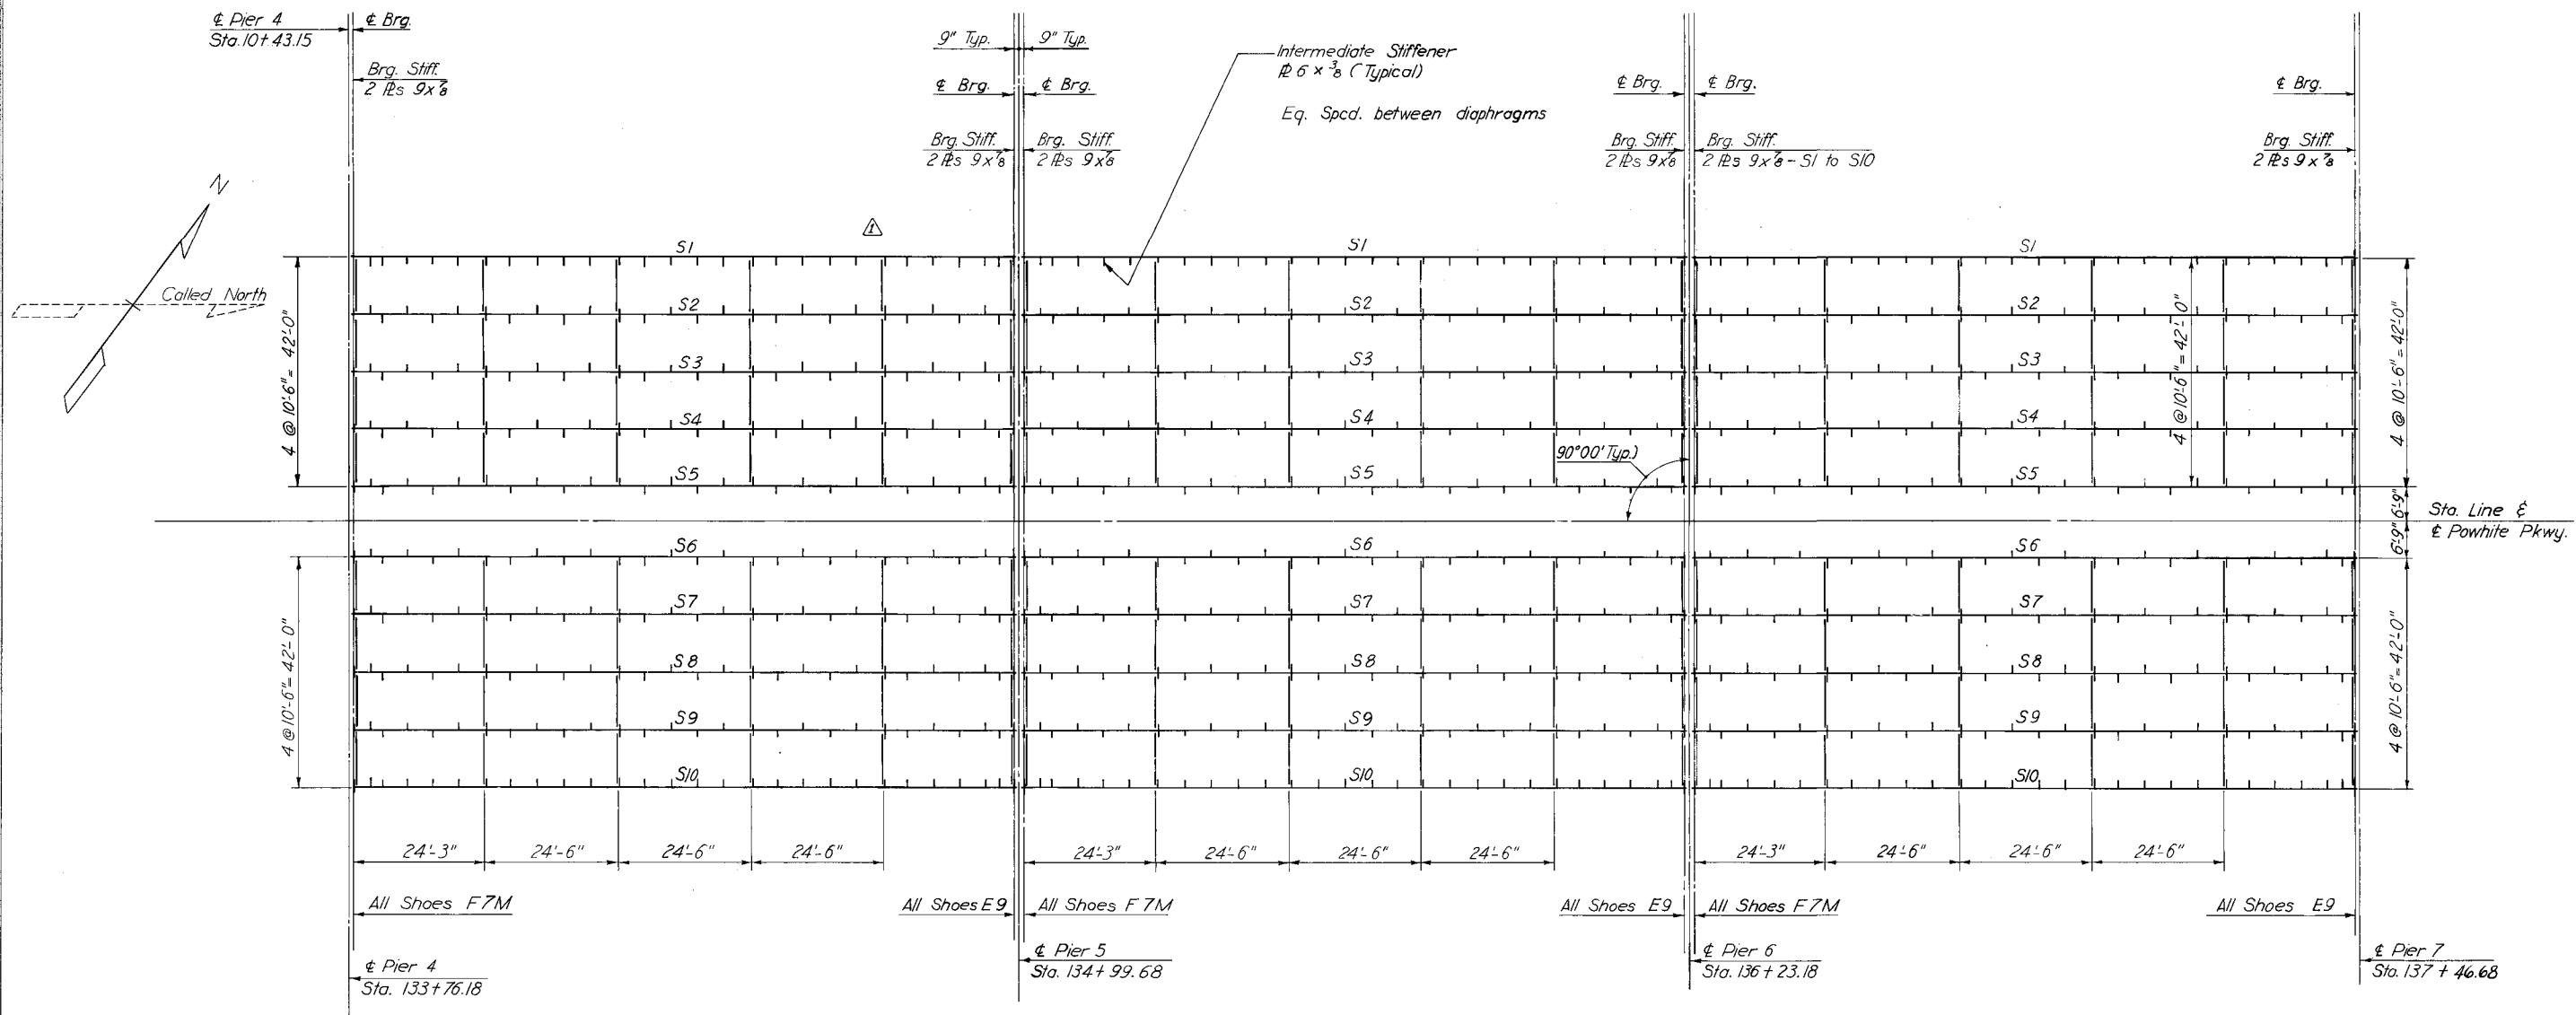

STRINGER LENGTHS (CC. Bearing)		
Unit	Stringer	Length
5-12	S1-S10	122'-0"

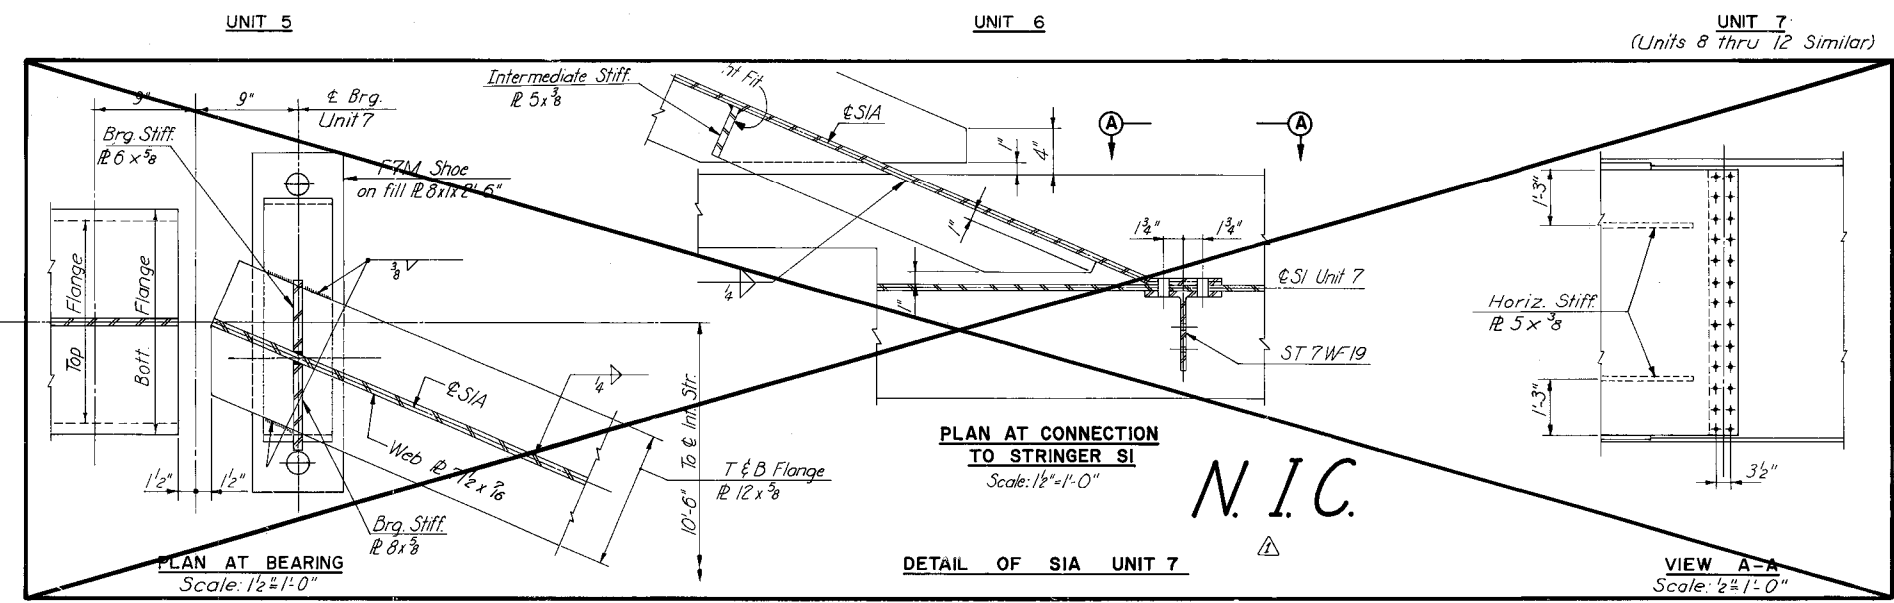


MADE	EVR	7-67	2	AS BUILT	JRC	12-72
CHECKED	FXH	8-67	1	Removed Ramp Widening	ER	2/20/71
IN CHARGE	FXH					

RICHMOND METROPOLITAN AUTHORITY
RICHMOND EXPRESSWAY SYSTEM

JAMES RIVER BRIDGE
FRAMING PLAN UNITS 5 THRU 12

HOWARD, NEEDLES, TAMMEN & BERGENDOFF
consulting engineers
NEW YORK ALEXANDRIA KANSAS CITY

SCALE: 1"=15' (Unless Noted)
CONTRACT NO.: C-3
SHEET NO. 29 OF 53

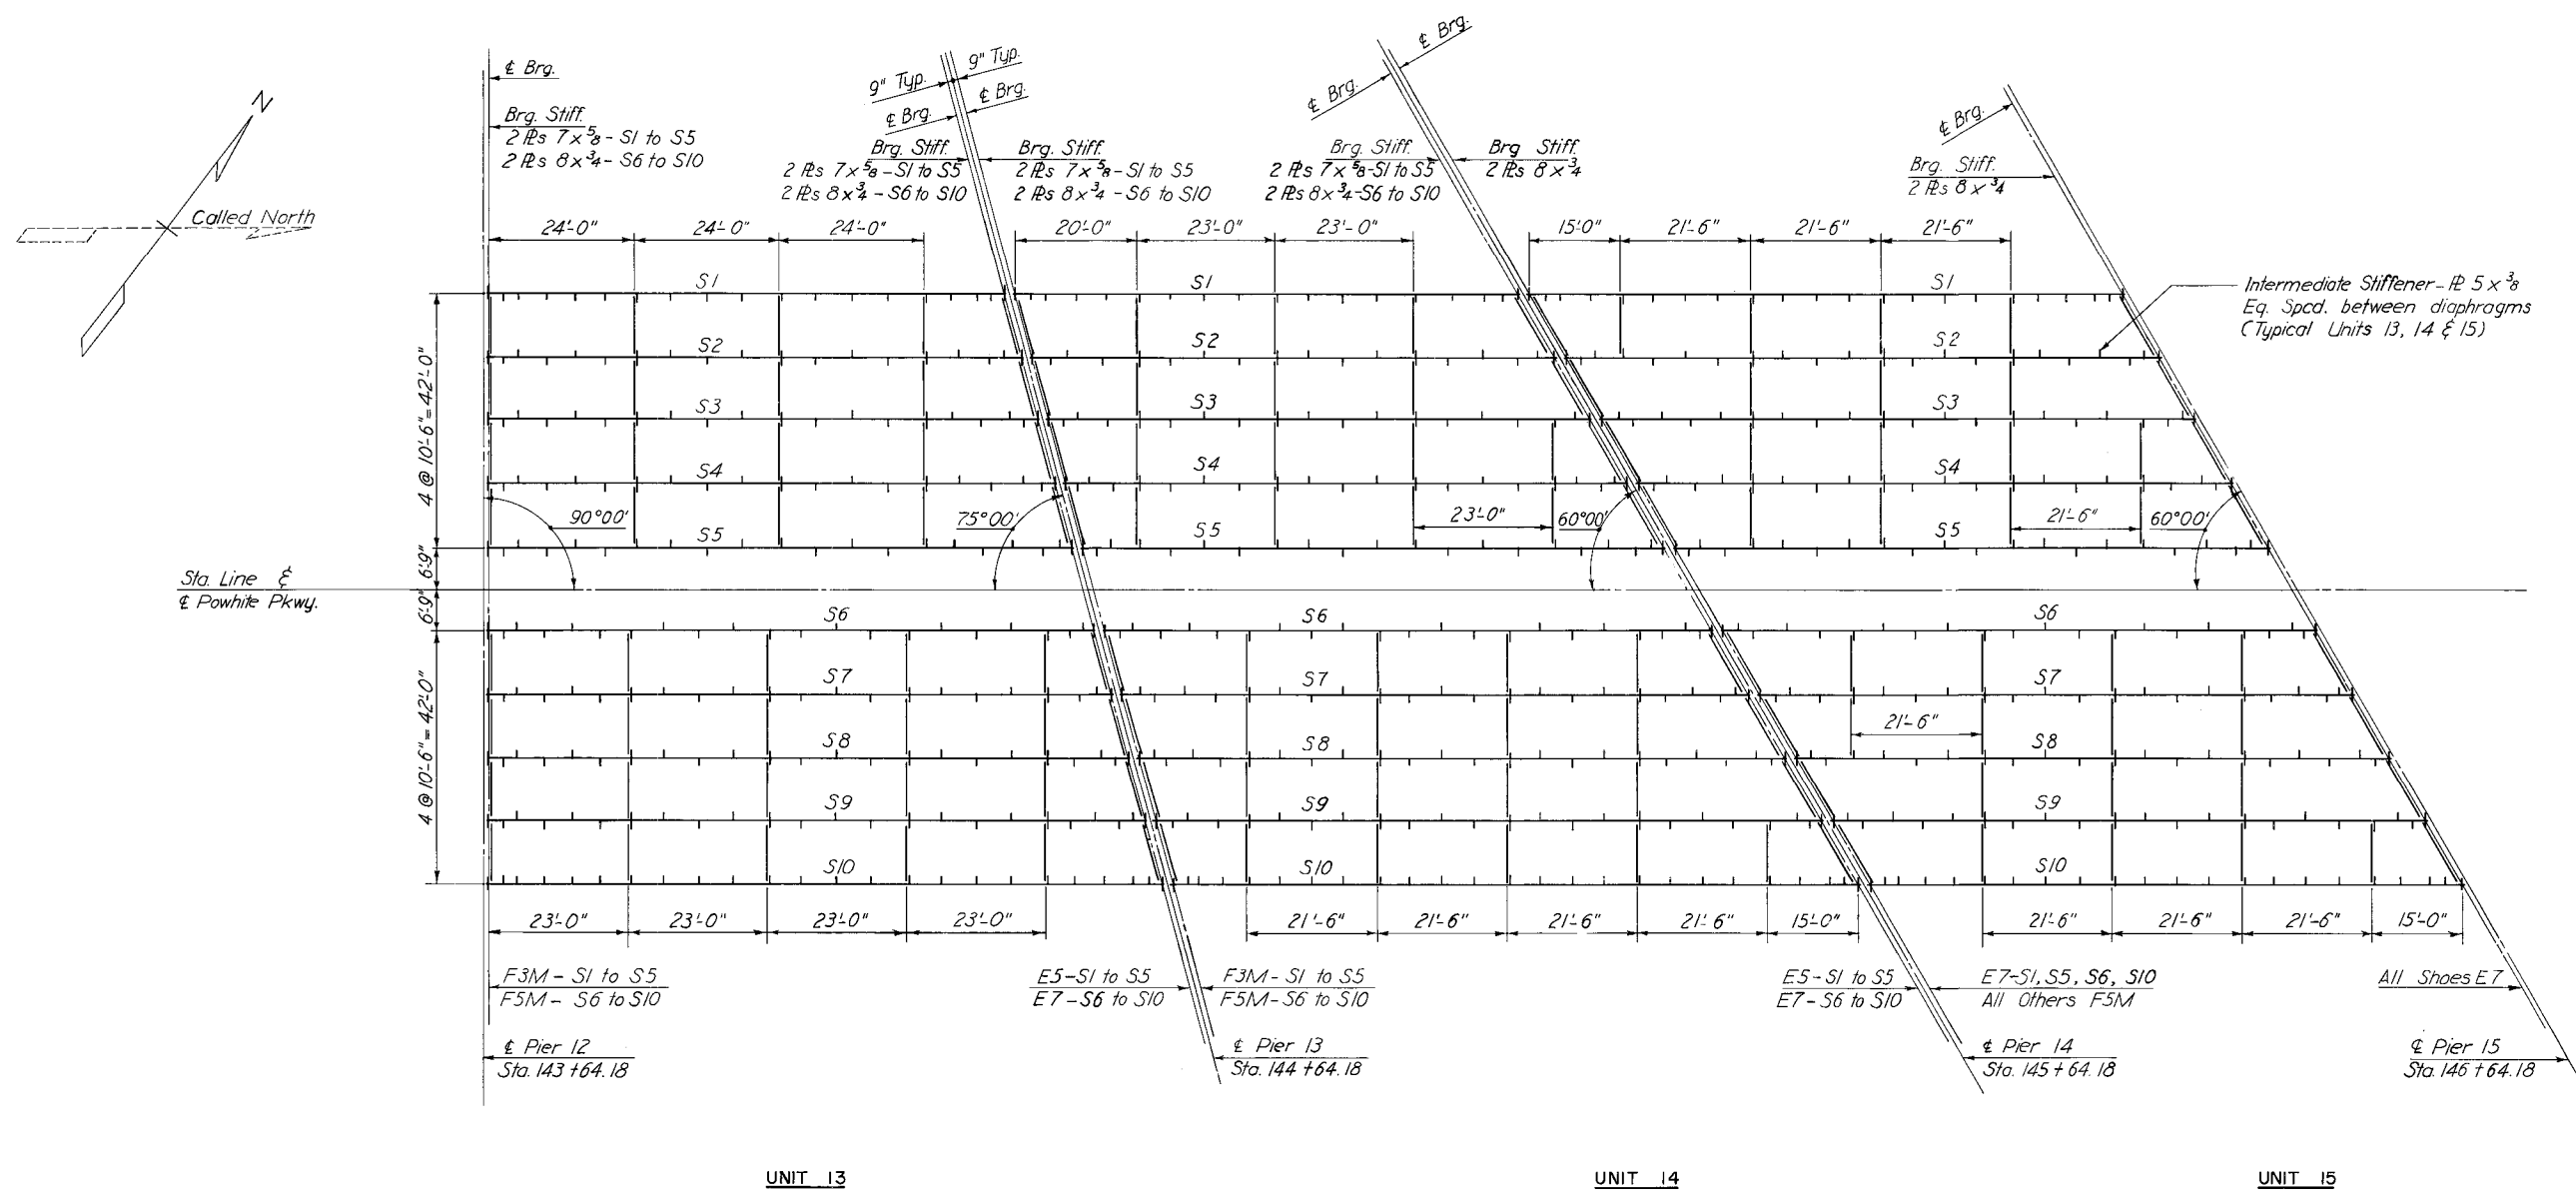

STRINGER LENGTHS (c to c Bearing)								
Unit	Stringer	Length	Unit	Stringer	Length	Unit	Stringer	Length
13	S1	85'-4 ¹ / ₂ "	13 (cont'd)	S8	105'-10 ⁷ / ₈ "	14 (cont'd)	S5	96'-3 ¹ / ₄ "
	S2	88'-2 ¹ / ₁₆ "		S9	108'-8 ¹ / ₁₆ "		S6	100'-5 ³ / ₈ "
	S3	91'-0 ⁷ / ₁₆ "		S10	111'-6 ⁷ / ₁₆ "		S7	103'-8 ⁵ / ₁₆ "
	S4	93'-10 ³ / ₁₆ "	14	S1	83'-3 ⁵ / ₁₆ "		S8	106'-11 ⁵ / ₁₆ "
	S5	96'-8"		S2	85'-6 ¹ / ₄ "		S9	110'-2 ⁵ / ₁₆ "
	S6	100'-3 ³ / ₈ "		S3	89'-9 ¹ / ₄ "		S10	113'-5 ⁵ / ₁₆ "
	S7	103'-1 ¹ / ₈ "		S4	93'-0 ¹ / ₄ "		S1-S10	98'-3 ³ / ₁₆ "


MADE	BY	DATE				
	EVR	7-67				
CHECKED	FXH	8-67	1	AS BUILT	JRC	12-72
IN CHARGE	FXH		NO.	REVISION	BY	DATE

RICHMOND METROPOLITAN AUTHORITY
RICHMOND EXPRESSWAY SYSTEM

JAMES RIVER BRIDGE
FRAMING PLAN UNITS 13, 14 & 15

HOWARD, NEEDLES, TAMMEN & BERGENDOFF
CONSULTING ENGINEERS
NEW YORK ALEXANDRIA KANSAS CITY

SCALE: 1" = 15'-0"
CONTRACT NO.: C-3
SHEET NO. 30 OF 53

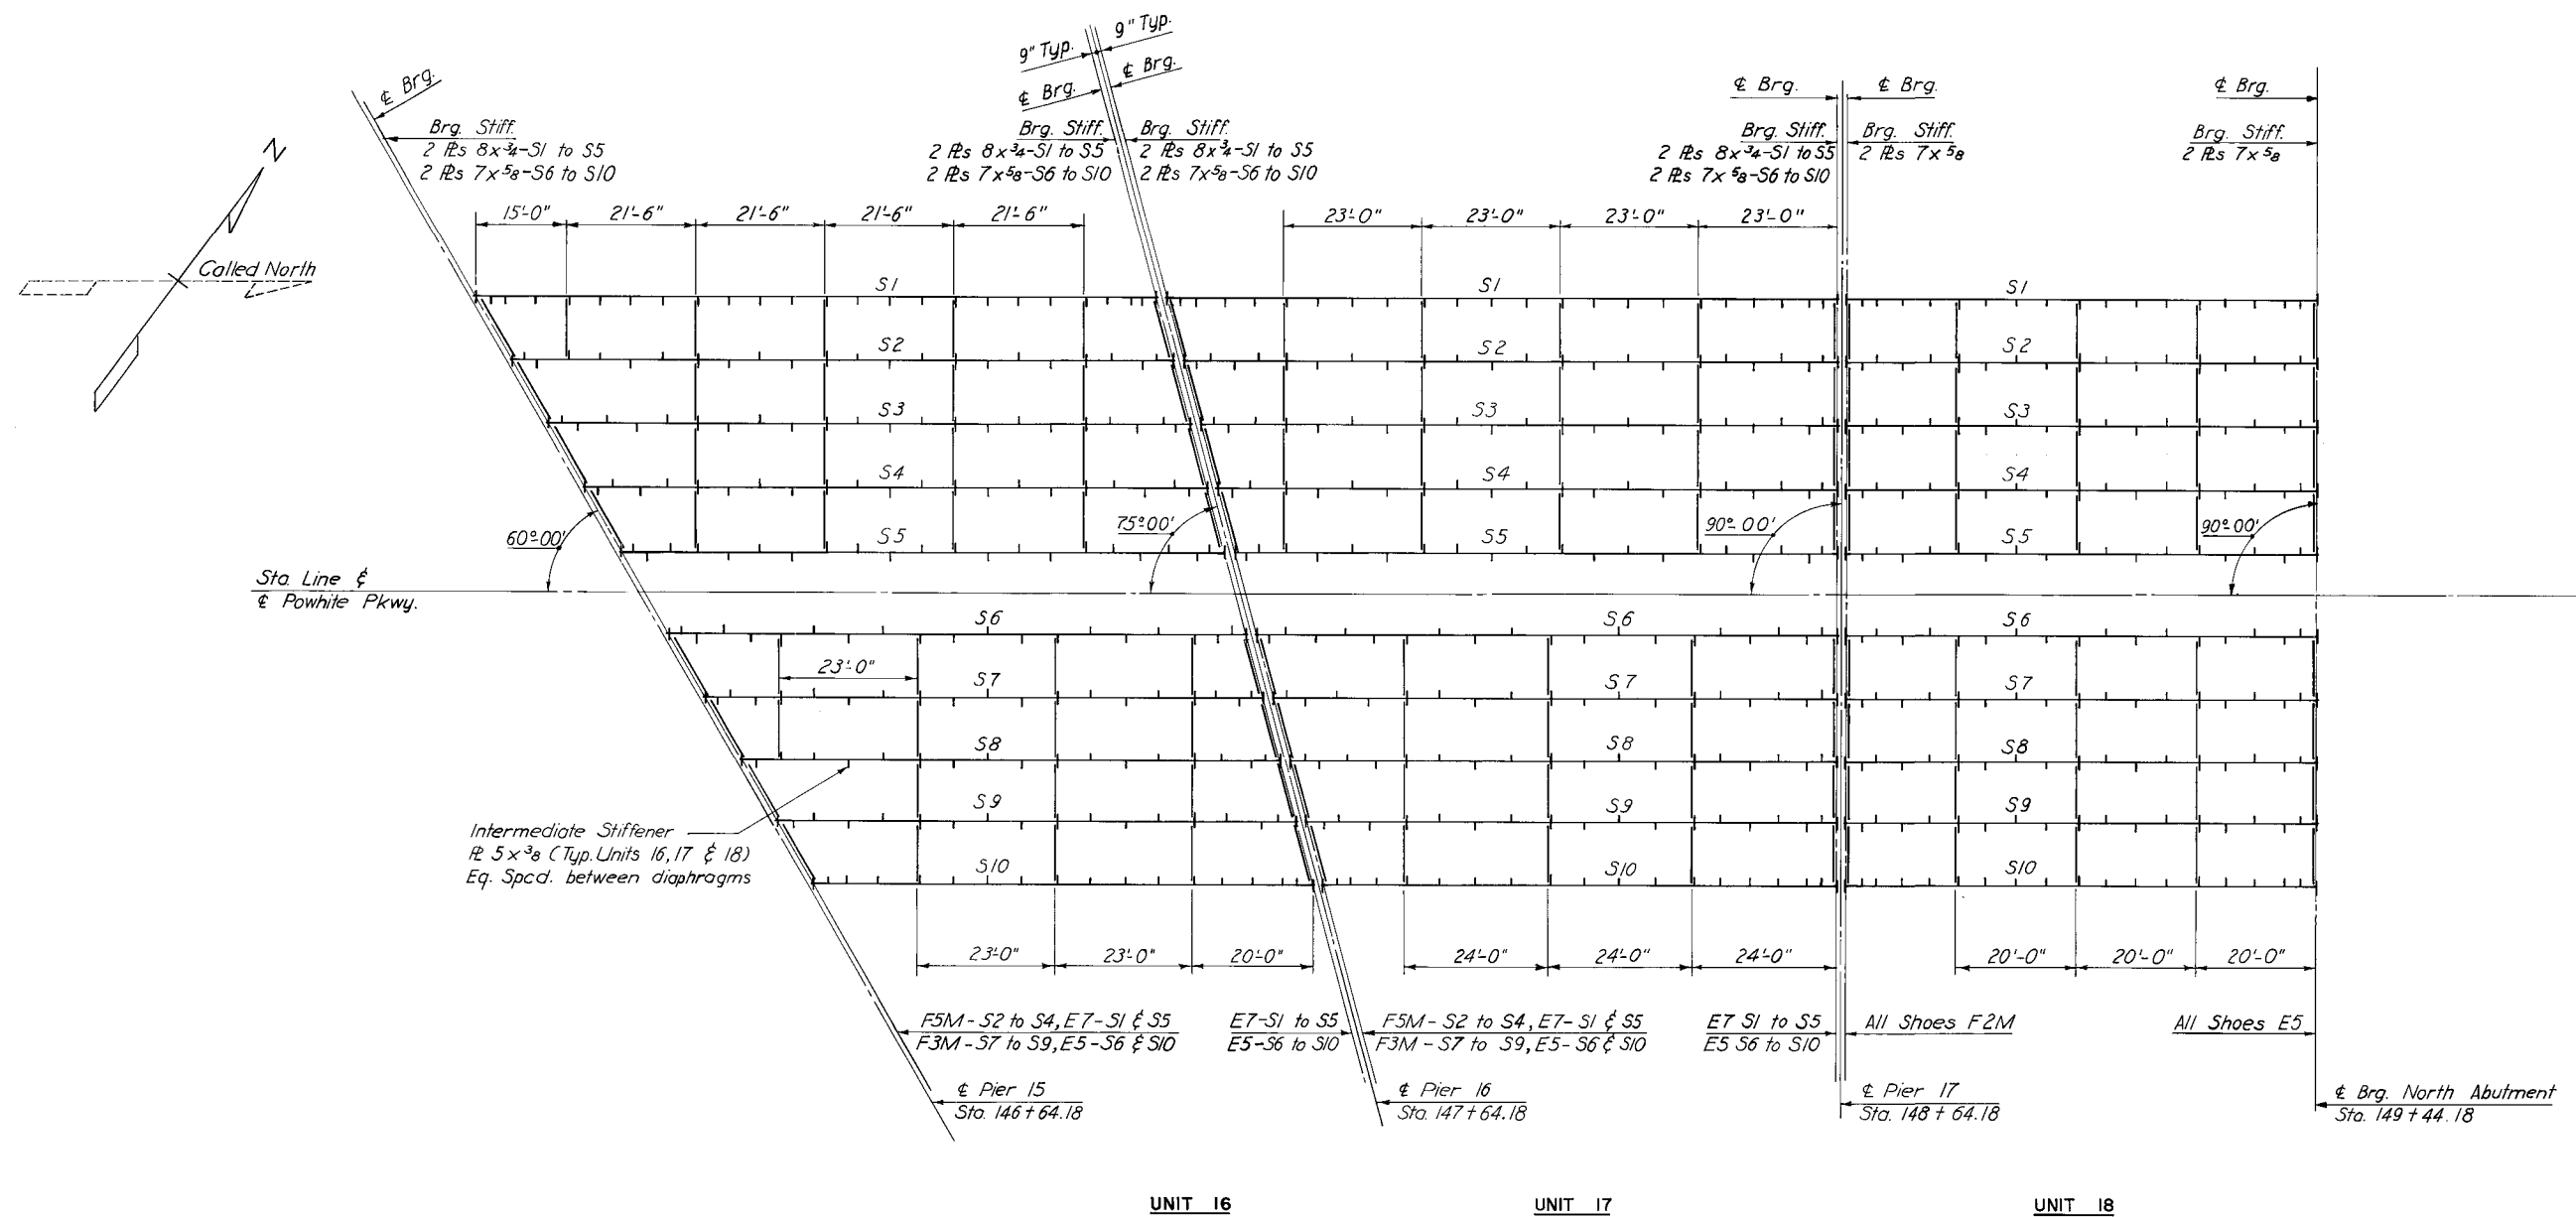

STRINGER LENGTHS (c to c Bearing)								
Unit	Stringer	Length	Unit	Stringer	Length	Unit	Stringer	Length
16	S1	113'-5 ⁵ / ₁₆ "	16 (cont'd)	S8	89'-9 ¹ / ₄ "	17 (cont'd)	S5	100'-3 ³ / ₈ "
	S2	110'-2 ⁵ / ₁₆ "		S9	85'-6 ¹ / ₄ "		S6	96'-8"
	S3	106'-11 ⁵ / ₁₆ "		S10	83'-3 ⁵ / ₁₆ "		S7	93'-10 ³ / ₁₆ "
	S4	103'-8 ⁵ / ₁₆ "		S1	111'-6 ¹ / ₁₆ "		S8	91'-0 ⁷ / ₁₆ "
	S5	100'-5 ³ / ₈ "	17	S2	108'-8 ¹ / ₁₆ "		S9	88'-2 ¹ / ₁₆ "
	S6	96'-3 ¹ / ₄ "		S3	105'-10 ⁷ / ₈ "		S10	85'-4 ¹⁵ / ₁₆ "
	S7	93'-0 ¹ / ₄ "		S4	103'-18"		S1-S10	79'-3"


BY	DATE				
MADE	EVR	7-67			
CHECKED	FXH	8-67	1	AS BUILT	JRC 12-72
IN CHARGE	FXH		NO.	REVISION	BY DATE

RICHMOND METROPOLITAN AUTHORITY
RICHMOND EXPRESSWAY SYSTEM


JAMES RIVER BRIDGE
FRAMING PLAN UNITS 16,17 & 18

SCALE: 1" = 15'-0"
CONTRACT NO.: C-3
SHEET NO. 31 OF 53


HOWARD, NEEDLES, TAMMEN & BERGENDOFF
consulting engineers
NEW YORK ALEXANDRIA KANSAS CITY

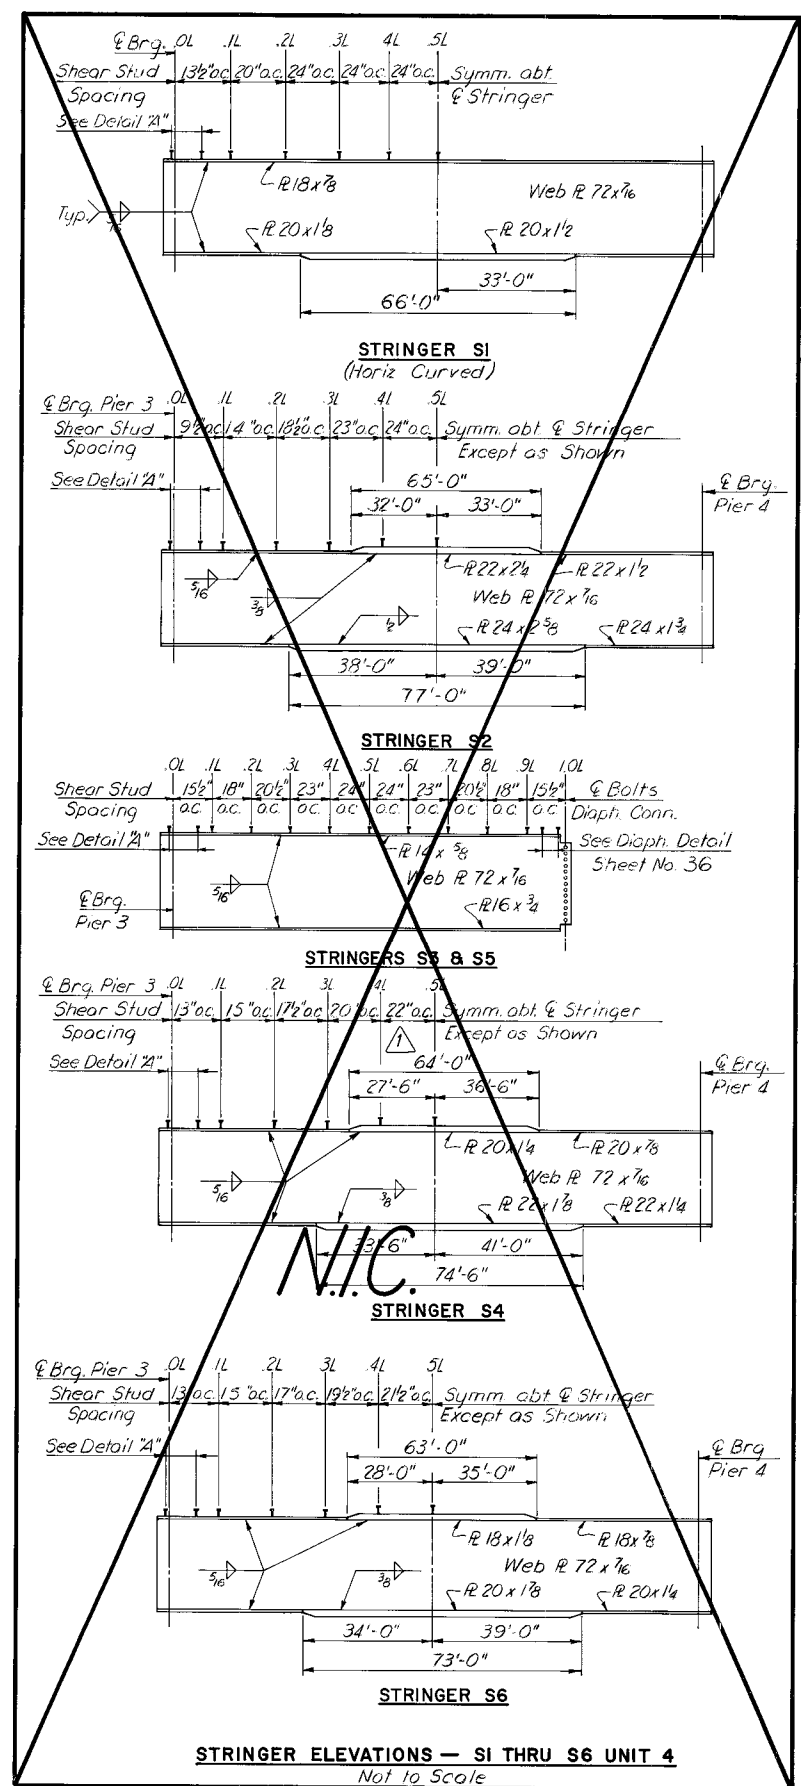

STRINGER ELEVATIONS — SI THRU S6 UNIT 4
Not to Scale

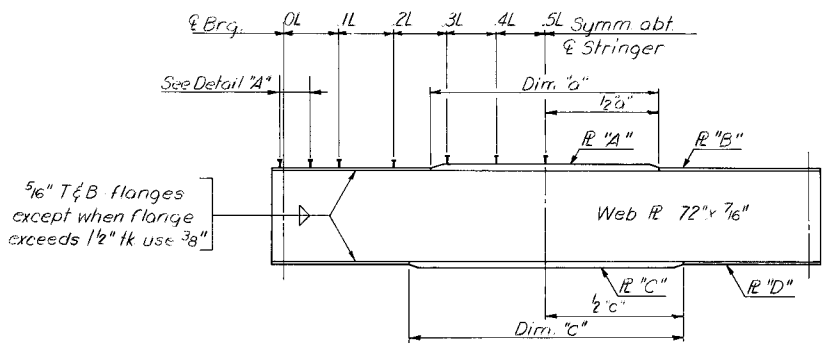


TYPICAL STRINGER ELEVATION
Not to Scale

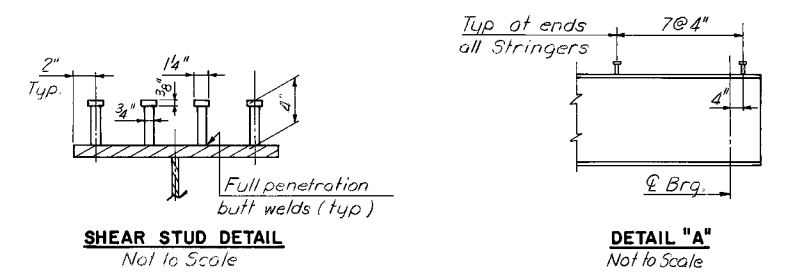

SHEAR STUD DETAIL
Not to Scale

DETAIL "A"
Not to Scale

SHEAR STUD NOTE:
Capacity = 3400 lbs. per stud.
The contractor may, if he elects, use three 7/8" diameter studs at the same longitudinal spacing in lieu of four 3/4" diameter studs shown.
Stud rows shall be placed parallel to the main deck reinforcing.
Shear stud spacing shown is maximum spacing.

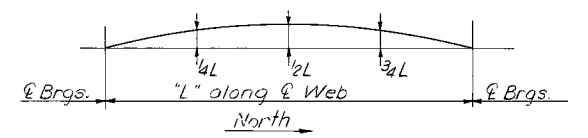

CAMBER DIAGRAM

NOTE TO FABRICATOR:
Stringers fabricated with an upward camber amounting to (see table). This will provide approximate compensation for deflection under full dead load.

UNIT	STRINGER	R. "A"	Dim. "a"	R. "B"	R. "C"	Dim. "c"	R. "D"	SHEAR STUD SPACING				
								0L-1L	1L-2L	2L-3L	3L-4L	4L-5L
1	S5&S6	14 x 3/8	F.L.	—	16 x 1/2	F.L.	—	12"	13 1/2"	15"	18 1/2"	20 1/2"
	SI-S4, S7-S10	14 x 5/8	F.L.	—	16 x 1	40'-6"	16 x 3/4	11 1/2"	13 1/2"	15 1/2"	18"	20"
2	S5&S6	16 x 3/4	F.L.	—	18 x 1 1/2	60'-6"	18 x 7/8	12"	14"	18"	22"	24"
	SI-S4, S7-S10	16 x 3/2	F.L.	—	18 x 1 1/2	58'-6"	18 x 1	12"	14"	16"	19"	21"
3	S5&S6	16 x 3/4	F.L.	—	18 x 1 1/2	60'-6"	18 x 7/8	12"	14"	18"	22"	24"
	SI-S4, S7-S10	16 x 3/2	F.L.	—	18 x 1 1/2	58'-6"	18 x 1	12"	14"	16"	19"	21"
4	SI-S4, S7-S10	18 x 1/2	62'-0"	18 x 7/8	20 x 1 1/2	74'-6"	20 x 1 1/4	12 1/2"	14 1/2"	17 1/2"	21"	23"
	S5&S6	18 x 1 1/2	59'-0"	18 x 7/8	20 x 1 1/2	72'-0"	20 x 1 1/4	12 1/2"	14 1/2"	18 1/2"	23 1/2"	24"
5	S5&S6	18 x 1 1/4	66'-0"	18 x 7/8	20 x 2	73'-0"	20 x 1 3/8	12 1/2"	14 1/2"	17 1/2"	21"	24"
	SI-S4, S7-S10	18 x 1 1/2	68'-6"	18 x 7/8	20 x 2	75'-6"	20 x 1 3/8	12 1/2"	14 1/2"	17 1/2"	21"	23 1/2"
6	S5&S6	18 x 1 1/4	66'-0"	18 x 7/8	20 x 2	73'-0"	20 x 1 3/8	12 1/2"	14 1/2"	17 1/2"	21"	24"
	SI-S4, S7-S10	18 x 1 1/2	68'-6"	18 x 7/8	20 x 2	75'-6"	20 x 1 3/8	12 1/2"	14 1/2"	17 1/2"	21"	23 1/2"
7 Thru 12	SI-S4, S7-S10	18 x 1 3/8	68'-6"	18 x 7/8	20 x 2	75'-6"	20 x 1 3/8	12 1/2"	14 1/2"	17 1/2"	21"	23 1/2"
	S5&S6	16 x 1 1/4	66'-0"	18 x 7/8	20 x 2	73'-0"	20 x 1 3/8	12 1/2"	14 1/2"	17 1/2"	21"	24"
13	S1	14 x 3/8	F.L.	—	16 x 1 1/2	51'-0"	16 x 3/4	11 1/2"	13"	15 1/2"	18"	20"
	S2	14 x 3/8	F.L.	—	16 x 1 1/4	51'-0"	16 x 3/8	11 1/2"	13 1/2"	15 1/2"	18"	20"
14	S3	14 x 3/8	F.L.	—	16 x 1 3/8	55'-6"	16 x 3/8	11 1/2"	13 1/2"	16 1/2"	18 1/2"	20"
	S4	14 x 3/8	F.L.	—	16 x 1 1/2	55'-6"	16 x 1	12"	13 1/2"	15 1/2"	18 1/2"	20"
15	SI-S4, S7-S10	16 x 3/4	F.L.	—	18 x 1 1/2	66'-6"	18 x 1 1/8	12"	14"	17"	19 1/2"	21 1/2"
	S5&S6	16 x 3/2	F.L.	—	18 x 1 3/8	67'-0"	18 x 1 1/4	12"	14"	17"	20"	22"
16	S1	16 x 1 1/8	63'-6"	16 x 3/4	18 x 2	68'-6"	18 x 1 3/8	12 1/2"	14"	16 1/2"	20 1/2"	22 1/2"
	S2	16 x 1	57'-0"	16 x 3/4	18 x 1 1/2	67'-0"	18 x 1 1/4	12"	14"	17"	20"	22"
17	S3	16 x 1	57'-0"	16 x 3/8	18 x 1 3/8	66'-6"	18 x 1 1/8	12"	14"	17"	19 1/2"	21 1/2"
	S4	16 x 7/8	F.L.	—	18 x 1 1/2	61'-0"	18 x 1 1/2	12"	14"	16"	19 1/2"	21"
18	SI-S4, S7-S10	14 x 3/8	F.L.	—	16 x 1	40'-6"	16 x 3/4	11 1/2"	13 1/2"	15 1/2"	18"	20"
	S5&S6	14 x 3/8	F.L.	—	16 x 3/8	F.L.	—	12"	13 1/2"	15"	18 1/2"	20 1/2"

NOTES:
For General Notes see sheet no. 4.
For Joint Details see sheet no. 35.
For Shoe Details see sheet no. 34.
Scupper locations shown on Deck Plans. For Scupper Details see sheet no. 36.
For stringer lengths see Framing Plans.

BY	DATE				
MADE	HBW 7-67	2	AS BUILT	JRC	12-72
CHECKED	FXH 8-67	1	Remove Ramp Toper Strs.	H.B.W.	2/20/71
IN CHARGE	FXH	NO.	REVISION	BY	DATE


RICHMOND METROPOLITAN AUTHORITY
RICHMOND EXPRESSWAY SYSTEM

JAMES RIVER BRIDGE
STRUCTURAL STEEL DETAILS


HOWARD, NEEDLES, TAMMEN & BERGENDOFF
consulting engineers
NEW YORK ALEXANDRIA KANSAS CITY

SCALE: AS SHOWN
CONTRACT NO.: C-3
SHEET NO. 32 OF 53


RICHMOND EXPRESSWAY SYSTEM			
SECTION	PROJECT	SHEET NO.	TOTAL SHEETS
3	JAMES RIVER BRIDGE	33	53

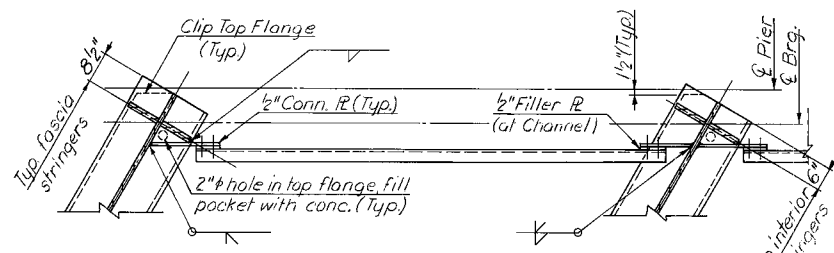

PLAN - SKEW 30°

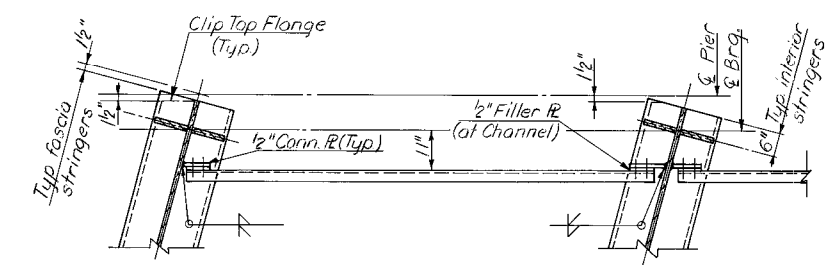


PLAN - SKEW 15°

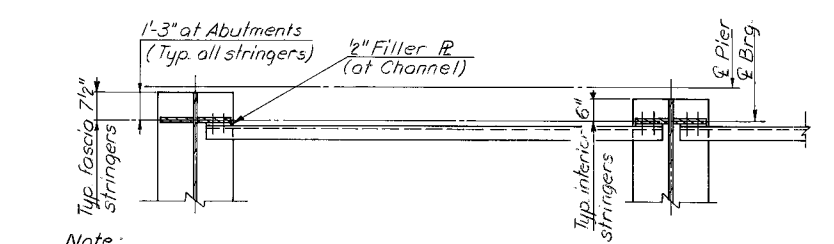

PLAN - SKEW 0° THRU 10°


Note:
For Skew up to 10°
Bearing Stiffeners to
be parallel to C Brg.

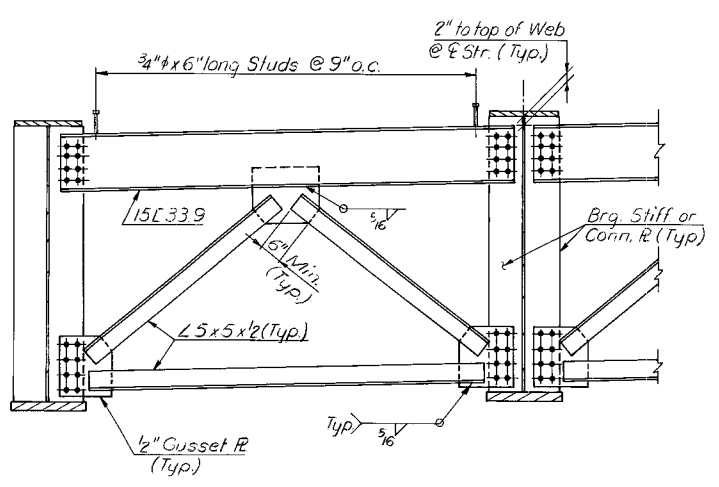

ELEVATION

TYPICAL END DIAPHRAGM DETAILS

Scale: 1/2" = 1'-0"

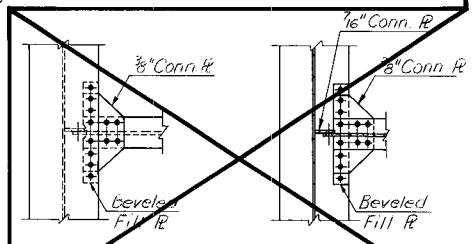


SECTION B-B

SECTION C-C


Scale: 1/2" = 1'-0"

Scale: 1/2" = 1'-0"

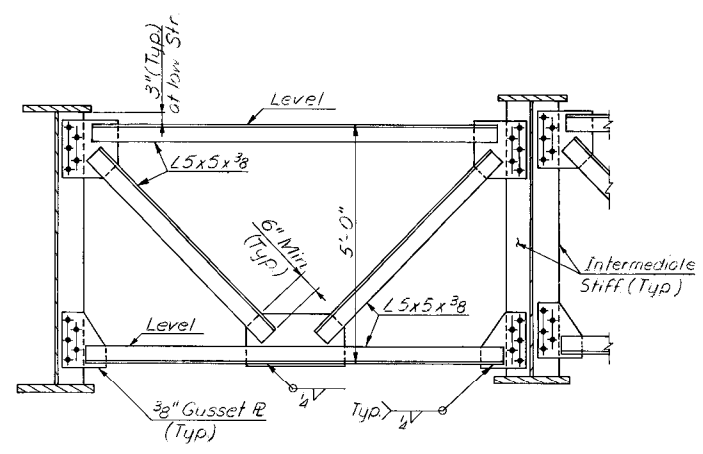


TYPICAL INTERMEDIATE DIAPHRAGM

Scale: 1/2" = 1'-0"

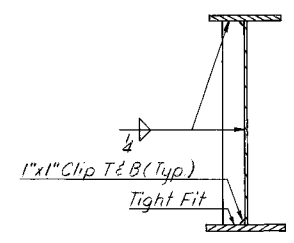


INTERMEDIATE STIFFENER DETAILS

Not to Scale

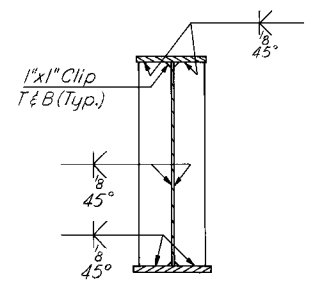

BEARING STIFFENER DETAIL


Not to Scale

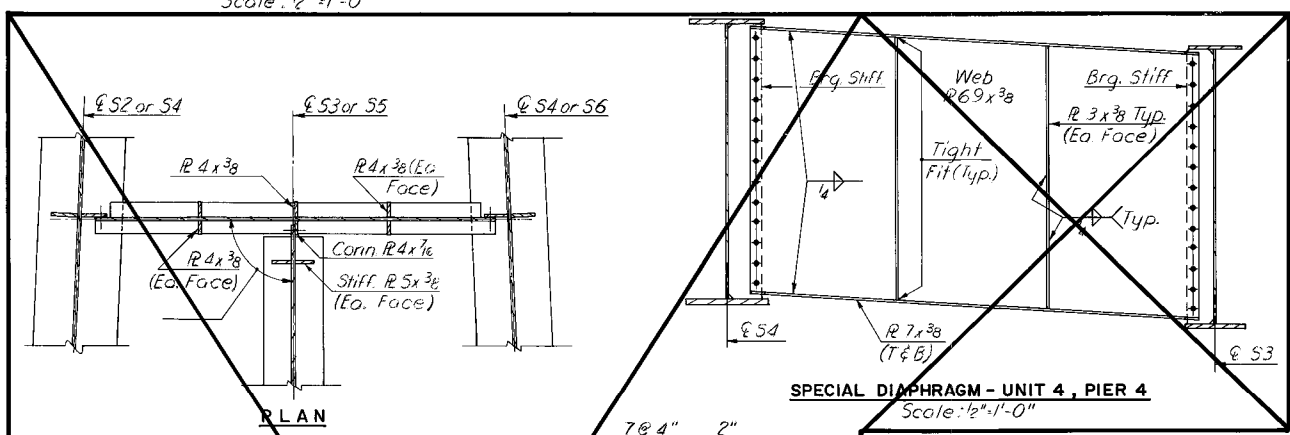

PLAN

SPECIAL DIAPHRAGM - UNIT 4, PIER 4

Scale: 1/2" = 1'-0"

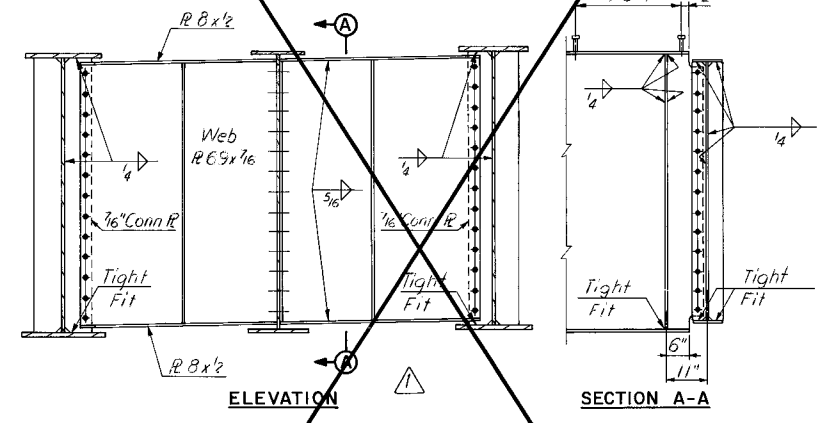


ELEVATION

SECTION A-A


DETAILS OF DIAPHRAGM AT END OF STRINGER S3 & S5 - UNIT 4

Scale: 1/2" = 1'-0"

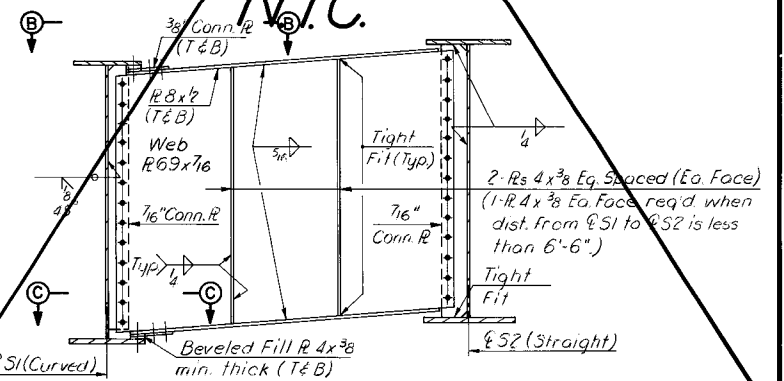

INTERMEDIATE DIAPHRAGM BETWEEN STRINGERS S1 & S2 - UNIT 4

Scale: 1/2" = 1'-0"

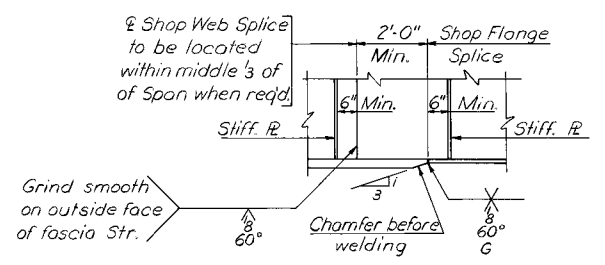

SHOP SPLICE DETAIL

Not to Scale

BY	DATE	NO.	REVISION	BY	DATE
MADE	HBW 7-67	2	AS BUILT	JRC	12-72
CHECKED	FXH 8-67		Remove Ramp Framing	J.G.V.	2-20-71
IN CHARGE	FXH				


AS BUILT

RICHMOND METROPOLITAN AUTHORITY
RICHMOND EXPRESSWAY SYSTEM


JAMES RIVER BRIDGE
STRUCTURAL STEEL DETAILS

HOWARD, NEEDLES, TAMMEN & BERGENDOFF
consulting engineers
NEW YORK ALEXANDRIA KANSAS CITY


SCALE: AS SHOWN
CONTRACT NO.: C-3
SHEET NO. 33 OF 53

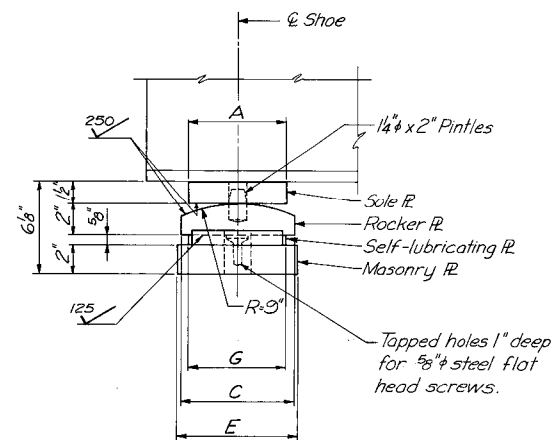


SIDE ELEVATION

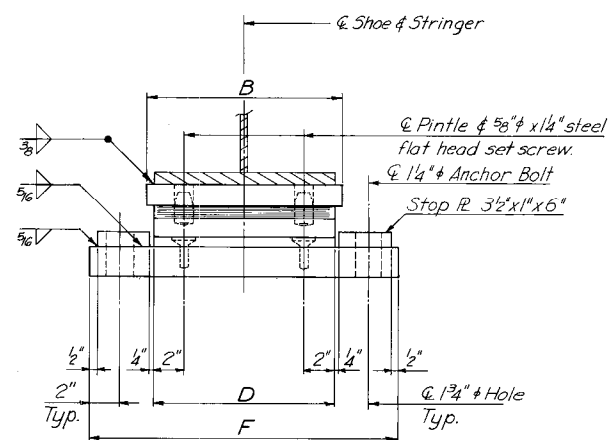

END ELEVATION

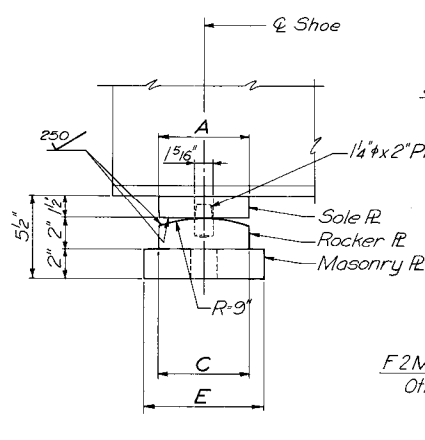


SIDE ELEVATION

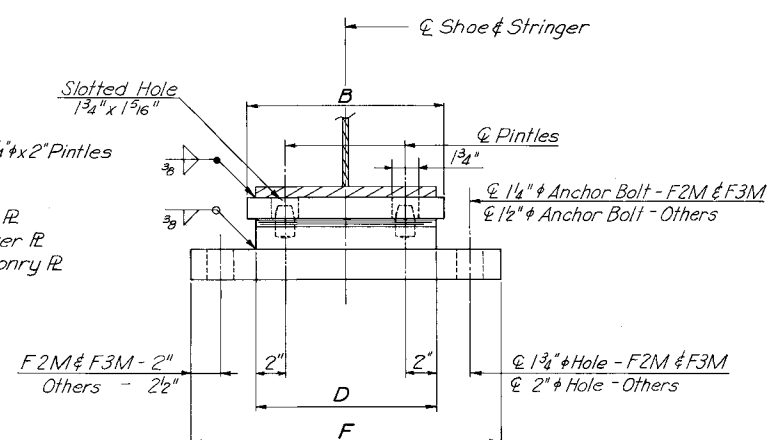


END ELEVATION

EXPANSION SHOE

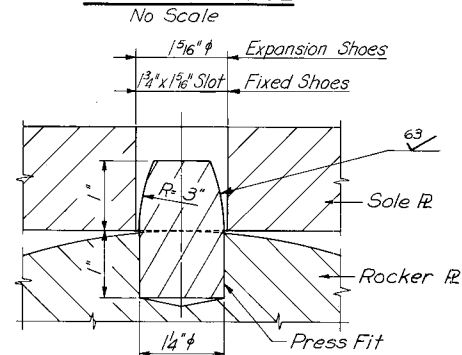

PINTLE DETAIL


Scale: 3/4" = 1"

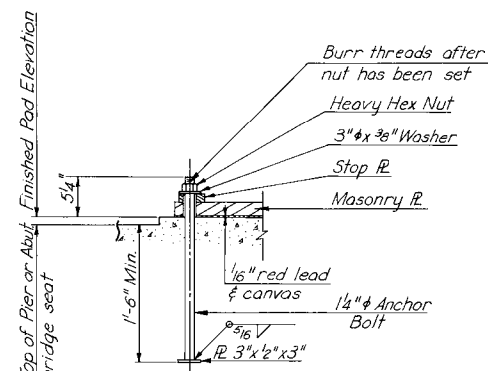

EXPANSION SHOE

ANCHOR BOLT DETAIL

No Scale

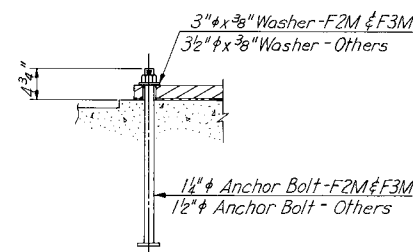

FIXED SHOE

Note:
Anchor Bolt for Fixed Shoes same as Anchor Bolt for Exp. Shoes except as shown.

Shoe Notes:

Top of masonry plates, bottom of rocker plates and top and bottom of sole plates planed, straightened or otherwise treated to secure true level surfaces. Contact surfaces noted on the plans with finish symbols shall be finished in accordance with the American National Standards Institute surface roughness requirement, as defined in ASA B46.1 Surface Roughness, Waviness and Lay, Part I. The plates comprising the expansion shoes shall be set so as to be truly centered under full dead load at a temperature of 68°F. Concrete pads shall be formed integral with abutment or pier and not less than 1/8" or more than 1/4" above finished elevation. Dress down pads by rubbing, grinding or as otherwise approved by the Engineer, to true level surfaces at the finished elevation. Anchor bolt assemblies shall conform to A.S.T.M. A-307 and shall be hot-dip galvanized conforming to A.S.T.M. A-153. Templates shall be used to accurately set the anchor bolts. Material for shoes (exclusive of self-lubricating plates) shall be high strength low alloy structural steel conforming to A.S.T.M. Specification A-588. Material for self-lubricating plates shall be Leaded Tin Bronze conforming to A.S.T.M. Specification B22, alloy D modified to the extent that 1.5 to 2.5 percent lead is allowable. Shoes shall be included with structural steel item for payment.

SHOE DIMENSIONS														
EXPANSION SHOES	A	B	C	D	E	F	G	FIXED SHOES	A	B	C	D	E	F
	E4	6"	1-3/4"	8"	1-4/8"	9 1/2"	2-1"		6"	F2M	6"	1-5/2"	6"	1-4/2"
E5	6"	1-5/2"	9"	1-4/8"	9 1/2"	2-1"	7"	F3M	6"	1-5/2"	6"	1-4/2"	8"	2-1"
E6	6"	1-7"	8"	1-6"	8 1/2"	2-2 1/2"	6"	F4M	6"	1-7"	6"	1-6"	7"	2-4"
E7	6"	1-7"	9 1/2"	1-6"	10 1/2"	2-2 1/2"	7 1/2"	F5M	6"	1-7"	6"	1-6"	8"	2-4"
E8	6"	1-9"	9"	1-9"	9 1/2"	2-2 1/2"	6"	F6M	6"	1-9"	6"	1-8"	7"	2-6"
E9	6"	1-9"	10"	1-8"	11"	2-4 1/2"	7 1/2"	F7M	6"	1-9"	6"	1-8"	8"	2-6"
E11	6"	1-11"	10"	1-10"	11"	2-6 1/2"	7 1/2"	F9M	6"	1-11"	6"	1-10"	8"	2-8"
E12	6"	2-1"	9"	2-0"	9 1/2"	2-8 1/2"	6 1/2"	F10M	6"	2-1"	6"	2-0"	7"	2-10"
E14	6"	2-1"	11-0"	2-0"	11-1"	2-8 1/2"	9 1/2"							







BY	DATE				
MADE	HBW	5-67	2	AS BUILT	JRC 12-72
CHECKED	FXH	8-67	Δ	Delete Shoes	H.B.W. 3/20/77
IN CHARGE	FXH		NO.	REVISION	BY DATE

RICHMOND METROPOLITAN AUTHORITY
RICHMOND EXPRESSWAY SYSTEM

JAMES RIVER BRIDGE
SHOES

HOWARD, NEEDLES, TAMMEN & BERGENDOFF
consulting engineers
NEW YORK ALEXANDRIA KANSAS CITY

SCALE: AS SHOWN
CONTRACT NO. C-3
SHEET NO. 34 OF 53

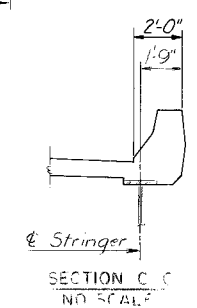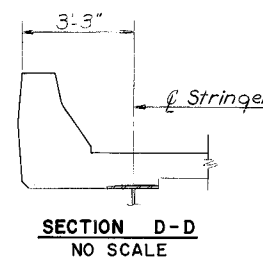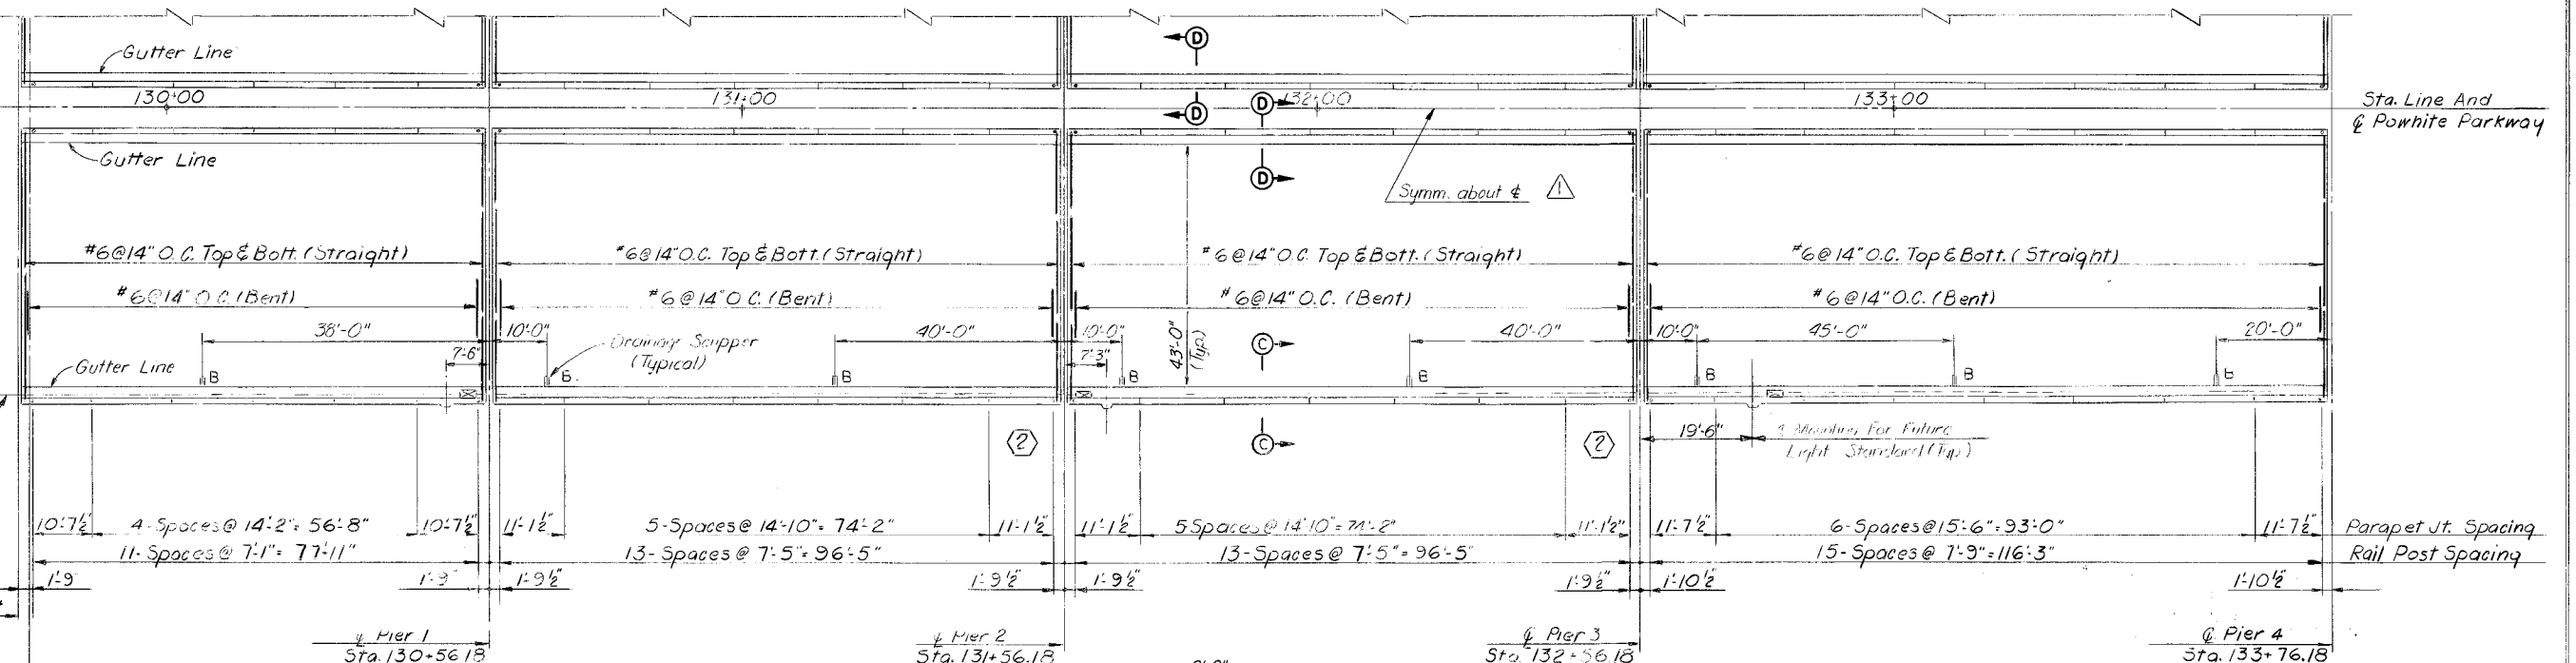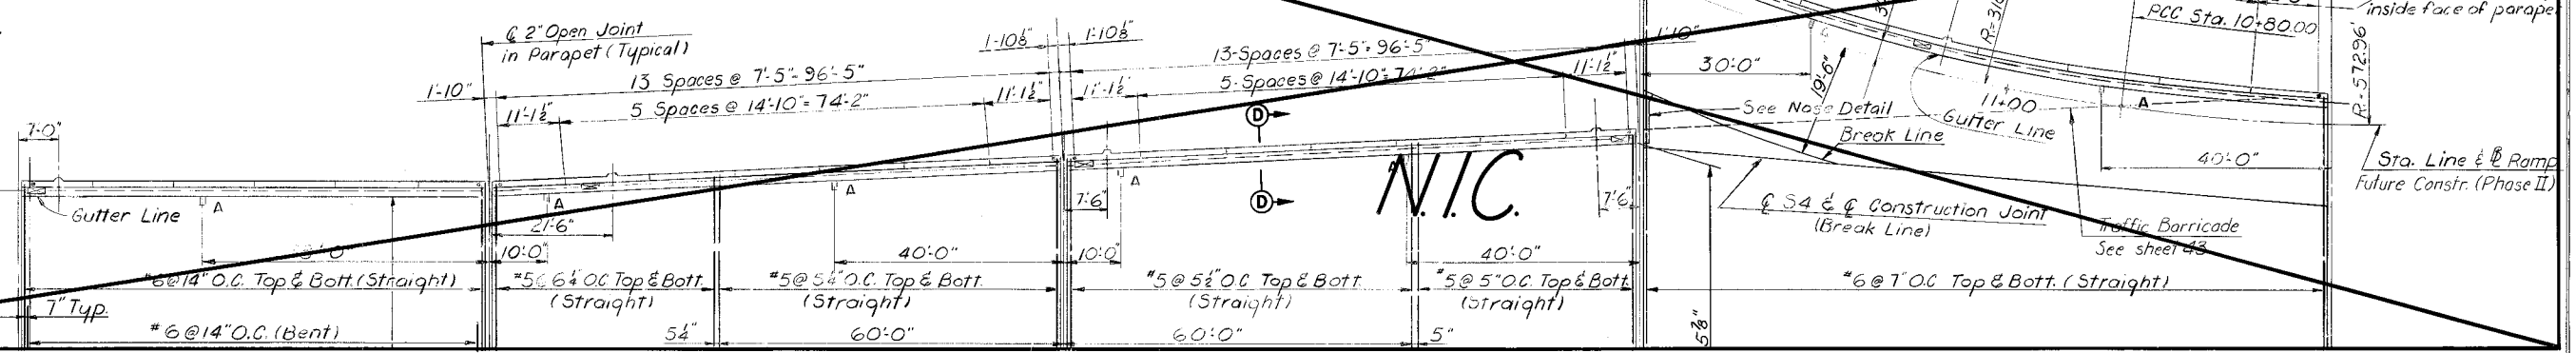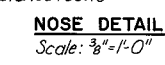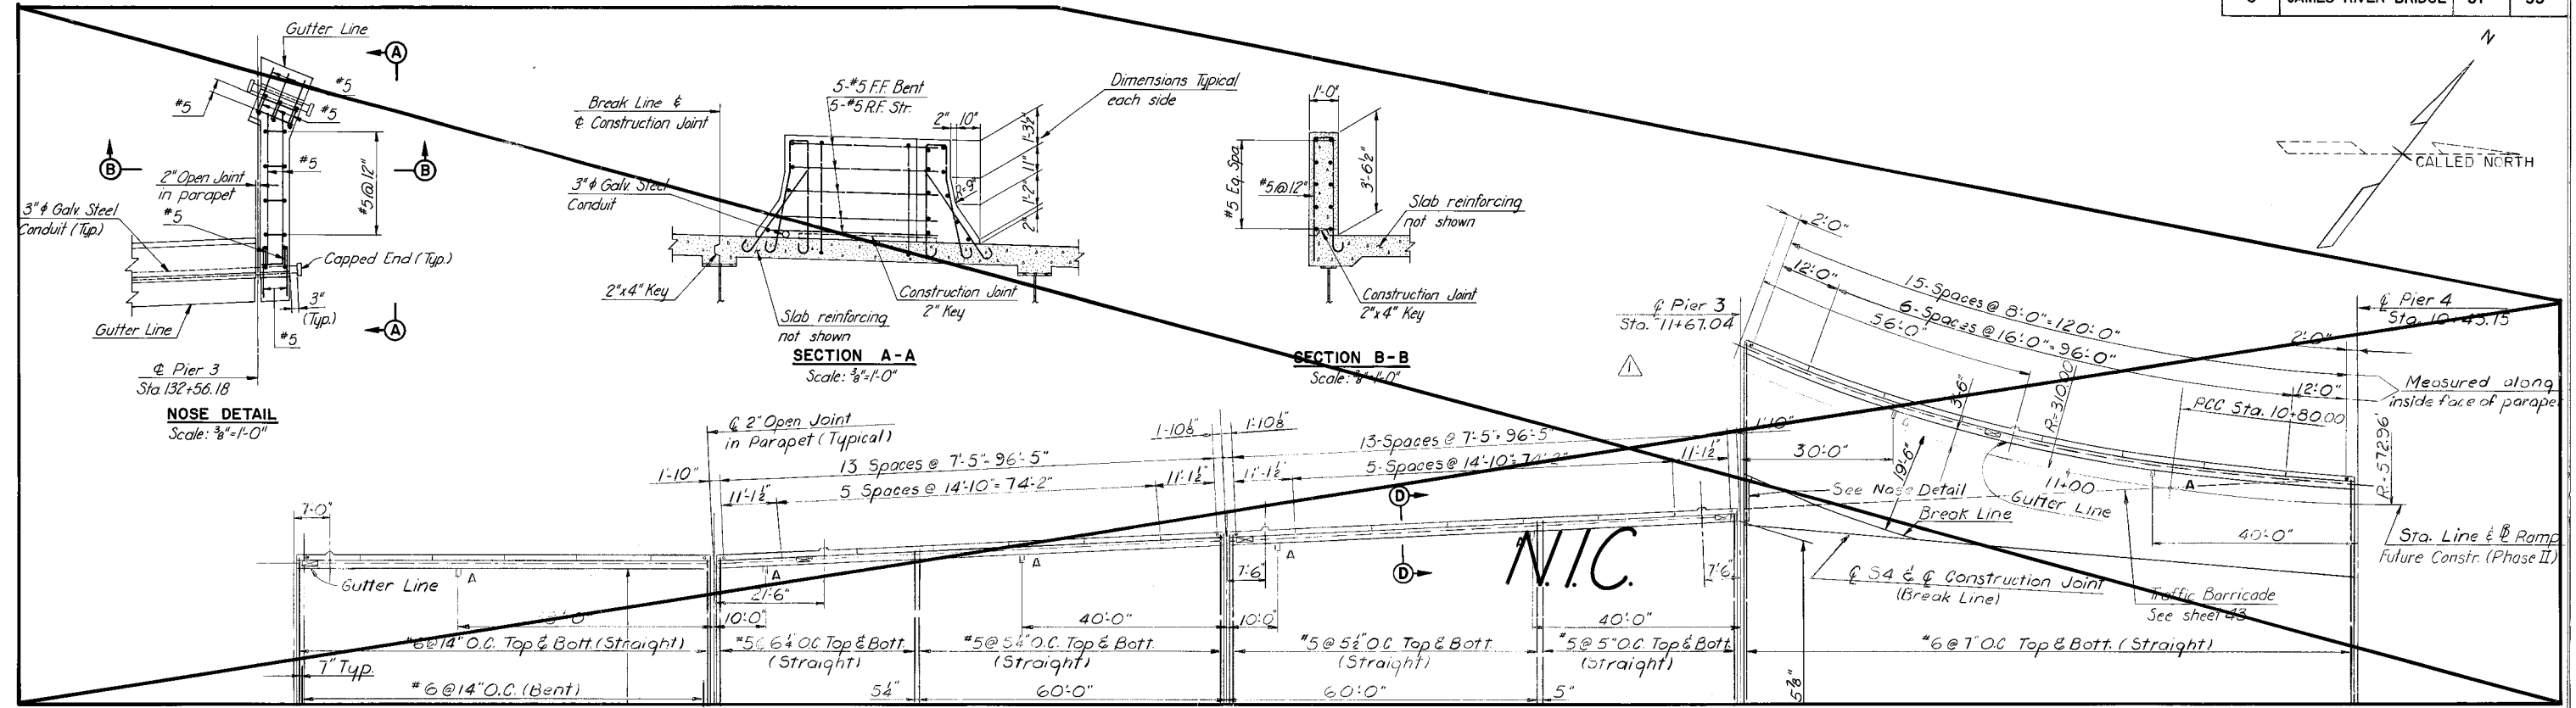

Notes:
 For General Notes see Sheet No. 4.
 For Longitudinal Reinforcement, additional reinforcement at Deck Joints, additional Details and Cross Section see Sheet No. 41.
 For Details of Mounting for Future Lighting Standard see Sheet No. 44.
 For Joint Details see Sheet No. 35.
 For Scupper Details see Sheet No. 36.

RICHMOND METROPOLITAN AUTHORITY
RICHMOND EXPRESSWAY SYSTEM






JAMES RIVER BRIDGE
DECK PLAN - UNITS 1, 2, 3 & 4

HOWARD, NEEDLES, TAMMEN & BERGENDOFF
 consulting engineers
 NEW YORK ALEXANDRIA KANSAS CITY

SCALE: 1"=15' UNLESS NOTED
 CONTRACT NO.: C-3
 SHEET NO. 37 OF 53

BY	DATE	3	AS BUILT	JRC	12-72
MADE	DEK. 7-67	②	Light Std. Location	J.G.V.	3/9/71
CHECKED	HB.W. 9-67	⚠	Remove Ramp Taper	J.G.V.	2-20-71
IN CHARGE	FX.H.	NO.	REVISION	BY	DATE

RICHMOND EXPRESSWAY SYSTEM			
SECTION	PROJECT	SHEET NO.	TOTAL SHEETS
3	JAMES RIVER BRIDGE	38	53

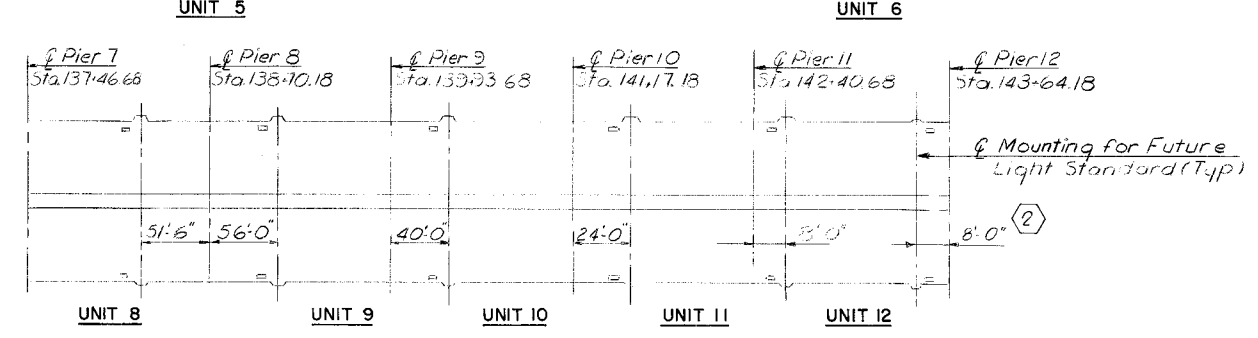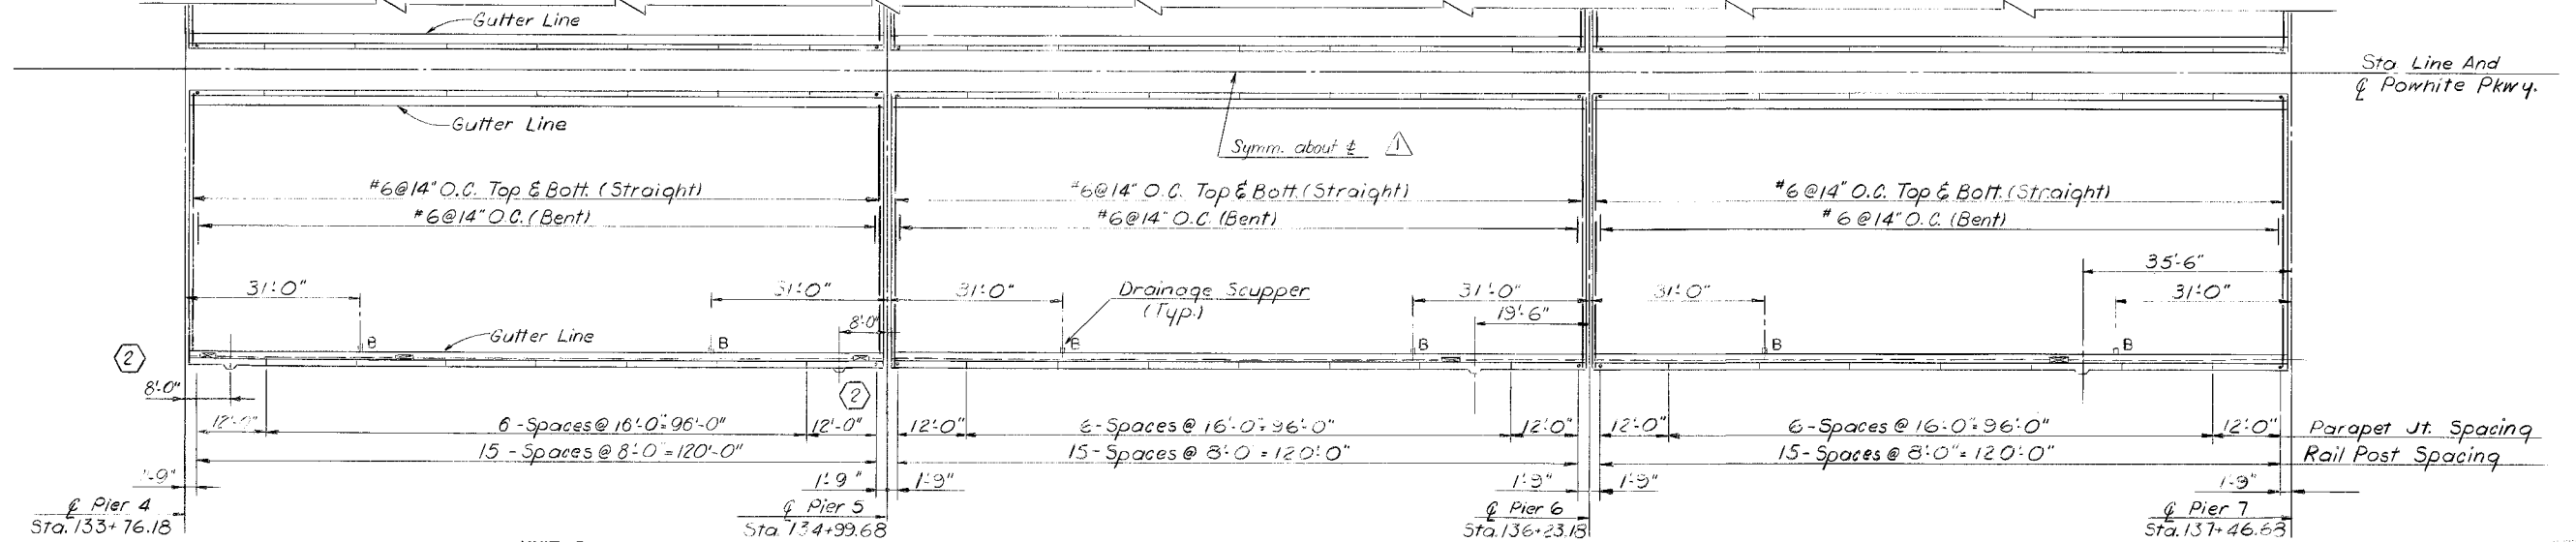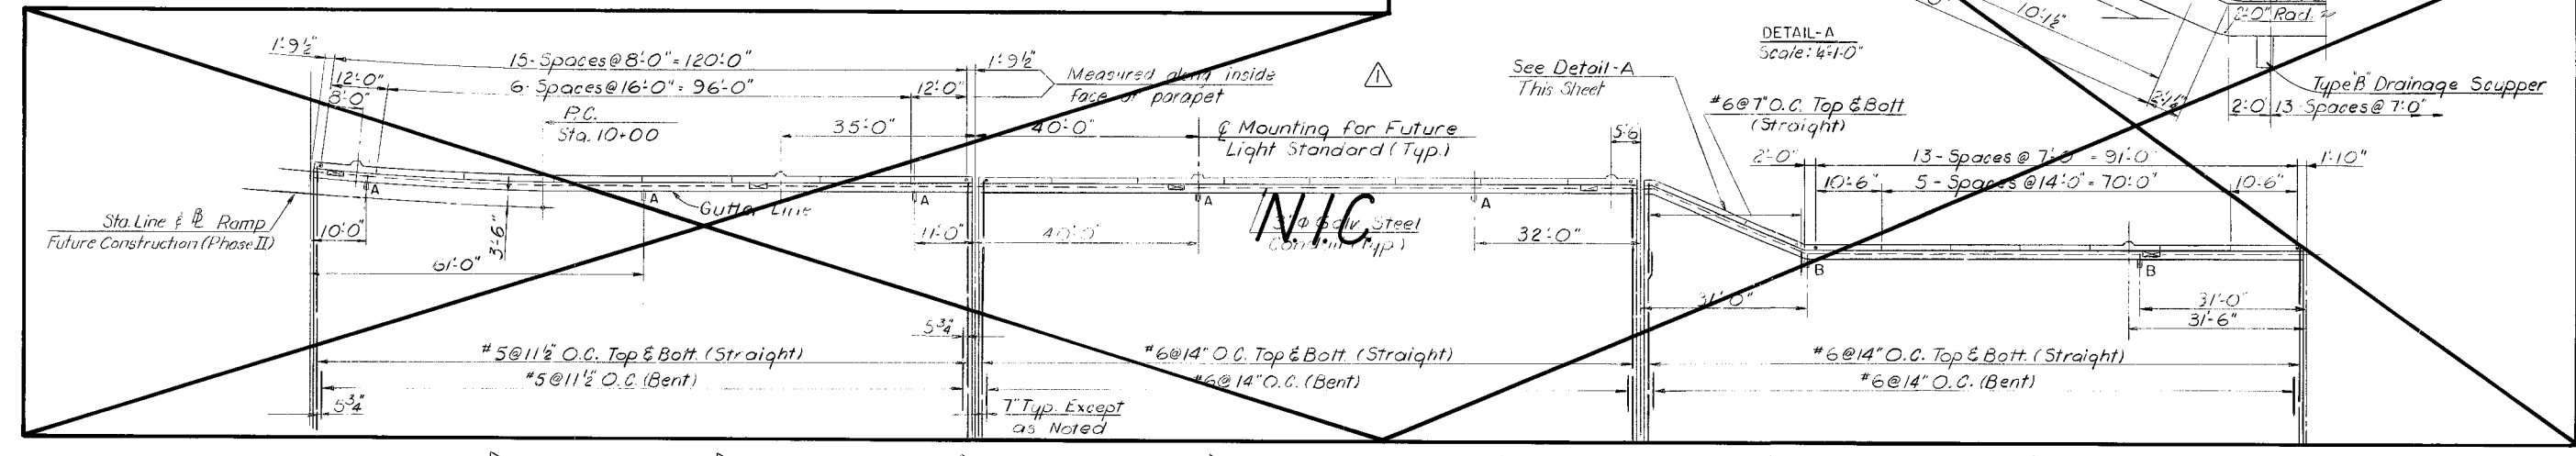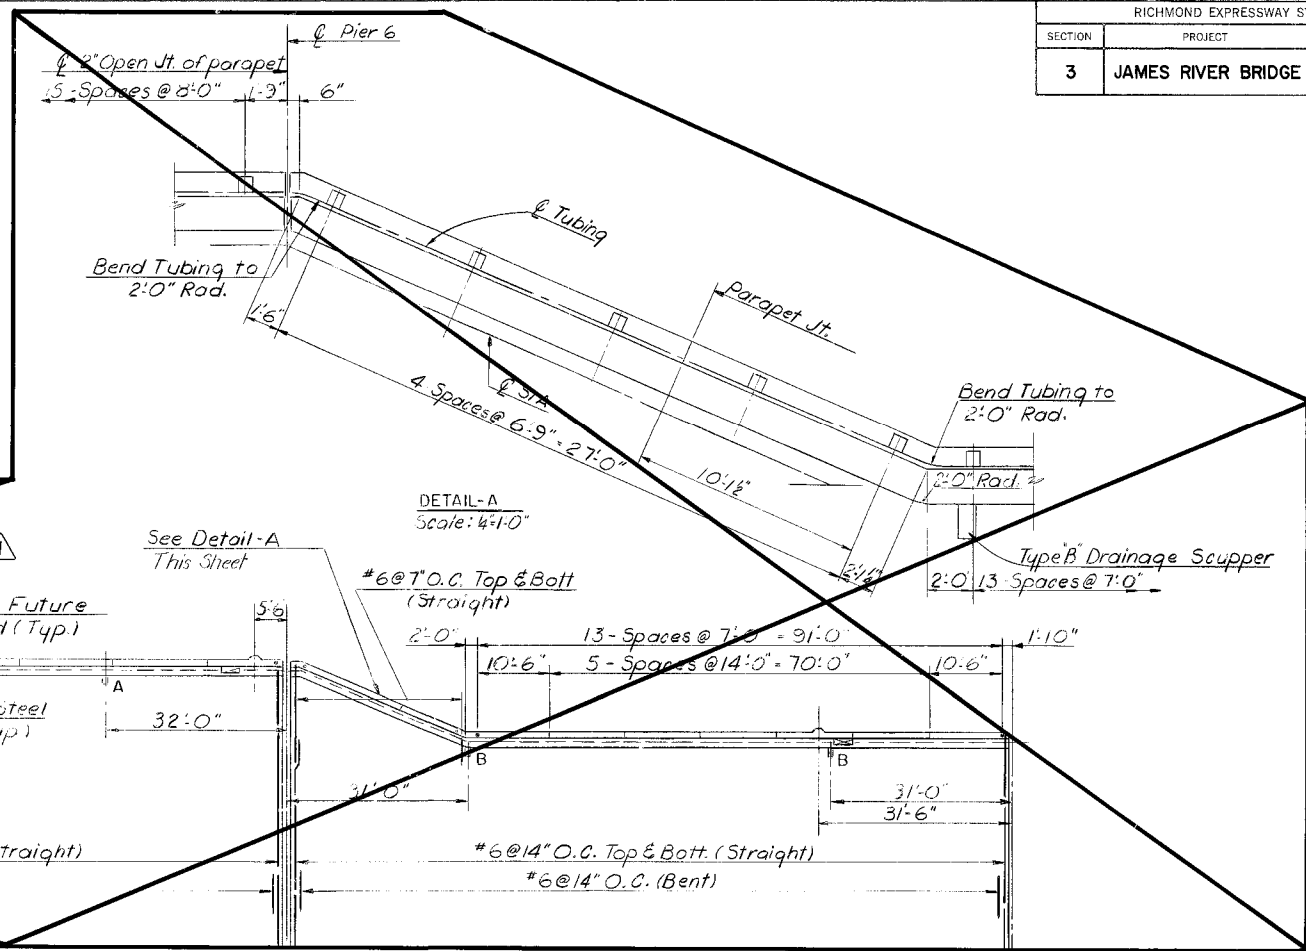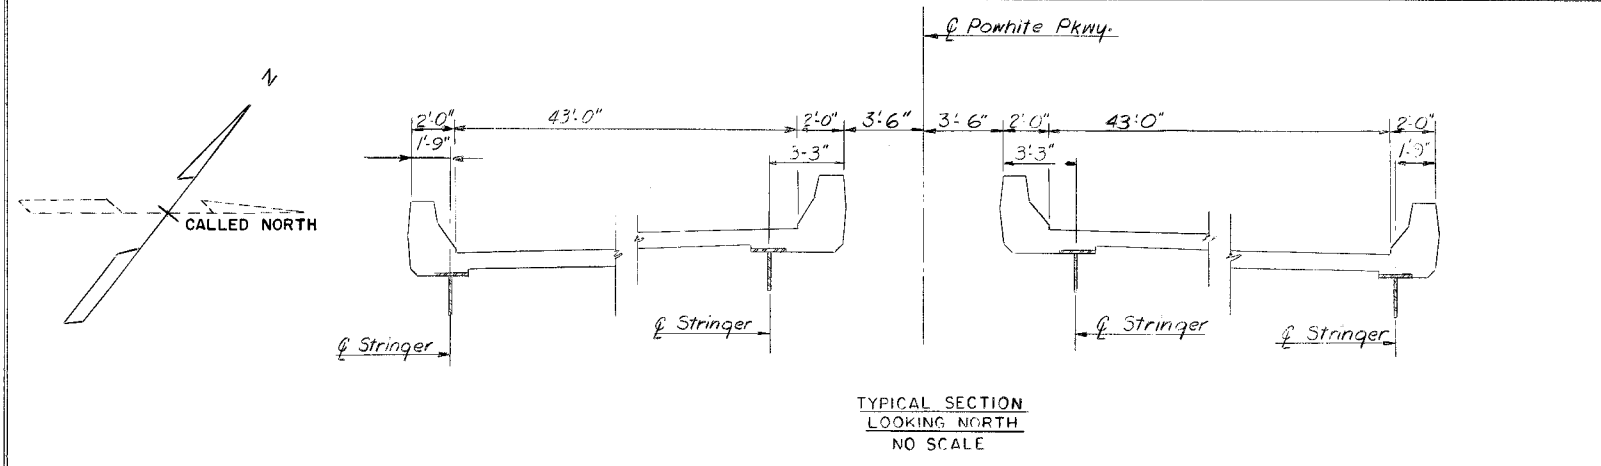

Notes:
For Notes see Sheet No. 37

RICHMOND METROPOLITAN AUTHORITY
RICHMOND EXPRESSWAY SYSTEM


JAMES RIVER BRIDGE
DECK PLAN-UNITS 5 THRU 12

BY	DATE	3	AS BUILT	JRC	12-72
MADE	D.E.K.	7-67	Light Std. Location	J.G.V.	3/9/77
CHECKED	H.B.W.	9-67	Remove Ramp Widening	J.G.V.	2-20-77
IN CHARGE	F.X.H.				

HOWARD, NEEDLES, TAMMEN & BERGENDOFF
consulting engineers
NEW YORK ALEXANDRIA KANSAS CITY


SCALE: 1" = 15' UNLESS NOTED
CONTRACT NO: C-3
SHEET NO. 38 OF 53

RICHMOND EXPRESSWAY SYSTEM			
SECTION	PROJECT	SHEET NO.	TOTAL SHEETS
3	JAMES RIVER BRIDGE	39	53

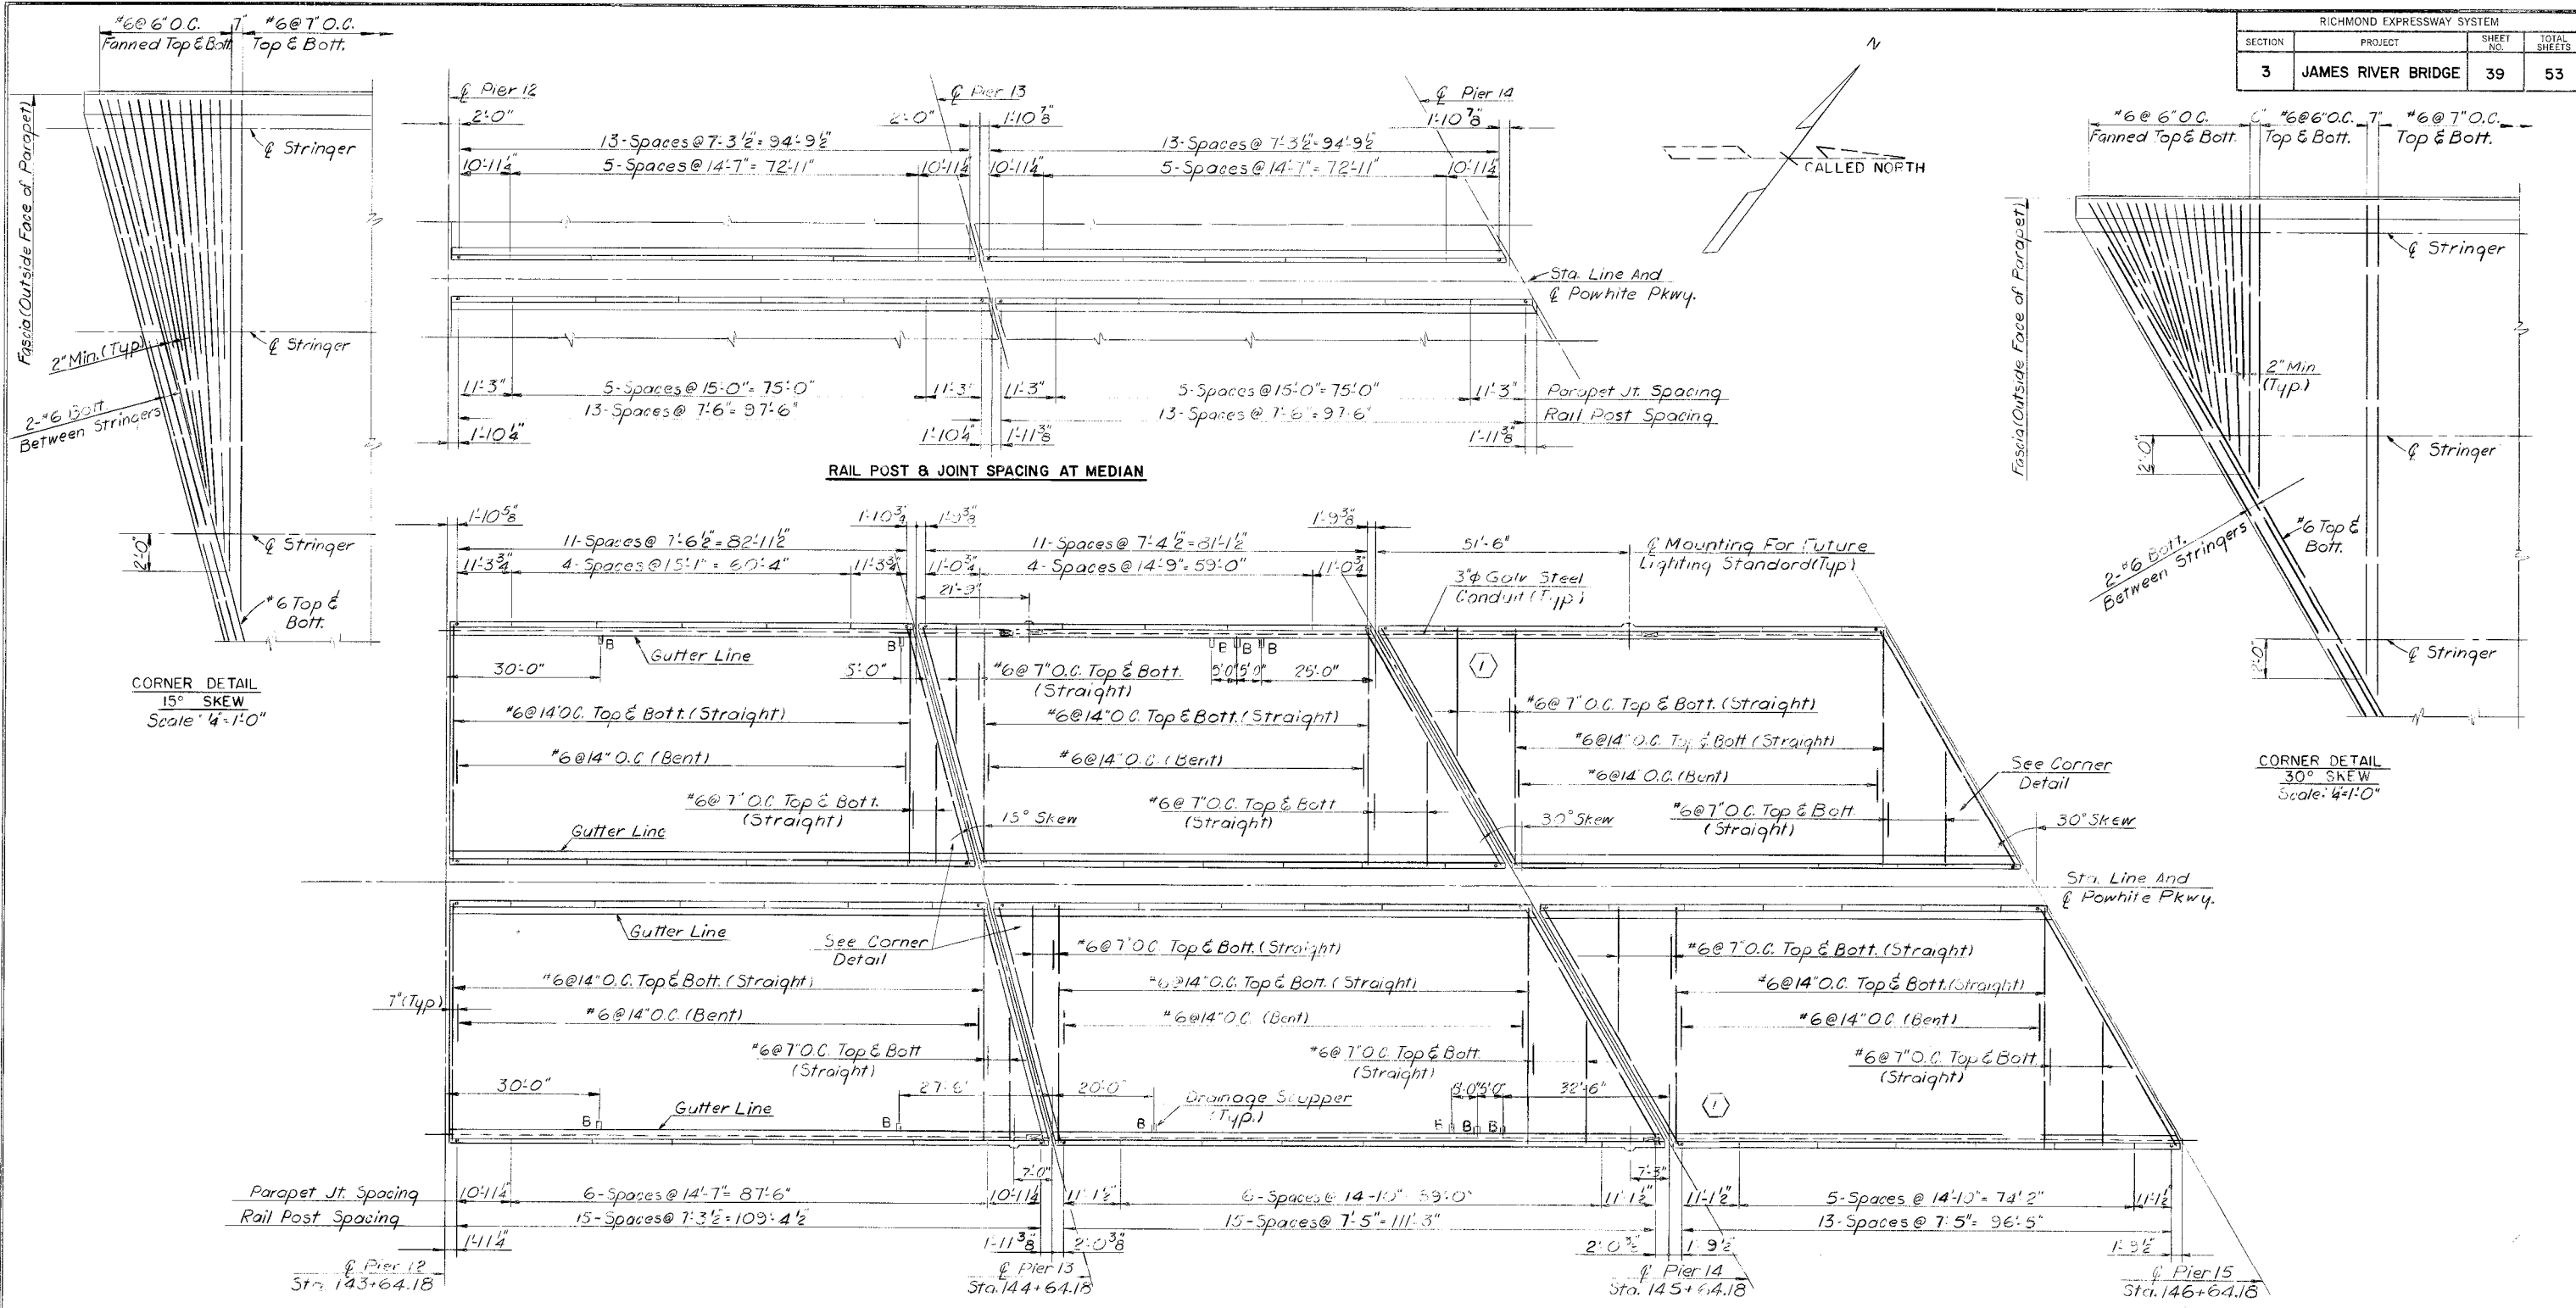

CORNER DETAIL
15° SKEW
Scale: 4"=1'-0"

CORNER DETAIL
30° SKEW
Scale: 4"=1'-0"

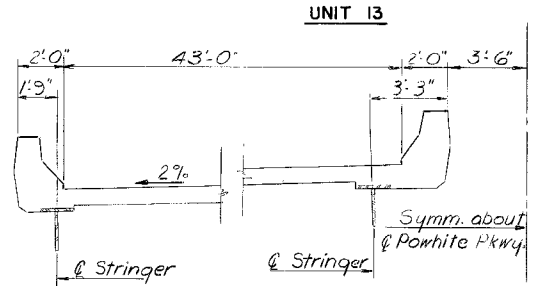

Notes:
For Notes See Sheet No. 37

BY	DATE	NO.	REVISION	BY	DATE
MADE	DE.K. 7-67	2	AS BUILT	JRC	12-72
CHECKED	H.B.W. 9-67	1	Light Std. & Scupper Location	J.G.V.	3/9/71
IN CHARGE	F.X.H.				



RICHMOND METROPOLITAN AUTHORITY
RICHMOND EXPRESSWAY SYSTEM

JAMES RIVER BRIDGE
DECK PLAN - UNITS 13, 14 & 15


HOWARD, NEEDLES, TAMMEN & BERGENDOFF
consulting engineers
NEW YORK ALEXANDRIA KANSAS CITY

SCALE: 1"=15' UNLESS NOTED
CONTRACT NO. C-3
SHEET NO. 39 OF 53






RICHMOND EXPRESSWAY SYSTEM			
SECTION	PROJECT	SHEET NO.	TOTAL SHEETS
3	JAMES RIVER BRIDGE	40	53

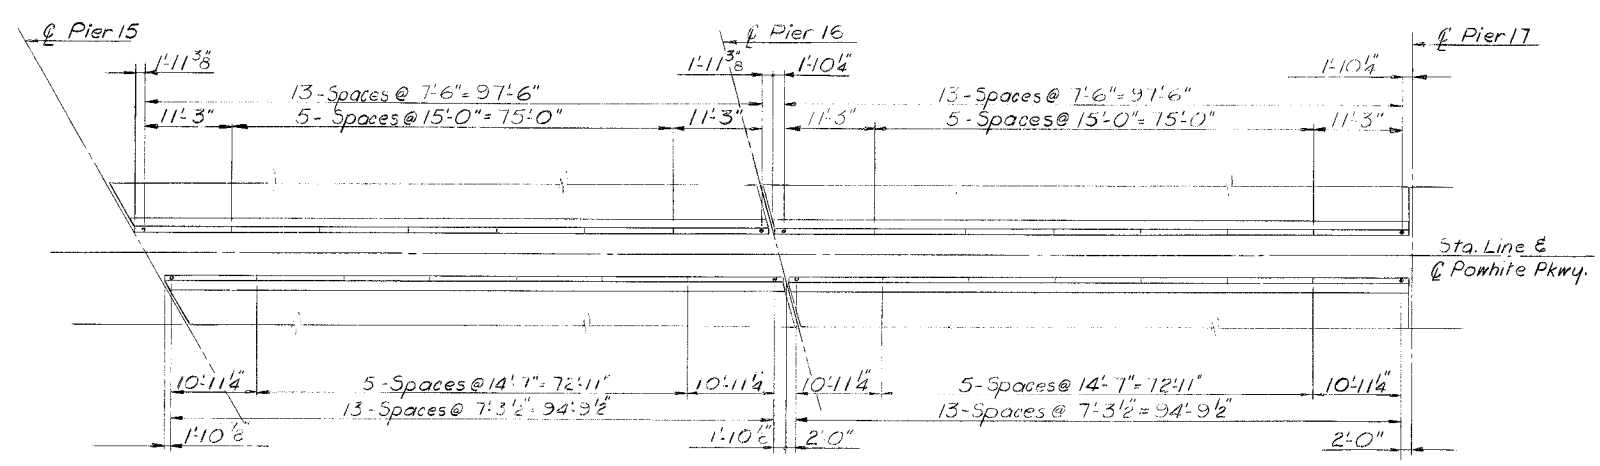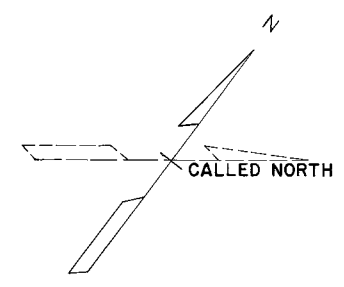

RAIL POST & JOINT SPACING AT MEDIAN

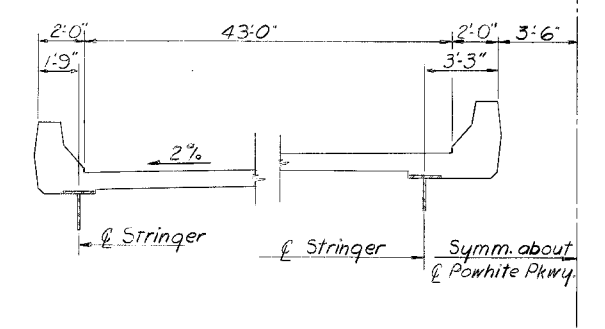

TYPICAL SECTION
SCALE: 1/4"=1'-0"

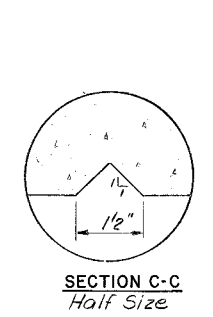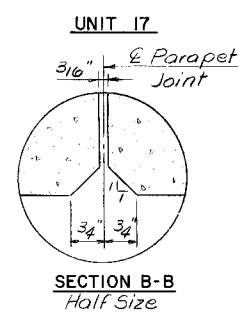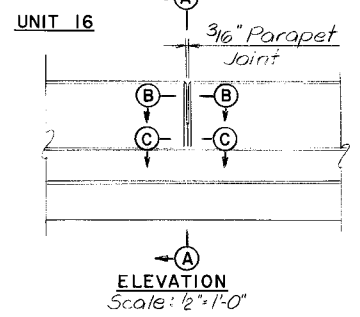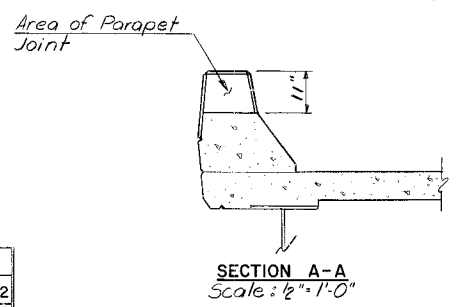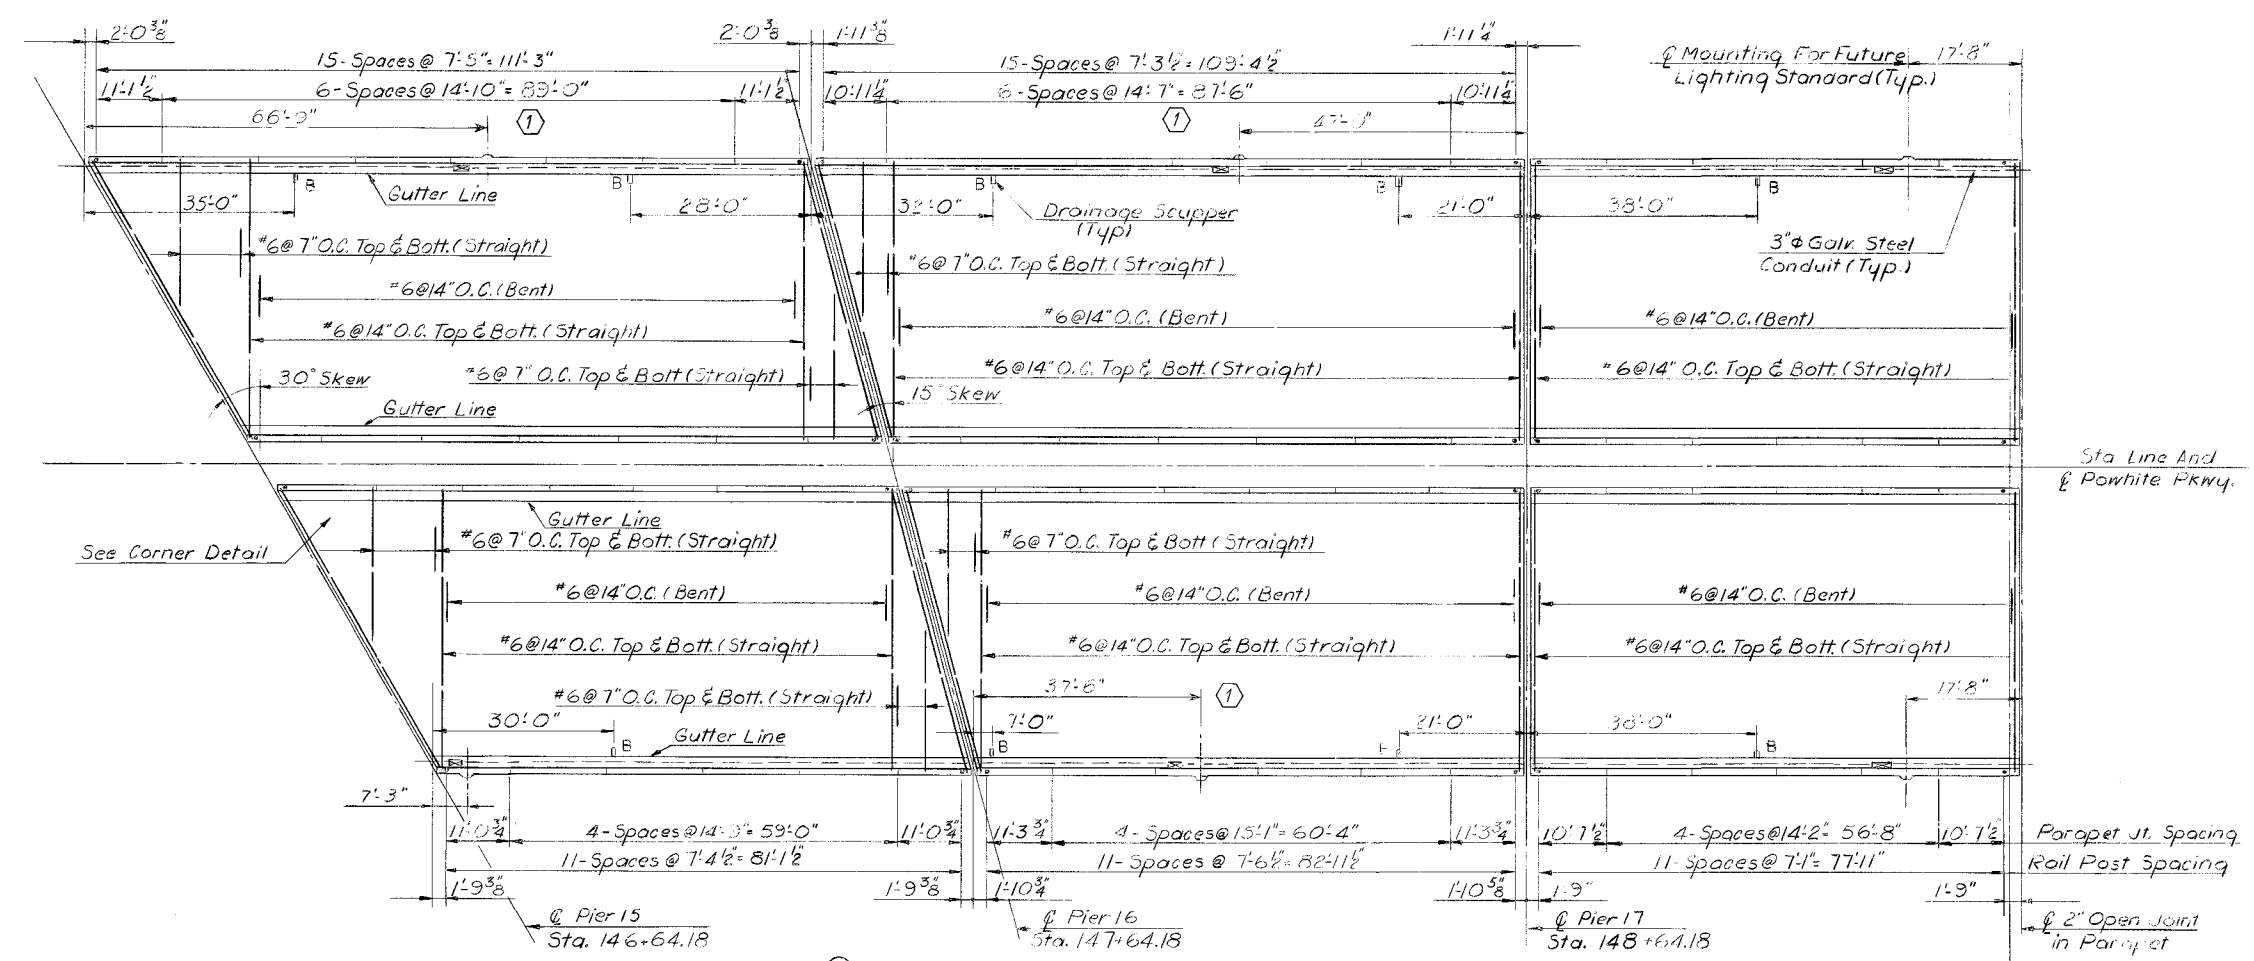

Notes:
For Notes See Sheet No. 37
For Corner Details See Sheet No. 39


BY	DATE	REVISION	BY	DATE
MADE	DE.K. 7-67	2 AS BUILT	JRC	12-72
CHECKED	H.B.W. 9-67	(1) Light Std. Location	H.B.W.	3/9/71
IN CHARGE	F.X.H.			

RICHMOND METROPOLITAN AUTHORITY
RICHMOND EXPRESSWAY SYSTEM

JAMES RIVER BRIDGE
DECK PLAN - UNITS 16, 17 & 18


HOWARD, NEEDLES, TAMMEN & BERGENDOFF
consulting engineers
NEW YORK ALEXANDRIA KANSAS CITY

SCALE: 1"=15' UNLESS NOTED
CONTRACT NO. C-3
SHEET NO. 40 OF 53

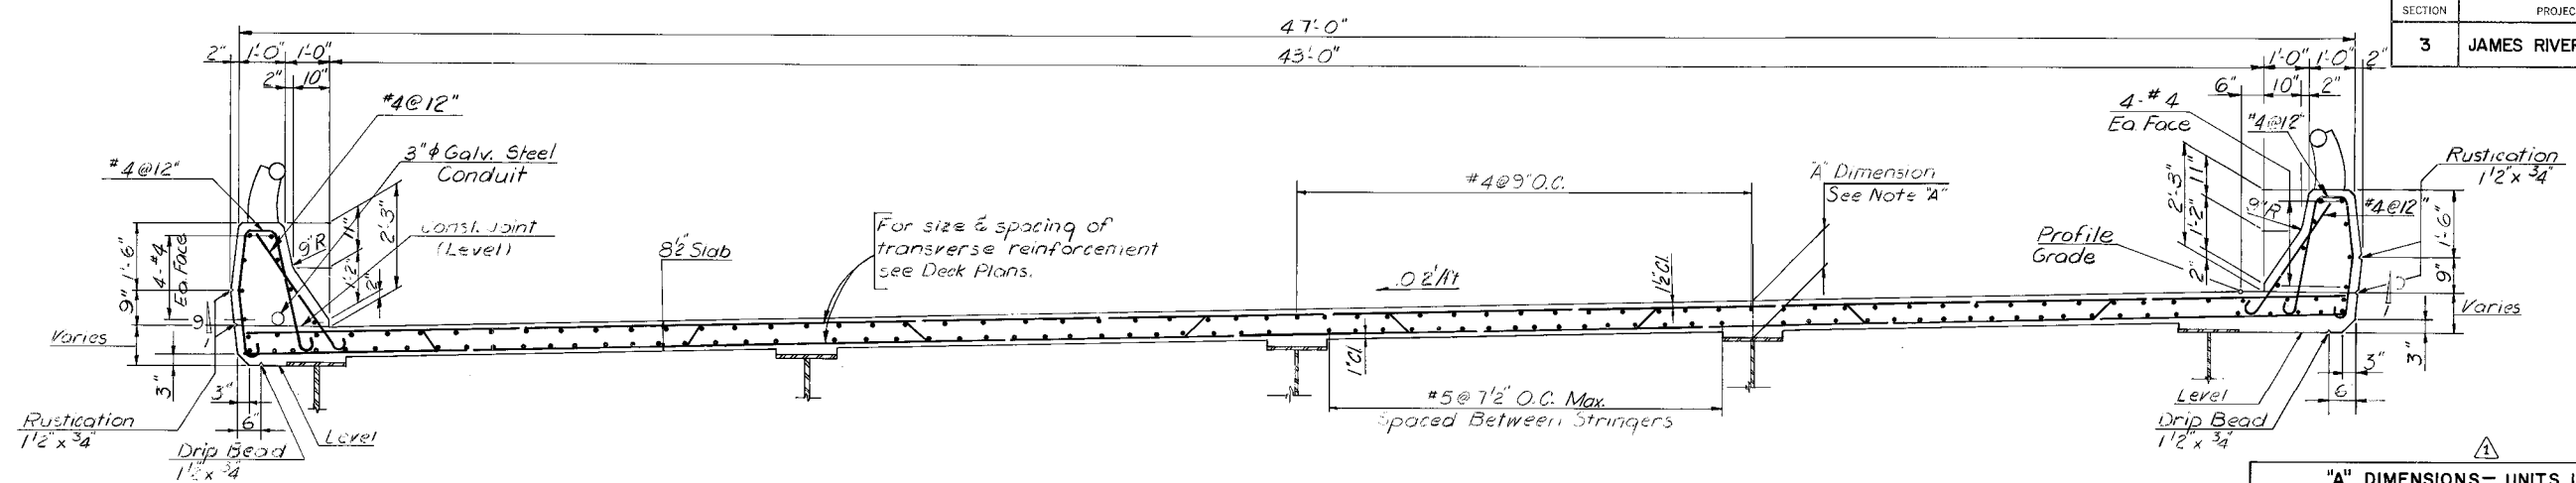

TYPICAL CROSS SECTION S.B. (N.B. OPPOSITE HAND)
SCALE: 1/2" = 1'-0"


"A" DIMENSIONS - UNITS 1 THRU 18			
UNIT 1		UNIT 7	
S5 & S6	10 3/8"	S1A	10 3/8"
S1-S4 & S7-S10	9 3/4"	S2-S4 & S7-S9	10 1/4"
UNIT 2 & 3		UNIT 8 THRU 12	
S5 & S6	10 1/4"	S5 & S6	10 1/8"
S1-S4 & S7-S10	9 3/4"	S1 & S10	10 1/2"
UNIT 4		UNIT 13 & 14	
S1 (AT PIER 3)	10"	S1	10 3/4"
S1 (AT PIER 4)	10 1/8"	S2, S3, S4 & S7	9 3/4"
S2	11"	S5 & S6	10 1/4"
S3	10"	S1 & S10	10 1/2"
S4	10 1/2"	S1	10 3/4"
S5	9 3/4"	S2, S3, S4 & S7	9 3/4"
S6	10"	S5 & S6	10 1/4"
S1-S10	10 1/8"	S8 & S9	10"
S10	10 1/2"	S10	10 1/2"
UNIT 5		UNIT 15	
S1	10 1/8"	S2-S4 & S7-S9	9 3/4"
S2	9 3/4"	S5 & S6	10 1/4"
S3	9 3/4"	S1 & S10	10 1/2"
S4	9 3/4"	S1	10 1/2"
S5 & S6	10 1/8"	S2 & S3	10"
S2-S4 & S7-S9	10 1/4"	S4, S7, S8 & S9	9 3/4"
S1 & S10	10 1/2"	S5 & S6	10 1/4"
UNIT 6		UNIT 16 & 17	
S5 & S6	10 1/8"	S1	10 1/2"
S2-S4 & S7-S9	10 1/4"	S2 & S3	10"
S1 & S10	10 1/2"	S4, S7, S8 & S9	9 3/4"
UNIT 18		UNIT 18	
S2-S4 & S7-S9	9 3/4"	S5 & S6	10 1/4"
S5 & S6	10 3/8"	S10	10 3/4"
S1 & S10	10 1/2"	S1 & S10	10 3/4"

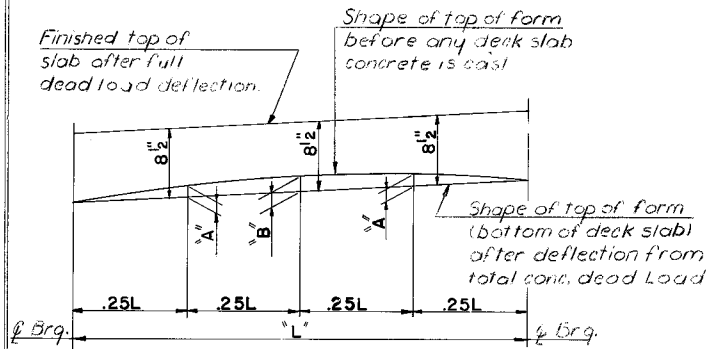

DEAD LOAD DEFLECTION DIAGRAM
NO SCALE


NOTE TO CONTRACTOR

The deflections noted are those anticipated to occur in the stringer upon placement of the total concrete dead load. In practice the stringers, in place, are not likely to have the exact camber to compensate for these deflections during construction. The residual amounts shall be provided for by adjusting forms to vary the thickness of the concrete 1/4" between the bottom of the slab & the top of stringer, without alteration of the slab thickness.

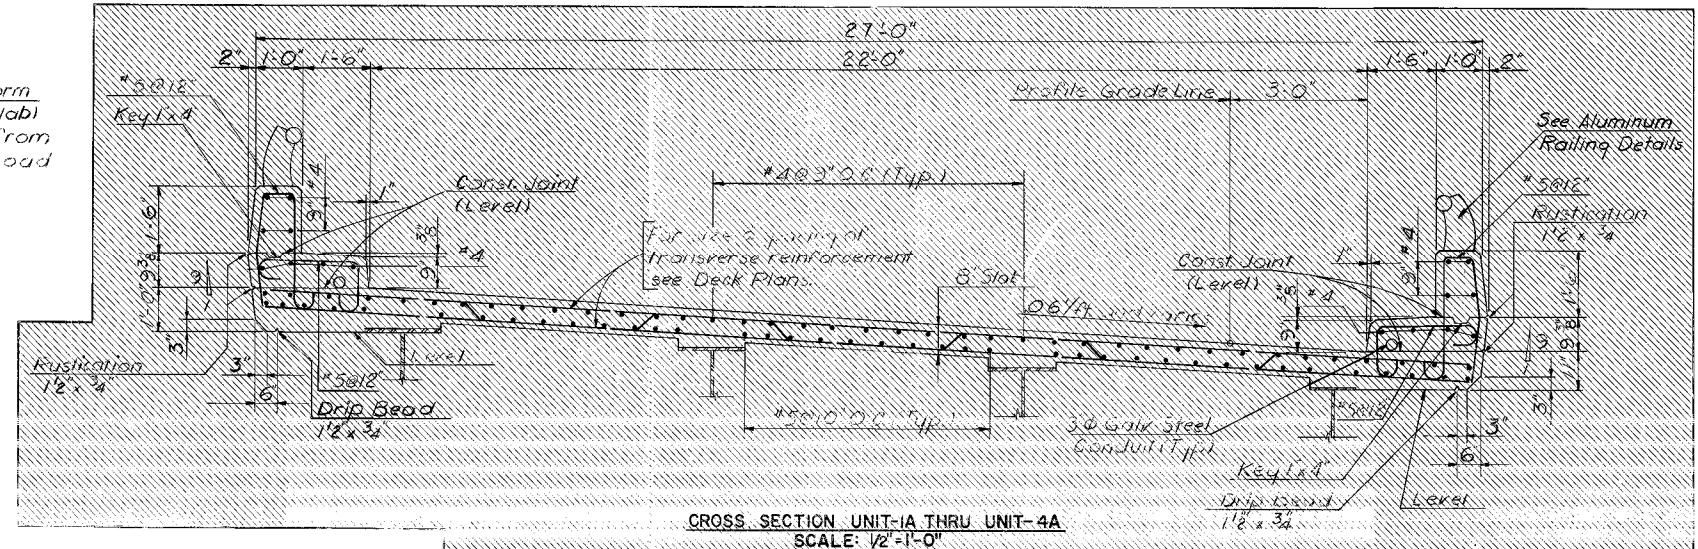


CROSS SECTION UNIT 1A THRU UNIT 4A
SCALE: 1/2" = 1'-0"


DEFLECTION SCHEDULE							
UNIT	STRINGER	A	B	UNIT	STRINGER	A	B
1	SI-S10	5/8"	7/8"	7-12	SI-S10	1 5/8"	2 1/4"
2	SI-S10	1 1/8"	1 1/2"	13 & 14	S1	3/4"	1"
	SI-S10	1 1/8"	1 1/2"		S2	7/8"	1 1/8"
3	SI-S10	1 1/8"	1 1/2"	16 & 17	S3	1 1/4"	1 3/4"
	SI-S10	1 1/8"	1 1/2"		S4	1"	1 3/8"
4	SI-S10	1 5/8"	2 1/4"	18	S5	1"	1 1/2"
	SI-S10	1 5/8"	2 1/4"		S6	1 1/8"	1 5/8"
	SI-S10	1 5/8"	2 1/4"		S7	1 1/4"	1 5/8"
	SI-S10	1 5/8"	2 1/4"		S8	7/8"	1 1/4"
	SI-S10	1 5/8"	2 1/4"		S9	7/8"	1 1/8"
	SI-S10	1 5/8"	2 1/4"		S10	3/4"	1"
5	SI-S10	1 5/8"	2 1/4"	15	SI-S10	1 1/8"	1 1/2"
6	SI-S10	1 5/8"	2 1/4"				

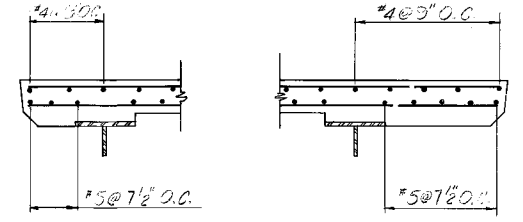

LONGITUDINAL REINFORCEMENT AT FASCIA

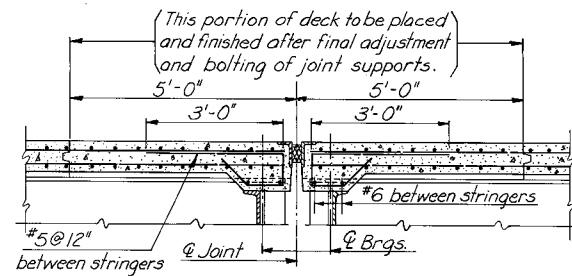

TYPICAL SECTION AT JOINT

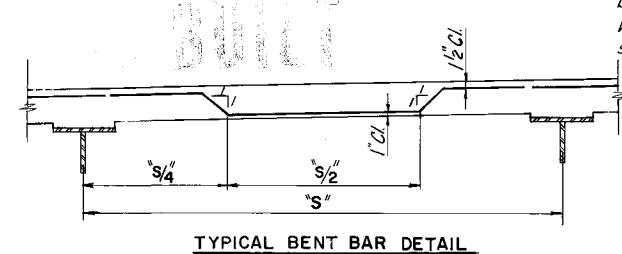

TYPICAL BENT BAR DETAIL

Notes:
For Notes see Sheet No. 37.
All Bar clearances to conc. face are 2" unless noted.

"A" DIMENSIONS - UNITS 1A THRU 4A			
UNIT 1A		UNIT 4A	
S1, S2 & S3	9 1/2"	S1 (AT PIER 3A)	9 1/2"
S4	10"	S1 (AT PIER 3)	10 1/4"
UNITS 2A & 3A		S2 & S3	
S1, S2 & S3	9 1/2"	S4	9 1/2"
S4	9 3/4"		

Note "A"
"A" Dimension is given at the intersection of the & Stringer and & Bearing. Dimension shown is measured from top of top flange to construction joint for Fascia Stringers with 1'-3" overhang (see deck plan) and from top of top flange to top of deck for all other stringers. This dimension may vary between bearings due to change in top flange thickness or variation in camber, except that no portion of the stringer flange may fall within the slab.

RICHMOND METROPOLITAN AUTHORITY
RICHMOND EXPRESSWAY SYSTEM

JAMES RIVER BRIDGE
DECK DETAILS

BY	DATE				
MADE	D.E.K.	7-67	2	AS BUILT	JRC 12-72
CHECKED	H.B.W.	9-67	1	X-Sections & Deflections	EB 2/20/71
IN CHARGE	F.X.H.			REVISION	BY DATE

RICHMOND METROPOLITAN AUTHORITY

RICHMOND EXPRESSWAY SYSTEM



PROPOSED WIDENING

JAMES RIVER BRIDGE

LIMITED ACCESS HIGHWAY			
RICHMOND EXPRESSWAY SYSTEM			
SECTION	PROJECT	SHEET NO.	TOTAL SHEETS
13	WIDENING JAMES RIVER BRIDGE	1	106

INDEX OF SHEETS

SHEET NO.	TITLE
1	COVER SHEET
2-3	GENERAL PLAN AND ELEVATION
4	GENERAL NOTES AND ESTIMATED QUANTITIES
5-7	SOUTH ABUTMENT DETAILS
8-10	NORTH ABUTMENT DETAILS
11	FLARED TERMINAL WALL DETAILS
12-28	PIER DETAILS
29	MISCELLANEOUS SUBSTRUCTURE DETAILS
30-44	FRAMING PLANS
45	STEEL DETAILS
46	SHOE DETAILS
47	CAMBER DIAGRAMS AND SCHEDULE
48-49	DECK SLAB ELEVATIONS
50	TYPICAL CROSS SECTION AND PARAPET DETAILS
51-65	DECK PLANS
66-67	LIGHTING STANDARD AND ELECTRICAL DETAILS
68	DEAD LOAD DEFLECTION DIAGRAM AND SCHEDULE
69	JOINT DETAILS
70	DRAIN ASSEMBLY DETAILS
71	ALUMINUM RAILING DETAILS
72-89	BAR LIST
90	BAR BENDS
91	SLOPE PROTECTION
92	APPROACH SLAB DETAILS
93-99	BORING LOGS
100	CONSTRUCTION SEQUENCE AND METHOD
101	MAINTENANCE AND PROTECTION OF TRAFFIC
102	PARTIAL EMBANKMENT PLAN
103	TYPICAL ROADWAY SECTION
104-105	EMBANKMENT CROSS SECTION
106	EROSION CONTROL

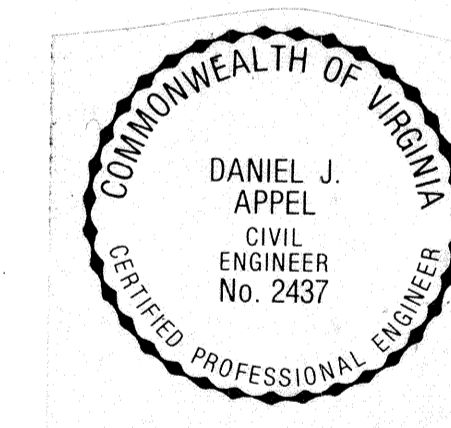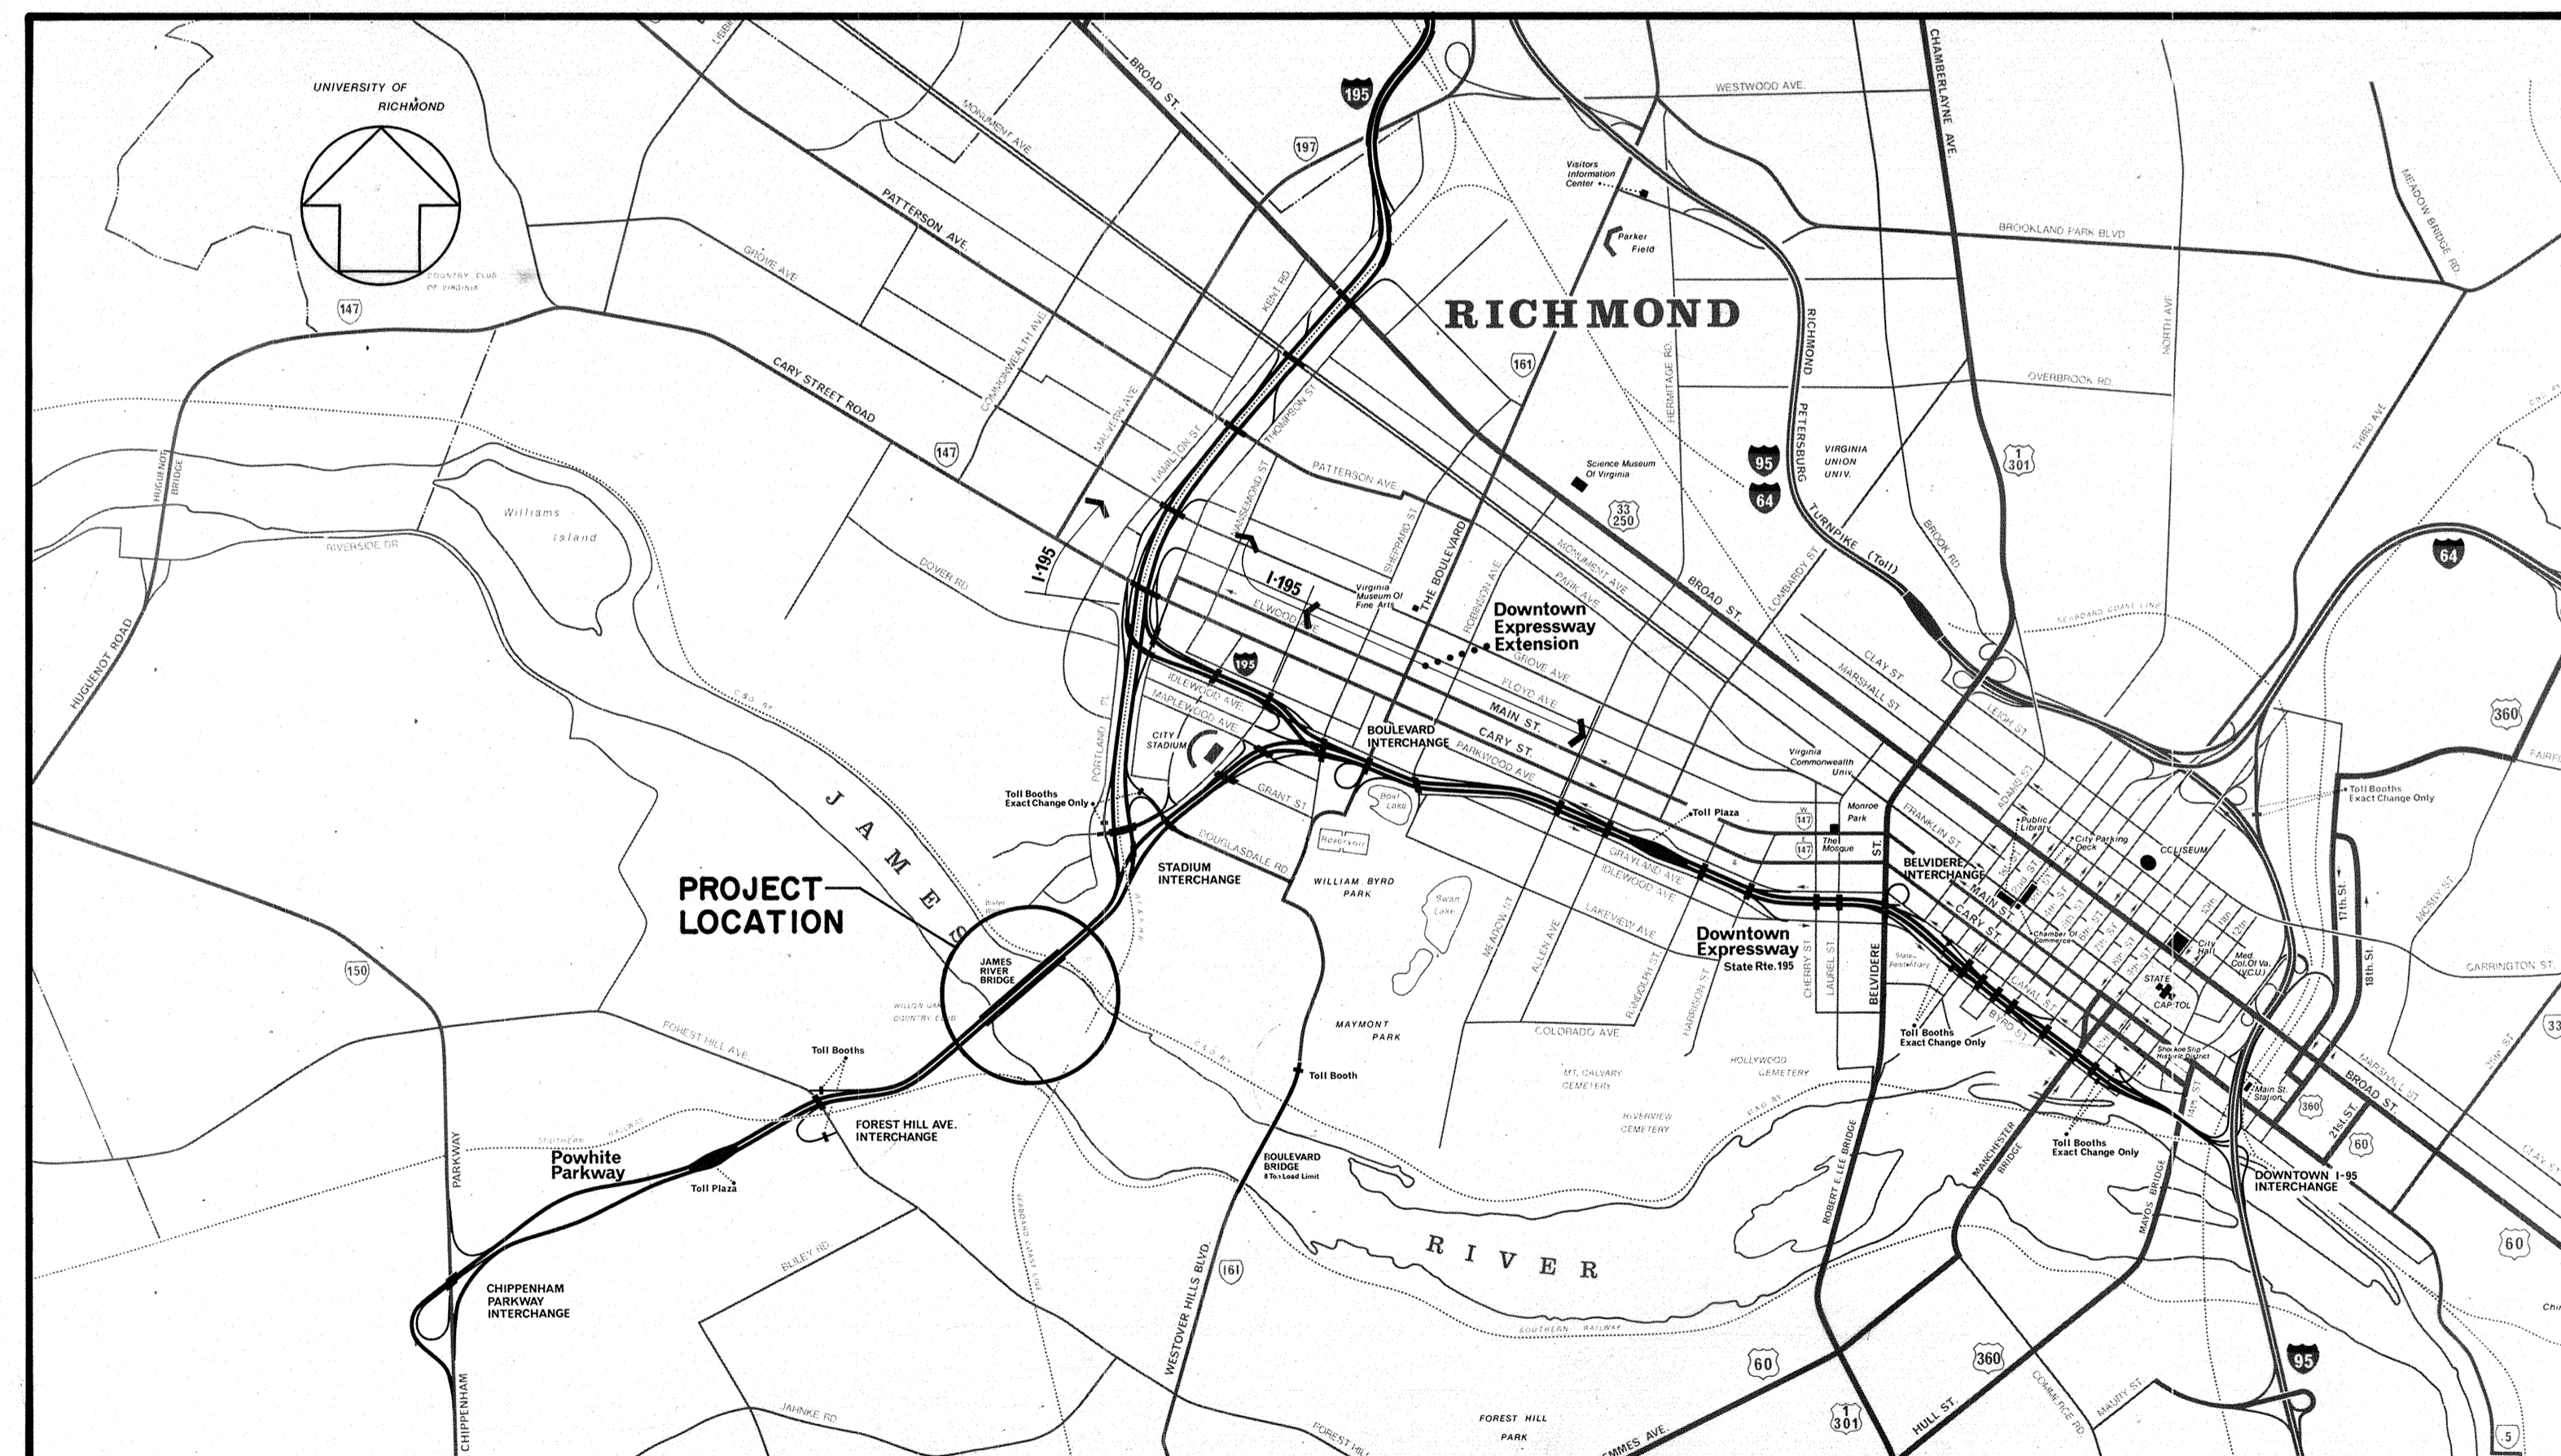

SUBMITTED BY	
Date	
3-16-87	HOWARD, NEEDLES, TAMMEN & BERGENDOFF general consultant

RECOMMENDED BY	
Date	
3-29-87	GENERAL MANAGER, RICHMOND METROPOLITAN AUTHORITY

APPROVED BY	
Date	
3-29-87	CHAIRMAN, RICHMOND METROPOLITAN AUTHORITY

Plans Revised			
Sheet No.	Date	Sheet No.	Date



CONVENTIONAL SIGNS	
STATE LINE	LEVEE OR EMBANKMENT
COUNTY LINE	BRIDGES
CITY, TOWN OR VILLAGE	CULVERTS
RIGHT OF WAY LINE	DROP INLET
FENCE LINE	TROLLEY POLES
UNFENCED PROPERTY LINE	POWER POLES
FENCED PROPERTY LINE	TELEPHONE OR TELEGRAPH POLES
TRAVELED WAY	MARSH
GUARD RAIL	HEDGE
RETAINING WALL	WOODS
RAILROADS	GROUND ELEVATION
BASE OR SURVEY LINE	GRADE ELEVATION
	POLES WITHIN CONSTRUCTION LIMITS

CONTRACT C-13

AS BUILT

DESIGNED BY _____ REVISED BY _____

RICHMOND EXPRESSWAY SYSTEM			
SECTION	PROJECT	SHEET NO.	TOTAL SHEETS
13	WIDENING JAMES RIVER BRIDGE	2	106

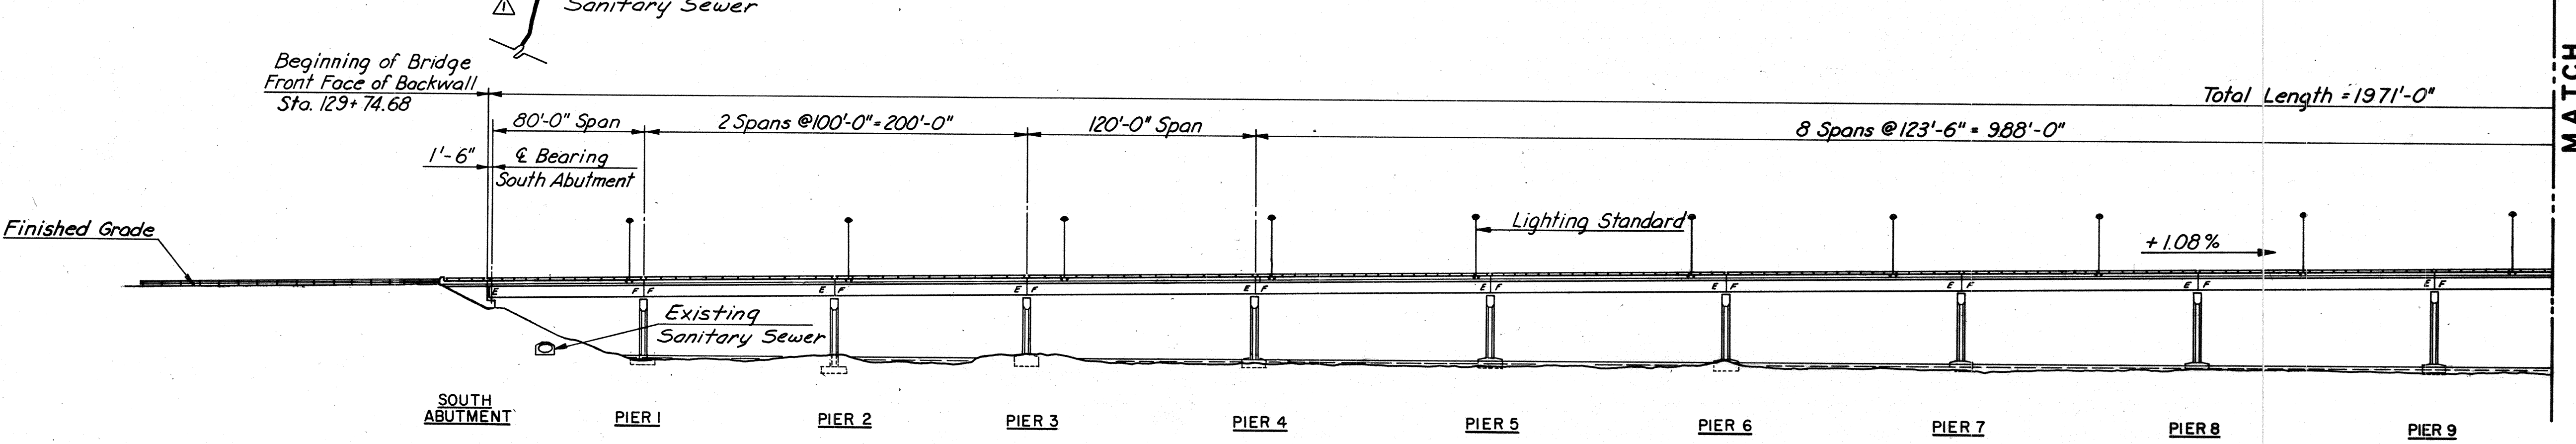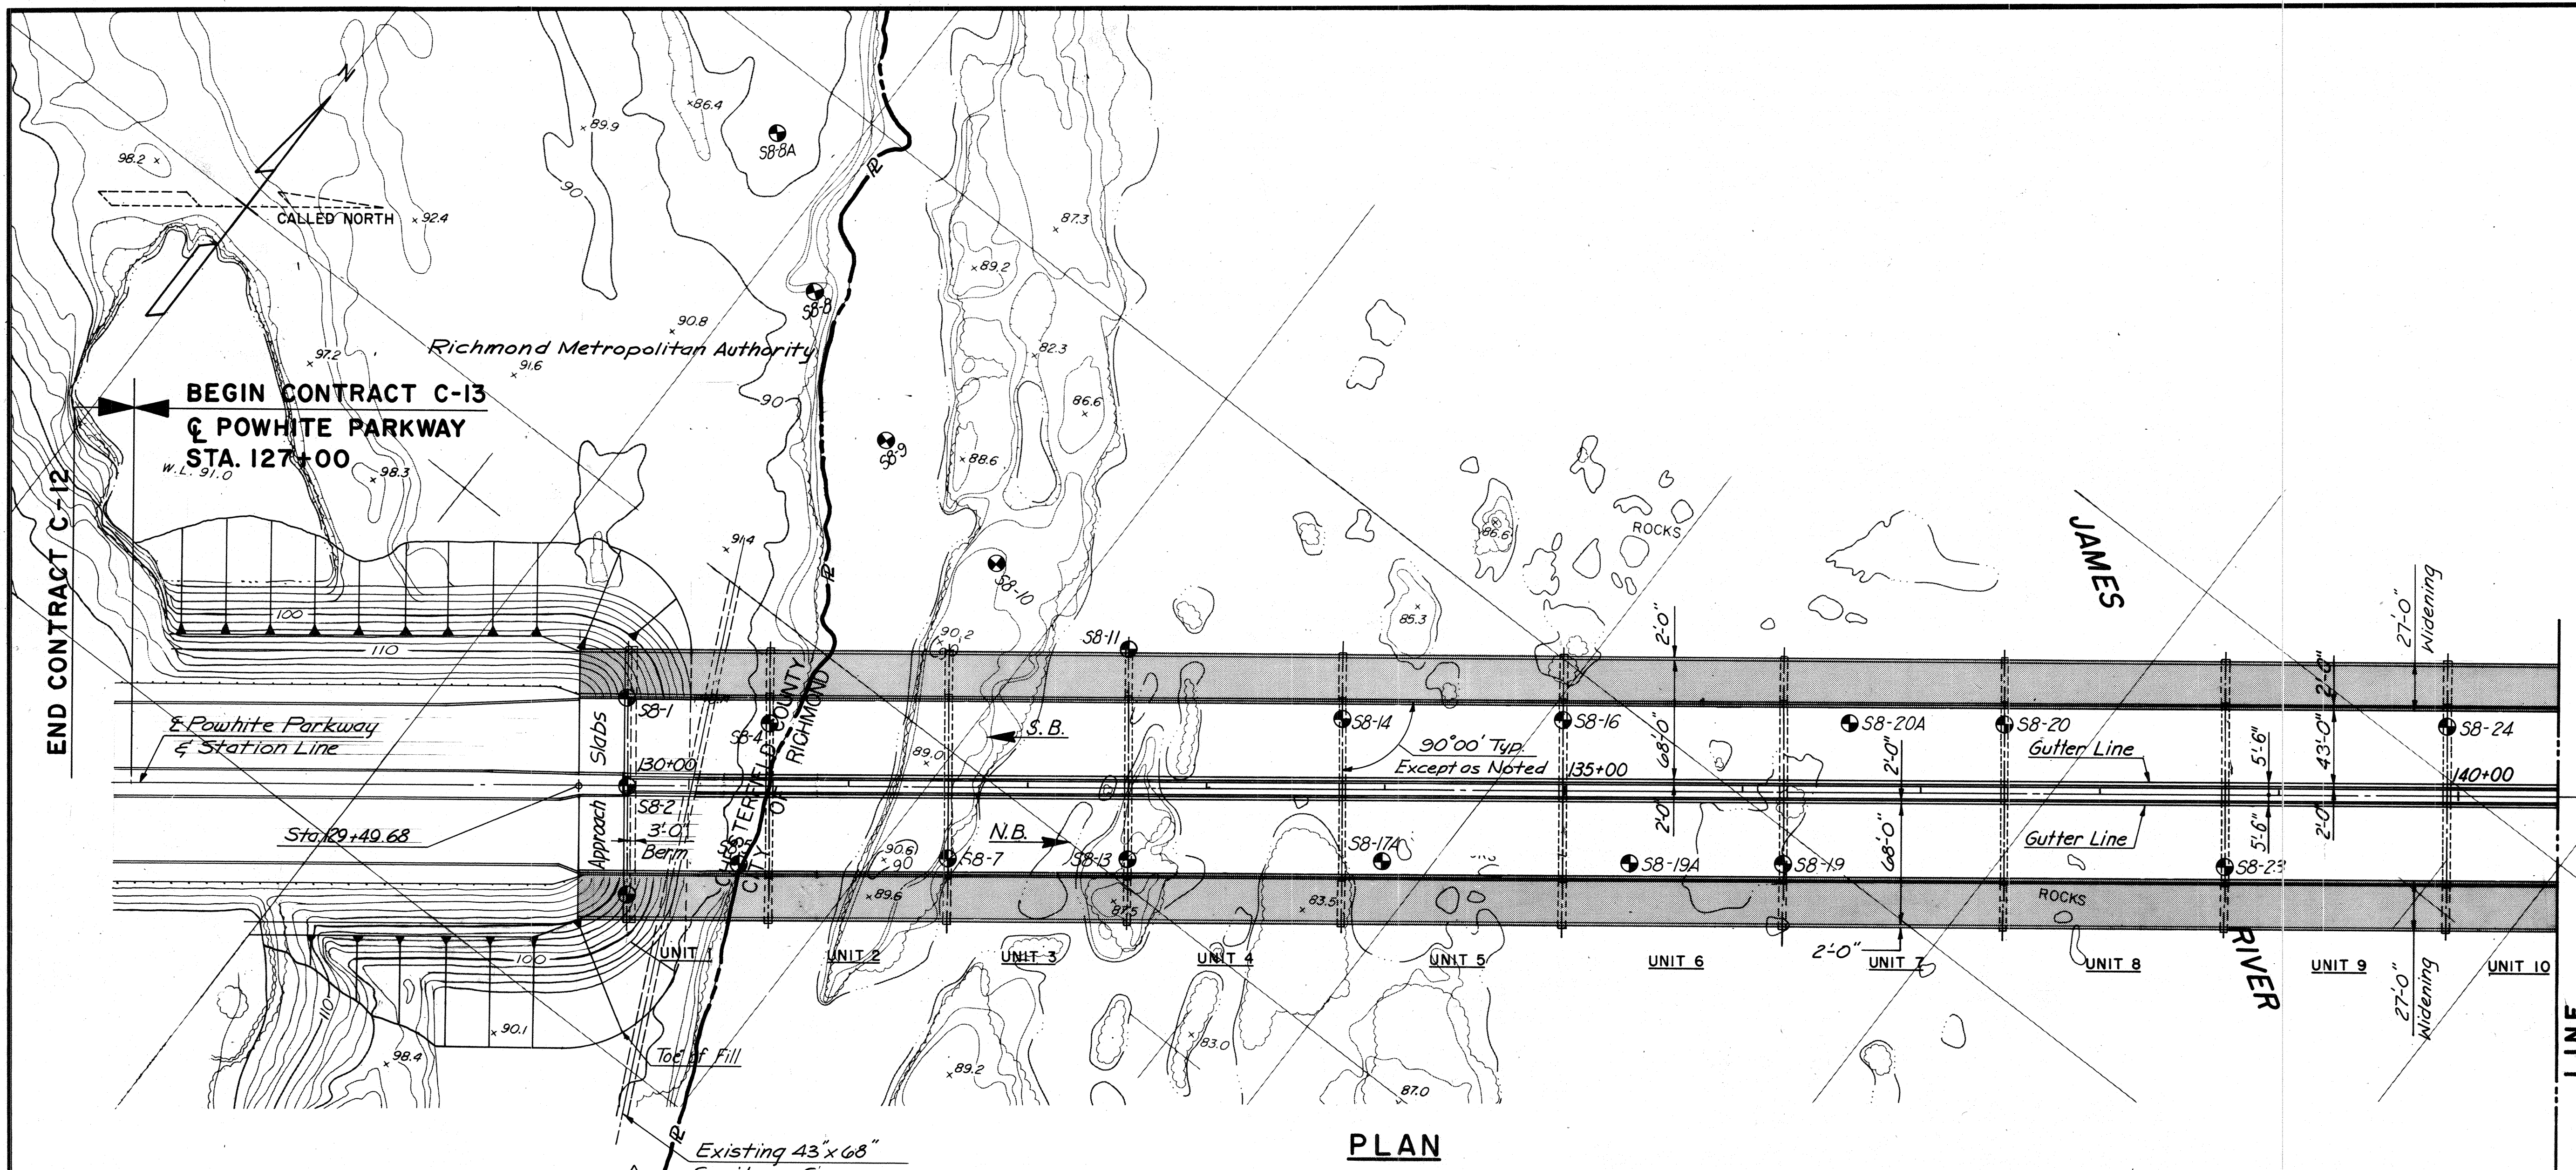

MADE	BY	DATE	NO.	REVISION	BY	DATE
ALC	ALC	3-87		As Built	TEM	3-89
TFP	TFP	3-87		Property Line	ALC	4-87
S.R.	S.R.					

**RICHMOND METROPOLITAN AUTHORITY
RICHMOND EXPRESSWAY SYSTEM**



GENERAL PLAN AND ELEVATION

HOWARD, NEEDLES, TAMMEN & BERGENDOFF
consulting engineers
Alexandria, Virginia

SCALE: 1" = 50'
CONTRACT NO.: C-13
SHEET NO. 2 OF 106

AS BUILT

RICHMOND EXPRESSWAY SYSTEM			
SECTION	PROJECT	SHEET NO.	TOTAL SHEETS
13	WIDENING JAMES RIVER BRIDGE	3	106

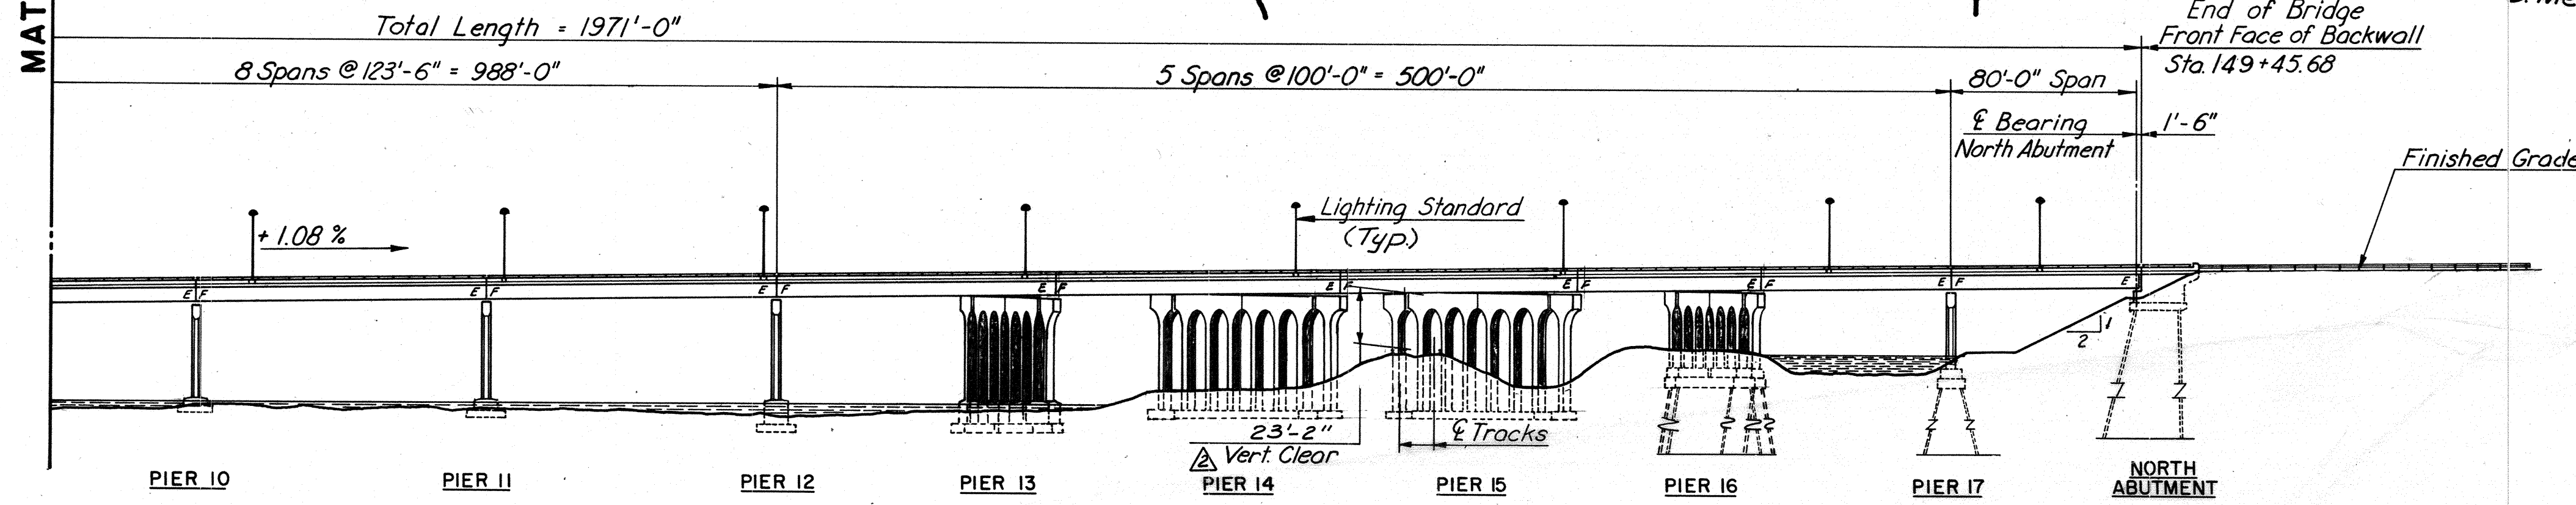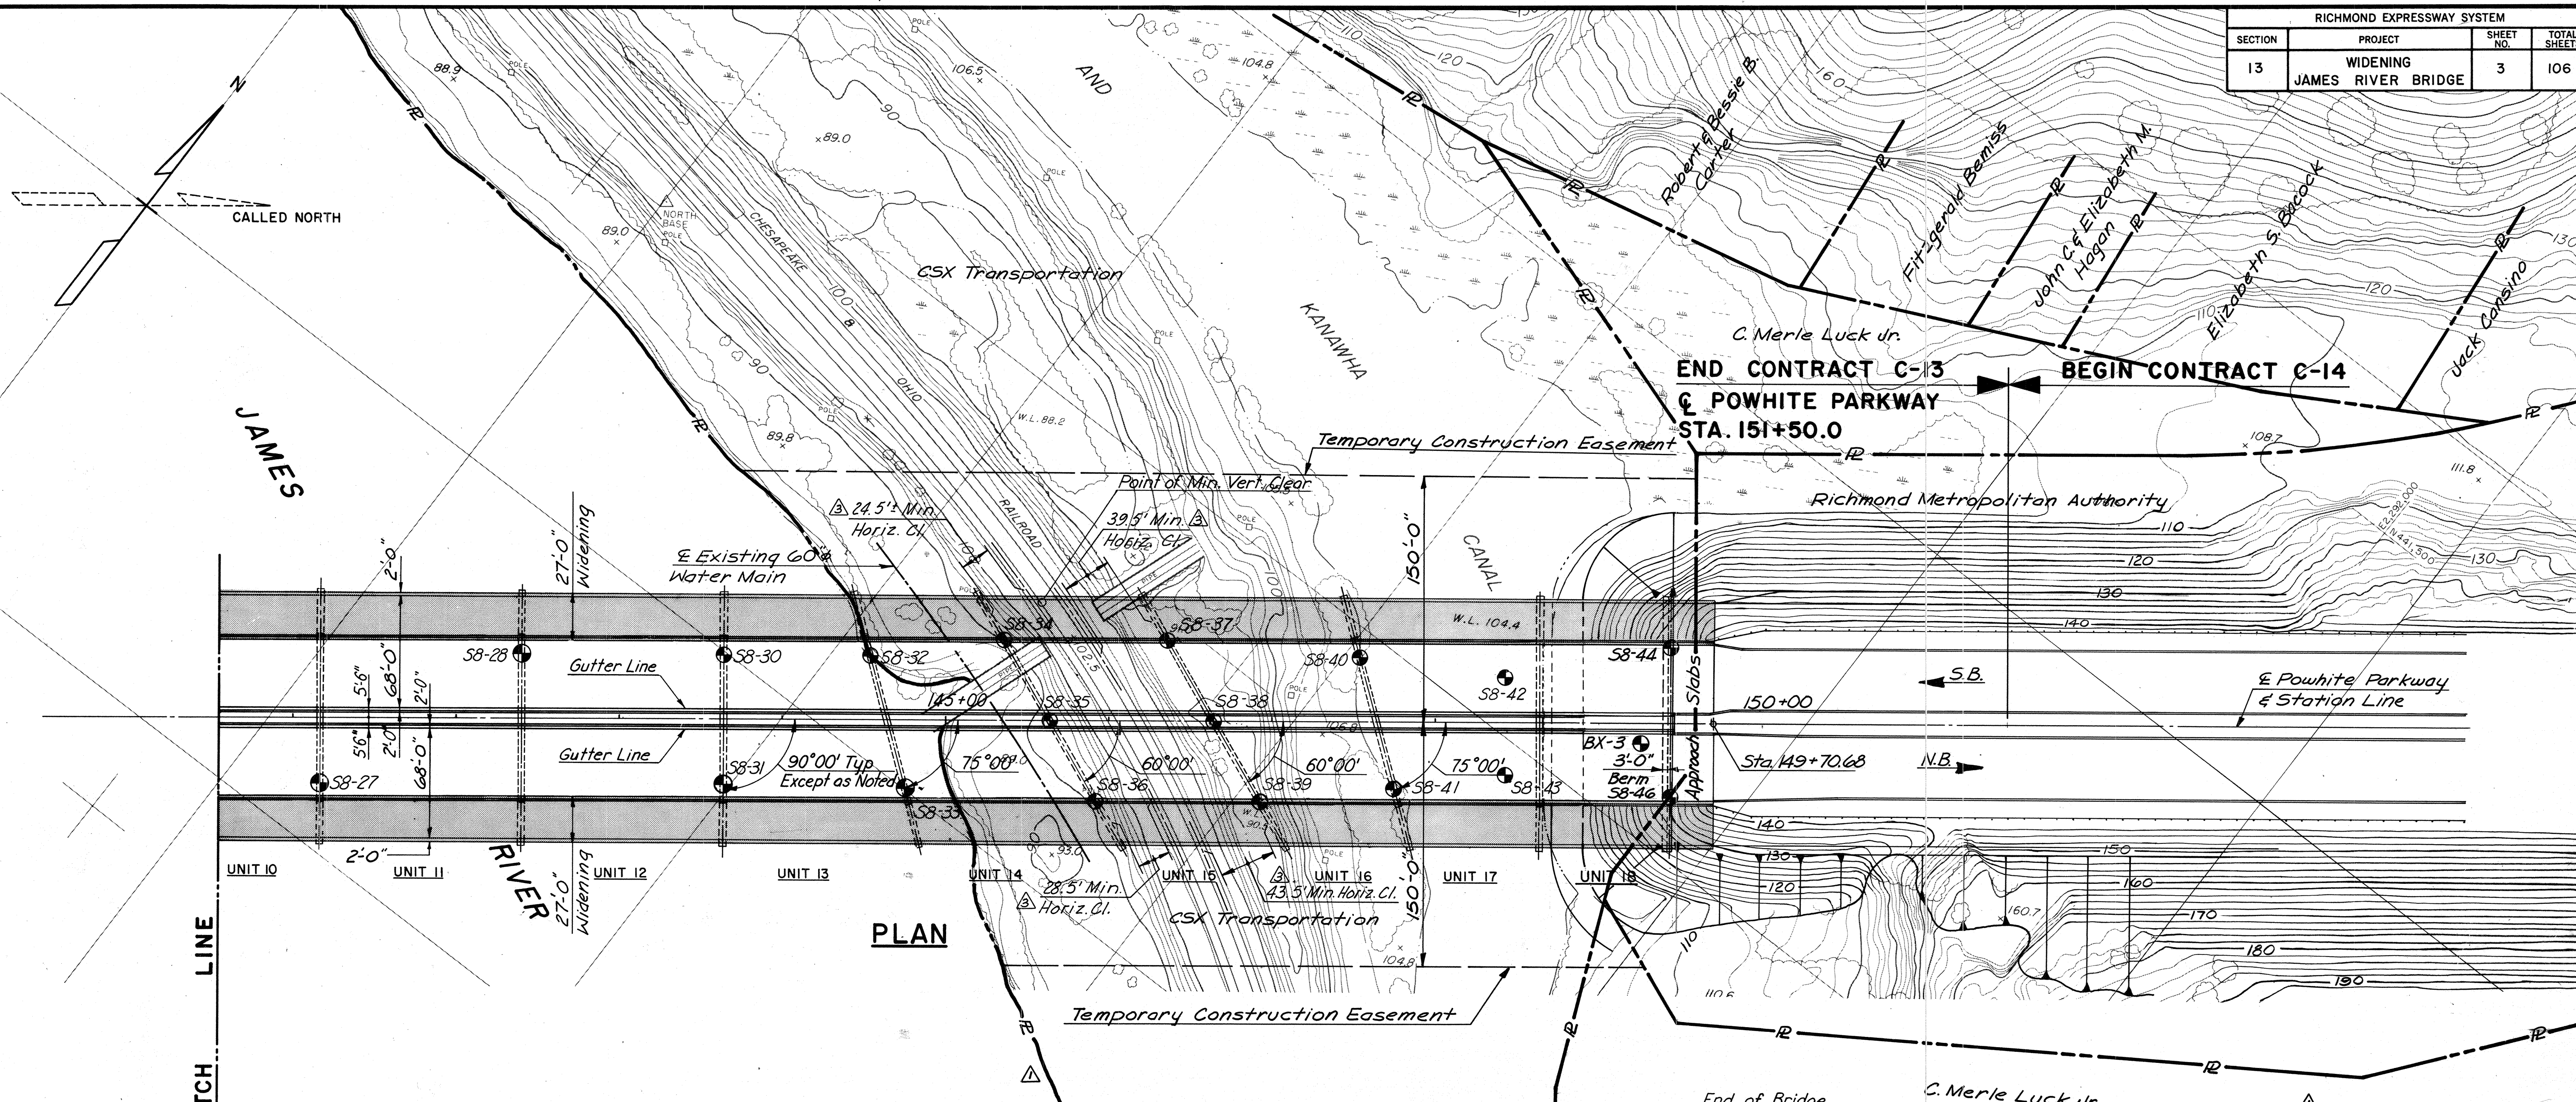

ELEVATION

MATCH LINE

PLAN

As Built TEM 3-89				
BY	DATE	REVISION	BY	DATE
ALC	3-87	Added Horiz. Cl.	EJM	7-87
T.F.P.	3-87	Vert. Clear	ALC	5-87
S.R.		Property Line	ALC	4-87

AS BUILT

RICHMOND METROPOLITAN AUTHORITY
RICHMOND EXPRESSWAY SYSTEM

GENERAL PLAN AND ELEVATION

HOWARD, NEEDLES, TAMMEN & BERGENDOFF
 consulting engineers
 Alexandria, Virginia

SCALE: 1" = 50'
 CONTRACT NO.: C-13
 SHEET NO. 3 of 106

ESTIMATE OF QUANTITIES *

	CONSTRUCTION SURVEY	EMBANKMENT	TEMPORARY SILT FENCE	FILTER CLOTH	STRUCTURE EXCAVATION AT PIERS	STRUCTURE EXCAVATION	POROUS BACKFILL	STEEL SHEET PILING	STEEL PILES 10BP42	DRIVING TEST FOR STEEL PILE 10BP42	CONCRETE CLASS A3 SUBSTRUCTURE	CONCRETE CLASS A4 CONCRETE APPROACH SLABS	CONCRETE CLASS A4	CONCRETE BRIDGE PARAPET	REINFORCING STEEL	EPOXY COATED REINFORCING STEEL	STRUCTURAL STEEL *	DRY RIPRAP CLASS I	RIPRAP FILTER CLOTH BEDDING	DAMP PROOFING	UNDERDRAIN 6" DIA.	MOBILIZATION	FIELD OFFICE	PARTIAL DEMOLITION OF EXISTING SUBSTRUCTURE	PARTIAL DEMOLITION OF EXISTING SUPERSTRUCTURE	TEMPORARY CAUSEWAYS AND ACCESS ROADS	ELASTOMETRIC EXPANSION DAM, 0-2"	
	L.S.	C.Y.	L.F.	S.Y.	C.Y.	C.Y.	C.Y.	S.F.	L.F.	L.F.	C.Y.	C.Y.	C.Y.	L.F.	LBS.	LBS.	L.S.	S.Y.	S.Y.	S.Y.	L.F.	L.S.	MTH.	L.S.	L.S.	L.S.	L.F.	
SUPERSTRUCTURE												3091.6		4038		604,840	1											2750
SOUTH ABUT.		2670	635	23		423	29		794	48	157.2				9100	590		1399	216		87	92						
NORTH ABUT.		2000	1100			305	28		1865		167.6				8410	590		942	120		93	98						
PIER 1					105						113.6				15750													
PIER 2					75						113.1				14900													
PIER 3					30						131.0				14890													
PIER 4					37						124.7				13710													
PIER 5					30						132.7				17250													
PIER 6					47						124.3				14420													
PIER 7					34						132.6				17610													
PIER 8					45						151.4				19170													
PIER 9					20						130.5				16170													
PIER 10					51						165.7				20760													
PIER 11					134						220.4				26080													
PIER 12					95						226.0				26640													
PIER 13					142						197.9				24480													
PIER 14					403			640			158.0				21120													
PIER 15					534			647			161.8				21700													
PIER 16					443			1540	976		180.4				19220	△												
PIER 17					417			1627	1080		180.8				19580	△												
APPROACH SLAB											99.2				15100													
TOTALS	1	4670	1735	23	2540	728	57	4454	4715	48	2946.6	992	3091.6	4038	356,060	606,020	1	2341	336	180	190	1	17		1	1	1	2750

GENERAL NOTES

WIDTH: WIDENING OF 27'-0" TO THE EAST AND WEST OF THE EXISTING STRUCTURE.

SPAN LAYOUT: 18-SIMPLE SPAN, STEEL PLATE GIRDER WITH SPANS OF 2-80 FEET, 7-100 FEET, 1-100 FEET AND 8-123.5 FEET.

CAPACITY: HS20-44 LOADING AND ALTERNATE MILITARY LOADING. DESIGN LOADING INCLUDES 15 P.S.F. FOR FUTURE WEARING SURFACE AND 20 P.S.F. ALLOWANCE FOR CONSTRUCTION TOLERANCES AND CONSTRUCTION METHODS.

SPECIFICATIONS:

CONSTRUCTION: VIRGINIA DEPARTMENT OF HIGHWAYS AND TRANSPORTATION ROAD AND BRIDGE SPECIFICATIONS, 1982.

DESIGN: AASHTO STANDARD SPECIFICATIONS FOR HIGHWAY BRIDGES, 1983, INCLUDING INTERIM SPECIFICATIONS, 1984, AND VDHT MODIFICATIONS.

STANDARDS: VIRGINIA DEPARTMENT OF HIGHWAYS AND TRANSPORTATION ROAD AND BRIDGE STANDARDS, 1982.

ALL DIMENSIONS ARE MEASURED HORIZONTALLY AND VERTICALLY UNLESS OTHERWISE SPECIFIED.

THESE PLANS ARE INCOMPLETE UNLESS ACCOMPANIED BY THE SUPPLEMENTAL SPECIFICATIONS AND SPECIAL PROVISIONS INCLUDED IN THE CONTRACT DOCUMENTS.

ALL STRUCTURAL STEEL SHALL BE A36, EXCEPT AS NOTED.

FINISH PAINT SHALL BE LIGHT GREEN, FEDERAL STANDARD 595-24227.

CONCRETE IN SUPERSTRUCTURE SHALL BE CLASS A4. ALL OTHER CONCRETE, EXCEPT TREMIE SEAL CONCRETE, SHALL BE CLASS A3.

ALL DEFORMED REINFORCING BARS SHALL CONFORM TO ASTM A615, GRADE 60.

ALL REINFORCING BAR DIMENSIONS ON THE DETAILED DRAWINGS ARE TO CENTER OF BARS EXCEPT WHERE OTHERWISE NOTED AND ARE SUBJECT TO FABRICATION AND CONSTRUCTION TOLERANCES.

ALL FOOTING CONCRETE SHALL BE PLACED IN THE DRY EXCEPT WHERE CLASS T3 CONCRETE IS INDICATED ON THE PLANS OR APPROVED BY THE ENGINEER.

BECAUSE OF THE ERRATIC NATURE OF THE GROUND CONDITIONS AT THE SITE, ELEVATIONS OF THE BOTTOM OF THE FOOTINGS SHOWN ON THE PLANS SHALL BE CONSIDERED APPROXIMATE ONLY. DURING CONSTRUCTION SHOULD EXCAVATION OPERATIONS REVEAL THAT THE FOUNDATION IS INADEQUATE, REDESIGN MAY BE REQUIRED AT THE DISCRETION OF THE ENGINEER.

STEEL PILES 10BP42 ARE DESIGNED FOR A CAPACITY OF 55 TONS PER PILE. ALL PILES SHALL BE DRIVEN TO PRACTICAL REFUSAL.

PRIOR TO THE COMMENCEMENT OF ANY WORK THE CONTRACTOR SHALL FIELD VERIFY ALL DIMENSIONS AND ELEVATIONS OF THE EXISTING STRUCTURE AND REPORT TO THE ENGINEER ANY DISCREPANCIES BETWEEN FIELD MEASUREMENTS AND MEASUREMENTS SHOWN ON THE CONTRACT PLANS.

△ ELEVATIONS TAKEN FROM CITY OF RICHMOND DATUM.

* For additional quantities see Sheet Nos. 67 & 101.

** The total weight of structural steel, 3,541,900 lbs, includes the shoes.

△ As Built TEM 3-89

BY	DATE	△	Quantities	ALC	4-87
MADE	ALC	3-87	Quantities	ALC	4-87
CHECKED	TFP	3-87	Quantities & Added Note	ALC	4-87
IN CHARGE	S.R.	NO.	REVISION	BY	DATE

**RICHMOND METROPOLITAN AUTHORITY
RICHMOND EXPRESSWAY SYSTEM**









GENERAL NOTES
AND
ESTIMATED QUANTITIES

HOWARD, NEEDLES, TAMMEN & BERGENDOFF
consulting engineers
Alexandria, Virginia

SCALE: AS SHOWN
CONTRACT NO. C-13
SHEET NO. 4 OF 106

AS BUILT

RICHMOND EXPRESSWAY SYSTEM			
SECTION	PROJECT	SHEET NO.	TOTAL SHEETS
13	WIDENING JAMES RIVER BRIDGE	12	106

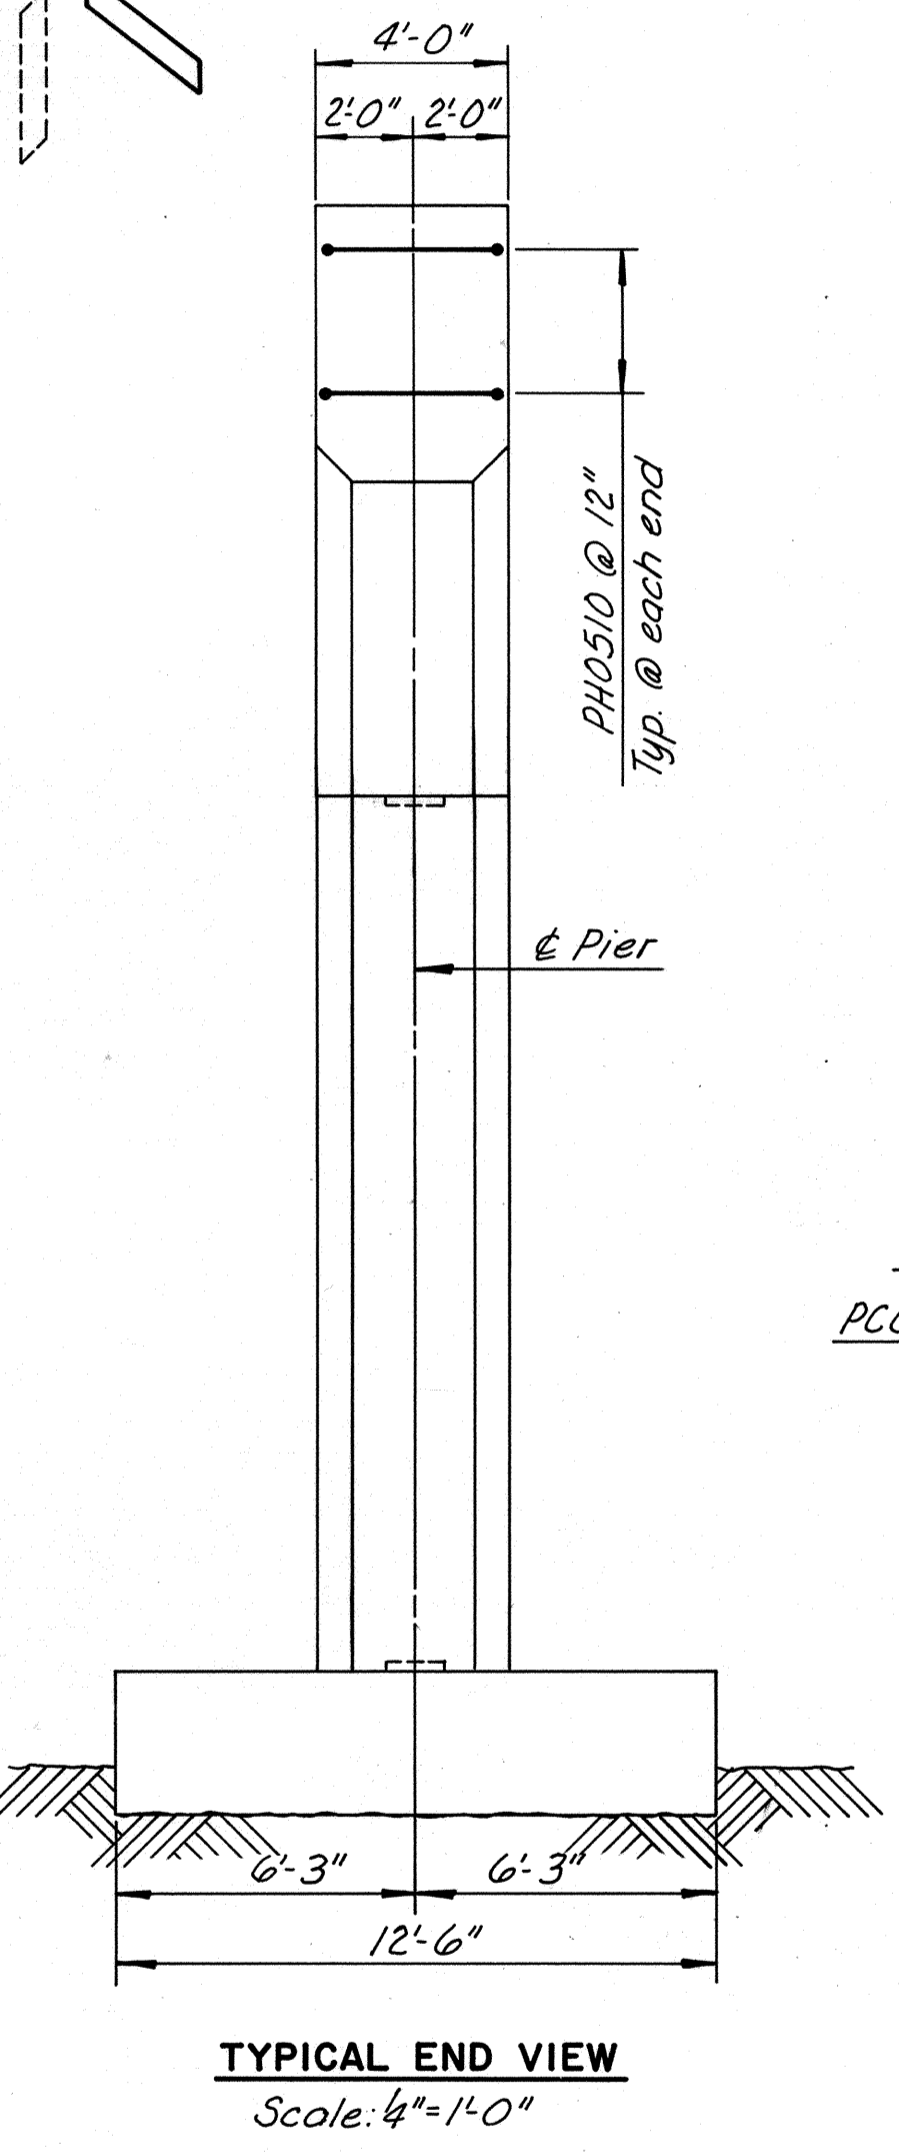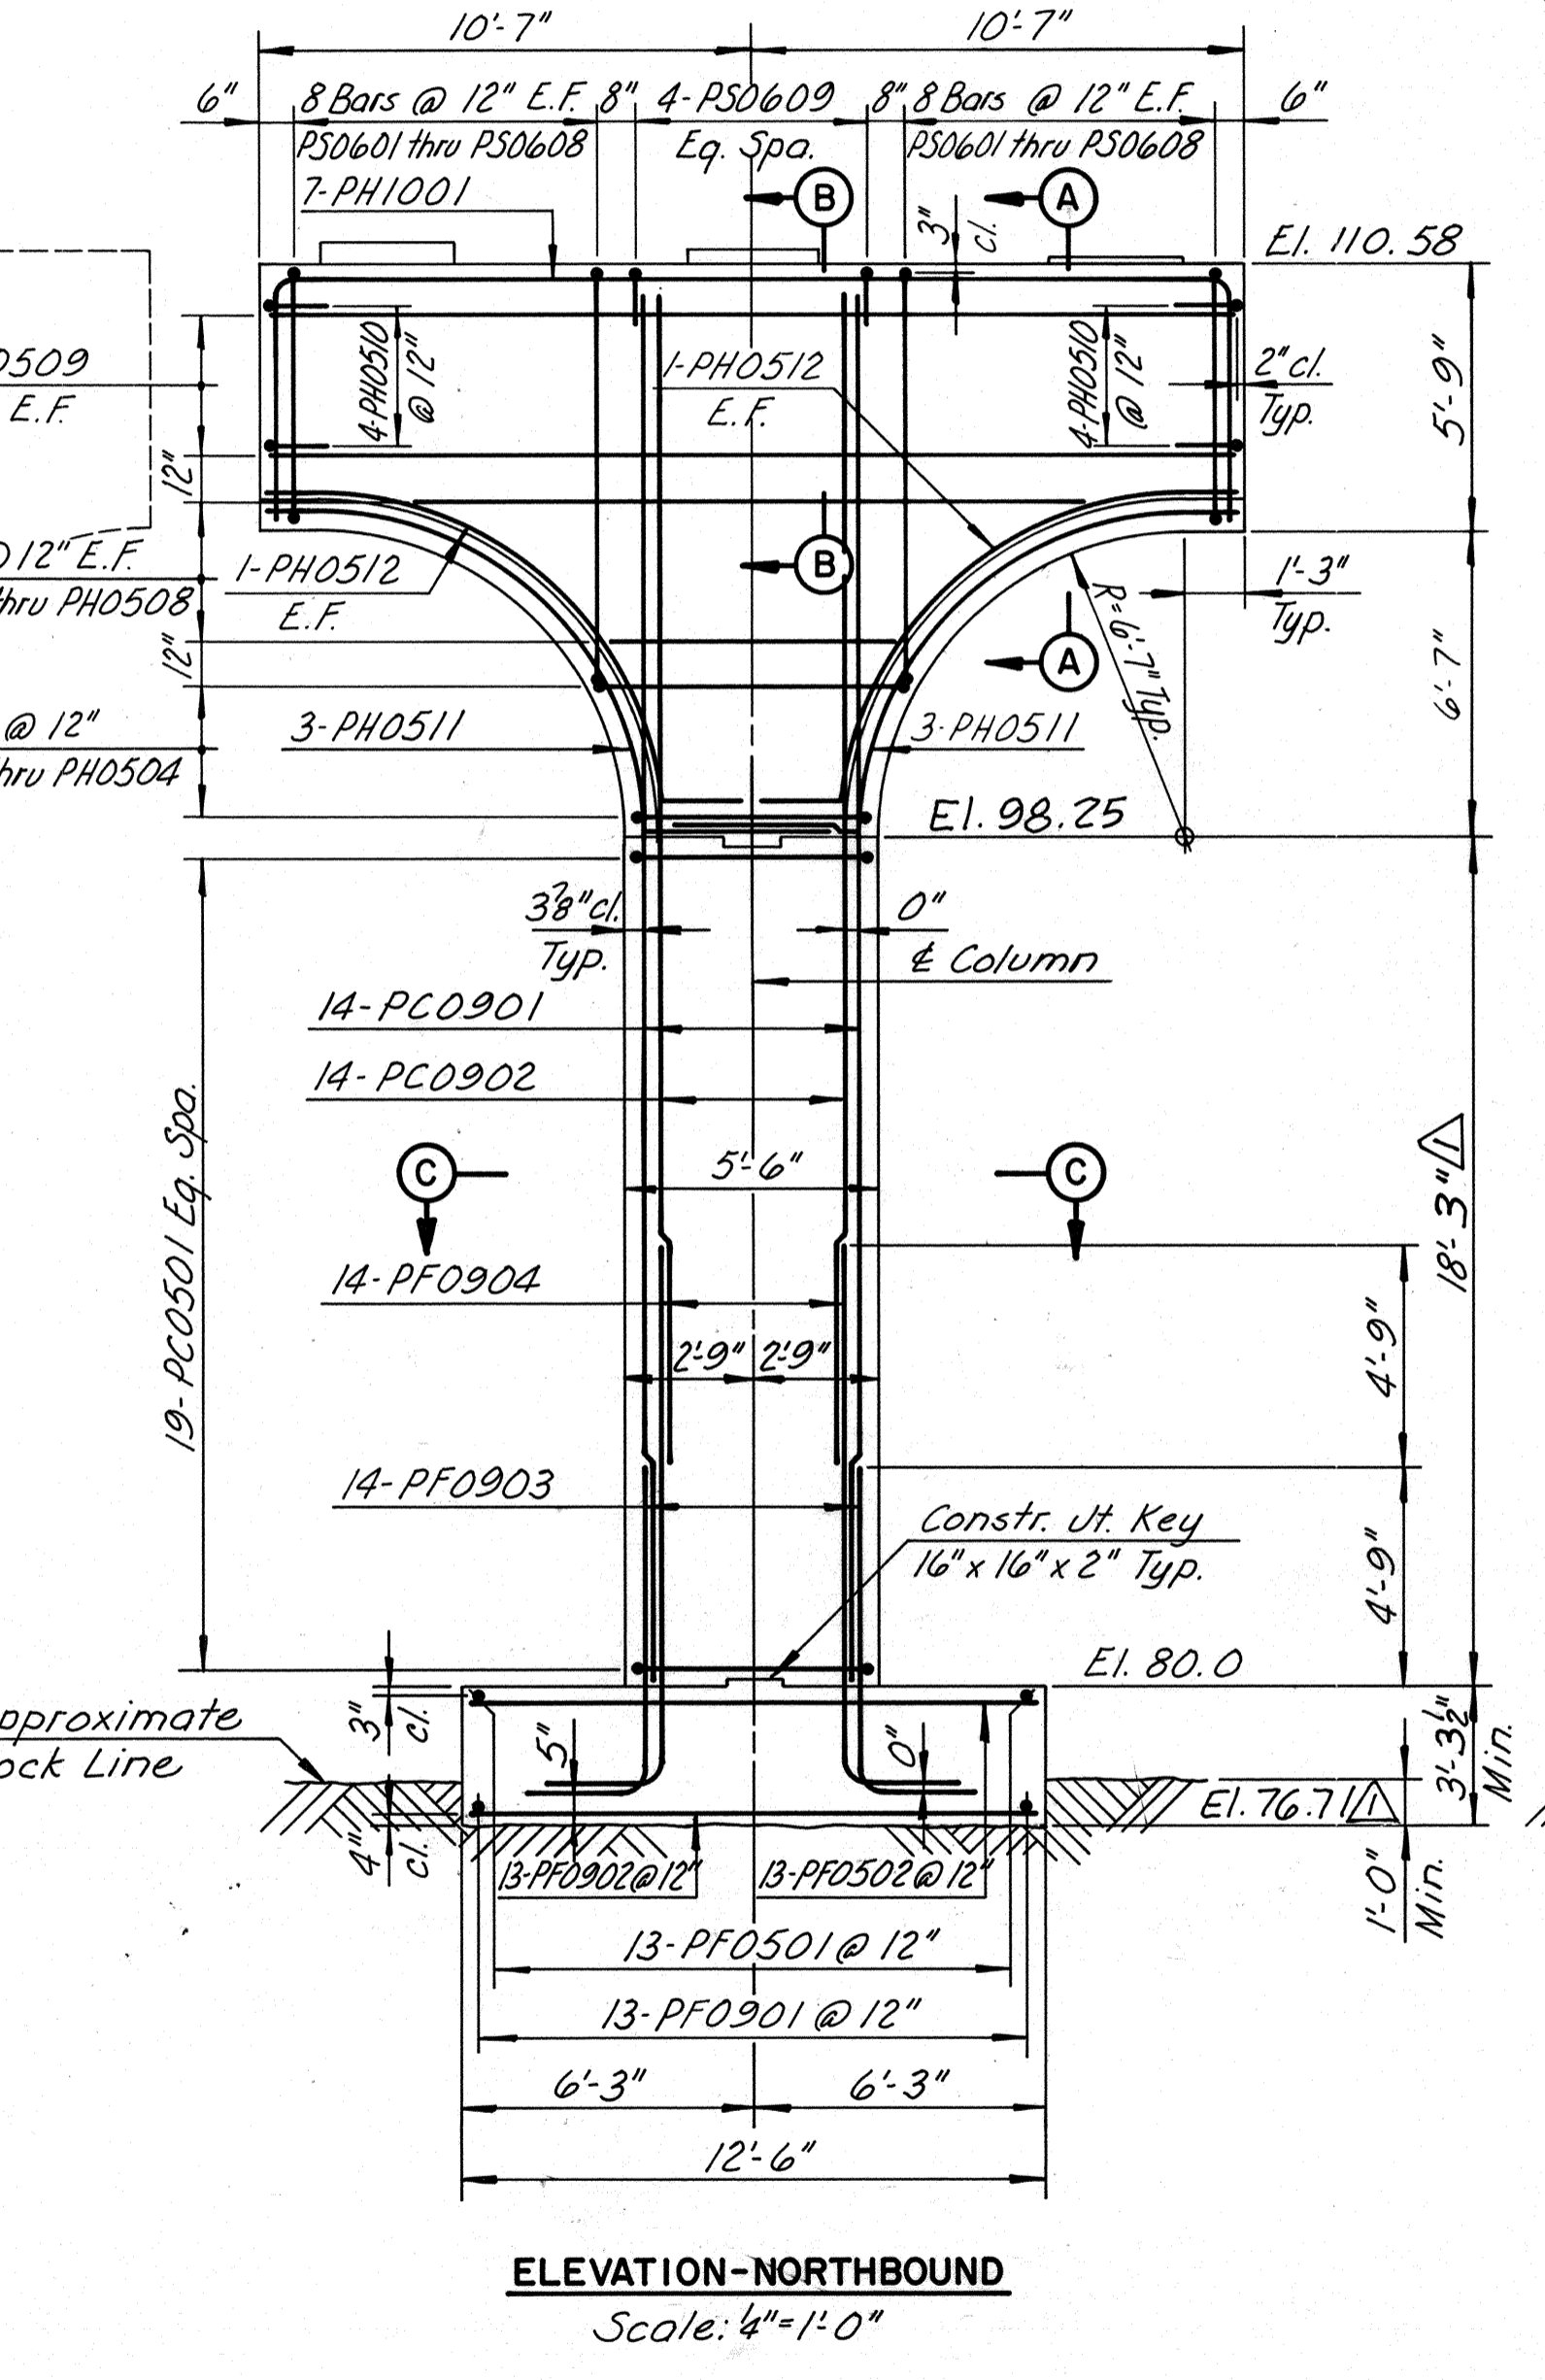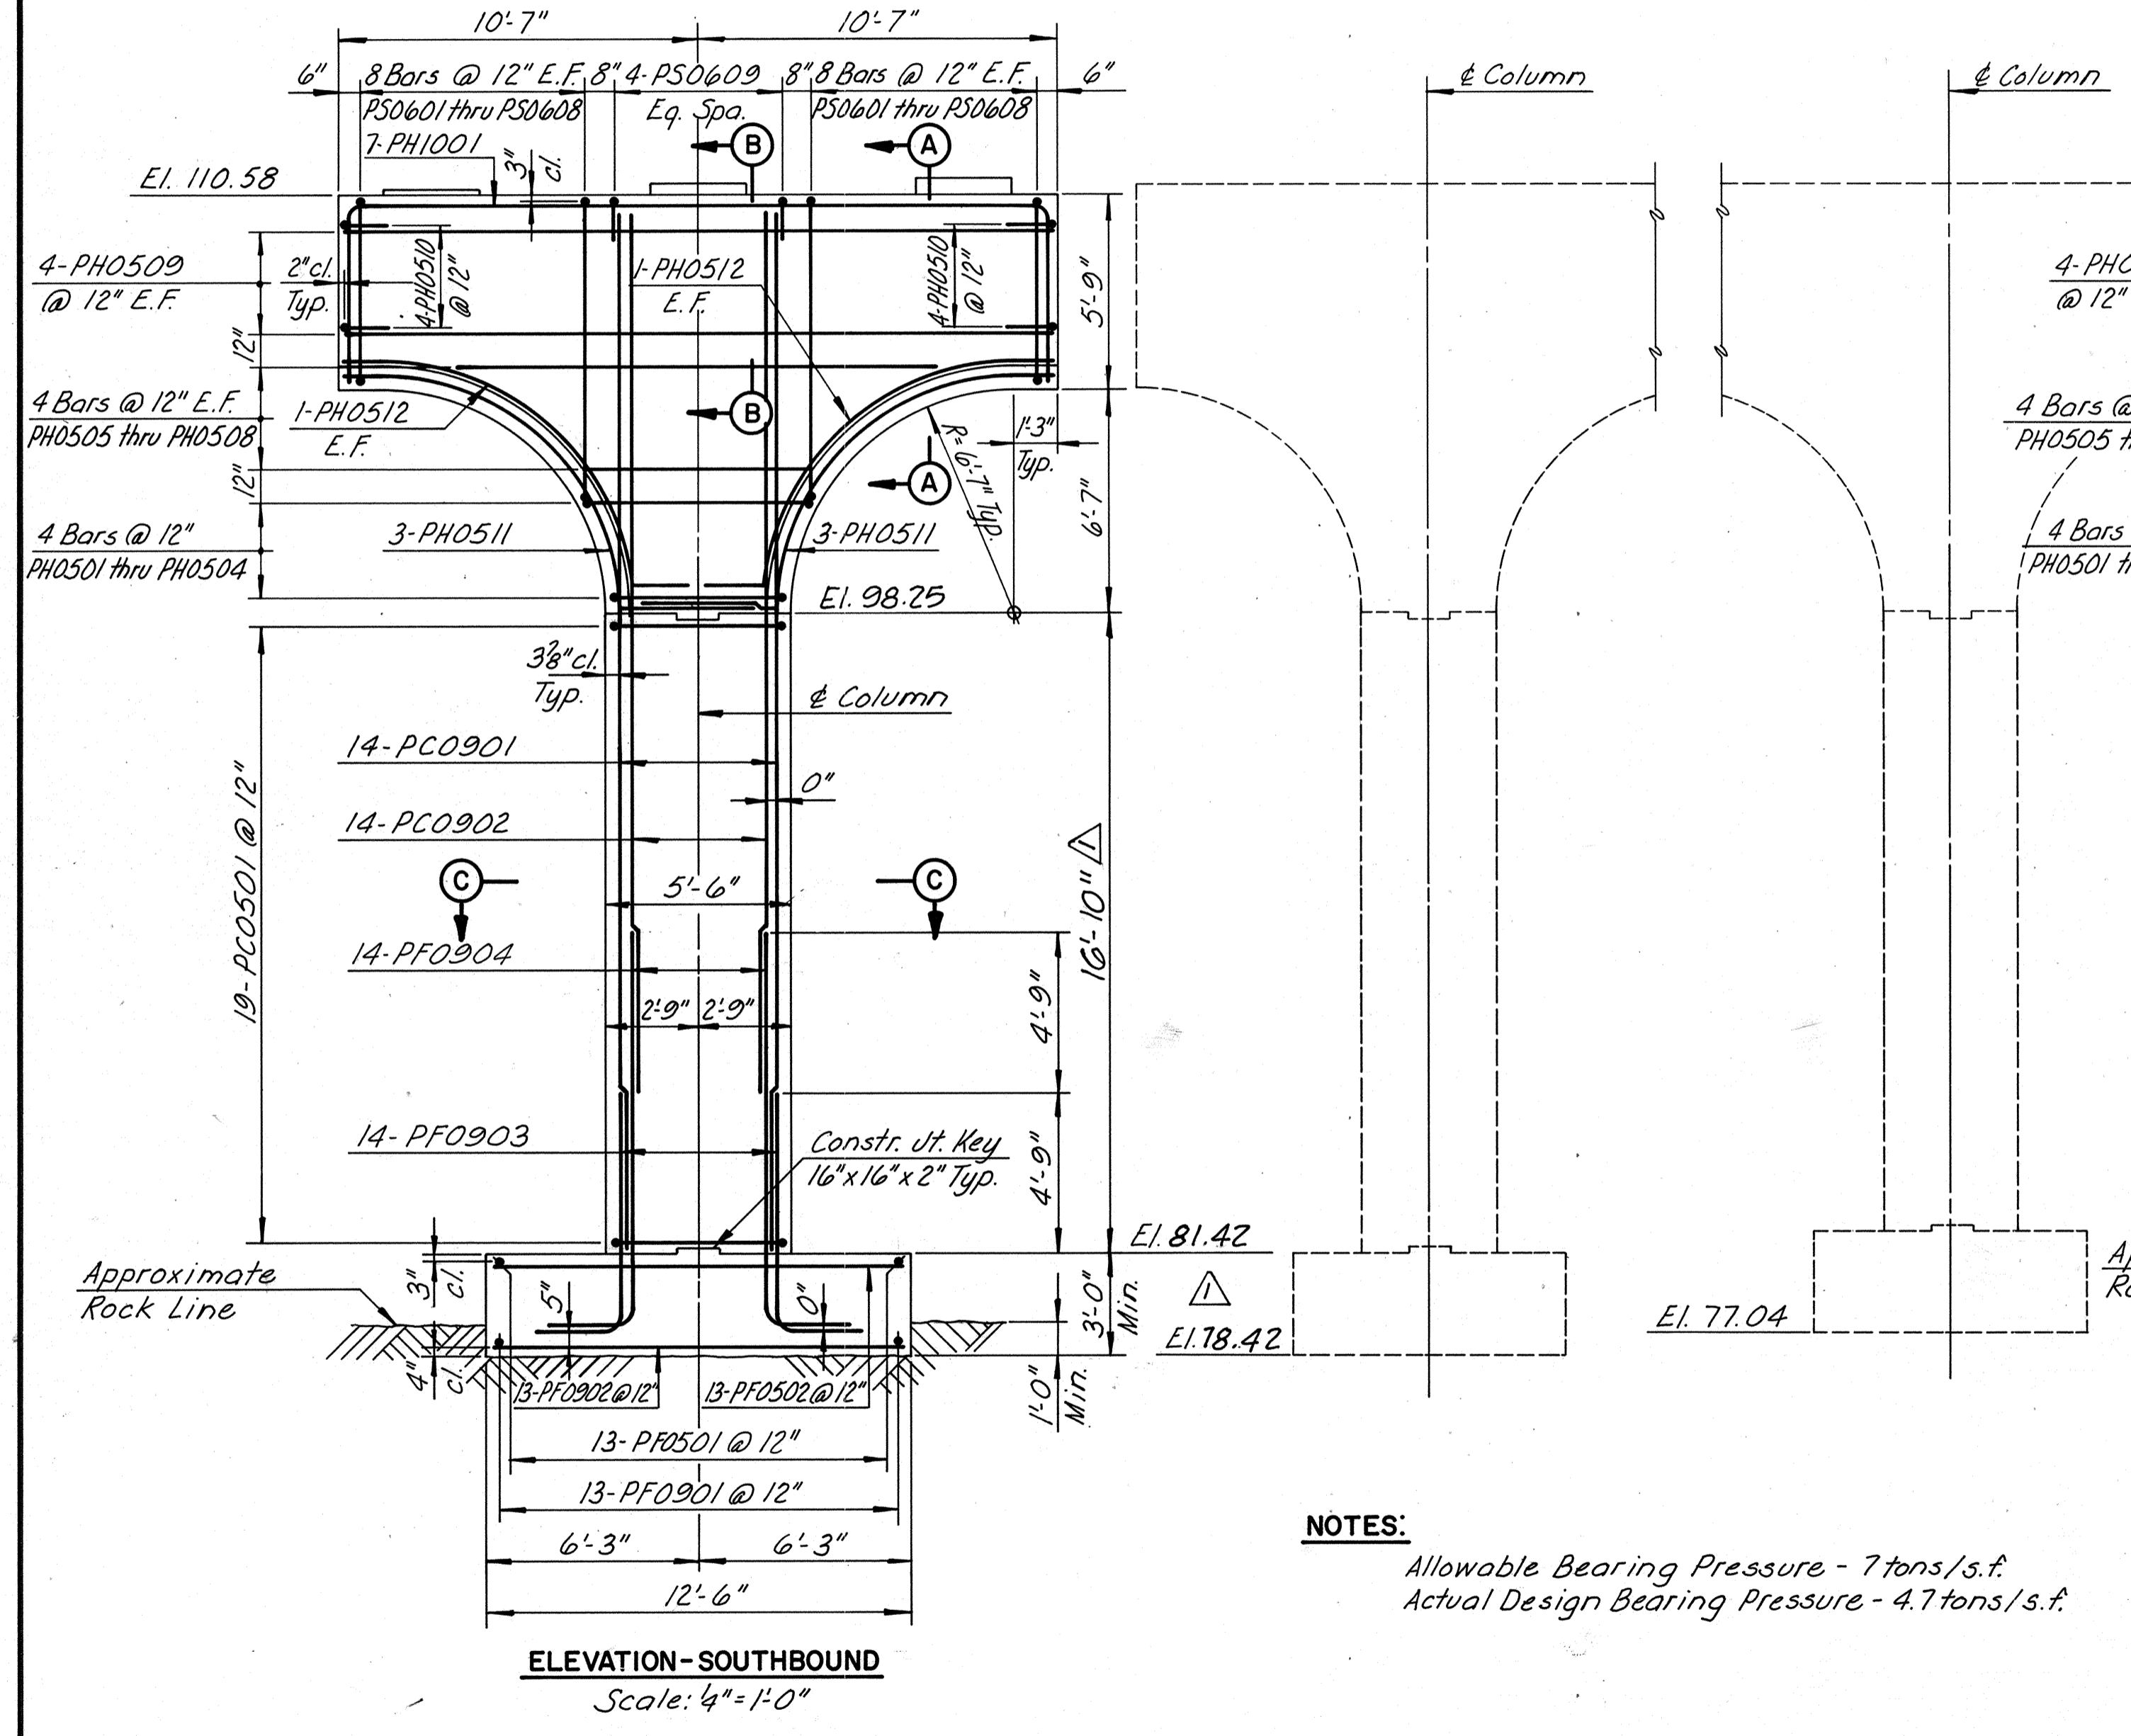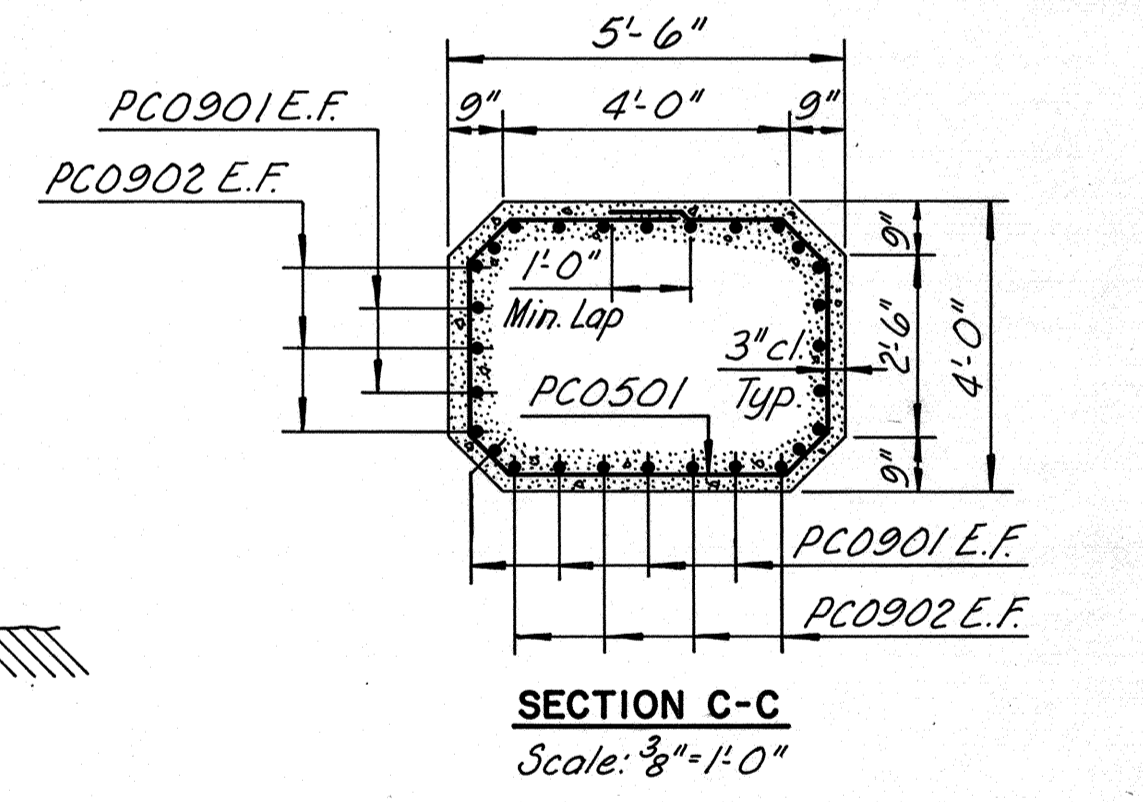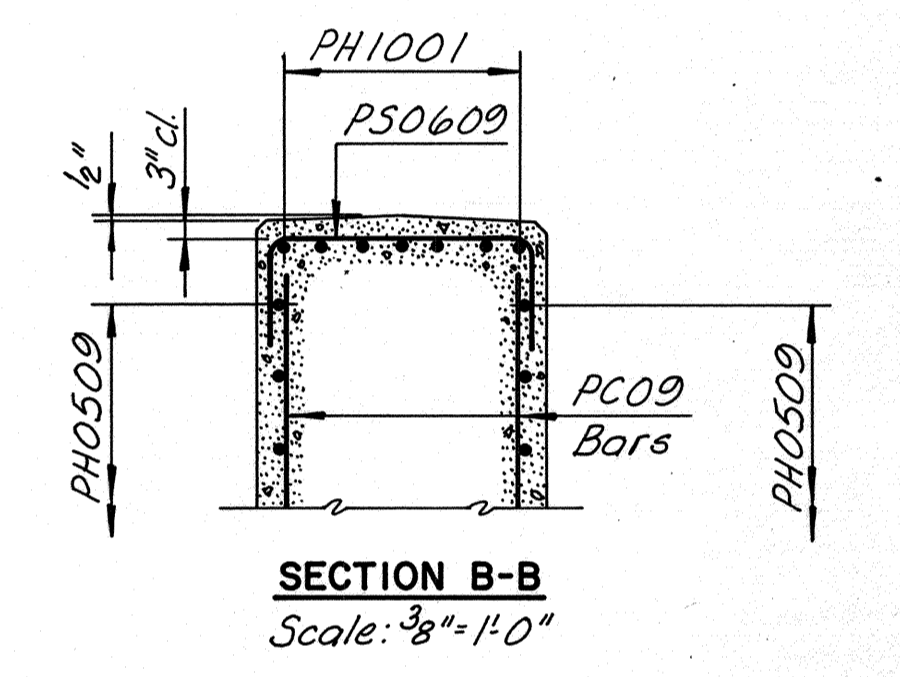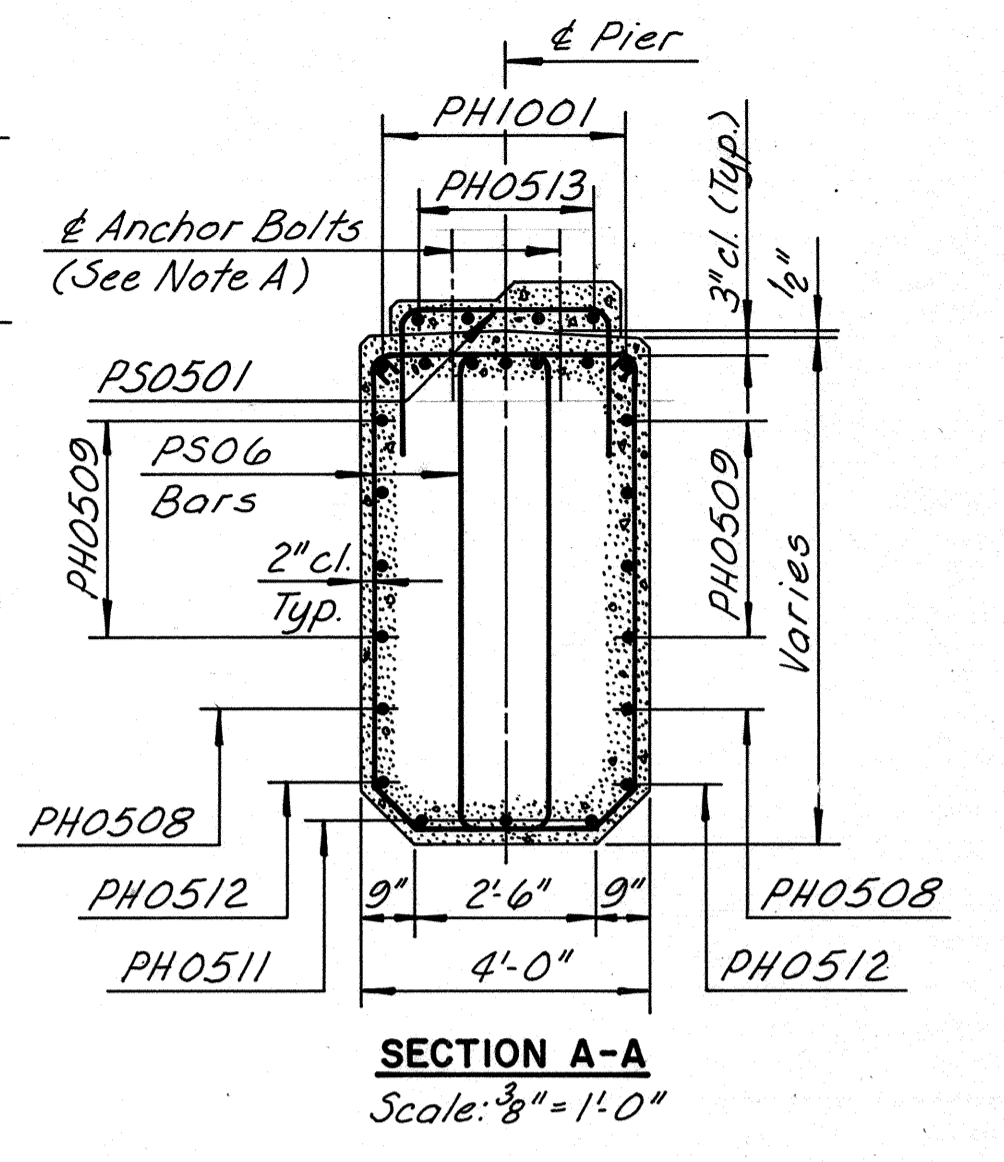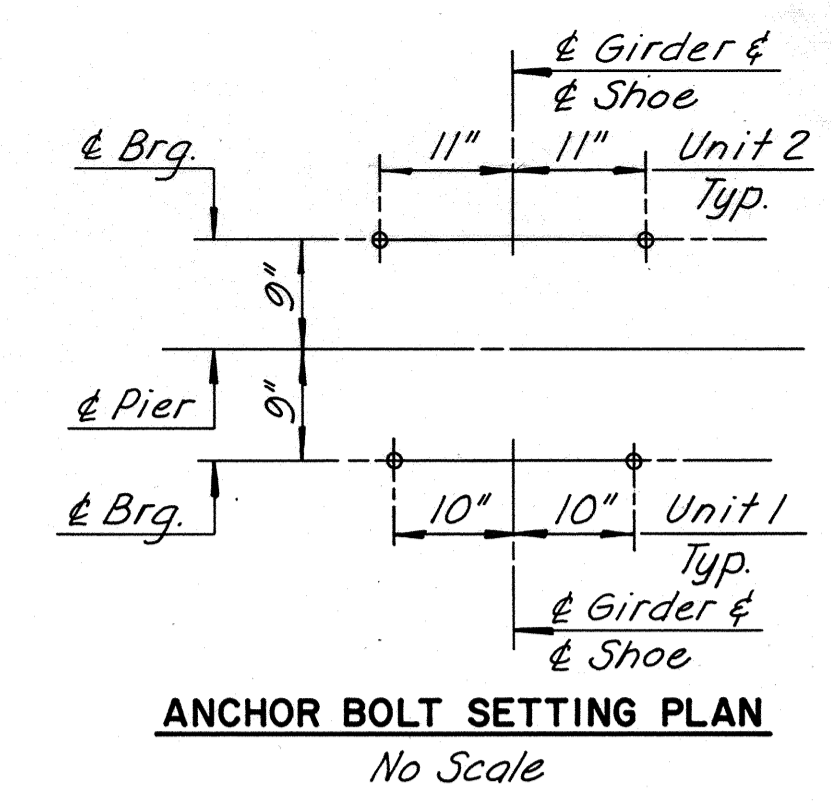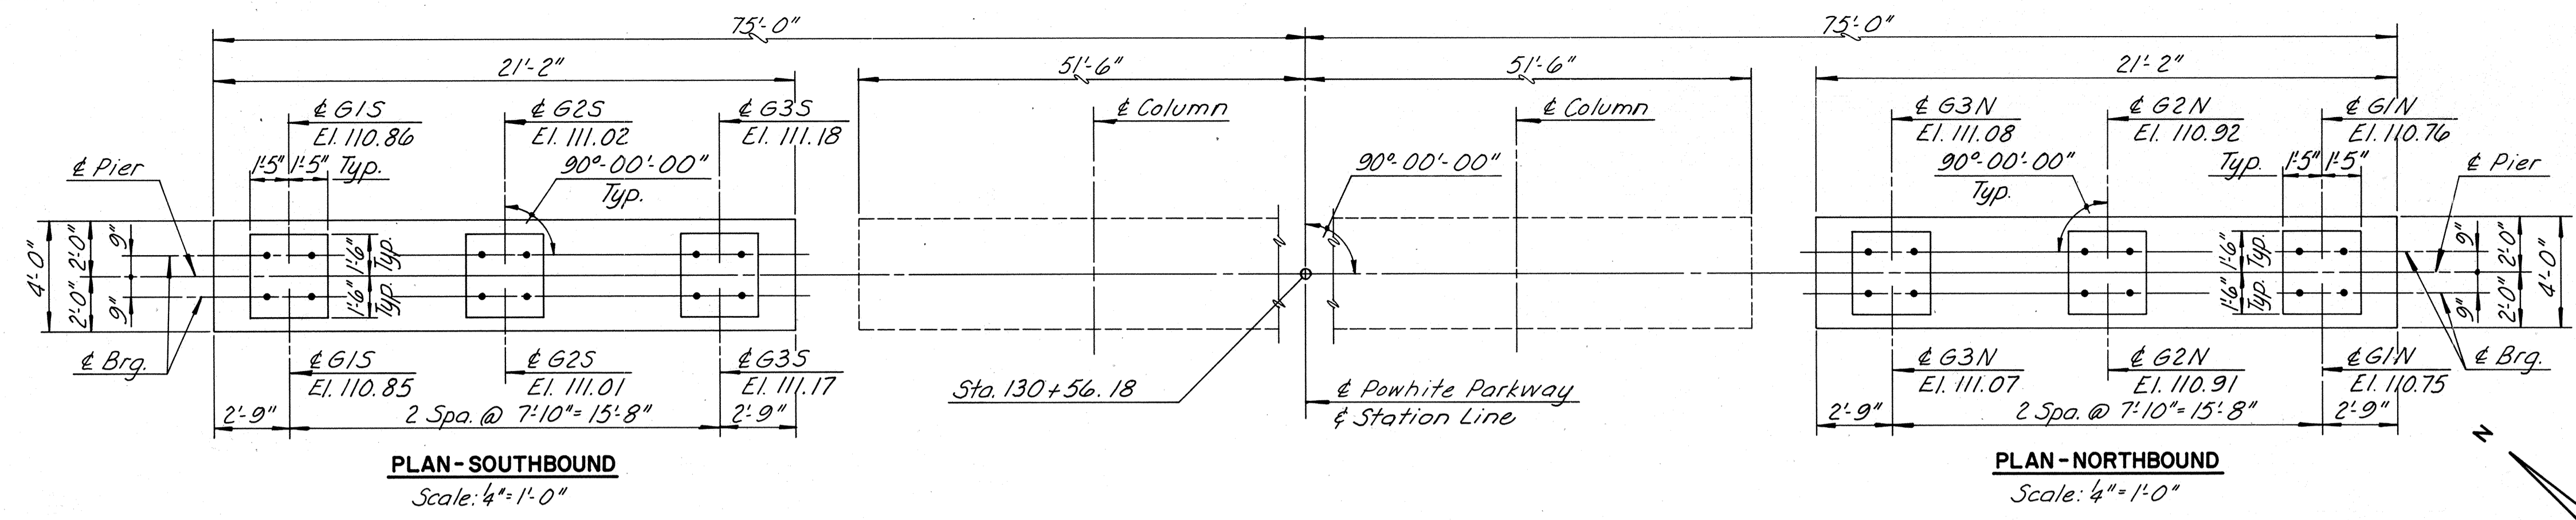

NOTES:
Allowable Bearing Pressure - 7 tons/s.f.
Actual Design Bearing Pressure - 4.7 tons/s.f.

NOTE A:
Pad reinforcing bars are to be spaced to clear Anchor Bolts.

BY	DATE	REVISION	BY	DATE
MADE	EJM 2-87			
CHECKED	TRF 3-87	As Built	TEM	3-89
IN CHARGE	S.R			

RICHMOND METROPOLITAN AUTHORITY
RICHMOND EXPRESSWAY SYSTEM



PIER 1 DETAILS

HOWARD, NEEDLES, TAMMEN & BERGENDOFF
consulting engineers
Alexandria, Virginia






SCALE: AS SHOWN
CONTRACT NO.: C-13
SHEET NO. 12 OF 106

AS BUILT

RICHMOND EXPRESSWAY SYSTEM			
SECTION	PROJECT	SHEET NO.	TOTAL SHEETS
13	WIDENING JAMES RIVER BRIDGE	14	106

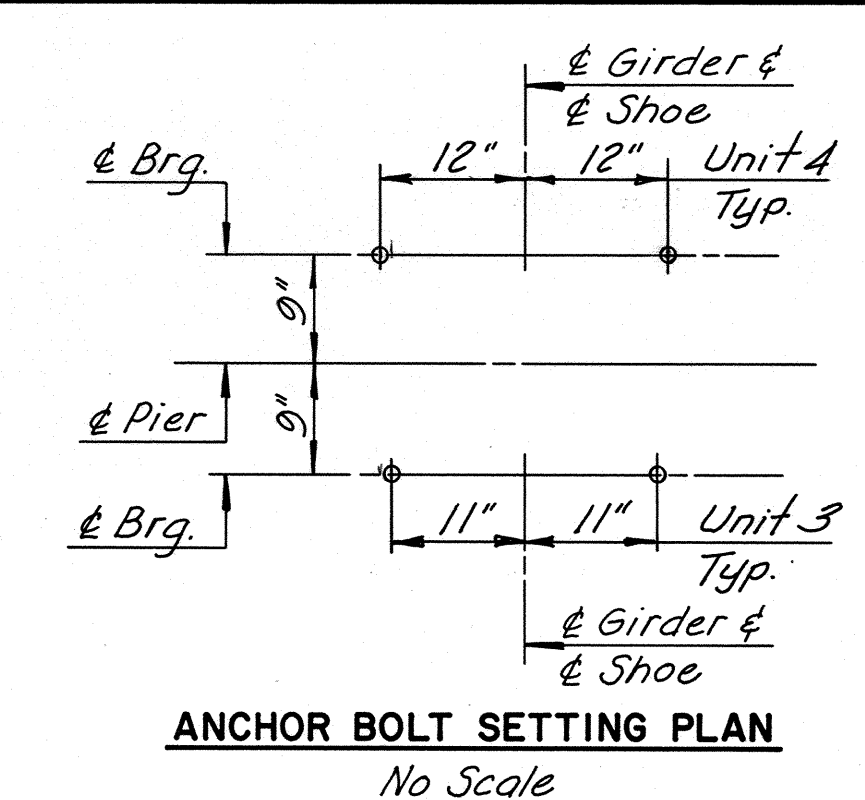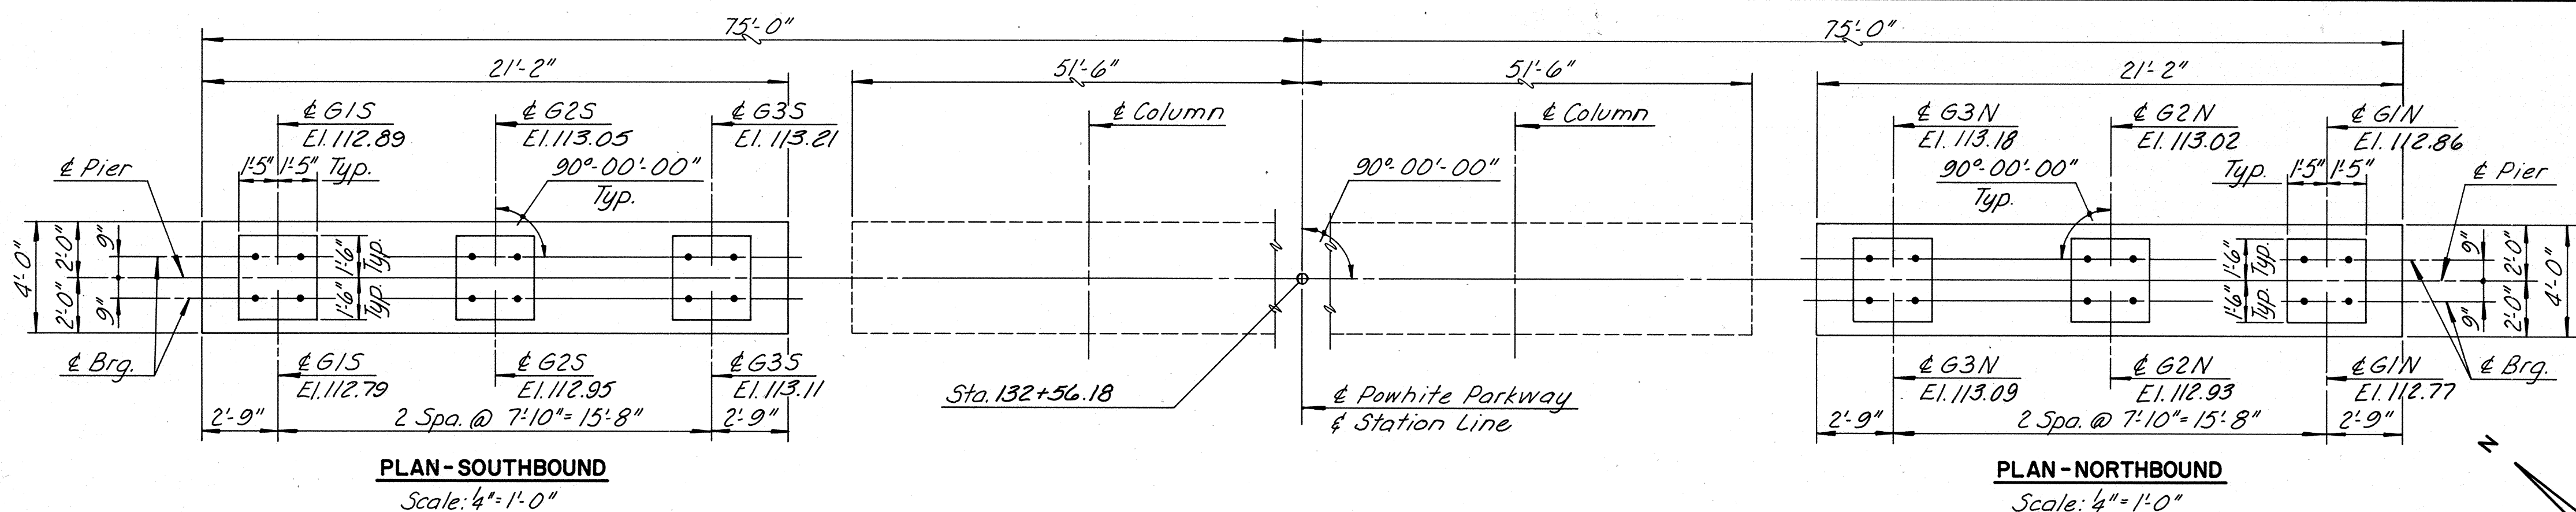

52-PF0504
Eq. Spa. Typ.

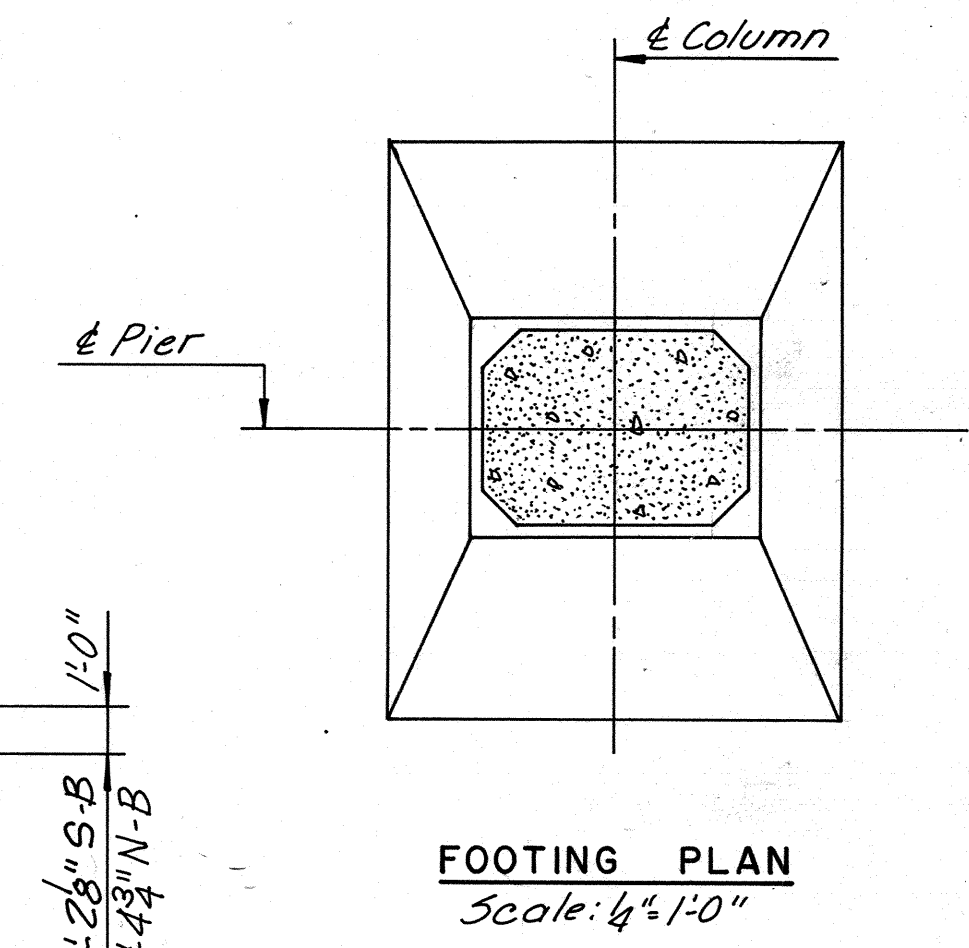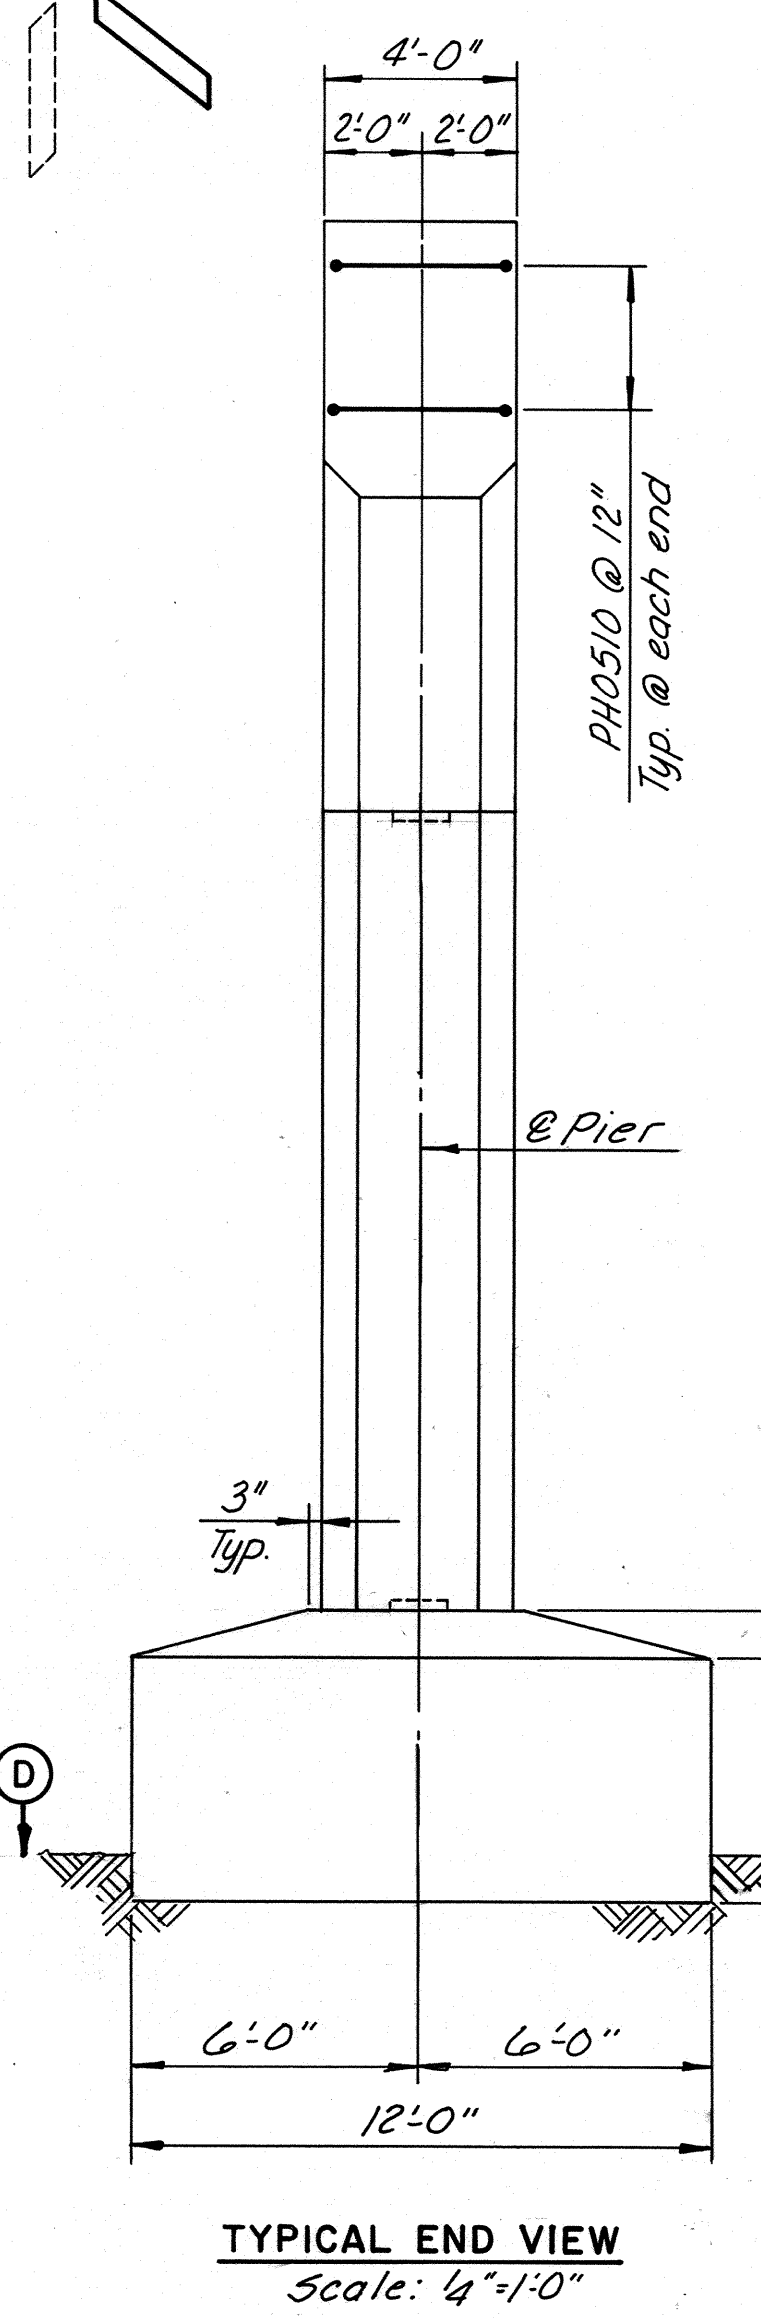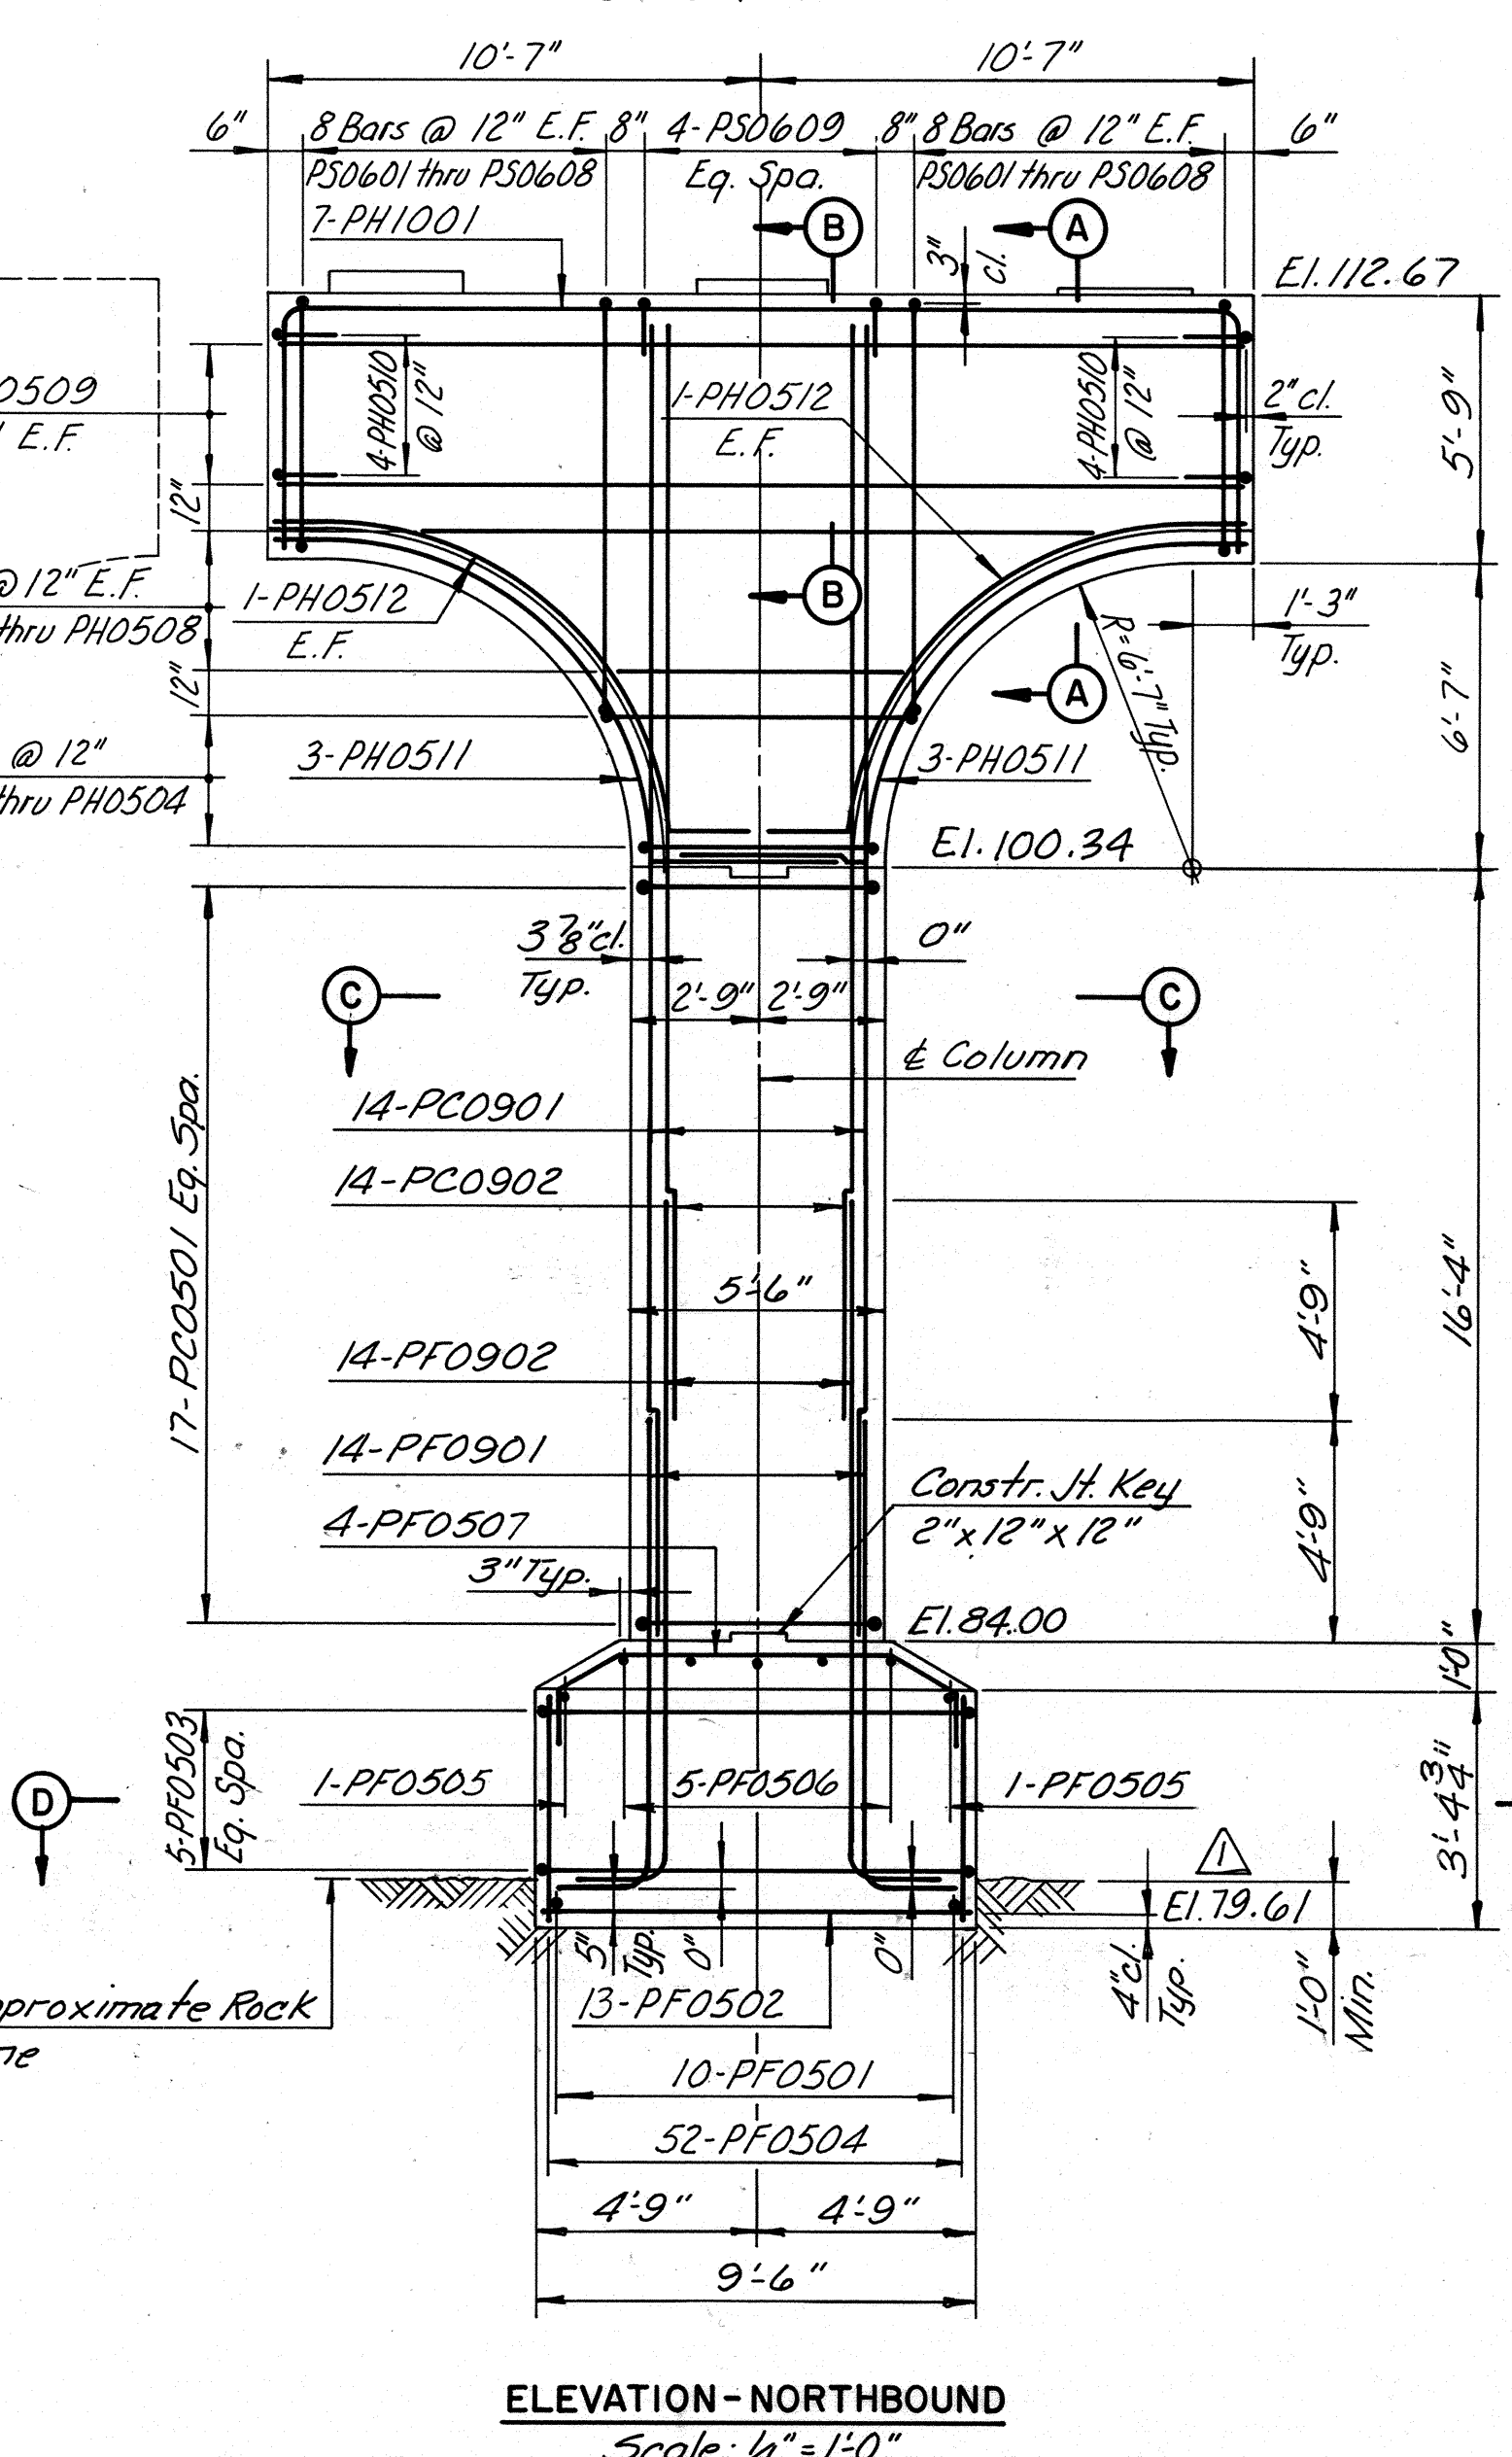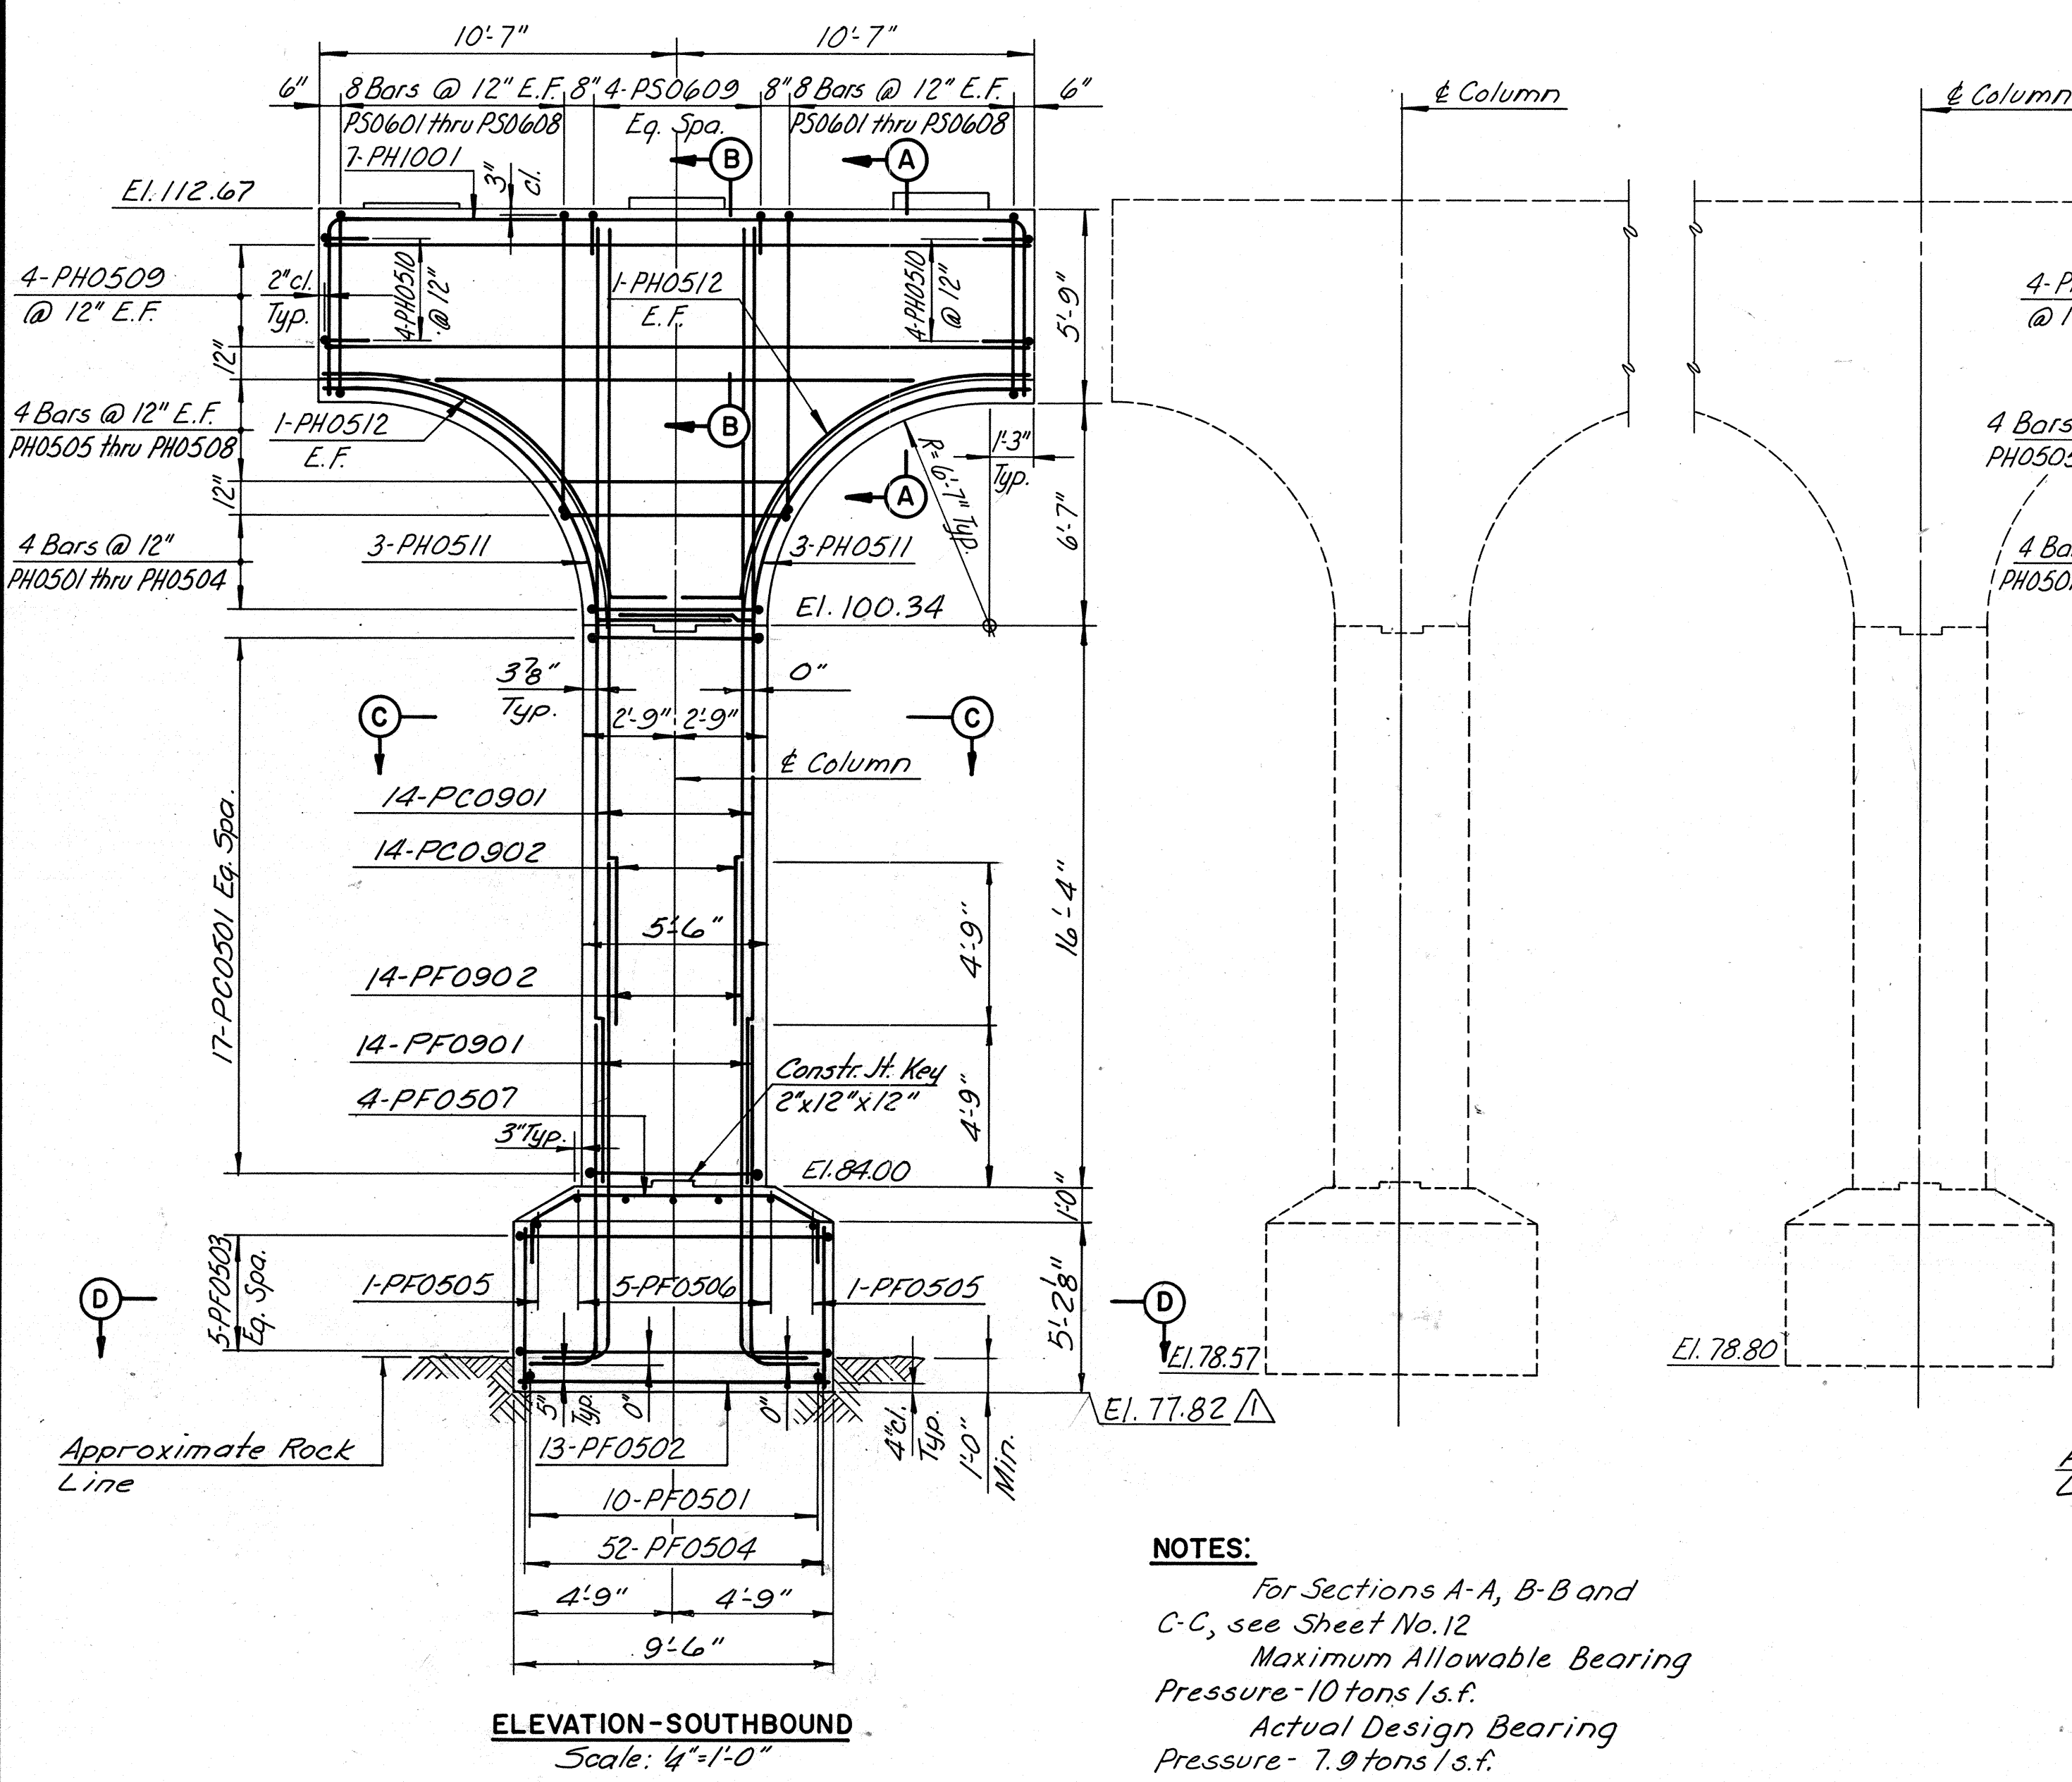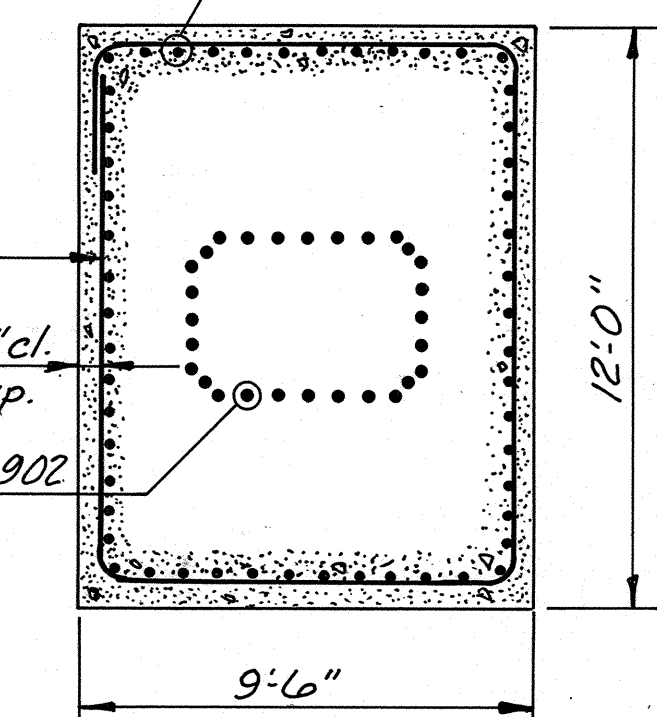

NOTES:
For Sections A-A, B-B and C-C, see Sheet No. 12
Maximum Allowable Bearing Pressure - 10 tons / s.f.
Actual Design Bearing Pressure - 7.9 tons / s.f.

MADE	BY	DATE	NO.	REVISION	BY	DATE
	T.A.L	3-87				
	T.F.P	3-87		As Built	TEM	3-89
	S.R.					

AS BUILT








RICHMOND METROPOLITAN AUTHORITY
RICHMOND EXPRESSWAY SYSTEM

PIER 3 DETAILS

SCALE: AS SHOWN
CONTRACT NO: C-13
SHEET NO. 14 OF 106

HOWARD, NEEDLES, TAMMEN & BERGENDOFF
consulting engineers
Alexandria, Virginia

RICHMOND EXPRESSWAY SYSTEM			
SECTION	PROJECT	SHEET NO.	TOTAL SHEETS
13	WIDENING JAMES RIVER BRIDGE	16	106

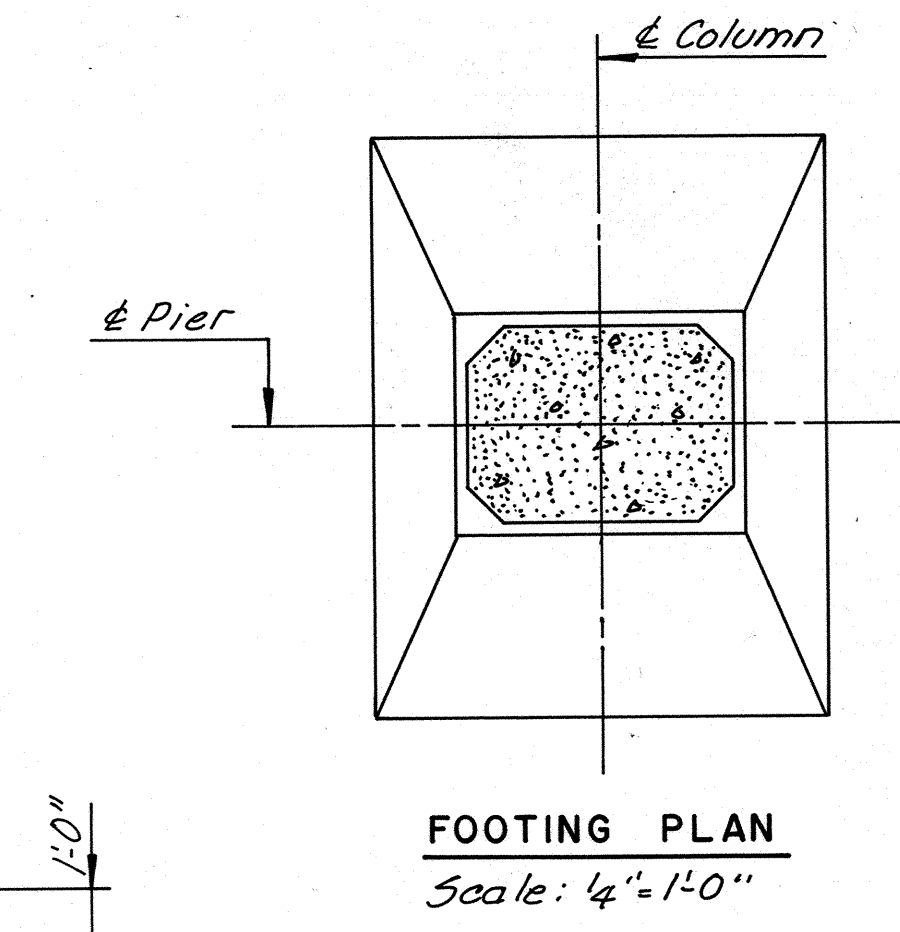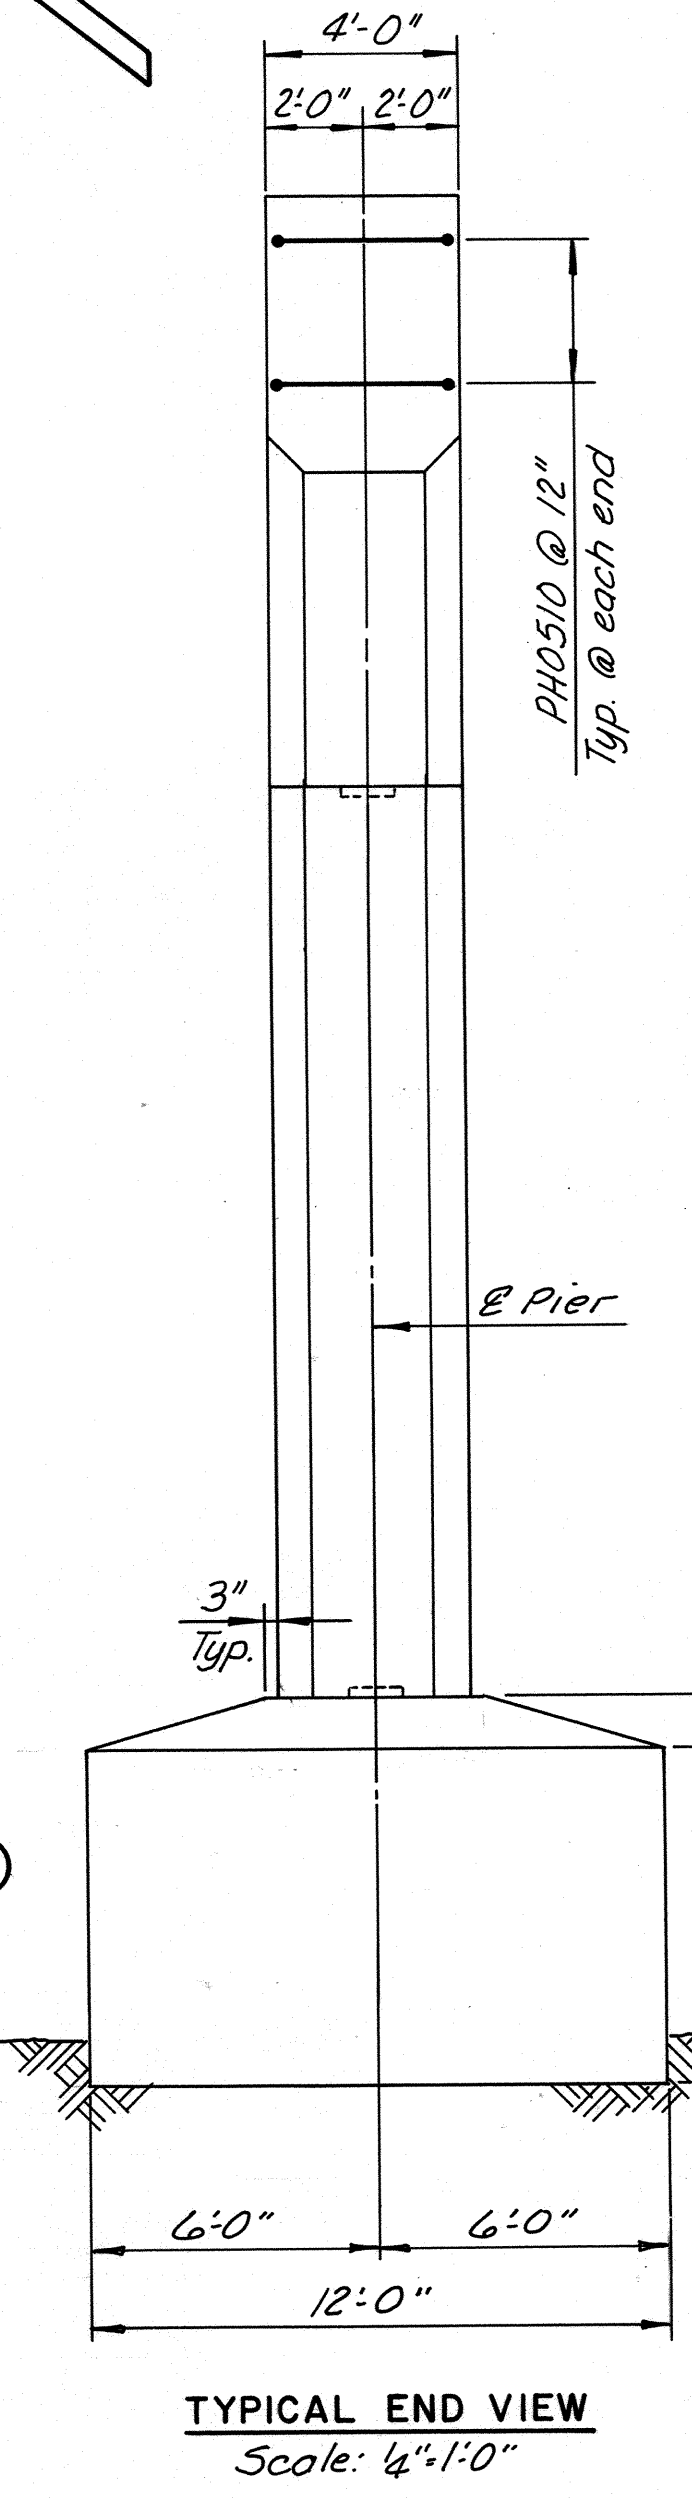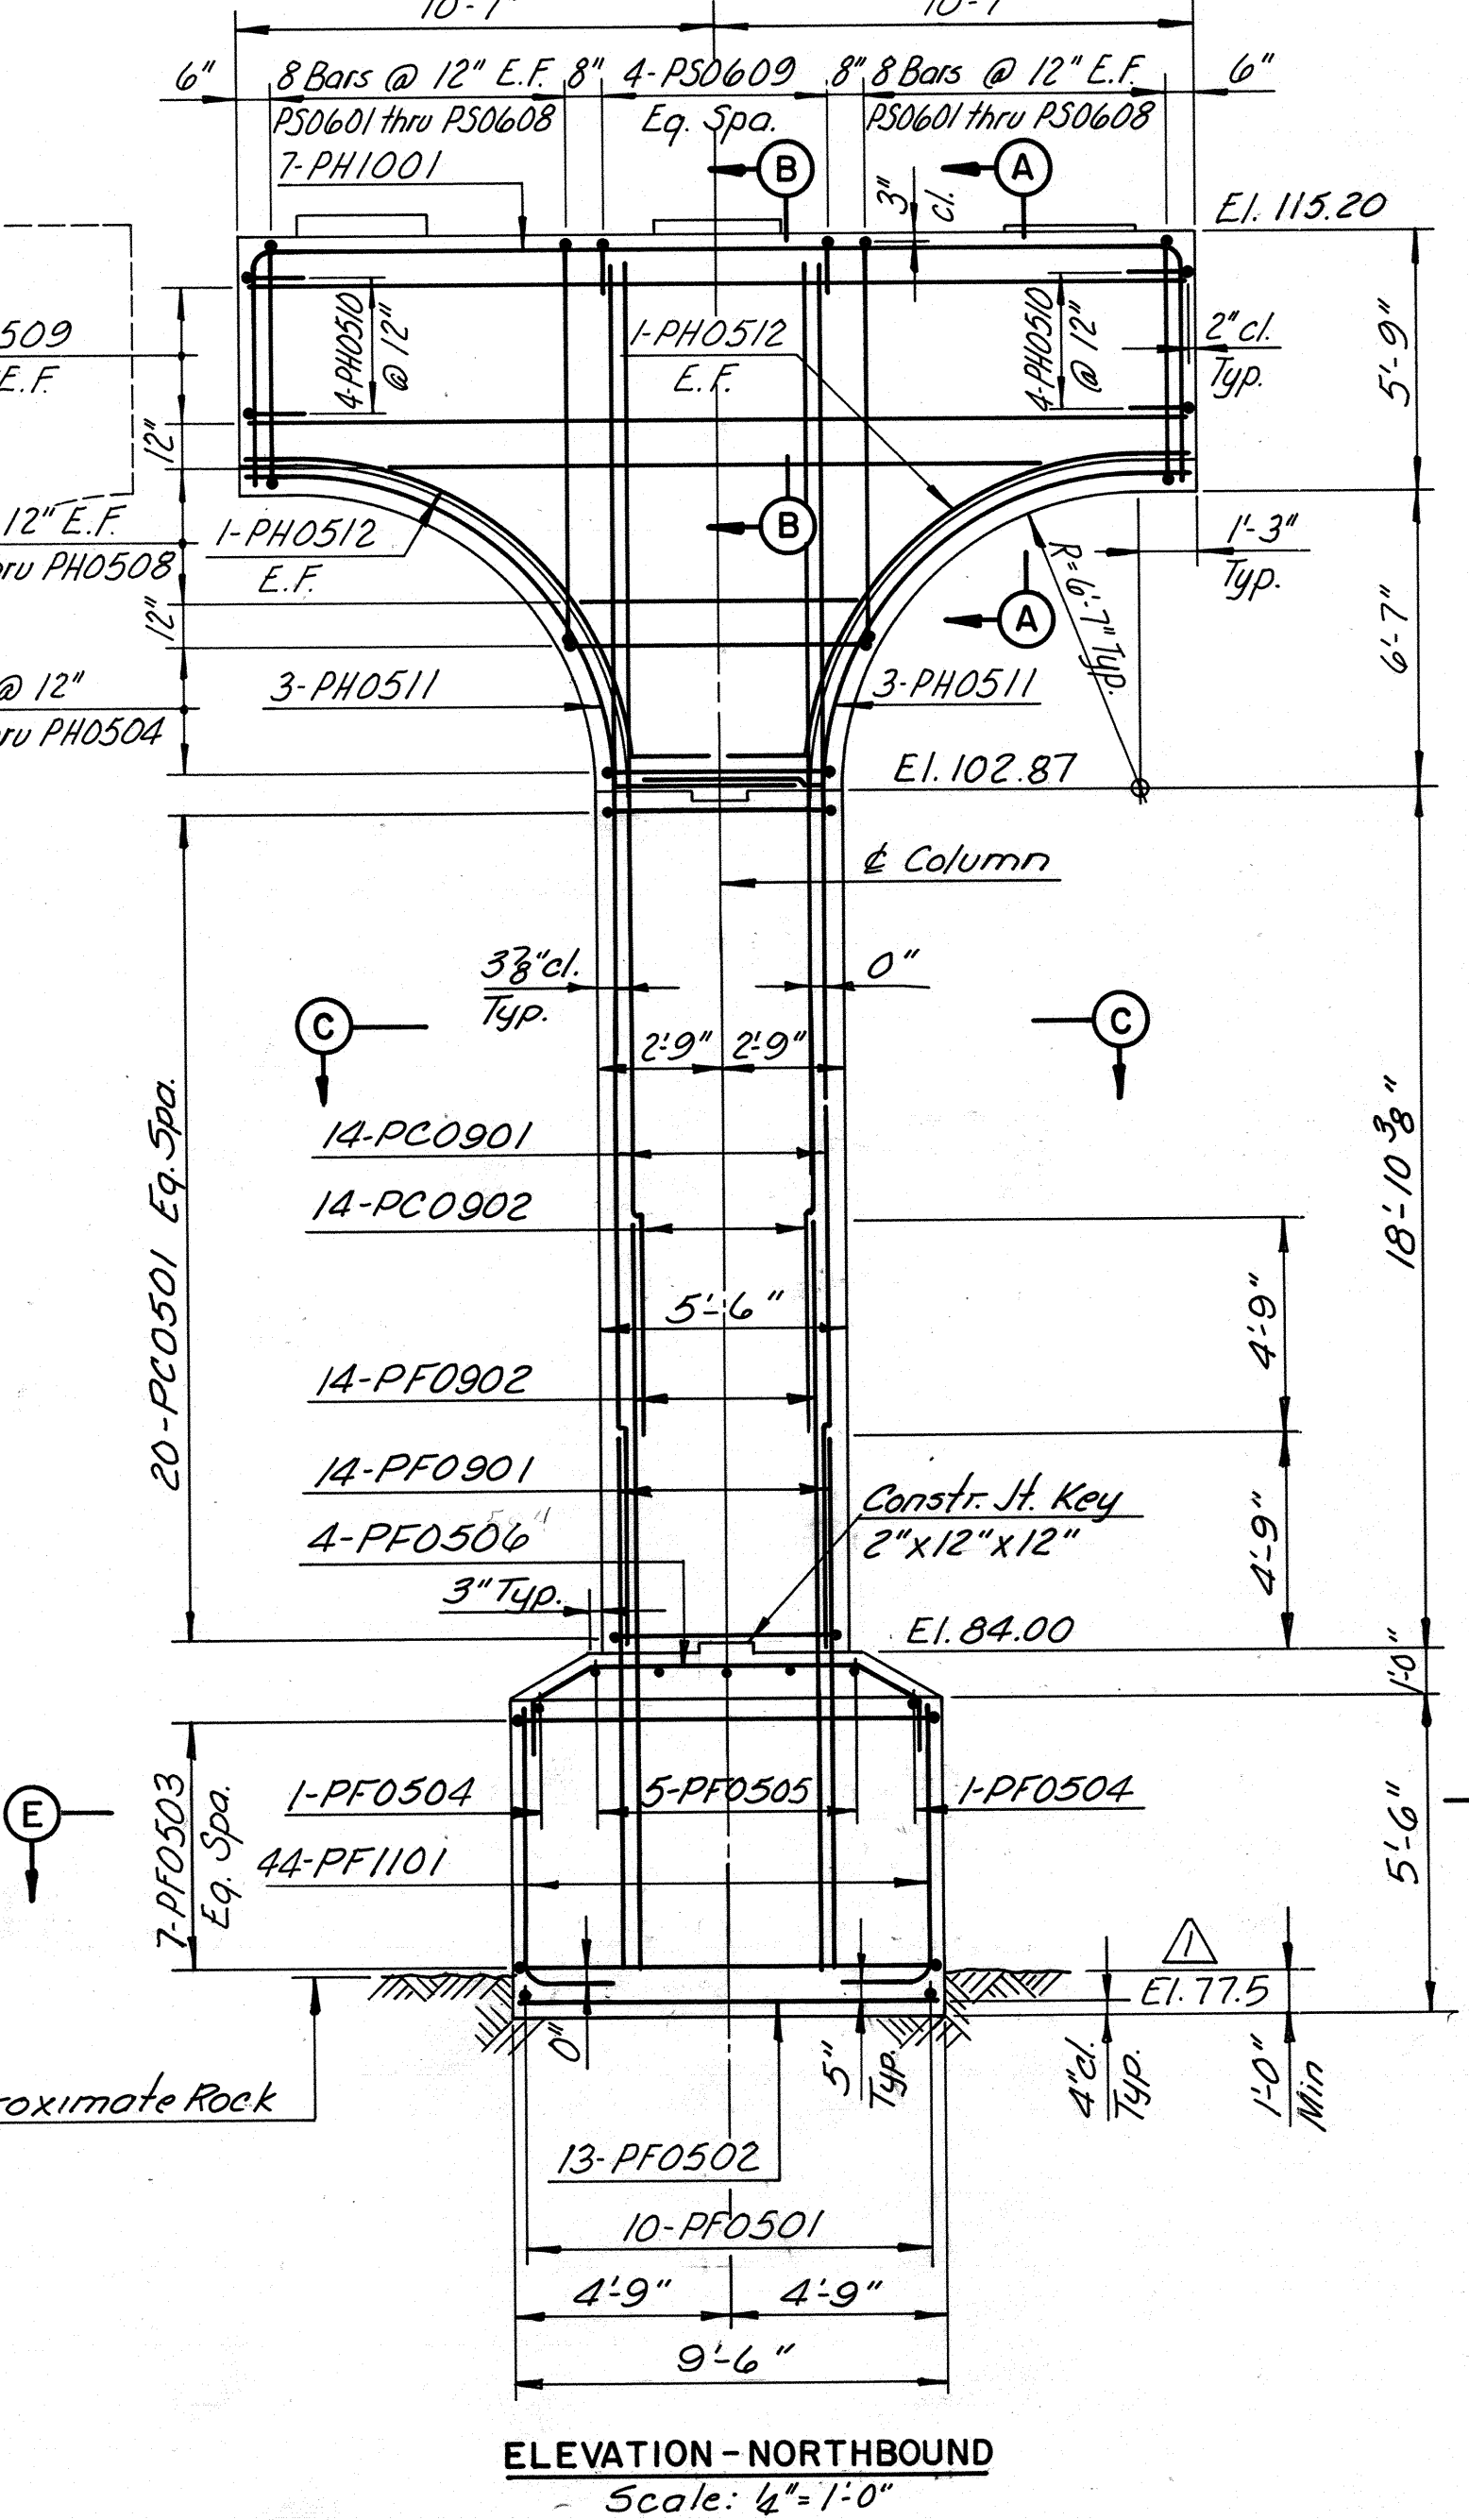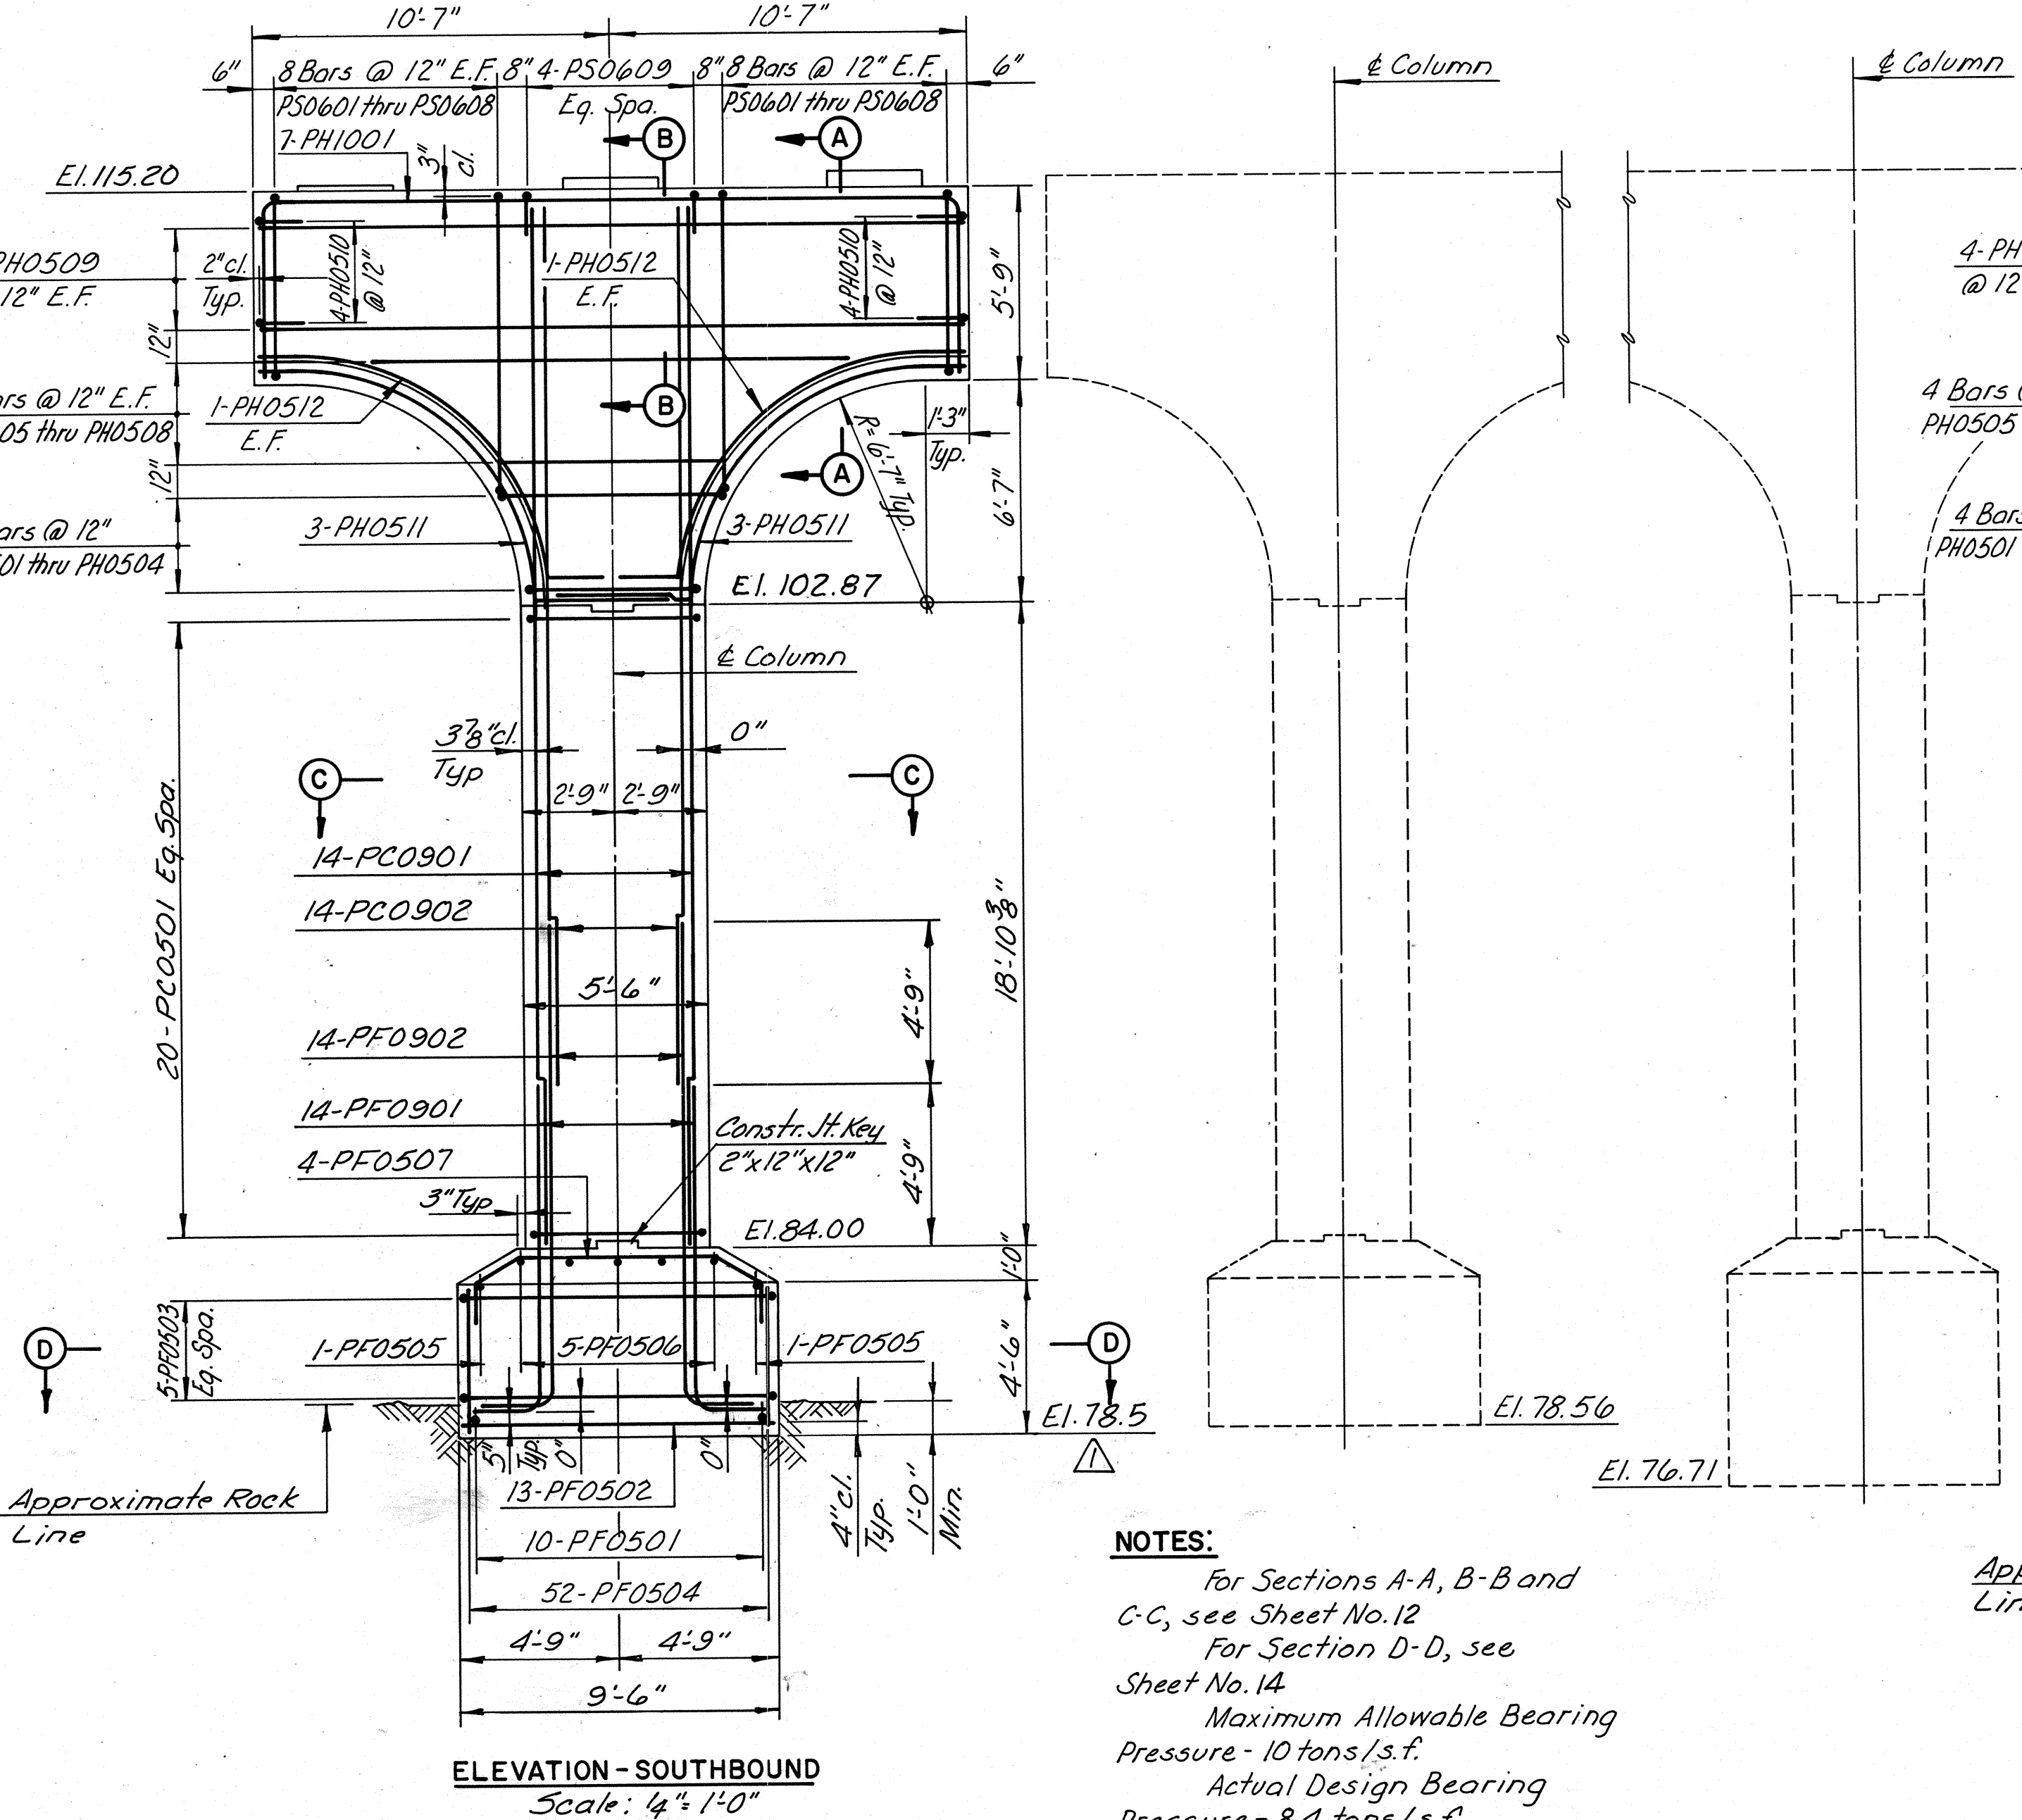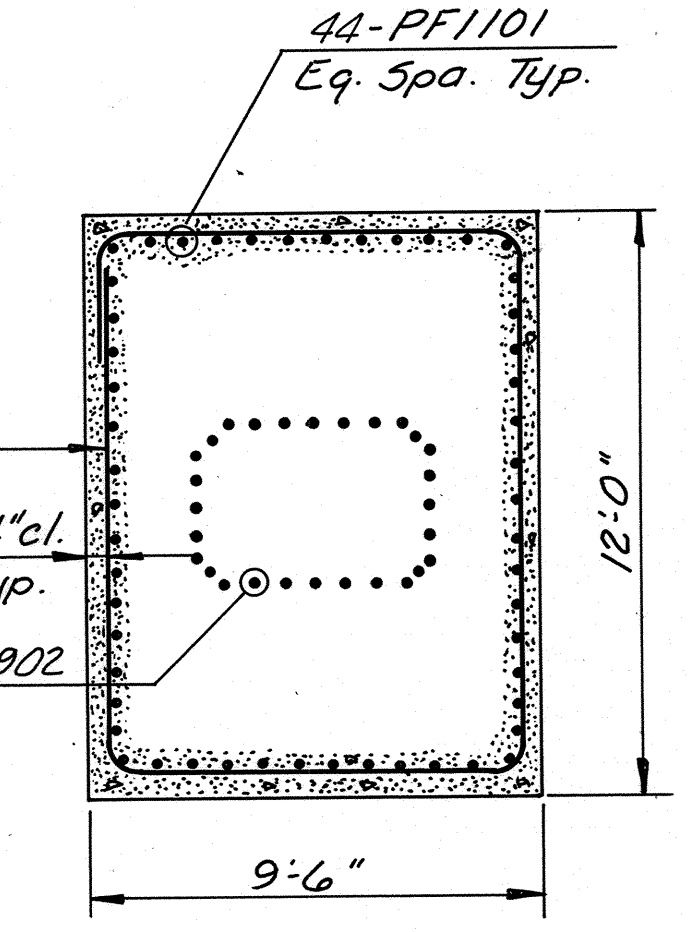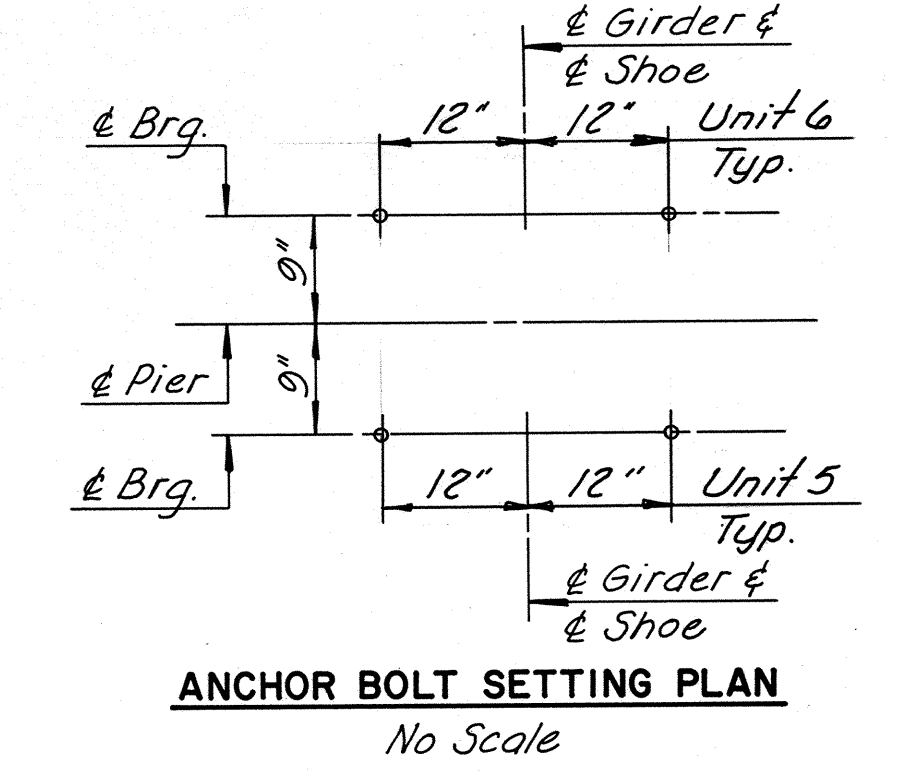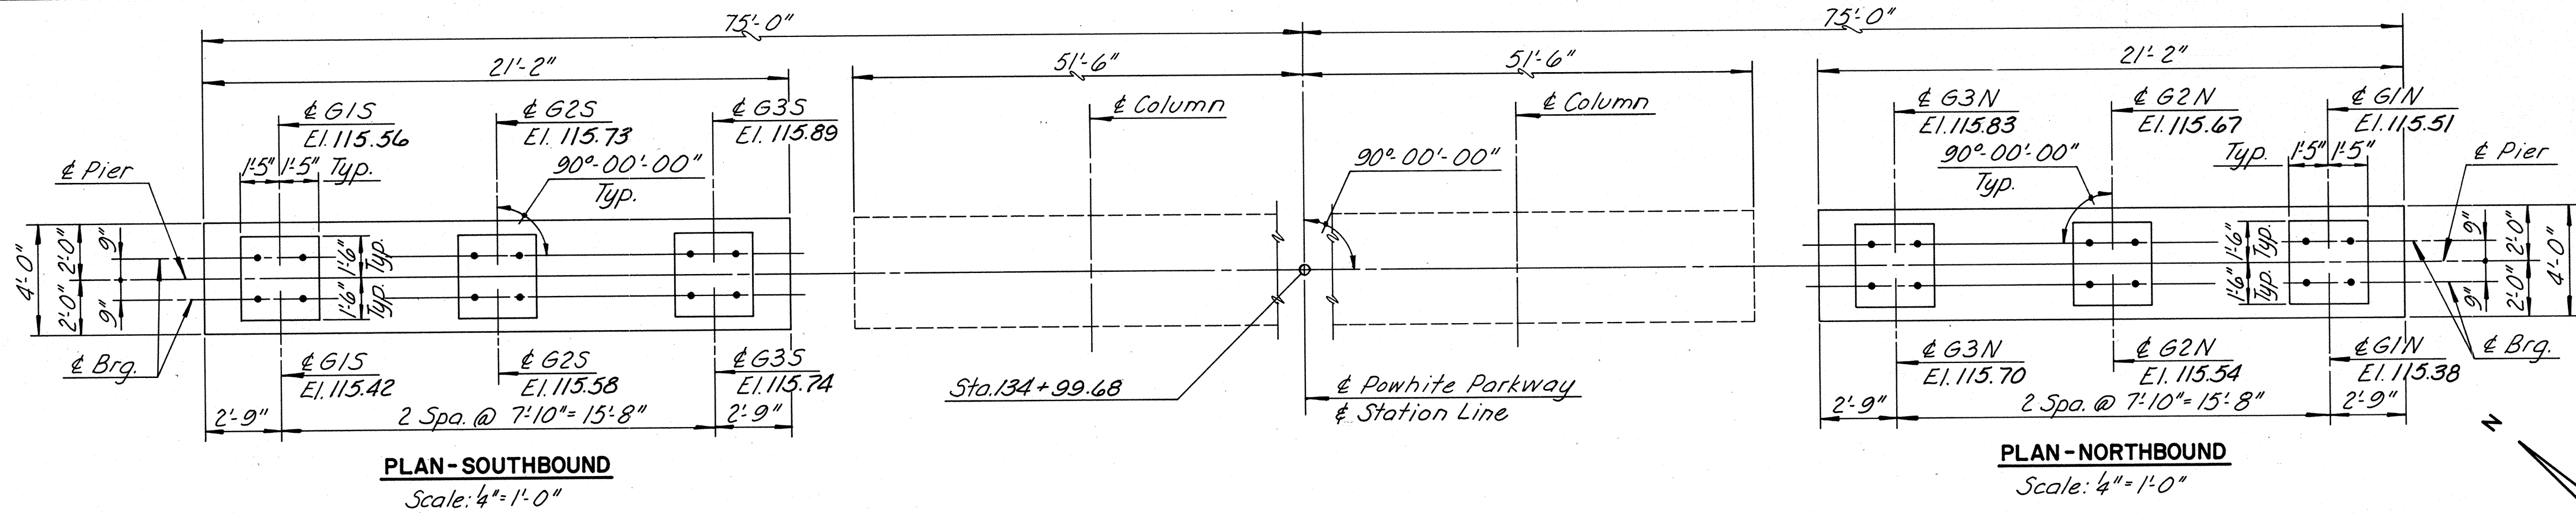

**RICHMOND METROPOLITAN AUTHORITY
RICHMOND EXPRESSWAY SYSTEM**







PIER 5 DETAILS

BY	DATE	NO.	REVISION	BY	DATE
MADE	T.A.L. 3-87				
CHECKED	T.F.P. 3-87		As Built	TEM	3-89
IN CHARGE	S.P.				

AS BUILT

SCALE: AS SHOWN
HOWARD, NEEDLES, TAMMEN & BERGENDOFF
consulting engineers
Alexandria, Virginia
CONTRACT NO: C-13
SHEET NO. 16 of 106

RICHMOND EXPRESSWAY SYSTEM			
SECTION	PROJECT	SHEET NO.	TOTAL SHEETS
13	WIDENING JAMES RIVER BRIDGE	18	106

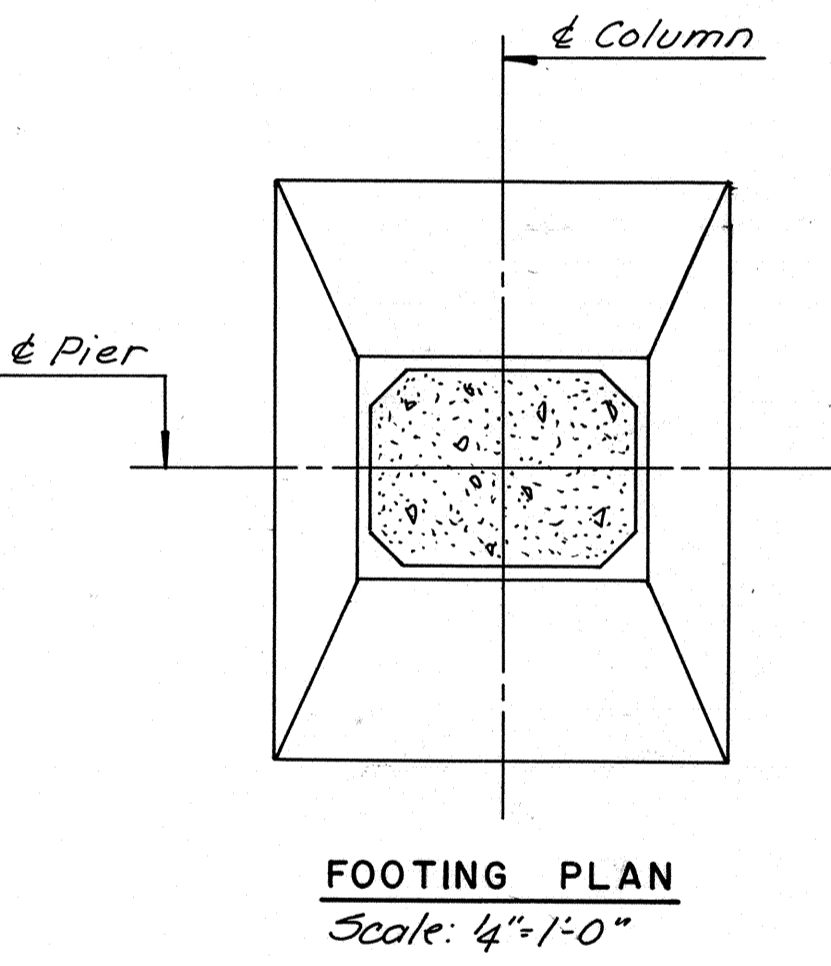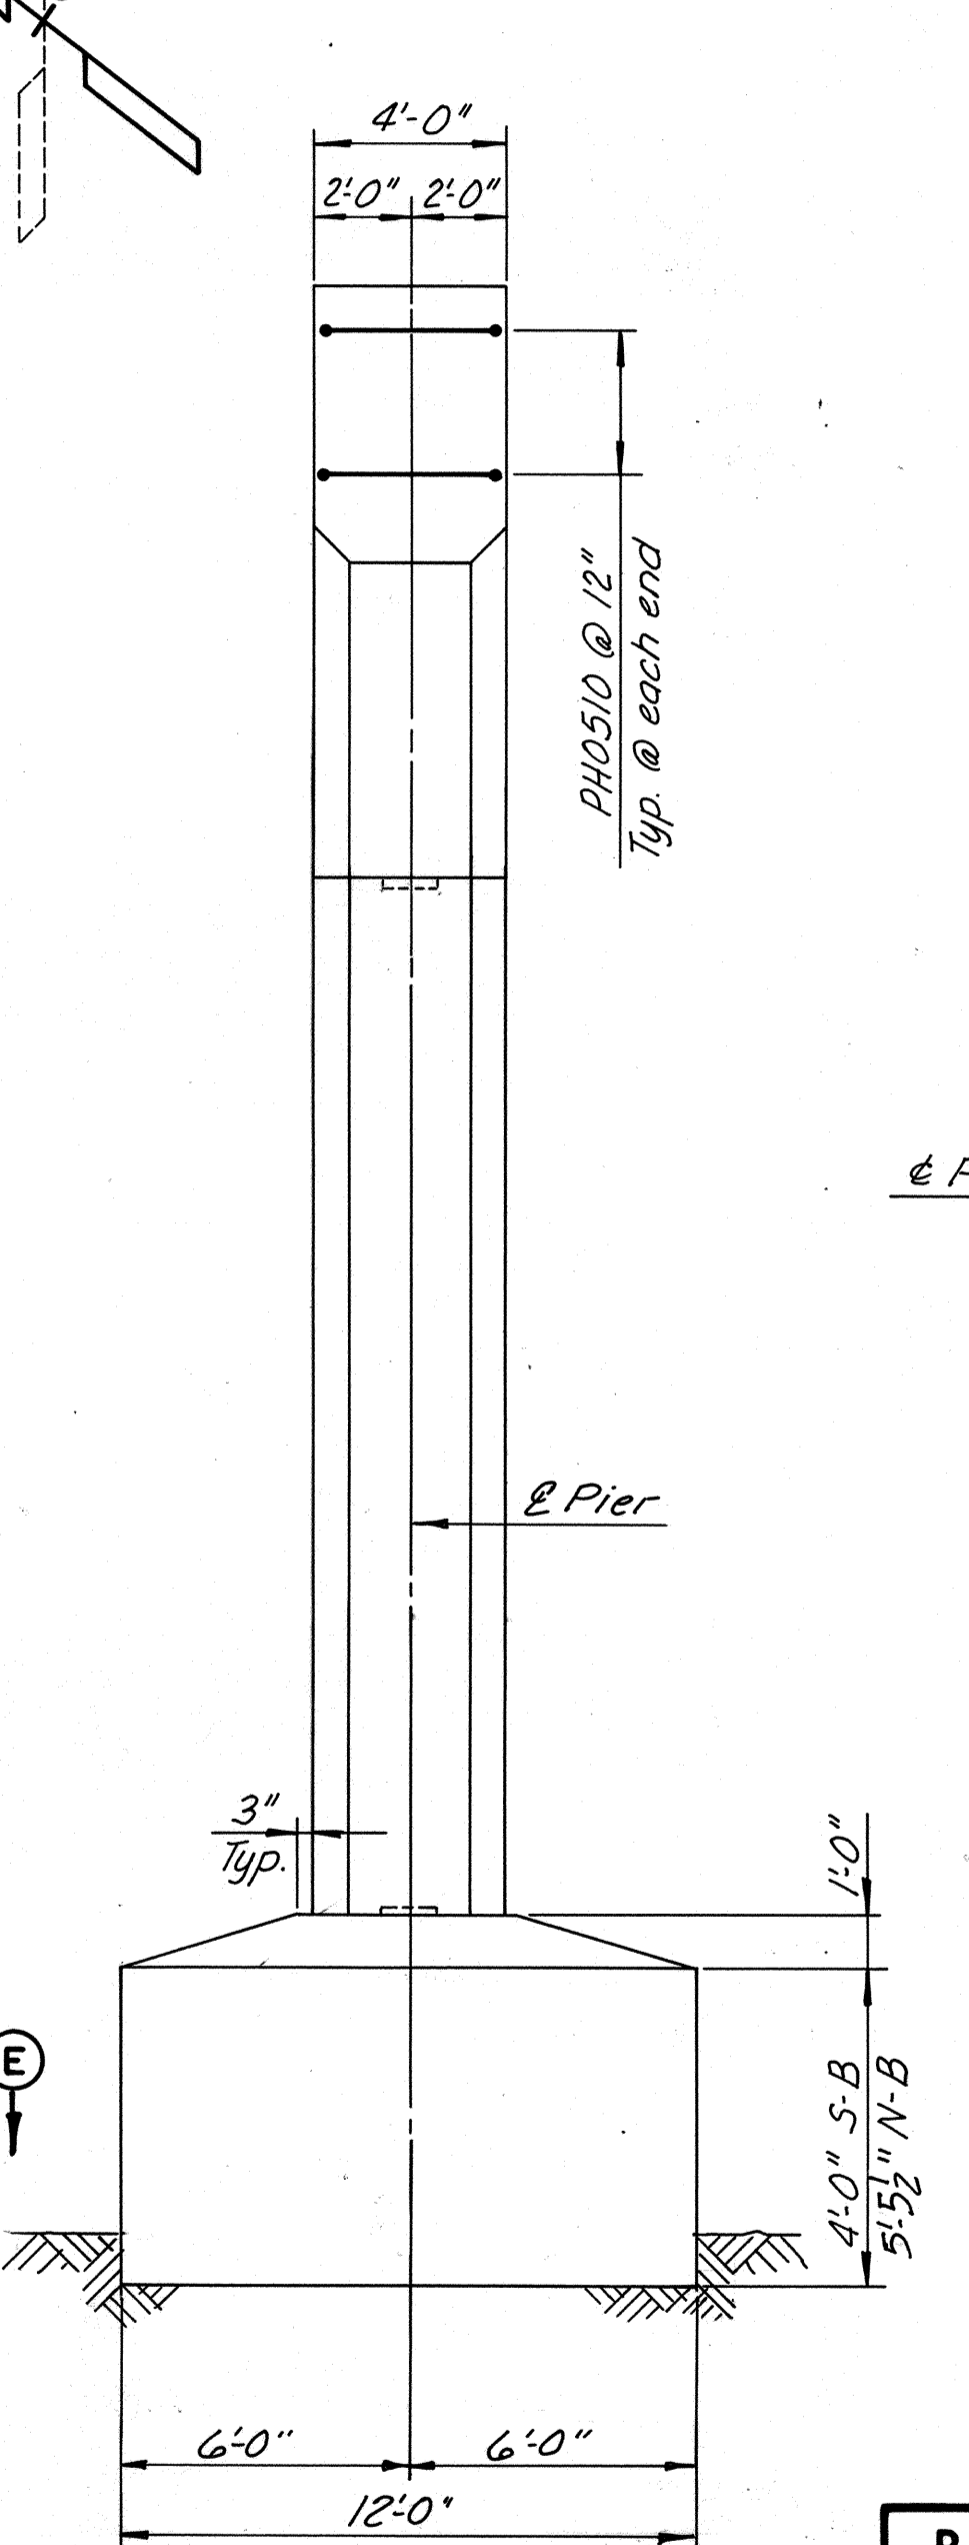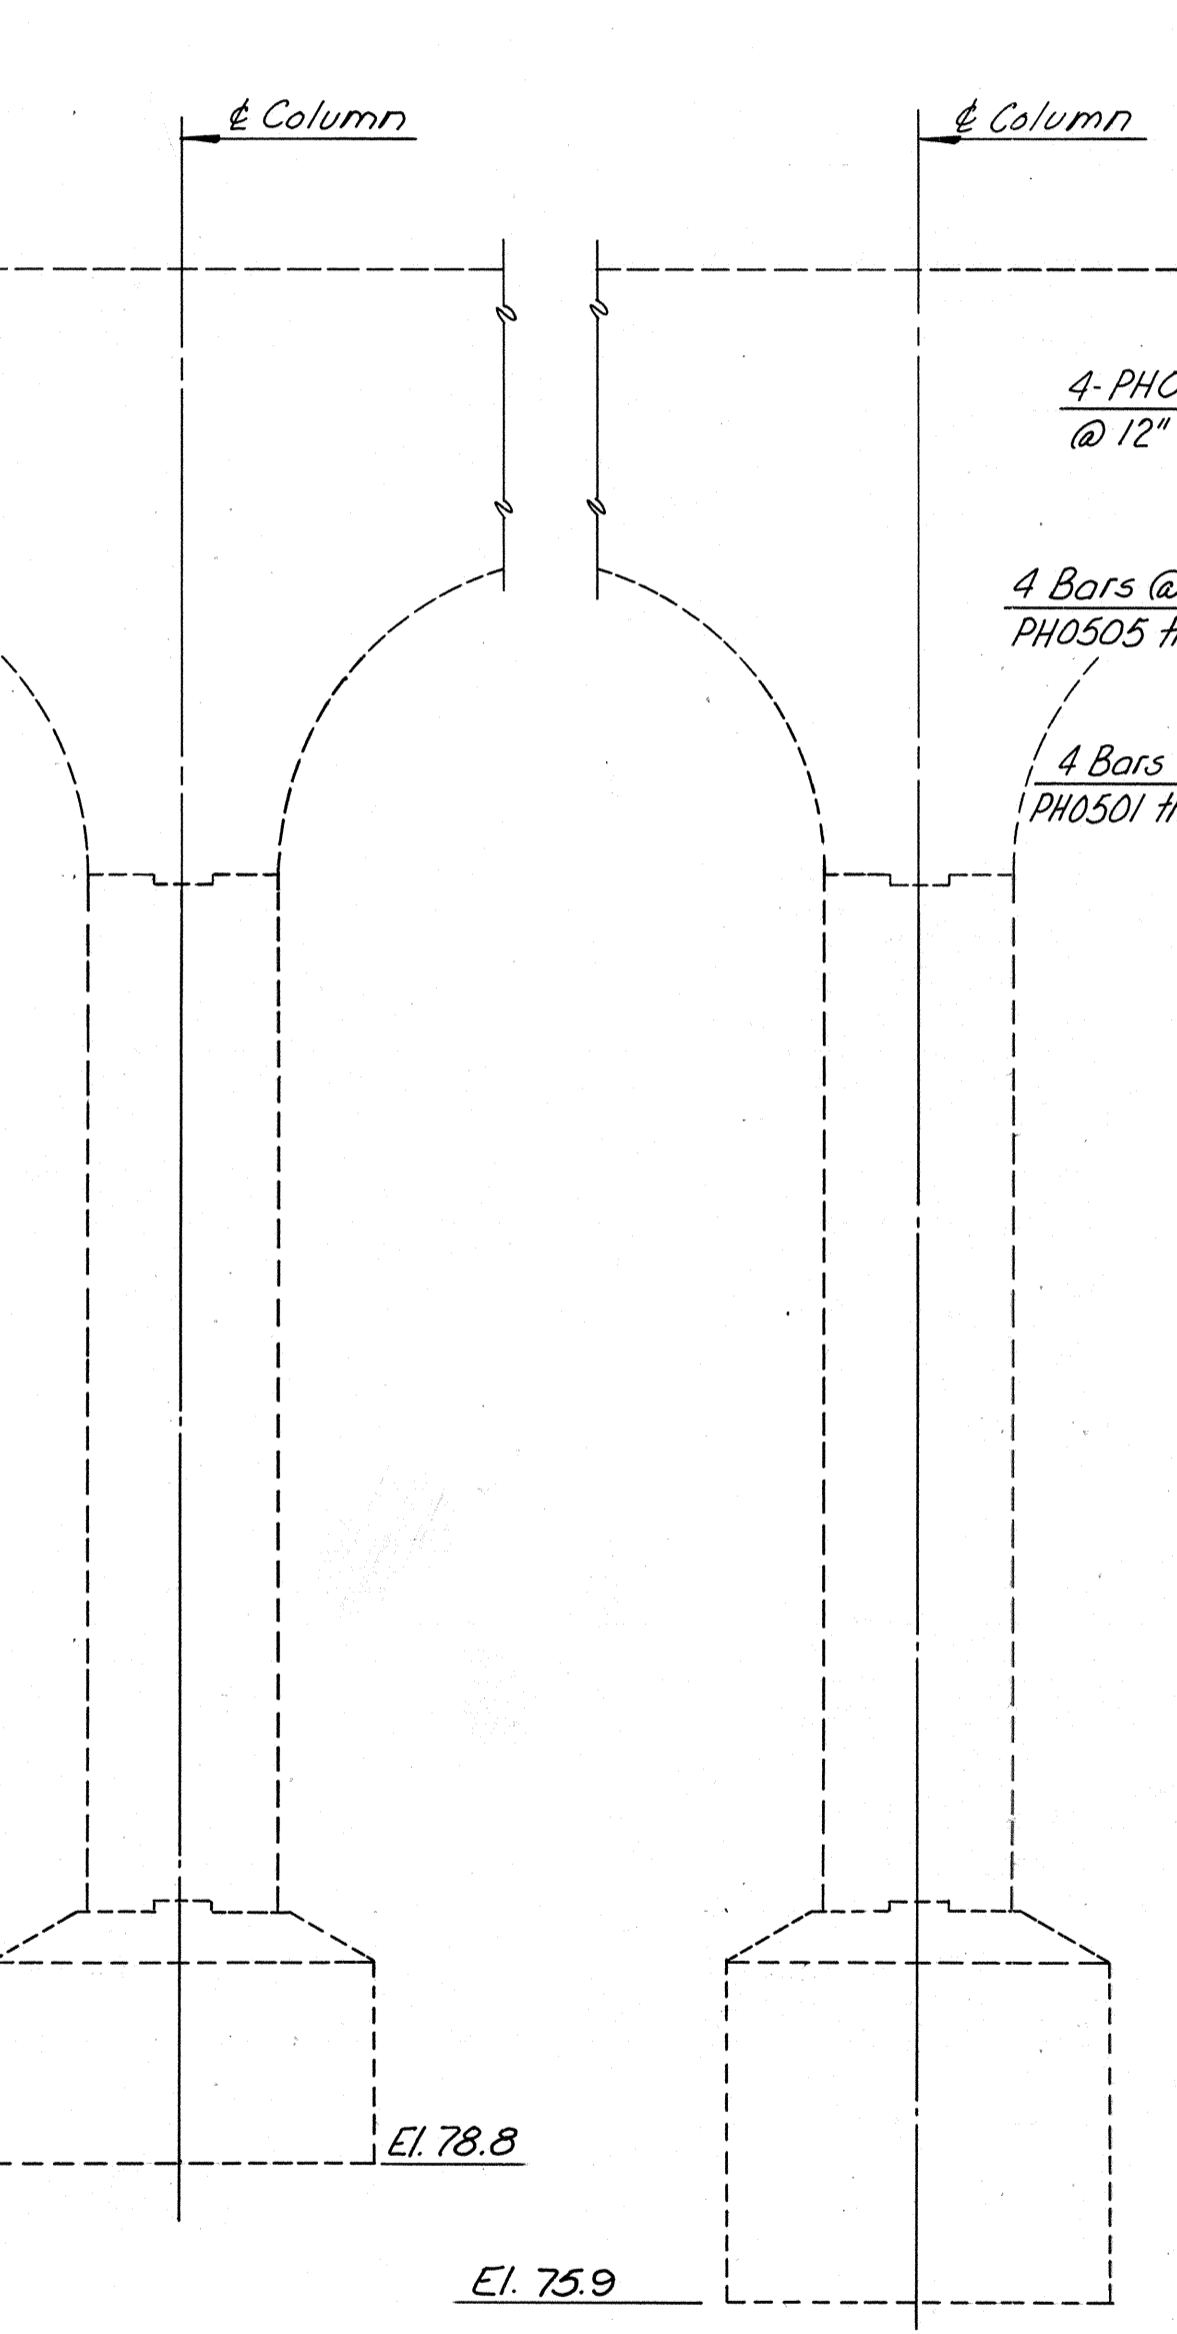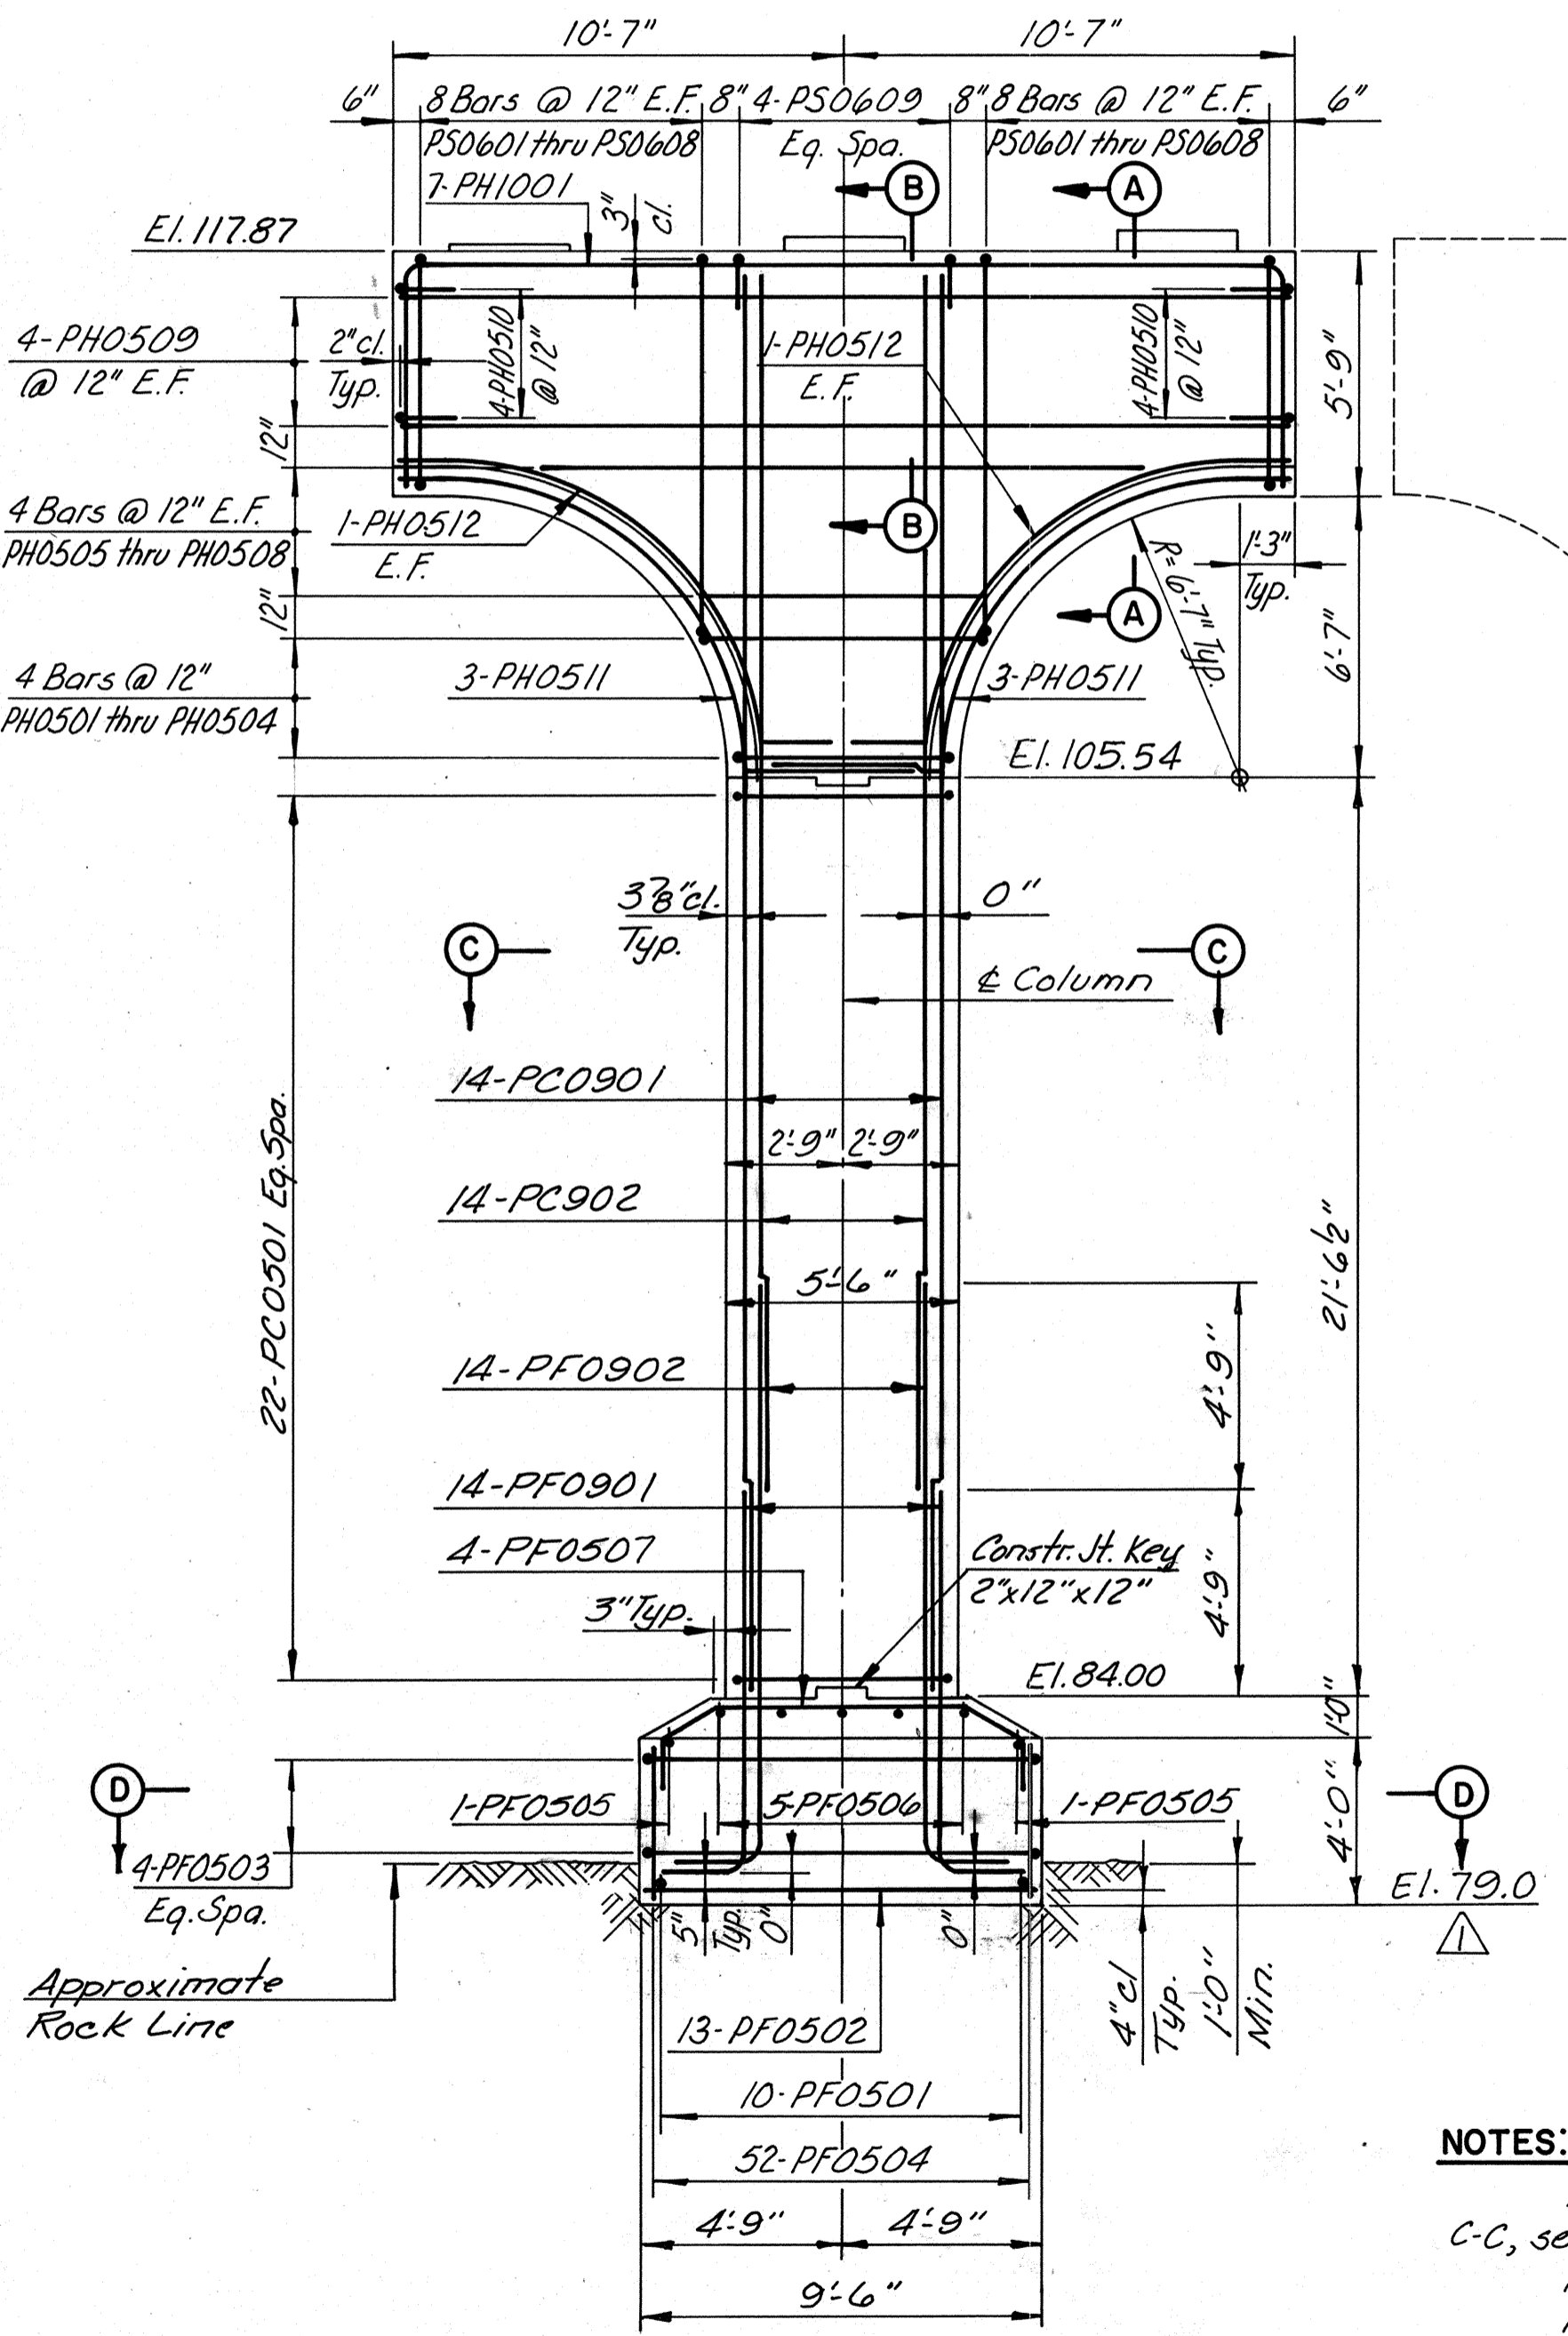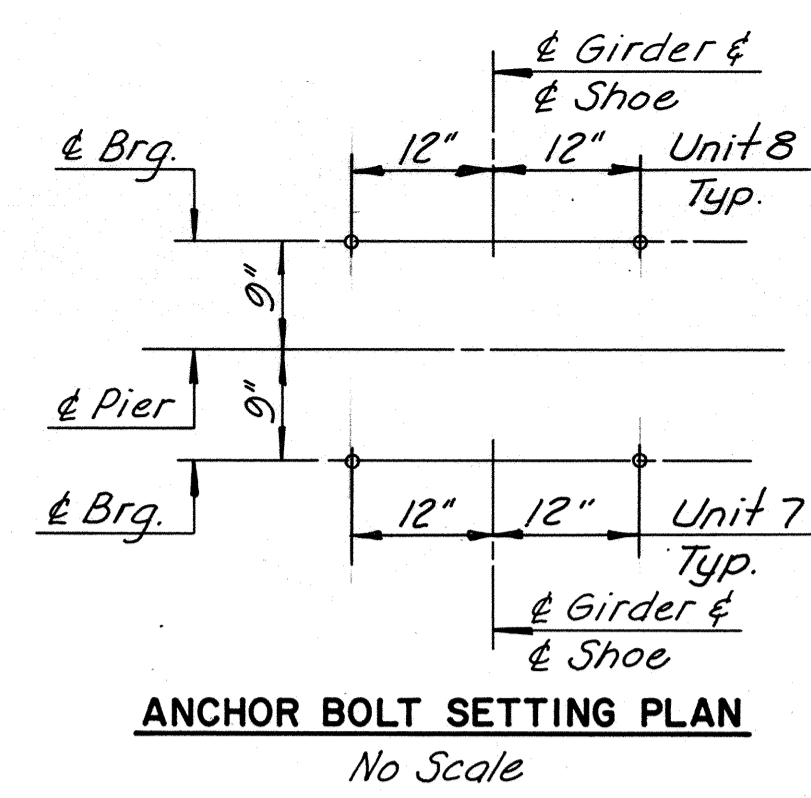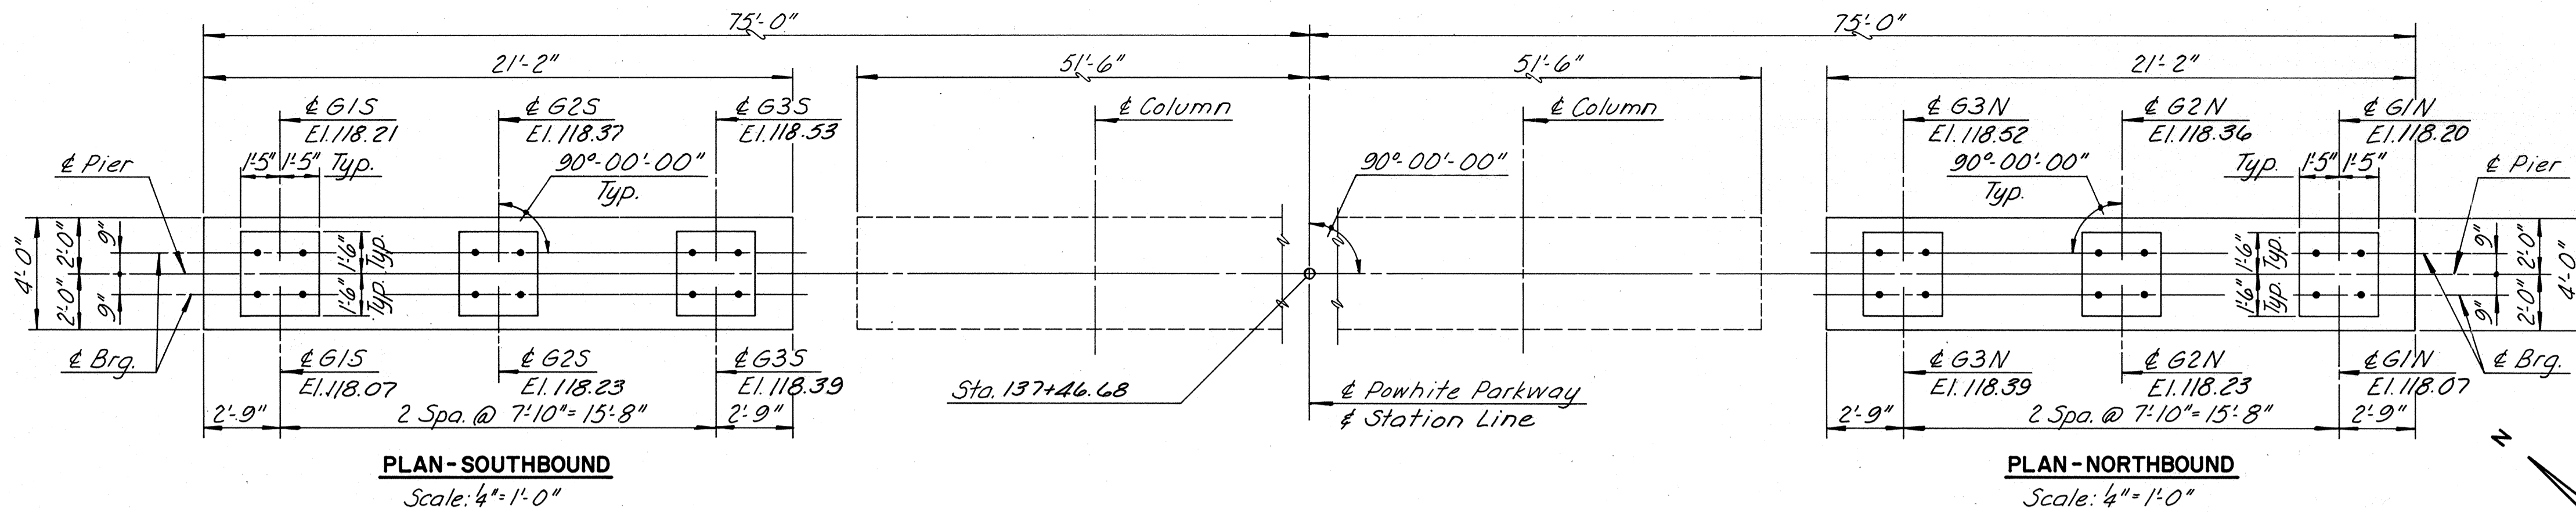

NOTES:

For Sections A-A, B-B and C-C, see Sheet No. 12

For Section D-D, see Sheet No. 14

For Section E-E, see Sheet No. 16

Maximum Allowable Bearing Pressure - 10 tons/s.f.

Actual Design Bearing Pressure - Southbound 7.9 tons/s.f. Northbound 8.3 tons/s.f.

BY	DATE	REVISION	BY	DATE
MADE	TAL 3-87			
CHECKED	T.F.P 3-87	As Built	TEM	3-89
IN CHARGE	S.R.			

AS BUILT






**RICHMOND METROPOLITAN AUTHORITY
RICHMOND EXPRESSWAY SYSTEM**

PIER 7 DETAILS

HOWARD, NEEDLES, TAMMEN & BERGENOFF
consulting engineers
Alexandria, Virginia

SCALE: AS SHOWN
CONTRACT NO.: C-13
SHEET NO. 18 OF 106

RICHMOND EXPRESSWAY SYSTEM			
SECTION	PROJECT	SHEET NO.	TOTAL SHEETS
13	WIDENING JAMES RIVER BRIDGE	22	106

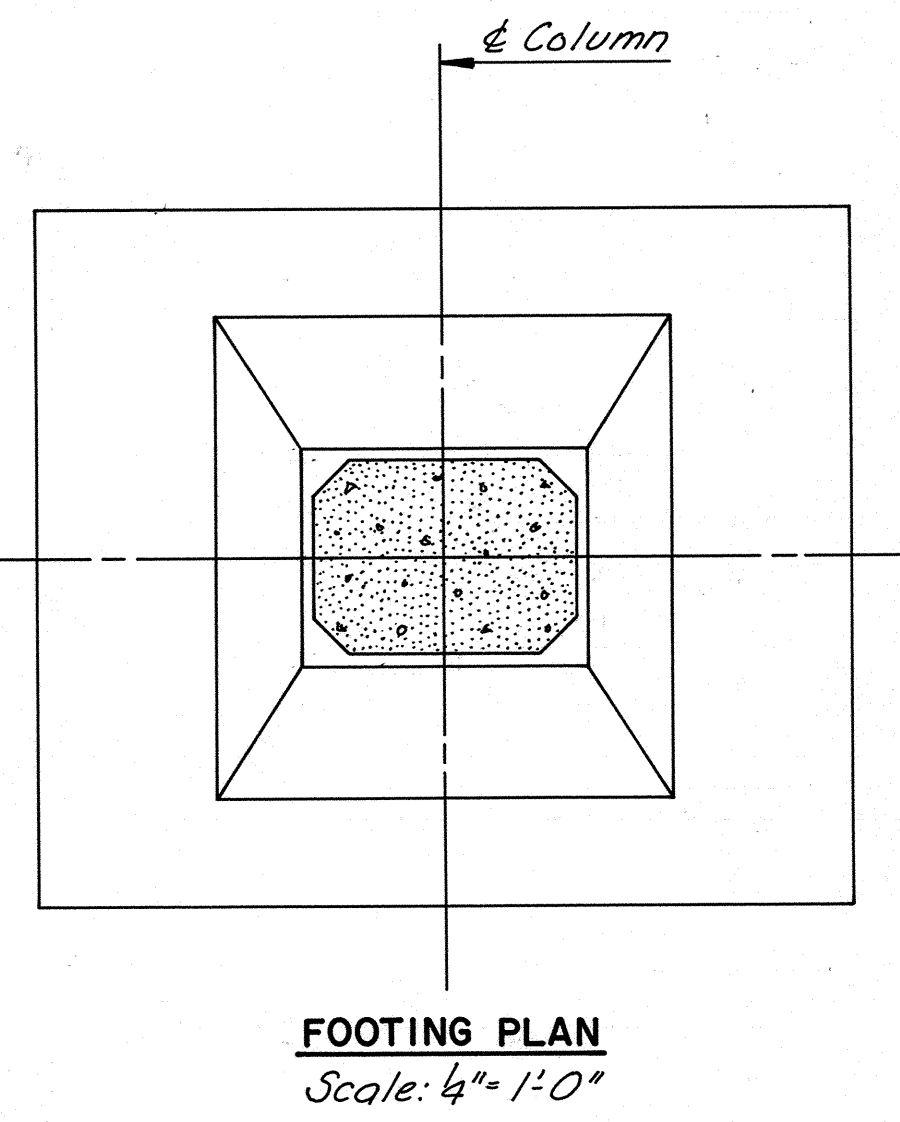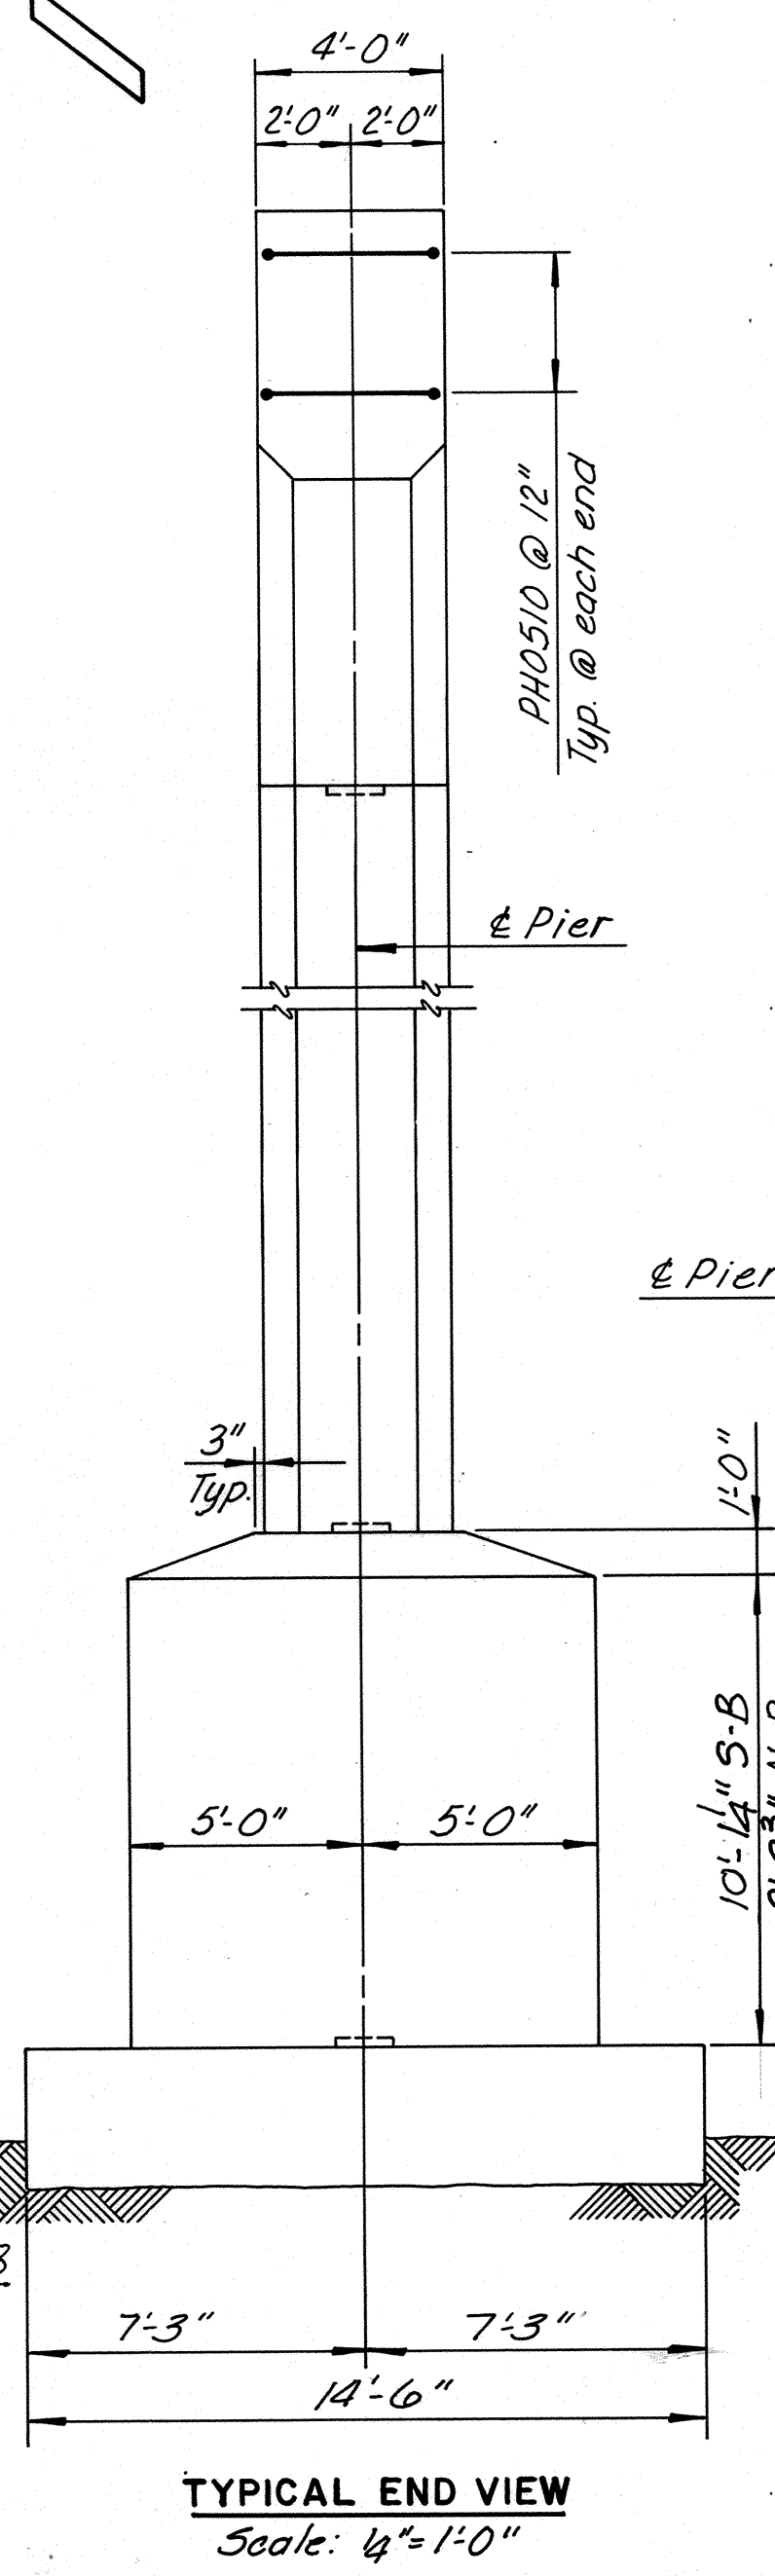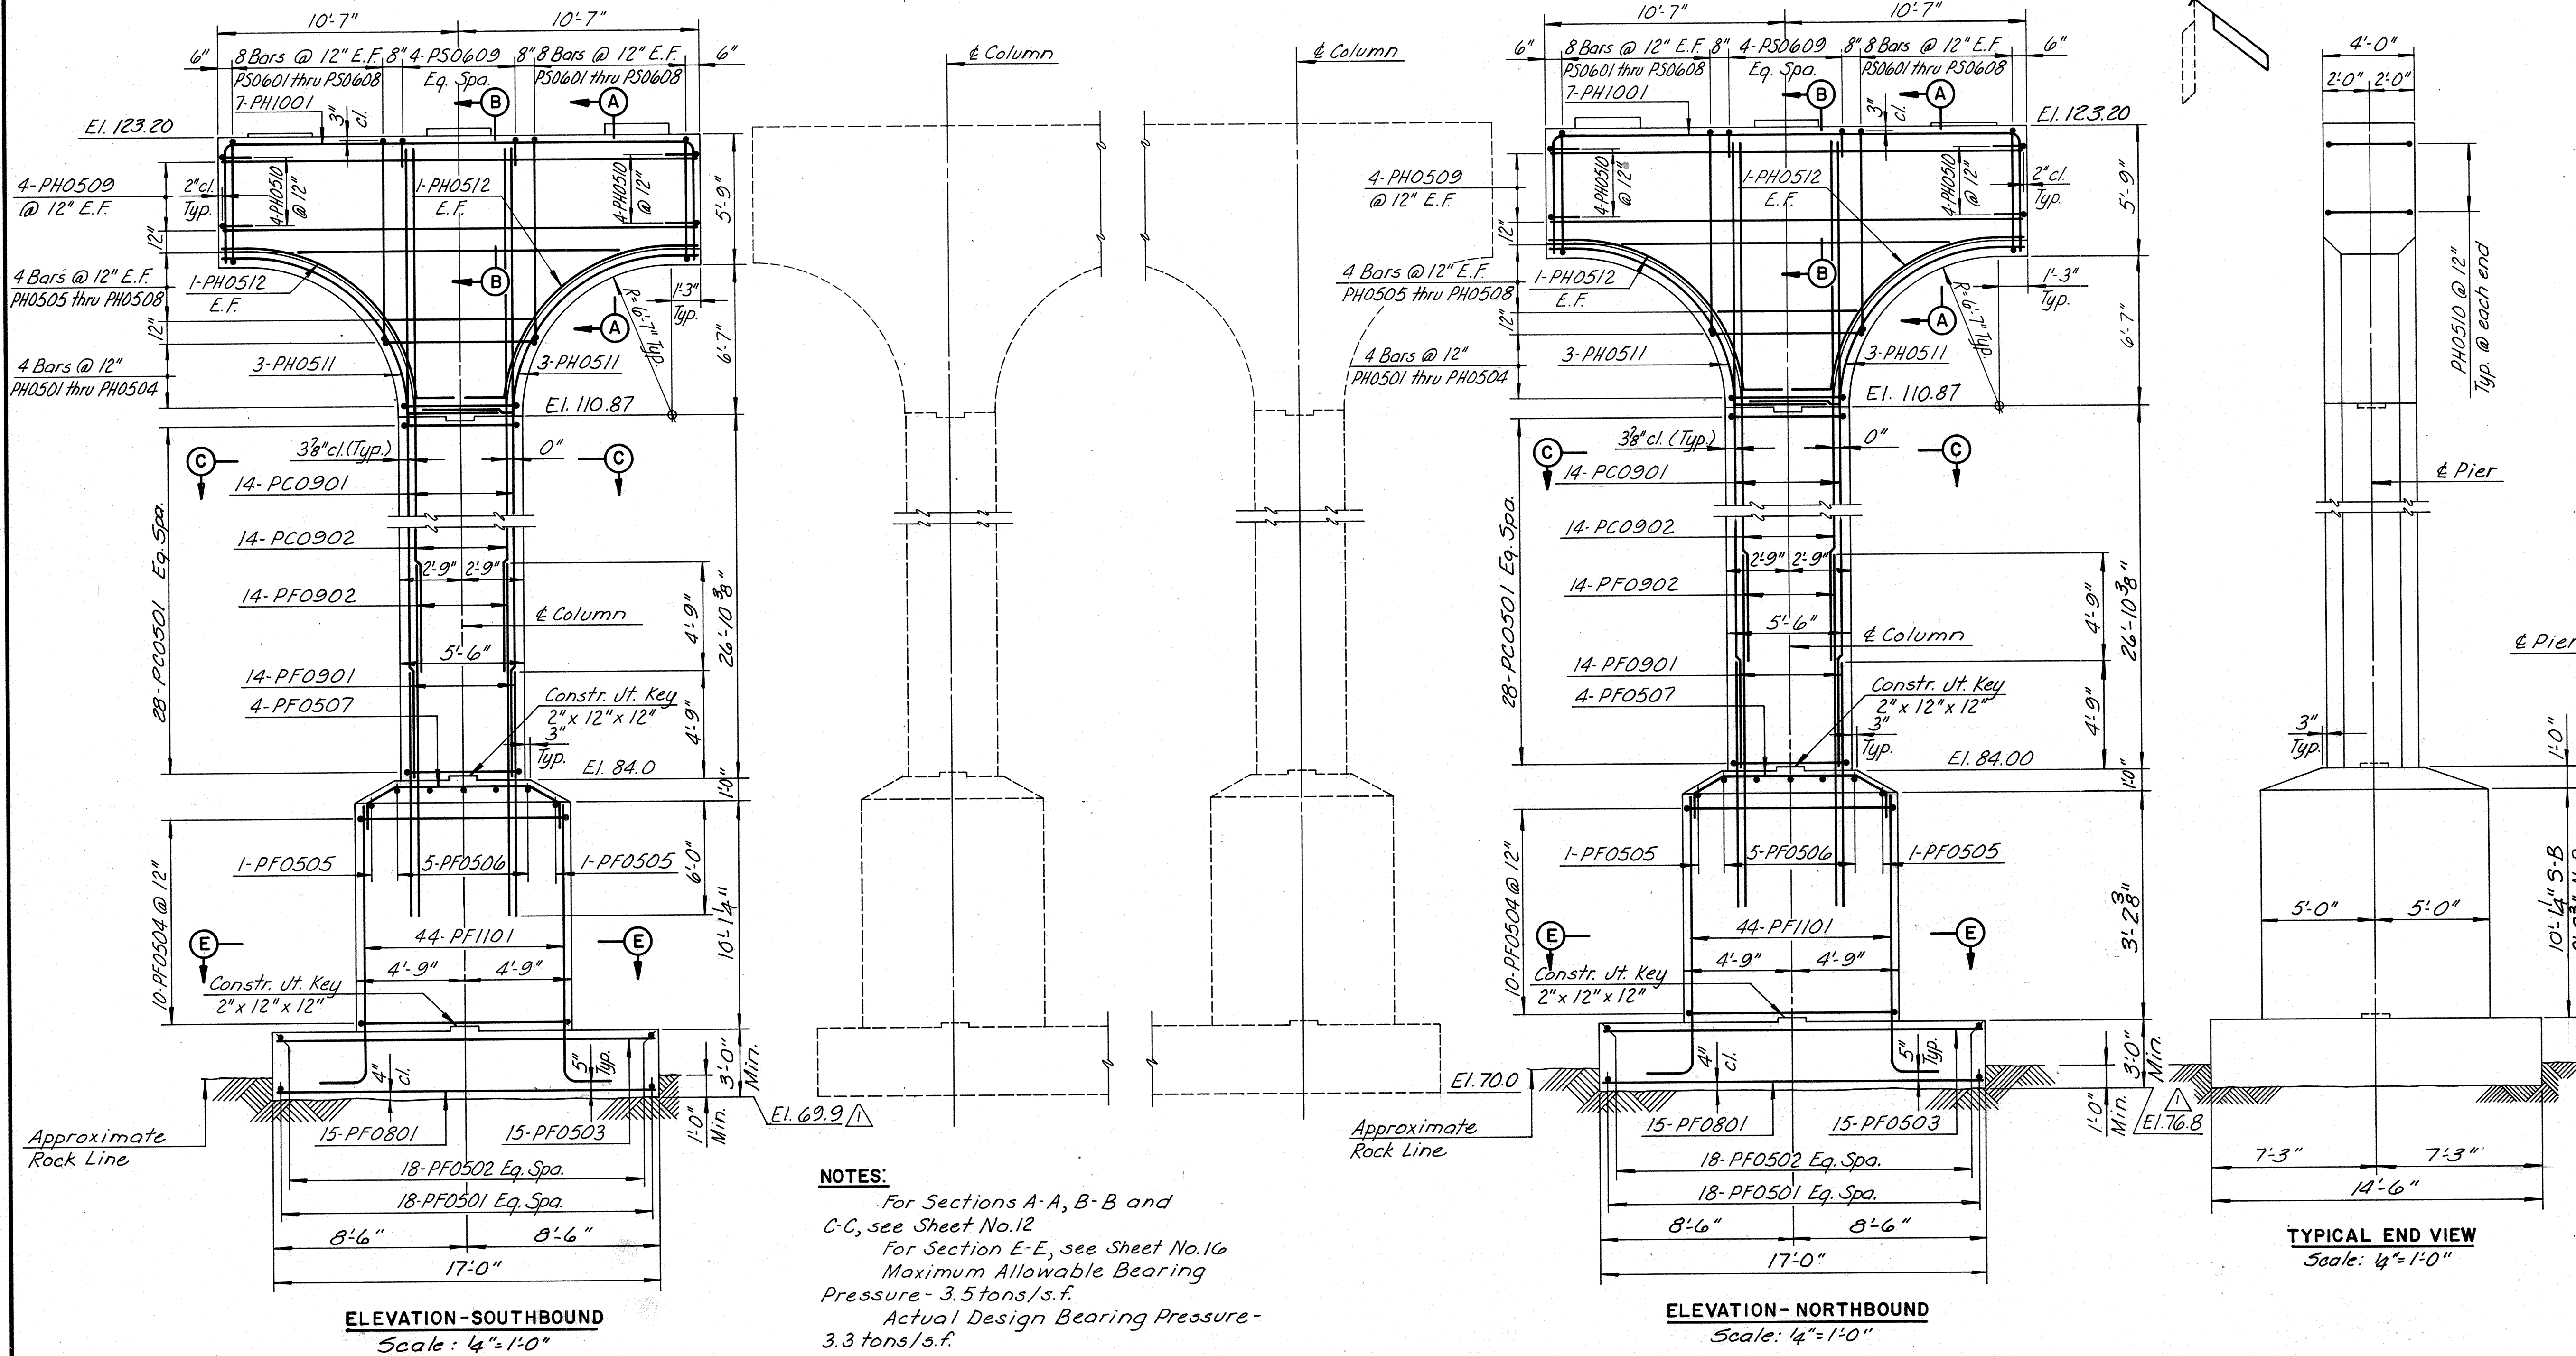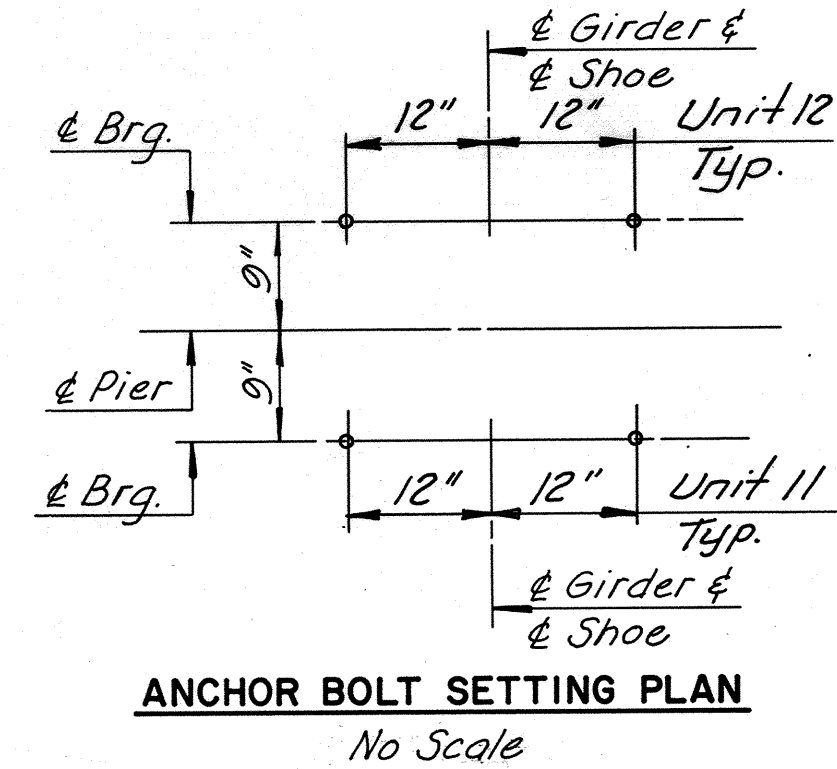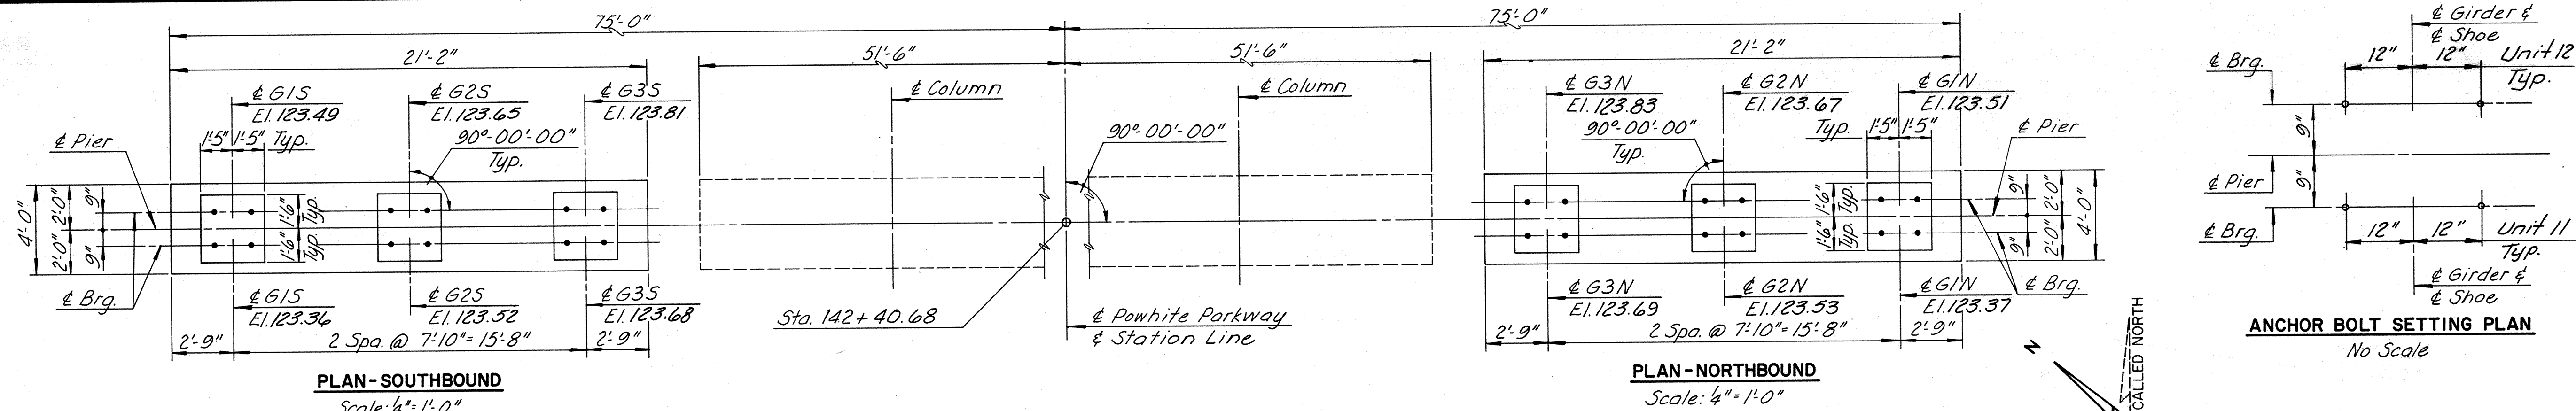

NOTES:
 For Sections A-A, B-B and C-C, see Sheet No.12
 For Section E-E, see Sheet No.16
 Maximum Allowable Bearing Pressure - 3.5 tons/s.f.
 Actual Design Bearing Pressure - 3.3 tons/s.f.

RICHMOND METROPOLITAN AUTHORITY
RICHMOND EXPRESSWAY SYSTEM






PIER II DETAILS

SCALE: AS SHOWN
 HOWARD, NEEDLES, TAMMEN & BERGENDOFF
 consulting engineers
 Alexandria, Virginia
 CONTRACT NO. C-13
 SHEET NO. 22 OF 106

BY	DATE	NO.	REVISION	BY	DATE
MADE	EJM 3-87				
CHECKED	T.F.P. 3-87	1	As Built	TEM	3-89
IN CHARGE	S.R.				

AS BUILT

RICHMOND EXPRESSWAY SYSTEM			
SECTION	PROJECT	SHEET NO.	TOTAL SHEETS
13	WIDENING JAMES RIVER BRIDGE	25	106

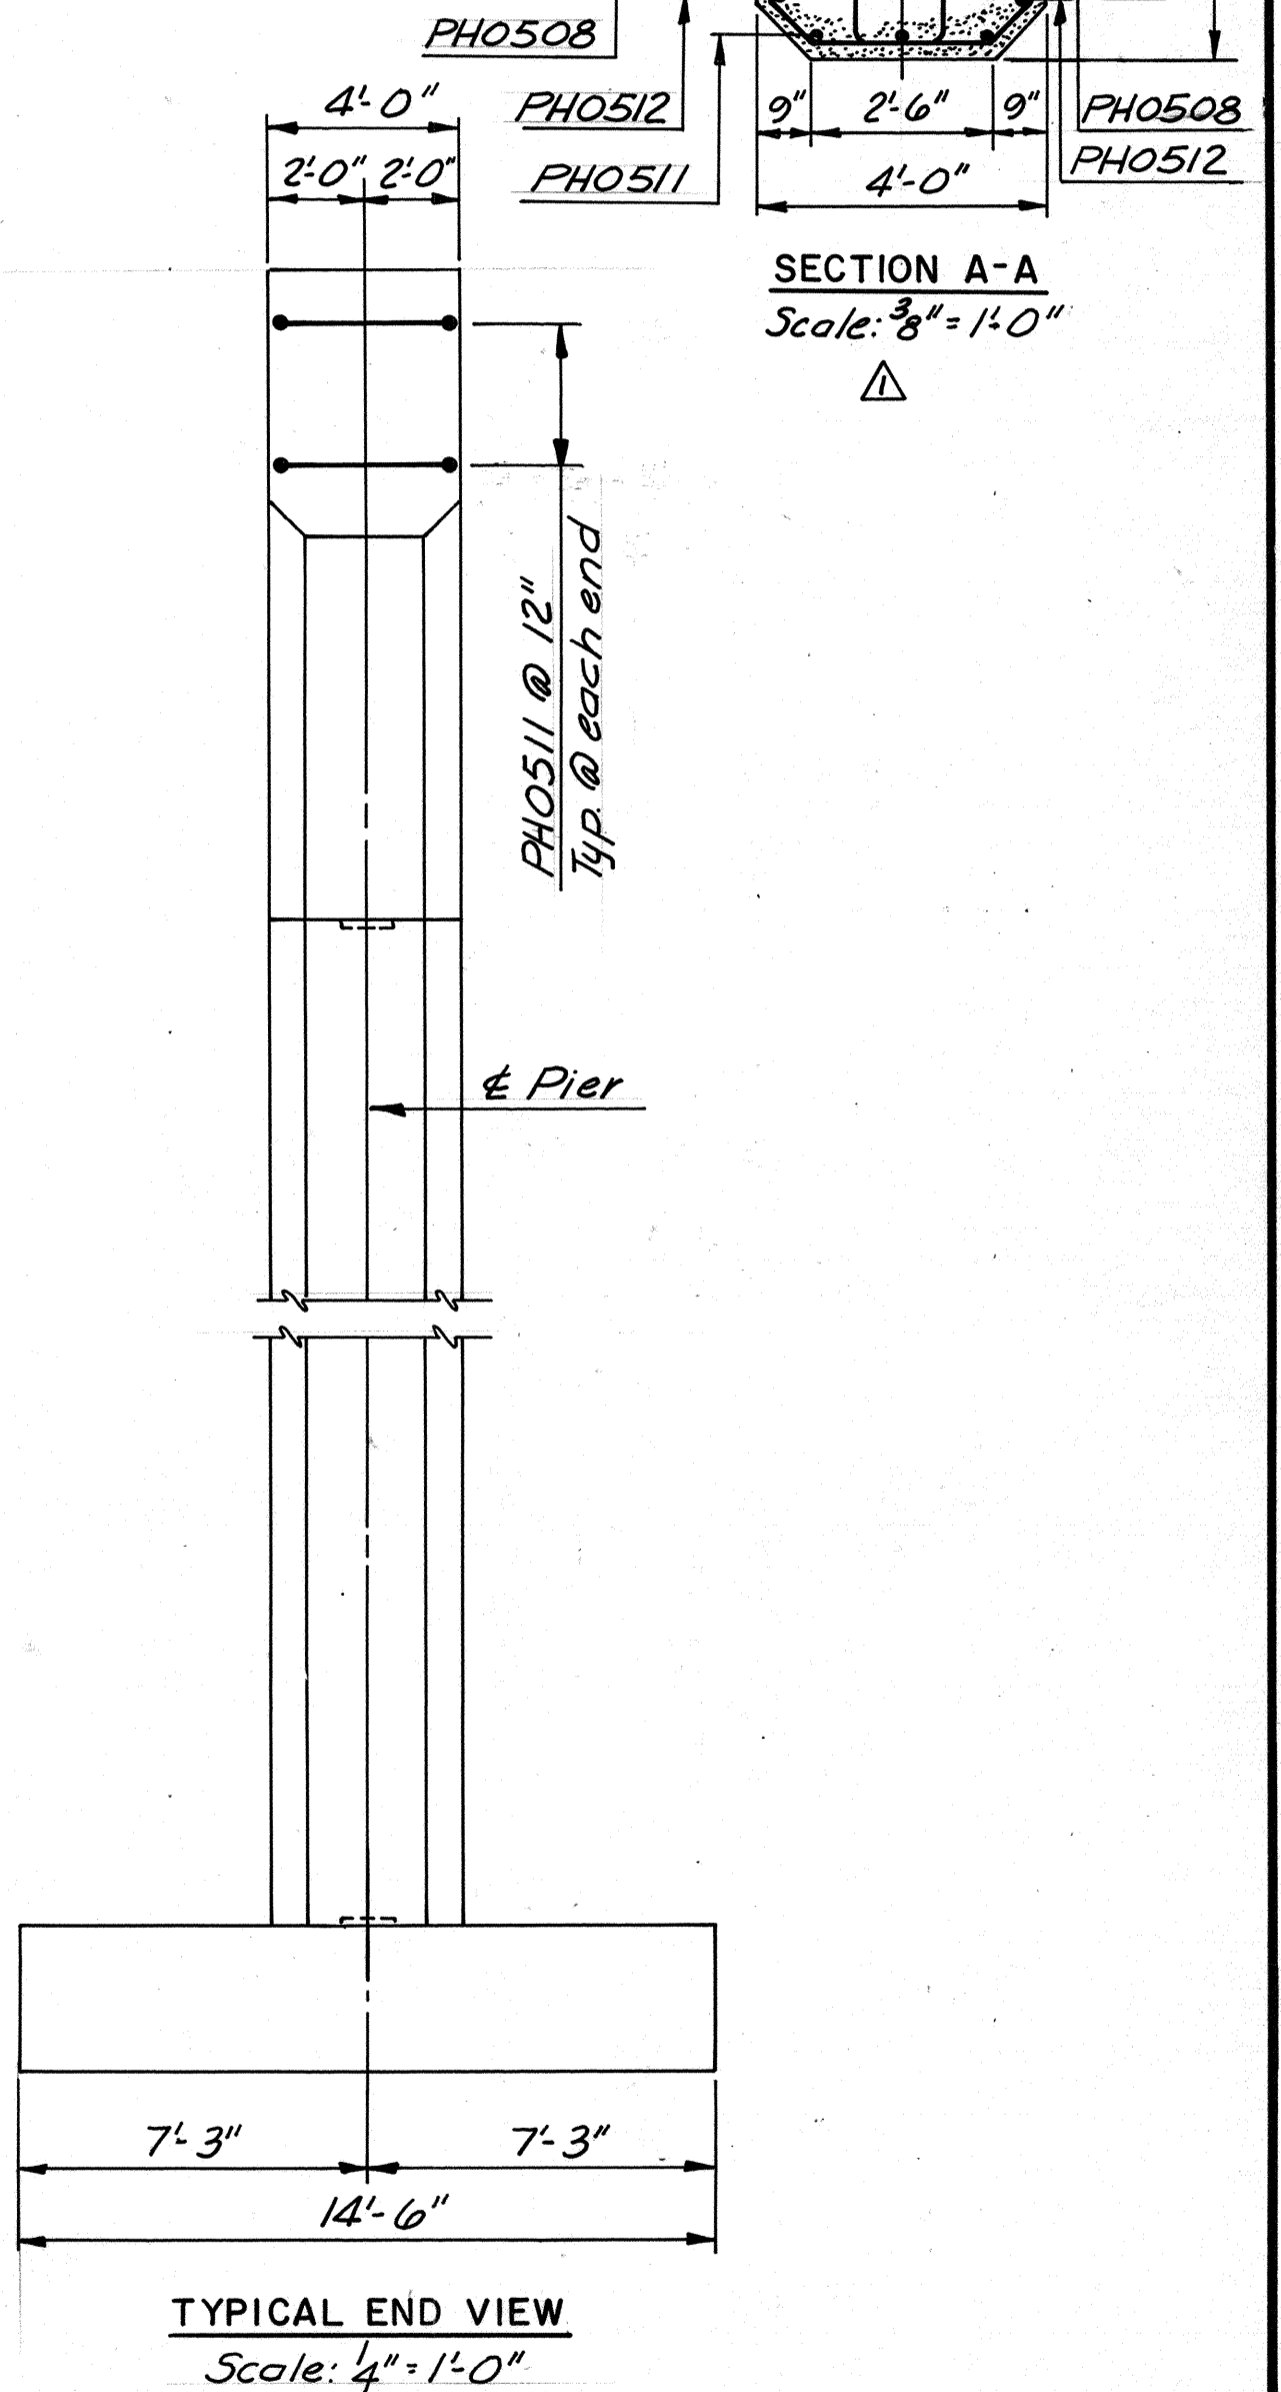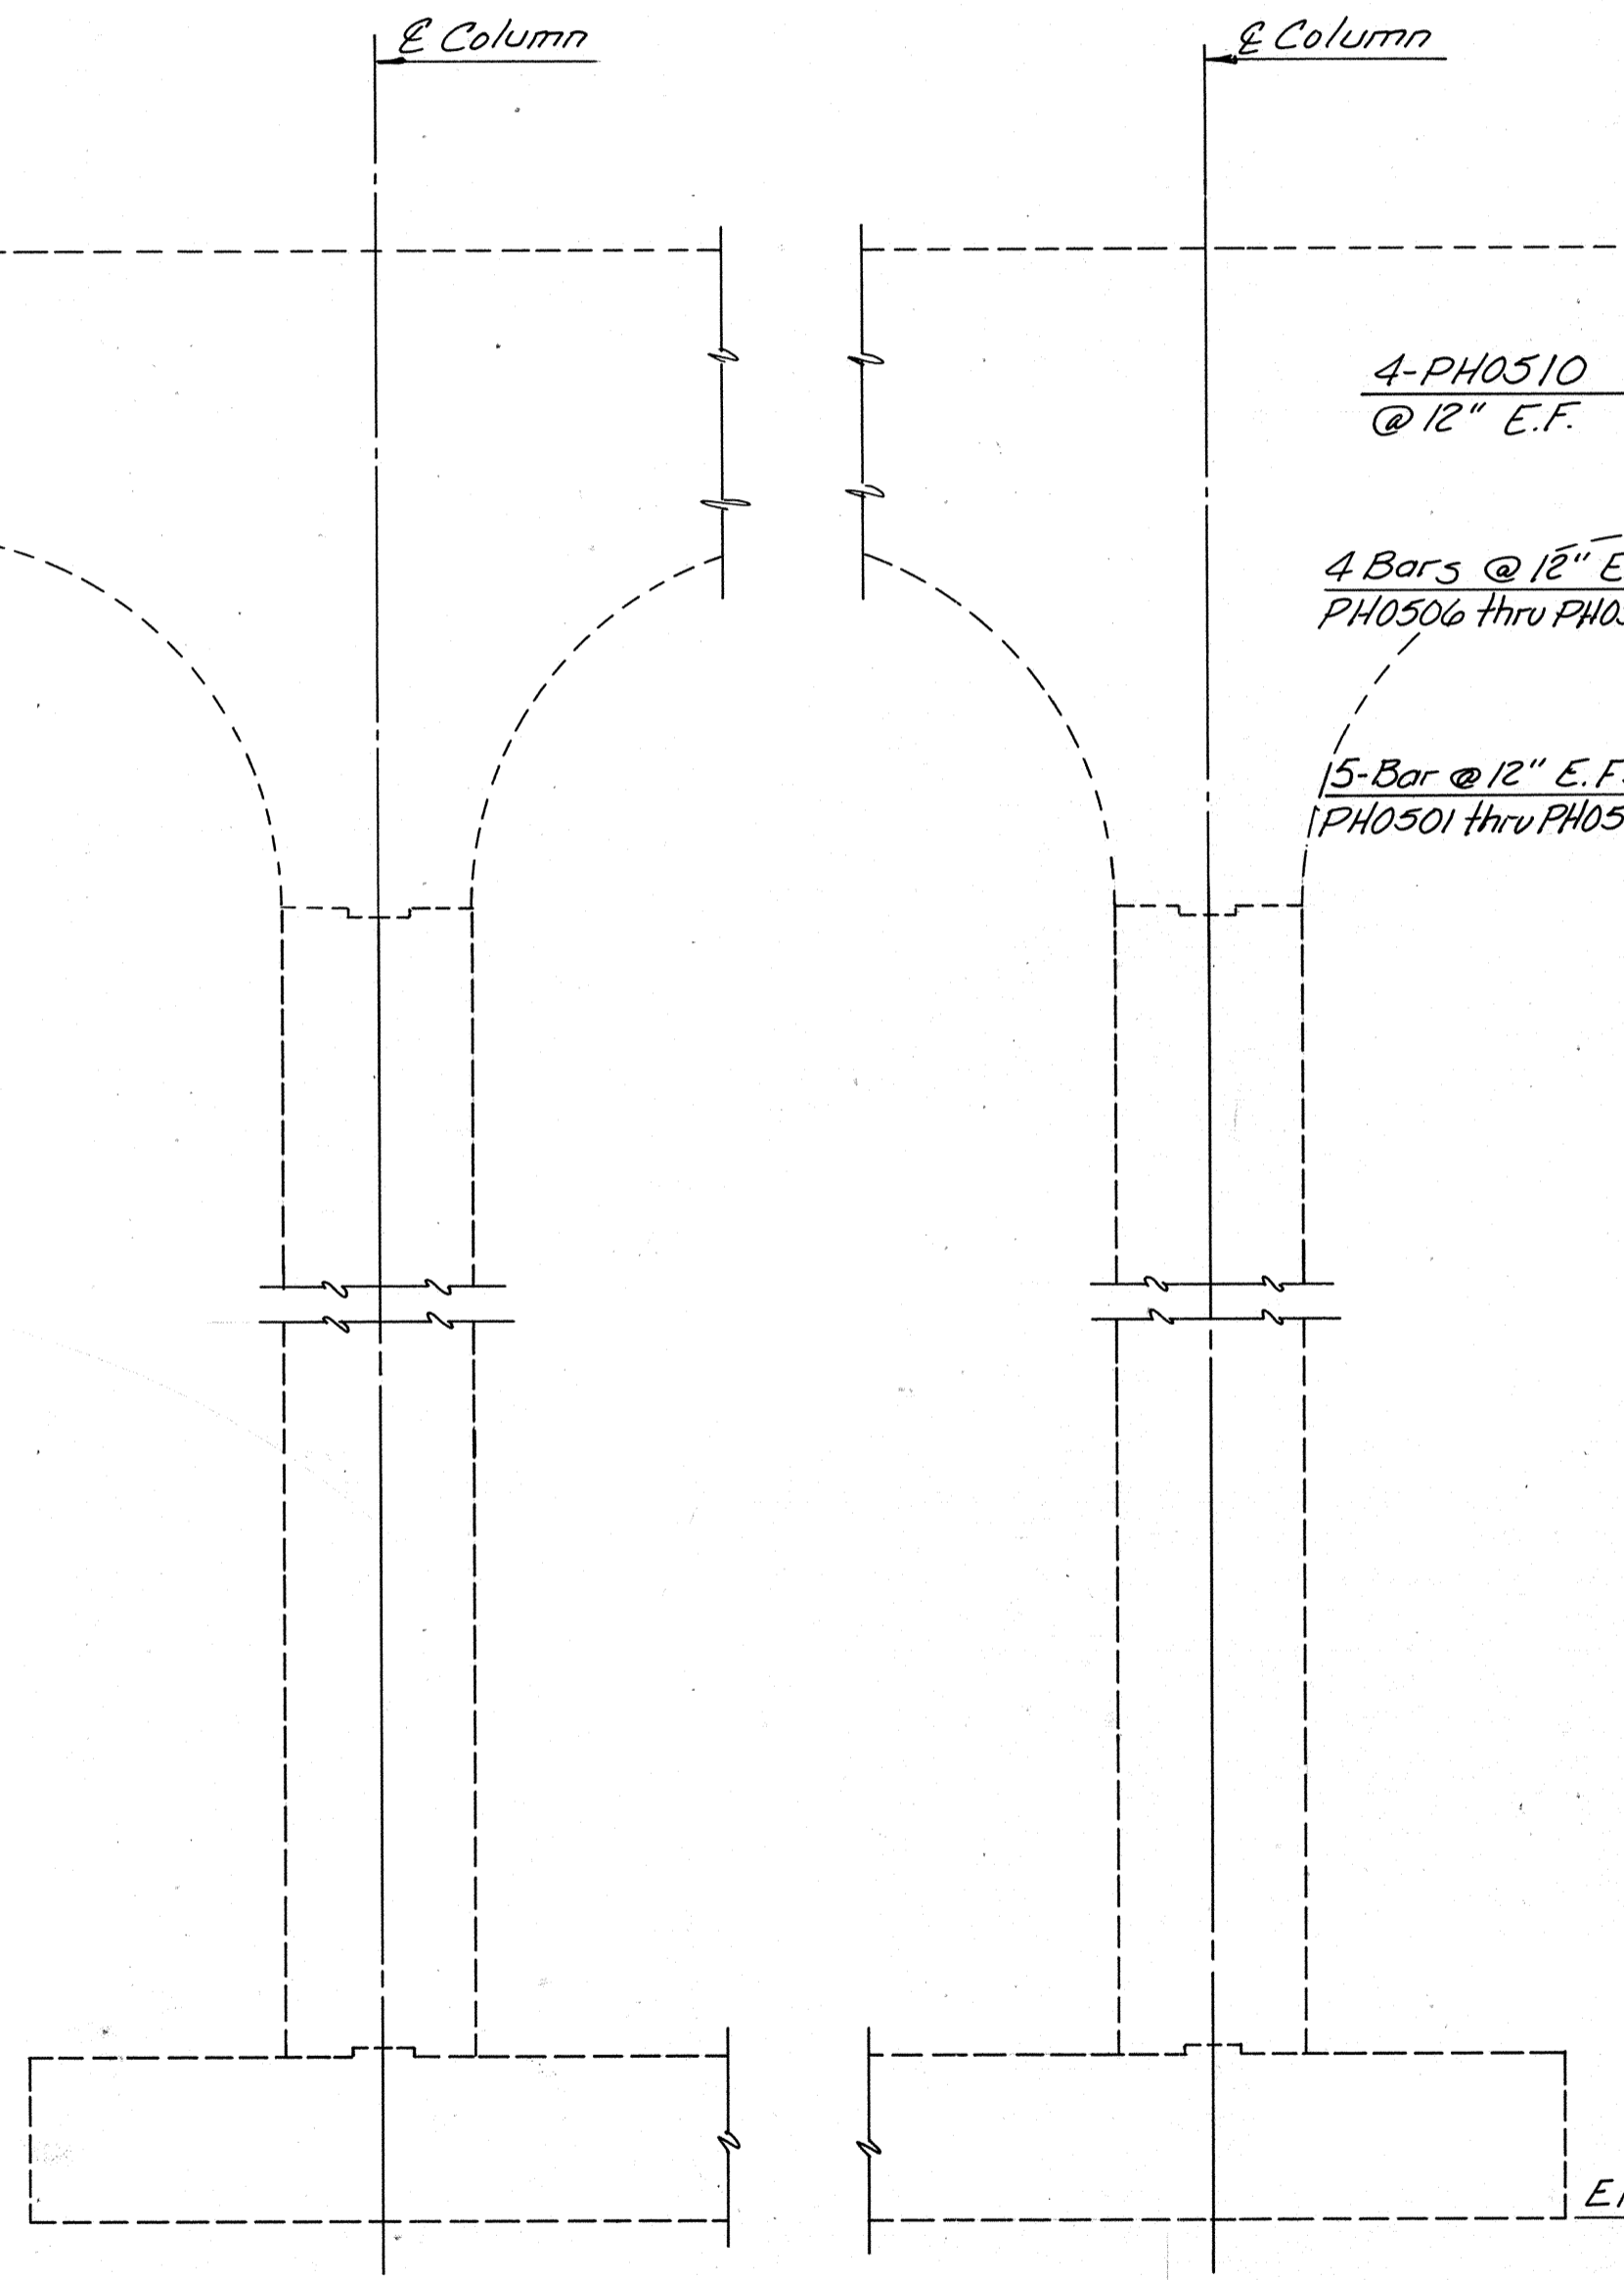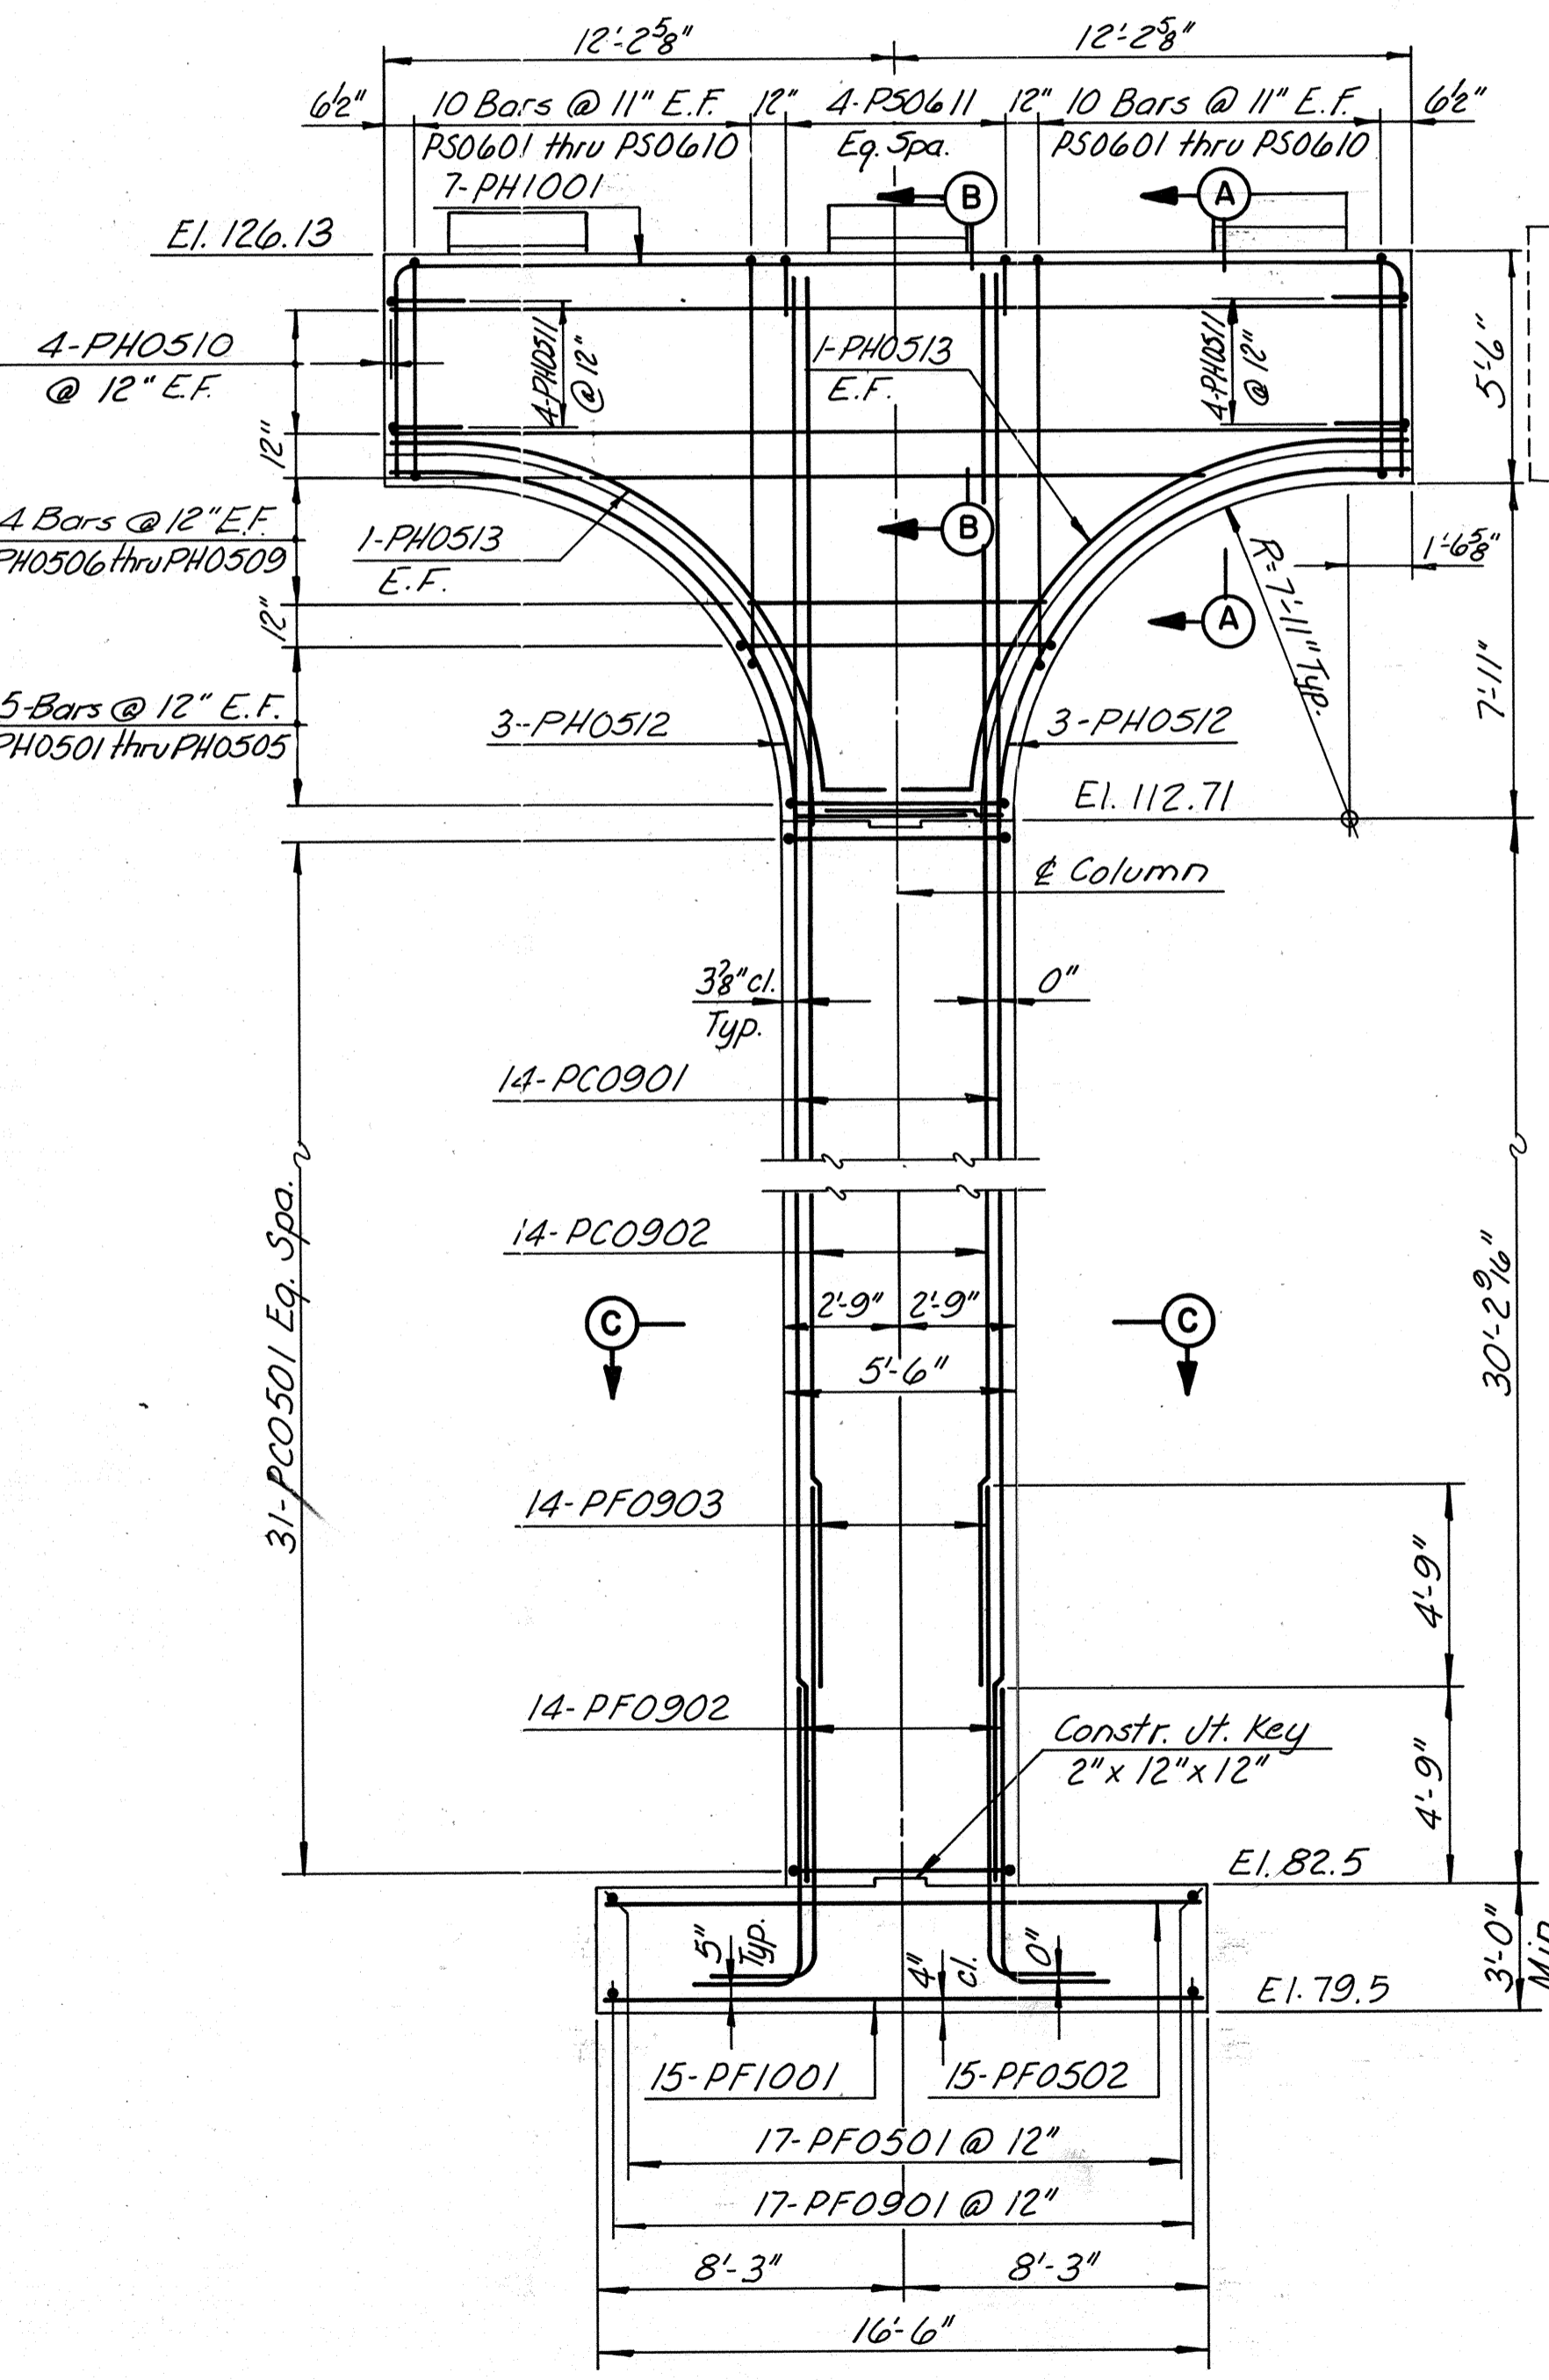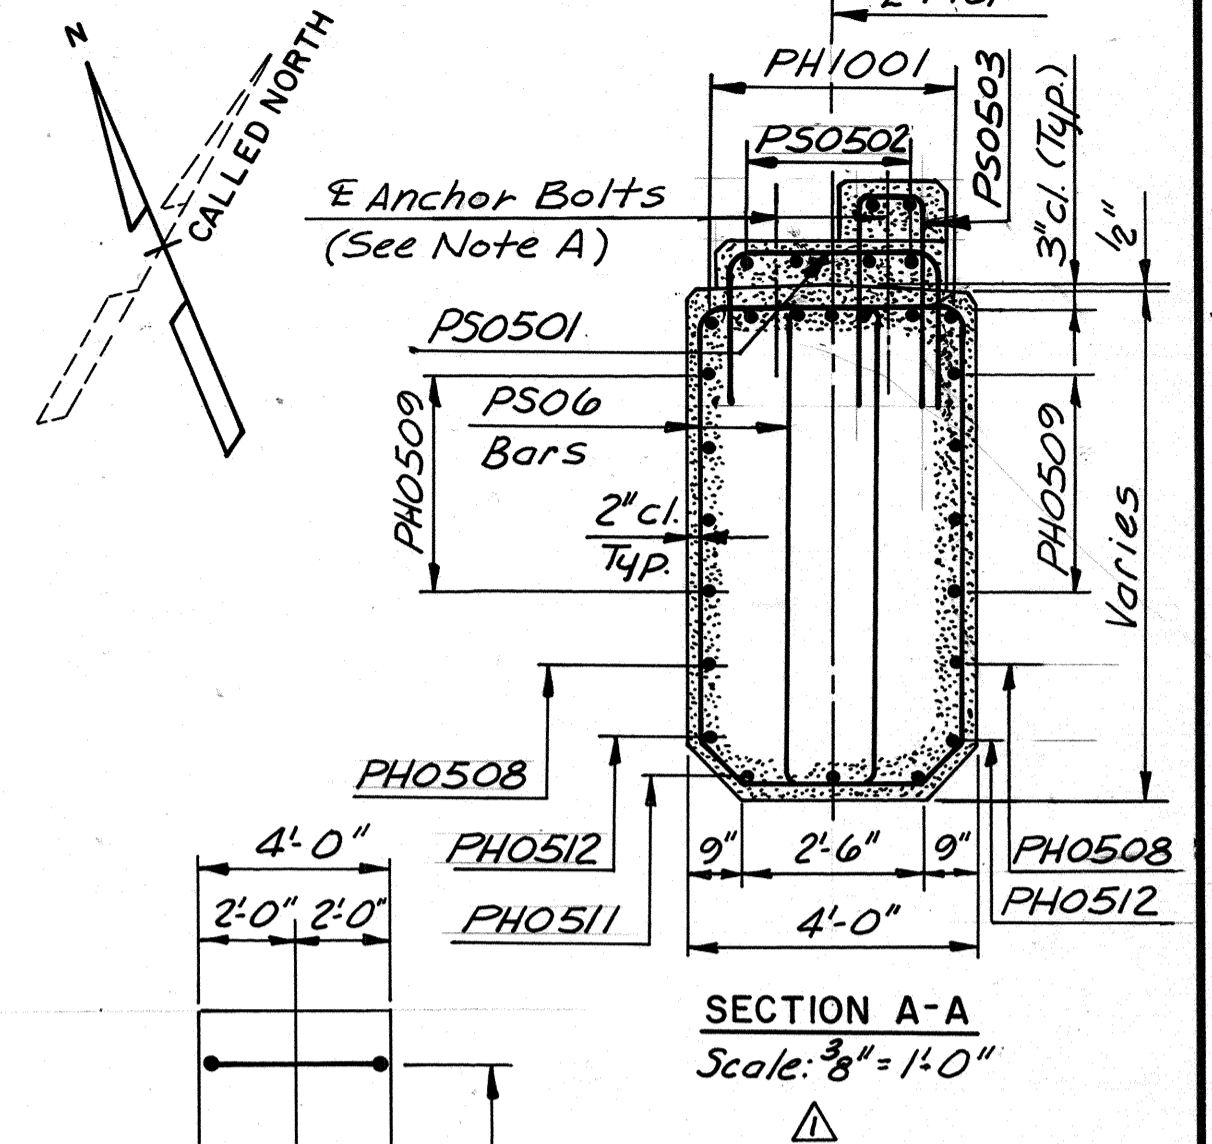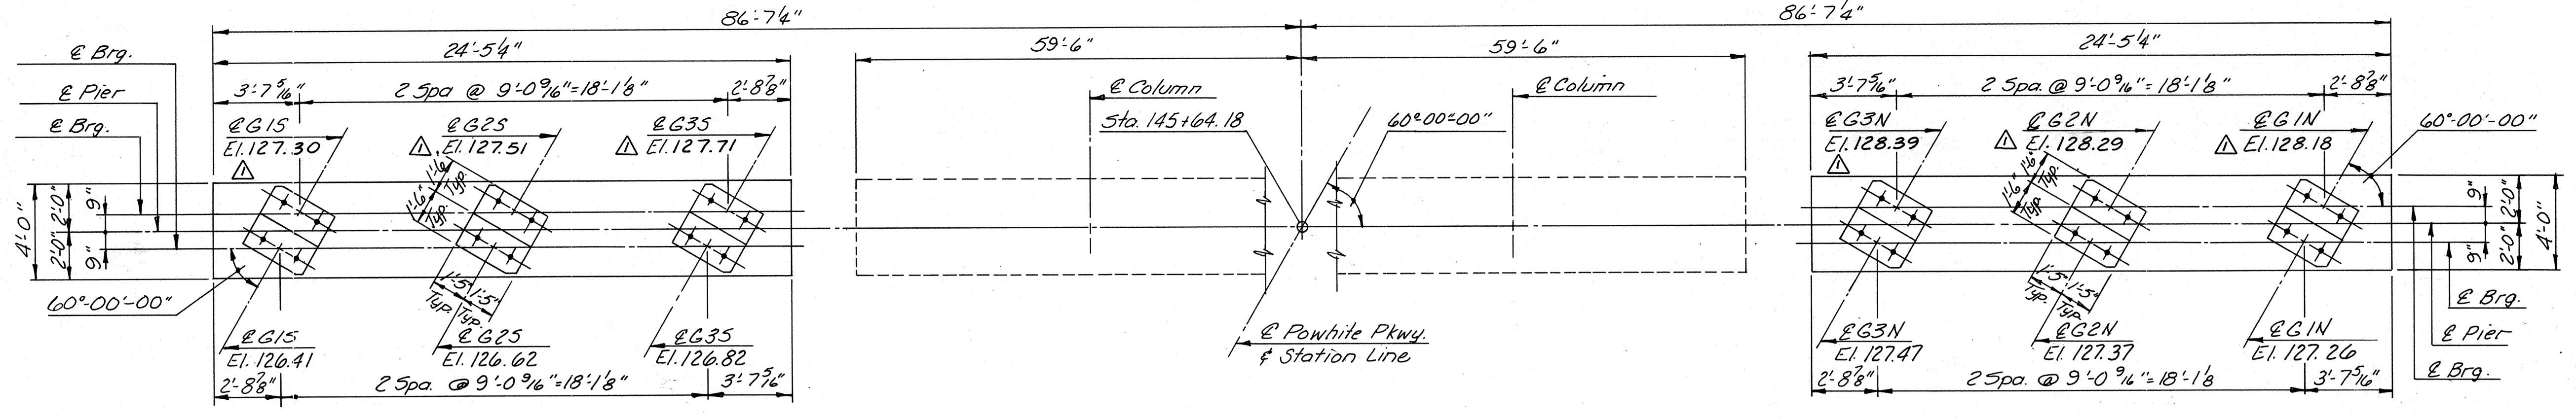

NOTES:

- ▲ For Sections B-B and C-C see Sheet No. 12
- For Anchor Bolt Setting Plan, see Sheet No. 29
- For Steel Sheet Piling requirements, see Sheet No. 29
- Maximum Allowable Bearing Pressure - 3.5 tons/s.f.
- Actual Design Bearing Pressure - Southbound - 3.3 tons/s.f.
- Northbound - 3.0 tons/s.f.

NOTE A:

▲ Pad reinforcing bars are to be spaced to clear Anchor Bolts.

BY	DATE	REVISION	BY	DATE
BY	DATE			
MADE	EJM 2-87	As Built	TEM	3-89
CHECKED	T.R.P. 3-87	EL. Plans Added Sect. A-A	ALC	5-87
IN CHARGE	S.R.			

AS BUILT



RICHMOND METROPOLITAN AUTHORITY
RICHMOND EXPRESSWAY SYSTEM

PIER 14 DETAILS



HOWARD, NEEDLES, TAMMEN & BERGENDOFF
consulting engineers
Alexandria, Virginia

SCALE: AS SHOWN
CONTRACT NO. C-13
SHEET NO. 25 OF 106

RICHMOND EXPRESSWAY SYSTEM			
SECTION	PROJECT	SHEET NO.	TOTAL SHEETS
13	WIDENING JAMES RIVER BRIDGING	27	106

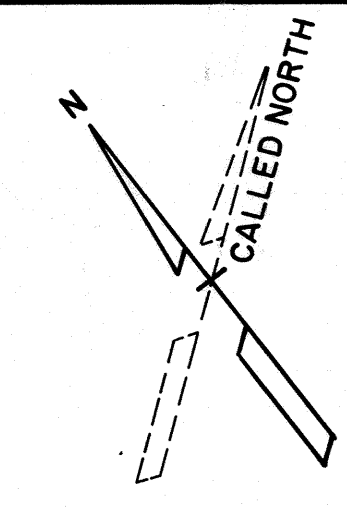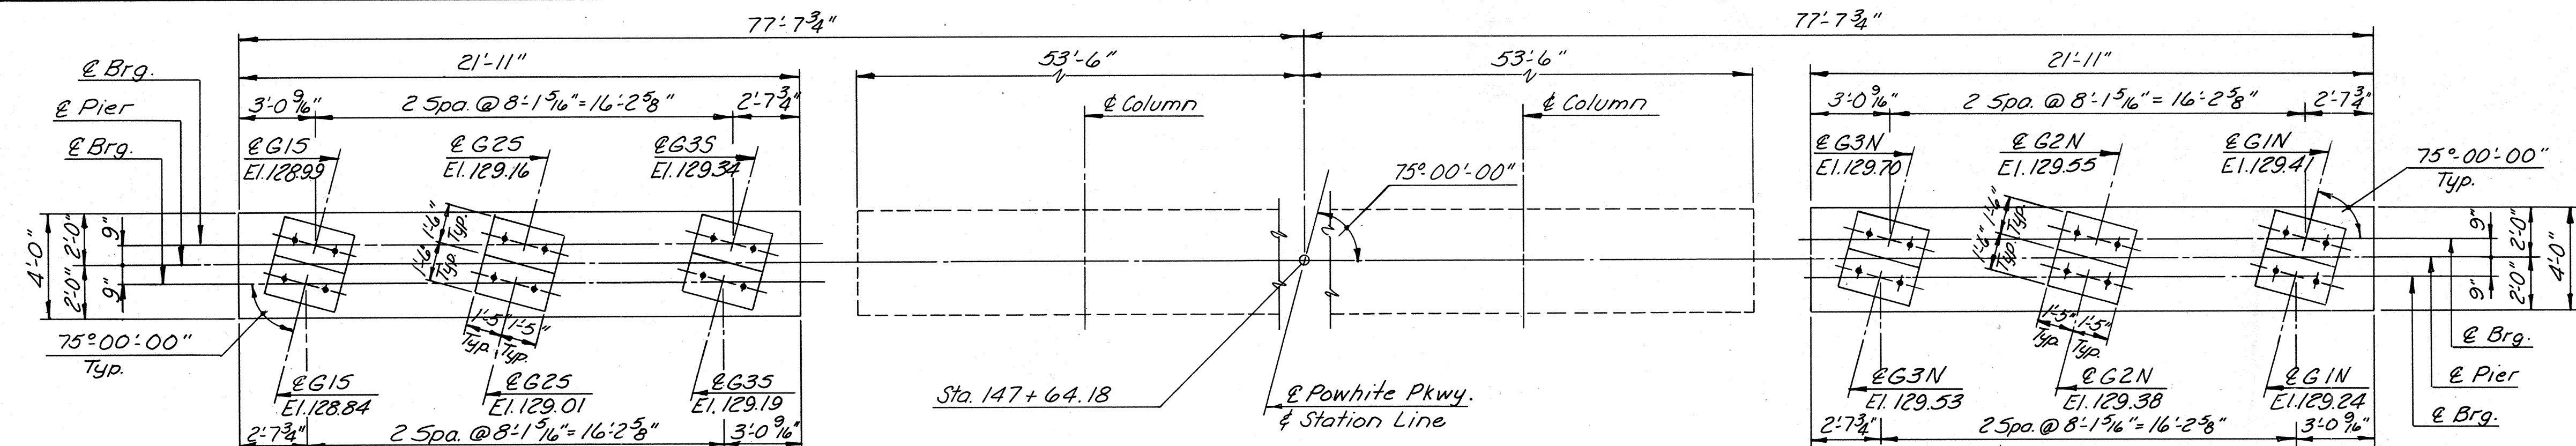


NOTE:
For Sections A-A, B-B and C-C, see Sheet No. 12.
For Anchor Bolt Setting Plan, see Sheet No. 29.

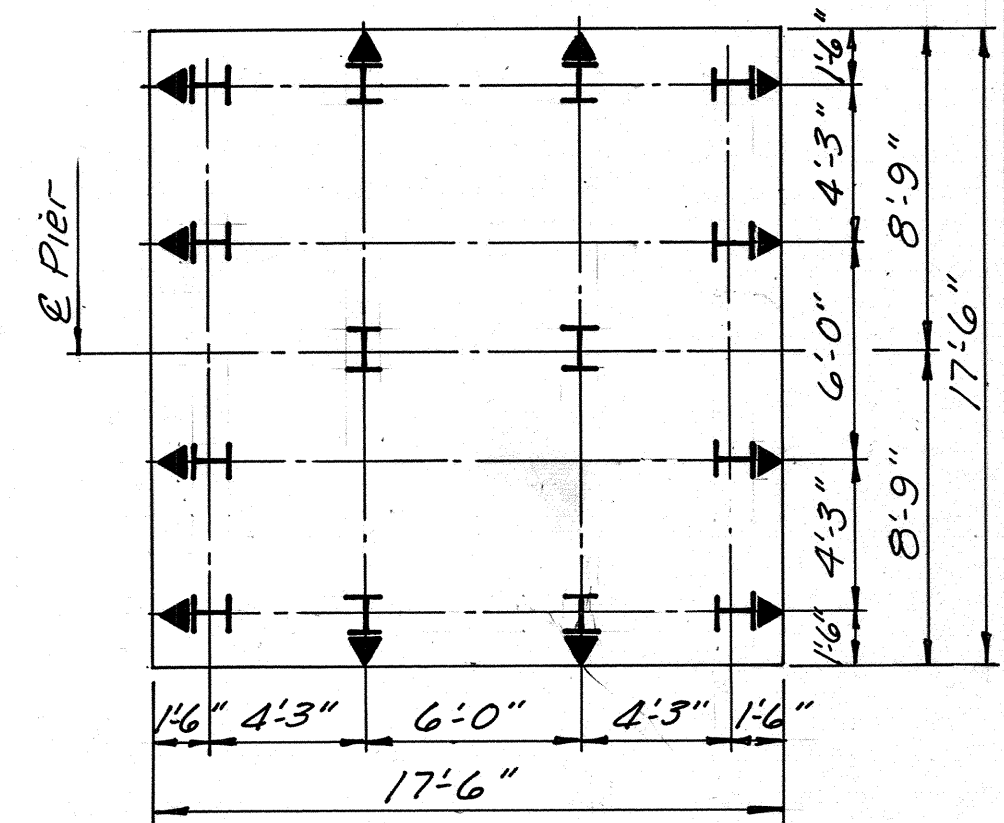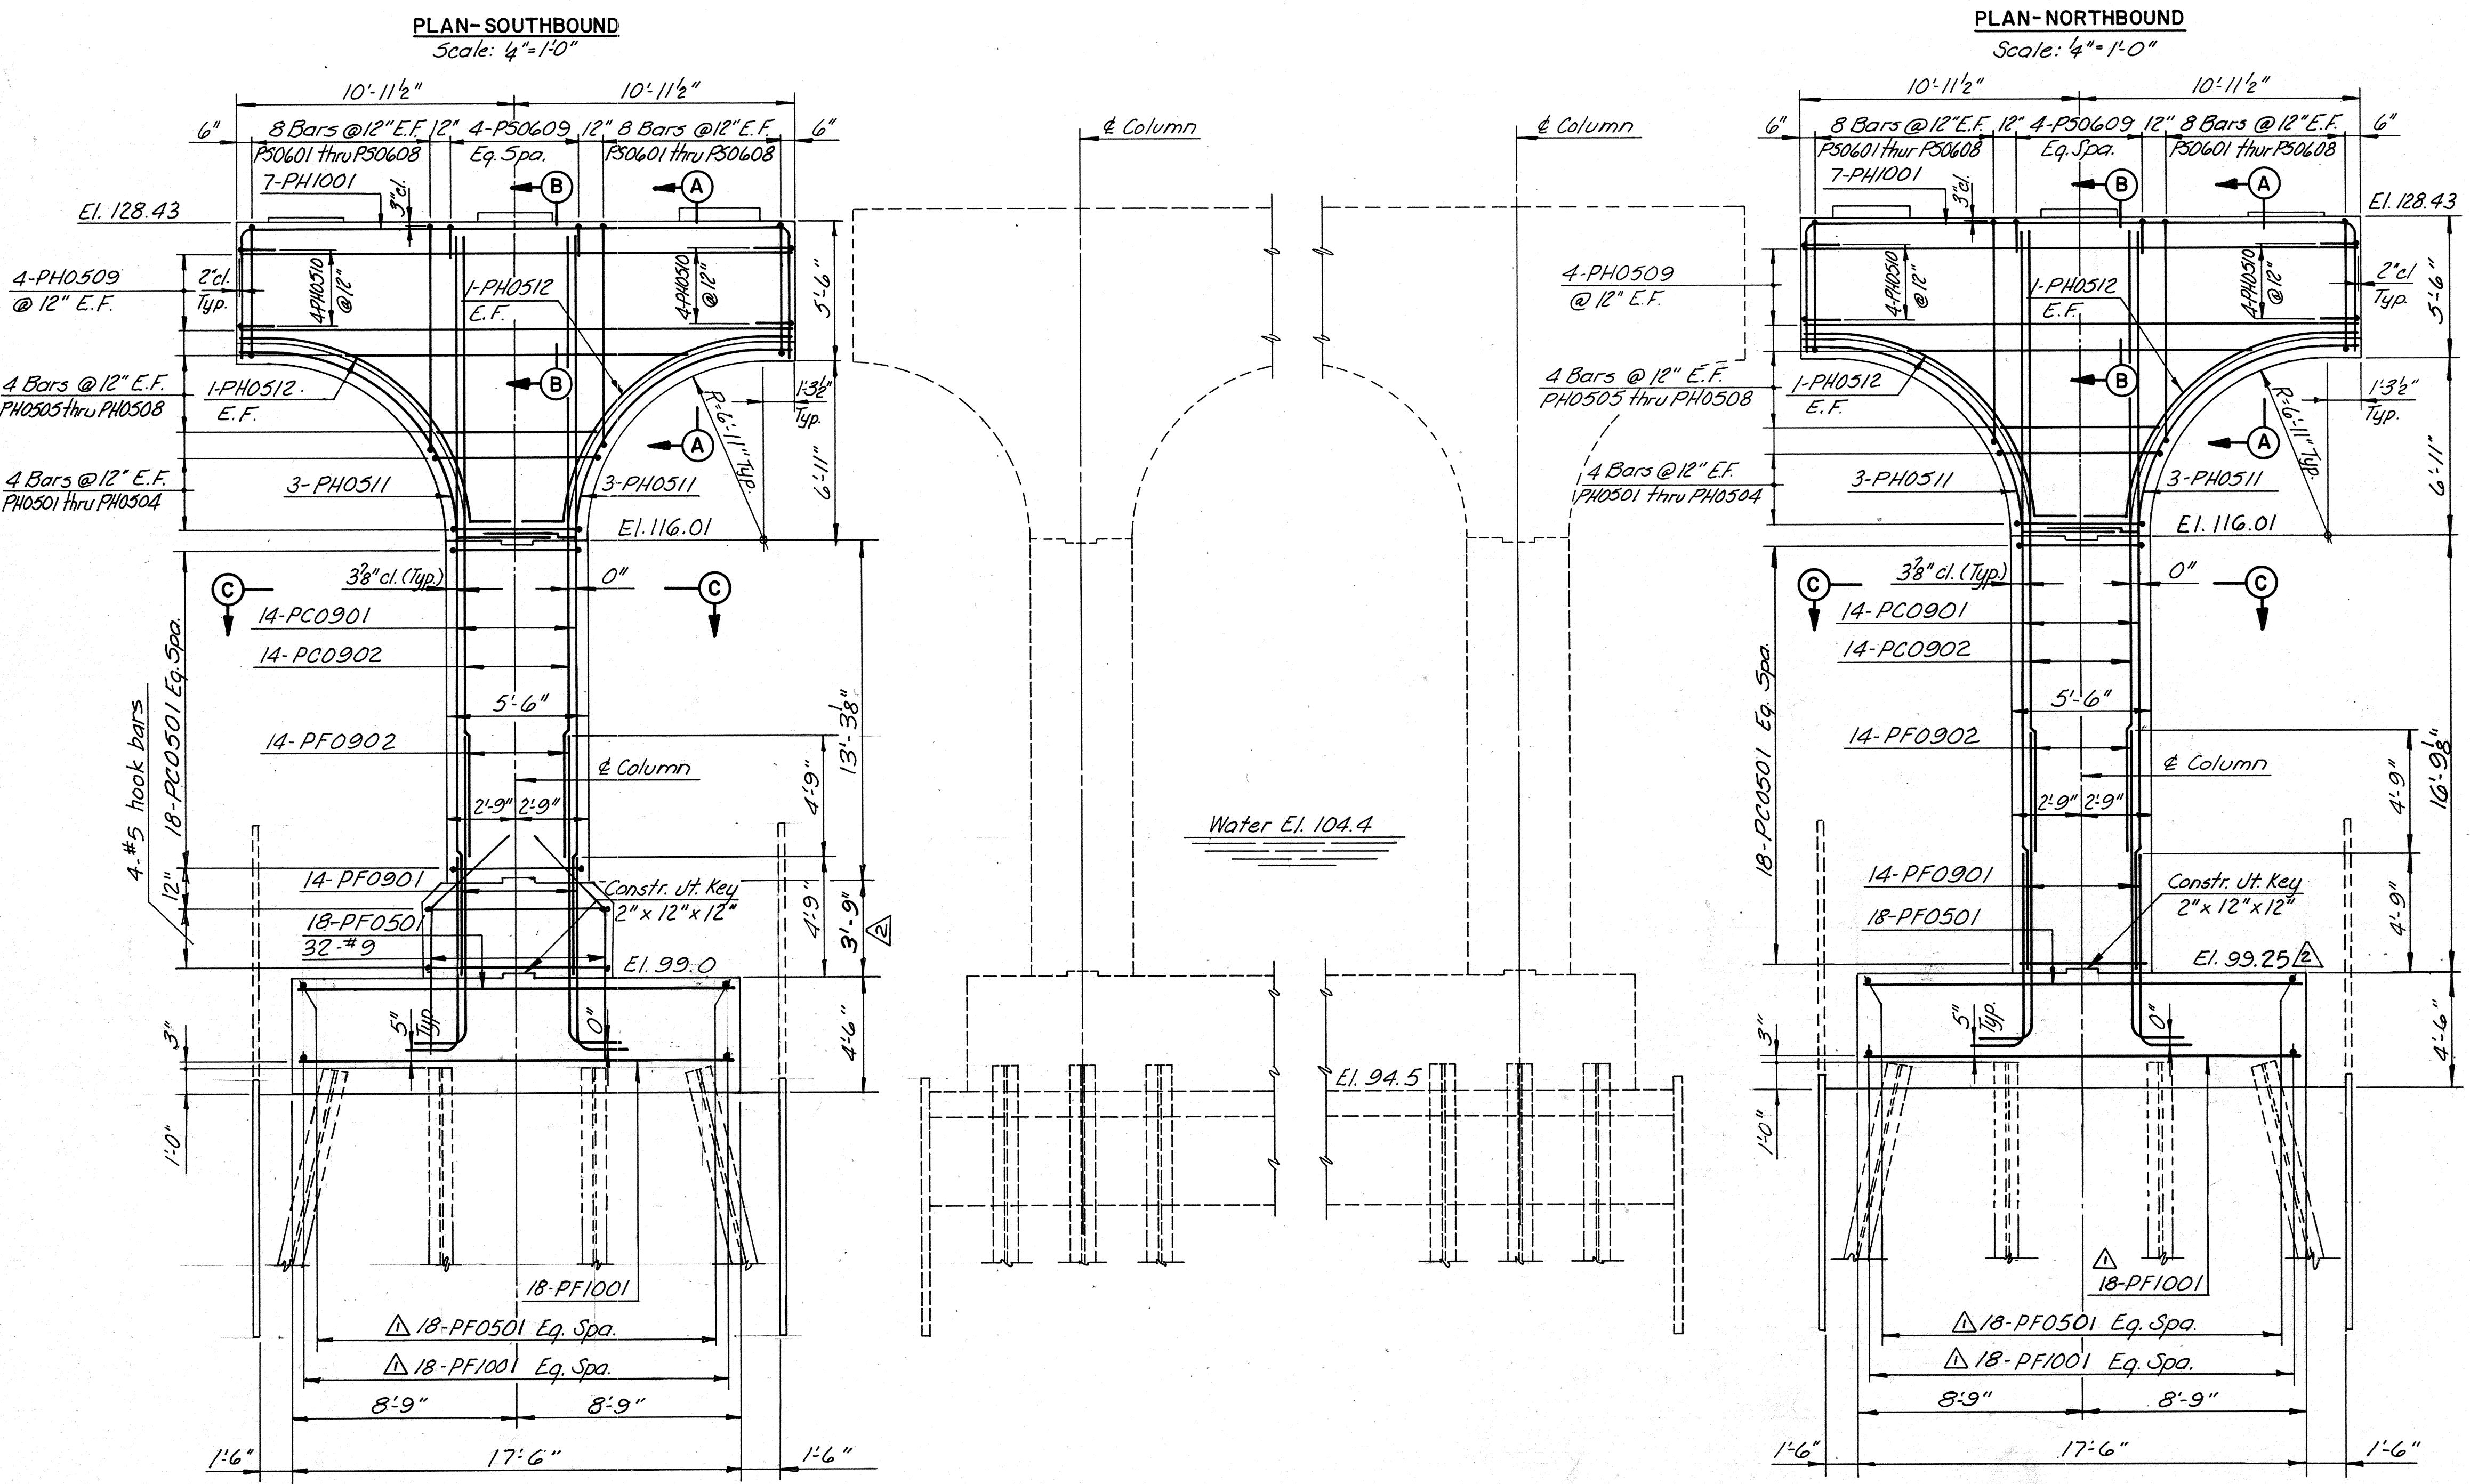

PILE NOTES:

- ▭ Indicates vertical piles.
- ▶ Indicates pile battered 2:12 in direction of arrow.

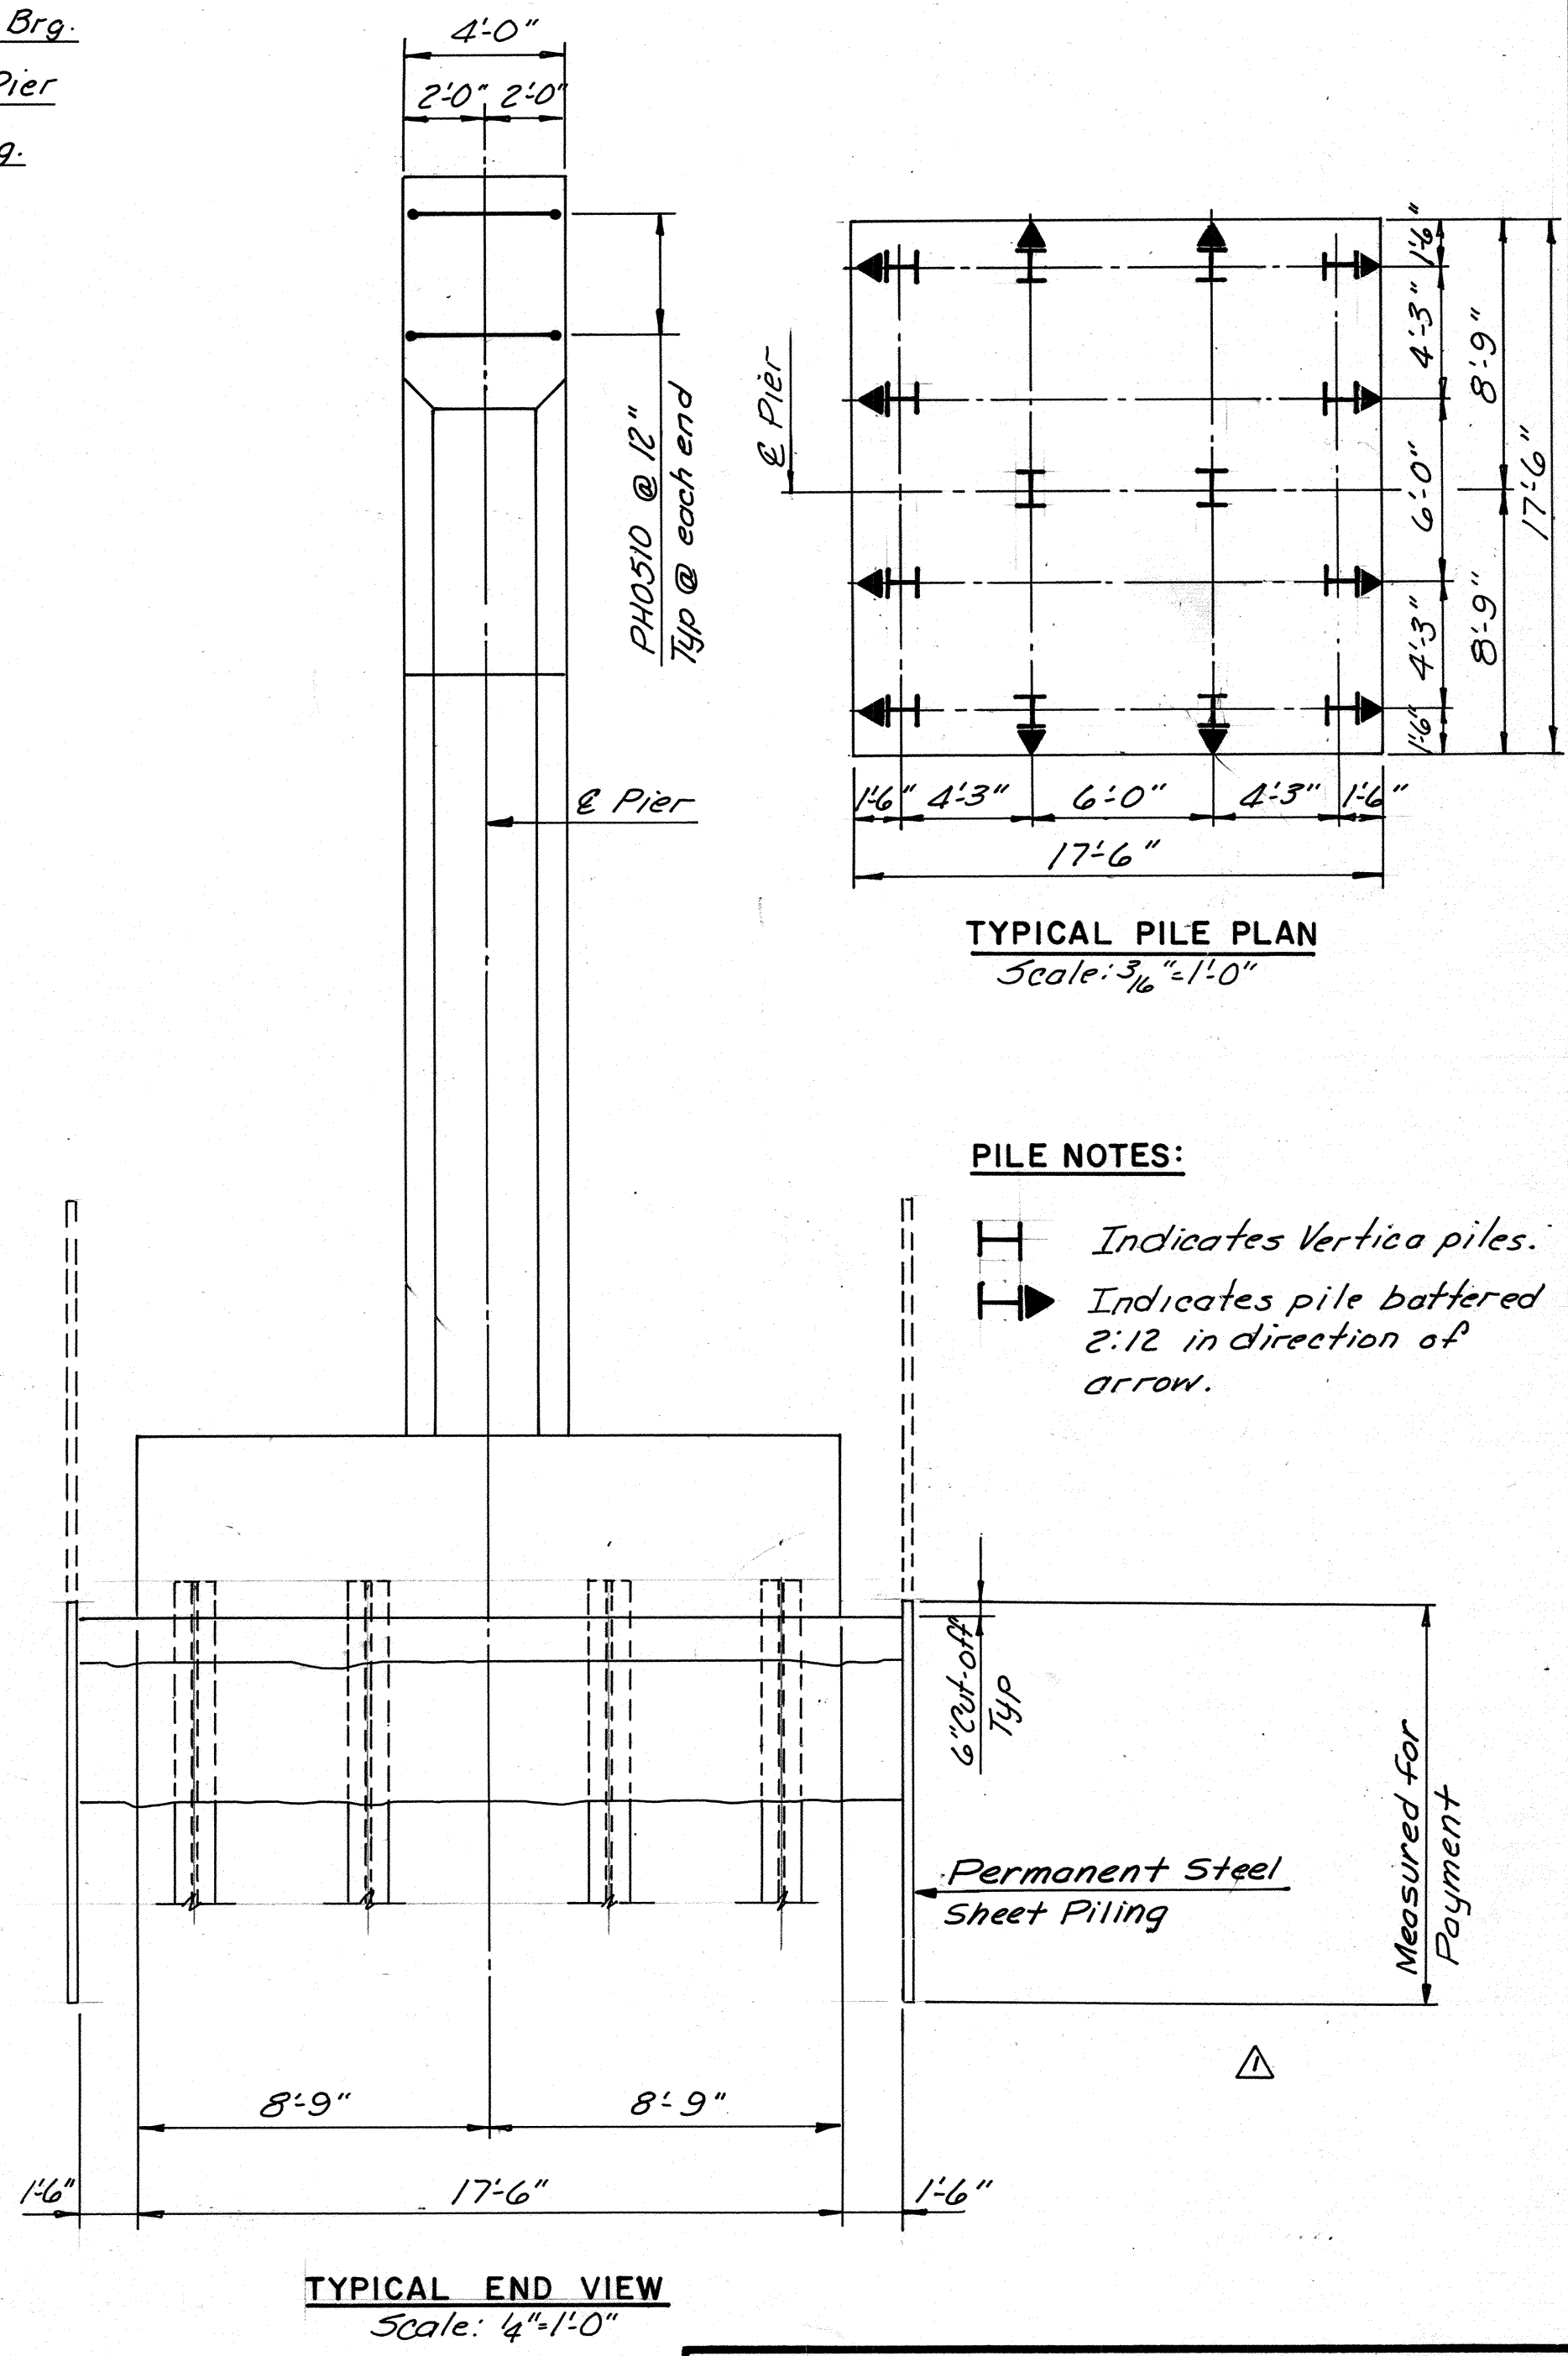

RICHMOND METROPOLITAN AUTHORITY
RICHMOND EXPRESSWAY SYSTEM

PIER 16 DETAILS





HOWARD, NEEDLES, TAMMEN & BERGENOFF
consulting engineers
Alexandria, Virginia

SCALE: AS SHOWN
CONTRACT NO.: C-13
SHEET NO. 27 OF 106

BY	DATE	REVISION	BY	DATE
MADE	EJM 3-87	As Built	TEM	3-89
CHECKED	T.F.P. 3-87	Both Elevation & End View	ALC	4-87
IN CHARGE	S.R.			


AS BUILT

RICHMOND EXPRESSWAY SYSTEM			
SECTION	PROJECT	SHEET NO.	TOTAL SHEETS
13	WIDENING JAMES RIVER BRIDGING	28	106

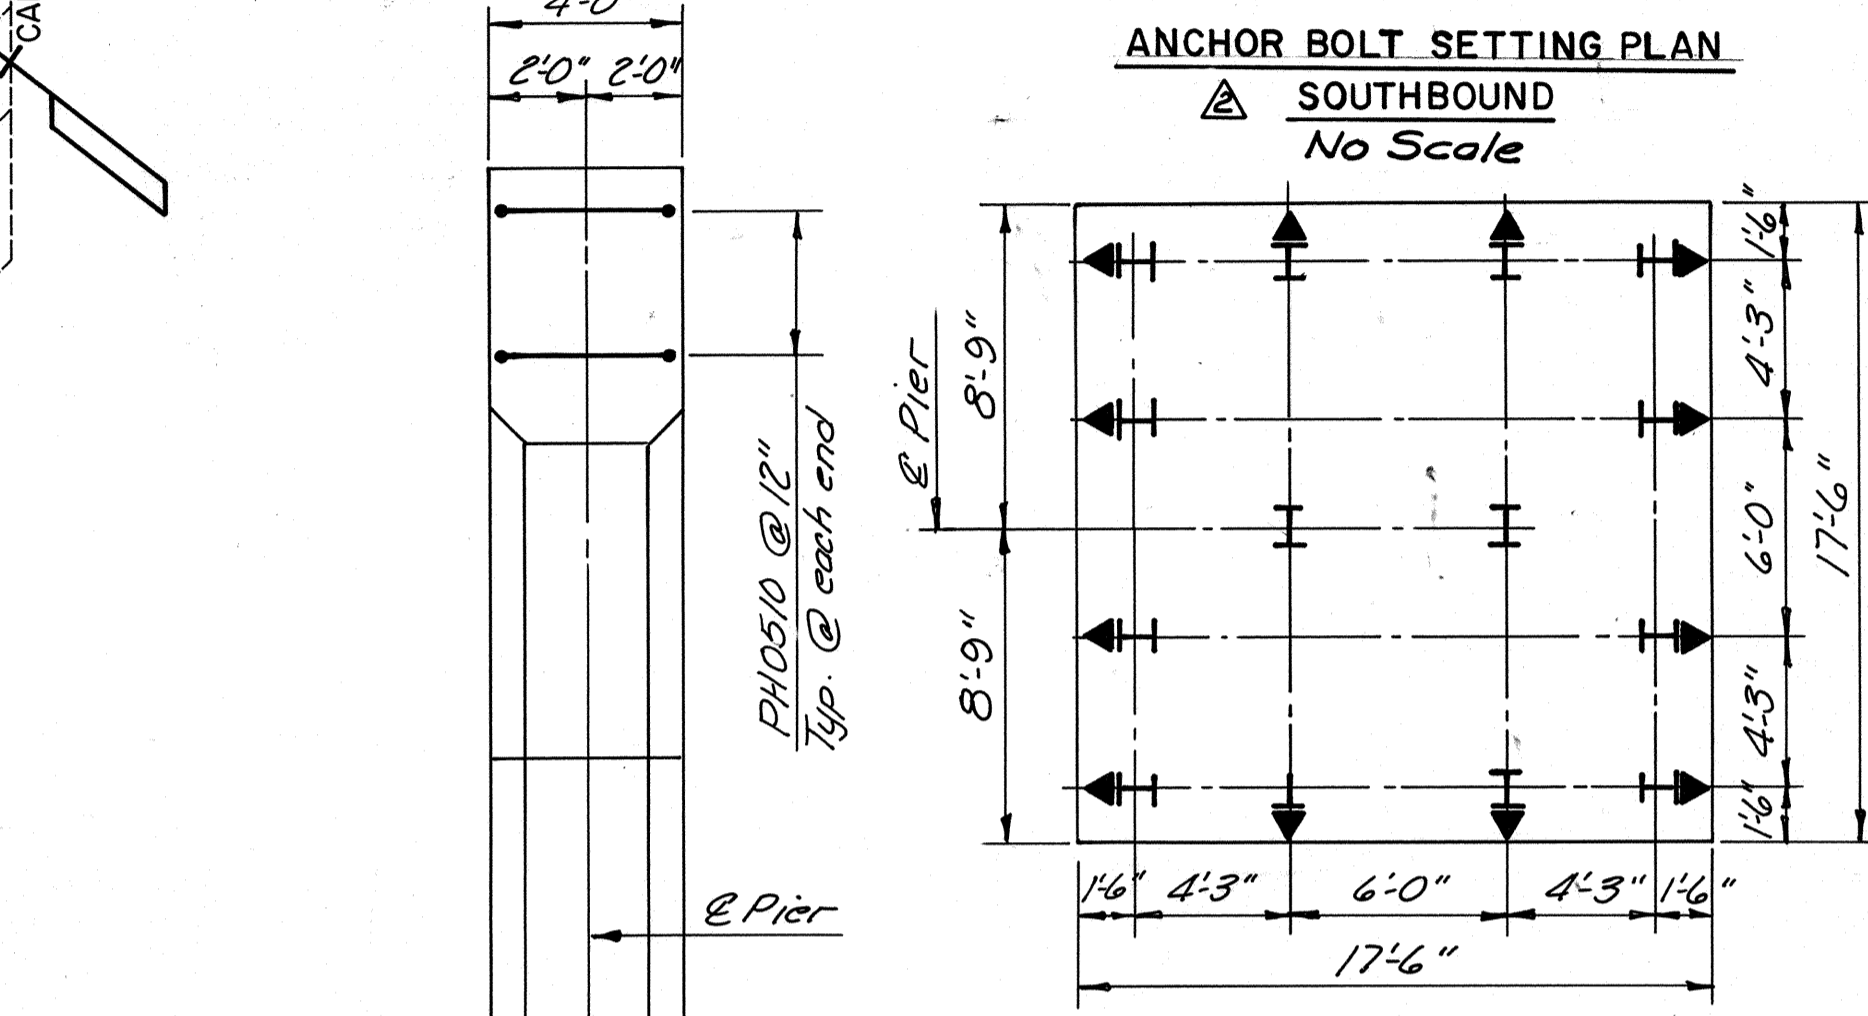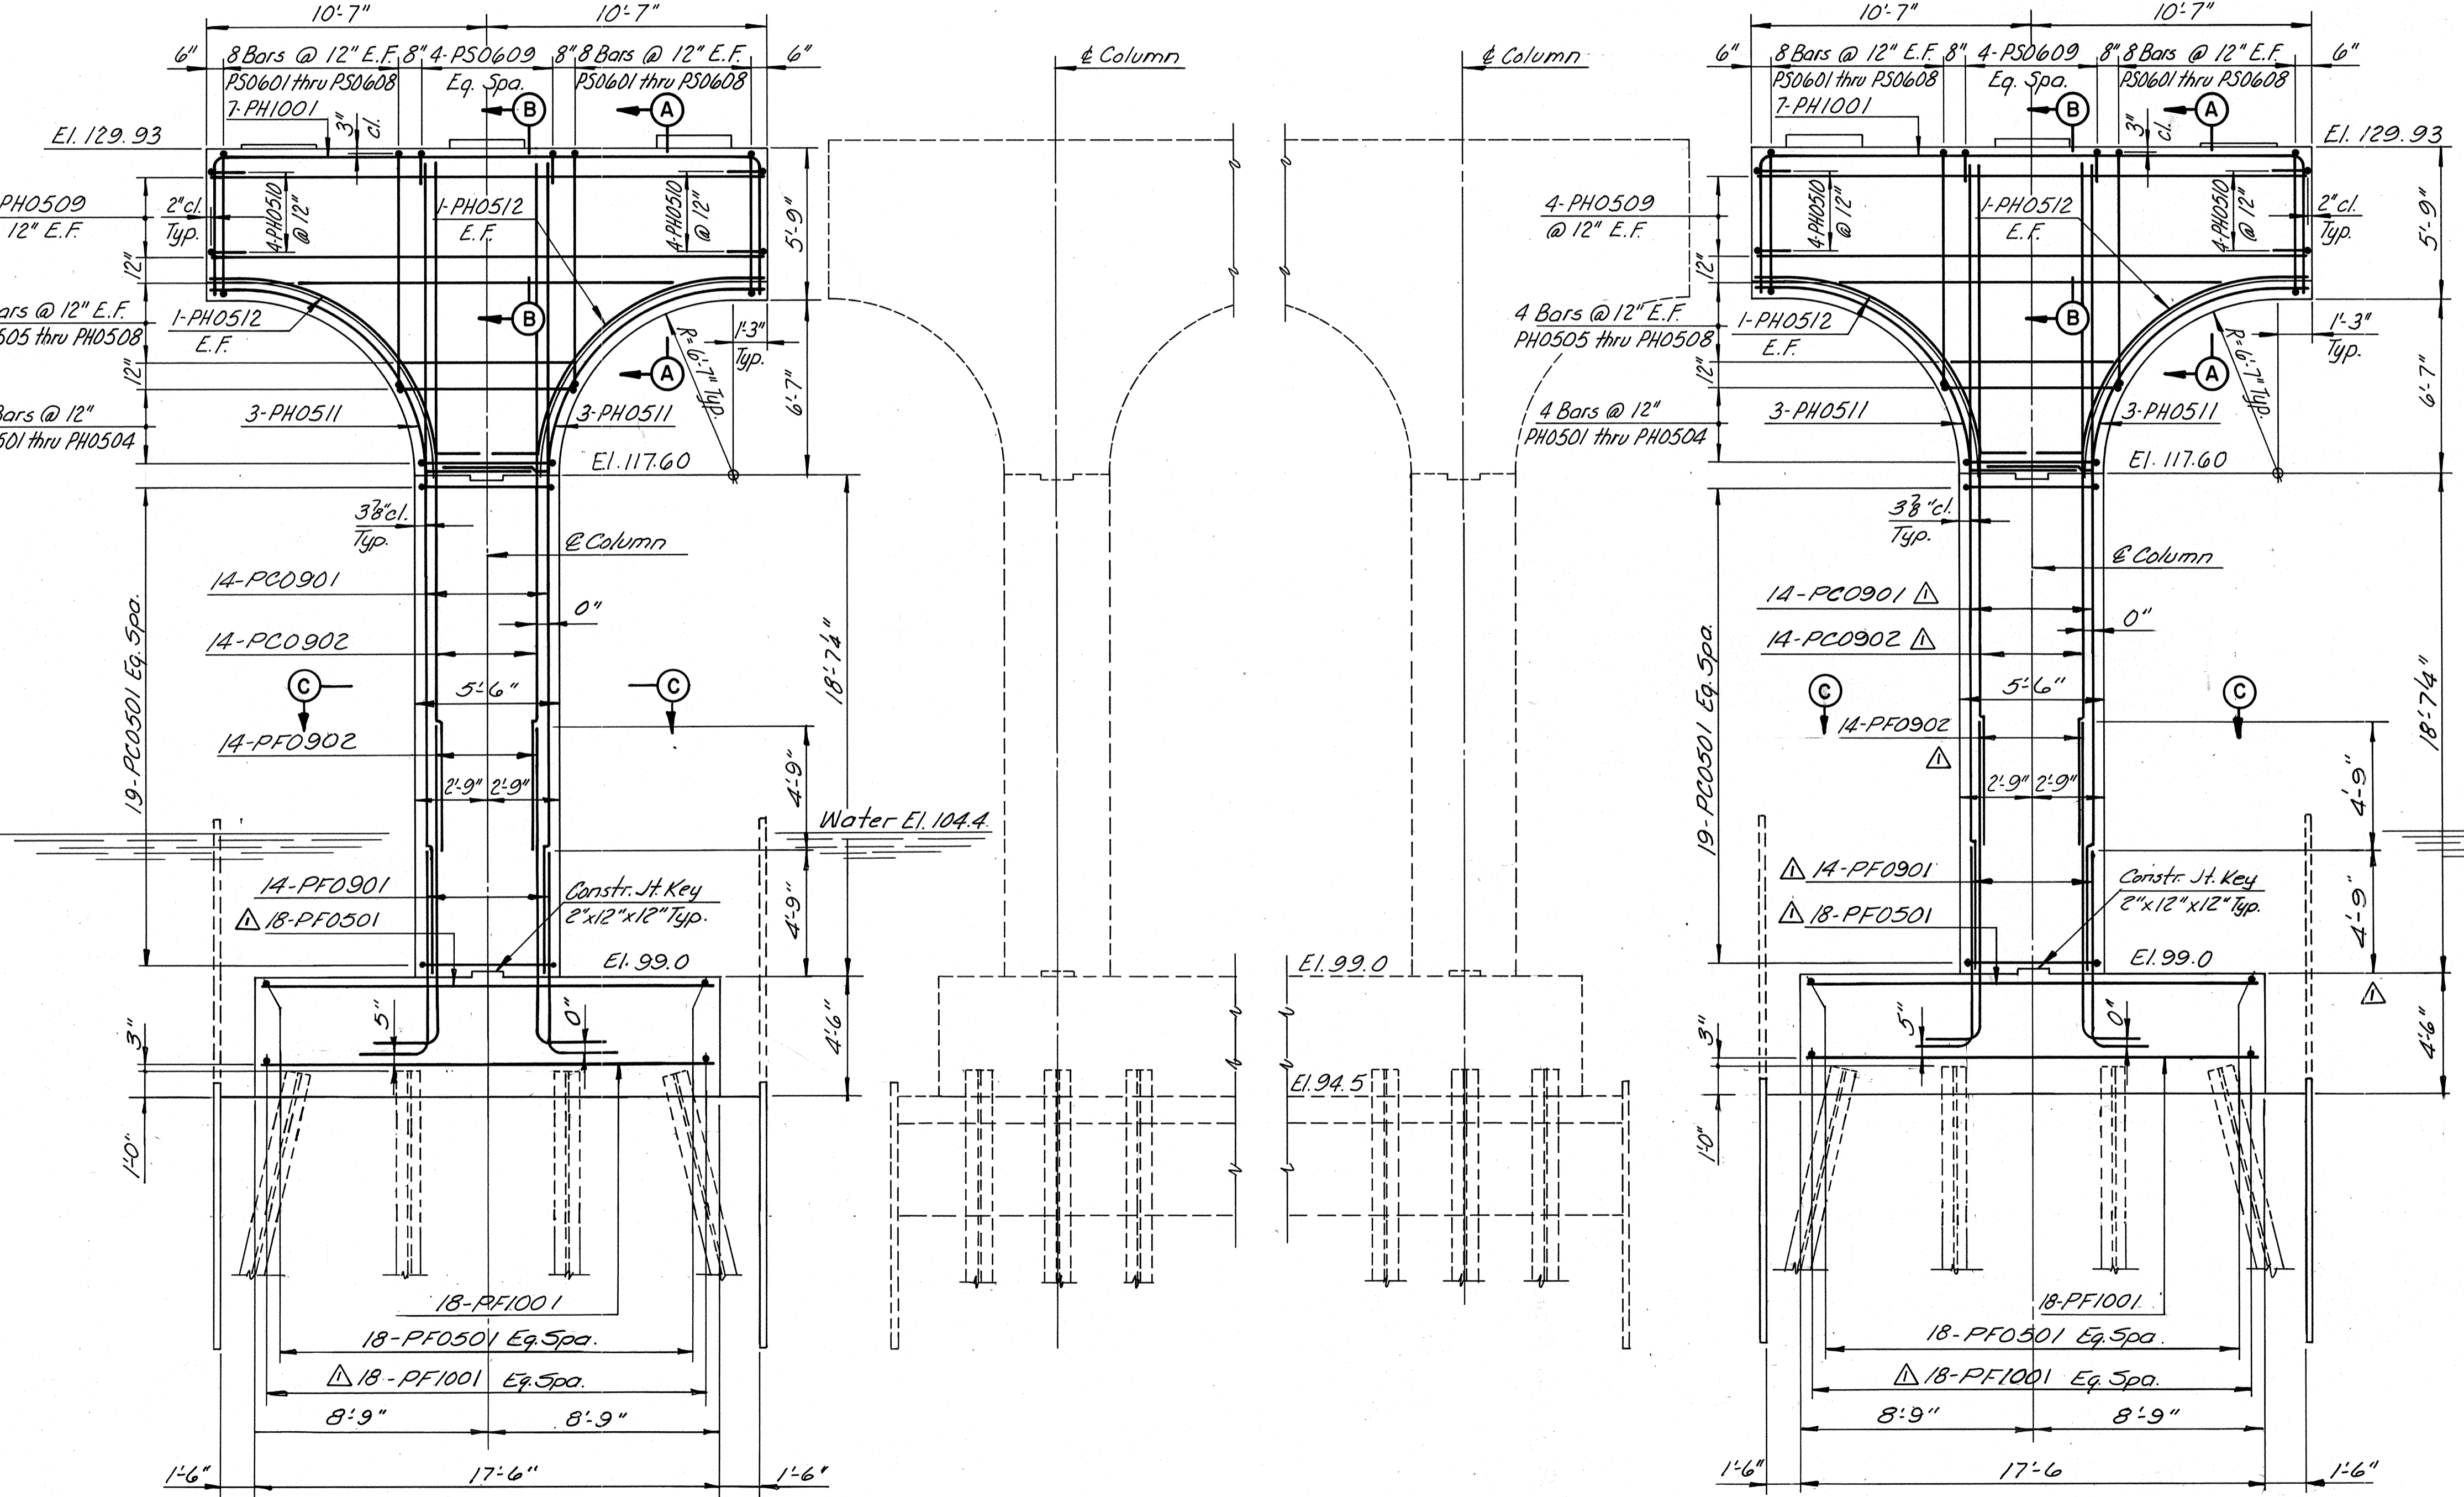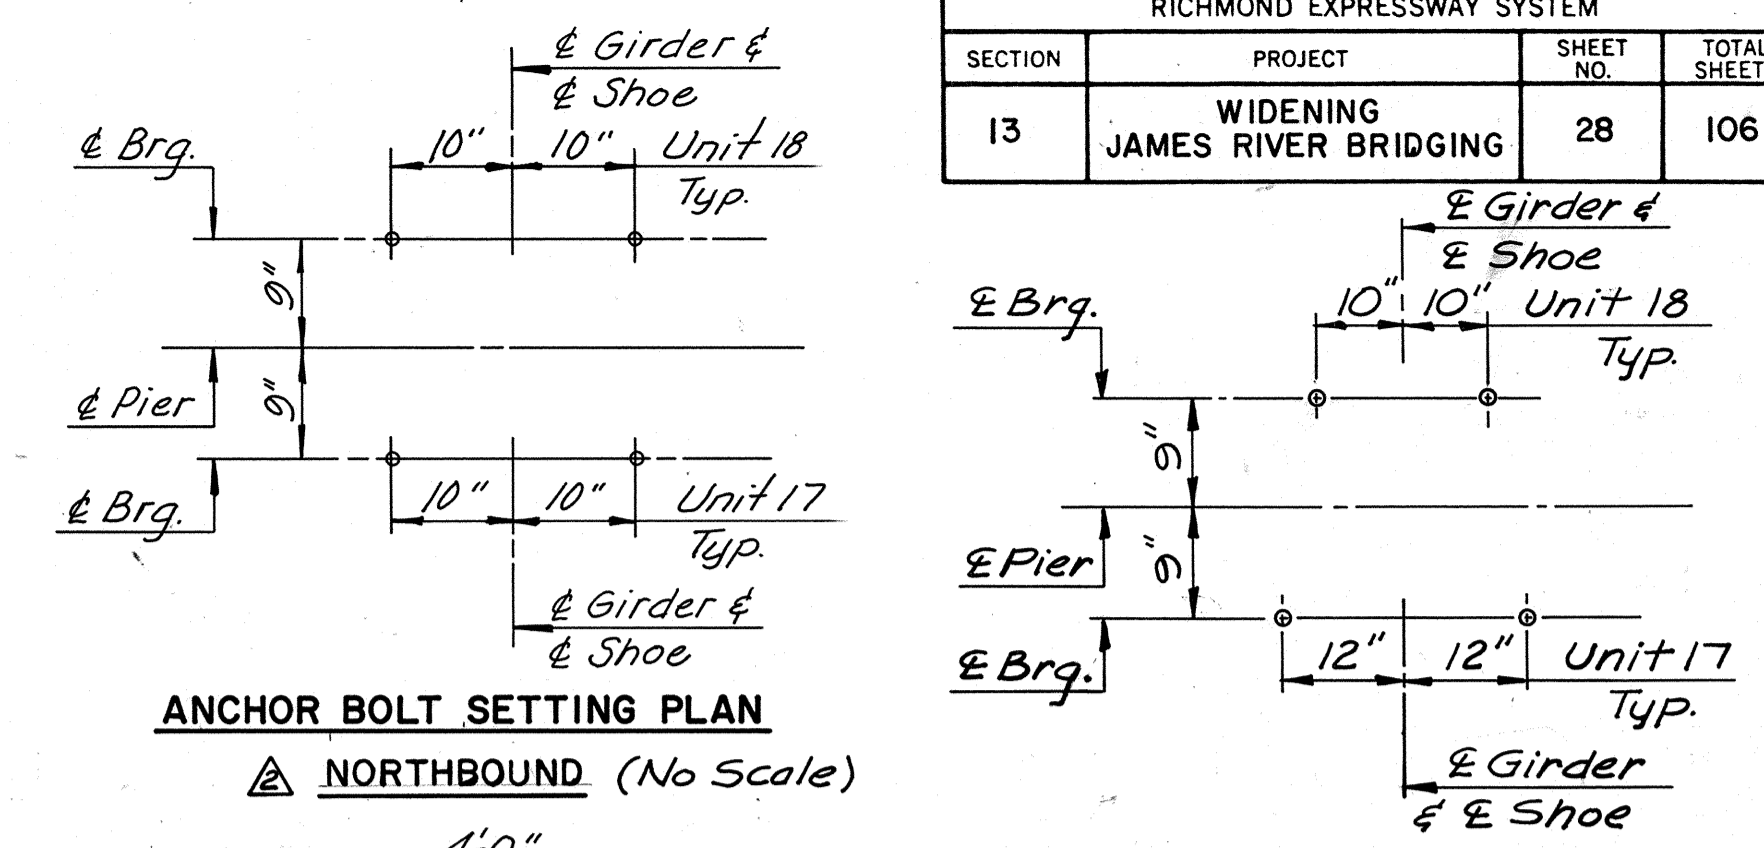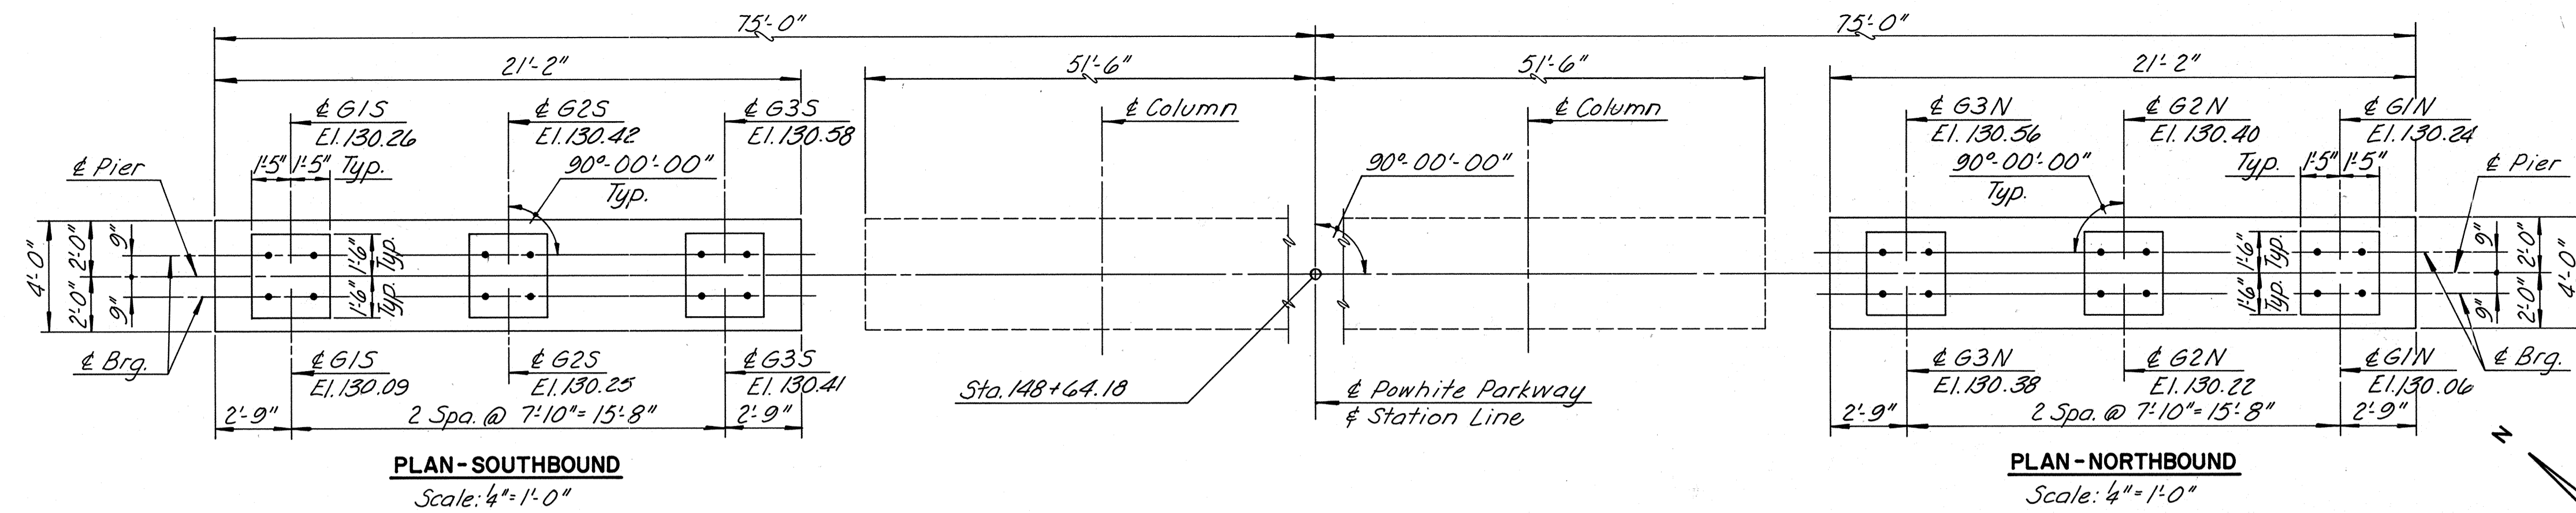

PILE NOTES:

- ⊥ Indicates vertical piles.
- ▶ Indicates piles battered 2:12 in direction of arrow.

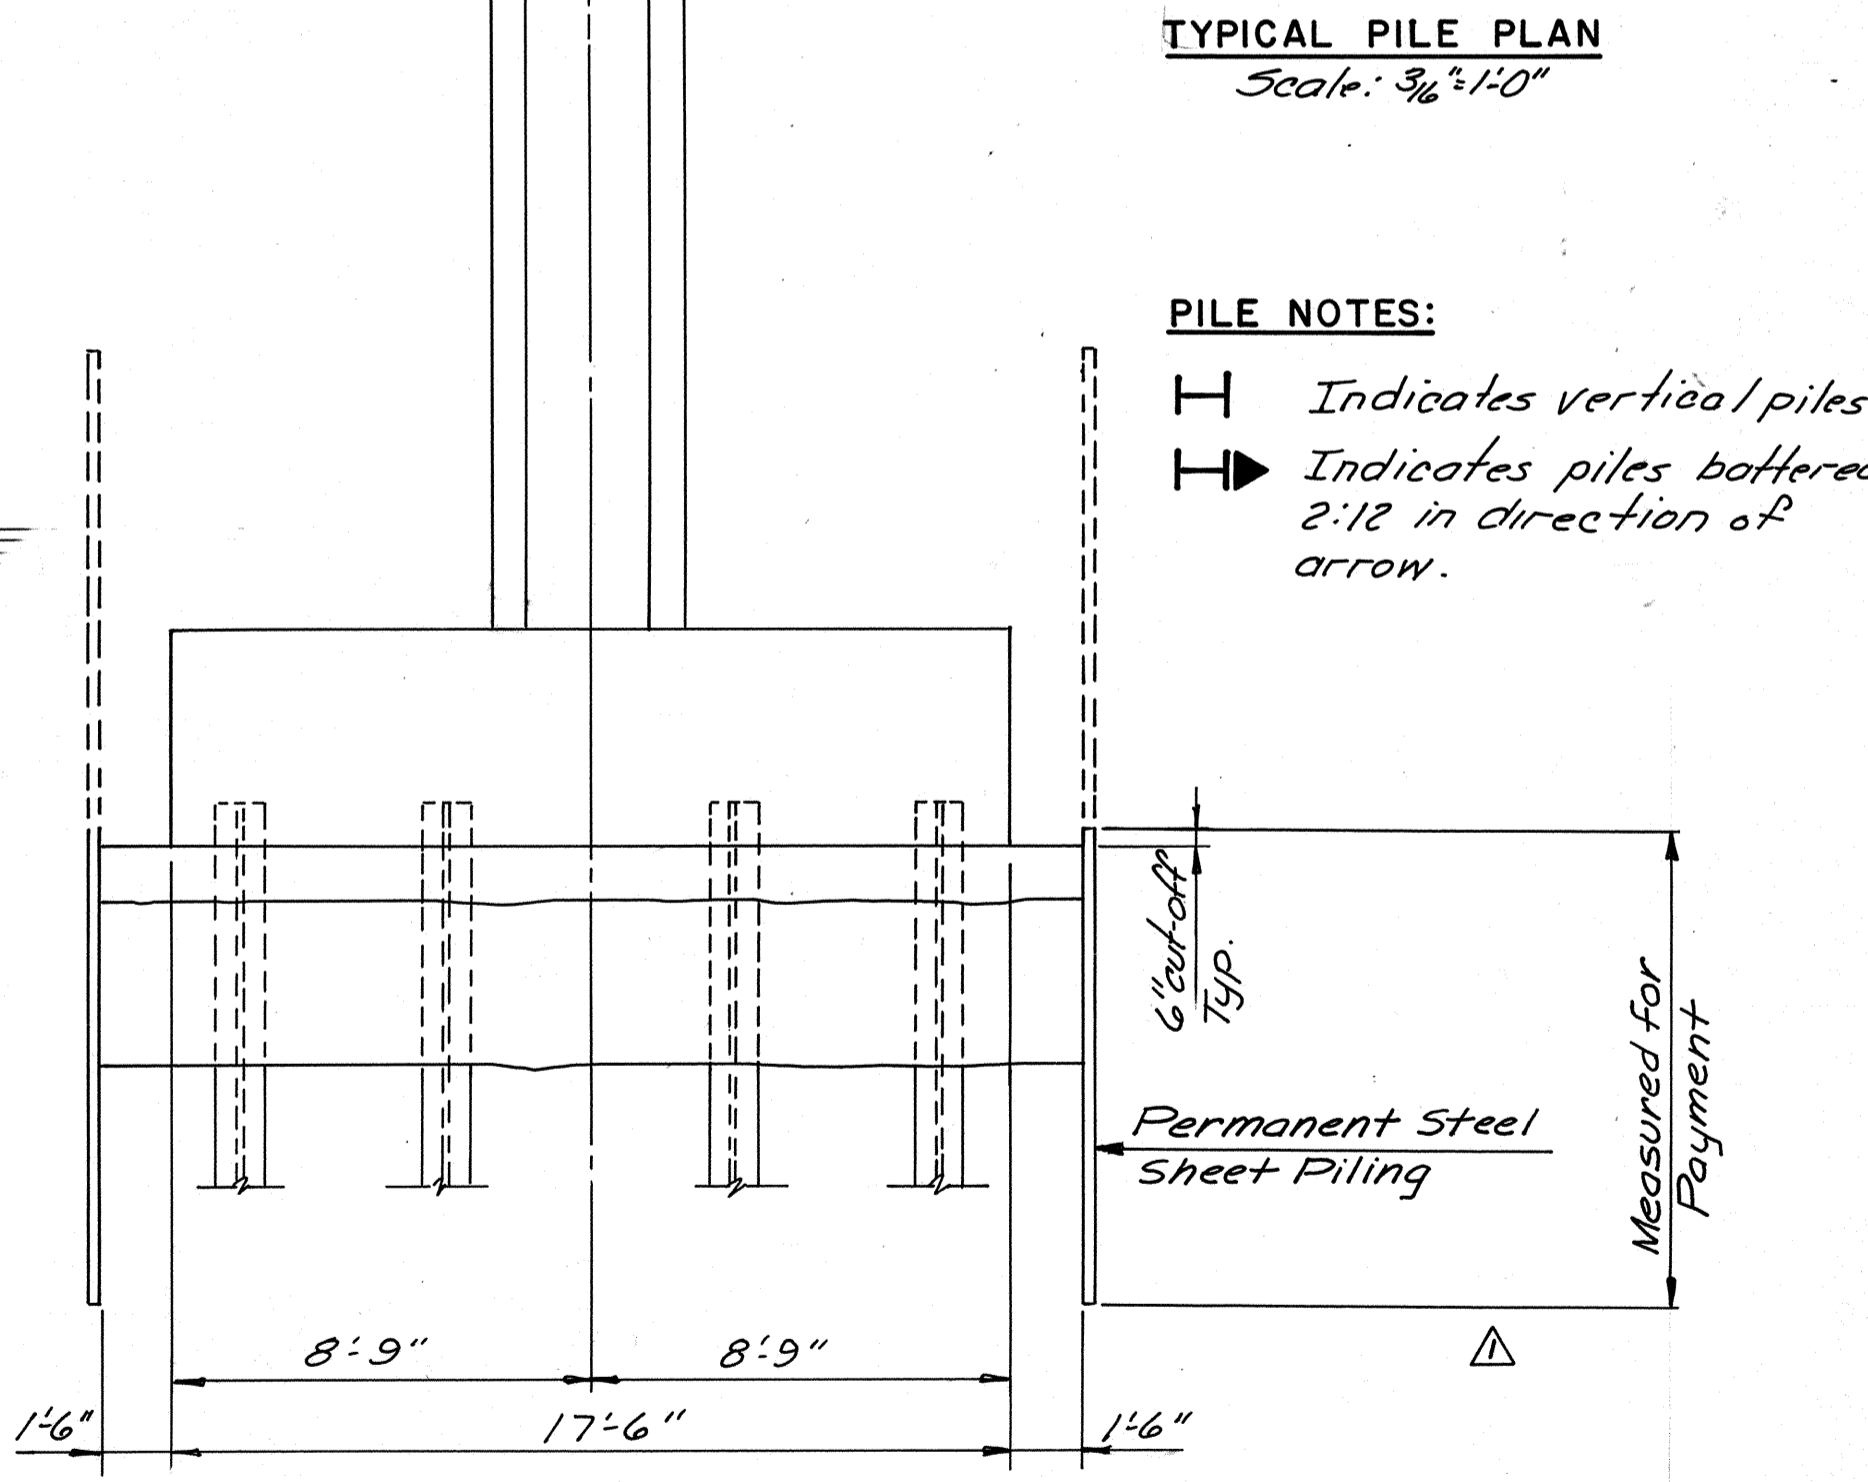

NOTE:
For Section A-A, B-B, and C-C see Sheet No. 12.

BY	DATE	As Built	TEM	3-89
MADE	TAL. 3-87	Rev Anchor Bolt	ALC	6-87
CHECKED	TJF 3-87	Both Elevation & End View	ALC	4-87
IN CHARGE	S.R			

AS BUILT


RICHMOND METROPOLITAN AUTHORITY
RICHMOND EXPRESSWAY SYSTEM

PIER 17 DETAILS

HOWARD, NEEDLES, TAMMEN & BERGENDOFF
consulting engineers
Alexandria, Virginia


SCALE: AS SHOWN
CONTRACT NO.: C-13
SHEET NO. 28 of 106

RICHMOND EXPRESSWAY SYSTEM			
SECTION	PROJECT	SHEET NO.	TOTAL SHEETS
13	WIDENING JAMES RIVER BRIDGE	30	106

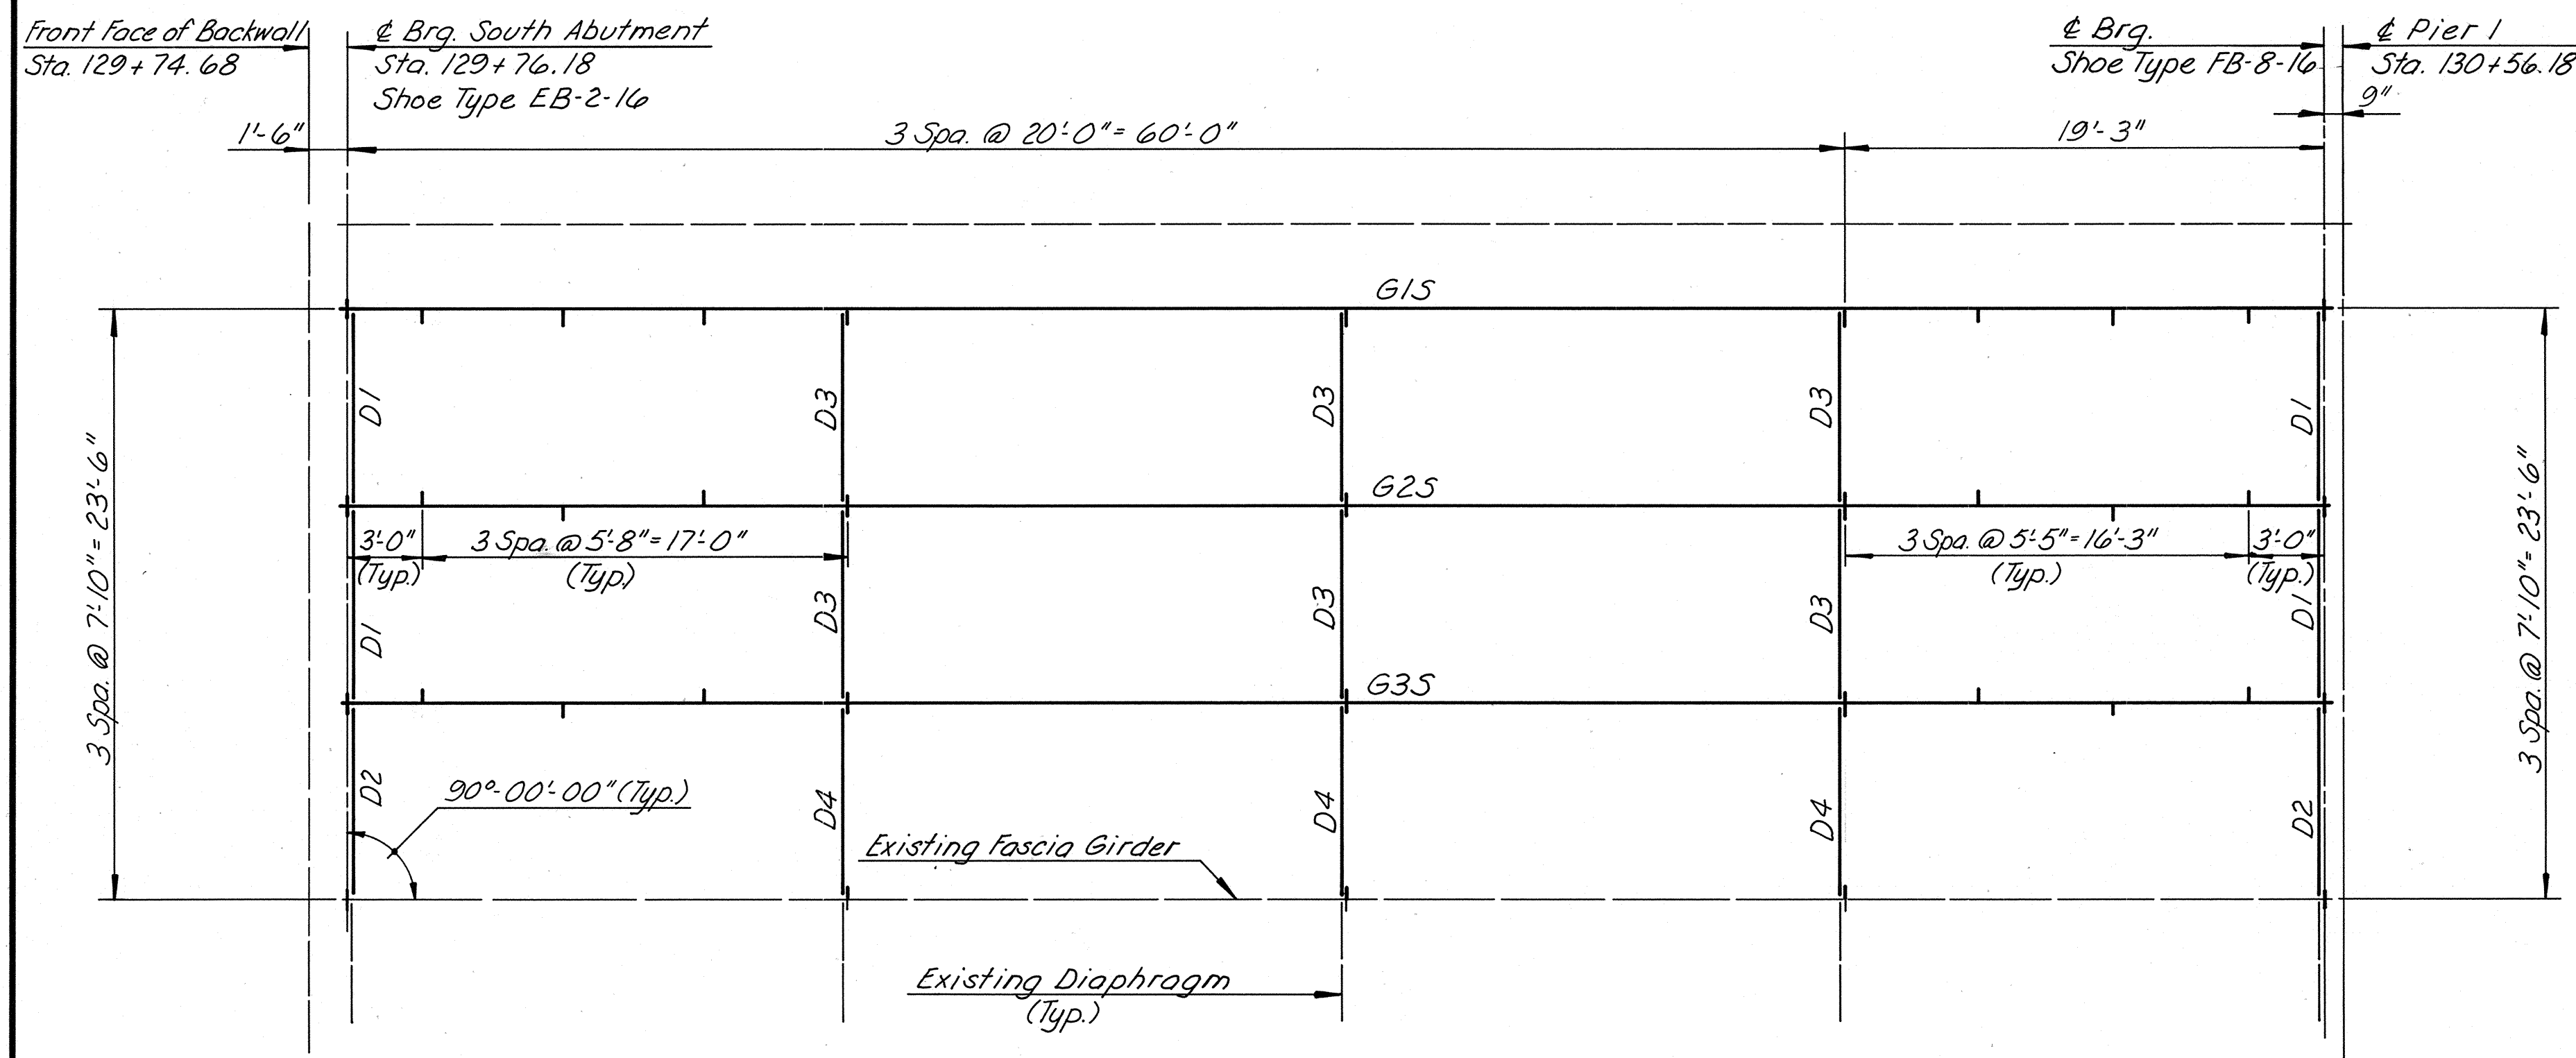

FRAMING PLAN - UNIT I SOUTHBOUND & NORTHBOUND
(SOUTHBOUND SHOWN)
Scale: $\frac{3}{16}'' = 1'-0''$

NOTE:
For Steel Details, see Sheet No. 45.

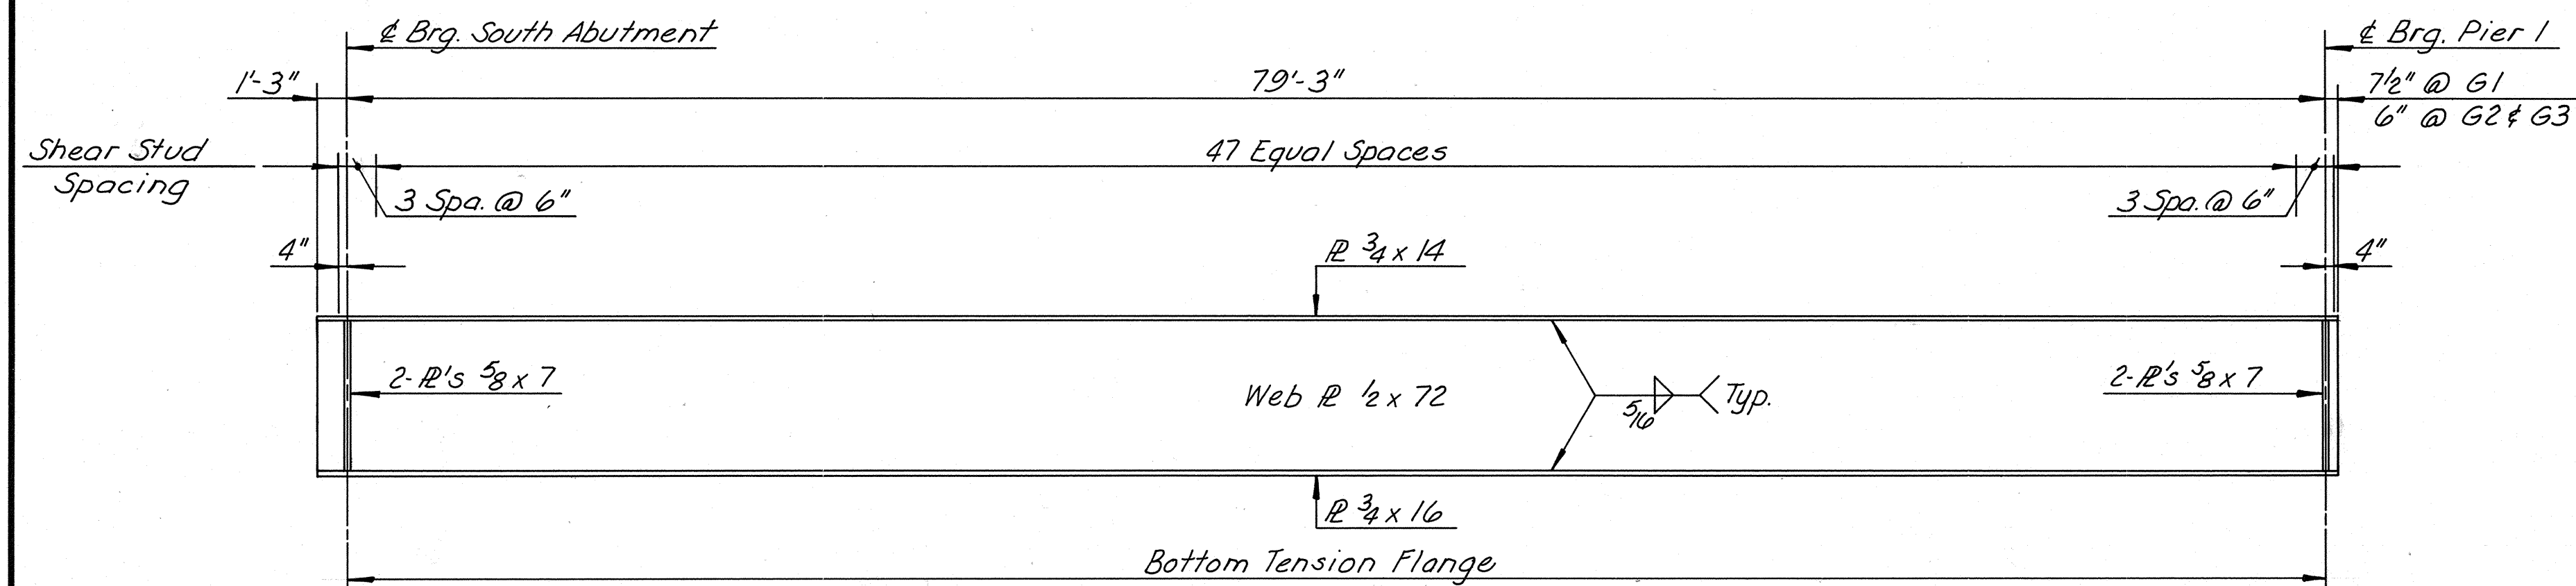

GIRDER ELEVATION - UNIT I SOUTHBOUND & NORTHBOUND
Scale: $\frac{3}{16}'' = 1'-0''$

BY	DATE				
MADE	EUM	1-87			
CHECKED	TFP	3-87	As Built	TEM	3-89
IN CHARGE	SR		NO.	REVISION	BY DATE

AS BUILT


RICHMOND METROPOLITAN AUTHORITY
RICHMOND EXPRESSWAY SYSTEM

FRAMING PLAN & GIRDER ELEVATION
UNIT I SOUTHBOUND & NORTHBOUND


HOWARD, NEEDLES, TAMMEN & BERGENDOFF
consulting engineers
Alexandria, Virginia

SCALE: AS SHOWN
CONTRACT NO.: C-13
SHEET NO. 30 OF 106

RICHMOND EXPRESSWAY SYSTEM			
SECTION	PROJECT	SHEET NO.	TOTAL SHEETS
13	WIDENING JAMES RIVER BRIDGE	31	106

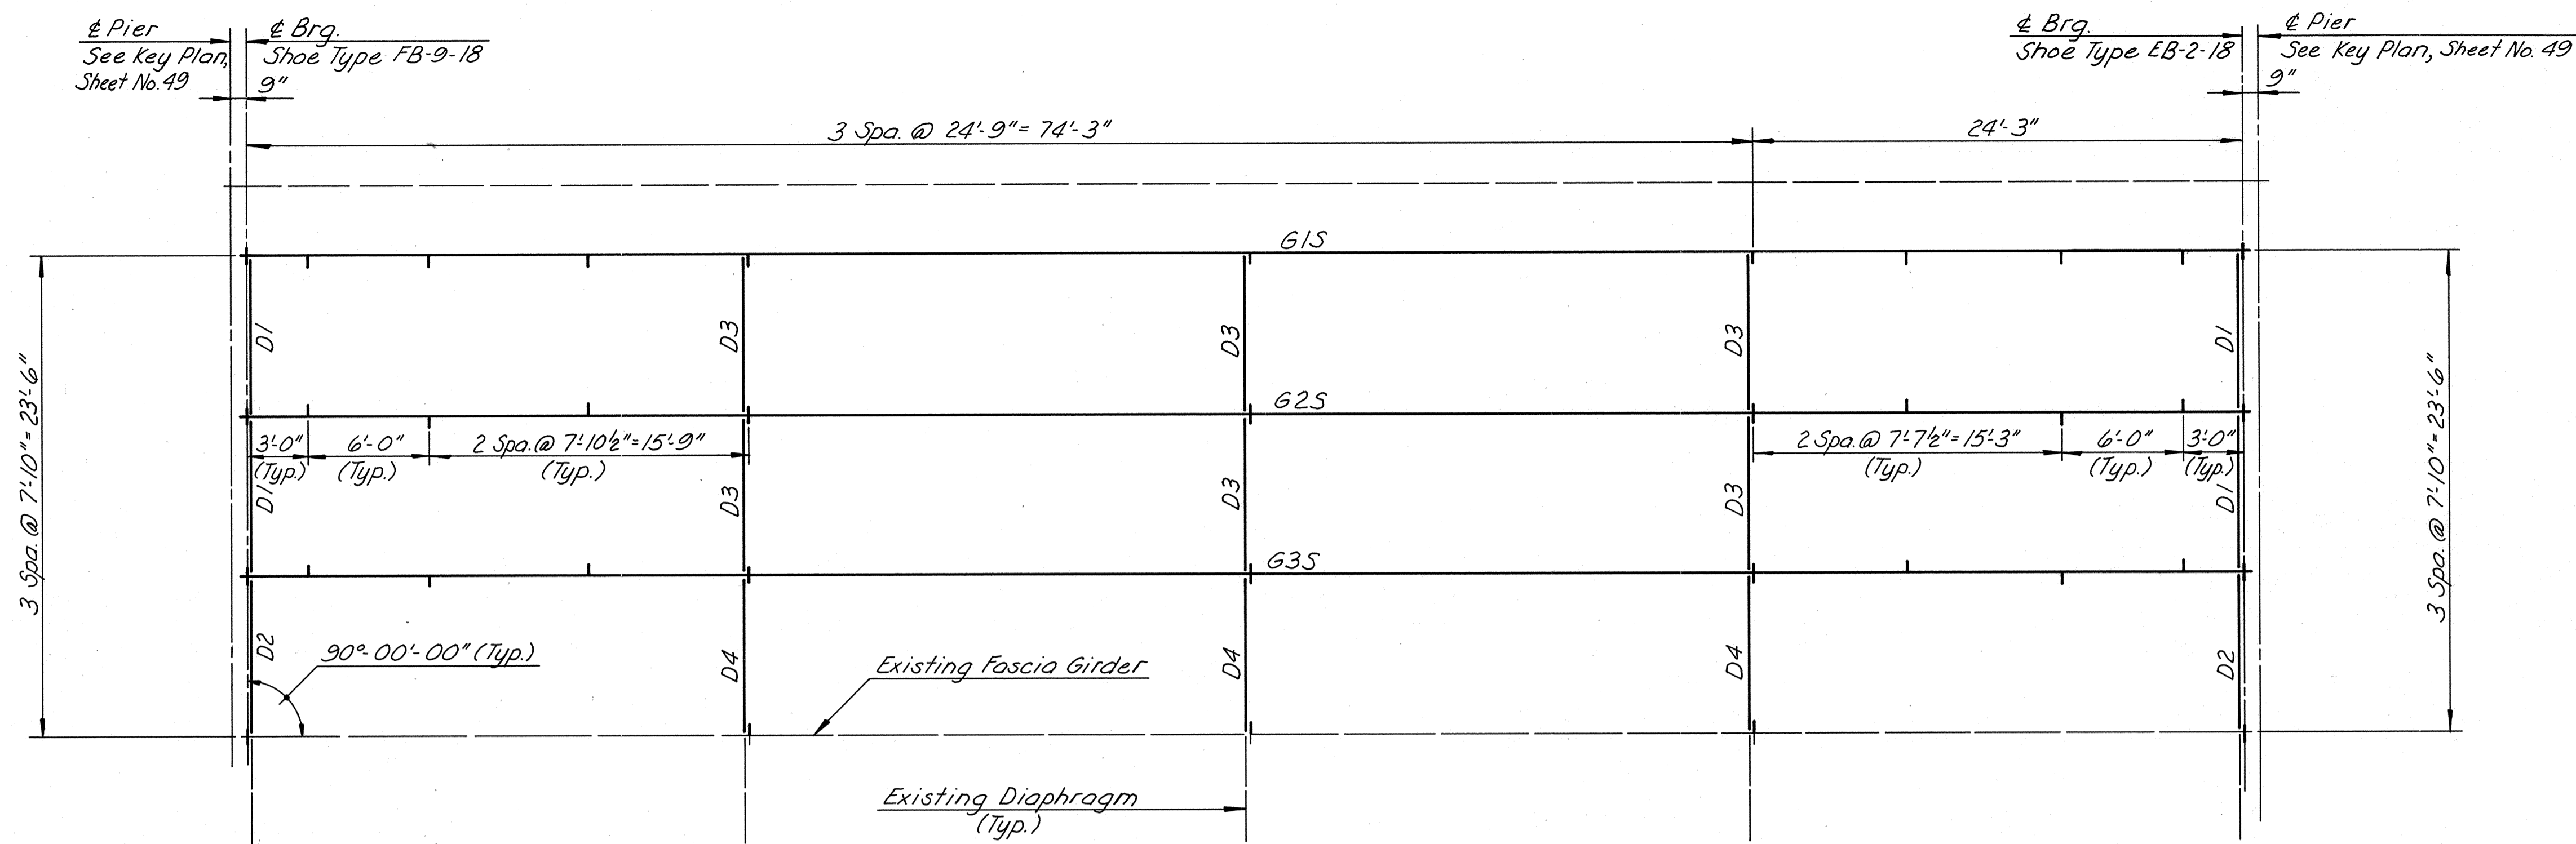

FRAMING PLAN - UNITS 2 & 3 SOUTHBOUND & NORTHBOUND
(SOUTHBOUND SHOWN)
Scale: $\frac{3}{16}'' = 1'-0''$

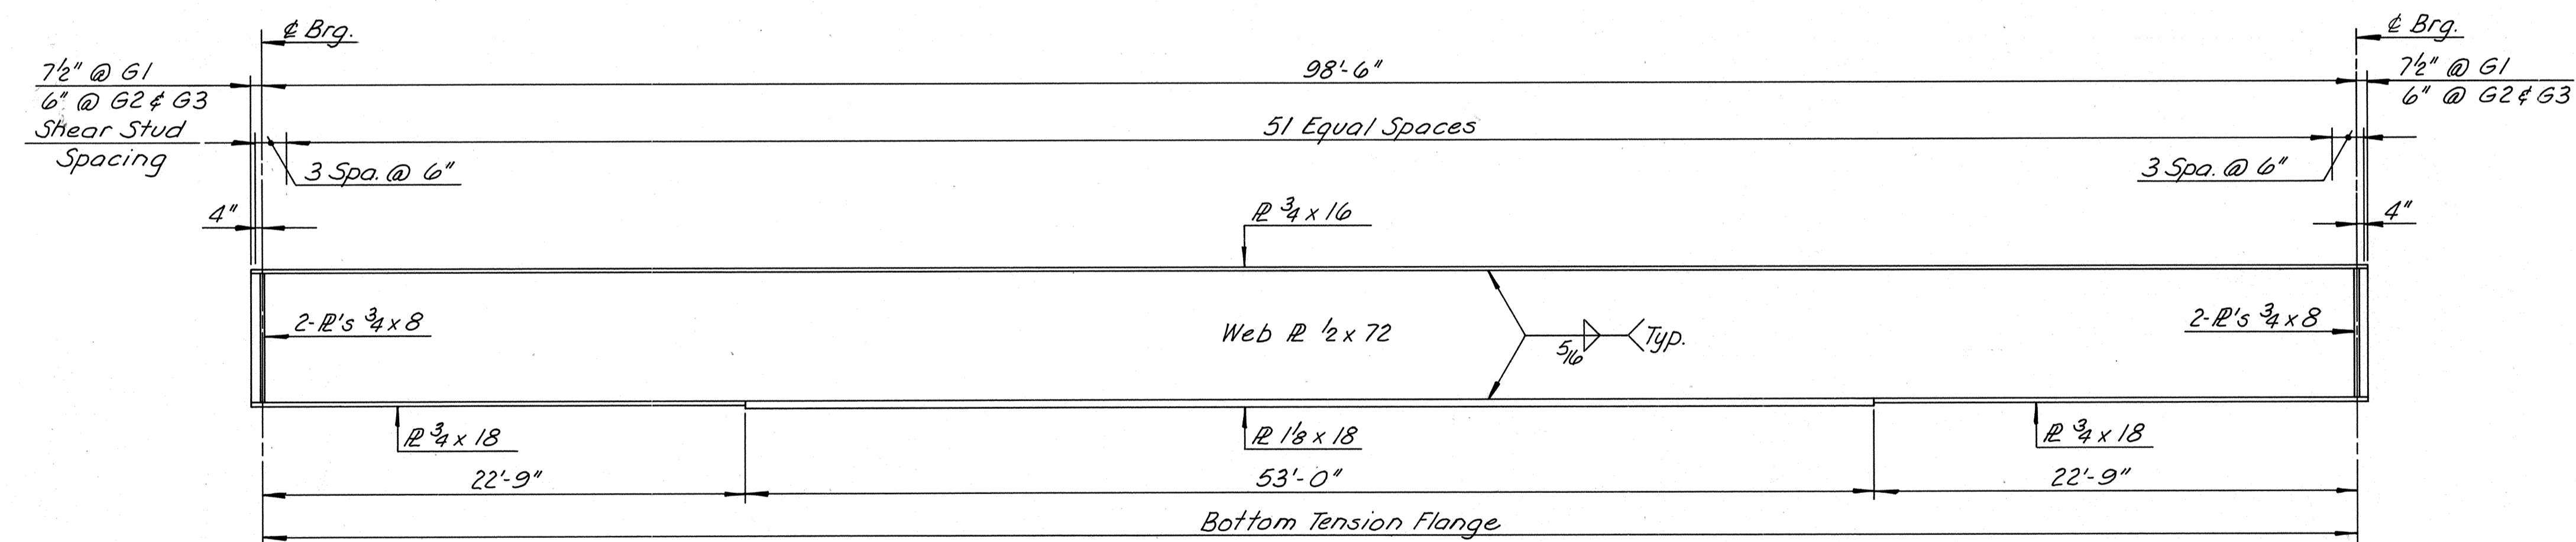

GIRDER ELEVATION - UNITS 2 & 3 SOUTHBOUND & NORTHBOUND
Scale: $\frac{3}{16}'' = 1'-0''$

NOTE:
For Steel Details, see Sheet No. 45.

	BY	DATE			
MADE	EJM	1-87			
CHECKED	TFP	3-87	As Built	TEM	3-89
IN CHARGE	SR				

AS BUILT

RICHMOND METROPOLITAN AUTHORITY
RICHMOND EXPRESSWAY SYSTEM


FRAMING PLAN & GIRDER ELEVATION
UNITS 2 & 3 SOUTHBOUND & NORTHBOUND

HOWARD, NEEDLES, TAMMEN & BERGENDOFF
consulting engineers
Alexandria, Virginia


SCALE: AS SHOWN
CONTRACT NO.: C-13
SHEET NO. 31 OF 106

RICHMOND EXPRESSWAY SYSTEM			
SECTION	PROJECT	SHEET NO.	TOTAL SHEETS
13	WIDENING JAMES RIVER BRIDGE	32	106

NOTE:
For Steel Details, see Sheet No. 45.

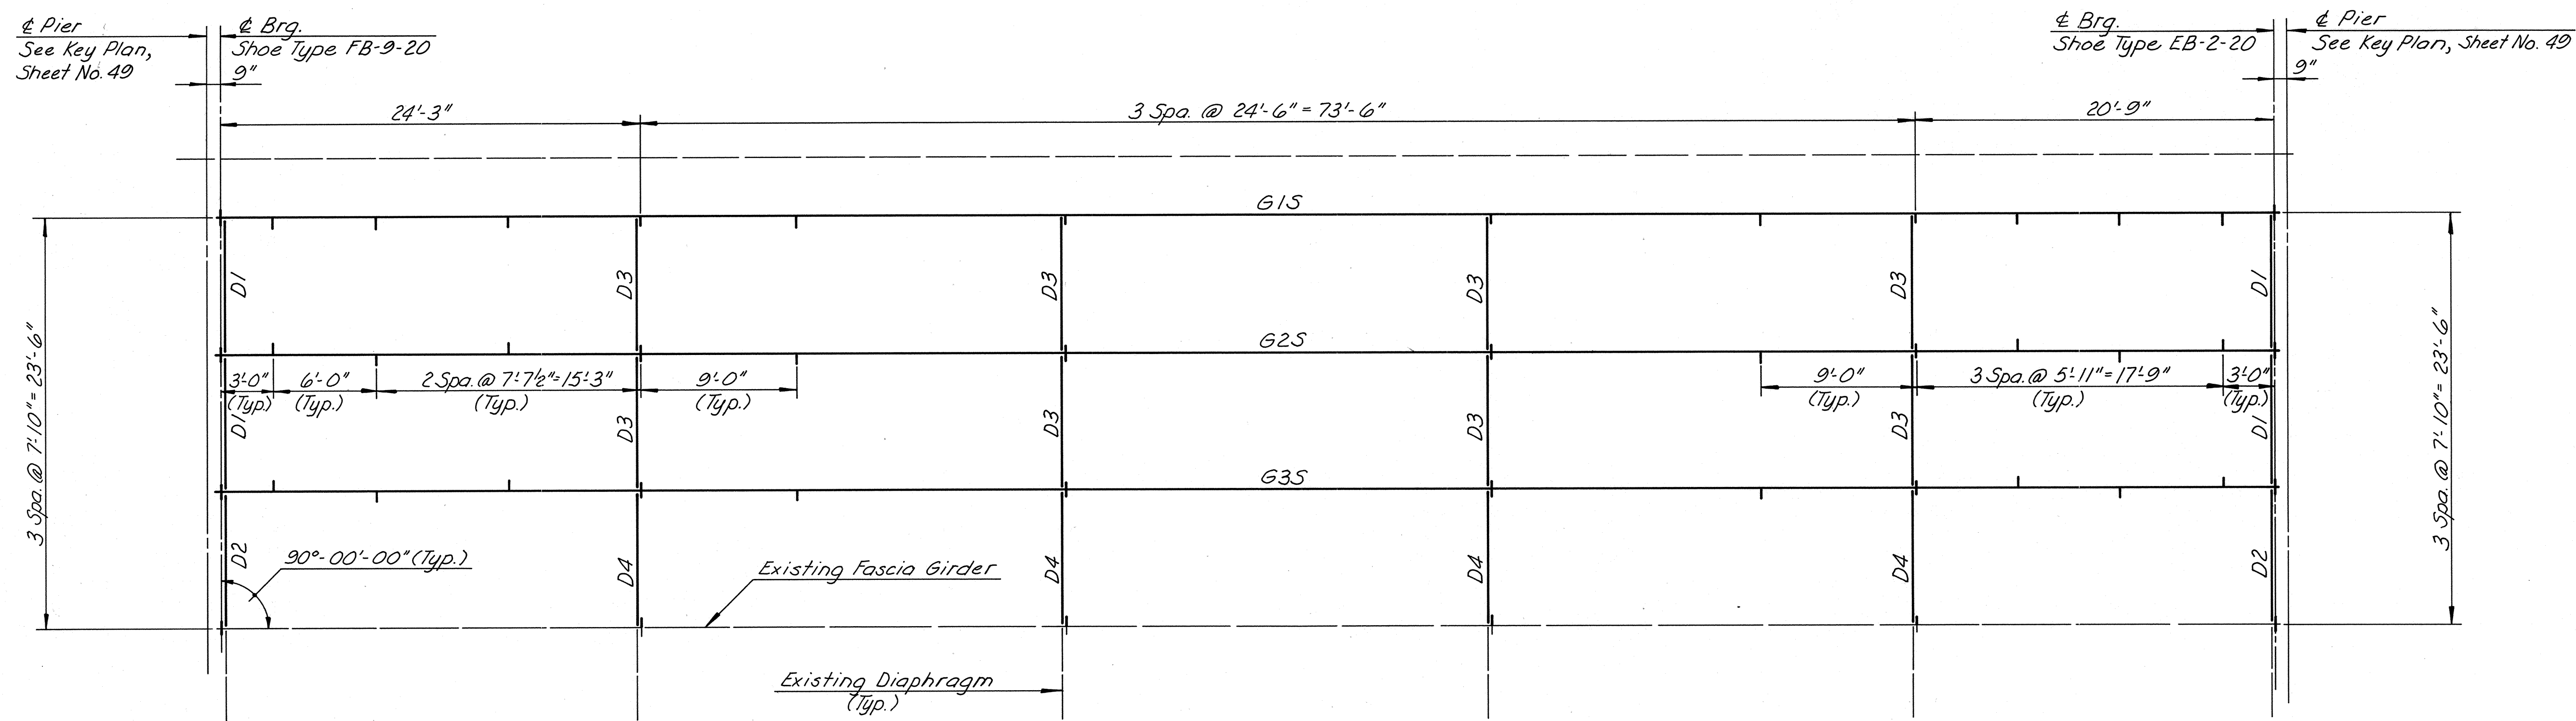

FRAMING PLAN - UNIT 4 SOUTHBOUND & NORTHBOUND
(SOUTHBOUND SHOWN)
Scale: $\frac{3}{16}'' = 1'-0''$

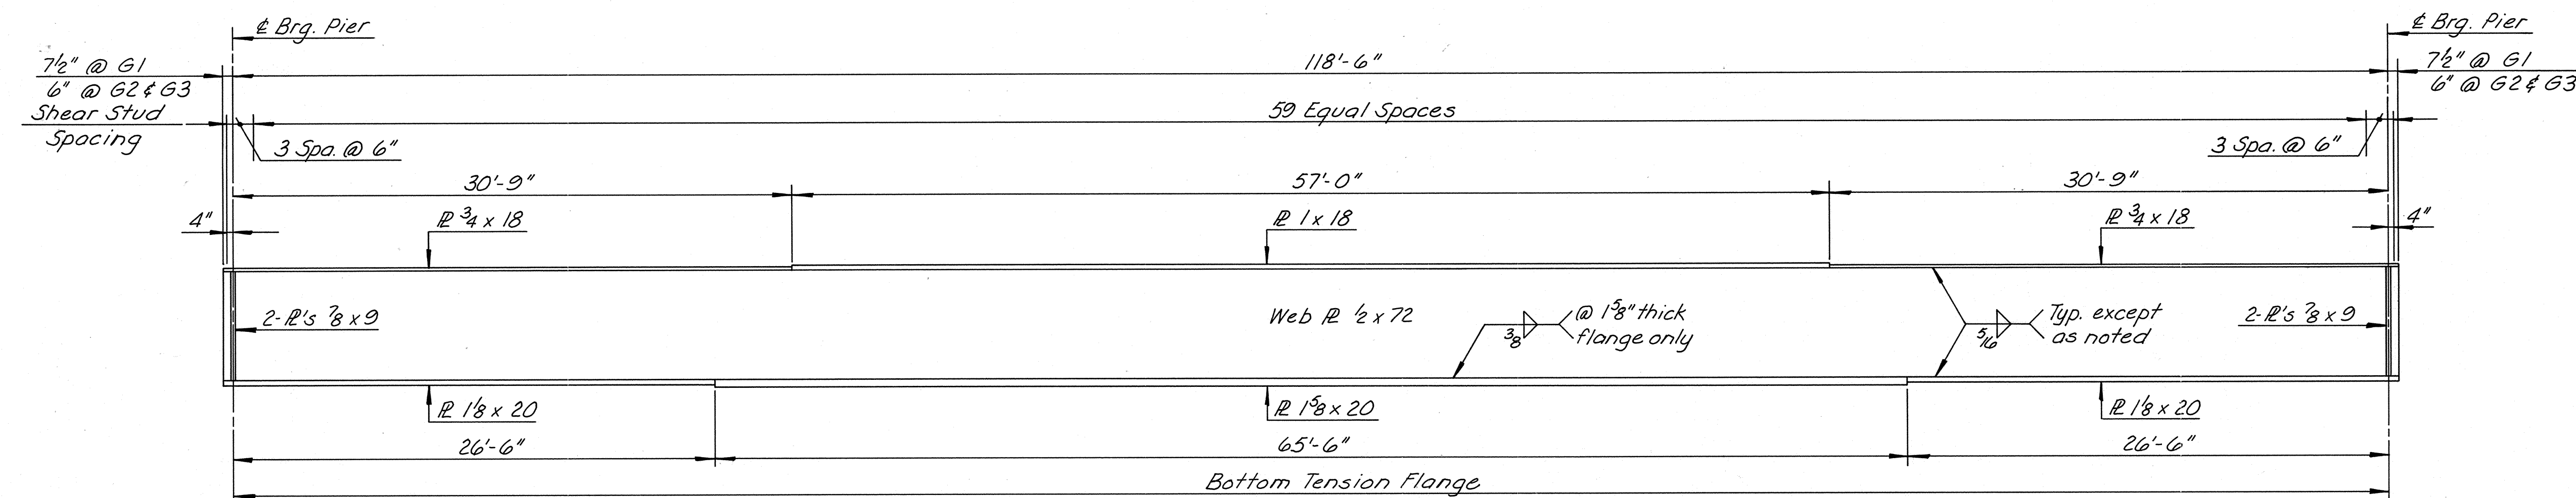

GIRDER ELEVATION - UNIT 4 SOUTHBOUND & NORTHBOUND
Scale: $\frac{3}{16}'' = 1'-0''$

BY	DATE	NO.	REVISION	BY	DATE
MADE	EJM 1-87				
CHECKED	TFP 3-87		As-Built	TEM	3-89
IN CHARGE	SR				

AS BUILT


RICHMOND METROPOLITAN AUTHORITY
RICHMOND EXPRESSWAY SYSTEM

FRAMING PLAN & GIRDER ELEVATION
UNIT 4 SOUTHBOUND & NORTHBOUND

HOWARD, NEEDLES, TAMMEN & BERGENDOFF
consulting engineers
Alexandria, Virginia


SCALE: AS SHOWN
CONTRACT NO.: C-13
SHEET NO. 32 OF 106

RICHMOND EXPRESSWAY SYSTEM			
SECTION	PROJECT	SHEET NO.	TOTAL SHEETS
13	WIDENING JAMES RIVER BRIDGE	33	106

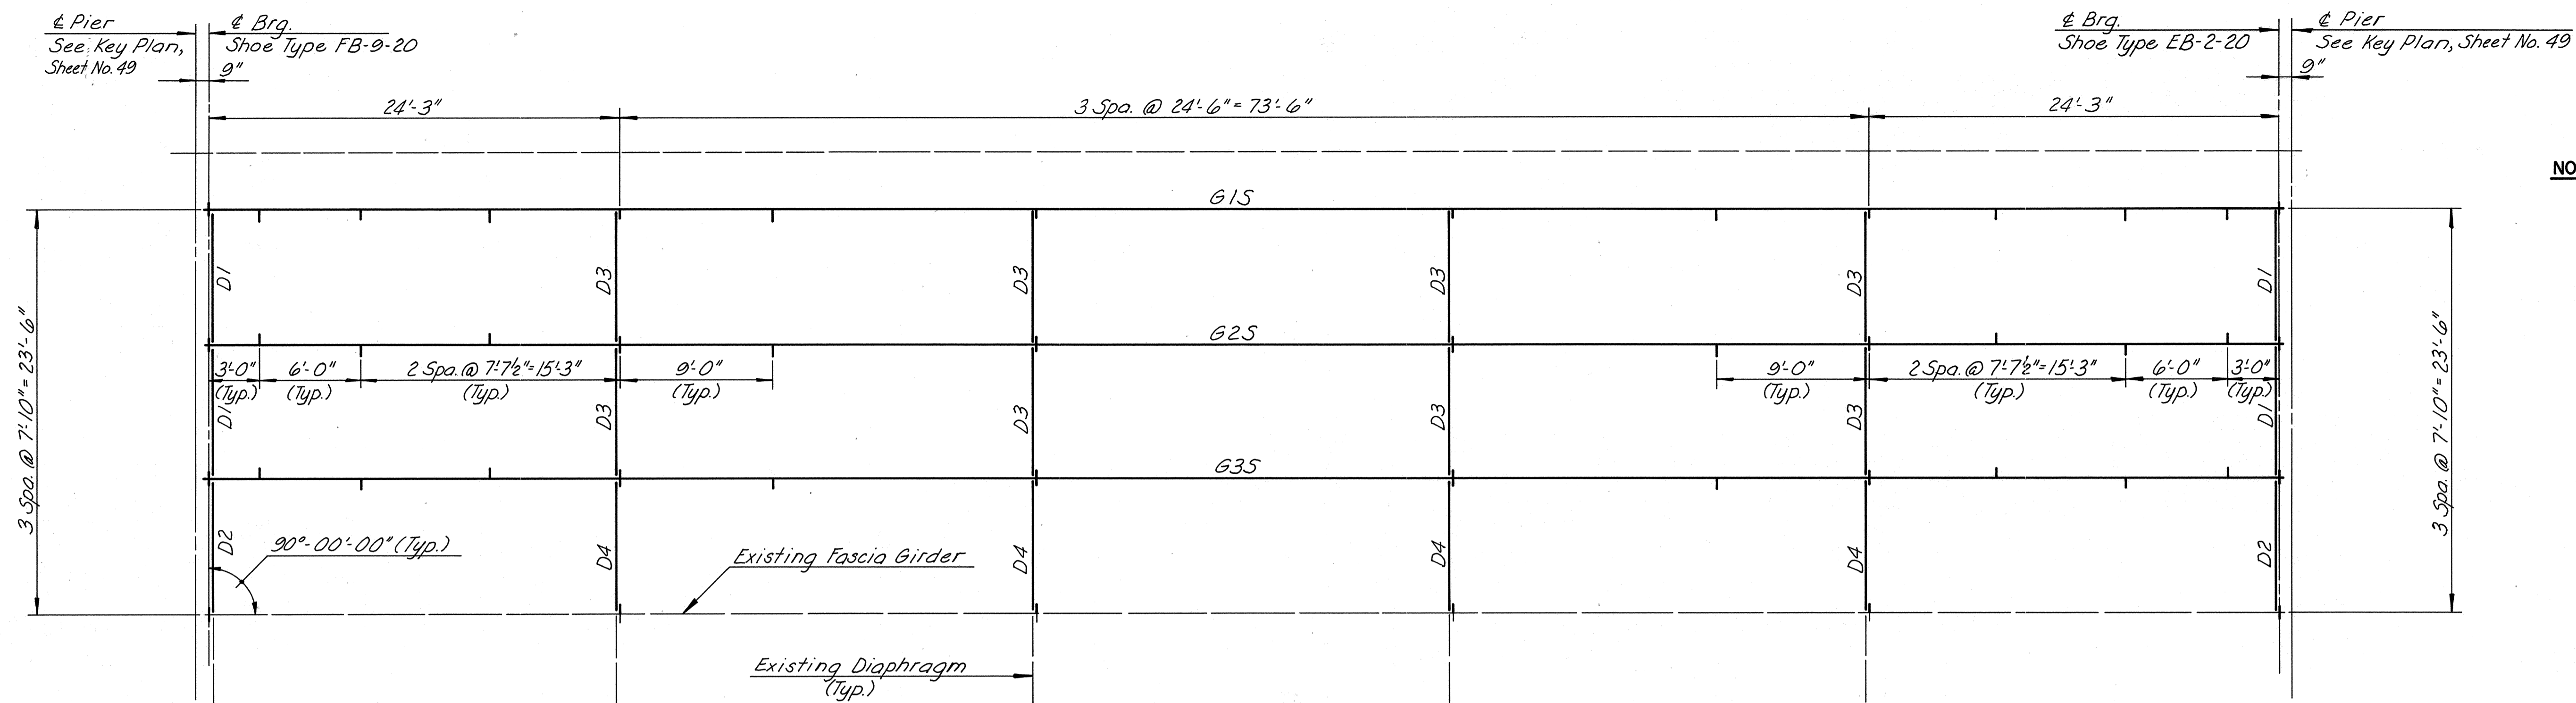

FRAMING PLAN - UNITS 5 THRU 12 SOUTHBOUND & NORTHBOUND
(SOUTHBOUND SHOWN)
Scale: $\frac{3}{16}'' = 1'-0''$

NOTE:
For Steel Details, see Sheet No. 45.

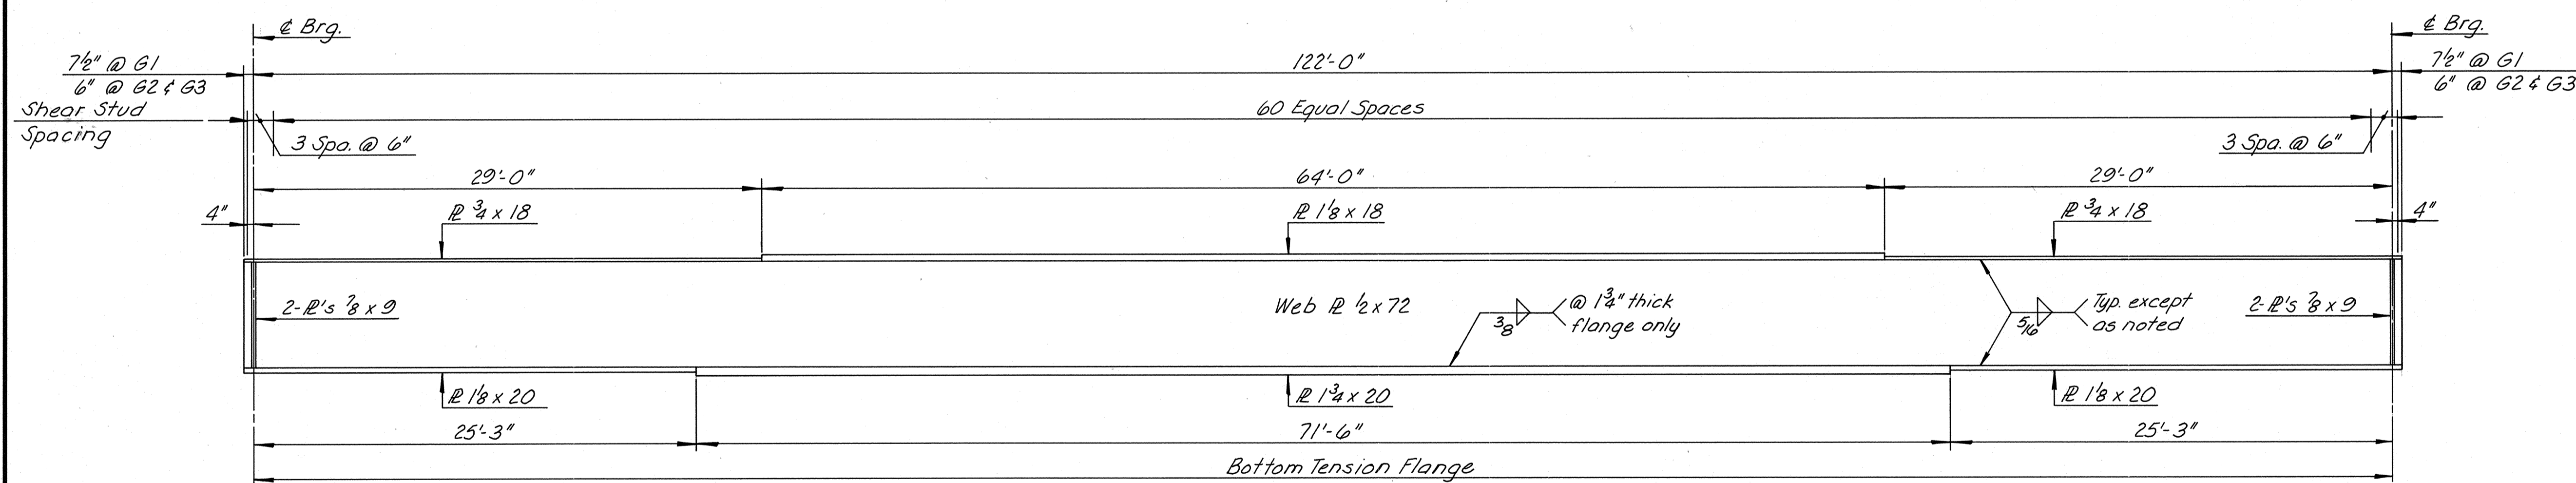

GIRDER ELEVATION - UNITS 5 THRU 12 SOUTHBOUND & NORTHBOUND
Scale: $\frac{3}{16}'' = 1'-0''$

BY	DATE	NO.	REVISION	BY	DATE
MADE	EJM 1-87				
CHECKED	TFP 3-87		As Built	TEM	3-89
IN CHARGE	SR				

AS BUILT


RICHMOND METROPOLITAN AUTHORITY
RICHMOND EXPRESSWAY SYSTEM

FRAMING PLAN & GIRDER ELEVATION
UNITS 5 THRU 12 SOUTHBOUND & NORTHBOUND

HOWARD, NEEDLES, TAMMEN & BERGENDOFF
consulting engineers
Alexandria, Virginia


SCALE: AS SHOWN
CONTRACT NO.: C-13
SHEET NO. 33 OF 106

RICHMOND EXPRESSWAY SYSTEM			
SECTION	PROJECT	SHEET NO.	TOTAL SHEETS
13	WIDENING JAMES RIVER BRIDGE	34	106

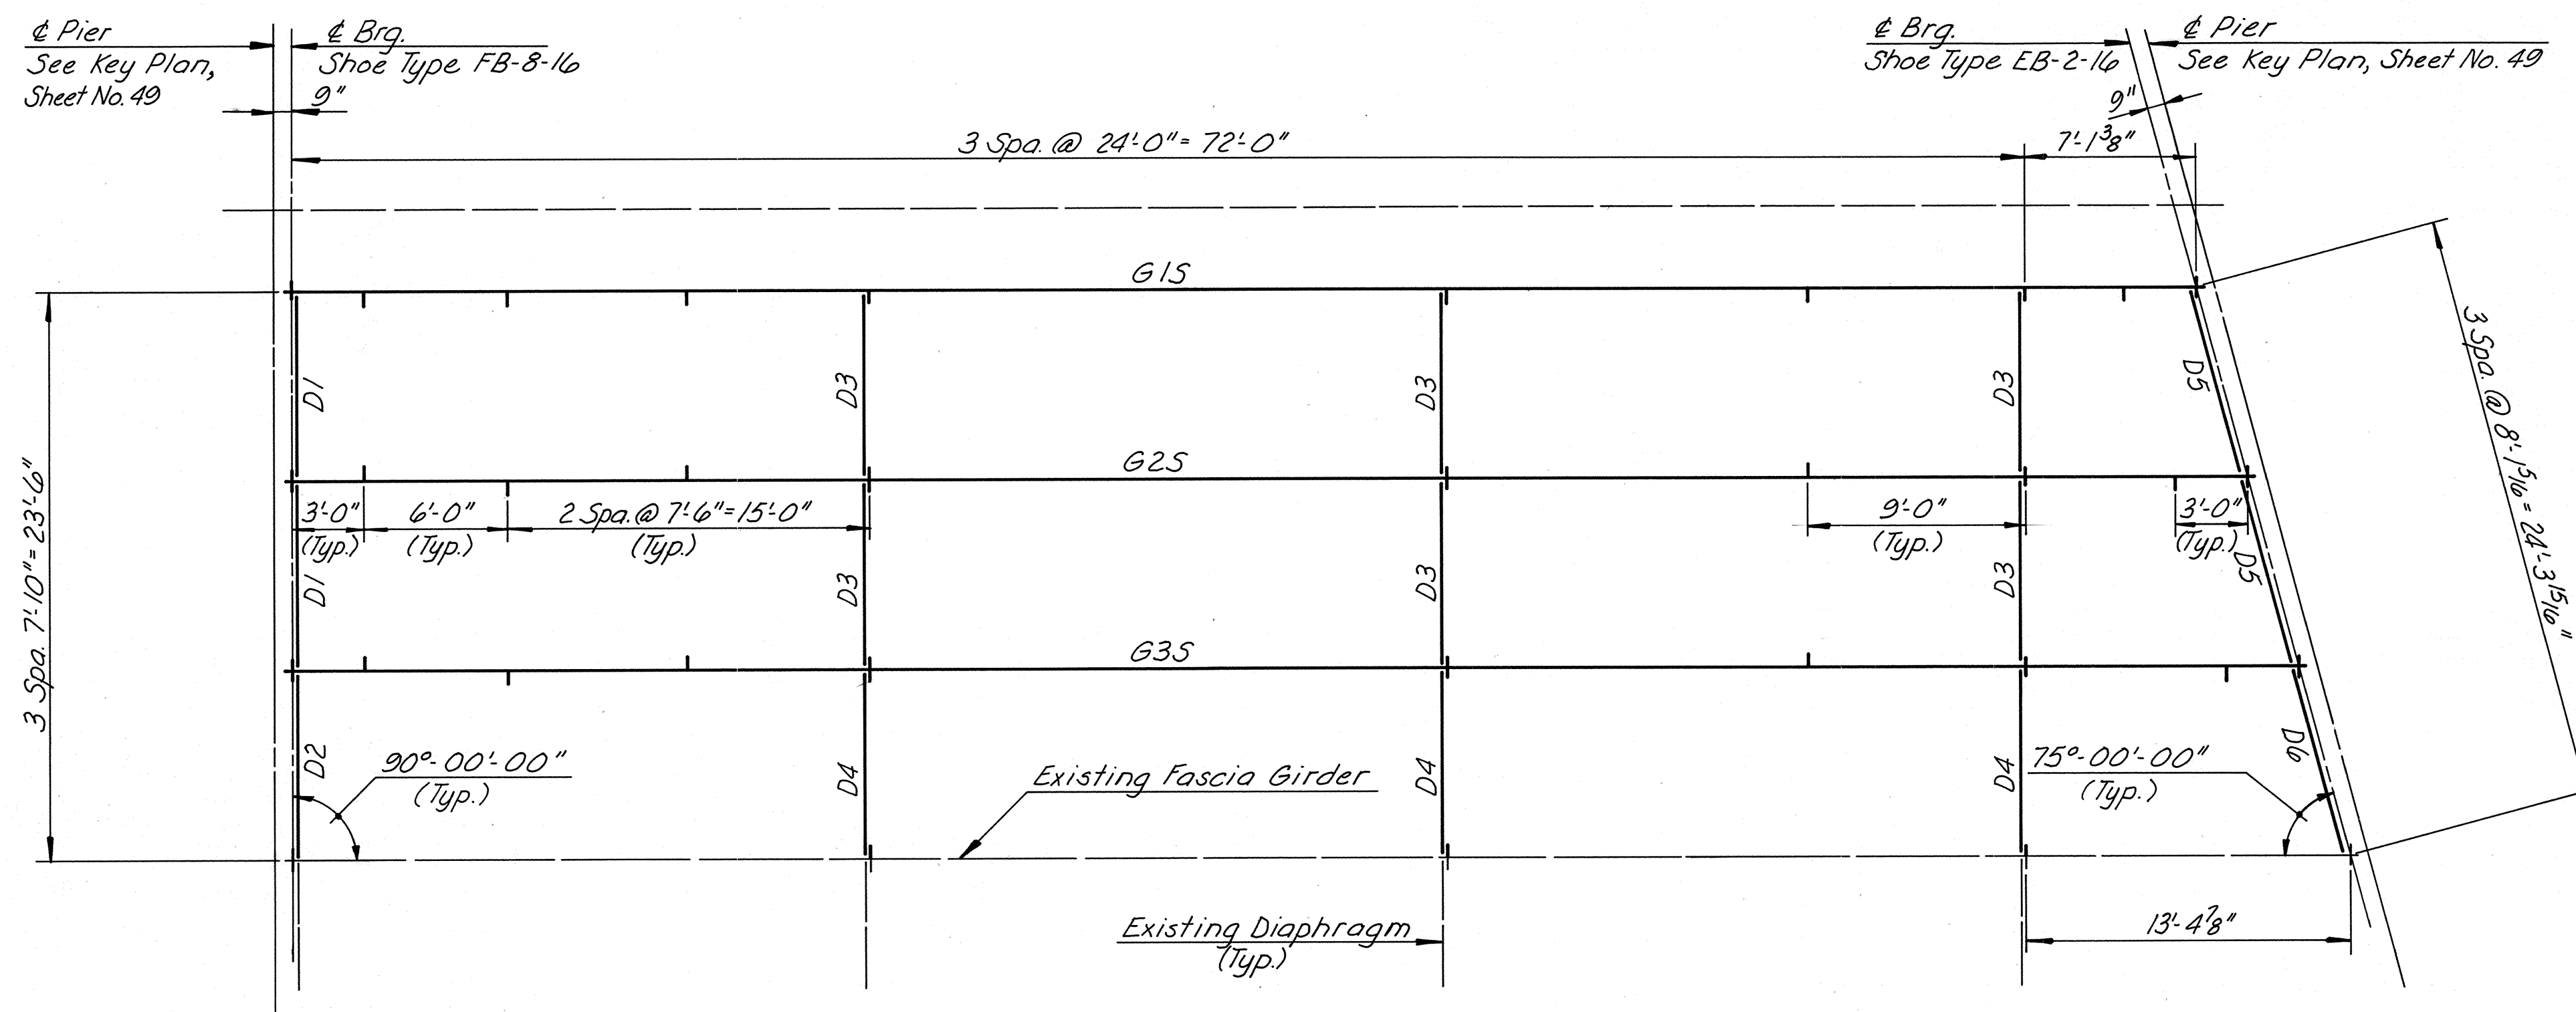

FRAMING PLAN-UNIT 13 SOUTHBOUND
Scale: $\frac{3}{16}'' = 1'-0''$

NOTE:
For Steel Details, see Sheet No. 45.

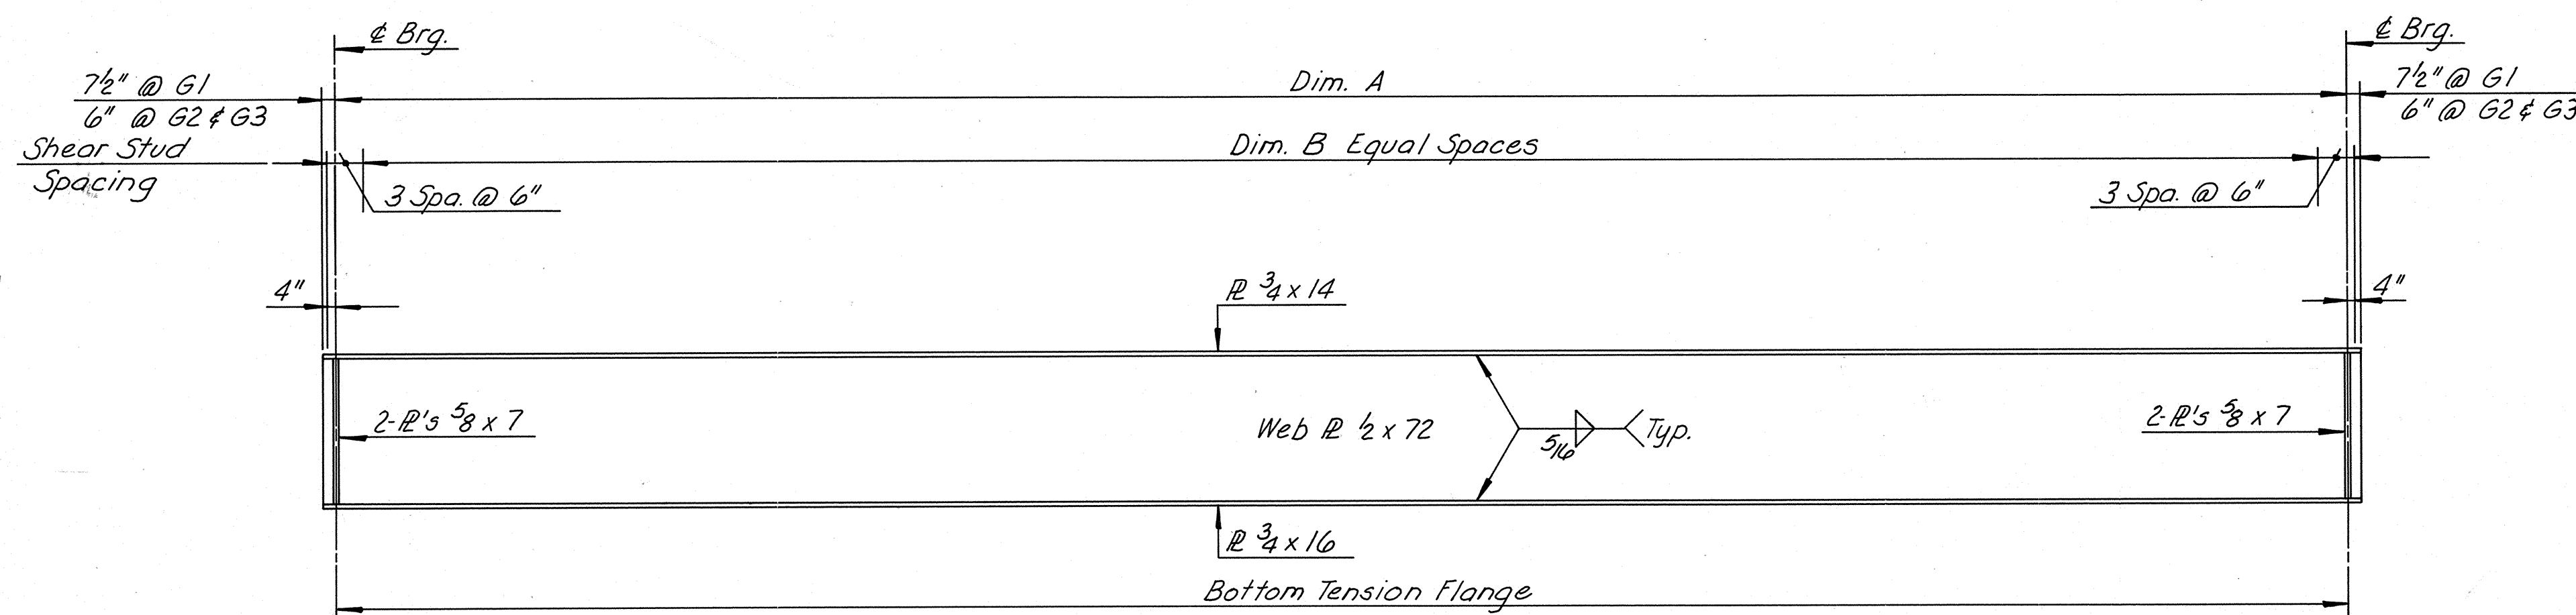

GIRDER ELEVATION-UNIT 13 SOUTHBOUND
Scale: $\frac{3}{16}'' = 1'-0''$

GIRDER	DIM. A	DIM. B
G1	79'-1 $\frac{3}{8}$ "	43
G2	81'-2 $\frac{1}{2}$ "	44
G3	83'-3 $\frac{3}{4}$ "	45

BY	DATE	NO.	REVISION	BY	DATE
MADE	EUM 1-87				
CHECKED	TFP 3-87		As Built	TEM	3-89
IN CHARGE	SR				

AS BUILT


RICHMOND METROPOLITAN AUTHORITY
RICHMOND EXPRESSWAY SYSTEM

FRAMING PLAN & GIRDER ELEVATION
UNIT 13 SOUTHBOUND


HOWARD, NEEDLES, TAMMEN & BERGENDOFF
consulting engineers
Alexandria, Virginia

SCALE: AS SHOWN
CONTRACT NO.: C-13
SHEET NO. 34 OF 106

NOTE:
For Steel Details, see Sheet No. 45

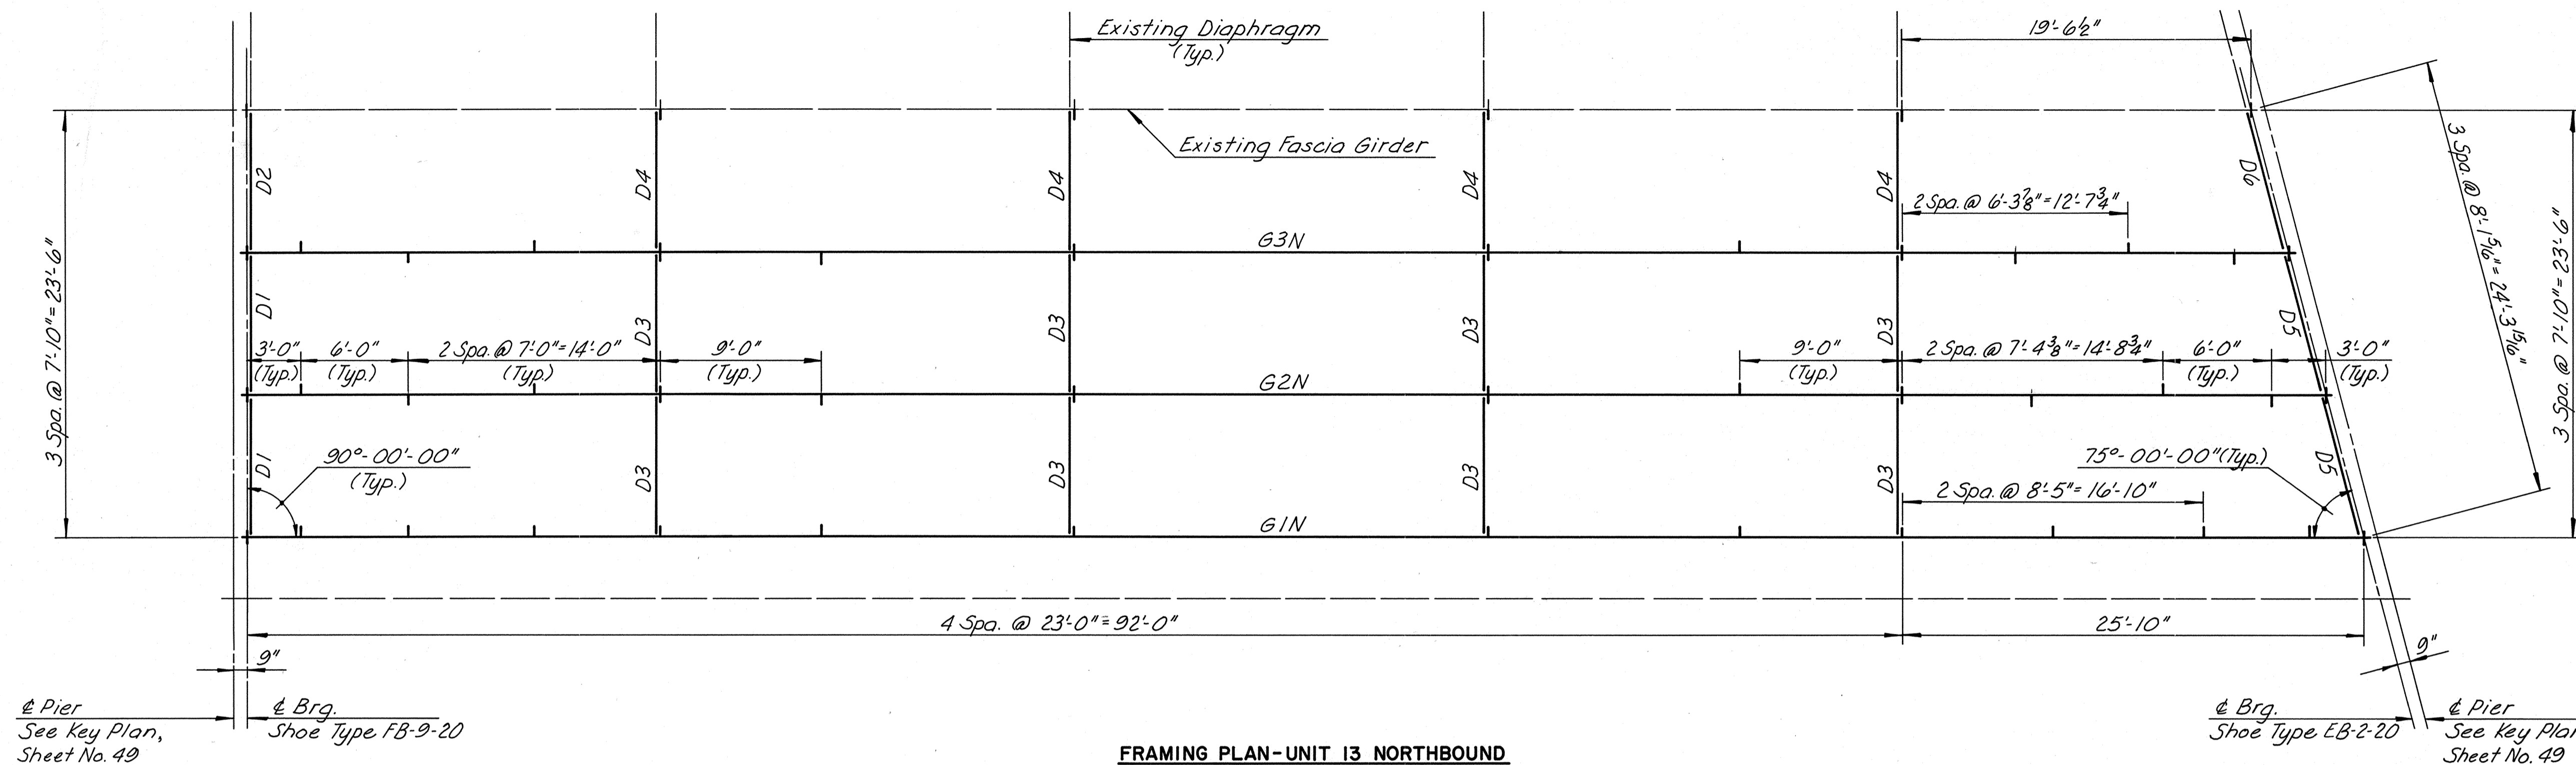

FRAMING PLAN-UNIT 13 NORTHBOUND
Scale: $\frac{3}{16}'' = 1'-0''$

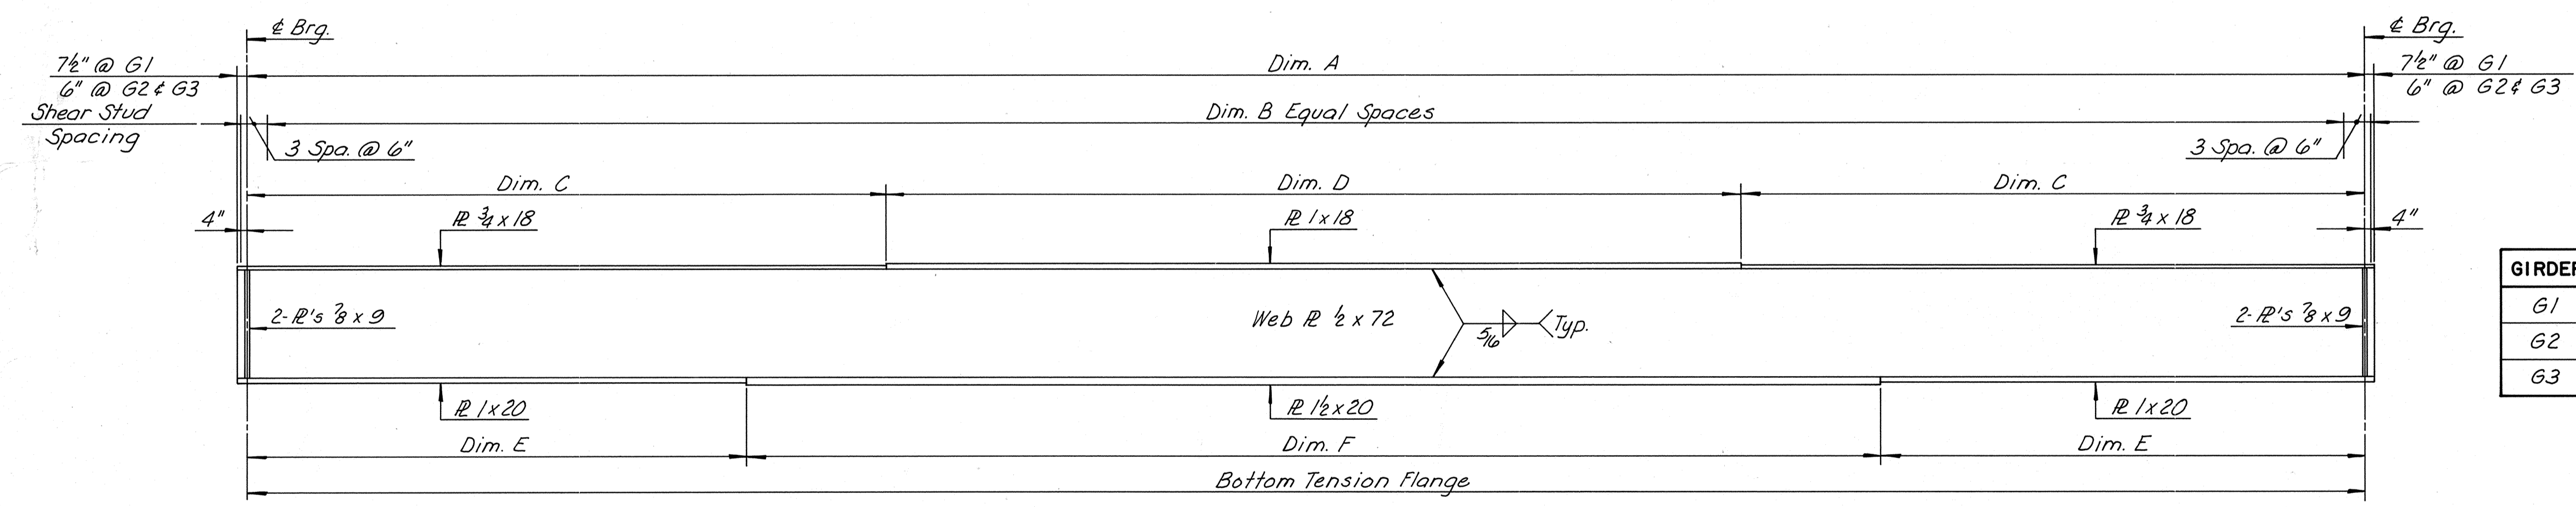

GIRDER ELEVATION-UNIT 13 NORTHBOUND
Scale: $\frac{3}{16}'' = 1'-0''$

GIRDER	DIM. A	DIM. B	DIM. C	DIM. D	DIM. E	DIM. F
G1	117'-10"	58	32'-11"	52'-0"	25'-8"	66'-6"
G2	115'-8 ³ / ₄ "	57	32'-1 ³ / ₈ "	51'-6"	24'-7 ³ / ₈ "	66'-6"
G3	113'-7 ³ / ₈ "	56	33'-9 ³ / ₁₆ "	46'-0"	25'-6 ³ / ₁₆ "	62'-6"

BY	DATE				
MADE	EJM	1-87			
CHECKED	TFP	3-87	As Built	TEM	3-89
IN CHARGE	SR				

AS BUILT

RICHMOND METROPOLITAN AUTHORITY
RICHMOND EXPRESSWAY SYSTEM


FRAMING PLAN & GIRDER ELEVATION
UNIT 13 NORTHBOUND

HOWARD, NEEDLES, TAMMEN & BERGENDOFF
consulting engineers
Alexandria, Virginia


SCALE: AS SHOWN
CONTRACT NO.: C-13
SHEET NO. 35 OF 106

RICHMOND EXPRESSWAY SYSTEM			
SECTION	PROJECT	SHEET NO.	TOTAL SHEETS
13	WIDENING JAMES RIVER BRIDGE	36	106

NOTE:
For Steel Details, see Sheet No. 45.

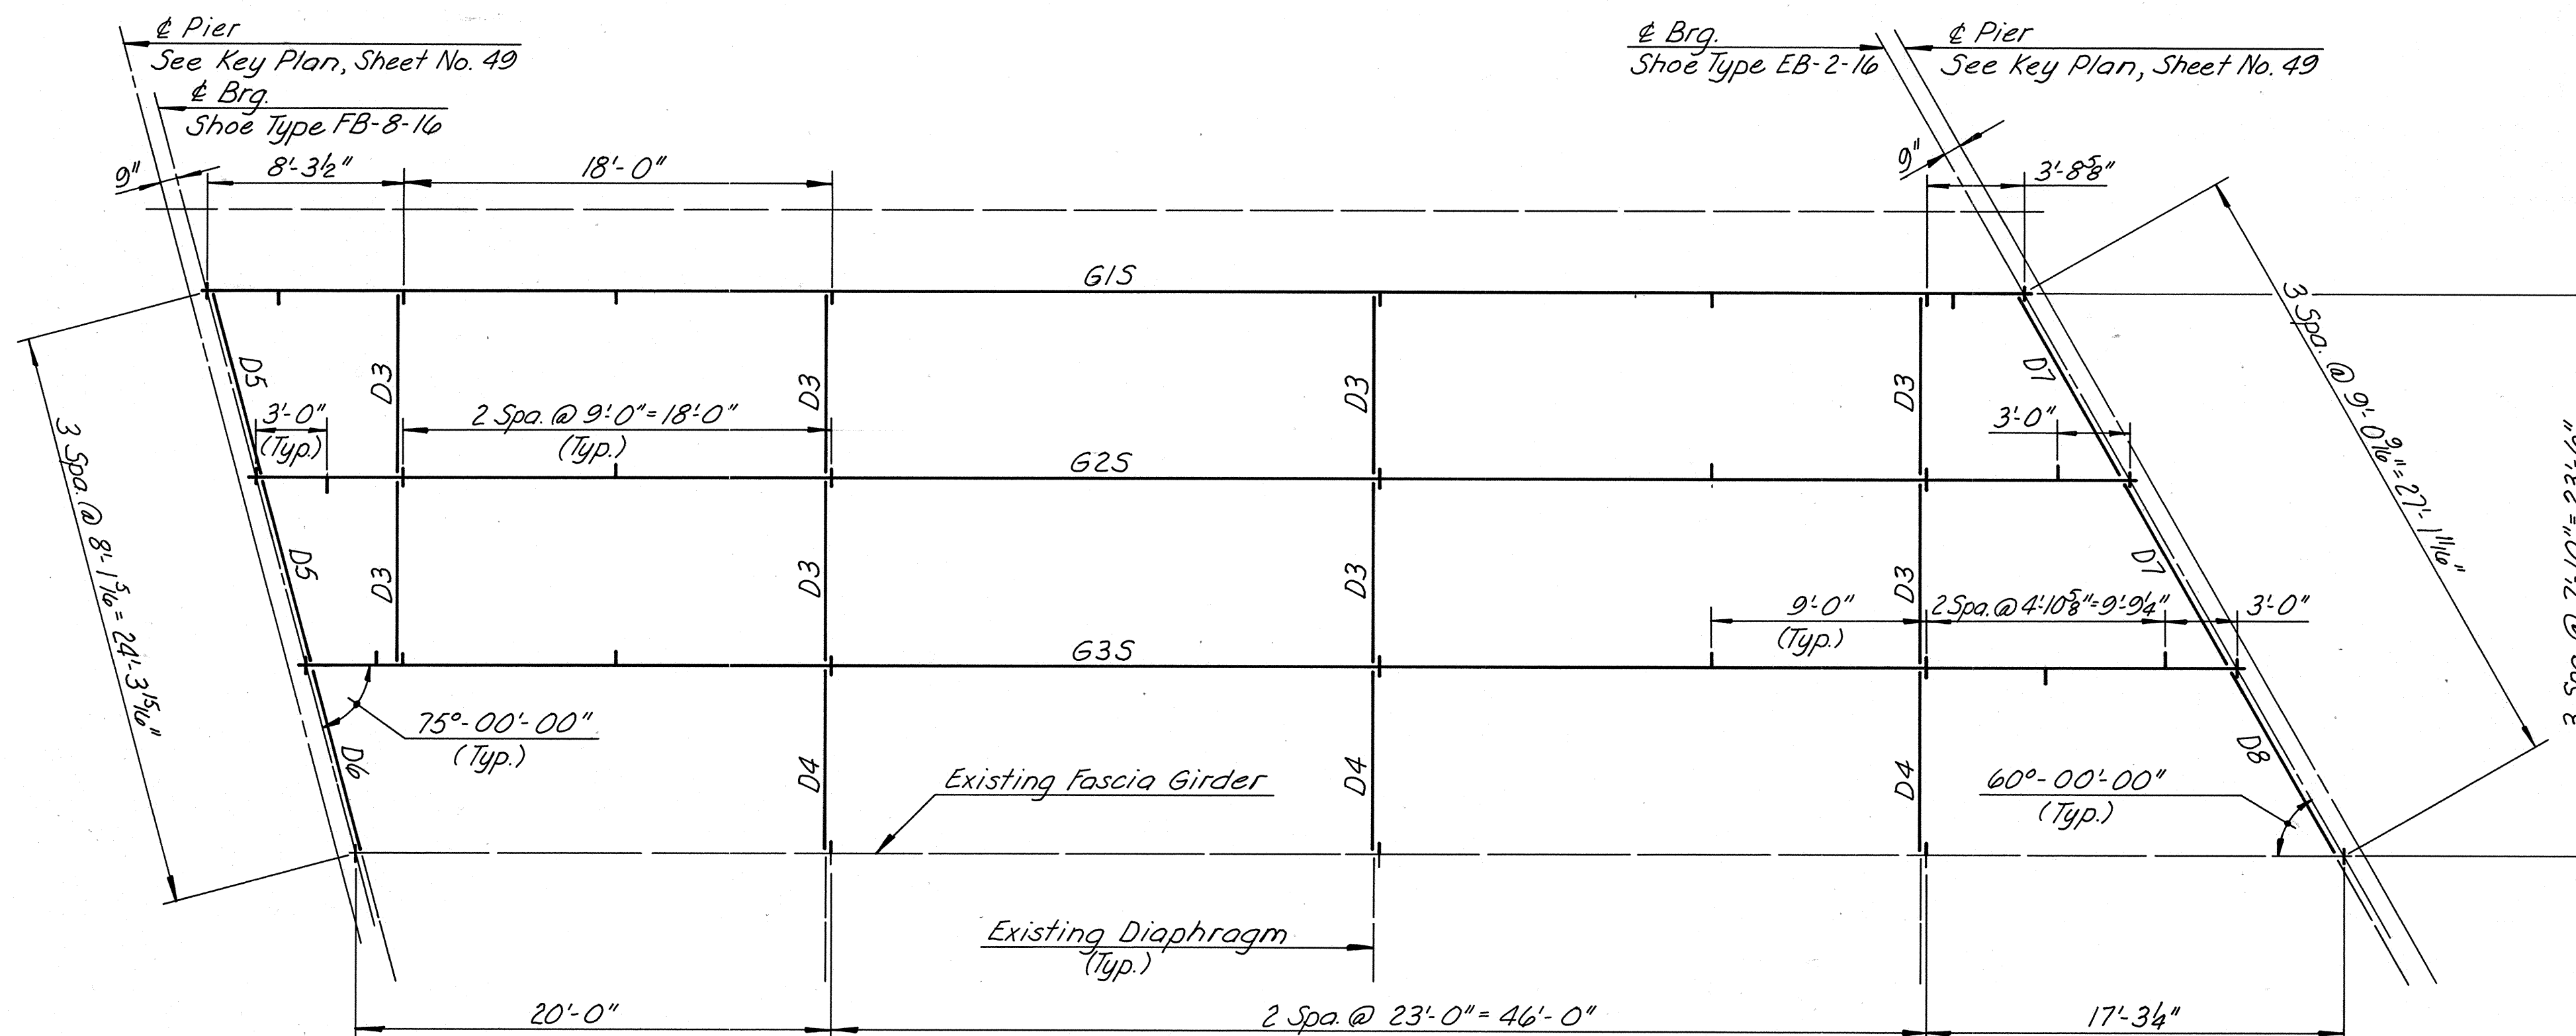

FRAMING PLAN - UNIT 14 SOUTHBOUND
Scale: $\frac{3}{16}'' = 1'-0''$

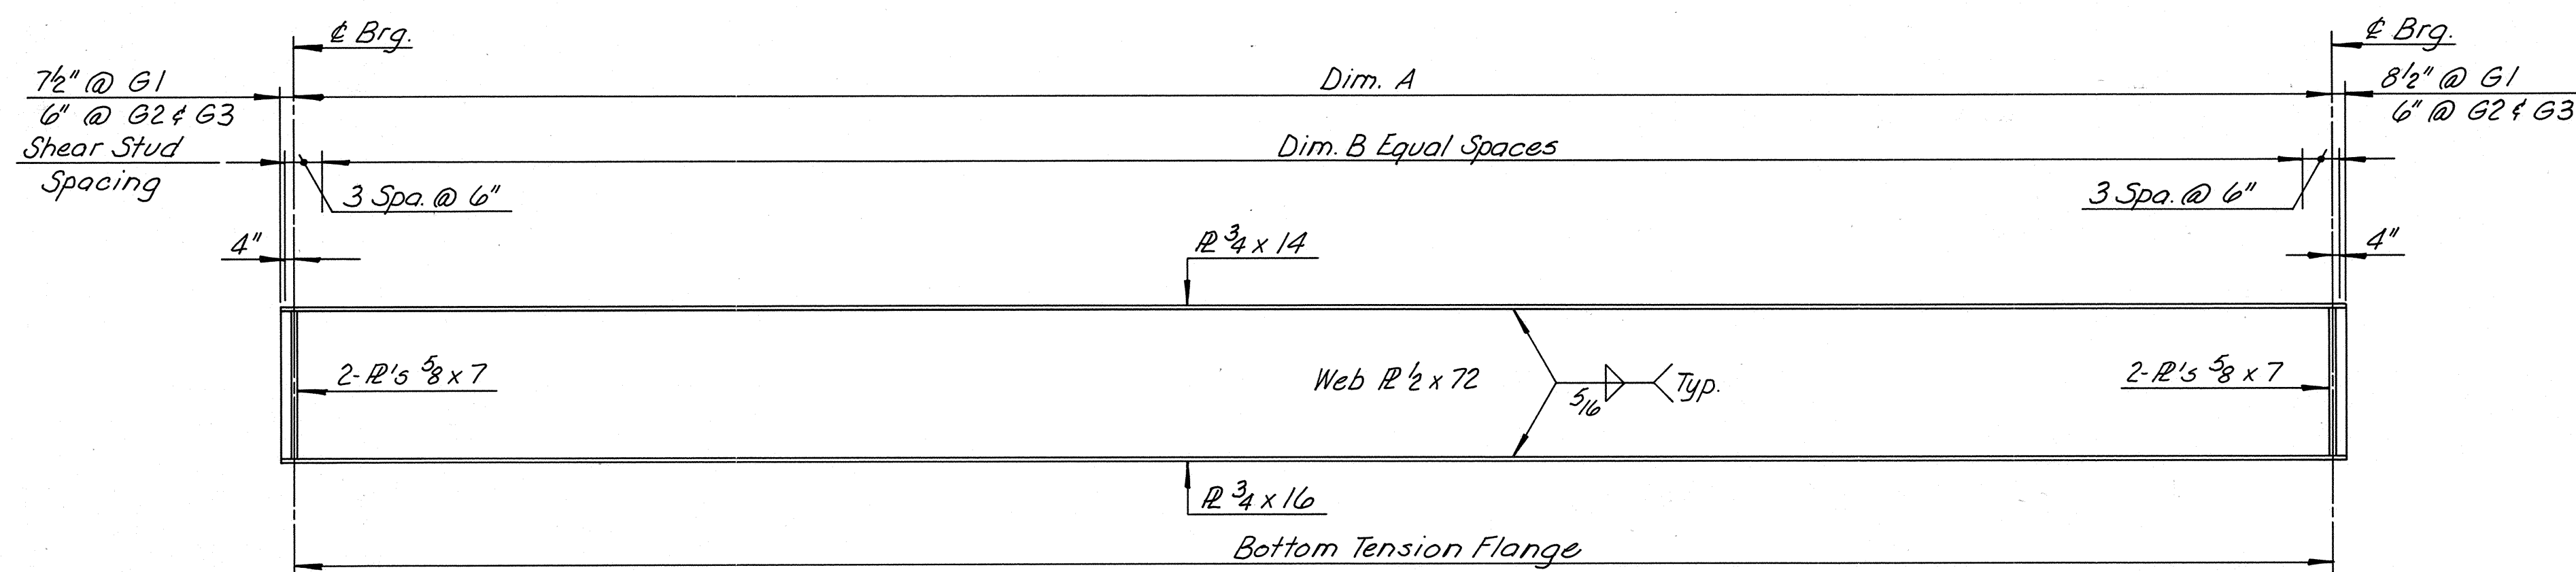

GIRDER ELEVATION - UNIT 14 SOUTHBOUND
Scale: $\frac{3}{16}'' = 1'-0''$

GIRDER	DIM. A	DIM. B
G1	76'-0"	43
G2	78'-5 1/2"	44
G3	80'-10 1/4"	46

BY	DATE	NO.	REVISION	BY	DATE
MADE	EJM 1-87				
CHECKED	TFP 3-87		A3 Built	TEM	3-89
IN CHARGE	SR				

AS BUILT

RICHMOND METROPOLITAN AUTHORITY
RICHMOND EXPRESSWAY SYSTEM


FRAMING PLAN & GIRDER ELEVATION
UNIT 14 SOUTHBOUND

HOWARD, NEEDLES, TAMMEN & BERGENDOFF
consulting engineers
Alexandria, Virginia


SCALE: AS SHOWN
CONTRACT NO.: C-13
SHEET NO. 36 OF 106

RICHMOND EXPRESSWAY SYSTEM			
SECTION	PROJECT	SHEET NO.	TOTAL SHEETS
13	WIDENING JAMES RIVER BRIDGE	37	106

NOTE:
For Steel Details, see Sheet No. 45.

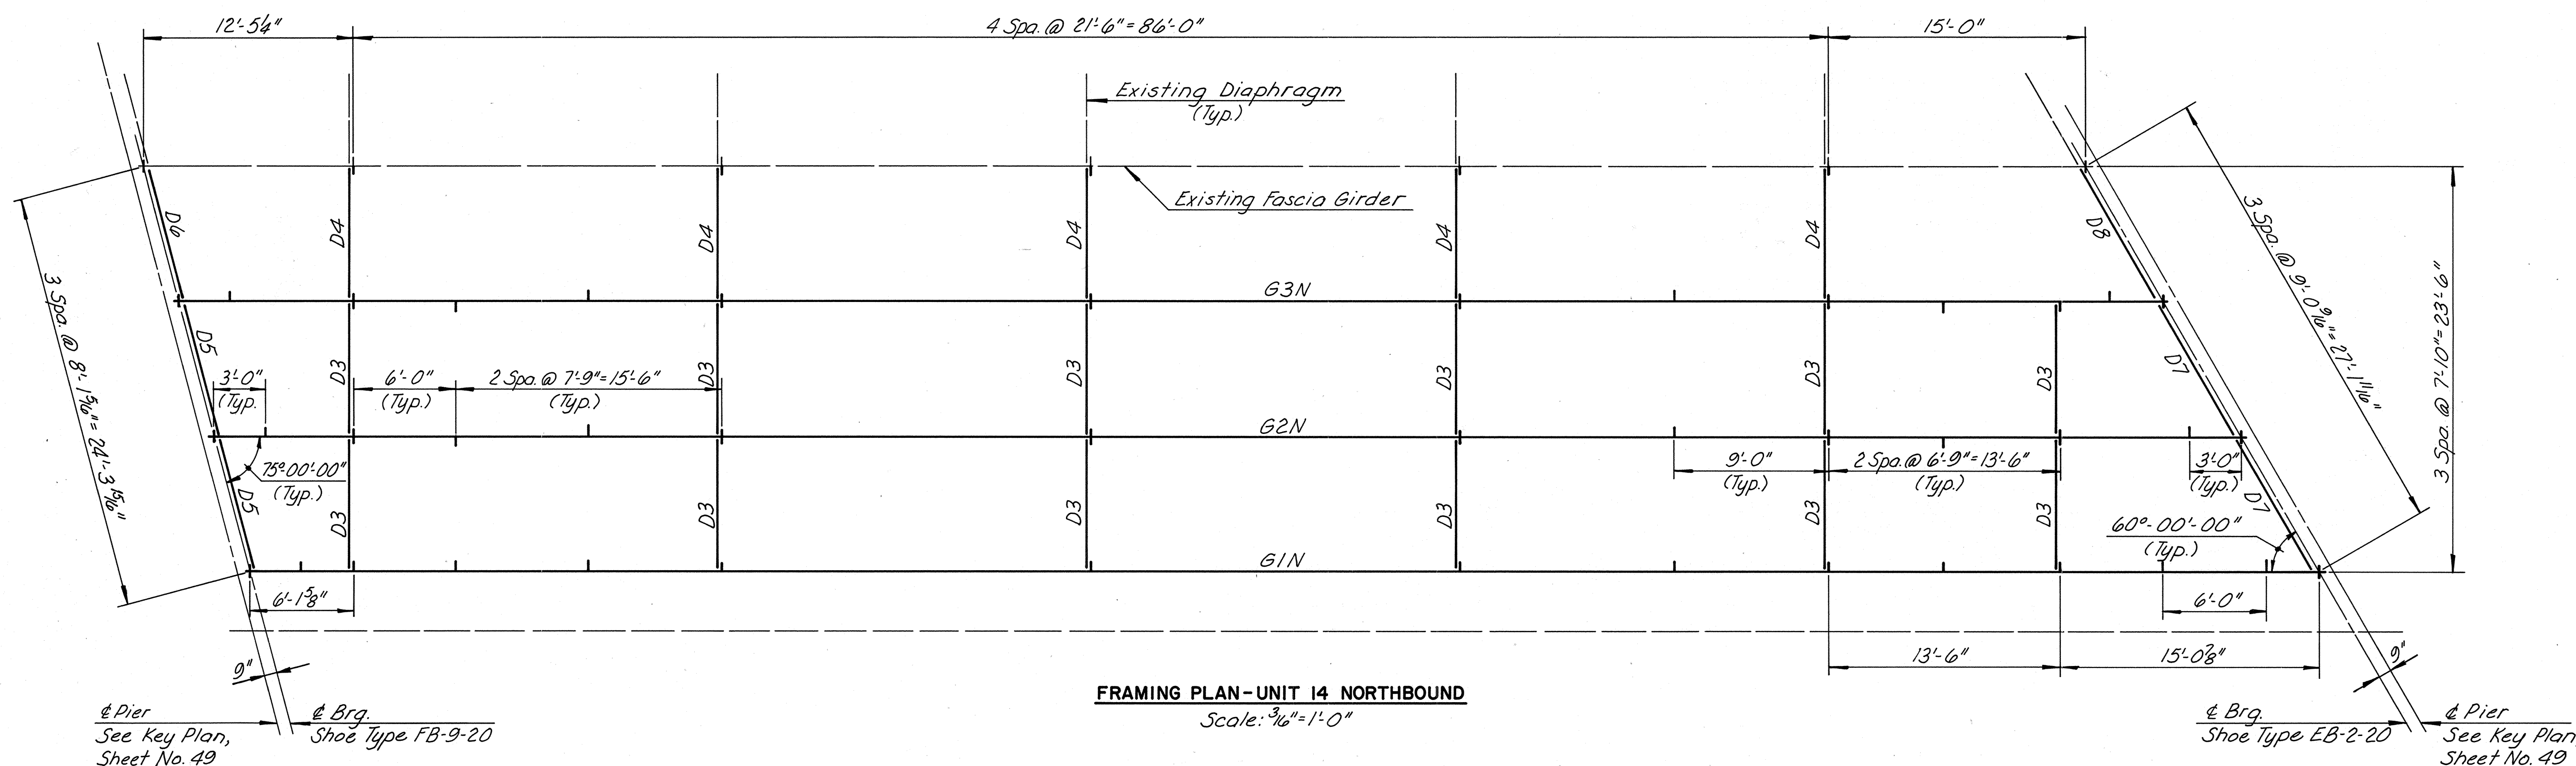

FRAMING PLAN-UNIT 14 NORTHBOUND
Scale: 3/16"=1'-0"

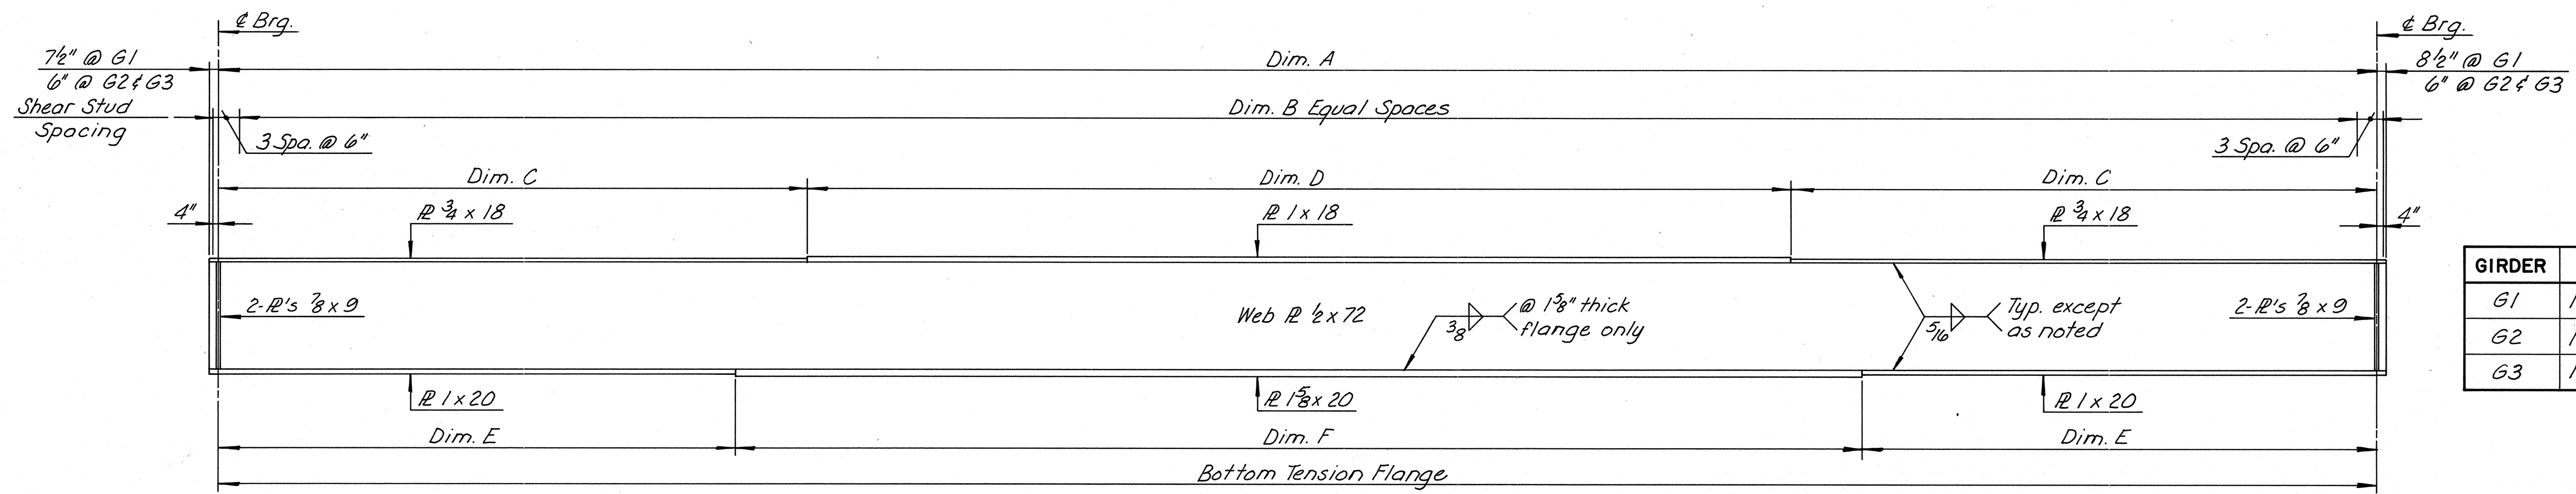

GIRDER ELEVATION-UNIT 14 NORTHBOUND
Scale: 3/16"=1'-0"

GIRDER	DIM. A	DIM. B	DIM. C	DIM. D	DIM. E	DIM. F
G1	120'-8 1/2"	60	32'-10 1/4"	55'-0"	26'-1 1/4"	68'-6"
G2	118'-3 1/2"	59	30'-10 3/4"	56'-6"	26'-7 3/4"	65'-0"
G3	115'-10 3/8"	58	31'-11 3/16"	52'-0"	24'-8 3/16"	66'-6"

BY	DATE				
MADE	EJM	1-87			
CHECKED	JFP	3-87	As Built	TEM	3-89
IN CHARGE	SR				

AS BUILT


RICHMOND METROPOLITAN AUTHORITY
RICHMOND EXPRESSWAY SYSTEM

FRAMING PLAN & GIRDER ELEVATION
UNIT 14 NORTHBOUND


HOWARD, NEEDLES, TAMMEN & BERGENDOFF
consulting engineers
Alexandria, Virginia

SCALE: AS SHOWN
CONTRACT NO.: C-13
SHEET NO. 37 OF 106

RICHMOND EXPRESSWAY SYSTEM			
SECTION	PROJECT	SHEET NO.	TOTAL SHEETS
13	WIDENING JAMES RIVER BRIDGE	38	106

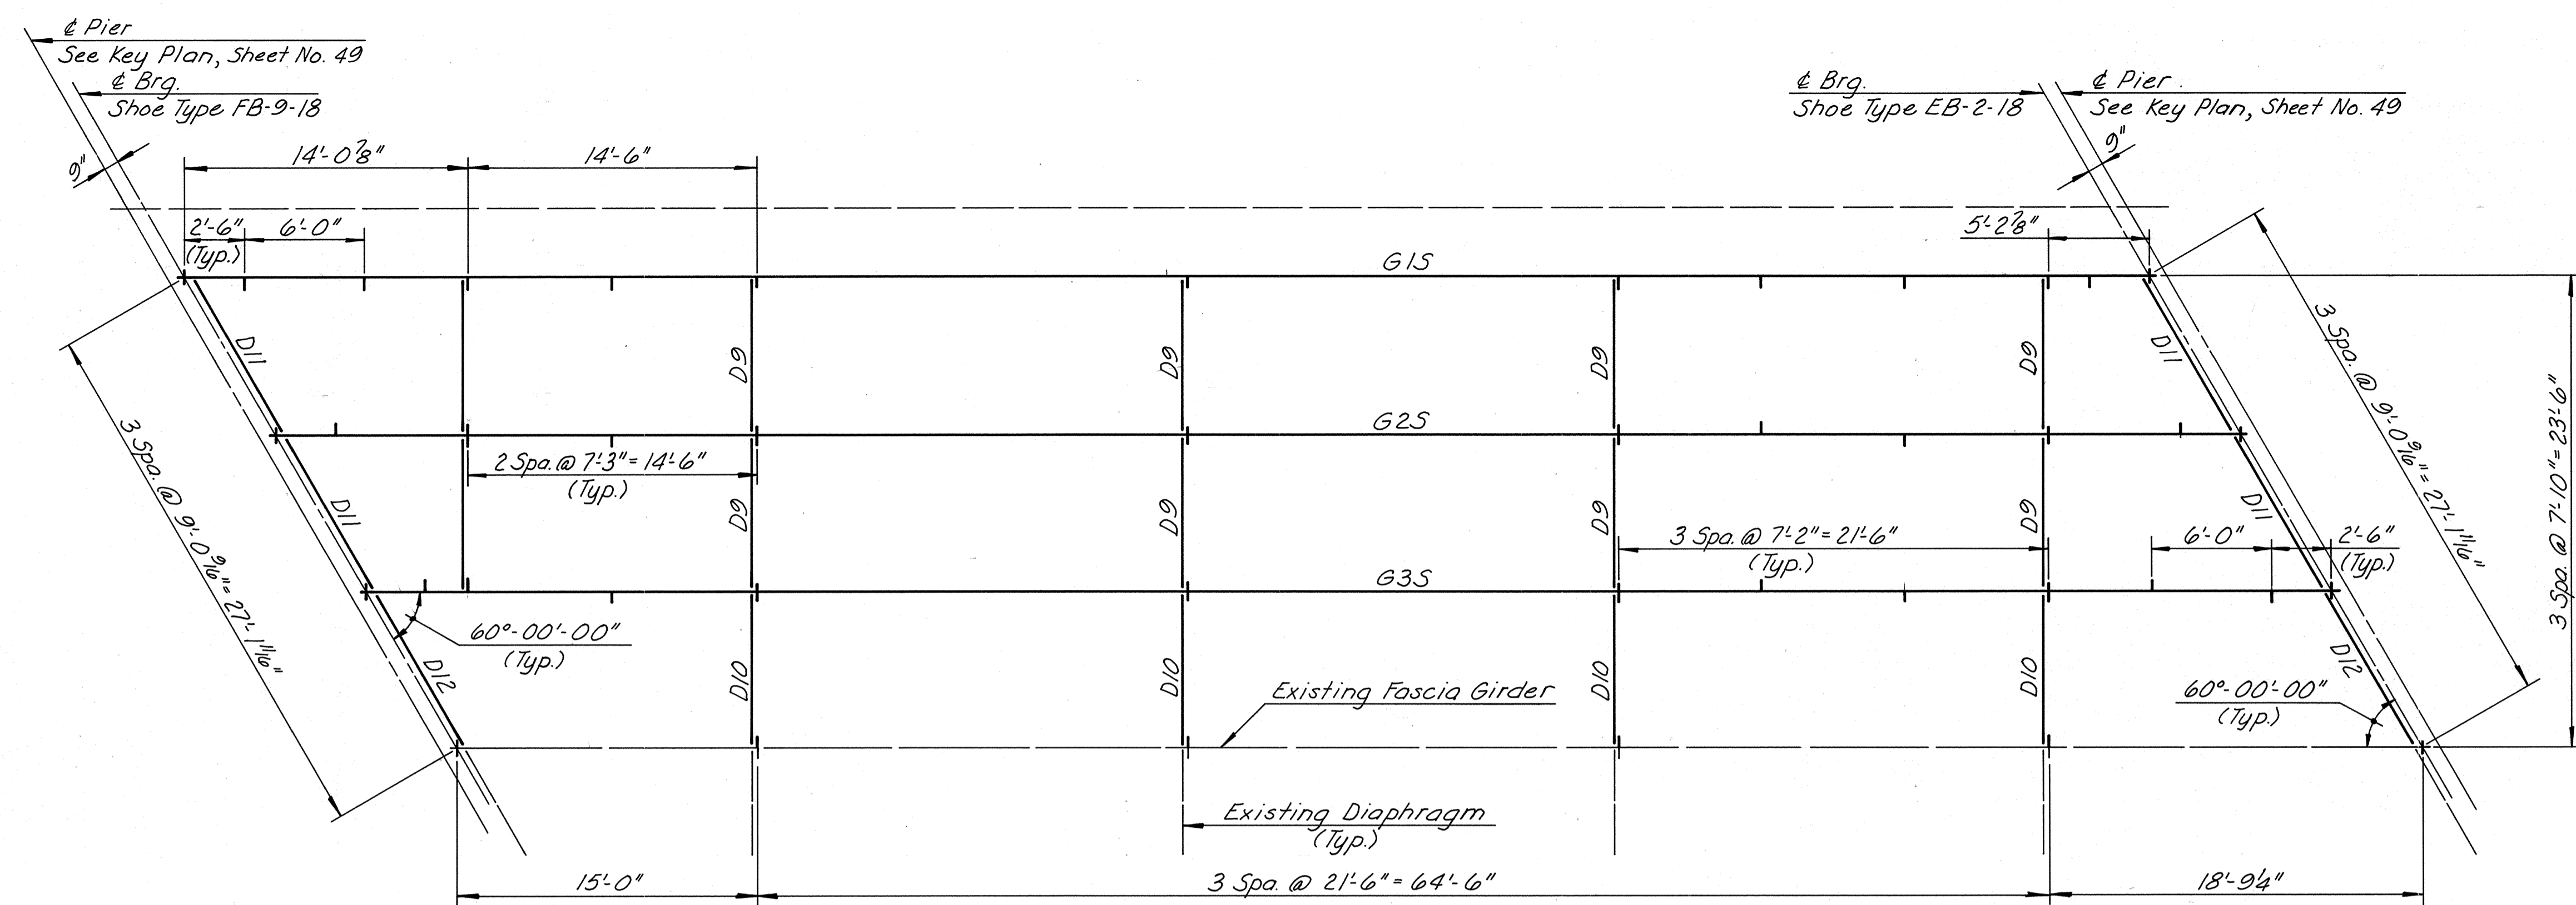


△ **FRAMING PLAN-UNIT 15 SOUTHBOUND**
Scale: 3/16" = 1'-0"

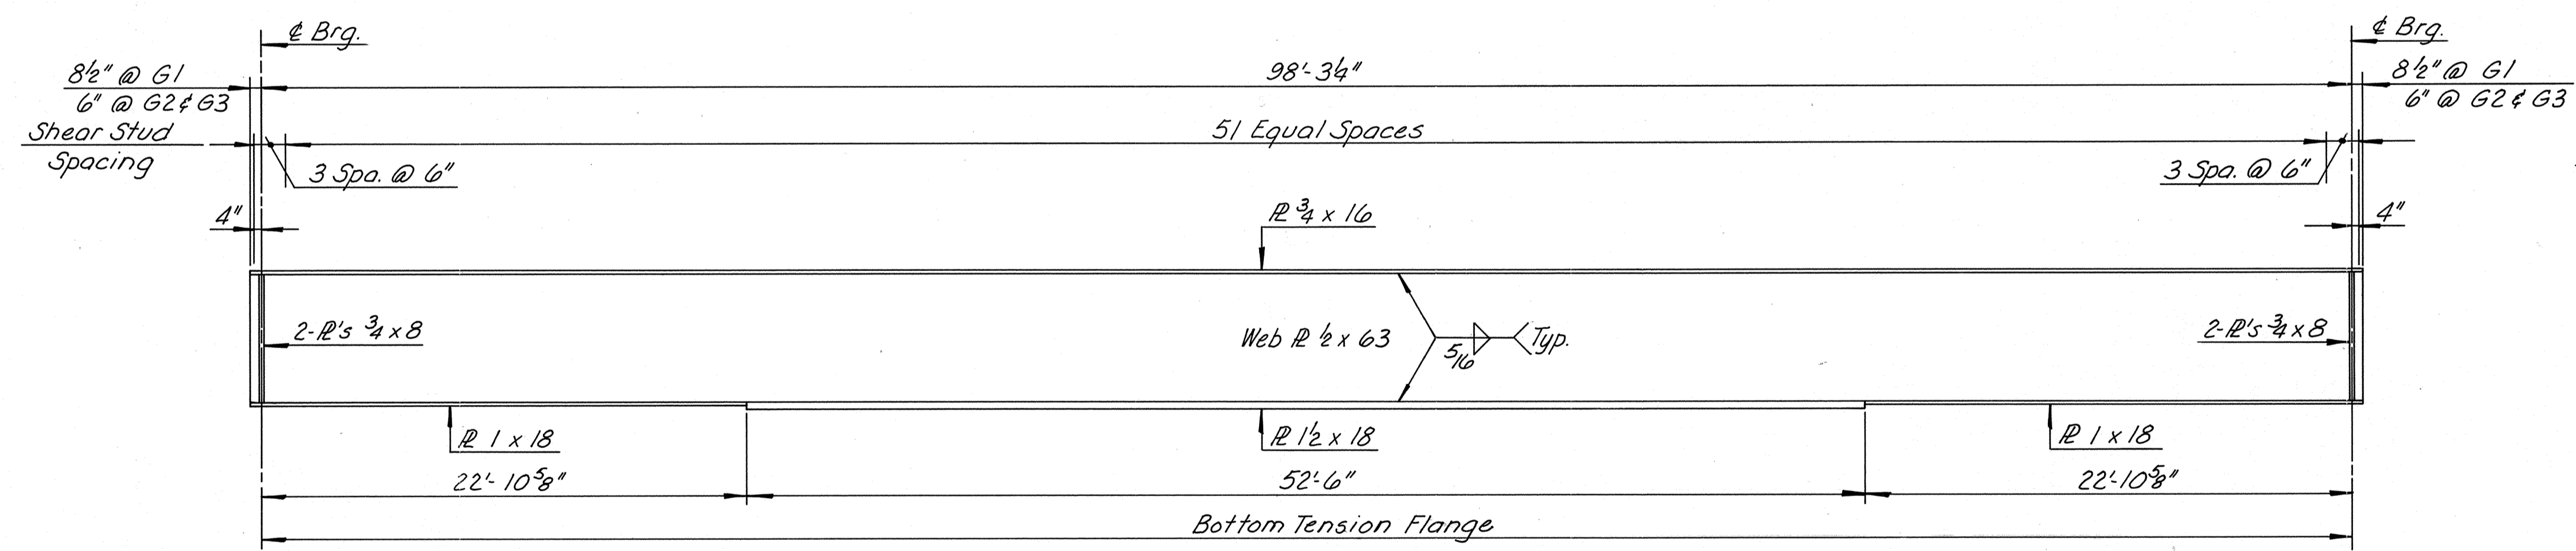


△ **GIRDER ELEVATION-UNIT 15 SOUTHBOUND**
Scale: 3/16" = 1'-0"

NOTE:
For Section A-A, see Sheet No. 45.
For Diaphragms 11 & 12, see Sheet No. 39.
For Additional Steel Details, see Sheet No. 45.

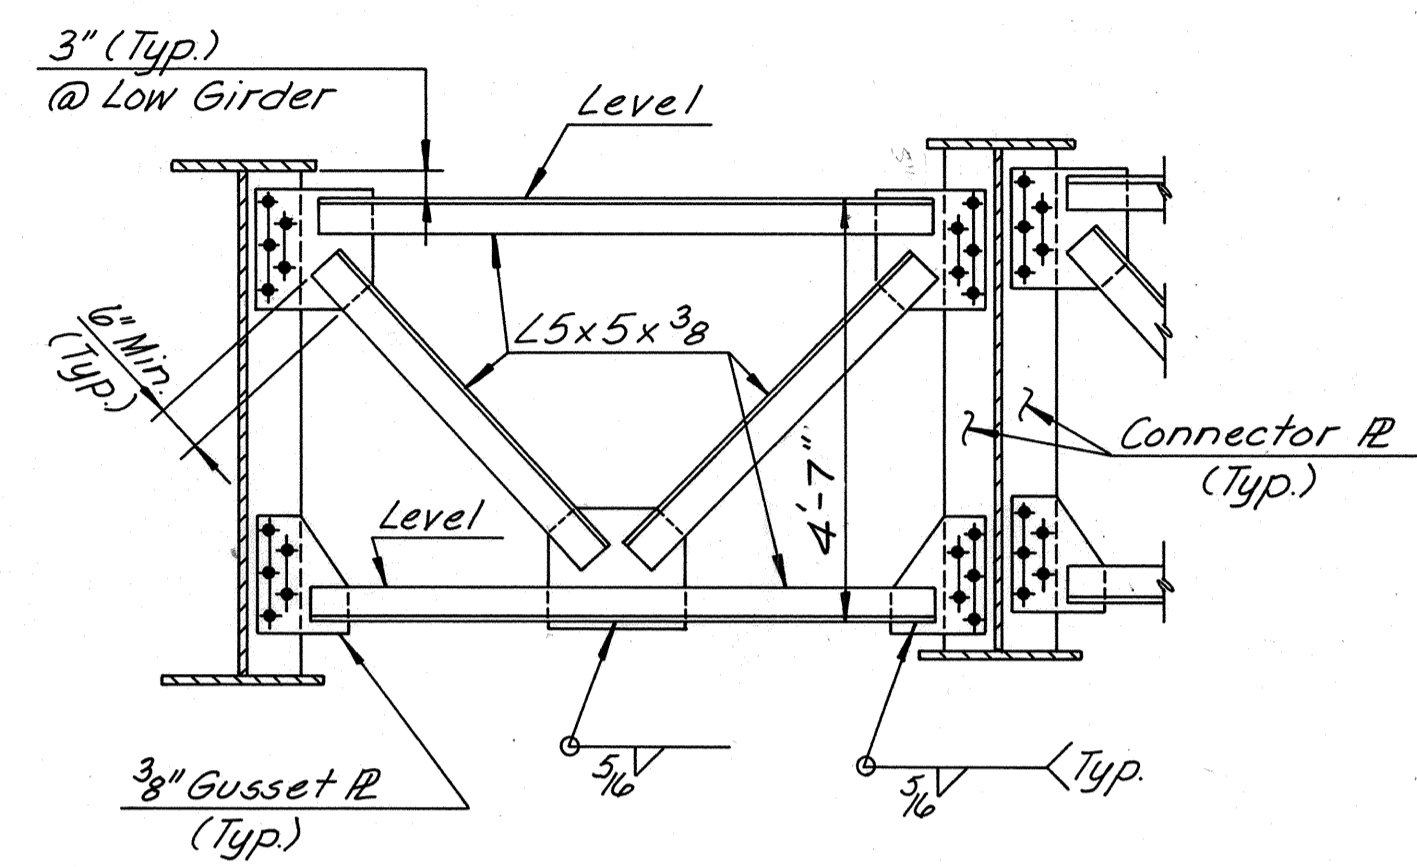

△ **INTERMEDIATE DIAPHRAGM D9**
Scale: 1/2" = 1'-0"

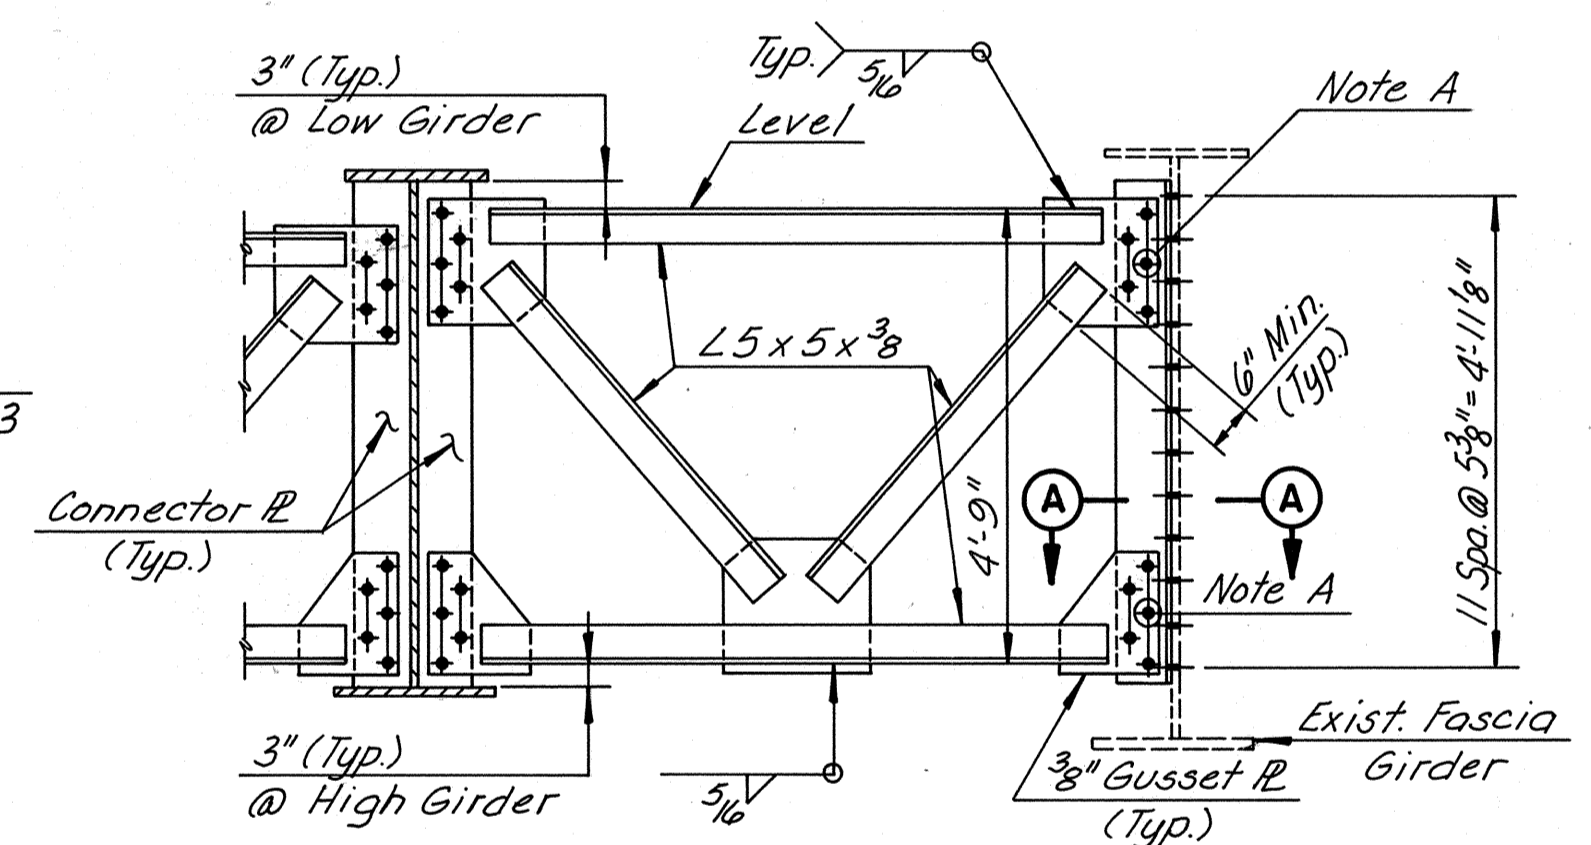

△ **INTERMEDIATE DIAPHRAGM D10**
Scale: 1/2" = 1'-0"

BY	DATE	NO.	REVISION	BY	DATE
MADE	EJM 1-87		As Built	TEM	3-89
CHECKED	TFP 3-87	△	DIAPHRAGM & GIRDER REV.	EJM	5-87
IN CHARGE	SR				

AS BUILT


RICHMOND METROPOLITAN AUTHORITY
RICHMOND EXPRESSWAY SYSTEM

FRAMING PLAN & GIRDER ELEVATION
UNIT 15 SOUTHBOUND

HOWARD, NEEDLES, TAMMEN & BERGENDOFF
consulting engineers
Alexandria, Virginia


SCALE: AS SHOWN
CONTRACT NO.: C-13
SHEET NO. 38 OF 106

RICHMOND EXPRESSWAY SYSTEM			
SECTION	PROJECT	SHEET NO.	TOTAL SHEETS
13	WIDENING JAMES RIVER BRIDGE	39	106

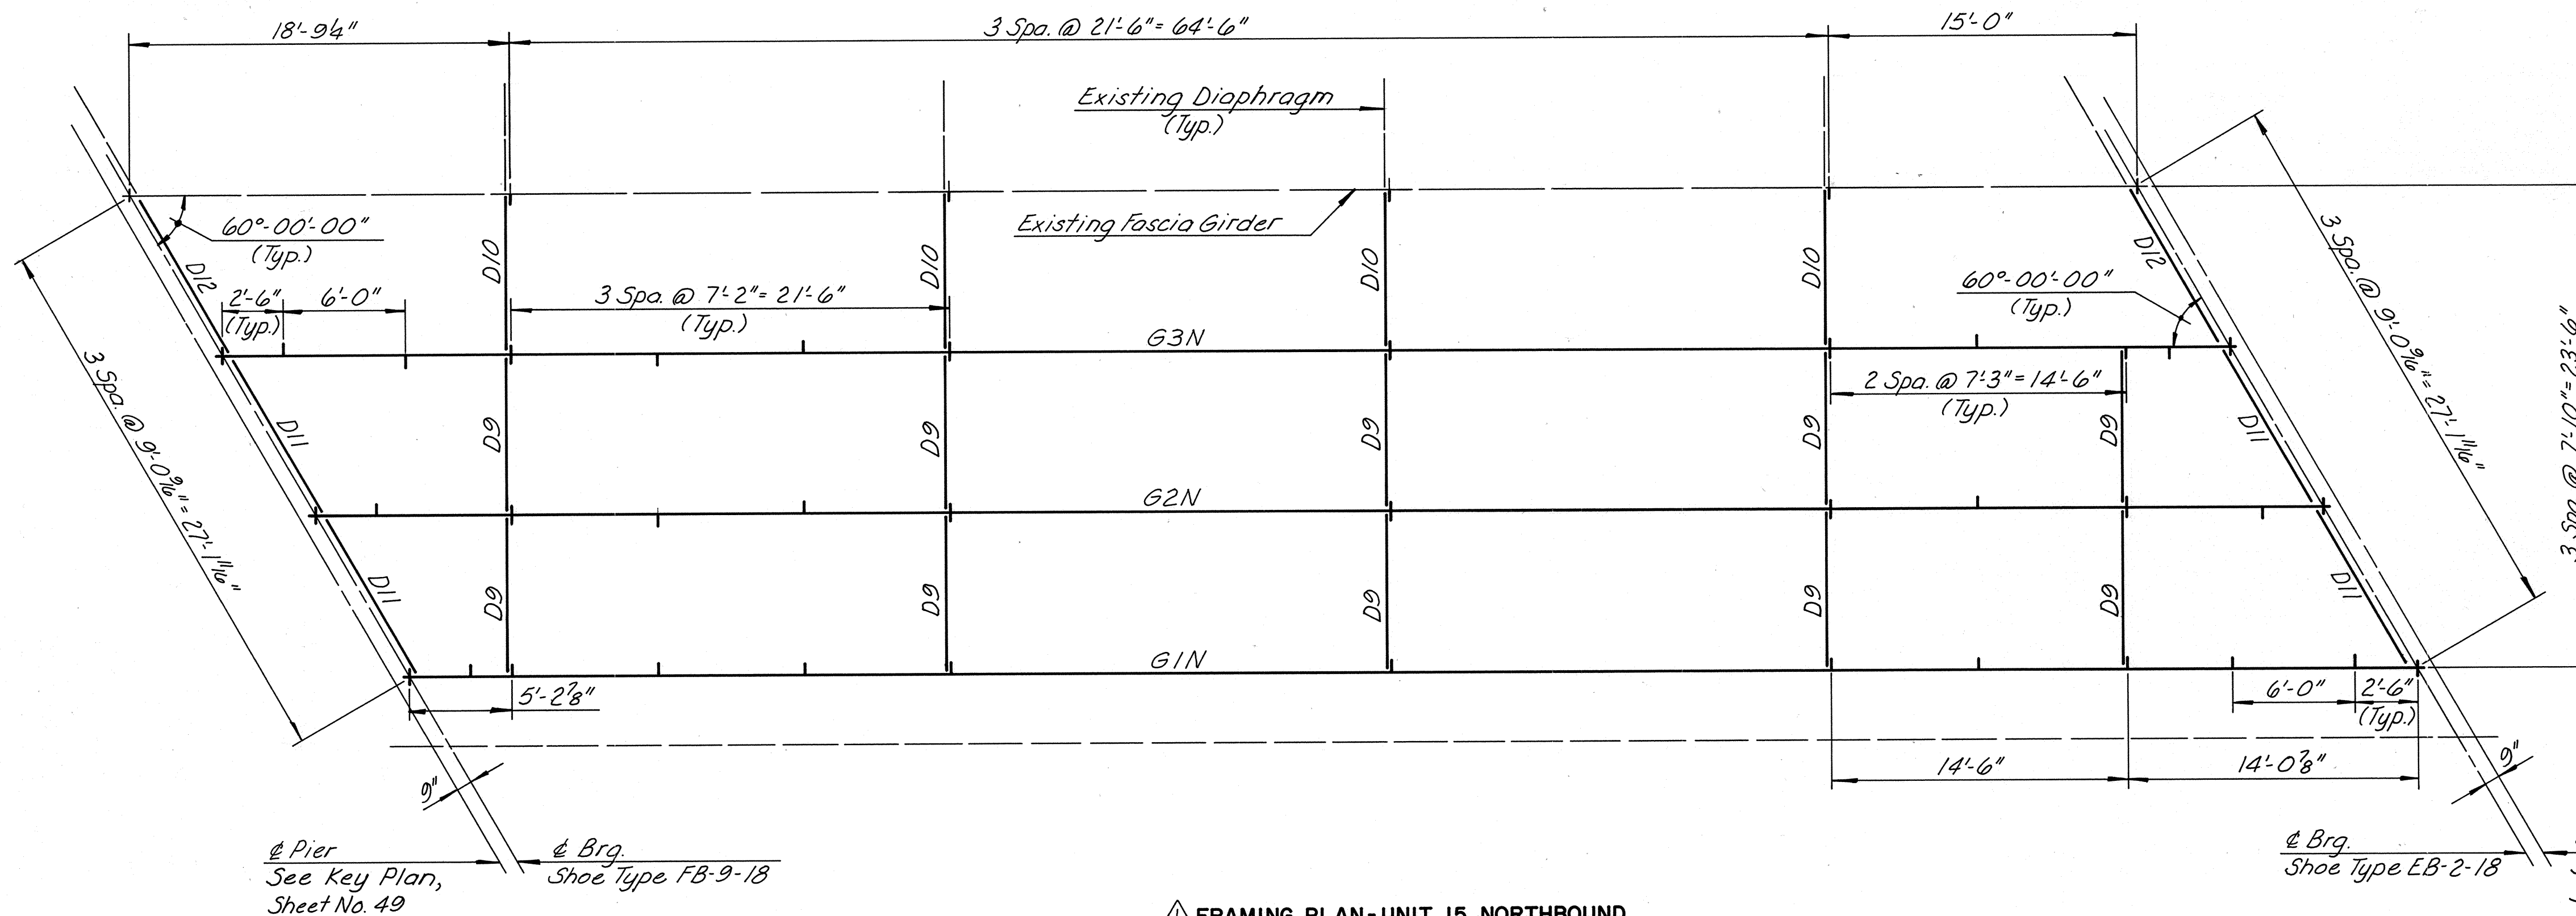


△ FRAMING PLAN - UNIT 15 NORTHBOUND
Scale: 3/16" = 1'-0"


NOTE:
For Steel Details, see Sheet No. 45.

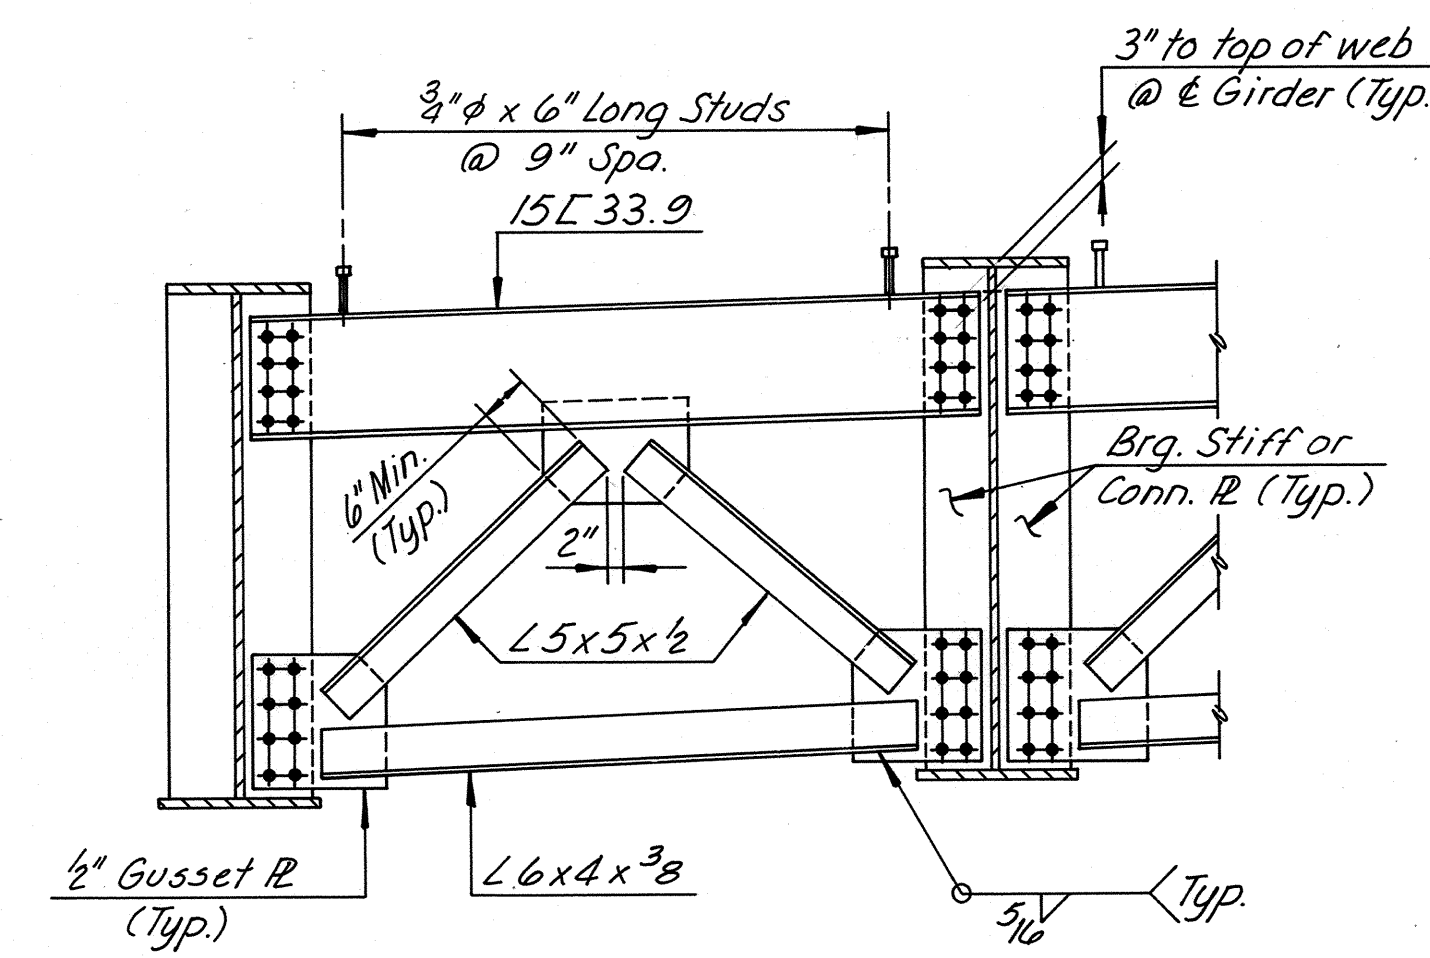

△ END DIAPHRAGM D11
Scale: 1/2" = 1'-0"

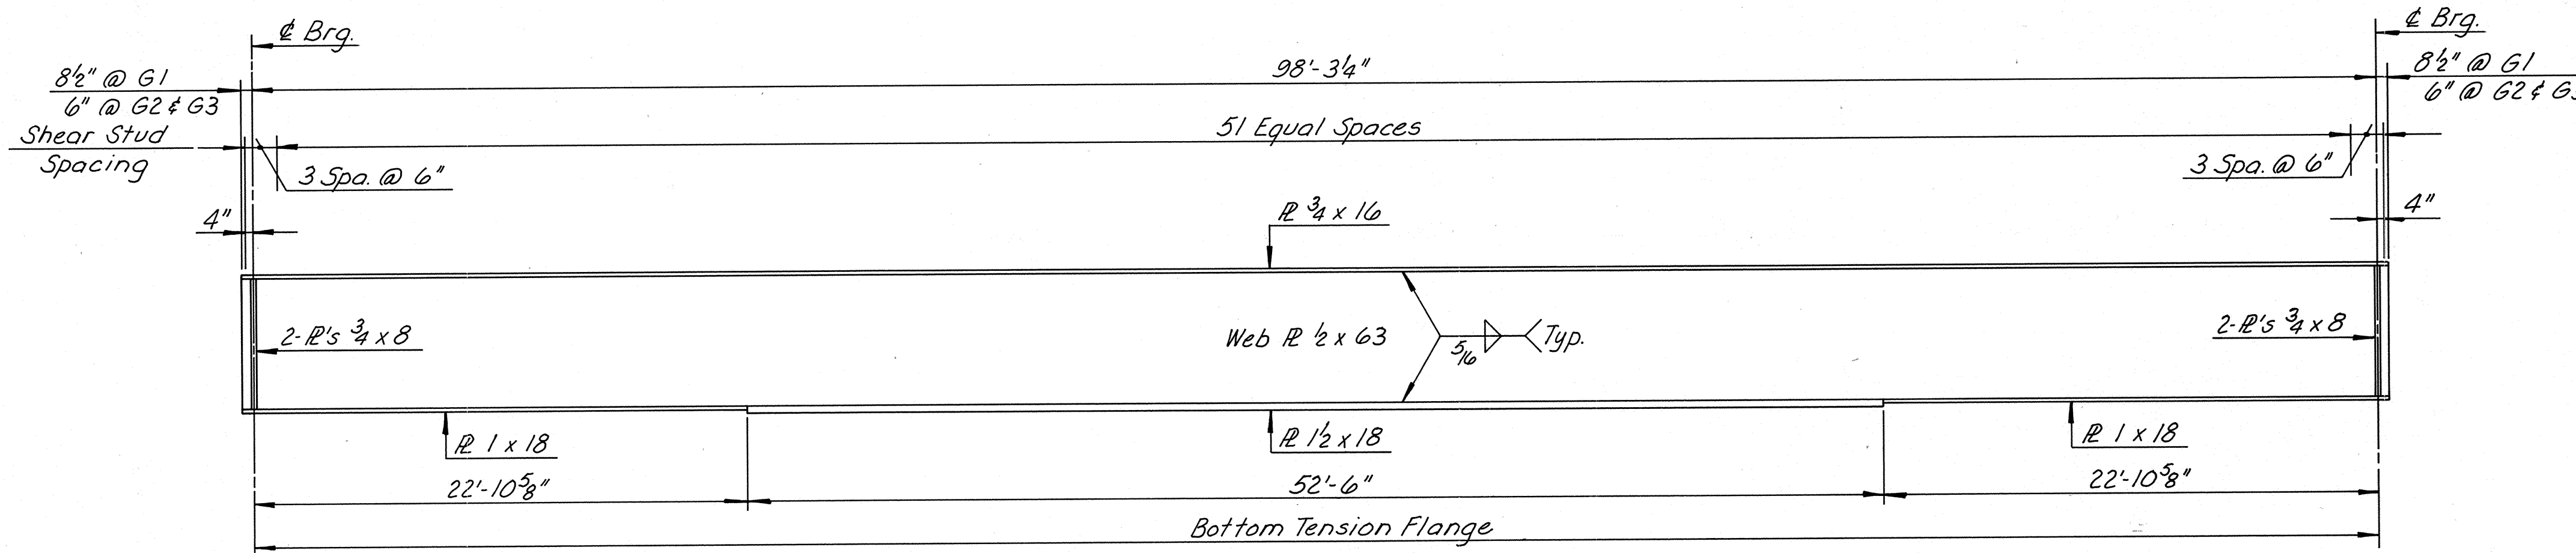

△ GIRDER ELEVATION - UNIT 15 NORTHBOUND
Scale: 3/16" = 1'-0"

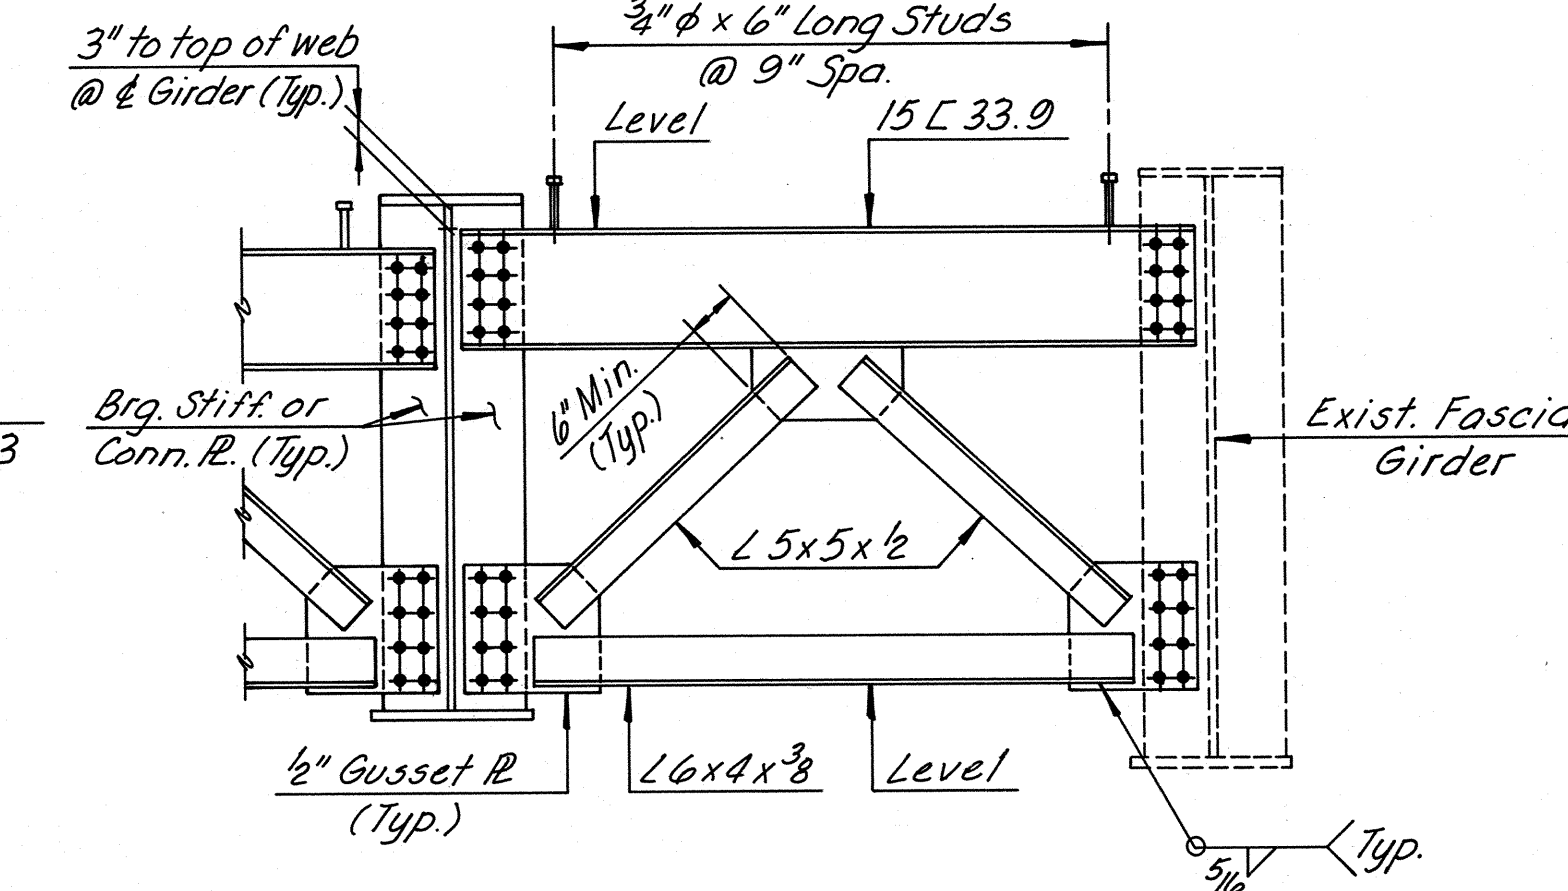

△ END DIAPHRAGM D12
Scale: 1/2" = 1'-0"

BY	DATE	NO.	REVISION	BY	DATE
MADE	EJM	1-87			
CHECKED	TFP	3-87	Rev. Diaph. & Girder	EJM	5-87
IN CHARGE	SR				


AS BUILT

RICHMOND METROPOLITAN AUTHORITY
RICHMOND EXPRESSWAY SYSTEM

FRAMING PLAN & GIRDER ELEVATION
UNIT 15 NORTHBOUND


SCALE: AS SHOWN
HOWARD, NEEDLES, TAMMEN & BERGENDOFF
consulting engineers
Alexandria, Virginia
CONTRACT NO.: C-13
SHEET NO. 39 of 106

RICHMOND EXPRESSWAY SYSTEM			
SECTION	PROJECT	SHEET NO.	TOTAL SHEETS
13	WIDENING JAMES RIVER BRIDGE	40	106

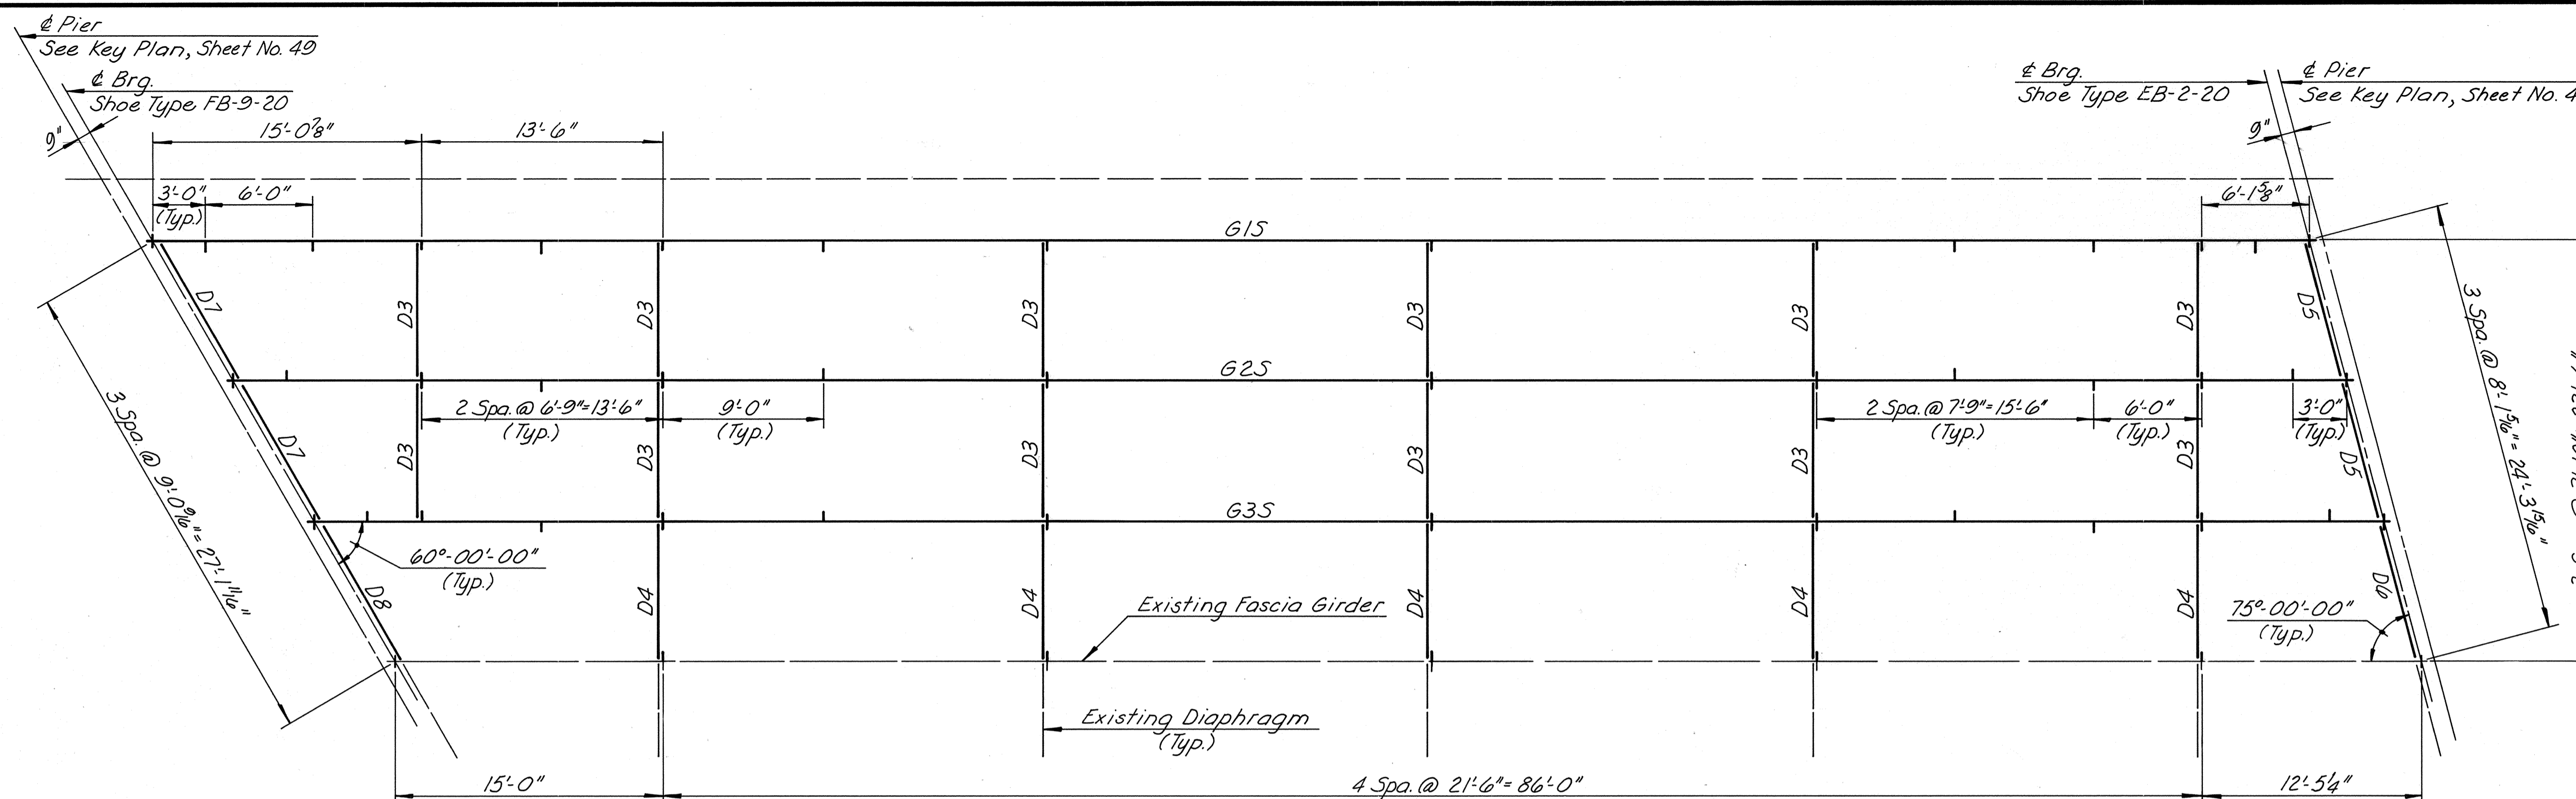

FRAMING PLAN - UNIT 16 SOUTHBOUND
Scale: 3/16" = 1'-0"

NOTE:
For Steel Details, see Sheet No. 45.

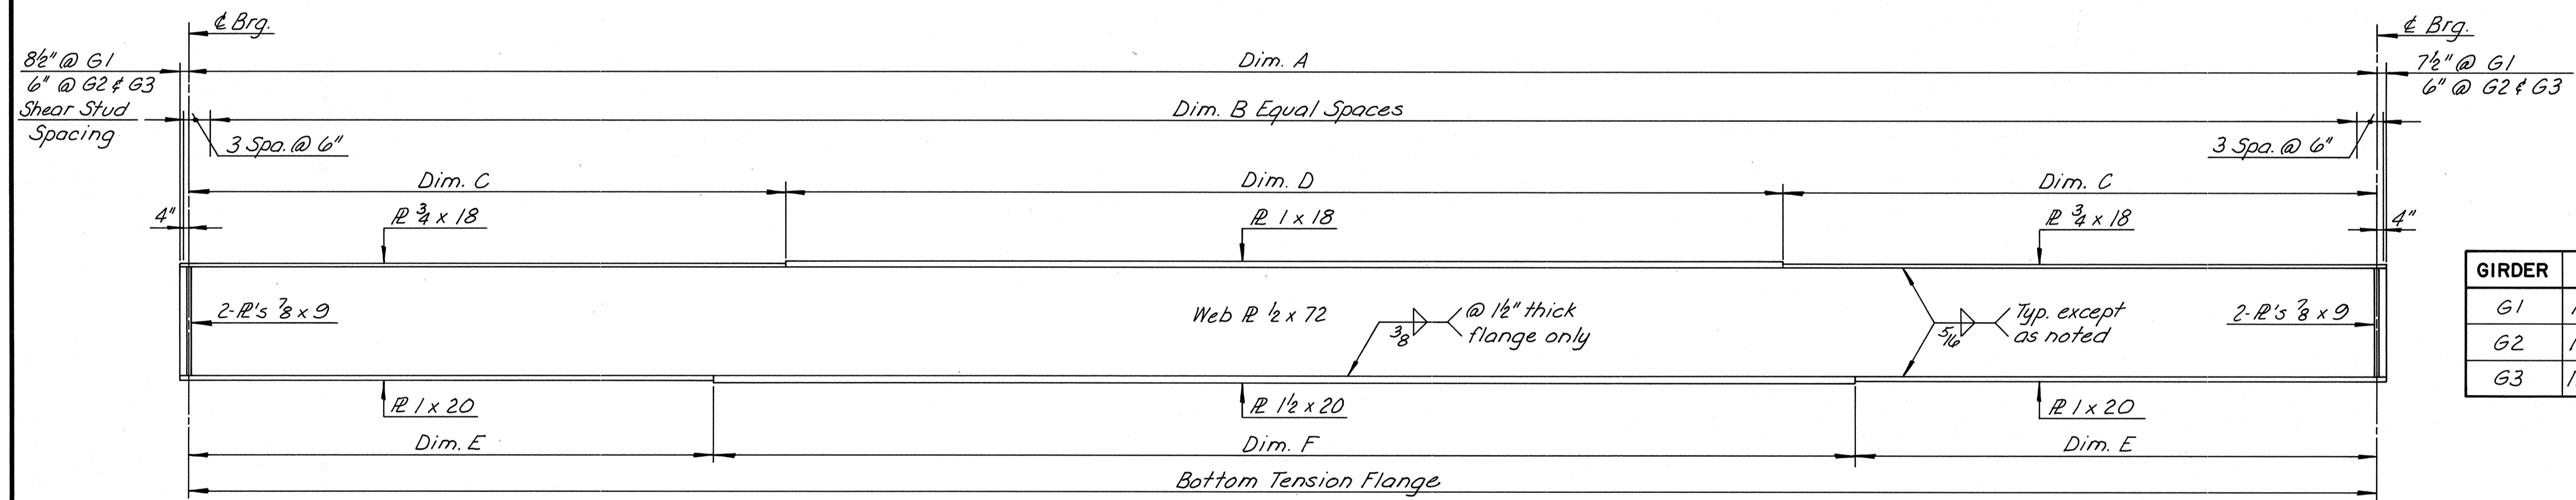

GIRDER ELEVATION - UNIT 16 SOUTHBOUND
Scale: 3/16" = 1'-0"

GIRDER	DIM. A	DIM. B	DIM. C	DIM. D	DIM. E	DIM. F
G1	120'-8 1/2"	60	32'-10 1/4"	55'-0"	26'-1 1/4"	68'-6"
G2	118'-3 1/2"	59	30'-10 3/4"	56'-6"	26'-7 3/4"	65'-0"
G3	115'-10 3/8"	58	31'-11 3/16"	52'-0"	24'-8 3/16"	66'-6"

BY	DATE	NO.	REVISION	BY	DATE
MADE	EJM 1-87				
CHECKED	TFP 3-87		As Built	TEM	3-89
IN CHARGE	SR				


AS BUILT

RICHMOND METROPOLITAN AUTHORITY
RICHMOND EXPRESSWAY SYSTEM


FRAMING PLAN & GIRDER ELEVATION
UNIT 16 SOUTHBOUND

HOWARD, NEEDLES, TAMMEN & BERGENDOFF
consulting engineers
Alexandria, Virginia

SCALE: AS SHOWN
CONTRACT NO.: C-13
SHEET NO. 40 OF 106

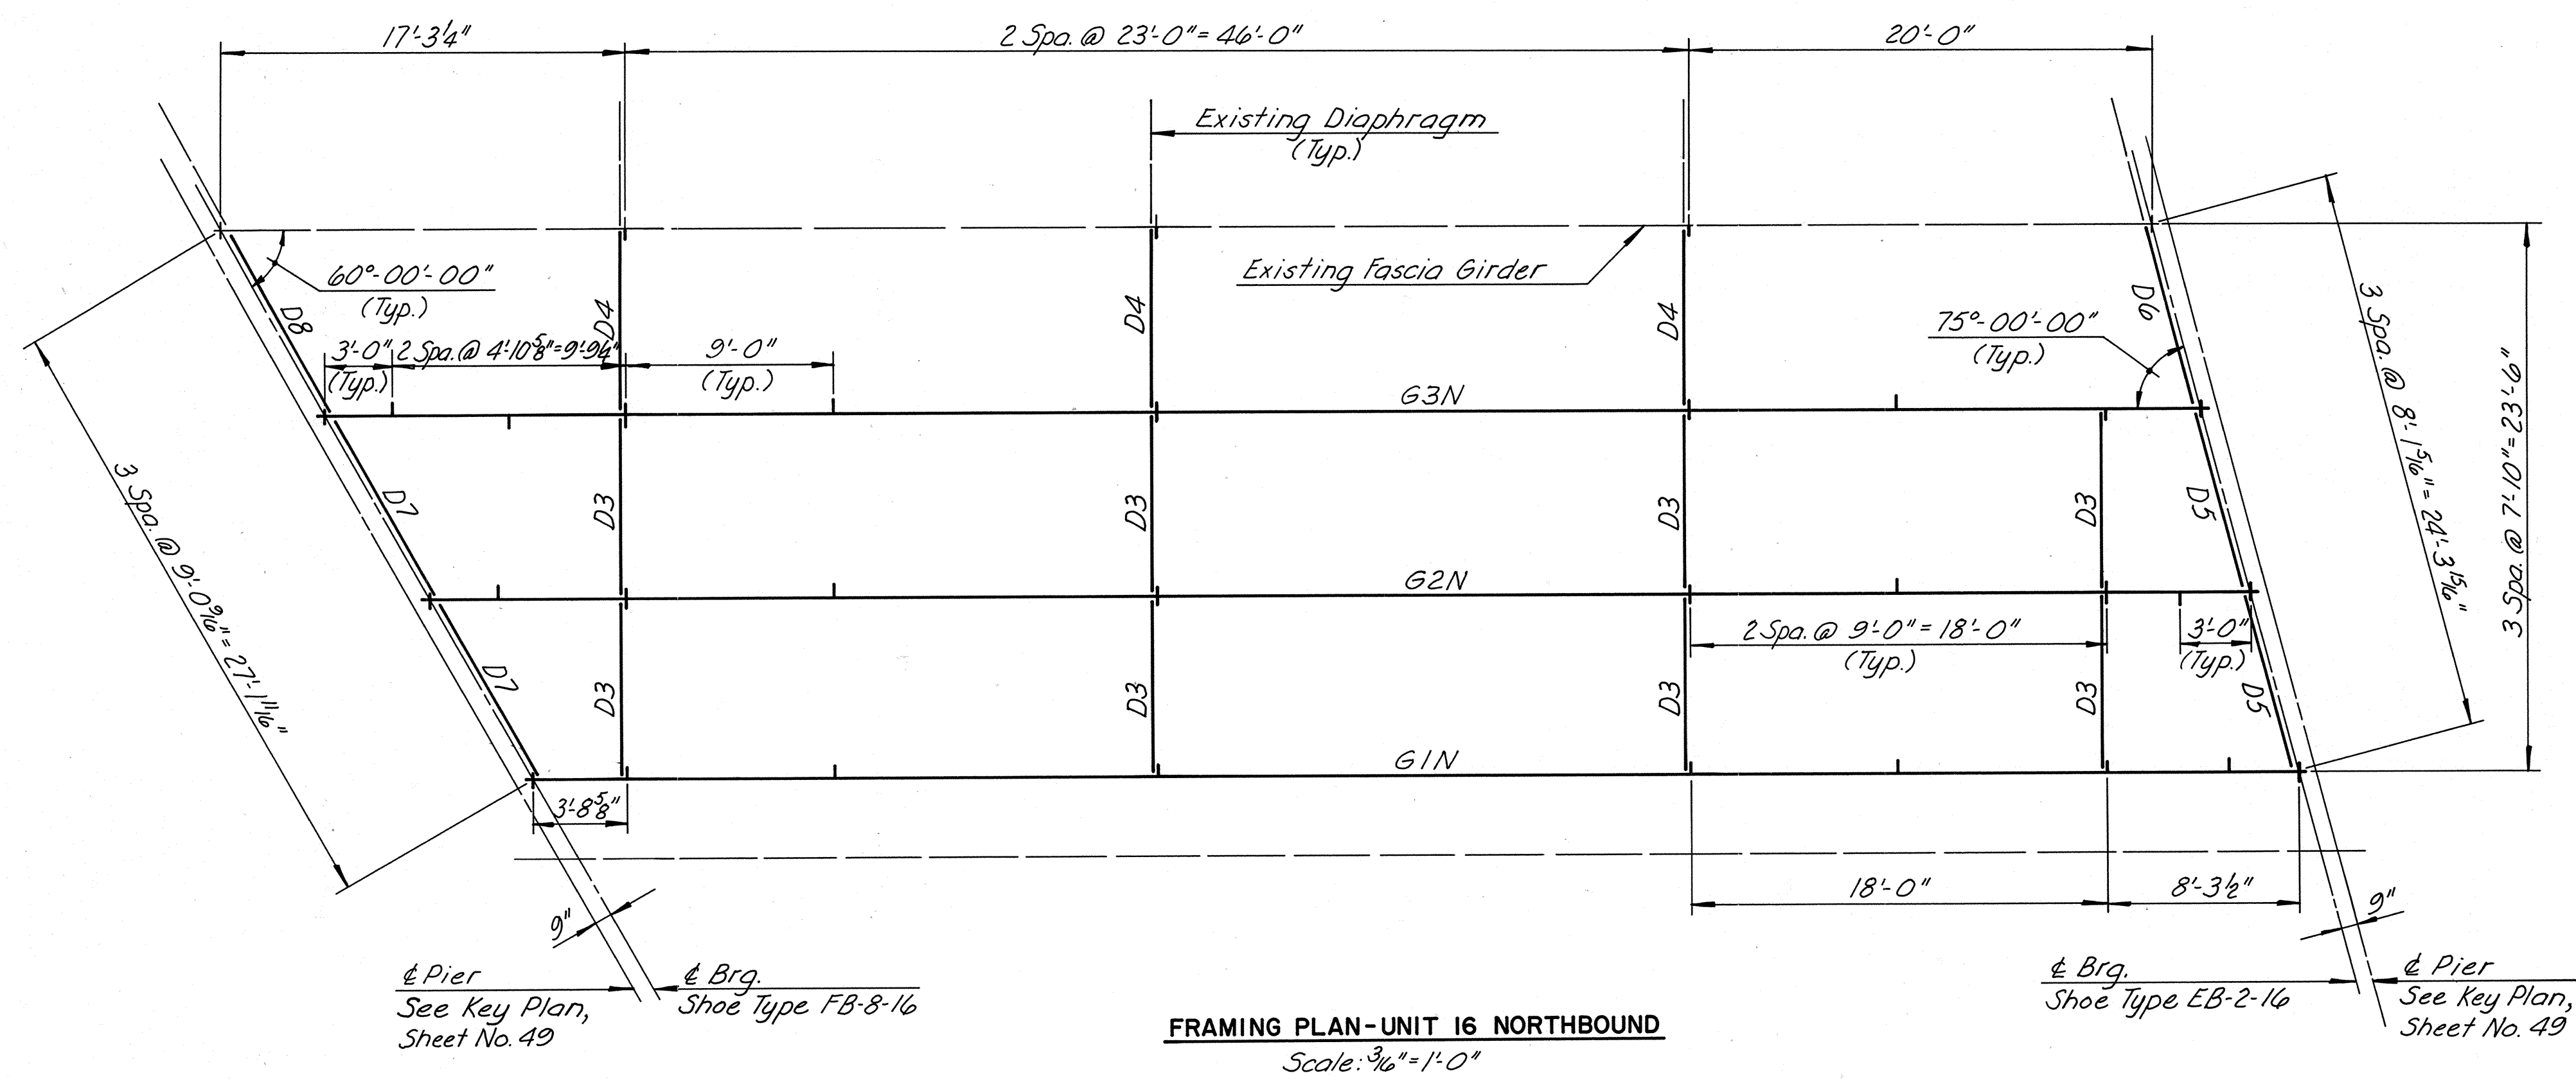

NOTE:
For Steel Details, see Sheet No. 45.

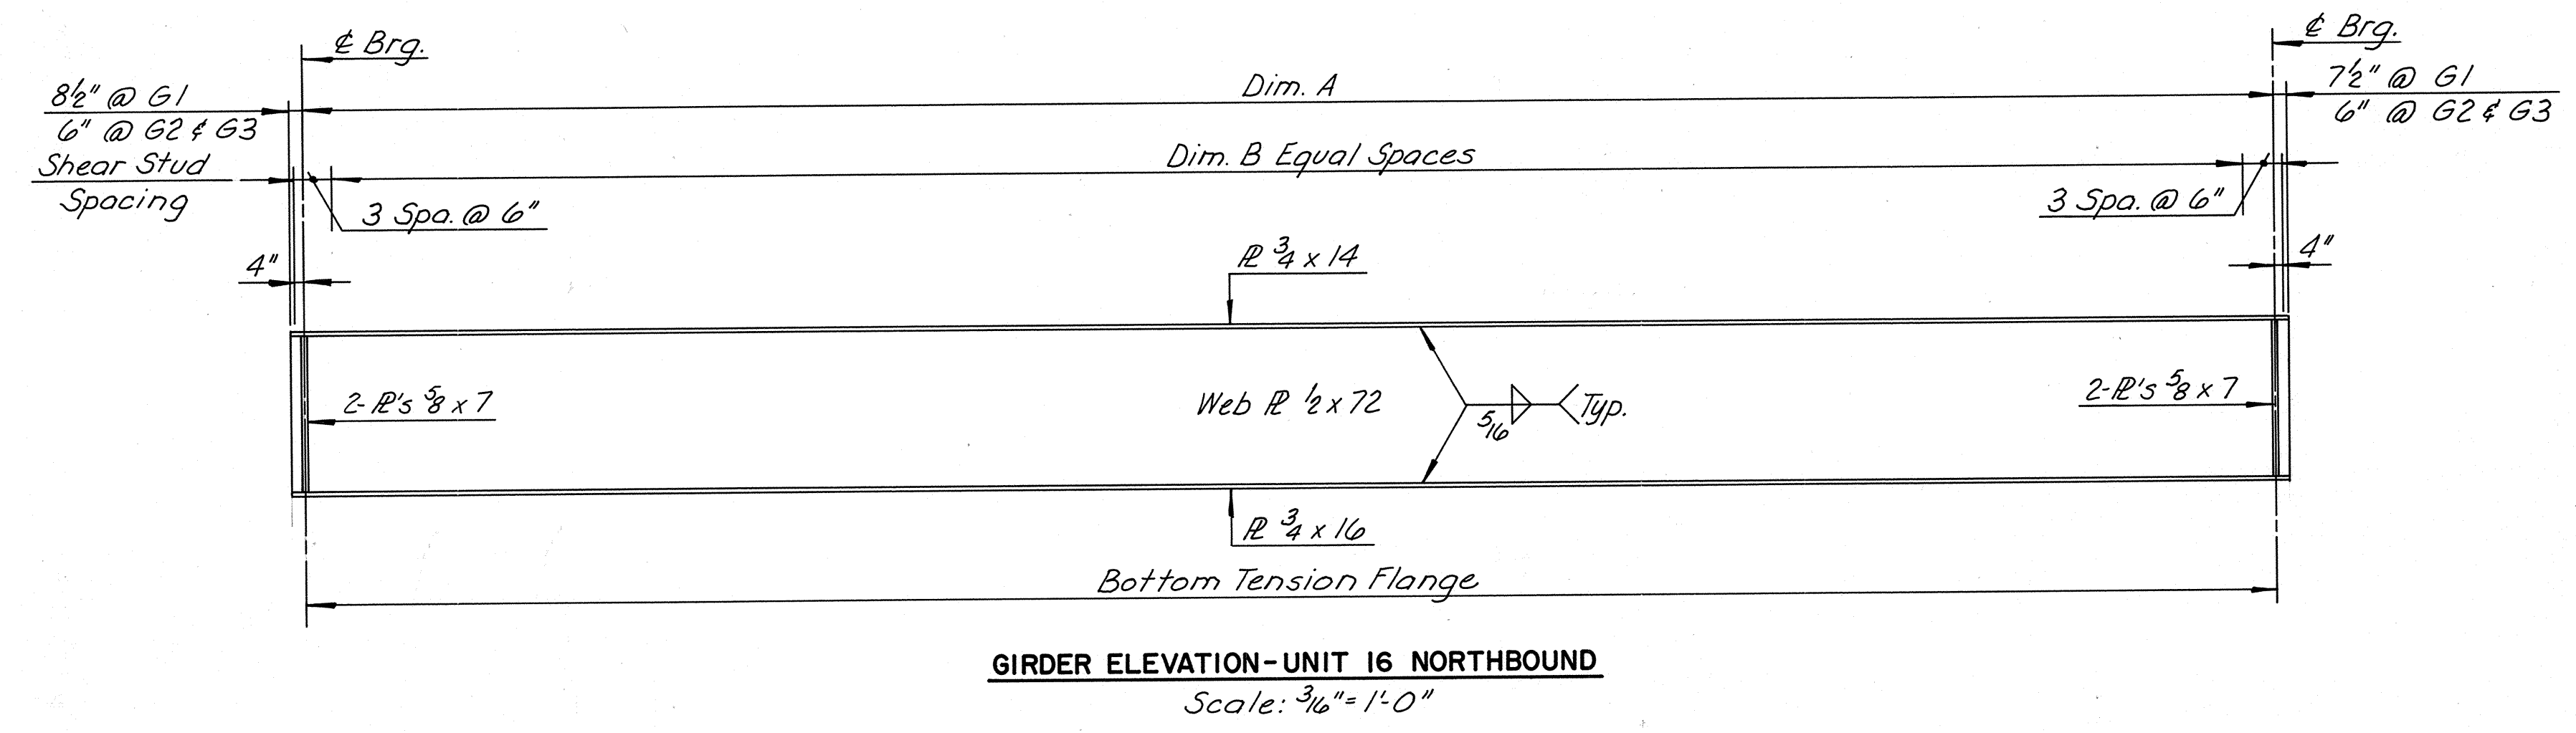

GIRDER	DIM. A	DIM. B
G1	76'-0"	43
G2	78'-5 1/8"	44
G3	80'-10 1/4"	46

MADE	BY	DATE			
	EJM	1-87			
CHECKED	TFP	3-87	As Built	TEM	3-89
IN CHARGE	SR				

RICHMOND METROPOLITAN AUTHORITY
RICHMOND EXPRESSWAY SYSTEM


FRAMING PLAN & GIRDER ELEVATION
UNIT 16 NORTHBOUND

SCALE: AS SHOWN
CONTRACT NO. C-13
SHEET NO. 41 OF 106

HOWARD, NEEDLES, TAMMEN & BERGENDORF
consulting engineers
Alexandria, Virginia


AS BUILT

RICHMOND EXPRESSWAY SYSTEM			
SECTION	PROJECT	SHEET NO.	TOTAL SHEETS
13	WIDENING JAMES RIVER BRIDGE	42	106

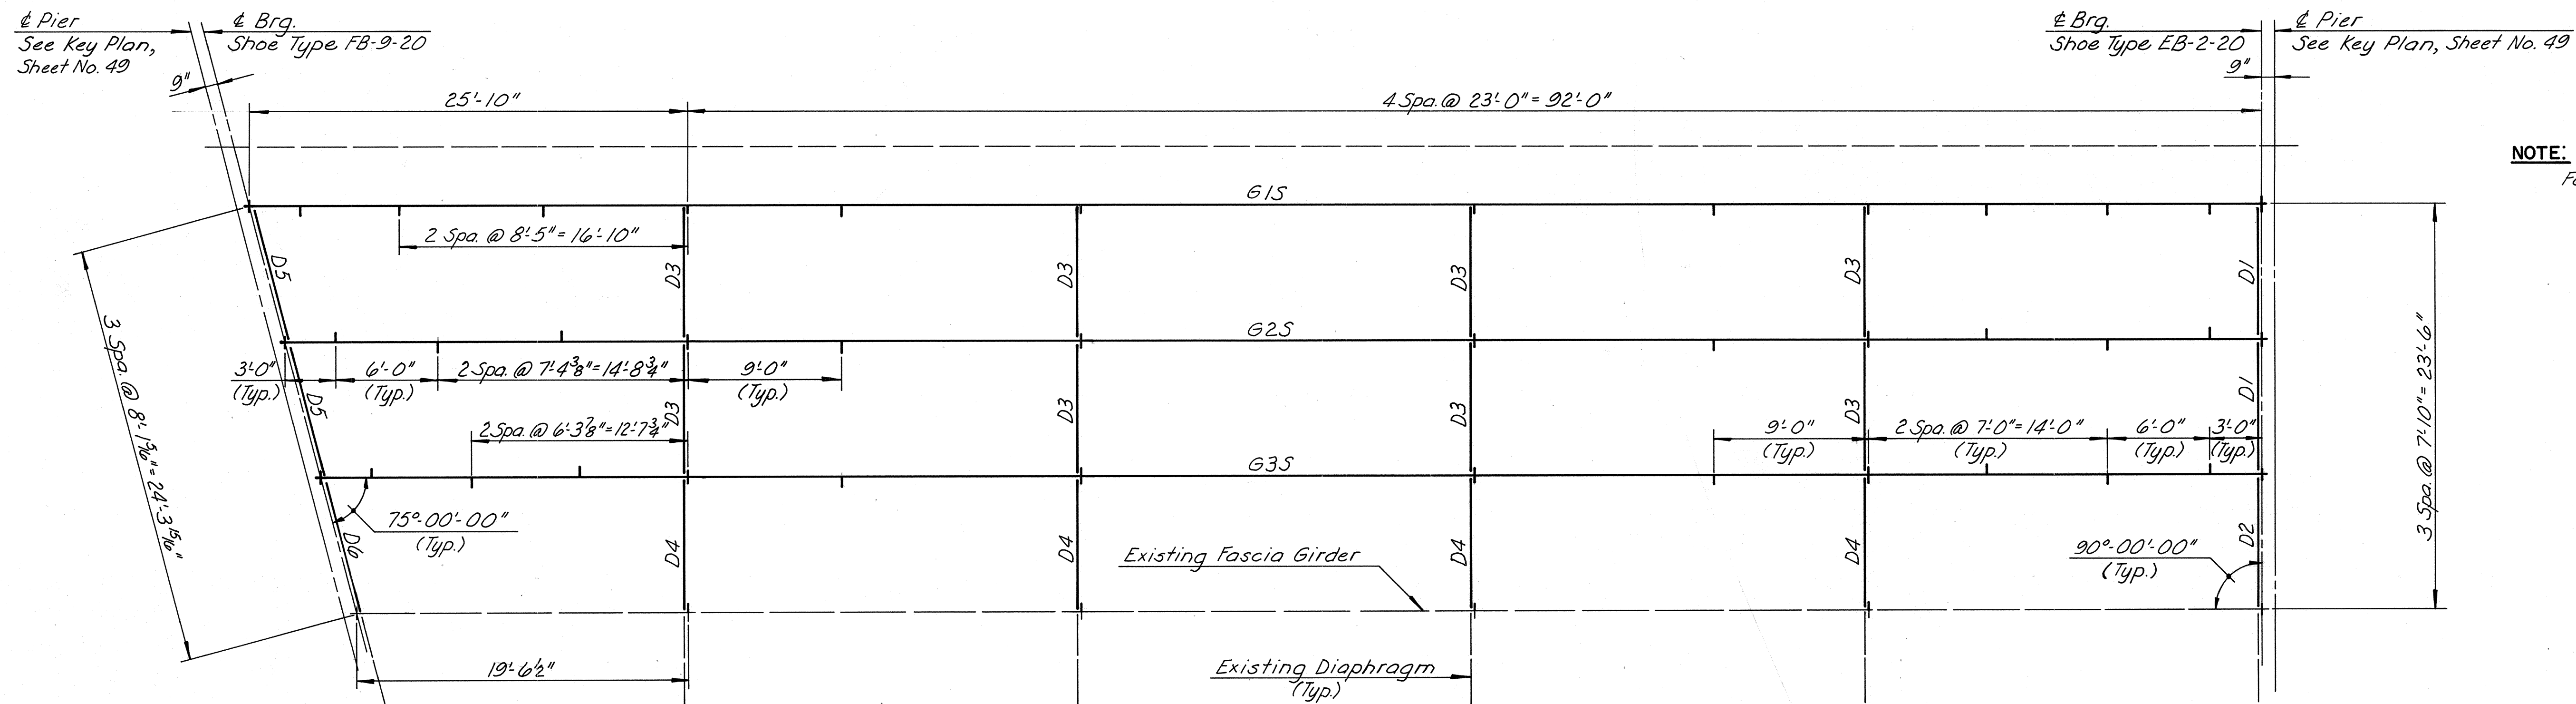

NOTE:
For Steel Details, see Sheet No. 45.

FRAMING PLAN-UNIT 17 SOUTHBOUND
Scale: $\frac{3}{16}'' = 1'-0''$

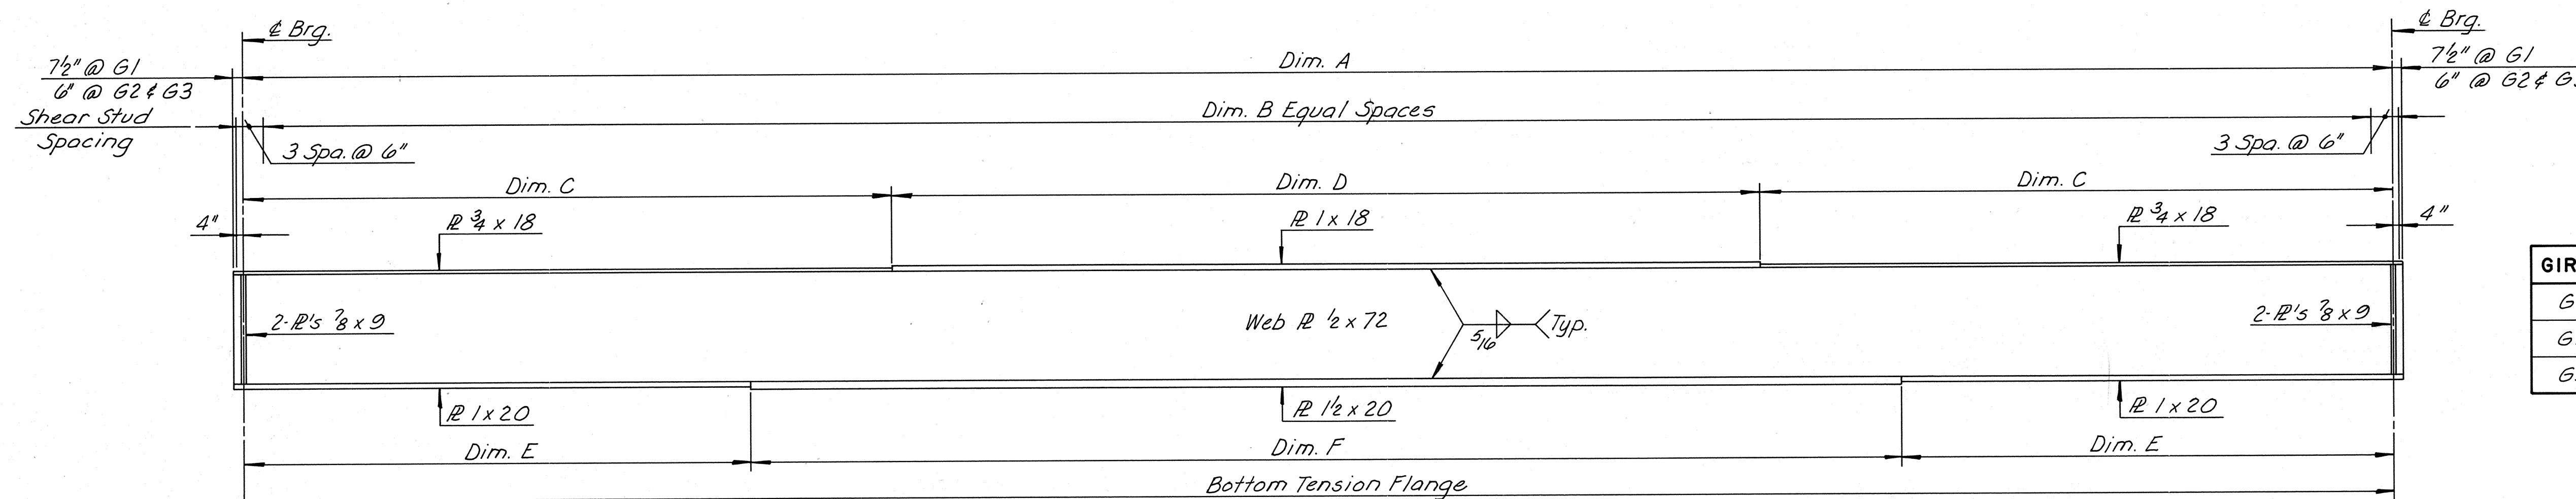

GIRDER	DIM. A	DIM. B	DIM. C	DIM. D	DIM. E	DIM. F
G1	117'-10"	58	32'-11"	52'-0"	25'-8"	66'-6"
G2	115'-8 $\frac{3}{4}$ "	57	32'-1 $\frac{3}{8}$ "	51'-6"	24'-7 $\frac{3}{8}$ "	66'-6"
G3	113'-7 $\frac{5}{8}$ "	56	33'-9 $\frac{13}{16}$ "	46'-0"	25'-6 $\frac{13}{16}$ "	62'-6"

GIRDER ELEVATION-UNIT 17 SOUTHBOUND
Scale: $\frac{3}{16}'' = 1'-0''$

BY	DATE	NO.	REVISION	BY	DATE
MADE	EJM 1-87				
CHECKED	TFP 3-87	As Built	TEM 3-89		
IN CHARGE	SR				

RICHMOND METROPOLITAN AUTHORITY
RICHMOND EXPRESSWAY SYSTEM


FRAMING PLAN & GIRDER ELEVATION
UNIT 17 SOUTHBOUND

HOWARD, NEEDLES, TAMMEN & BERGENDOFF
consulting engineers
Alexandria, Virginia

SCALE: AS SHOWN
CONTRACT NO.: C-13
SHEET NO. 42 OF 106


AS BUILT

RICHMOND EXPRESSWAY SYSTEM			
SECTION	PROJECT	SHEET NO.	TOTAL SHEETS
13	WIDENING JAMES RIVER BRIDGE	43	106

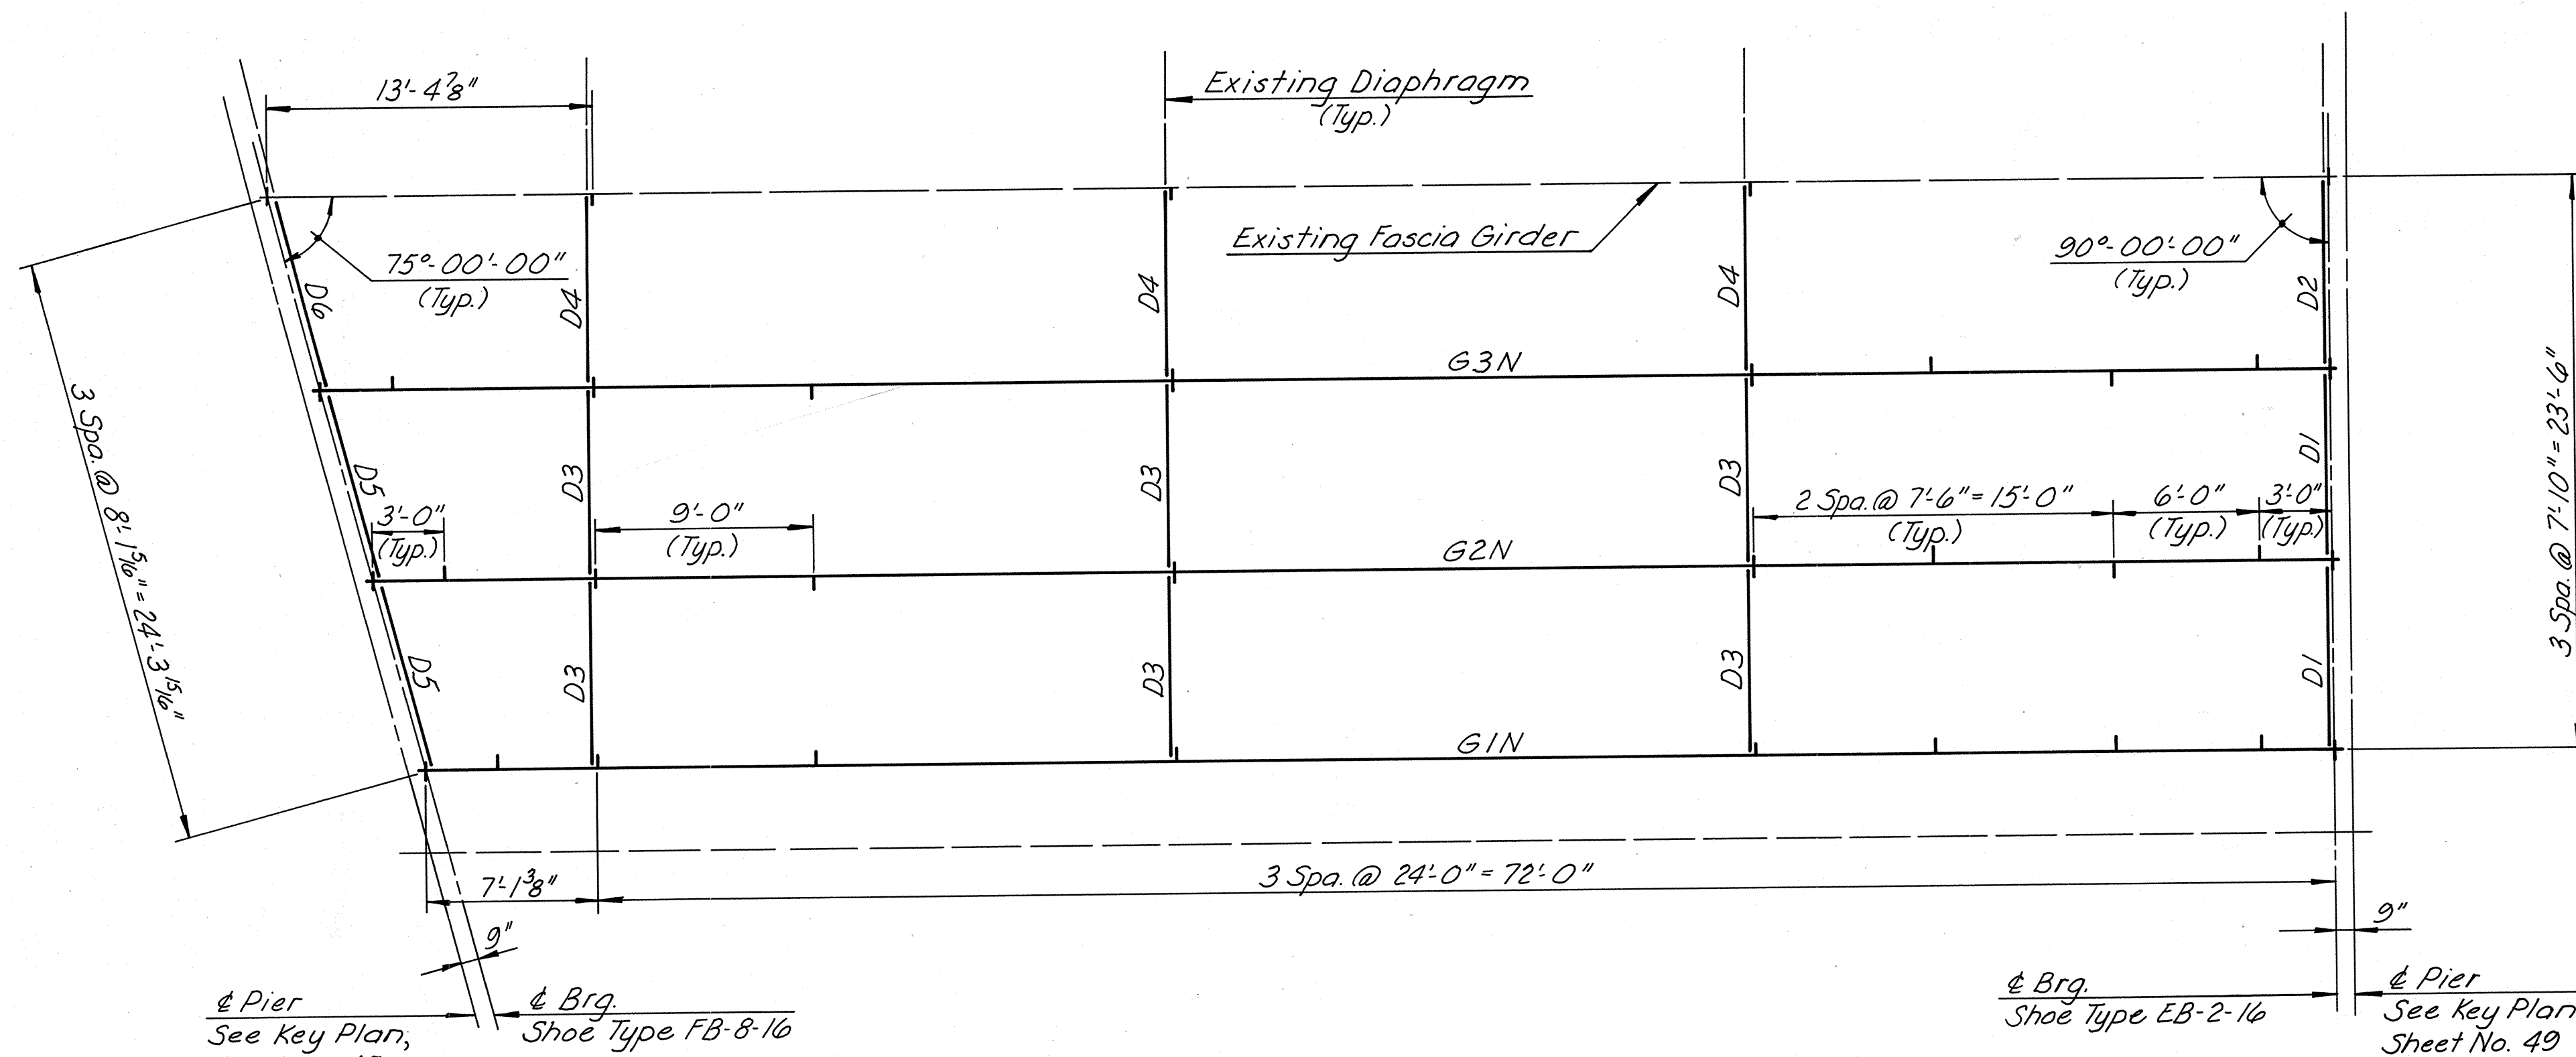

FRAMING PLAN - UNIT 17 NORTHBOUND
Scale: $\frac{3}{16}'' = 1'-0''$

NOTE:
For Steel Details, see Sheet No. 45.

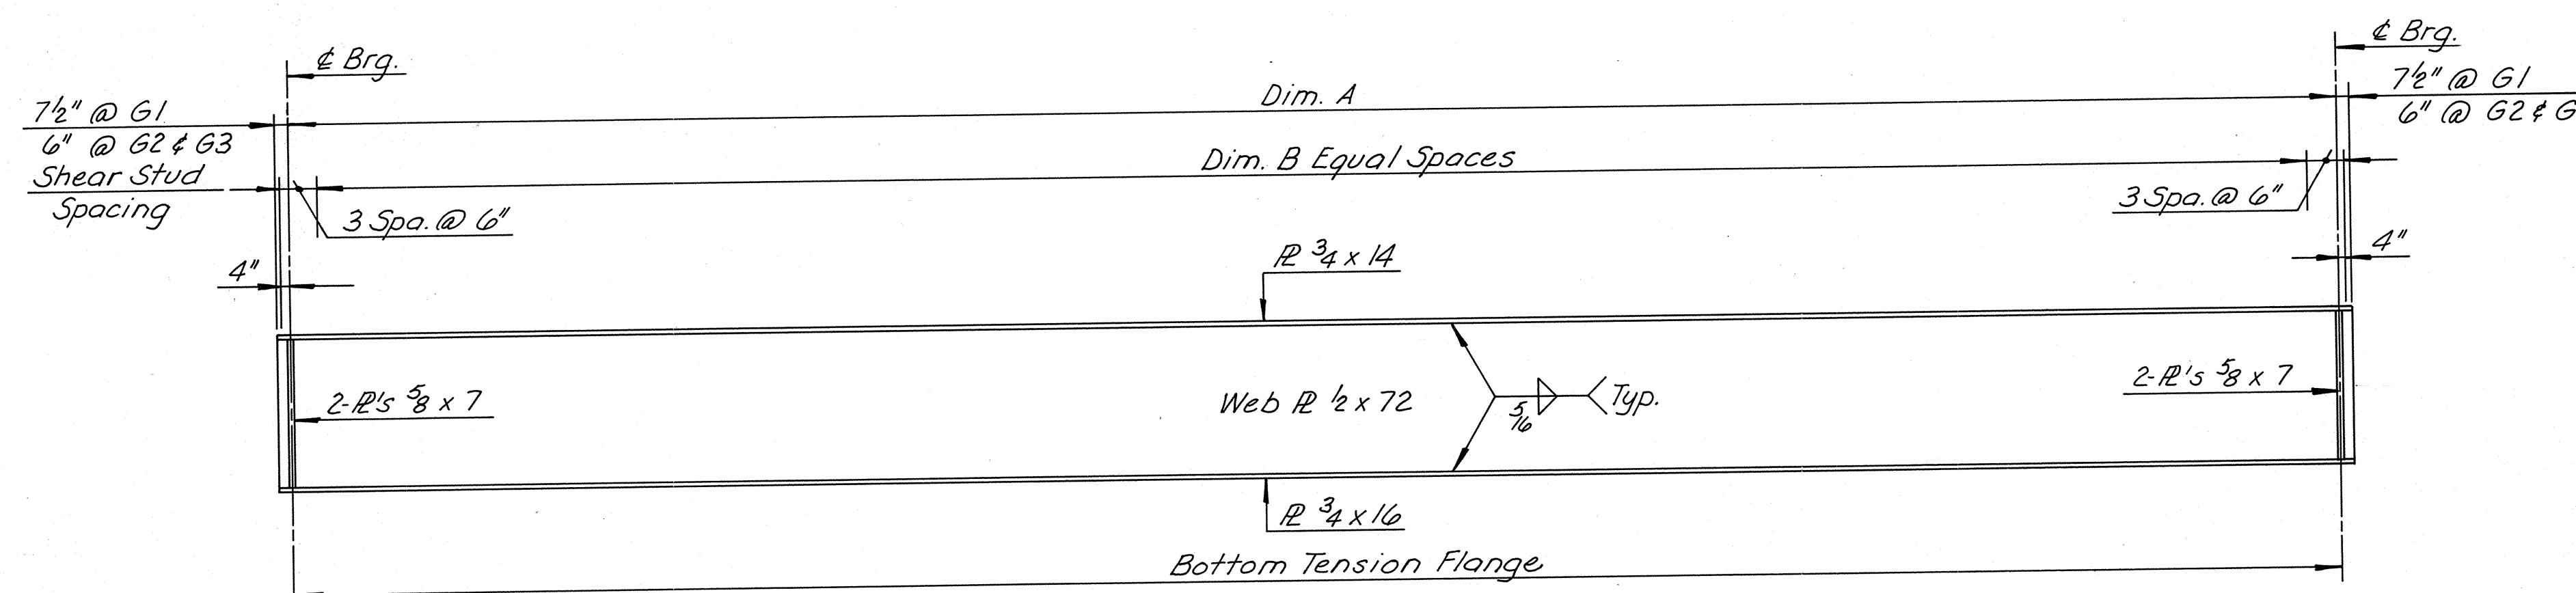

GIRDER ELEVATION - UNIT 17 NORTHBOUND
Scale: $\frac{3}{16}'' = 1'-0''$

GIRDER	DIM. A	DIM. B
G1	79'-1 3/8"	43
G2	81'-2 1/2"	44
G3	83'-3 3/4"	45

BY	DATE				
MADE	EJM	1-87			
CHECKED	TFP	3-87	As Built	TEM	3-89
IN CHARGE	SR				

AS BUILT


RICHMOND METROPOLITAN AUTHORITY
RICHMOND EXPRESSWAY SYSTEM

FRAMING PLAN & GIRDER ELEVATION
UNIT 17 NORTHBOUND


HOWARD, NEEDLES, TAMMEN & BERGENDOFF
consulting engineers
Alexandria, Virginia

SCALE: AS SHOWN
CONTRACT NO.: C-13
SHEET NO. 43 OF 106

RICHMOND EXPRESSWAY SYSTEM			
SECTION	PROJECT	SHEET NO.	TOTAL SHEETS
13	WIDENING JAMES RIVER BRIDGE	44	106

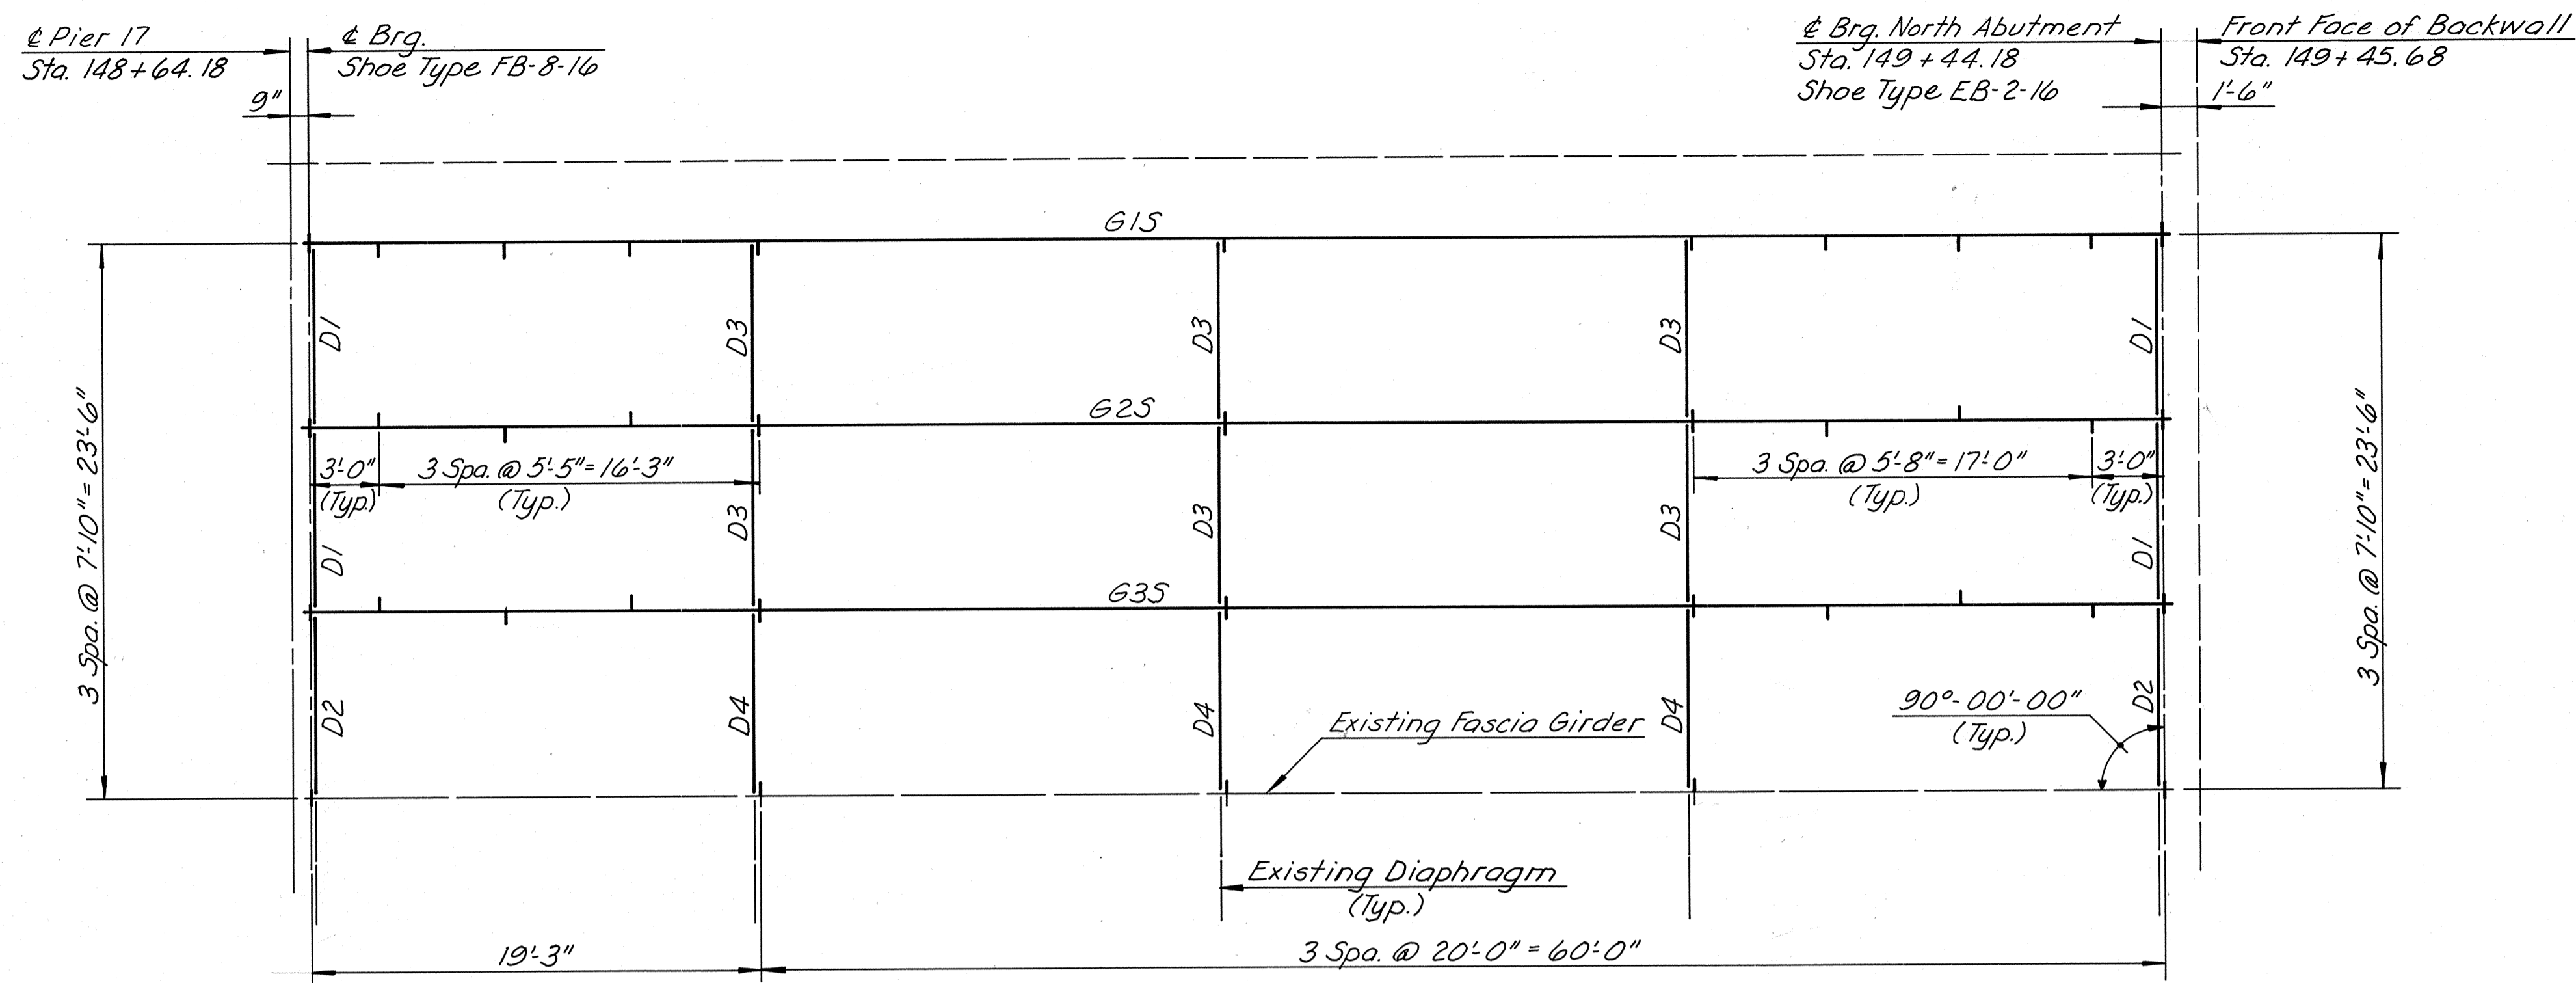

**FRAMING PLAN - UNIT 18 SOUTHBOUND & NORTHBOUND
(SOUTHBOUND SHOWN)**
Scale: 3/16" = 1'-0"

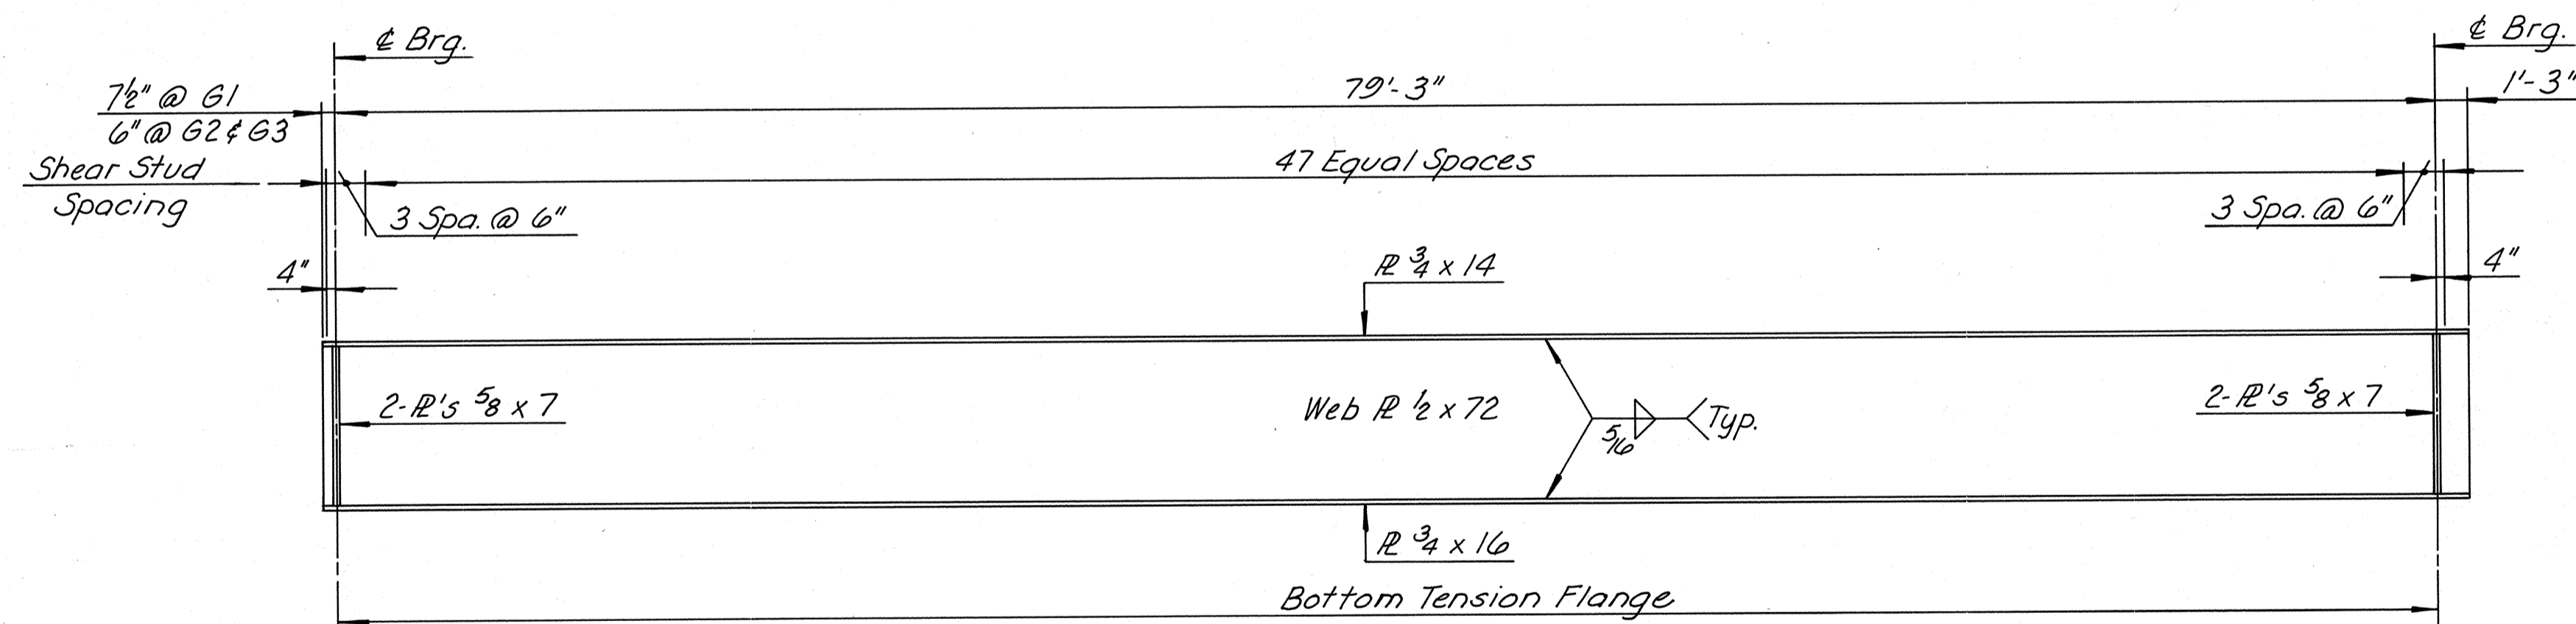

GIRDER ELEVATION - UNIT 18 SOUTHBOUND & NORTHBOUND
Scale: 3/16" = 1'-0"

NOTE:
For Steel Details, see Sheet No. 45.

BY	DATE				
MADE	EJM	1-87			
CHECKED	TFP	3-87	As Built	TEM	3-89
IN CHARGE	SR				

**RICHMOND METROPOLITAN AUTHORITY
RICHMOND EXPRESSWAY SYSTEM**


**FRAMING PLAN & GIRDER ELEVATION
UNIT 18 SOUTHBOUND & NORTHBOUND**

HOWARD, NEEDLES, TAMMEN & BERGENDOFF
consulting engineers
Alexandria, Virginia


SCALE: AS SHOWN
CONTRACT NO.: C-13
SHEET NO. 44 OF 106

AS BUILT


RICHMOND EXPRESSWAY SYSTEM			
SECTION	PROJECT	SHEET NO.	TOTAL SHEETS
13	WIDENING JAMES RIVER BRIDGE	45	106

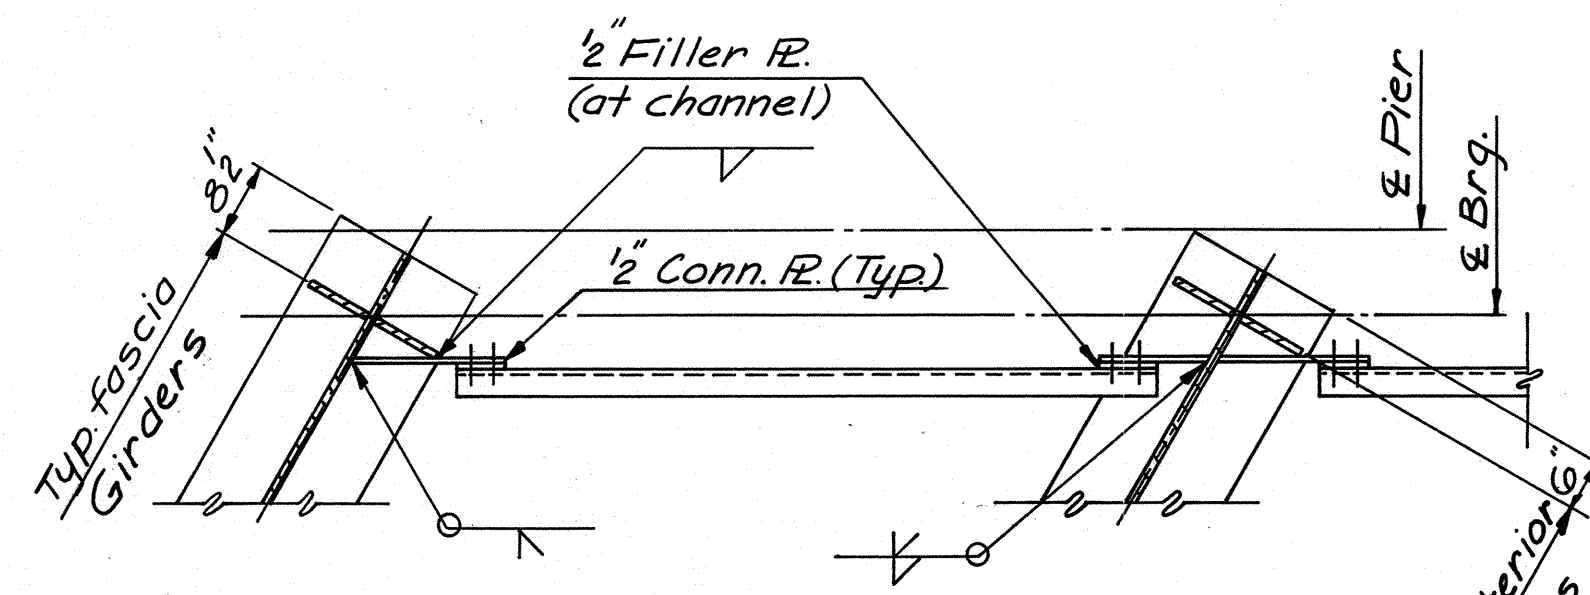


PLAN-DIAPHRAGM D7 & D11

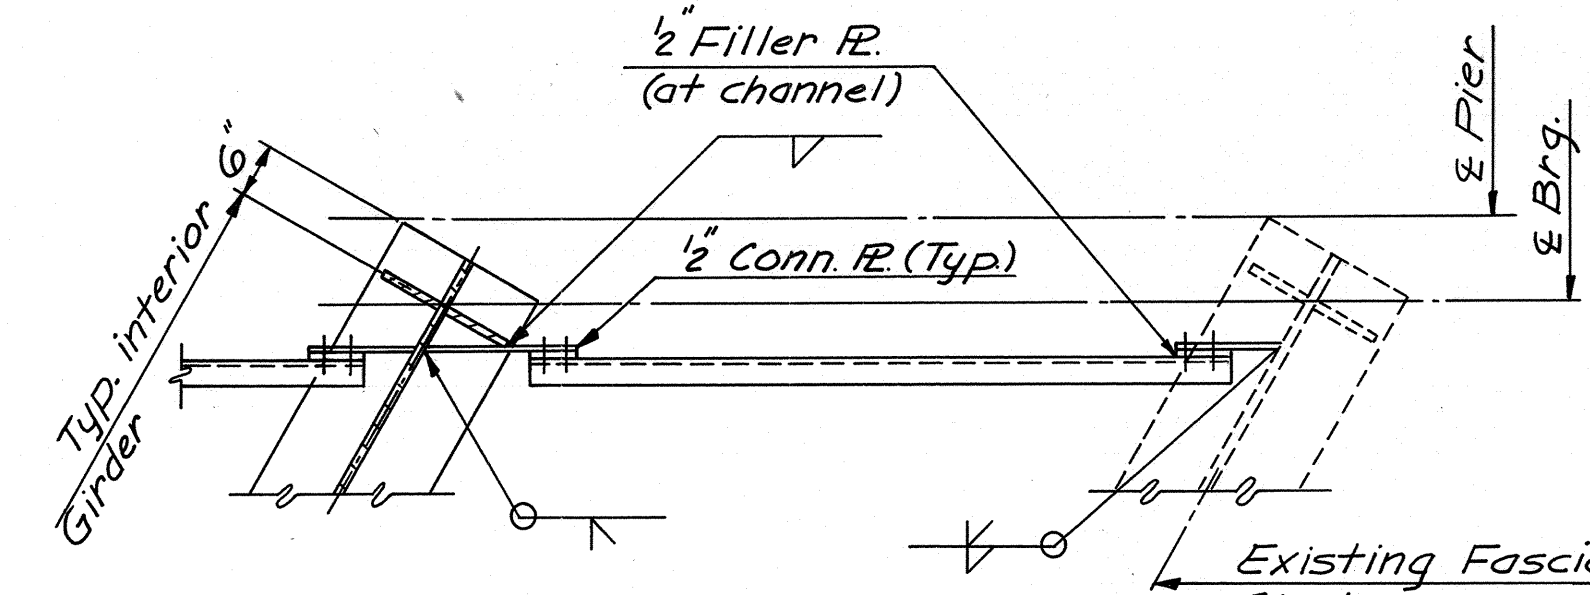


PLAN-DIAPHRAGM D8 & D12

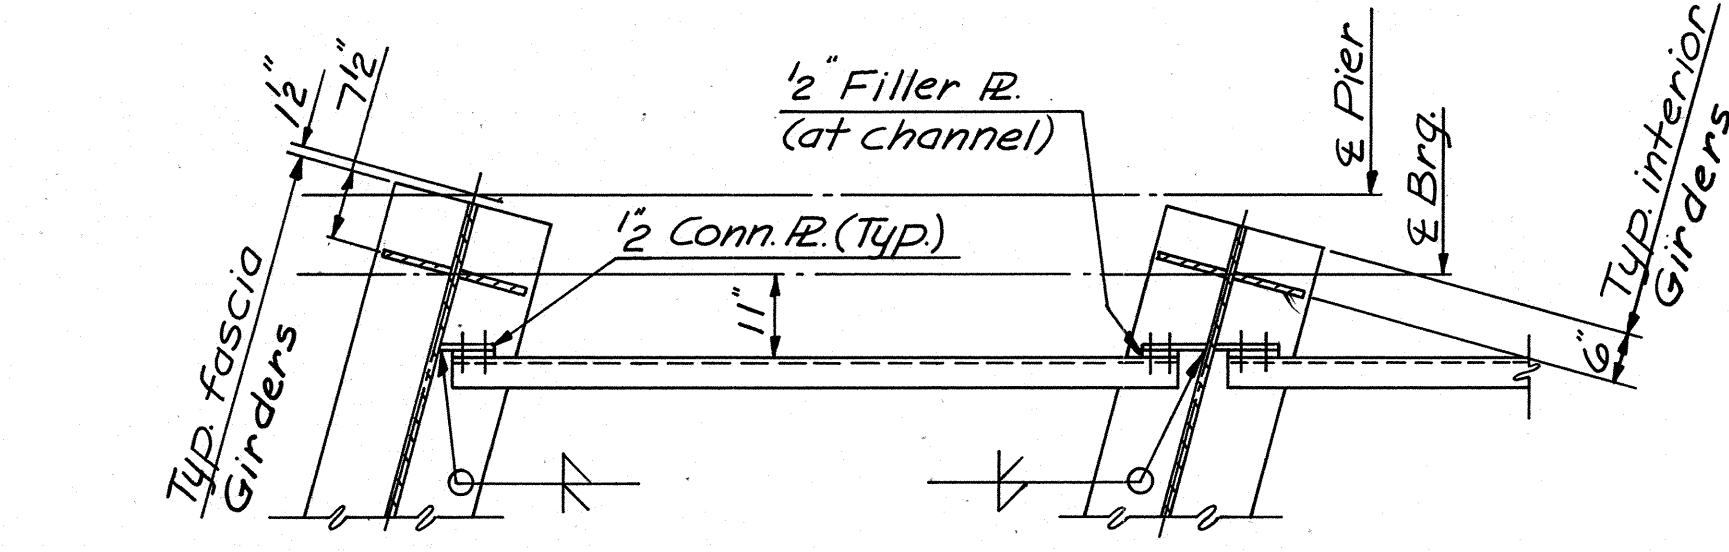


PLAN-DIAPHRAGM D5

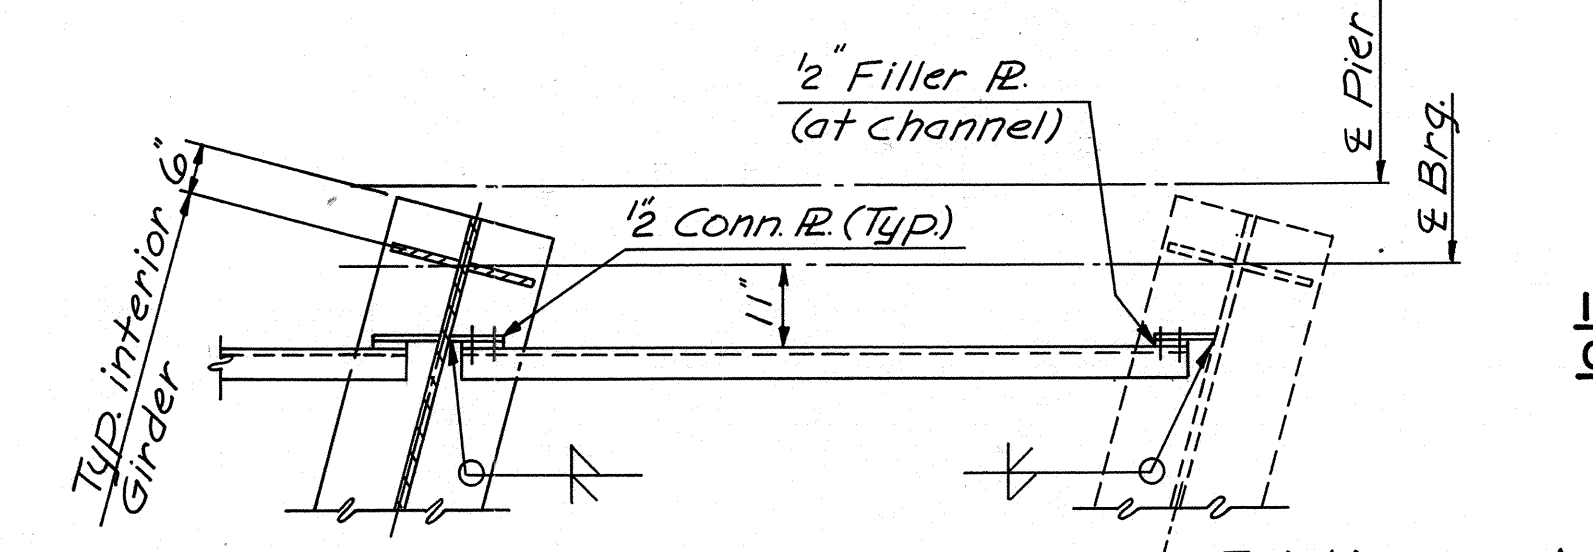


PLAN-DIAPHRAGM D6

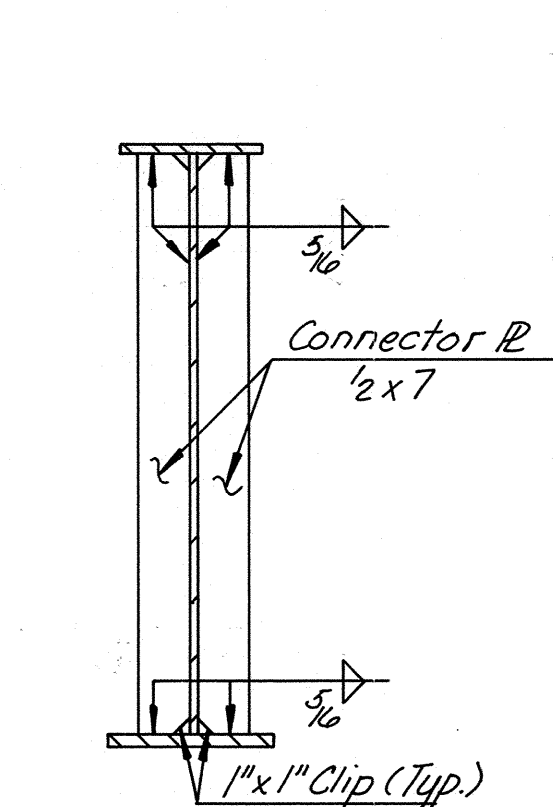


INTERMEDIATE DIAPHRAGM CONNECTOR PLATE DETAIL

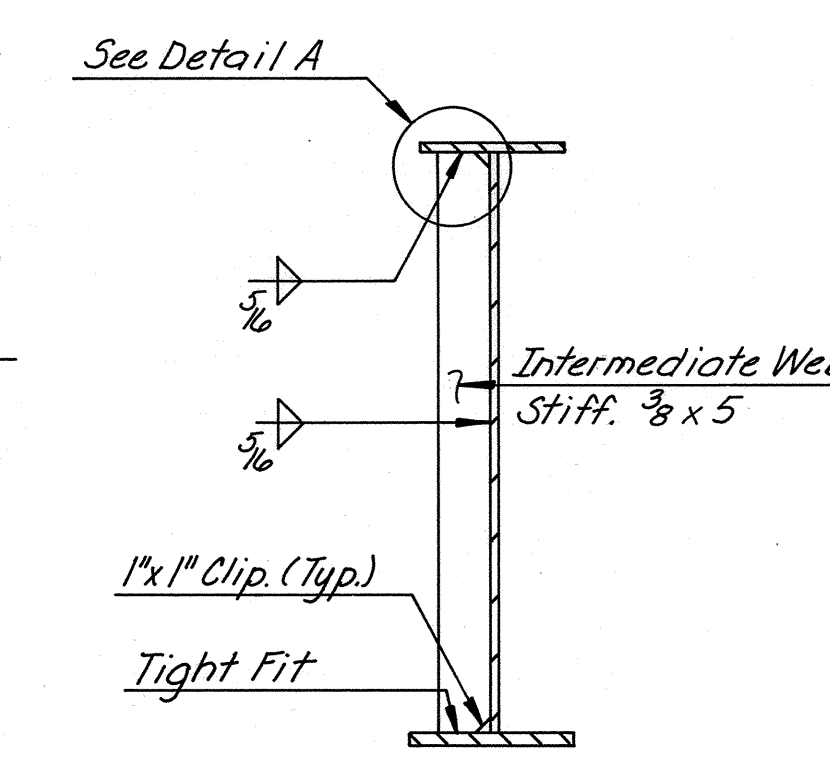


INTERMEDIATE WEB STIFFENER DETAIL

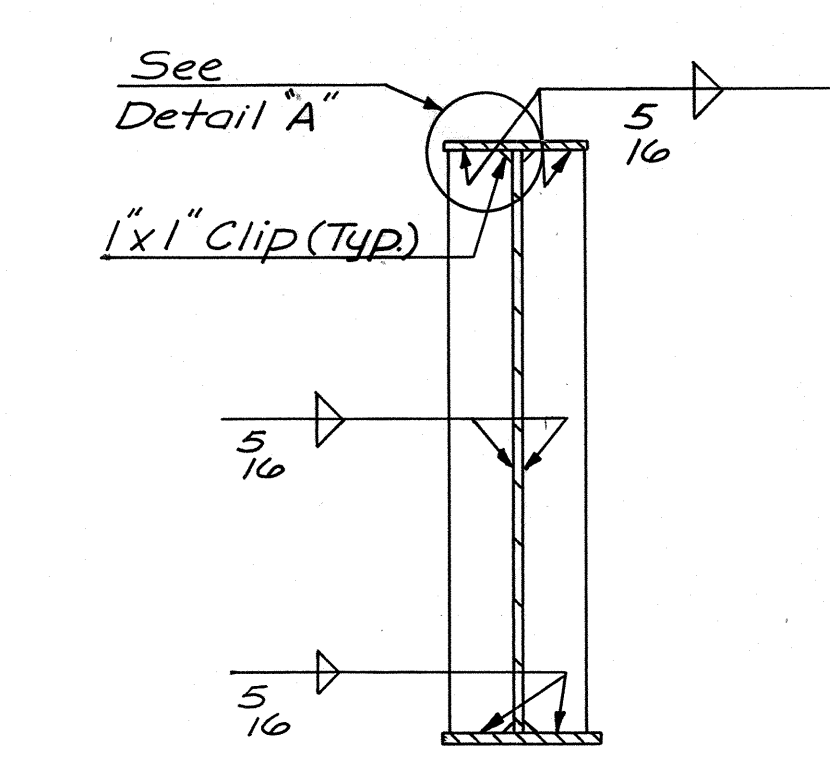


BEARING STIFFENER DETAIL

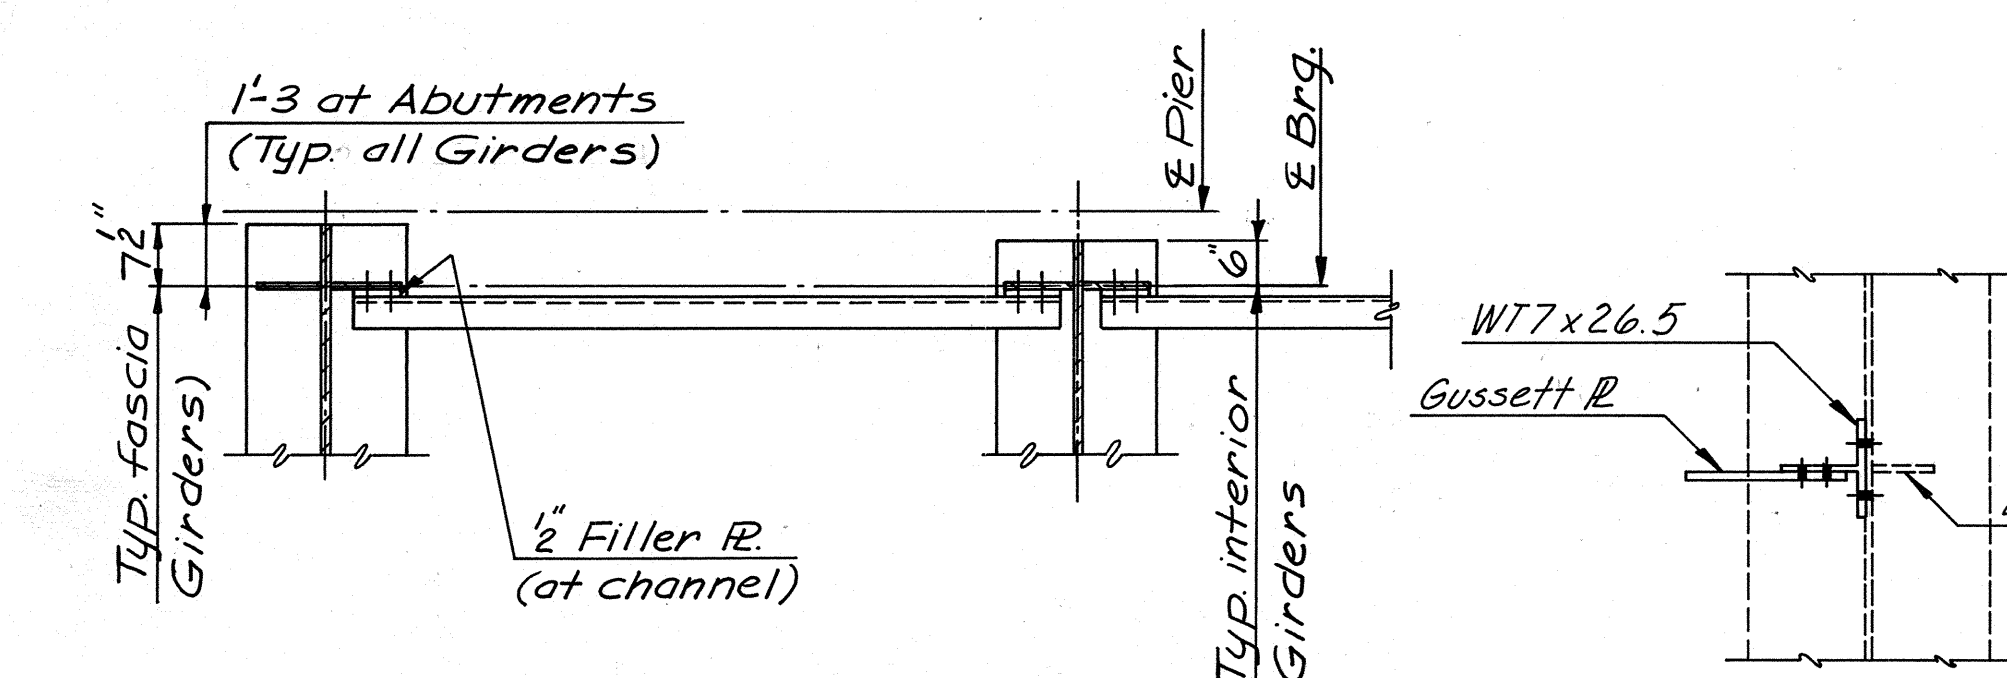


PLAN-DIAPHRAGM D1

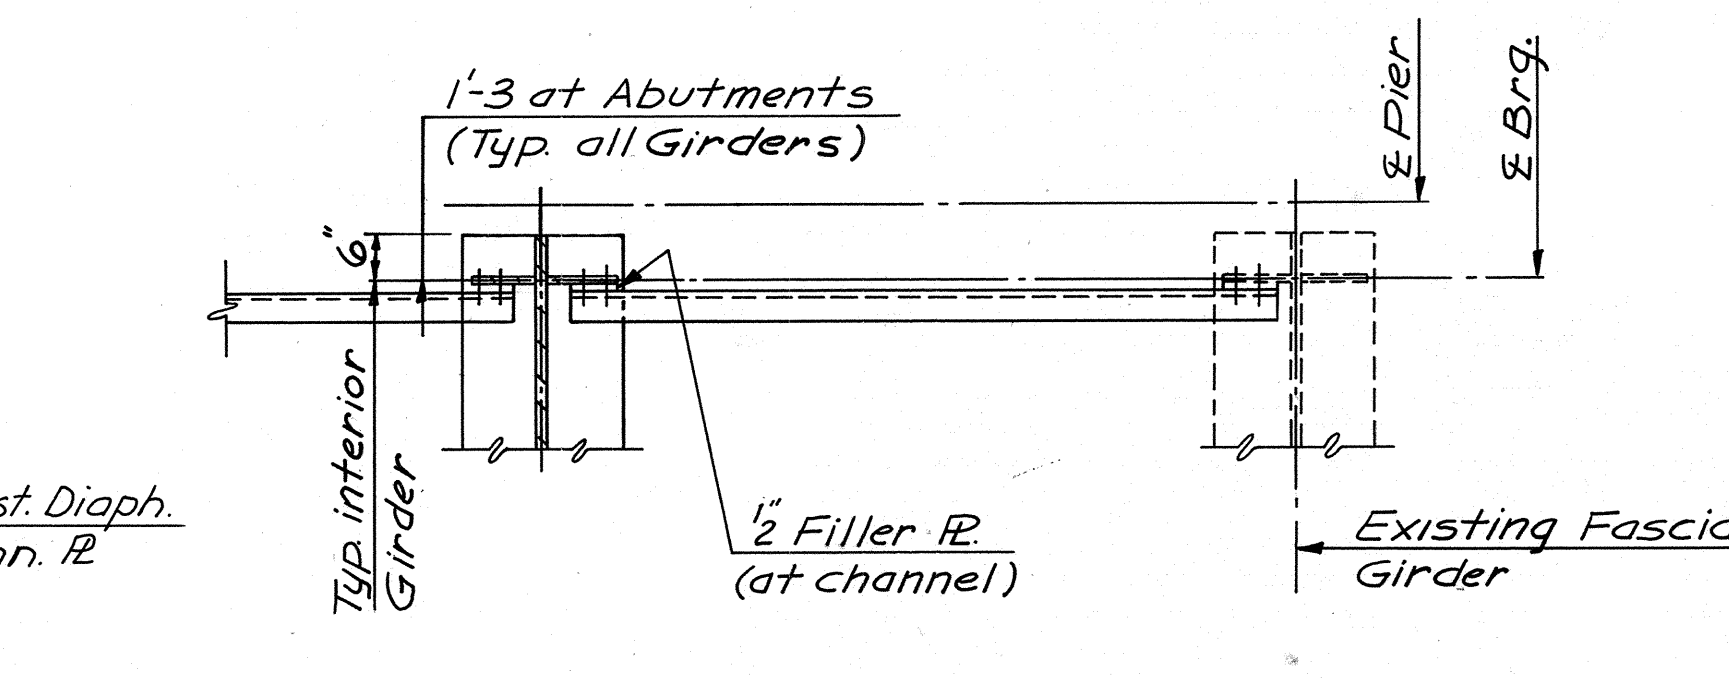


PLAN-DIAPHRAGM D2

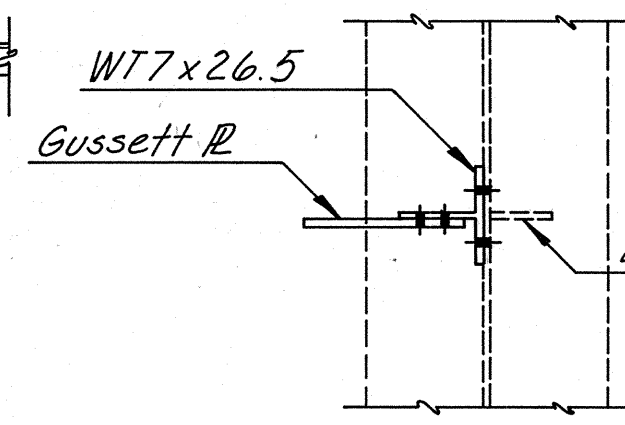


SECTION A-A

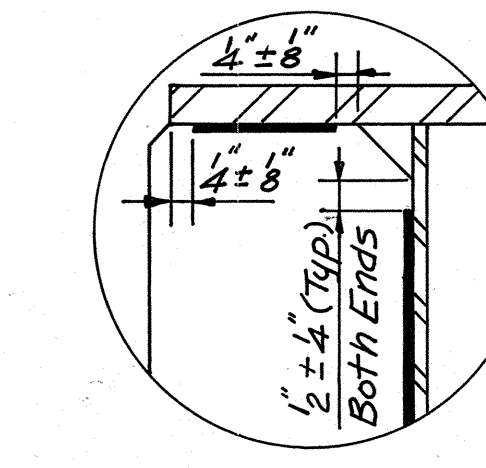


DETAIL "A"

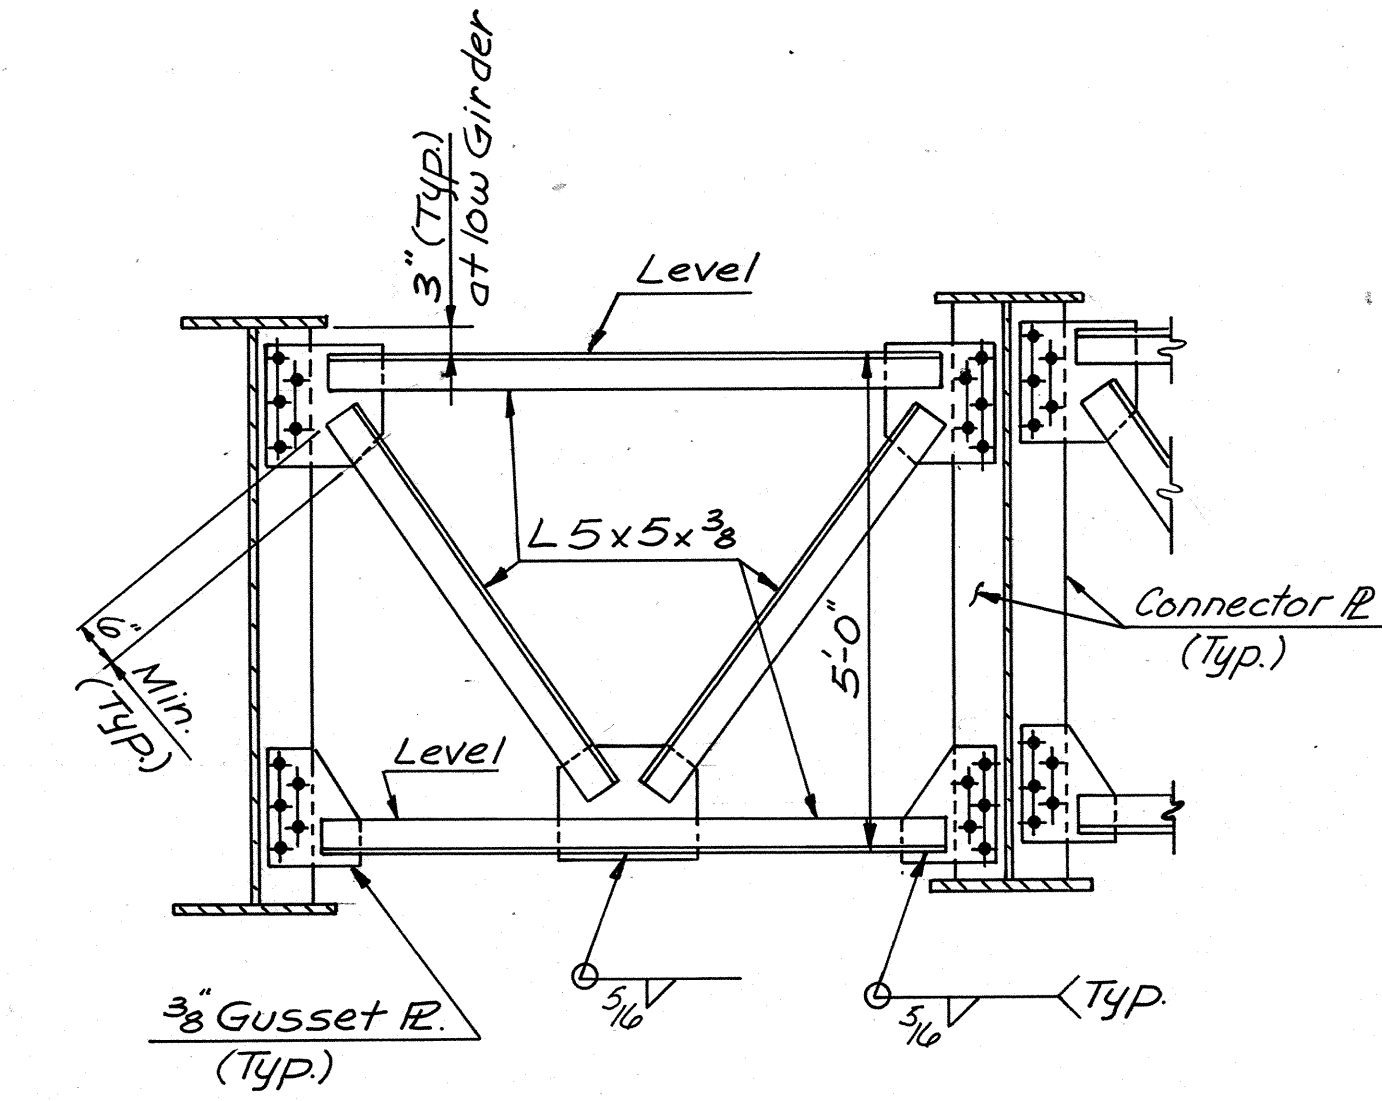


INTERMEDIATE DIAPHRAGM D3

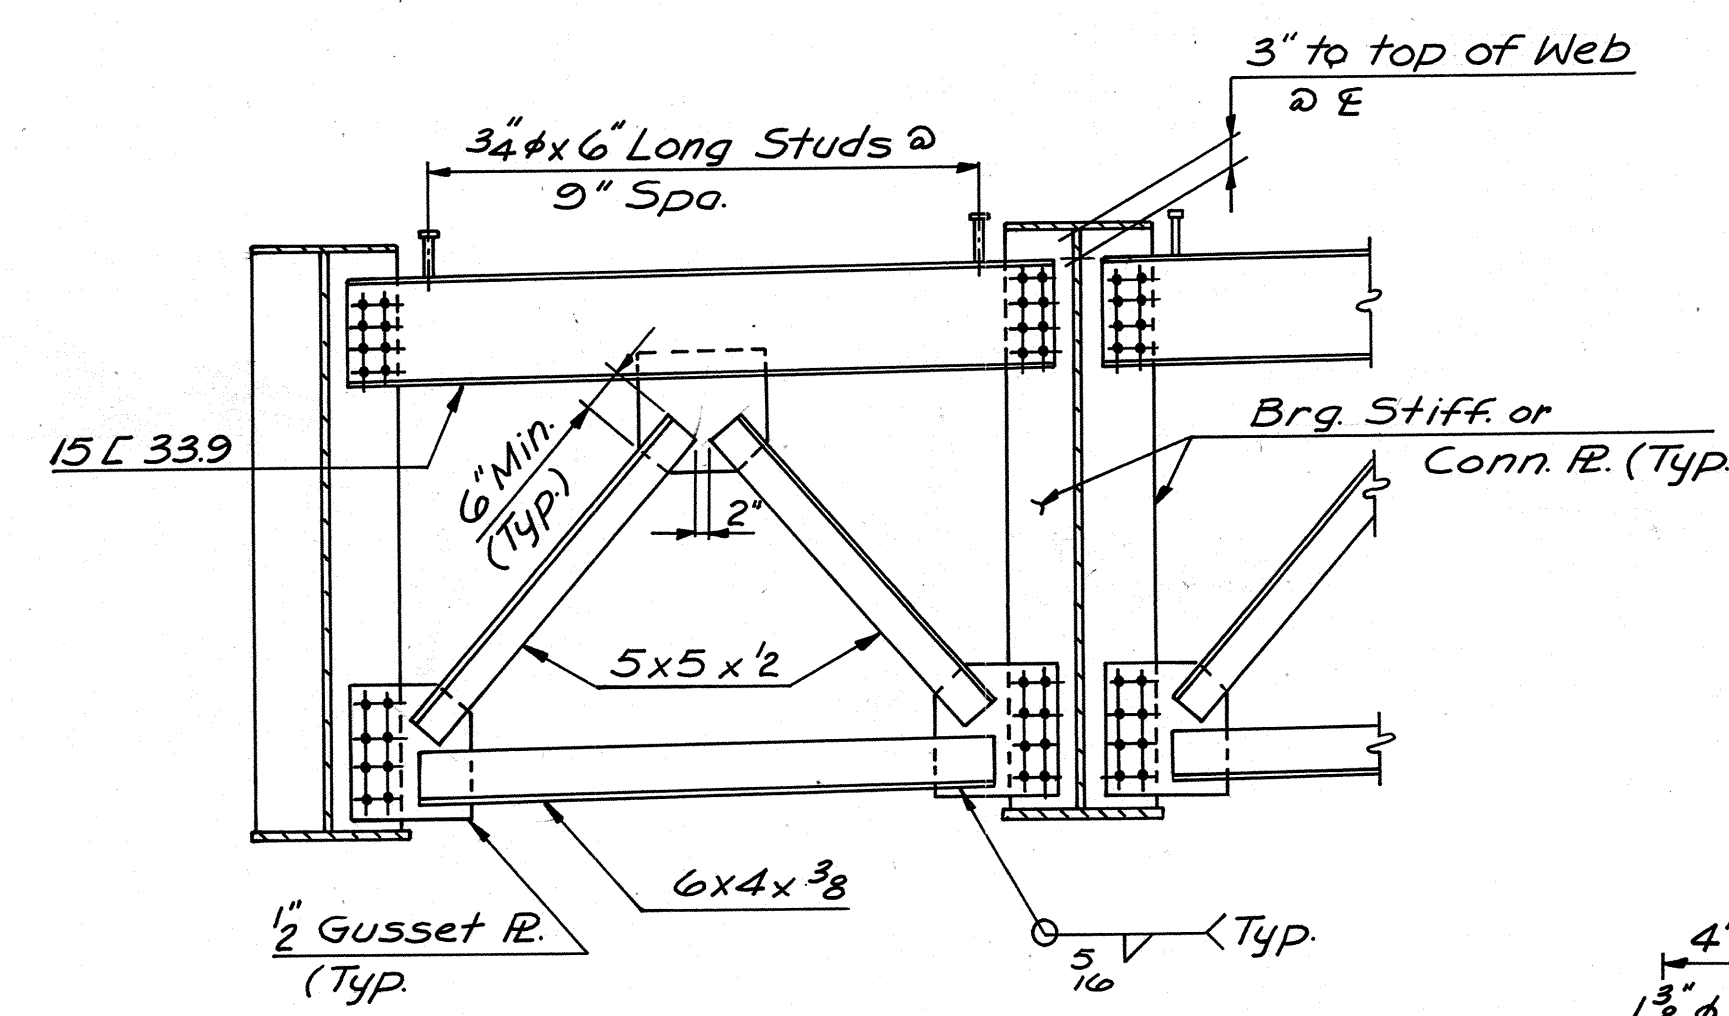

ELEVATION END DIAPHRAGM DETAILS - D1, D5, D7

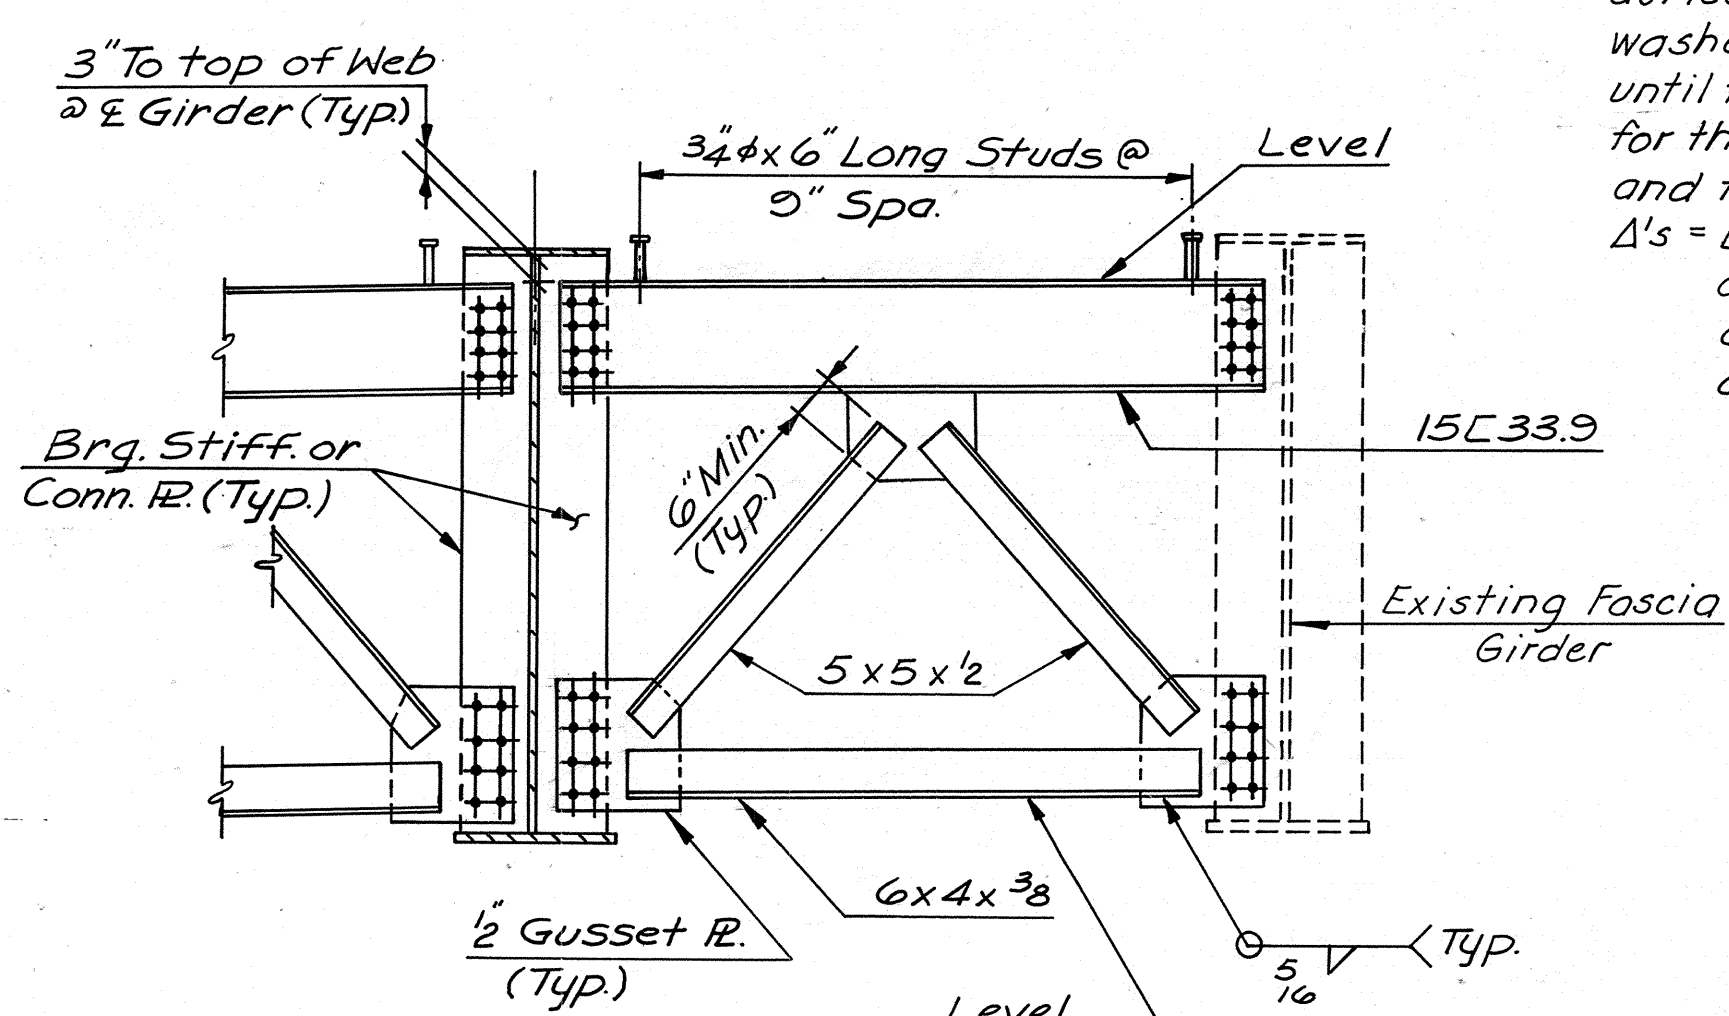


ELEVATION END DIAPHRAGM DETAILS - D2, D6, D8

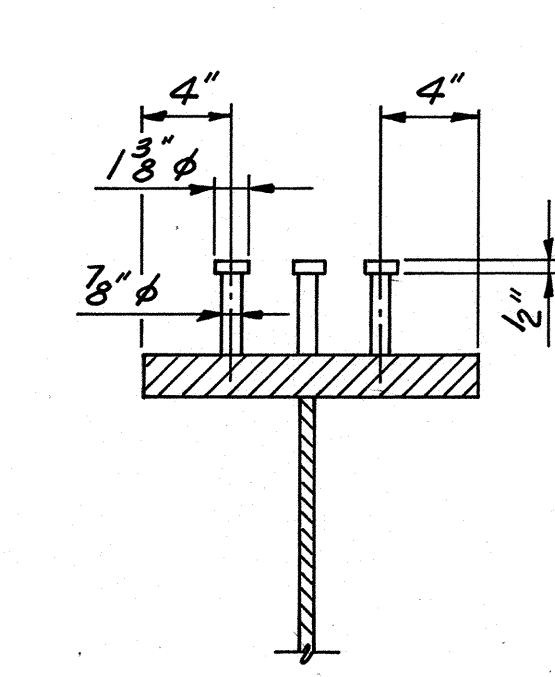


SHEAR STUD DETAIL

NOTE A:
Provide slotted hole in Conn. Pl. for Δ's deflection and 1"φ erection bolt with 3"φ washers. The bolt shall remain snug tight until the deck slab is placed, then the holes for the remaining bolts shall be field drilled and tightened.
Δ's = Deflection of girder from dead load of concrete deck slab, bolster and 20 p.s.f. allowance for construction tolerance and construction methods. See Sheets No. 68

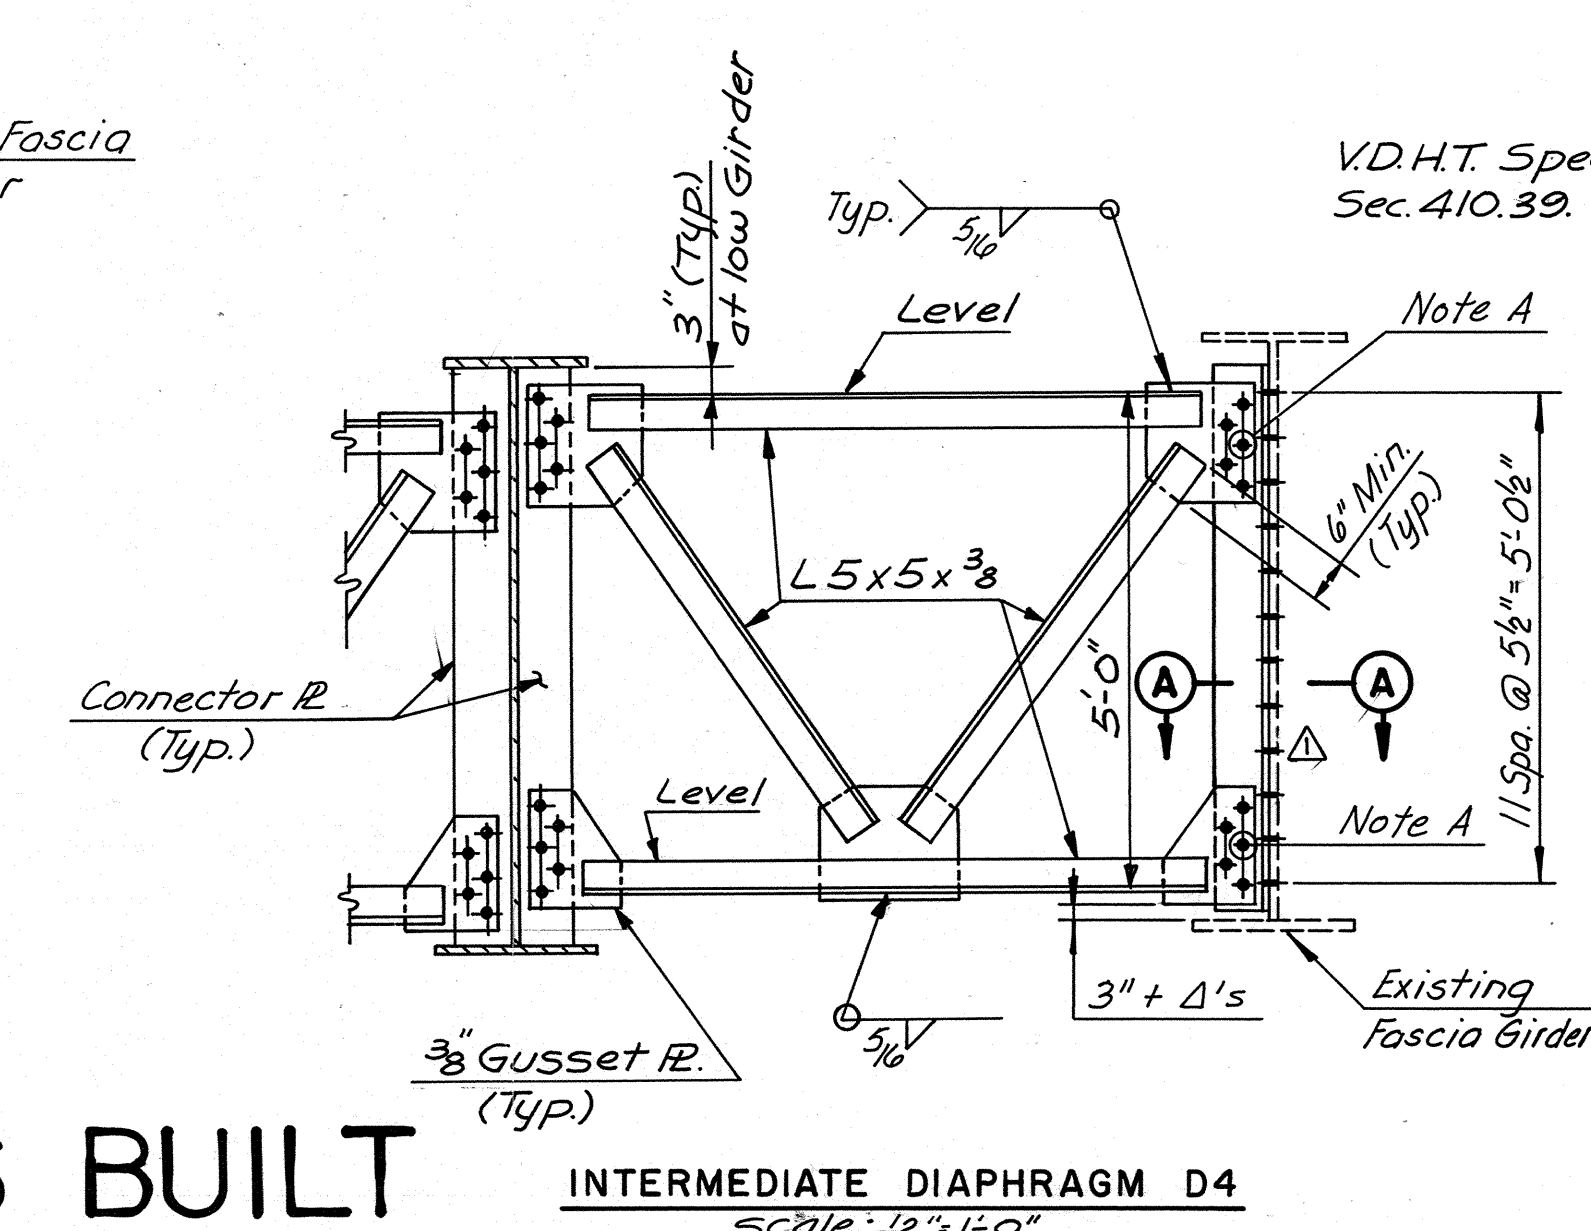

INTERMEDIATE DIAPHRAGM D4

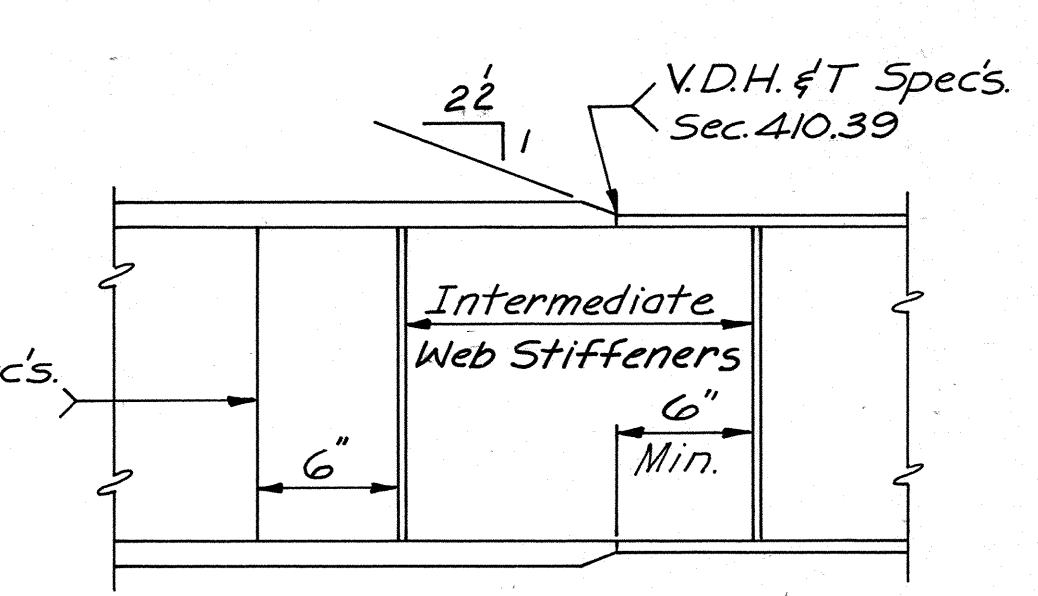

WELDED SPLICE DETAIL

NO.	BY	DATE	As Built	TEM	3-89
MADE	ALC	3-87	Added Diaphs.	ALC	5-87
CHECKED	T.F.P.	3-87	Revised Conn. Pl.	T.F.P.	4-87
IN CHARGE	SR.				
	NO.	REVISION	BY	DATE	

NOTES:
Capacity = 6010 lbs. per stud shear spacing shown is maximum spacing.
All connections shall be made with 3/8"φ H.S. Bolts and shall conform to ASTM A-325.





AS BUILT

RICHMOND METROPOLITAN AUTHORITY
RICHMOND EXPRESSWAY SYSTEM

STEEL DETAILS

HOWARD, NEEDLES, TAMMEN & BERGENDOFF
consulting engineers
Alexandria, Virginia

SCALE: AS SHOWN
CONTRACT NO.: C-13
SHEET NO. 45 of 106

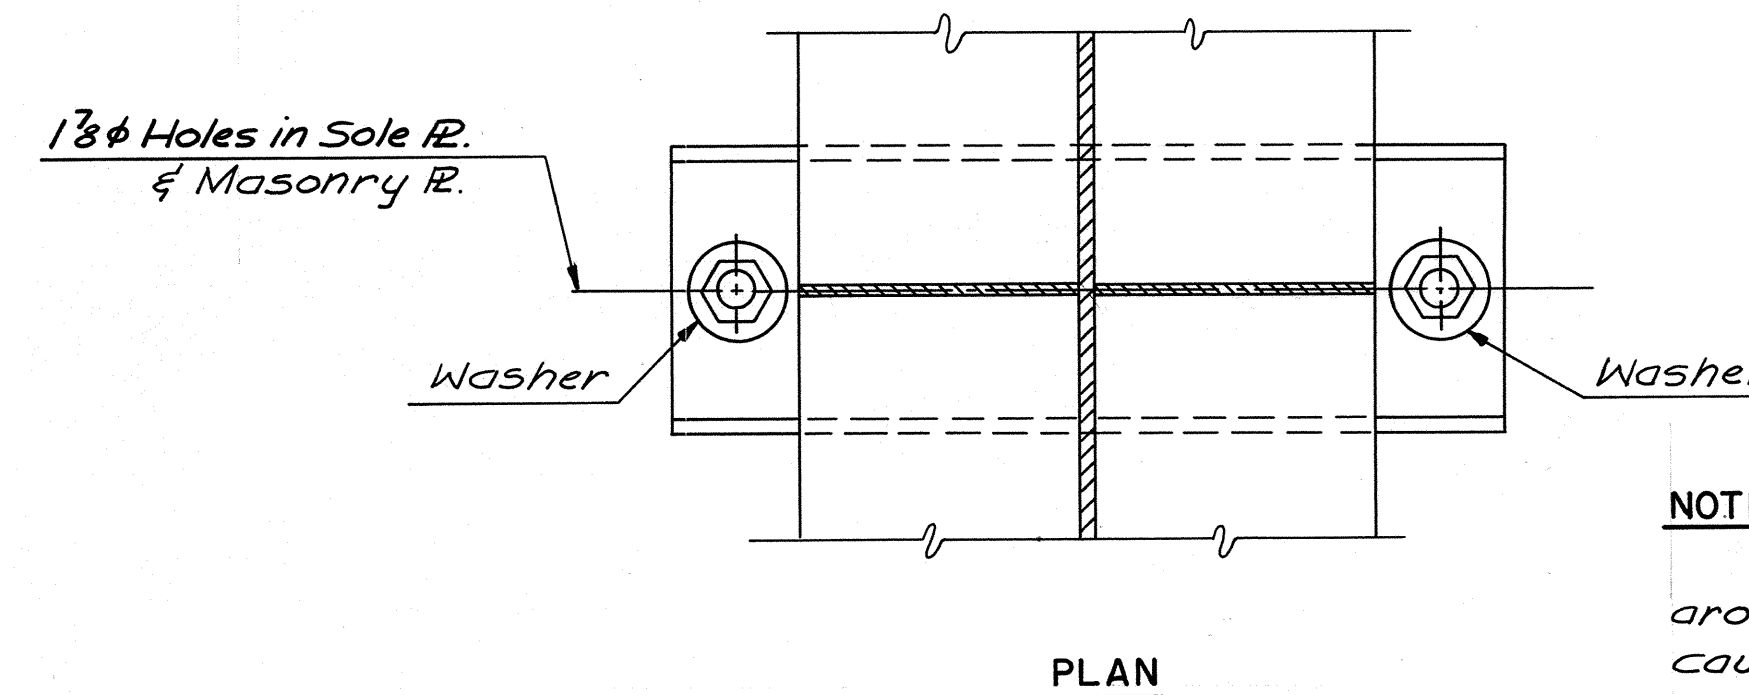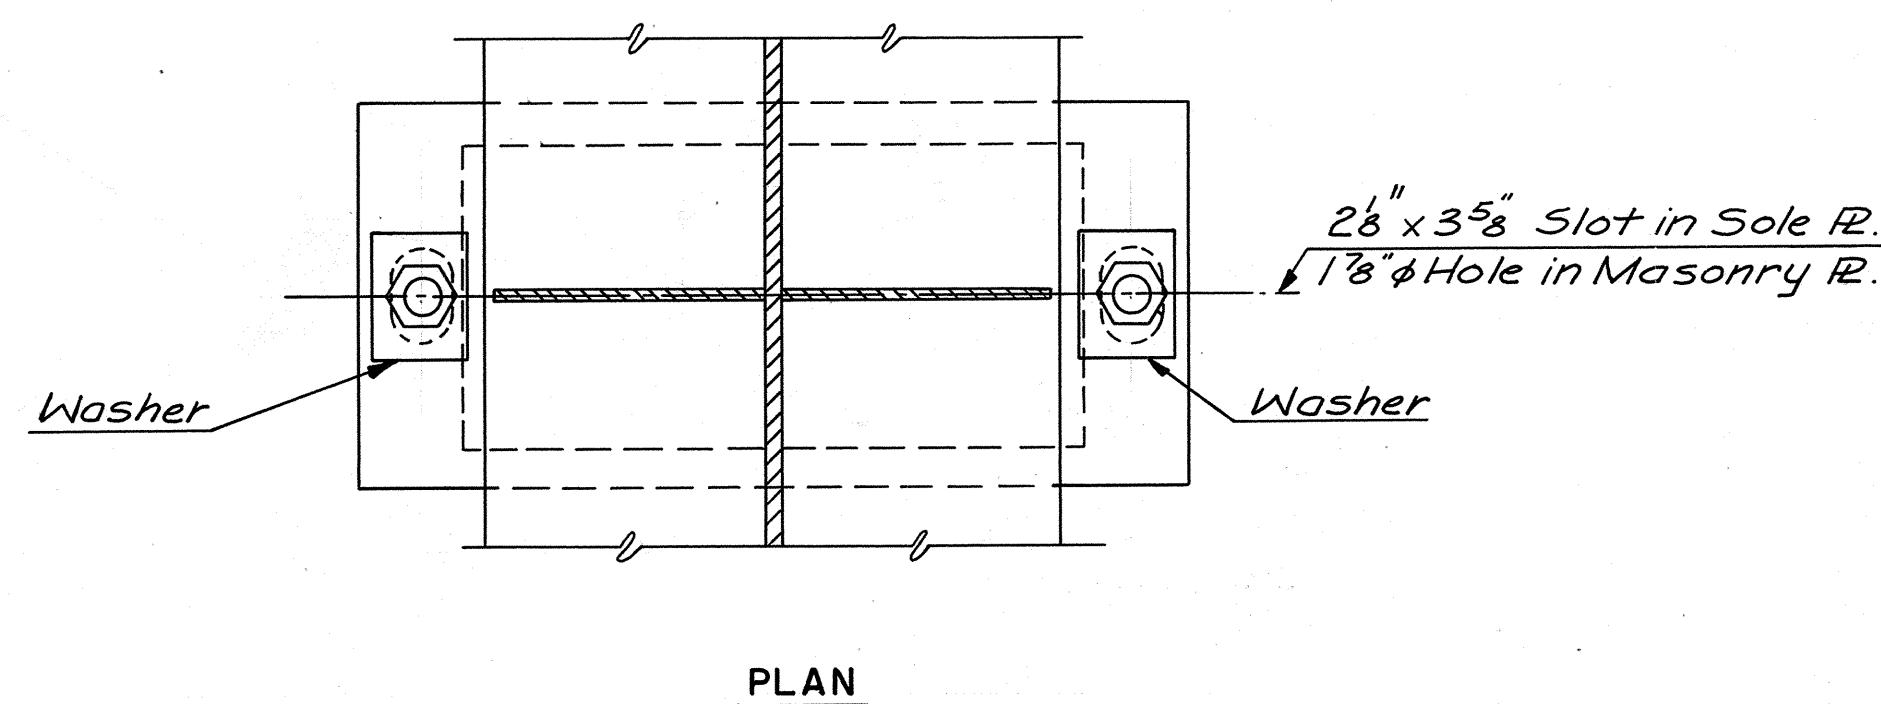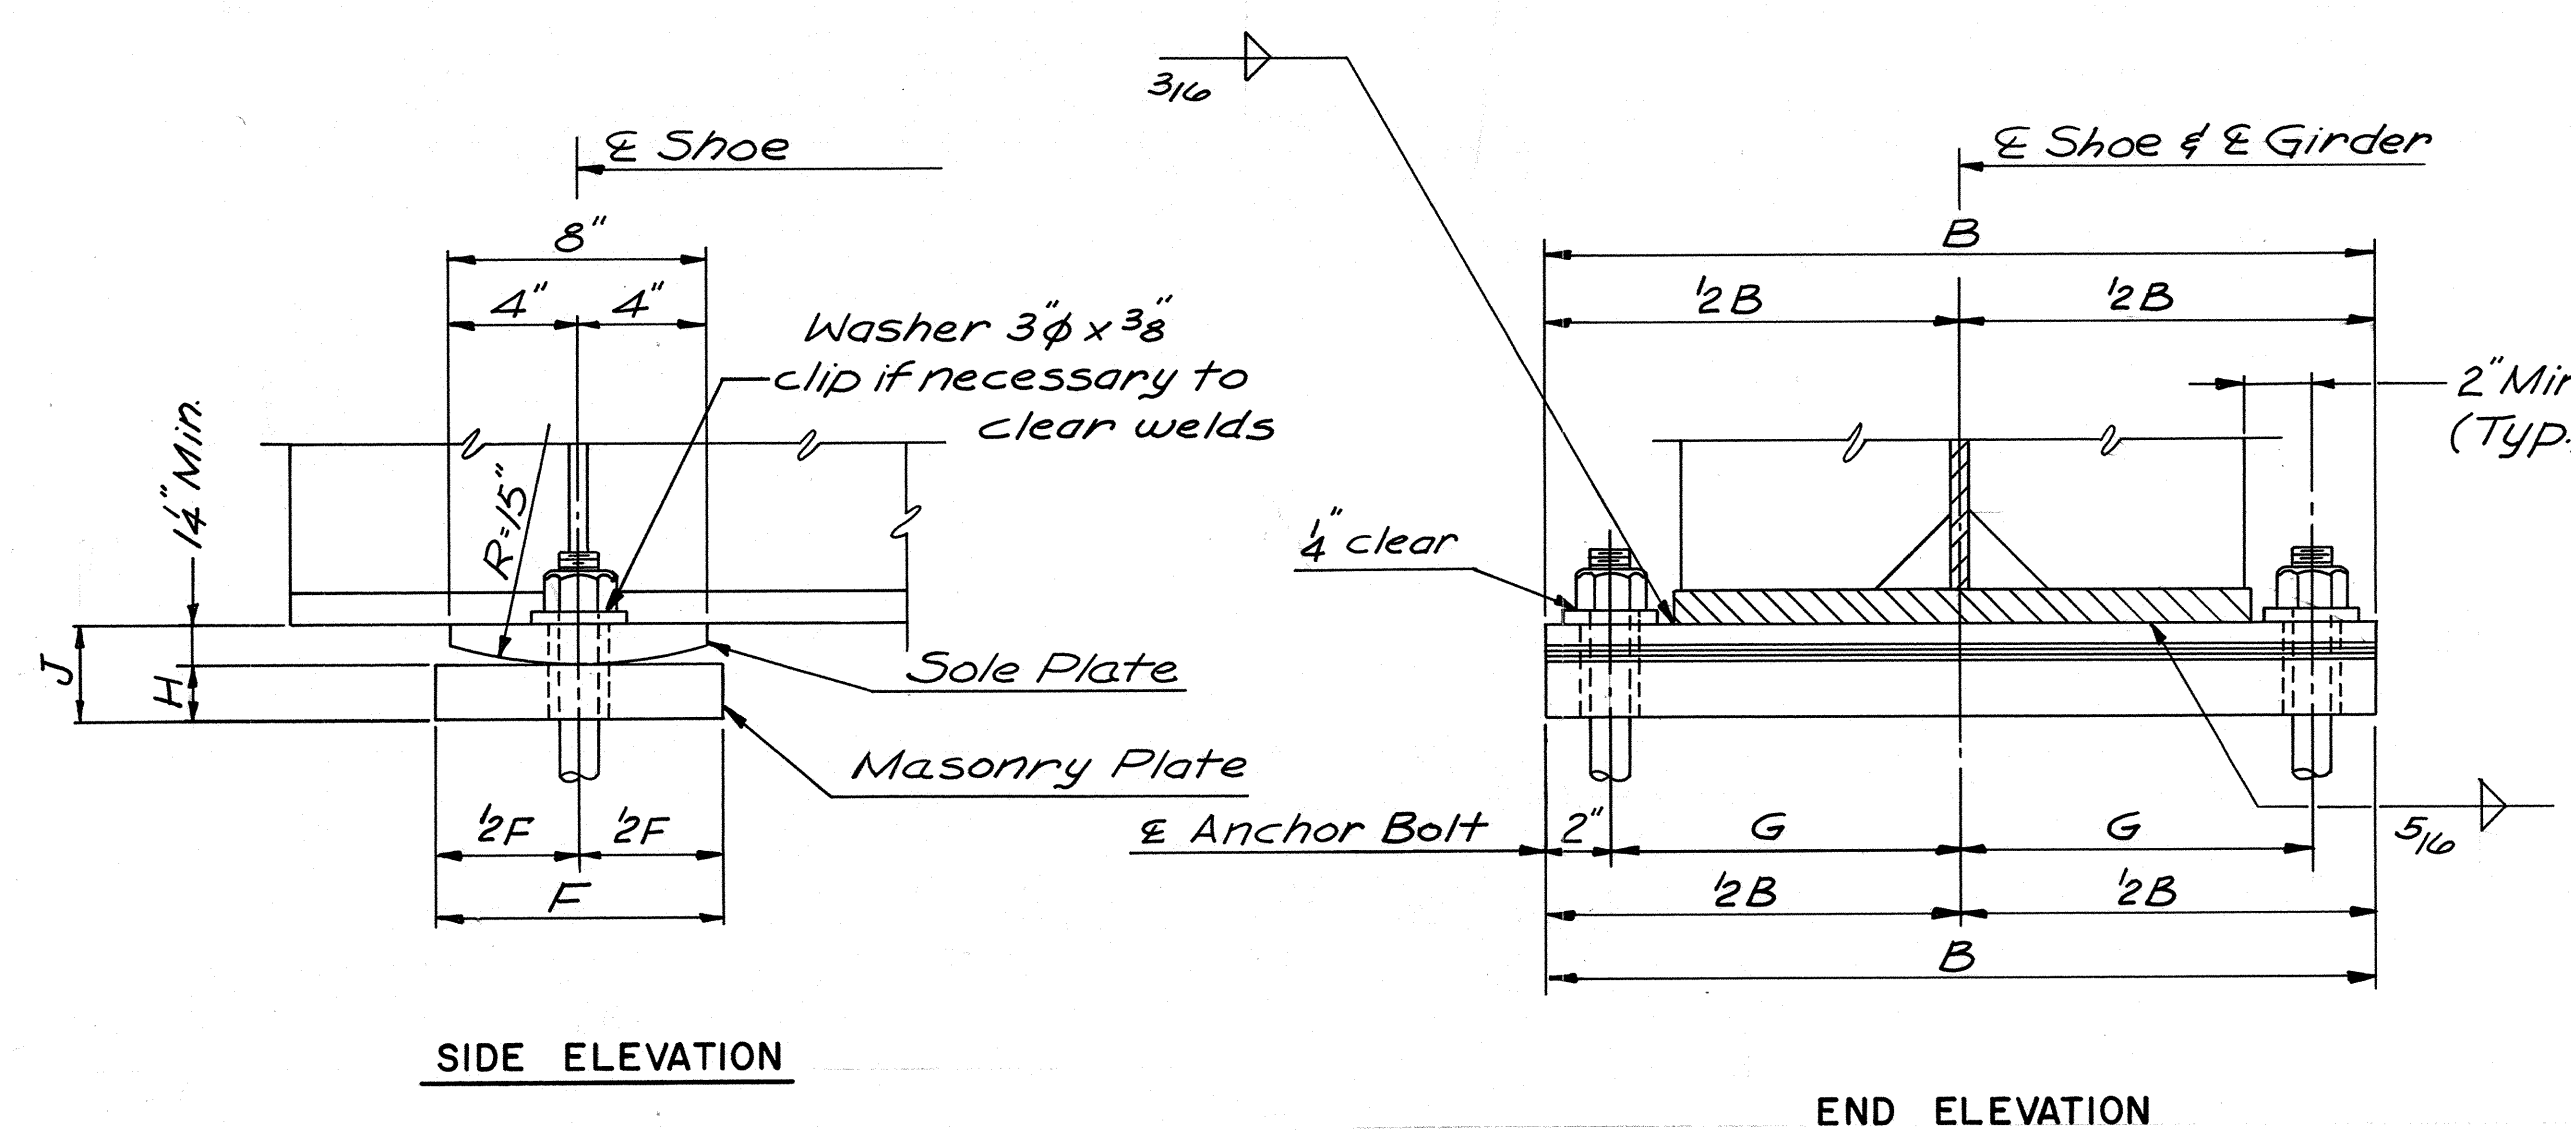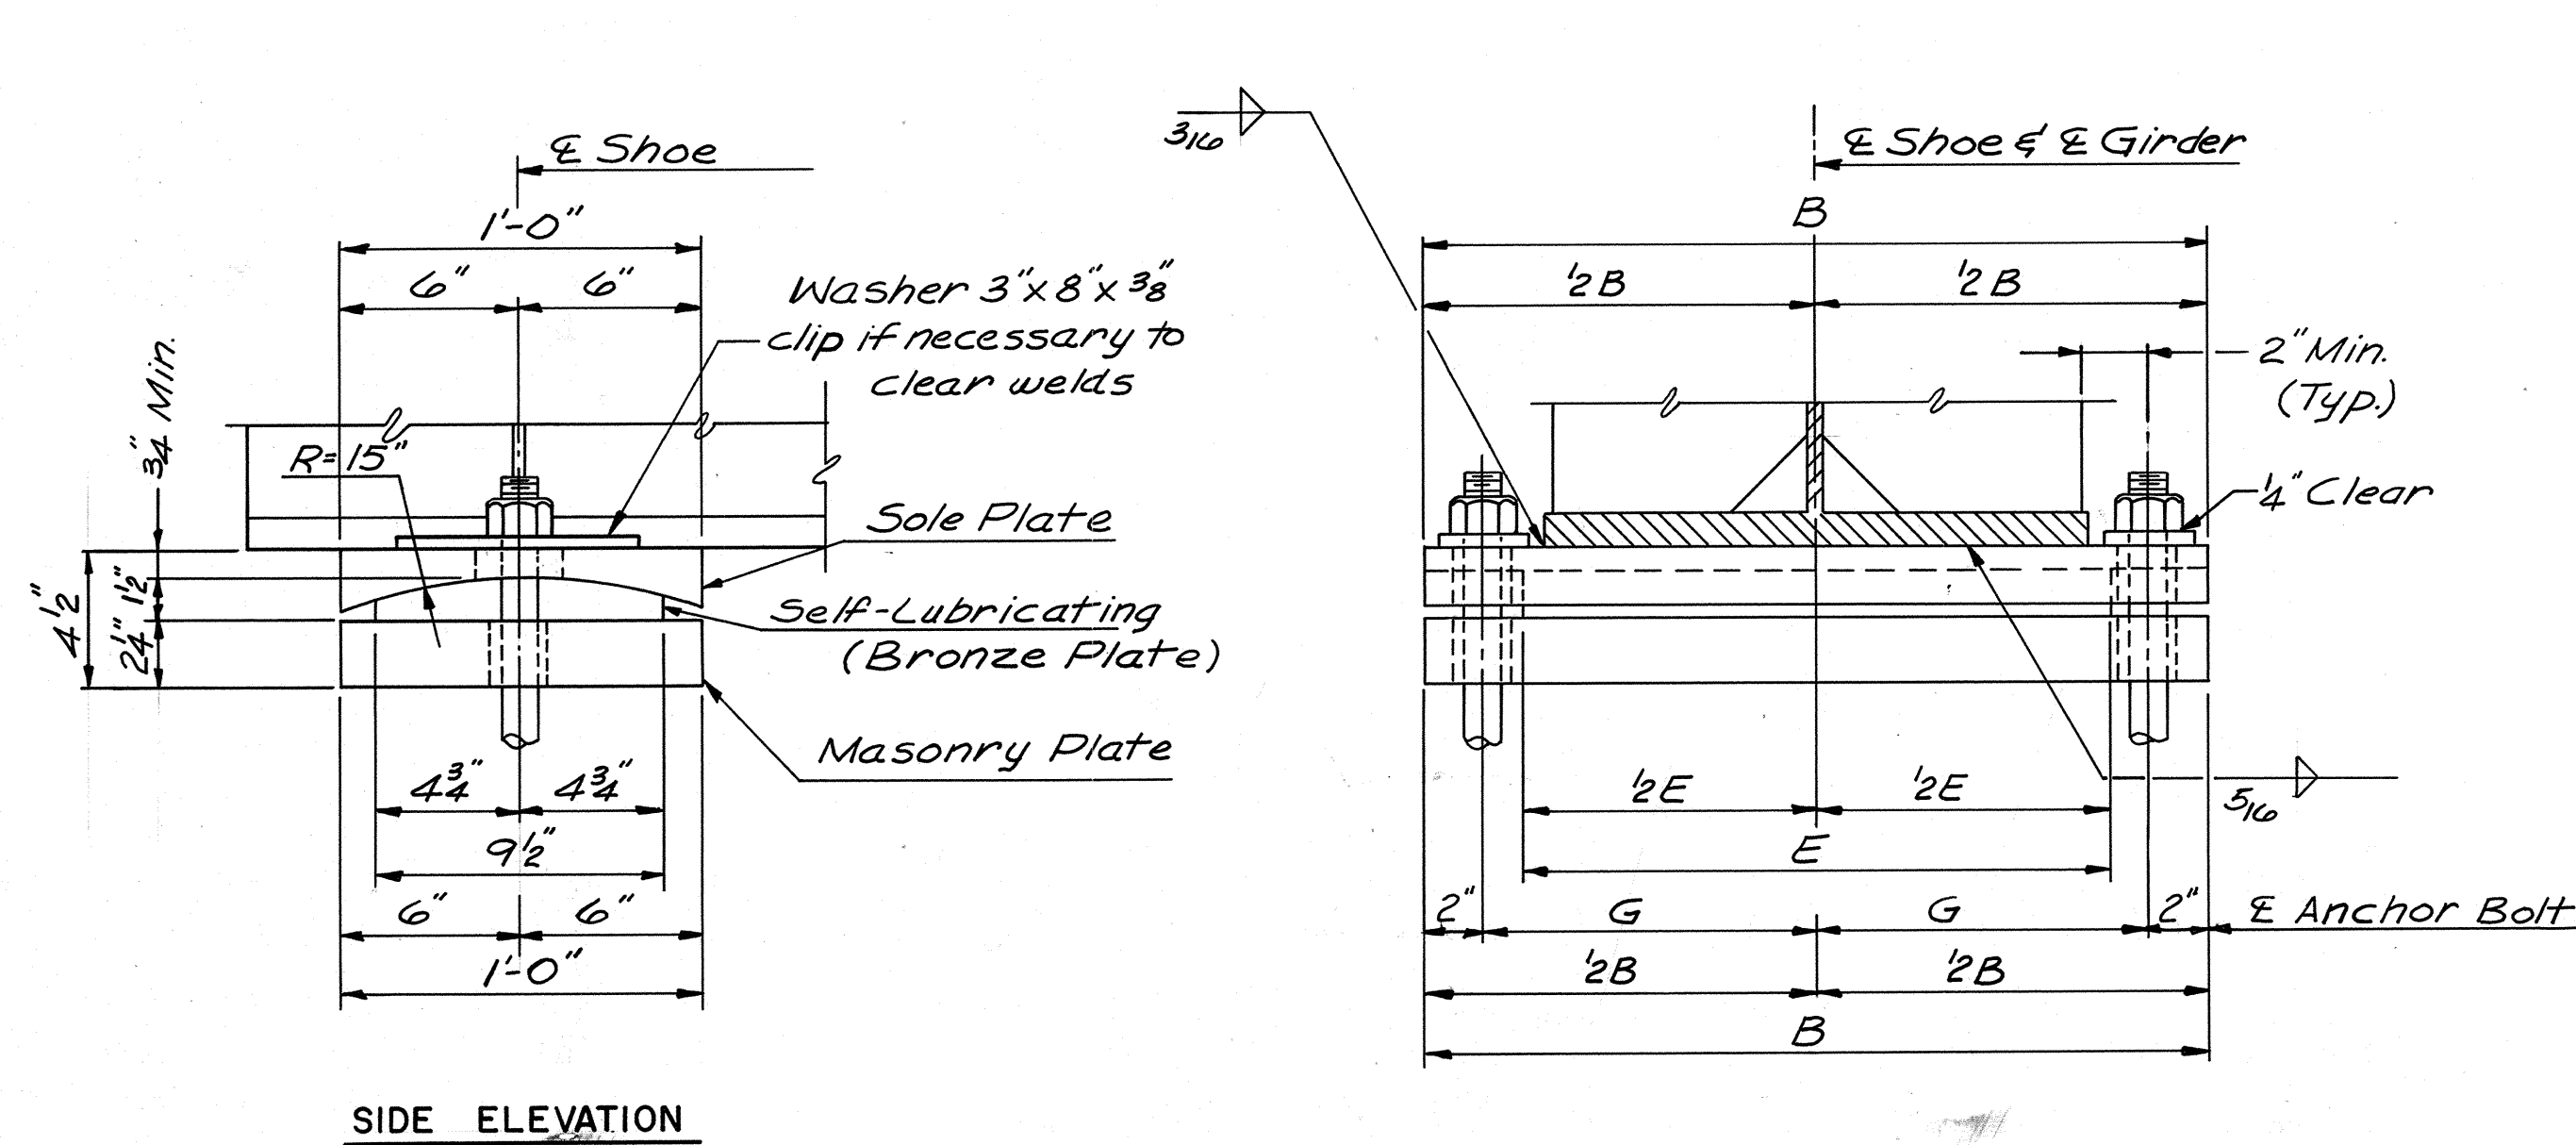

EXPANSION SHOE EB-2
No Scale


FIXED SHOE
No Scale

NOTES:

Fill slots and holes in masonry plate around anchor bolts with a nonhardening caulking compound or elastic joint sealer. For expansion bearing, bevel sole plate to match grade. Steel in bearing may be ASTM A36, A572, Grade 50, or A588 and shall be painted. Surface of sole plate and masonry plate in contact with bronze plates shall not be painted, but coated with multipurpose grease before shipment. Prior to assembly in place these surfaces shall be thoroughly coated with additional antioxidant lubricant furnished by the manufacturer. Radius may be machined to compensate for grade. Bearing shall be set so that at 68°F, it is at the midpoint of its movement. For Expansion bearing, 15" Radius tolerances:
Sole Plate $-0, +0.1$ "
Bronze Plate $-0.1, +0$ "

EXPANSION SHOES											
SHOE TYPE	NO. REQ'D	A	B	C	D	E	F	G	H	J	L
EB-2-16	24		2'-0"			1'-5 1/2"		10"			1'-7"
EB-2-18	18		2'-2"			1'-7 1/2"		11"			1'-7"
EB-2-20	66		2'-4"			1'-9 1/2"		1'-0"			1'-7"

FIXED SHOES											
SHOE TYPE	NO. REQ'D	A	B	C	D	E	F	G	H	J	L
FB-8-16	24		2'-0"				8"	10"	1 1/2"	2 3/4"	1'-2"
FB-9-18	18		2'-2"				9"	11"	1 1/2"	4 1/2"	1'-2 1/4"
FB-9-20	66		2'-4"				9"	1'-0"	1 1/2"	4 1/2"	1'-2 1/4"

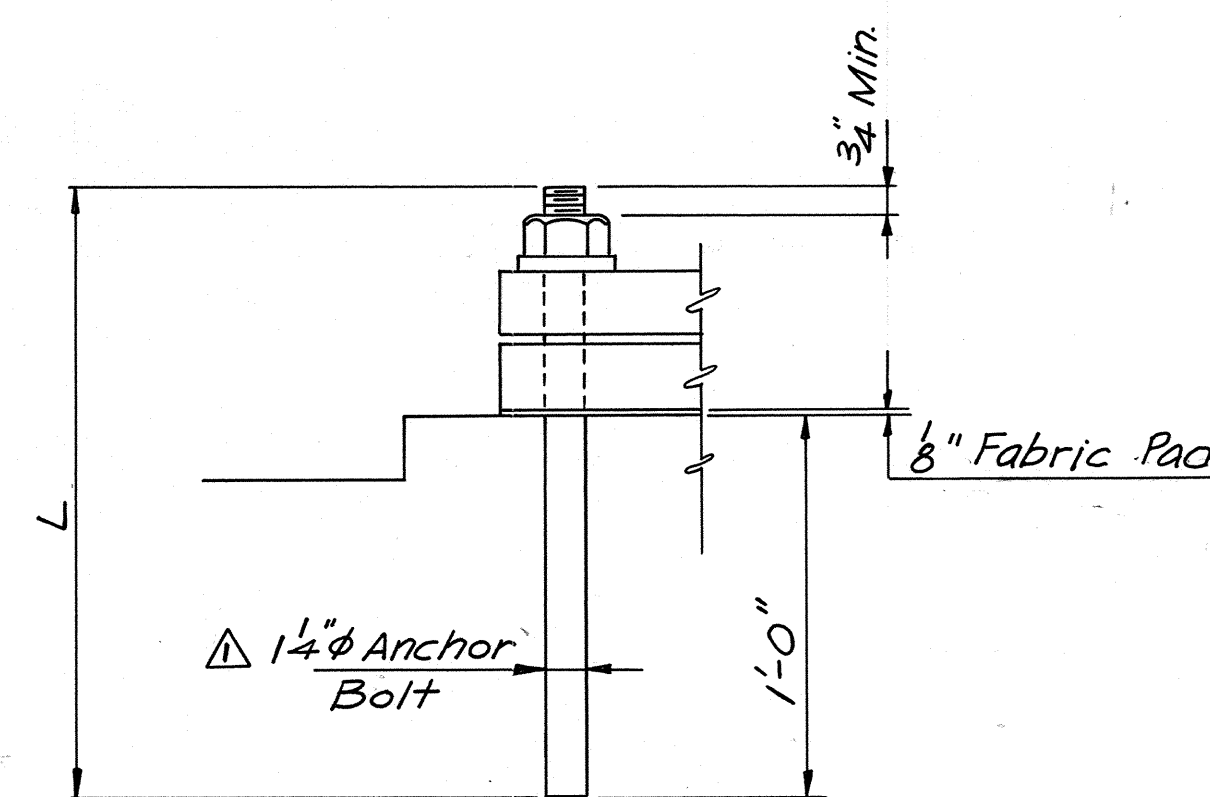

ANCHOR BOLT DETAIL
No Scale

BY	DATE				
MADE	ALC 2-87	As Built	TEM	3-89	
CHECKED	TFP 3-87	1/4" Anchor Bolt	ALC	4-87	
IN CHARGE	S.R.				

AS BUILT


RICHMOND METROPOLITAN AUTHORITY
RICHMOND EXPRESSWAY SYSTEM

SHOE DETAILS


HOWARD, NEEDLES, TAMMEN & BERGENDOFF
consulting engineers
Alexandria, Virginia

SCALE: AS SHOWN
CONTRACT NO. C-13
SHEET NO. 46 OF 106


RICHMOND EXPRESSWAY SYSTEM			
SECTION	PROJECT	SHEET NO.	TOTAL SHEETS
13	WIDENING JAMES RIVER BRIDGE	51	106

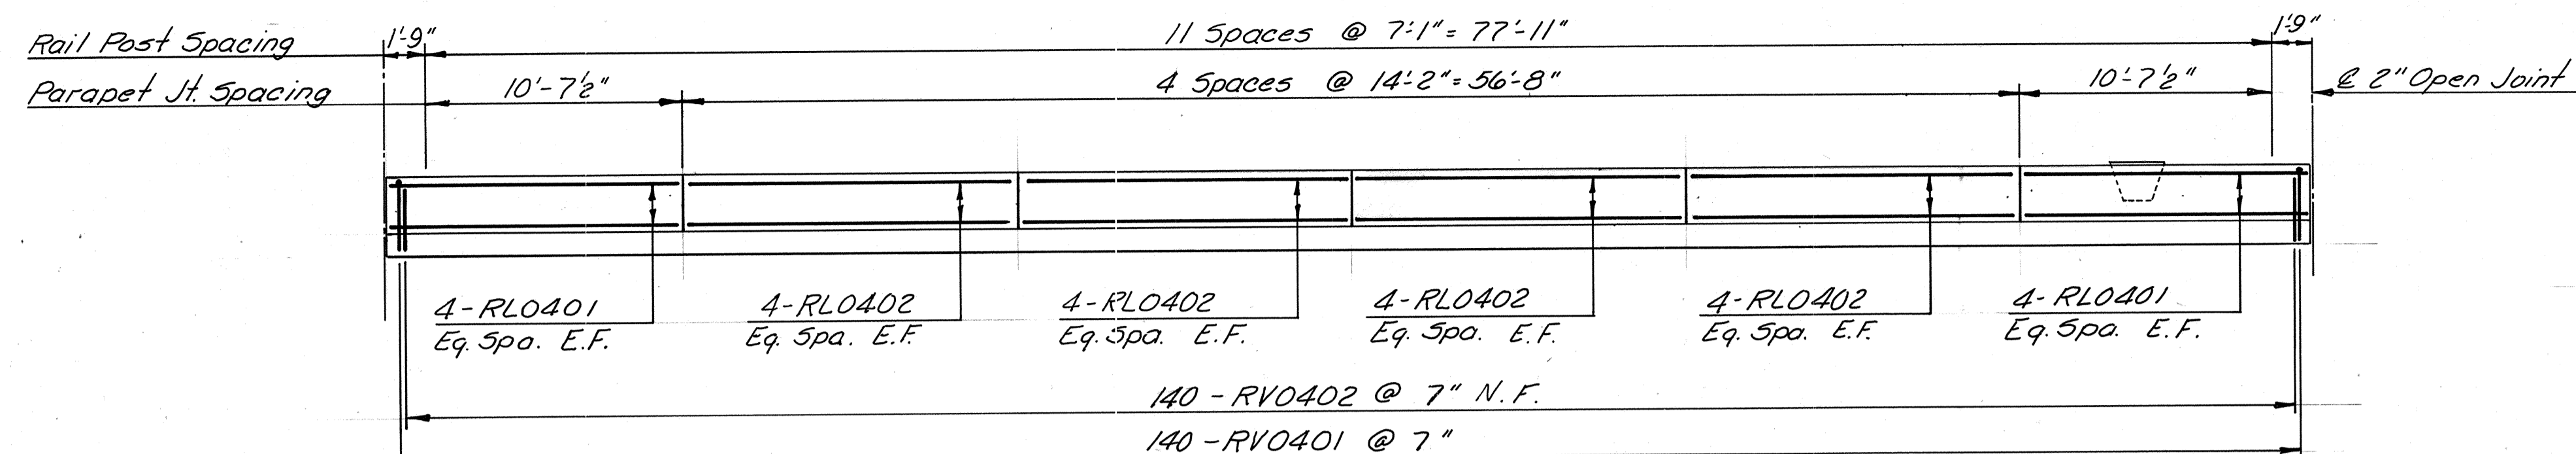

PARAPET ELEVATION - UNIT I SOUTHBOUND & NORTHBOUND
(SOUTHBOUND SHOWN)
Scale: 3/16" = 1'-0"

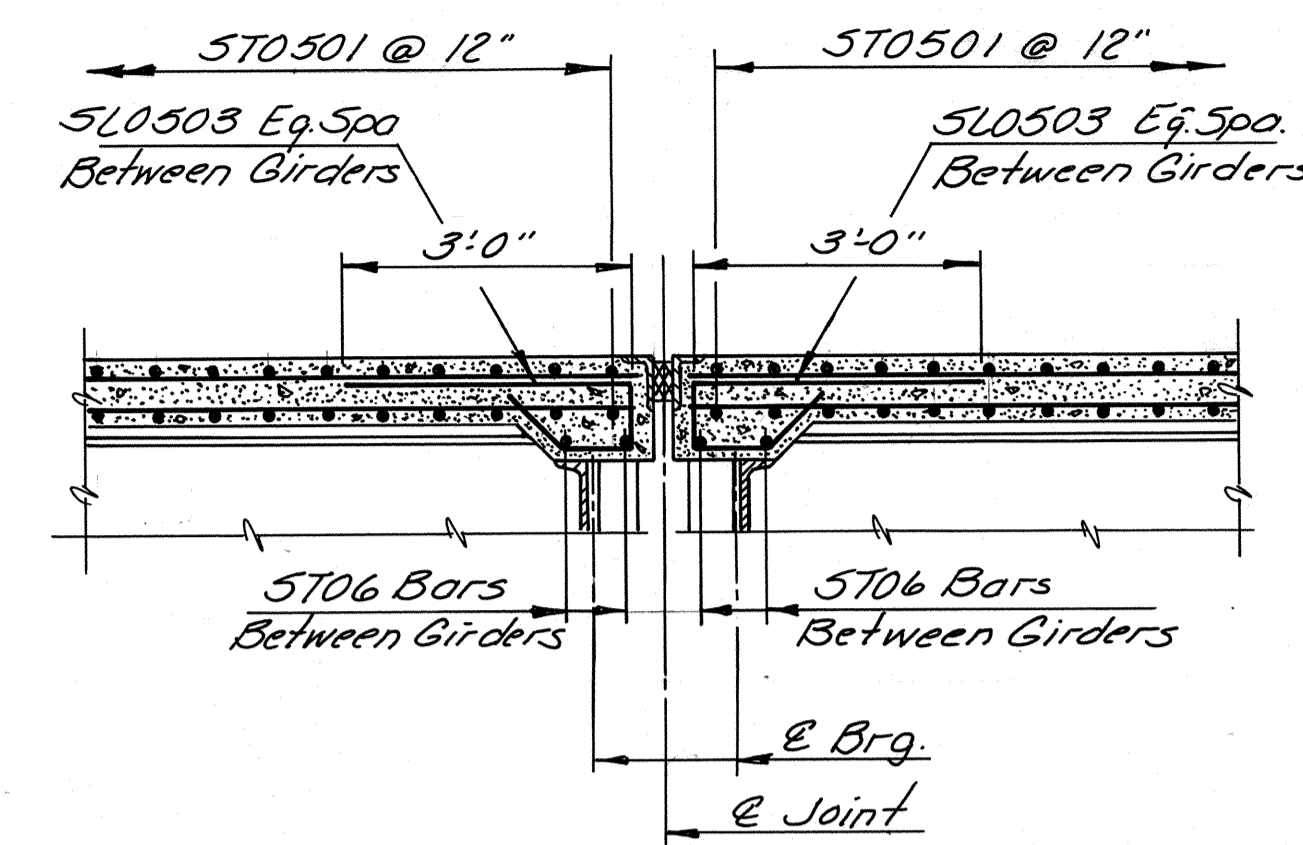

TYPICAL SECTION AT JOINT
Scale: 1/2" = 1'-0"

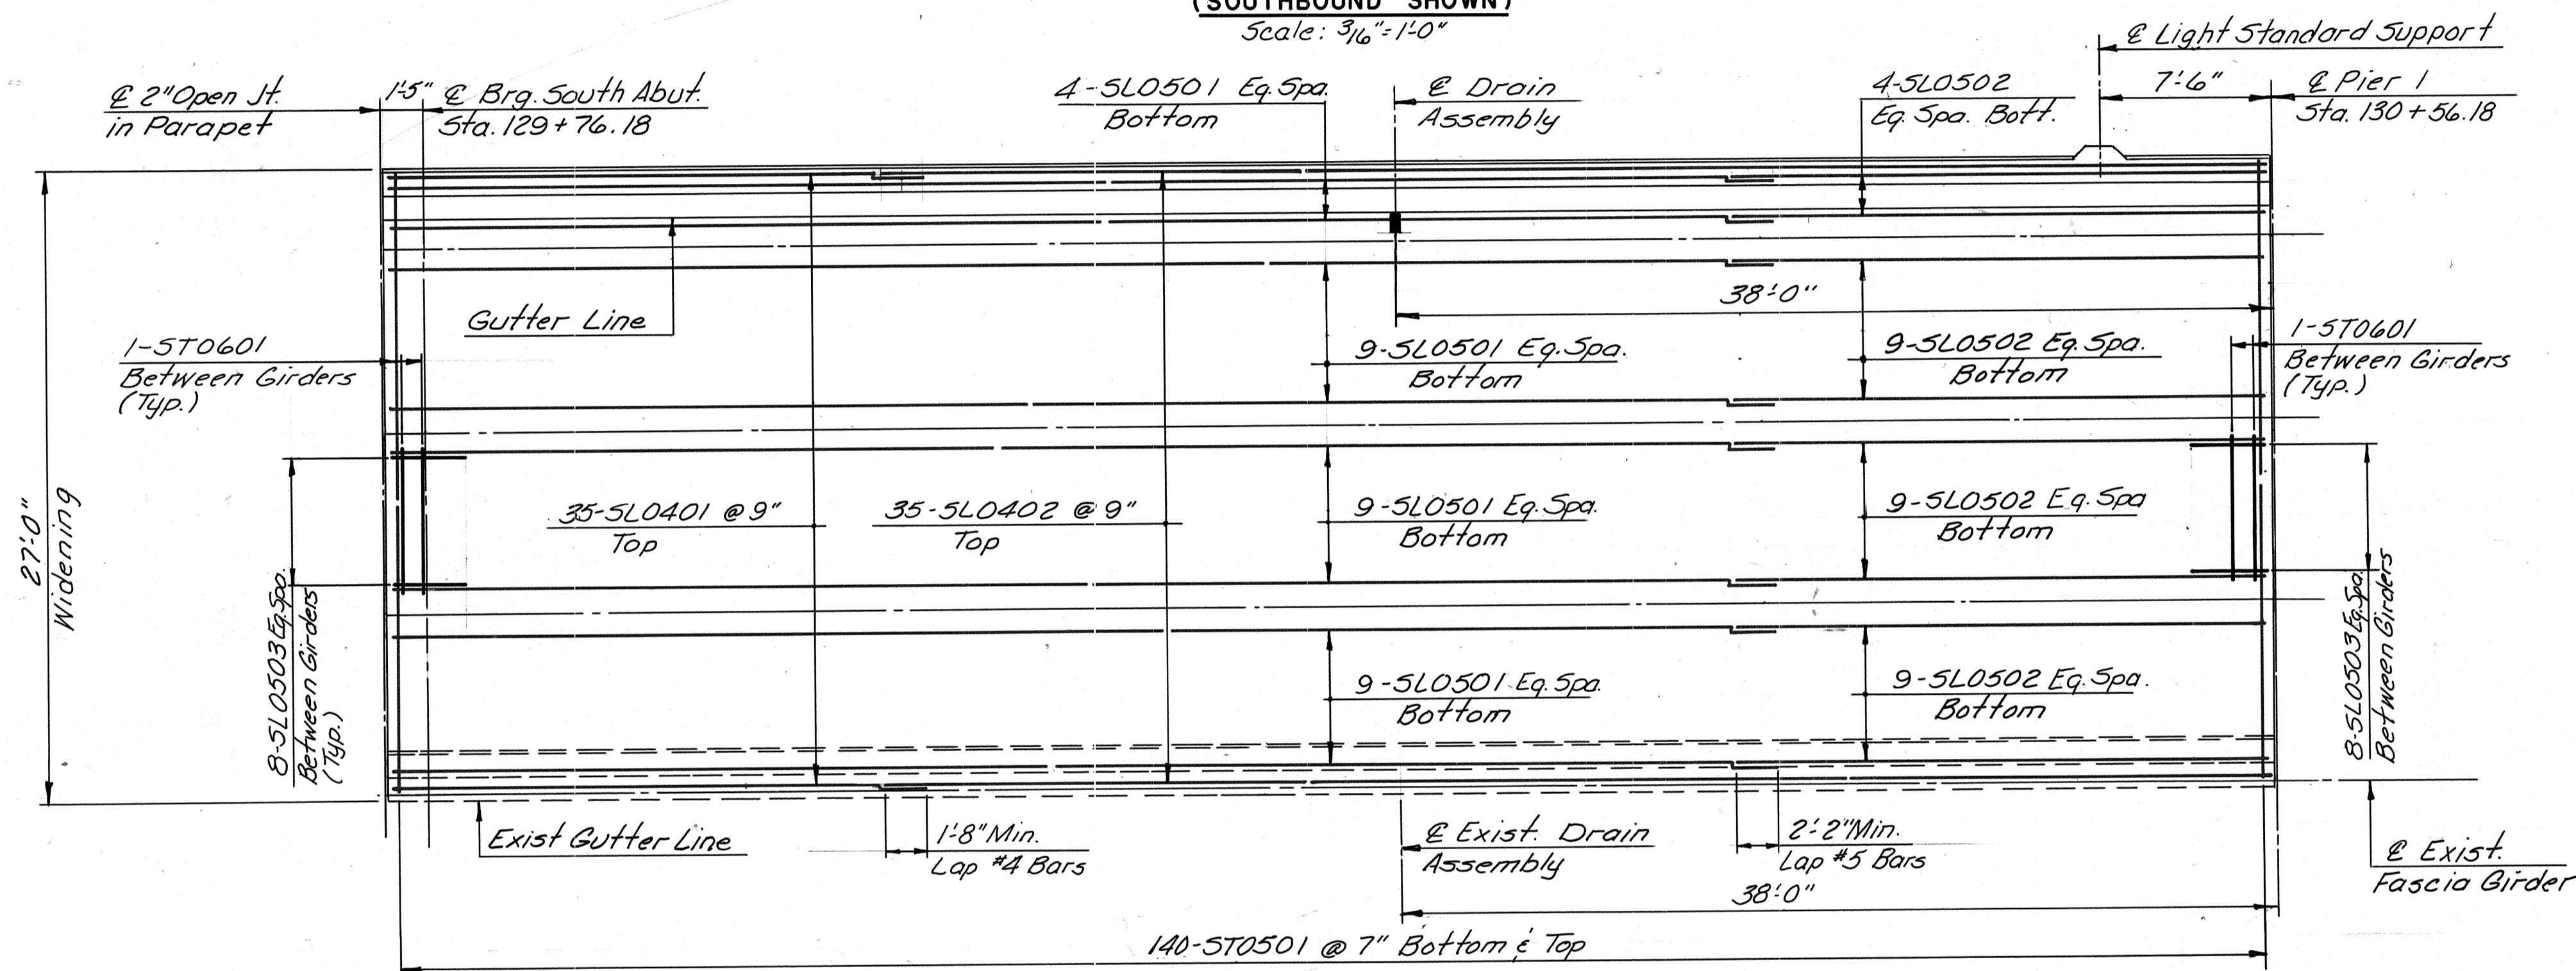

DECK PLAN - UNIT I SOUTHBOUND & NORTHBOUND
(SOUTHBOUND SHOWN)
Scale: 3/16" = 1'-0"

BY	DATE				
MADE	TAL	3-87			
CHECKED	T.F.R.	3-87	As Built	TEM	3-89
IN CHARGE	S.R.				

AS BUILT


RICHMOND METROPOLITAN AUTHORITY
RICHMOND EXPRESSWAY SYSTEM

DECK PLAN
UNIT I SOUTHBOUND & NORTHBOUND


HOWARD, NEEDLES, TAMMEN & BERGENDOFF
consulting engineers
Alexandria, Virginia

SCALE: AS SHOWN
CONTRACT NO.: C-13
SHEET NO. 51 OF 106

RICHMOND EXPRESSWAY SYSTEM			
SECTION	PROJECT	SHEET NO.	TOTAL SHEETS
13	WIDENING JAMES RIVER BRIDGE	52	106

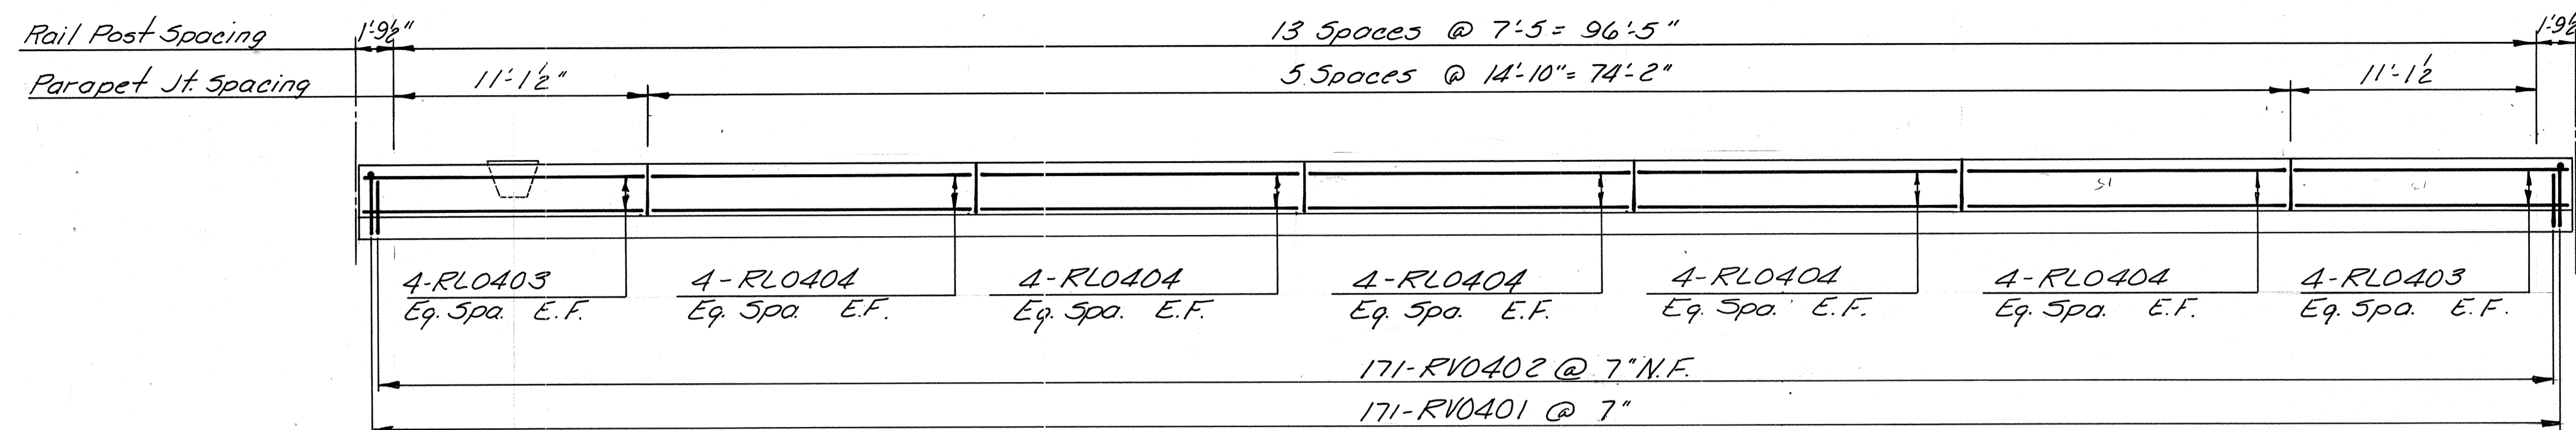

PARAPET ELEVATION - UNITS 2 & 3 SOUTHBOUND & NORTHBOUND
(SOUTHBOUND SHOWN)
Scale: 3/16" = 1'-0"

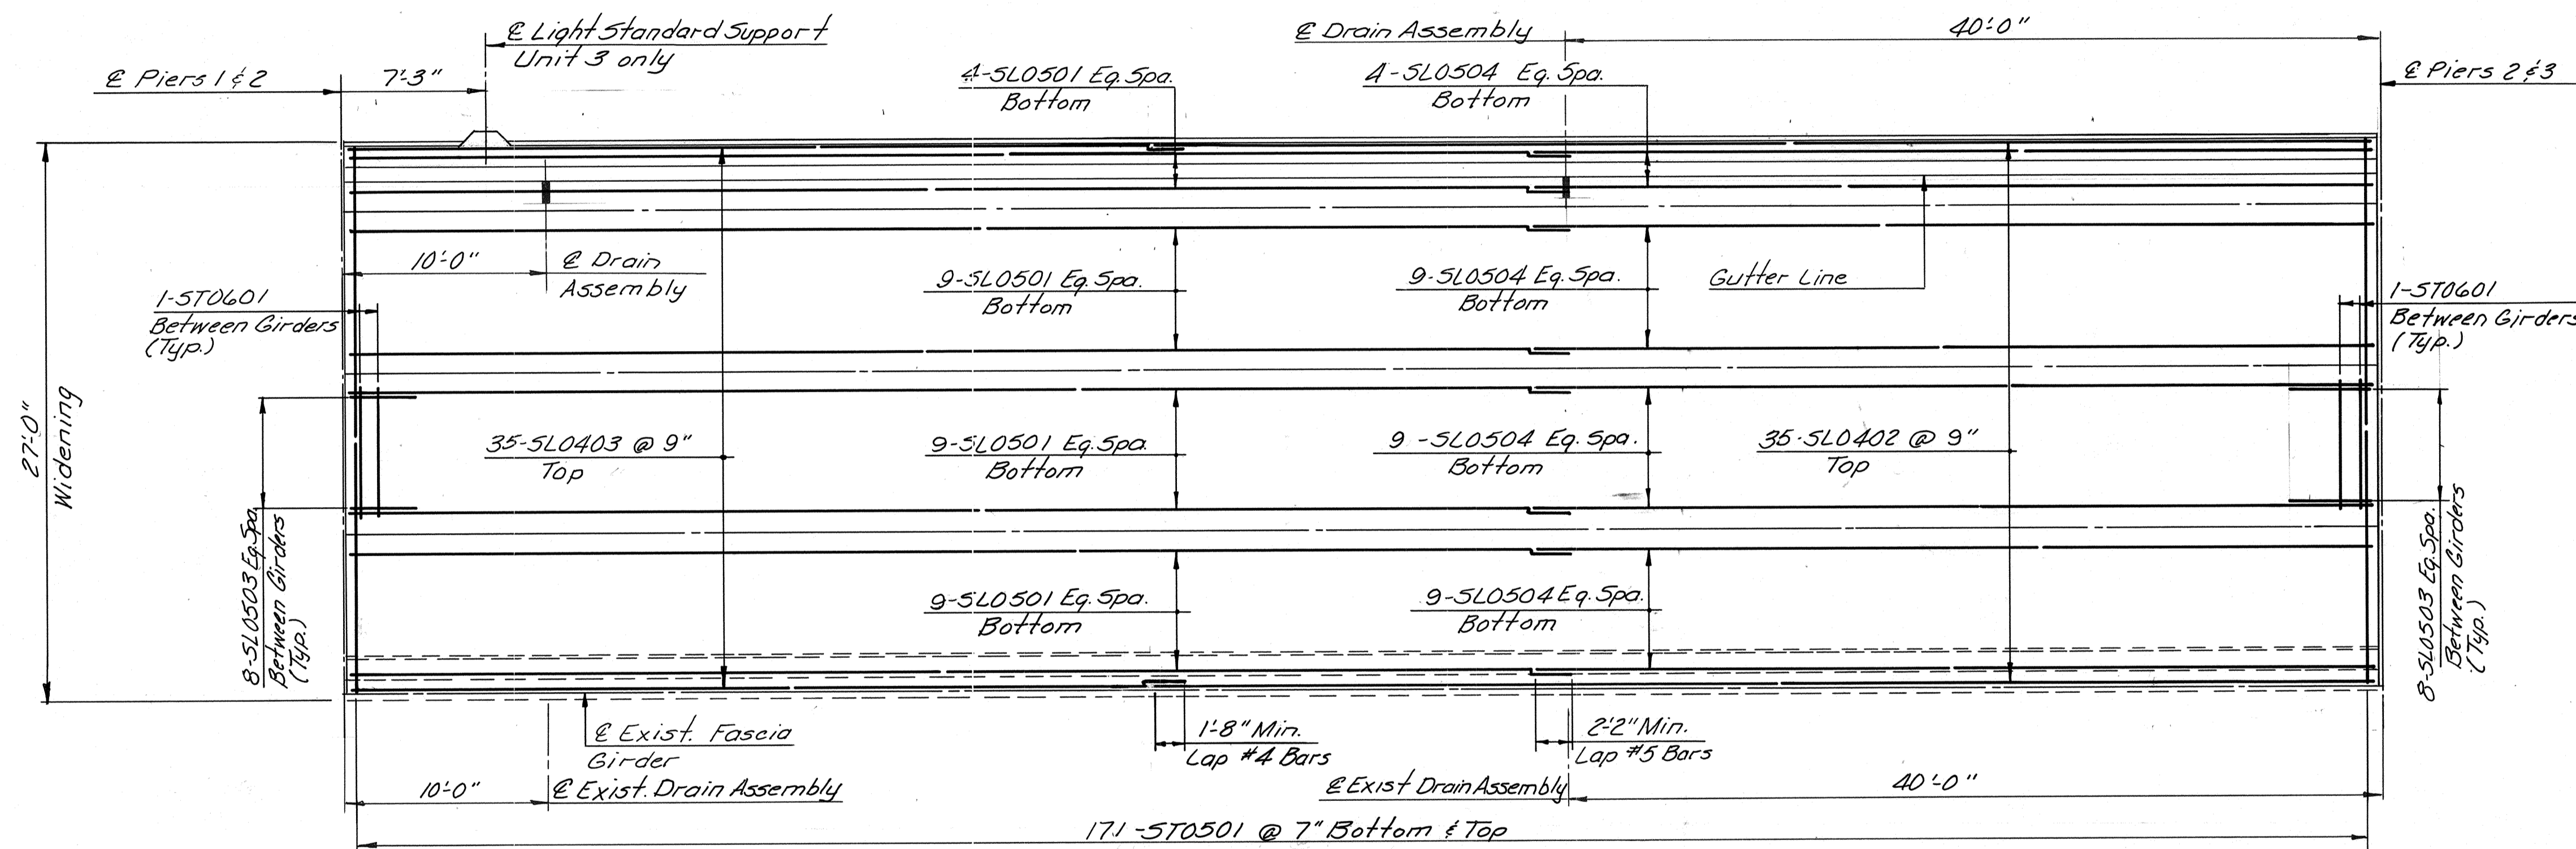

DECK PLAN - UNITS 2 & 3 SOUTHBOUND & NORTHBOUND
(SOUTHBOUND SHOWN)
Scale: 3/16" = 1'-0"

	BY	DATE			
MADE	TAL	3-87			
CHECKED	TEP	3-87	As Built	TEM	3-89
IN CHARGE	S.R.				

**RICHMOND METROPOLITAN AUTHORITY
RICHMOND EXPRESSWAY SYSTEM**


**DECK PLAN
UNITS 2 & 3 SOUTHBOUND & NORTHBOUND**

HOWARD, NEEDLES, TAMMEN & BERGENDOFF
consulting engineers
Alexandria, Virginia

SCALE: AS SHOWN
CONTRACT NO.: C-13
SHEET NO. 52 OF 106


AS BUILT

RICHMOND EXPRESSWAY SYSTEM			
SECTION	PROJECT	SHEET NO.	TOTAL SHEETS
13	WIDENING JAMES RIVER BRIDGE	53	106

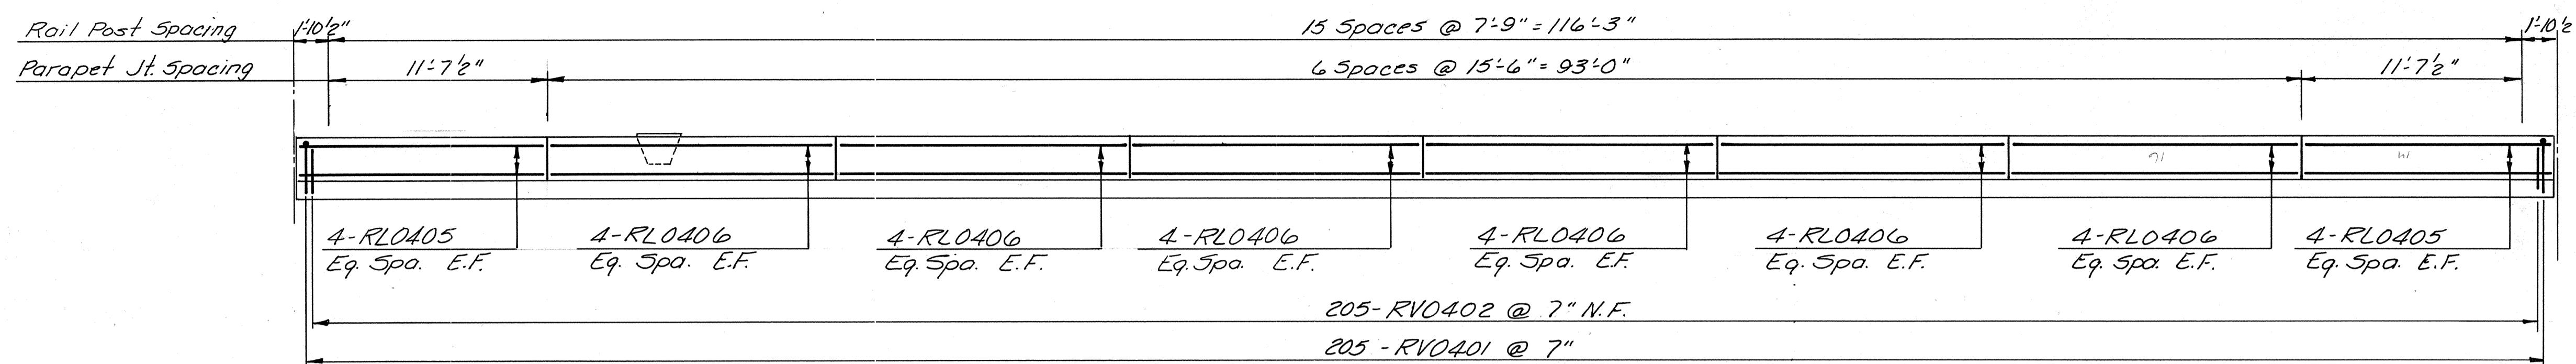

**PARAPET ELEVATION - UNIT 4 SOUTHBOUND & NORTHBOUND
(SOUTHBOUND SHOWN)**

Scale: 3/16" = 1'-0"

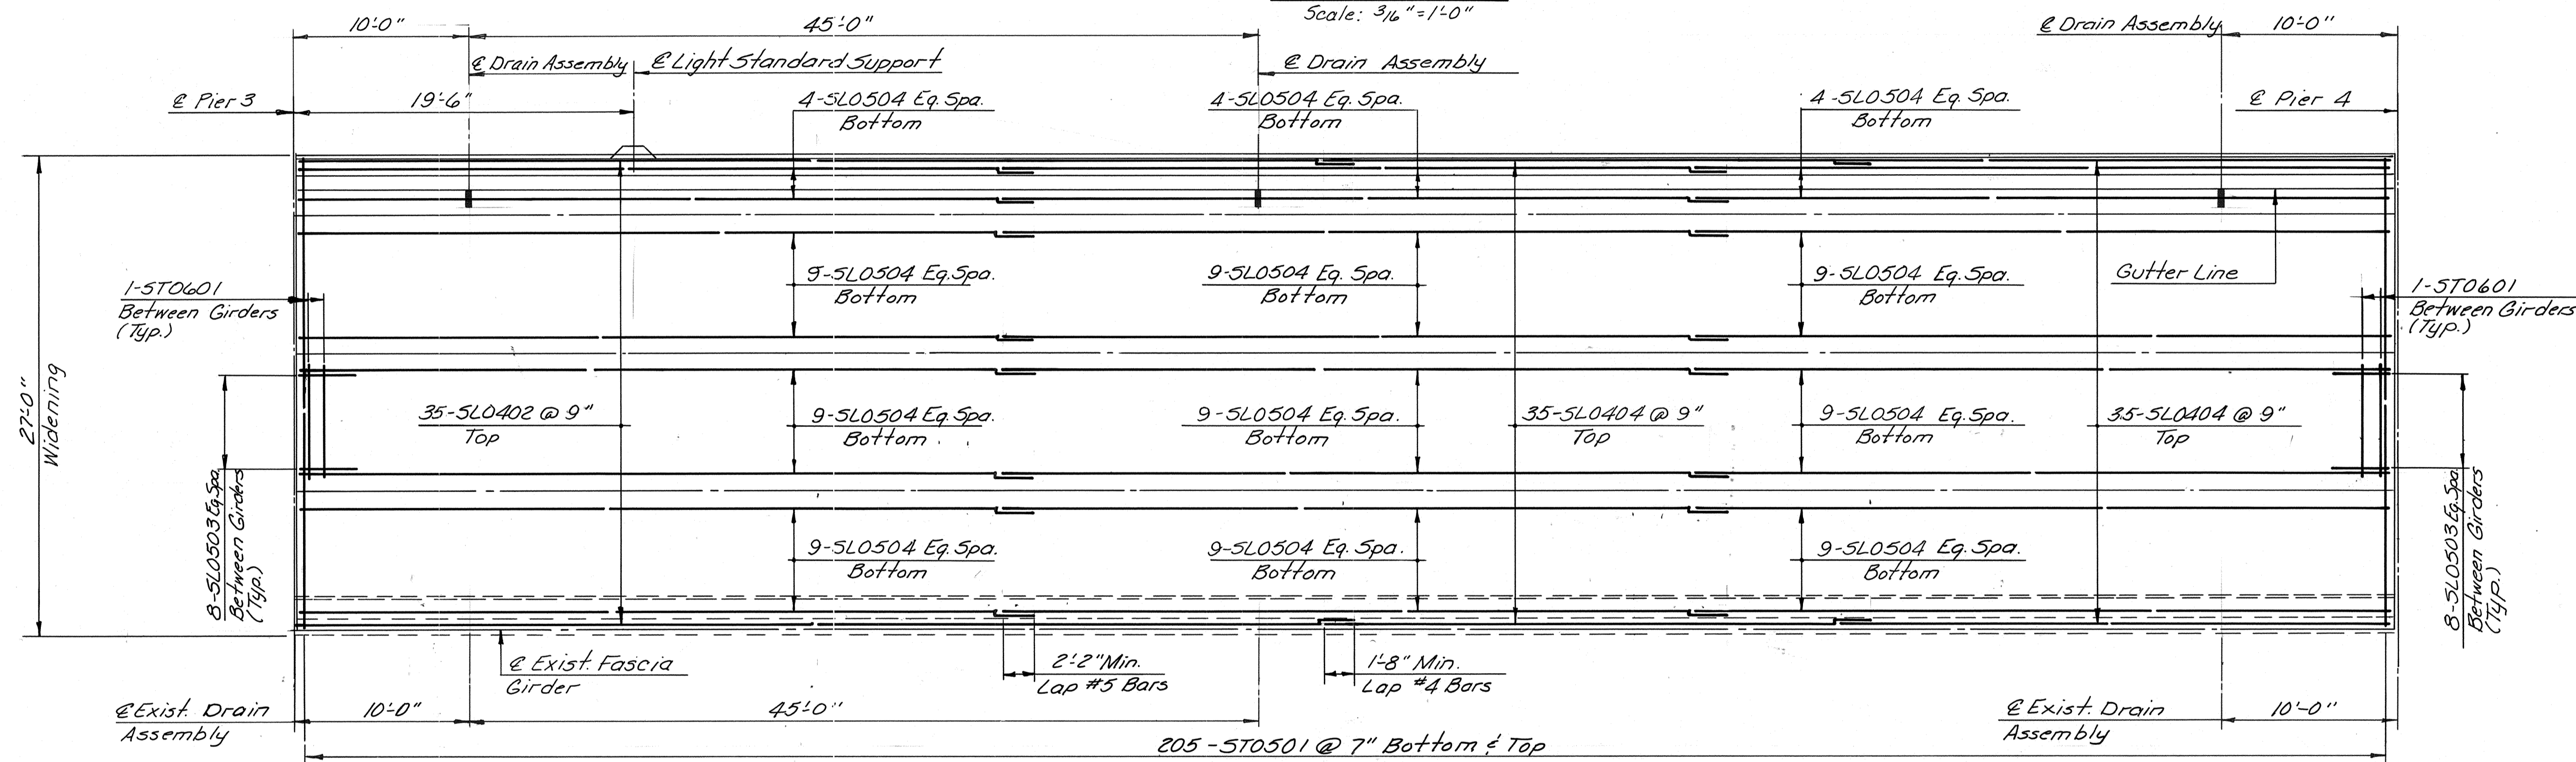

**DECK PLAN - UNIT 4 SOUTHBOUND & NORTHBOUND
(SOUTHBOUND SHOWN)**

Scale: 3/16" = 1'-0"

	BY	DATE			
MADE	TAL	3-87			
CHECKED	TFP	3-87	As Built	TEM	3-89
IN CHARGE	S.R.				

AS BUILT


**RICHMOND METROPOLITAN AUTHORITY
RICHMOND EXPRESSWAY SYSTEM**

**DECK PLAN
UNIT 4 SOUTHBOUND & NORTHBOUND**


HOWARD, NEEDLES, TAMMEN & BERGENDOFF
consulting engineers
Alexandria, Virginia

SCALE: AS SHOWN
CONTRACT NO.: C-13
SHEET NO. 53 OF 106


RICHMOND EXPRESSWAY SYSTEM			
SECTION	PROJECT	SHEET NO.	TOTAL SHEETS
13	WIDENING JAMES RIVER BRIDGE	54	106

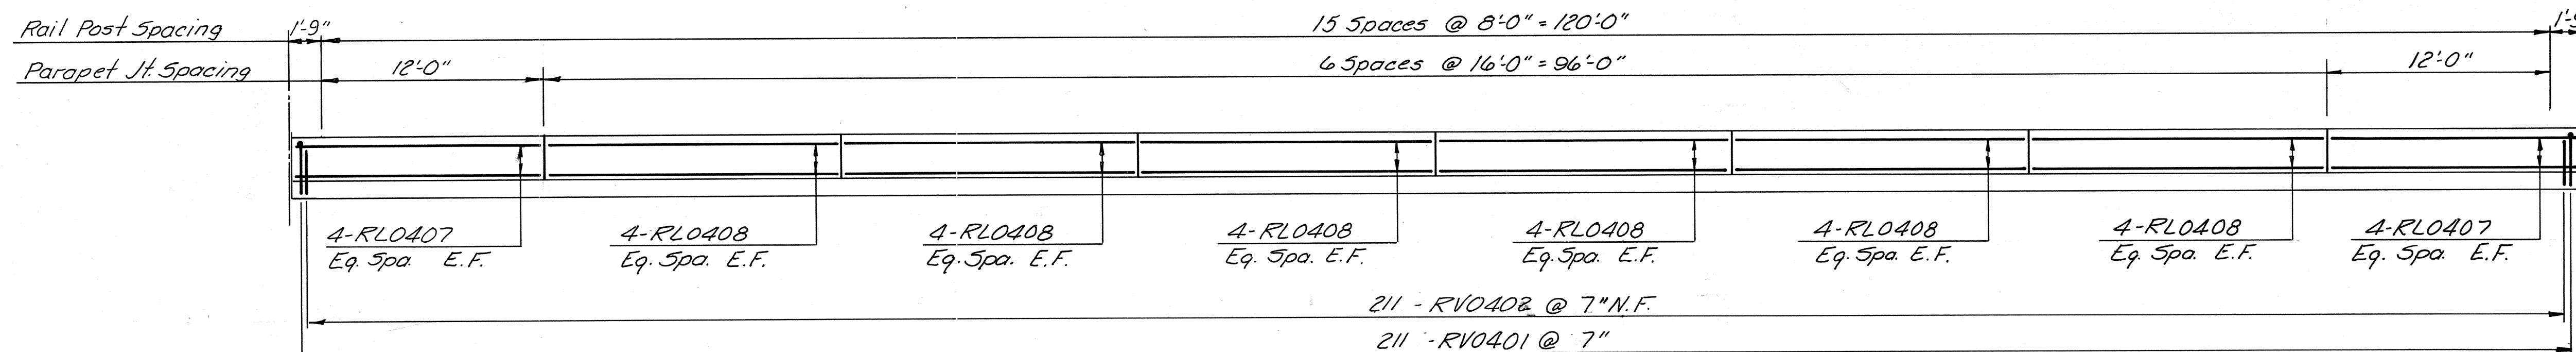

PARAPET ELEVATION - UNITS 5 THRU 12 SOUTHBOUND & NORTHBOUND
(SOUTHBOUND SHOWN)
Scale: 3/16"=1'-0"

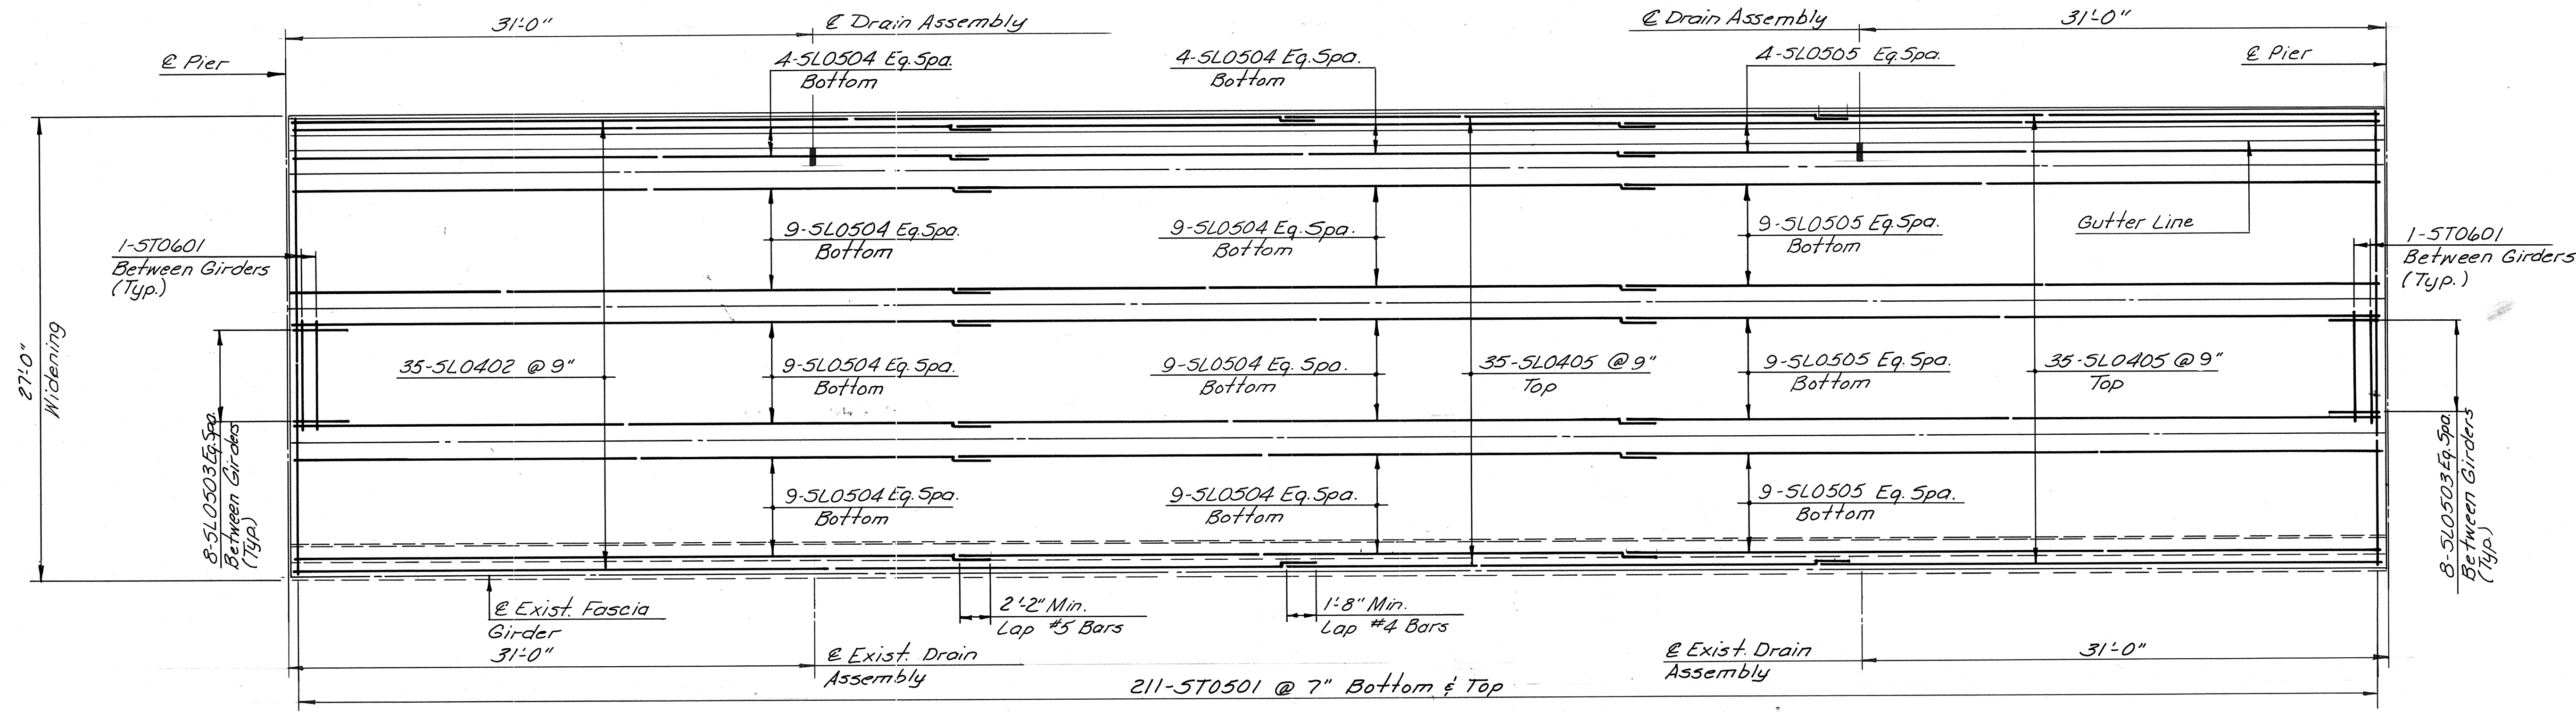

DECK PLAN - UNITS 5 THRU 12 SOUTHBOUND & NORTHBOUND
(SOUTHBOUND SHOWN)
Scale: 3/16"=1'-0"

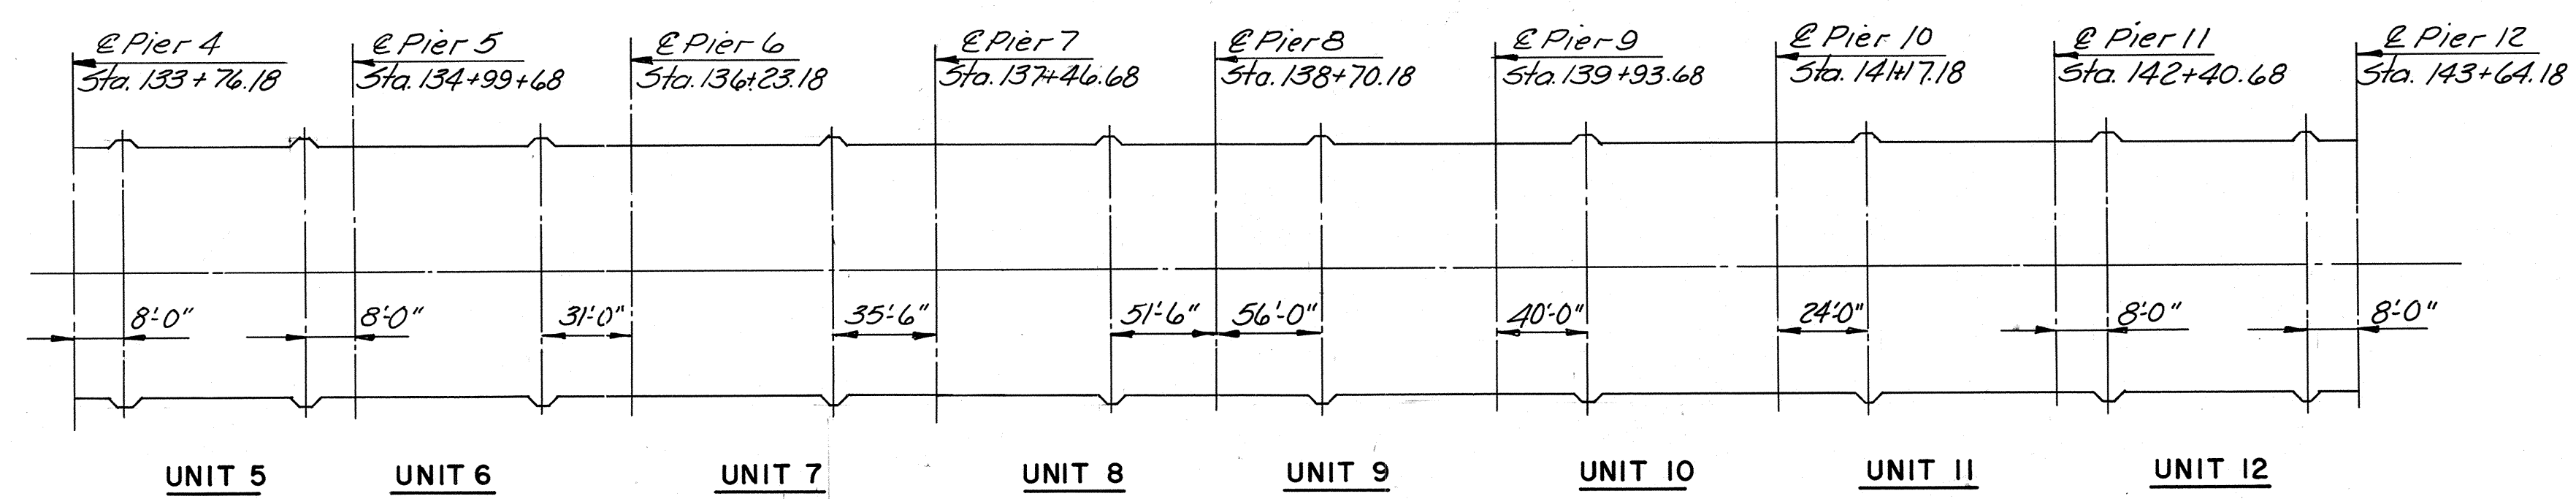

LIGHTING STANDARD LOCATIONS FOR UNITS 5 THRU 12
No Scale

	BY	DATE			
MADE	TAL	3-87			
CHECKED	TRP	3-87	As Built	TEM	3-89
IN CHARGE	S.R.				

AS BUILT


RICHMOND METROPOLITAN AUTHORITY
RICHMOND EXPRESSWAY SYSTEM

DECK PLAN
UNITS 5 THRU 12 SOUTHBOUND & NORTHBOUND


HOWARD, NEEDLES, TAMMEN & BERGENDOFF
consulting engineers
Alexandria, Virginia

SCALE: AS SHOWN
CONTRACT NO.: C-13
SHEET NO. 54 of 106

RICHMOND EXPRESSWAY SYSTEM			
SECTION	PROJECT	SHEET NO.	TOTAL SHEETS
13	WIDENING JAMES RIVER BRIDGE	55	106

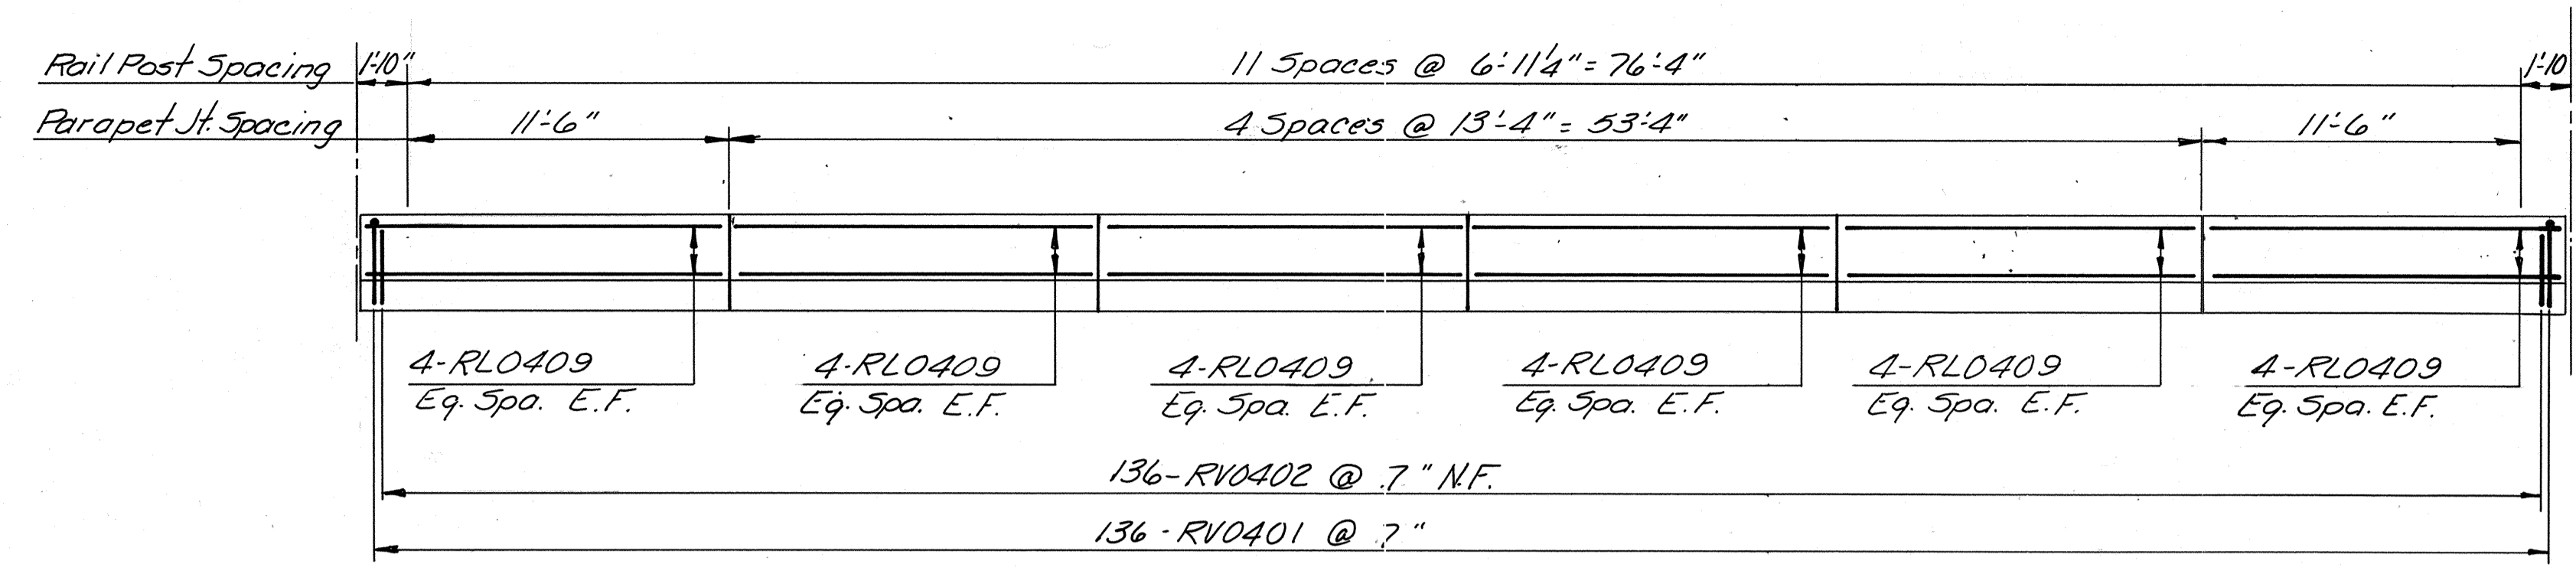

PARAPET ELEVATION - UNIT 13 SOUTHBOUND
Scale: 3/16" = 1'-0"

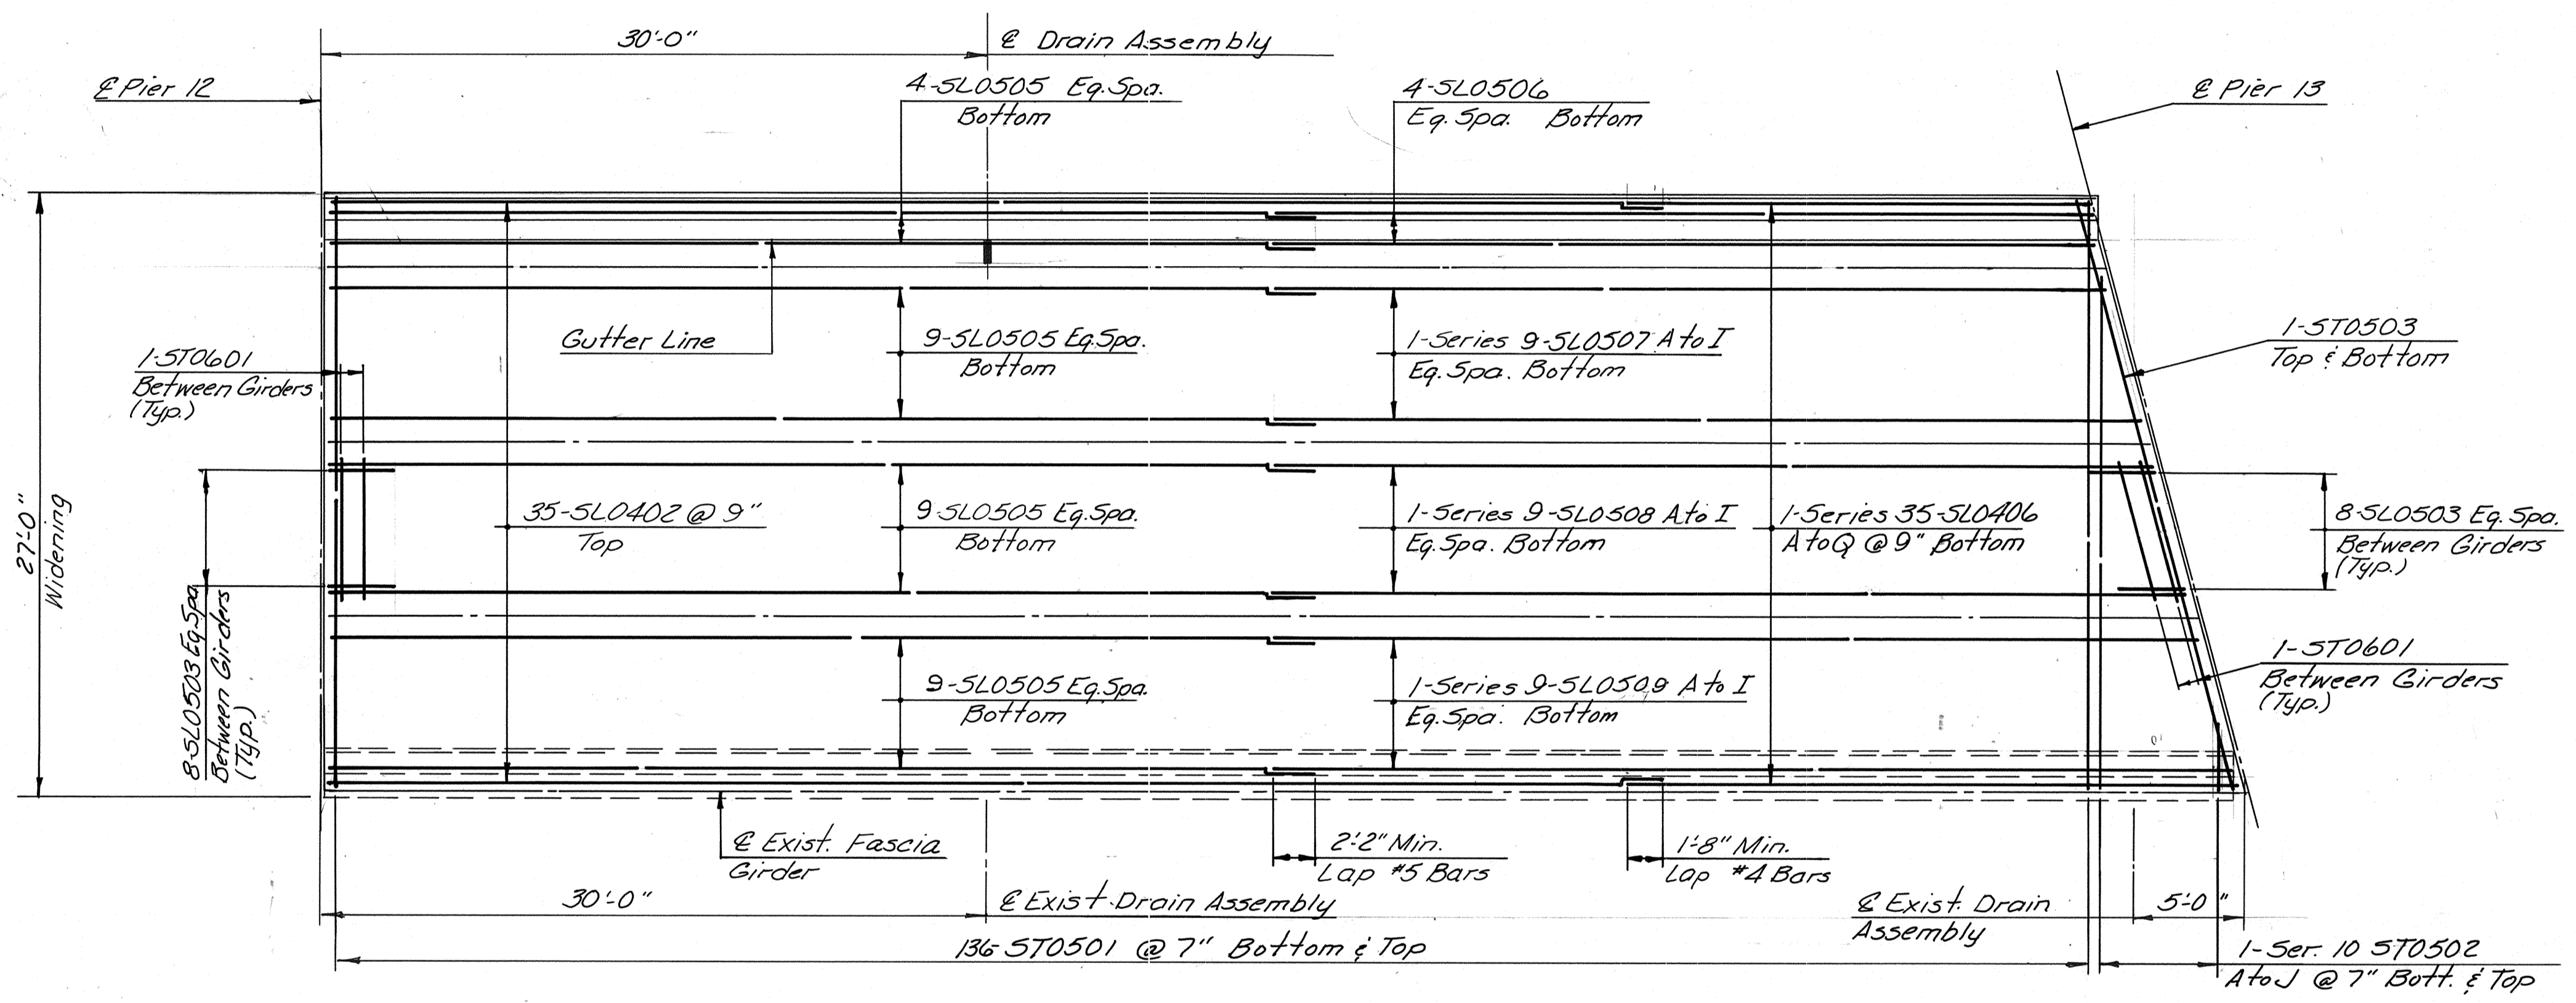

DECK PLAN - UNIT 13 SOUTHBOUND
Scale: 3/16" = 1'-0"

	BY	DATE			
MADE	TAL	3-87			
CHECKED	TFP	3-87	As Built	TEM	3-89
IN CHARGE	SR		NO.	REVISION	BY DATE

AS BUILT



RICHMOND METROPOLITAN AUTHORITY
RICHMOND EXPRESSWAY SYSTEM

DECK PLAN - UNIT 13 SOUTHBOUND

HOWARD, NEEDLES, TAMMEN & BERGENDOFF
consulting engineers
Alexandria, Virginia

SCALE: AS SHOWN
CONTRACT NO.: C-13
SHEET NO. 55 OF 106

RICHMOND EXPRESSWAY SYSTEM			
SECTION	PROJECT	SHEET NO.	TOTAL SHEETS
13	WIDENING JAMES RIVER BRIDGE	56	106

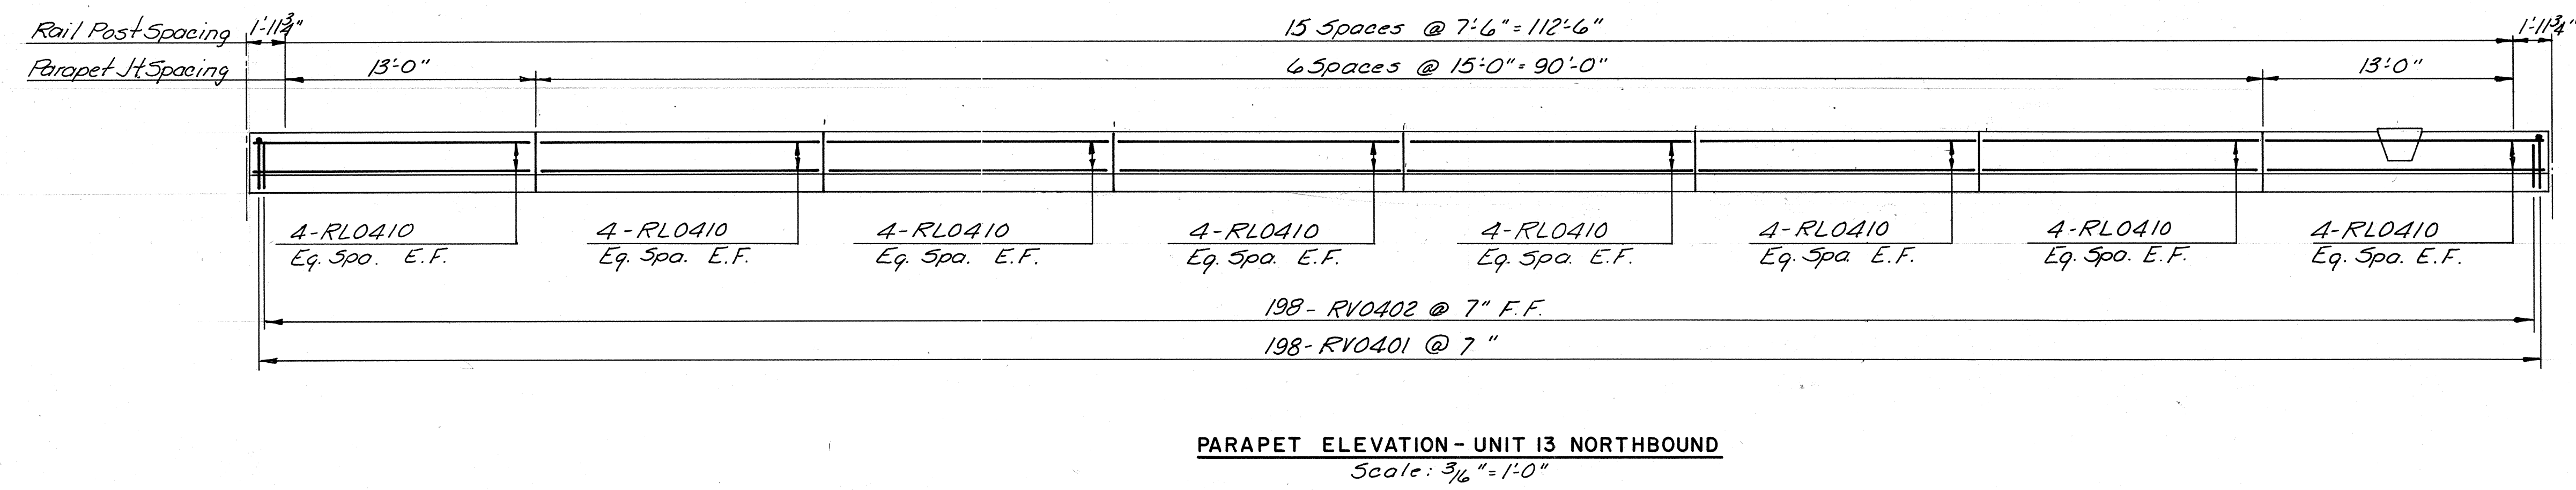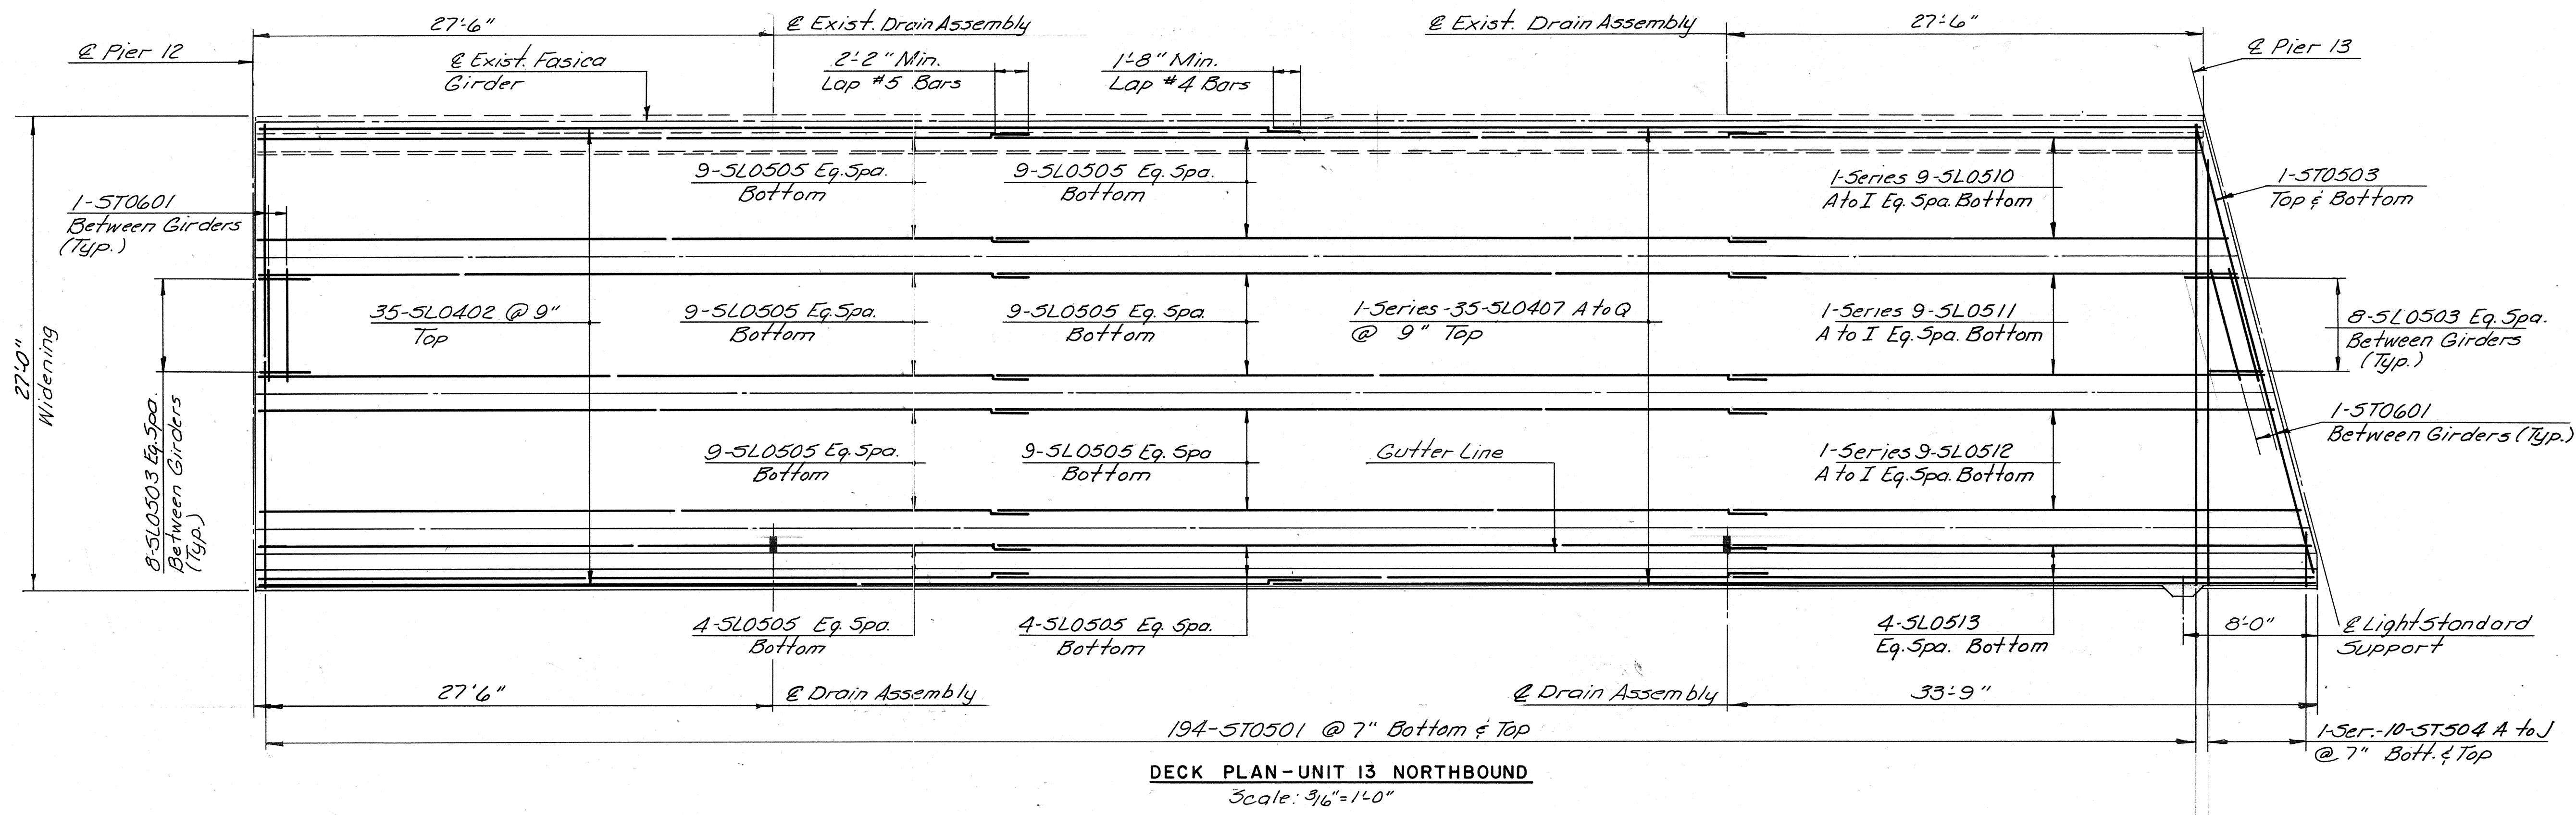

BY	DATE				
MADE	TAL	3-87			
CHECKED	TRP	3-87	As Built	TEM	3-89
IN CHARGE	S.R.				

AS BUILT


RICHMOND METROPOLITAN AUTHORITY
RICHMOND EXPRESSWAY SYSTEM

DECK PLAN - UNIT 13 NORTHBOUND


HOWARD, NEEDLES, TAMMEN & BERGENOFF
consulting engineers
Alexandria, Virginia

SCALE: AS SHOWN
CONTRACT NO.: C-13
SHEET NO. 56 OF 106

RICHMOND EXPRESSWAY SYSTEM			
SECTION	PROJECT	SHEET NO.	TOTAL SHEETS
13	WIDENING JAMES RIVER BRIDGE	57	106

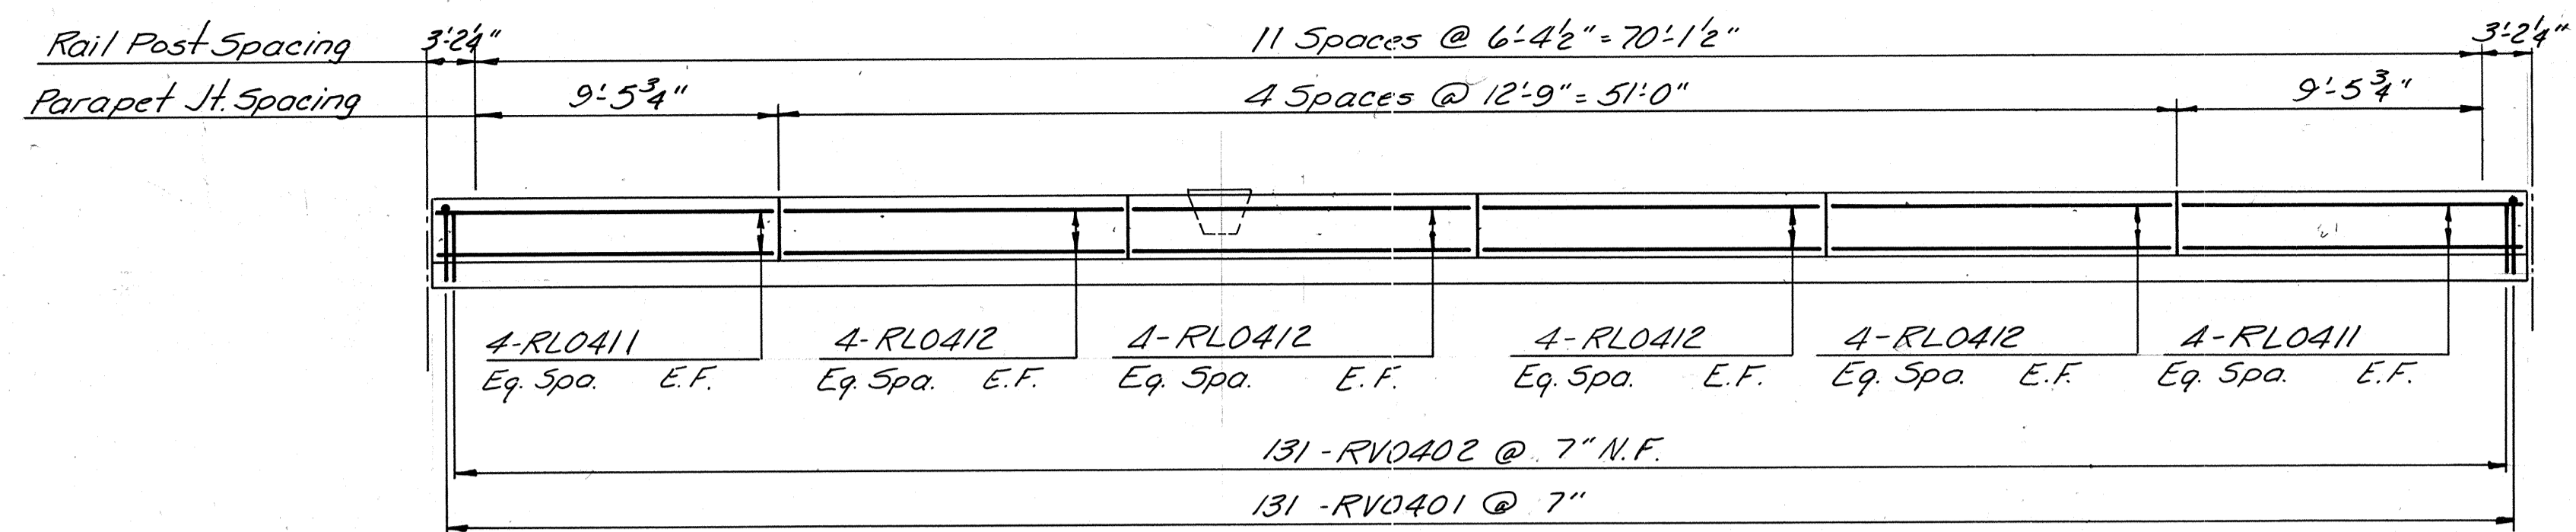

PARAPET ELEVATION - UNIT 14 SOUTHBOUND
Scale: 3/16" = 1'-0"

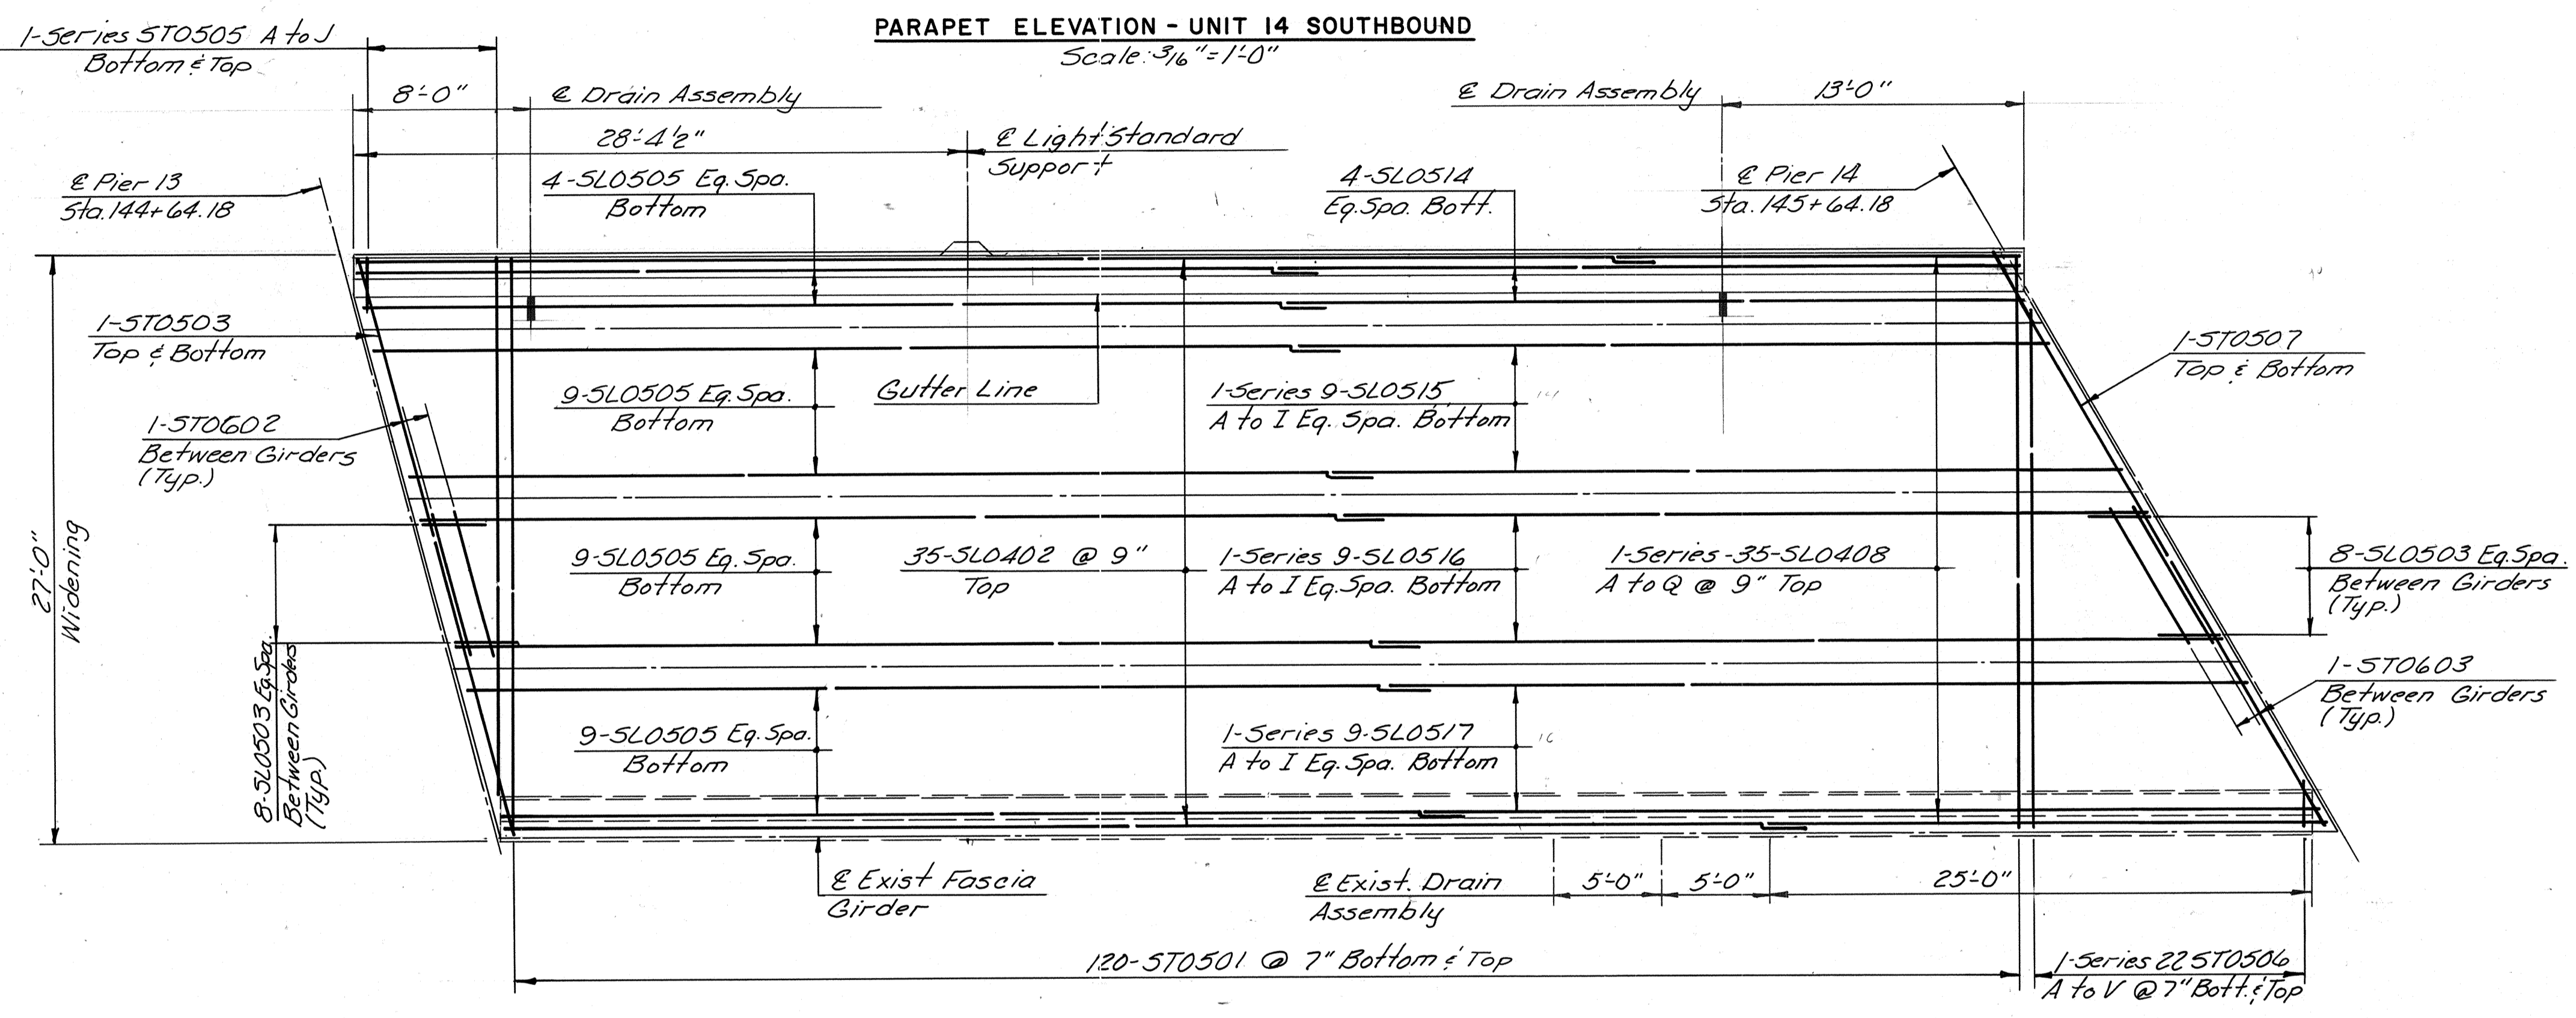

DECK PLAN - UNIT 14 SOUTHBOUND
Scale: 3/16" = 1'-0"

BY	DATE	NO.	REVISION	BY	DATE
MADE	TAL 3-87				
CHECKED	TEP 3-87		As Built	TEM 3-89	
IN CHARGE	S.R.				

AS BUILT


RICHMOND METROPOLITAN AUTHORITY
RICHMOND EXPRESSWAY SYSTEM

DECK PLAN - UNIT 14 SOUTHBOUND


HOWARD, NEEDLES, TAMMEN & BERGENDOFF
consulting engineers
Alexandria, Virginia

SCALE: AS SHOWN
CONTRACT NO.: C-13
SHEET NO. 57 OF 106

RICHMOND EXPRESSWAY SYSTEM			
SECTION	PROJECT	SHEET NO.	TOTAL SHEETS
13	WIDENING JAMES RIVER BRIDGE	58	106

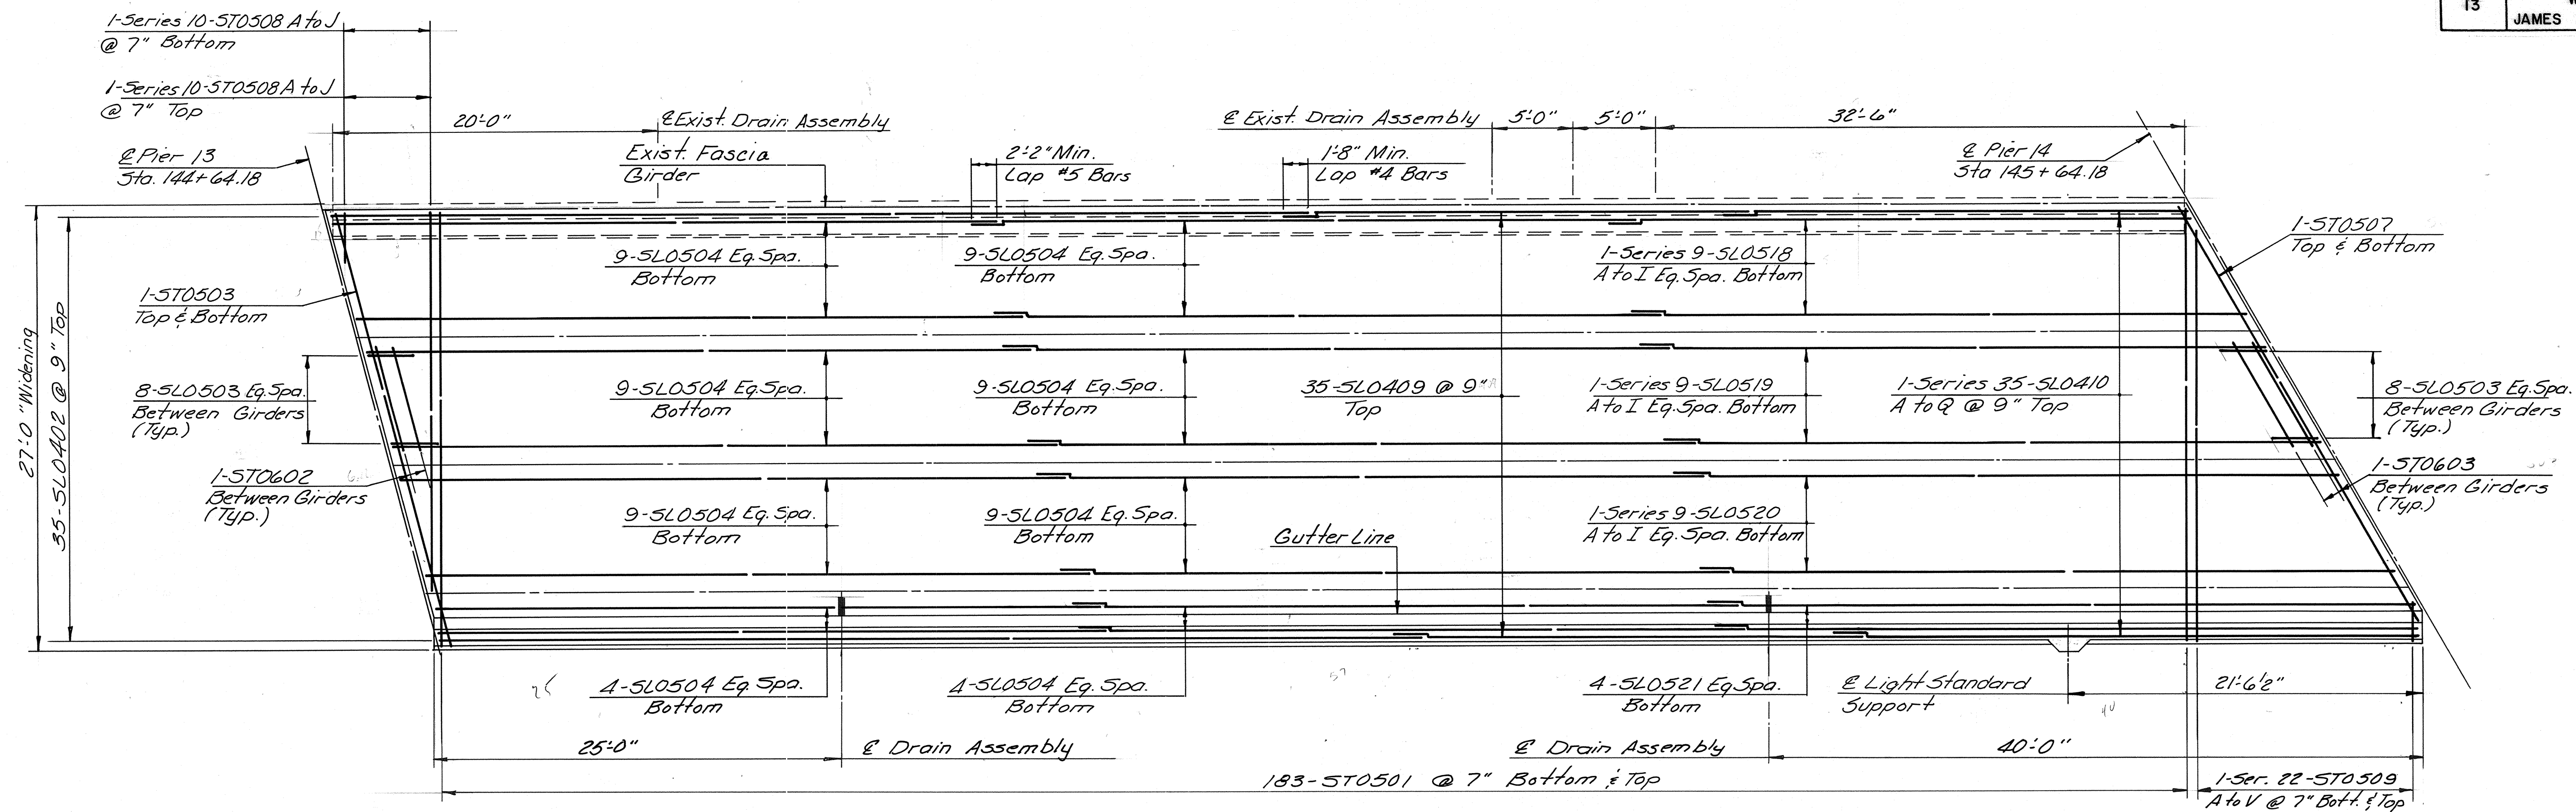

DECK PLAN - UNIT 14 NORTHBOUND
Scale: 3/16" = 1'-0"

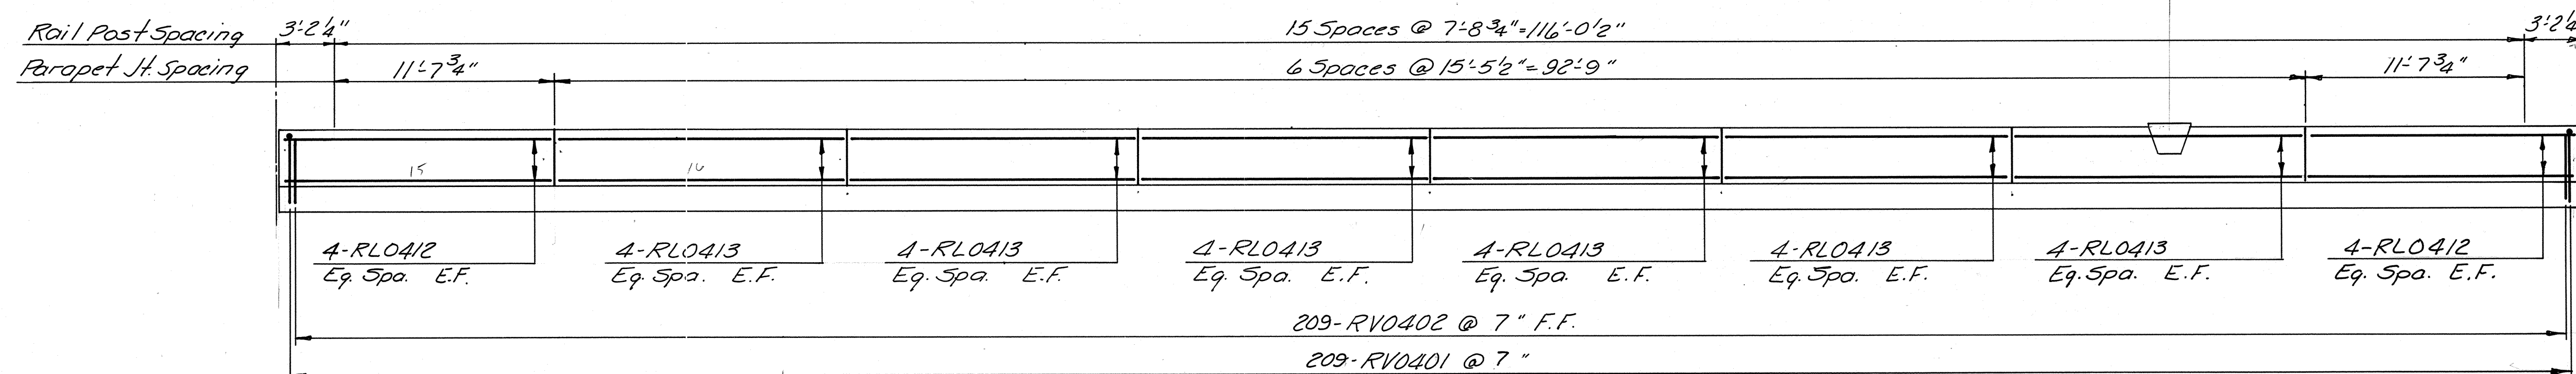

PARAPET ELEVATION - UNIT 14 NORTHBOUND
Scale: 3/16" = 1'-0"

BY	DATE	NO.	REVISION	BY	DATE
MADE	TAL 3-87				
CHECKED	T.F.P. 3-87		As Built	TEM	3-89
IN CHARGE	S.R.				

RICHMOND METROPOLITAN AUTHORITY
RICHMOND EXPRESSWAY SYSTEM


DECK PLAN - UNIT 14 NORTHBOUND

HOWARD, NEEDLES, TAMMEN & BERGENOFF
consulting engineers
Alexandria, Virginia


SCALE: AS SHOWN
CONTRACT NO.: C-13
SHEET NO. 58 OF 106

AS BUILT

RICHMOND EXPRESSWAY SYSTEM			
SECTION	PROJECT	SHEET NO.	TOTAL SHEETS
13	WIDENING JAMES RIVER BRIDGE	59	106

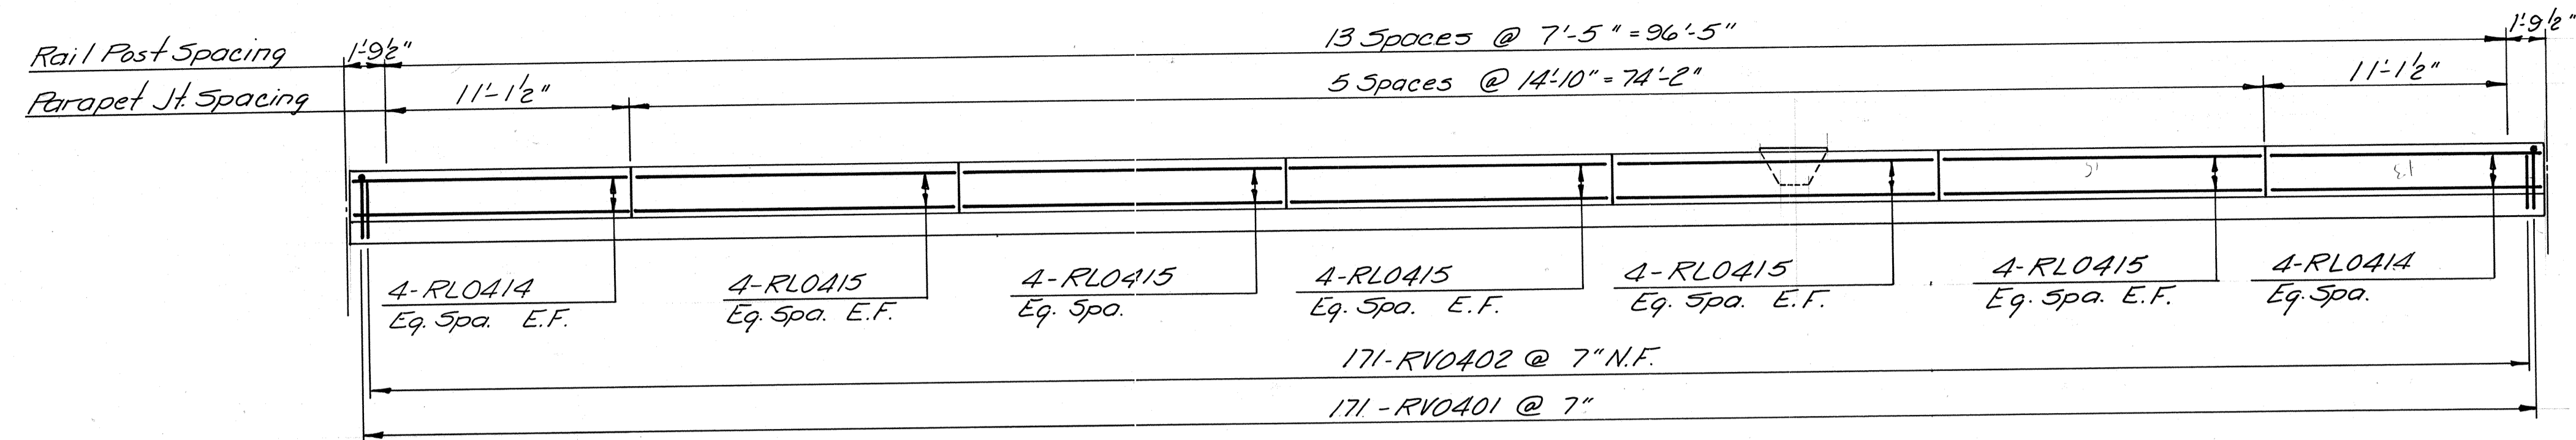

PARAPET ELEVATION - UNIT 15 SOUTHBOUND
Scale: 3/16" = 1'-0"

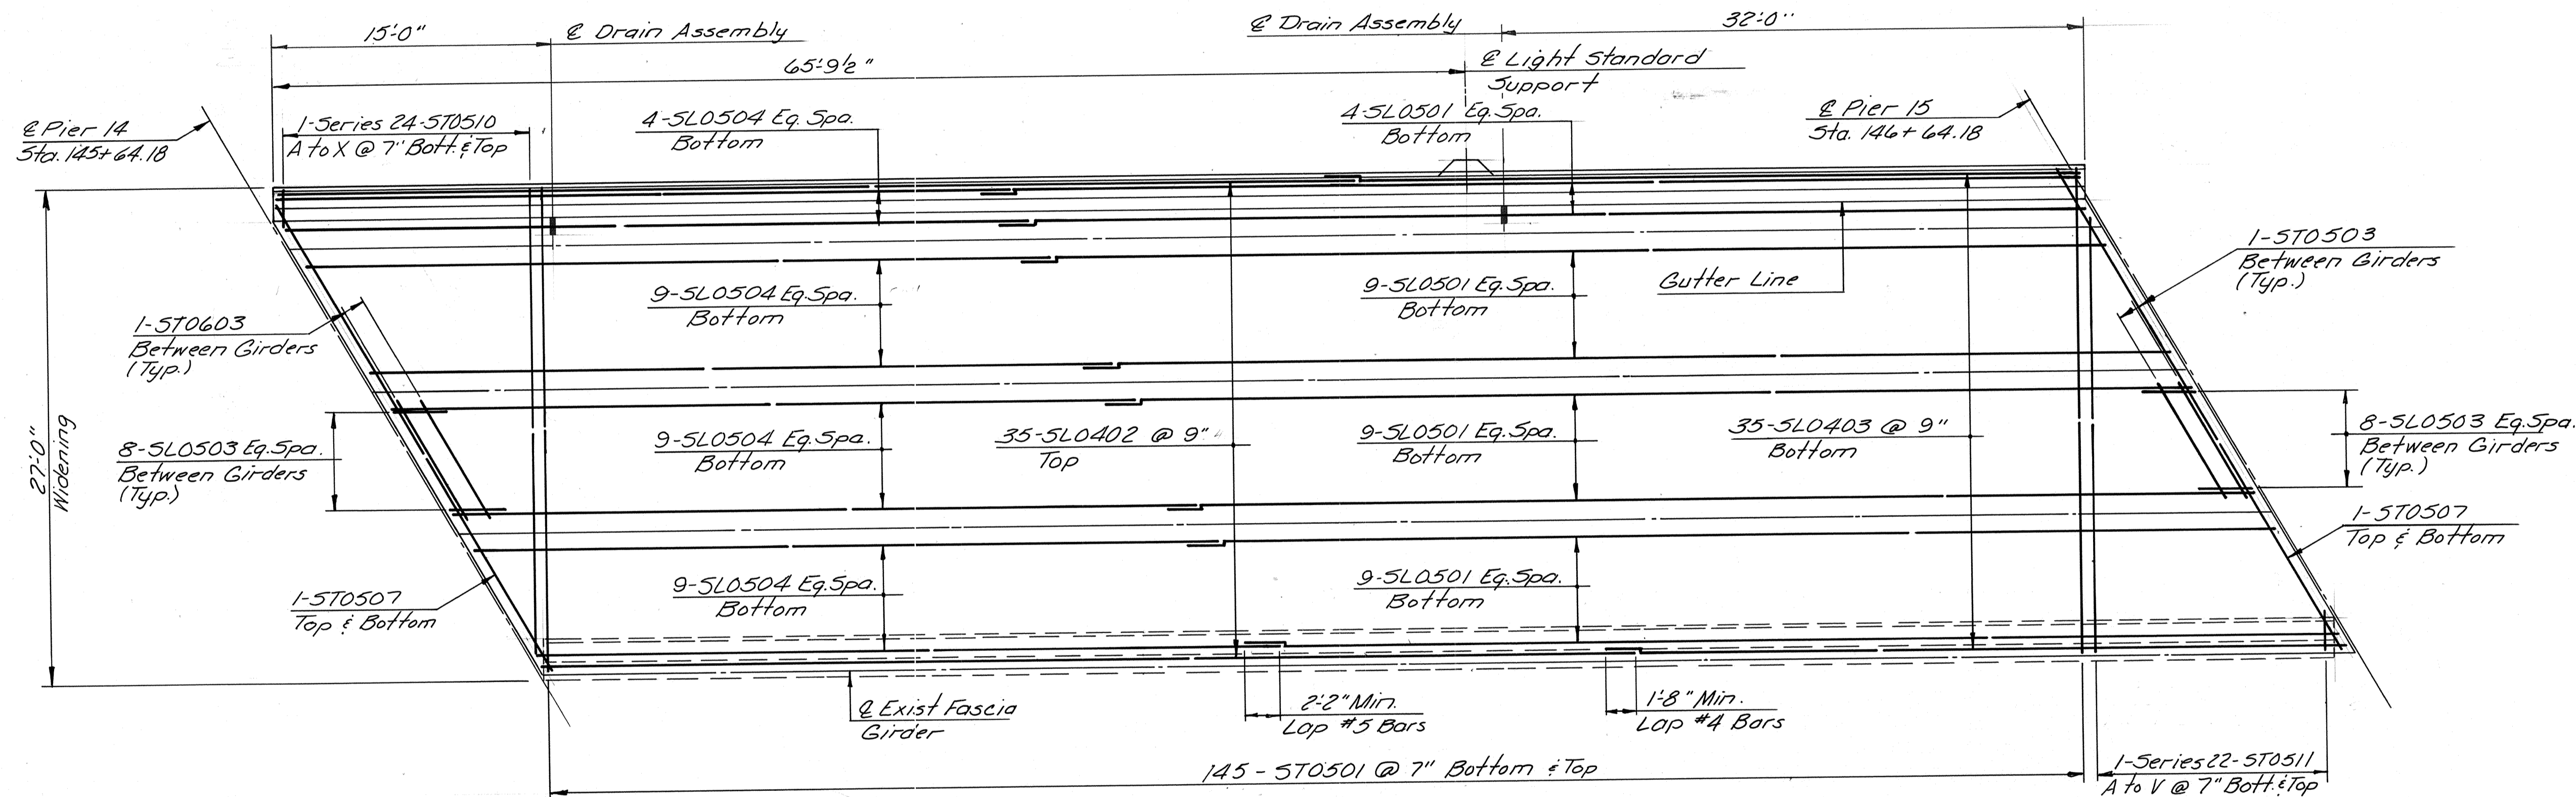

DECK PLAN - UNIT 15 SOUTHBOUND
Scale: 3/16" = 1'-0"

BY	DATE				
MADE	TAL	3-87			
CHECKED	T.F.P.	3-87	As Built	TEM	3-89
IN CHARGE	S.R.				

RICHMOND METROPOLITAN AUTHORITY
RICHMOND EXPRESSWAY SYSTEM


DECK PLAN - UNIT 15 SOUTHBOUND

HOWARD, NEEDLES, TAMMEN & BERGENDOFF
consulting engineers
Alexandria, Virginia


SCALE: AS SHOWN
CONTRACT NO.: C-13
SHEET NO. 59 OF 106

AS BUILT

RICHMOND EXPRESSWAY SYSTEM			
SECTION	PROJECT	SHEET NO.	TOTAL SHEETS
13	WIDENING JAMES RIVER BRIDGE	60	106

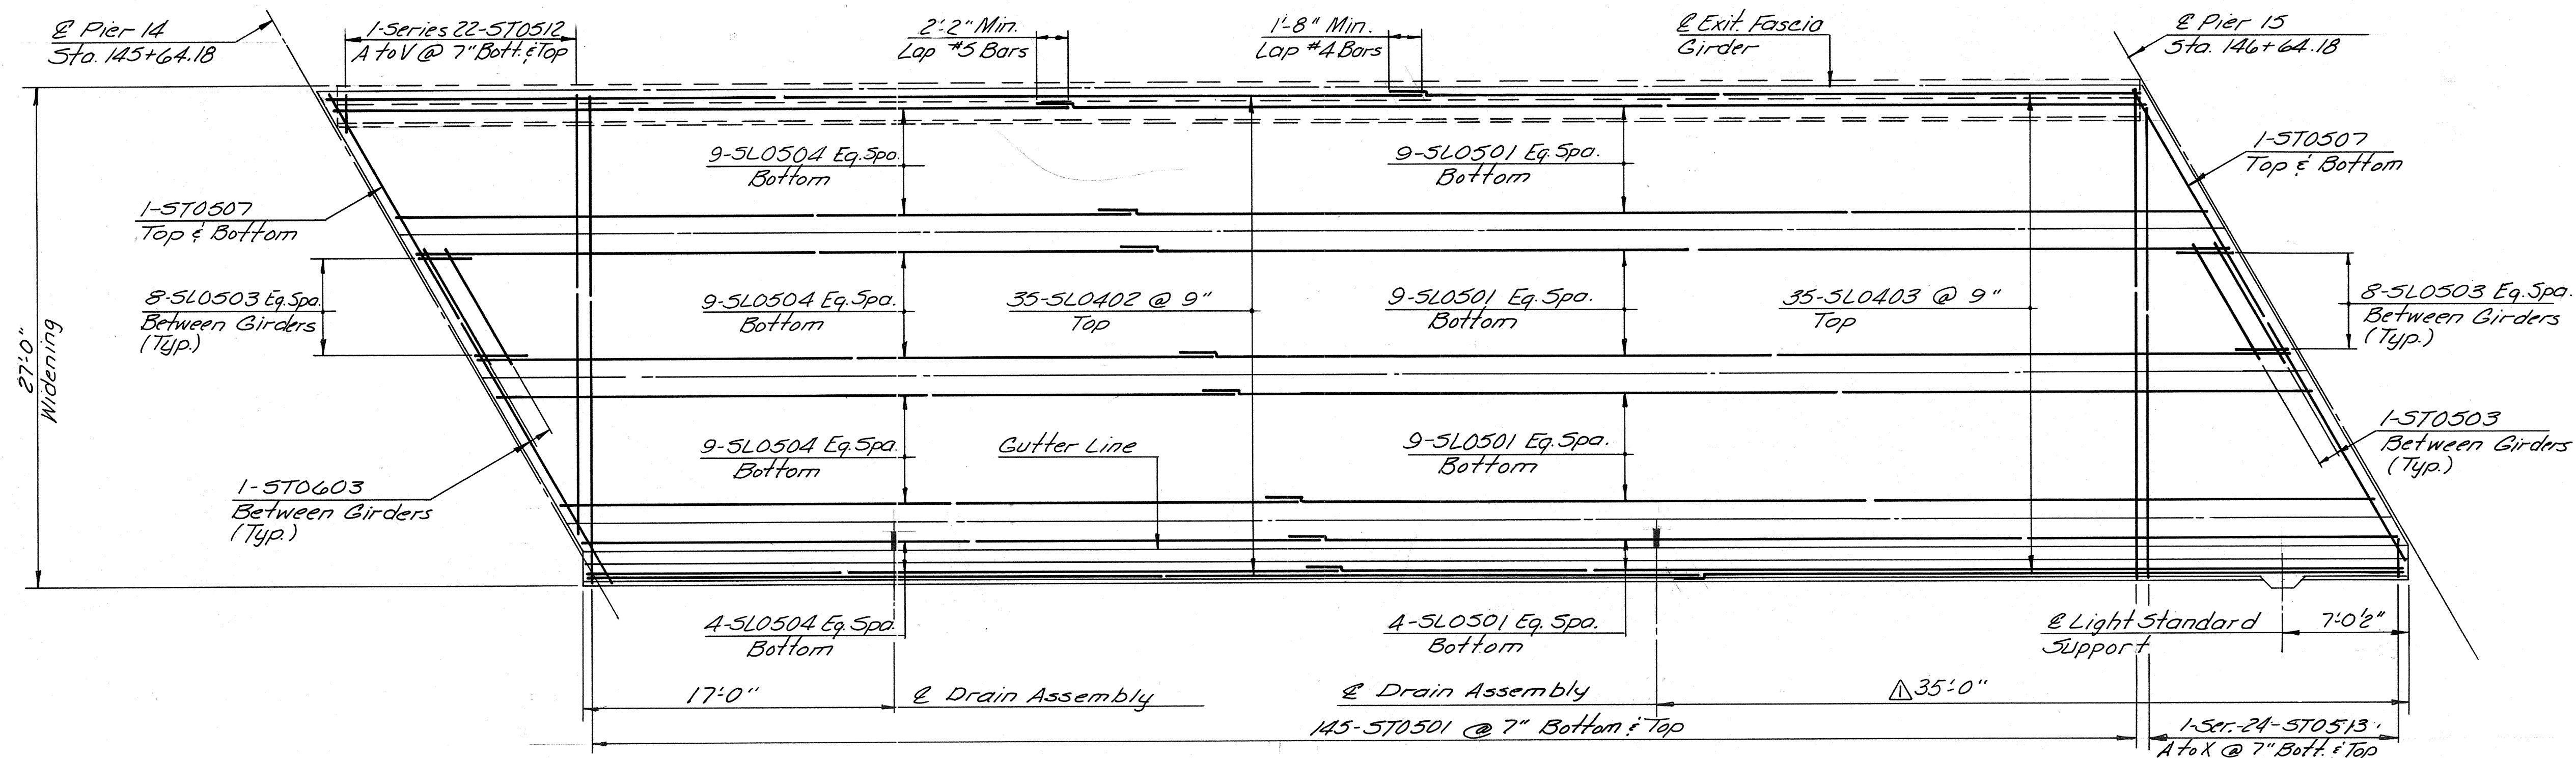

DECK PLAN - UNIT 15 NORTHBOUND
Scale: 3/16"=1'-0"

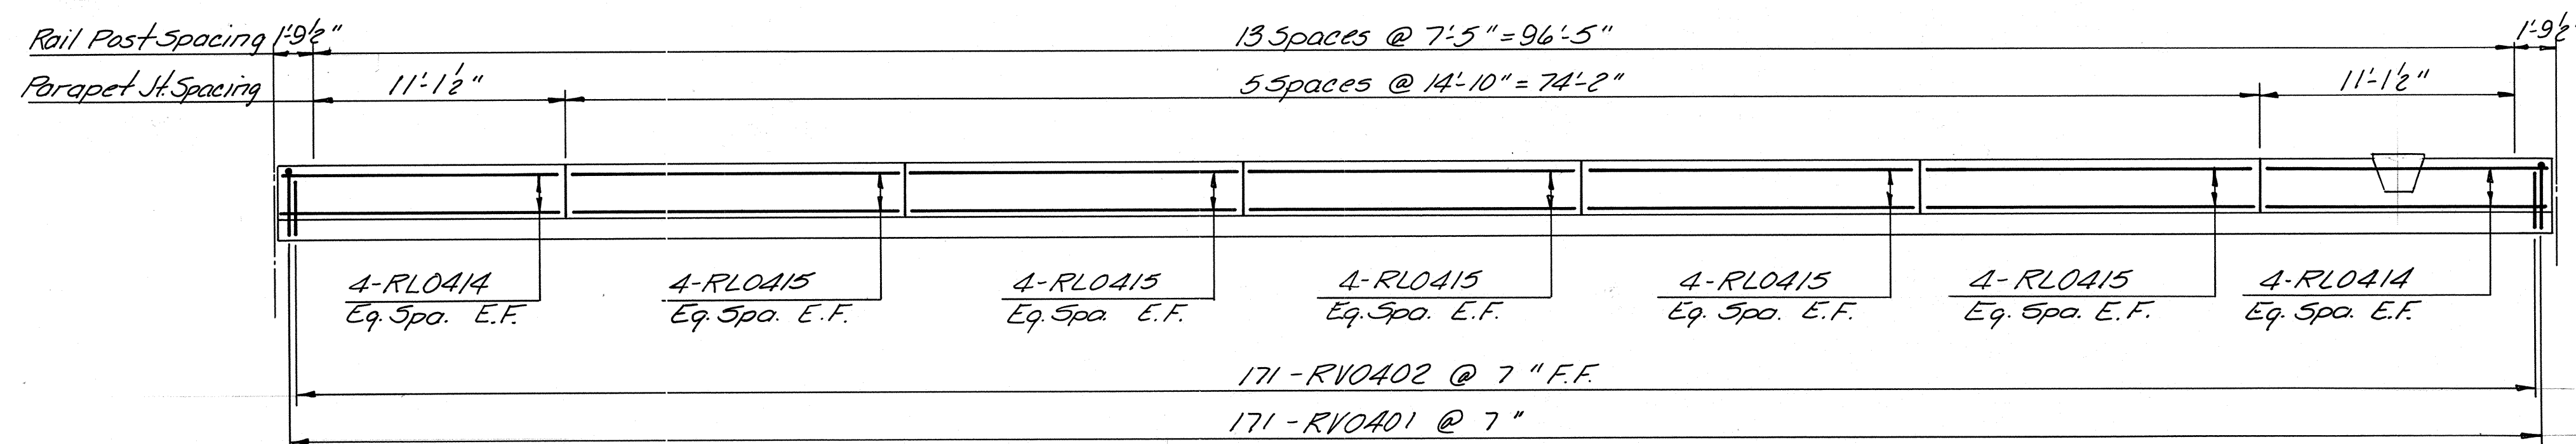

PARAPET ELEVATION - UNIT 15 NORTHBOUND
Scale: 3/16"=1'-0"

BY	DATE				
MADE	TAL 3-87	As Built	TEM	3-89	
CHECKED	TFP 3-87	Rel. Drain Assbly	EJM	7-87	
IN CHARGE	S.R.				

RICHMOND METROPOLITAN AUTHORITY
RICHMOND EXPRESSWAY SYSTEM


DECK PLAN - UNIT 15 NORTHBOUND

HOWARD, NEEDLES, TAMMEN & BERGENDOFF
consulting engineers
Alexandria, Virginia


SCALE: AS SHOWN
CONTRACT NO.: C-13
SHEET NO. 60 OF 106

AS BUILT

RICHMOND EXPRESSWAY SYSTEM			
SECTION	PROJECT	SHEET NO.	TOTAL SHEETS
13	WIDENING JAMES RIVER BRIDGE	61	106

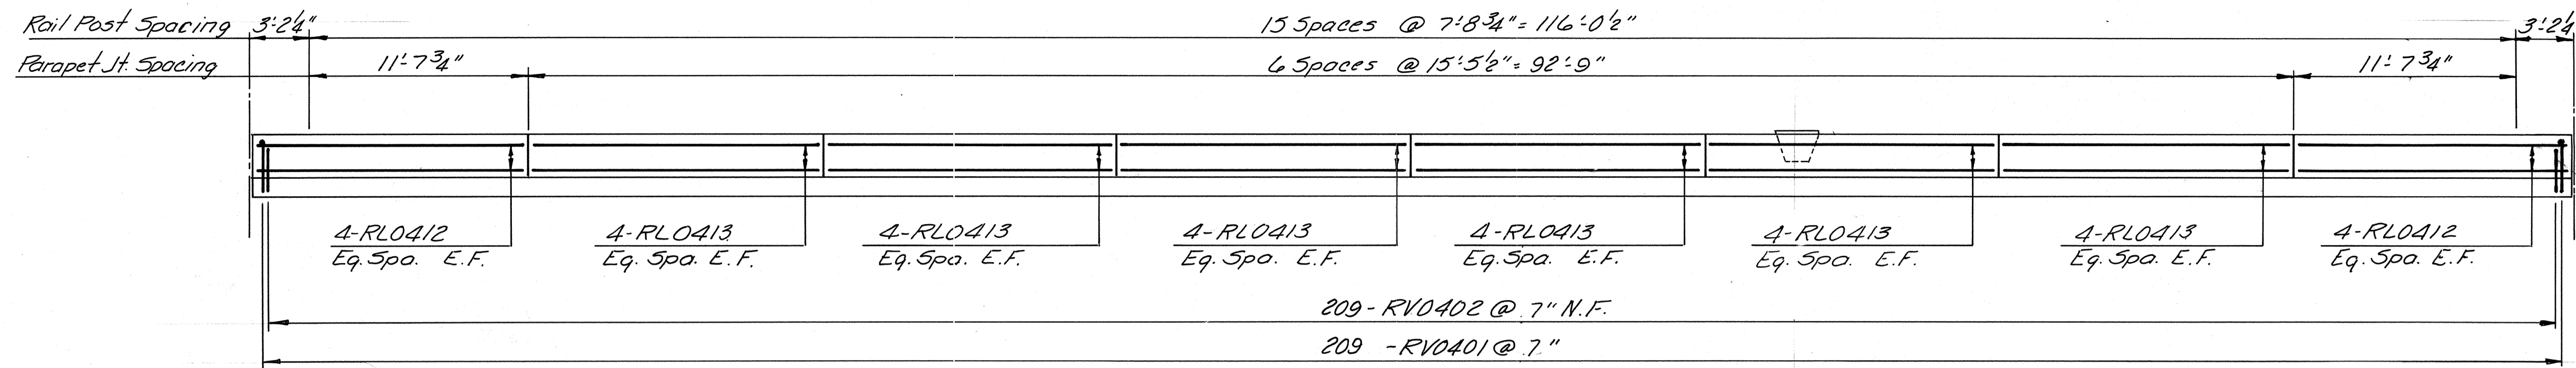

PARAPET ELEVATION - UNIT 16 SOUTHBOUND
Scale: 3/16" = 1'-0"

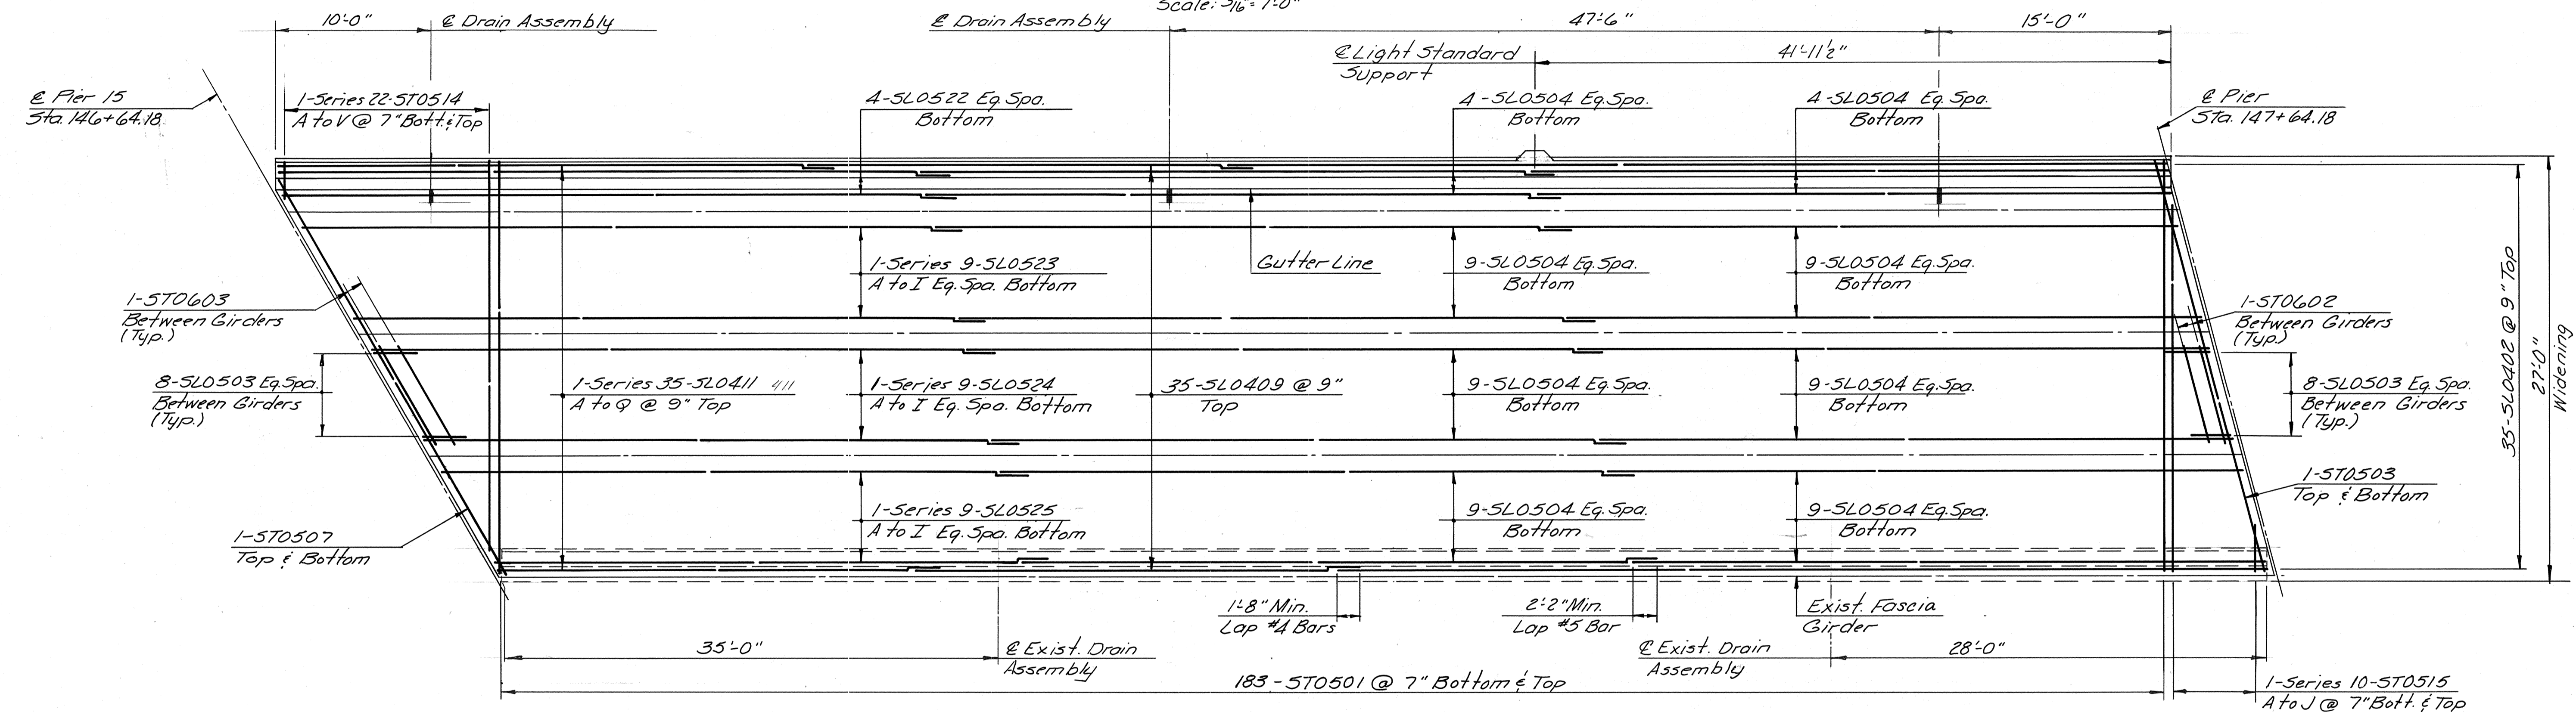

DECK PLAN - UNIT 16 SOUTHBOUND
Scale: 3/16" = 1'-0"

BY	DATE	NO.	REVISION	BY	DATE
MADE	TAL 3-87				
CHECKED	TFP 3-87		As Built	TEM	3-89
IN CHARGE	S.R.				

AS BUILT


RICHMOND METROPOLITAN AUTHORITY
RICHMOND EXPRESSWAY SYSTEM

DECK PLAN - UNIT 16 SOUTHBOUND


HOWARD, NEEDLES, TAMMEN & BERGENDOFF
consulting engineers
Alexandria, Virginia

SCALE: AS SHOWN
CONTRACT NO.: C-13
SHEET NO. 61 OF 106

RICHMOND EXPRESSWAY SYSTEM			
SECTION	PROJECT	SHEET NO.	TOTAL SHEETS
13	WIDENING JAMES RIVER BRIDGE	62	106

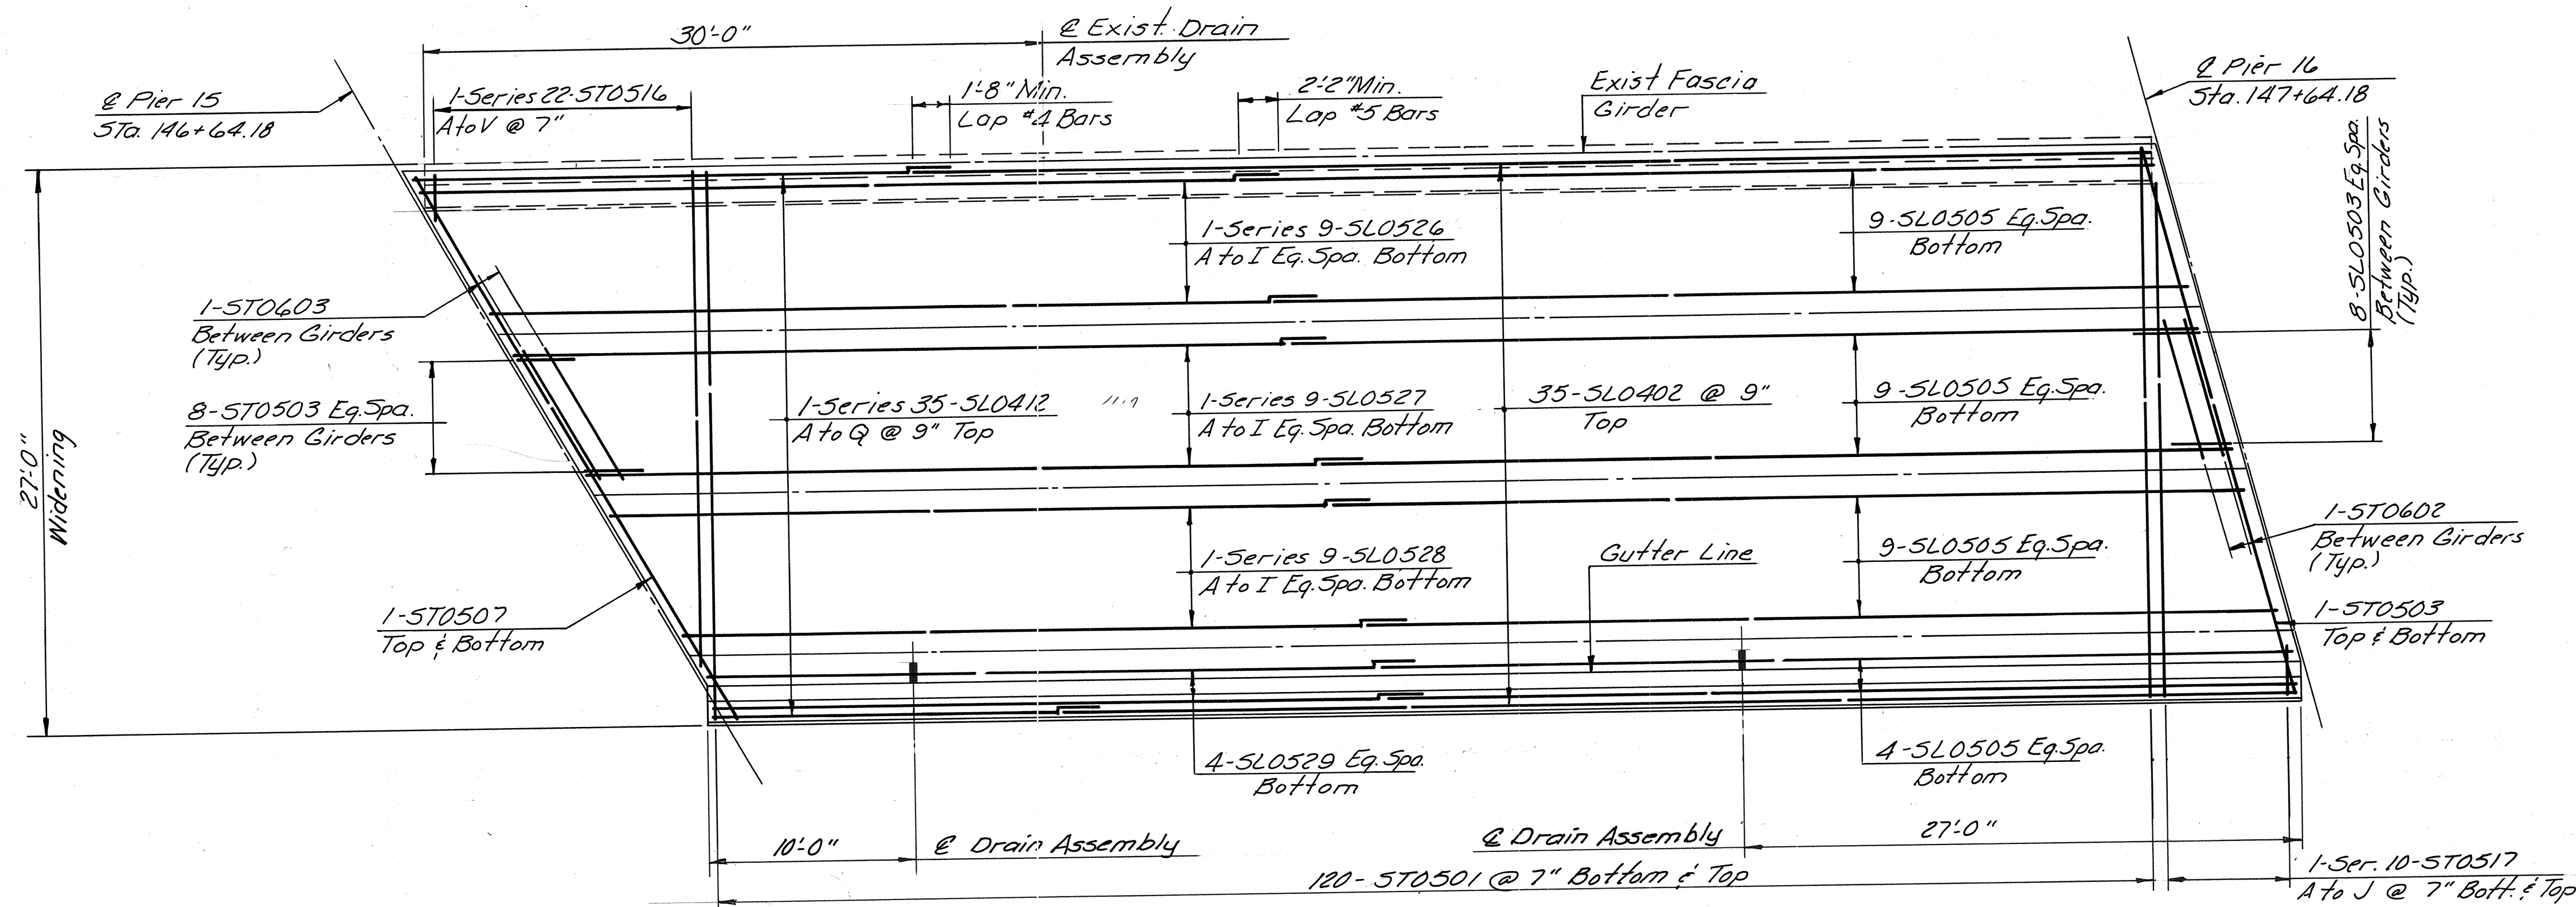

DECK PLAN - UNIT 16 NORTHBOUND
Scale: 3/16" = 1'-0"

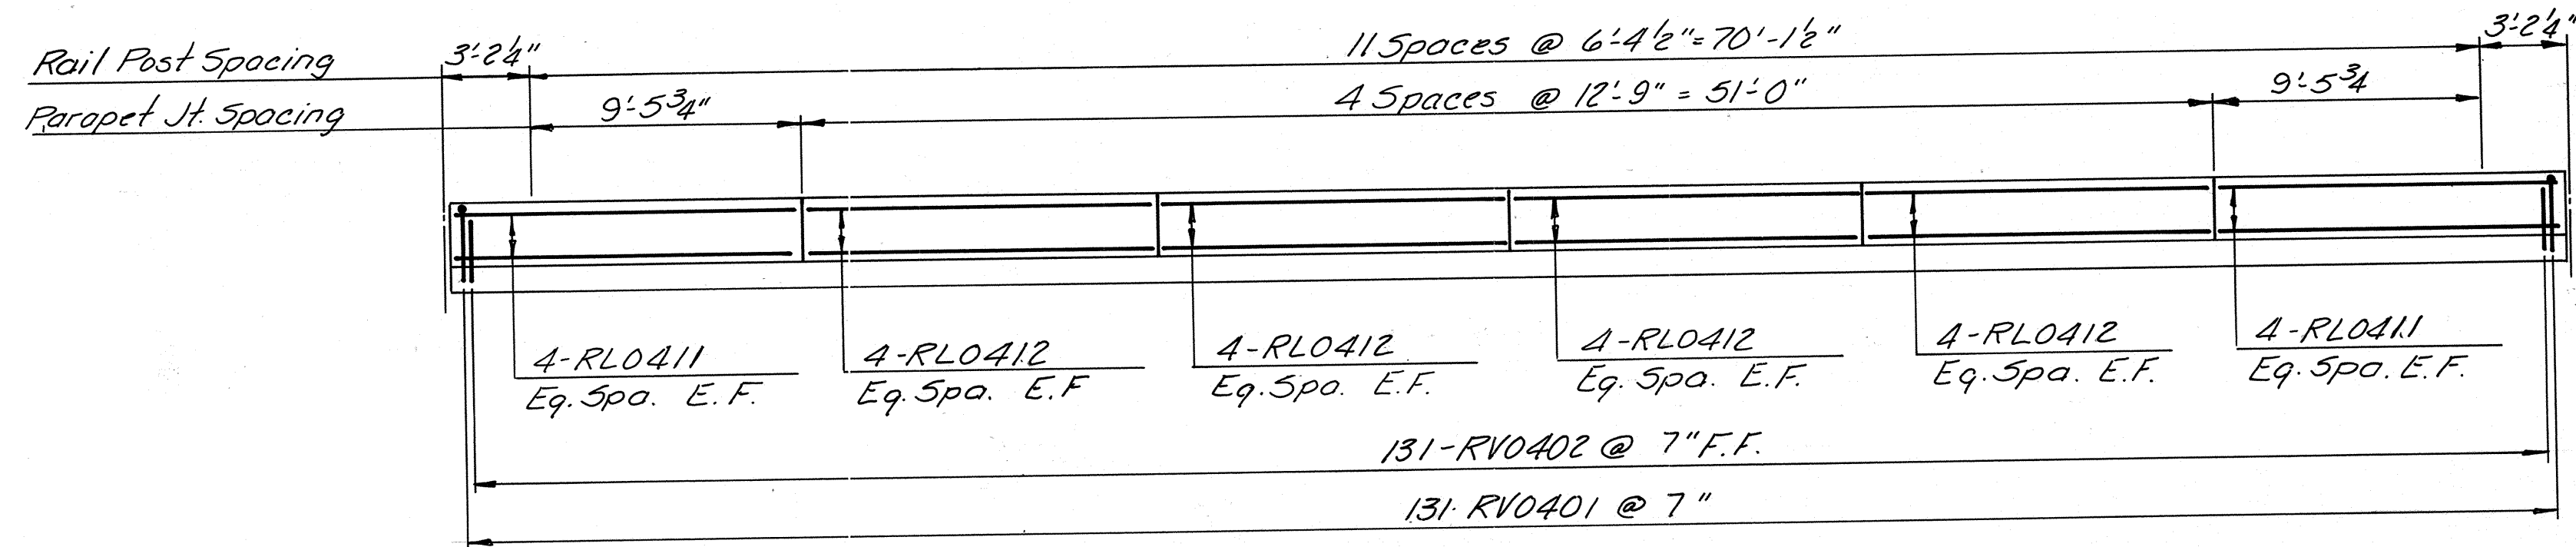

PARAPET ELEVATION - UNIT 16 NORTHBOUND
Scale: 3/16" = 1'-0"

BY	DATE	NO.	REVISION	BY	DATE
MADE	TAL 3-87				
CHECKED	T.F.P. 3-87		As Built	TEM 3-89	
IN CHARGE	S.R.				

AS BUILT


**RICHMOND METROPOLITAN AUTHORITY
RICHMOND EXPRESSWAY SYSTEM**

DECK PLAN - UNIT 16 NORTHBOUND


HOWARD, NEEDLES, TAMMEN & BERGENDOFF
consulting engineers
Alexandria, Virginia

SCALE: AS SHOWN
CONTRACT NO. C-13
SHEET NO. 62 OF 106

RICHMOND EXPRESSWAY SYSTEM			
SECTION	PROJECT	SHEET NO.	TOTAL SHEETS
13	WIDENING JAMES RIVER BRIDGE	63	106

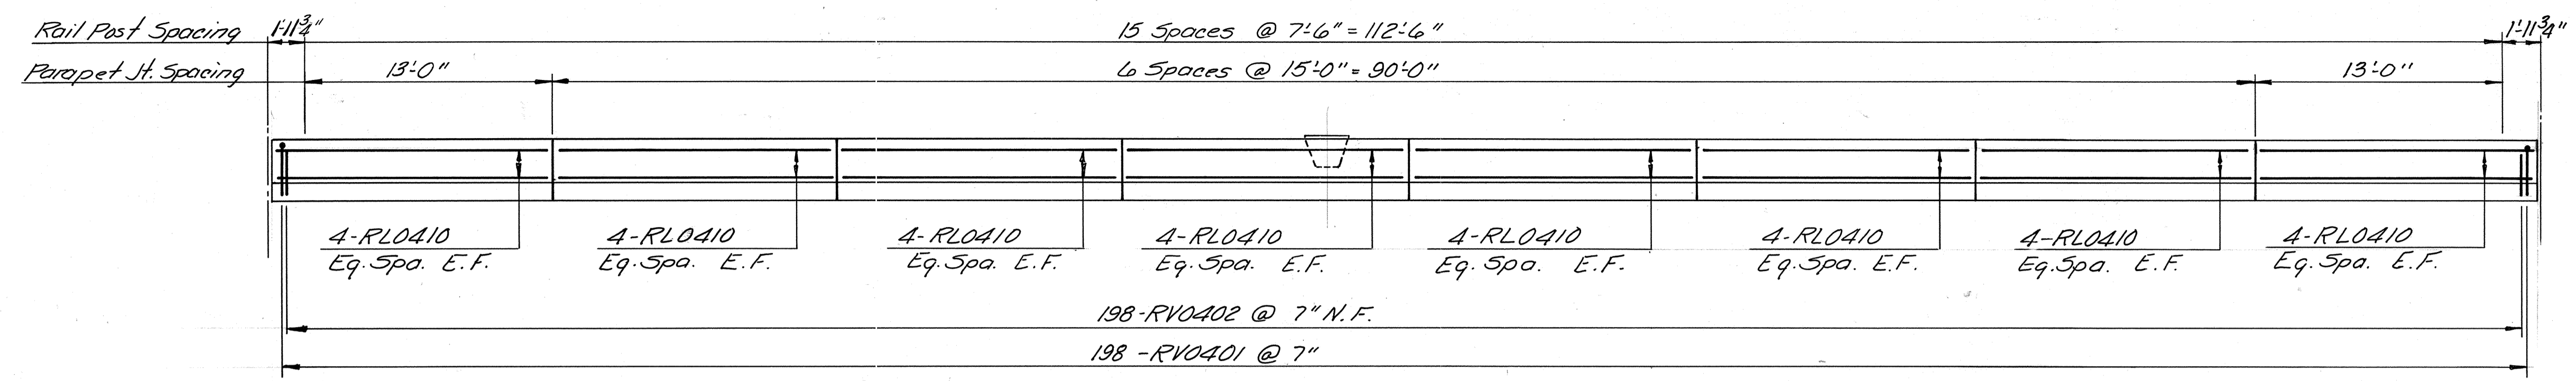

PARAPET ELEVATION - UNIT 17 SOUTHBOUND
Scale: 3/16" = 1'-0"

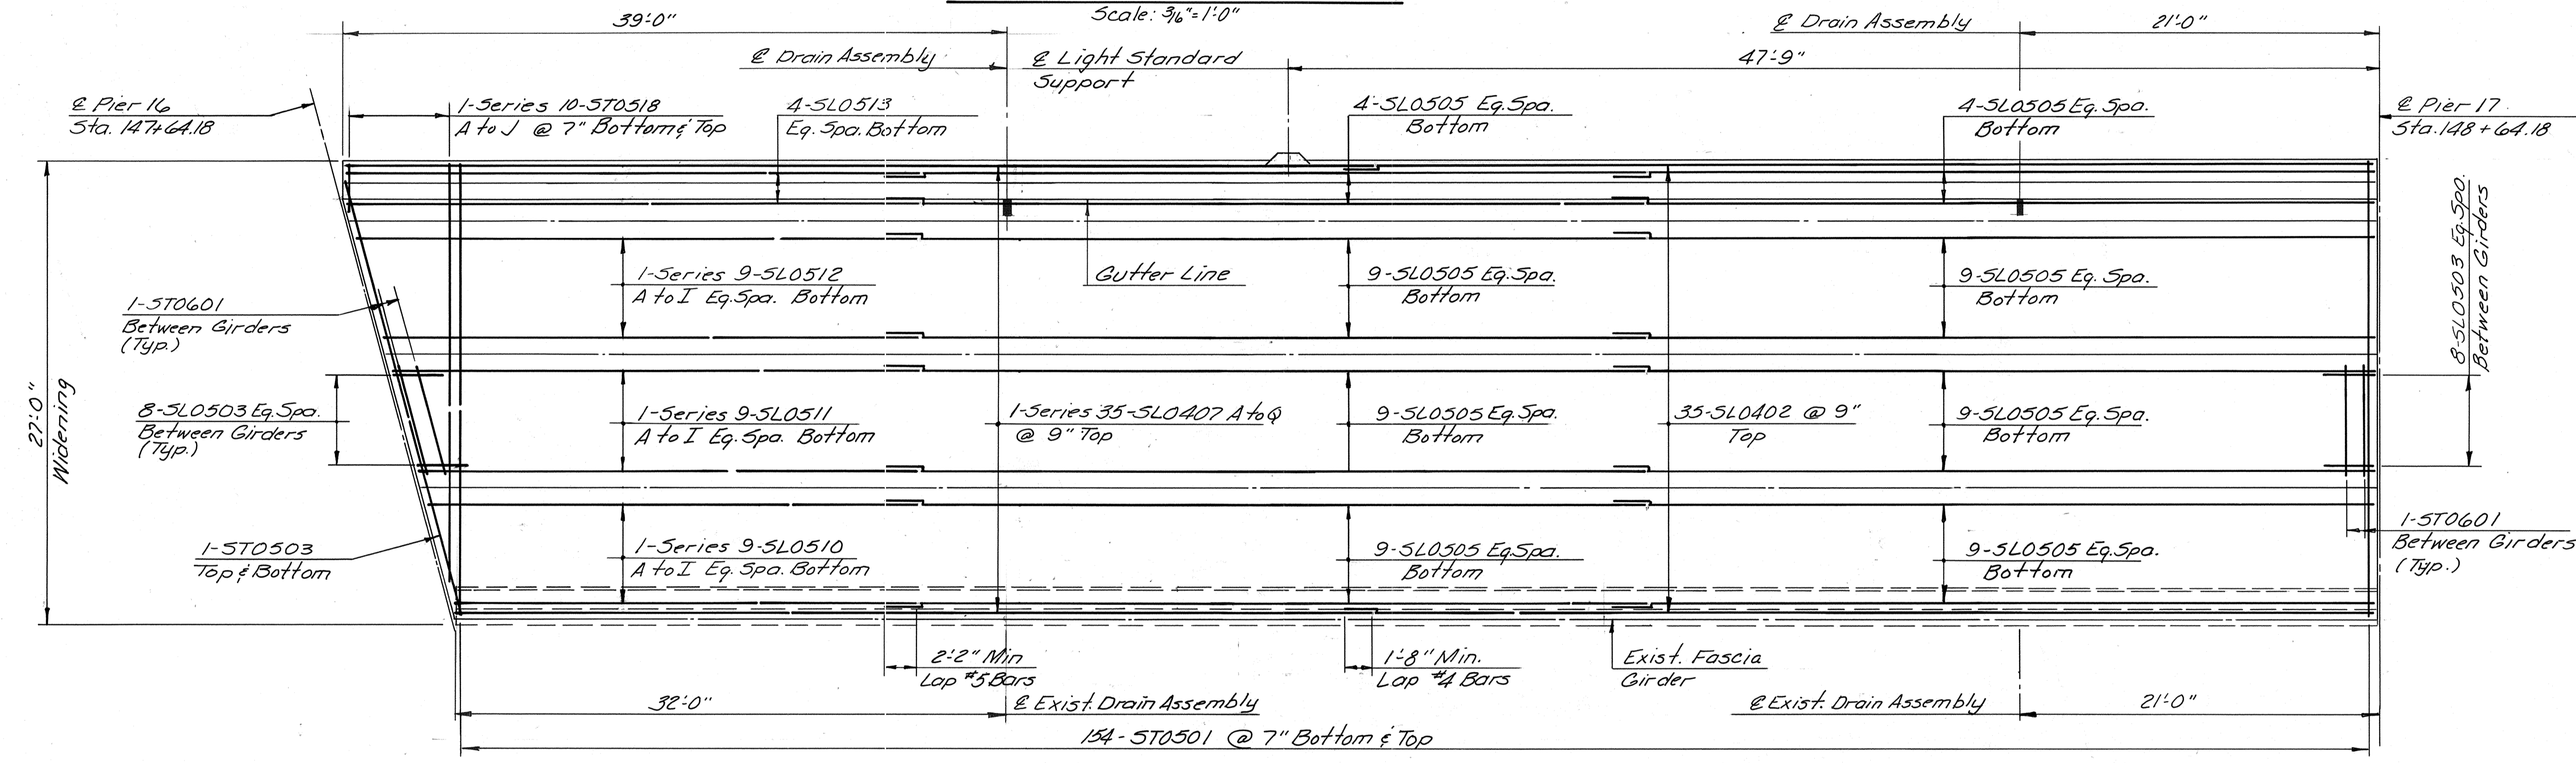


DECK PLAN - UNIT 17 SOUTHBOUND
Scale: 3/16" = 1'-0"

BY	DATE	NO.	REVISION	BY	DATE
MADE	TAL	3-87			
CHECKED	T.F.P.	3-87	As Built	T&M	3-89
IN CHARGE	S.R.				


AS BUILT

RICHMOND METROPOLITAN AUTHORITY
RICHMOND EXPRESSWAY SYSTEM
 DECK PLAN - UNIT 17 SOUTHBOUND
 HOWARD, NEEDLES, TAMMEN & BERGENDOFF
 consulting engineers
 Alexandria, Virginia
 SCALE: AS SHOWN
 CONTRACT NO. C-13
 SHEET NO. 63 OF 106

RICHMOND EXPRESSWAY SYSTEM			
SECTION	PROJECT	SHEET NO.	TOTAL SHEETS
13	WIDENING JAMES RIVER BRIDGE	64	106

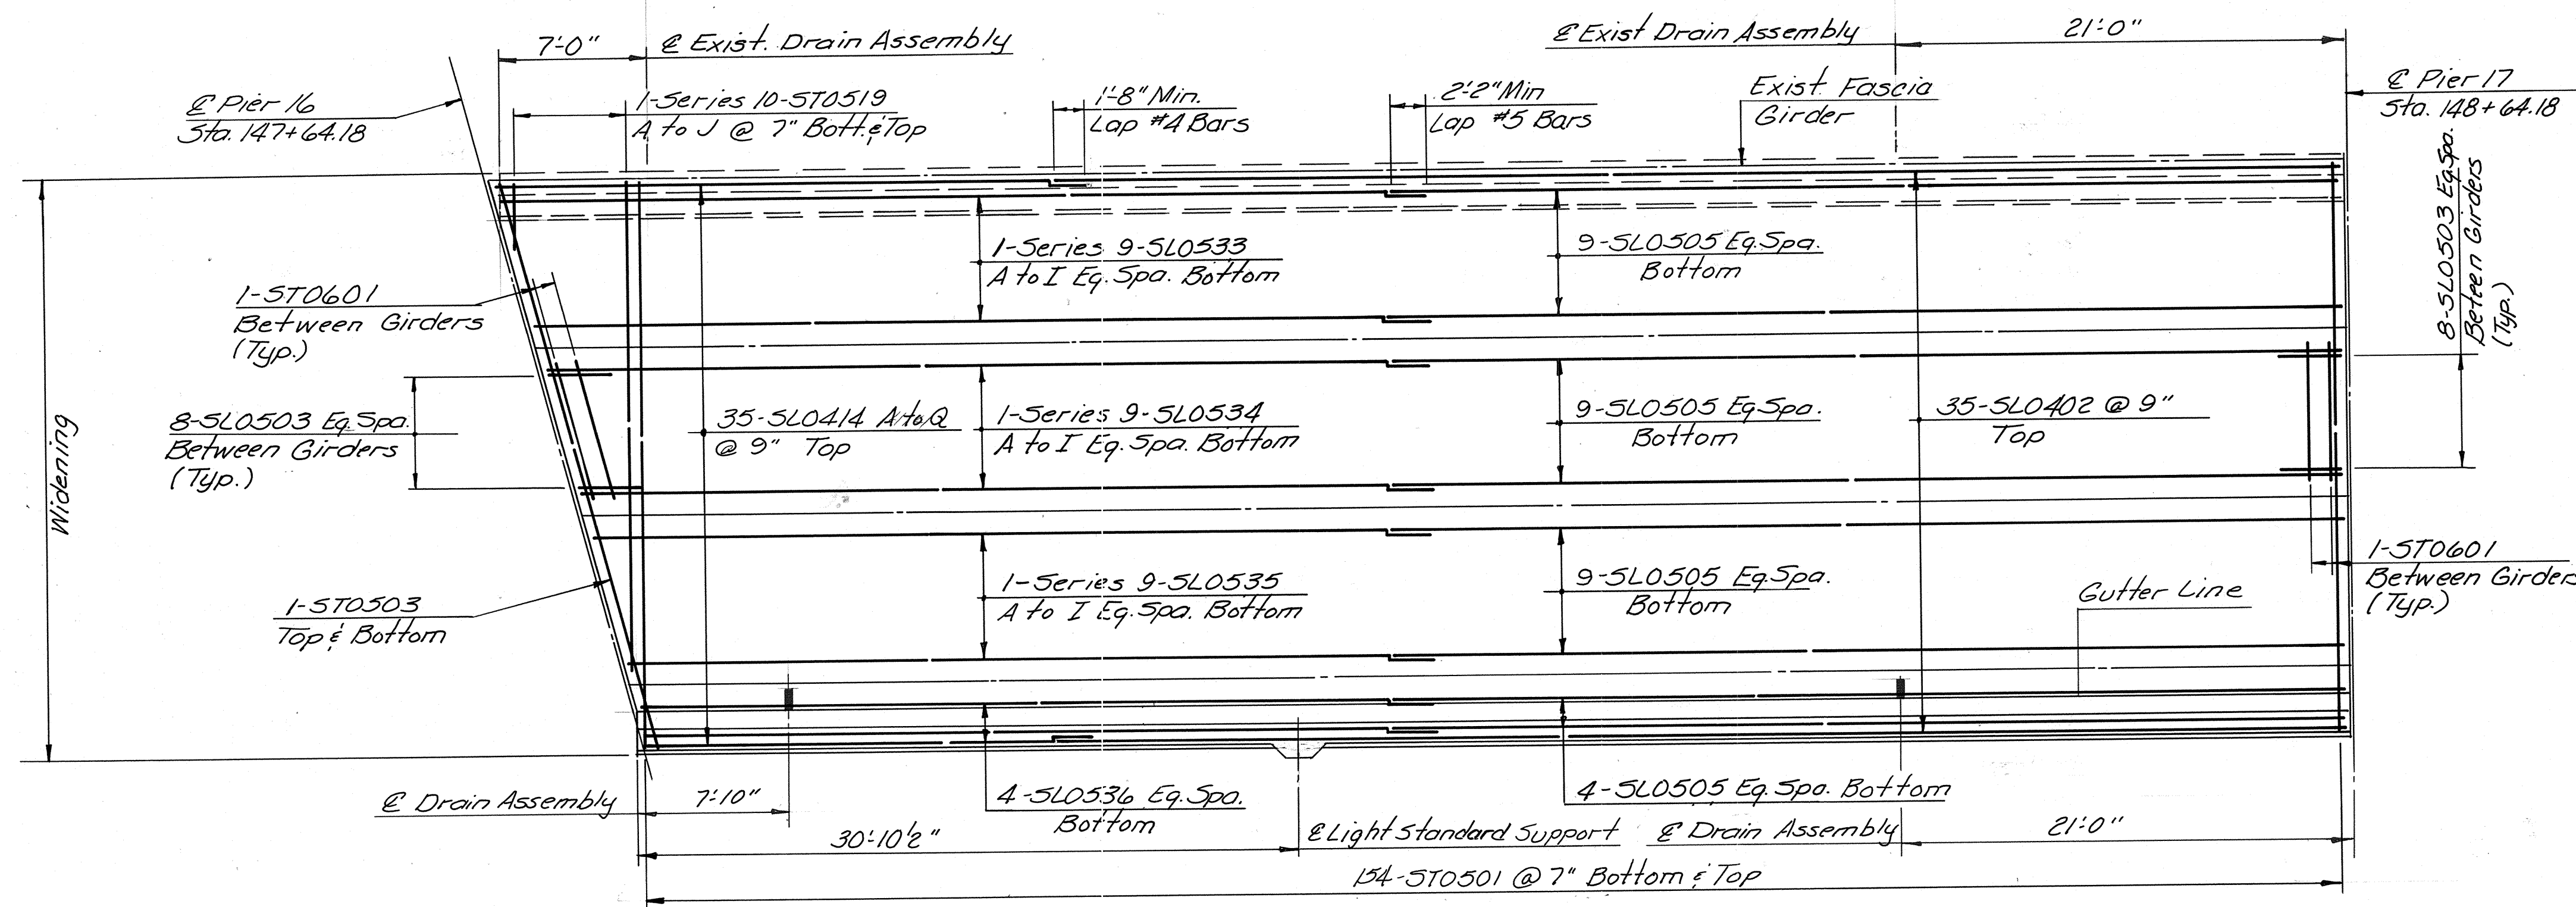

DECK PLAN - UNIT 17 NORTHBOUND
Scale: 3/16" = 1'-0"

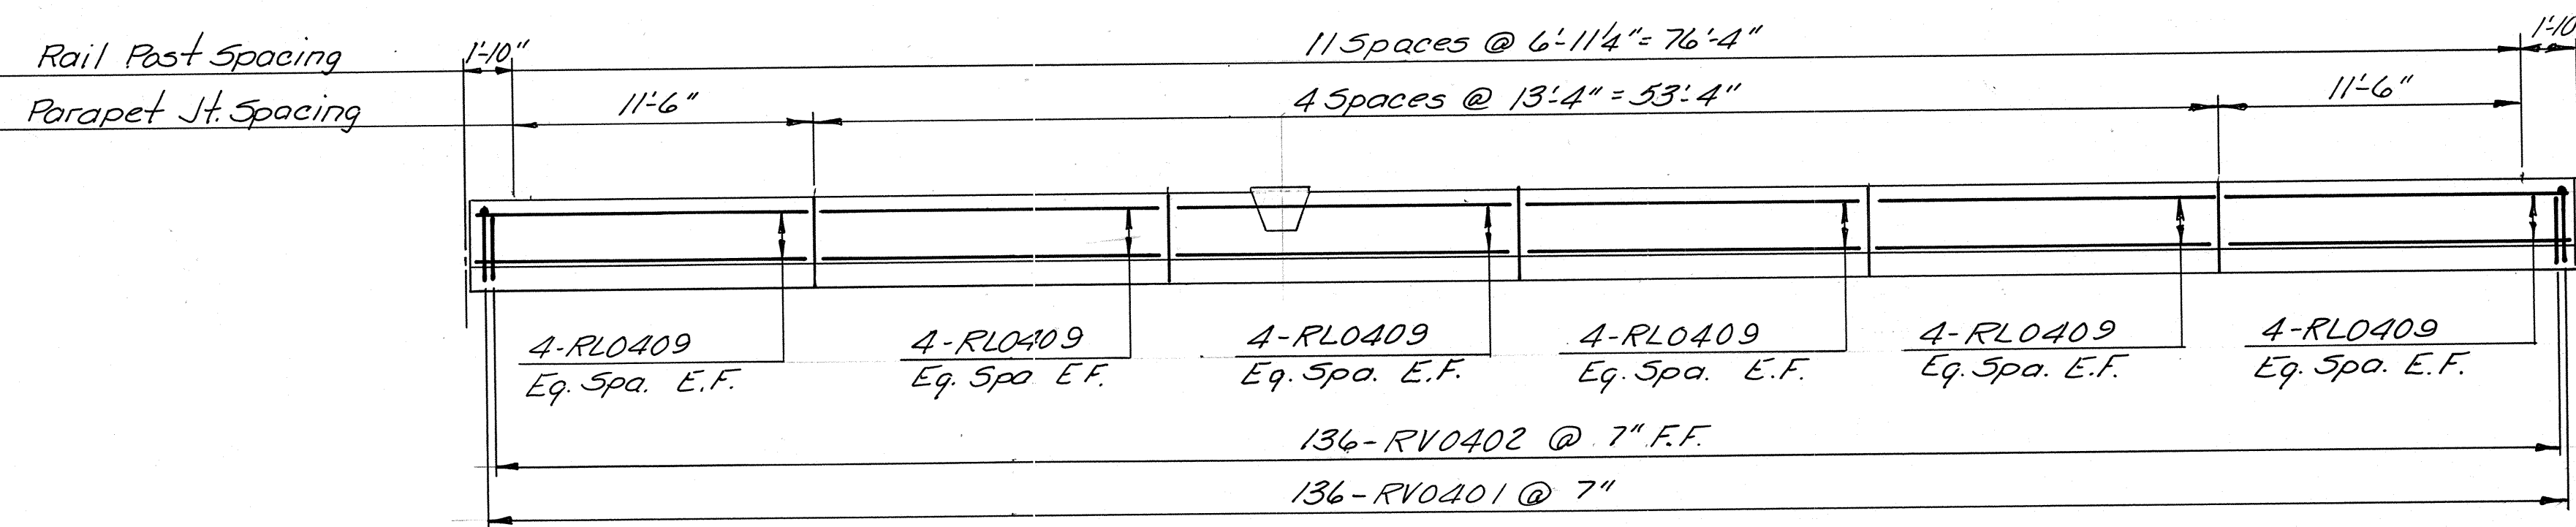

PARAPET ELEVATION - UNIT 17 NORTHBOUND
Scale: 3/16" = 1'-0"

BY	DATE				
MADE	TAL	3-87			
CHECKED	TFP	3-87	As Built	TEM	3-89
IN CHARGE	S.R.				

AS BUILT


RICHMOND METROPOLITAN AUTHORITY
RICHMOND EXPRESSWAY SYSTEM

DECK PLAN - UNIT 17 NORTHBOUND


HOWARD, NEEDLES, TAMMEN & BERGENDOFF
consulting engineers
Alexandria, Virginia

SCALE: AS SHOWN
CONTRACT NO.: C-13
SHEET NO. 64 OF 106

RICHMOND EXPRESSWAY SYSTEM			
SECTION	PROJECT	SHEET NO.	TOTAL SHEETS
13	WIDENING JAMES RIVER BRIDGE	65	106

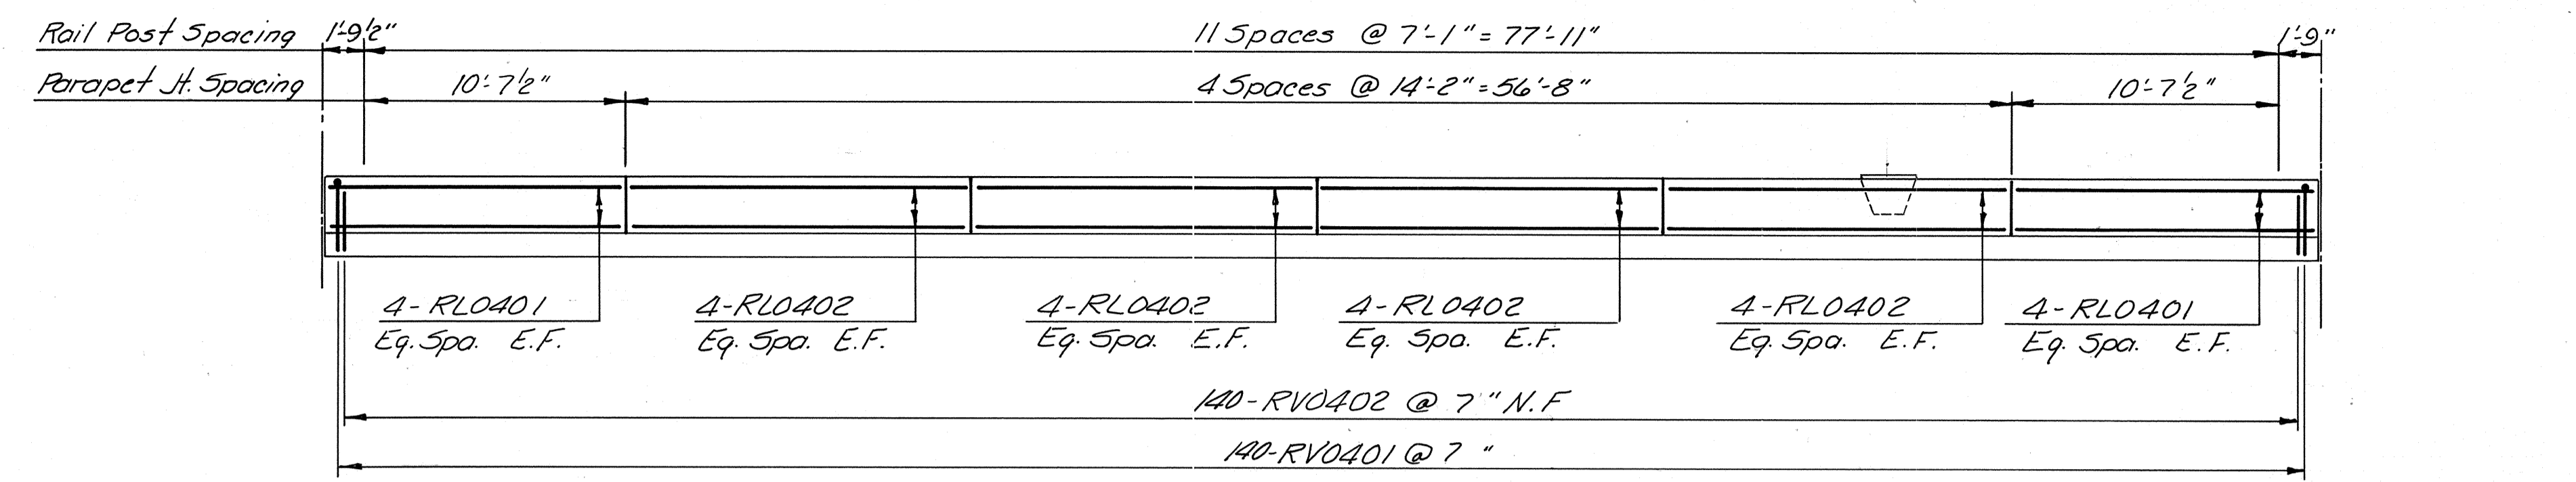

**PARAPET ELEVATION - UNIT 18 SOUTHBOUND & NORTHBOUND
(SOUTHBOUND SHOWN)**

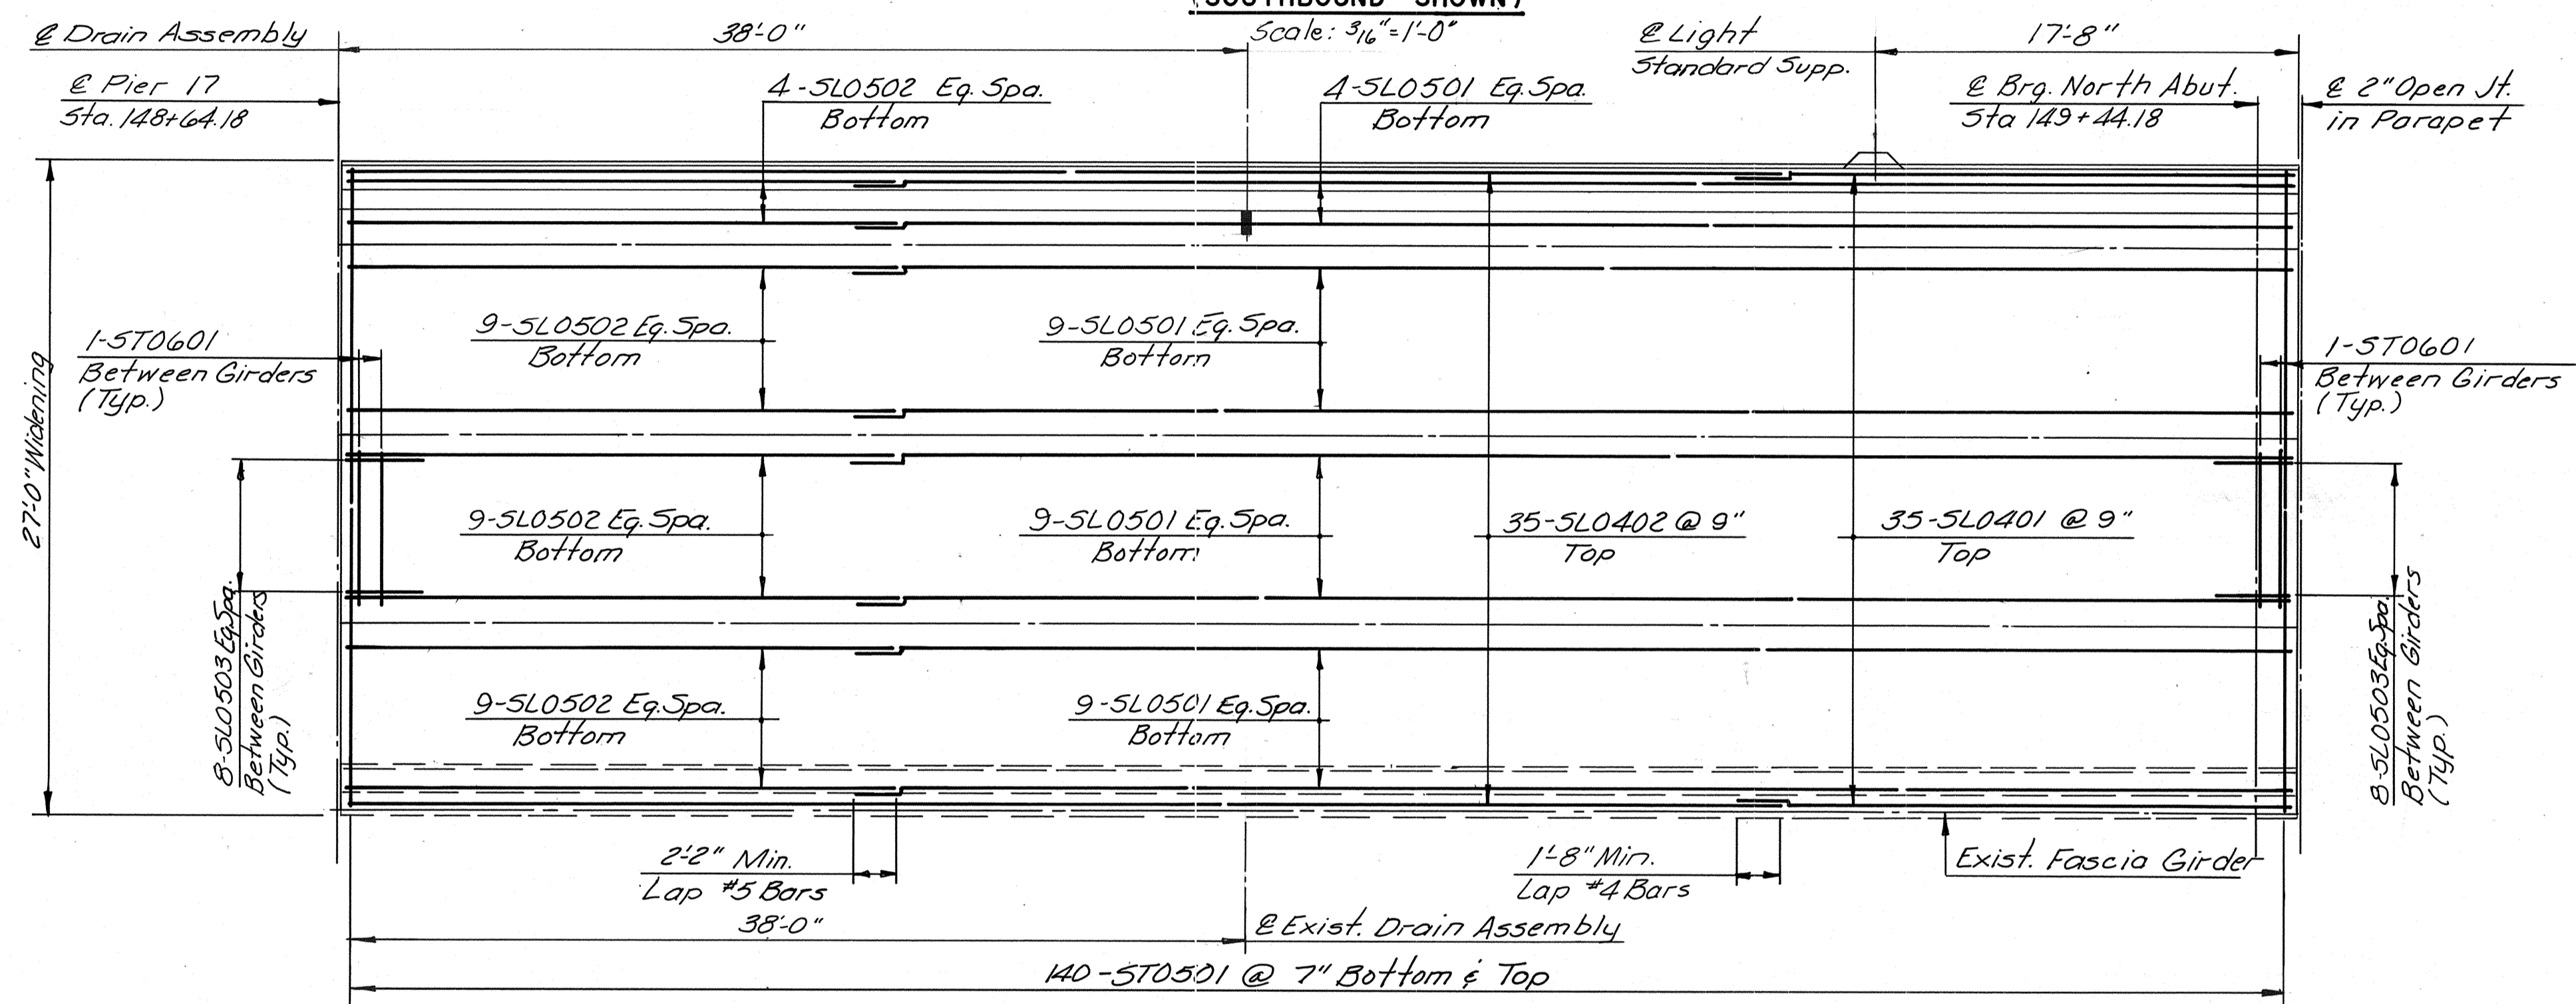

**DECK PLAN - UNIT 18 SOUTHBOUND & NORTHBOUND
(SOUTHBOUND SHOWN)**
Scale: 3/16"=1'-0"

BY	DATE				
MADE	TAL	3-87			
CHECKED	TFP	3-87	As Built	TEM	3-89
IN CHARGE	S.R.				





AS BUILT

**RICHMOND METROPOLITAN AUTHORITY
RICHMOND EXPRESSWAY SYSTEM**

**DECK PLAN
UNIT 18 SOUTHBOUND & NORTHBOUND**

HOWARD, NEEDLES, TAMMEN & BERGENDOFF
consulting engineers
Alexandria, Virginia

SCALE: AS SHOWN
CONTRACT NO.: C-13
SHEET NO. 65 OF 106

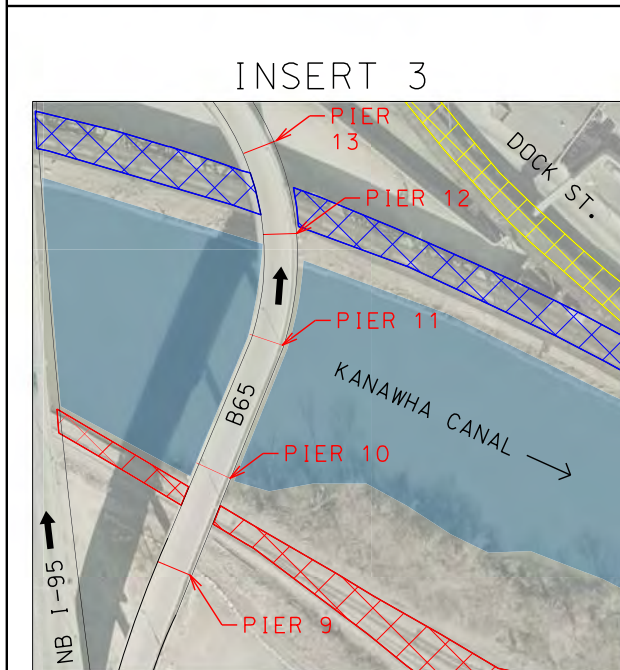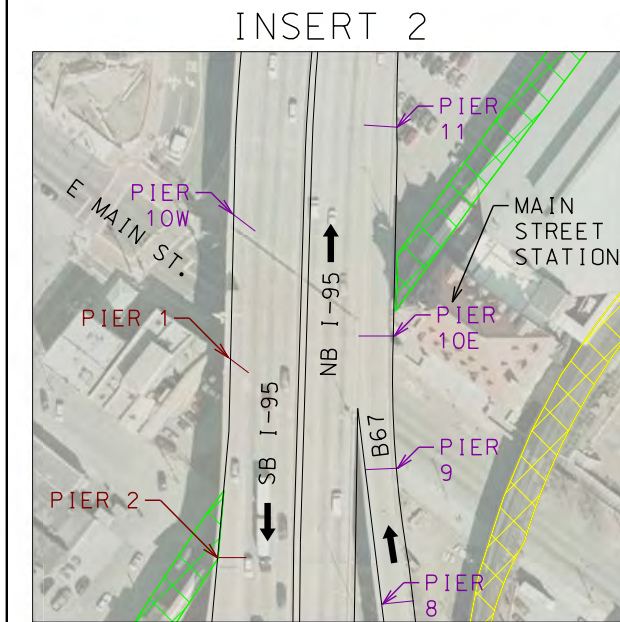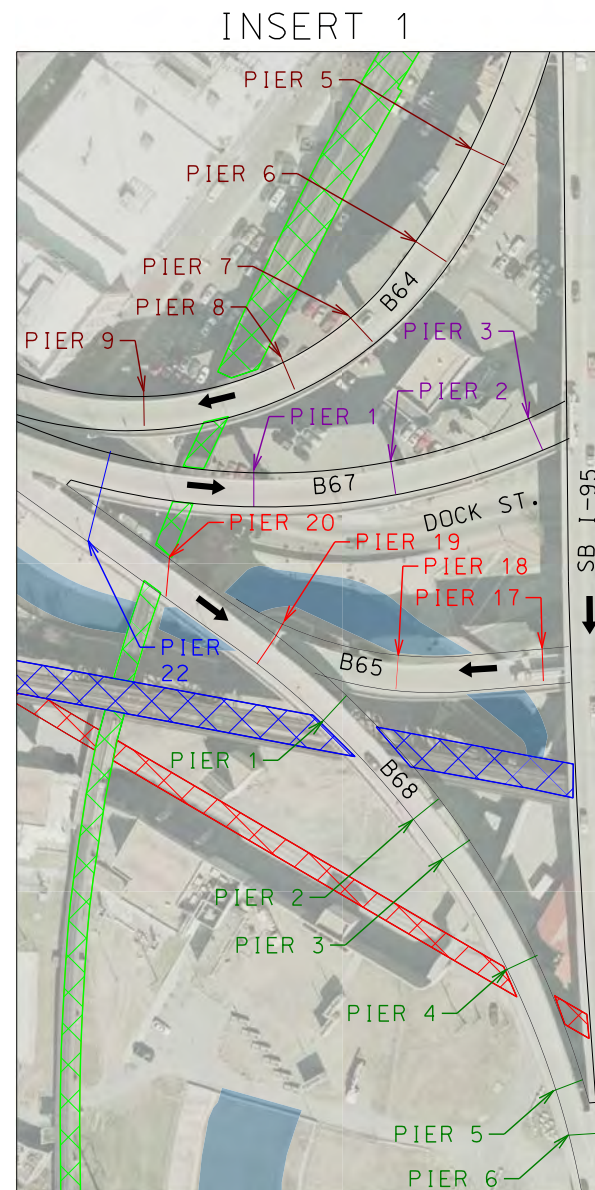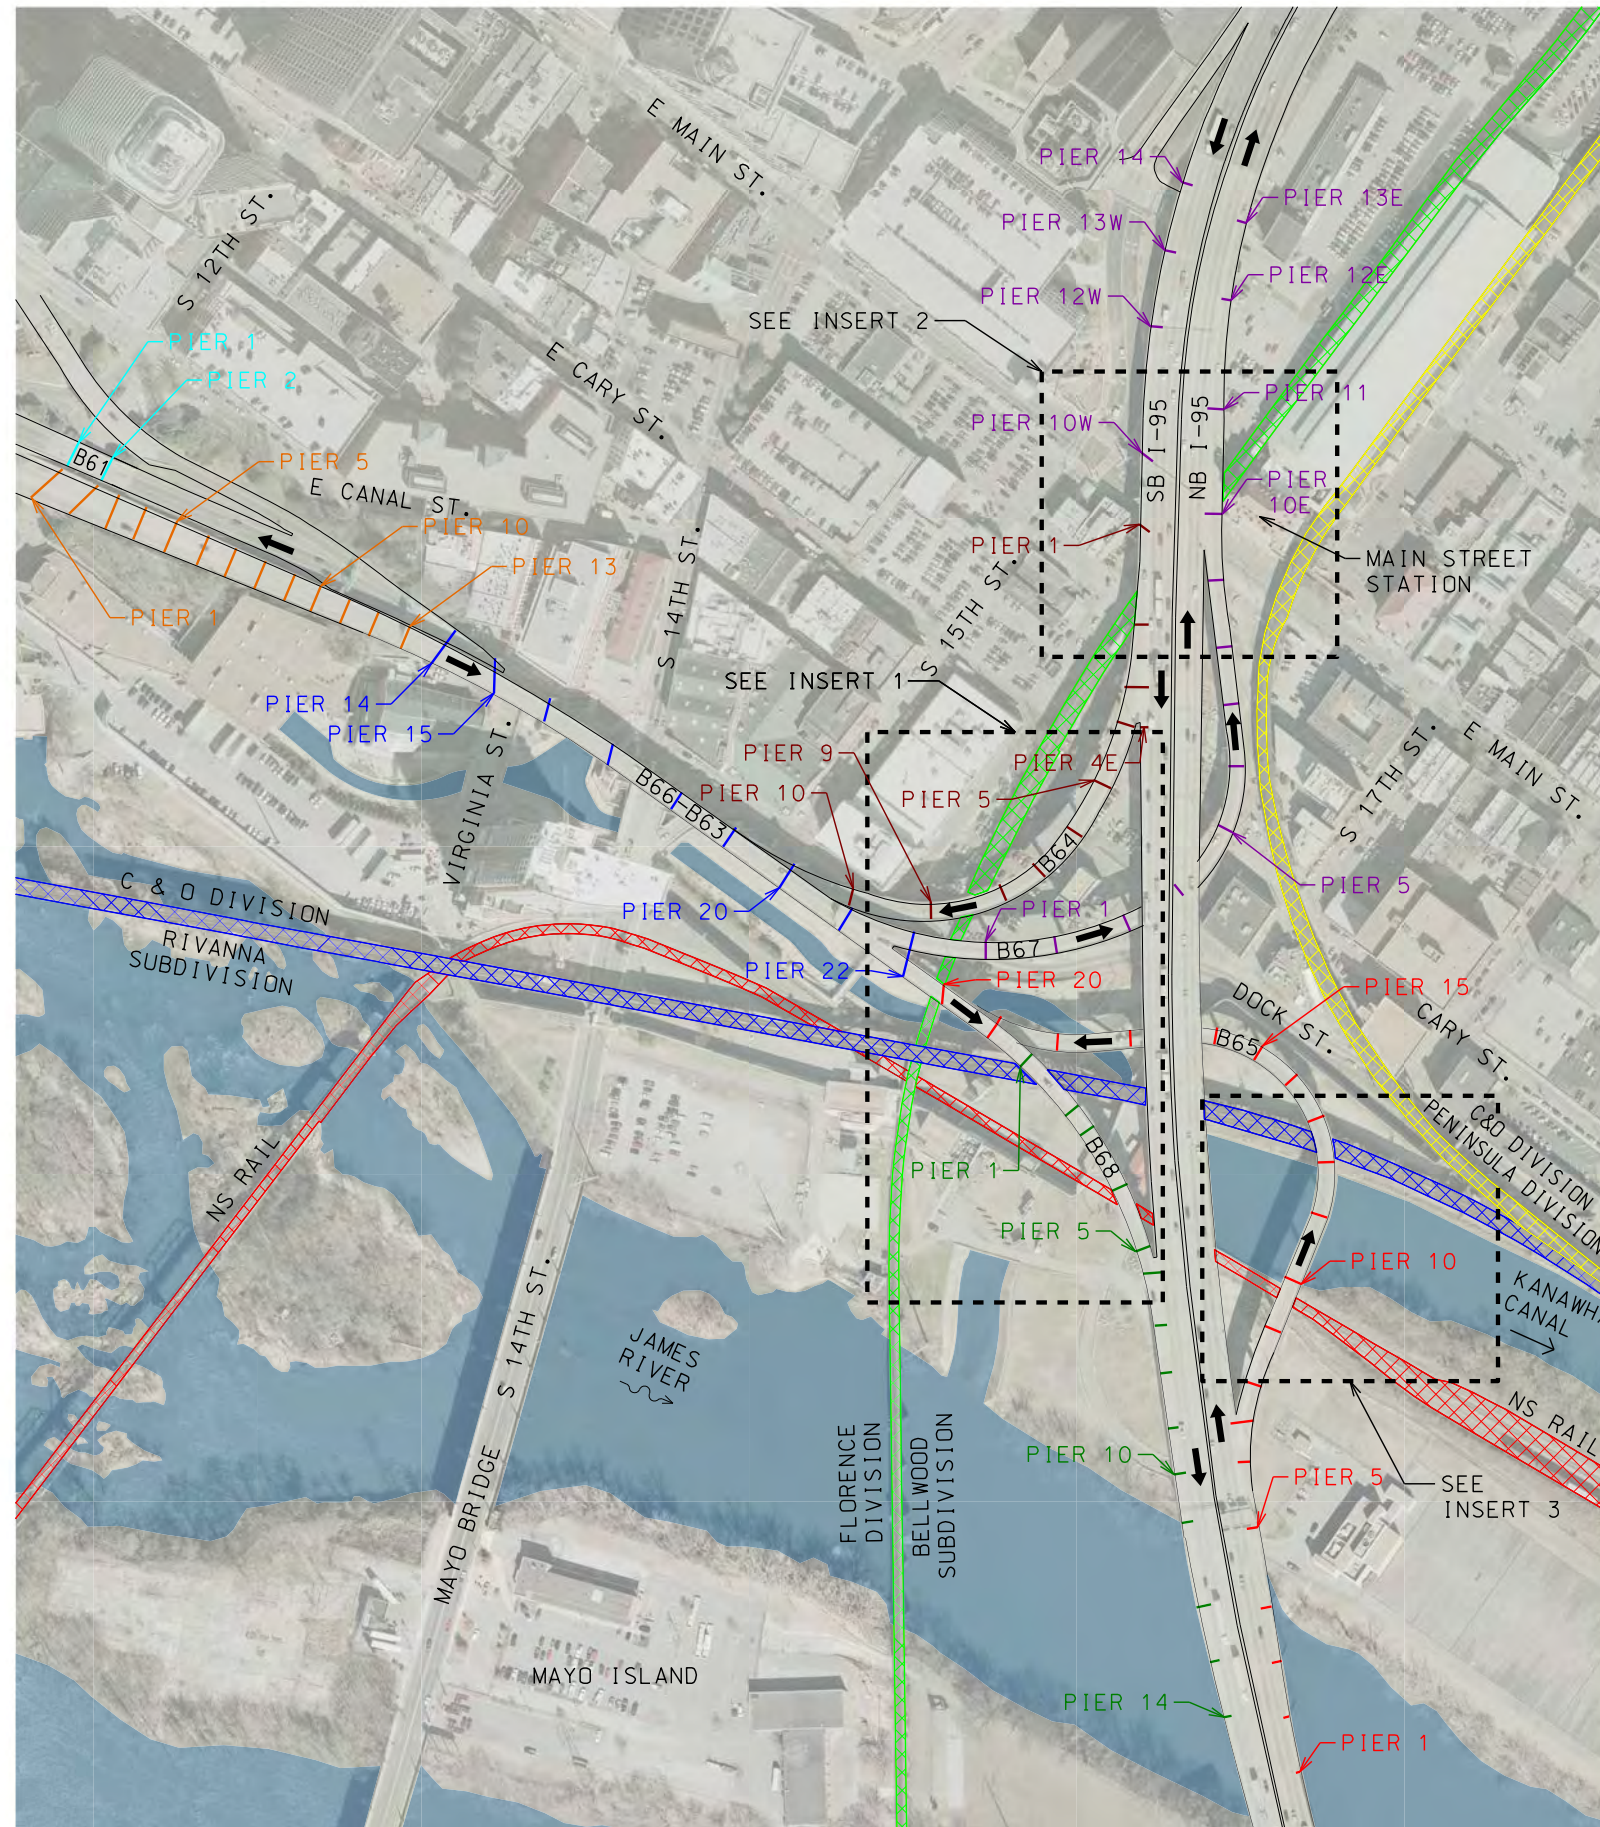

LEGEND:

	BRIDGE 63
	BRIDGE 64
	BRIDGE 65
	BRIDGE 66
	BRIDGE 67
	BRIDGE 68
	N&S RAILROAD
	CSX RAILROAD
	CSX RAILROAD
	CSX RAILROAD

- NOTES:**
- 1) PIER NUMBERS BASED ON AS-BUILT DRAWINGS FROM CONTRACTS C-10 AND C-11.
 - 2) RAILROAD LIMITS AND PIER LOCATIONS BASED ON AERIAL PHOTOGRAPHY.
 - 3) THIS EXHIBIT IS FOR REFERENCE ONLY. REFER TO AS-BUILT DRAWINGS FOR EXACT PIER LOCATIONS.
 - 4) BRIDGE 63 IS ON BOTTOM, BRIDGE 66 IS ON TOP.

RICHMOND METROPOLITAN TRANSPORTATION AUTHORITY

HNTB

I-95 RAMPS PIER LOCATION EXHIBIT

2900 S. QUINCY STREET, SUITE 200
ARLINGTON, VIRGINIA
(703) 824-5100

Scale: N.T.S.	Date: MAY 2015	Contract No.: MR-2015	Sheet: 1 OF 1
------------------	-------------------	--------------------------	------------------

GENERAL NOTES

STRUCTURE: Dual structures with one welded steel girder span and one rolled beam at each approach. Distance between girders of 18'-4" with 1'-6" min. clear between structures.

CAPACITY: Live Loads - Cooper E-80 with 50% impact

SPECIFICATIONS: GENERAL: Virginia Department of Highway Road and Bridge Specifications 1970 and Contract Special Specifications. DESIGN: A.R.E.A. 1966 for Steel Railway Bridges, for Fixed Spans not exceeding 400 feet in length. WELDING: 1969 Standard Specifications for Welded Highway and Railway Bridges of the American Welding Society.

CONTRACT SPECIAL PROVISIONS: Specifications and Contract Special Provisions referred to above are necessary to make these plans complete.

DATUM: City of Richmond

TEMPERATURE: The normal temperature referred to on the plan is 68°F. The temperature range for movement is 0°F to 120°F.

DIMENSIONS: All dimensions are measured horizontally and vertically unless otherwise noted.

EXCAVATION: Excavation below subgrade and cut slope template shall be classified as Structure Excavation. All excavation above these limits shall be classified as Regular Excavation and is not included in the Structural Quantities.




FOUNDATION: Piles shall be driven to a minimum length corresponding to the approximate tip elevations shown on the Plans but in no case to less than a penetration affording the required safe bearing capacity noted on the Plans.

CONCRETE NOTES: All concrete shall be Class A3. All exposed edges and corners shall have a 3/4" chamfer or fillet unless otherwise noted. Finishing Concrete Surfaces: See The Standard Architectural Detail sheets and the Contract Special Provisions for Types and details.

All reinforcing steel shall conform to A.S.T.M. A615, Grade 40. All reinforcing bar dimensions on the detailed drawings are to centers of bars unless otherwise noted. Clear distance between reinforcing steel and face of concrete shall be as noted on the plans. All bar laps shall be 30 diameters of the smaller bar unless otherwise noted.

STEEL NOTES: Structural steel shall conform to A.S.T.M. Specification A-36 and A-588. All Field Connections shall be made with high strength bolts or rivets. High strength bolts and rivets shall be 1/2" diameter unless otherwise noted and shall conform to A.S.T.M. Specification A-325.

BENCH MARK: A-15 Copperweld rod on bridge on Blue Shingles Road Elev. 204.73.

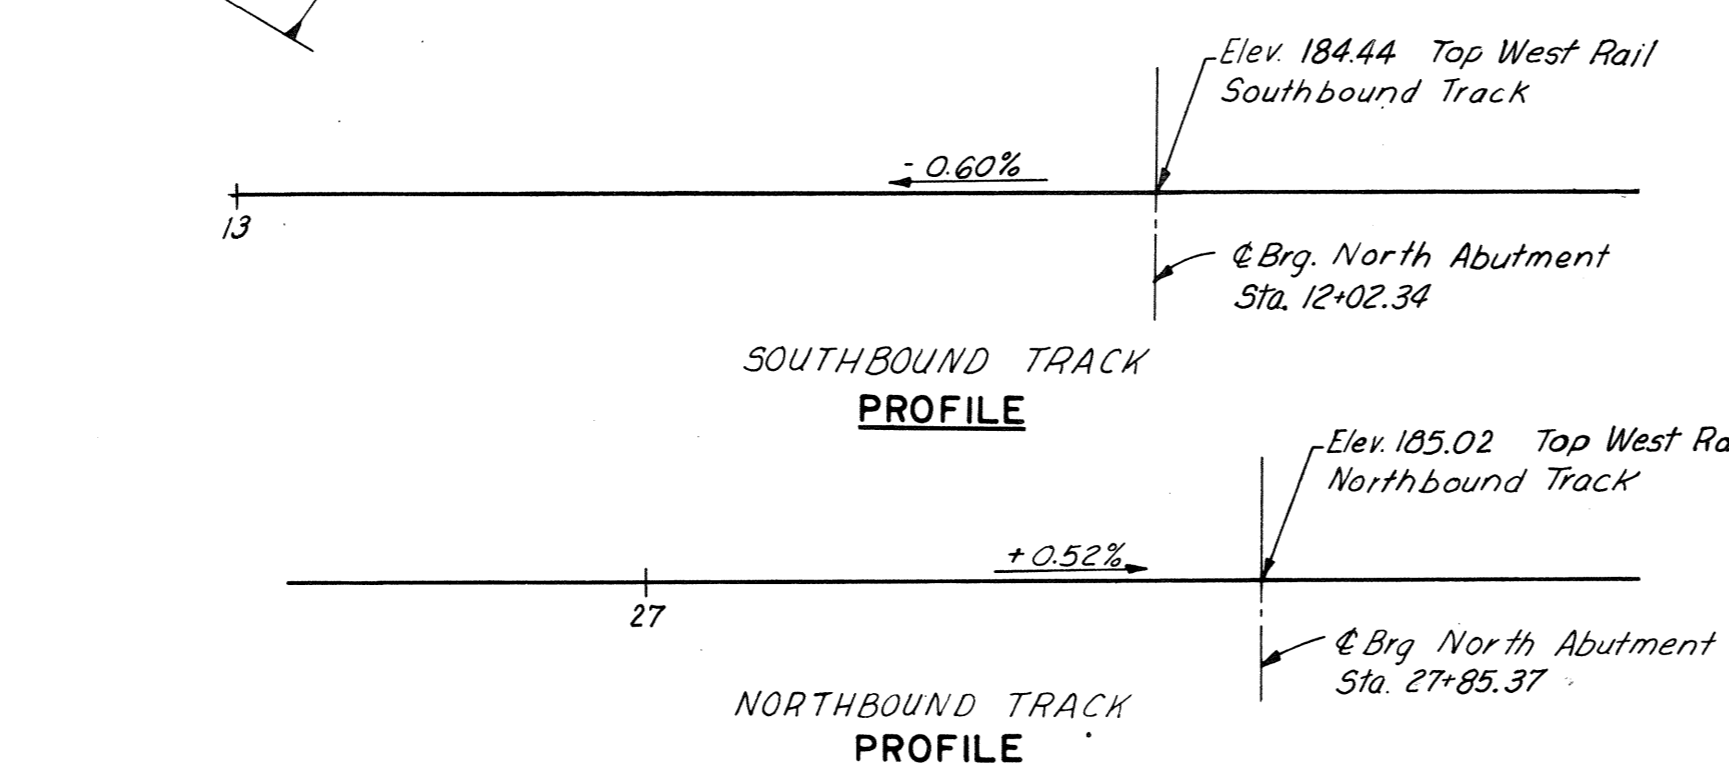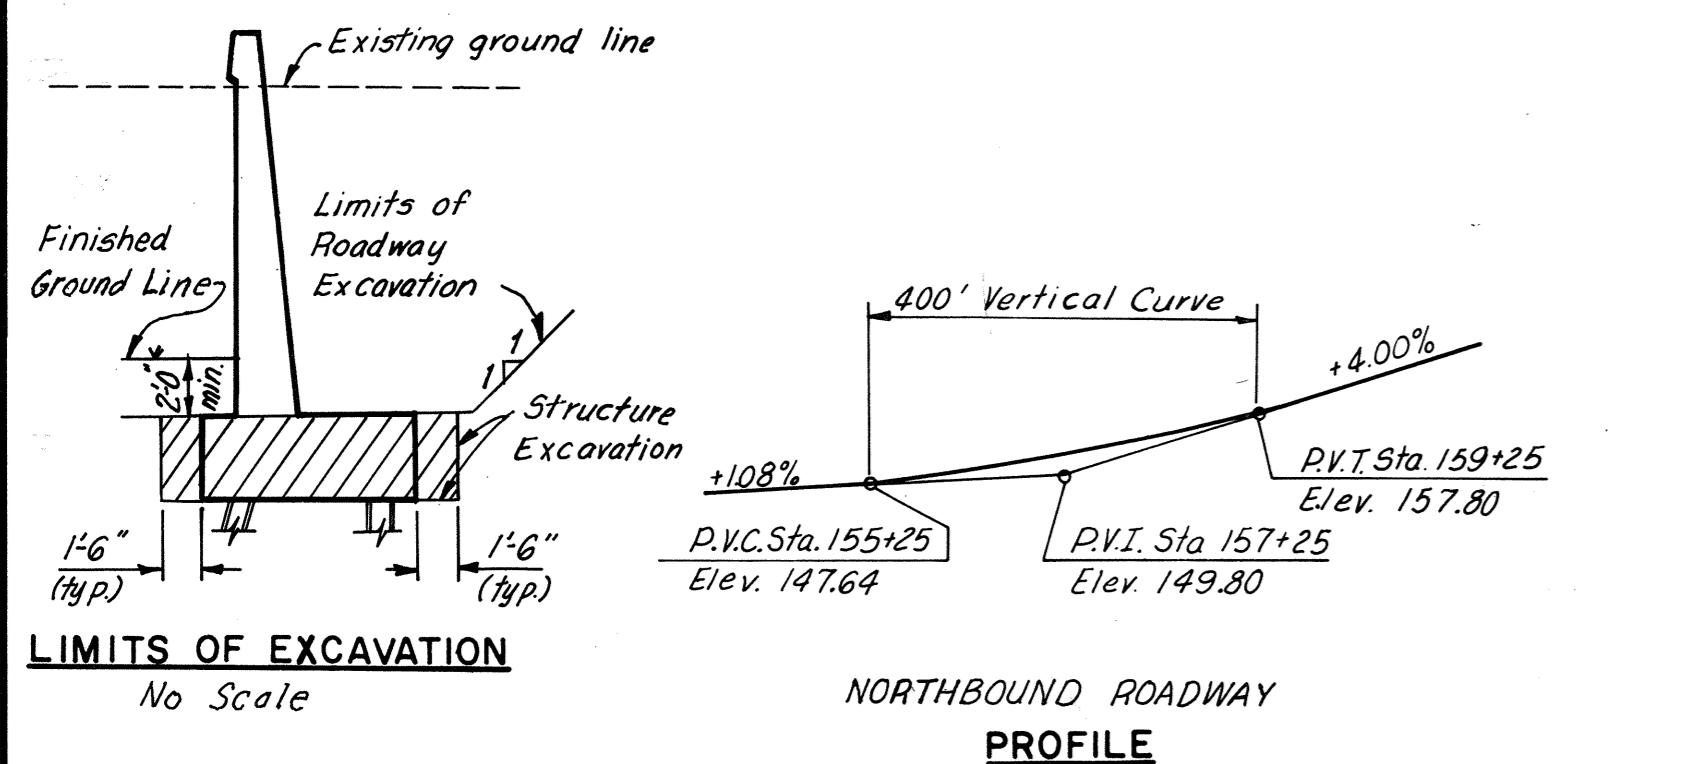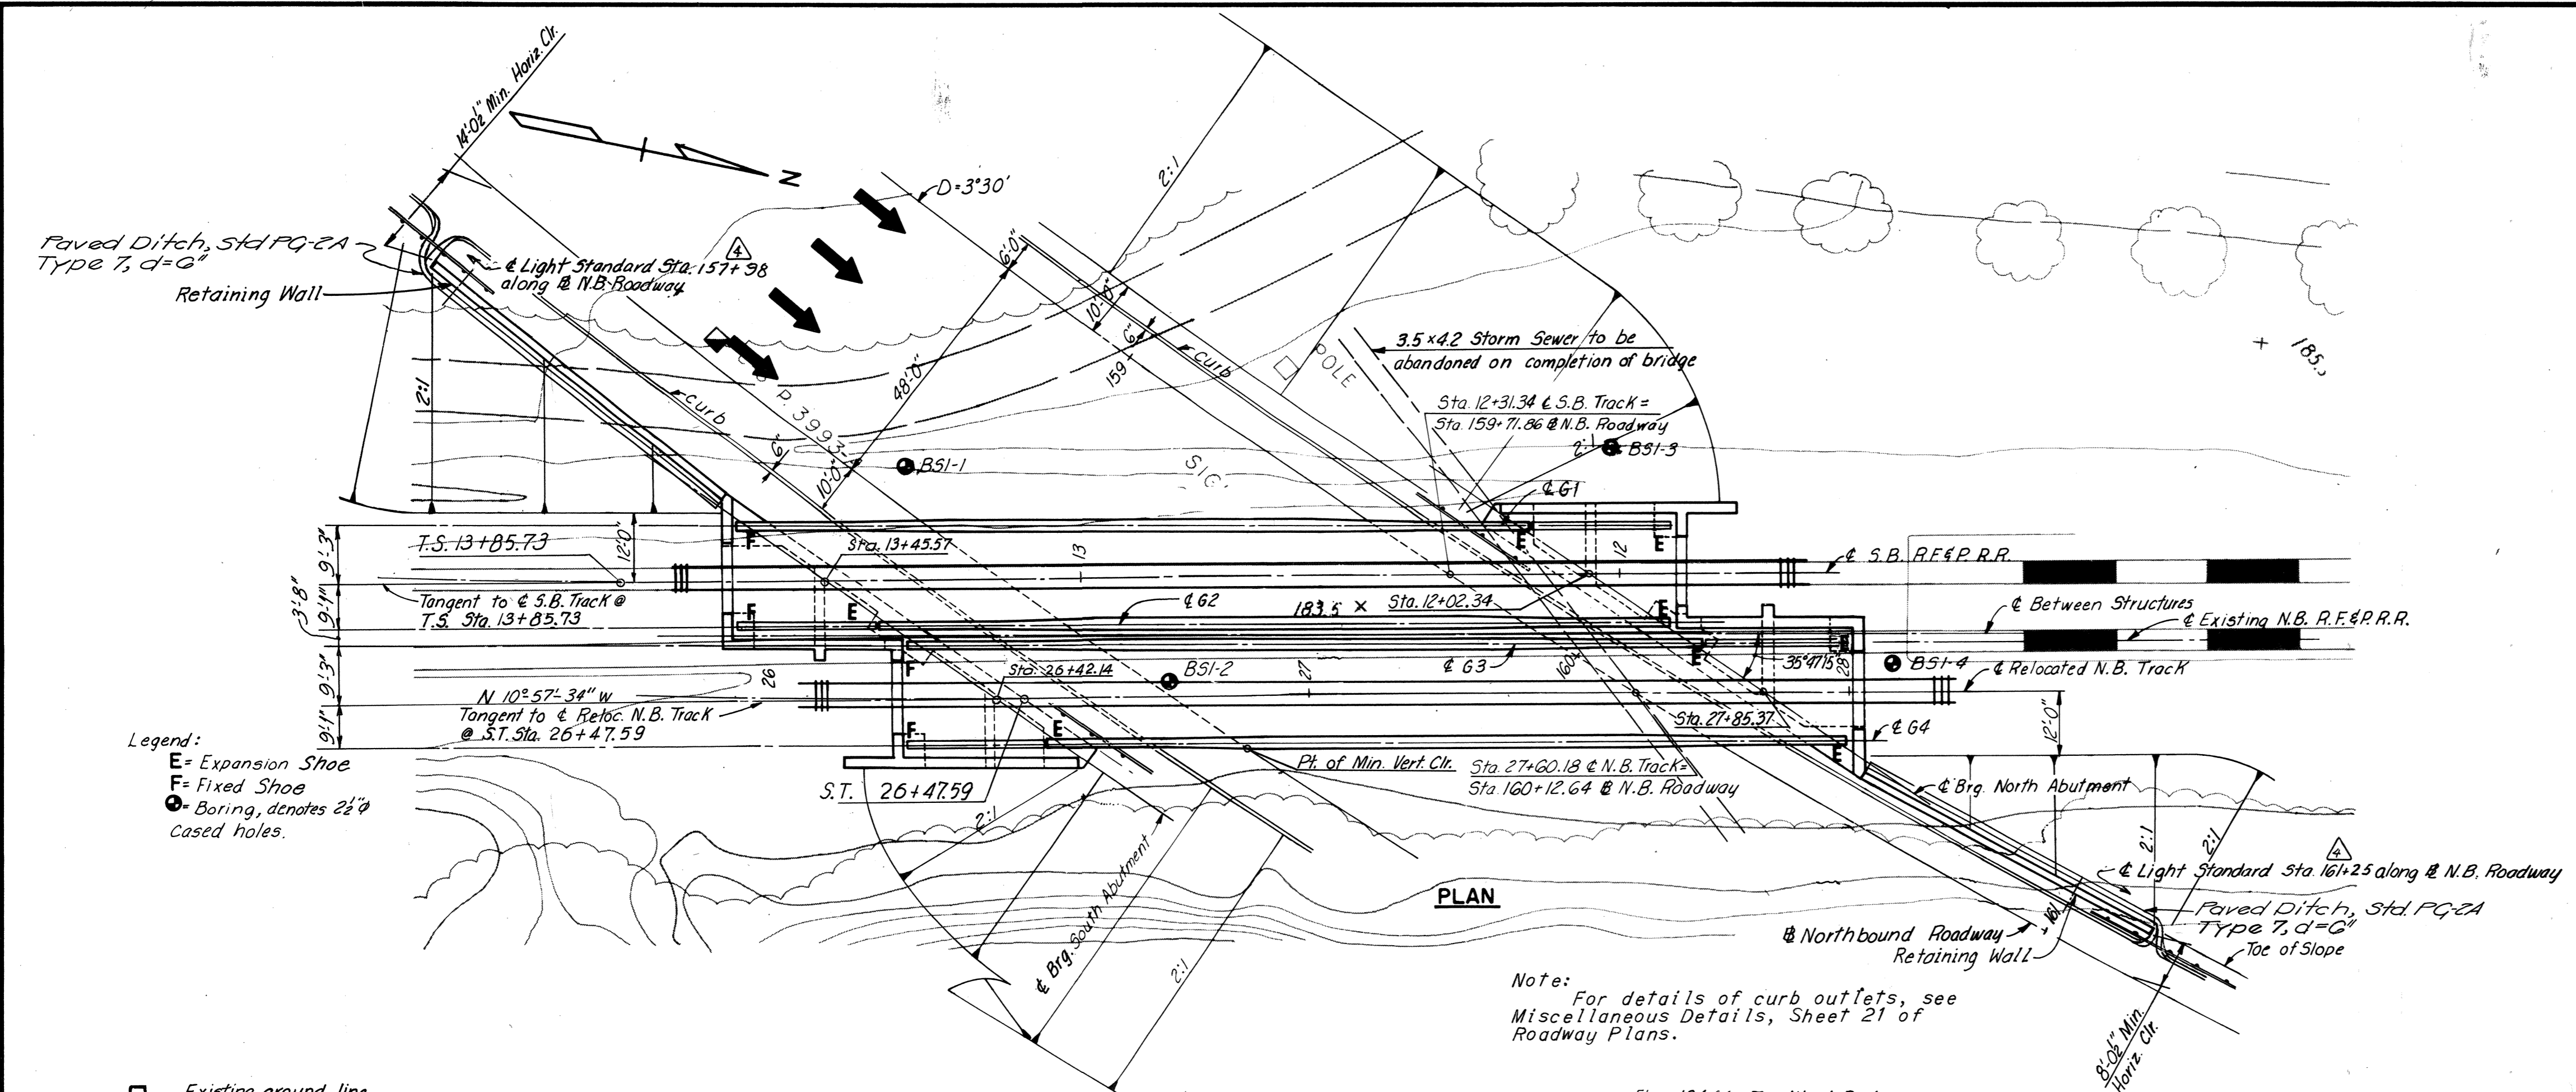

ESTIMATED QUANTITIES


	Struct. Excav. Cu. Yds.	Concrete (a) Cu. Yds.	Reinf. Steel Lbs.	Struct. Steel (Lbs.)		Porous Backfill Cu. Yds.	Under-drain 6" Dia. Pipe Lin. Ft.	Steel piles 10BP42 Lin. Ft.	Steel piles 12BP53 Lin. Ft.	Asphalt damp-proofing Sq. Yds.	1/2" Asphalt Plank Sq. Ft.	1/2" Butyl Rubber Water-proofing Square	Bridge Drainage Metalwork Lbs.
				Mild Carbon	High Strength								
Superstructure				855,568.2	280,976.7						7498	75	
North Abutment	286	538.82	65,027			64	129	1,858.4	2,993.0	183			
South Abutment	298	657.26	76,926			75	136	982.8	2,030.4	207			2,691
TOTAL	584	1,256.08	141,953	855,568.2	280,976.7	139	265	2,841.2	5,023.4	390	7498	75	2,691

(a) Class A3

INDEX

Sheet

GENERAL PLAN AND ELEVATION	1
NORTH ABUTMENT	2
NORTH ABUTMENT RETAINING WALL	3
SOUTH ABUTMENT	4
SOUTH ABUTMENT RETAINING WALL	5
ABUTMENT DETAILS	6
FRAMING PLAN	7
SUPERSTRUCTURE DETAILS	8
SUPERSTRUCTURE DETAILS	9
SHOE DETAILS	10
BORING LOGS	11
BORING LOGS	12
STANDARD ELECTRICAL DETAILS	56
STANDARD ARCHITECTURAL DETAILS - S8 AND S9	

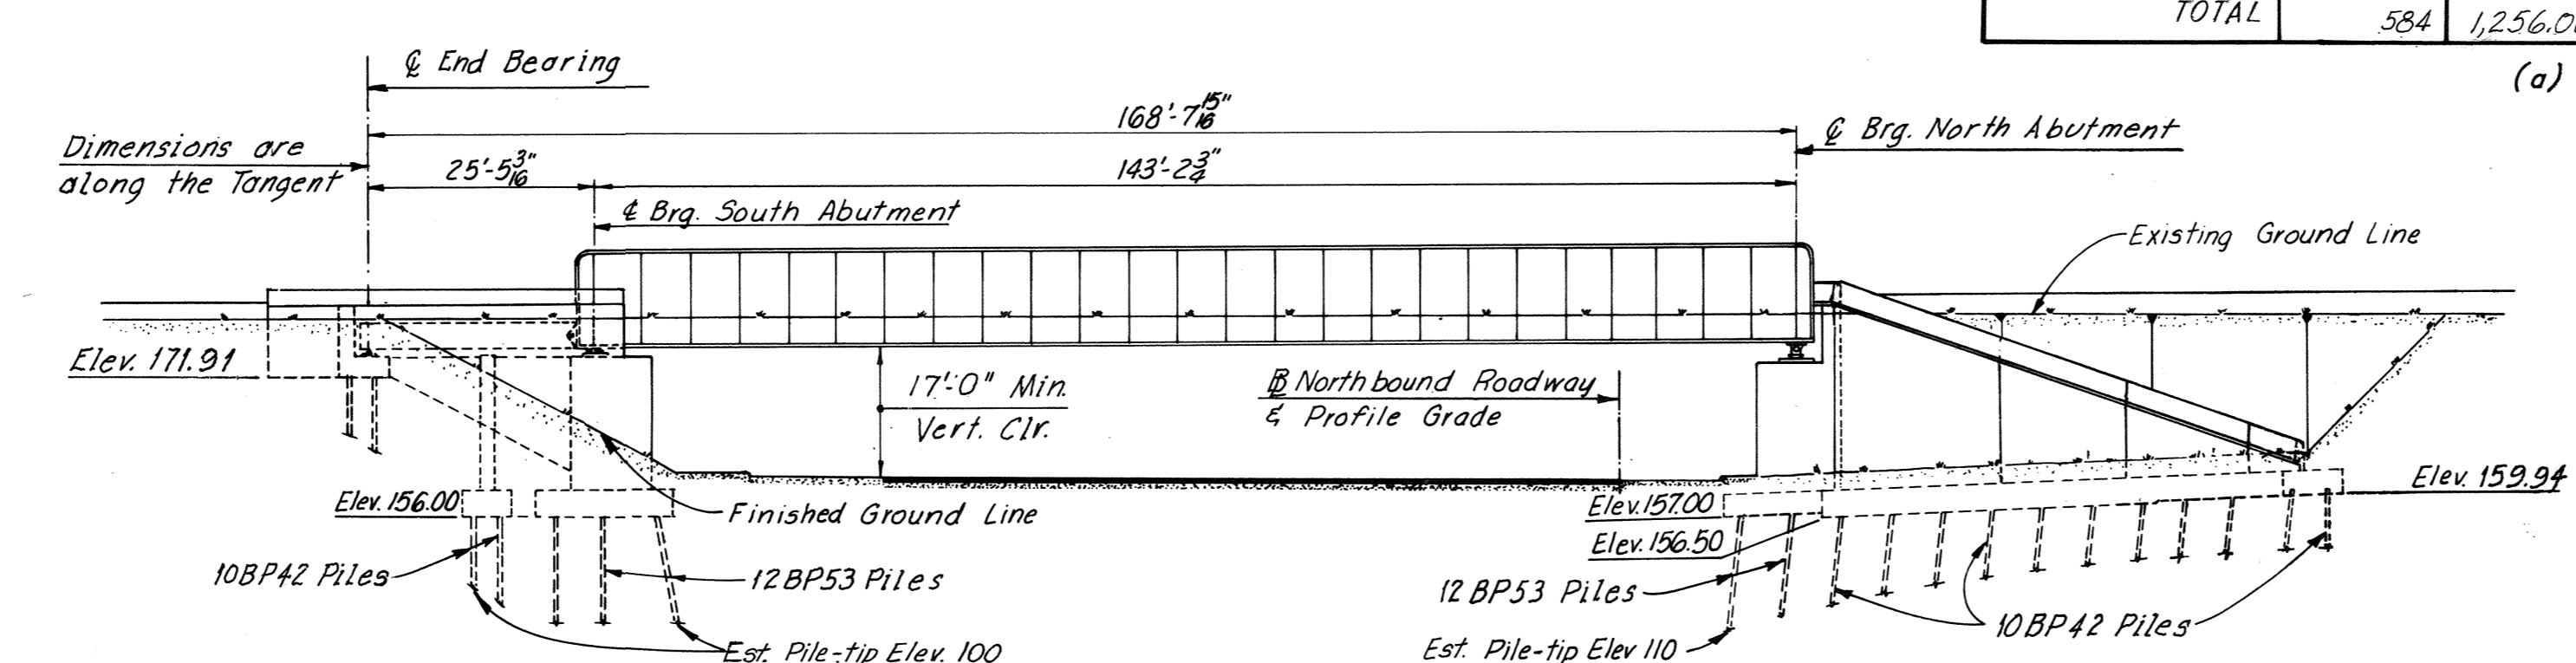

BY	DATE	NO.	REVISION	BY	DATE
RLM	12-2-67	2	General	J.G.V.	10-70
JEH	4-11-68	1	General Checking	AMH	5-13-68
FKD					

CURVE DATA

Station	Value	Station	Value	Station	Value
T.S.	Sta. 13+85.73	P.I.	Sta. 156+91.30	C.S.	Sta. 23+97.59
S.C.	Sta. 16+41.73	A	37°59'54"	S.T.	Sta. 26+47.59
Ls	256.00'	D	3°30'100"	Ls	250.00'
Os	5'40'149"	T	563.64'	Os	4°22'30"
Xc	255.75'	L	1085.66'	Xc	249.85'
Yc	8.45'	R	1637.02'	Yc	6.36'
L.T.	170.75'			L.T.	166.72'
S.T.	85.41'			S.T.	83.38'
L.C.	255.89'			L.C.	249.94'

AS BUILT


RICHMOND METROPOLITAN AUTHORITY
RICHMOND EXPRESSWAY SYSTEM
BELTLINE EXPRESSWAY

BRIDGE NO. 9
R.F.&P.R.R. OVER
NORTHBOUND ROADWAY
GENERAL PLAN AND ELEVATION

HOWARD, NEEDLES, TAMMEN & BERGENDOFF
consulting engineers
NEW YORK ALEXANDRIA KANSAS CITY


SCALE: 1" = 20' unless noted
CONTRACT NO.: 4
SHEET NO. 1 OF 12

RICHMOND EXPRESSWAY SYSTEM			
SECTION	PROJECT	SHEET NO.	TOTAL SHEETS
4	BELTLINE EXPRESSWAY	95	155

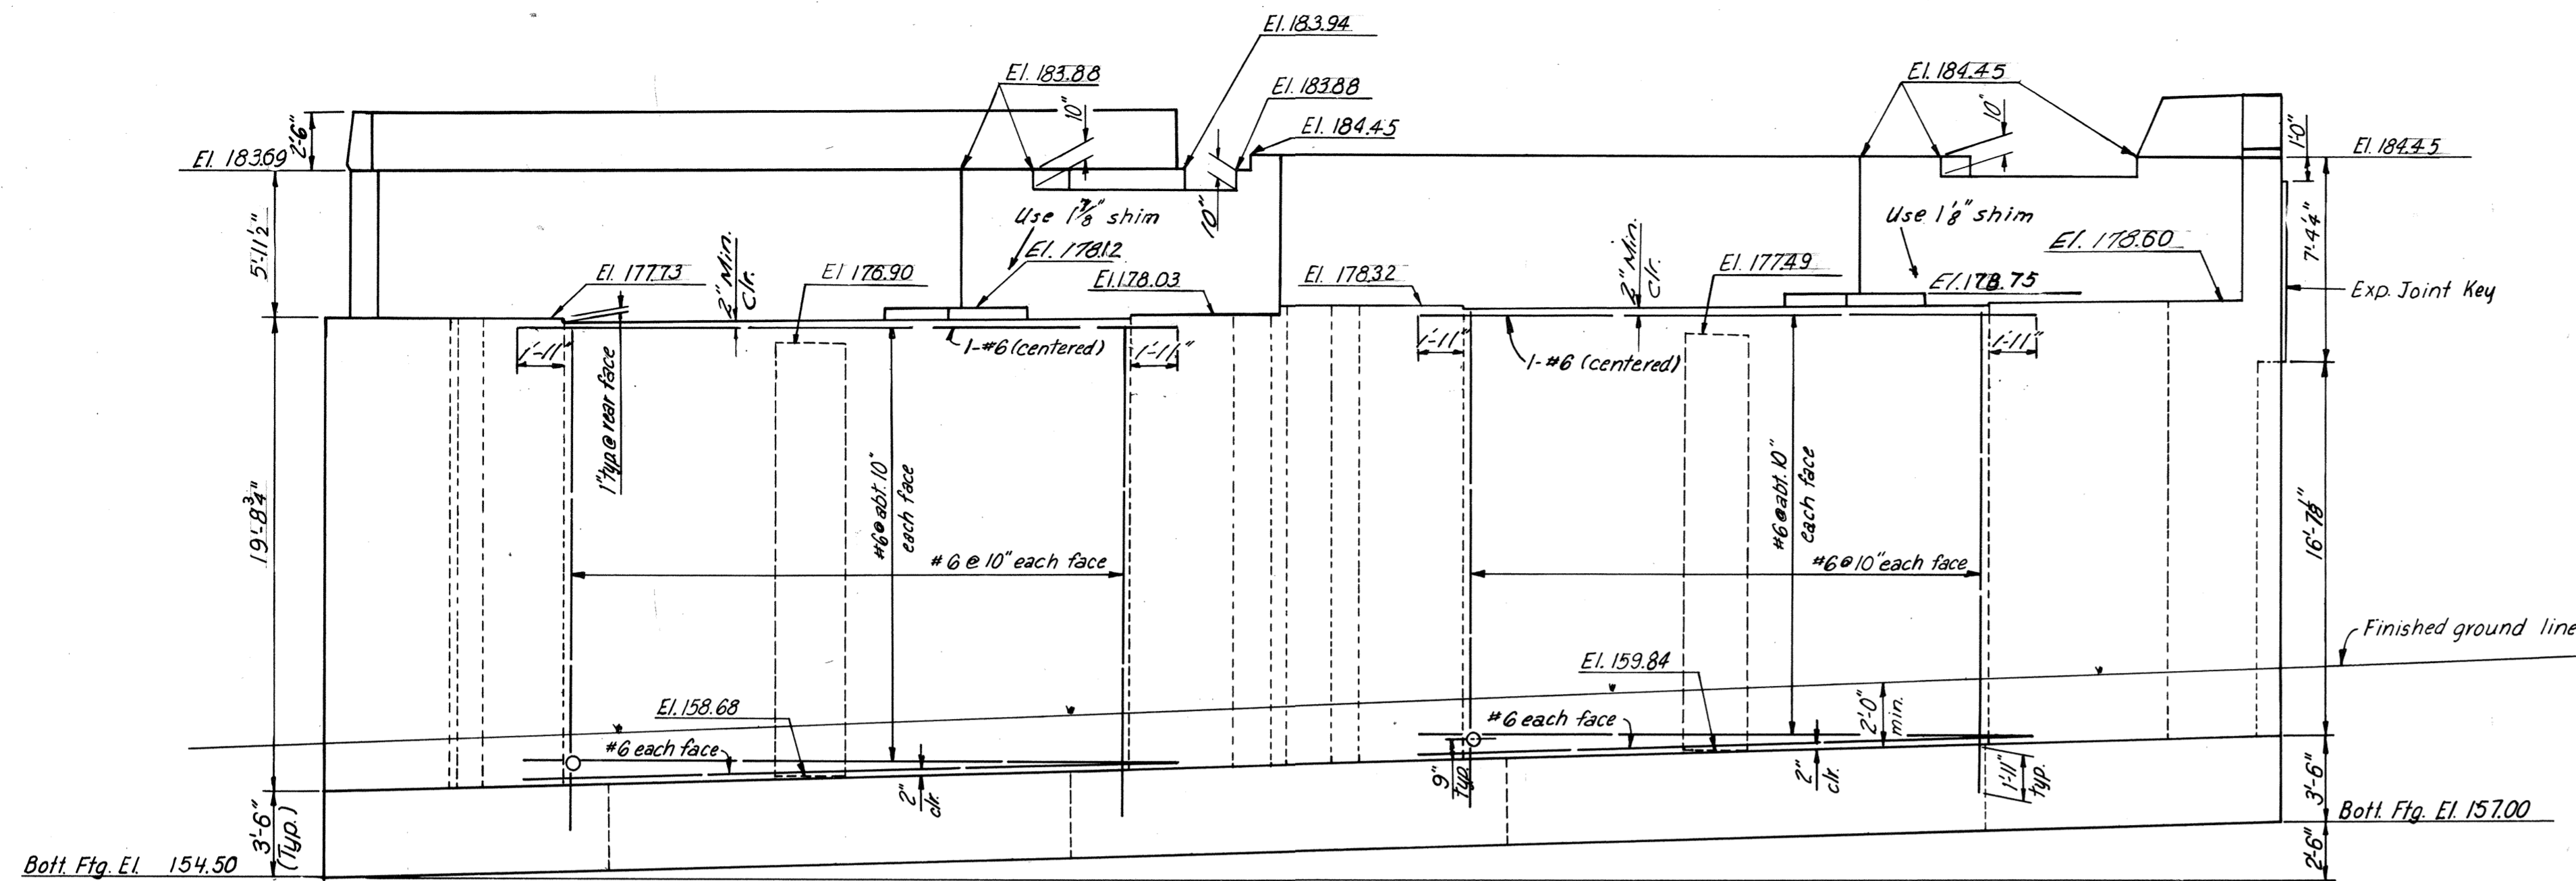


ELEVATION
Scale 3/16" = 1'-0"

Note: Piles not shown in Elevation. For location, see Footing Plan. Concrete pavement over backfill is level.

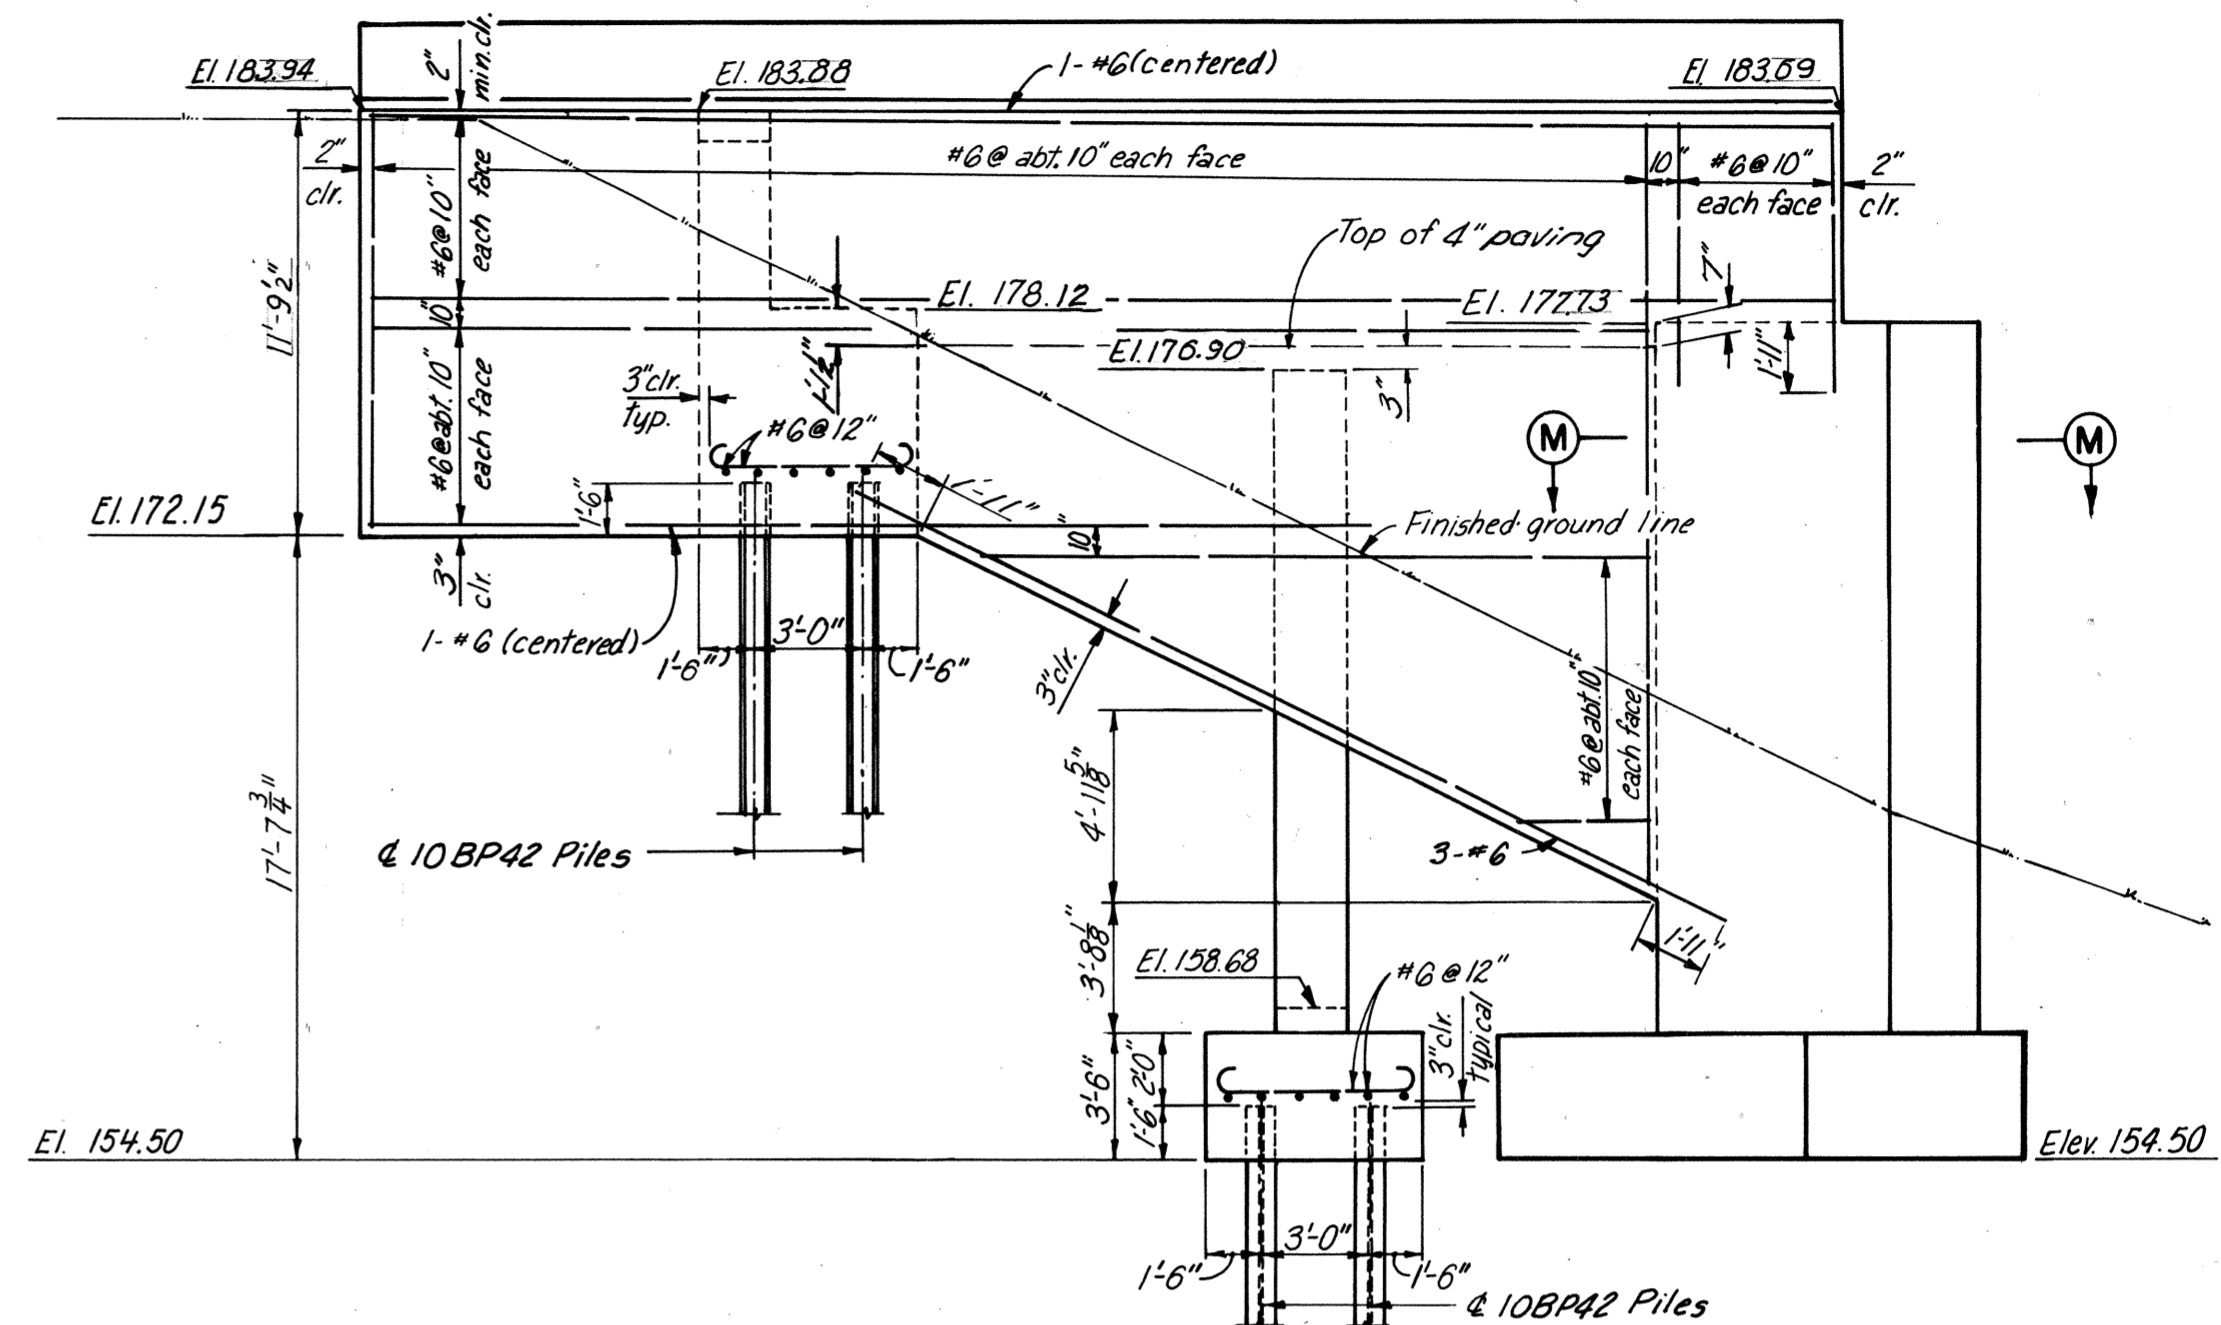


WEST WINGWALL ELEVATION
Scale 3/16" = 1'-0"

Note: Piles not shown in front footing. For location of piles, see Footing Plan.

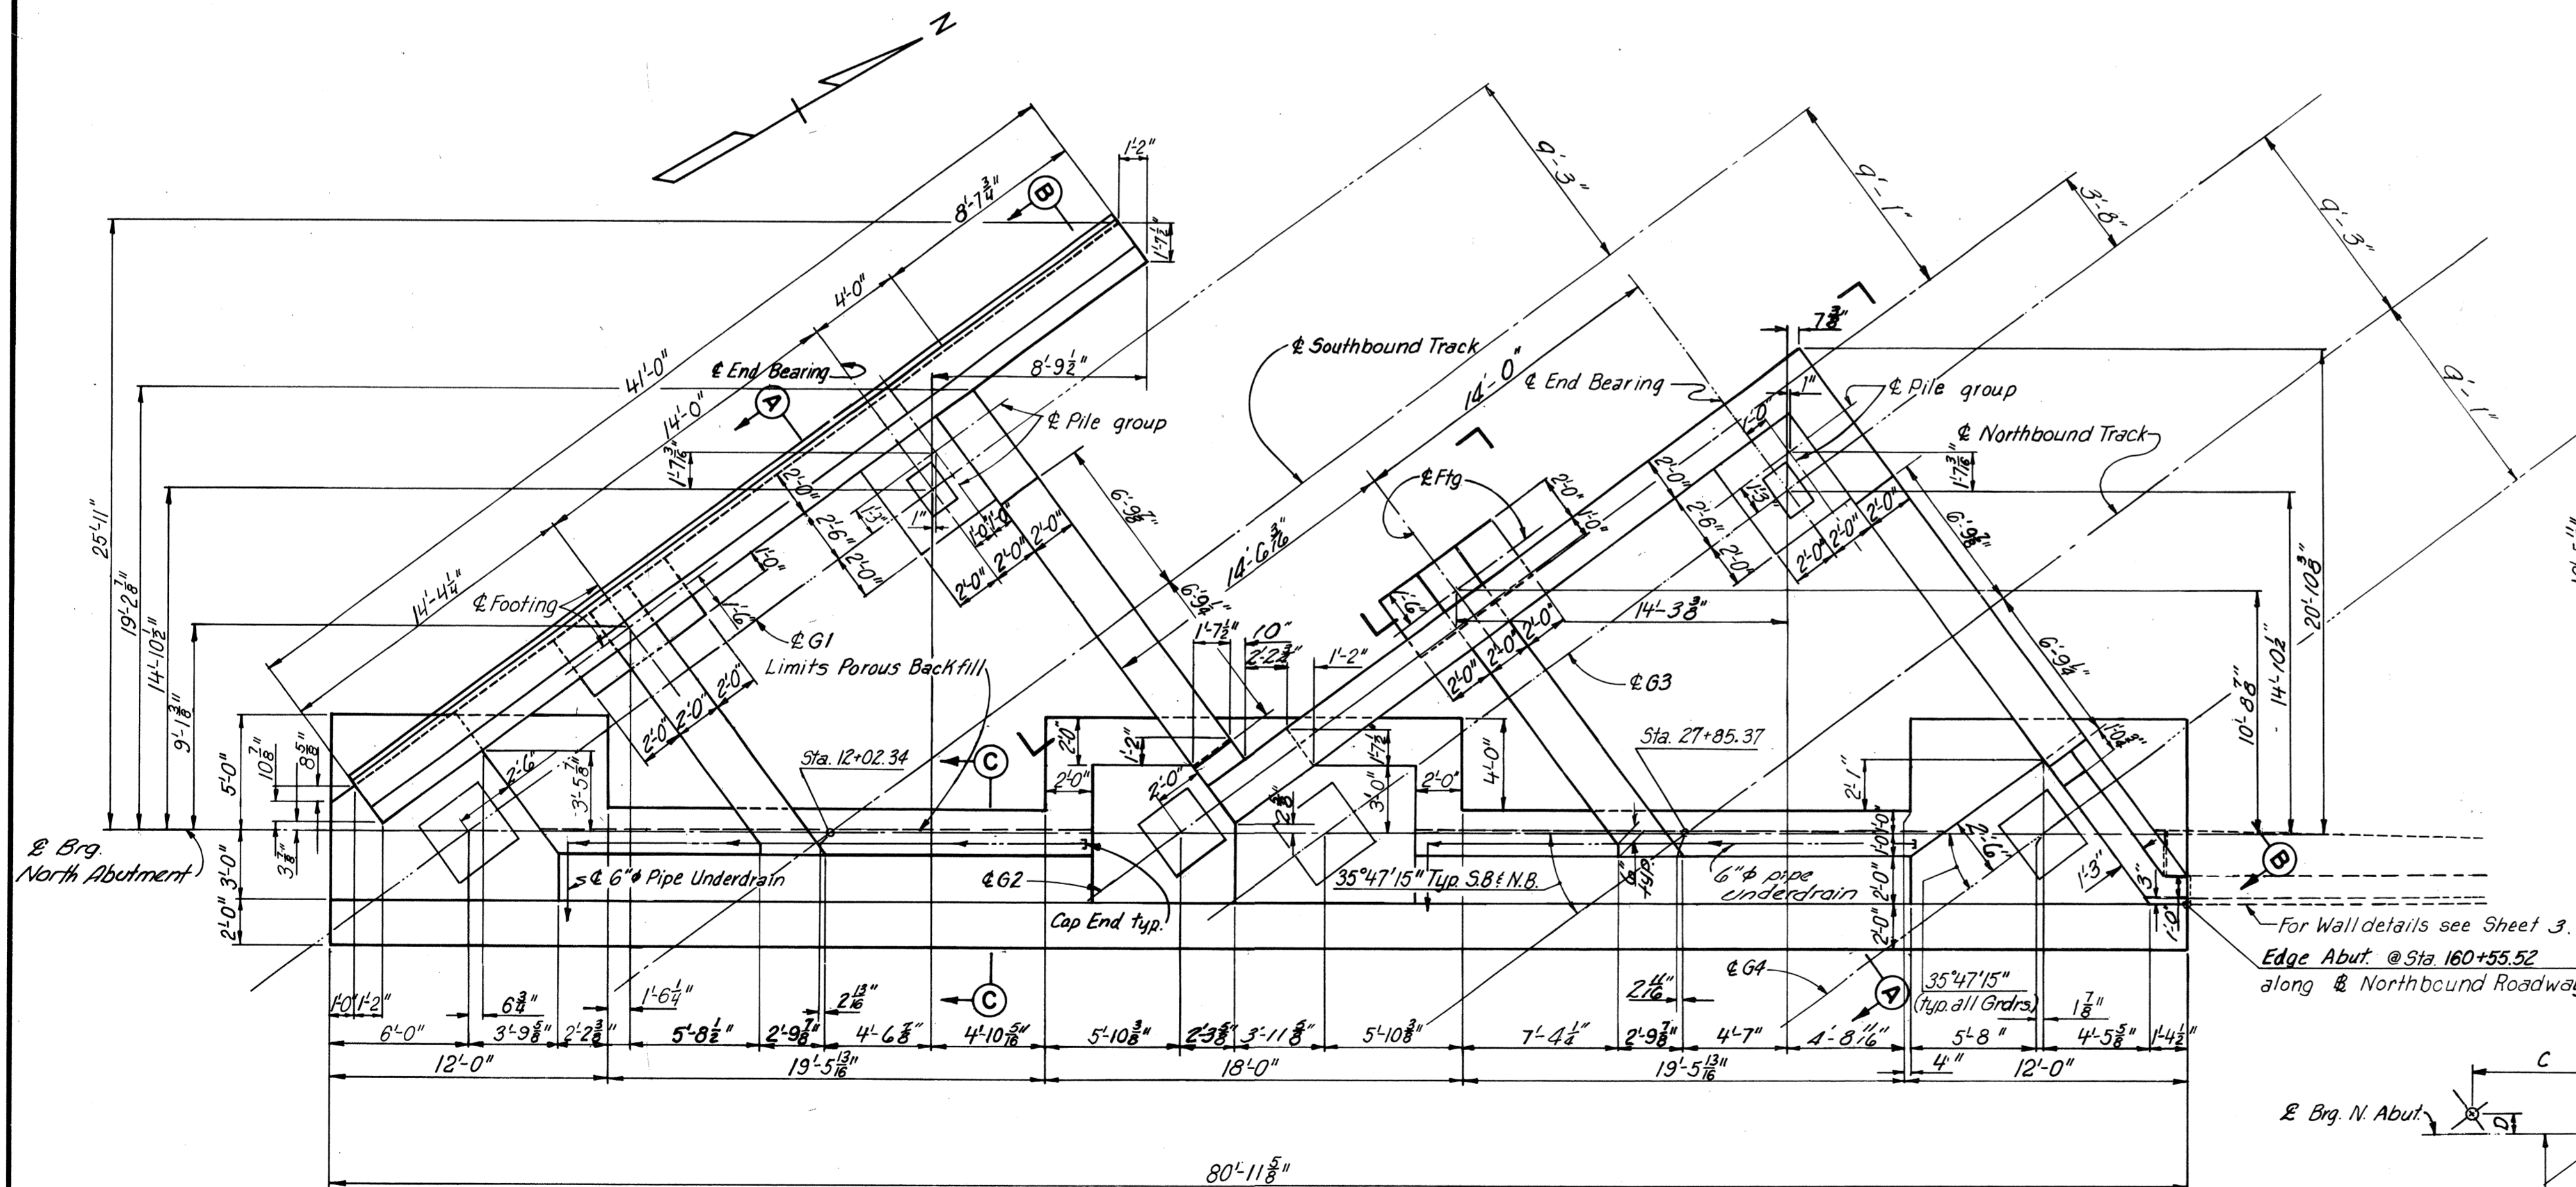


PLAN
Scale 3/16" = 1'-0"

Note: For Sections A-A, B-B, C-C, and M-M, see Sheet 6. For Reinforcing not shown, see Abutment Details, Sheet 6. For Drainage Details, see Sheet 10. Reinforcing to be shifted to miss underdrain. 6" Dia. Underdrain to be sloped at 4"/ft. towards outlet in front wall.

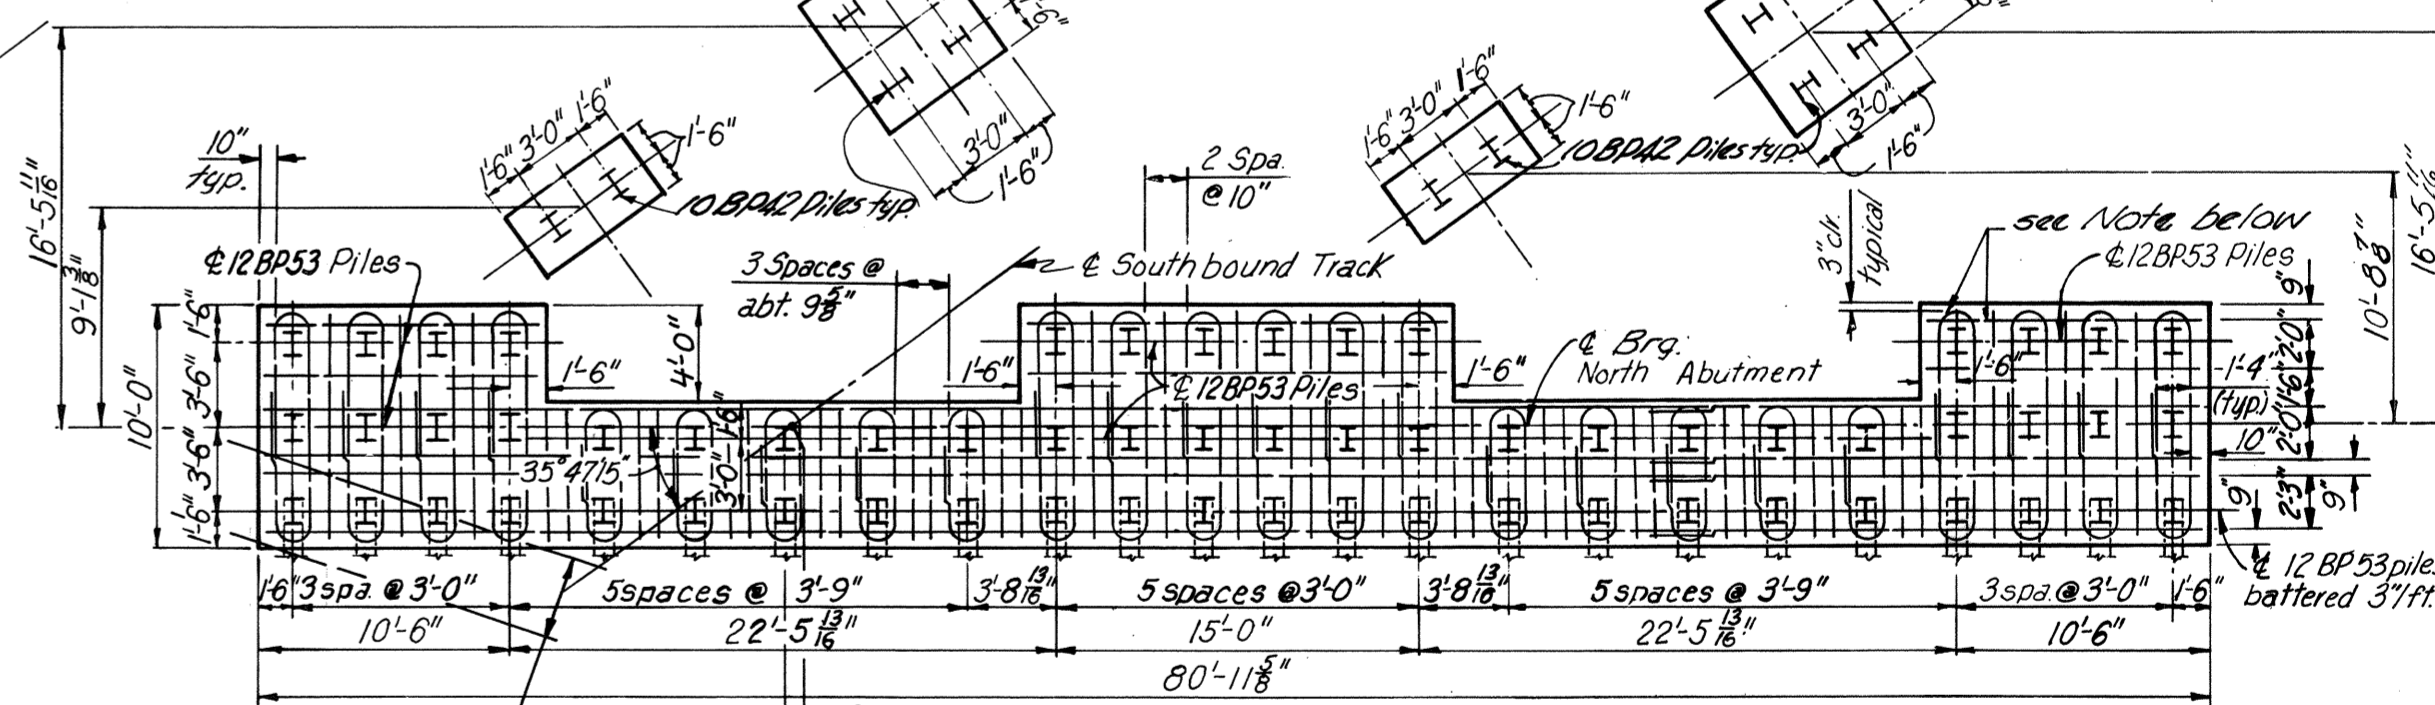

FOOTING PLAN
Scale 3/8" = 1'-0"

For Wall details see Sheet 3. Edge Abut. @ Sta 160+55.52 along Northbound Roadway

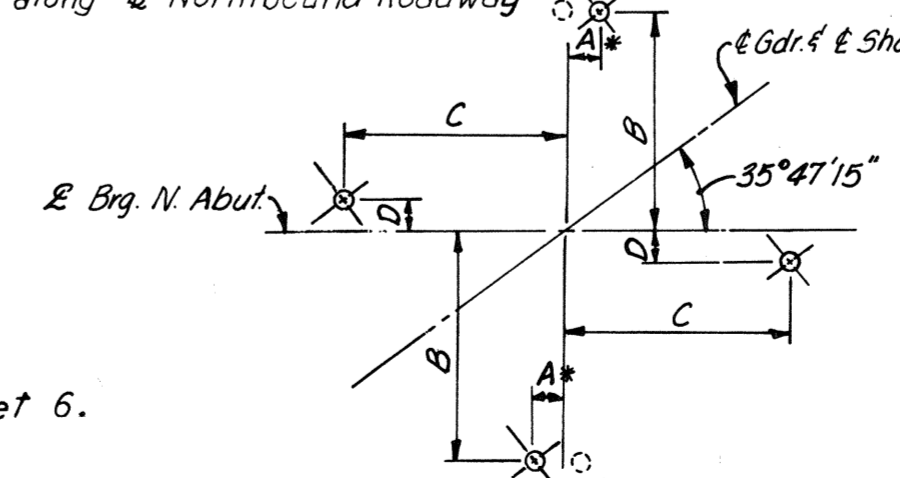

ANCHOR BOLT SETTING PLAN
No Scale

	A	B	C	D
1-EL SHOE	3 3/4"	1'-11 1/8"	1'-11 1/8"	3 3/4"
2-E SHOE	16"	1'-7 1/8"	1'-6 1/8"	16"

*Anchor Bolt for 2-E Shoe lies on other side of dimension line as shown by dotted circle. This will also put dimension A on other side of dimension line.

AS BUILT

Note: Stirrups around piles have a radius of 8" for the bends and a lap of 21-6". Reinforcing shown is typical for both top and bottom. All footing bars are # 8 bars.


RICHMOND METROPOLITAN AUTHORITY
RICHMOND EXPRESSWAY SYSTEM
BELTLINE EXPRESSWAY
BRIDGE NO. 9
R.F.&P.R.R. OVER
NORTHBOUND ROADWAY
NORTH ABUTMENT

HOWARD, NEEDLES, TAMMEN & BERGENDORFF
consulting engineers
NEW YORK ALEXANDRIA KANSAS CITY
SCALE: As noted
CONTRACT NO: 4
SHEET NO. 2 OF 12

BY	DATE	3	As Built	JRC	3-73
MADE	RLM	2-7-68	2	Profile Grade	P.S.
CHECKED	AMH	5-10-68	1	General Checking	AMH
IN CHARGE	FKD				





Note: 6" Dia. Pipe Underdrain going thru front wall of Abutment, is to connect with tee to Std. UD-1 under N.B. Roadway. See Roadway Plans.

Note: For North Abutment, see Sheet 2.

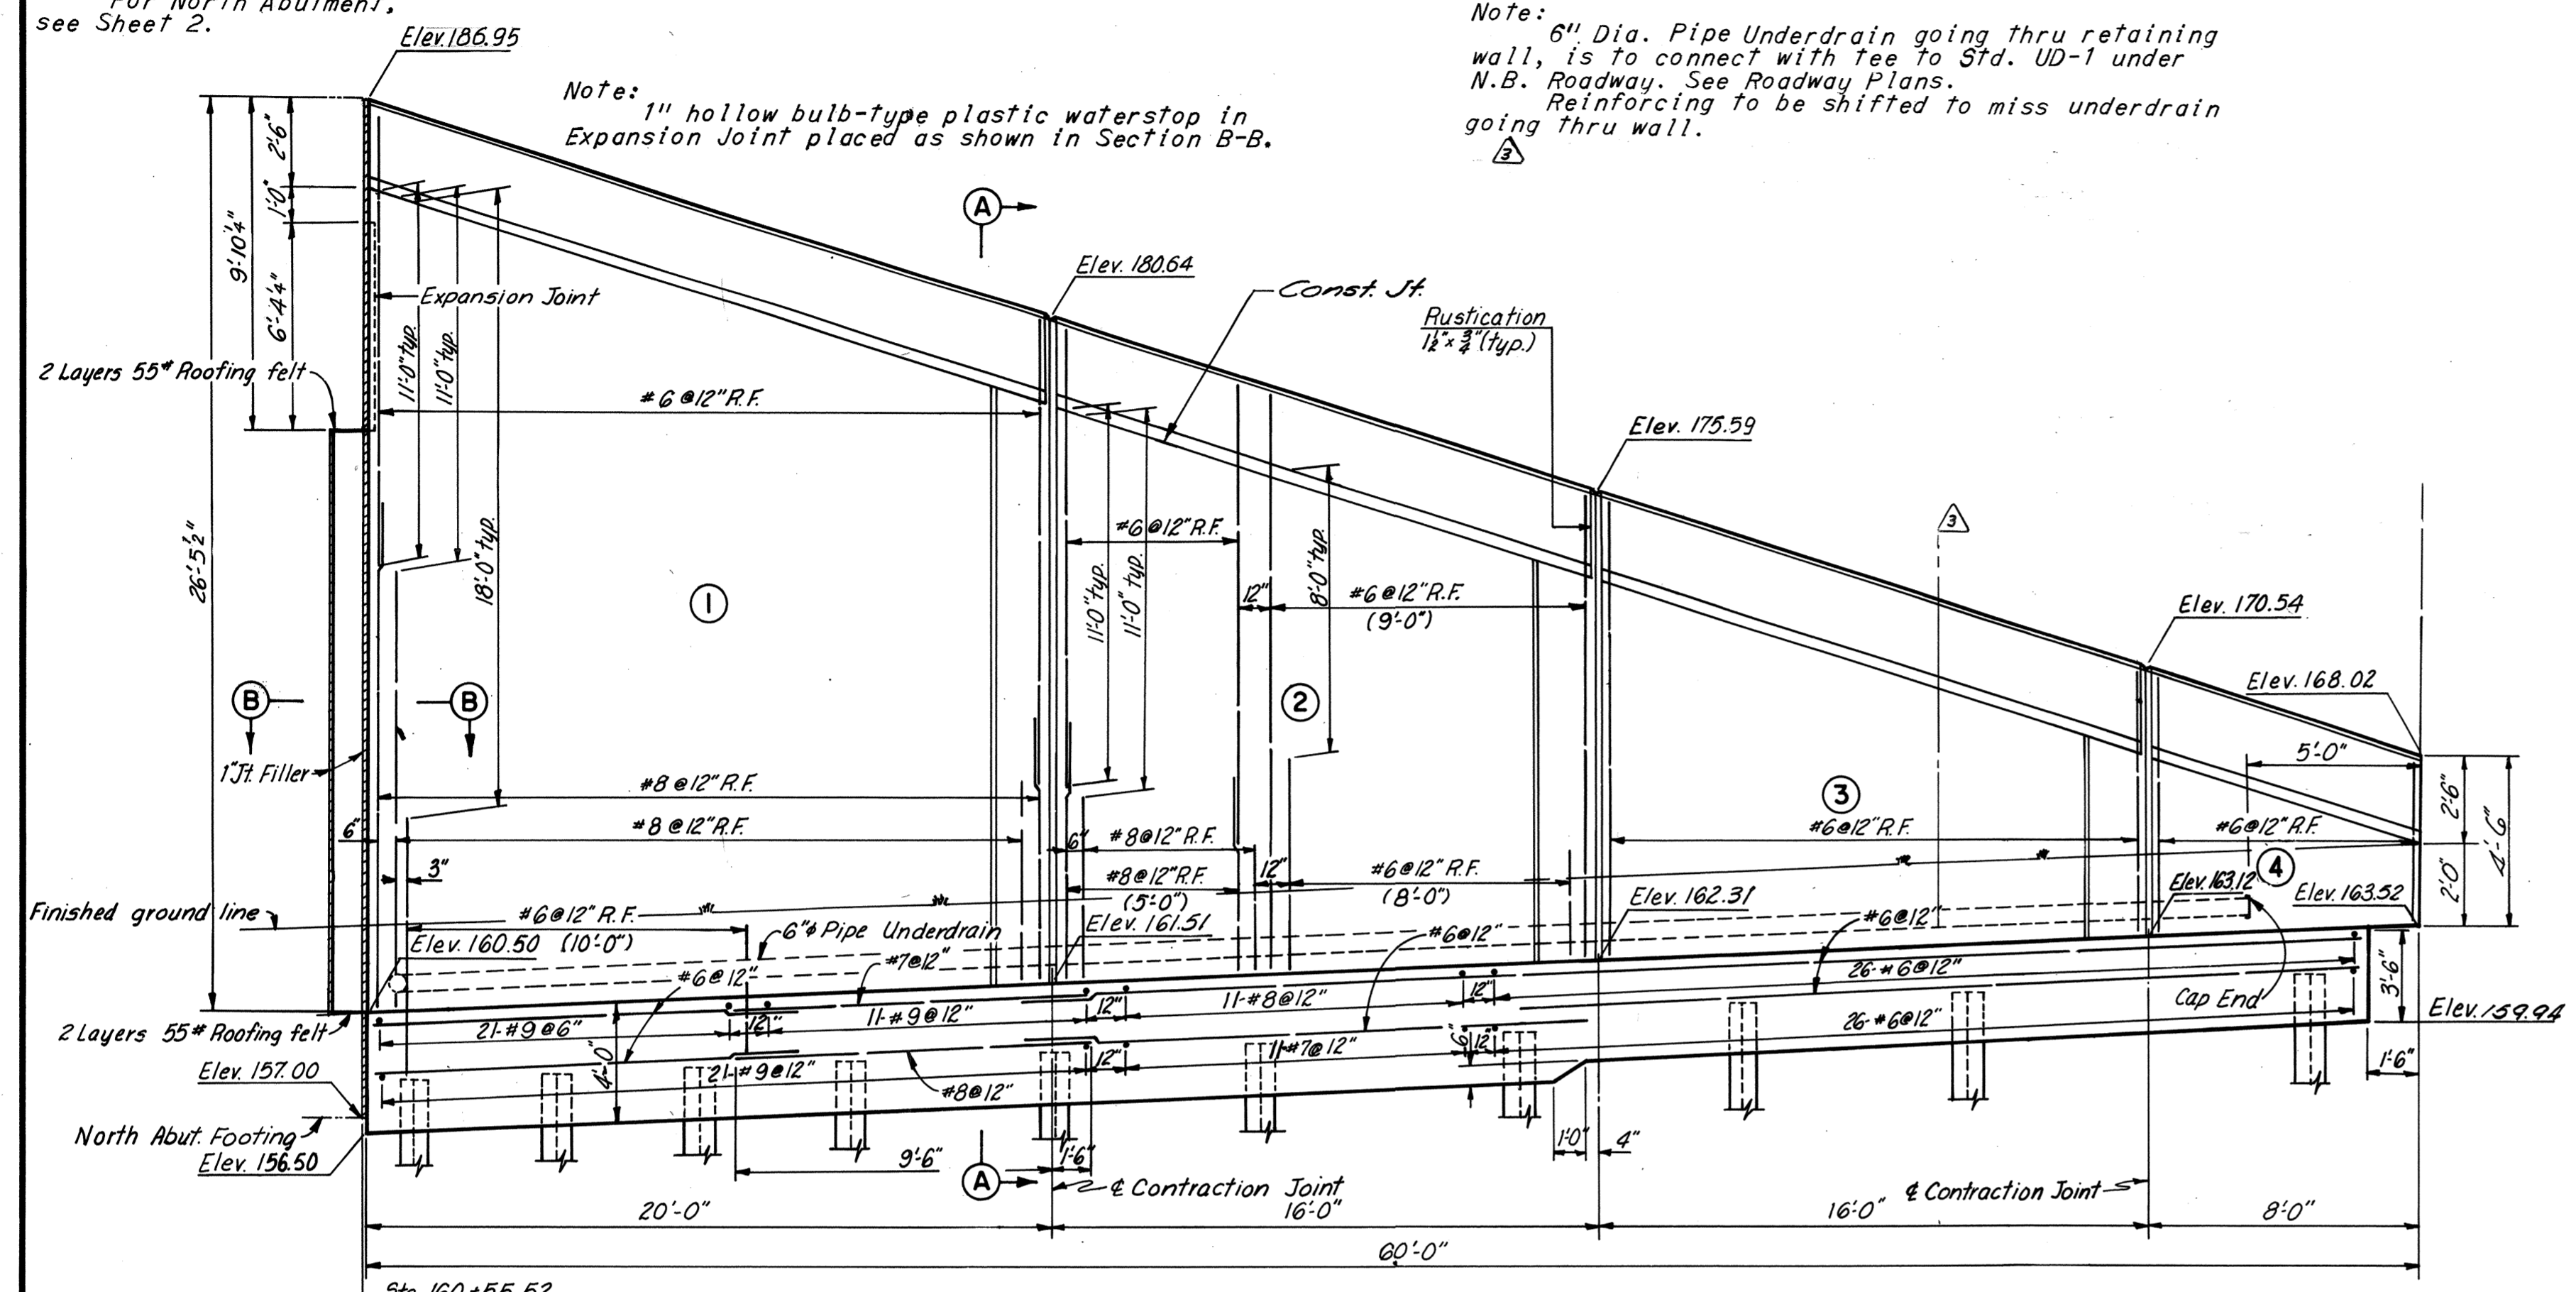

Legend:
R.F. denotes Rear Face.

Note: Longitudinal footing bars have the following splice lengths:
 #6 Bar = 1'-11"
 #8 Bar = 2'-6"
 #9 Bar = 2'-10"
 Dowel bars not shown. See Section A-A for shape and spacing.

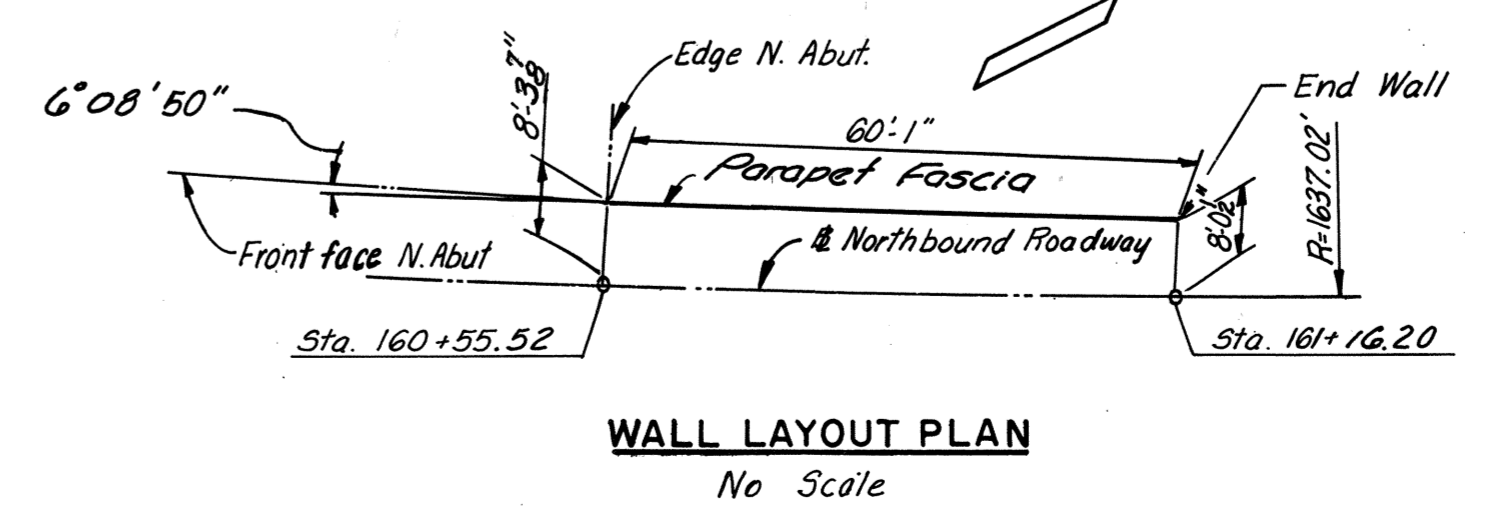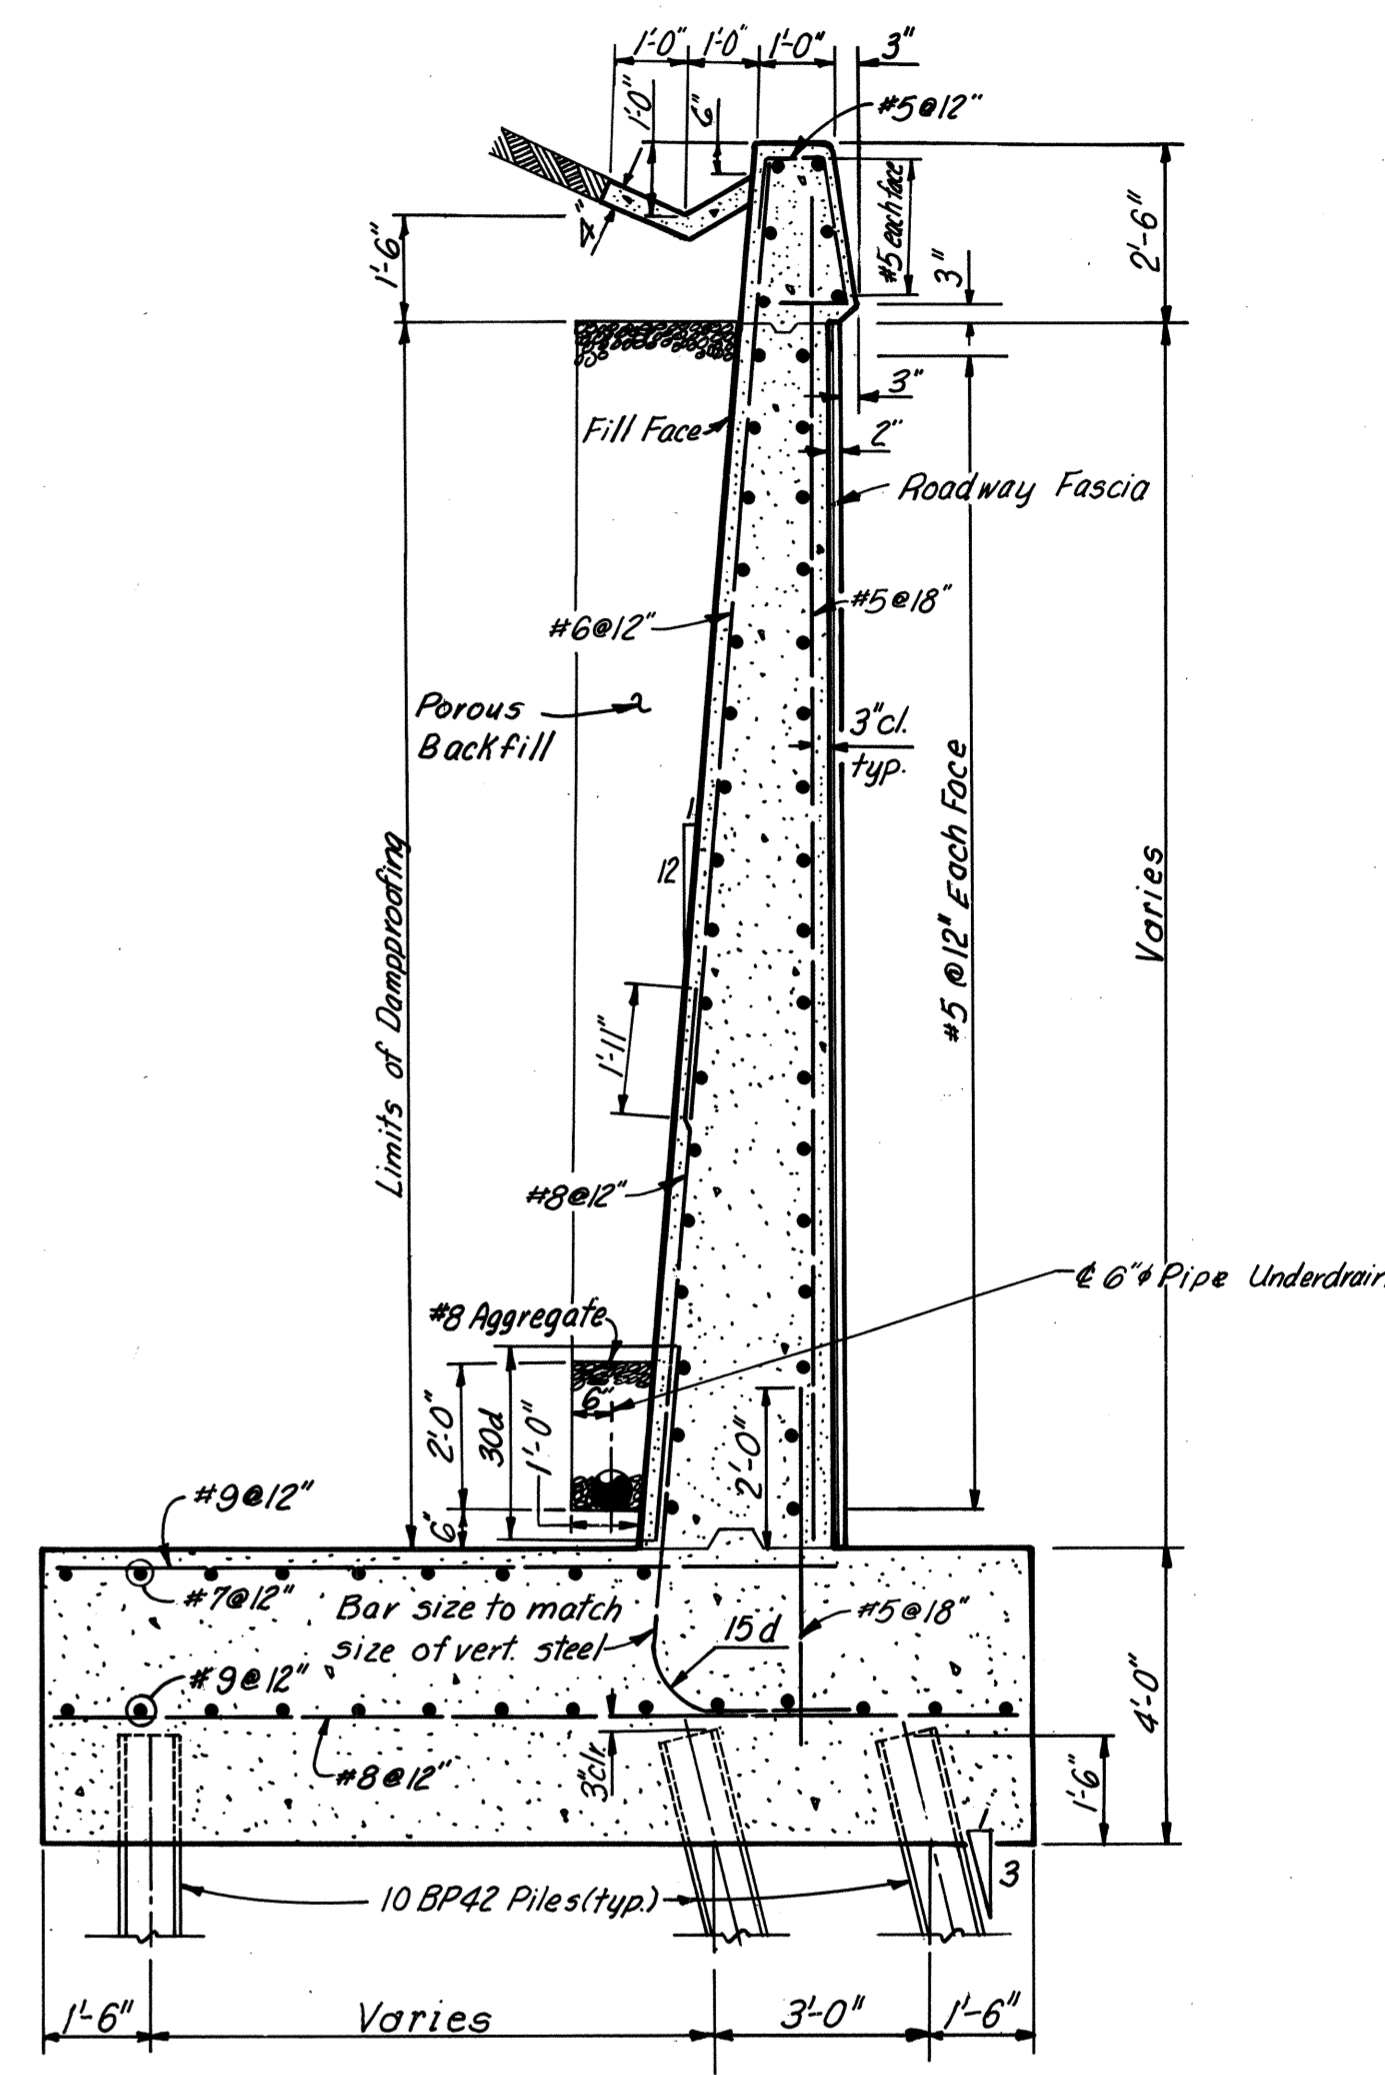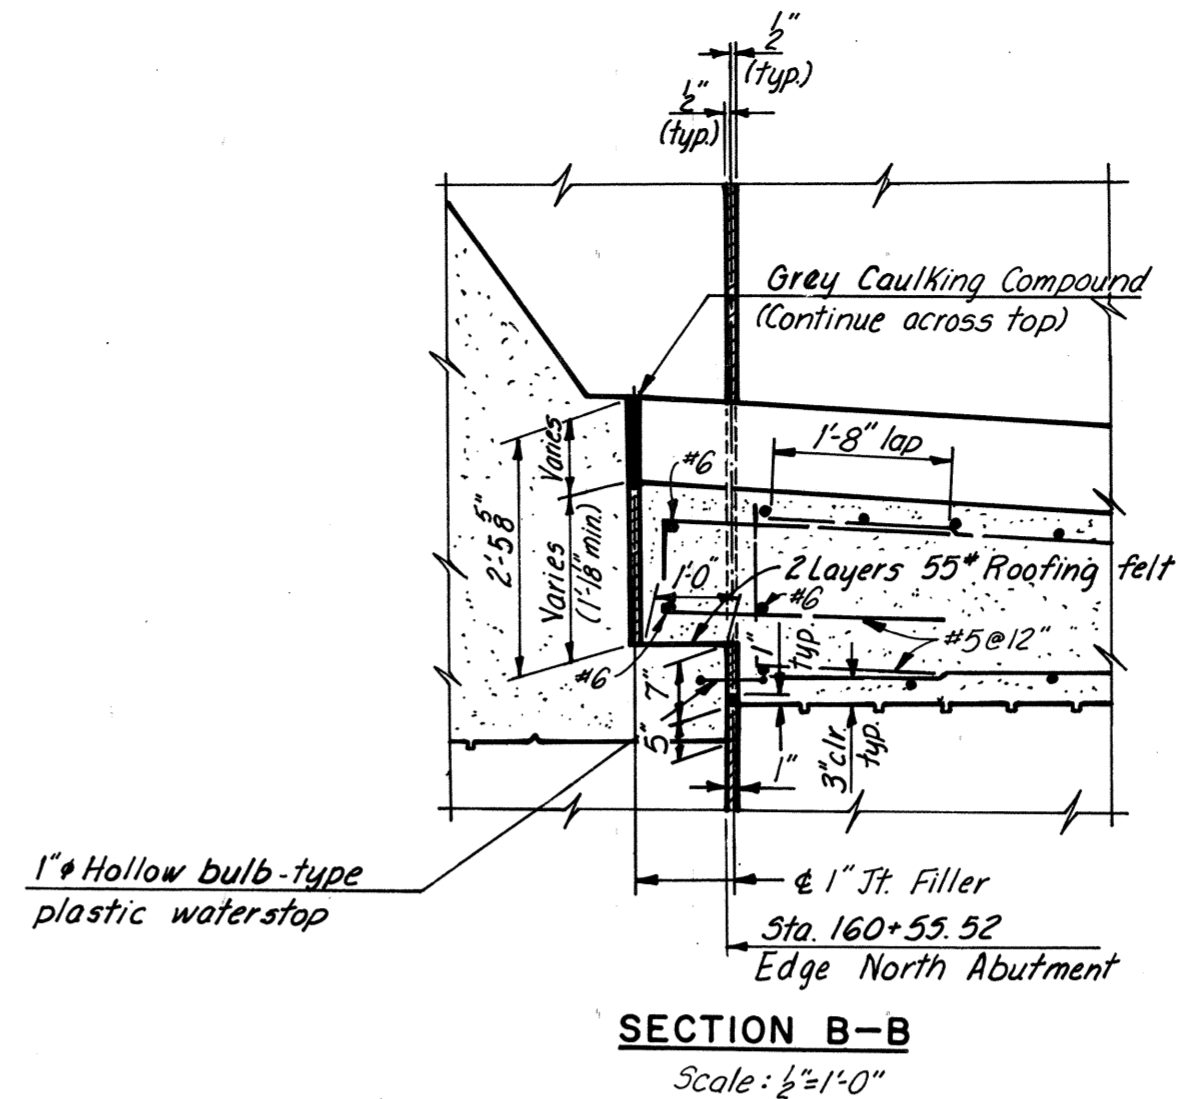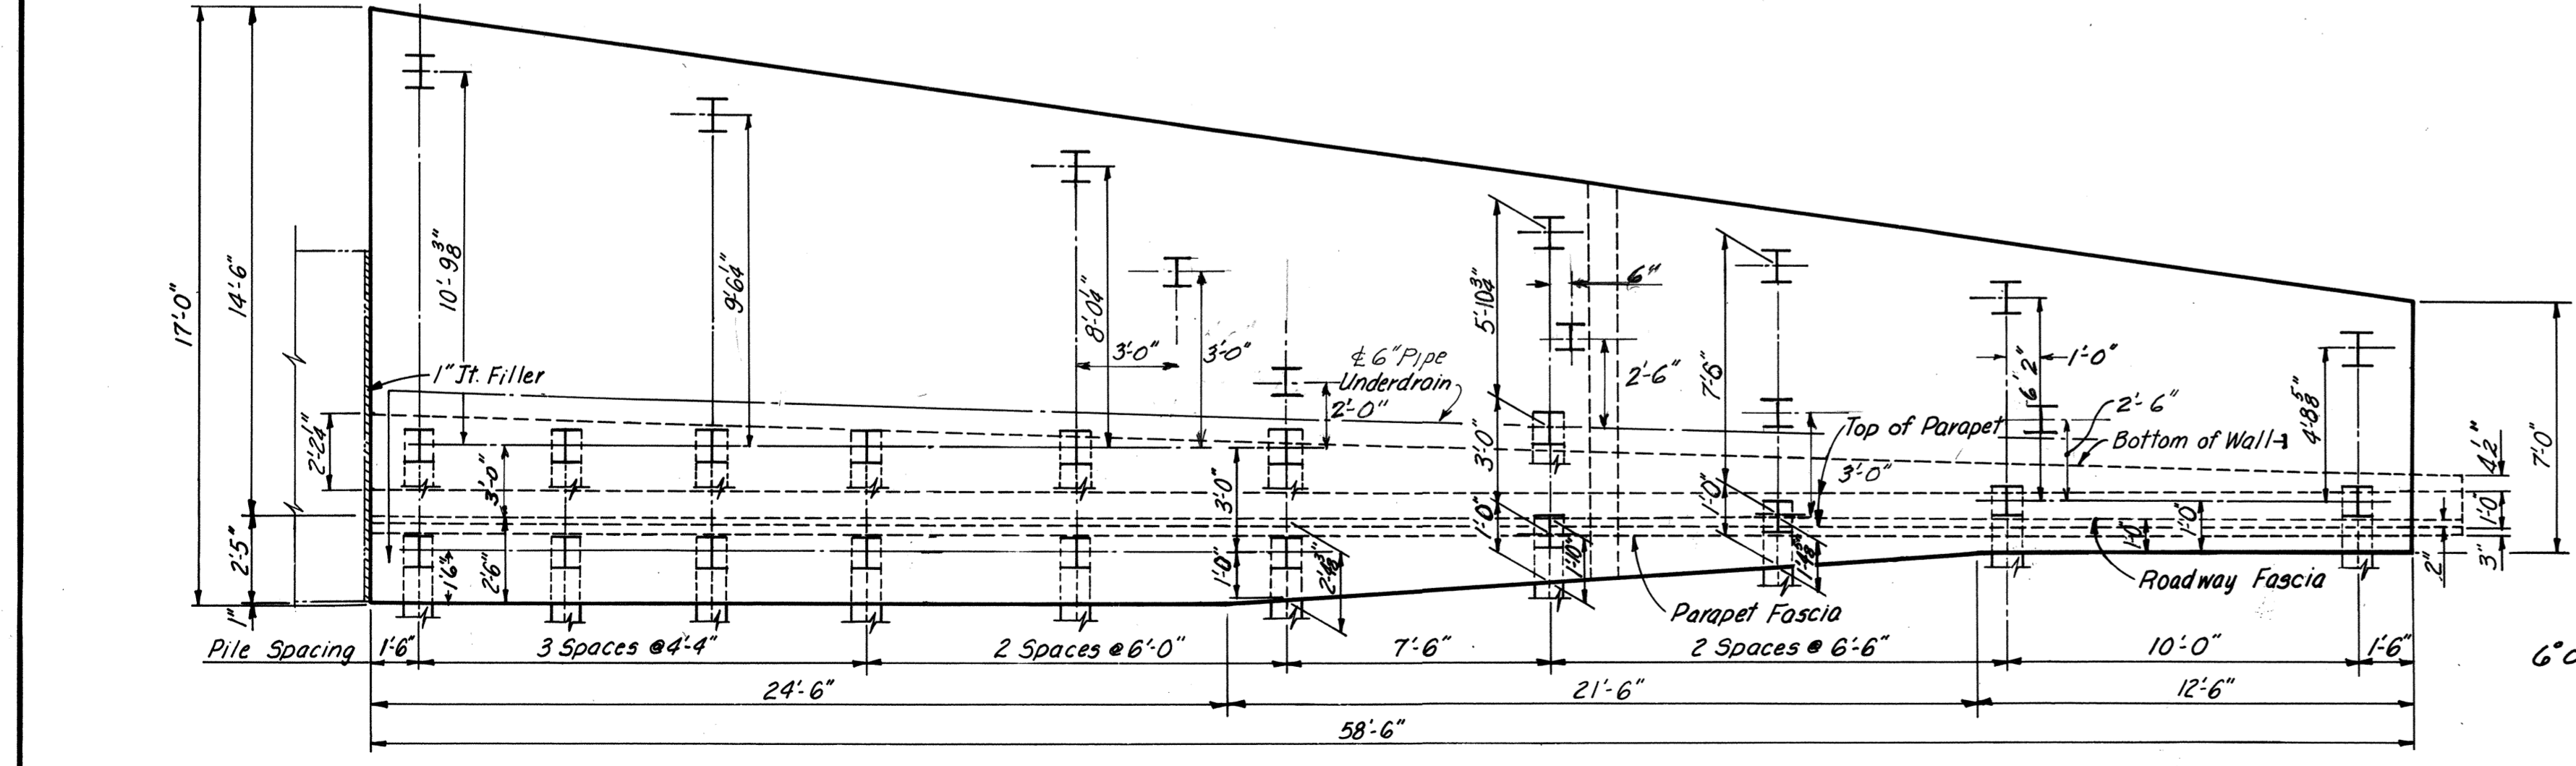


AS BUILT

RICHMOND METROPOLITAN AUTHORITY
 RICHMOND EXPRESSWAY SYSTEM
 BELTLINE EXPRESSWAY
 BRIDGE NO. 9
 R.F.&P.R.R. OVER
 NORTHBOUND ROADWAY
 NORTH ABUTMENT RETAINING WALL


BY	DATE	3	As Built	JRC	3-73
MADE	RLM	2-16-68	2	Revise Lig. Std.	JRC 9-71
CHECKED	WJC	5-2-60	1	Profile Grade	P.S. 4-12-71
IN CHARGE	FKD		1	General Checking	AMH 5-13-68
			NO.	REVISION	BY DATE

HOWARD, NEEDLES, TAMMEN & BERGENDOFF
 consulting engineers
 NEW YORK ALEXANDRIA KANSAS CITY

SCALE: As Noted
 CONTRACT NO. 4
 SHEET NO. 3 OF 12

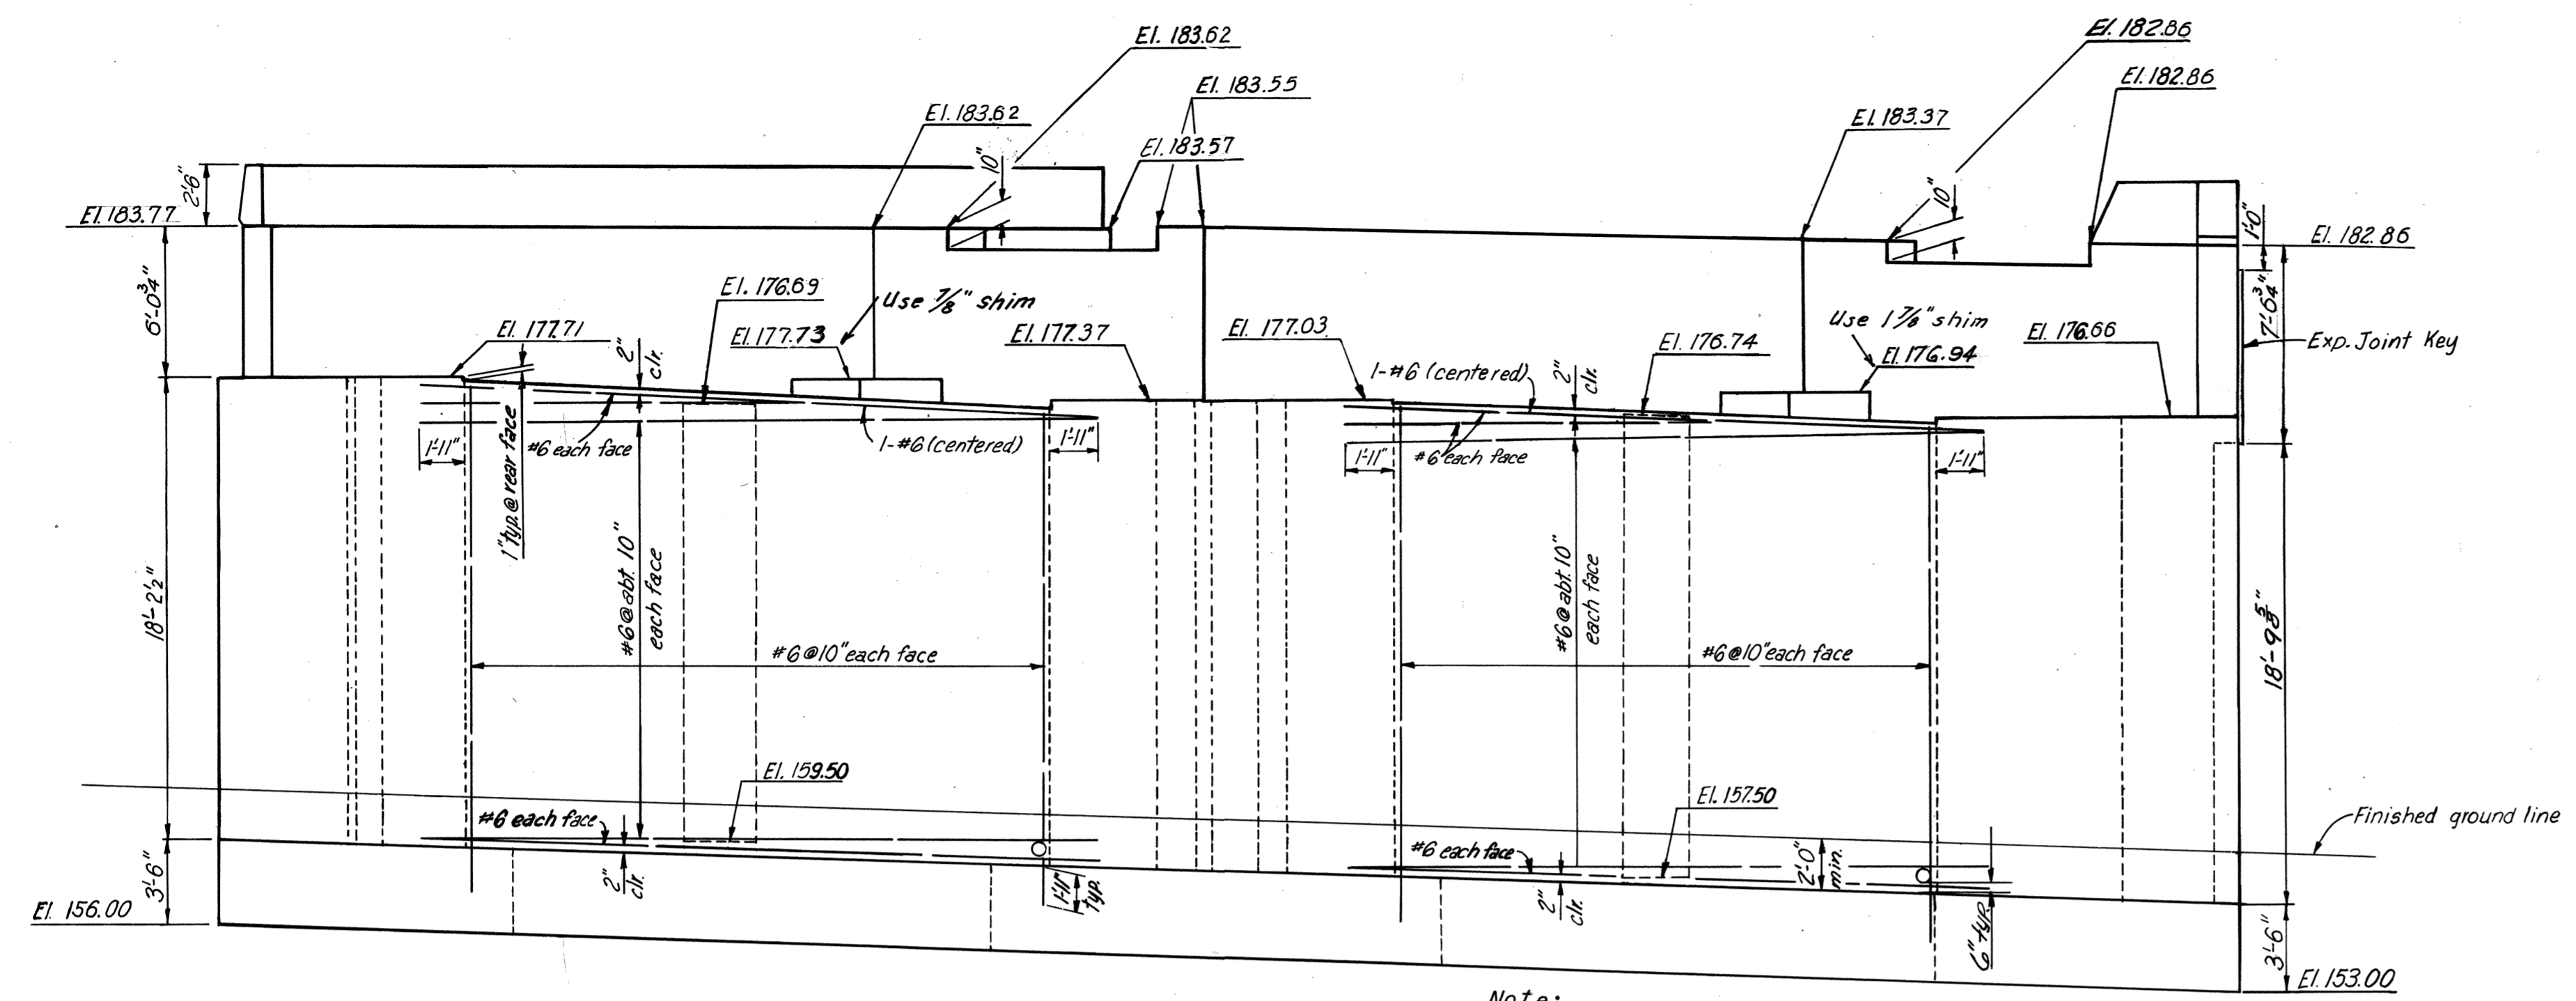


ELEVATION
No Scale

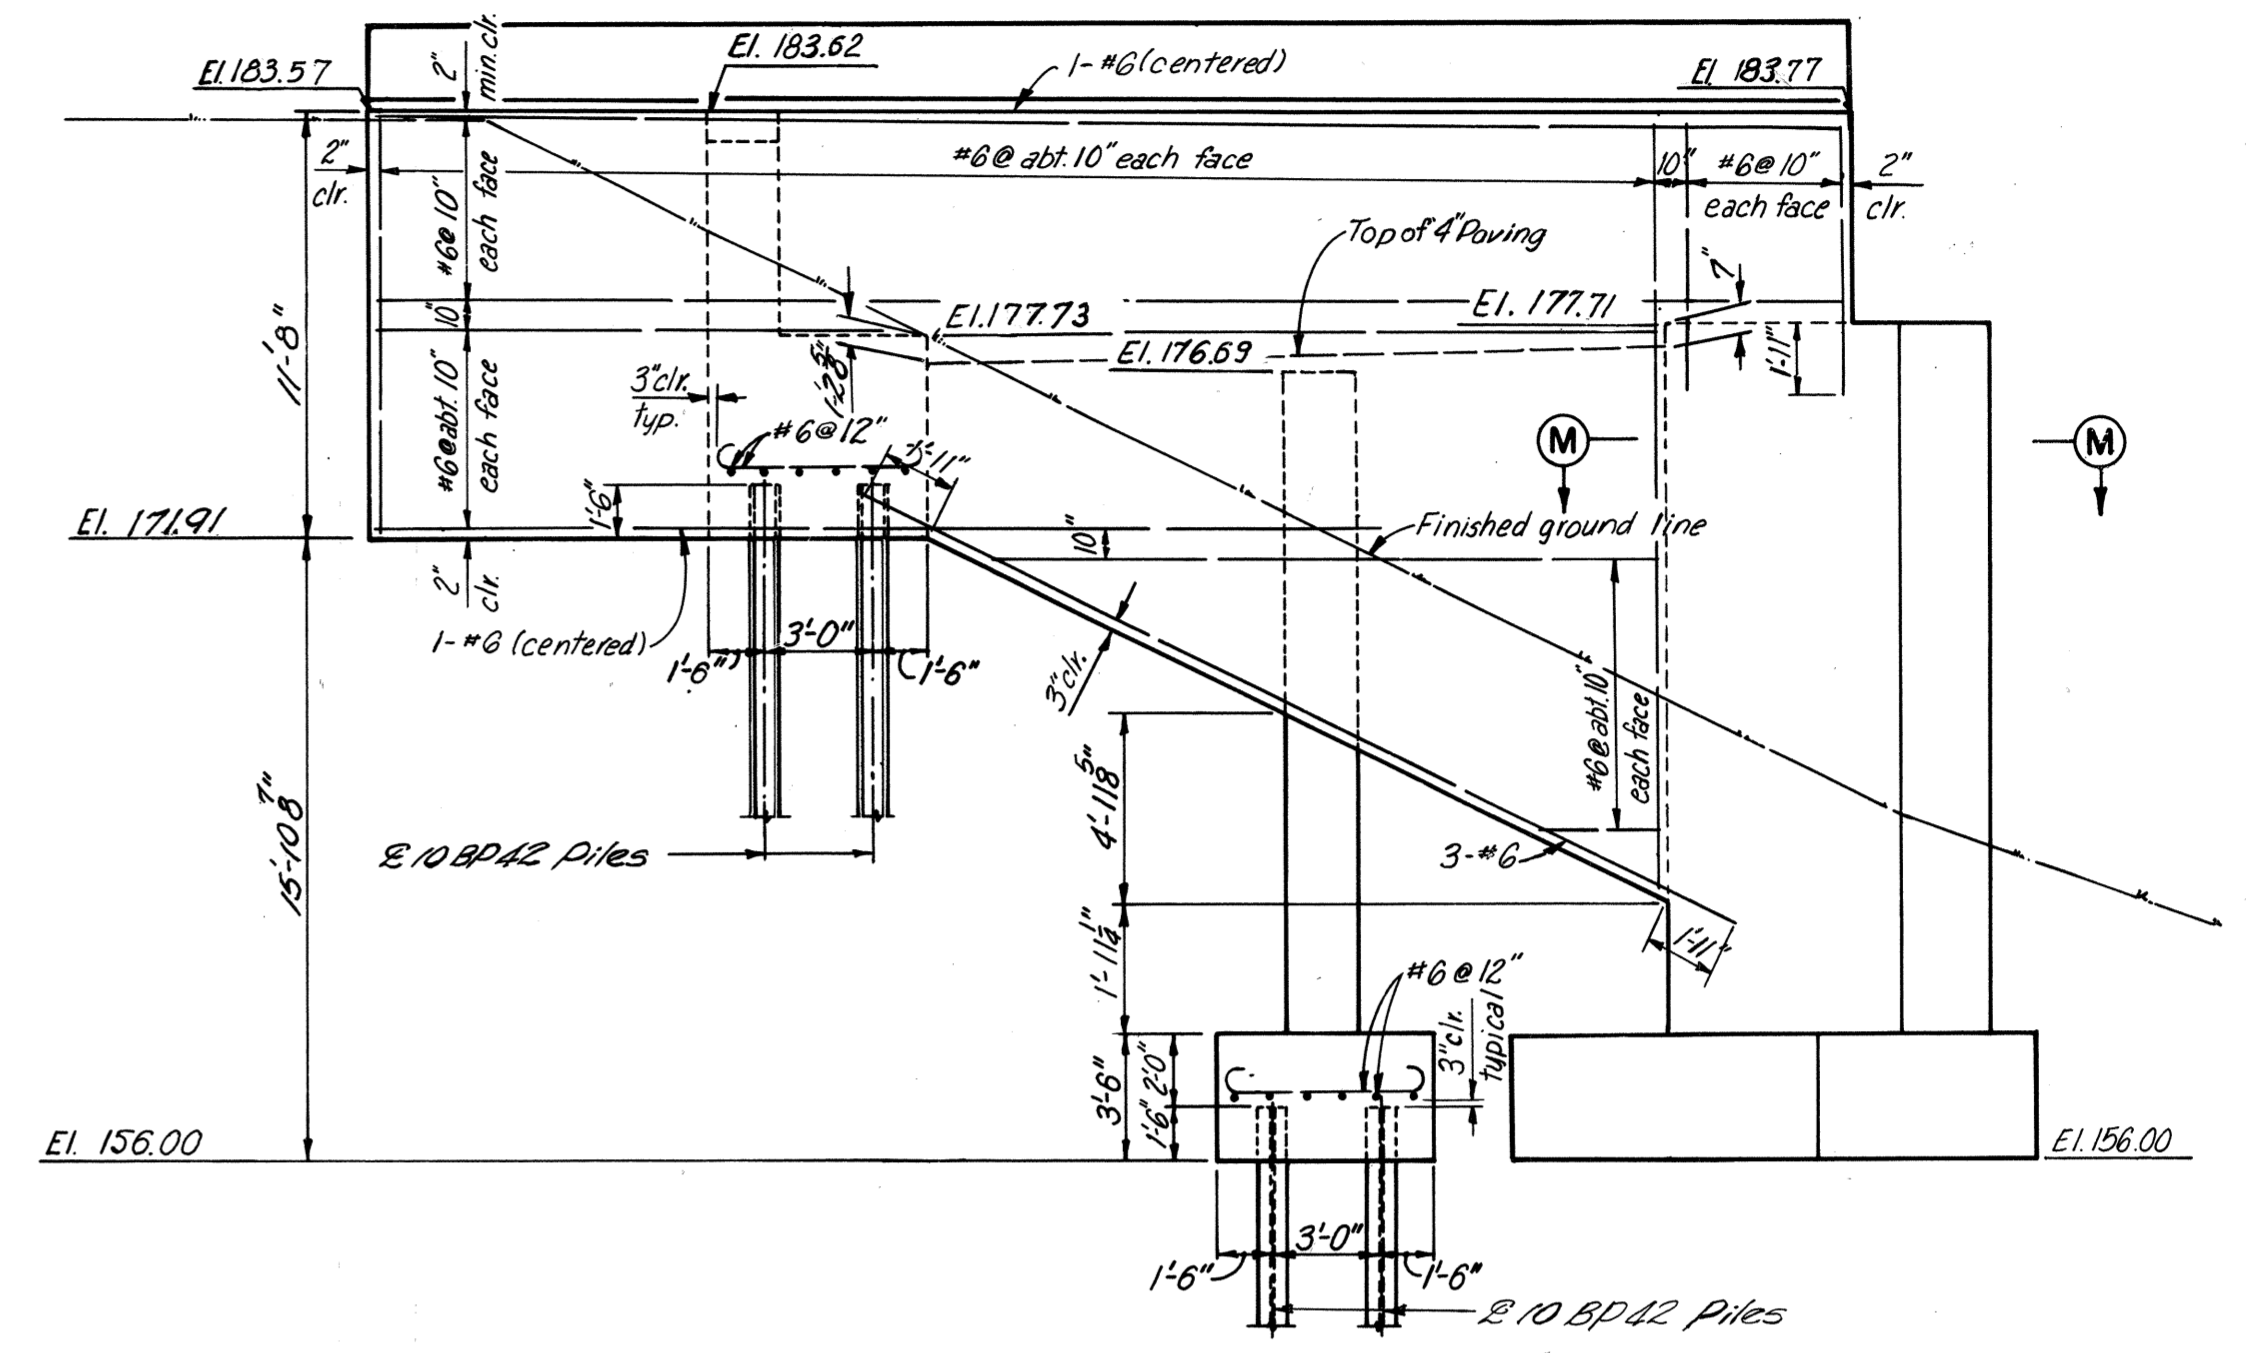

EAST WINGWALL ELEVATION
Scale 3/8" = 1'-0"


Note: Piles not shown in front footing. For location of piles, see Footing Plan.

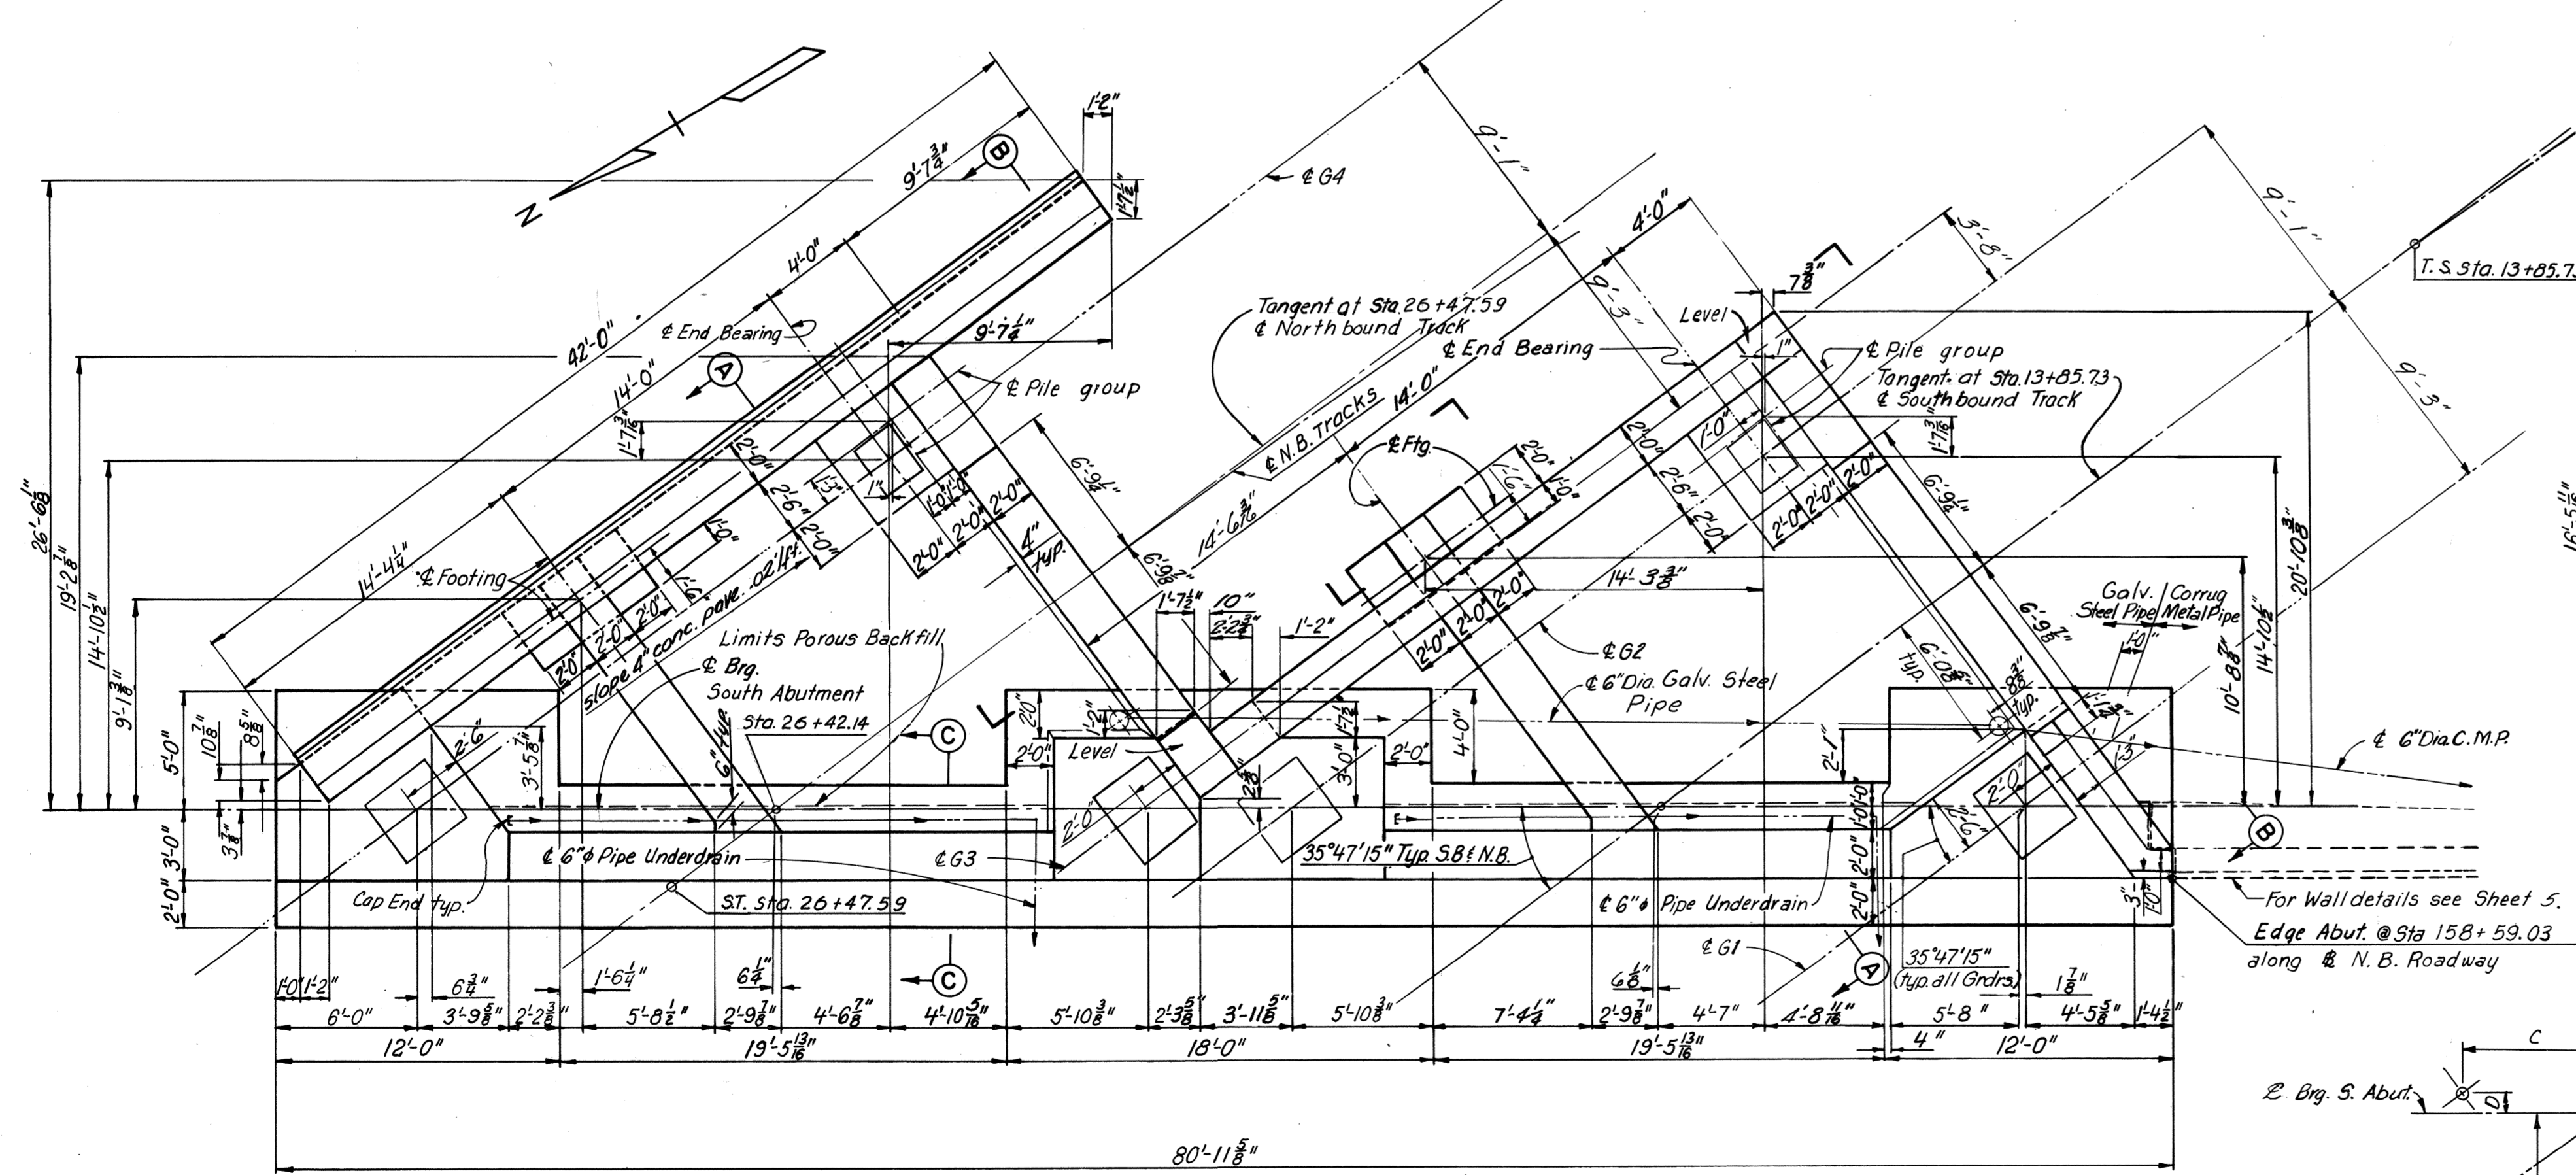

PLAN
Scale 3/16" = 1'-0"

Note: Payment for 6" Dia. C.M.P. and attachment of 6" Dia. C.M.P. to Paved Ditch is incidental to unit price bid for Paved Ditch, STD RQ-2A. For details of connection of 6" Dia. C.M.P. to Paved Ditch, see Sheet 7.

Note: For Sections A-A, B-B, C-C, and M-M, see Sheet 6. For Reinforcing not shown, see Abutment Details, Sheet 6. For Drainage Details, see Sheet 9. Reinforcing to be shifted to miss underdrain and drainpipe going thru walls. 6" Dia. Underdrain to be sloped at 1/4"/ft. towards outlet in front wall.

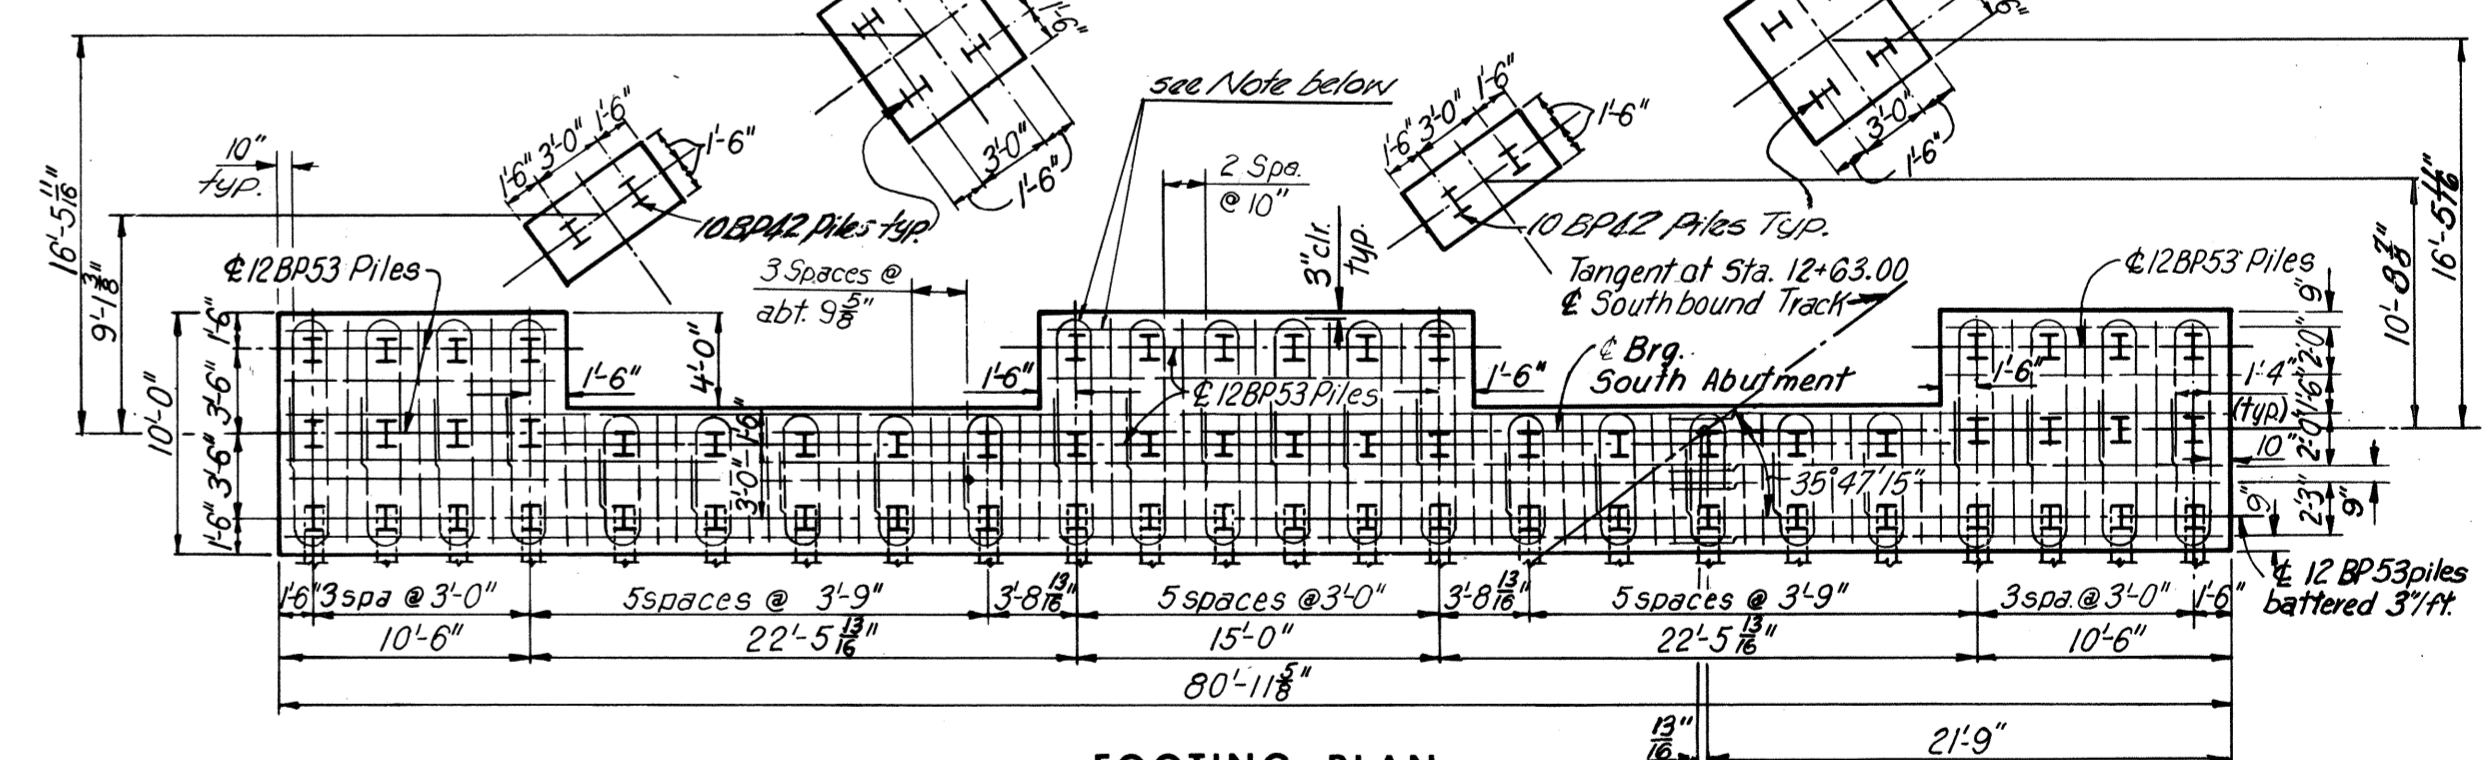

FOOTING PLAN
Scale 1/8" = 1'-0"

Note: Stirrups around piles have a radius of 8" for the bends and a lap of 2'-6". Reinforcing shown is typical for both top and bottom. All footing bars are #8 bars.

ANCHOR BOLT SETTING PLAN
No Scale

	A	B	C	D	E	F	G	H
1-EL Shoe	3 3/4"	1-1 1/8"	1-1 1/8"	3 3/4"	—	—	—	—
1-F Shoe	1 3/8"	7 1/8"	1-2 1/8"	1-7 1/8"	5 3/8"	2 3/4"	1-0 1/8"	1-8 3/8"

ANCHOR BOLT SETTING PLAN
No Scale

AS BUILT


RICHMOND METROPOLITAN AUTHORITY
RICHMOND EXPRESSWAY SYSTEM
BELTLINE EXPRESSWAY
BRIDGE NO. 9
R.F.&P.R.R. OVER
NORTHBOUND ROADWAY
SOUTH ABUTMENT

HOWARD, NEEDLES, TAMMEN & BERGENDOFF
consulting engineers
NEW YORK ALEXANDRIA KANSAS CITY
SCALE: As noted
CONTRACT NO. 4
SHEET NO. 4 OF 12


BY	DATE	3	As Built	JRC	3-73
MADE	RLM	2-21-68	2	Profile Grade	P.S. 4-12-71
CHECKED	AMH	5-9-68	1	General Checking	AMH 5-13-68
IN CHARGE	FKD		NO.	REVISION	BY DATE

Note: 6" Dia. Pipe Underdrain going thru front wall of Abutment, is to connect with tee to Sta. UD-1 under N.B. Roadway. See Roadway Plans.


RICHMOND EXPRESSWAY SYSTEM			
SECTION	PROJECT	SHEET NO.	TOTAL SHEETS
4	BELTLINE EXP.	98A	155

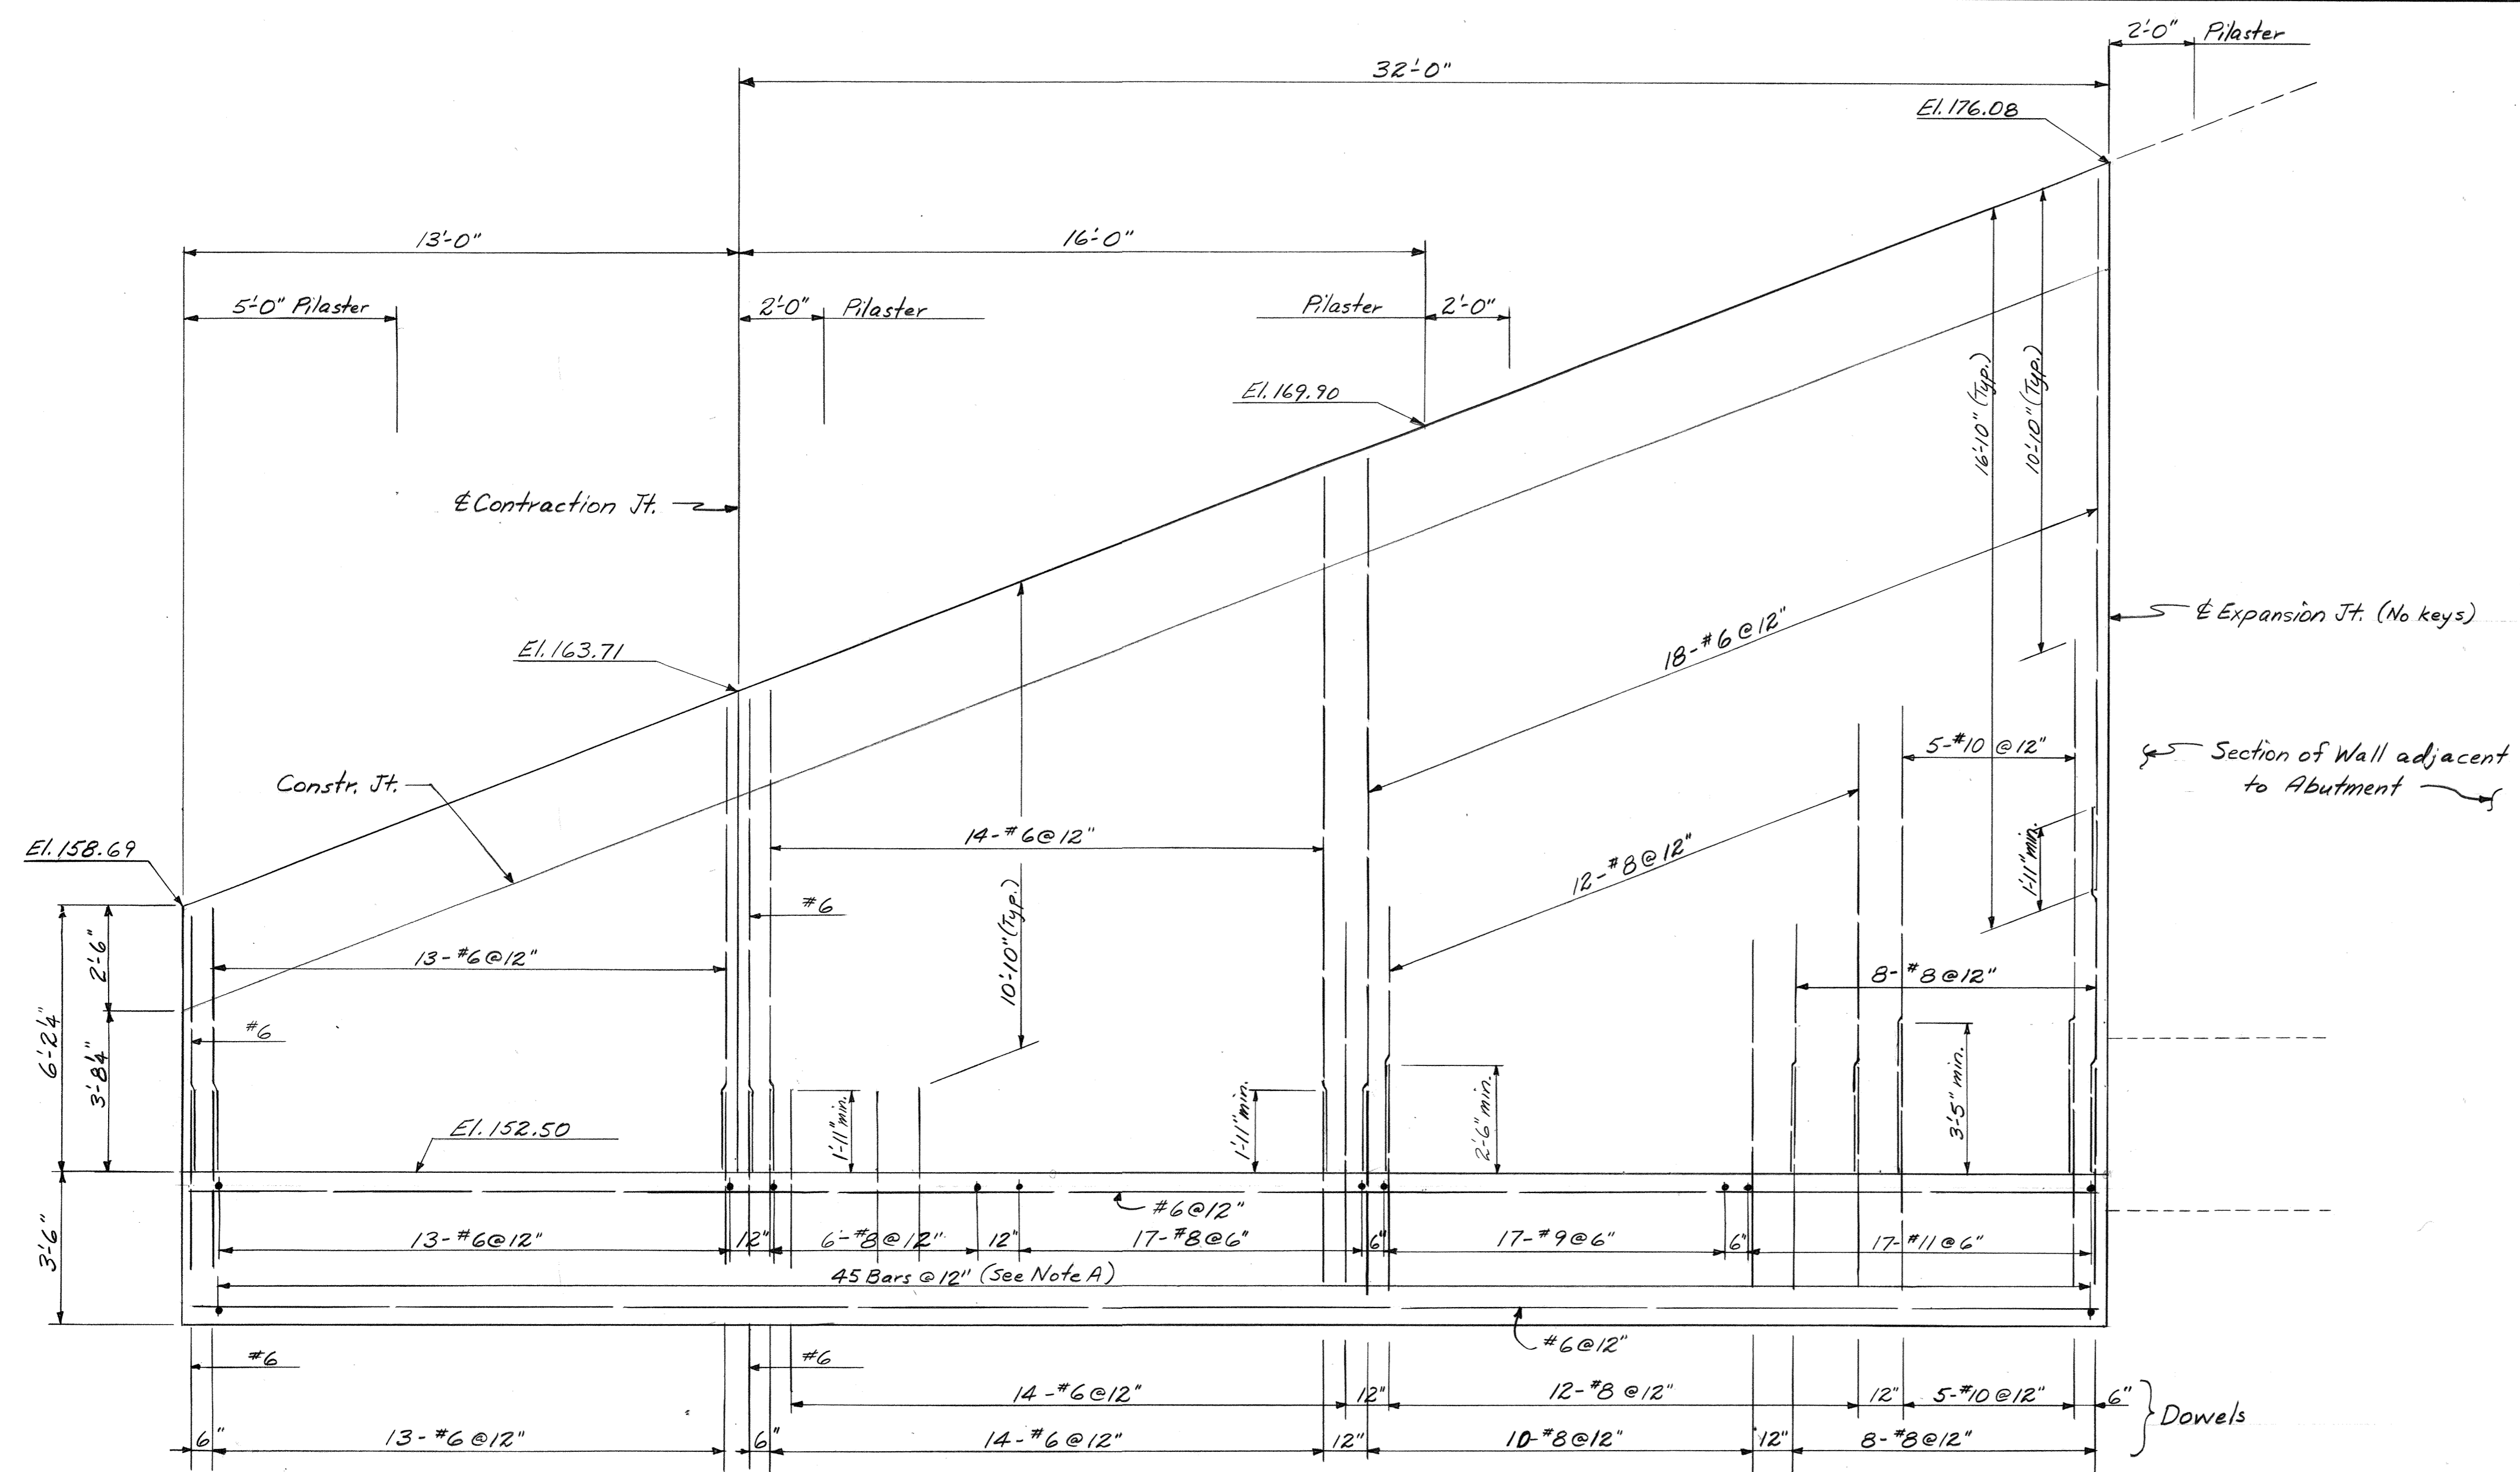

ELEVATION
All stem reinforcing and dowels shown for fill face.

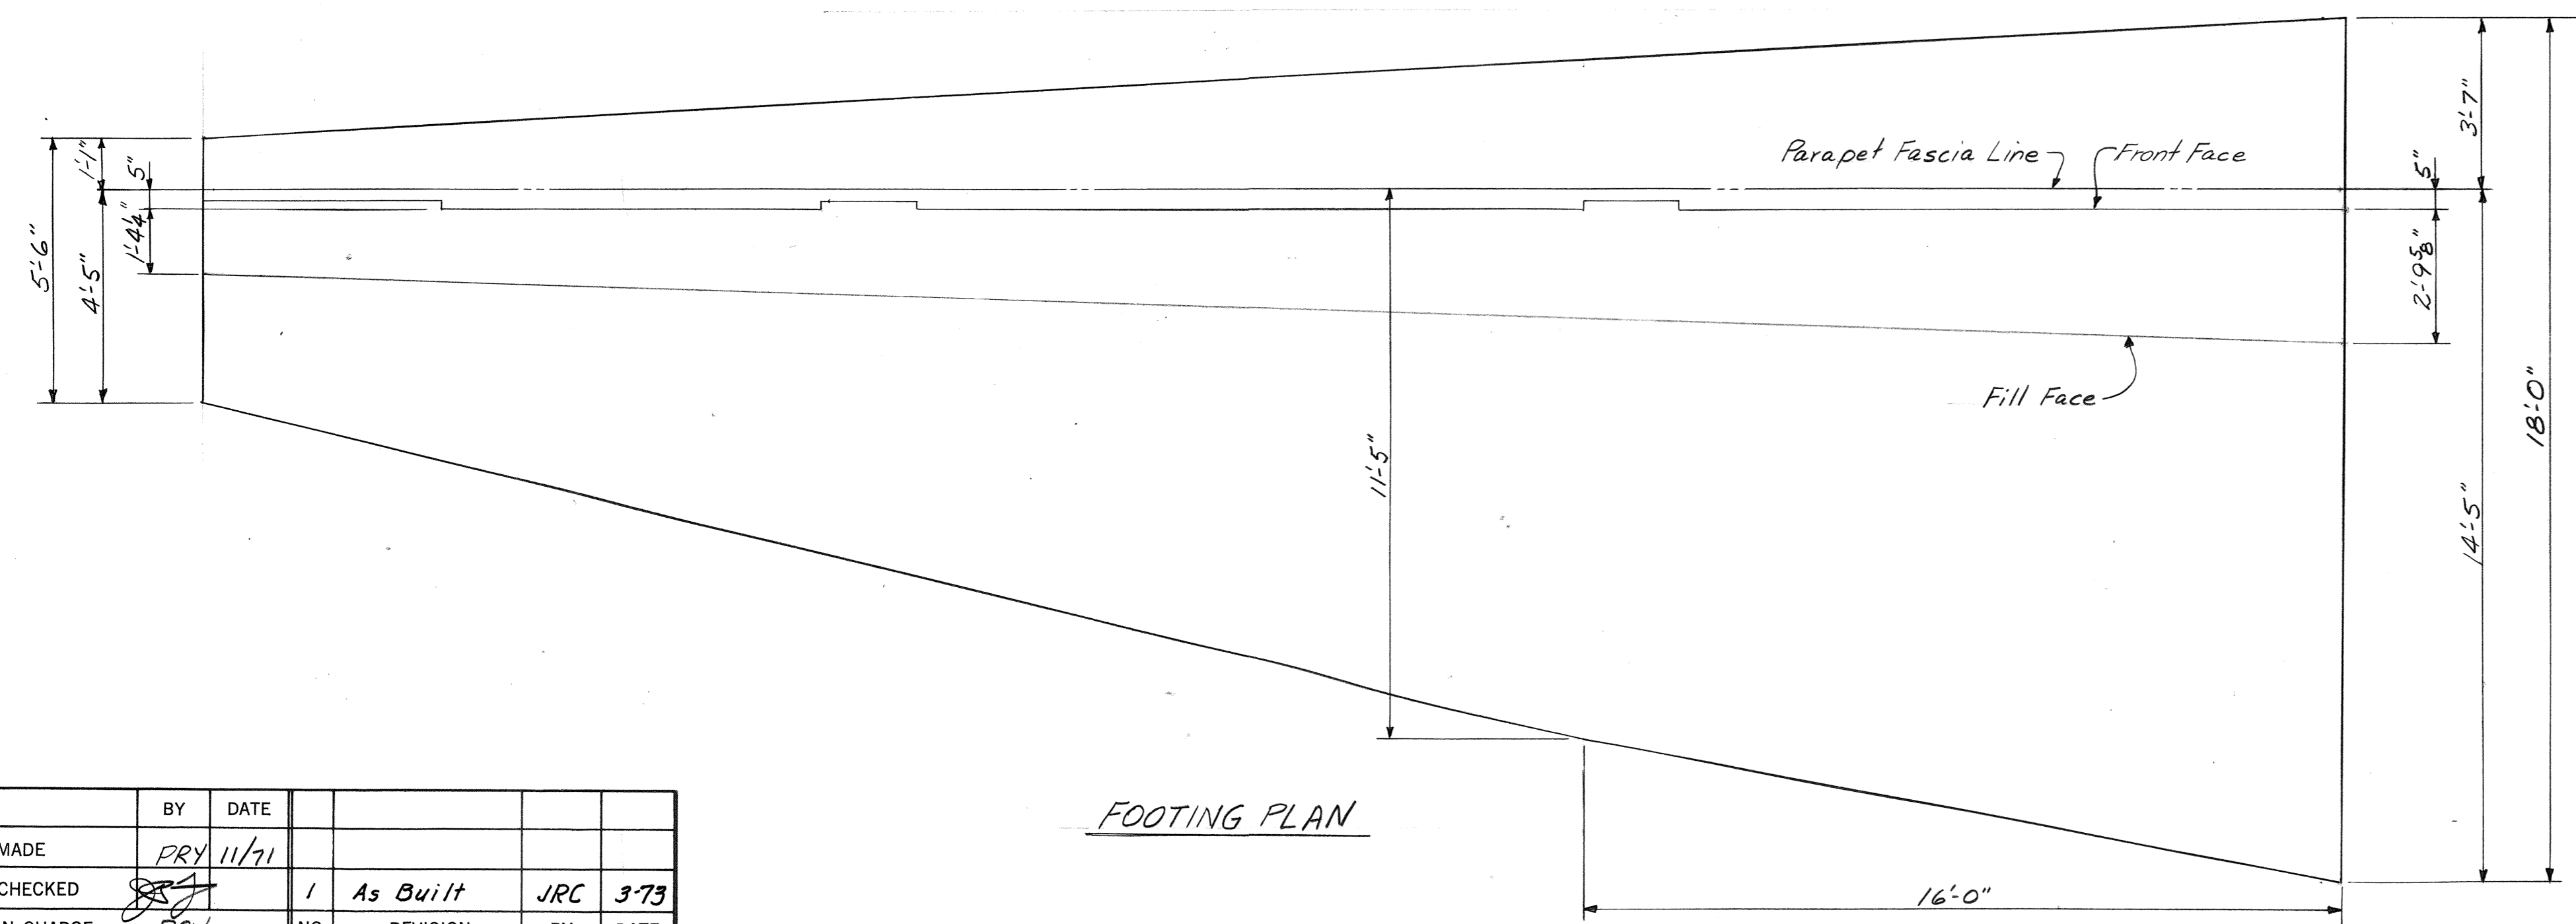

FOOTING PLAN

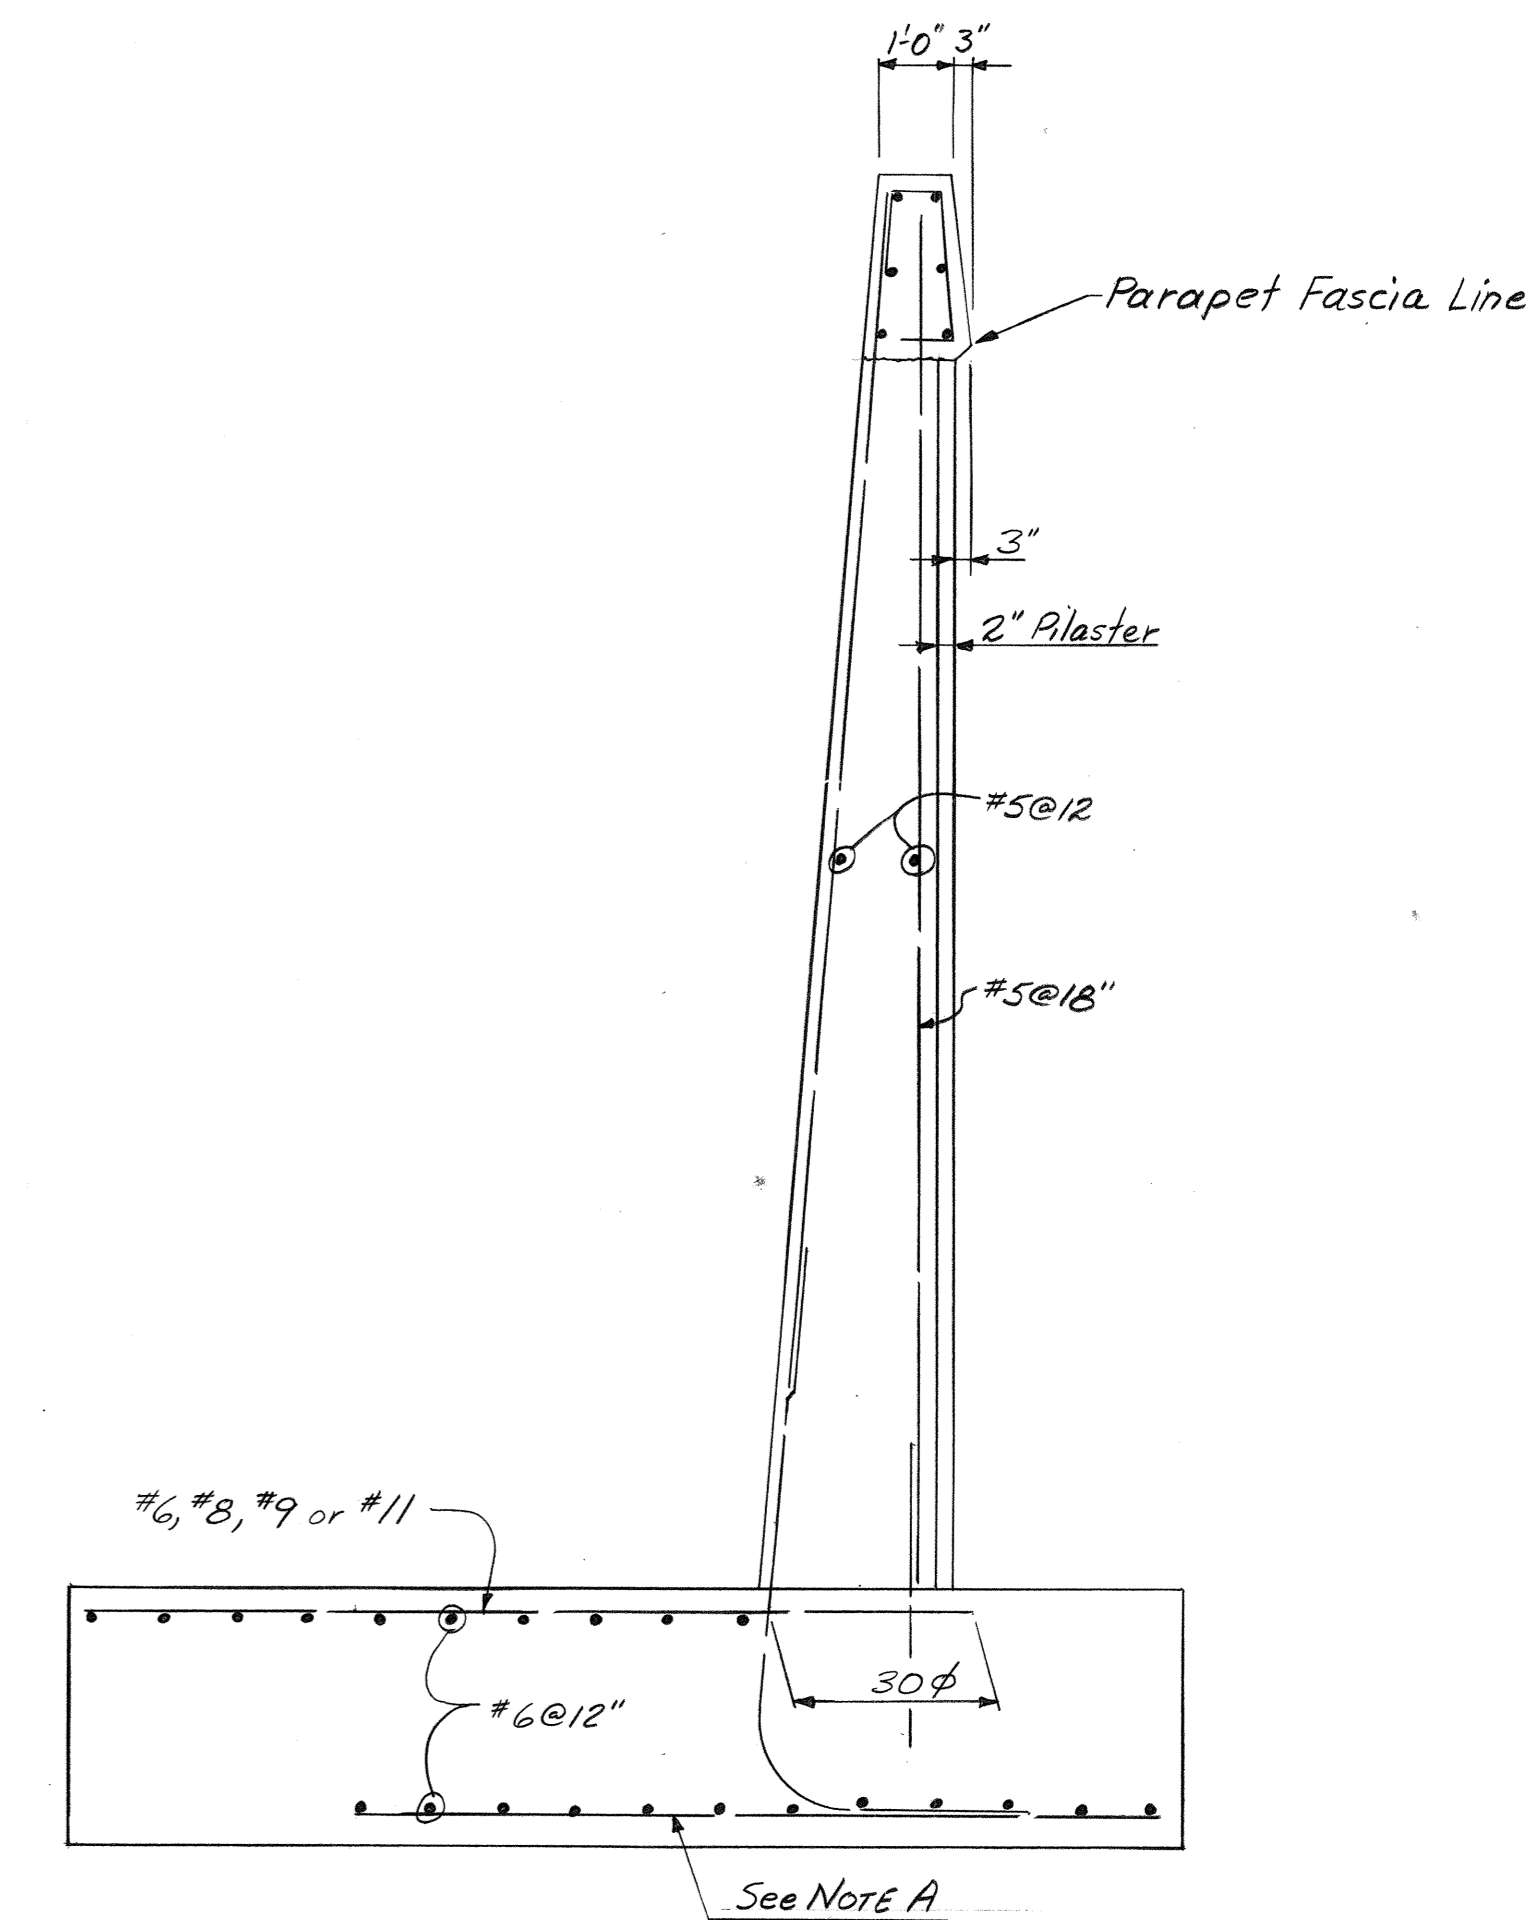

TYPICAL SECTION

Note:
Horizontal stem steel, parapet bars and front face vertical bars & dowels are same as original except for increased quantity and/or length due to increased stem height.






NOTE A:
Use original transverse footing steel to the maximum extent possible. Place steel forward into the toe leaving the lower rear of the footing unreinforced if necessary. At the low end of the wall, salvage the longer original #6 top bars for use in the bottom as required.

AS BUILT

RICHMOND METROPOLITAN AUTHORITY RICHMOND EXPRESSWAY SYSTEM	
BRIDGE No. 9 R.F. & P.R.R. OVER NORTHBOUND ROADWAY REVISED PORTION SOUTH ABUTMENT RETAINING WALL	
HOWARD, NEEDLES, TAMMEN & BERGENDOFF consulting engineers NEW YORK ALEXANDRIA KANSAS CITY	SCALE: 3/8"=1'-0" CONTRACT NO.: 4 SHEET NO. 5A OF 12



MADE	BY	DATE	NO.	REVISION	BY	DATE
	PRY	11/71	1	As Built	JRC	3-73

Note: For detail of connection of 6" Dia. C.M.P. to Concrete V-Gutter, see Detail C.

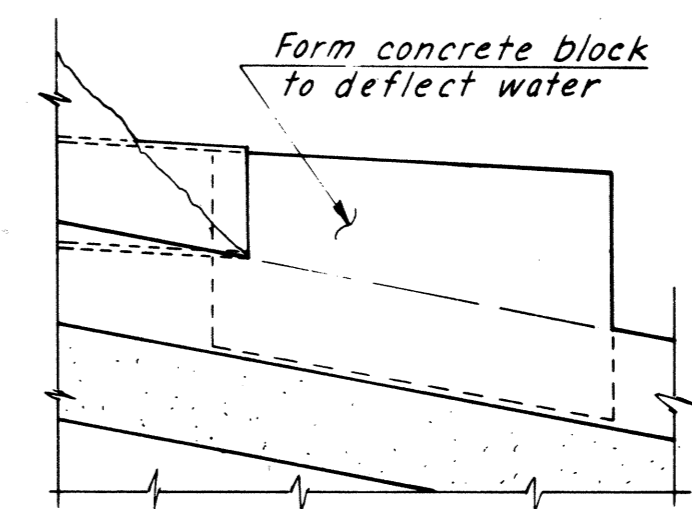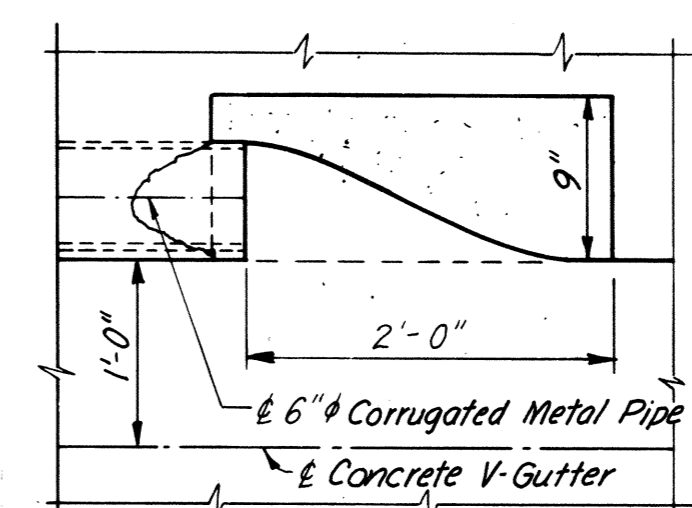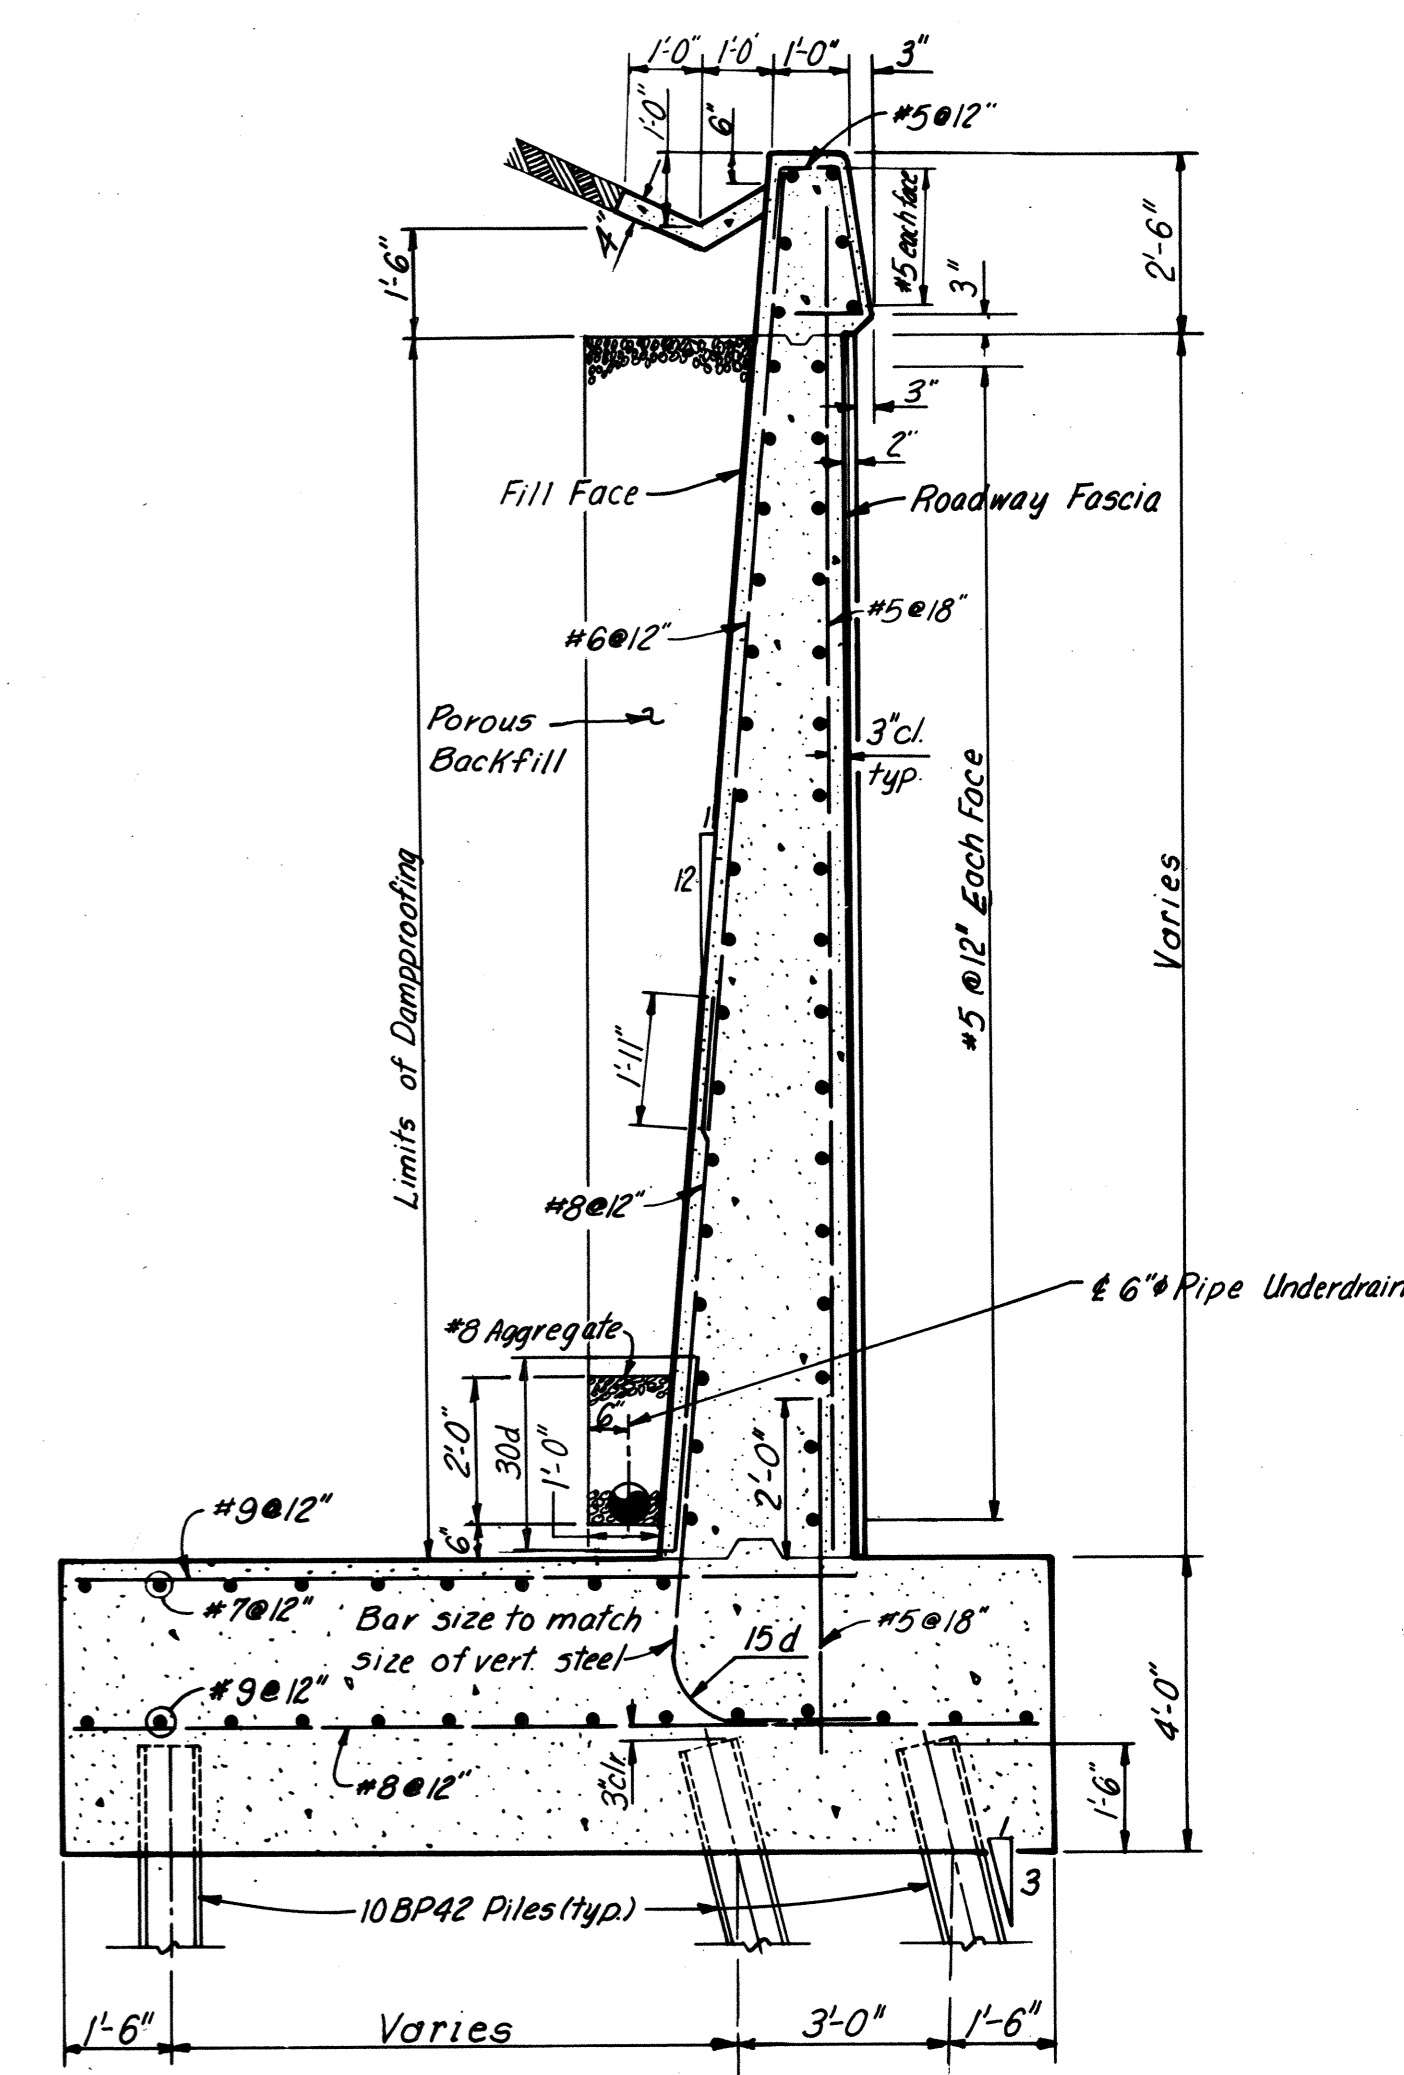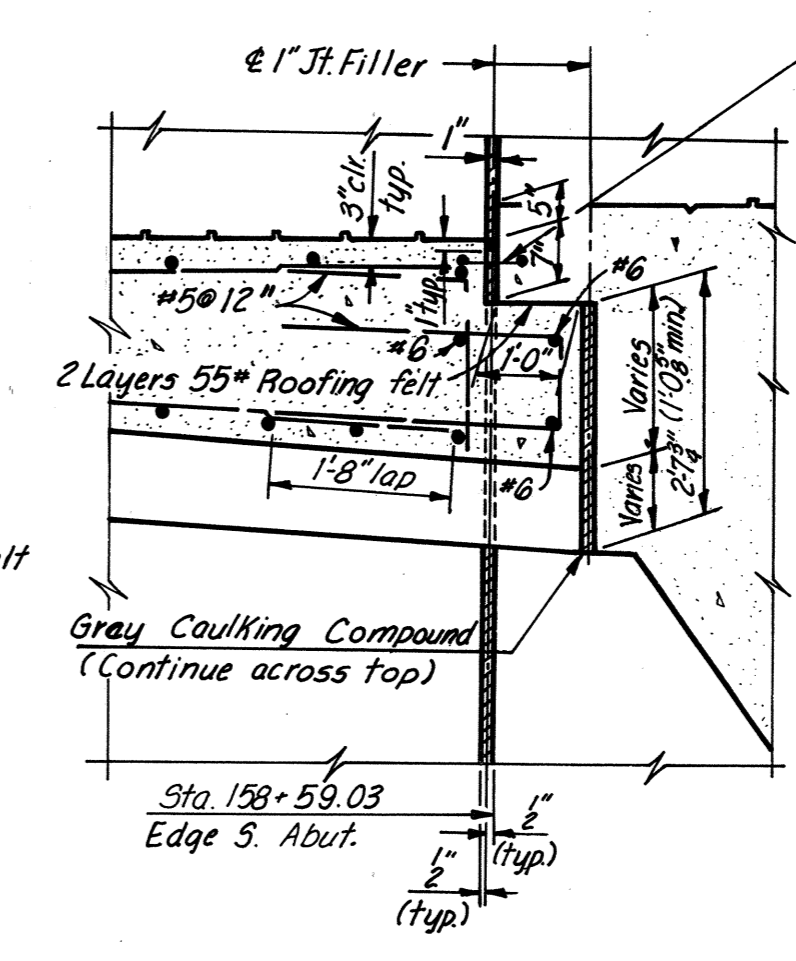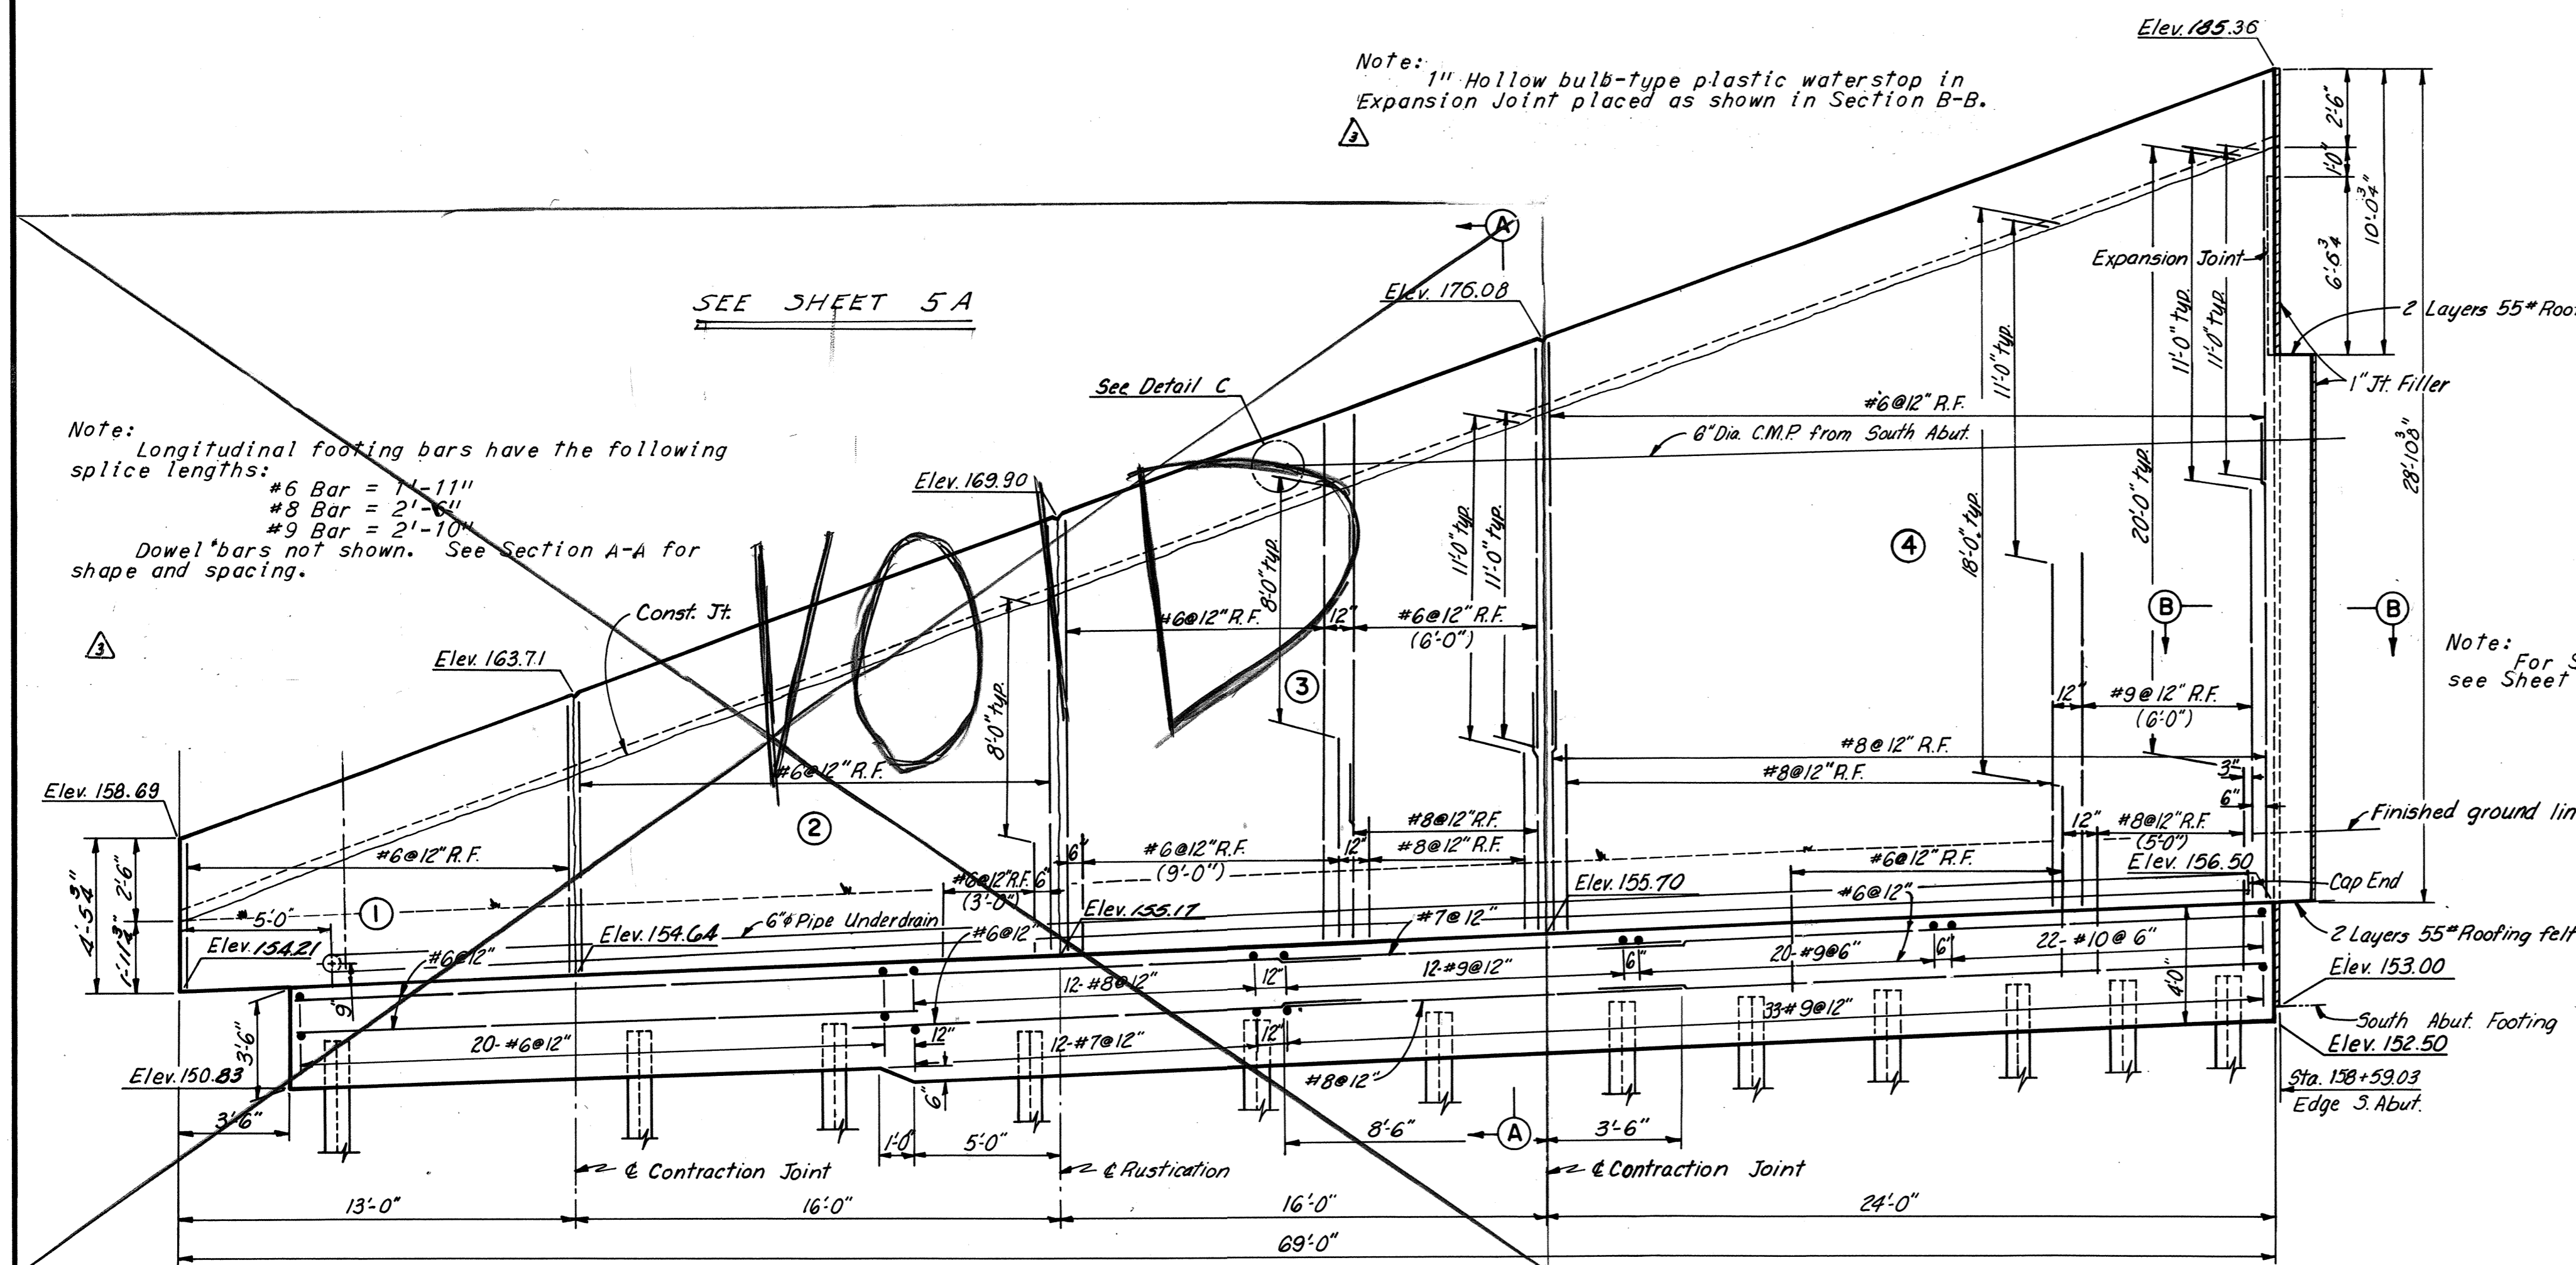

Note: 6" Dia. Pipe Underdrain going thru retaining wall, is to connect with tee to Std. UD-1 under N.B. Roadway. See Roadway Plans. Reinforcing to be shifted to miss underdrain going thru wall.

ELEVATION
Scale: 1/4" = 1'-0"
Legend: R.F. denotes Fill Face.

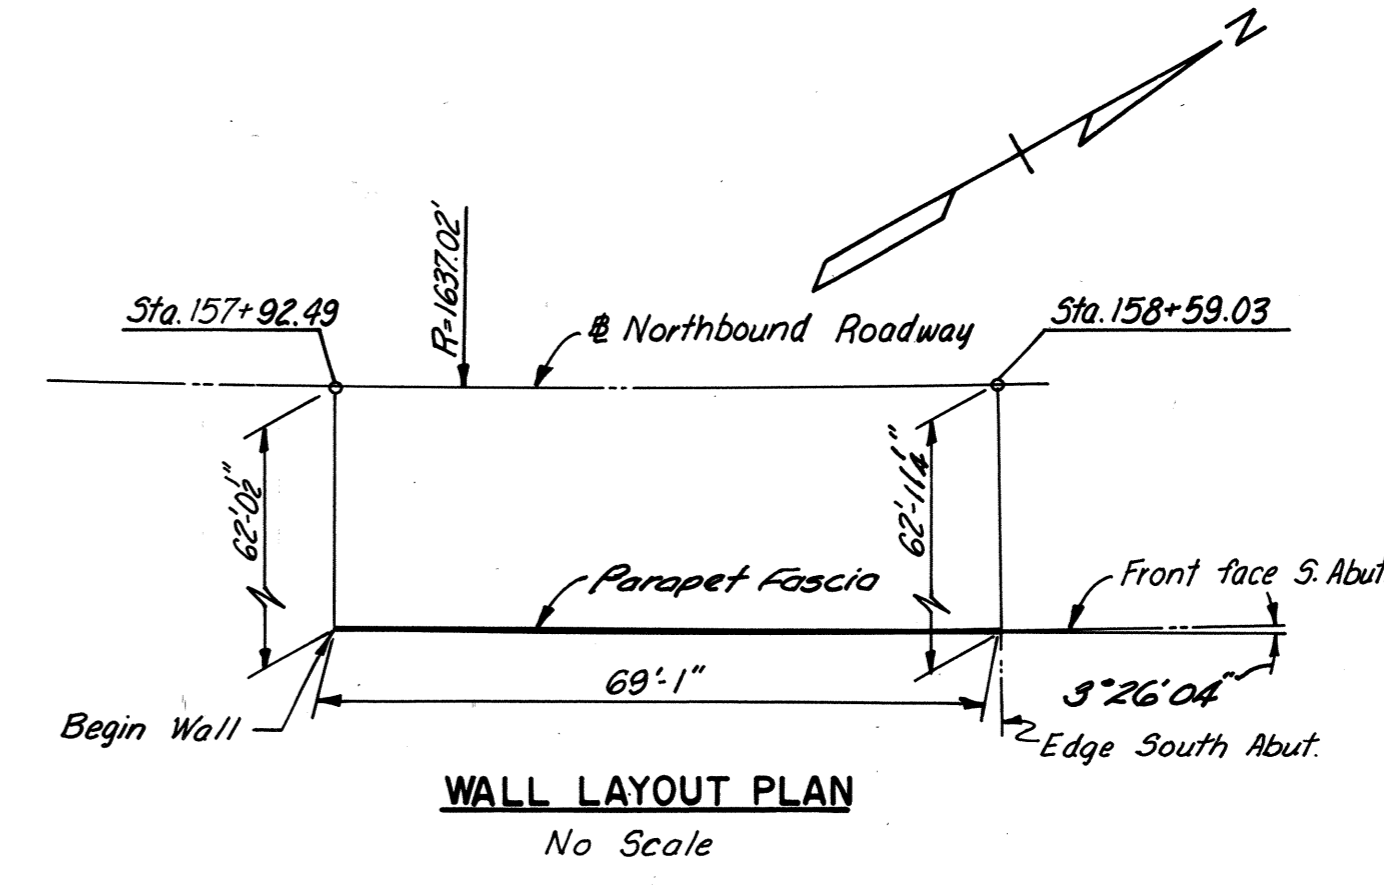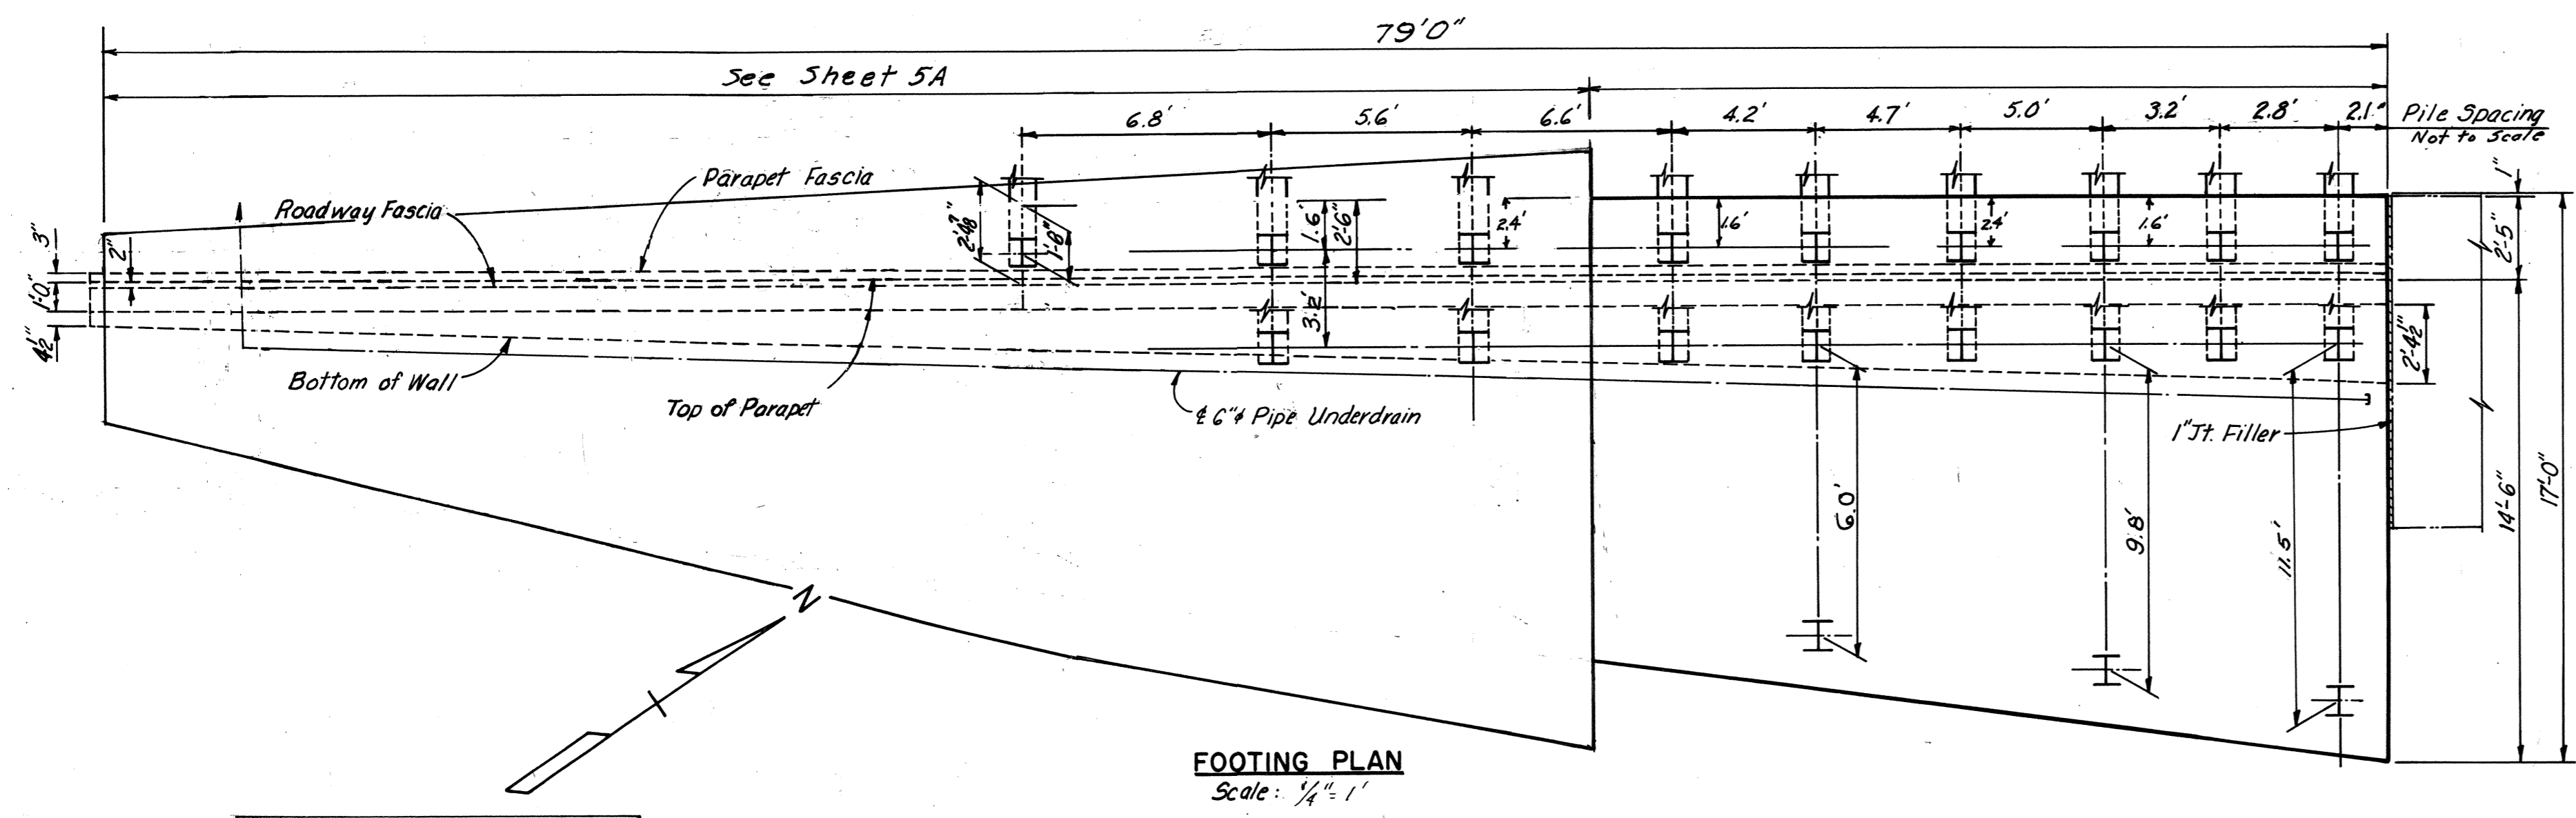

AS BUILT

RICHMOND METROPOLITAN AUTHORITY
RICHMOND EXPRESSWAY SYSTEM
 BELTLINE EXPRESSWAY
 BRIDGE NO. 9
 R.F.&P.R.R. OVER
 NORTHBOUND ROADWAY
SOUTH ABUTMENT RETAINING WALL


HOWARD, NEEDLES, TAMMEN & BERGENDOFF
 consulting engineers
 NEW YORK ALEXANDRIA KANSAS CITY

SCALE: As Noted
 CONTRACT NO.: 4
 SHEET NO. 5 OF 12


BY	DATE	4	As Built	JRC	5-73
MADE	RLM 2-19-68	3	Revised Lt. Std.	JRC	9-71
CHECKED	AKC 4-2-68	2	Profile Grade	P.S.	4-12-71
IN CHARGE	FKD	1	General Revision	AMH	5-13-68
		NO.	REVISION	BY	DATE

RICHMOND EXPRESSWAY SYSTEM			
SECTION	PROJECT	SHEET NO.	TOTAL SHEETS
4	BELTLINE EXPRESSWAY	99	155


Note: For Parapet Details, see Section H-H, Section S-S, and Section Y-Y, on Sheet 2 of Bridge 10 Plans.

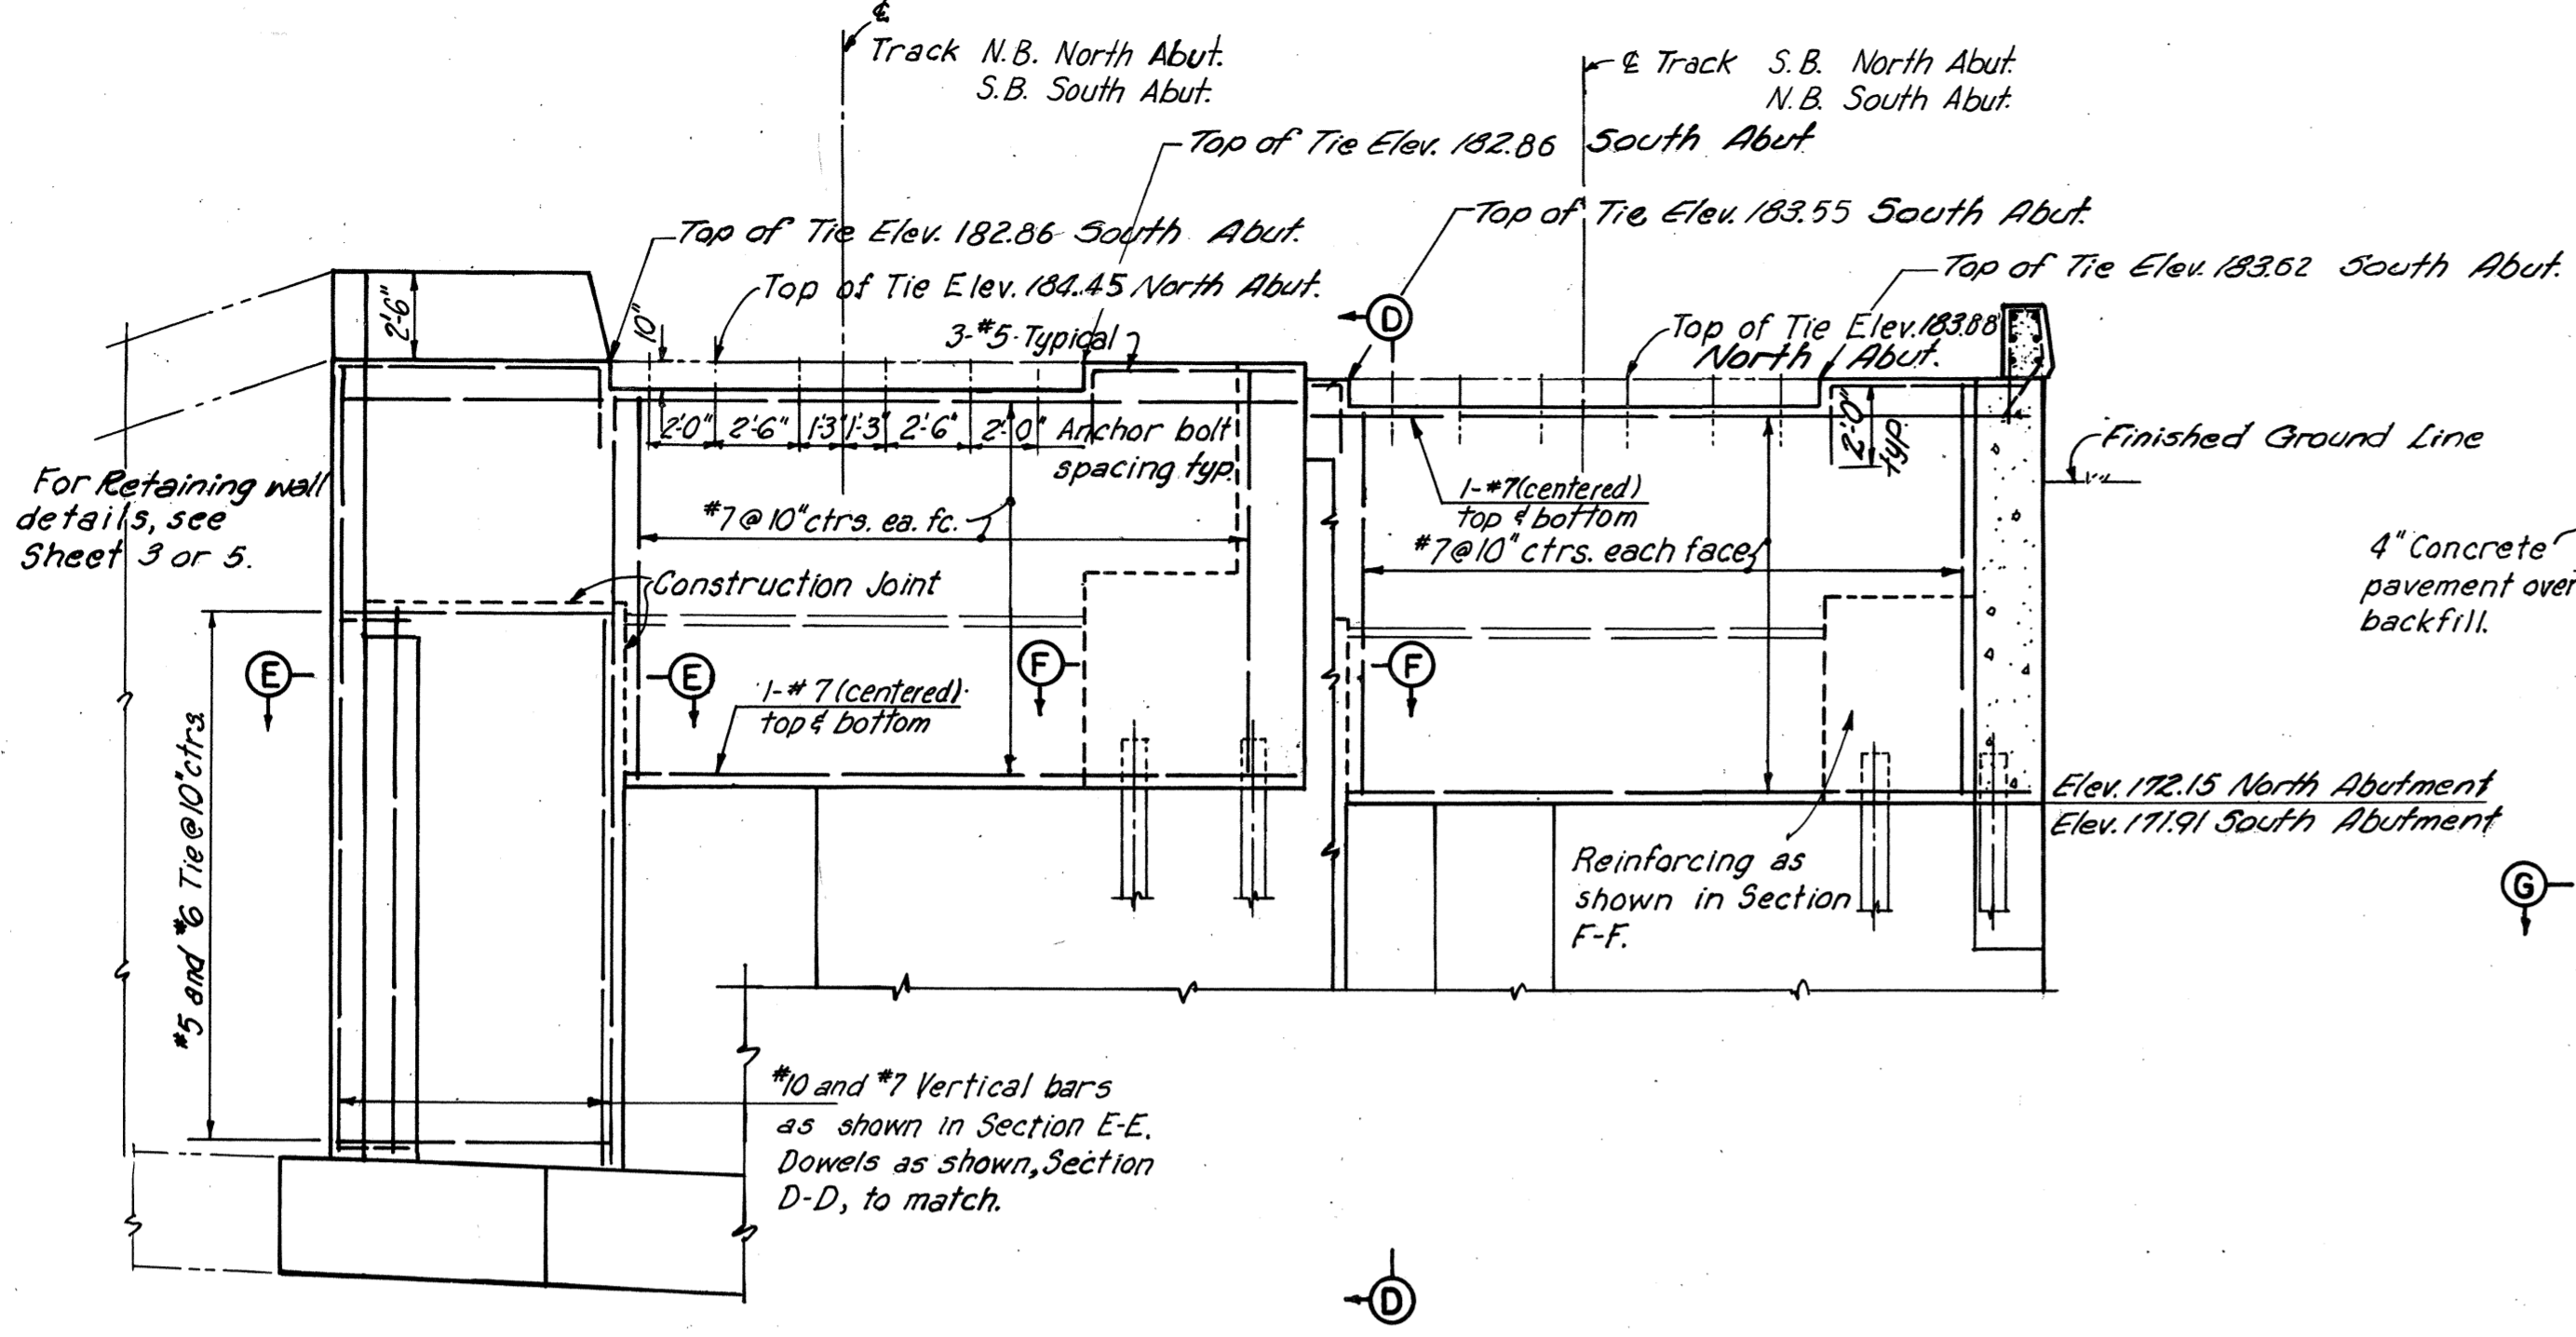

SECTION B-B
Scale: 3/8"=1'-0"
For location, see Sheet 2 or 4.

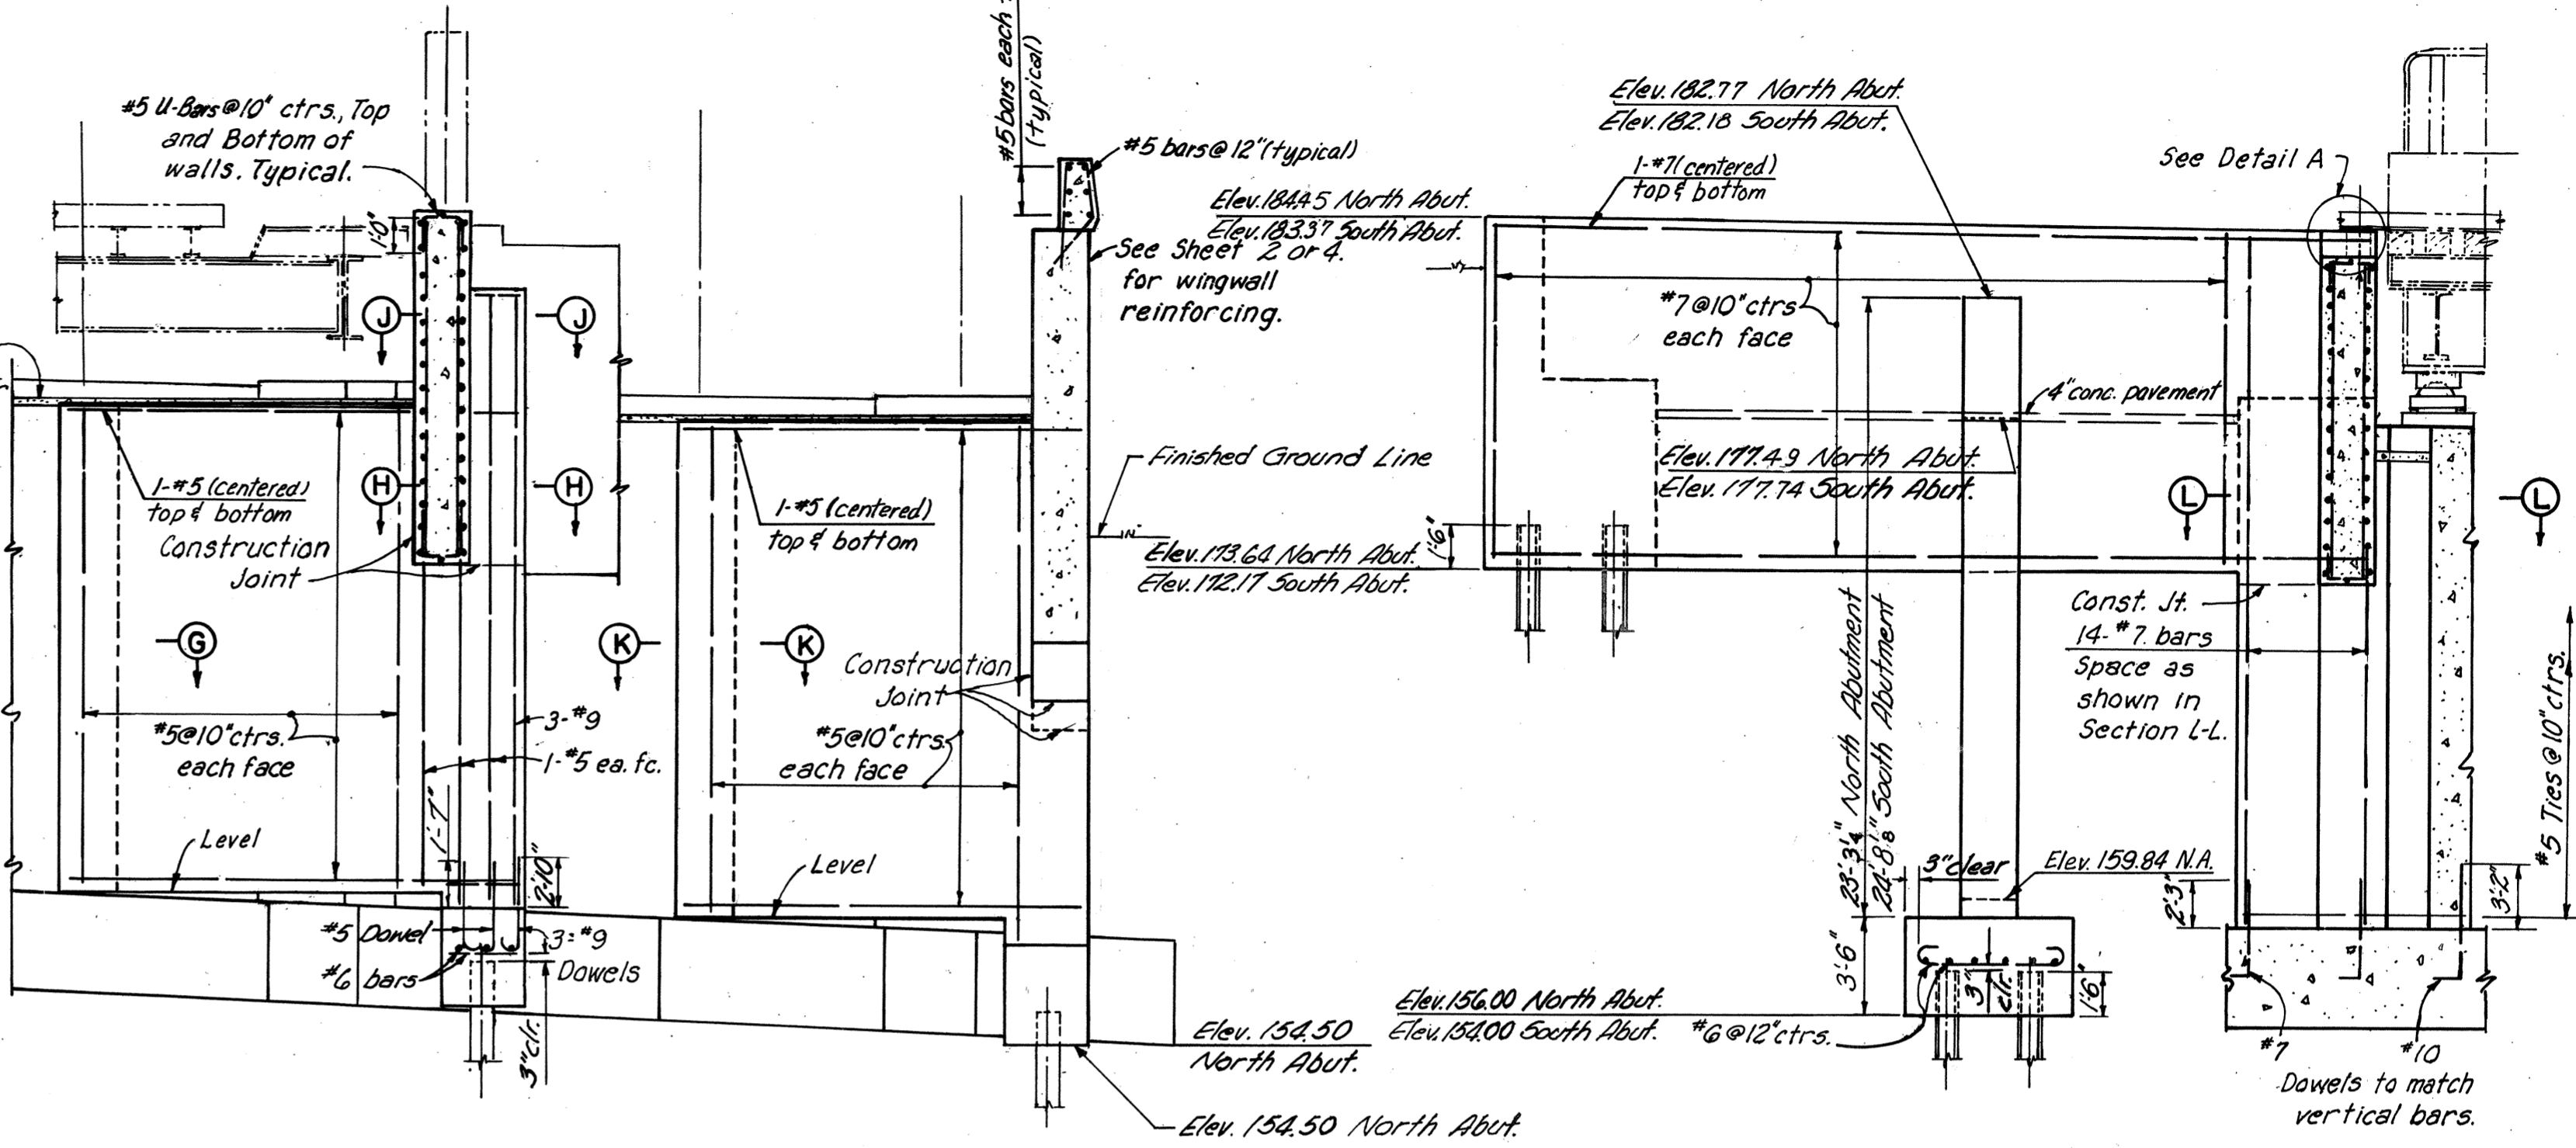


SECTION A-A
Scale: 3/8"=1'-0"
For location, see Sheet 2 or 4.

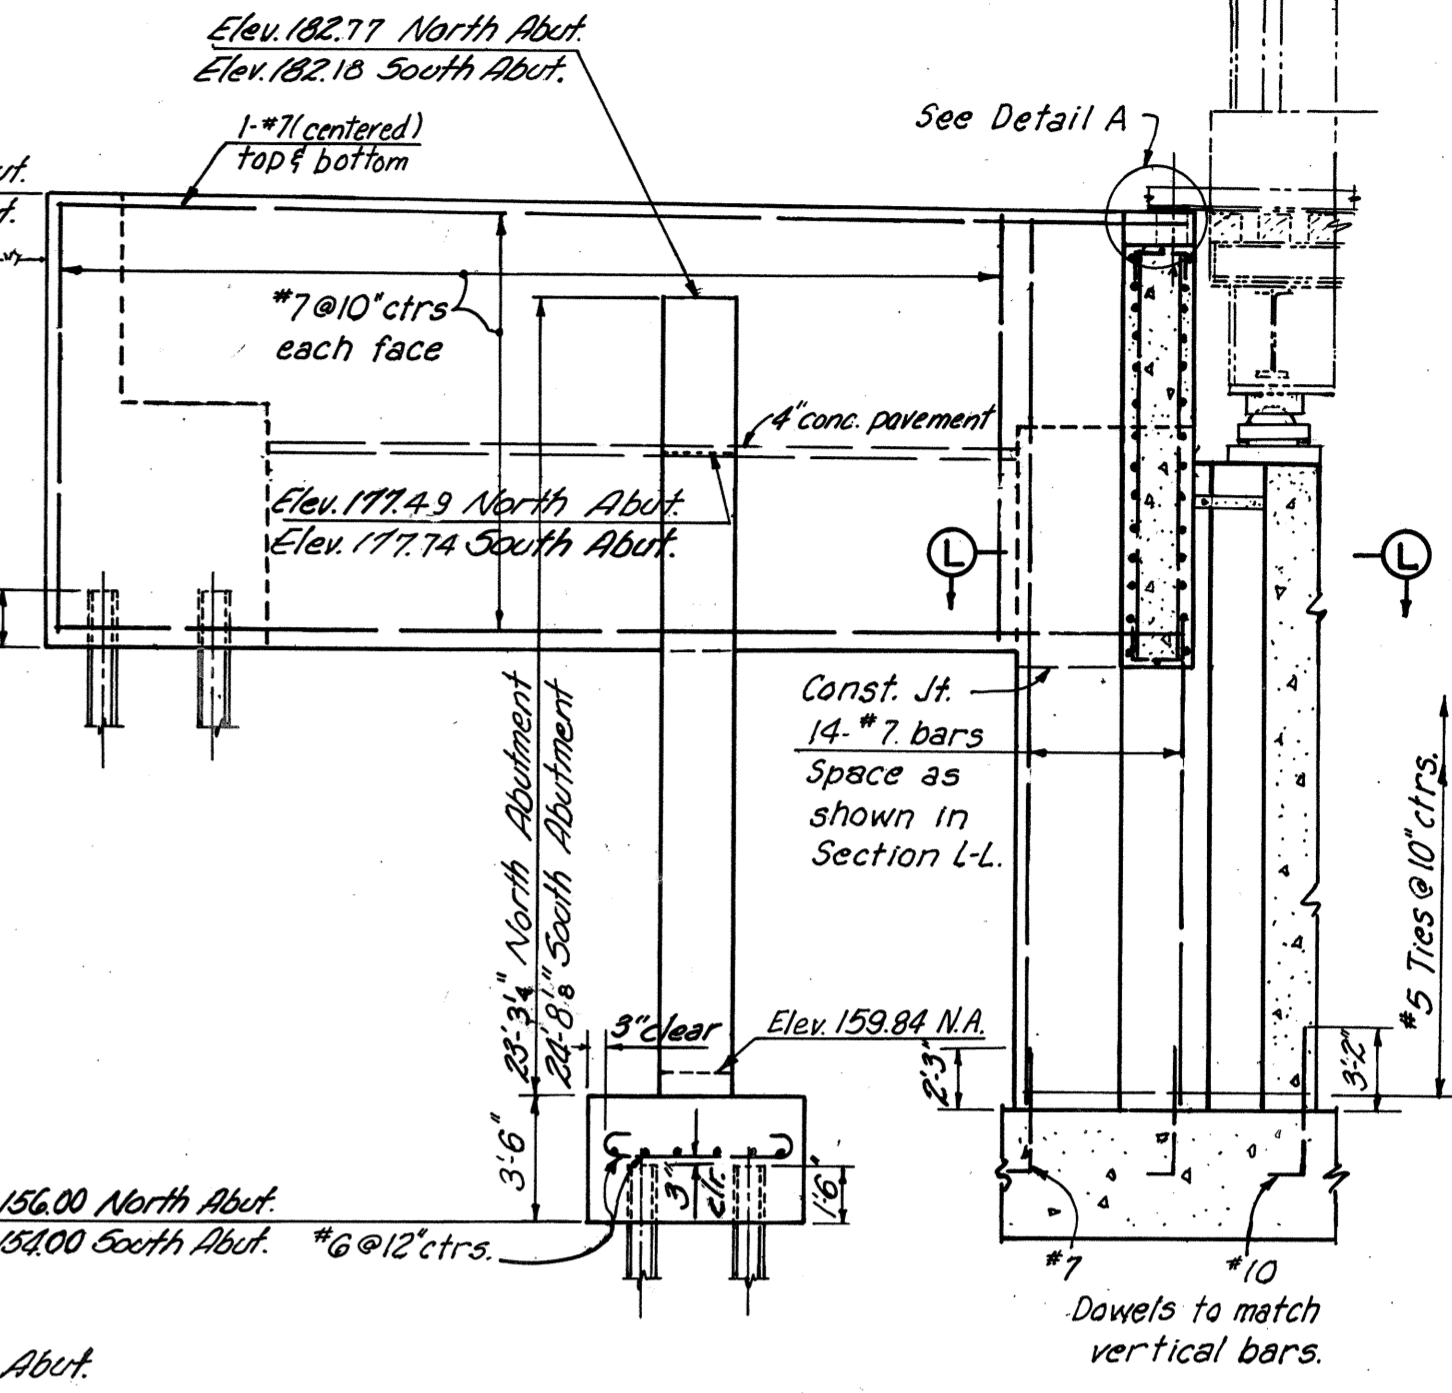


SECTION D-D
Scale: 3/8"=1'-0"


Note: Paving shown within limits of abutment shall be 4" thick, 1/2" preformed joint filler, sealed with a 7" depth of hot applied joint sealer, shall be installed between paving and abutment walls. Preformed joint sealer shall be bituminous type conforming to AASHTO M213. Paving will be paid for as "Concrete, Class A3, Substructures and Walls."

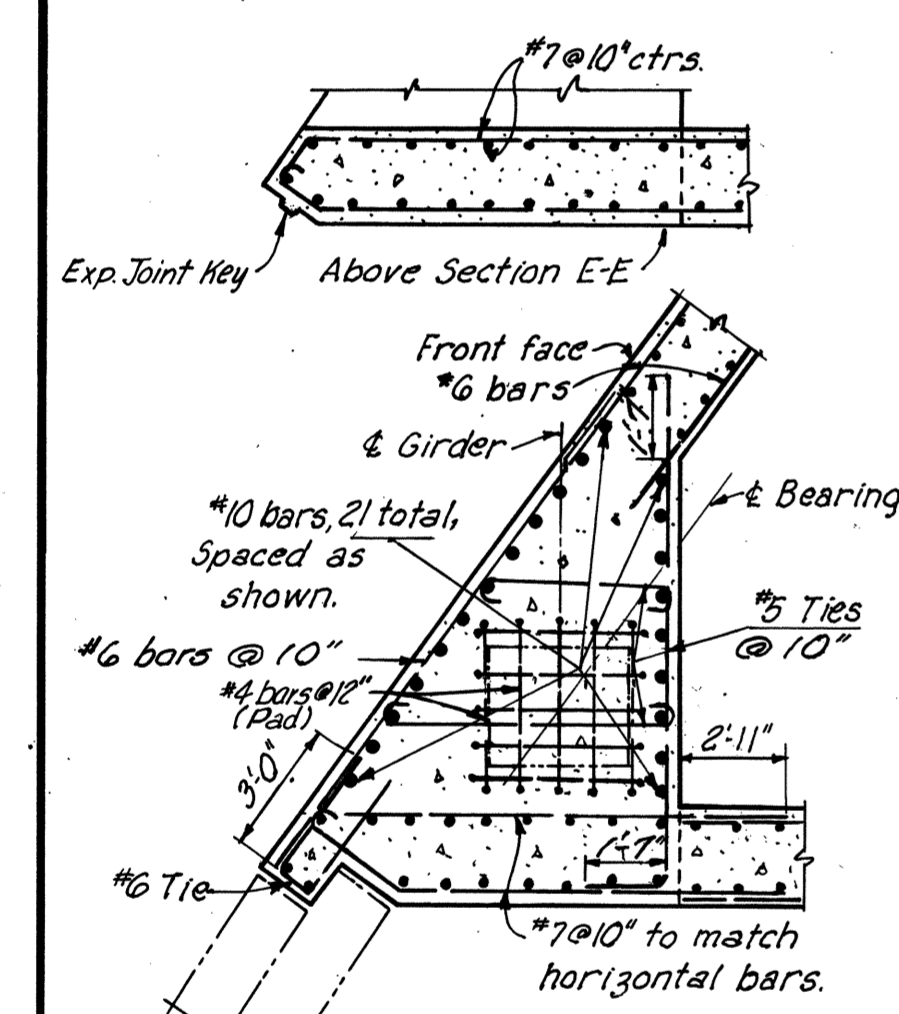


SECTION E-E
Scale: 1/4"=1'-0"

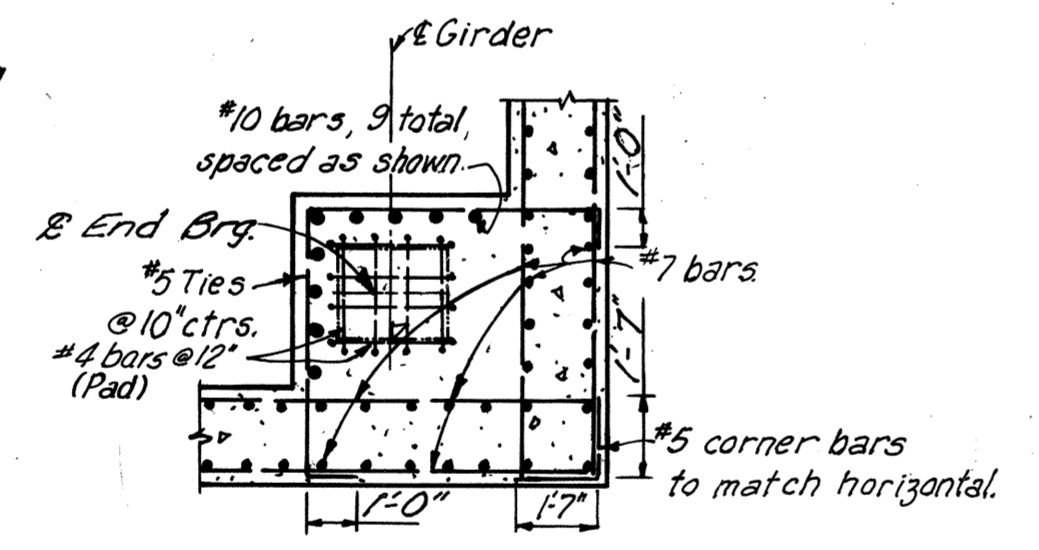


SECTION F-F
Scale: 1/4"=1'-0"

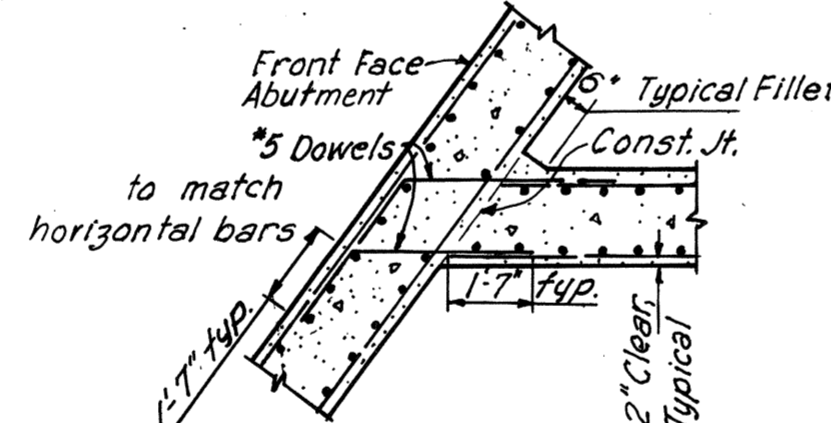


SECTION G-G
Scale: 1/4"=1'-0"

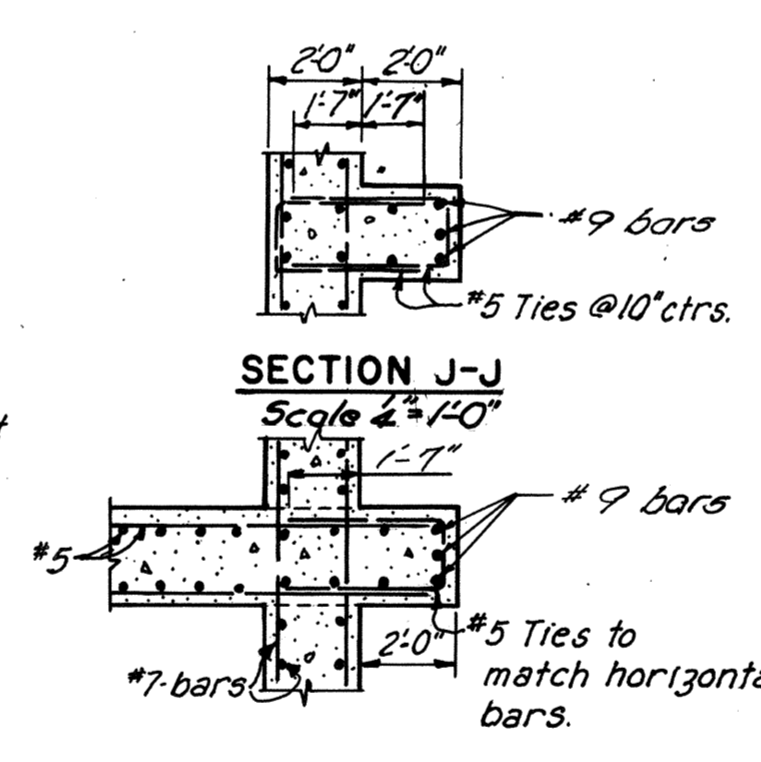


SECTION H-H
Scale: 1/4"=1'-0"

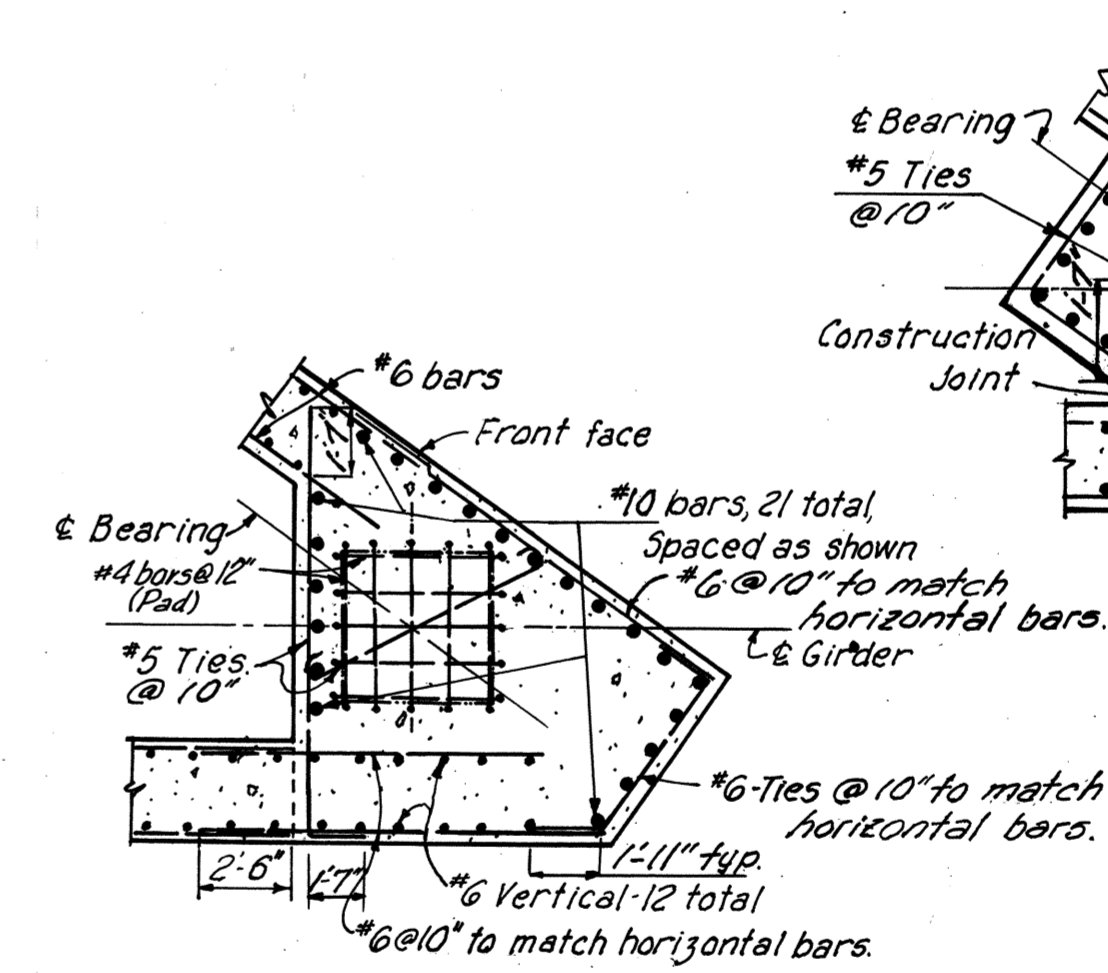


SECTION M-M
Scale: 1/4"=1'-0"
For location, see Sheet 2 or 4.

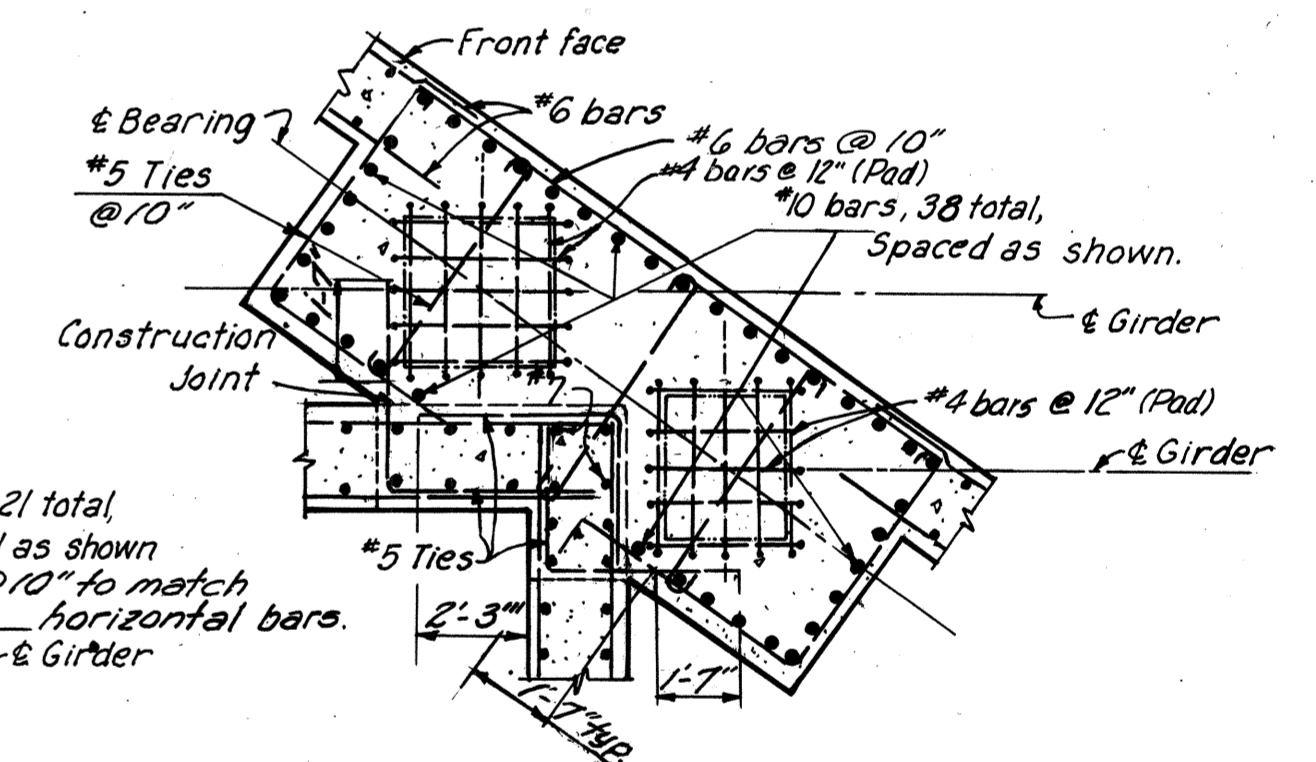

SECTION L-L
Scale: 1/4"=1'-0"

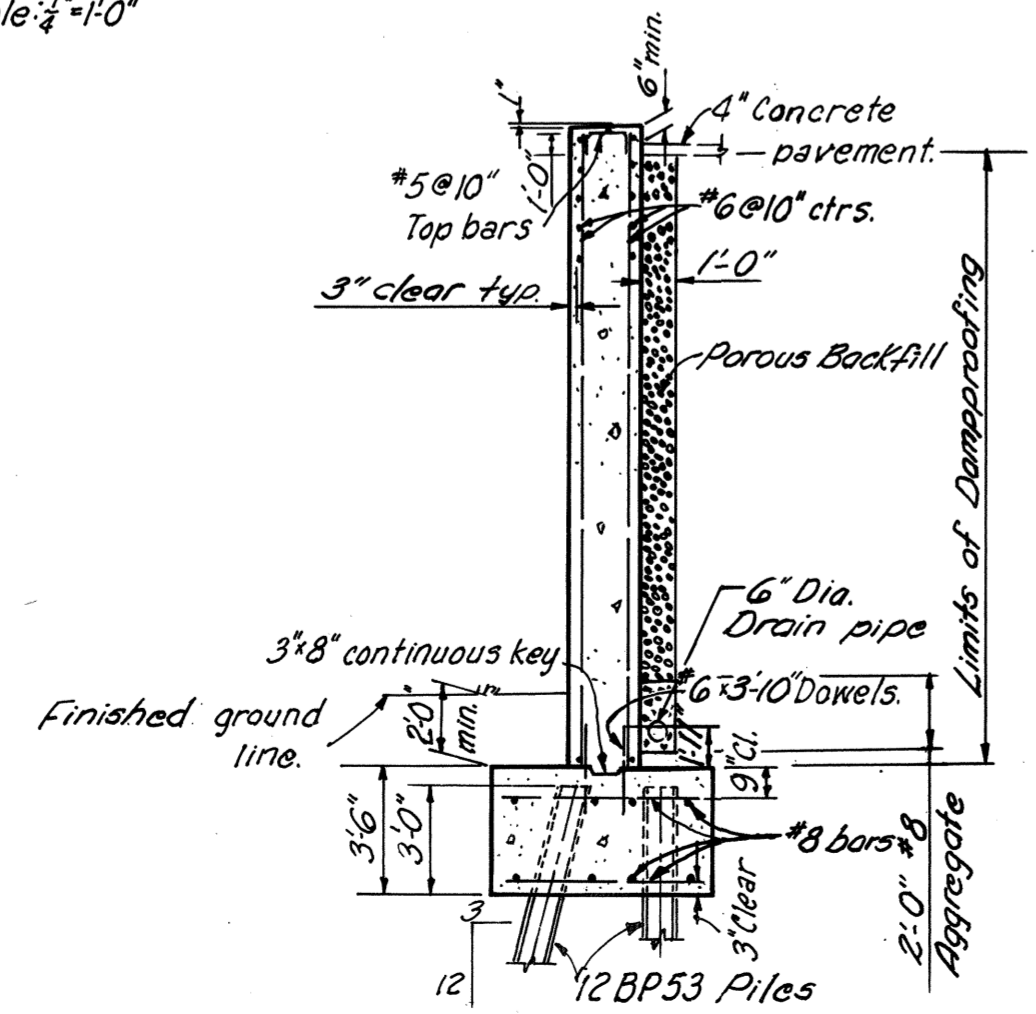

SECTION C-C
Scale: 3/8"=1'-0"
For location, see Sheet 2 or 4.

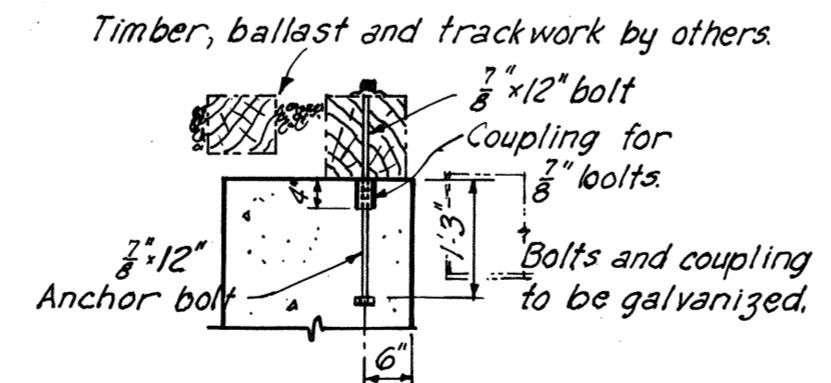

DETAIL A
Scale: 1/2"=1'-0"



Note: Sections shown are for North Abutment, South Abutment similar. #4 Bars @ 12" shown in Sections E-E, F-F, L-L, and M-M, are to be U-shaped bars with 1'-6" legs.

AS BUILT

RICHMOND METROPOLITAN AUTHORITY
RICHMOND EXPRESSWAY SYSTEM
BELTLINE EXPRESSWAY
BRIDGE NO. 9
R.F.&P.R.R. OVER
NORTHBOUND ROADWAY
ABUTMENT DETAILS

BY	DATE	NO.	REVISION	BY	DATE
BY	DATE	3	As Built	JRC	3-73
MADE	RGF	2	Profile Grade	P.S.	4-15-71
CHECKED	RLM	1	General Checking	AMH	5-13-68
IN CHARGE	FKD				

HOWARD, NEEDLES, TAMMEN & BERGENDOFF consulting engineers NEW YORK ALEXANDRIA KANSAS CITY	SCALE: As Shown CONTRACT NO. 4 SHEET NO. 6 OF 12
---	--


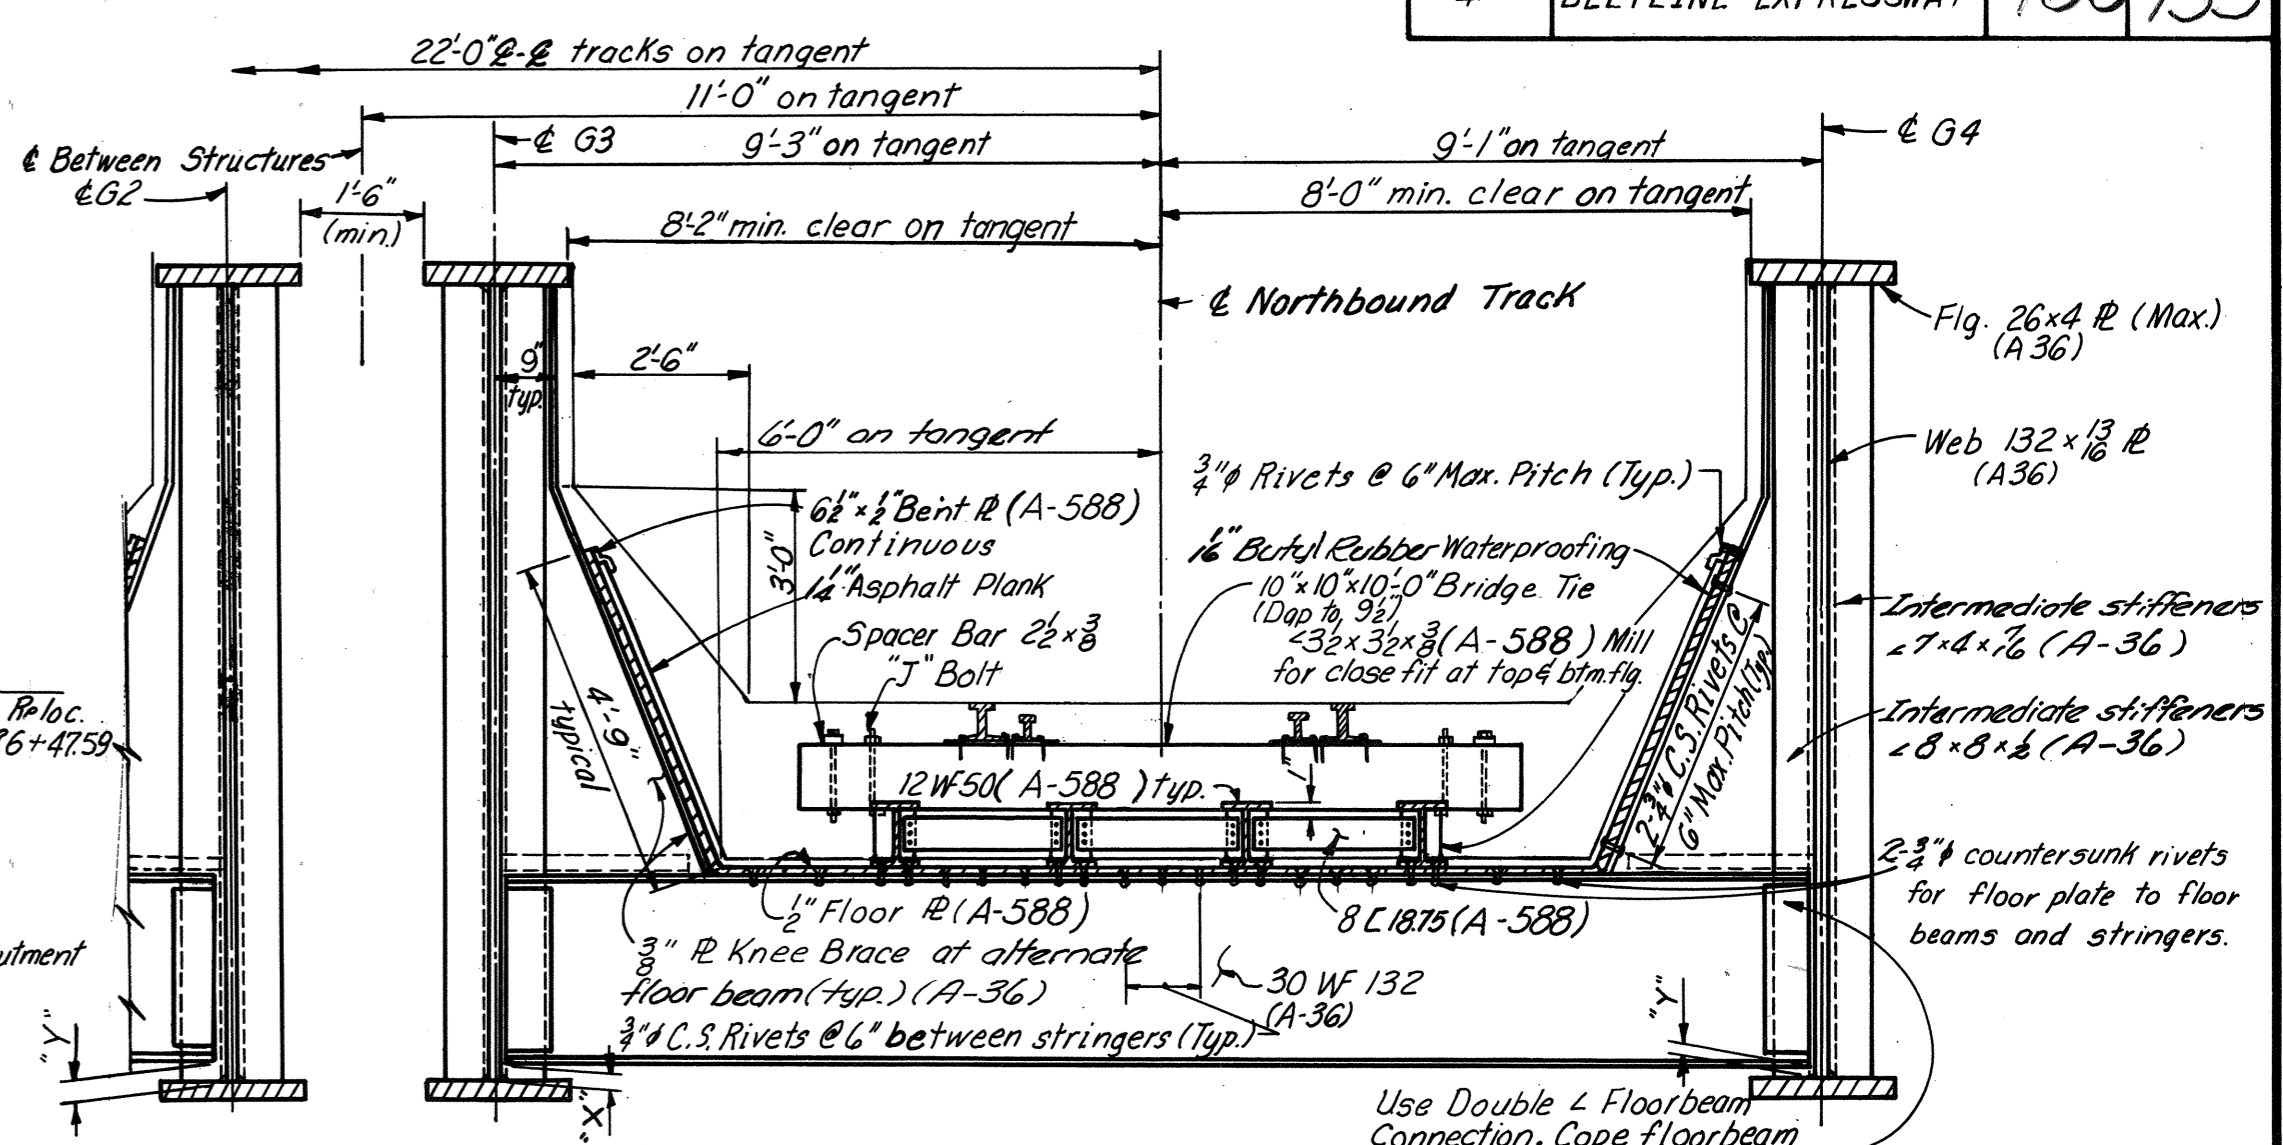
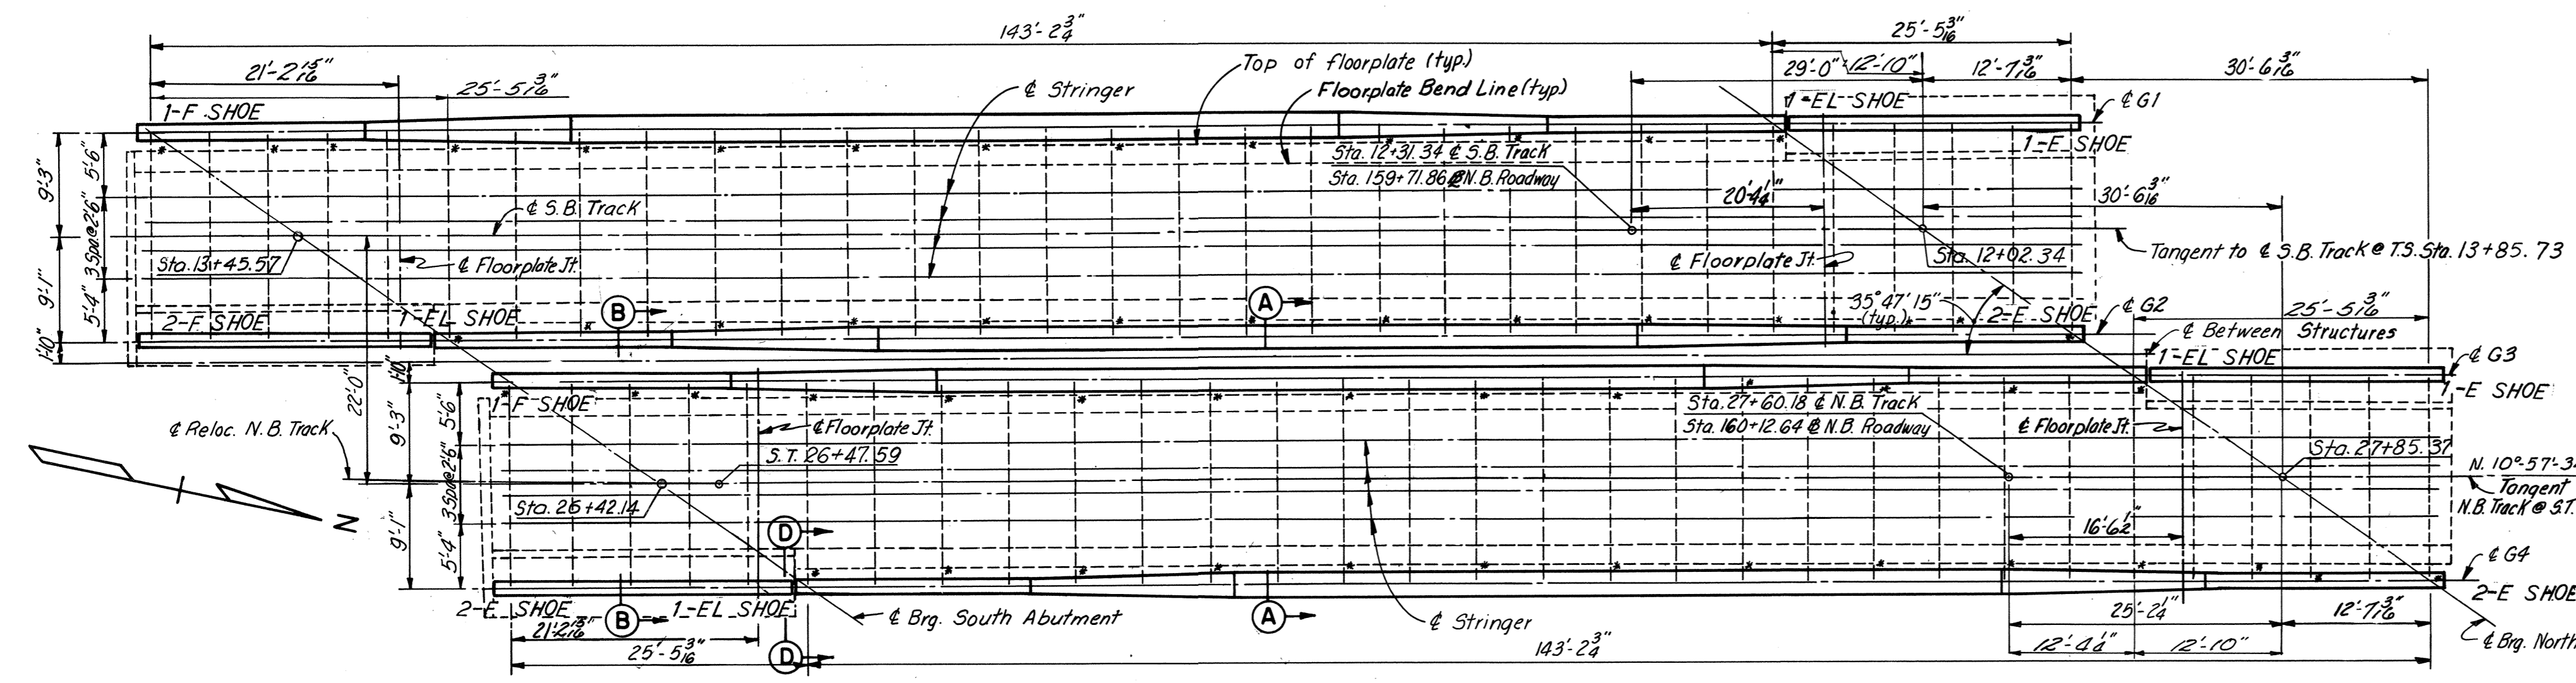


Note: Floorplate connected to stringers by 2 rows of 3/4" Dia. countersunk rivets at 6" maximum pitch.
 All riveted connections shown herein may, at the contractor's option, be replaced by high strength bolt connections.

Note: Ties, track, and fasteners are to be furnished and installed by others.
 Note: Asphalt plank shall be recessed to receive flange of 12 WF 50 stringers.

FLOOR BEAM LOCATION TABLE		
SOUTHBOUND TRACK		
DISTANCE	G1 DIMENSION "X"	G2 DIMENSION "Y"
0	2 3/4"	3"
4'-11 1/2"	2 3/4"	3"
10'-0 1/2"	2 3/4"	3"
15'-1 1/2"	2 3/4"	3"
20'-2 1/2"	2 3/4"	3"
25'-5 3/8"	3"	3"
31'-4 3/8"	3"	3"
37'-2 3/8"	3"	3"
43'-1 3/8"	3"	3"
49'-0 3/8"	3"	3"
54'-10 1/8"	3"	3"
60'-9 1/8"	3"	3"
66'-8 1/8"	3"	3"
72'-6 1/8"	3"	3"
78'-5 3/8"	3"	3"
84'-3 3/8"	3"	3"
90'-2 3/8"	3"	3"
96'-1 3/8"	3"	3"
101'-11 1/8"	3"	3"
107'-10 1/8"	3"	3"
113'-9 1/8"	3"	3"
119'-7 1/8"	3"	3"
125'-6 3/8"	3"	3"
131'-4 3/8"	3"	3"
137'-3 3/8"	3"	3"
143'-2 3/8"	3"	3"
148'-5"	3"	2 3/4"
153'-6"	3"	2 3/4"
158'-7"	3"	2 3/4"
163'-8"	3"	2 3/4"
168'-7 1/8"	3"	2 3/4"

FLOOR BEAM LOCATION TABLE		
NORTHBOUND TRACK		
DISTANCE	G3 DIMENSION "X"	G4 DIMENSION "Y"
0	2 9/16"	3 1/8"
4'-11 1/2"	2 9/16"	3 1/8"
10'-0 1/2"	2 9/16"	3 1/8"
15'-1 1/2"	2 9/16"	3 1/8"
20'-2 1/2"	3"	3 1/8"
25'-5 3/8"	3"	3 1/8"
31'-4 3/8"	3"	3 1/8"
37'-3 1/8"	3"	3 1/8"
43'-1 3/8"	3"	3 1/8"
49'-0 1/8"	3"	3 1/8"
54'-10 1/8"	3"	3 1/8"
60'-9 1/8"	3"	3 1/8"
66'-8 1/8"	3"	3 1/8"
72'-6 1/8"	3"	3 1/8"
78'-5 3/8"	3"	3 1/8"
84'-4 1/8"	3"	3 1/8"
90'-2 3/8"	3"	3 1/8"
96'-1 3/8"	3"	3 1/8"
101'-11 1/8"	3"	3 1/8"
107'-10 1/8"	3"	3 1/8"
113'-9 1/8"	3"	3 1/8"
119'-7 1/8"	3"	3 1/8"
125'-6 3/8"	3"	3 1/8"
131'-5 1/8"	3"	3 1/8"
137'-3 3/8"	3"	3 1/8"
143'-2 3/8"	3"	3 1/8"
148'-5"	3"	2 3/4"
153'-6"	3"	2 3/4"
158'-7"	3"	2 3/4"
163'-8"	3"	2 3/4"
168'-7 1/8"	3"	2 3/4"

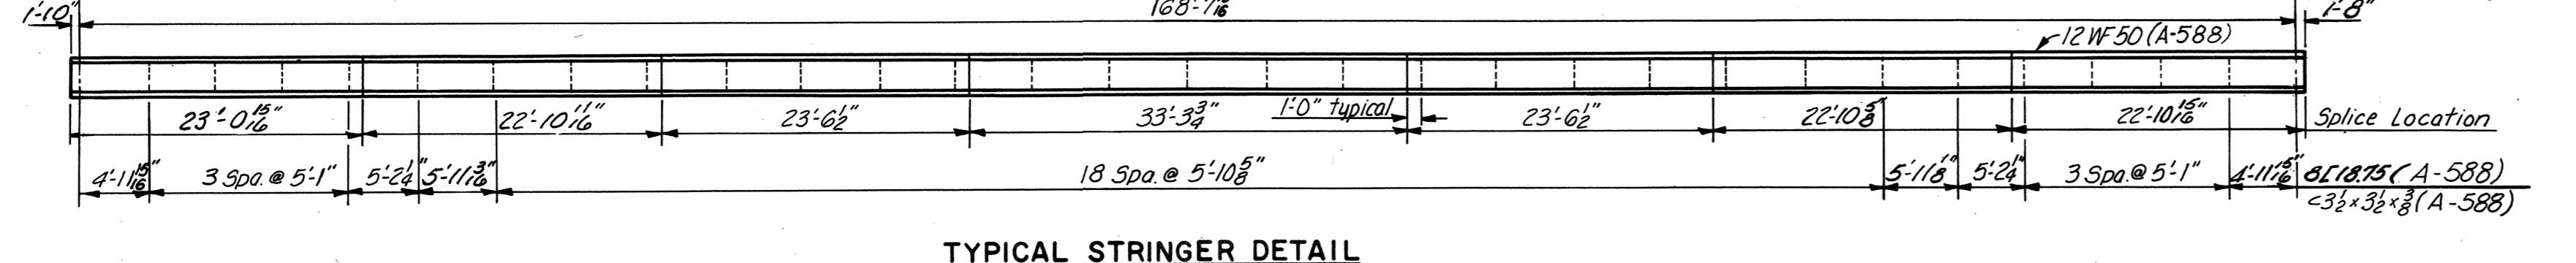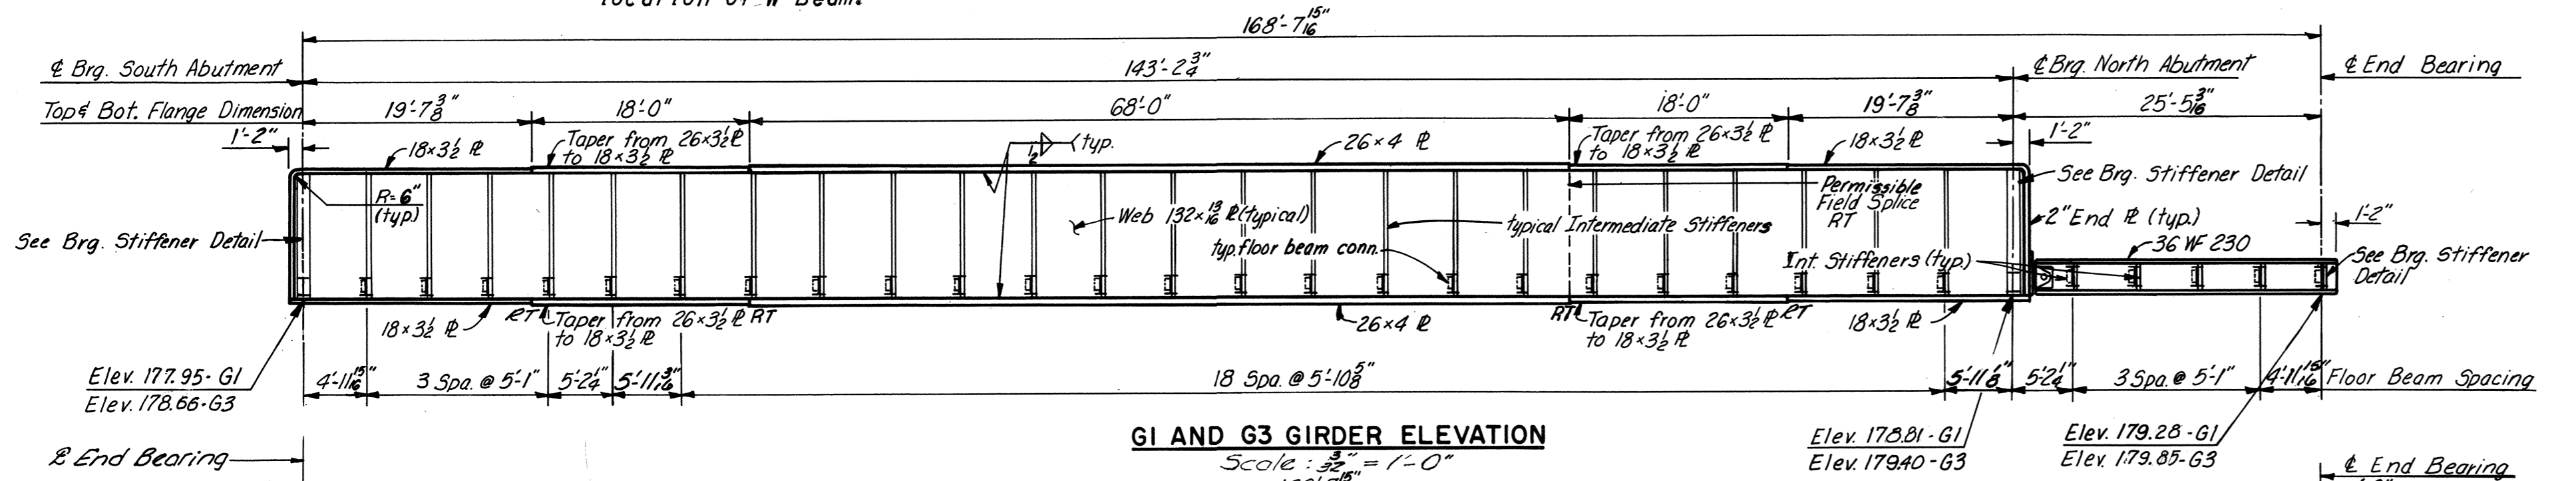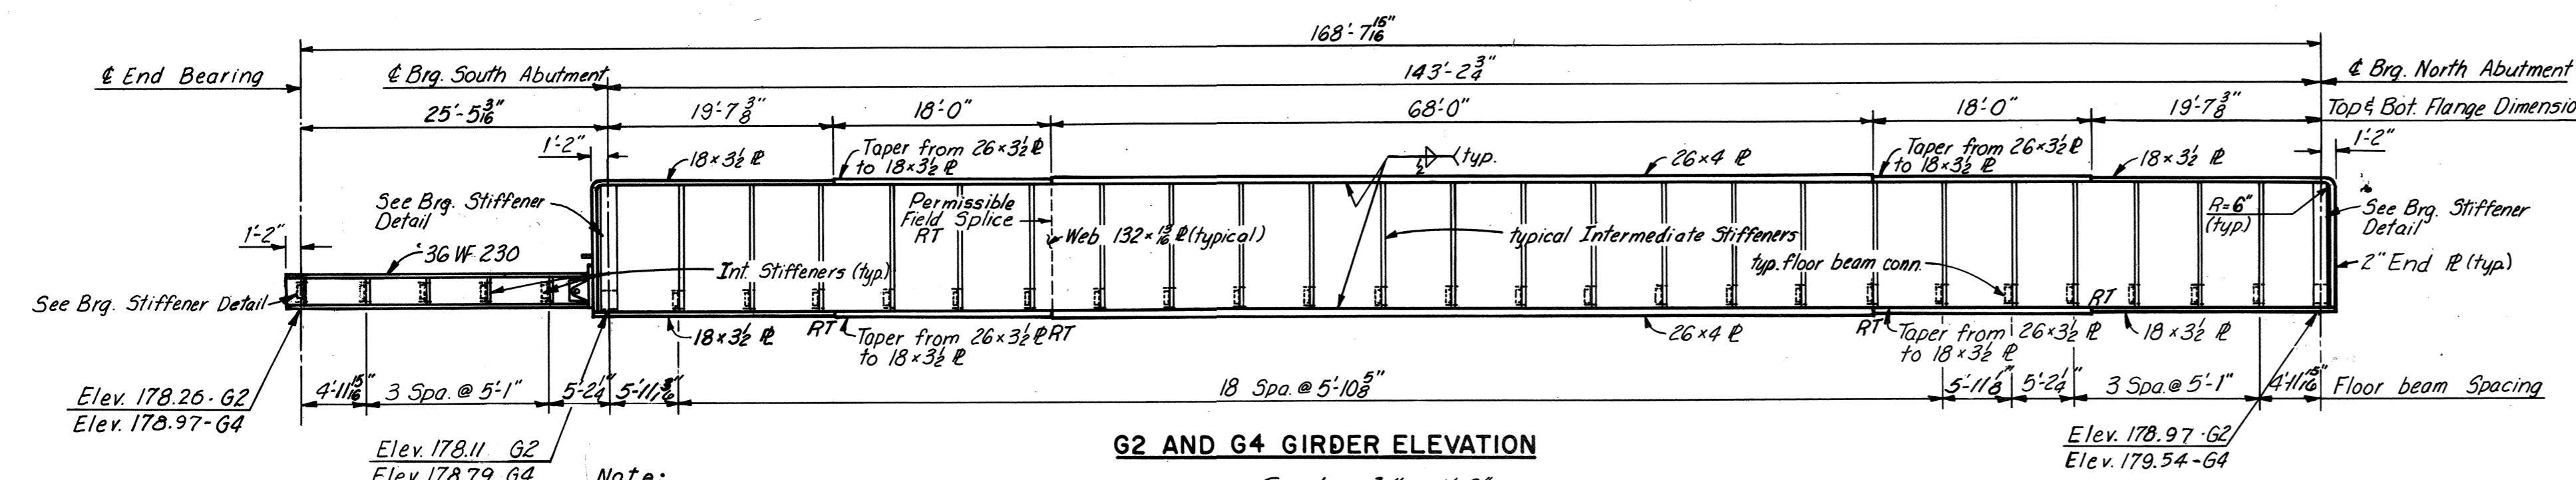

RADIOGRAPHIC INSPECTION NOTE:
 An "RT" shown on elevation views indicates radiographic inspection of adjacent flange and web, flange, or web welds in accordance with the Special Provisions.

Note: Welded Girders are to be cambered to compensate for full anticipated dead load, see Sheet 9.

Notes - Southbound Track:
 Distances shown in Floor Beam Table are measured from north to south, starting at the extreme north floor beam.
 Dimensions "X" and "Y" shown in Floor Beam Table for G1 and G2 are measured from top of bottom flange for Plate Girder section and from bottom of WF beam section.

Elevations shown on Girder Elevations are at bottom of bottom flange for Plate Girder section and for WF beam section.

Notes - Northbound Track:
 Distances shown in Floor Beam Table are measured from south to north, starting at the extreme south floor beam.
 Dimensions "X" and "Y" shown in Floor Beam Table for G3 and G4 are measured from top of bottom flange for Plate Girder section and from bottom of WF beam section.

Elevations shown on Girder Elevations are at bottom of bottom flange for Plate Girder section and for WF beam section.

Notes:
 For Shoe Details, see Sheet 10.
 For Dead Load Deflections, see Sheet 9.
 For Superstructure Details, see Sheets 8 and 9.
 For Sections B-B, and D-D, see Sheet 9.

Note:
 One butt welded shop splice will be permitted in each 26"x4" flange plate; details of splice shall be similar to that shown for Field Flange Splice, sheet 8. A maximum of 3 web splices including web splice at "Permissible Field Splice", will be permitted; detail of shop web splice shall be similar to that shown for Field Flange Splice, Sheet 8, except that web opening is not required and web splice shall not be located within 2'-0" of a shop flange splice.

BY	DATE	NO.	REVISION	BY	DATE
4	As Built	JRC	3-73		
BY	DATE	NO.	REVISION	BY	DATE
MADE	RLM 12-13-67	2	Profile Grade	ER	4-12-71
CHECKED	JFH 4-9-68	1	General Checking	AMH	5-13-68
IN CHARGE	FKD				

AS BUILT

RICHMOND METROPOLITAN AUTHORITY
RICHMOND EXPRESSWAY SYSTEM
BELTLINE EXPRESSWAY
BRIDGE NO. 9
R.F.&P.R.R. OVER
NORTHBOUND ROADWAY
FRAMING PLAN

HOWARD, NEEDLES, TAMMEN & BERGENDOFF
 consulting engineers
 NEW YORK ALEXANDRIA KANSAS CITY

SCALE: As Noted
 CONTRACT NO. 4
 SHEET NO. 7 OF 12

GENERAL NOTES

STRUCTURE: Dual structures with one welded steel girder span and one rolled beam at each approach. Distance between girders of 18'-4" with 1'-6" min. clear between structures.

CAPACITY: Live Loads - Cooper E-80 with 50% impact.

SPECIFICATIONS: GENERAL: Virginia Department of Highway Road and Bridge Specifications 1970 and Contract Special Specifications. DESIGN: A.R.E.A. 1966 for Steel Railway Bridges, for Fixed Spans not exceeding 400 feet in length. WELDING: 1969 Standard Specifications for Welded Highway and Railway Bridges of the American Welding Society.

CONTRACT SPECIAL PROVISIONS: Specifications and Contract Special Provisions referred to above are necessary to make these plans complete.

DATUM: City of Richmond

TEMPERATURE: The normal temperature referred to on the plan is 68°F. The temperature range for movement is 0°F to 120°F.

DIMENSIONS: All dimensions are measured horizontally and vertically unless otherwise noted.

EXCAVATION: Excavation below subgrade and cut slope template shall be classified as Structure Excavation. All excavation above these limits shall be classified as Regular Excavation and is not included in the Structural Quantities.

FOUNDATION: Footings shall rest on firm material. Foundation material shall be kept dry and special attention is called to Section 401.05 of the General Specifications, and to the Contract Special provisions, concerning preparation of foundations for footings.


CONCRETE NOTES: All concrete shall be Class A3. All exposed edges and corners shall have a 3/4" chamfer or fillet unless otherwise noted. Finishing Concrete Surfaces: See the Standard Architectural Detail Sheets and the Contract Special Provisions for types and details.

All reinforcing steel shall conform to A.S.T.M. A615, Grade 40. All reinforcing bar dimensions on the detailed drawings are to centers of bars unless otherwise noted. Clear distance between reinforcing steel and face of concrete shall be as noted on the plans. All bar laps shall be 30 diameters of the smaller bar unless otherwise noted.

STEEL NOTES: Structural steel shall conform to A.S.T.M. Specification A-36 and A-588. All field connections shall be made with high strength bolts or rivets. High strength bolts and rivets shall be 1/2" diameter unless otherwise noted and shall conform to A.S.T.M. Specification A-325.


BENCH MARK: A-15 Copperweld rod on bridge on Blue Shingles Road Elev. 204.73.

FOUNDATION: Piles shall be driven to a minimum length corresponding to the approximate tip elevations shown on the Plans but in no case to less than a penetration affording the required safe bearing capacity noted on the Plans.

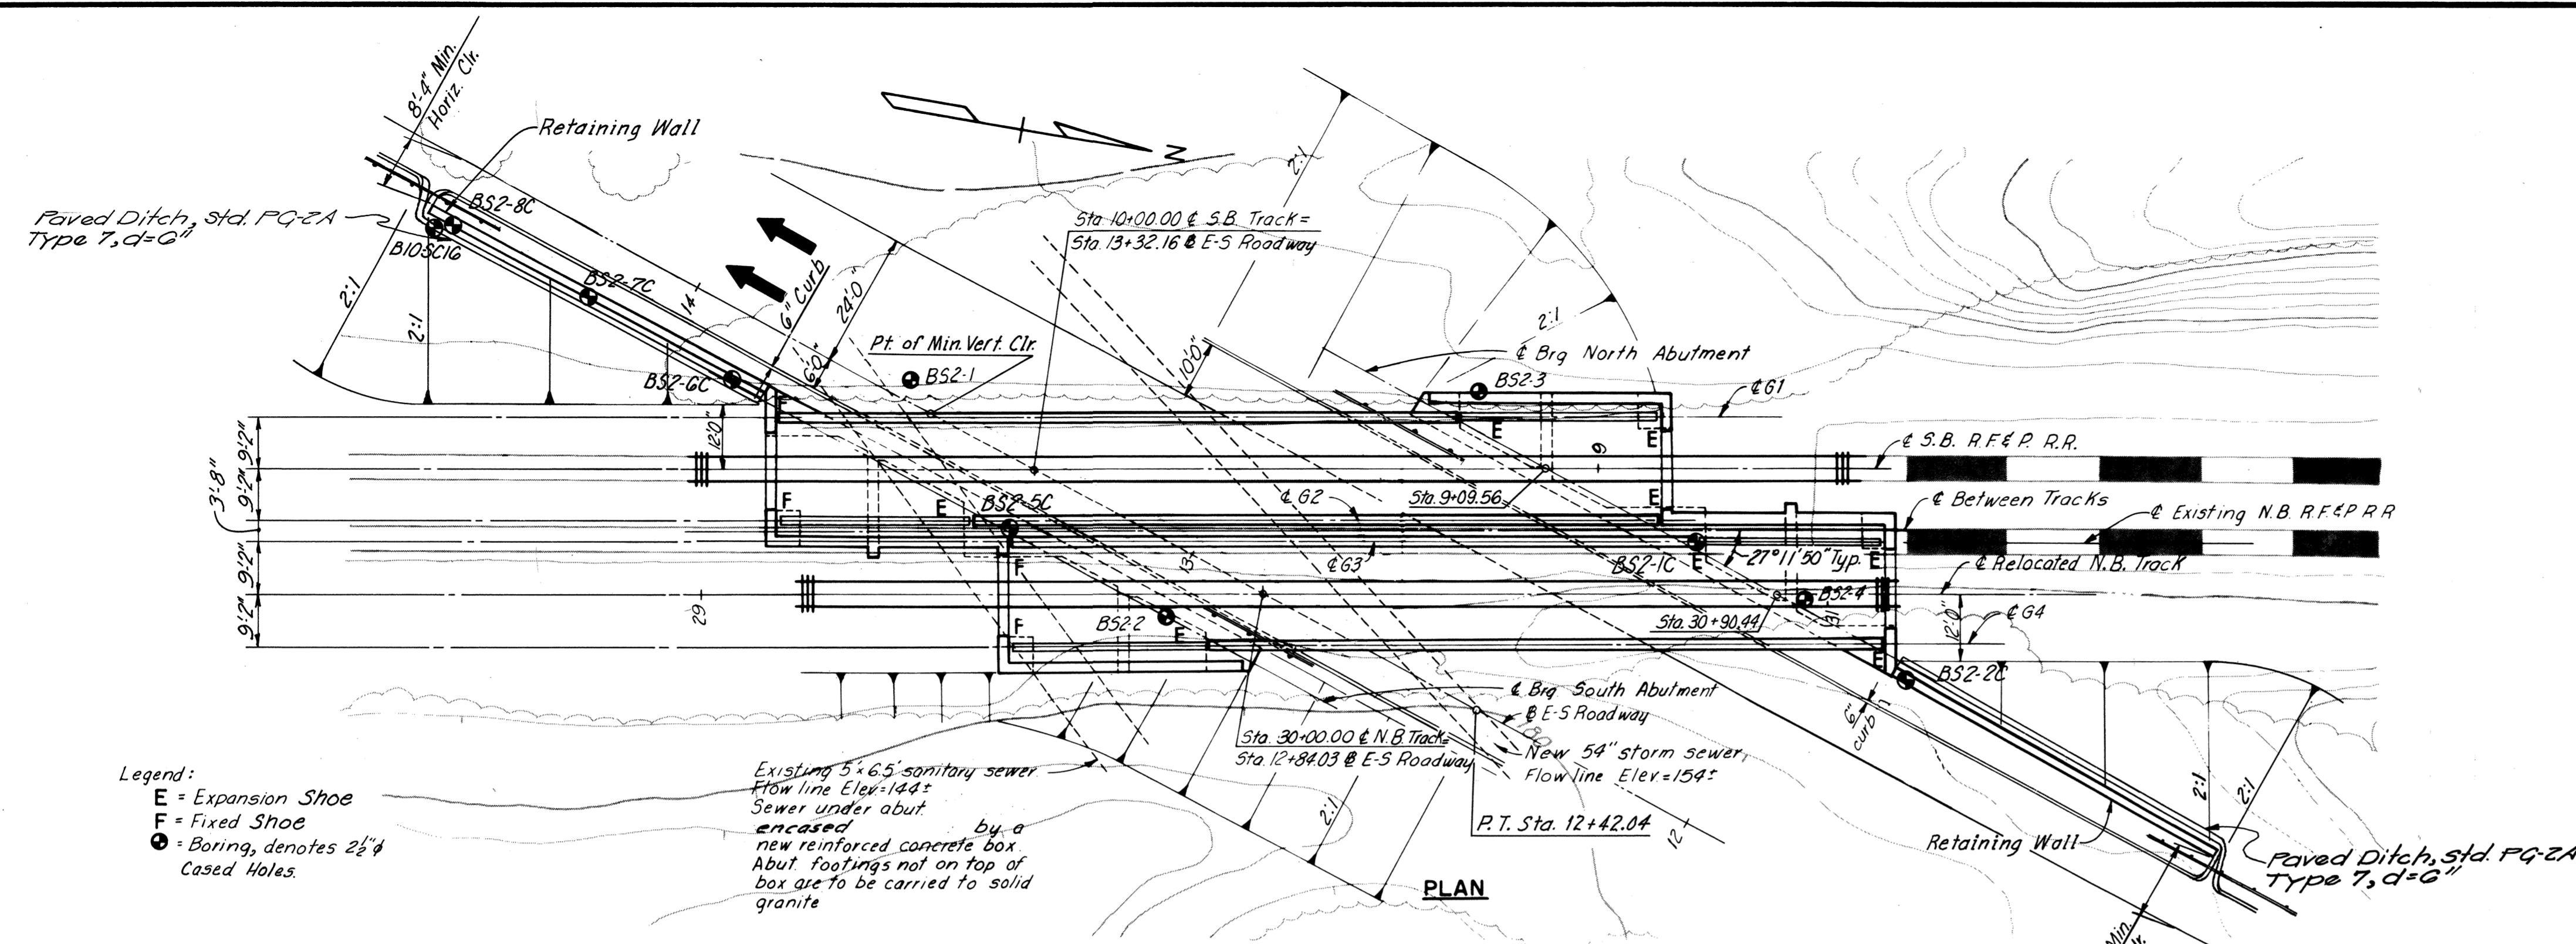

Legend:
 E = Expansion Shoe
 F = Fixed Shoe
 ● = Boring, denotes 2 1/2" Cased Holes.

Note: For details of curb outlets, see Miscellaneous Details, Sheet 21 of Roadway Plans.

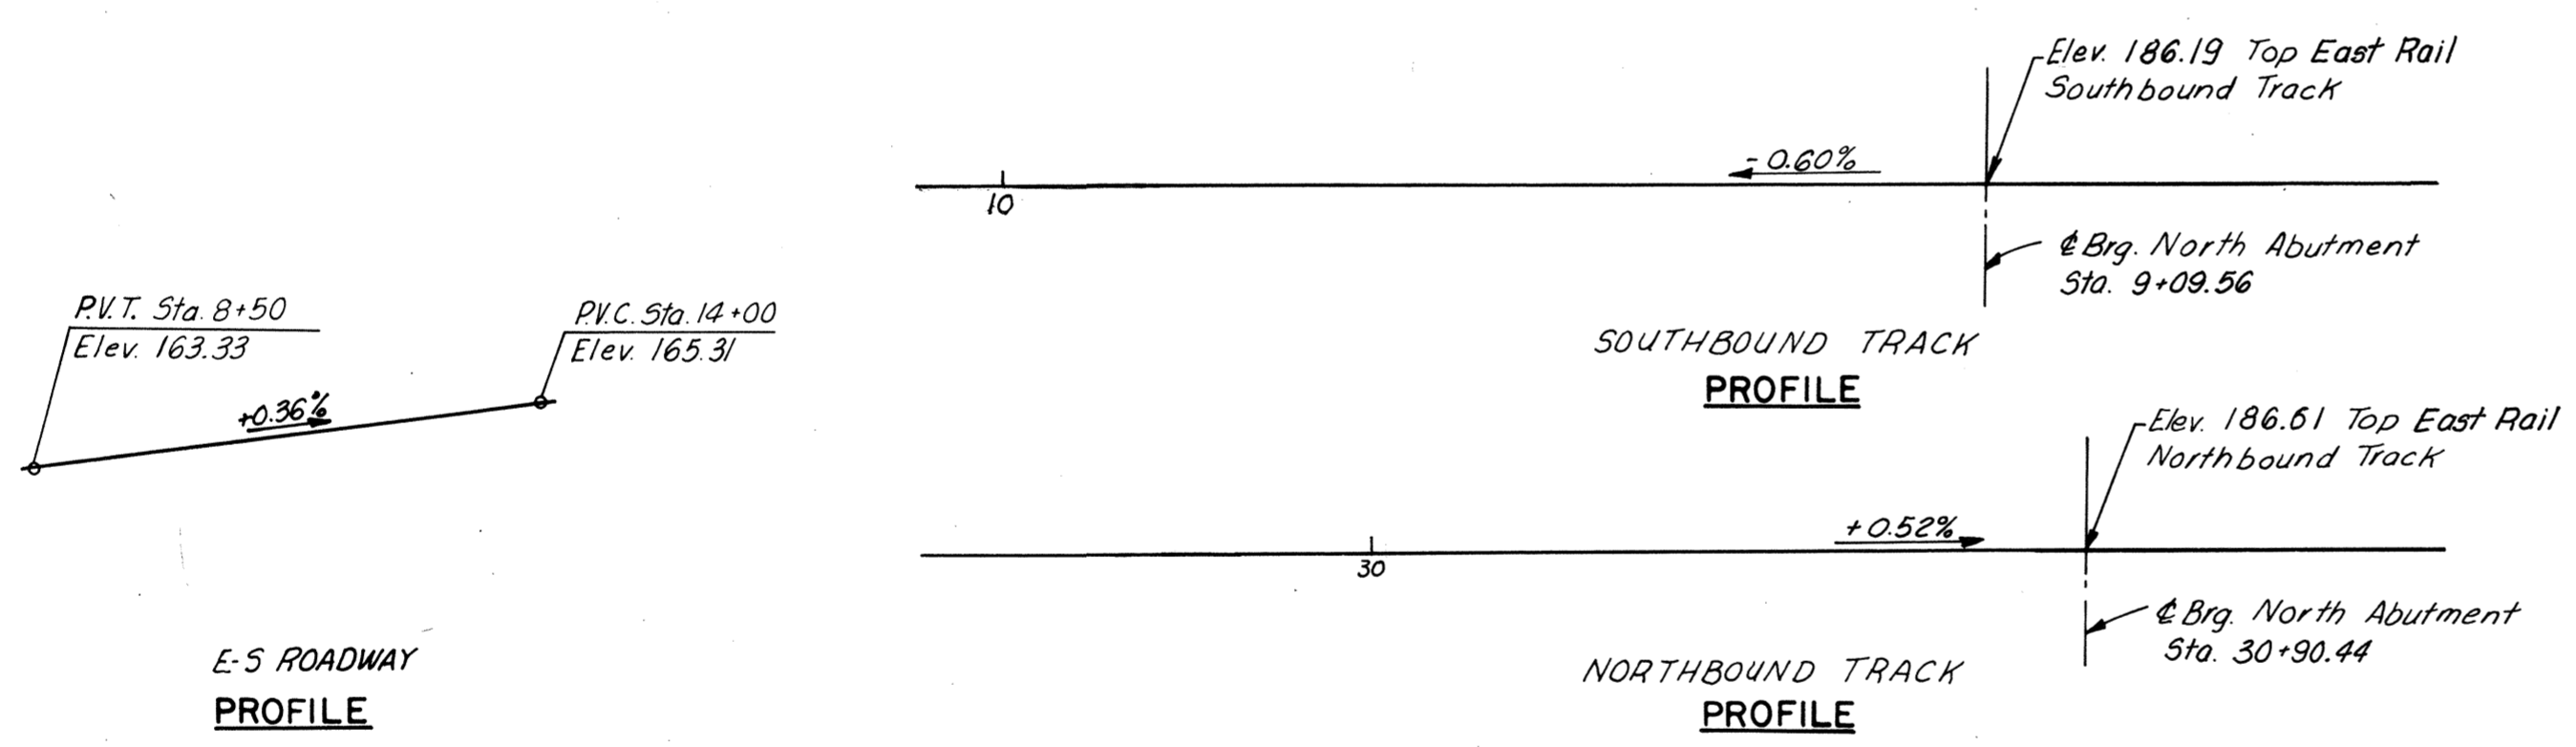


ESTIMATED QUANTITIES


	Struct. Excav. Cu. Yds.	Concrete (a) Cu. Yds.	Reinf. Steel Lbs.	Steel Piles 10HP42 Lin. Ft.	Porous Backfill Cu. Yds.	Under-drain 6" Pipe Lin. Ft.	Struct. Steel (Lbs.)		Asphalt Damp Proofing Sq. Yds.	1/4" Asphalt Plank Sq. Ft.	1/2" Butyl Rubber Waterproofing Square	Bridge Drainage Metalwork Lbs.
							Mild Carbon	High Strength				
Superstructure							674,692.2	251,107.1		6,756	68	
North Abutment	267	656.47	75,346		66	167			242			
South Abutment	1,284	788.15	91,072	794.9	62	163			231			3,080
TOTAL	1,551	1,444.62	166,418	794.9	128	330	674,692.2	251,107.1	473	6,756	68	3,080

INDEX

GENERAL PLAN AND ELEVATION	1
NORTH ABUTMENT	2
NORTH ABUTMENT DETAILS	3
NORTH ABUTMENT RETAINING WALL	4
SOUTH ABUTMENT	5
SOUTH ABUTMENT DETAILS	6
SOUTH ABUTMENT RETAINING WALL	7
FRAMING PLAN	8
SUPERSTRUCTURE DETAILS	9
SUPERSTRUCTURE DETAILS	10
SHOE DETAILS	11
BORING LOGS	12
STANDARD ARCHITECTURAL DETAILS - S8 AND S9	

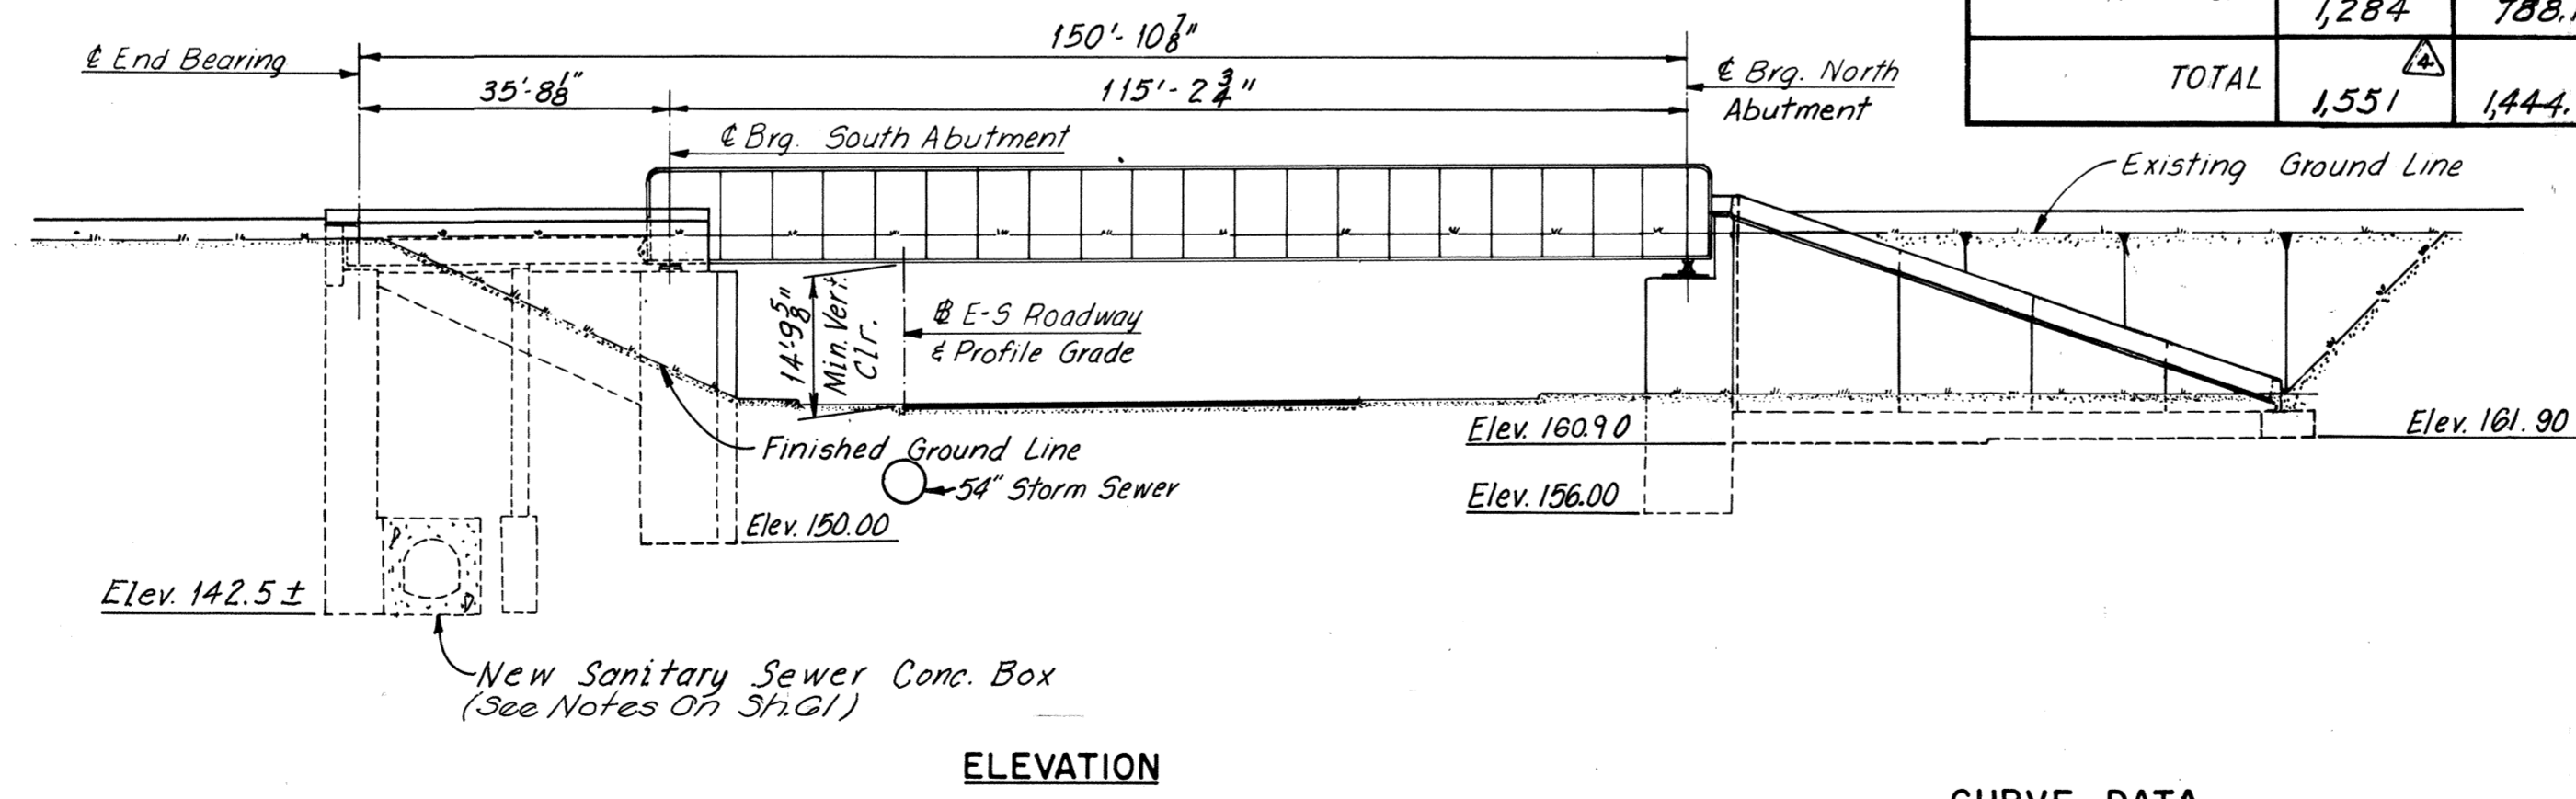

CURVE DATA
 @ E-S Roadway
 P.I. = Sta. 6+43.88
 Δ = 37°15'41"
 D = 3°00'00"
 T = 643.88'
 L = 1242.04'
 R = 1909.86'

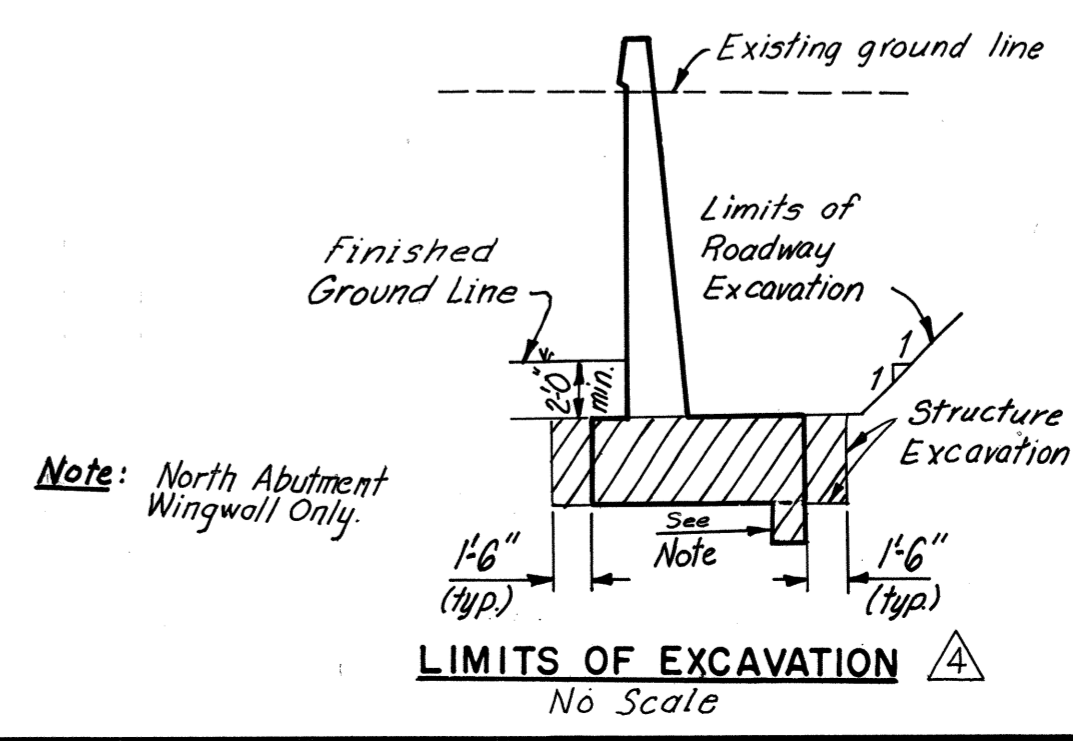

AS BUILT


RICHMOND METROPOLITAN AUTHORITY
RICHMOND EXPRESSWAY SYSTEM
BELTLINE EXPRESSWAY
BRIDGE NO. 10
R.F.&P.R.R. OVER
EAST-SOUTH ROADWAY
GENERAL PLAN AND ELEVATION

HOWARD, NEEDLES, TAMMEN & BERGENDOFF consulting engineers
 NEW YORK ALEXANDRIA KANSAS CITY

SCALE: 1"=20' unless noted
 CONTRACT NO.: 4
 SHEET NO. 1 OF 12




MADE	RLM	12-5-67	2	General	J.G.V.	10-70
CHECKED	JEH	4-9-68	1	General Checking	AMH	5-13-68
IN CHARGE	FKD					

RICHMOND EXPRESSWAY SYSTEM			
SECTION	PROJECT	SHEET NO.	TOTAL SHEETS
4	BELTLINE EXPRESSWAY	107	155

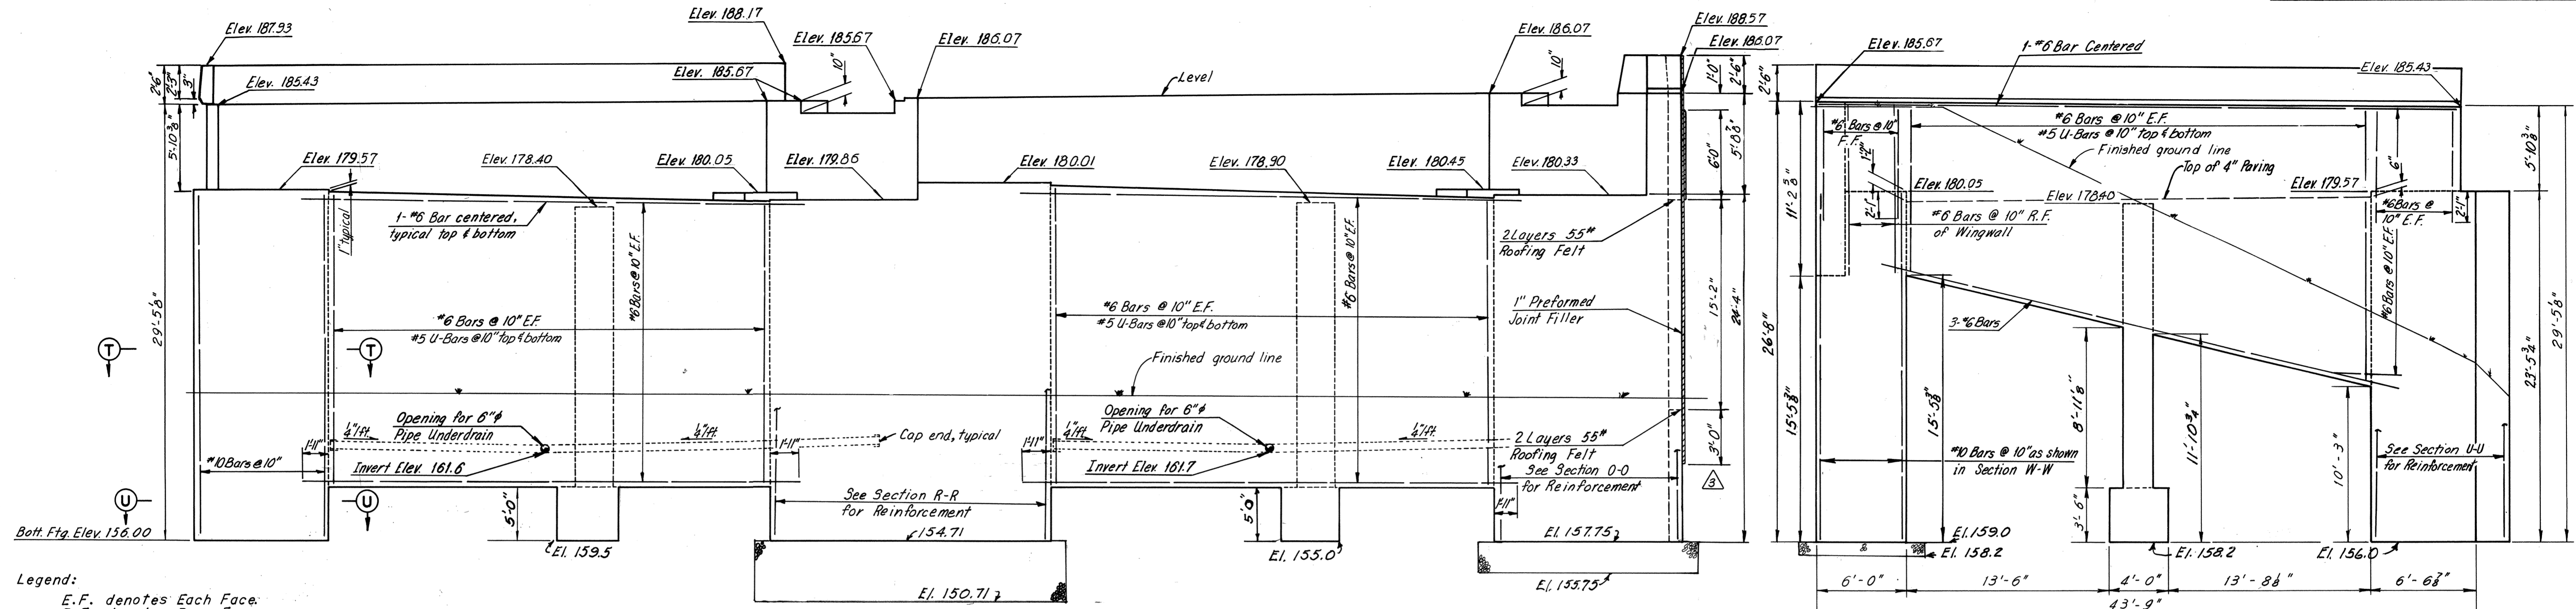

ELEVATION

WEST WINGWALL ELEVATION

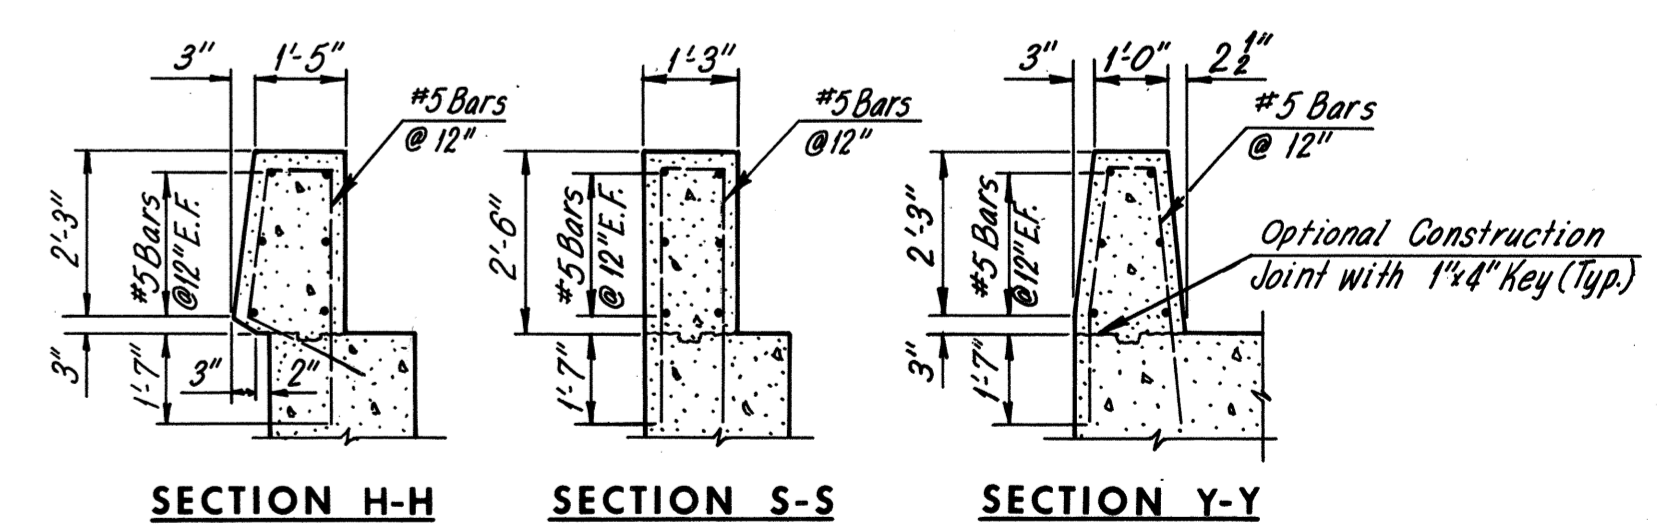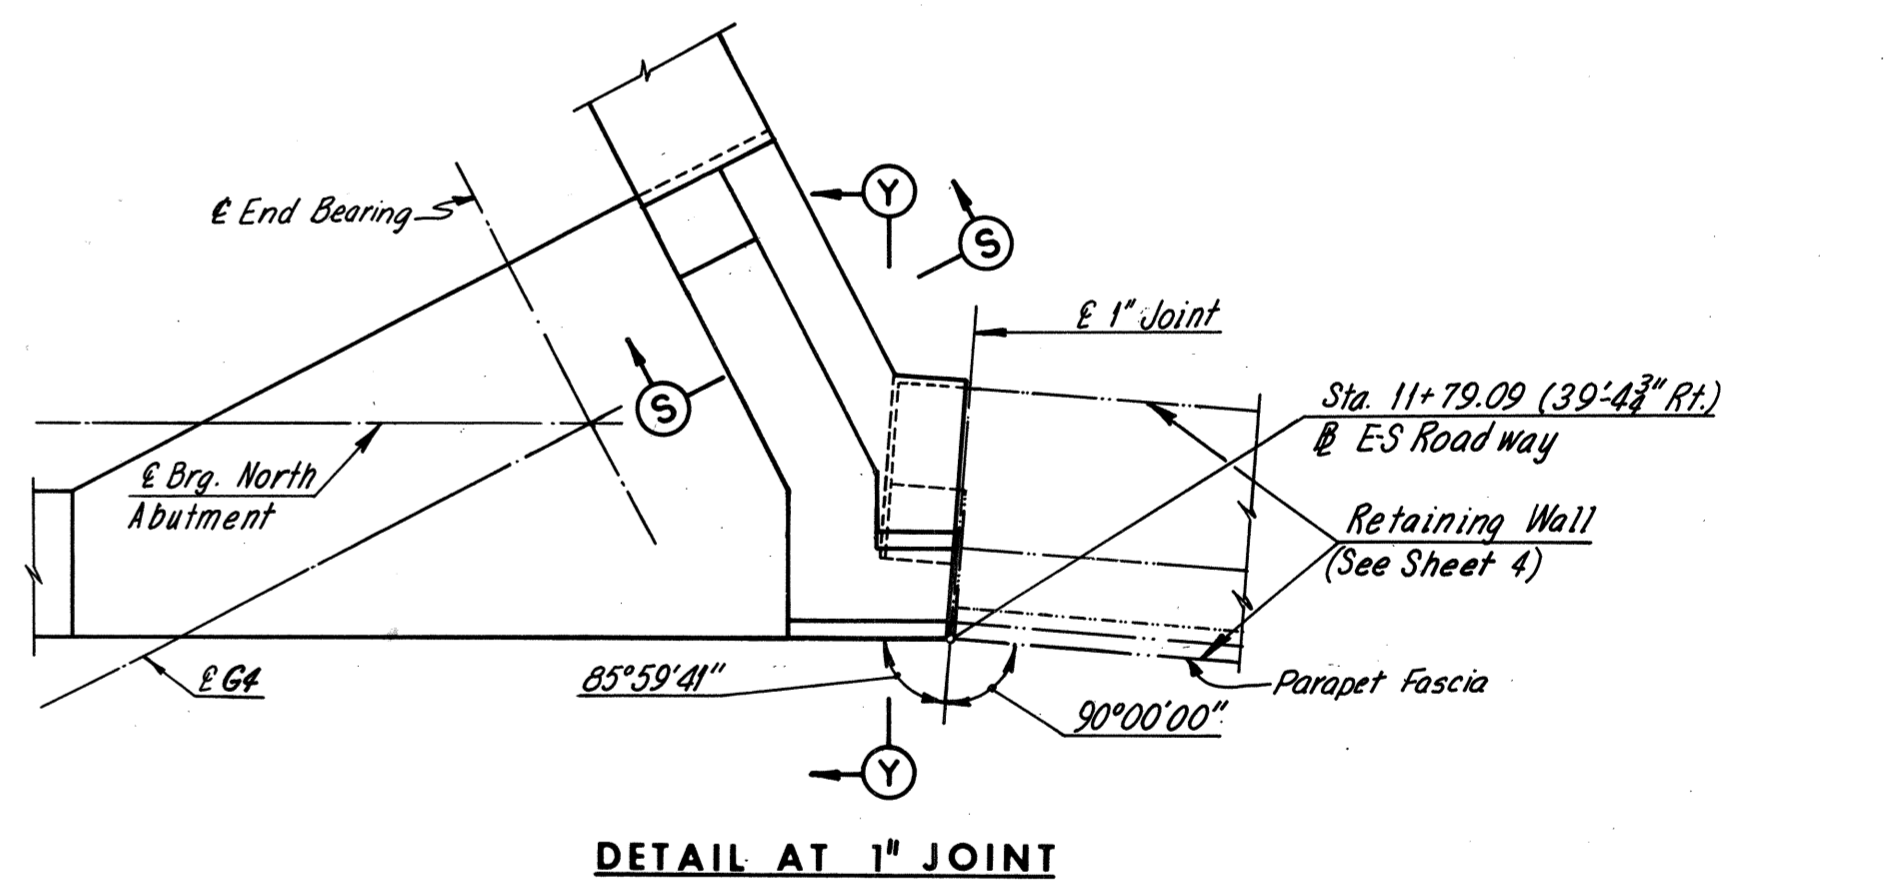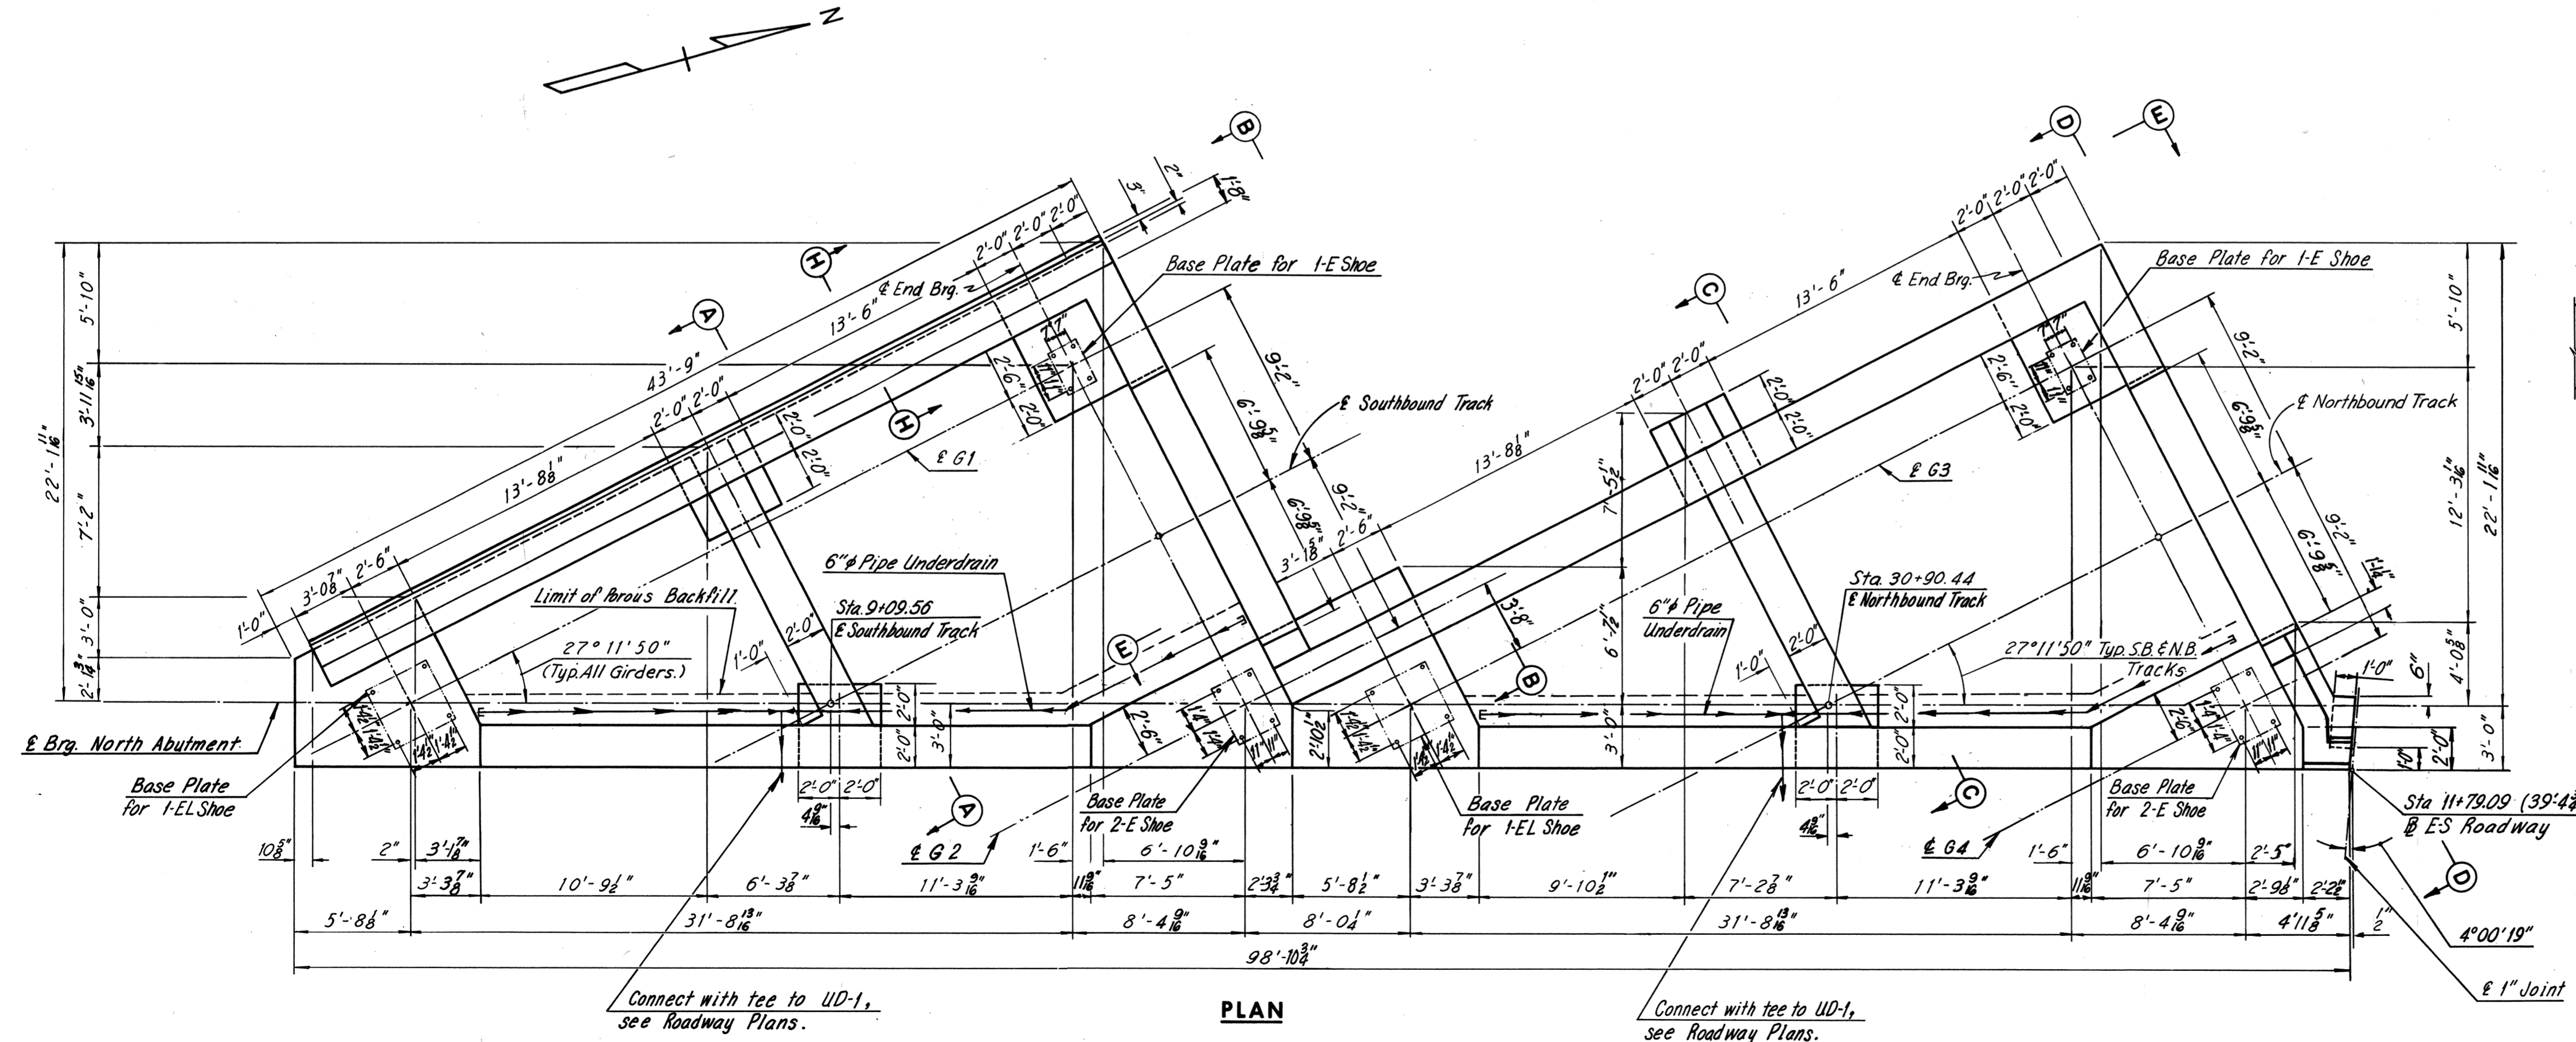

AS BUILT


Note:
 For Sections, see Sheet 3.
 Reinforcing to be shifted to miss underdrain going thru walls.

RICHMOND METROPOLITAN AUTHORITY
RICHMOND EXPRESSWAY SYSTEM
 BELTLINE EXPRESSWAY
 BRIDGE NO. 10
 R.F.&P.R. OVER
 EAST-SOUTH ROADWAY
 NORTH ABUTMENT

NO.	REVISION	BY	DATE
4	As Built	JRC	3-73
3	Wall Ftg. Elev.	J.G.V.	2-23-72
2	Profile Grade	P.S.	4-15-71
1	General Checking	AMH	5-17-68

HOWARD, NEEDLES, TAMMEN & BERGENDOFF consulting engineers NEW YORK ALEXANDRIA KANSAS CITY	SCALE: No Scale CONTRACT NO: 4 SHEET NO. 2 OF 12
---	--
















RICHMOND EXPRESSWAY SYSTEM			
SECTION	PROJECT	SHEET NO.	TOTAL SHEETS
4	BELTLINE EXPRESSWAY	108	155

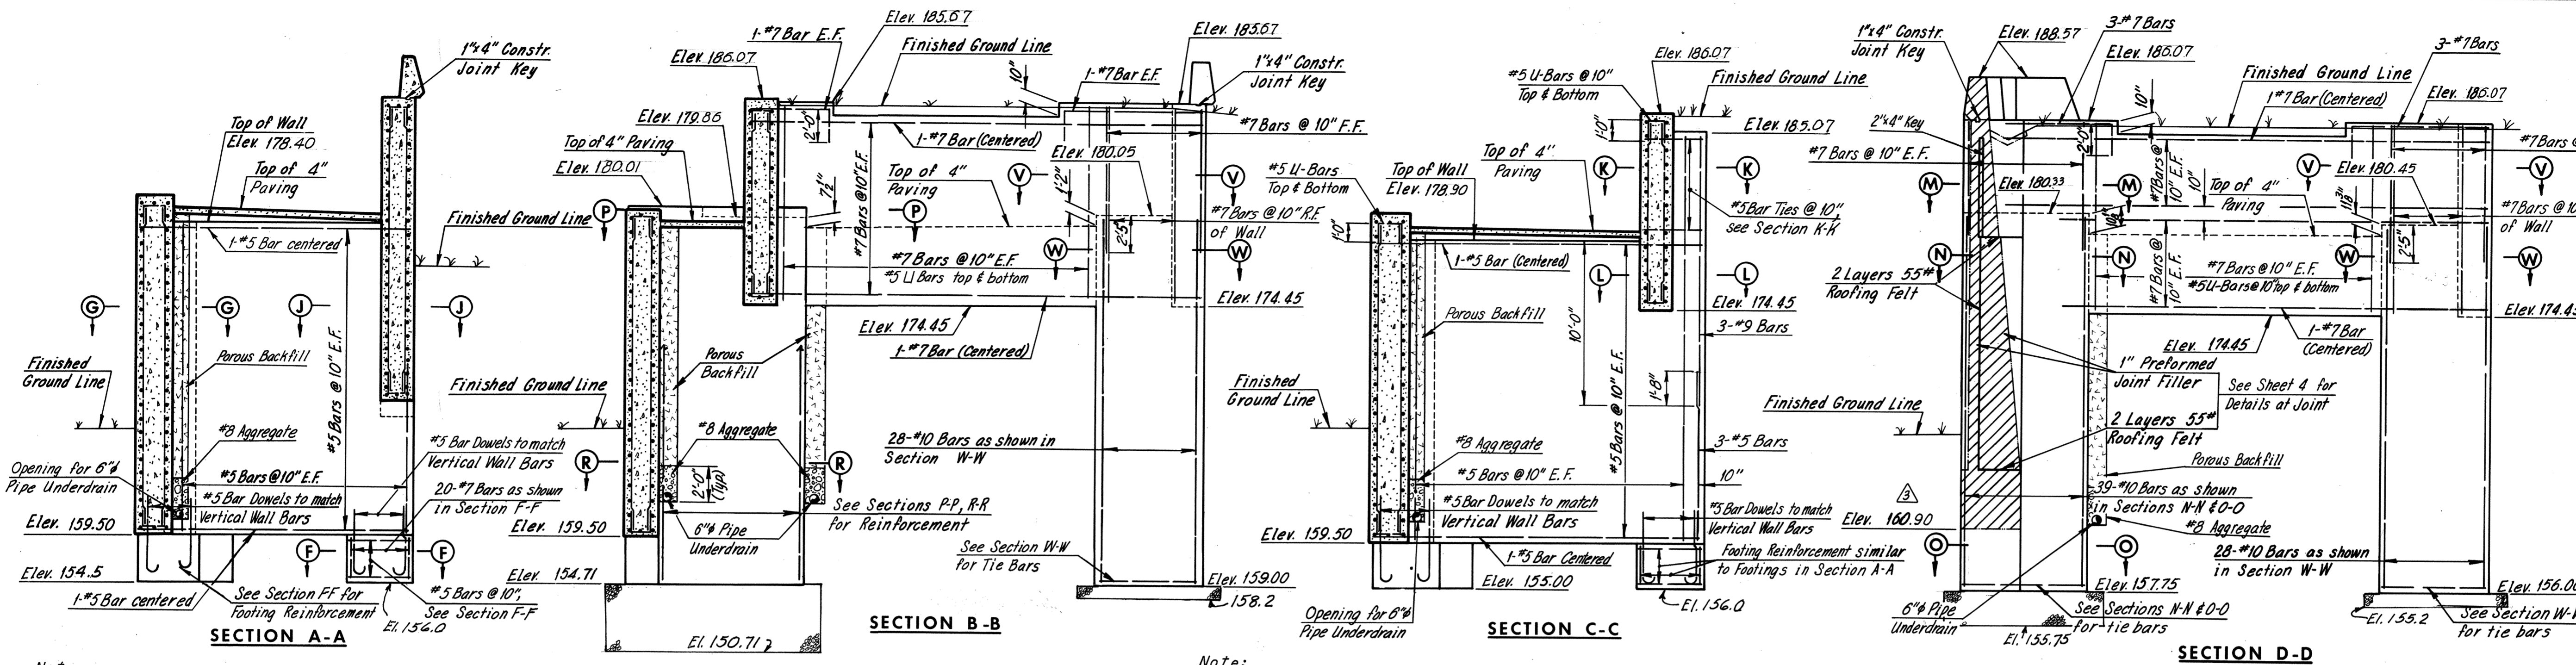

Note: #5 U-Bars to be placed @ 10" ctrs. between footings in Section A-A and Section C-C.

Note: Dampproofing to be applied between wall and porous backfill, from bottom of 4" concrete paving to bottom of wall.

Note: #4 Bars @ 12" shown in Sections M-M, P-P, T-T, and W-W, are to be U-Shaped Bars with 1'-6" legs.

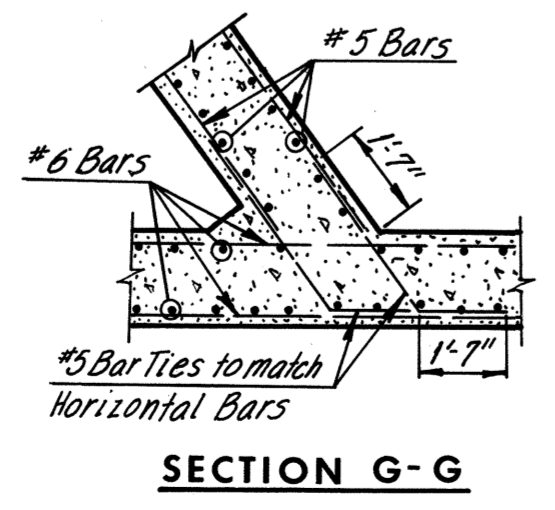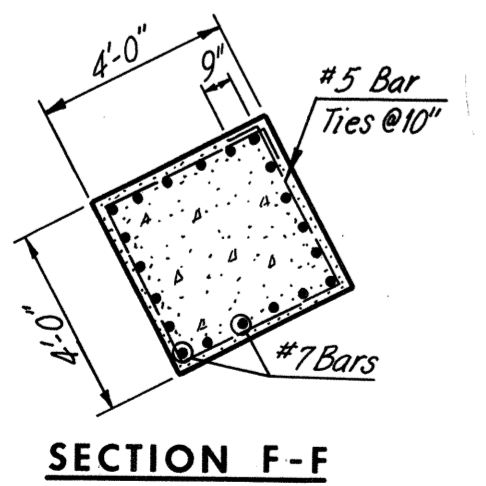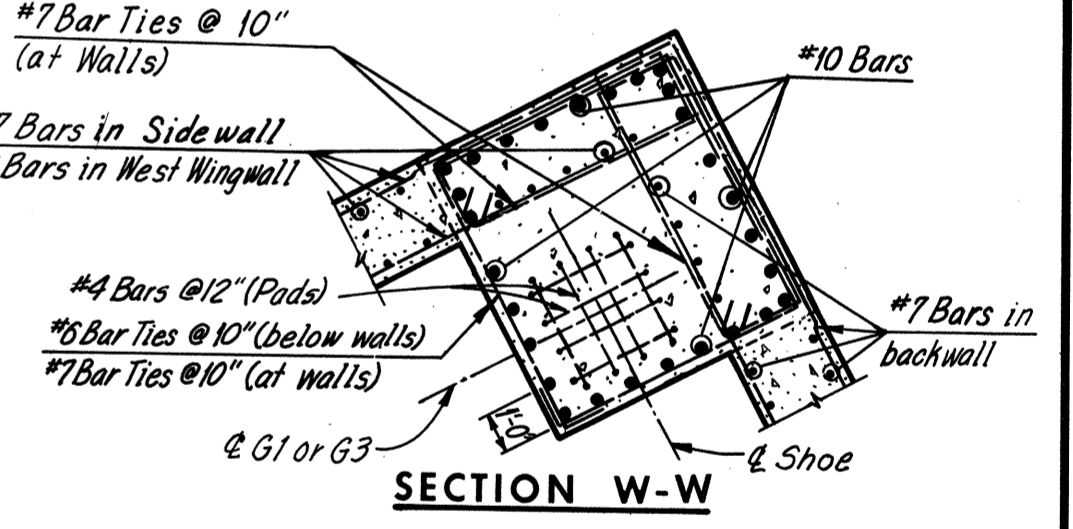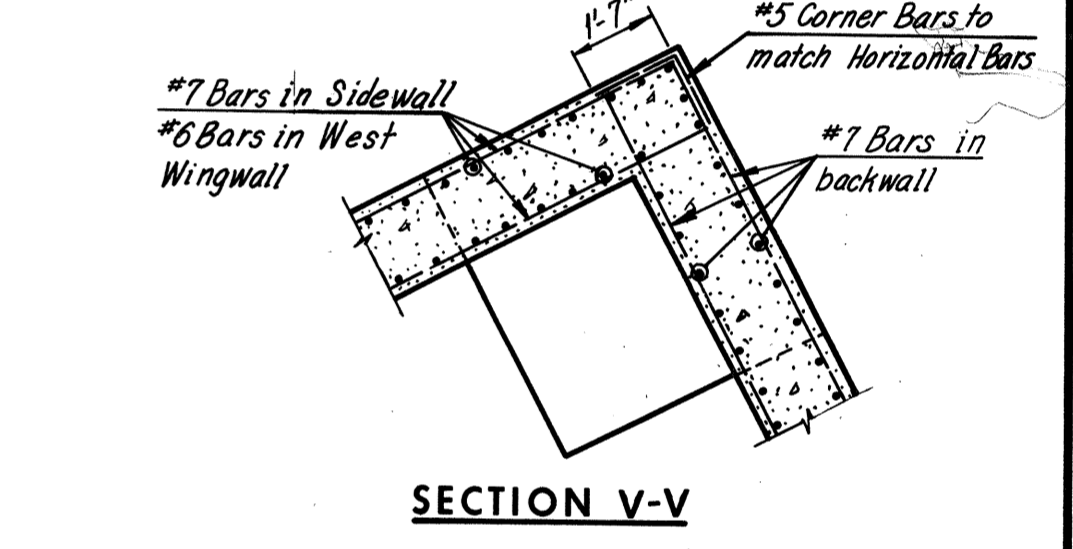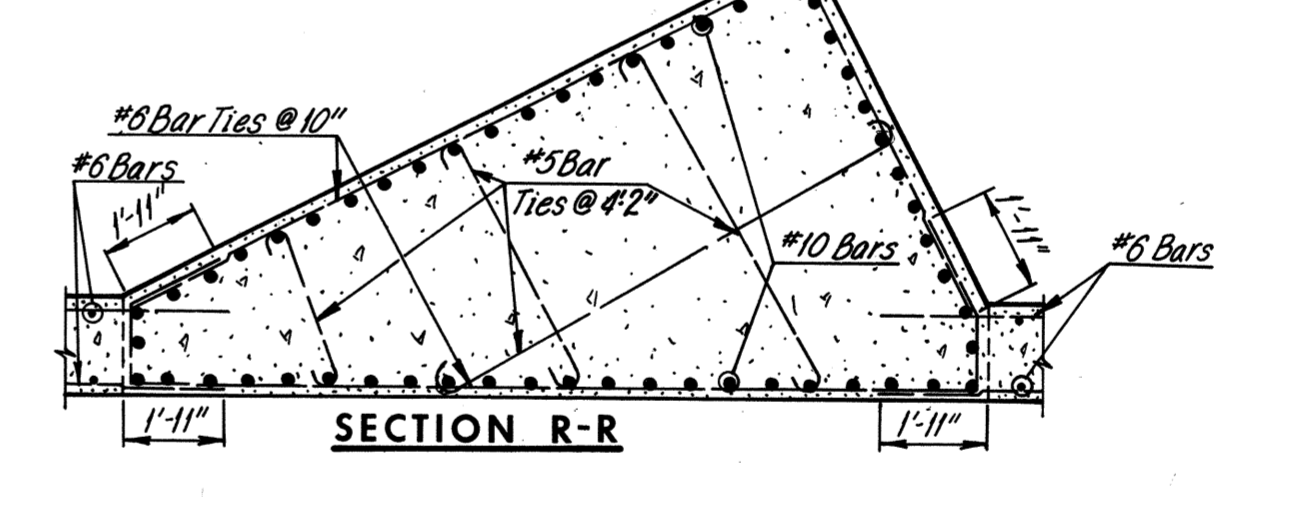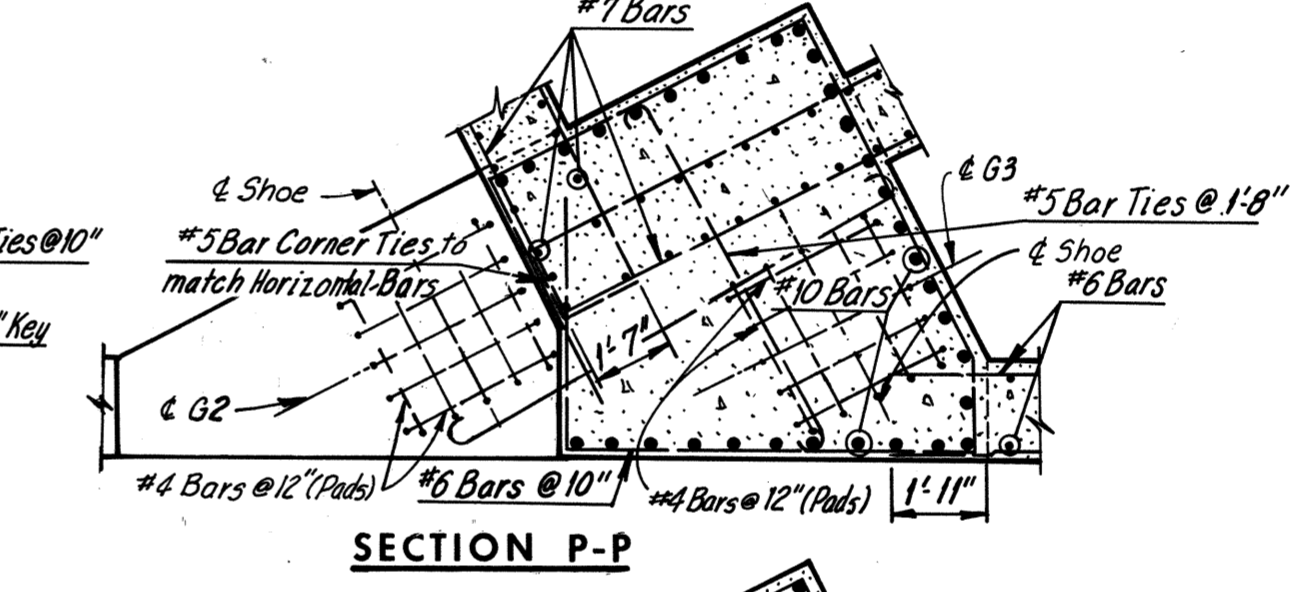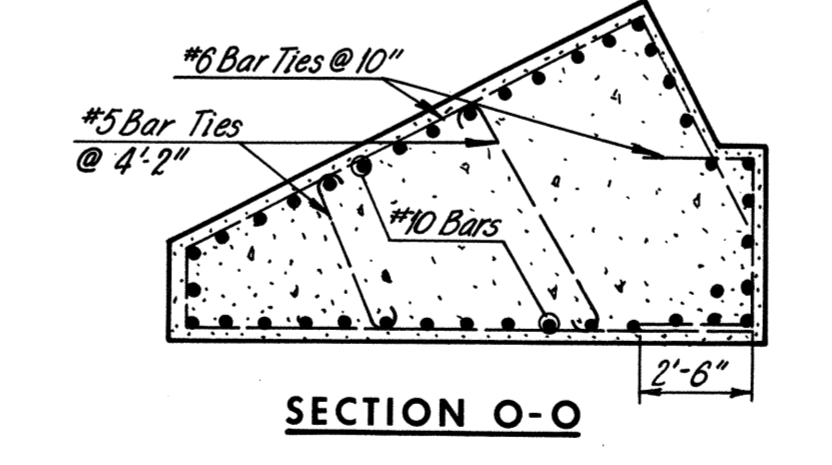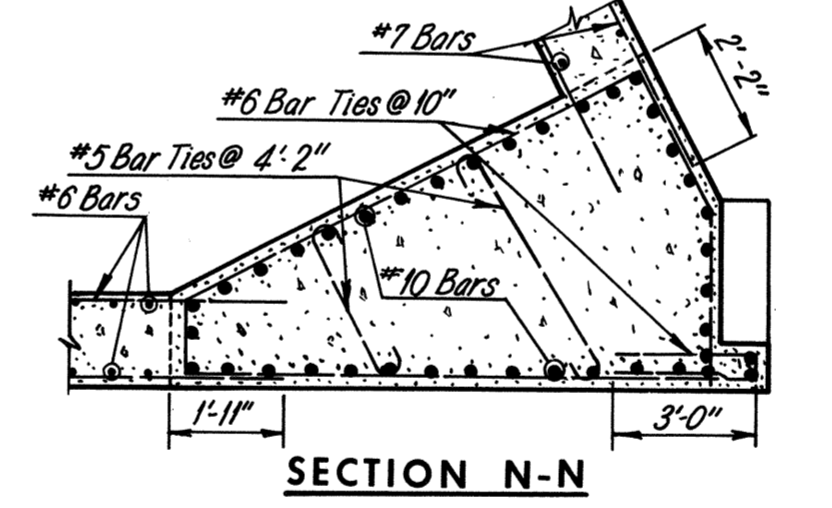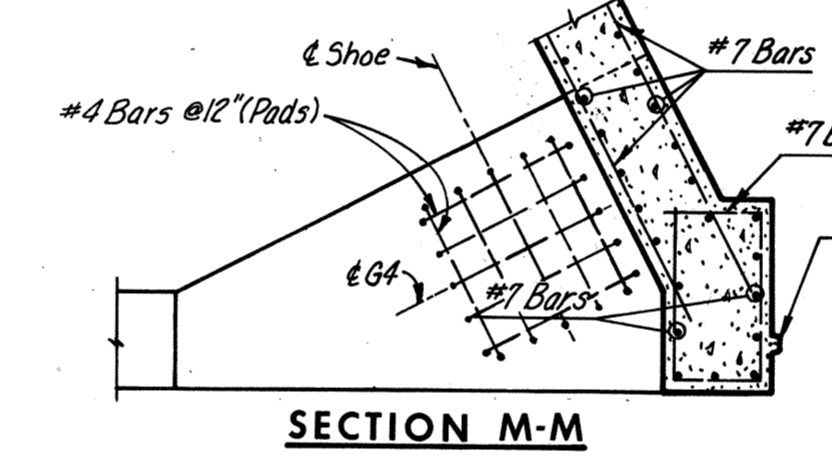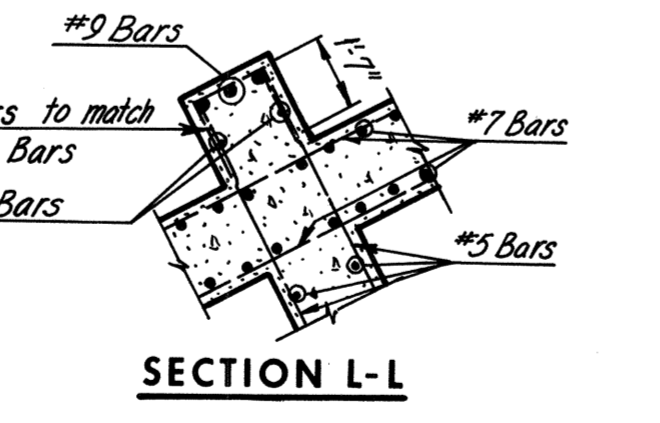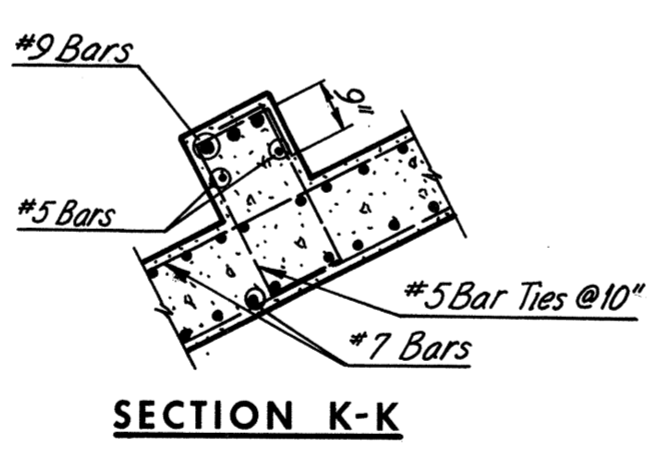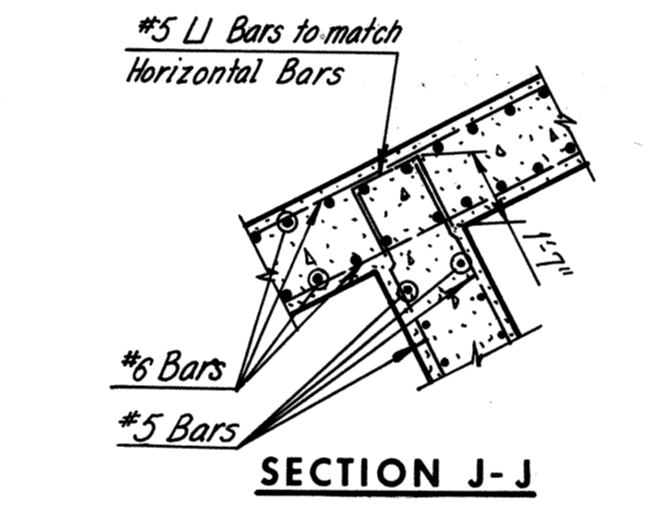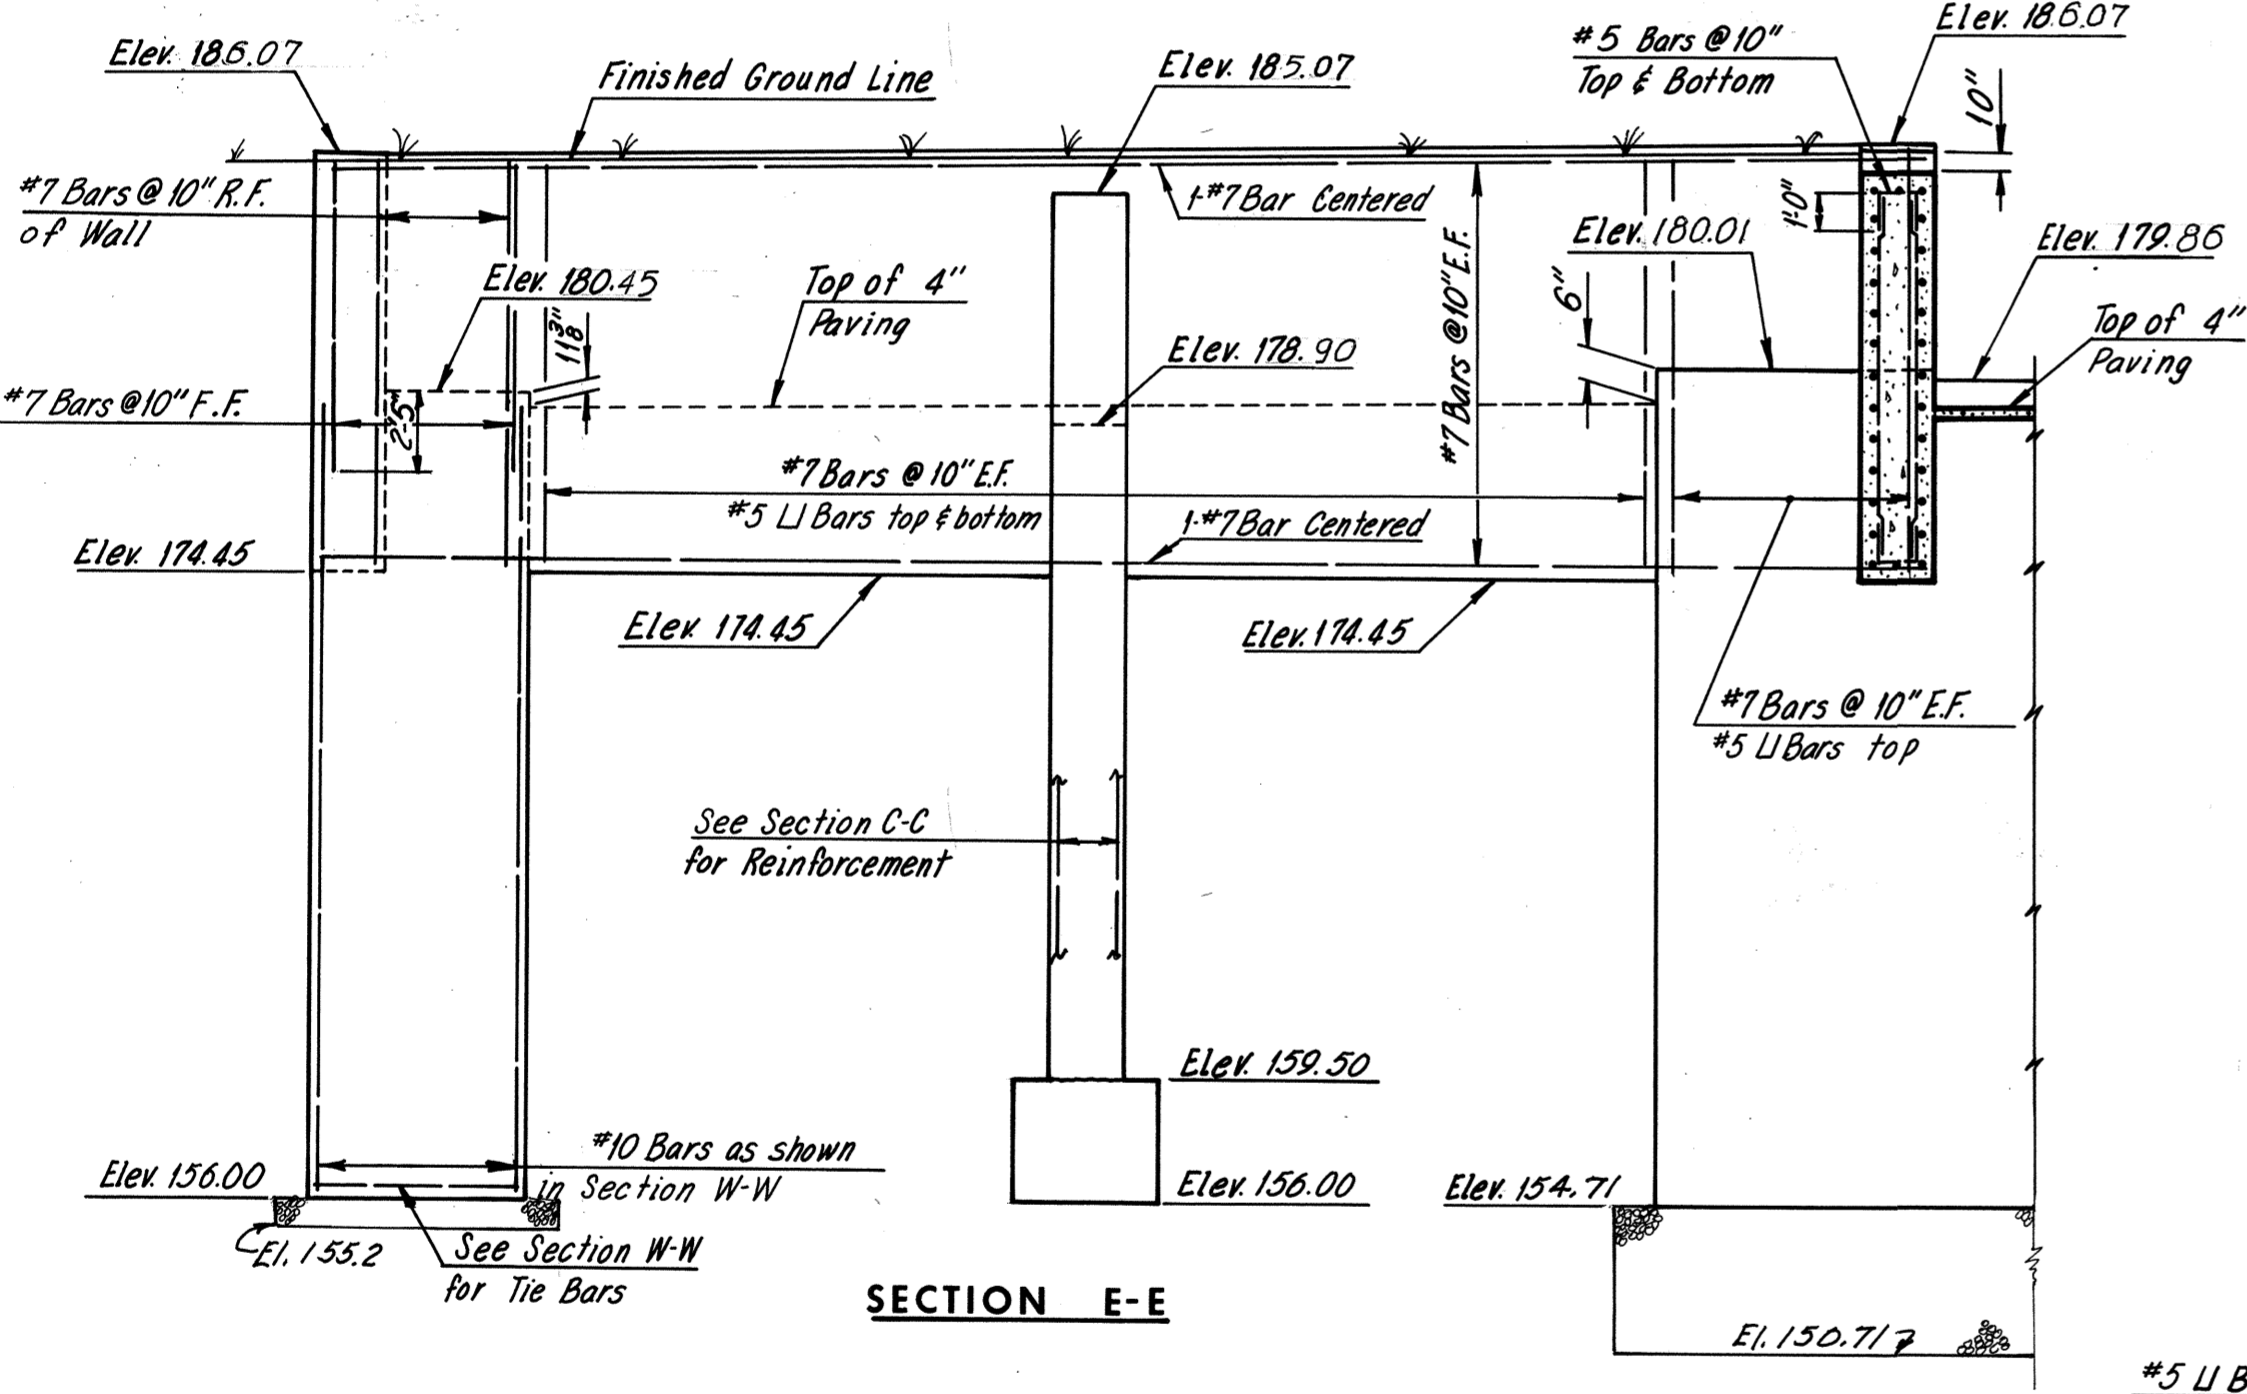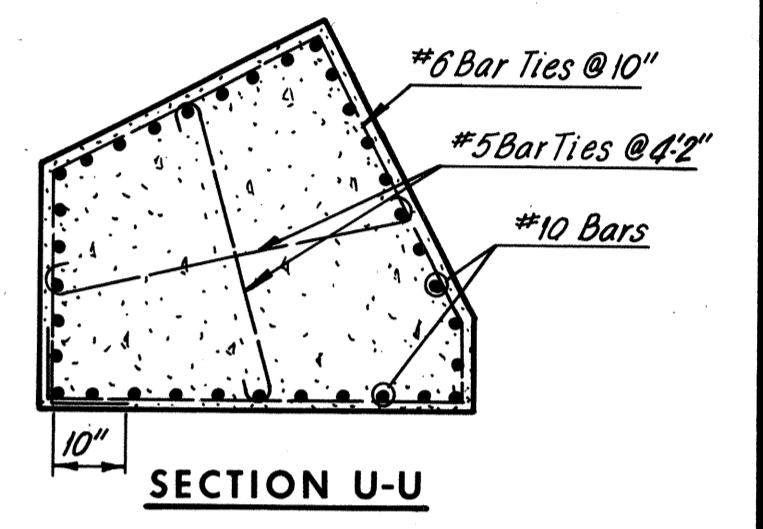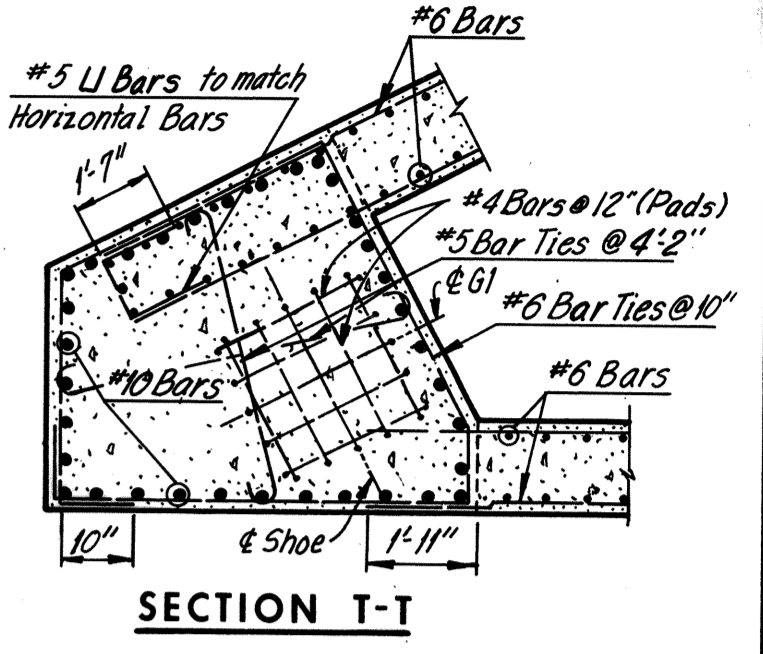

NO.	REVISION	BY	DATE
1	As Built	JRC	3-73
2	Wall Fig. Elev.	J.G.V.	2-23-72
3	Profile Grade	P.S.	4-15-71
4	General Checking	AMH	5-13-68

Notes:
 Paving shown within limits of abutment shall be 4" thick.
 2" preformed joint filler, sealed with a 1" depth of hot applied joint sealer, shall be installed between paving and abutment walls.
 Preformed joint filler shall be bituminous type conforming to AASHTO M213.
 Paving will be paid for as "Concrete, Class A3, Substructures and Walls."
 For Location of sections A-A, B-B, C-C, D-D, E-E, T-T and U-U, see Sheet 2.








AS BUILT

Legend:
 E.F. denotes Each Face
 F.F. denotes Front Face
 R.F. denotes Rear Face

RICHMOND METROPOLITAN AUTHORITY
RICHMOND EXPRESSWAY SYSTEM
BELTLINE EXPRESSWAY
BRIDGE NO. 10
R.F.&P.R. OVER
EAST-SOUTH ROADWAY
NORTH ABUTMENT DETAILS

HOWARD, NEEDLES & BERGENDOFF
 consulting engineers
 NEW YORK ALEXANDRIA KANSAS CITY

SCALE: No Scale
 CONTRACT NO. 4
 SHEET NO. 3 OF 12

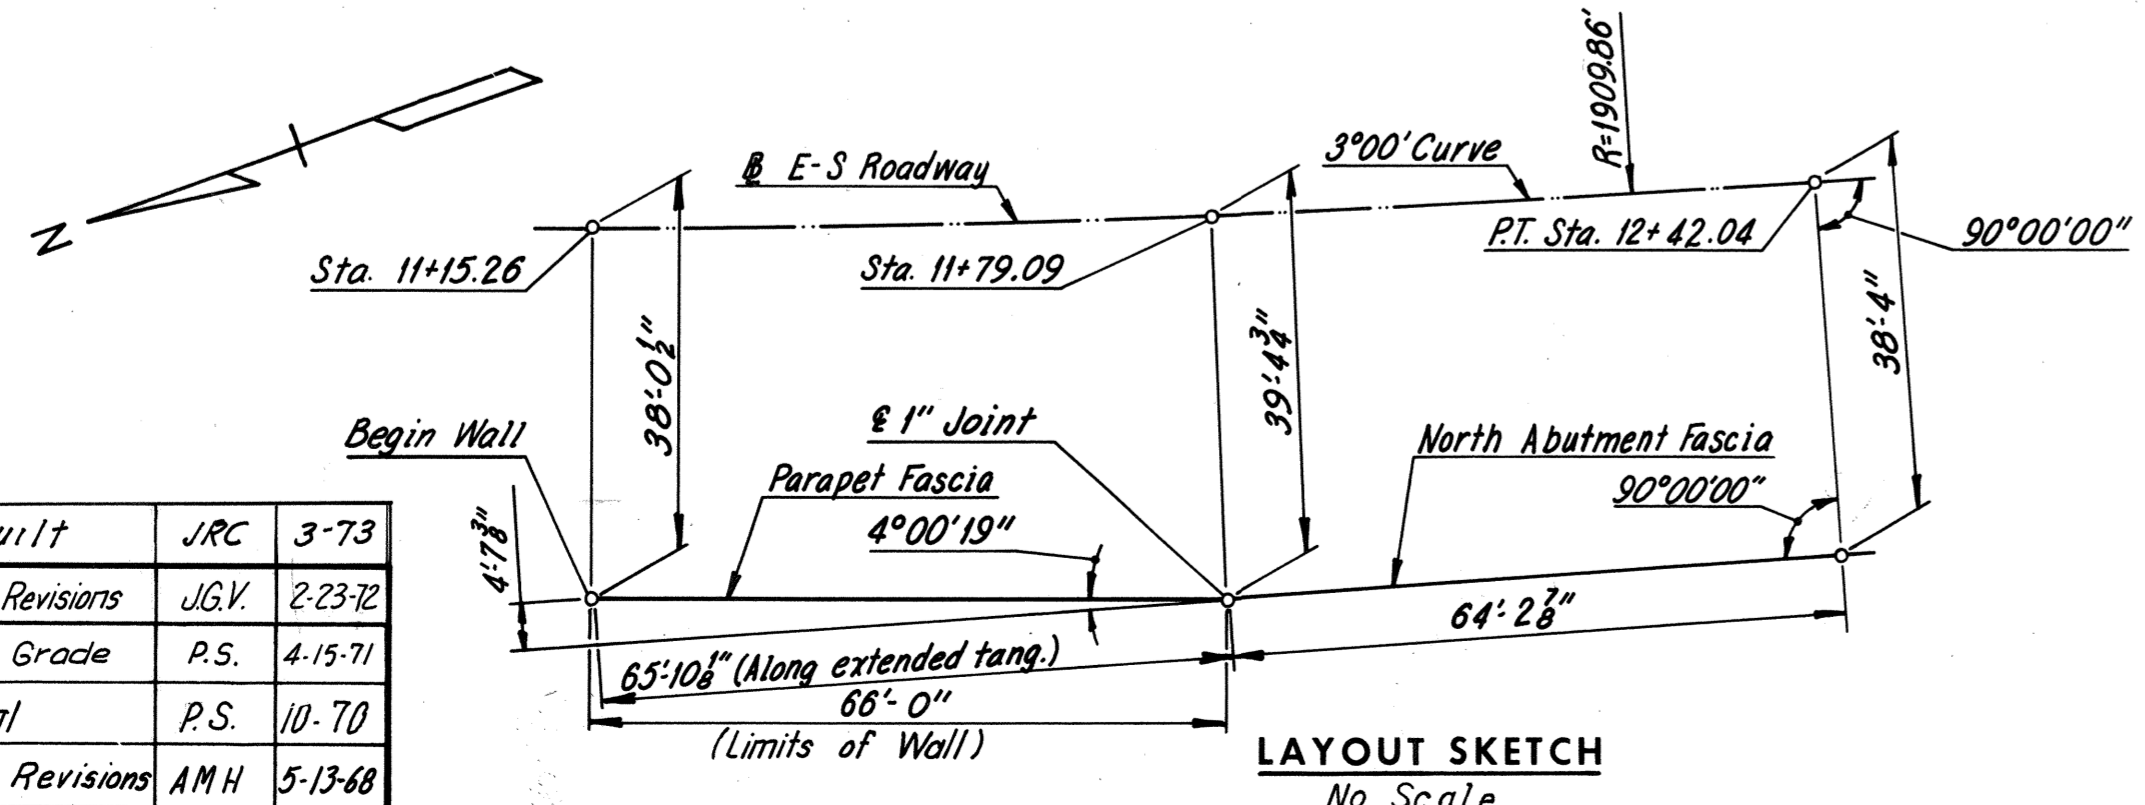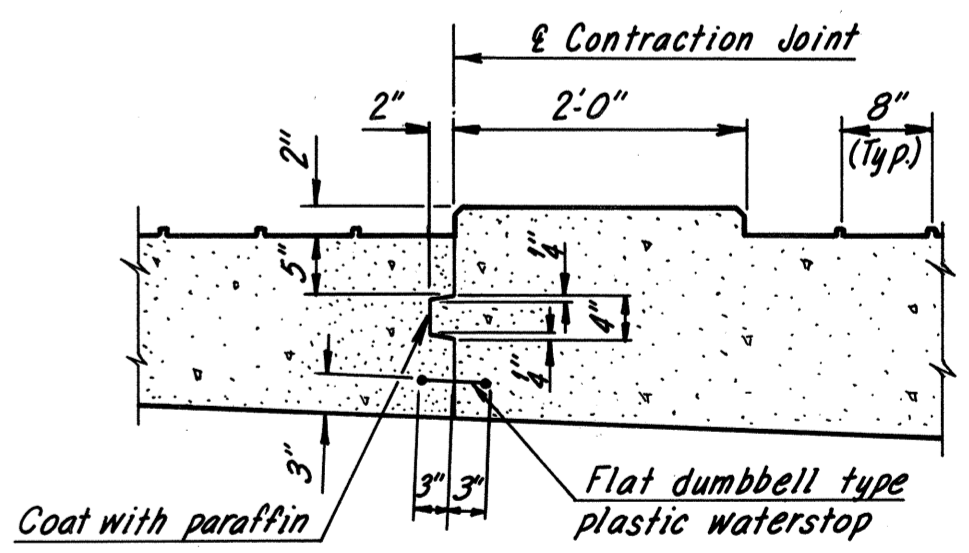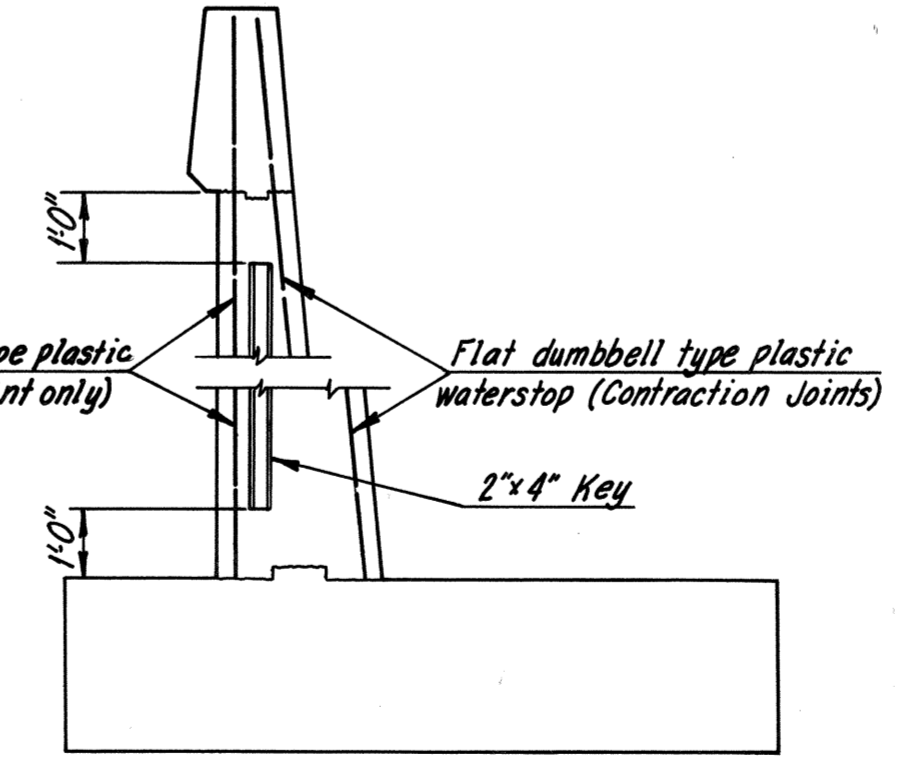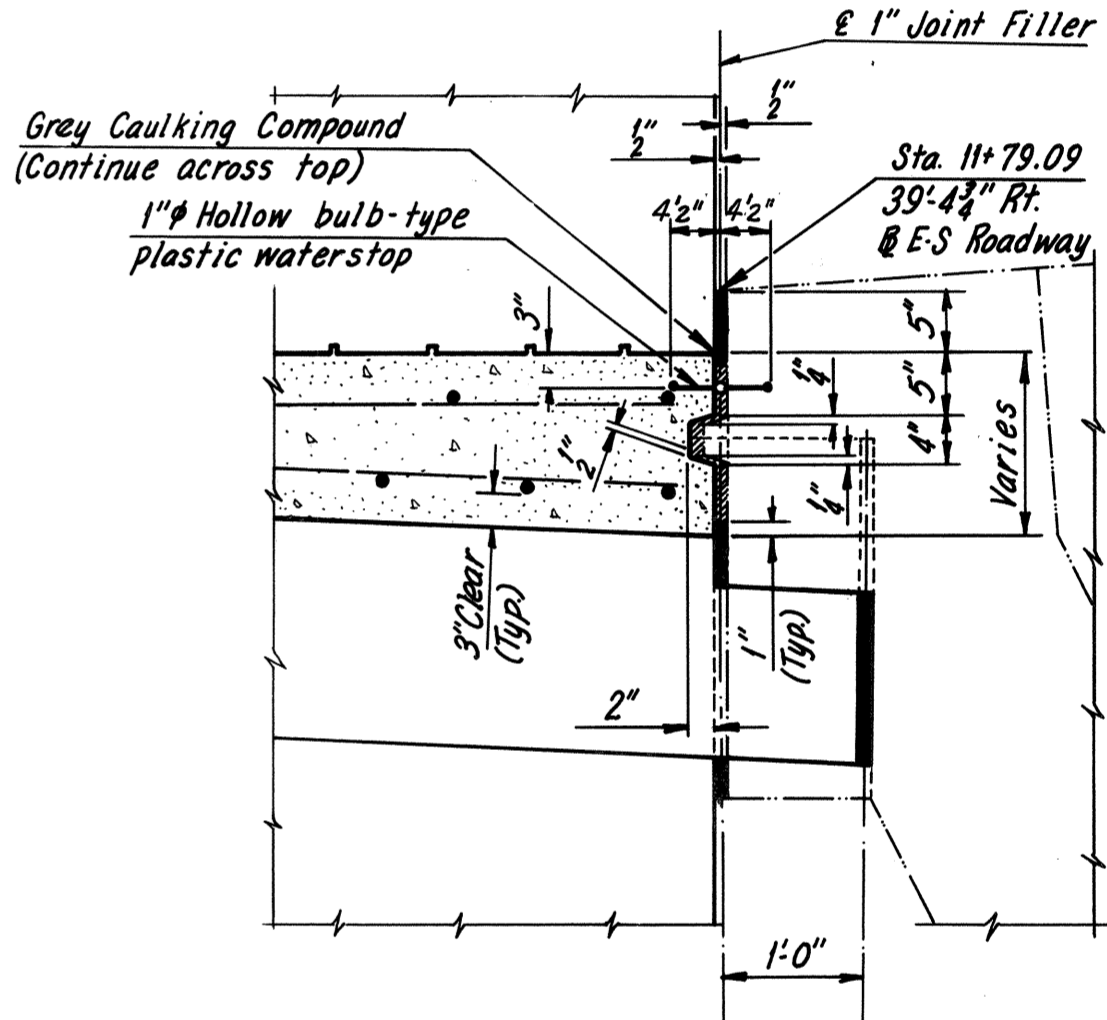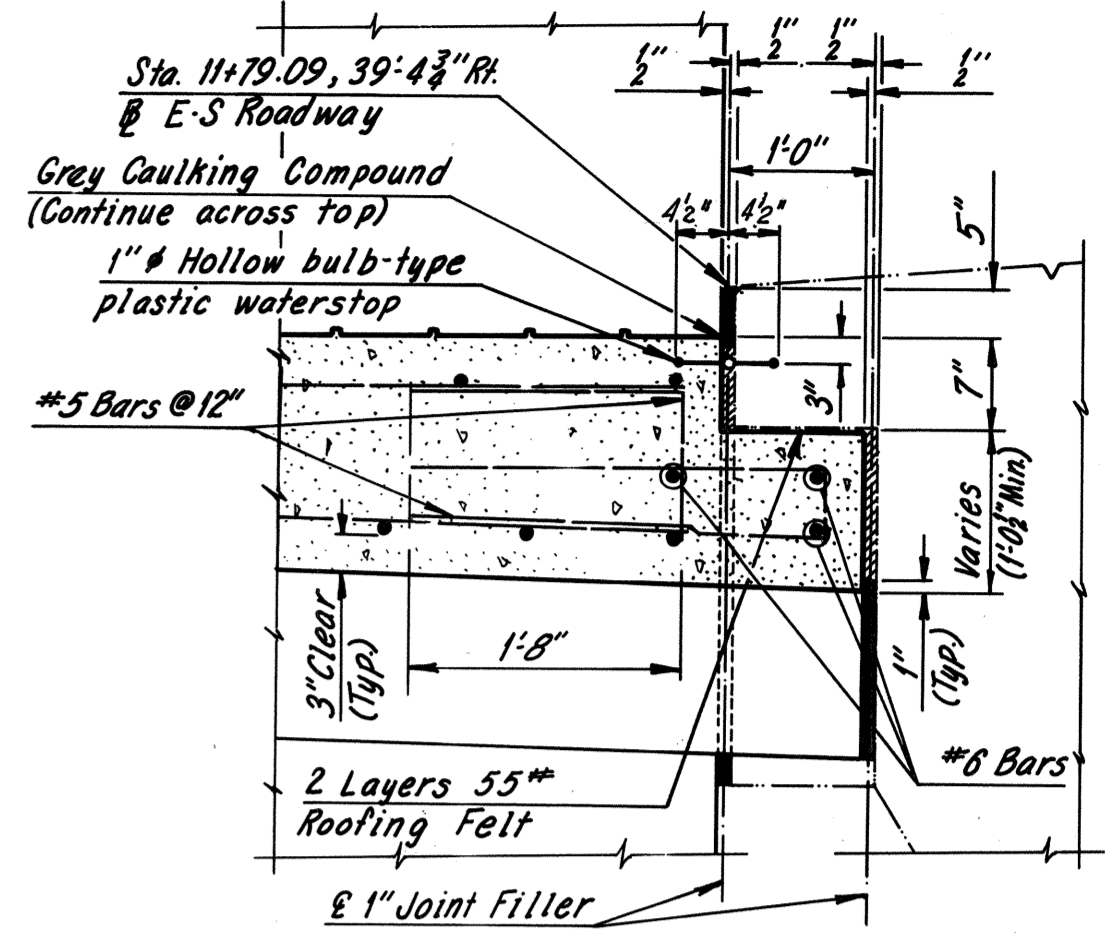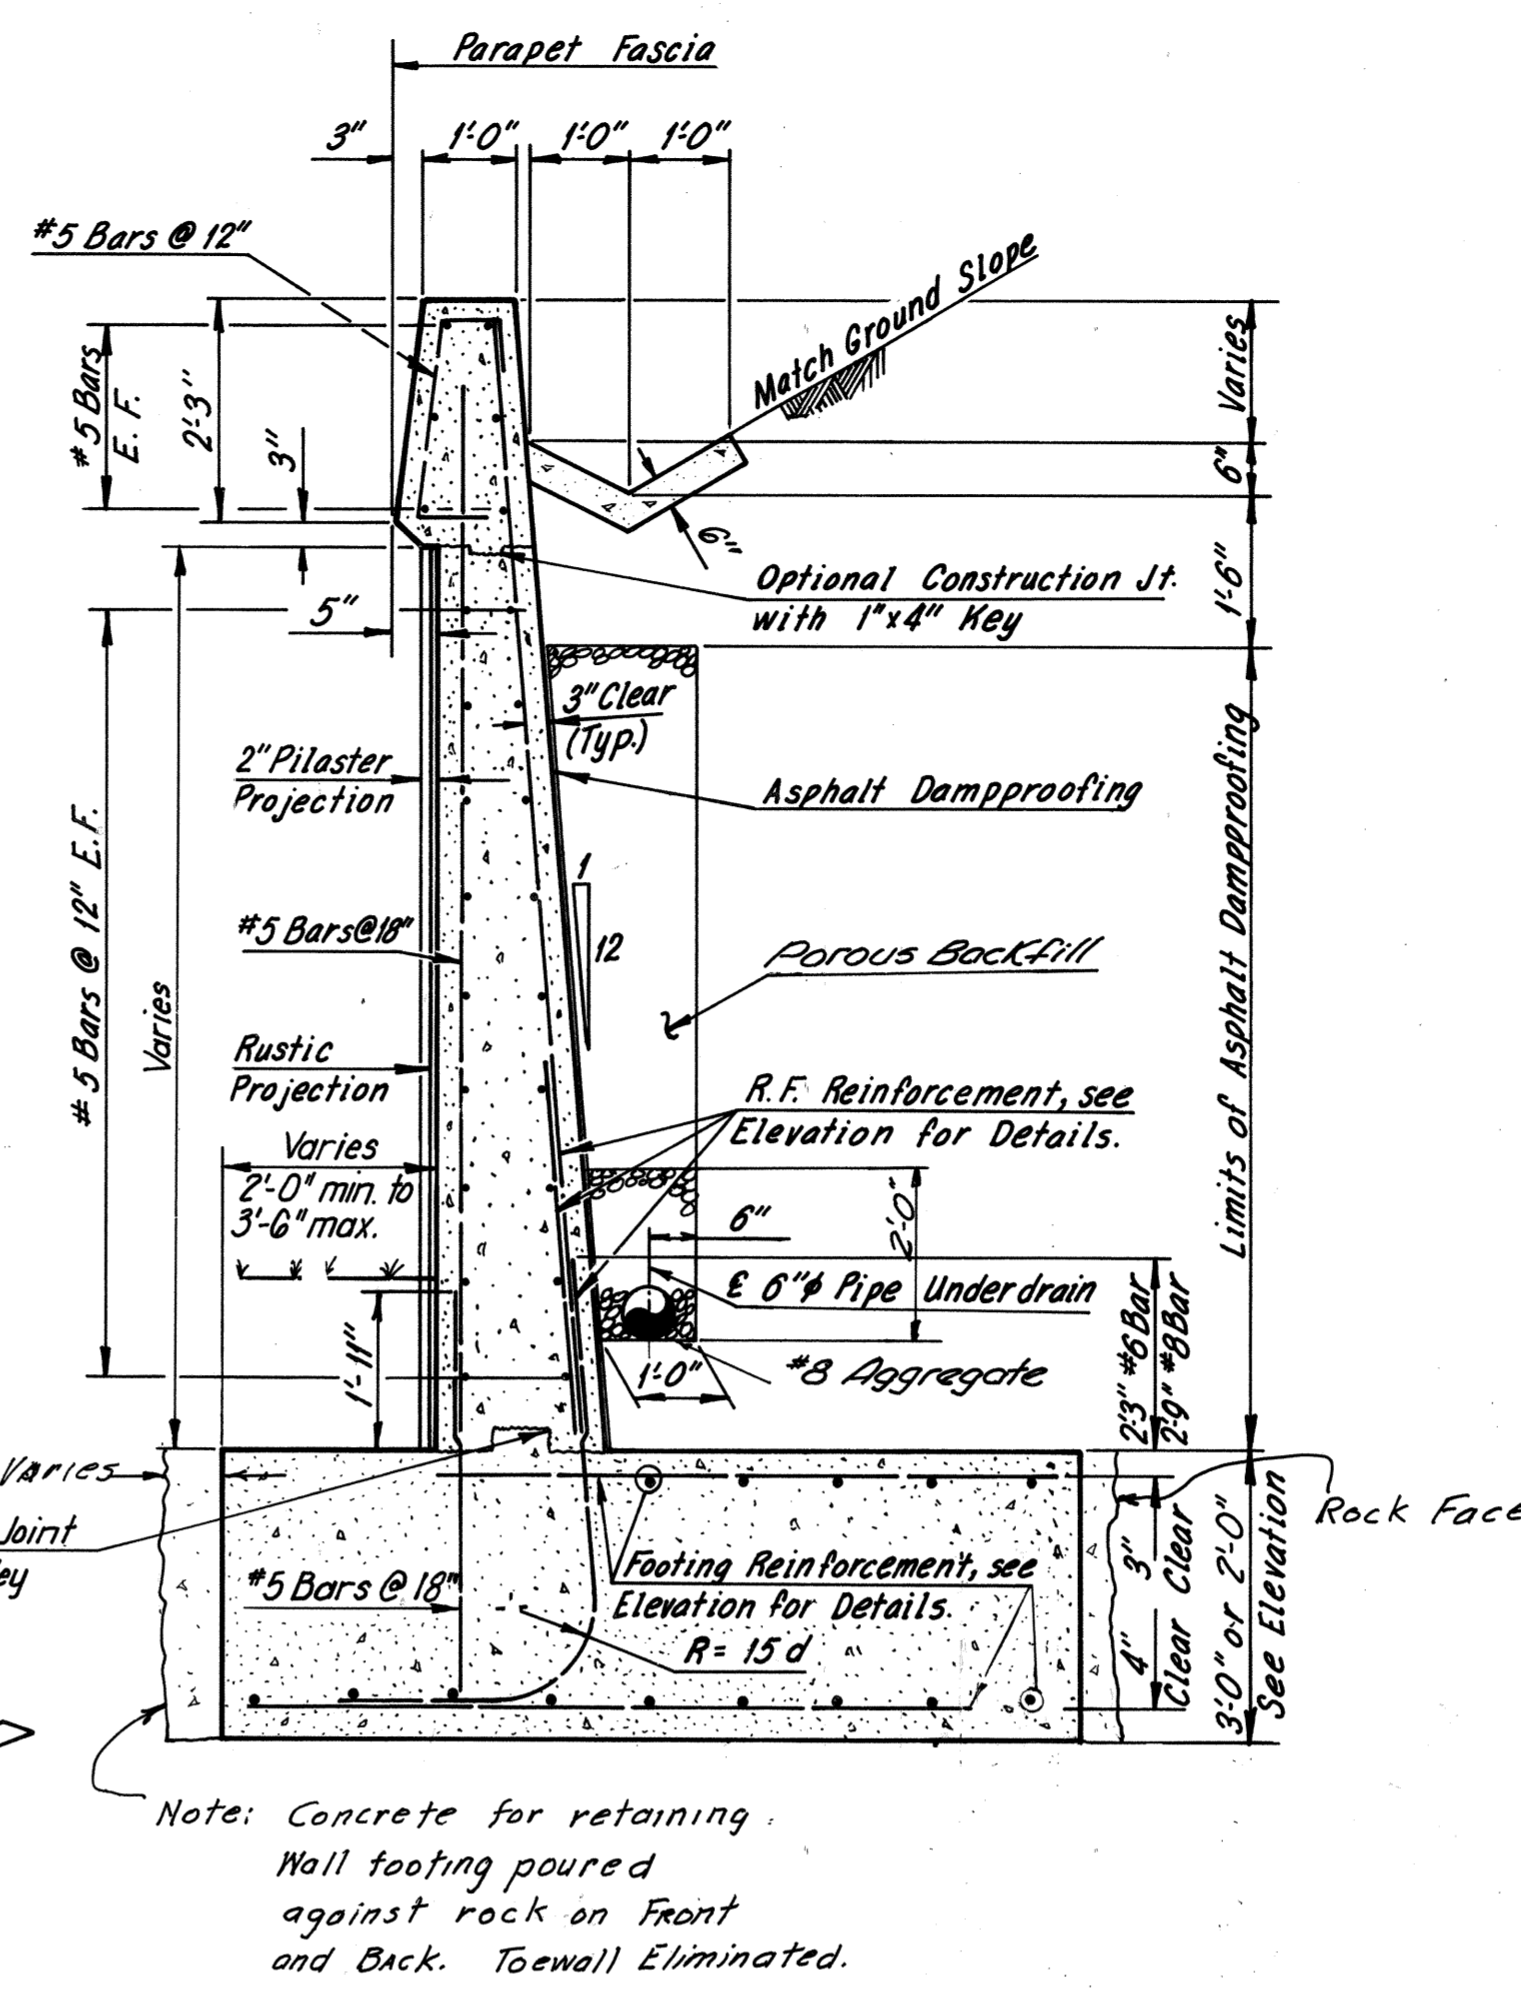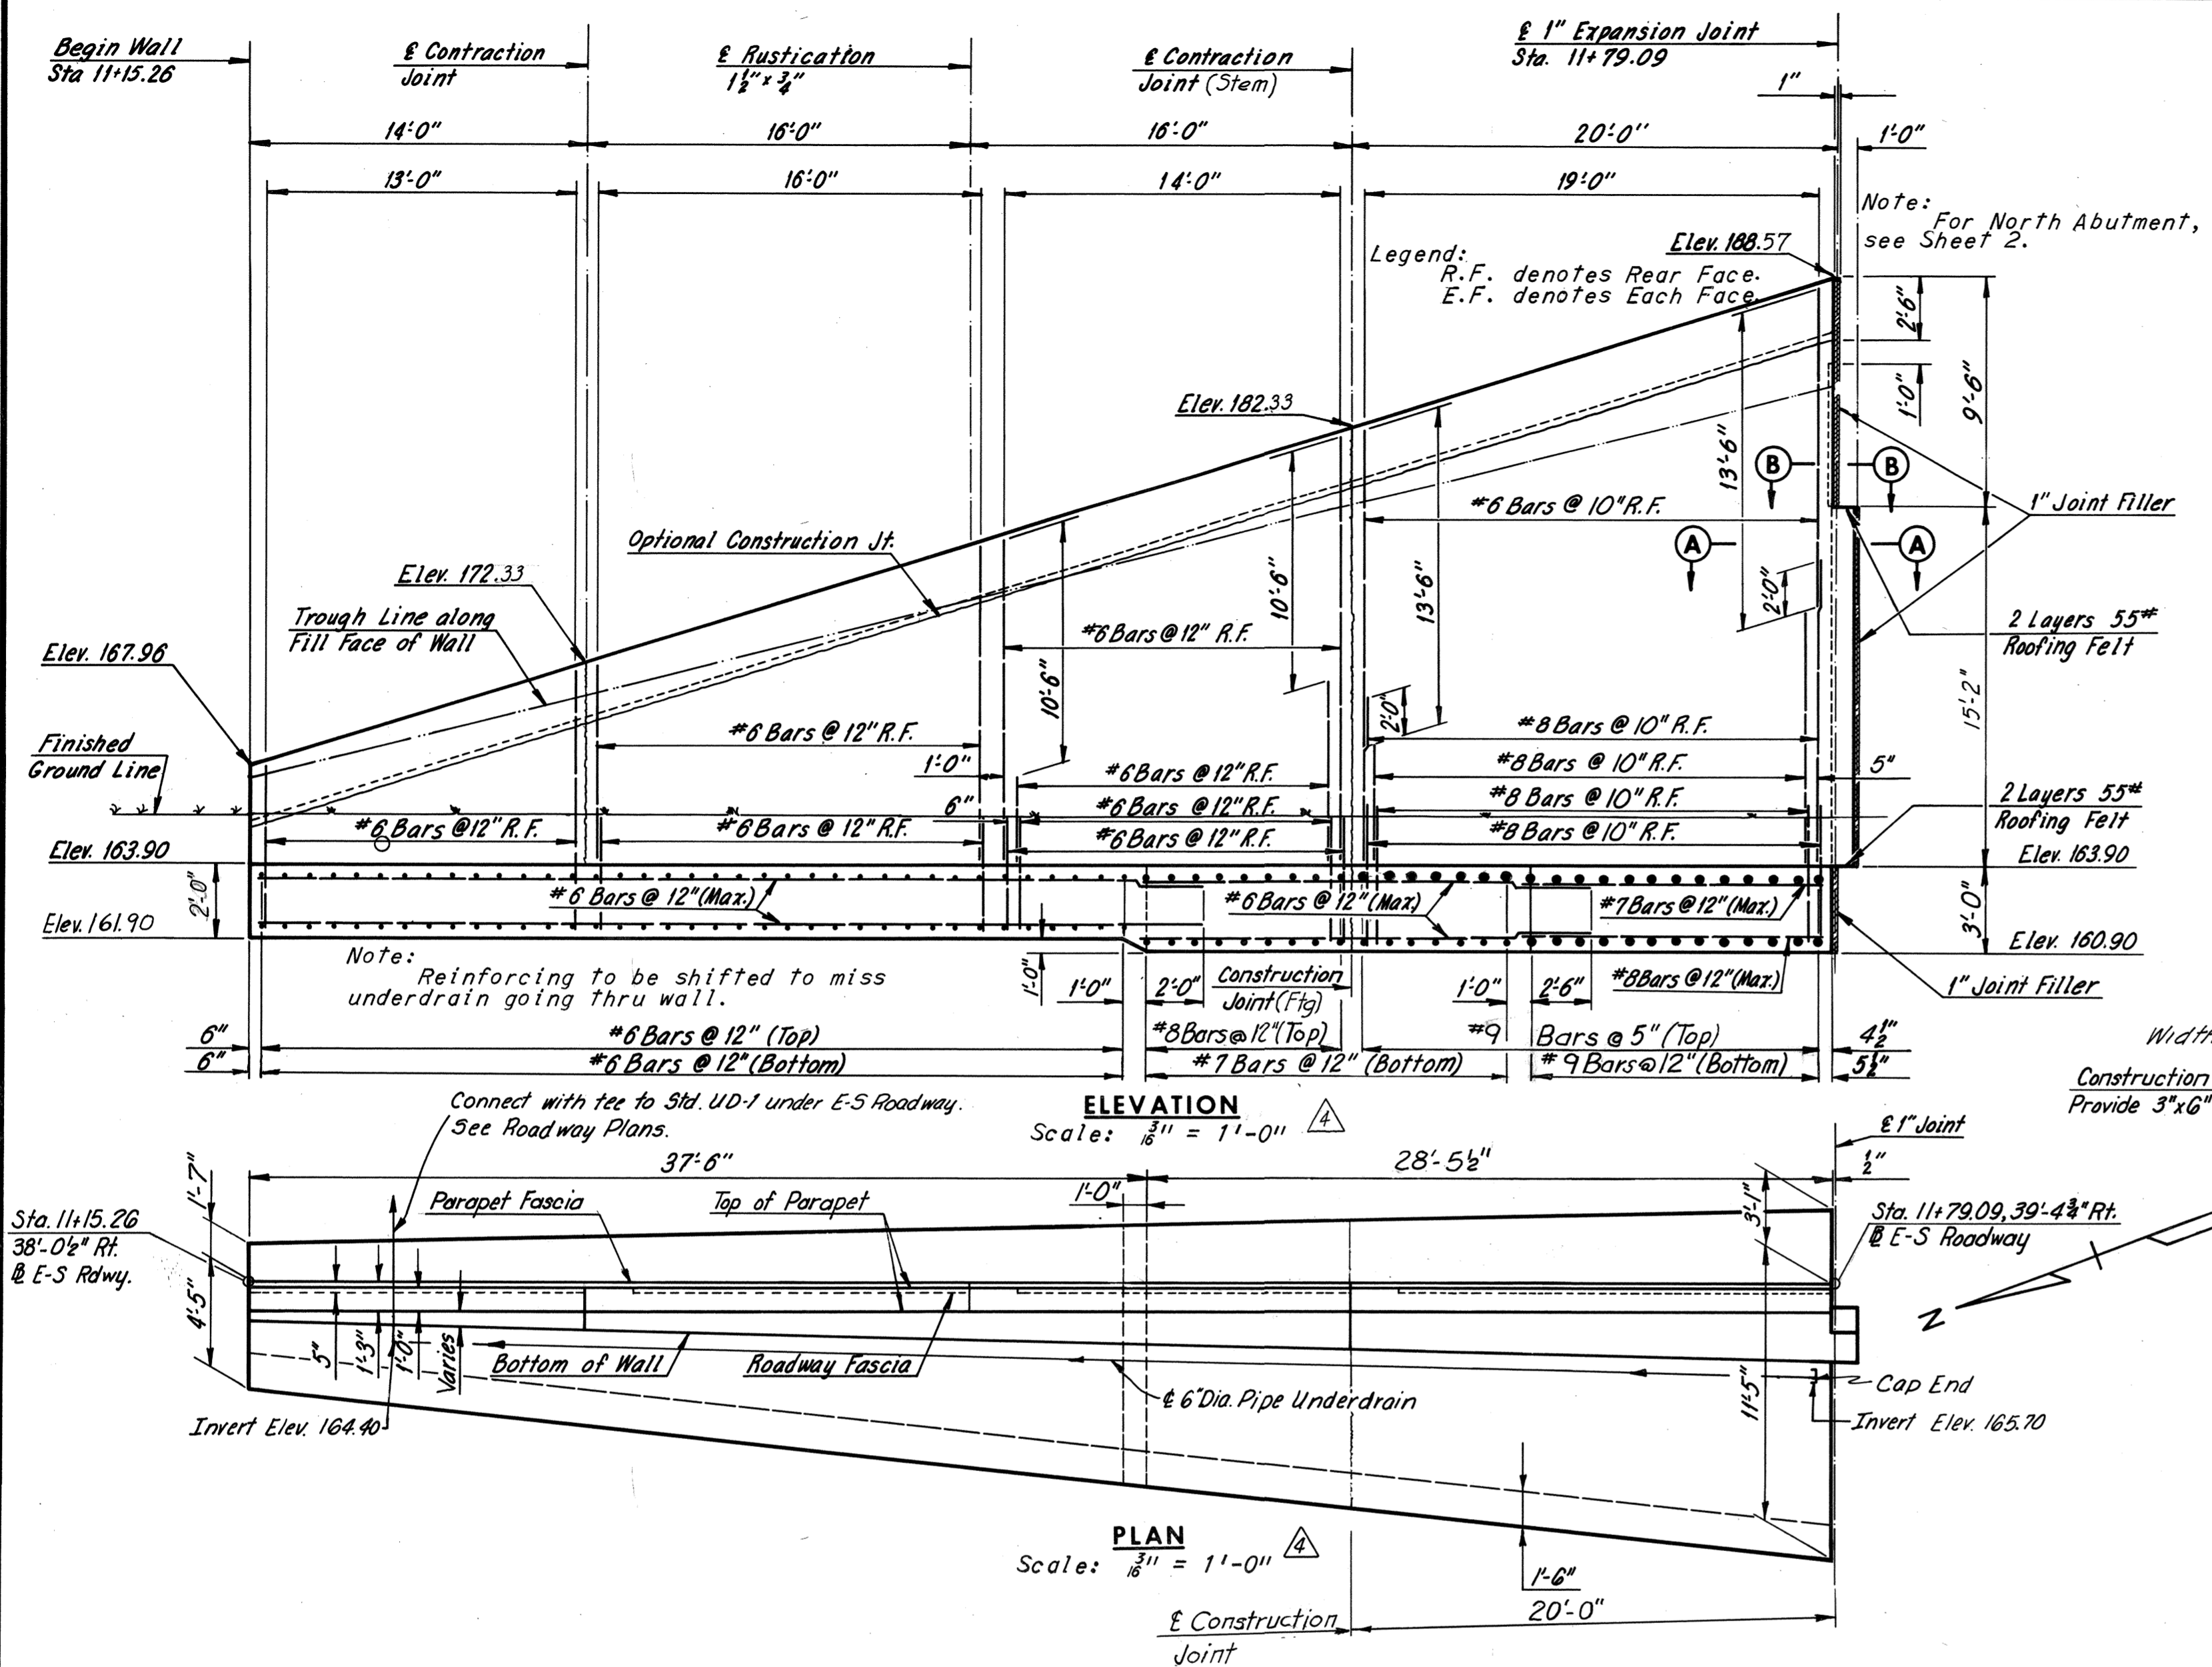

NO.	REVISION	BY	DATE
5	As Built	JRC	3-73
4	Footing Revisions	J.G.V.	2-23-72
3	Profile Grade	P.S.	4-15-71
2	General	P.S.	10-70
1	General Revisions	AMH	5-13-68

AS BUILT





RICHMOND METROPOLITAN AUTHORITY
RICHMOND EXPRESSWAY SYSTEM
BELTLINE EXPRESSWAY

BRIDGE NO. 10
R.F.&P.R.R. OVER
EAST-SOUTH ROADWAY
NORTH ABUTMENT RETAINING WALL

HOWARD, NEEDLES, TAMMEN & BERGENDOFF
consulting engineers
NEW YORK ALEXANDRIA KANSAS CITY

SCALE: *As Noted*
CONTRACT NO.: 4
SHEET NO. 4 OF 12

RICHMOND EXPRESSWAY SYSTEM			
SECTION	PROJECT	SHEET NO.	TOTAL SHEETS
4	BELTLINE EXPRESSWAY	110	155

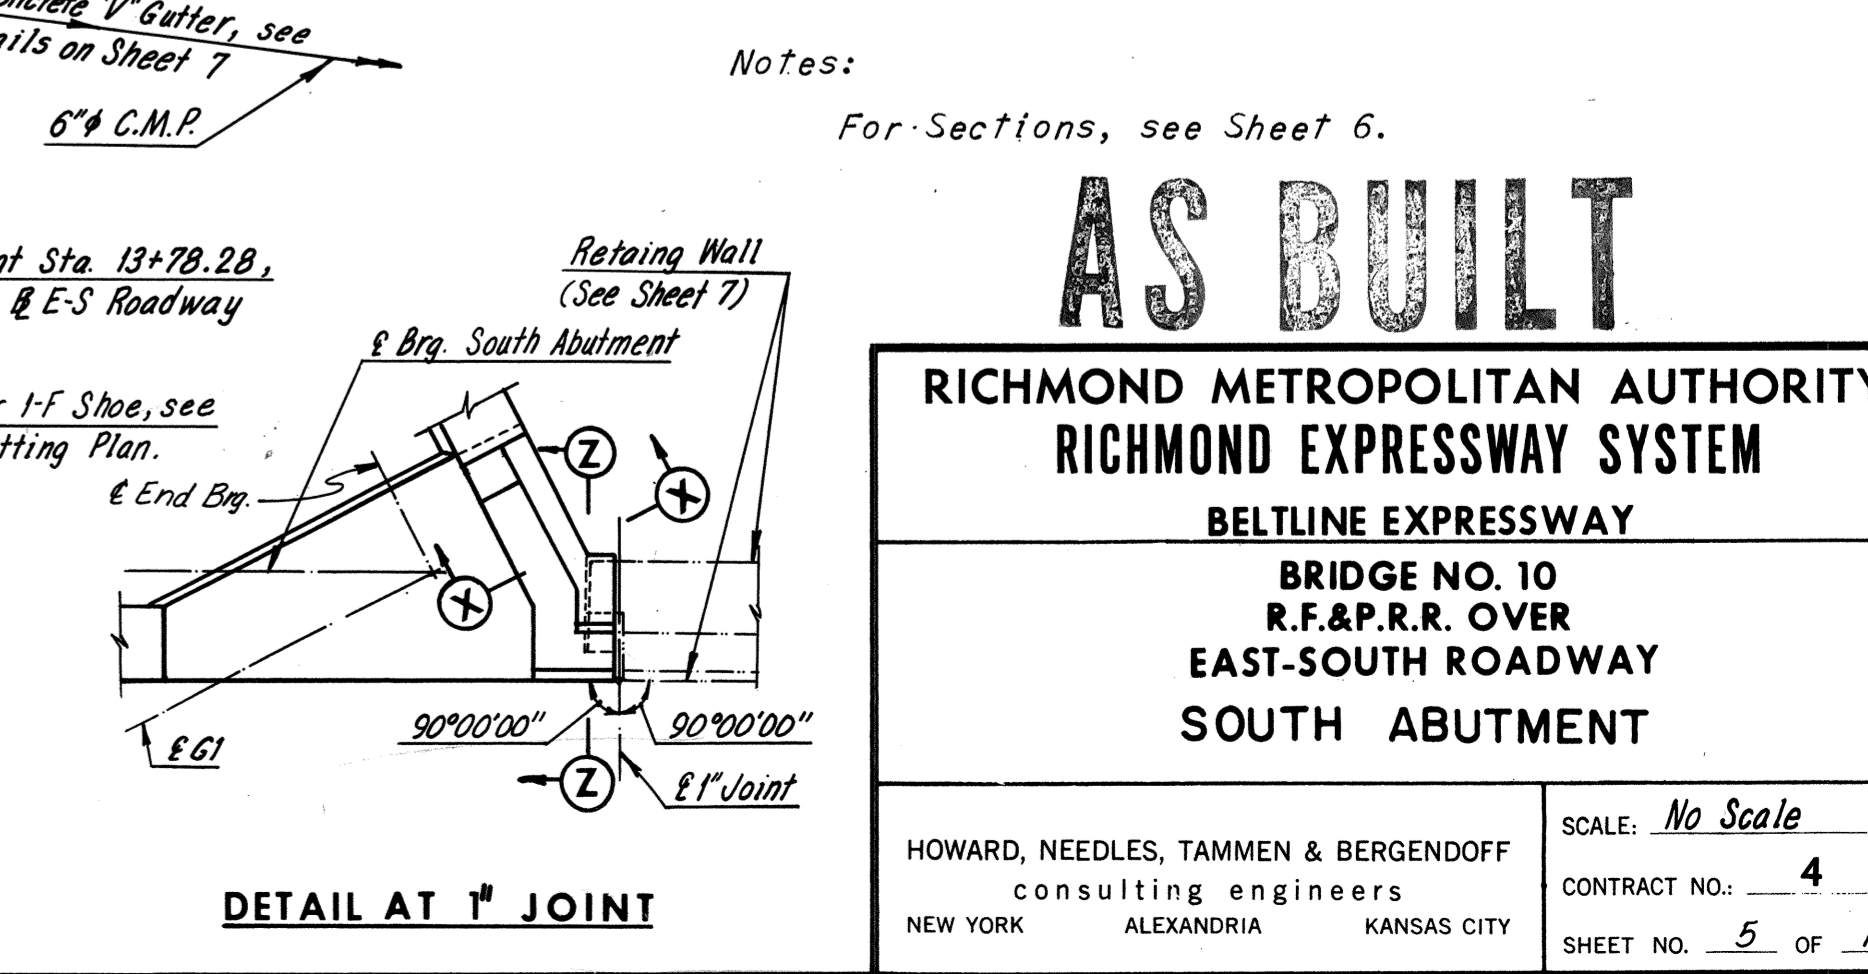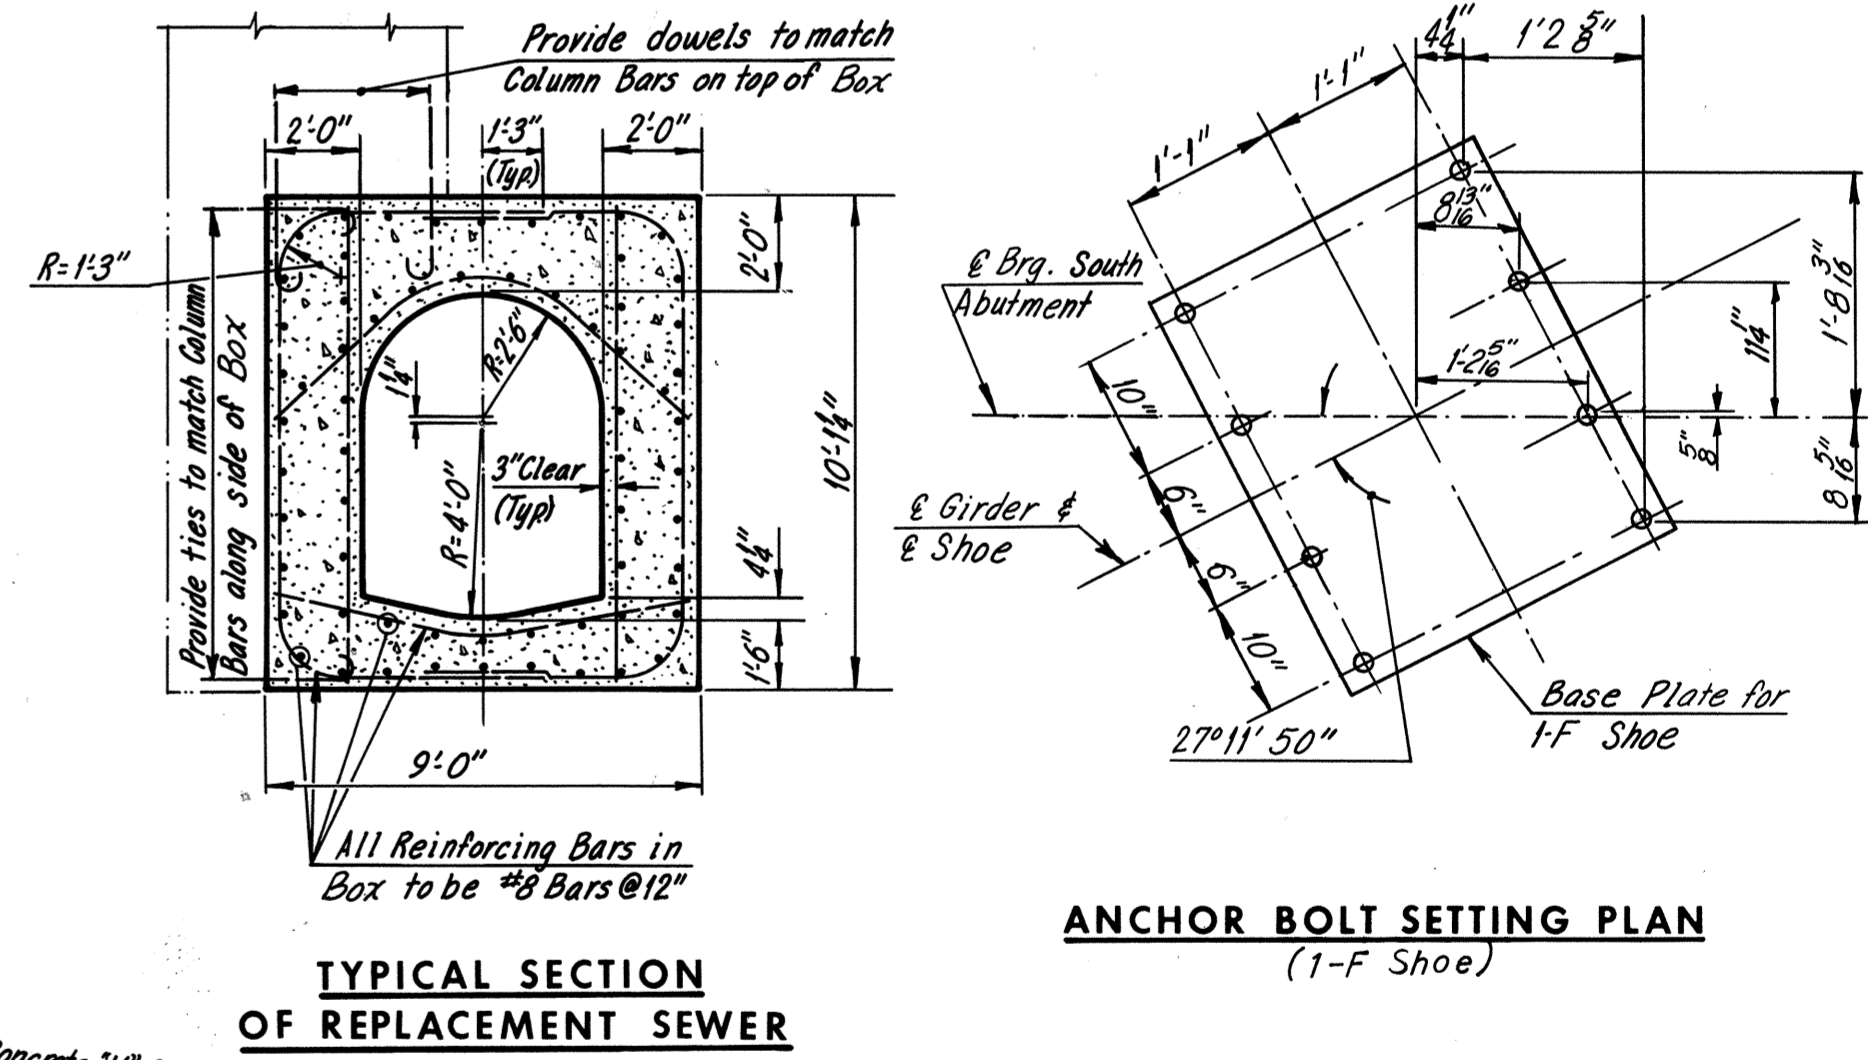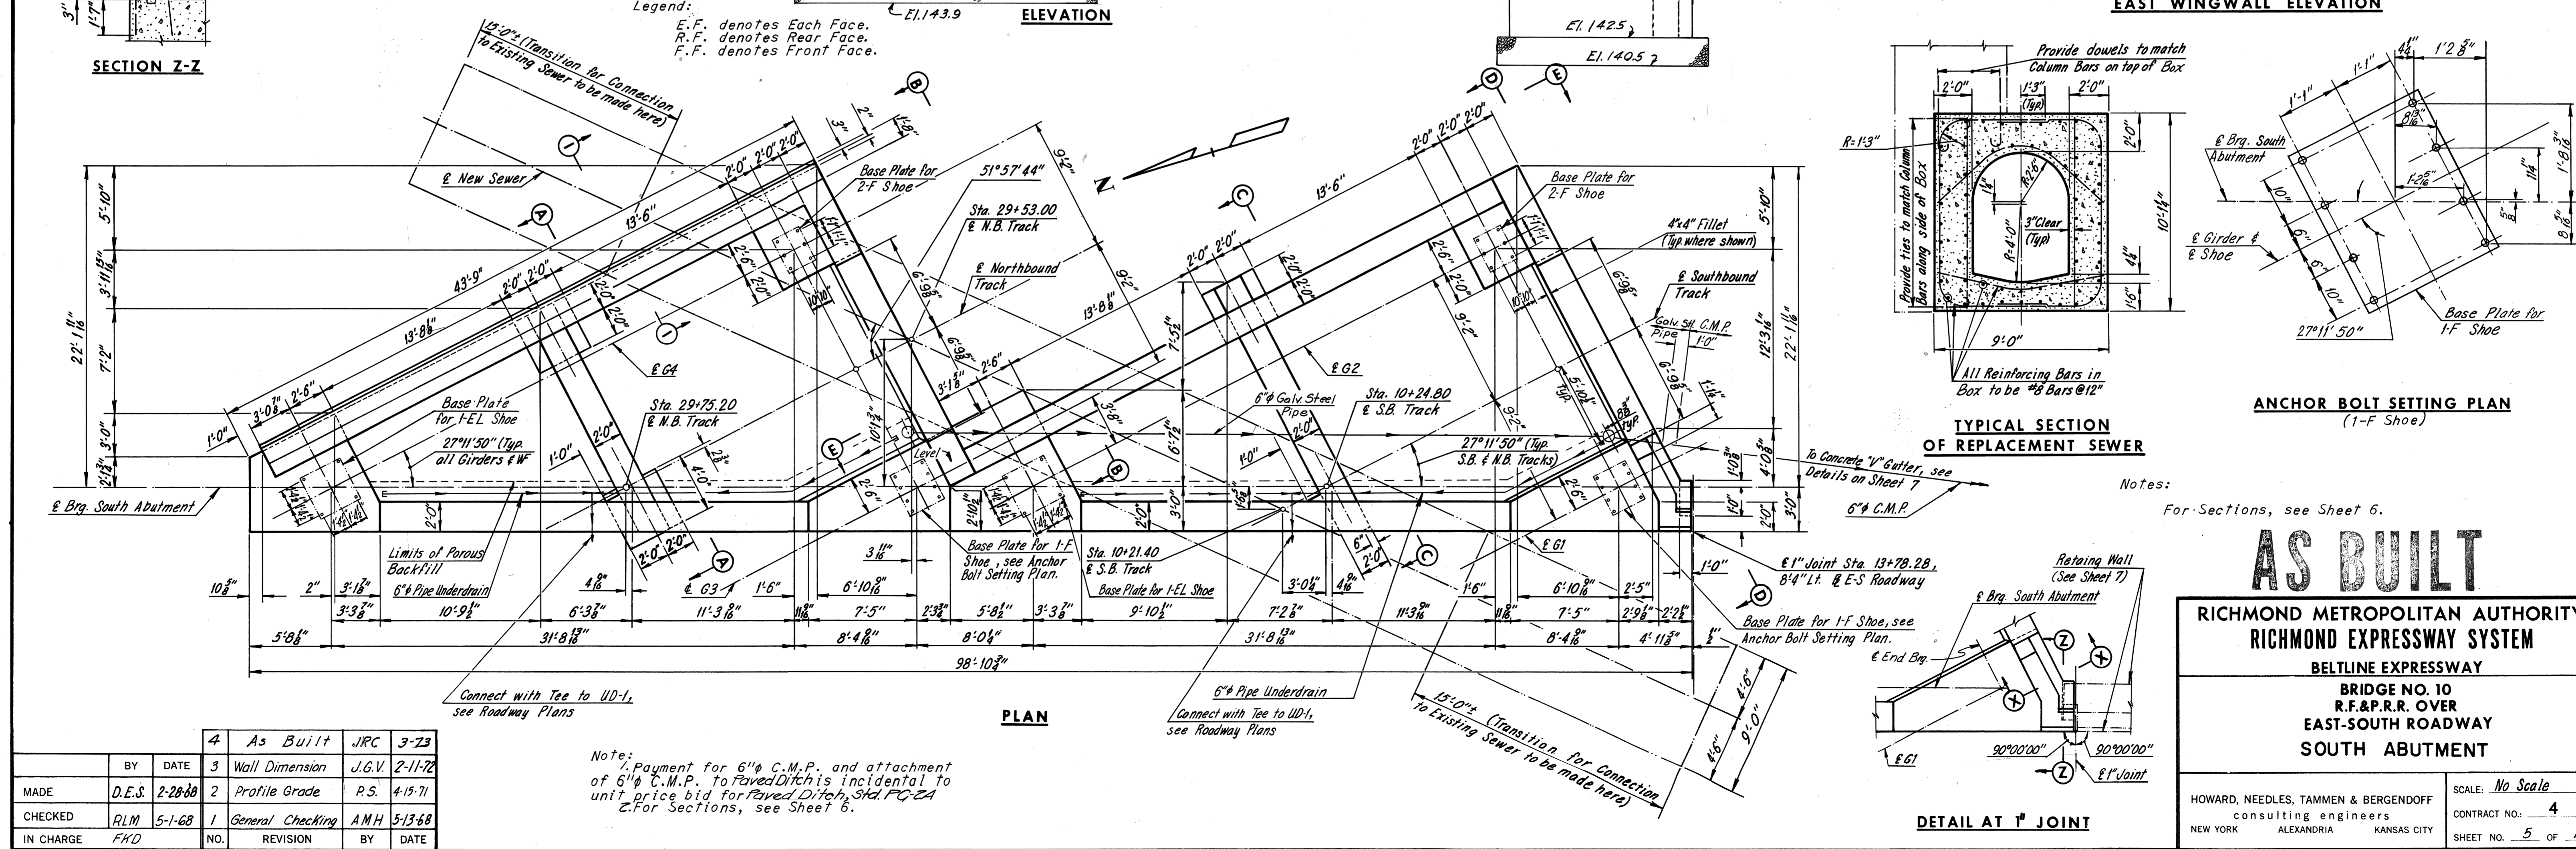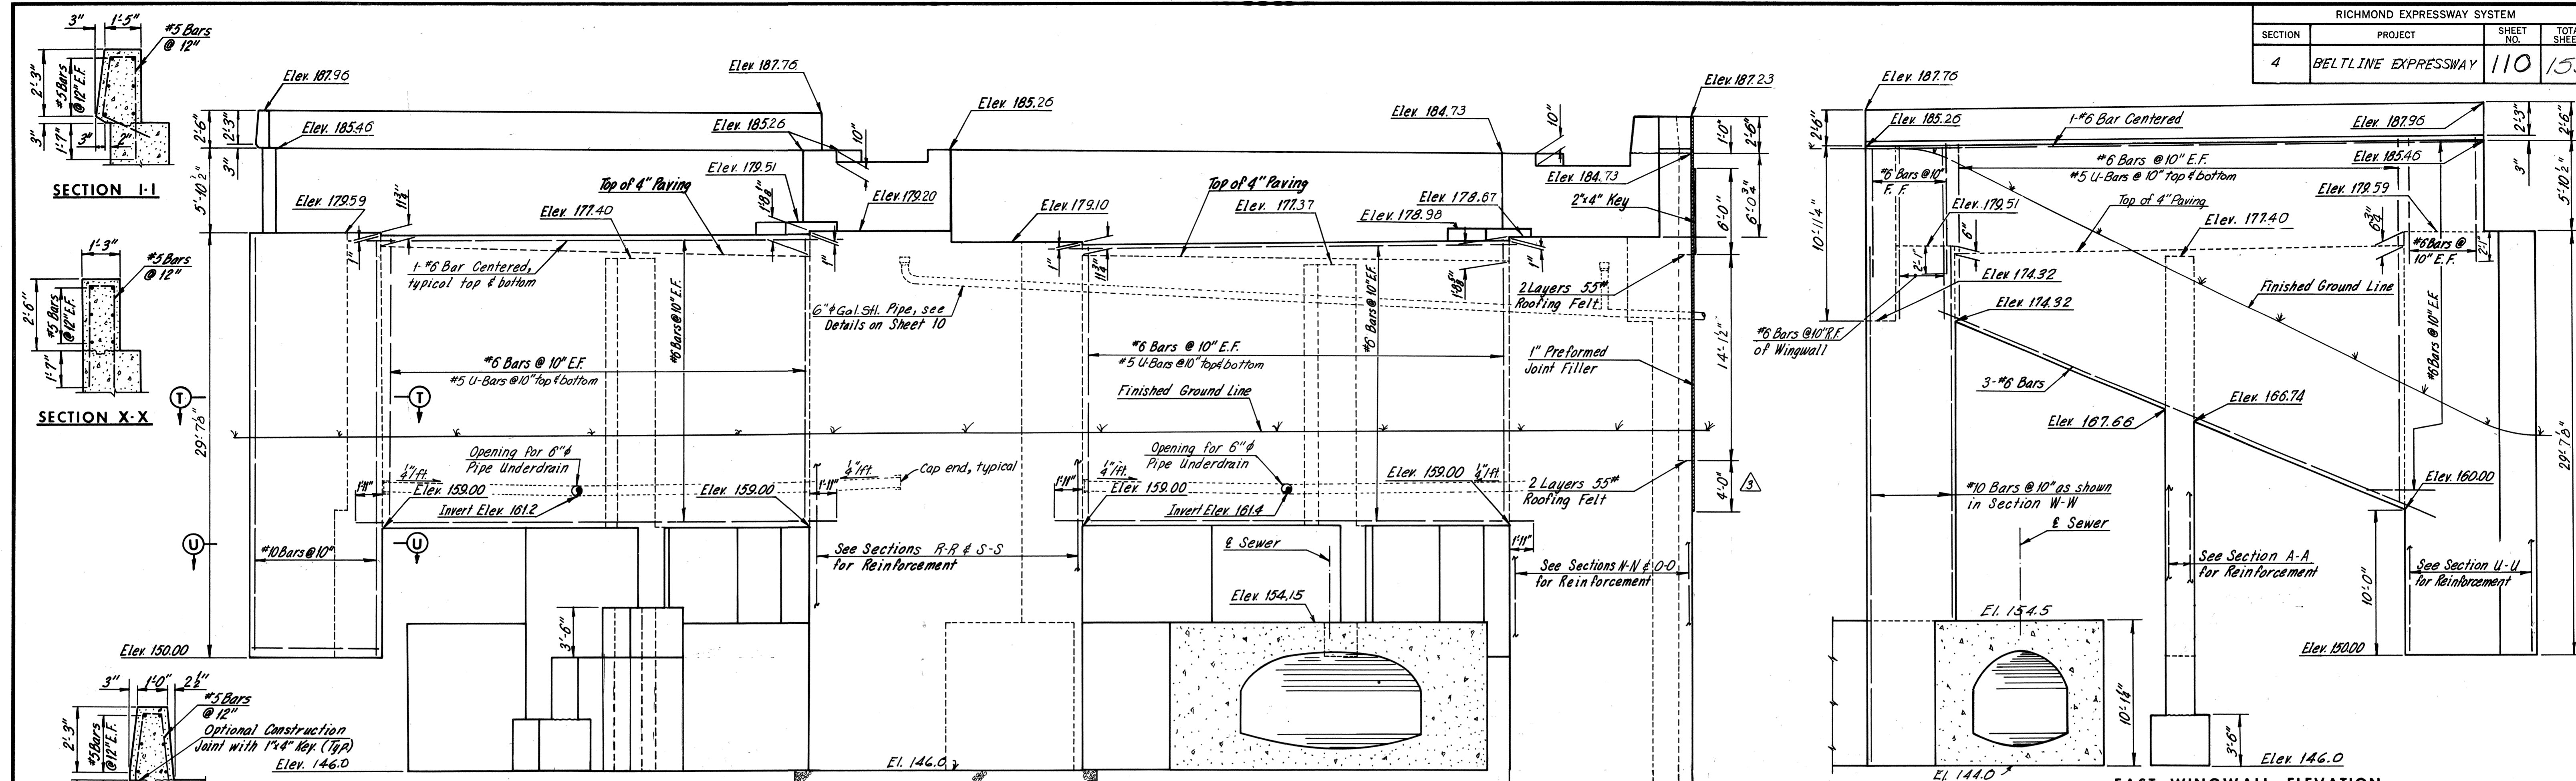

NO.	REVISION	BY	DATE
4	As Built	JRC	3-23
3	Wall Dimension	J.G.V.	2-11-72
2	Profile Grade	P.S.	4-15-71
1	General Checking	AMH	5-13-68

Note: Payment for 6" C.M.P. and attachment of 6" C.M.P. to paved ditch is incidental to unit price bid for Paved Ditch, Std. PC-2A. For Sections, see Sheet 6.





AS BUILT

RICHMOND METROPOLITAN AUTHORITY
RICHMOND EXPRESSWAY SYSTEM
BELTLINE EXPRESSWAY
BRIDGE NO. 10
R.F.&P.R.R. OVER
EAST-SOUTH ROADWAY
SOUTH ABUTMENT

HOWARD, NEEDLES, TAMMEN & BERGENDOFF
consulting engineers
NEW YORK ALEXANDRIA KANSAS CITY

SCALE: No Scale
CONTRACT NO. 4
SHEET NO. 5 OF 12



Legend:
 E.F. denotes Each Face
 F.F. denotes Front Face
 R.F. denotes Rear Face

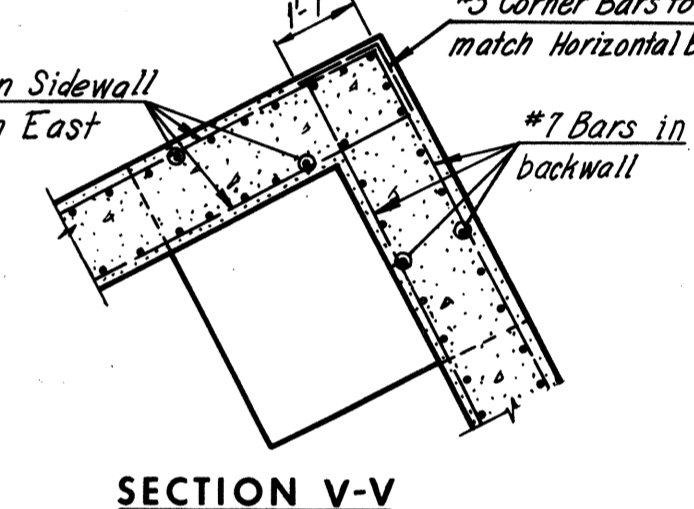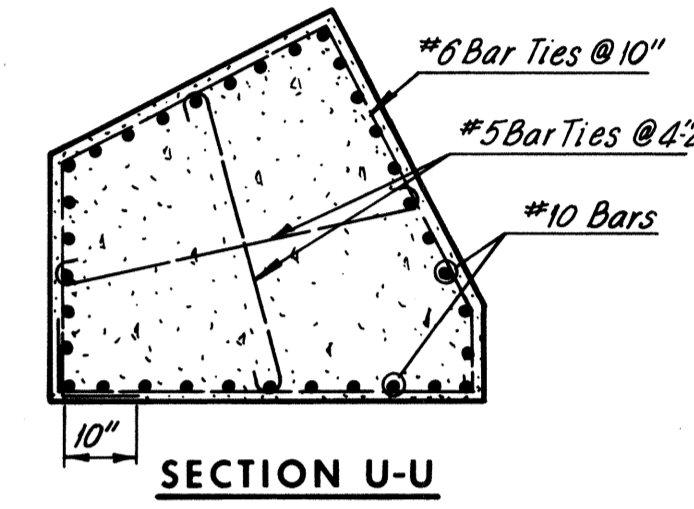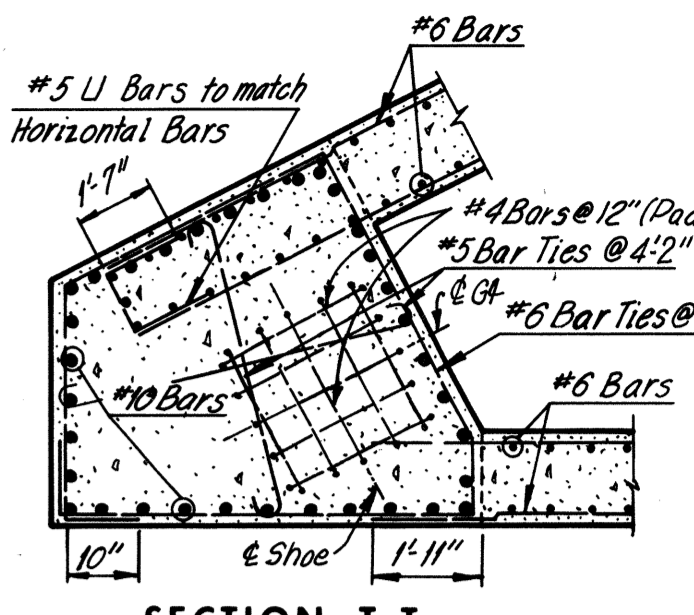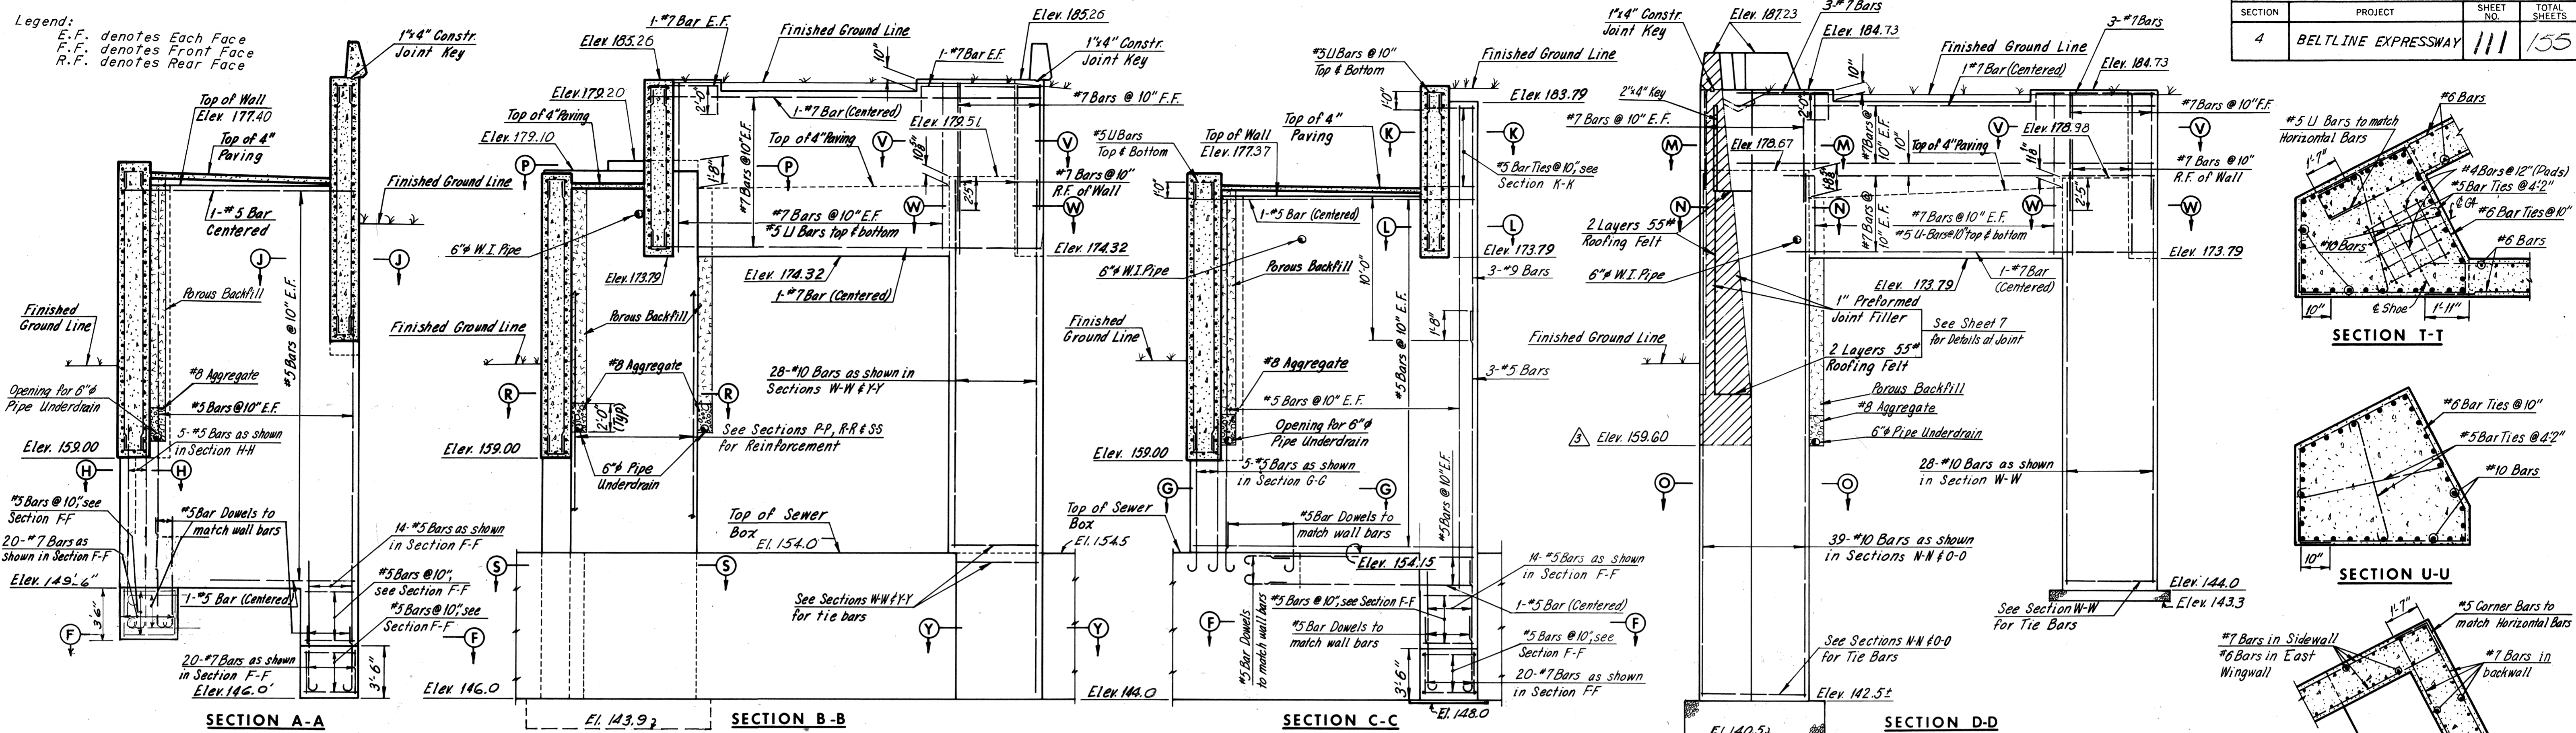

Note: #5 U-Bars to be placed @ 10" ctrs. between wall and porous backfill, from bottom of 4" concrete paving to bottom of wall.

Note: Dampproofing to be applied between wall and porous backfill, from bottom of 4" concrete paving to bottom of wall.

Note: #4 Bars @ 12" shown in Sections M-M, P-P, T-T, and W-W, are to be U-Shaped Bars with 1'-6" legs.

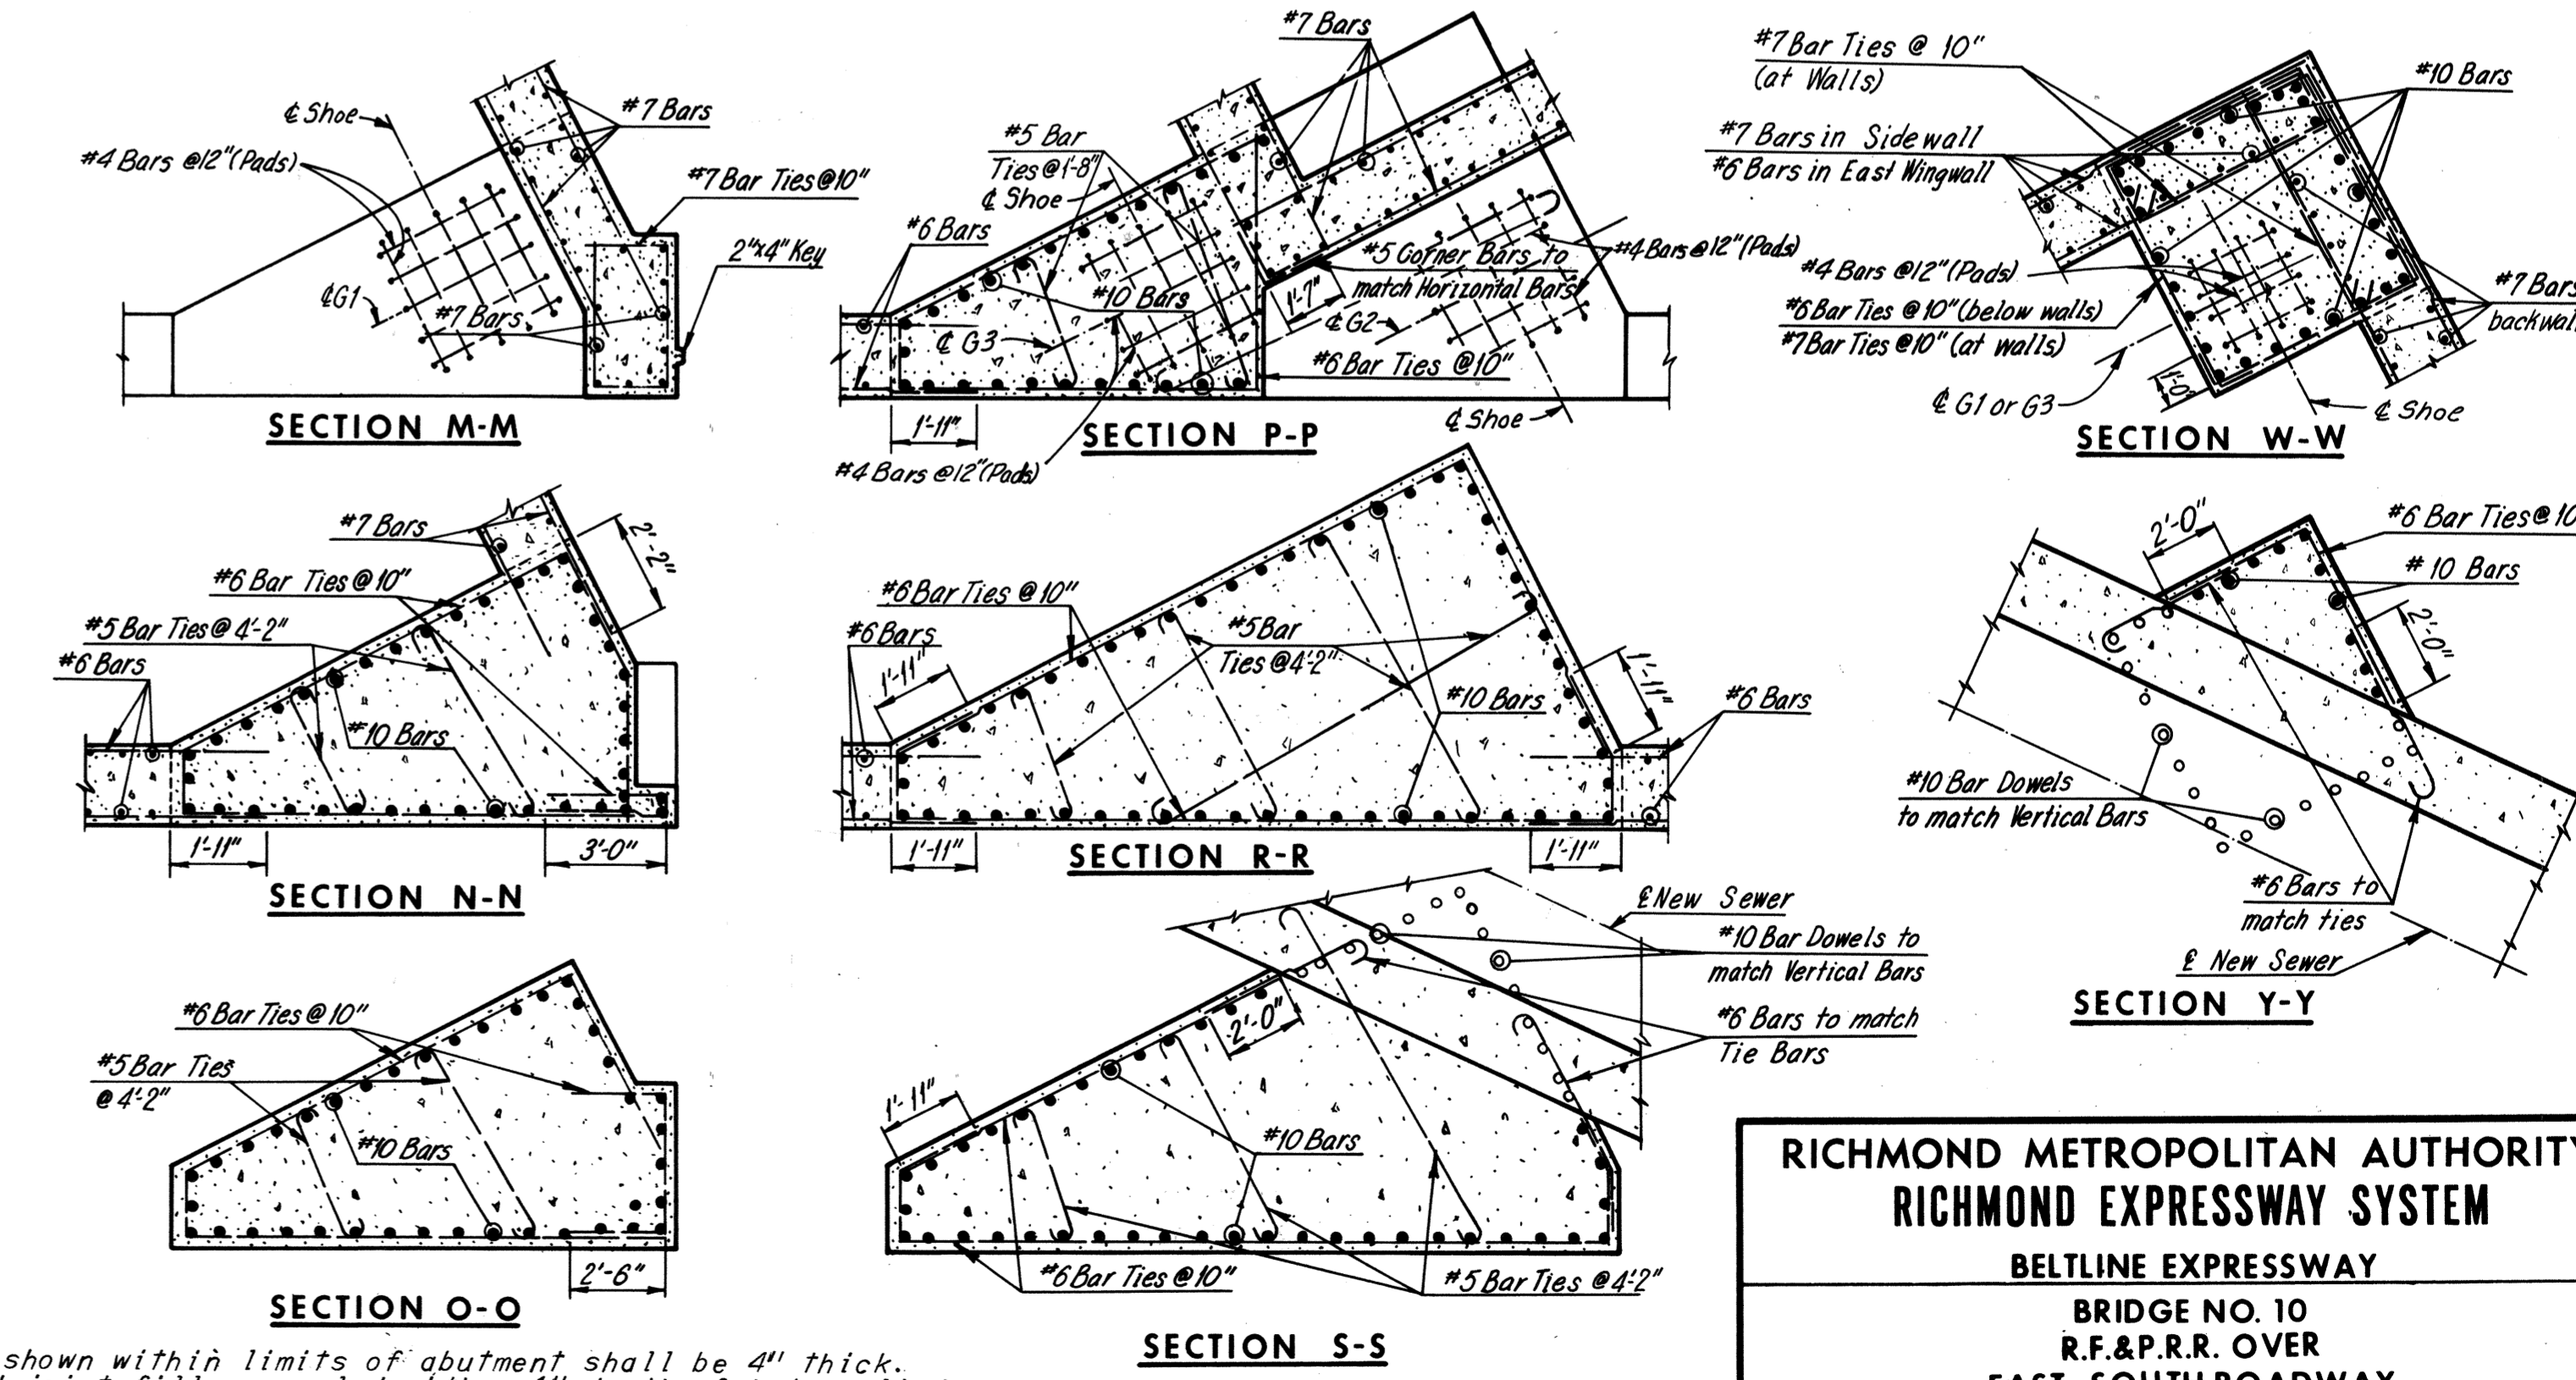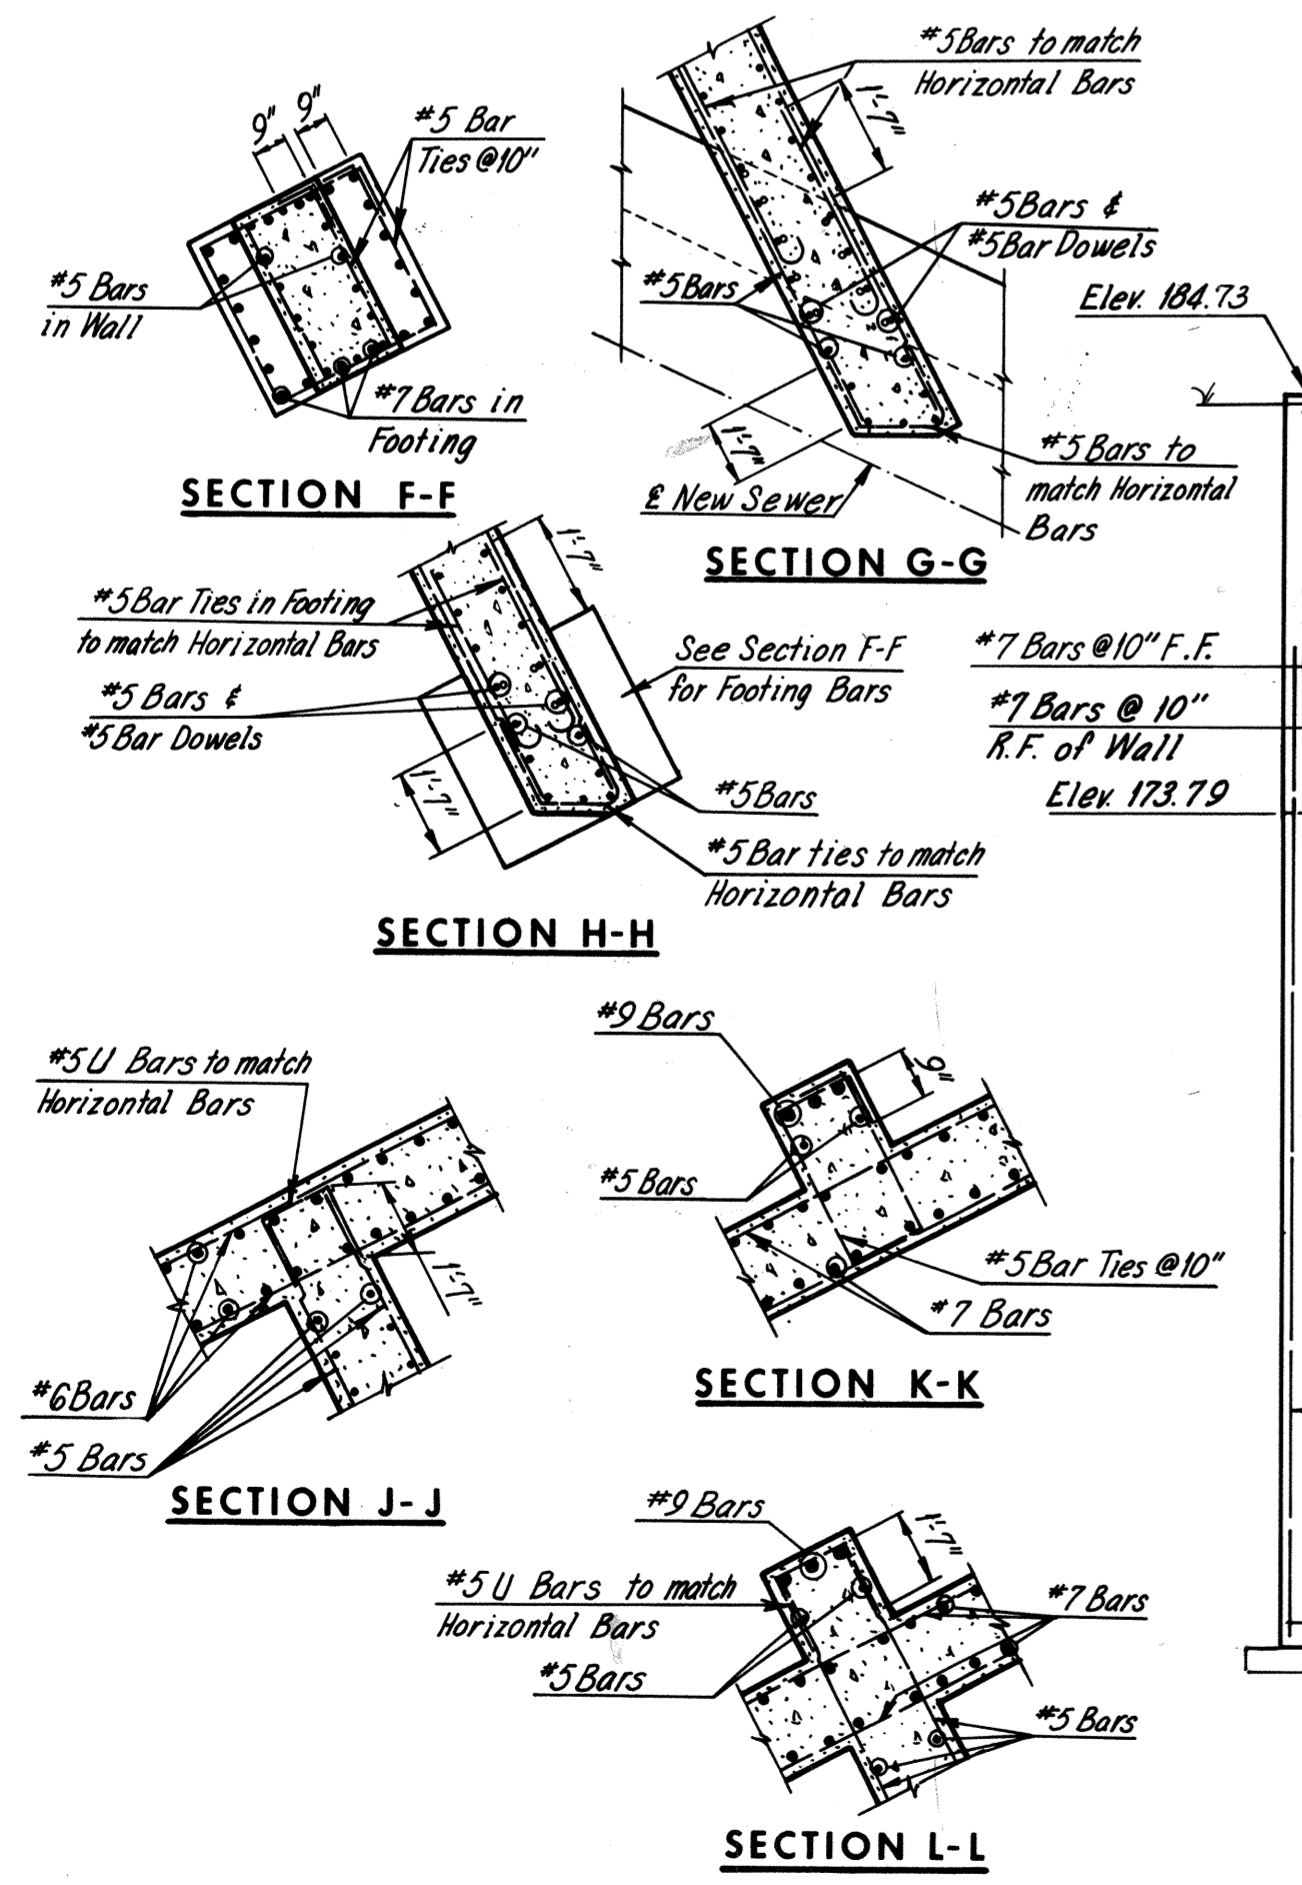

Notes:
 Paving shown within limits of abutment shall be 4" thick.
 2" preformed joint filler, sealed with a 1" depth of hot applied joint sealer, shall be installed between paving and abutment walls.
 Preformed joint filler shall be bituminous tape conforming to AASHTO M213.
 Paving will be paid for as "Concrete, Class A3, Substructures and Walls."
 For Location of sections A-A, B-B, C-C, D-D, E-E, T-T and U-U, see Sheet 5.

AS BUILT


RICHMOND METROPOLITAN AUTHORITY
RICHMOND EXPRESSWAY SYSTEM
BELTLINE EXPRESSWAY
BRIDGE NO. 10
R.F.&P.R. OVER
EAST-SOUTH ROADWAY
SOUTH ABUTMENT DETAILS

BY	DATE	3	Wall Elevation	J.G.V.	2-11-72
MADE	DATE	2	Profile Grade	P.S.	4-15-71
CHECKED	DATE	1	General Checking	AMH	5-13-68
IN CHARGE	DATE	NO.	REVISION	BY	DATE
FKD					

HOWARD, NEEDLES, TAMMEN & BERGENDOFF consulting engineers NEW YORK ALEXANDRIA KANSAS CITY	SCALE: No Scale CONTRACT NO. 4 SHEET NO. 6 OF 12
---	--











RICHMOND EXPRESSWAY SYSTEM			
SECTION	PROJECT	SHEET NO.	TOTAL SHEETS
4	BELTLINE EXPRESSWAY	112	155

Note: For detail of connection of 6" Dia. C.M.P. to Concrete V-Gutter, see Detail C.

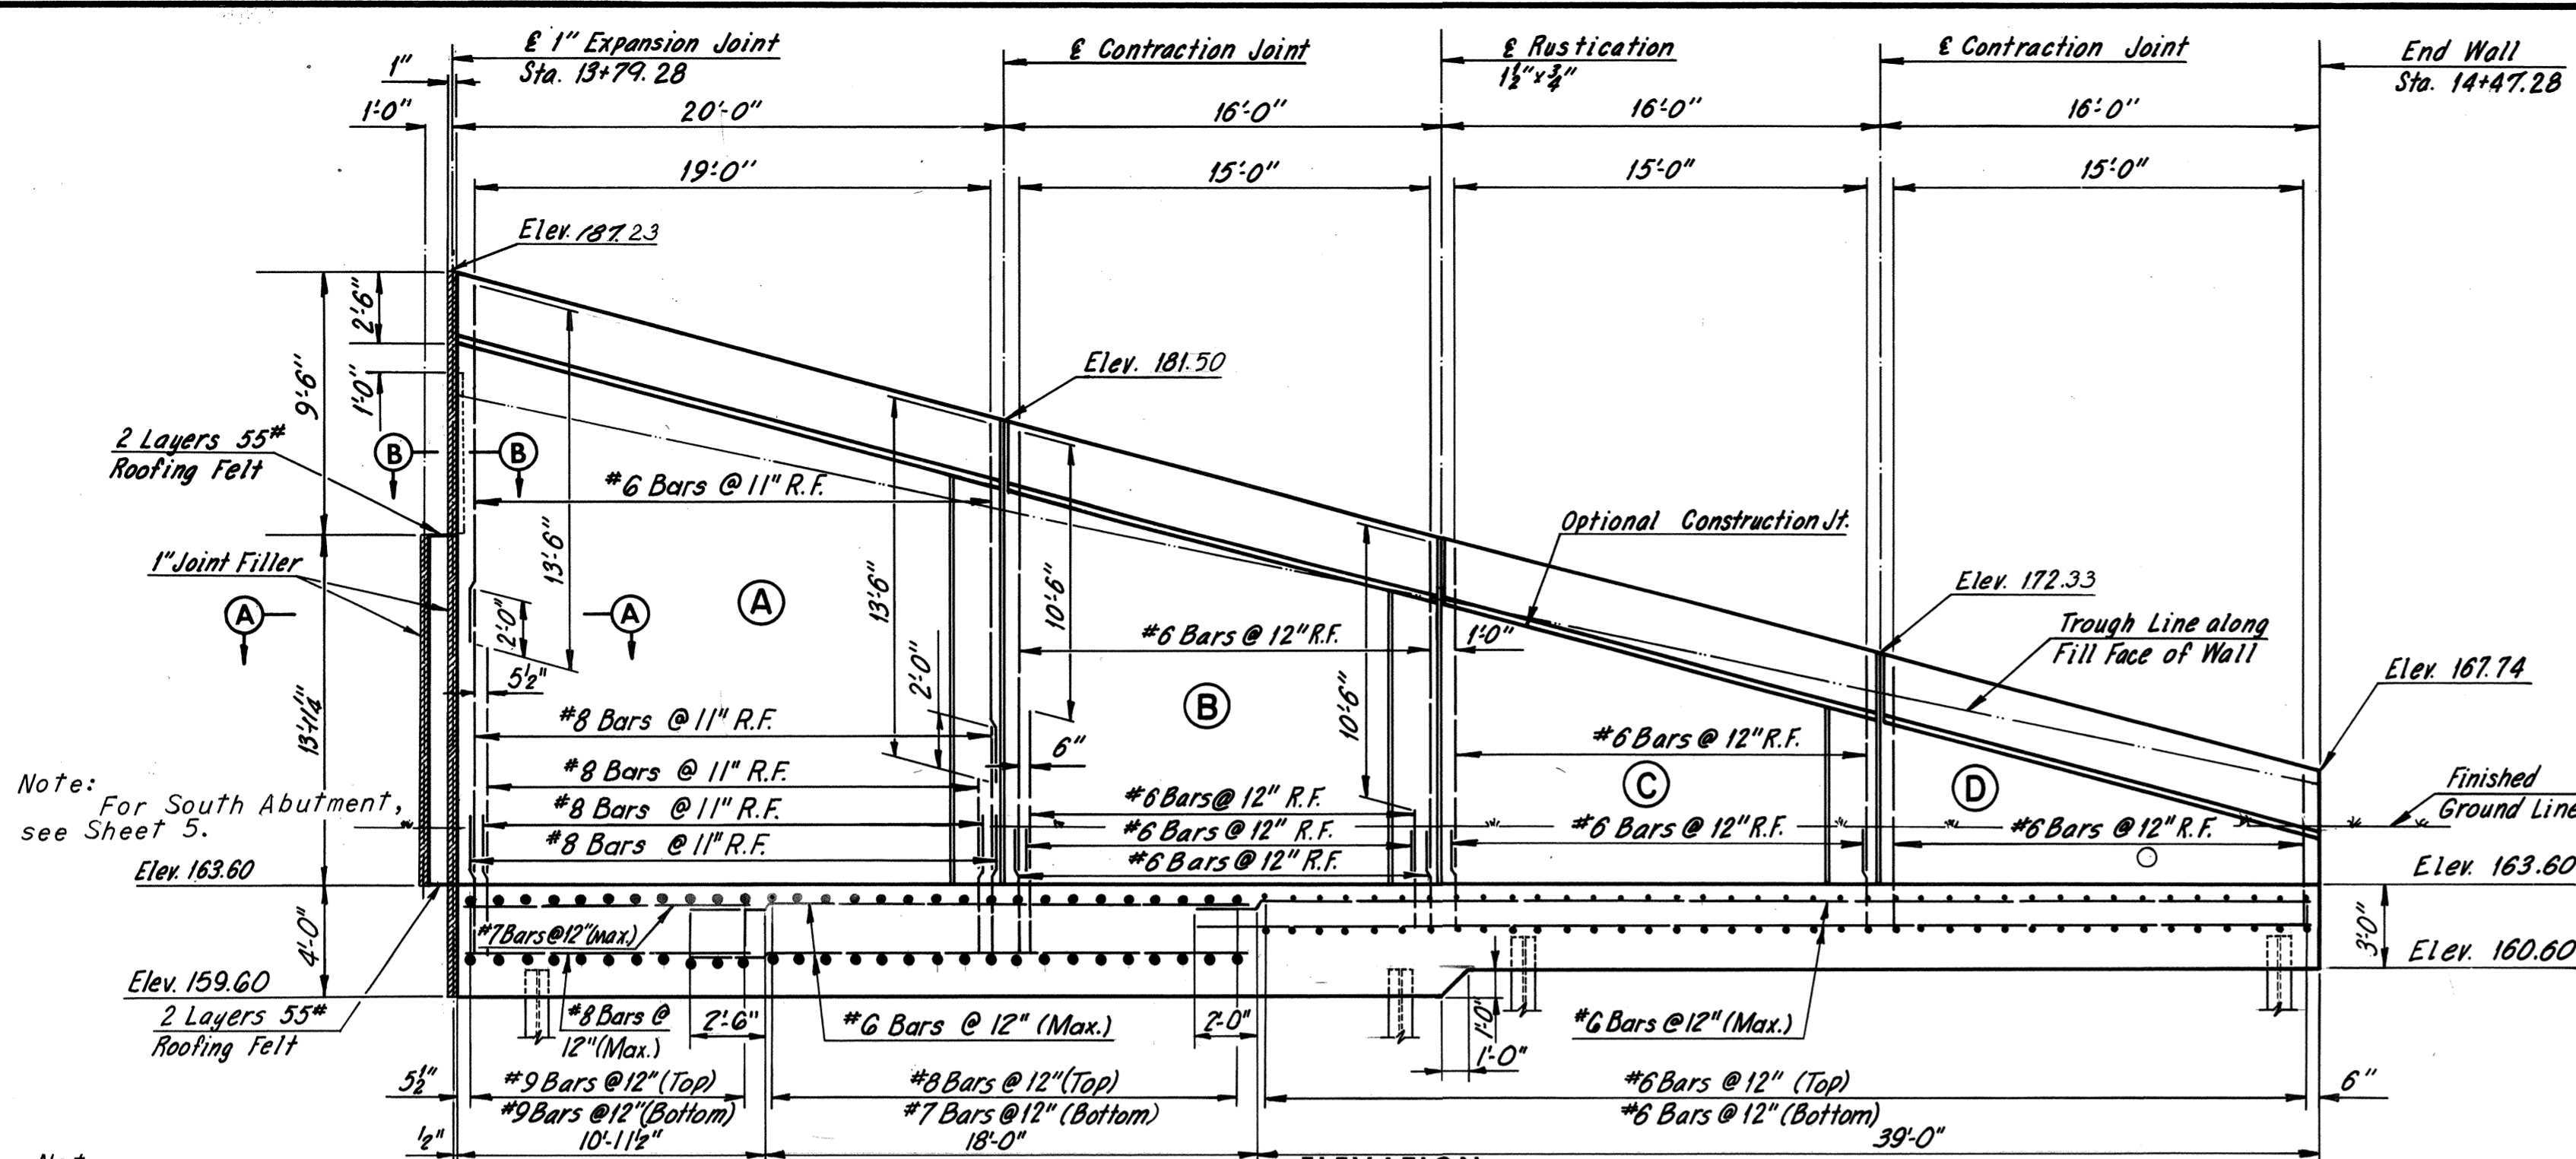

Note: For South Abutment, see Sheet 5.

Note: Reinforcing to be shifted to miss underdrain going thru wall.
Legend: R.F. denotes Rear Face. E.F. denotes Each Face.

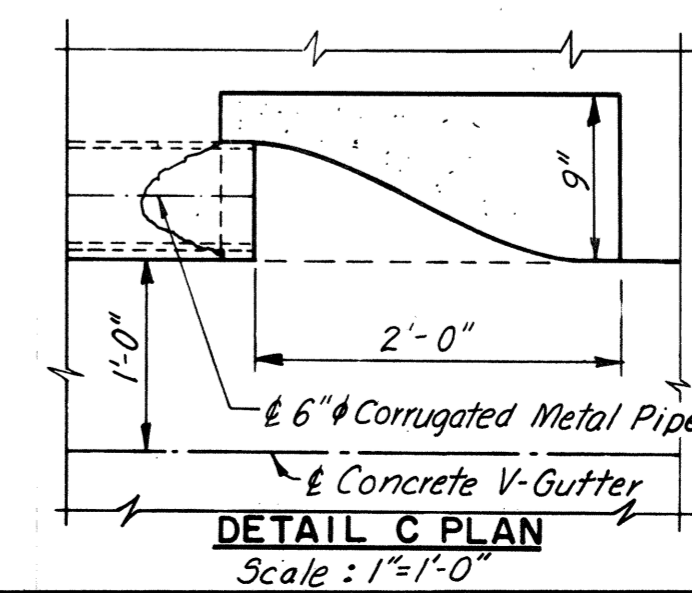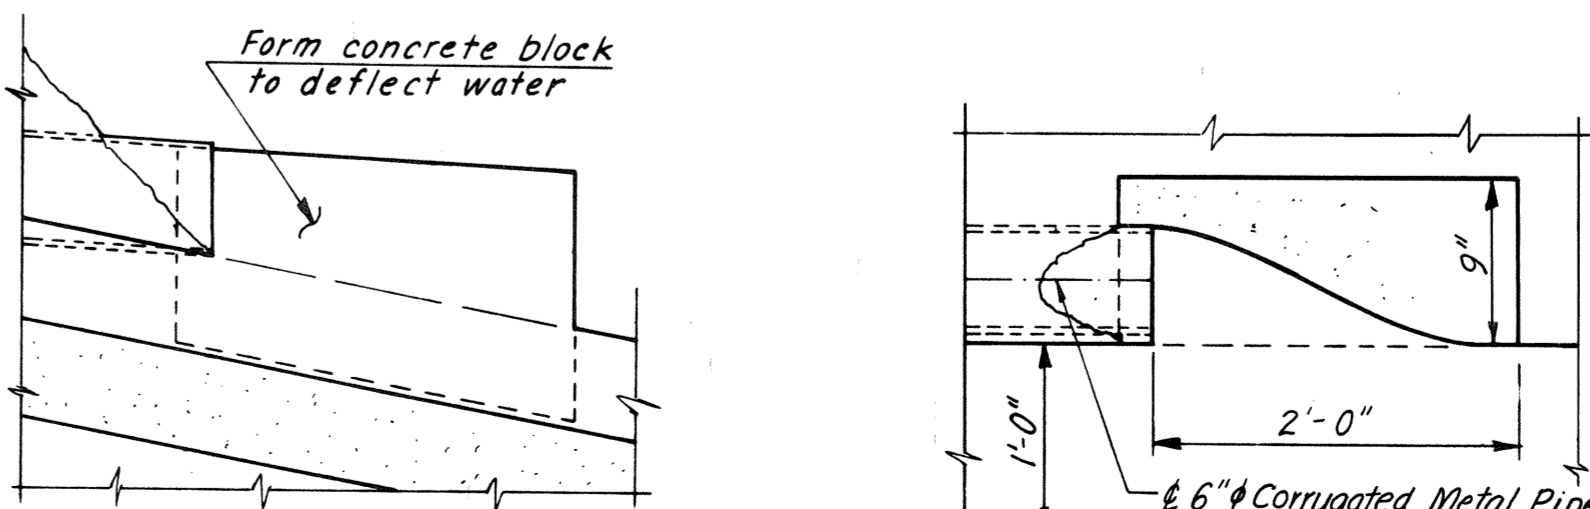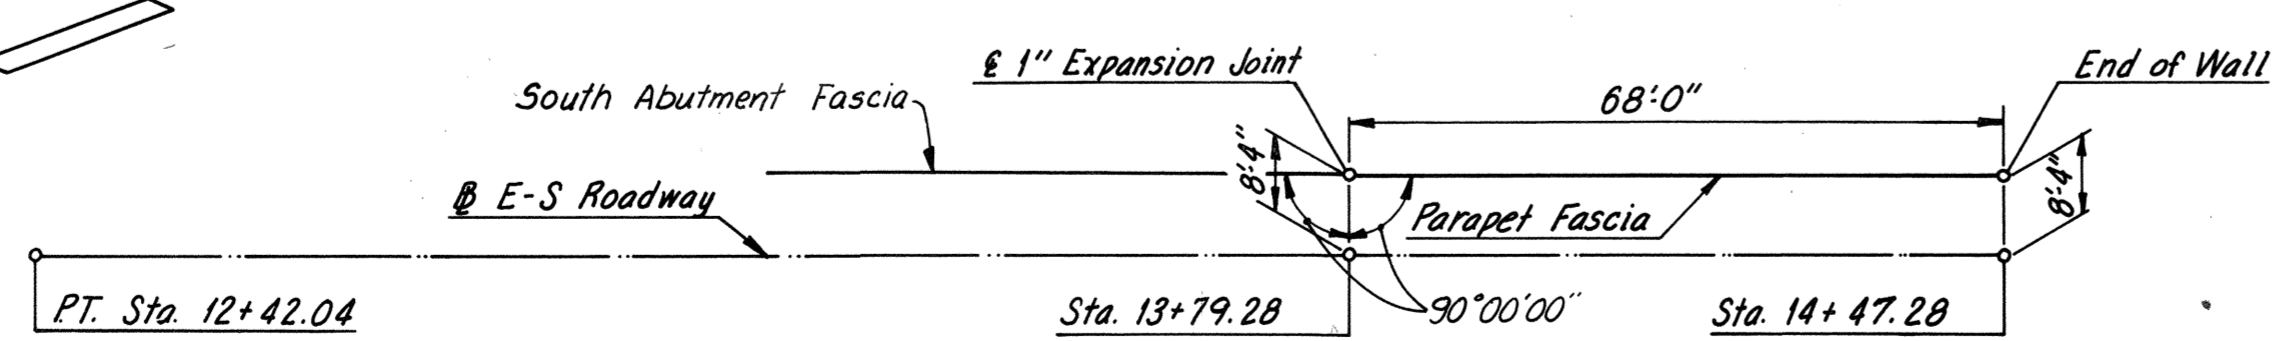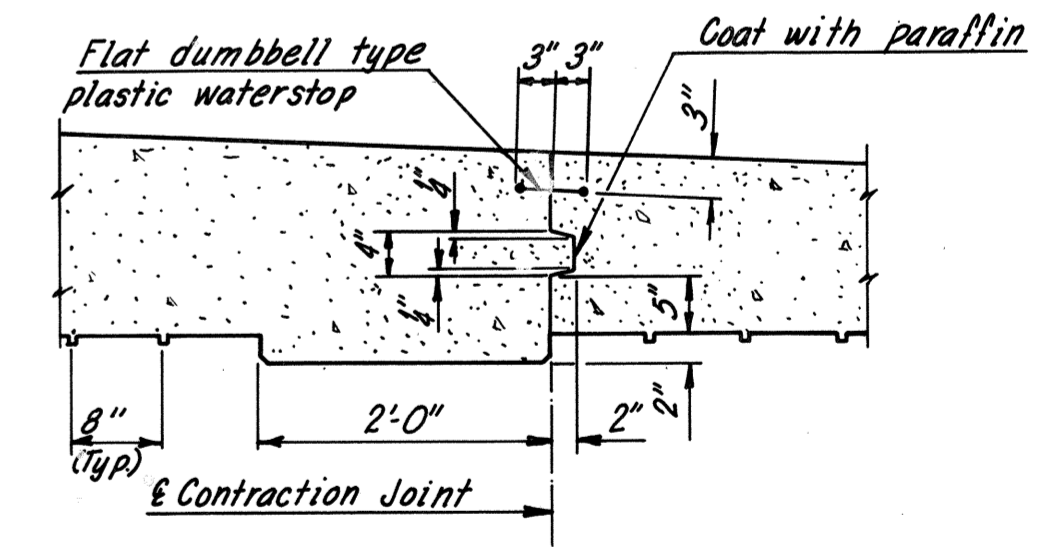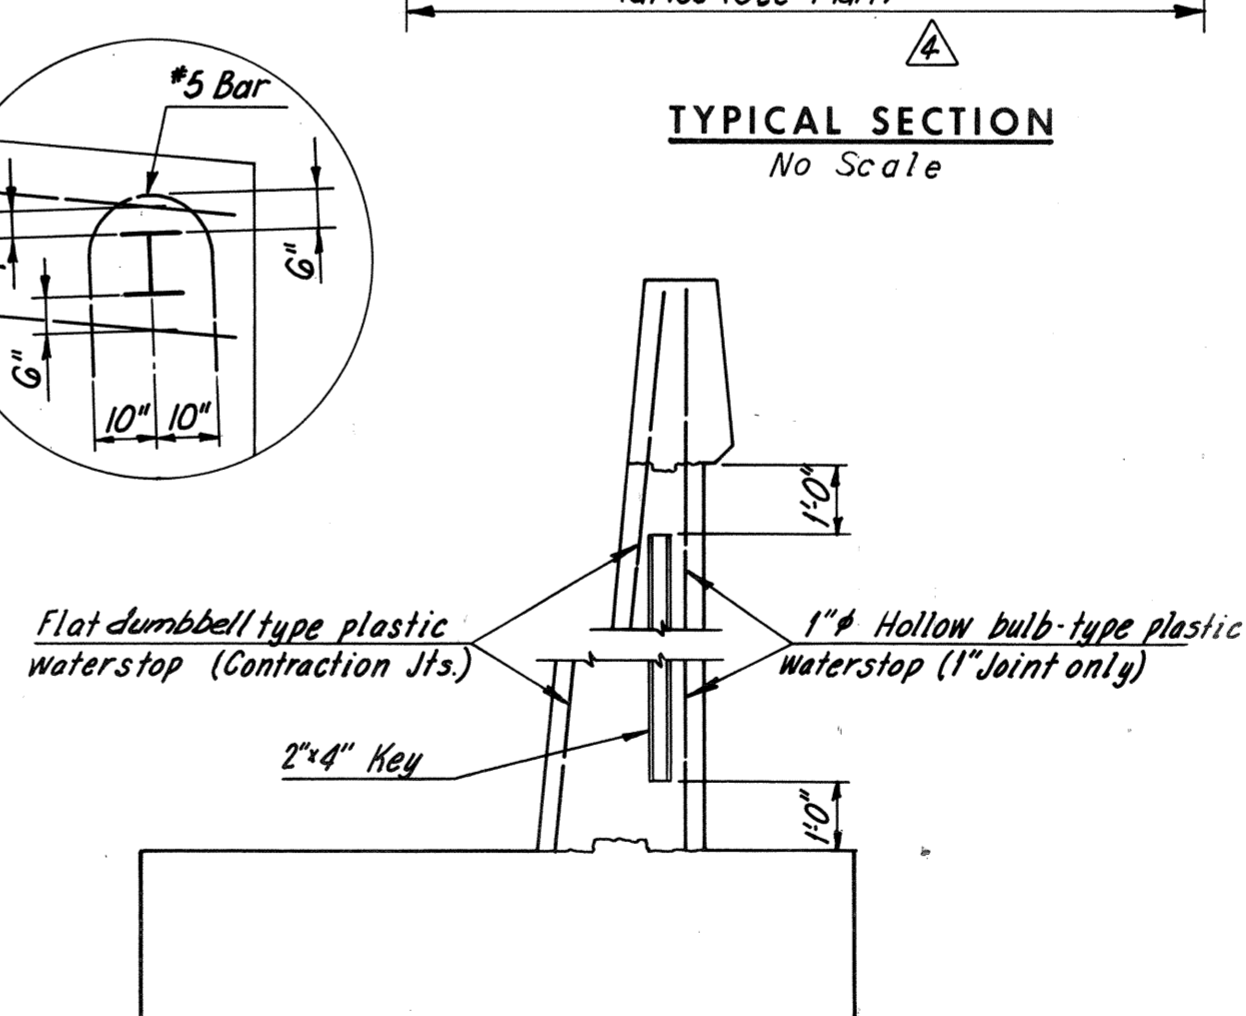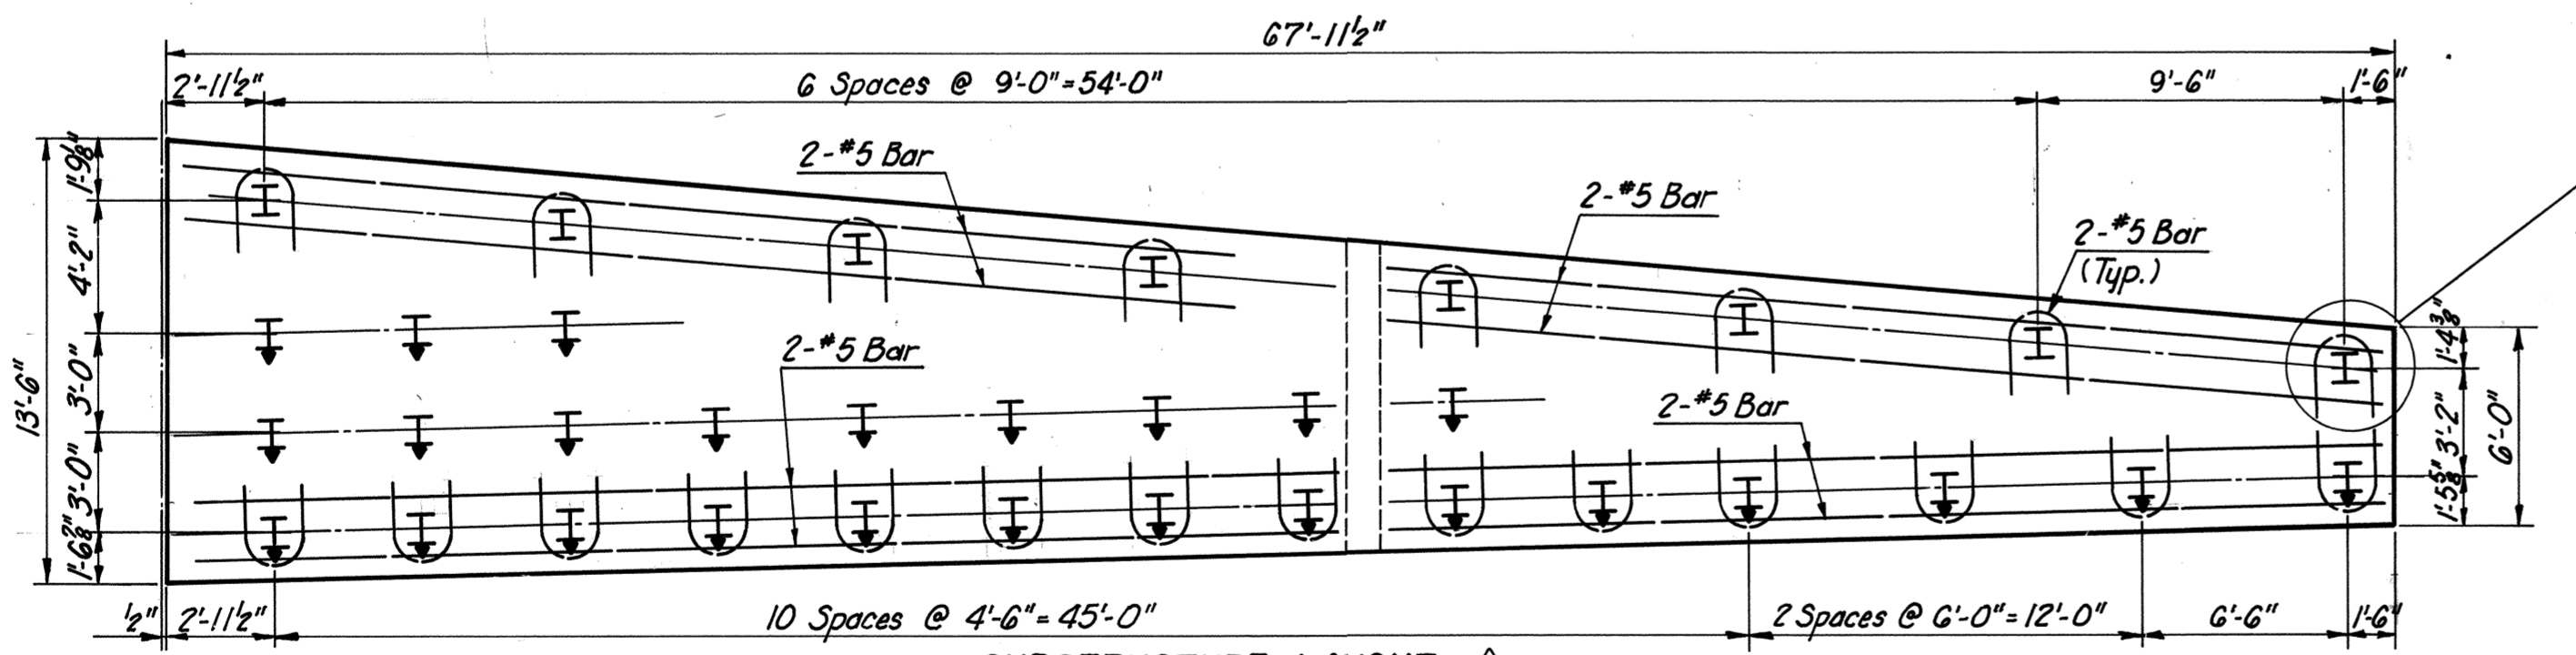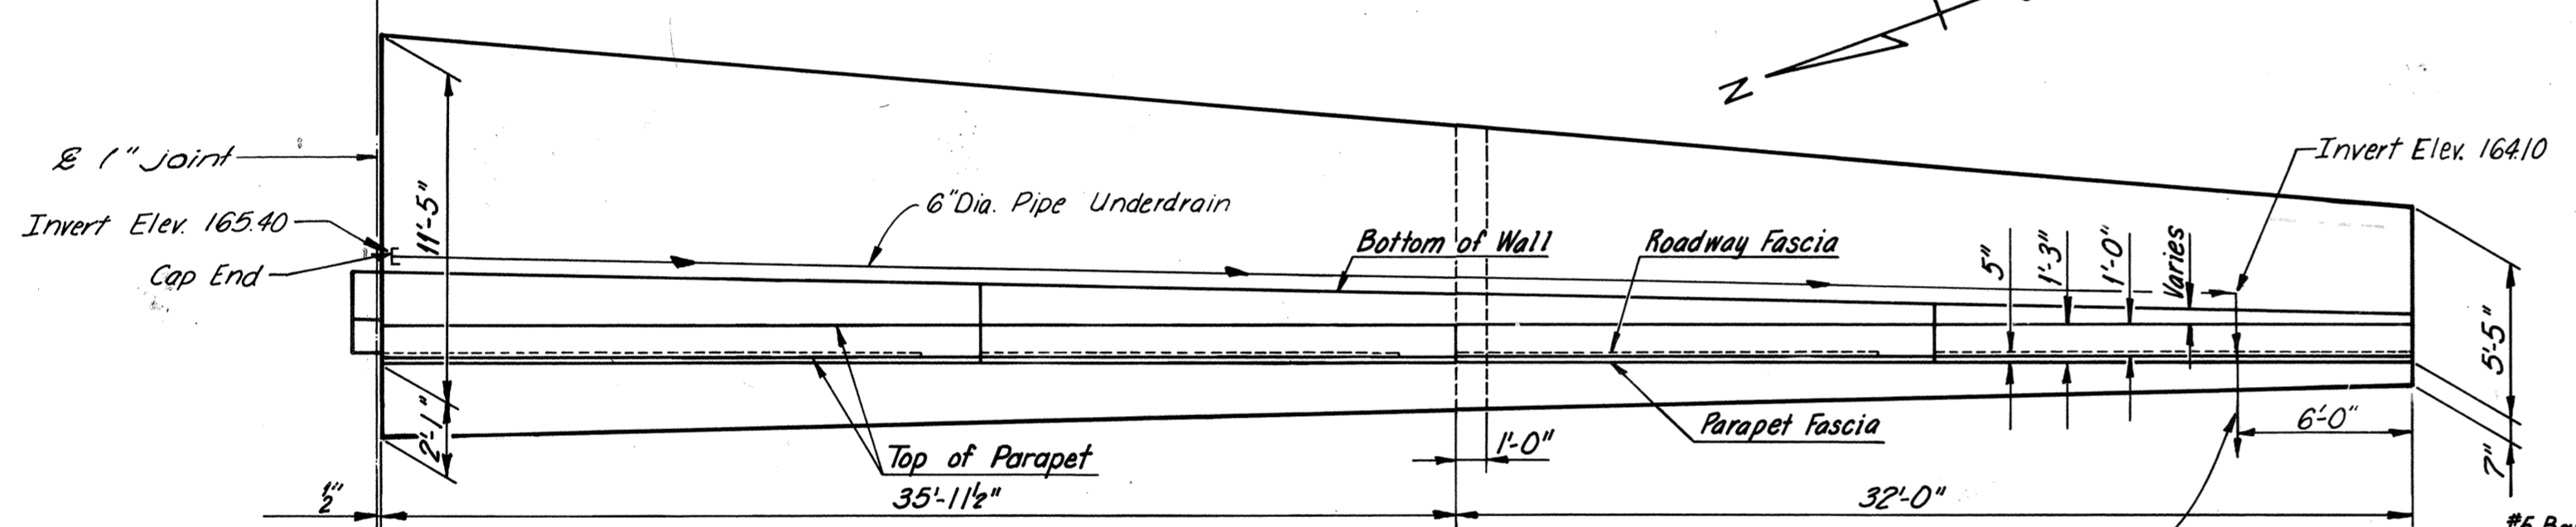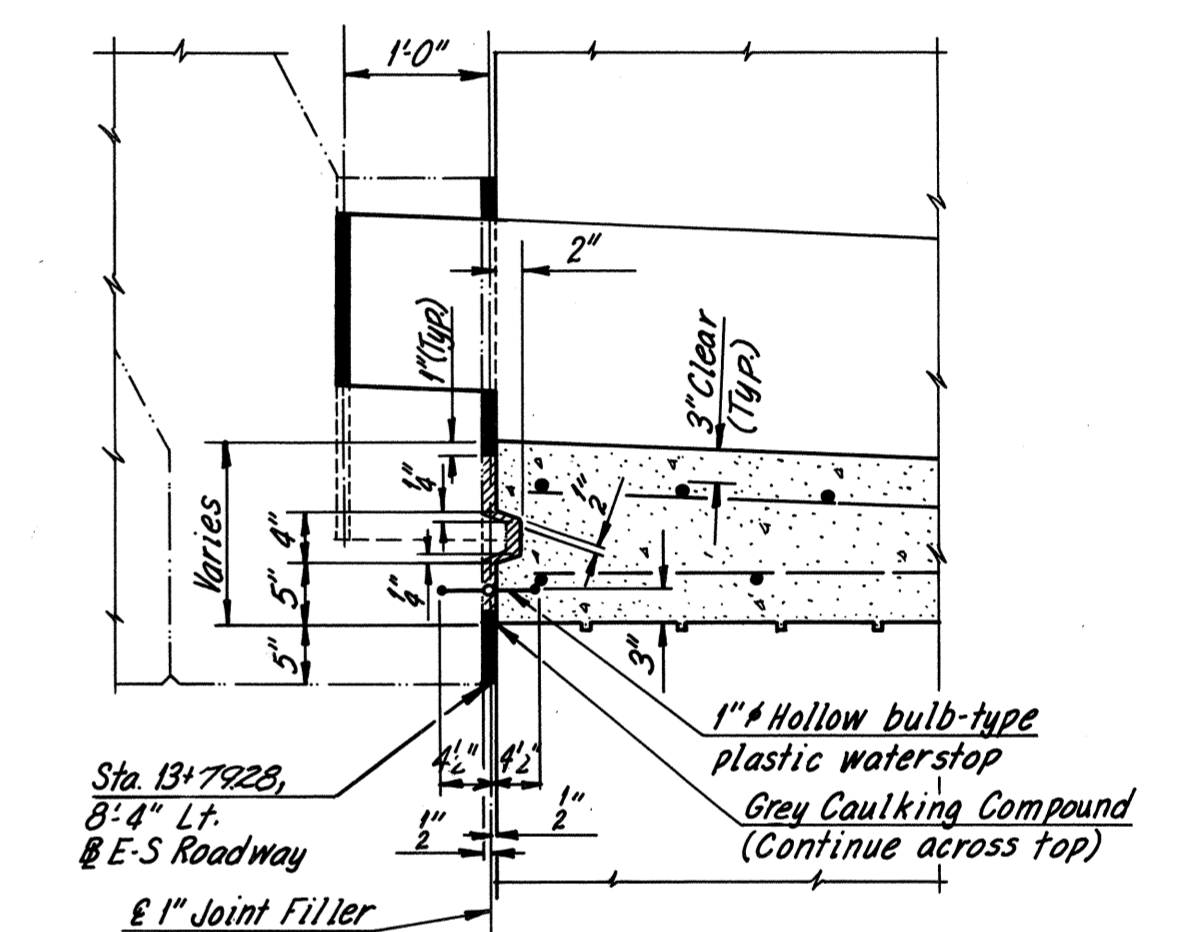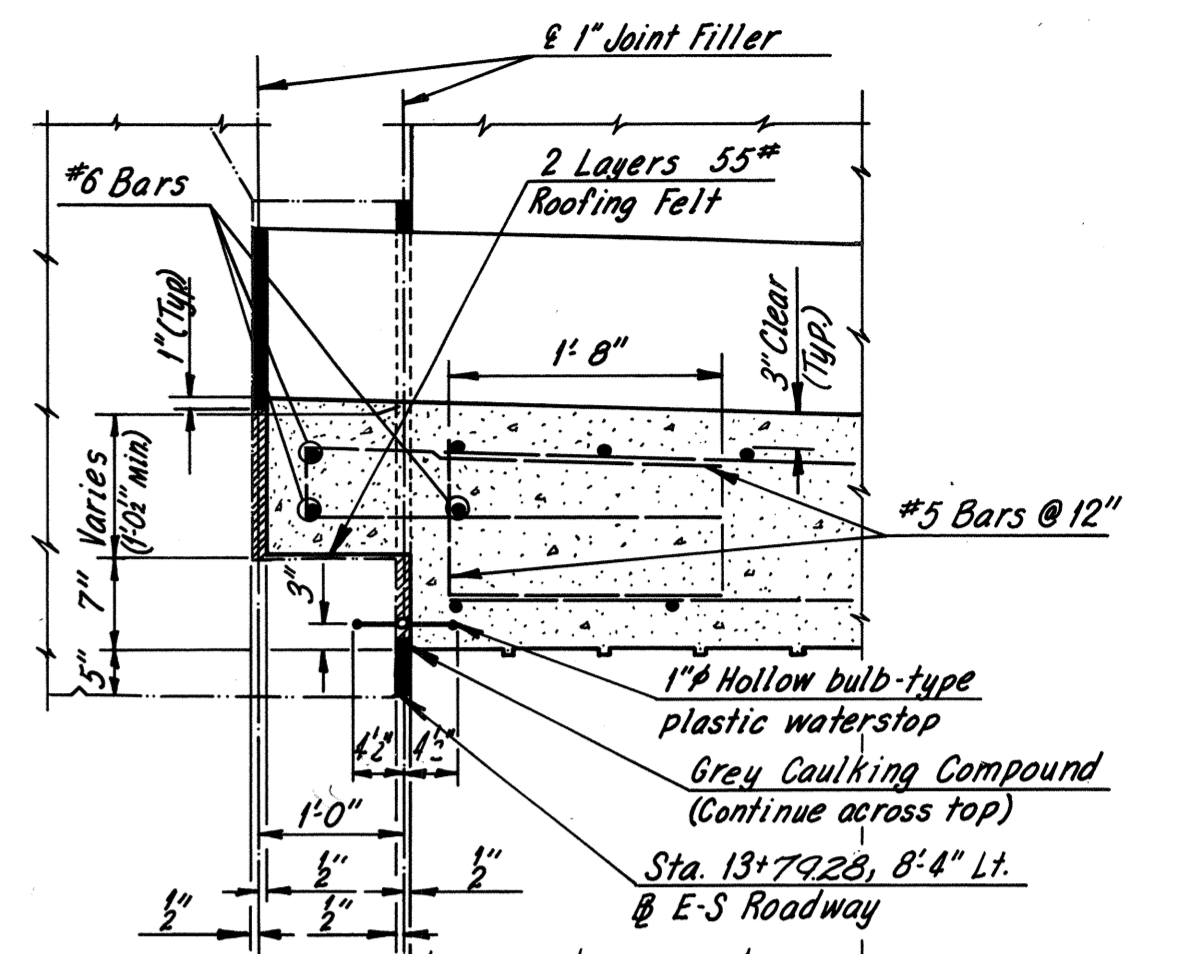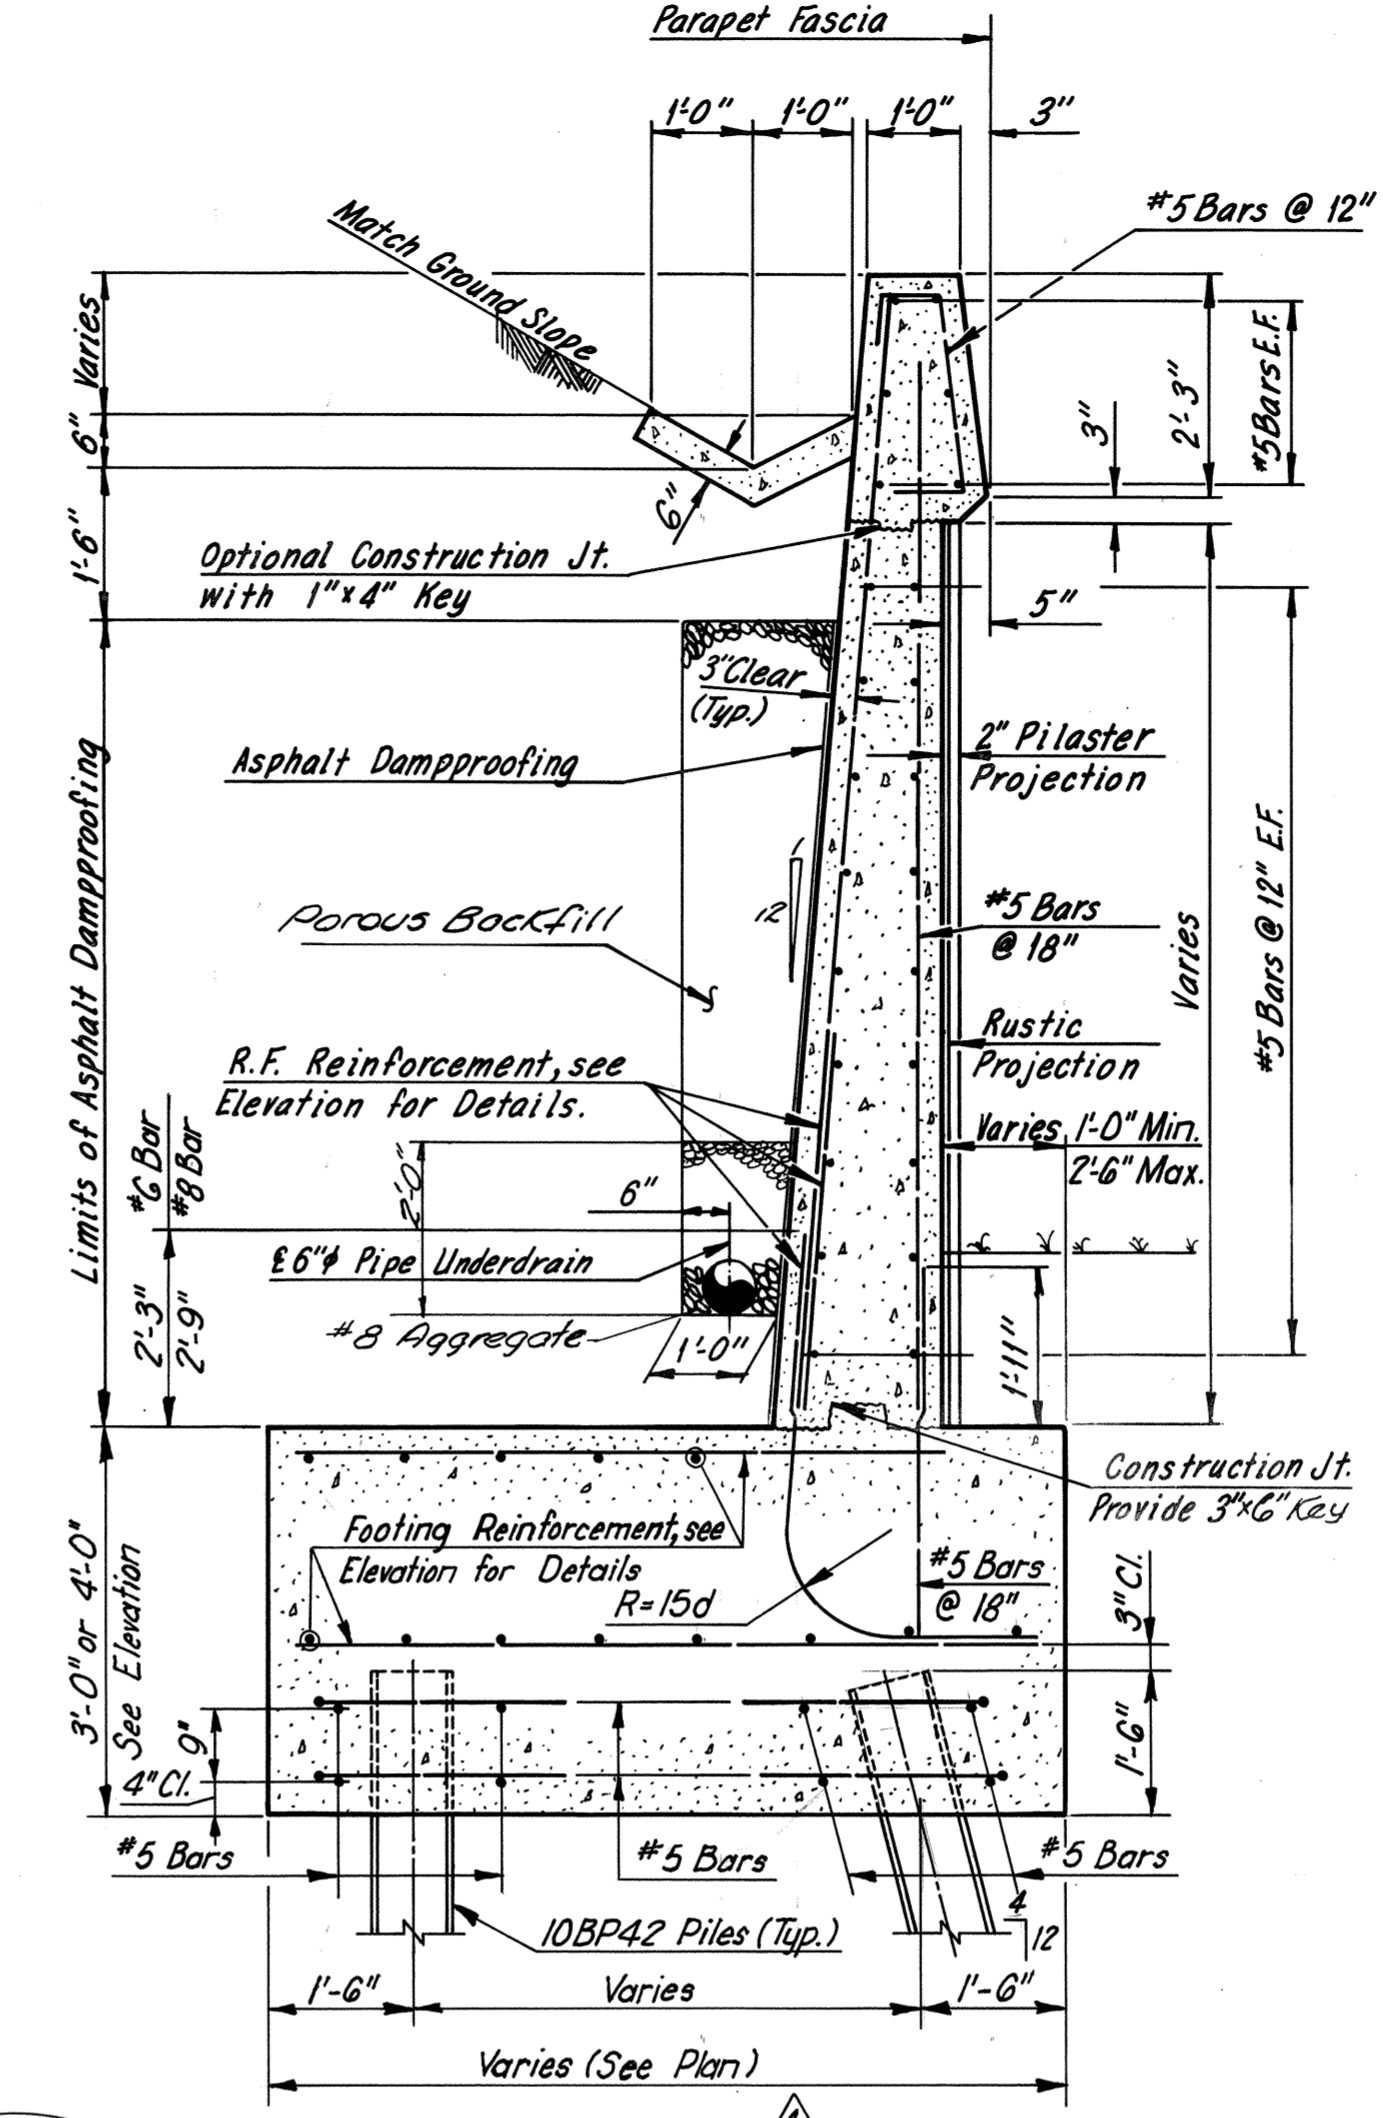

NOTES:
All Piles 10BP42 steel piles (design capacity = 45 tons)
Jetting not permitted.
Number of Piles = 34.

⊥ Denotes 4:12 batter in direction of arrow.
⊥ Denotes vertical pile.


AS BUILT

RICHMOND METROPOLITAN AUTHORITY
RICHMOND EXPRESSWAY SYSTEM
BELTLINE EXPRESSWAY
BRIDGE NO. 10
R.F.&P.R.R. OVER
EAST-SOUTH ROADWAY
SOUTH ABUTMENT RETAINING WALL


HOWARD, NEEDLES, TAMMEN & BERGENDOFF
consulting engineers
NEW YORK ALEXANDRIA KANSAS CITY
SCALE: As Noted
CONTRACT NO. 4
SHEET NO. 7 OF 12

NO.	REVISION	BY	DATE
5	As Built	JRC	3-73
4	Footing Revision	J.G.V.	2-11-72
3	Profile Grade	P.S.	4-15-71
2	General	P.S.	7-70
1	General Revisions	AMH	5-13-68

Note: Asphalt plank shall be recessed to receive flange of 12 WF 50 stringers.

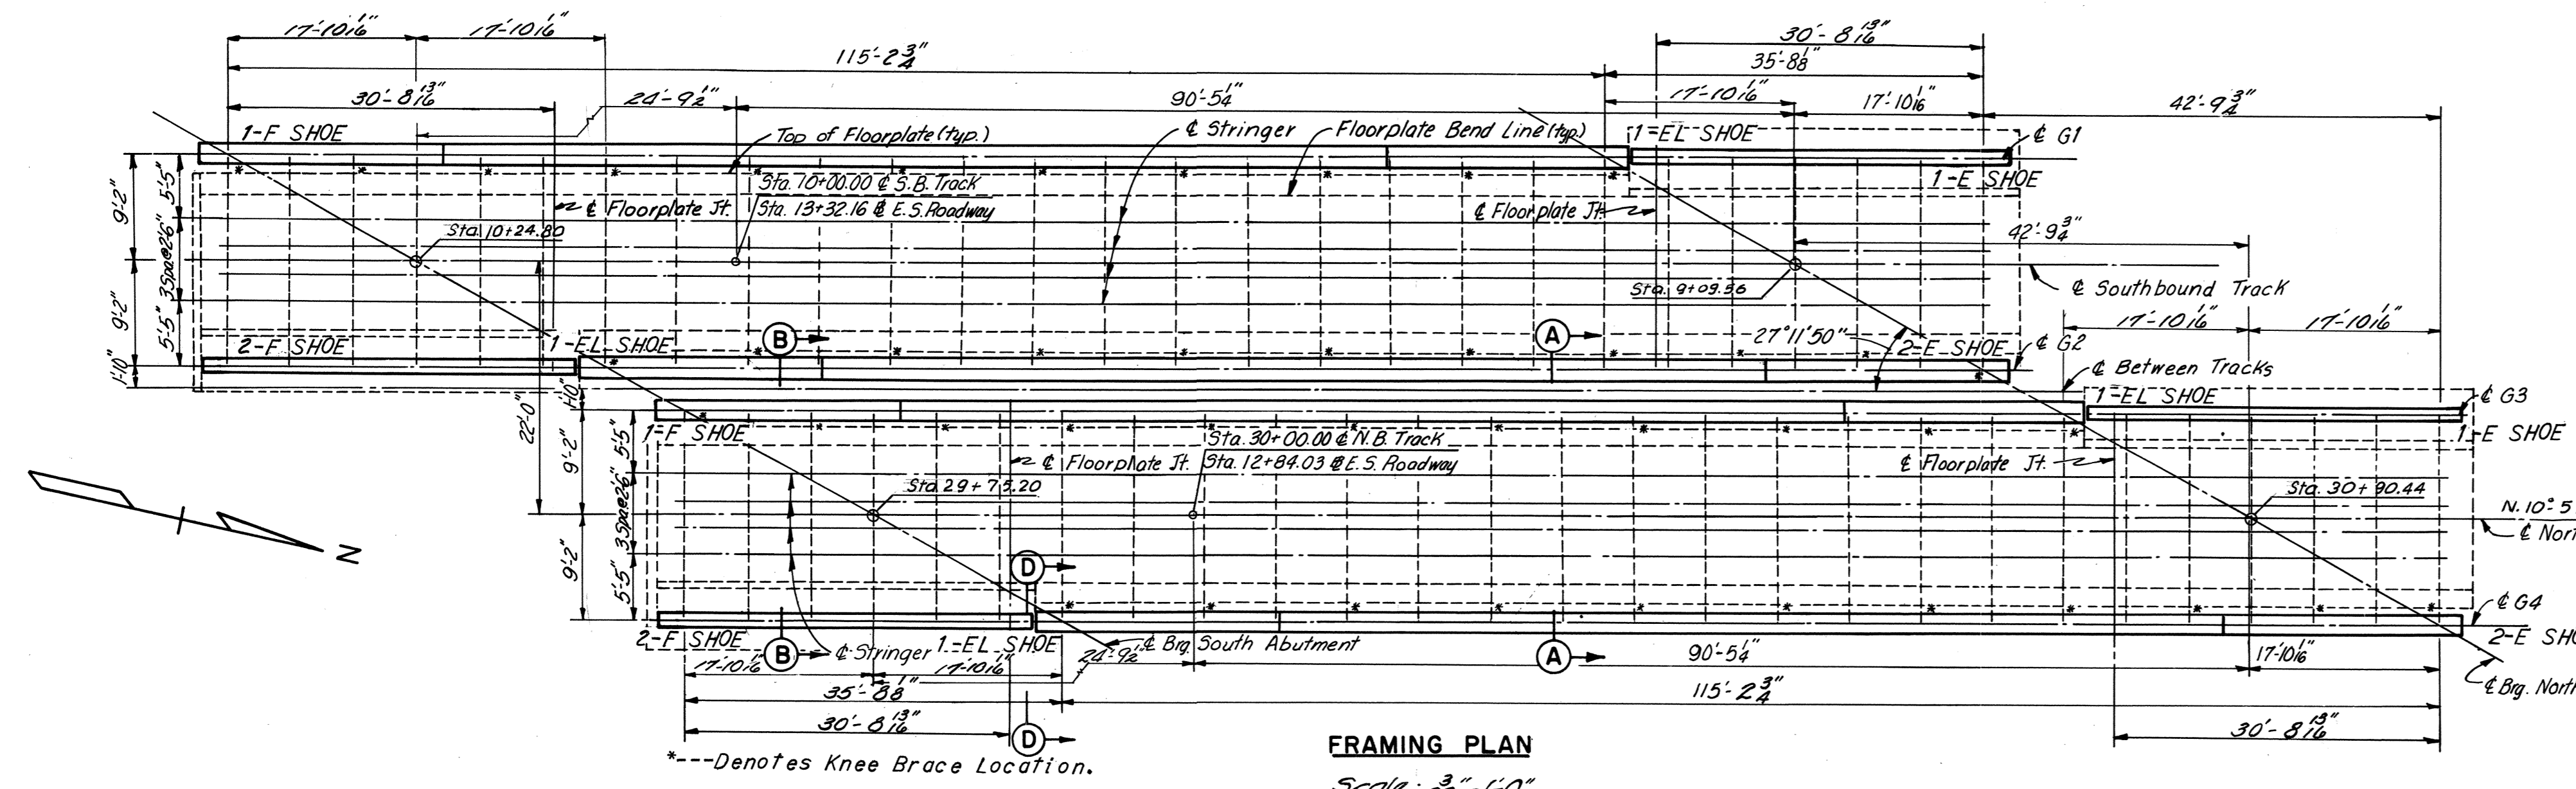


FRAMING PLAN
Scale: 3/32" = 1'-0"

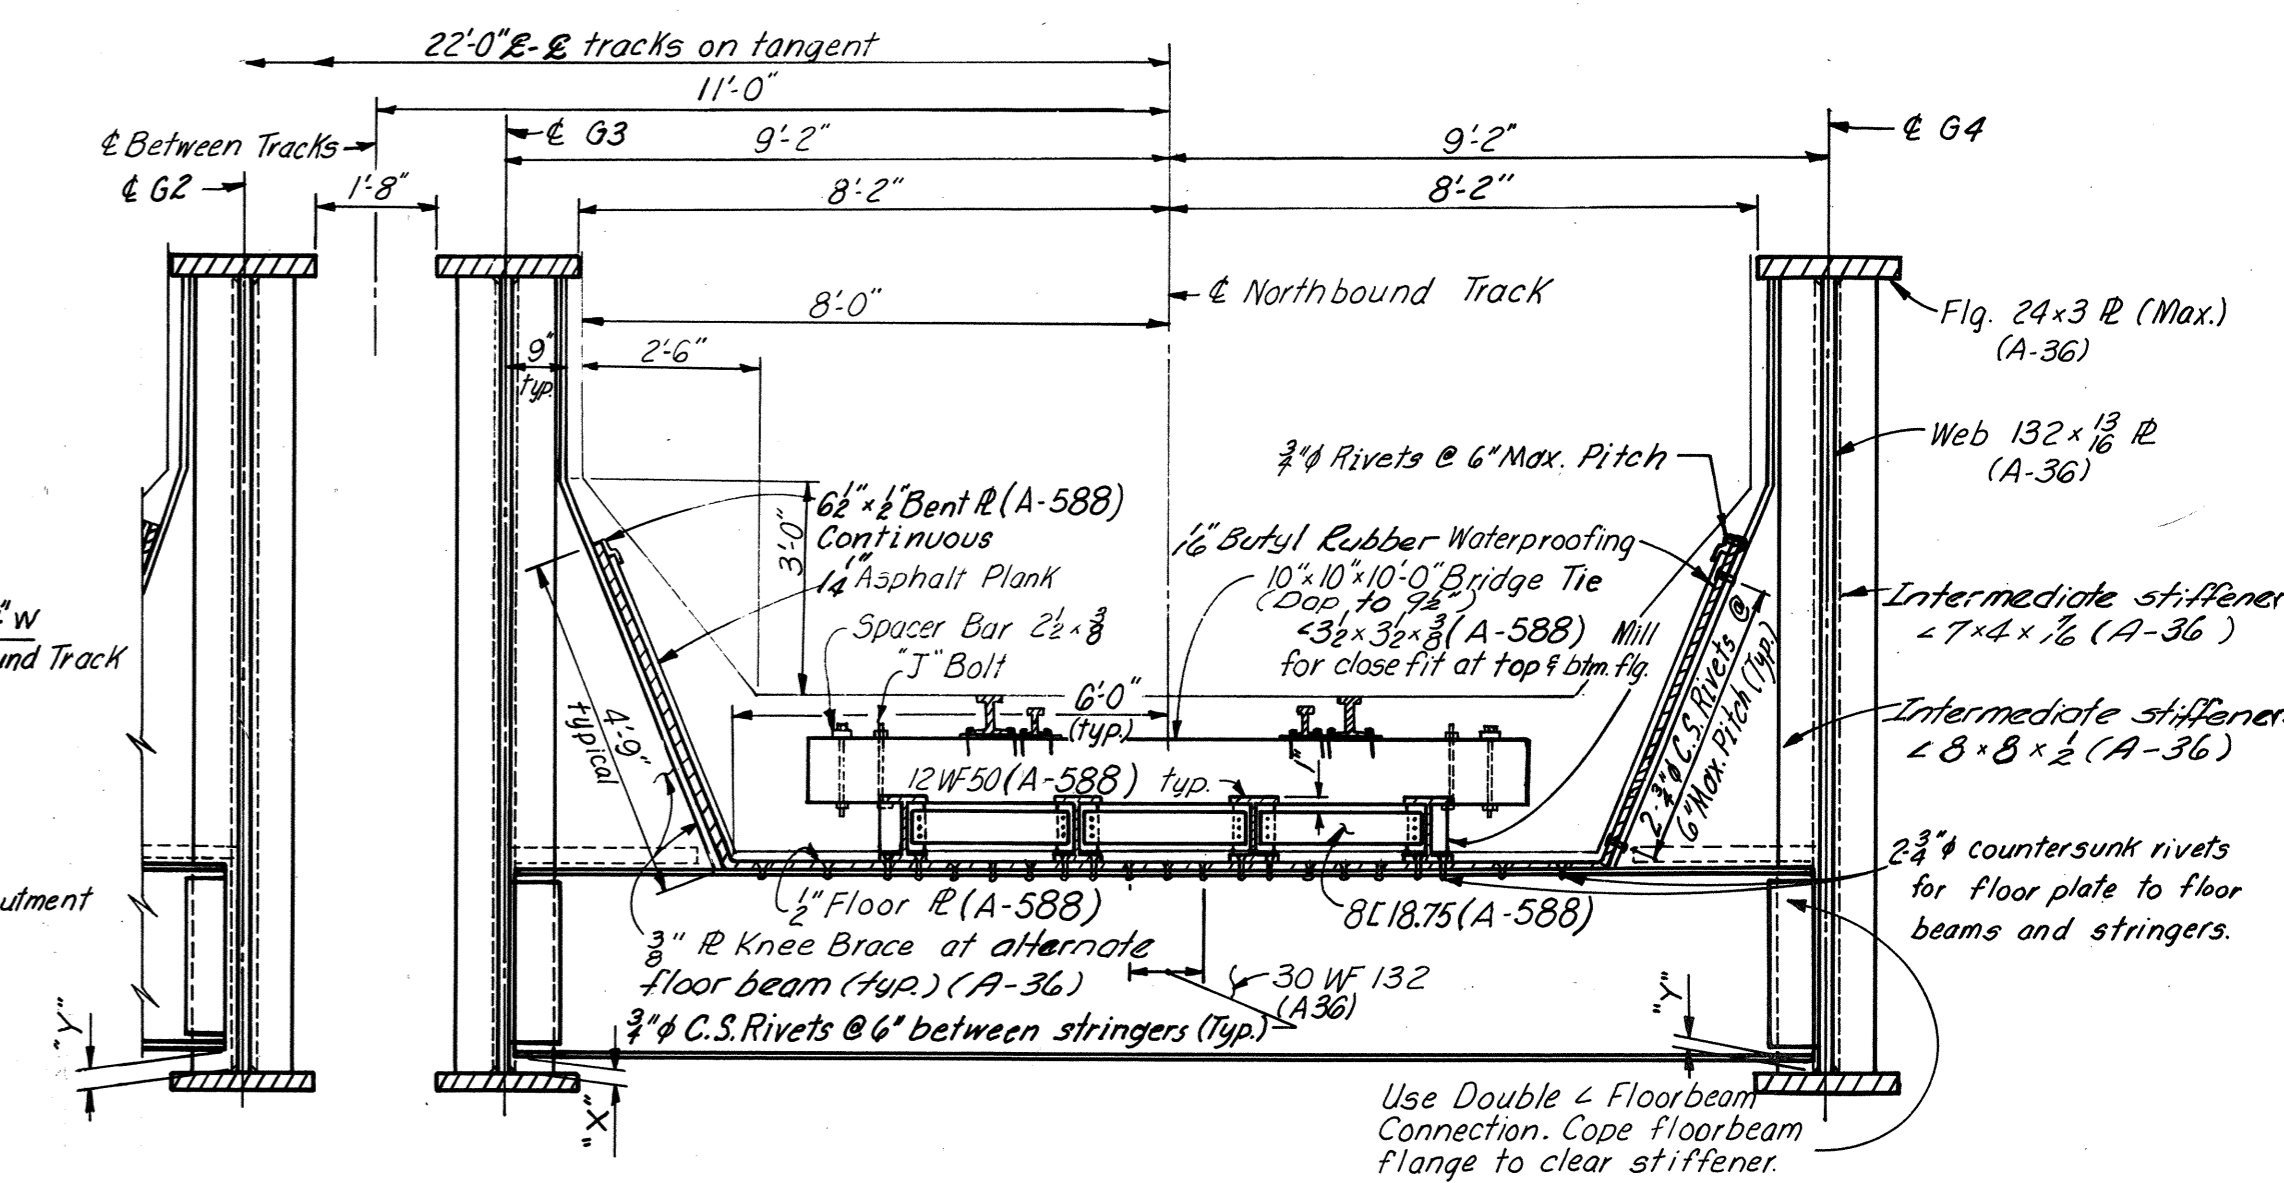


SECTION A-A
Scale: 3/8" = 1'-0"

Note: Floorplate connected to stringers by two rows of 3/4" Dia. countersunk rivets at 6" maximum pitch.


Note: Ties, track, and fasteners are to be furnished and installed by others.

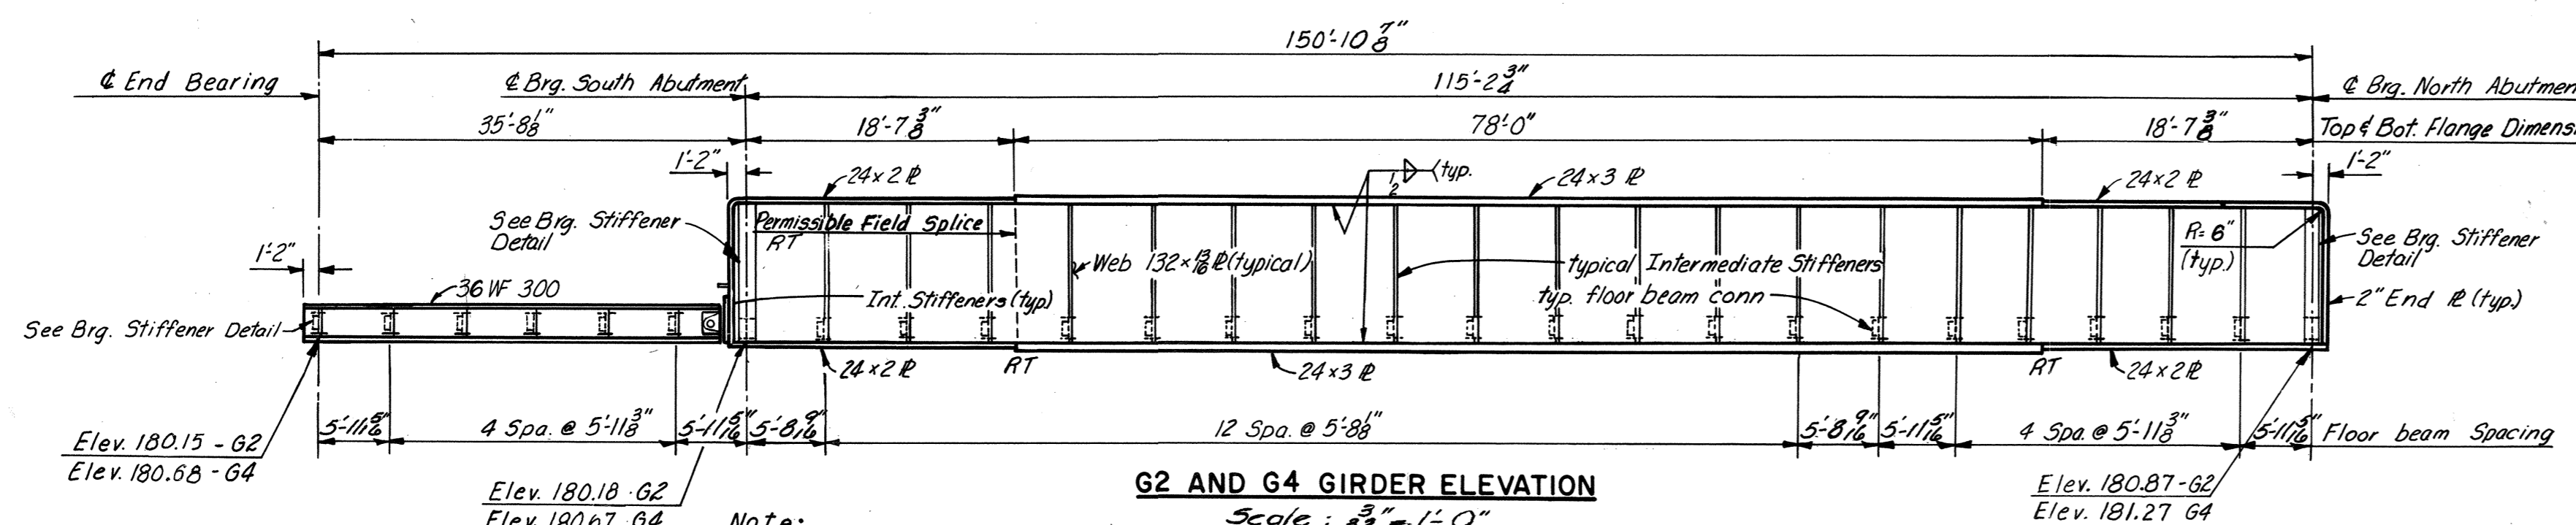

G2 AND G4 GIRDER ELEVATION
Scale: 3/32" = 1'-0"

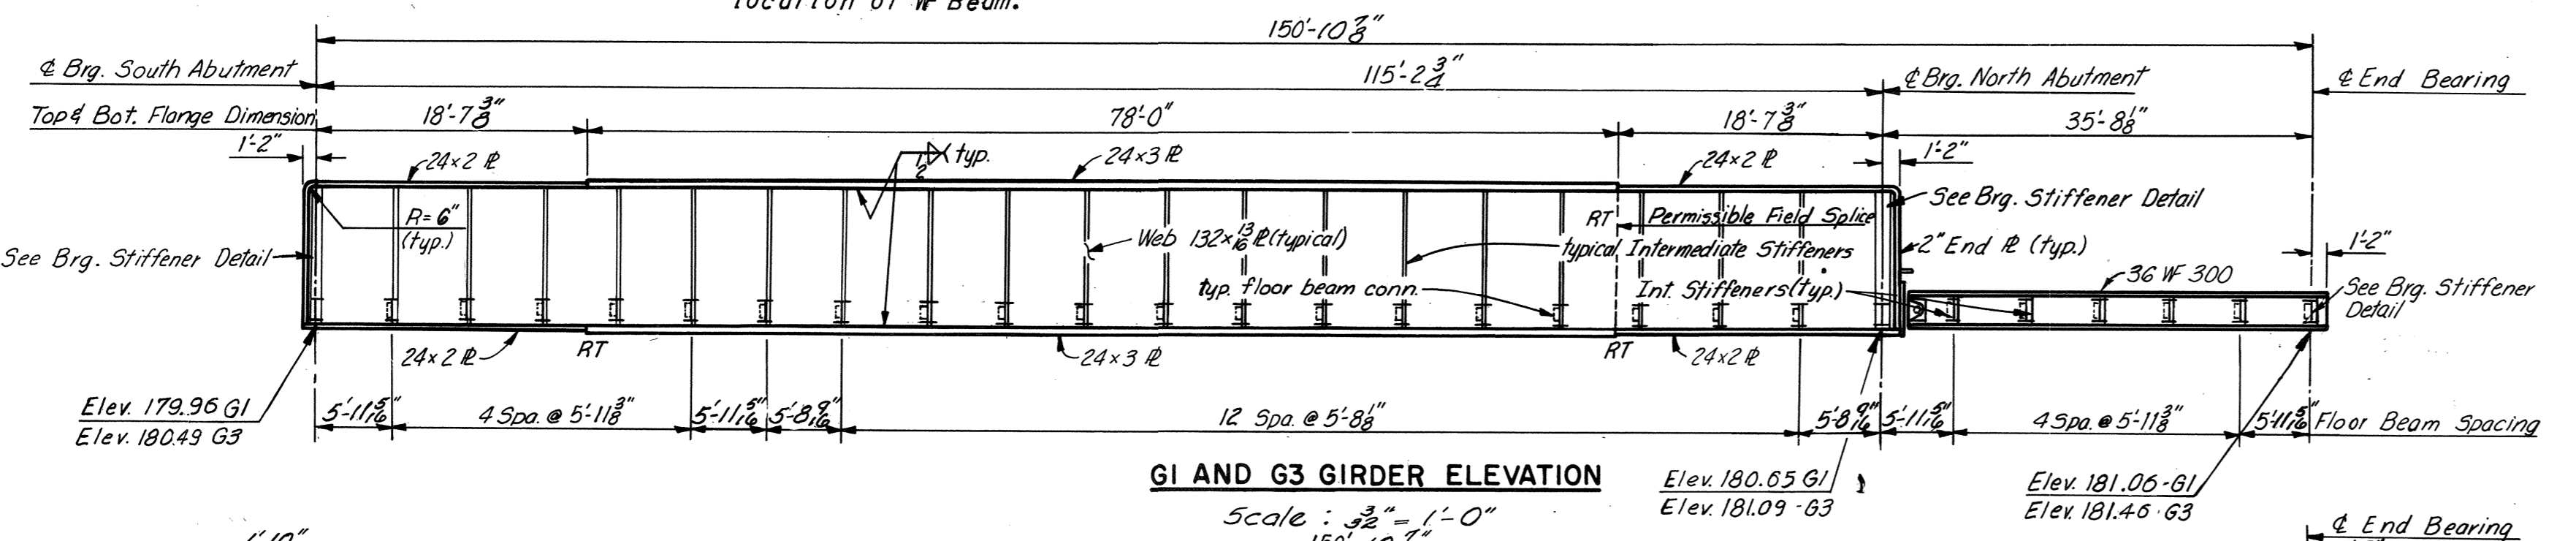

G1 AND G3 GIRDER ELEVATION
Scale: 3/32" = 1'-0"

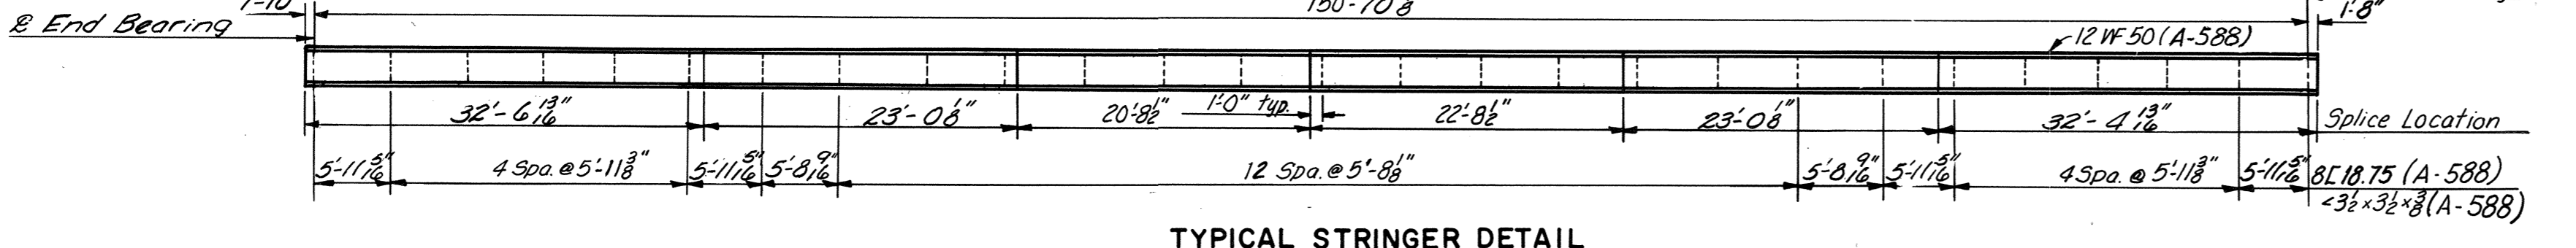

TYPICAL STRINGER DETAIL
Scale: 3/32" = 1'-0"

FLOOR BEAM LOCATION TABLE		
SOUTHBOUND TRACK		
DISTANCE	DIMENSION "X"	DIMENSION "Y"
0	2 3/4"	3"
5'-11 5/8"	2 3/4"	3"
11'-10 1/4"	2 3/4"	3"
17'-10 1/4"	2 3/4"	3"
23'-9 3/4"	2 3/4"	3"
29'-8 3/4"	2 3/4"	3"
35'-8 3/4"	3"	3"
41'-4 1/4"	3"	3"
47'-0 3/4"	3"	3"
52'-8 3/4"	3"	3"
58'-5 1/4"	3"	3"
64'-1 3/4"	3"	3"
69'-9 3/4"	3"	3"
75'-5 1/4"	3"	3"
81'-1 3/4"	3"	3"
86'-9 1/4"	3"	3"
92'-5 1/4"	3"	3"
98'-1 1/4"	3"	3"
103'-10 1/4"	3"	3"
109'-6 3/4"	3"	3"
115'-2 3/4"	3"	3"
121'-2 1/4"	3"	2 3/4"
127'-1 1/4"	3"	2 3/4"
133'-0 3/4"	3"	2 3/4"
139'-0 3/4"	3"	2 3/4"
144'-11 3/4"	3"	2 3/4"
150'-10 3/4"	3"	2 3/4"

FLOOR BEAM LOCATION TABLE		
NORTHBOUND TRACK		
DISTANCE	DIMENSION "X"	DIMENSION "Y"
0	3"	2 3/4"
5'-11 5/8"	3"	2 3/4"
11'-10 1/4"	3"	2 3/4"
17'-10 1/4"	3"	2 3/4"
23'-9 3/4"	3"	2 3/4"
29'-8 3/4"	3"	2 3/4"
35'-8 3/4"	3"	3"
41'-4 1/4"	3"	3"
47'-0 3/4"	3"	3"
52'-8 3/4"	3"	3"
58'-5 1/4"	3"	3"
64'-1 3/4"	3"	3"
69'-9 3/4"	3"	3"
75'-5 1/4"	3"	3"
81'-1 3/4"	3"	3"
86'-9 1/4"	3"	3"
92'-5 1/4"	3"	3"
98'-1 1/4"	3"	3"
103'-10 1/4"	3"	3"
109'-6 3/4"	3"	3"
115'-2 3/4"	3"	3"
121'-2 1/4"	2 3/4"	3"
127'-1 1/4"	2 3/4"	3"
133'-0 3/4"	2 3/4"	3"
139'-0 3/4"	2 3/4"	3"
144'-11 3/4"	2 3/4"	3"
150'-10 3/4"	2 3/4"	3"

Note: All riveted connections shown hereon may, at the contractors option, be replaced by high strength bolt connections.

RADIOGRAPHIC INSPECTION NOTE
An "RT" shown on elevation views indicates radiographic inspection of adjacent flange and web, flange, or web welds in accordance with the Special Provisions.

Note: Welded Girders are to be cambered to compensate for full anticipated dead load, see Sheet 10.

Notes - Southbound Track:
Distances shown in Floor Beam Table are measured from north to south, starting at the extreme north floor beam. Dimensions "X" and "Y" shown in Floor Beam Table for G1 and G2 are measured from top of bottom flange for Plate Girder section and from bottom of WF Beam section.
Elevations shown on Girder Elevations are at bottom of bottom flange for Plate Girder section and for WF Beam section.

Notes - Northbound Track:
Distances shown in Floor Beam Table are measured from south to north, starting at the extreme south floor beam. Dimensions "X" and "Y" shown in Floor Beam Table for G3 and G4 are measured from top of bottom flange for Plate Girder section and from bottom of WF Beam section.
Elevations shown on Girder Elevations are at bottom of bottom flange for Plate Girder section and for WF Beam section.

Notes:
For Shoe Details, see Sheet 11.
For Dead Load Deflections, see Sheet 10.
For Superstructure Details, see Sheets 9 and 10.
For Sections B-B, and D-D, see Sheet 10.

BY	DATE	NO.	REVISION	BY	DATE
4	As Built	ARC	3-73		
1	Addendum 3 Amendment 3	EE	4-12-71		
2	Profile Grade	EE	4-12-71		
1	General Checking	AMH	5-13-68		

Note: One butt welded shop splice will be permitted in each 24" x 3" flange plate; details of splice shall be similar to that shown for Field Flange Splice, sheet 9.A maximum of 2 web splices including web splice at "Permissible Field Splice" will be permitted; detail of shop web splice shall be similar to that shown for Field Flange Splice, sheet 9, except that web opening is not required and web splice shall not be located within 2'-0" of a shop flange splice.





AS BUILT

RICHMOND METROPOLITAN AUTHORITY
RICHMOND EXPRESSWAY SYSTEM
BELTLINE EXPRESSWAY
BRIDGE NO. 10
R.F.&P.R.R. OVER
EAST-SOUTH ROADWAY
FRAMING PLAN

HOWARD, NEEDLES, TAMMEN & BERGENDOFF
consulting engineers
NEW YORK ALEXANDRIA KANSAS CITY

SCALE: As Noted
CONTRACT NO.: 4
SHEET NO. 8 OF 12

RICHMOND EXPRESSWAY SYSTEM			
SECTION	PROJECT	SHEET NO.	TOTAL SHEETS
10	DOWNTOWN EXPRESSWAY	70	265

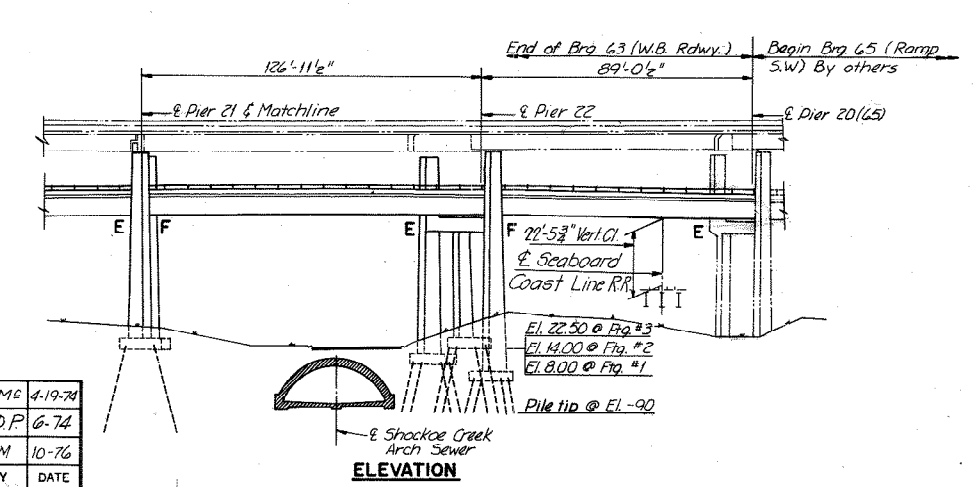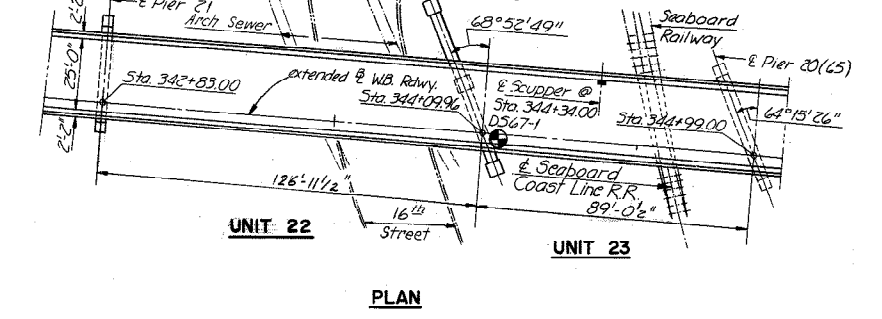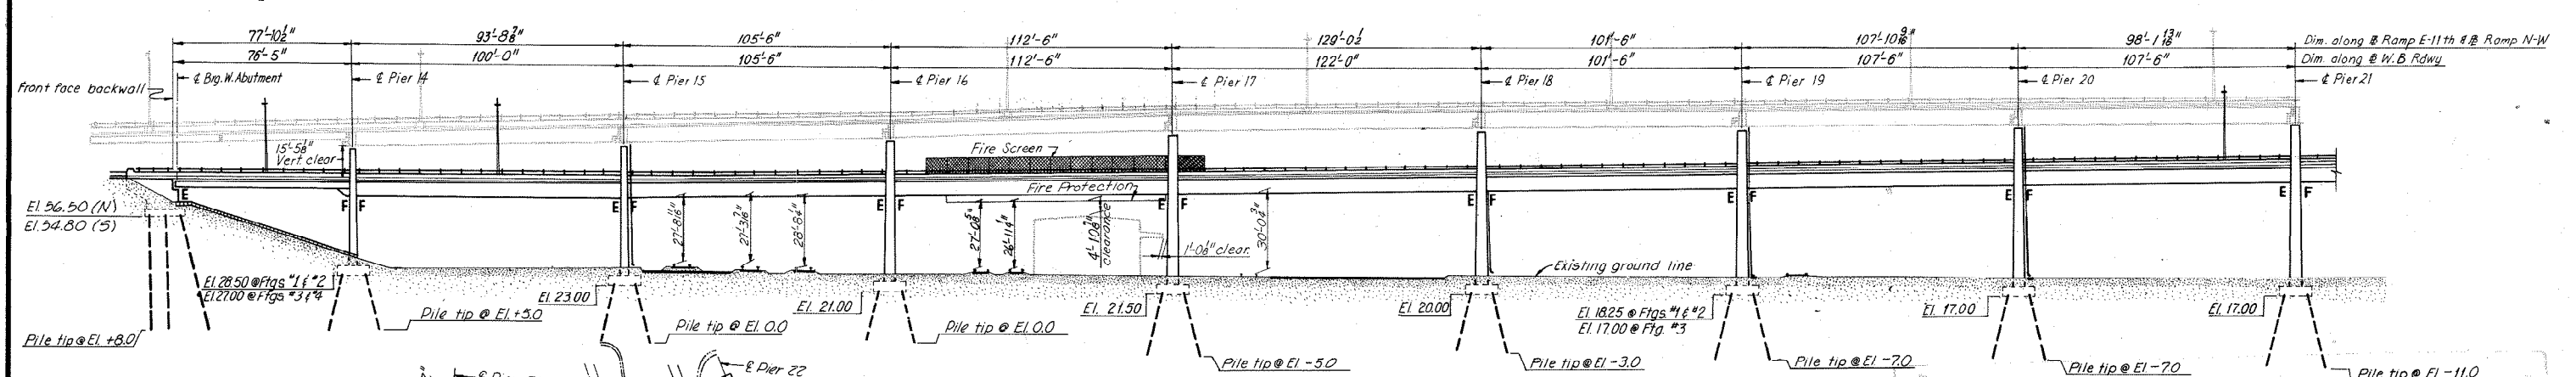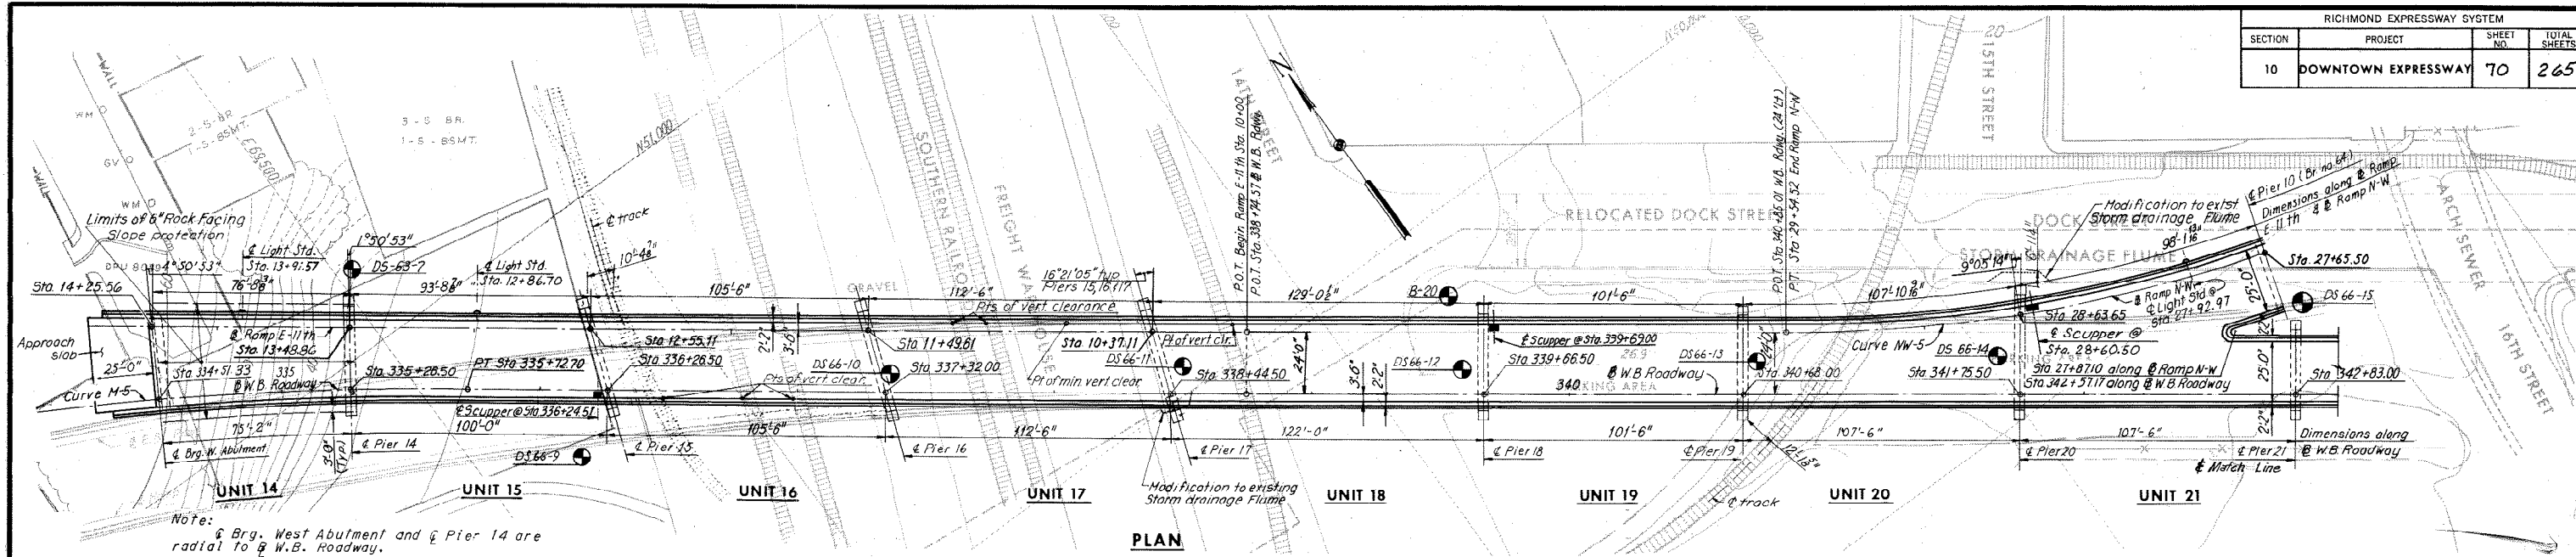

# W.B. Roadway		# Ramp N-W	
Curve: M-5		Curve NW-5	
P.I. = Sta. 334+26.15		P.I. = Sta. 28+25.38	
Δ = 11°45'15"		Δ = 26°18'00"	
D = 4°00'		D = 10°00'	
T = 147.59'		T = 133.86'	
L = 294.14'		L = 263.00'	
R = 1432.40'		R = 572.96'	

HORIZONTAL CURVE DATA

Notes:
 For Estimated quantities and General Notes see Sheet 2.
 For Boring Logs see Sheets 26 thru 29.
 For Layout of Pier 10(64) see Bridge No. 64 (Ramp N-W) Sheet 3.
 ● Indicates boring location.
 Footing numbers (1, 2, etc.) on each pier go from North to South.
 For Profile Grade Data see Sheet 2.

INDEX	SHEET
GENERAL PLAN AND ELEVATION.	1
QUANTITIES	2
WEST ABUTMENT	3
WEST ABUTMENT DETAILS	4
PIER 14	5
PIER 15	6
PIER 16	7
PIER 17	8
PIERS 18 AND 19	9
PIER 20	10
PIER 21	11
PIER 22	12
FRAMING PLAN UNITS 14, 15 AND 16.	13
FRAMING PLAN UNITS 17 AND 18.	14
FRAMING PLAN UNITS 19, 20 AND 21.	15
FRAMING DETAILS UNITS 20 AND 21.	16
FRAMING PLAN UNITS 22 AND 23.	17
DECK PLAN UNITS 14, 15 AND 16.	18
DECK PLAN UNITS 17 AND 18.	19
DECK PLAN UNITS 19, 20 AND 21.	20
DECK PLAN UNITS 22 AND 23.	21
SUPERSTRUCTURE DETAILS.	22
FIRE PROTECTION DETAILS.	23
JOINT DETAILS.	24
APPROACH SLABS AND SLOPE PROTECTION DETAILS.	25
BORING LOGS.	26 THRU 29
STANDARD SHEETS.	30 THRU 57

BY	DATE	Joint Type & Rail-Road Name Added	PRM	DATE
MADE	Y.C.P. 1-9-69	Seaboard Coast Line Added to Elev.	K.D.P.	6-74
CHECKED	J.D. 3-13-69	As Built	TEM	10-76
IN CHARGE	FRD			

RICHMOND METROPOLITAN AUTHORITY
RICHMOND EXPRESSWAY SYSTEM
DOWNTOWN EXPRESSWAY







BRIDGE NO. 63
WESTBOUND ROADWAY OVER
12TH ST. - R.R. TRACKS AND 16TH ST.
GENERAL PLAN AND ELEVATION

HOWARD, NEEDLES, TAMMEN & BERGENDOFF
 consulting engineers
 NEW YORK ALEXANDRIA KANSAS CITY


SCALE: 1" = 30'
 CONTRACT NO. 10
 SHEET NO. 1 OF 29

AS BUILT

RICHMOND EXPRESSWAY SYSTEM			
SECTION	PROJECT	SHEET NO.	TOTAL SHEETS
10	DOWNTOWN EXPRESSWAY	78	265

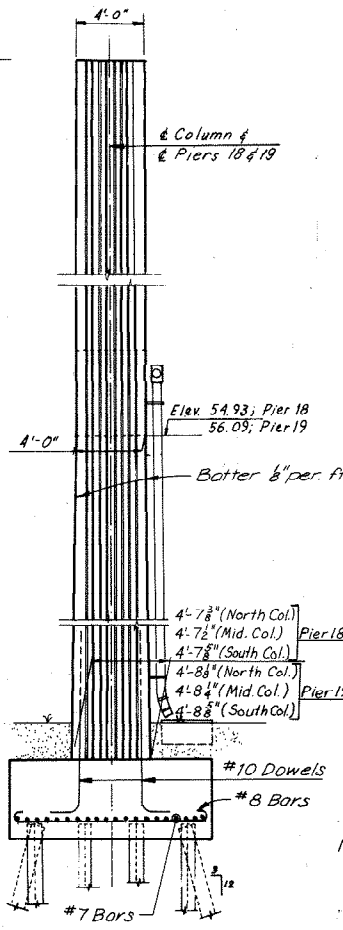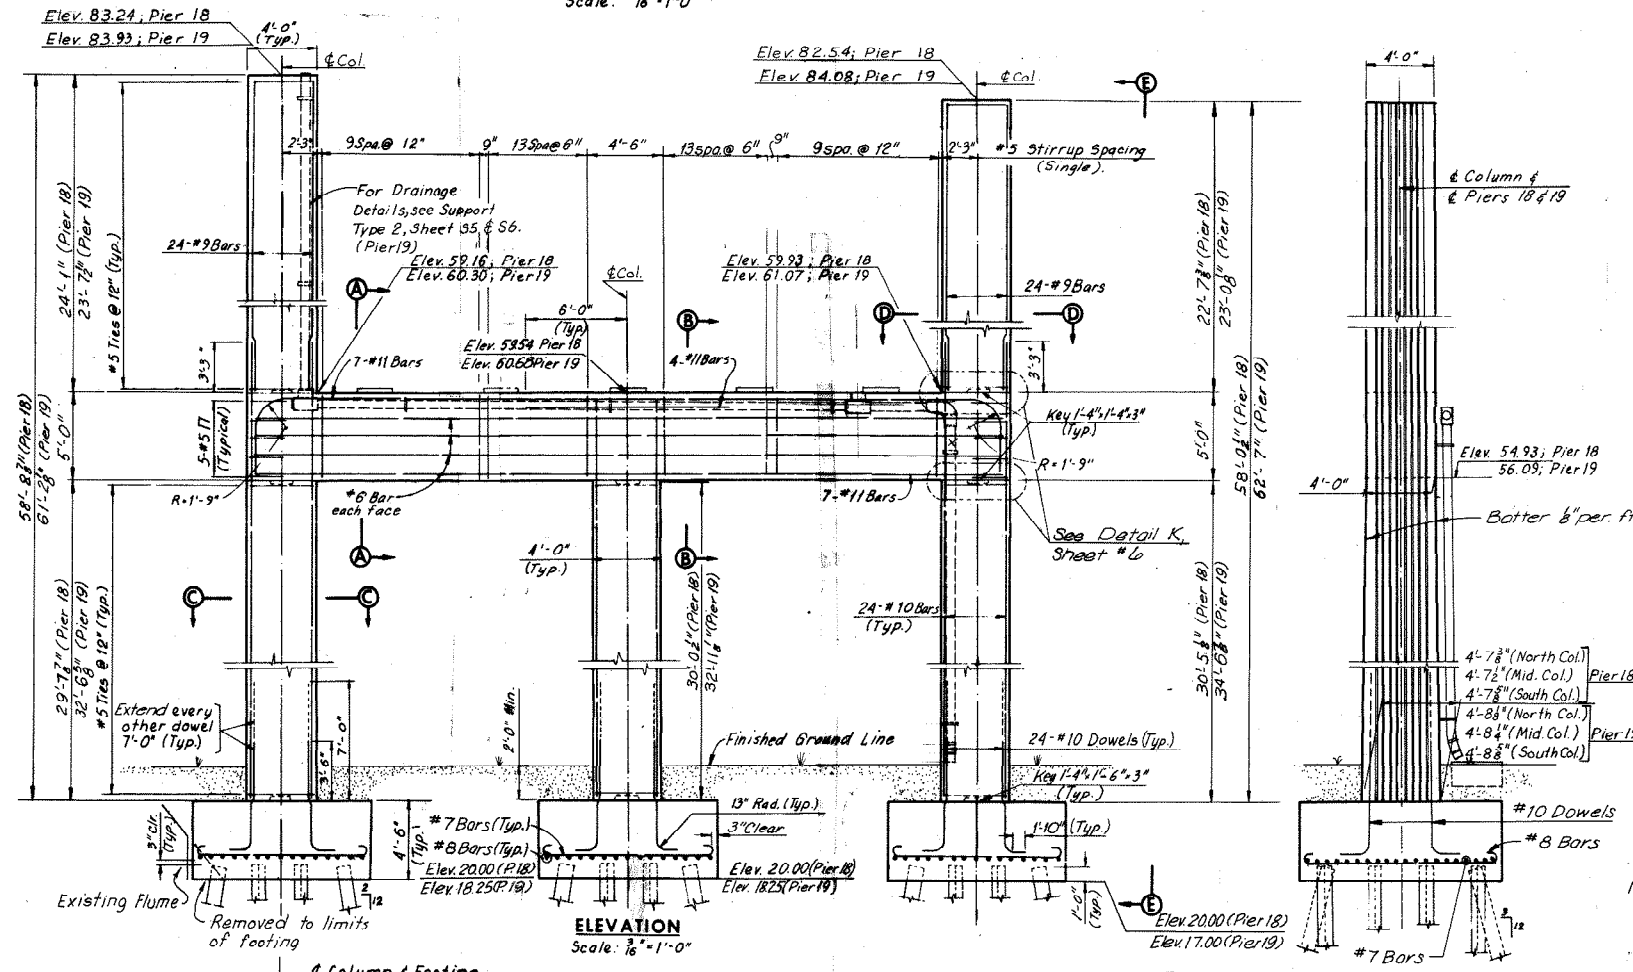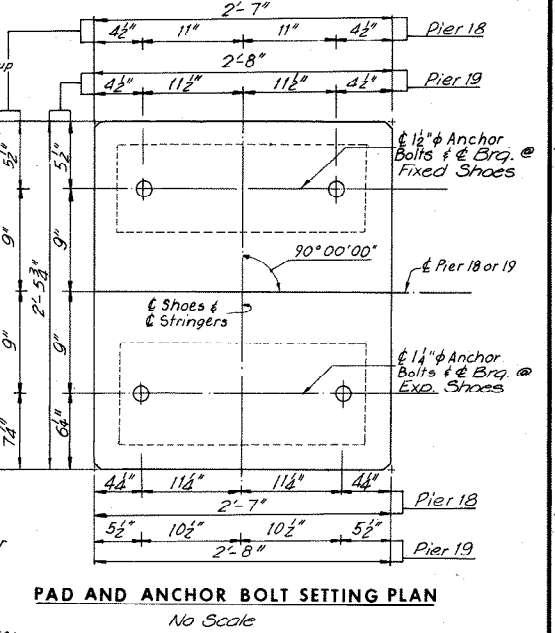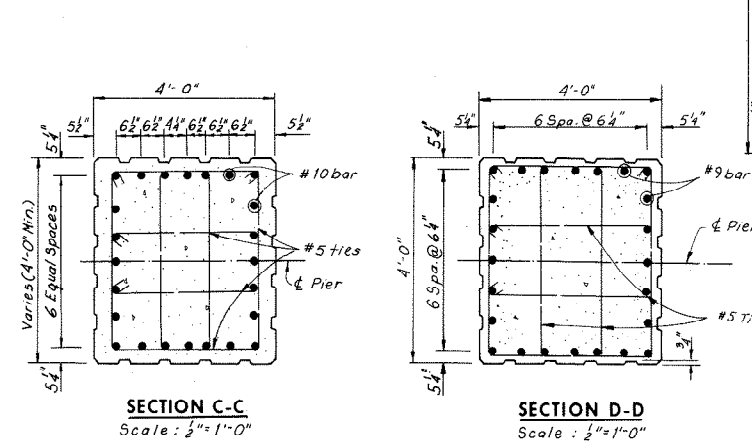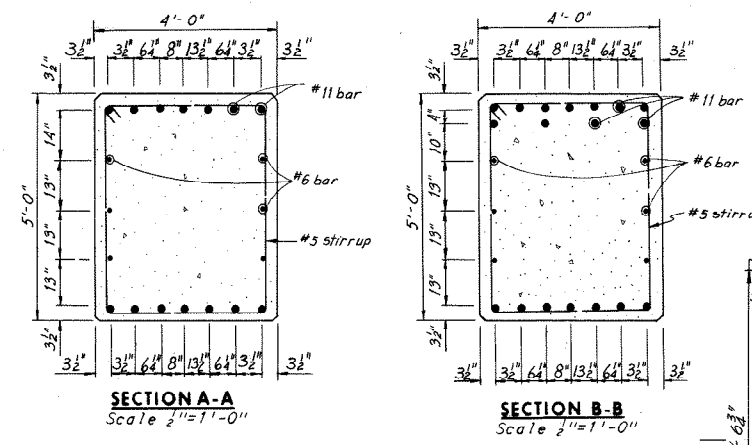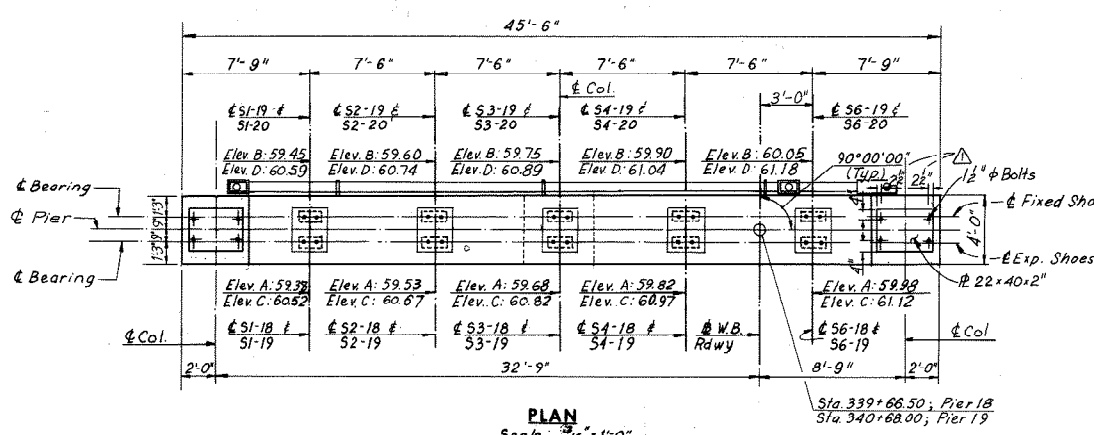

Note:
1) Footing elevations are approximate only and may be varied to suit field conditions as directed by the Engineer. Vertical shaft reinforcing shall not be cut until these elevations are established. Where elevations change more than 2 ft. redesign will be required.
2) Flume modification at Pier 18 only.

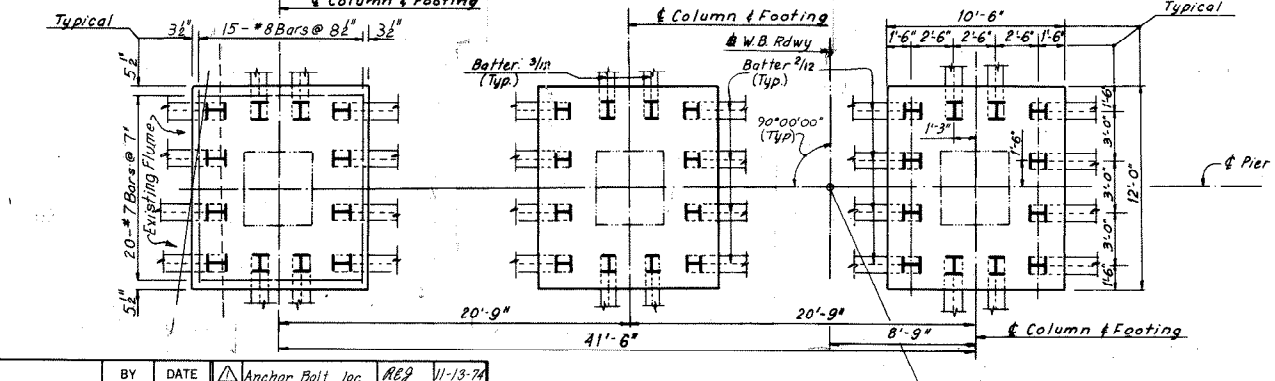

BY	DATE	Anchor Bolt Loc.	REVISION	BY	DATE
MADE	C.E.B. 12-13-68	2 As Built		TEM	10-76
CHECKED	PTA 01-24-69				
IN CHARGE					

Note:
Dimensions given in Footing Plan are measured at bottom of Footing.

RICHMOND METROPOLITAN AUTHORITY
RICHMOND EXPRESSWAY SYSTEM
DOWNTOWN EXPRESSWAY



BRIDGE NO. 63
WESTBOUND ROADWAY OVER
12TH ST. - R.R. TRACKS AND 16TH ST.
PIERS 18 AND 19

HOWARD, NEEDLES, TAMMEN & BERGENDOFF
consulting engineers
NEW YORK ALEXANDRIA KANSAS CITY

SCALE: As Noted
CONTRACT NO.: 10
SHEET NO.: 9 OF 29


AS BUILT

RICHMOND EXPRESSWAY SYSTEM			
SECTION	PROJECT	SHEET NO.	TOTAL SHEETS
10	DOWNTOWN EXPRESSWAY	84	265

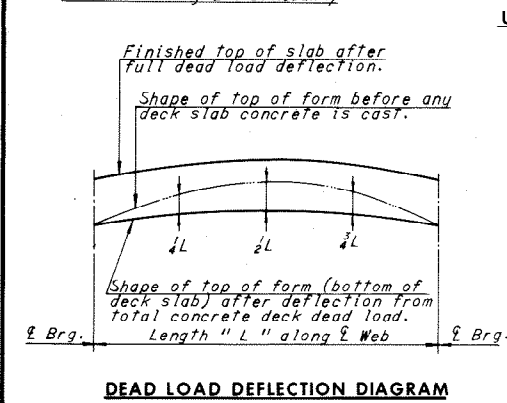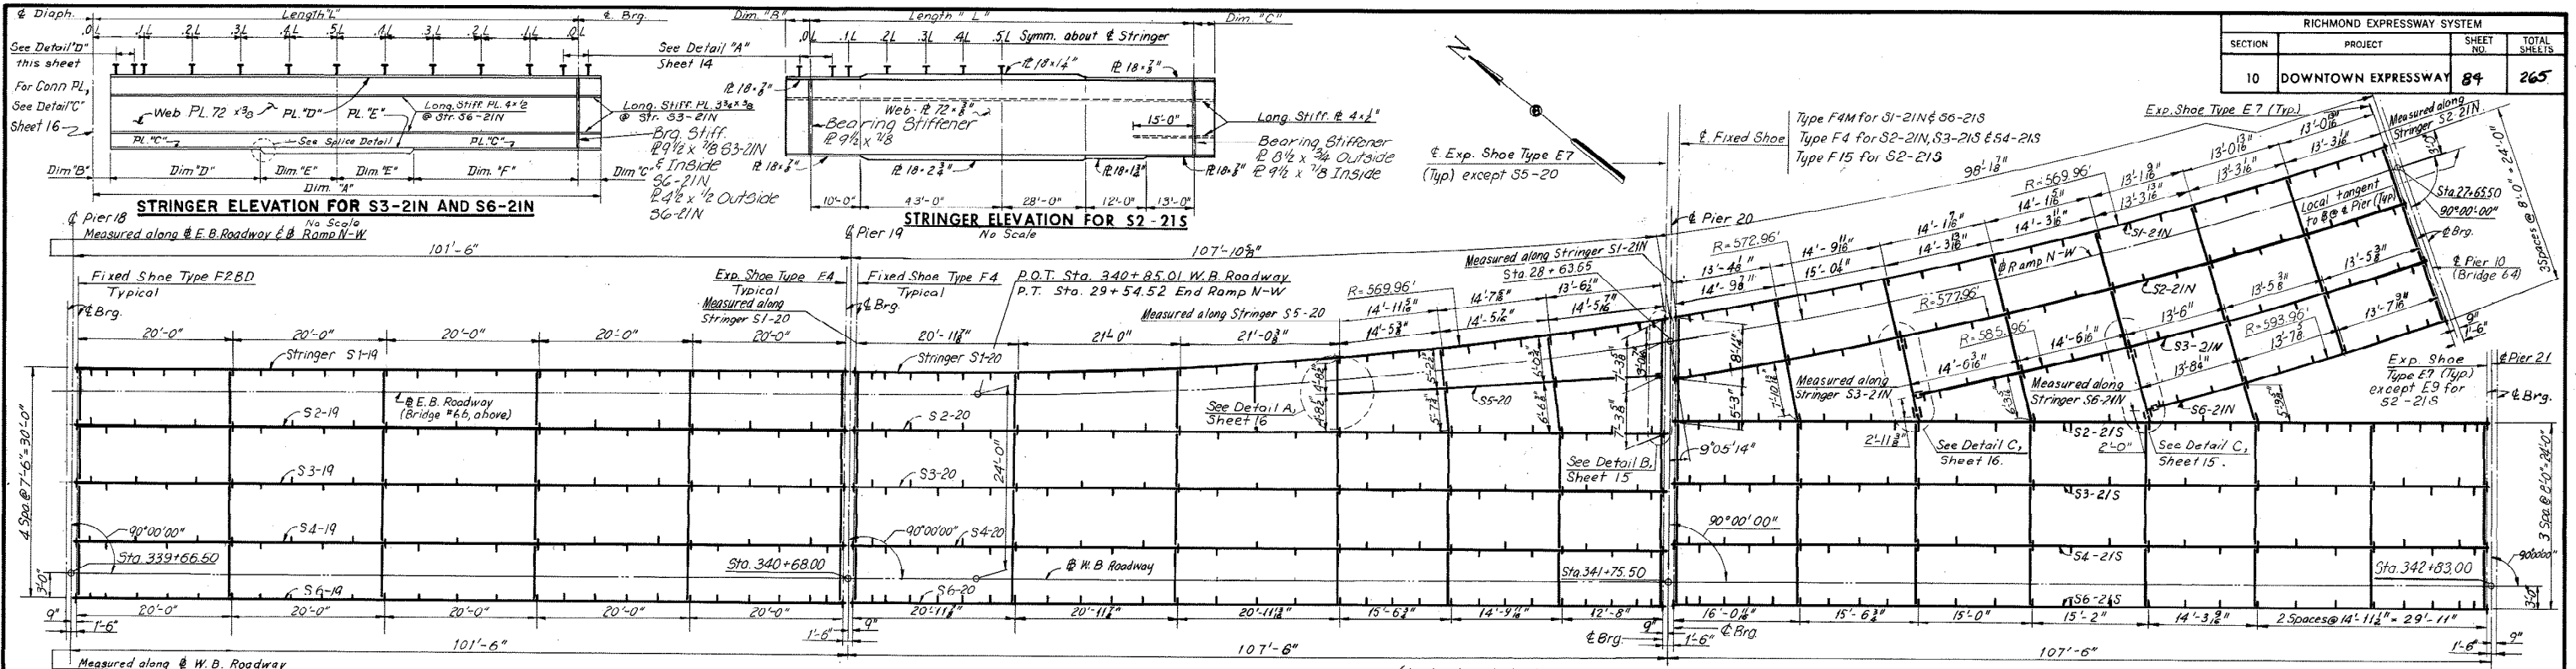


NOTE TO CONTRACTOR

Deflections given are those anticipated to occur in the stringer upon placement of the total concrete deck dead load. In practice, the stringers in place are not likely to have the exact camber to compensate for these deflections during construction. The residual amounts shall be provided by adjusting forms to vary the thickness of the concrete haunch between the bottom of the slab and the top of stringer without altering the slab thickness.

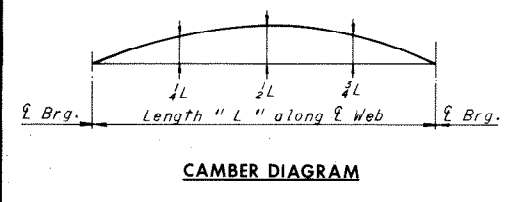


NOTE TO FABRICATOR

The stringers shall be fabricated with an upward camber amounting to the tabulated value. This will provide approximate compensation conformity with finished grade. Dimensions are in inches. (-) Sign in camber denotes downward camber.

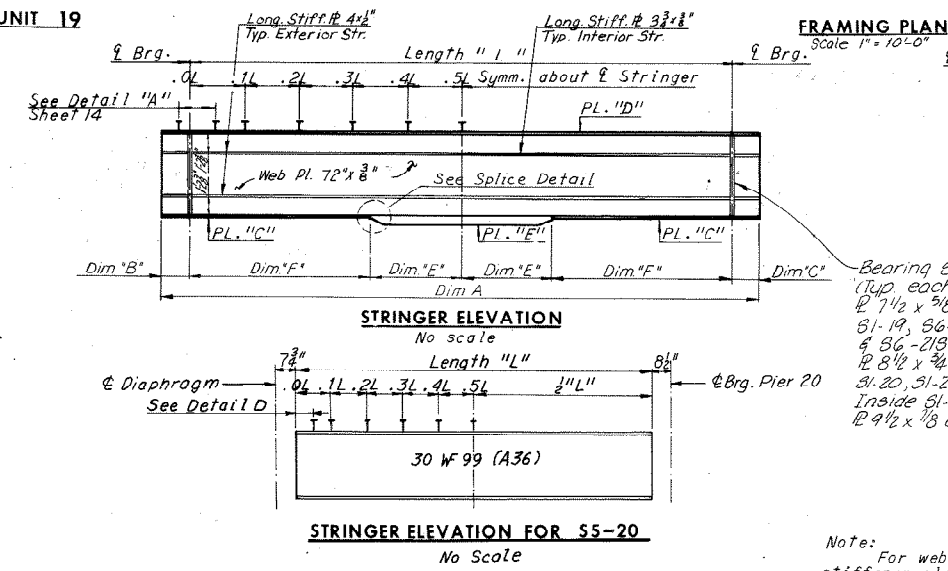


UNIT	STRINGER	Dim. "A"	LENGTH "L"	Dim. "B"	Dim. "C"	Dim. "D"	Dim. "E"	Dim. "F"	PL. "C"	PL. "D"	PL. "E"	MAX. SHEAR STUD SPACING					DEAD LOAD DEFLECTION SCHEDULE			CAMBER SCHEDULE						
												0.0L-0.1L	0.1L-0.2L	0.2L-0.3L	0.3L-0.4L	0.4L-0.5L	1/4	1/2	3/4	1/4	1/2	3/4				
19	S1-19	101'-4"	100'-0"	8"	8"	--	25'-0"	25'-0"	15x3"	15x3"	15x14"	14 1/2"	17"	20"	24"	24"	1 1/2"	1 3/8"	1 1/2"	1 1/2"	1 3/8"	1 1/2"	1 1/2"	1 1/2"	1 1/2"	1 1/2"
	S2-19	101'-2"	100'-0"	7"	7"	--	24'-0"	26'-0"	15x3"	15x3"	15x14"	16"	18"	21"	24"	24"	1 1/2"	1 3/8"	1 1/2"	1 1/2"	1 3/8"	1 1/2"	1 1/2"	1 1/2"	1 1/2"	1 1/2"
	S3-19	101'-2"	100'-0"	7"	7"	--	24'-0"	26'-0"	15x3"	15x3"	15x14"	16"	18"	21"	24"	24"	1 1/2"	1 3/8"	1 1/2"	1 1/2"	1 3/8"	1 1/2"	1 1/2"	1 1/2"	1 1/2"	1 1/2"
	S4-19	101'-2"	100'-0"	7"	7"	--	24'-0"	26'-0"	15x3"	15x3"	15x14"	16"	18"	21"	24"	24"	1 1/2"	1 3/8"	1 1/2"	1 1/2"	1 3/8"	1 1/2"	1 1/2"	1 1/2"	1 1/2"	1 1/2"
	S6-19	101'-4"	100'-0"	8"	8"	--	25'-0"	25'-0"	15x3"	15x3"	15x14"	14 1/2"	17"	20"	24"	24"	1 1/2"	1 3/8"	1 1/2"	1 1/2"	1 3/8"	1 1/2"	1 1/2"	1 1/2"	1 1/2"	1 1/2"
20	S1-20	107'-8 3/8"	106'-4 1/2"	8"	8 1/2"	--	34'-0"	19'-2 1/2"	18x3"	18x3"	18x13"	12"	13 1/2"	17 1/2"	21 1/2"	24"	1 1/2"	1 1/2"	1 1/2"	1 1/2"	1 1/2"	1 1/2"	1 1/2"	1 1/2"	1 1/2"	1 1/2"
	S2-20	107'-2"	106'-0"	7"	7"	--	29'-6"	23'-6"	15x3"	15x3"	15x13"	15 1/2"	18"	21"	24"	24"	1 1/2"	1 3/8"	1 1/2"	1 1/2"	1 3/8"	1 1/2"	1 1/2"	1 1/2"	1 1/2"	
	S3-20	107'-2"	106'-0"	7"	7"	--	29'-6"	23'-6"	15x3"	15x3"	15x13"	15 1/2"	18"	21"	24"	24"	1 1/2"	1 3/8"	1 1/2"	1 1/2"	1 3/8"	1 1/2"	1 1/2"	1 1/2"	1 1/2"	
	S4-20	107'-2"	106'-0"	7"	7"	--	29'-6"	23'-6"	15x3"	15x3"	15x13"	15 1/2"	18"	21"	24"	24"	1 1/2"	1 3/8"	1 1/2"	1 1/2"	1 3/8"	1 1/2"	1 1/2"	1 1/2"	1 1/2"	
	S5-20	--	41'-9 1/2"	--	--	--	--	--	--	Stringer Size 30W99	9"	10"	11"	13"	15"	15"	4"	4"	4"	4"	4"	4"	4"	4"	4"	4"
21	S6-20	107'-4"	106'-0"	8"	8"	--	28'-0"	25'-0"	15x3"	15x3"	15x14"	14 1/2"	17"	20"	24"	24"	1 1/2"	1 3/8"	1 1/2"	1 1/2"	1 3/8"	1 1/2"	1 1/2"	1 1/2"	1 1/2"	
	S1-21N	96'-11 1/2"	95'-7 3/4"	8 1/2"	8 1/2"	--	33'-0"	14'-9 3/4"	18x3"	18x3"	18x13"	15"	17"	22"	24"	24"	1 1/2"	1 3/8"	1 1/2"	1 1/2"	1 3/8"	1 1/2"	1 1/2"	1 1/2"	1 1/2"	
	S2-21N	99'-5 1/2"	98'-3 3/8"	7 1/2"	7 1/2"	--	34'-0"	15'-1 1/8"	18x3"	18x3"	18x13"	12 1/2"	14"	17 1/2"	24"	24"	1 1/2"	1 3/8"	1 1/2"	1 1/2"	1 3/8"	1 1/2"	1 1/2"	1 1/2"	1 1/2"	
	S3-21N	69'-4"	69'-5"	7 3/4"	7 1/2"	--	10'-0 3/4"	24'-0"	12x3"	12x3"	12x13"	11"	12"	15"	17"	20 1/2"	24"	1 1/2"	1 3/8"	1 1/2"	1 1/2"	1 3/8"	1 1/2"	1 1/2"	1 1/2"	1 1/2"
	S4-21N	107'-2"	106'-0"	7"	7"	--	28'-6"	24'-6"	15x3"	15x3"	15x13"	15 1/2"	17"	20"	22 1/2"	24"	1 1/2"	1 3/8"	1 1/2"	1 1/2"	1 3/8"	1 1/2"	1 1/2"	1 1/2"	1 1/2"	1 1/2"
	S6-21S	107'-4"	106'-0"	8"	8"	--	28'-6"	24'-6"	15x3"	15x3"	15x13"	14 1/2"	16 1/2"	19 1/2"	24"	24"	1 1/2"	1 3/8"	1 1/2"	1 1/2"	1 3/8"	1 1/2"	1 1/2"	1 1/2"	1 1/2"	1 1/2"

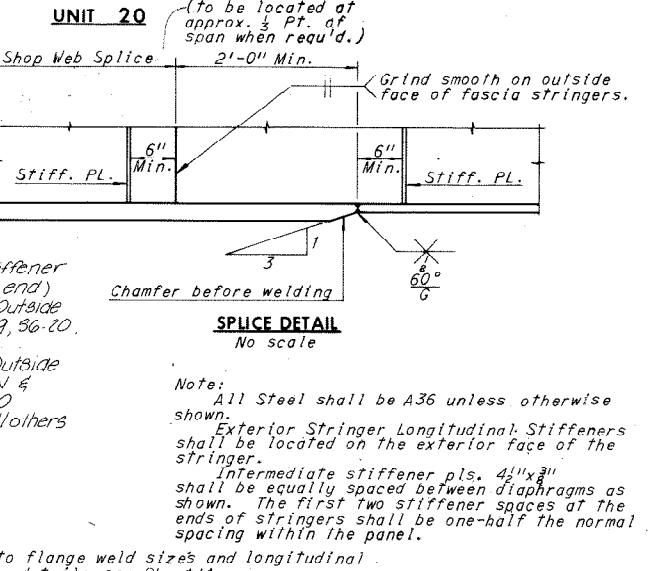

NOTE: All Steel shall be A36 unless otherwise shown. Exterior Stringer Longitudinal Stiffeners shall be located on the exterior face of the stringer. Intermediate stiffener pls. 4 1/2" x 3/8" shall be equally spaced between diaphragms as shown. The first two stiffener spaces at the ends of stringers shall be one-half the normal spacing within the panel.

SHOE SCHEDULE			
EXPANSION SHOES		FIXED SHOES	
TYPE	NO. REQD.	TYPE	NO. REQD.
E4	5	F2BD	5
E7	12	F4	8
E9	1	F15	1

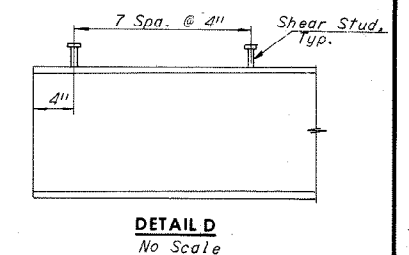

Notes:

- For Shoe details, see Sheets S152
- For Diaphragm details, see Sheet 20
- For Superstructure steel quantities, see Sheet 2
- For additional framing details, see Sheet 16
- For joint details, see Sheet 24
- For Shear stud detail see Sheet 14.

AS BUILT

RICHMOND METROPOLITAN AUTHORITY
RICHMOND EXPRESSWAY SYSTEM
DOWNTOWN EXPRESSWAY

BRIDGE NO. 63
WESTBOUND ROADWAY OVER
12TH ST. - R.R. TRACKS AND 16TH ST.
FRAMING PLAN—UNITS 19, 20 AND 21




HOWARD, NEEDLES, TAMMEN & BERGENDOFF
 consulting engineers
 NEW YORK ALEXANDRIA KANSAS CITY

SCALE: As Noted
 CONTRACT NO. 10
 SHEET NO. 15 OF 29

BY	DATE	Note Added	PRMS	4-19-74		
MADE	GSH	07-31-68	2	As Built	TEM	10-76
CHECKED	PTA	10-23-68				
IN CHARGE						

* Spacing begins at termination of B spaces @ 4".

RICHMOND EXPRESSWAY SYSTEM			
SECTION	PROJECT	SHEET NO.	TOTAL SHEETS
10	DOWNTOWN EXPRESSWAY	85	265

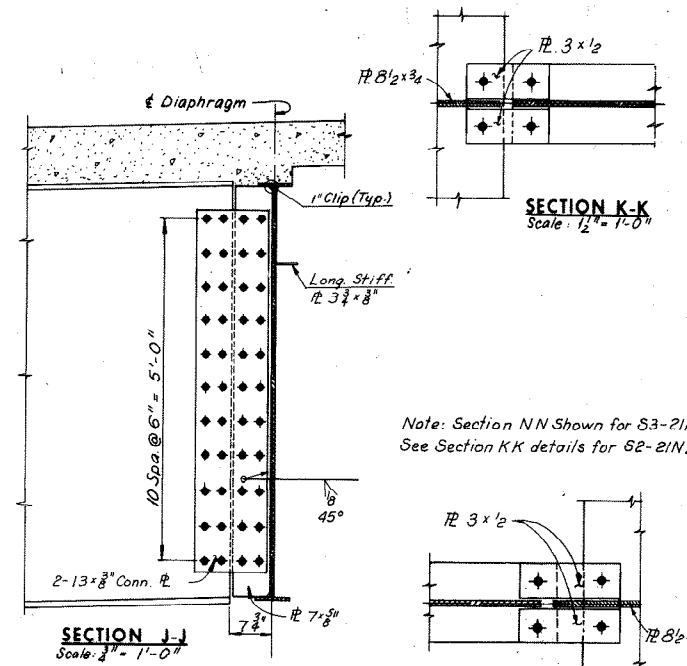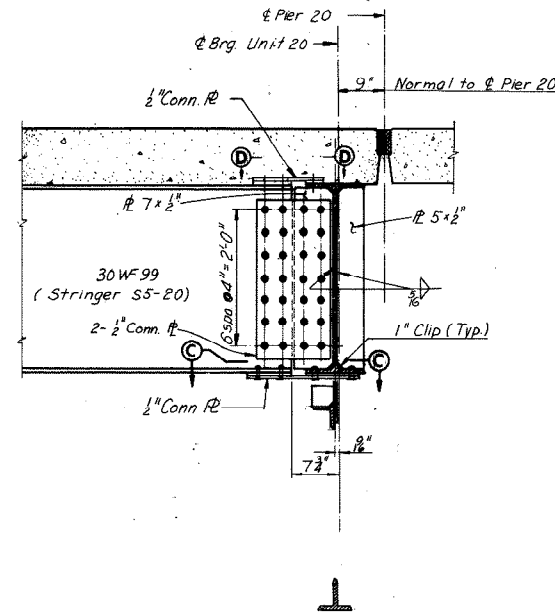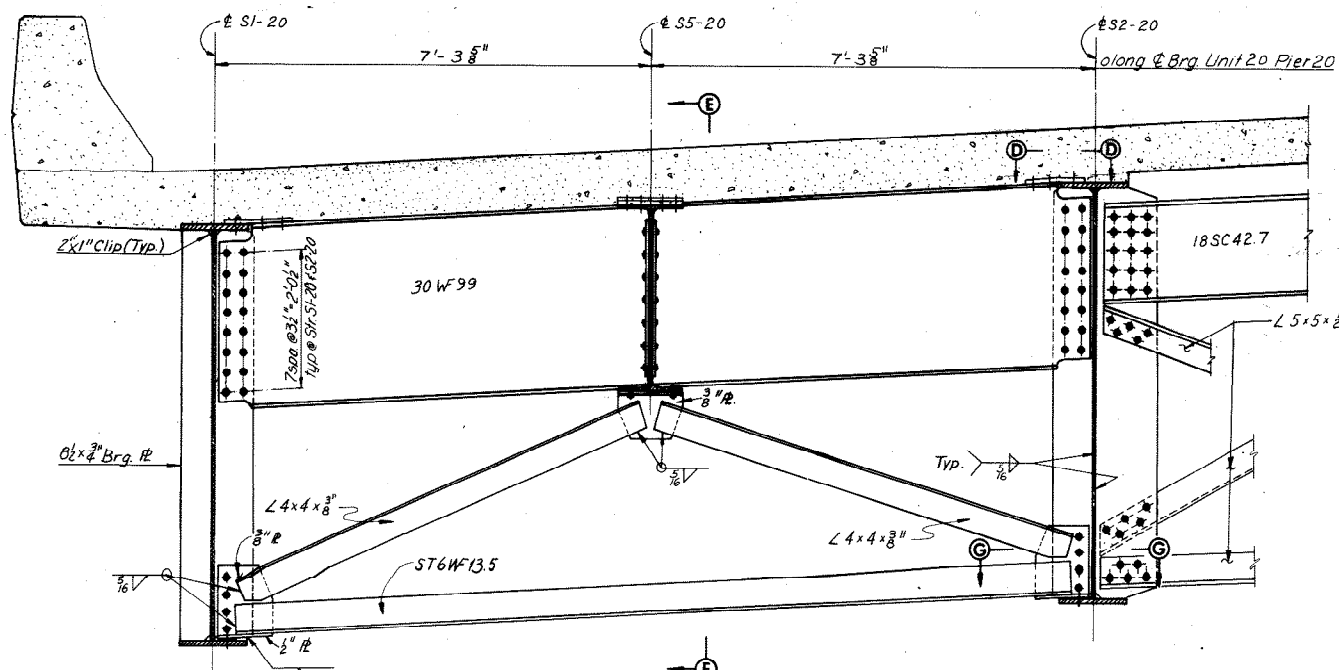




Note: Section NN Shown for S3-21N. See Section KK details for S2-21N.

DETAIL B
Scale: 3/4" = 1'-0"
Looking East

SECTION E-E
Scale: 3/4" = 1'-0"

SECTION J-J
Scale: 3/4" = 1'-0"

SECTION N-N
Scale: 1/2" = 1'-0"

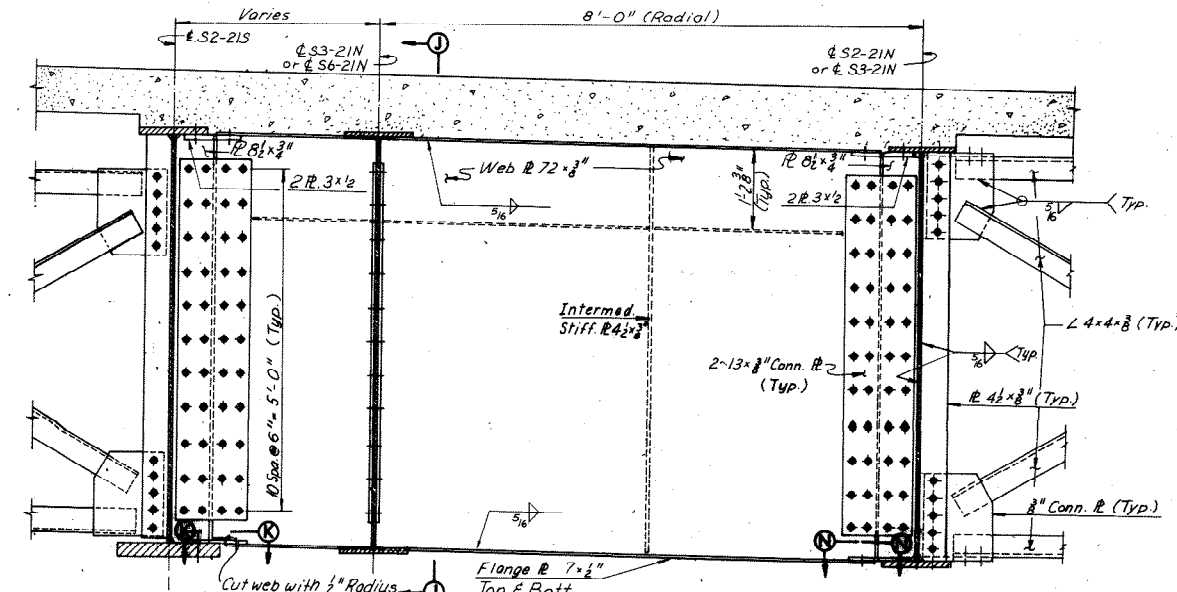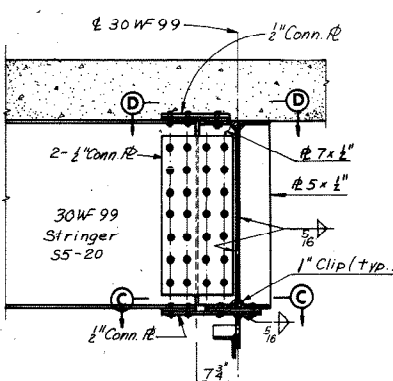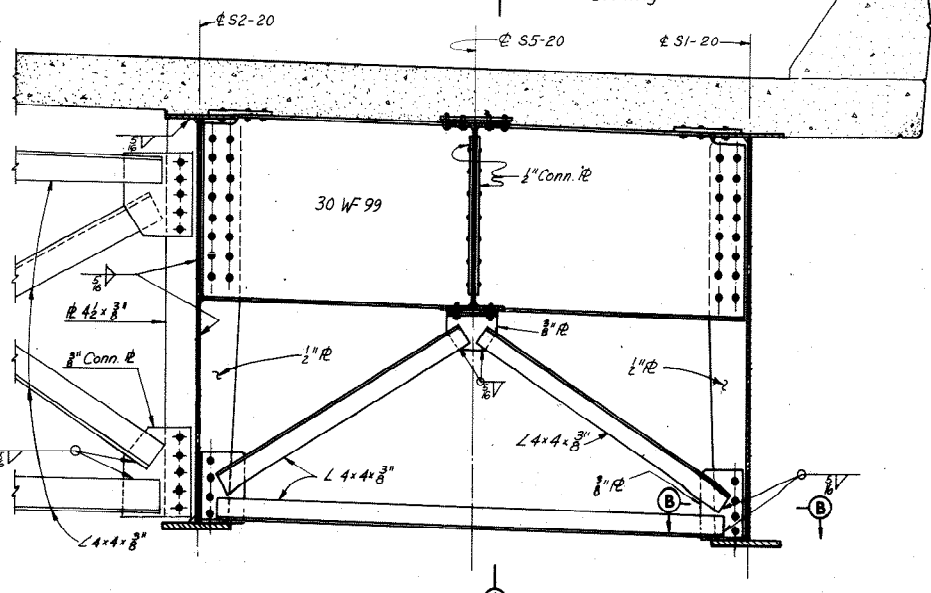


DETAIL A
Scale: 3/4" = 1'-0"
Looking West


SECTION A-A
Scale: 3/4" = 1'-0"

DETAIL C
Scale: 3/4" = 1'-0"
Looking West


Note: For location of Details A, B and C, see Framing Plan Units 20 and 21, Sheet 15. All steel shall be A36 unless otherwise shown.

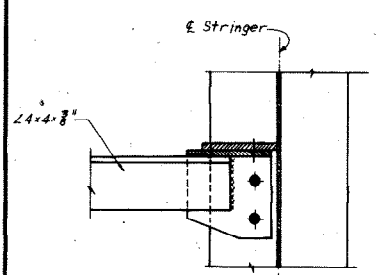

SECTION B-B
Scale: 1/2" = 1'-0"

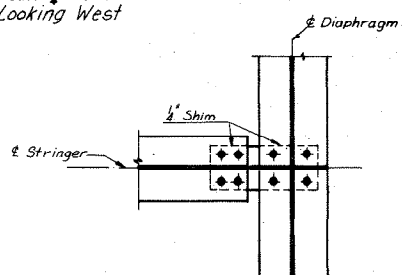

SECTION C-C
Scale: 3/4" = 1'-0"

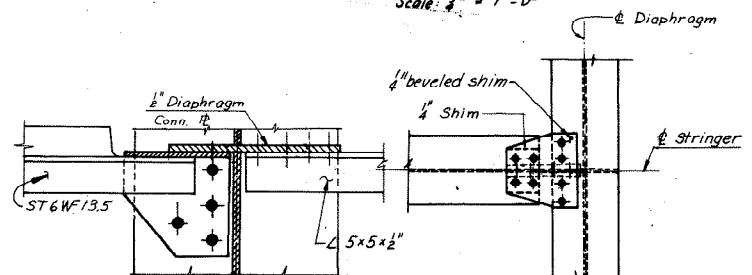

SECTION G-G
Scale: 1/2" = 1'-0"

SECTION D-D
Scale: 3/4" = 1'-0"

Section H-H similar

BY	DATE	NO.	REVISION	BY	DATE
MADE	J.D. 12-18-68				
CHECKED	PTA 1-29-69	1	As Built	TEM	10-76
IN CHARGE					

RICHMOND METROPOLITAN AUTHORITY
RICHMOND EXPRESSWAY SYSTEM
DOWNTOWN EXPRESSWAY

BRIDGE NO. 63
WESTBOUND ROADWAY OVER
12TH ST. - R.R. TRACKS AND 16TH ST.
FRAMING DETAILS
UNITS 20 AND 21

SCALE: As Noted

HOWARD, NEEDLES, TAMMEN & BERGENDOFF
consulting engineers
NEW YORK ALEXANDRIA KANSAS CITY


CONTRACT NO. 10
SHEET NO. 16 OF 29

AS BUILT


RICHMOND EXPRESSWAY SYSTEM			
SECTION	PROJECT	SHEET NO.	TOTAL SHEETS
10	DOWNTOWN EXPRESSWAY	89	265

Notes:
 For End Diaphragms at Pier 18, Unit 19, see Section A-A, Sheet 19.
 For End Diaphragms at Pier 19, Units 19 & 20, see Section A-A, Sheet 19.
 For End Diaphragms at Pier 20, Units 20 & 21, see Section A-A, Sheet 19.
 and For Detail "C" see Sheet 16.
 For End Diaphragms at Pier 10, Unit 21N and Pier 21, Unit 21S, see Section C-C this Sheet.


Note: Transverse dotted lines in Units 20 and 21 represent interior diaphragm at left end of stringers S5-20, S3-21N and S6-21N.
 For location of diaphragms see Sheet 14.

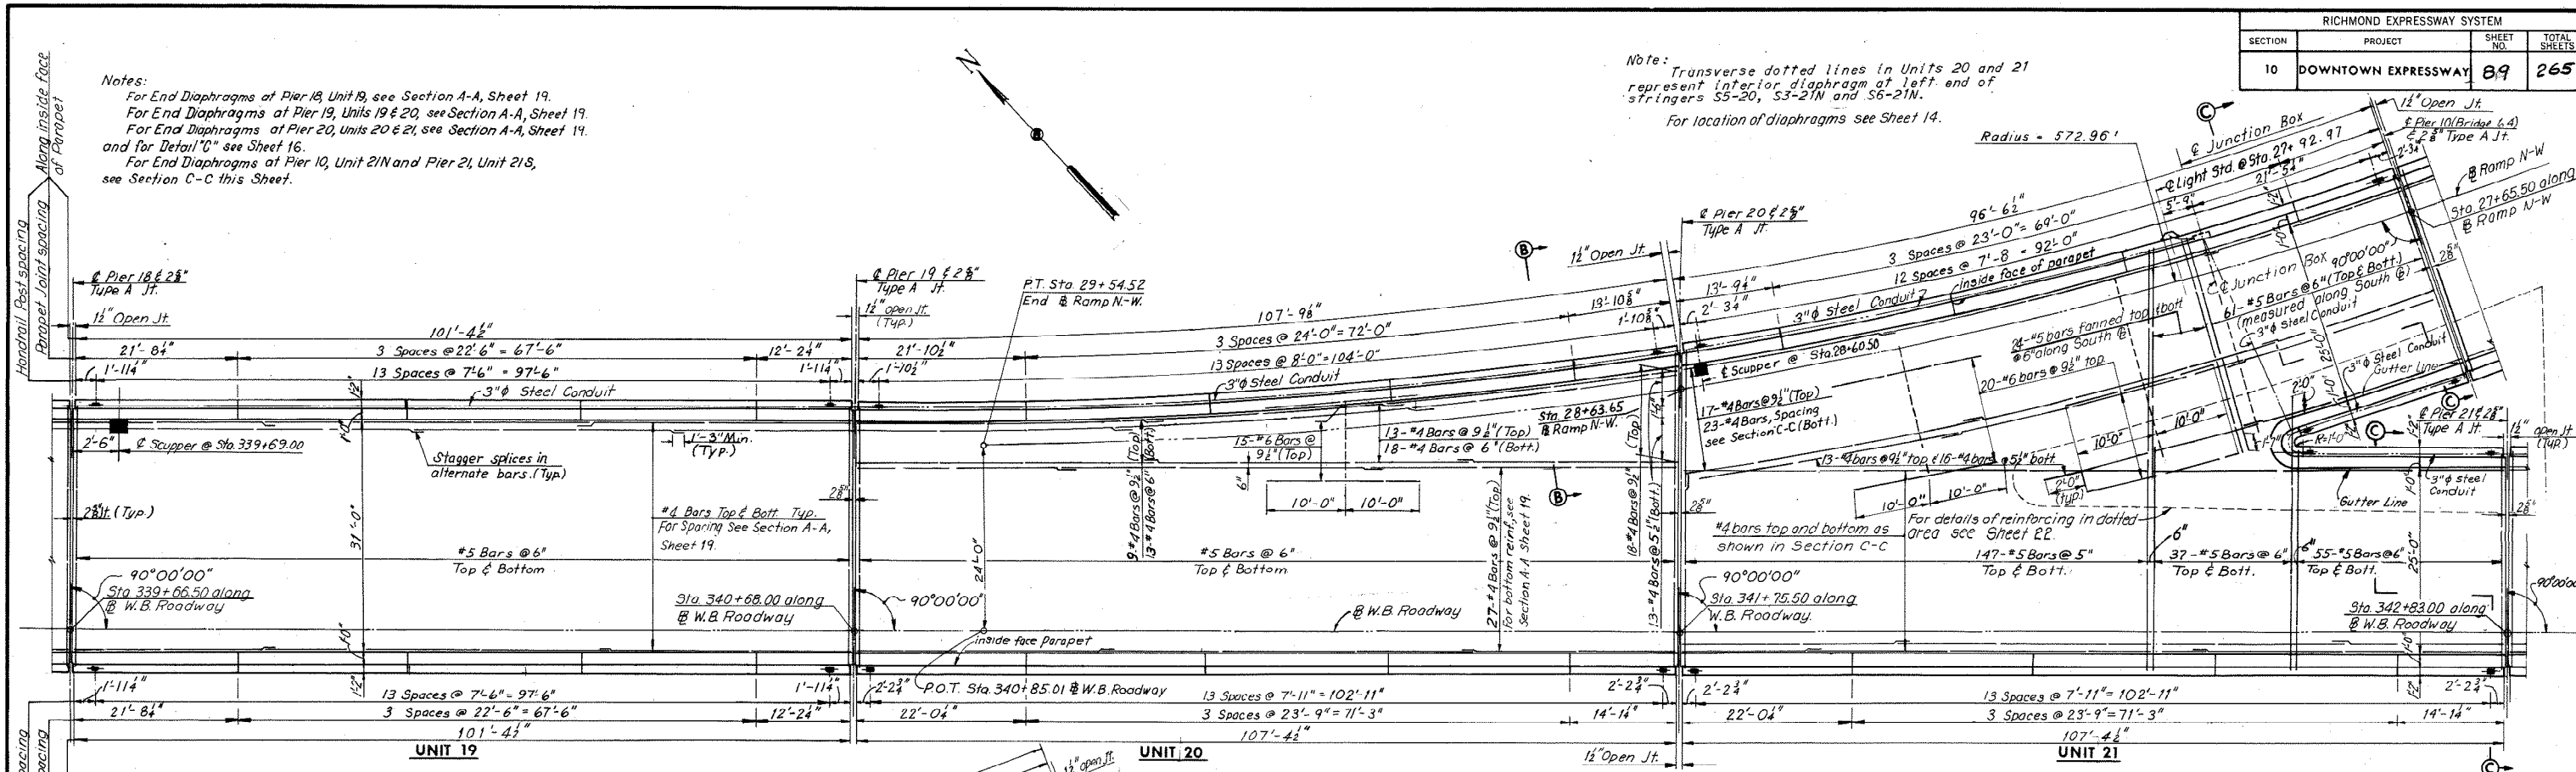


DECK PLAN
 Scale 1"=10'-0"

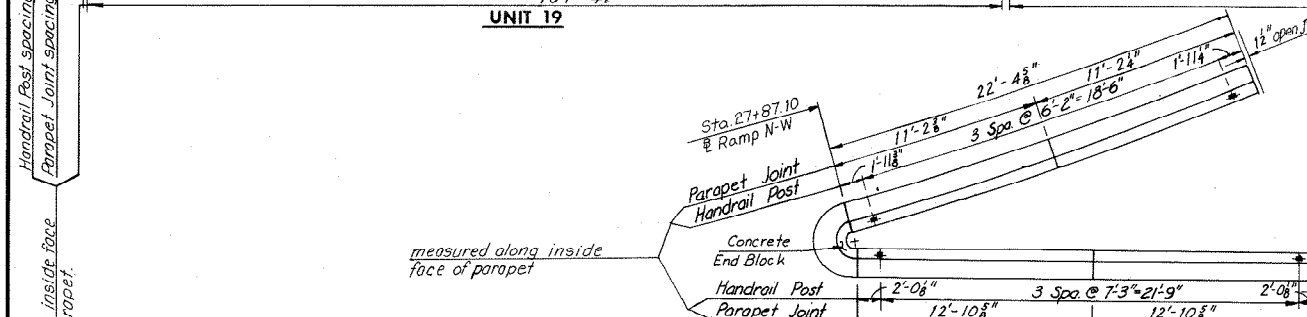

CURB AND PARAPET DETAIL
 No Scale

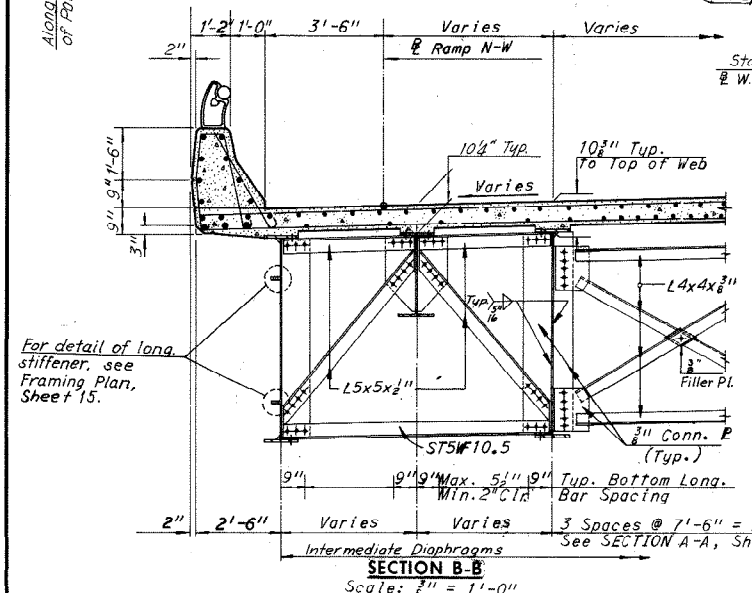

SECTION B-B
 Scale: 3/8" = 1'-0"

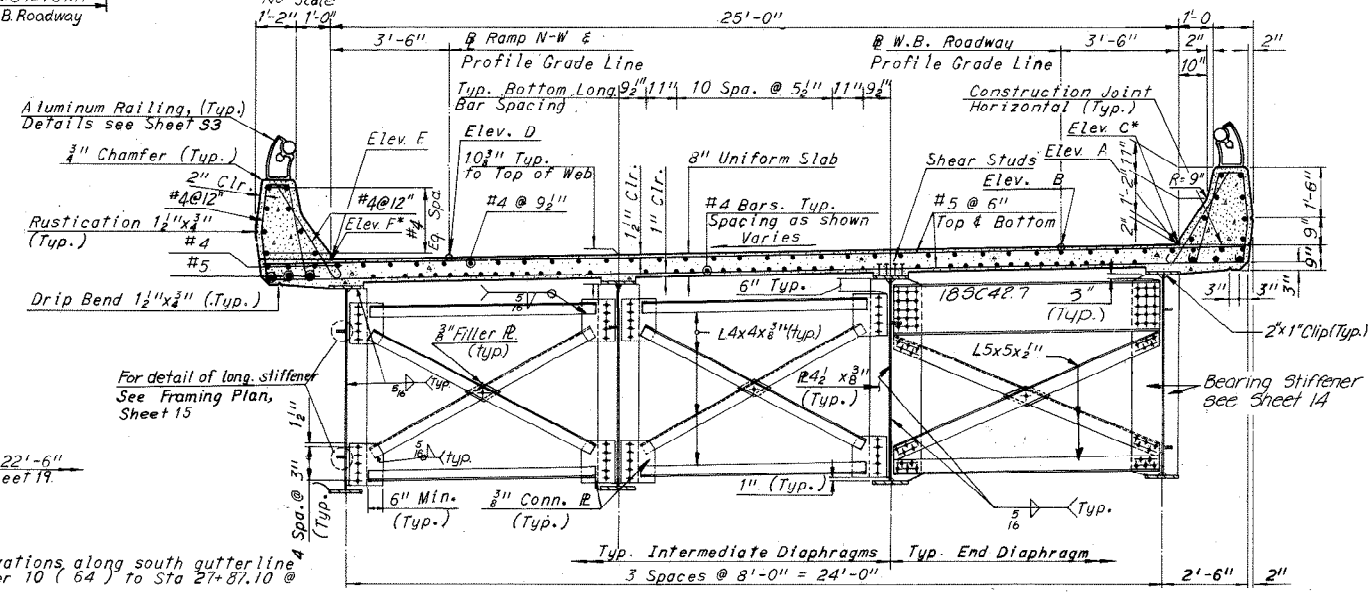

SECTION C-C
 Scale: 3/8" = 1'-0"

Notes:
 For Superstructure quantities, see Sheet 2.
 For Framing plan, see Sheet 15.
 For Joint details, see Sheet 24.
 For Railing details, see Sheet 53.
 For Standard Drainage Details, see Sheet 55 & 56.
 Support Type 2 for Units 19 and 21.

Note: Intermediate Diaphragms shown in Section C-C can only be used where stringers are straight. For Intermediate Diaphragm Details for curved stringers, see Sheet 19.

STATION @ W.B.	ELEVATION TABLE				
	ELEV. A	ELEV. B	ELEV. F	ELEV. D	ELEV. E
339+66.50	67.46	67.39	—	66.91	66.84
+70.00	67.49	67.42	—	66.94	66.87
+80.00	67.61	67.54	—	67.06	66.99
+90.00	67.72	67.65	—	67.17	67.10
340+00.00	67.83	67.76	—	67.28	67.21
+10.00	67.94	67.87	—	67.39	67.32
+20.00	68.05	67.98	—	67.50	67.43
+30.00	68.17	68.10	—	67.62	67.55
+40.00	68.28	68.21	—	67.73	67.66
+50.00	68.39	68.32	—	67.84	67.77
+60.00	68.50	68.43	—	67.95	67.88
+63.65	68.59	68.52	—	68.04	67.97
+70.00	68.61	68.54	—	68.06	67.99
+80.00	68.73	68.66	—	68.18	68.11
+85.01	68.78	68.71	—	68.23	68.16
+90.00	68.84	68.77	—	—	—
341+00.00	68.95	68.88	—	—	—
+10.00	69.06	68.99	—	—	—
+20.00	69.18	69.11	—	—	—
+30.00	69.29	69.22	—	—	—
+40.00	69.40	69.33	—	—	—
+50.00	69.51	69.44	—	—	—
+60.00	69.62	69.55	—	—	—
+70.00	69.73	69.66	—	—	—
+75.50	69.80	69.73	—	—	—
+80.00	69.85	69.78	—	—	—
+90.00	69.96	69.89	—	—	—
342+00.00	70.07	70.00	—	—	—
+10.00	70.18	70.11	—	—	—
+20.00	70.29	70.22	—	—	—
+30.00	70.41	70.34	—	—	—
+40.00	70.52	70.45	—	—	—
+50.00	70.63	70.56	—	—	—
+57.17	70.71	70.64	70.21	—	—
+60.00	70.74	70.67	70.24	—	—
+70.00	70.85	70.78	70.35	—	—
+80.00	70.97	70.90	70.47	—	—
342+83.00	71.00	70.93	70.50	—	—


STATION @ Ramp N-W	ELEVATION TABLE		
	ELEV. D	ELEV. E	ELEV. C
29+54.52	68.23	—	—
+50.00	68.28	68.21	—
+40.00	68.39	68.32	—
+30.00	68.50	68.43	—
+20.00	68.60	68.53	—
+10.00	68.70	68.63	—
29+00.00	68.80	68.73	—
28+90.00	68.89	68.82	—
+80.00	68.98	68.91	—
+70.00	69.07	69.00	—
+63.65	69.12	—	—
+63.17	—	69.05	—
+60.00	69.15	69.08	—
+50.00	69.23	69.16	—
+40.00	69.30	69.23	—
+30.00	69.37	69.30	—
+20.00	69.44	69.37	—
+10.00	69.51	69.44	—
28+00.00	69.57	69.50	—
27+90.00	69.64	69.56	—
27+87.10	69.67	69.58	70.21
+80.00	69.74	69.64	70.34
+70.00	69.87	69.76	70.56
27+65.50	69.94	69.87	70.66

AS BUILT
 RICHMOND METROPOLITAN AUTHORITY
 RICHMOND EXPRESSWAY SYSTEM
 DOWNTOWN EXPRESSWAY
 BRIDGE NO. 63
 WESTBOUND ROADWAY OVER
 12TH ST. - R.R. TRACKS AND 16TH ST.
 DECK PLAN - UNITS 19, 20 AND 21


BY	DATE	NO.	REVISION	BY	DATE
MADE	GSH	7-29-68			
CHECKED	KCT	10-18-68	As Built	TEM	10-76
IN CHARGE					

Note: Elev. C* are elevations along south gutterline of Ramp N-W from Pier 10 (64) to Sta 27+87.10 @ ctr. of Nose.
 Elev. F* are elevations along north gutterline of W.B. Roadway between Sta. 342+57.17 @ ctr. of Nose and Sta. 342+83.00 @ Pier 21.


HOWARD, NEELES, TAMMEN & BERGENDOFF
 consulting engineers
 NEW YORK ALEXANDRIA KANSAS CITY
 SCALE: As Noted
 CONTRACT NO. 10
 SHEET NO. 20 OF 29

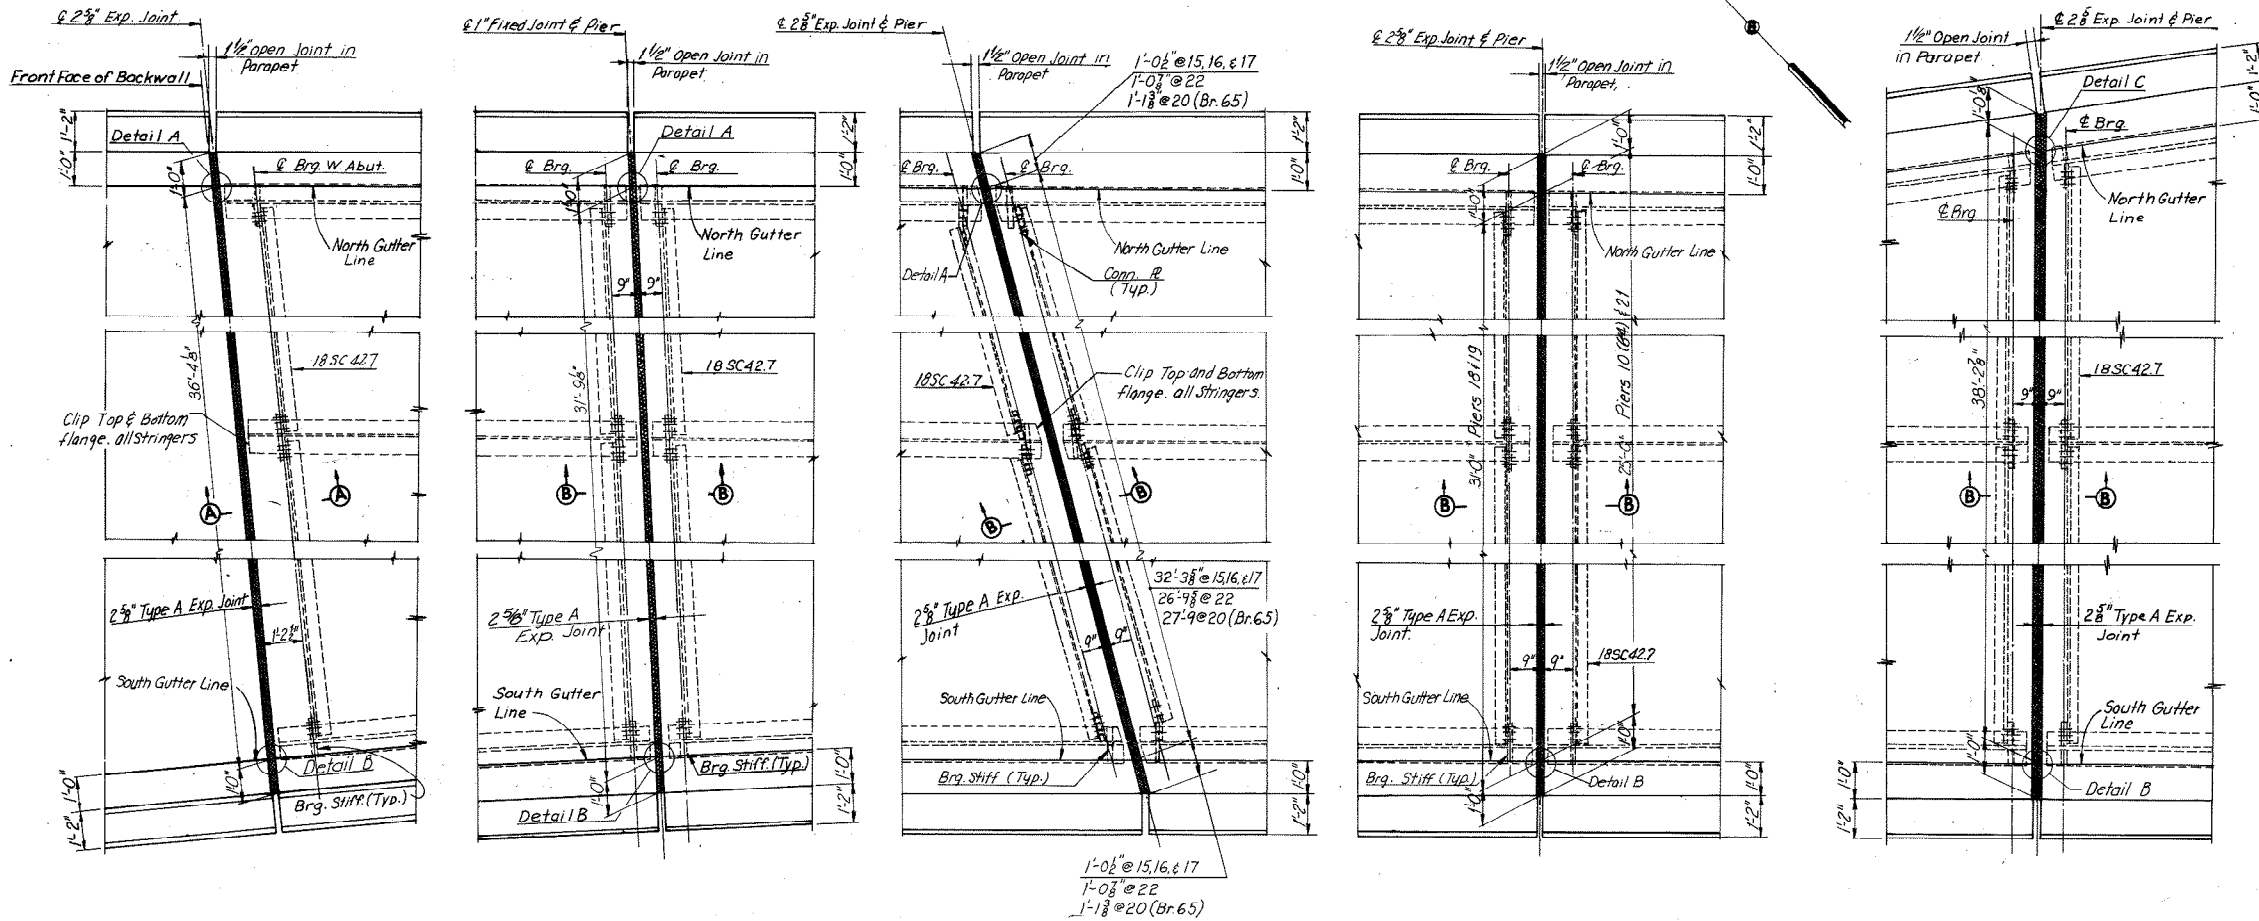


PLAN - JOINT AT WEST ABUTMENT Scale: $\frac{1}{8}'' = 1'-0''$
PLAN - JOINT AT PIER 14 Scale: $\frac{1}{8}'' = 1'-0''$
PLAN - JOINT AT PIERS 15, 16, 17, 22 AND 20 (BR. 65) Scale: $\frac{1}{8}'' = 1'-0''$
PLAN - JOINT AT PIERS 18, 19, 21 AND 10 (BR. 64) Scale: $\frac{1}{8}'' = 1'-0''$
PLAN - JOINT AT PIER 20 Scale: $\frac{1}{8}'' = 1'-0''$

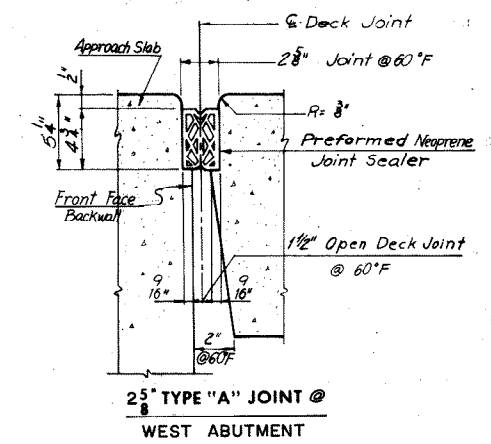


2 1/2" TYPE "A" JOINT @ WEST ABUTMENT

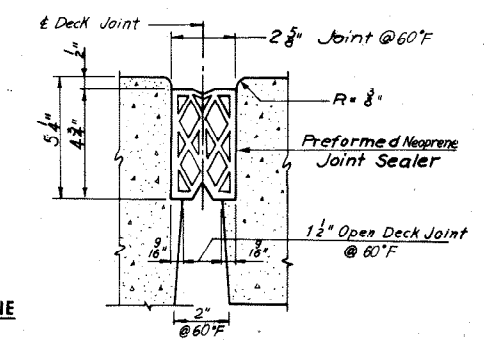


2 1/2" TYPE "A" JOINT EXPANSION JOINTS

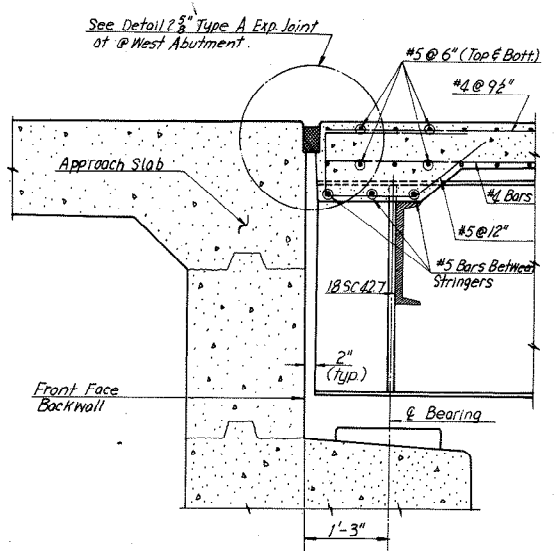


SECTION A-A Scale: $\frac{1}{4}'' = 1'-0''$

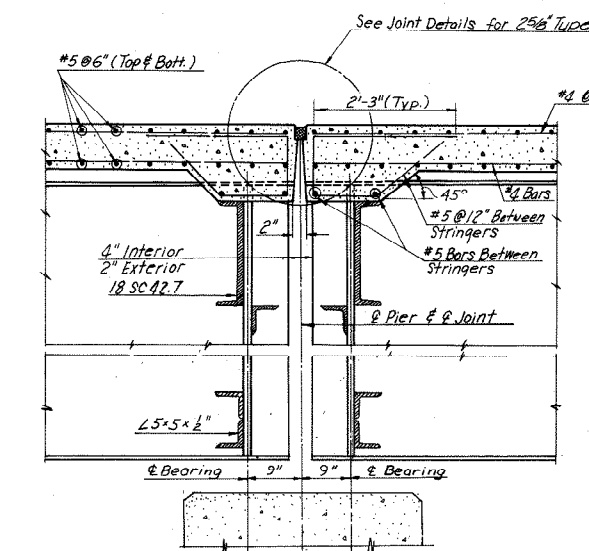


SECTION B-B Scale: $\frac{1}{4}'' = 1'-0''$

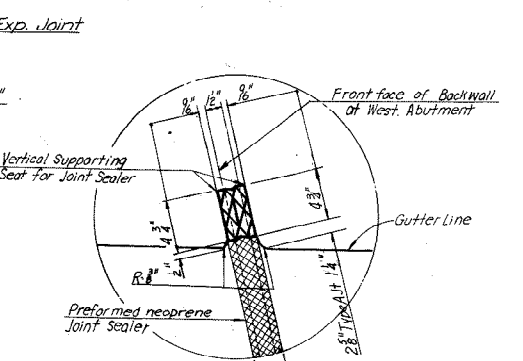


DETAIL A No Scale
Typical for W. Abutment and Piers 14, 15, 16, 17, 22, and 20 (Br. 65)

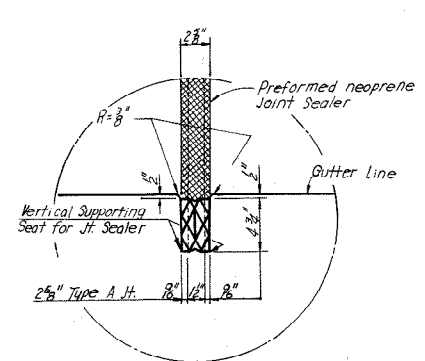


DETAIL B No Scale
Typical for W. Abutment and Piers 14, 18, 19, 20, 21 and 10 (bridge 64).

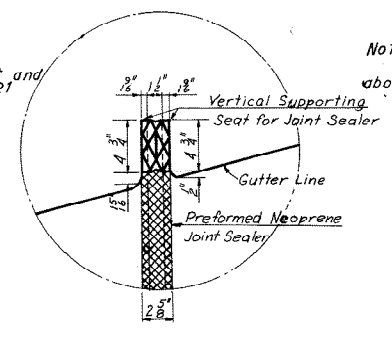

DETAIL C No Scale
Typical for Pier 20.

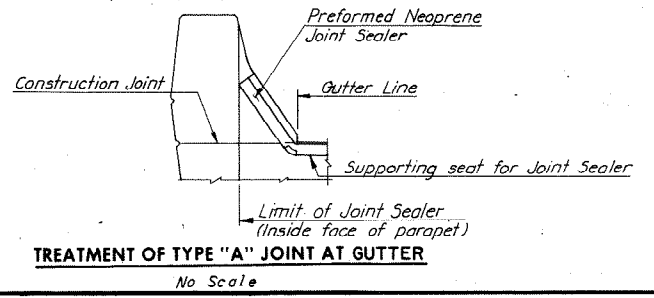

TREATMENT OF TYPE "A" JOINT AT GUTTER No Scale

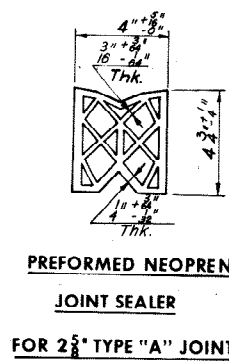

PREFORMED NEOPRENE JOINT SEALER FOR 2 1/2" TYPE "A" JOINT

Note: All horizontal dimensions shown above are normal to ϵ joint.

Note: All horizontal dimensions of Sections shown above are normal to ϵ joint.

Note: It is absolutely essential that the openings for the preformed neoprene joint sealers be accurately formed and constructed to smooth, straight lines. The size of opening shall be adjusted to allow for anticipated dead load rotation of the ends of the slab and for the temperature at the time of construction.

BY	DATE				
MADE	GSH	10-1-68			
CHECKED	J.D.	11-19-68	1	As Built	TEM 10-76
IN CHARGE			NO.	REVISION	BY DATE

RICHMOND METROPOLITAN AUTHORITY
RICHMOND EXPRESSWAY SYSTEM
DOWNTOWN EXPRESSWAY

BRIDGE NO. 63
WESTBOND ROADWAY OVER
12TH ST. - R.R. TRACKS AND 16TH ST.
JOINT DETAILS


HOWARD, NEEDLES, TAMMEN & BERGENDOFF
 consulting engineers
 NEW YORK ALEXANDRIA KANSAS CITY

SCALE: As Noted
 CONTRACT NO. 10
 SHEET NO. 24 OF 29

AS BUILT



RICHMOND EXPRESSWAY SYSTEM			
SECTION	PROJECT	SHEET NO.	TOTAL SHEETS
10	DOWNTOWN EXPRESSWAY	99	265

INDEX	SHEET
GENERAL PLAN AND ELEVATION	1
GENERAL PLAN AND ELEVATION	2
LAYOUT PLAN	3
PIERS 1 AND 2	4
PIERS 3 AND 4E	5
PIER 4	6
PIER 5	7
PIERS 6 AND 7	8
PIER 8	9
PIER 9	10
PIER 10	11
FRAMING PLAN - UNITS 1 AND 2	12 & 12a
FRAMING PLAN - UNITS 3 AND 4	13
FRAMING PLAN AND DECK PLAN - UNITS 5E AND 6E	14
FRAMING PLAN - UNITS 5 AND 6	15
FRAMING PLAN - UNITS 7 AND 8	16
FRAMING PLAN - UNITS 9 AND 10	17
FRAMING DETAILS	18
DECK PLAN - UNITS 1 AND 2	19
DECK PLAN - UNITS 3 AND 4	20
DECK PLAN - UNITS 5 AND 6	21
DECK PLAN - UNITS 7 AND 8	22
DECK PLAN - UNITS 9 AND 10	23
SUPERSTRUCTURE DETAILS	24
JOINT DETAILS	25
JOINT DETAILS	26
BORING LOGS	27
BORING LOGS	28
STANDARD DETAILS	29 THRU 57

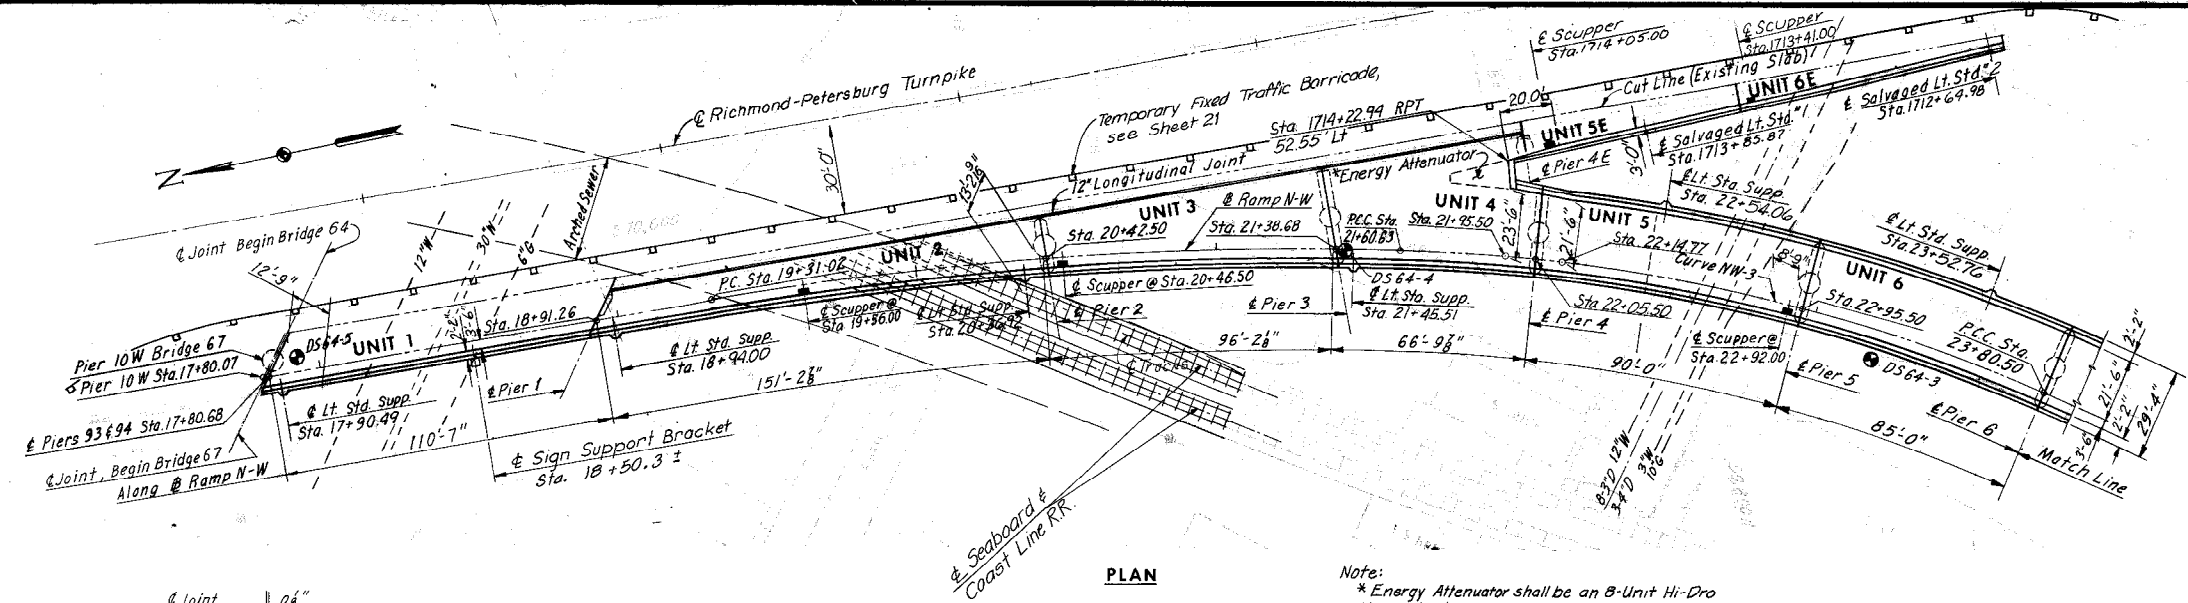


Note:
 * Energy Attenuator shall be an 8-Unit Hi-Dro Cell Sandwich Unit as supplied by Hydro-Cell, Ltd., 11 Lincoln Ave., New Rochelle, N.Y. 10801, or approved equal.
 984'-9 1/2" to Pier 10 (End of Bridge 64)

Note:
 For General Notes, see Sheet 2.
 For Quantity Table, see Sheet 2.

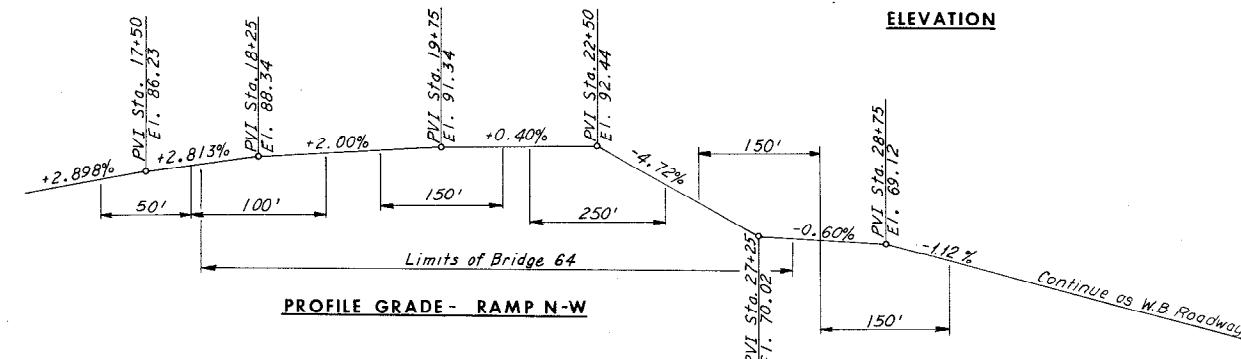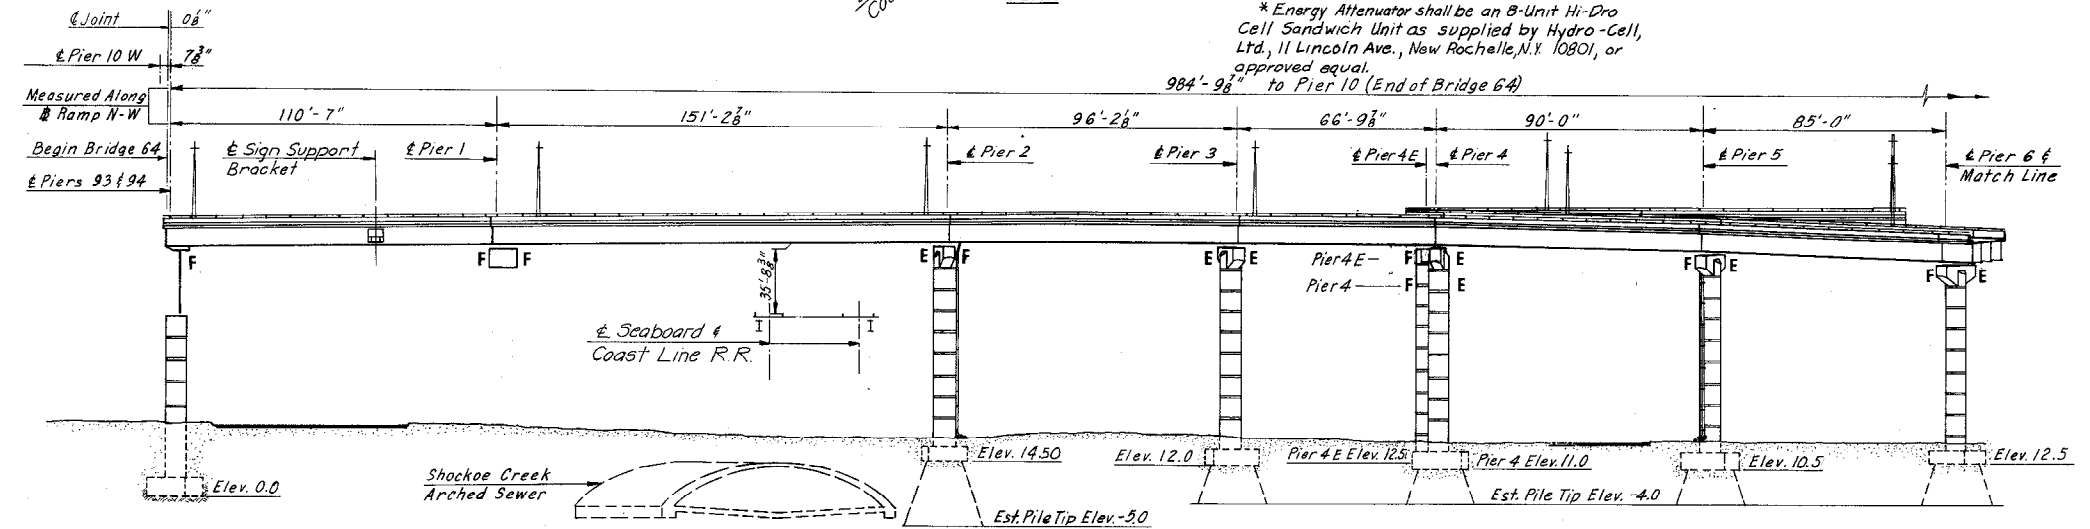

HORIZONTAL CURVE DATA

R. P. Turnpike		R. Ramp N-W		Curve: NW-1		Curve: NW-2		Curve: NW-3	
Curve: R.P.T.-1	Curve: R.P.T.-2	Curve: NW-1	Curve: NW-2	Curve: NW-3	Curve: NW-4	Curve: NW-5			
P.I. = Sta. 1704+68.83	P.I. = Sta. 1723+07.01	P.I. = Sta. 13+42.50	P.I. = Sta. 20+46.21	P.I. = Sta. 22+71.93	P.I. = Sta. 25+55.02	P.I. = Sta. 28+25.38			
Δ = 15° 03' 56.2"	Δ = 35° 27' 06.8"	Δ = 32° 07' 32"	Δ = 11° 28' 49.9"	Δ = 21° 59' 14.3"	Δ = 64° 48' 04"	Δ = 26° 18' 00"			
D = 1° 00' 00"	D = 49° 00' 00"	D = 3° 51' 35.6"	D = 5° 00'	D = 10° 00' 00"	D = 20° 50' 05.4"	D = 10° 00' 00"			
T = 757.65'	T = 430.45'	T = 426.01'	T = 115.19'	T = 111.31'	T = 174.52'	T = 133.86'			
L = 1,506.56'	L = 836.30'	L = 829.72'	L = 229.61'	L = 219.88'	L = 311.02'	L = 263.00'			
R = 5,729.58'	R = 1,432.39'	R = 1,484.39'	R = 1,145.92'	R = 572.96'	R = 275.00'	R = 572.96'			

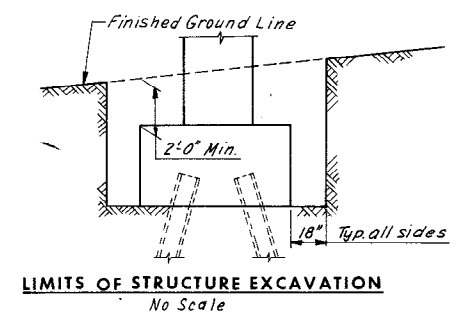

NO.	REVISION	BY	DATE
4	As Built	TEM	6-77
	Seaboard & Coast Line Add'l. Plan Et. Sign Support Bracket & Sheet 12a added	K.D.P.	6-74
	Added Sta.	L.B.P.	8-74
		REG	1-13-75

RICHMOND METROPOLITAN AUTHORITY
RICHMOND EXPRESSWAY SYSTEM
DOWNTOWN EXPRESSWAY



BRIDGE NO. 64
RAMP N-W CONNECTION FROM
RICHMOND-PETERSBURG TURNPIKE
GENERAL PLAN AND ELEVATION

HOWARD, NEEDLES, TAMMEN & BERGENDOFF
 consulting engineers
 NEW YORK ALEXANDRIA KANSAS CITY

SCALE: 1" = 30'-0"
 CONTRACT NO.: 10
 SHEET NO. 1 OF 28

AS BUILT

RICHMOND EXPRESSWAY SYSTEM			
SECTION	PROJECT	SHEET NO.	TOTAL SHEETS
10	DOWNTOWN EXPRESSWAY	100	265

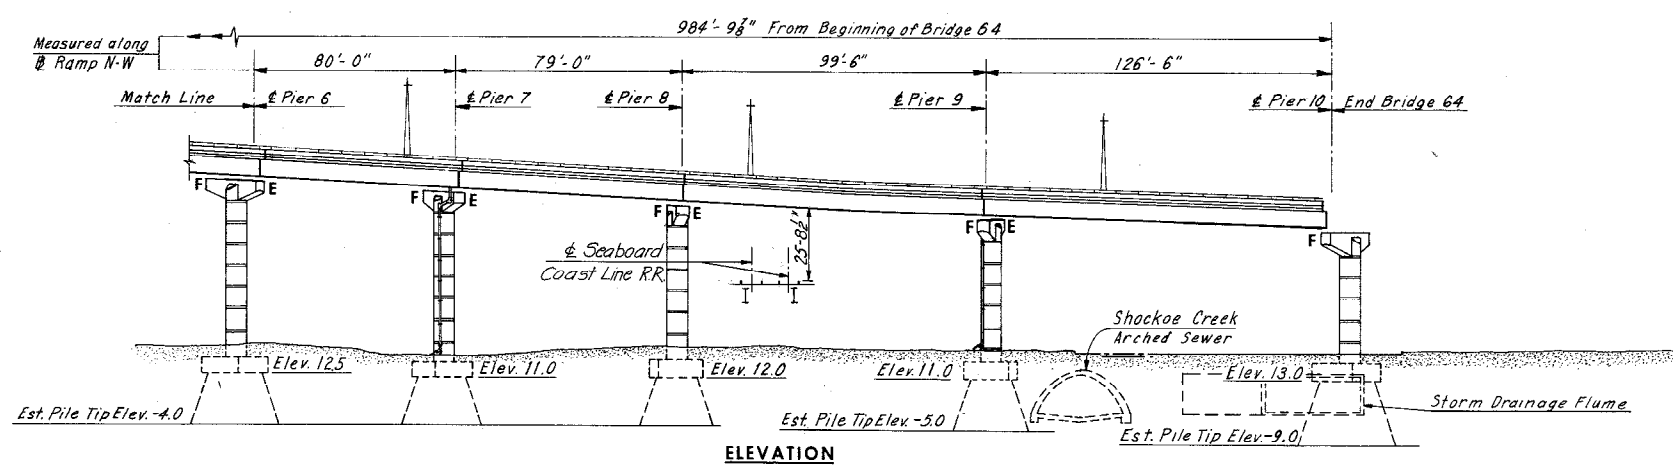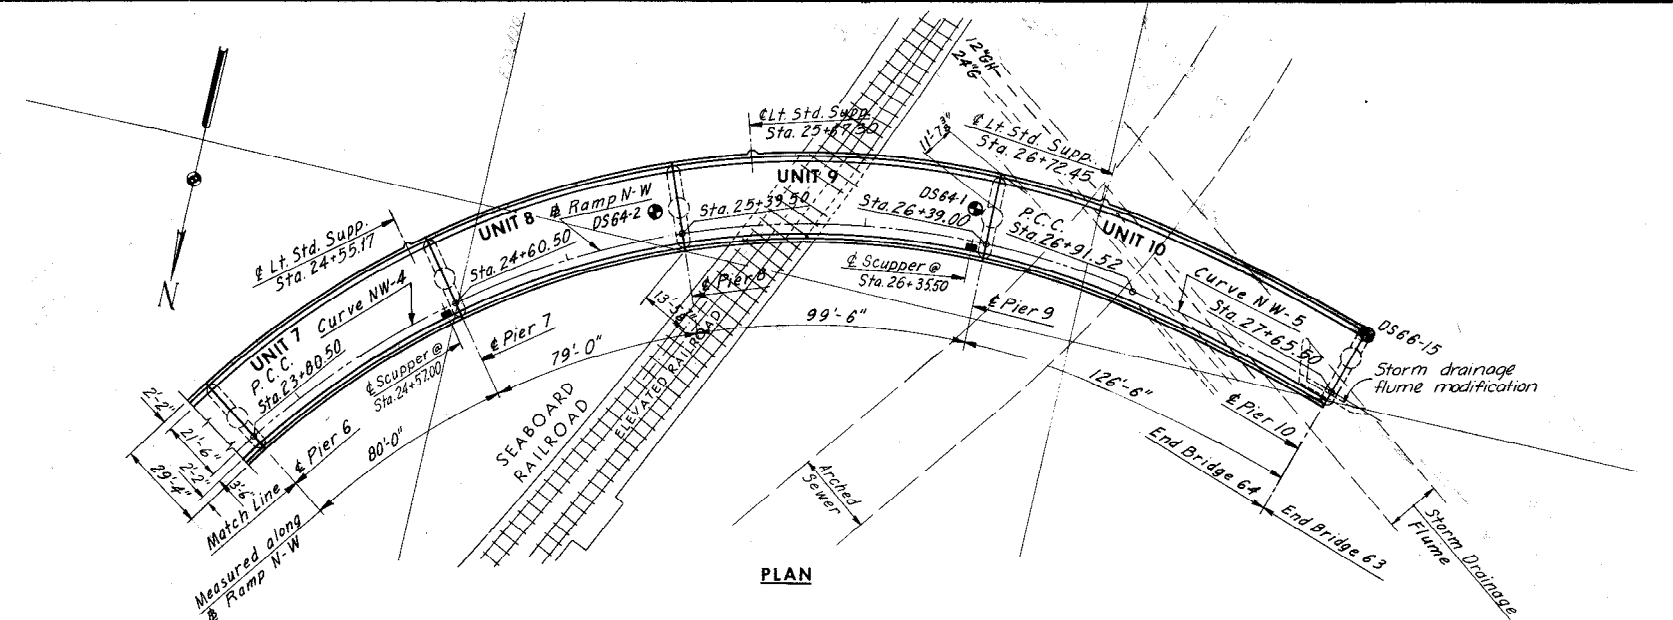

ESTIMATED QUANTITIES

	Structure Excavation Cu. Yds.	Concrete (#) Cu. Yds.	Reinforcing Steel Lbs.	Str. Steel Mild Carbon Lbs.	Str. Steel High Strength Lbs.	Aluminum Railing (1-Rail) Lin. Ft.	Steel Piles 10BP42 Lin. Ft.
Superstructure	--	1,023.8	213,790	768,100	413,900	1,600	---
Substructure	1,125	1,484.1	236,580	2,000	---	---	145
Total	1,125	2,507.9	450,370	770,100	413,900	1,600	145

	Steel Piles 12BP53 Lin. Ft.	Sheet Piling Lump Sum	Metal Conduit Lin. Ft.	Energy Attenuator B-Unit Each	Bridge Drainage Metal Work Lbs.	Modifications to R.P. Turnpike Bridge Lump Sum	Modifications to Storm Drainage Flume Cu. Yds.
Superstructure	---	--	1,075	1	13,030	1	--
Substructure	3,035	1	--	--	--	--	116
Total	3,035	1	1,075	1	13,030	1	116

* All Concrete for Superstructure shall be Class A4 and for Substructure Class A3.

BY	DATE	REVISION	BY	DATE
MADE	AMH 1-13-69	1	KDP	6-74
CHECKED	GCC 4-28-69	3	R.B.H.	9-74
IN CHARGE			TEM	6-77

GENERAL NOTES:

ROADWAY: One variable width roadway transitioning from a widening of Southbound roadway of Richmond-Petersburg Turnpike to a ramp with 25'-0" clear roadway connecting with W.B. Roadway (Br. 63).

CAPACITY: Dead load includes 15 lbs. per sq. ft. for future wearing surface. Live load, HS 20-44 loading and alternate military loading.

SPECIFICATIONS:
GENERAL: Virginia Department of Highway Road and Bridge Specifications 1970.
DESIGN: A.A.S.H.O. Standard Specifications for Highway Bridges 1973, modified by Special Design provisions.
WELDING: 1972 Standard Specifications for Welded Highway and Railway Bridges of the American Welding Society.
CONTRACT SPECIAL PROVISIONS: Specifications and Contract Special Provisions referred to above are necessary to make these plans complete.

DATUM:

City of Richmond

TEMPERATURE:

The normal temperature referred to in the plans is 60°F. The temperature range for movement is 0°F. to 120°F.

DIMENSIONS:

All dimensions are measured horizontally and vertically unless otherwise noted.

EXCAVATION:

Excavation below subgrade and cut slope template shall be classified as Structure Excavation. All excavation above these limits shall be classified as Regular Excavation and is not included in the Structural Quantities.

FOUNDATIONS:

Footings shall rest on firm material. Foundation material shall be dry and special attention is called to Section 401.05 of Standard Specifications and to the Contract Special Provisions, concerning preparation of foundations for footings.

CONCRETE NOTES:

Concrete in superstructure shall be Class A 4. All other concrete shall be Class A 3. All exposed edges and corners shall have a 1/2" chamfer or fillet unless otherwise noted. Care in the method of vibration, the use of low-slump concrete, and other means shall be employed to prevent downgrade movement of newly placed slab concrete. Finishing Concrete Surfaces: See Standard Architectural Detail Sheets and the Contract Special Provisions for types and details. All reinforcing bar dimensions on the detailed drawings are to centers of bars unless otherwise noted. Clear distance between reinforcing steel and face to concrete shall be as noted on the plans. All bar laps shall be 30 diameters of the smaller diameter bar unless otherwise noted. All reinforcing steel shall conform to ASTM A615 Grade 40.

STEEL NOTES:

Structural steel shall conform to A.S.T.M. Designations A36, A572 - Grade 50 and A588 as noted. See Special Provisions. All field connections shall be made with high strength bolts. High strength bolts shall be 1/2" diameter unless otherwise noted and shall conform to A.S.T.M. Specification A-325.

Note: For Curve Data and Profile Grade, see Sheet 1.
For Layout Plan, see Sheet 3.












**RICHMOND METROPOLITAN AUTHORITY
RICHMOND EXPRESSWAY SYSTEM
DOWNTOWN EXPRESSWAY**

**BRIDGE NO. 64
RAMP N-W CONNECTION FROM
RICHMOND-PETERSBURG TURNPIKE
GENERAL PLAN AND ELEVATION**

HOWARD, NEEDLES, TAMMEN & BERGENDOFF consulting engineers NEW YORK ALEXANDRIA KANSAS CITY	SCALE: 1" = 30'-0" CONTRACT NO. 10 SHEET NO. 2 OF 28
---	--




AS BUILT

RICHMOND EXPRESSWAY SYSTEM			
SECTION	PROJECT	SHEET NO.	TOTAL SHEETS
10	DOWNTOWN EXPRESSWAY	102	265

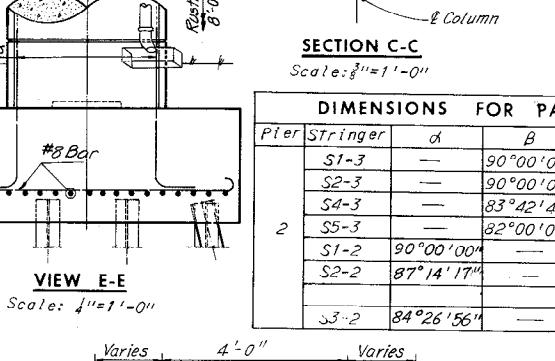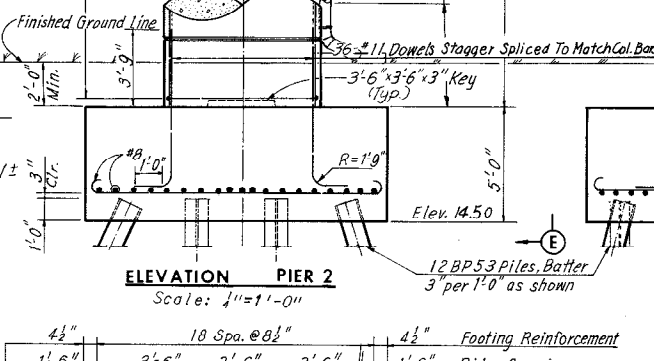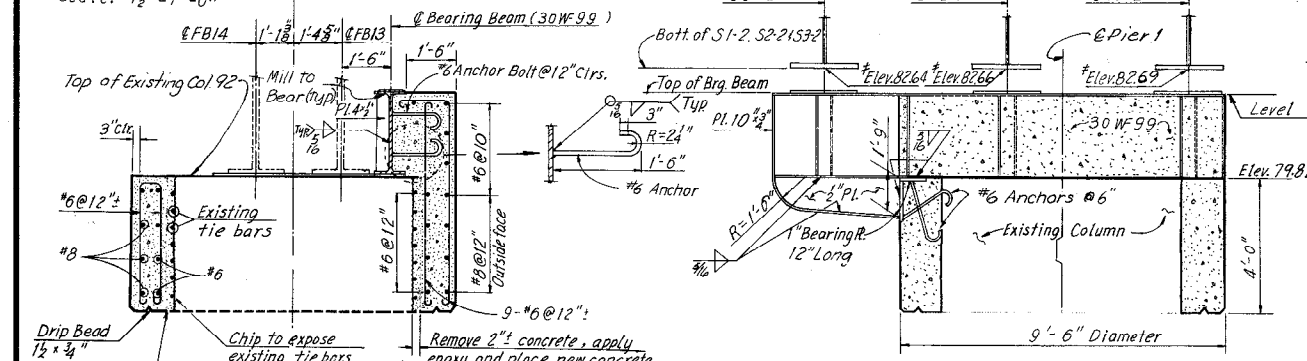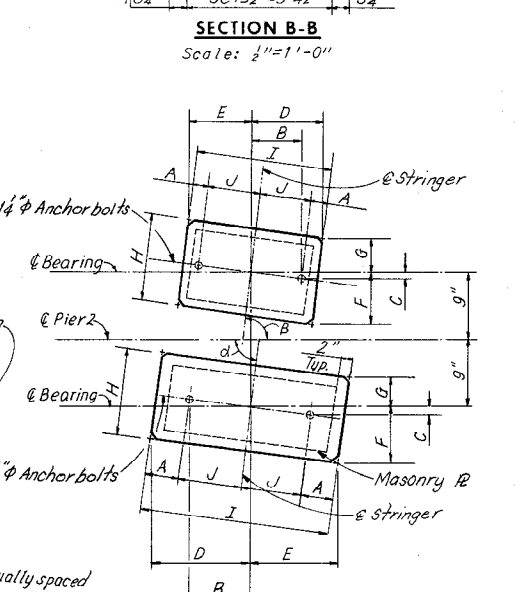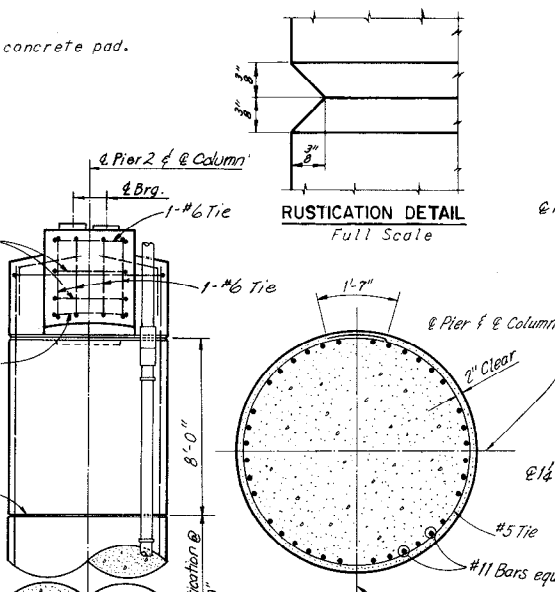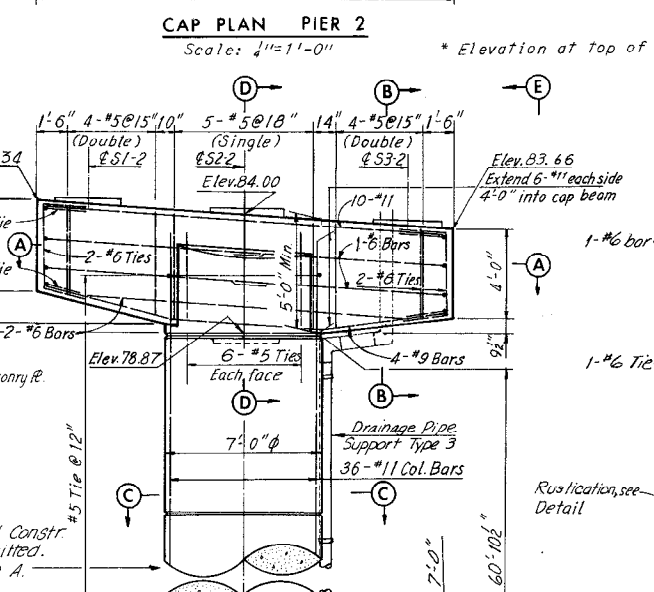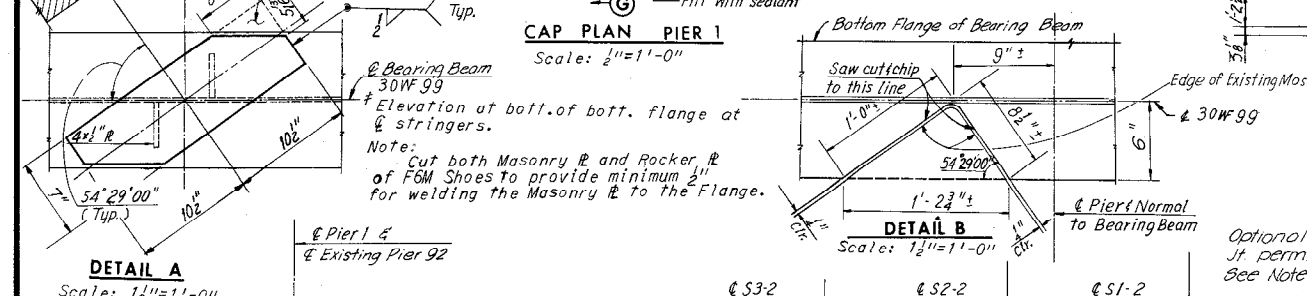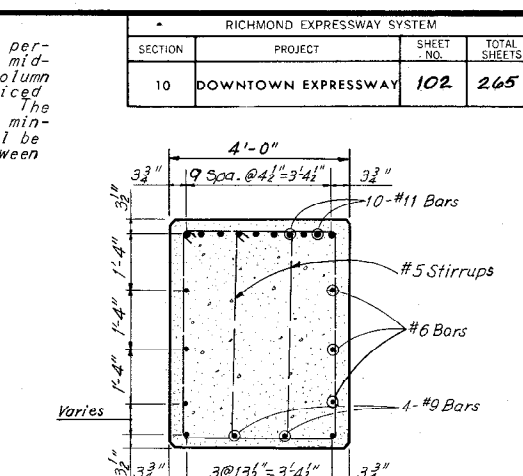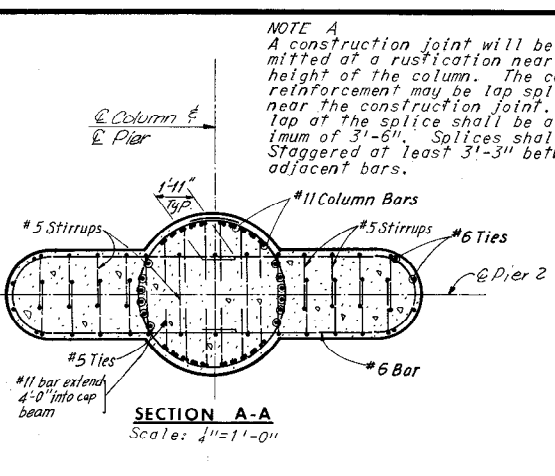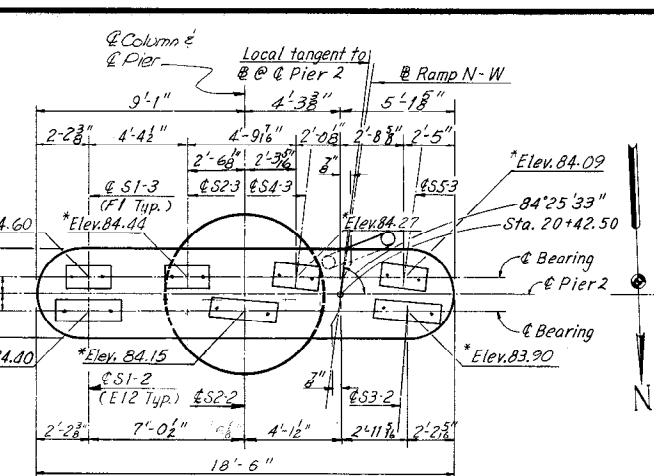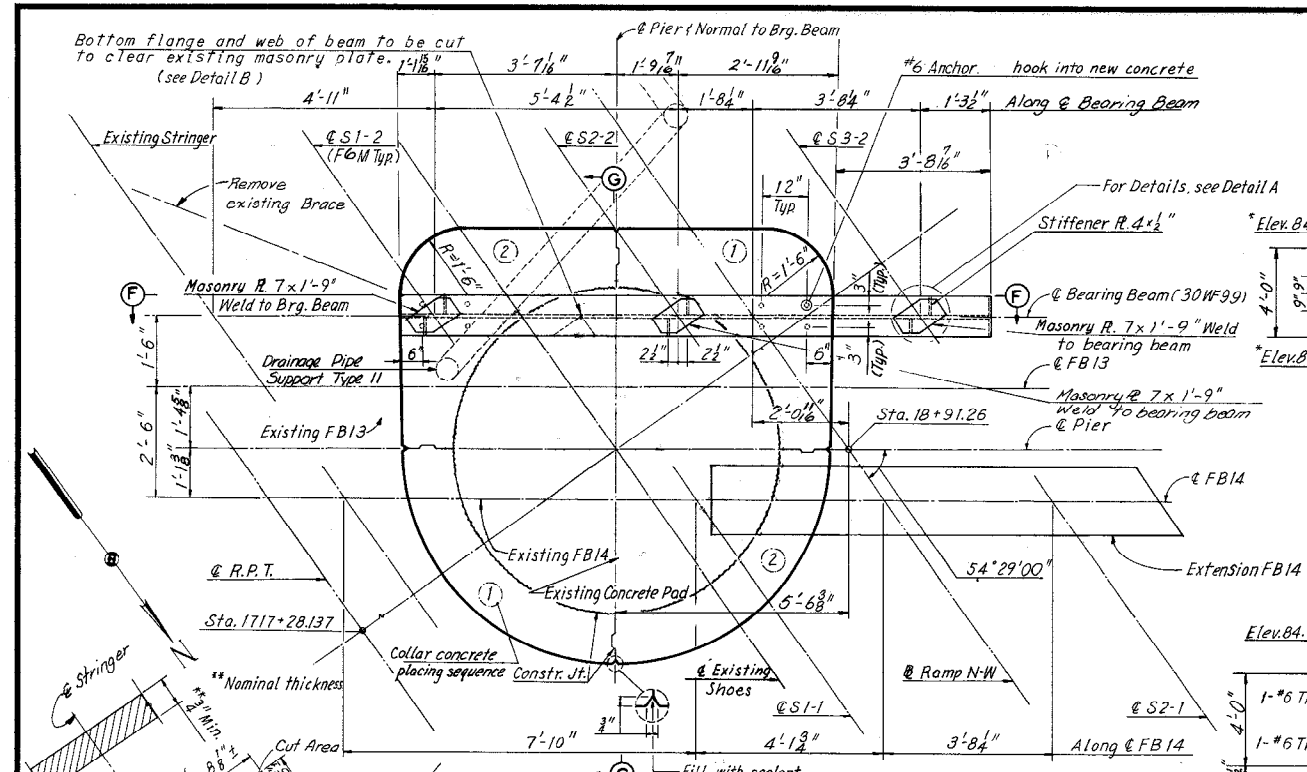

DIMENSIONS FOR PAD AND ANCHOR BOLT SETTING PLAN

Pier	Stringer	a	B	A	B	C	D	E	F	G	H	I	J
1	S1-3	—	90°00'00"	4 1/2"	8"	0	12 1/2"	12 1/2"	5 1/2"	5 1/2"	11 1/2"	25"	8"
	S2-3	—	90°00'00"	4 1/2"	8"	0	12 1/2"	12 1/2"	5 1/2"	5 1/2"	11 1/2"	25"	8"
	S4-3	—	83°42'49"	4 1/2"	7 7/8"	8"	13 1/2"	11 1/2"	7"	4 1/2"	11 1/2"	25"	8"
2	S5-3	—	82°00'00"	4 1/2"	7 7/8"	1 1/2"	13 1/2"	11 1/2"	7 1/2"	4"	11 1/2"	25"	8"
	S1-2	90°00'00"	—	4"	14 1/2"	0	18 1/2"	18 1/2"	6 1/2"	6 1/2"	13 1/2"	36 1/2"	14 1/2"
	S2-2	87°14'17"	—	4"	14 1/2"	0	16 1/2"	17 1/2"	6 1/2"	6"	13 1/2"	36 1/2"	14 1/2"
S3-2	84°26'56"	—	4"	14 1/2"	1 1/2"	18 1/2"	17 1/2"	8 1/2"	5 1/2"	13 1/2"	36 1/2"	14 1/2"	

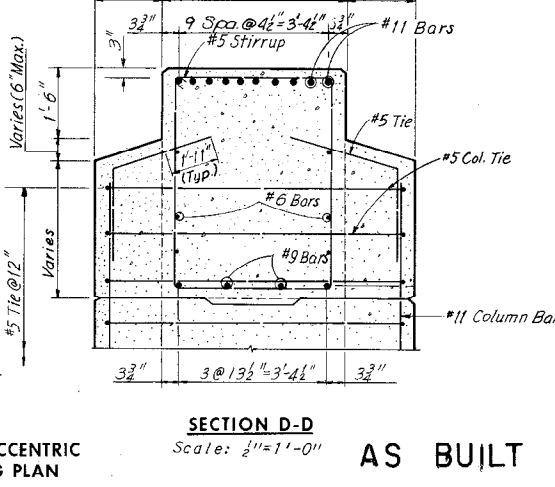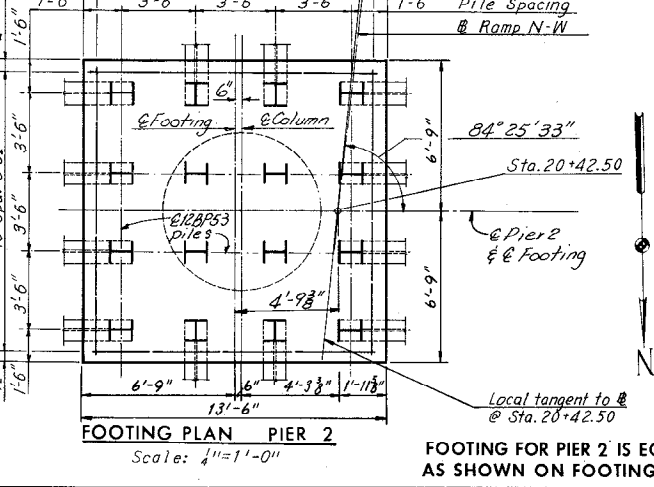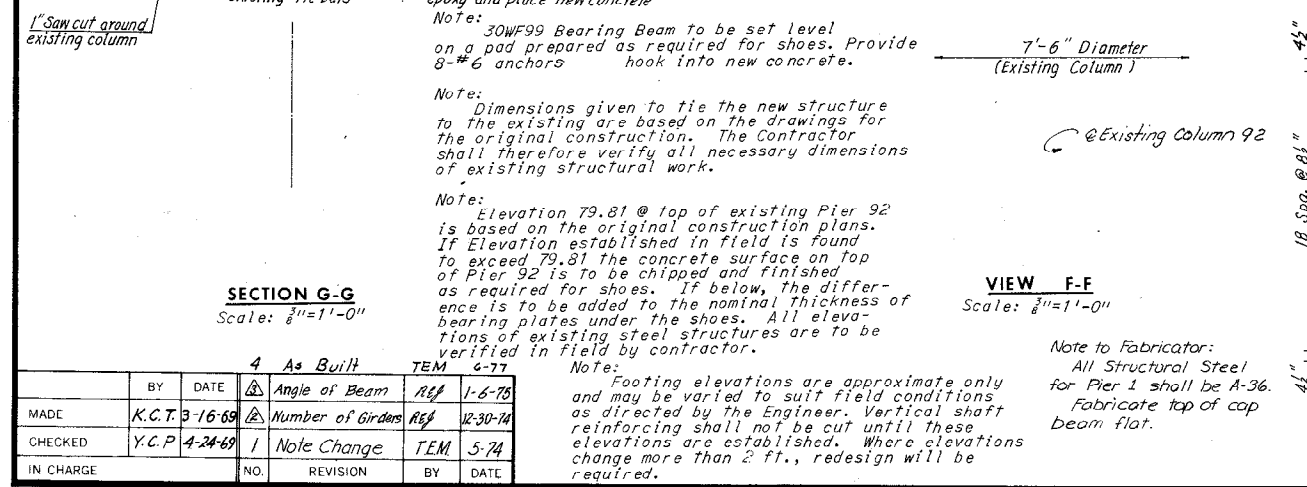

RICHMOND METROPOLITAN AUTHORITY
RICHMOND EXPRESSWAY SYSTEM
DOWNTOWN EXPRESSWAY

BRIDGE NO. 64
RAMP N-W CONNECTION FROM
RICHMOND-PETERSBURG TURNPIKE

PIERS 1 AND 2

AS BUILT

HOWARD, NEEDLES, TAMMEN & BERGENDOFF
consulting engineers
NEW YORK ALEXANDRIA KANSAS CITY

SCALE: As Noted
CONTRACT NO. 10
SHEET NO. 4 OF 28








NO.	REVISION	BY	DATE
1	Angle of Beam	Ref	1-6-75
2	Number of Girders	Ref	12-30-74
3	Note Change	TEM	5-74

Note: Footing elevations are approximate only and may be varied to suit field conditions as directed by the Engineer. Vertical shaft reinforcing shall not be cut until these elevations are established. Where elevations change more than 2 ft., redesign will be required.

Note to Fabricator: All Structural Steel for Pier 1 shall be A-36. Fabricate top of cap beam flat.

Note: For Standard Shoe Details, see Sheets S1 & S2. For Framing Plan, see Sheets 12 & 13. For Steel and Concrete Quantities, see Sheet 2. All piles shall be 12BP53 Steel Pile. Estimated pile elevation, Pier 2 = -5.0 For Pile Details, see Sheet 7. For Details of Extension FB 14, see Sheet 18. For Standard Drainage Details, see Sheet 56.

RICHMOND EXPRESSWAY SYSTEM			
SECTION	PROJECT	SHEET NO.	TOTAL SHEETS
10	DOWNTOWN EXPRESSWAY	110	265

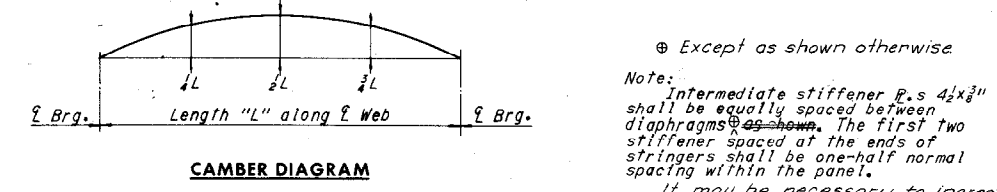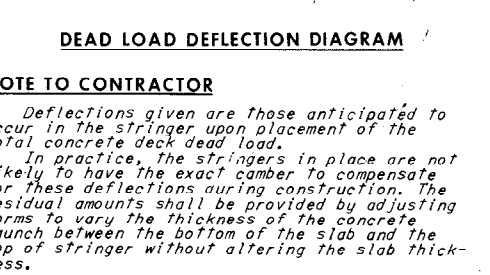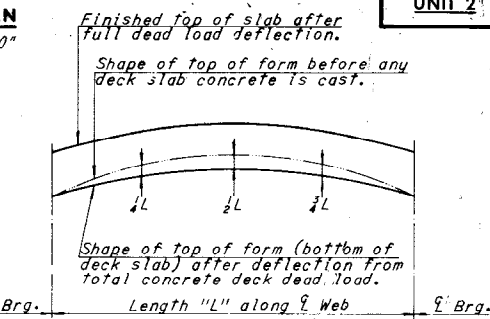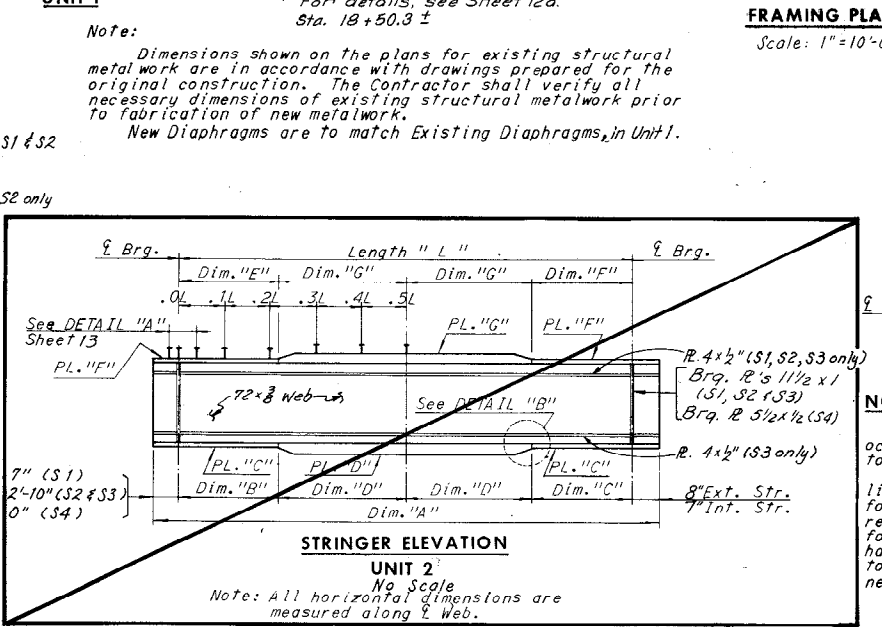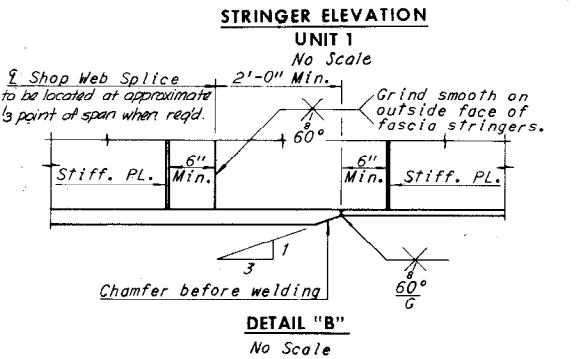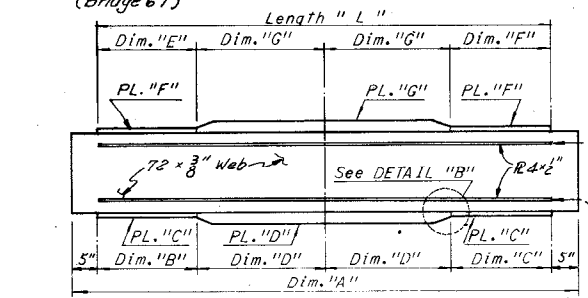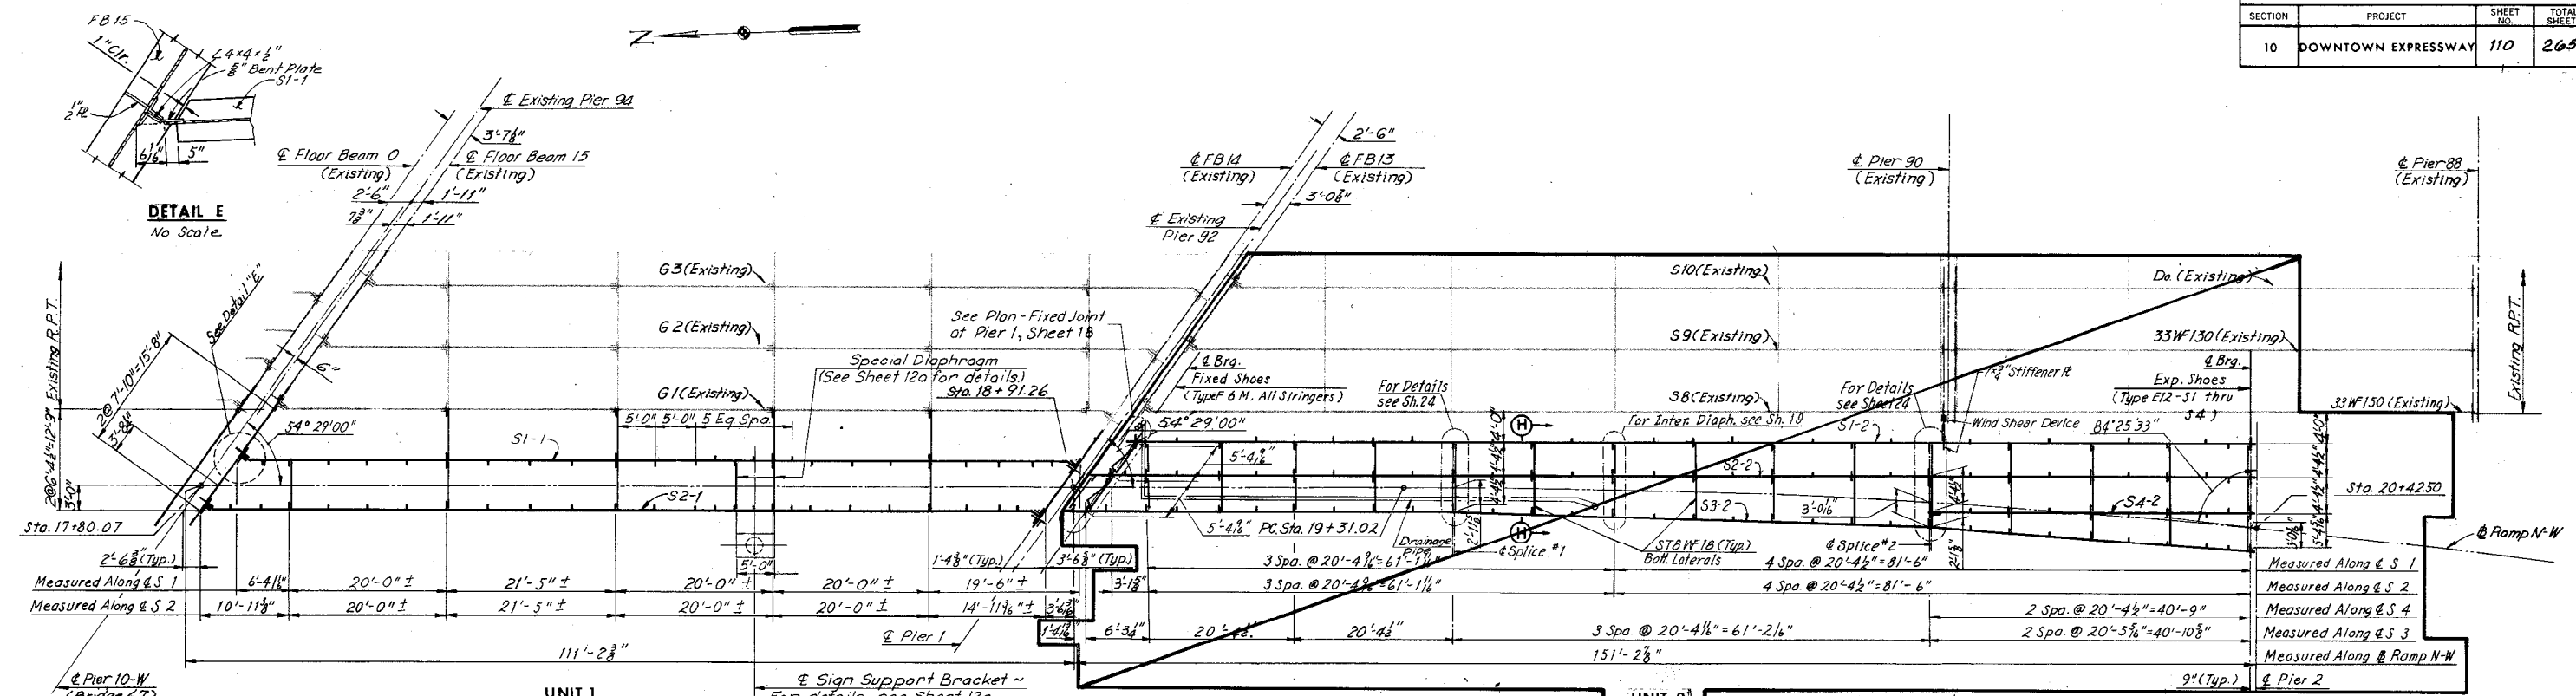

NOTE TO CONTRACTOR

Deflections given are those anticipated to occur in the stringer upon placement of the total concrete deck dead load. In practice, the stringers in place are not likely to have the exact camber to compensate for these deflections during construction. The residual amounts shall be provided by adjusting forms to vary the thickness of the concrete haunch between the bottom of the slab and the top of stringer without altering the slab thickness.

NOTE: Intermediate stiffener R.s 4x4 shall be equally spaced between diaphragms. The first two stiffeners spaced at the ends of stringers shall be one-half normal spacing within the panel.

If it may be necessary to increase Bearing Stiffener size to accommodate erection of end diaphragm.

Note: For Deck Plan, see Sheet 19. For Joint Details, see Sheets 18 & 25. For Joint Details of Pier 10W, see Sheet 42, Bridge 67. For Standard Shoe Details, see Sheet 51. For Details of FB 14 and FB 15, see Sheet 18.

See Sheet 4 for special modifications of masonry plate, F6M @ Pier 1.

For Section H-H, see Sheet 19. For Horizontal Stiffener Detail and Flange to Web Welds, see Sheet 15.

SHOE SCHEDULE			
EXPANSION SHOE		FIXED SHOE	
TYPE	NO. REQD.	TYPE	NO. REQD.
E 12	4	F 6 M	3

UNIT	STRINGER	Dim. "A"	LENGTH	Dim. "B"	Dim. "C"	Dim. "D"	Dim. "E"	Dim. "F"	Dim. "G"	PL "C"	PL "D"	PL "F"	PL "G"	MAX. SHEAR STUD SPACING										
														0.0L-0.1L	0.1L-0.2L	0.2L-0.3L	0.3L-0.4L	0.4L-0.5L	1/4L	1/2L	3/4L			
1	S1-1	106'-3 3/8"	105' 15 3/8"	23'-0 1/2"	23'-0"	29'-8 3/4"	23'-0 1/2"	23'-0"	29'-8 3/4"	18x7 1/2"	18x1 1/2"	18x7 1/2"	18x1 1/2"	—	—	—	—	—	7/8"	1 1/4"	7/8"	2 3/16"	2 1/8"	2 1/8"
	S2-1	106'-3 3/8"	105' 15 3/8"	23'-0 1/2"	23'-0"	29'-8 3/4"	23'-0 1/2"	23'-0"	29'-8 3/4"	18x7 1/2"	18x1 1/2"	18x7 1/2"	18x1 1/2"	—	—	—	—	—	7/8"	1 1/4"	7/8"	2 3/16"	2 1/8"	2 1/8"
2	S1-2	143'-9 1/2"	142' 7 1/4"	19'-0"	19'-7 1/4"	52'-0"	—	—	71'-3 1/2"	24x1 1/2"	24x2 1/2"	—	18x1"	24"	24"	24"	24"	24"	1 3/16"	2 9/16"	1 3/16"	4 3/8"	6 3/16"	4 1/4"
	S2-2	149'-2 5/8"	145'-9 3/8"	20'-0"	20'-9 3/8"	52'-6"	—	—	72'-10 1/2"	24x1 1/2"	24x2 1/2"	—	18x1"	24"	24"	24"	24"	2 1/4"	2 9/16"	2 1/4"	4 3/8"	6 3/16"	4 1/4"	
	S3-2	152'-6 1/2"	149'-0 1/2"	20'-0"	22'-0 1/2"	53'-6"	—	—	74'-0 1/2"	24x1 1/2"	24x2 1/2"	—	18x1"	24"	24"	24"	24"	2 1/4"	2 9/16"	2 1/4"	4 3/8"	6 3/16"	4 1/4"	
	S4-2	141'-4"	141'-4"	—	—	20'-4 1/2"	—	—	20'-4 1/2"	—	12x3 1/2"	—	12x3 1/2"	24"	24"	24"	24"	24"	0	1 1/16"	0	4 1/4"	1 1/16"	1 1/16"

NO.	REVISION	BY	DATE
5	As Built	TEM	6-77
4	Pier Angle Chg.	REB	1-13-75
3	Note changed added	PRMS	4-19-74
2	Sign Support Bracket & Inter Diaph. Spc. added	L.N.B.	9-9-74
1	Unit 2 Deleted	L.N.B.	10-1-74

Note: * Spacing begins at termination of 6 spaces @ 4".
All steel shall be A36 unless otherwise shown.

Note: For revisions to Unit 2, see Sheet 12a.


RICHMOND METROPOLITAN AUTHORITY
RICHMOND EXPRESSWAY SYSTEM
DOWNTOWN EXPRESSWAY

BRIDGE NO. 64
RAMP N-W CONNECTION FROM
RICHMOND-PETERSBURG TURNPIKE
FRAMING PLAN-UNITS 1


HOWARD, NEEDLES, TAMMEN & BERGENOFF
consulting engineers
NEW YORK ALEXANDRIA KANSAS CITY

SCALE: As Noted
CONTRACT NO.: 10
SHEET NO. 12 OF 28


AS BUILT

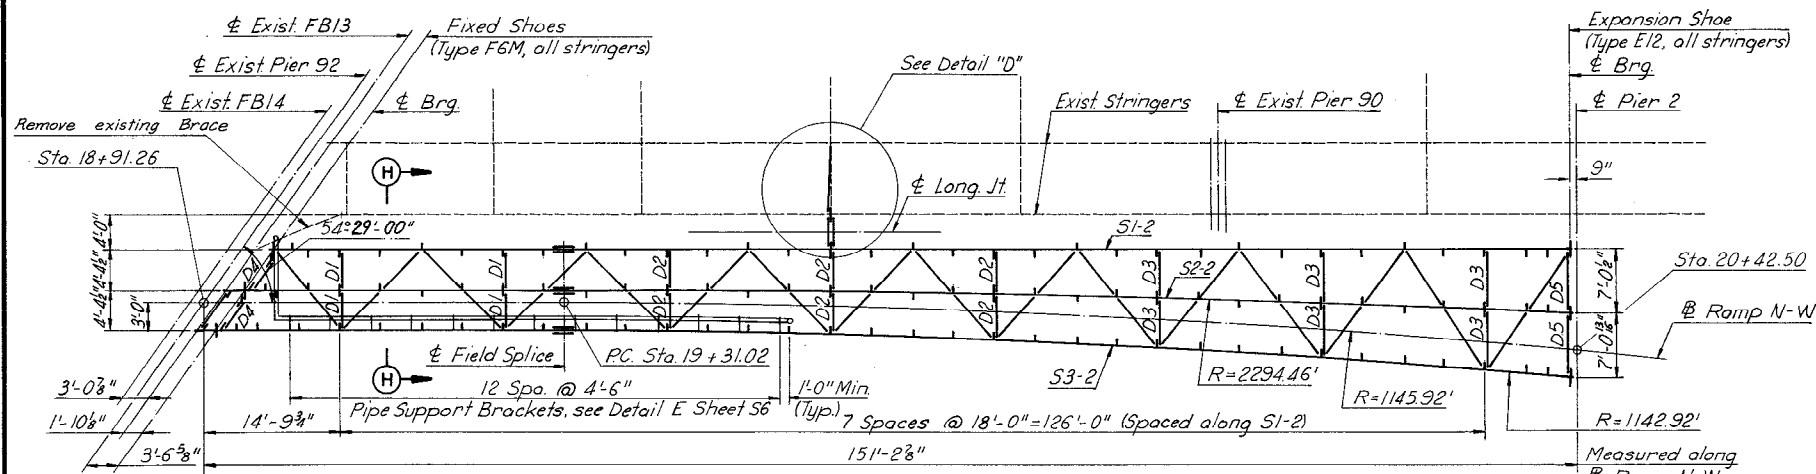


FRAMING PLAN
Scale: 1"=10'-0"

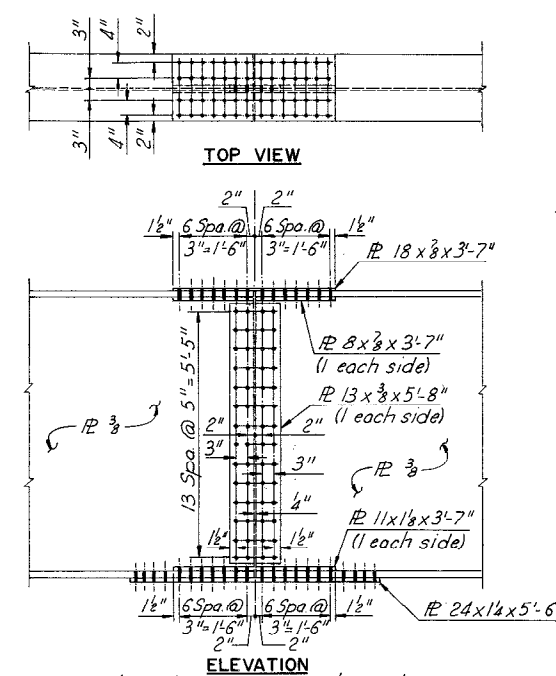

ELEVATION

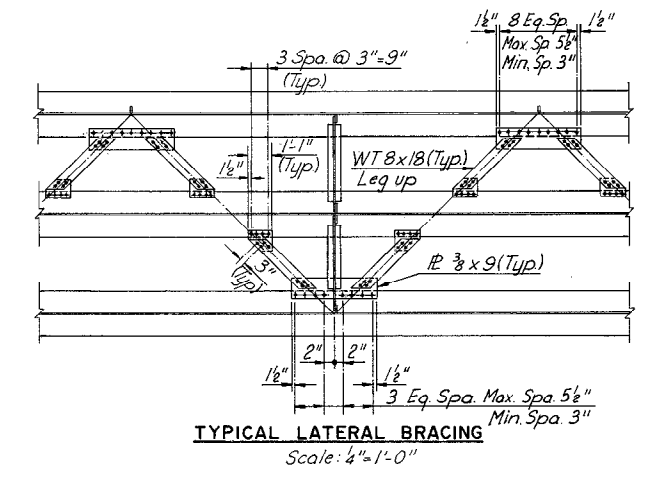


TYPICAL LATERAL BRACING
Scale: 1/4"=1'-0"

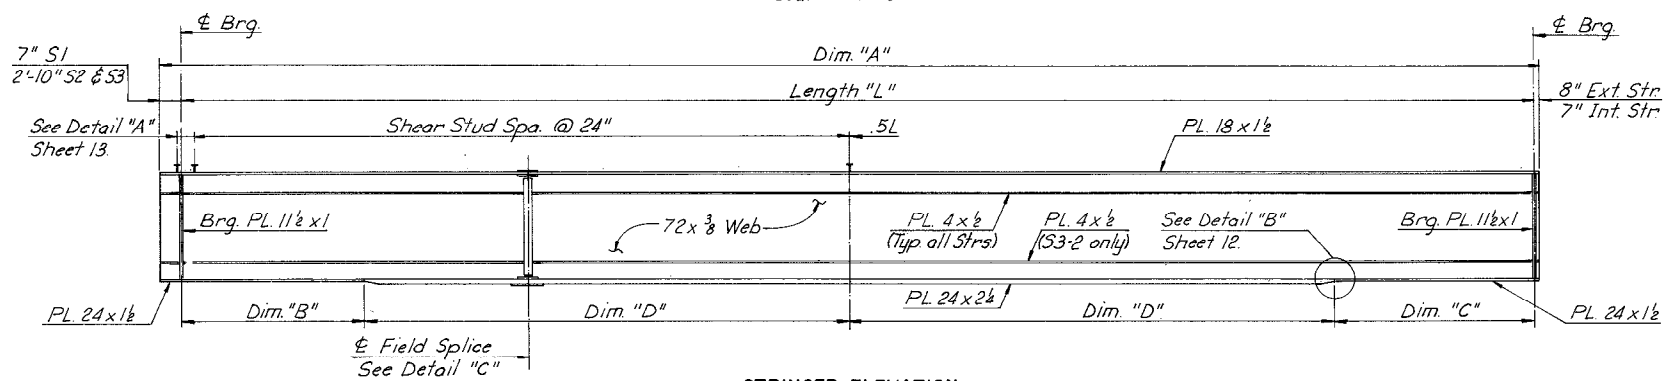


STRINGER ELEVATION
Scale: None

STRINGER SCHEDULE					DEAD LOAD DEFLECTION SCHEDULE						CAMBER SCHEDULE			
STRINGER	LENGTH "L"	DIM. "A"	DIM. "B"	DIM. "C"	DUE TO CONCRETE			DUE TO STEEL						
					1/4L	1/2L	3/4L	1/4L	1/2L	3/4L	1/4L	1/2L	3/4L	
S1-2	142'-7 1/8"	143'-9 3/8"	19'-0"	19'-7 1/8"	52'-0"	1 5/8"	1 7/8"	1 3/8"	3/4"	1 1/8"	3/8"	3 3/8"	4 1/8"	3 3/8"
S2-2	145'-9 3/8"	149'-2 3/8"	20'-0"	20'-9 3/8"	52'-6"	1 3/8"	2 1/4"	1 3/8"	3/8"	1 3/8"	3/8"	4 1/8"	6 1/4"	4 3/8"
S3-2	149'-1"	152'-6 1/8"	20'-0"	22'-1"	53'-6"	1 3/8"	2 1/2"	1 3/8"	1 3/8"	1 1/4"	3/8"	5 1/8"	7 1/2"	5 1/8"


These holes to be shop sub-punched. Ream and connect in field after full dead load deflection has occurred.

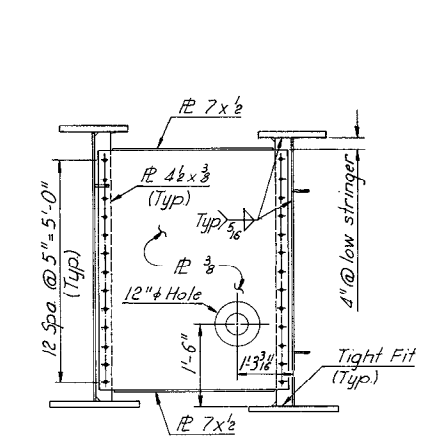


DIAPHRAGM D1
Scale: 1/2"=1'-0"

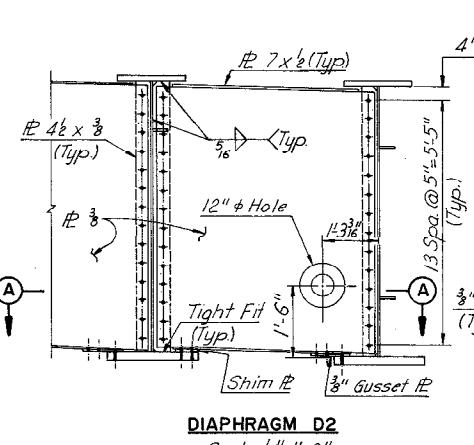


DIAPHRAGM D2
Scale: 1/2"=1'-0"

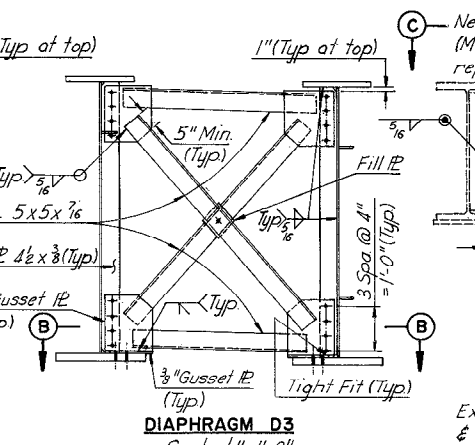


DIAPHRAGM D3
Scale: 1/2"=1'-0"

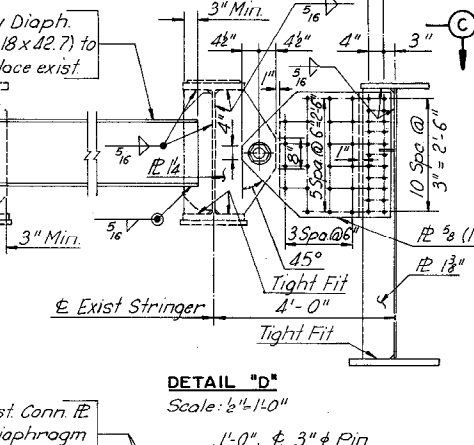

DIAPHRAGM D4
Scale: 1/2"=1'-0"

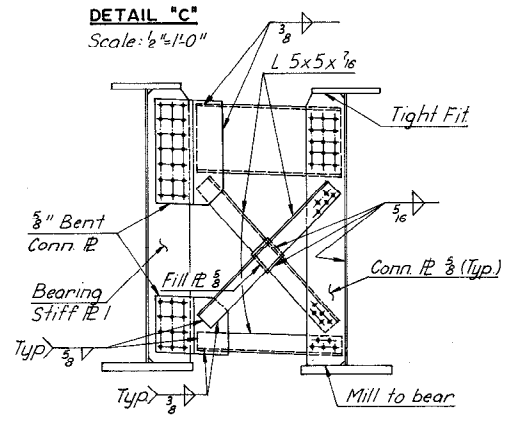


DETAIL 'C'
Scale: 1/2"=1'-0"

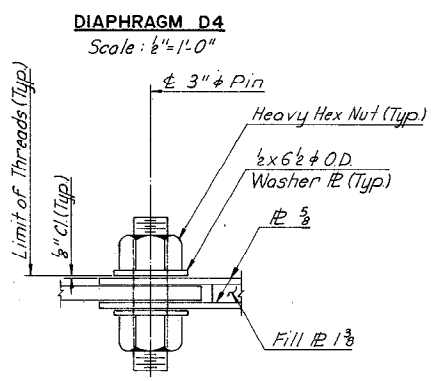


DETAIL 'E'
Scale: 1/2"=1'-0"


- NOTE:**
1. For Diaphragm D5 use type shown as end diaphragm section B-B, Sheet 20.
 2. For notes not shown, see Sheet 12.
 3. For Section H-H see Sheet 19.

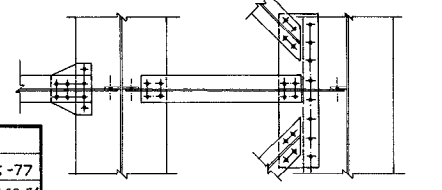

SECTION A-A
Scale: 1/2"=1'-0"

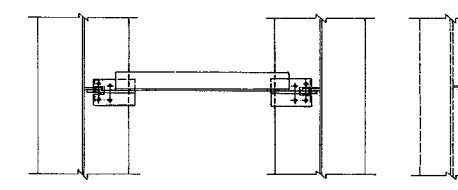

SECTION B-B
Scale: 1/2"=1'-0"

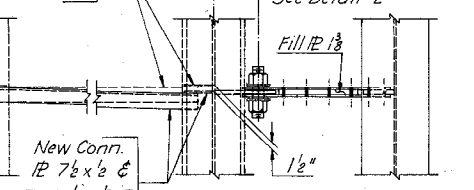

VIEW C-C
Scale: 1/2"=1'-0"

DESIGNED		3	As Built	TEM	6-77
DRAWN	N.L.B. 10-7-74	1	Remove Brace & Change angle	NLB	12-30-74
CHECKED	R.B.H. 11-4-74	1	New Sheet Added	NLB	10-7-74
IN CHARGE	PRY	NO.	REVISION	BY	DATE

AS BUILT

RICHMOND METROPOLITAN AUTHORITY
RICHMOND EXPRESSWAY SYSTEM
DOWNTOWN EXPRESSWAY


BRIDGE NO. 64
RAMP N-W CONNECTION FROM
RICHMOND-PETERSBURG TURNPIKE
FRAMING PLAN-UNIT 2

SCALE AS NOTED	SHEET 12b OF 28
DATE	

HOWARD, NEEDLES, TAMMEN & BERGENDOFF
CONSULTING ENGINEERS
Alexandria, Virginia


HNTB

RICHMOND EXPRESSWAY SYSTEM			
SECTION	PROJECT	SHEET NO.	TOTAL SHEETS
10.	DOWNTOWN EXPRESSWAY	116	265

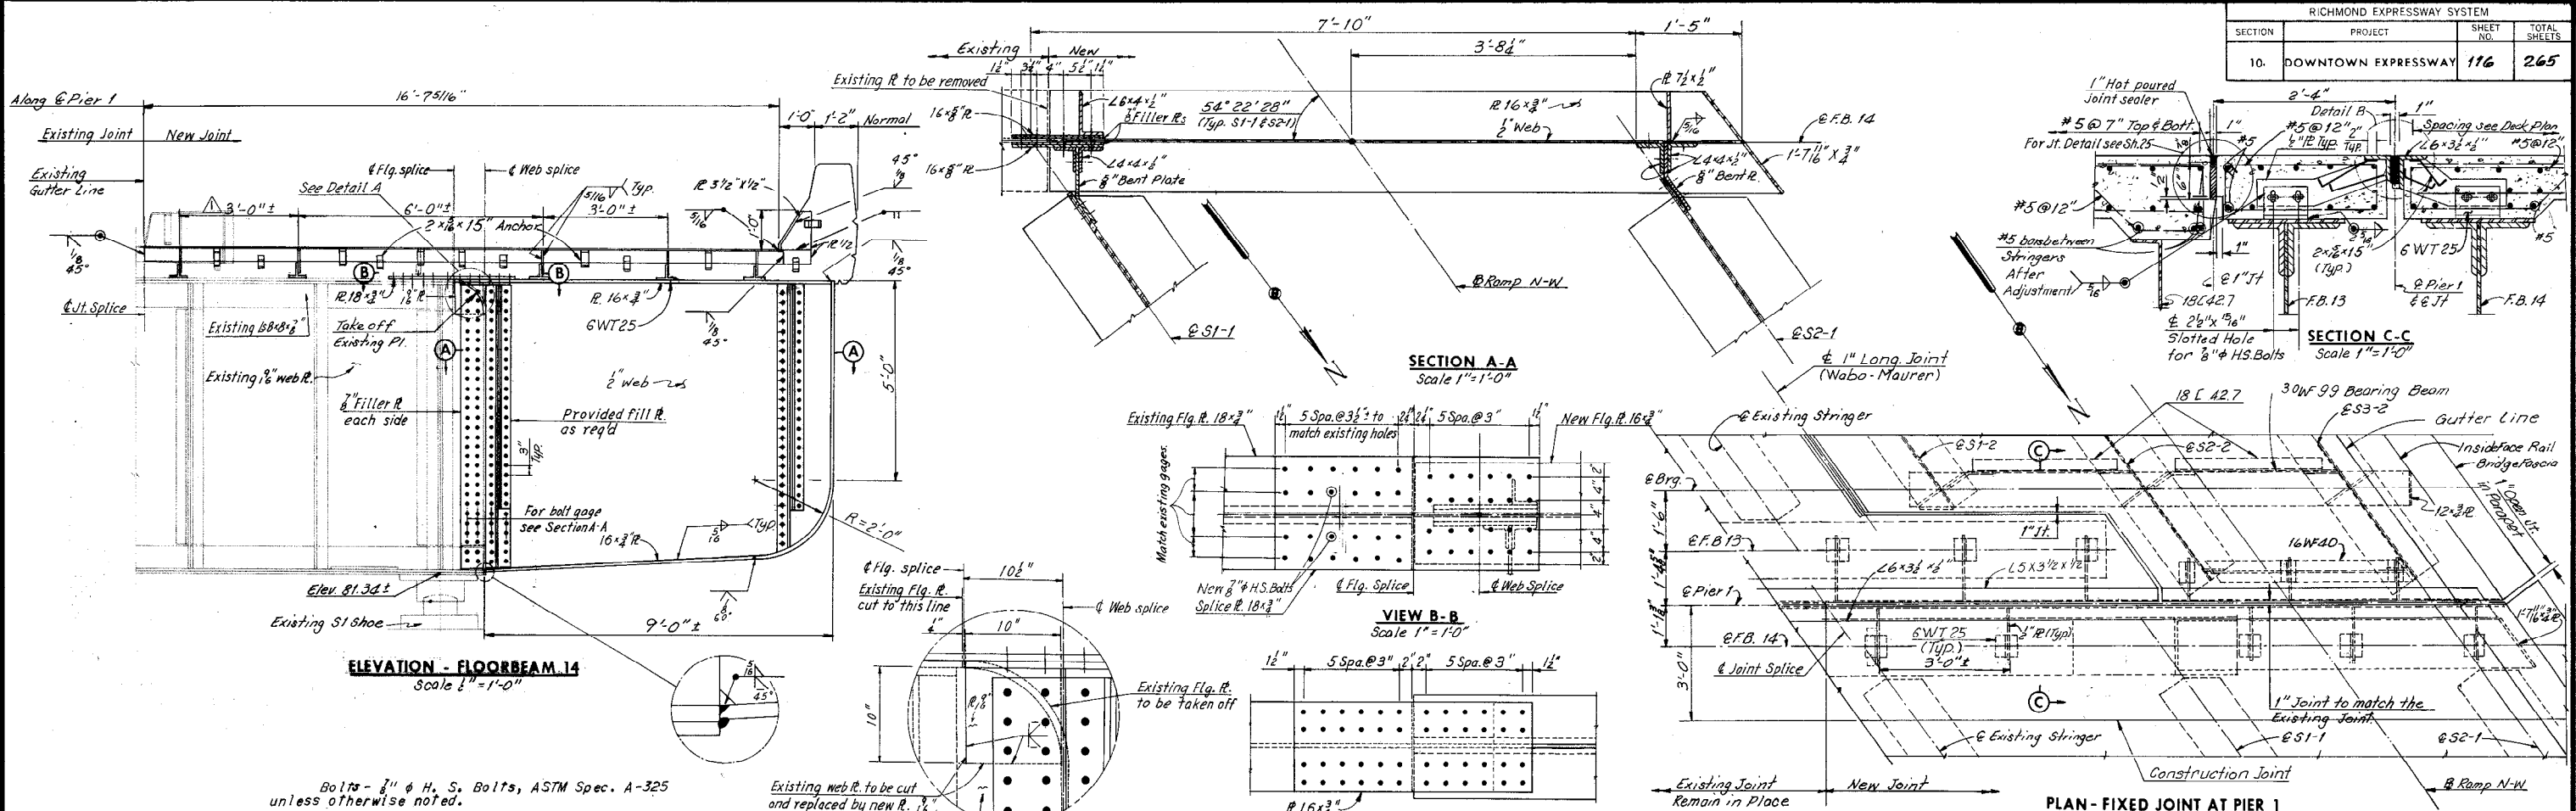

Bolts - 3/4" ϕ H. S. Bolts, ASTM Spec. A-325 unless otherwise noted.

Note: 1" Joint at pier 1 is to match the existing joint. The Contractor shall verify the location of joint.

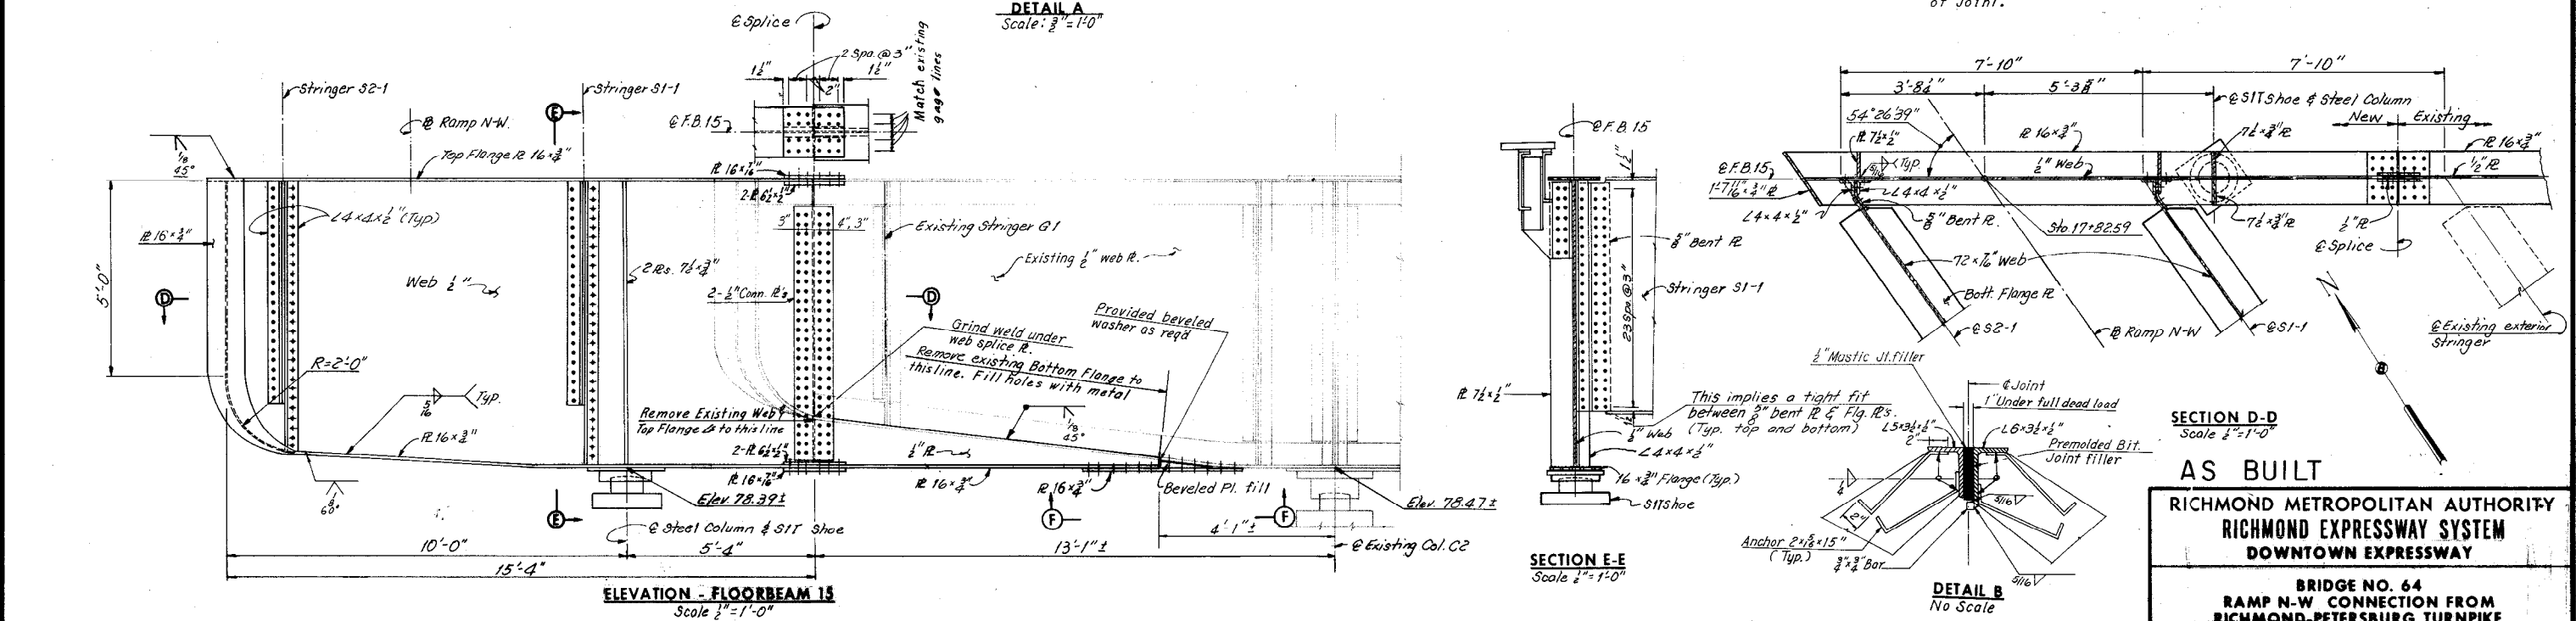

Note: Dimensions shown on the plans for existing structural metalwork are in accordance with drawings prepared for the original construction. The Contractor shall verify all necessary dimensions of existing structural metalwork prior to fabrication of new metalwork.

Note: For Joint Details at F.B. 15, see Sheet 42 Bridge 67. For Framing plan, see Sheet 12. For Steel Column Details, see Sheet 28 Bridge 67. For SIT Shoe Details, see Sheet 47 Bridge 67. All Elevations are to be verified by the Contractor.

BY	DATE	REVISION	BY	DATE	
BY	DATE	2	As Built	T&M	G-77
MADE	G.C.C. 3-13-69	1	Unit 2 End Depth Pier 1 revised	LBP	10-31-74
CHECKED	Y.C.P. 4-25-69	1	3/2 x 3/2 x 3 support changed to 6W125		
IN CHARGE		NO.			

AS BUILT

RICHMOND METROPOLITAN AUTHORITY
RICHMOND EXPRESSWAY SYSTEM
DOWNTOWN EXPRESSWAY


BRIDGE NO. 64
RAMP N-W CONNECTION FROM
RICHMOND-PETERSBURG TURNPIKE

FRAMING DETAILS

HOWARD, NEEDLES, TAMMEN & BERGENDOFF
consulting engineers
NEW YORK ALEXANDRIA KANSAS CITY








SCALE: As Noted
CONTRACT NO. 10
SHEET NO. 18 OF 28

RICHMOND EXPRESSWAY SYSTEM			
SECTION	PROJECT	SHEET NO.	TOTAL SHEETS
10	DOWNTOWN EXPRESSWAY	117	265

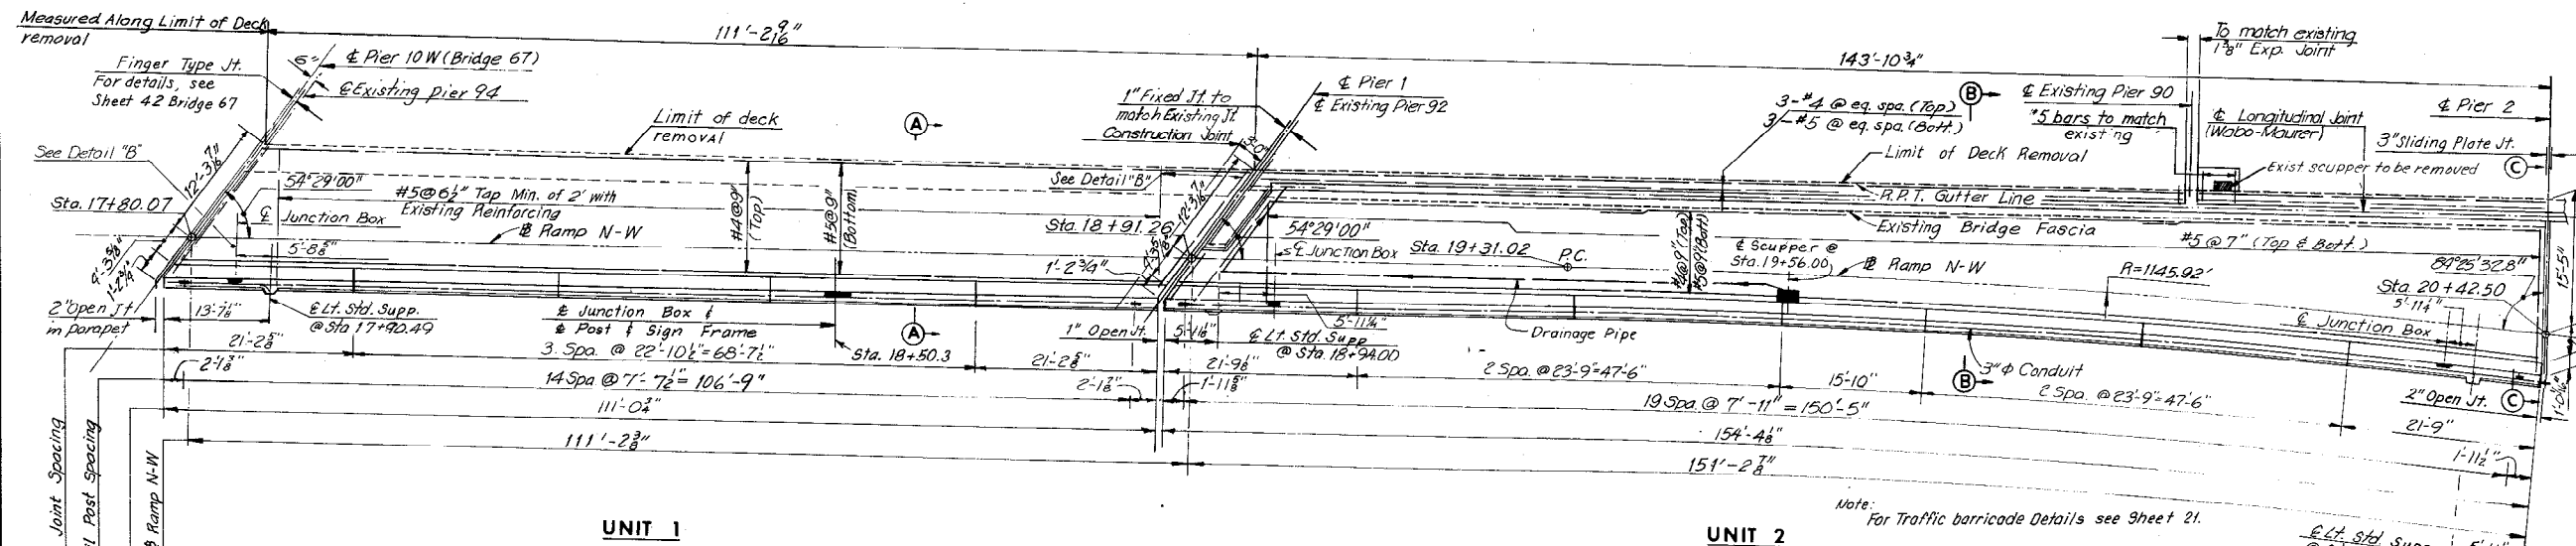

ELEVATION TABLE			
STATION	ELEV. A	ELEV. B	ELEV. C
17+77.57	87.11	-	-
17+80	87.17	87.07	86.78
17+80.07	-	87.07	-
17+87.21	-	-	87.00
17+90	87.44	87.35	87.07
18+00	87.70	87.61	87.35
18+10	87.95	87.87	87.63
18+20	88.19	88.12	87.90
18+30	88.43	88.36	88.15
18+40	88.66	88.59	88.40
18+50	88.88	88.81	88.64
18+60	89.09	89.03	88.87
18+70	89.29	89.24	89.10
18+80	89.49	89.44	89.32
18+88.75	89.65	-	-
18+90	89.67	89.64	89.57
18+91.26	-	89.66	-
18+98.42	-	-	89.72
19+00	89.87	89.84	89.78
19+10	90.06	90.03	89.98
19+20	90.23	90.22	90.18
19+30	90.40	90.39	90.37
19+40	90.56	90.55	90.54
19+50	90.71	90.71	90.71
19+60	90.84	90.85	90.88
19+70	90.95	90.98	91.04
19+80	91.05	91.10	91.20
19+90	91.15	91.21	91.35
20+00	91.24	91.31	91.49
20+10	91.31	91.39	91.64
20+20	91.38	91.47	91.77
20+30	91.43	91.54	91.91
20+40	91.47	91.59	92.04
20+41.28	-	-	92.06
20+42.50	-	91.60	-
20+42.84	91.49	-	-

Elevations given in the Elevation Table may require adjustment in the field.

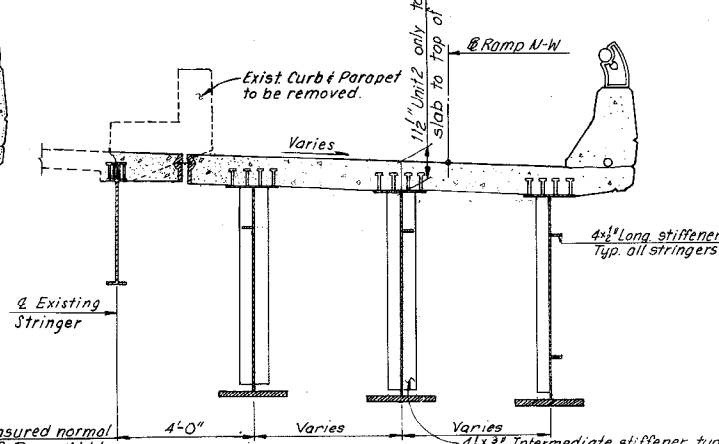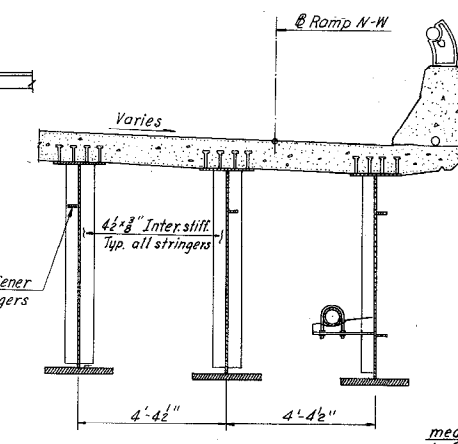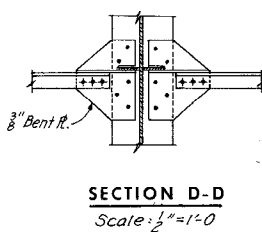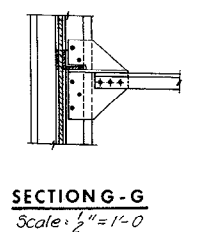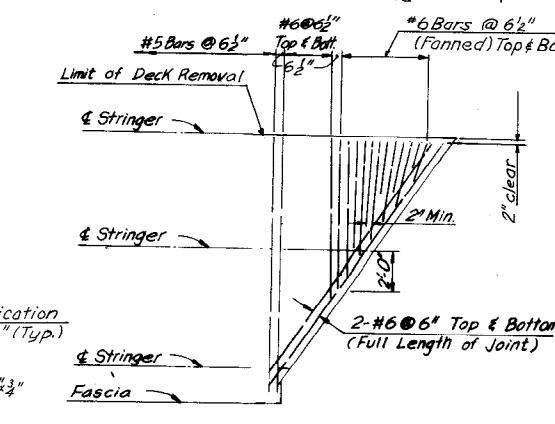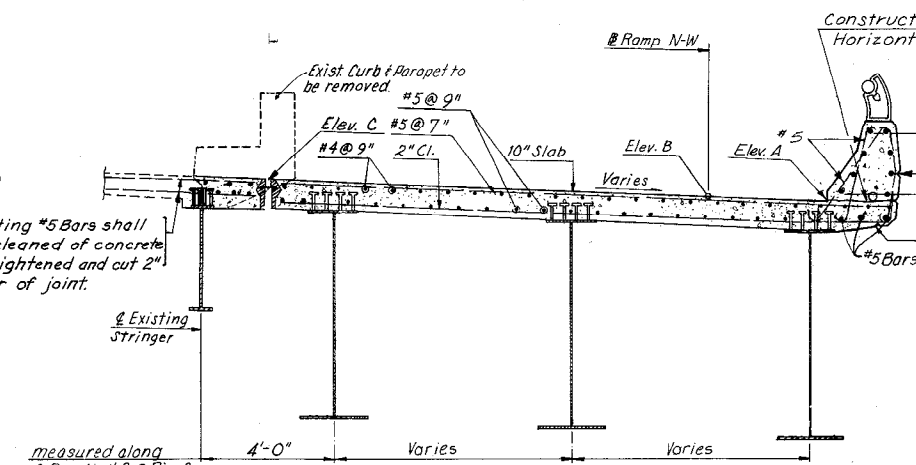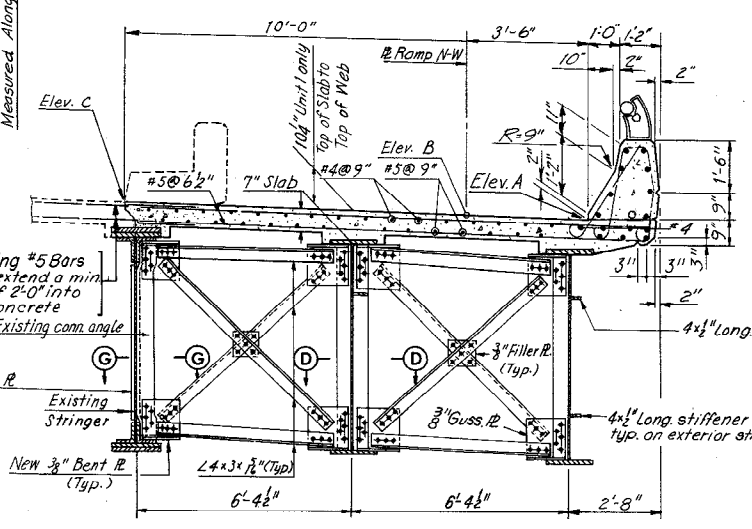

Notes:
For Joint Details, see Sheet 18, 25 and Sheet 42 Bridge 67.
Elevation C is to be confirmed by contractor.
For Framing Plan, see Sheet 12.
For Steel and Concrete Quantities, see Sheet 2.
For Handrail Details, see Sheet 33.
For Lighting Details, see Sheet 34.
For Standard Drainage Details, see Support Type II Sheet 56.

RICHMOND METROPOLITAN AUTHORITY
RICHMOND EXPRESSWAY SYSTEM
DOWNTOWN EXPRESSWAY

BRIDGE NO. 64
RAMP N-W CONNECTION FROM
RICHMOND-PETERSBURG TURNPIKE
DECK PLAN UNITS 1 AND 2
















HOWARD, NEEDLES, TAMMEN & BERGENDOFF
Consulting engineers
NEW YORK ALEXANDRIA KANSAS CITY

SCALE: As Noted
CONTRACT NO.: 10
SHEET NO. 19 OF 28

BY	DATE	REVISION	BY	DATE
4 As Built	TEM	G-77		
BY	DATE	Note for Table of Elevations	DWB	1-28-75
MADE	Y.C.P. 2-12-69	Chg. of Pier Angle Added	REB	1-13-75
CHECKED	SCC. 4-27-69	Deck Plan Sect. A-A, B-B, C-C, H-H, Det. B	TEM	10-31-74
IN CHARGE				

AS BUILT

RICHMOND EXPRESSWAY SYSTEM			
SECTION	PROJECT	SHEET NO.	TOTAL SHEETS
10	DOWNTOWN EXPRESSWAY	123	265

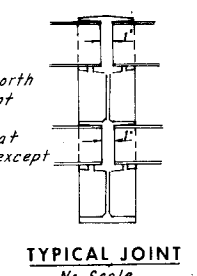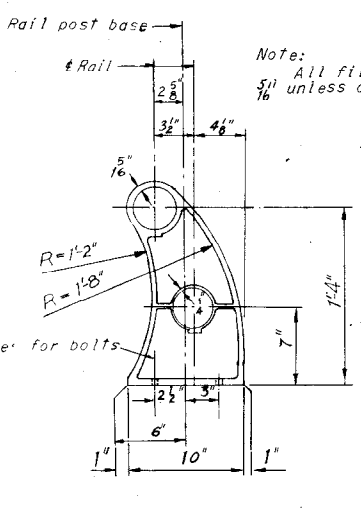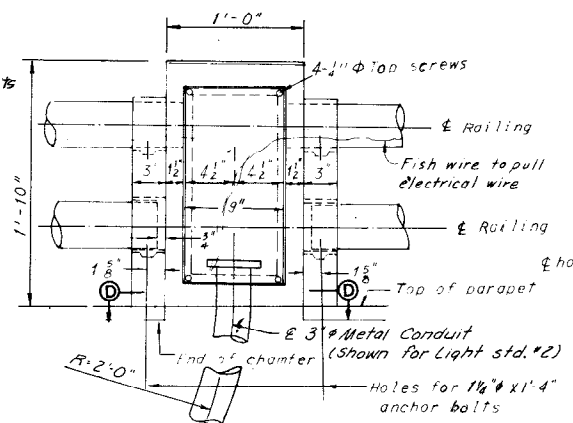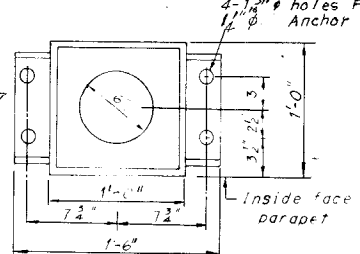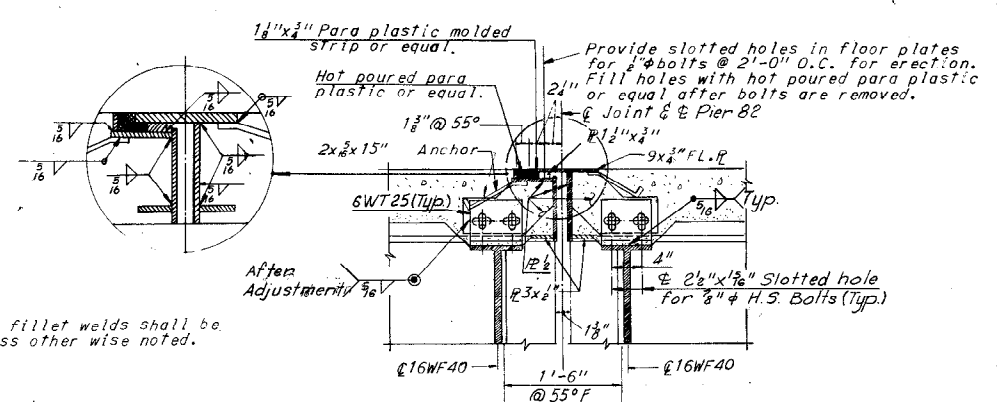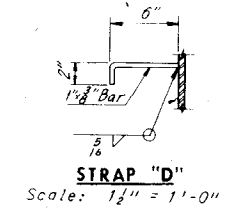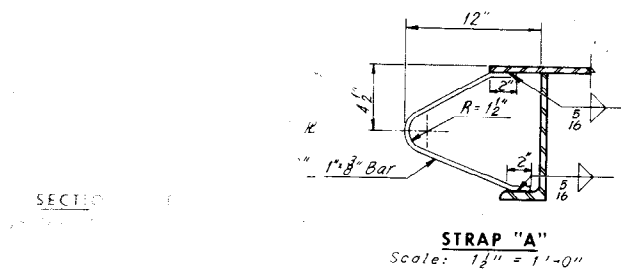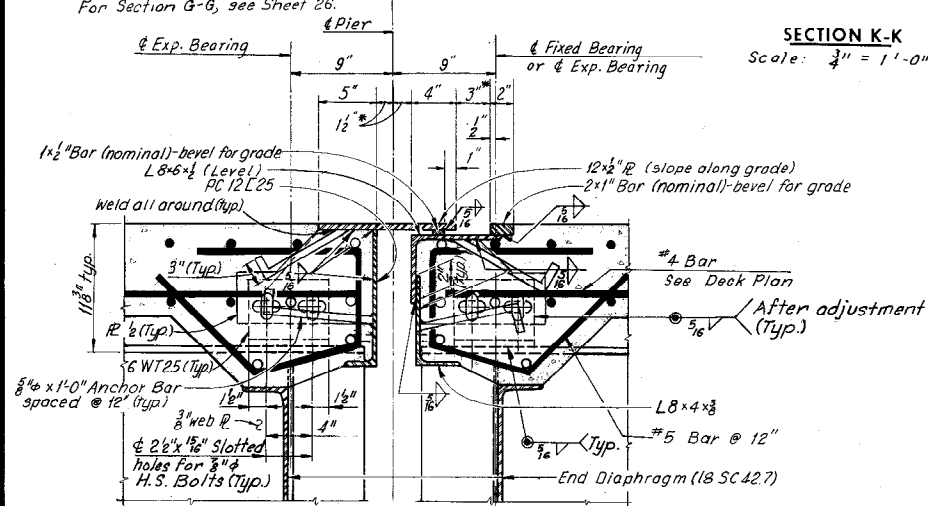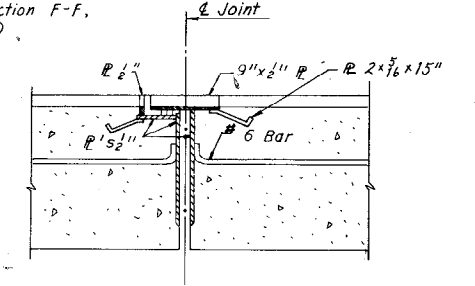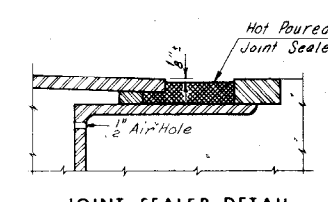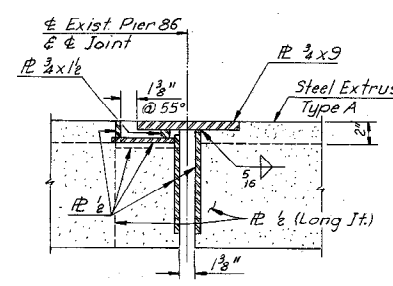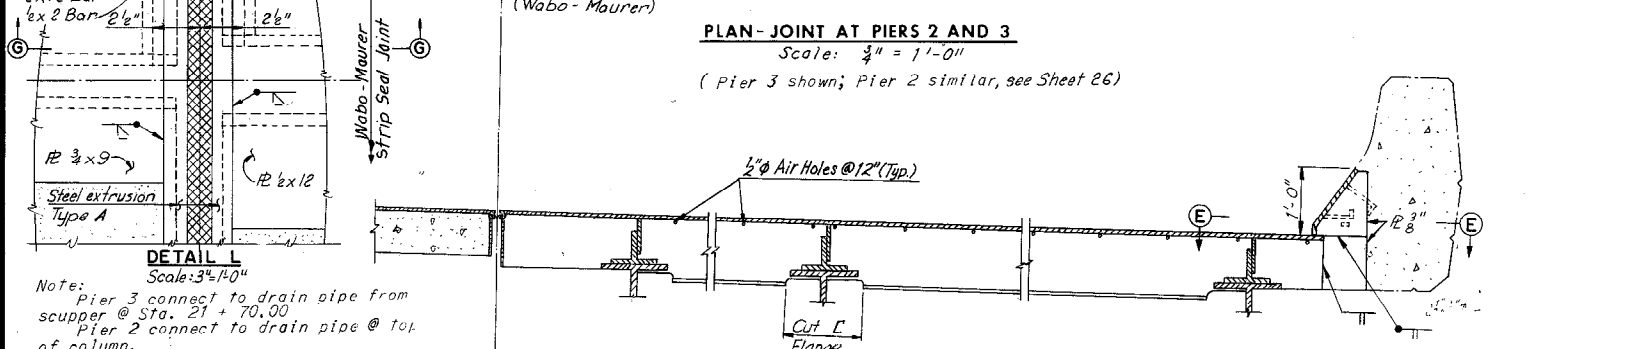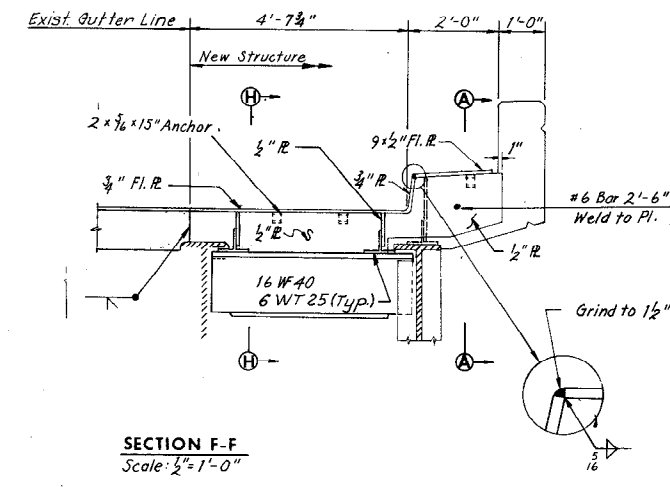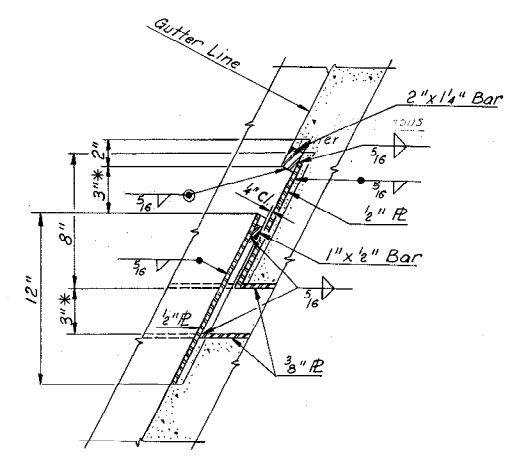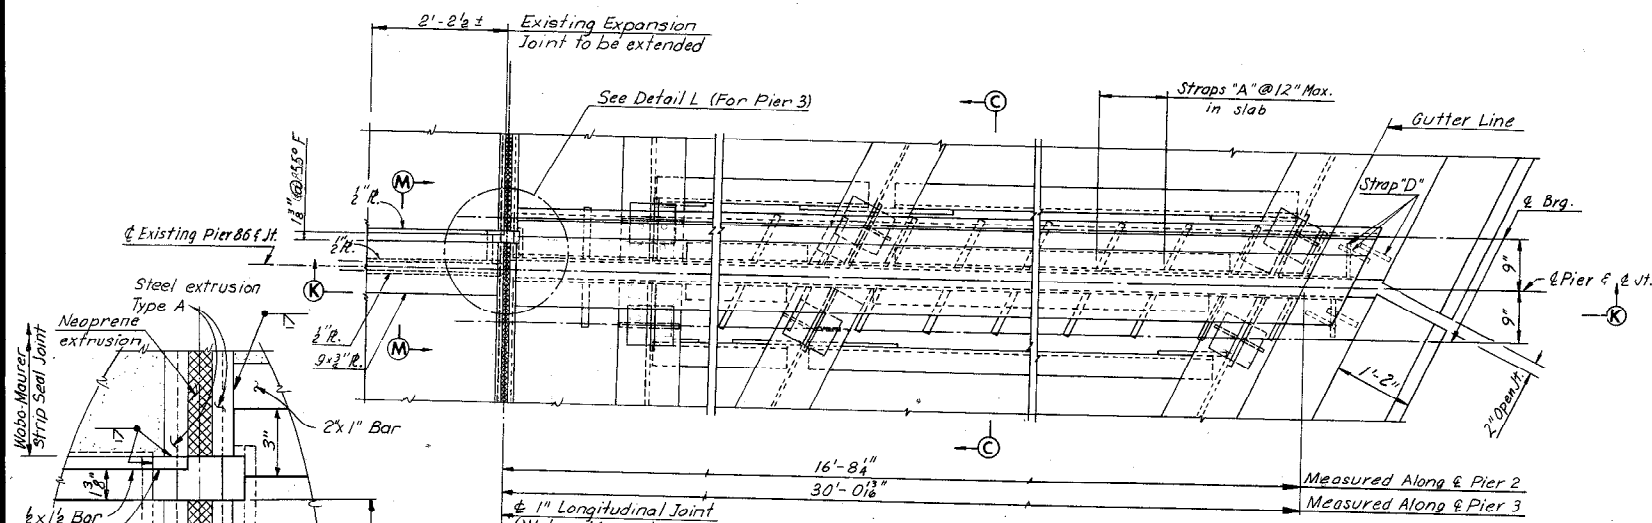

LEGEND

- Denotes transverse #5 Bar spaced as shown on Sheets 19 and 20.
- Denotes transverse #6 Bar between stringers.
- * Denotes dimension shown @ 60° F.

2 As Built		TEM G-77	
BY	DATE	NO.	REVISION
MADE	Y.C.P. 3-20-69	1	Sect G & 2 Det A moved to Sh. 26. Long. R. changed to Wabo-Maurer Slid'g R. Supports changed to 6 WT 25.
CHECKED	G.C.C. 4-21-69		
IN CHARGE			
BY	DATE	NO.	REVISION
NLB	10-31-74		

RICHMOND METROPOLITAN AUTHORITY
RICHMOND EXPRESSWAY SYSTEM
DOWNTOWN EXPRESSWAY

BRIDGE NO. 64
RAMP N-W CONNECTION FROM
RICHMOND-PETERSBURG TURNPIKE
JOINT DETAILS


HOWARD, NEEDLES, TAMMEN & BERGENDOFF
consulting engineers
NEW YORK ALEXANDRIA KANSAS CITY

SCALE: As Noted
CONTRACT NO. 10
SHEET NO. 25 OF 28


AS BUILT

NOTES FOR FILLED JOINTS:

Joints shall be free of cracked and spalled areas and their faces shall be free of all foreign matter, curing compound, oils, greases and dirt. All faces must be sandblasted or brushed with a mechanical rotary wire brush. Just prior to sealing, the joint shall be blown out with oil-free and water-free compressed air.

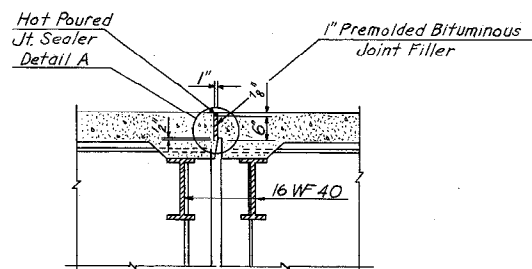


TYPICAL SECTION THRU 1" FIXED JOINT
Scale: 1/2"=1'-0"

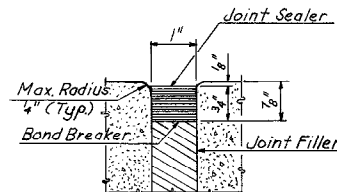

DETAIL A
No Scale

Note: Joint filler material and copper flashing to be included in price bid for Superstr. Concrete

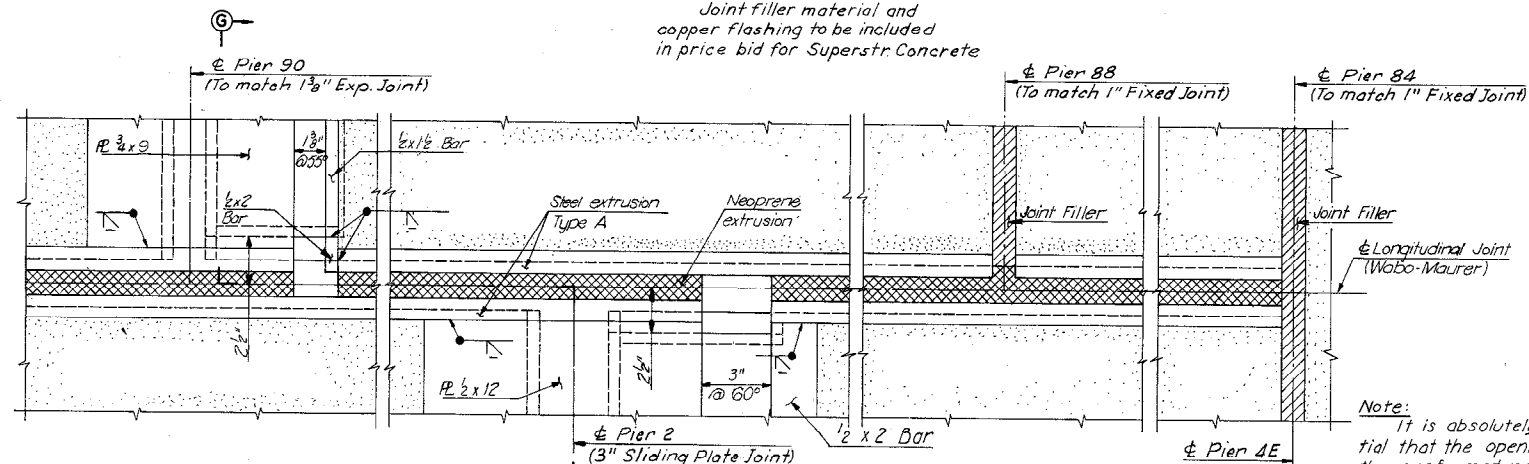

PLAN - LONGITUDINAL JOINT
Scale: 3"=1'-0"

NOTE: For Plan of Pier 3 & existing Pier 86, see Sheet 25.

Note: It is absolutely essential that the openings for the preformed neoprene joint sealers be accurately formed and constructed to smooth, straight lines. The size of opening shall be adjusted to allow for anticipated dead load rotation of the ends of the slab and for the temperature of the time of construction.


NOTES FOR WABO-MAURER JOINT:

Do not use steel extrusions as screed support. Steel extrusion shall conform to ASTM A36. Structural steel shall conform to ASTM A588. Steel assembly shall be shop welded to convenient lengths and butt welded in the field to desired length. Joint shall conform to grade of deck slab.


Steel assembly shall be sandblasted in the shop prior to painting.

Steel assembly shall receive one shop coat of epoxy zinc paint.

Neoprene extrusion shall be roughened with a wire brush before bonding to steel extrusion with Bon Lastic Adhesive. Groove in steel extrusion to be blown out with oil-free and water-free compressed air prior to installation of Neoprene extrusion. The Wabo-Maurer joint assembly shall be installed in accordance with manufacturer's recommended construction methods.

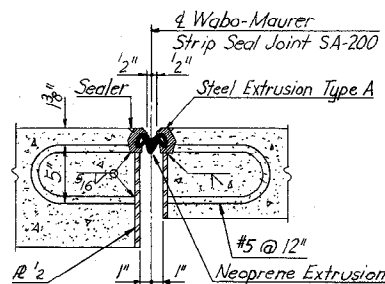


TYPICAL SECTION THRU WABO-MAURER JOINT
Scale: 1/2"=1'-0"

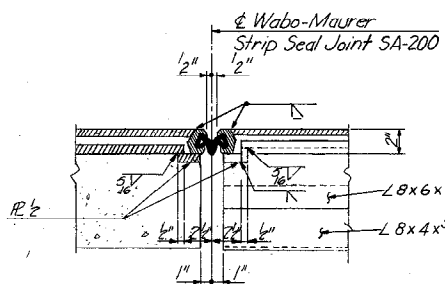


SECTION G-G
Scale: 1/2"=1'-0"


NOTE: Steel extrusion of Wabo-Maurer Joint to rest & slide on P 2. For location of Sect. G-G, see Plan-Long Joint above & Detail L, Sheet 25.

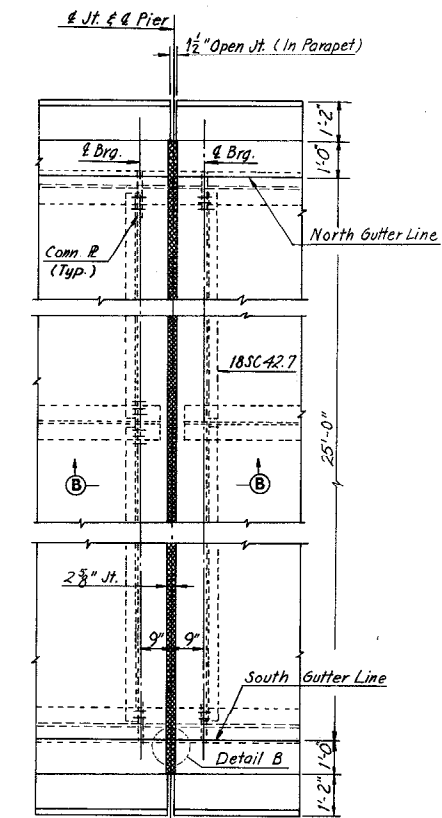

PLAN - JOINT AT PIERS 4, 5, 6, 7, 8 AND 9
Scale: 3/8"=1'-0"

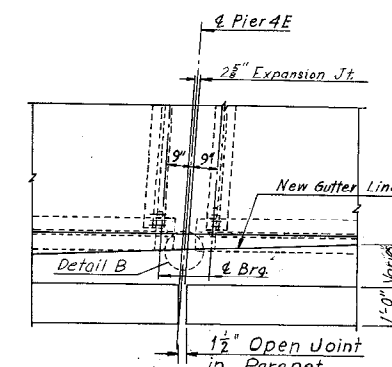


PLAN - JOINT AT PIER 4E
Scale: 3/8"=1'-0"

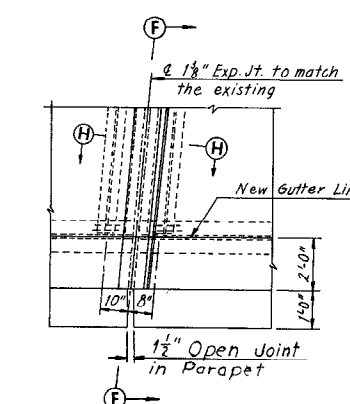


PLAN - JOINT AT EXISTING PIER 82
Scale: 3/8"=1'-0"

(For Section F-F & Section H-H, See Sheet 25)

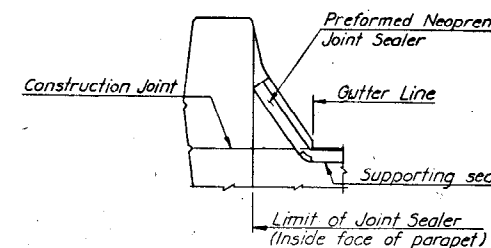


TREATMENT OF TYPE "A" JOINT AT GUTTER

PIERS 4, 5, 6, 7, 8 AND 9
No Scale

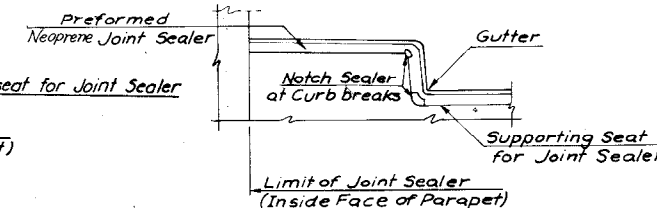


TREATMENT OF TYPE "A" JOINT AT CURB

PIER 4E
No Scale

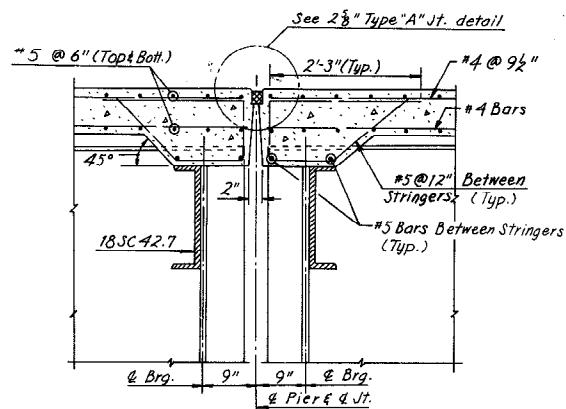

SECTION B-B
Scale: 3/4"=1'-0"

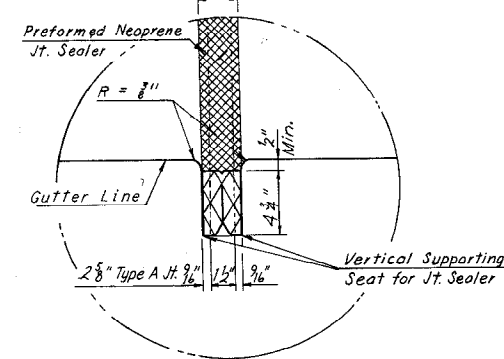

DETAIL B
No Scale

RICHMOND METROPOLITAN AUTHORITY
RICHMOND EXPRESSWAY SYSTEM
DOWNTOWN EXPRESSWAY

BRIDGE NO. 64
RAMP N-W CONNECTION FROM
RICHMOND-PETERSBURG TURNPIKE
JOINT DETAILS


HOWARD, NEEDLES, TAMMEN & BERGENDOFF
consulting engineers
NEW YORK ALEXANDRIA KANSAS CITY

SCALE: As Noted
CONTRACT NO. 10
SHEET NO. 26 OF 28

AS BUILT

BY	DATE	Z	As Built	TEM	G-77
MADE	Y.C.P. 3-18-69		Notes Typ Sect thru Joint Det. A, Typ Sect. thru Wabo-Maurer joint Sect. G-G add.	E.J.M. 10-31-70	
CHECKED	G.C.C. 4-21-69				
IN CHARGE		NO	REVISION	BY	DATE


RICHMOND EXPRESSWAY SYSTEM			
SECTION	PROJECT	SHEET NO.	TOTAL SHEETS
11	DOWNTOWN EXPRESSWAY	26	97

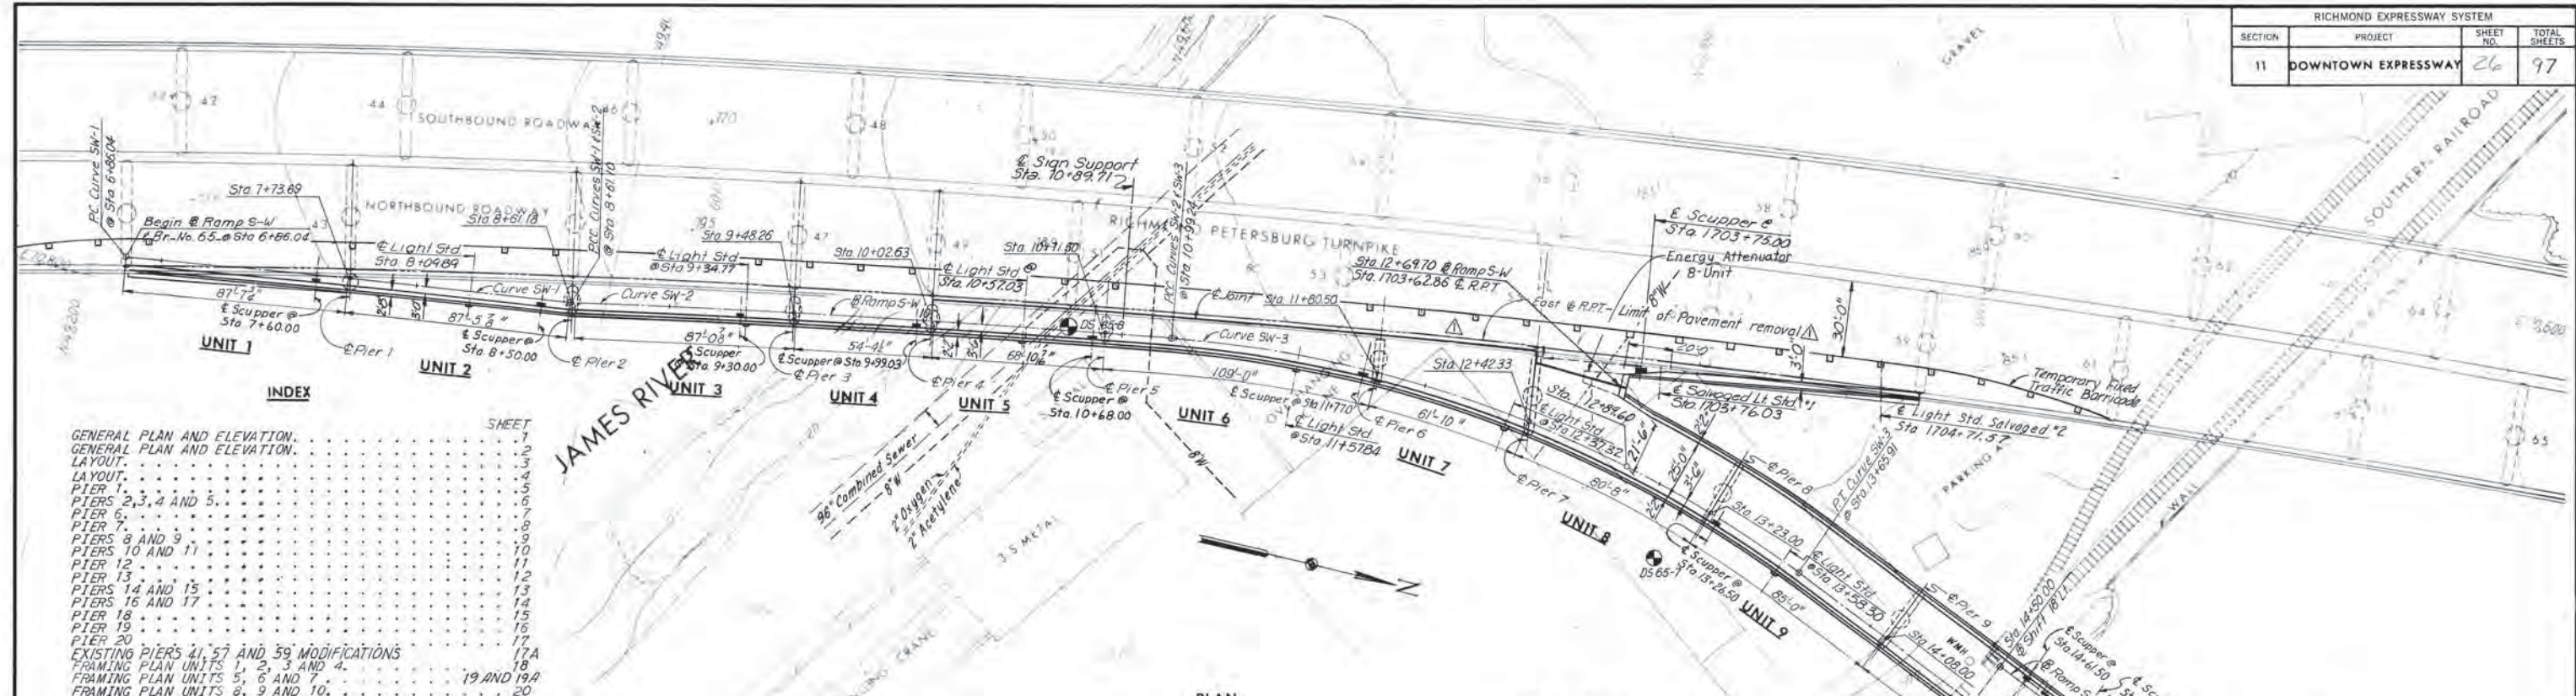


GENERAL PLAN AND ELEVATION	SHEET
GENERAL PLAN AND ELEVATION	1
LAYOUT	2
PIER 1	3
PIERS 2, 3, 4 AND 5	4
PIER 6	5
PIER 7	6
PIERS 8 AND 9	7
PIERS 10 AND 11	8
PIER 12	9
PIER 13	10
PIERS 14 AND 15	11
PIERS 16 AND 17	12
PIER 18	13
PIER 19	14
PIER 20	15
EXISTING PIERS 21, 57 AND 59 MODIFICATIONS	16
FRAMING PLAN UNITS 1, 2, 3 AND 4	17A
FRAMING PLAN UNITS 5, 6 AND 7	18
FRAMING PLAN UNITS 8, 9 AND 10	19 AND 19A
FRAMING PLAN UNITS 11, 12 AND 13	20
FRAMING PLAN UNITS 14, 15 AND 16	21
FRAMING PLAN UNITS 17 AND 18	22
FRAMING PLAN UNITS 19 AND 20	23
FRAMING PLAN UNITS 21 AND 22	24
DECK PLAN UNITS 1, 2, 3 AND 4	25
DECK PLAN UNITS 5, 6 AND 7	26
DECK PLAN UNITS 8, 9 AND 10	27
DECK PLAN UNITS 11, 12 AND 13	28
DECK PLAN UNITS 14, 15 AND 16	29
DECK PLAN UNITS 17 AND 18	30
DECK PLAN UNITS 19 AND 20	31
SUPERSTRUCTURE DETAILS	32
FIRE PROTECTION	(DELETED)
JOINT DETAILS	34 AND 35
BORING LOGS	36 THRU 38
FRAMING PLAN UNITS 8 AND 8W	20A

PLAN

PROFILE GRADE DATA

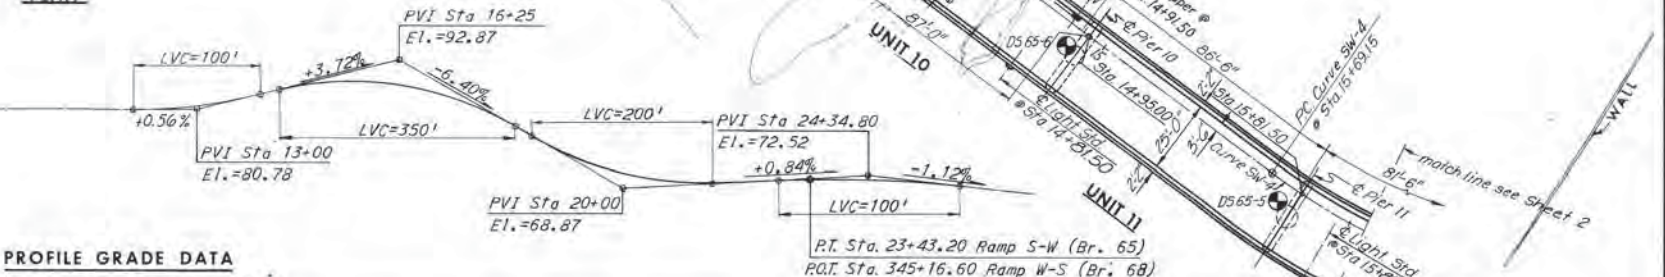


ELEVATION

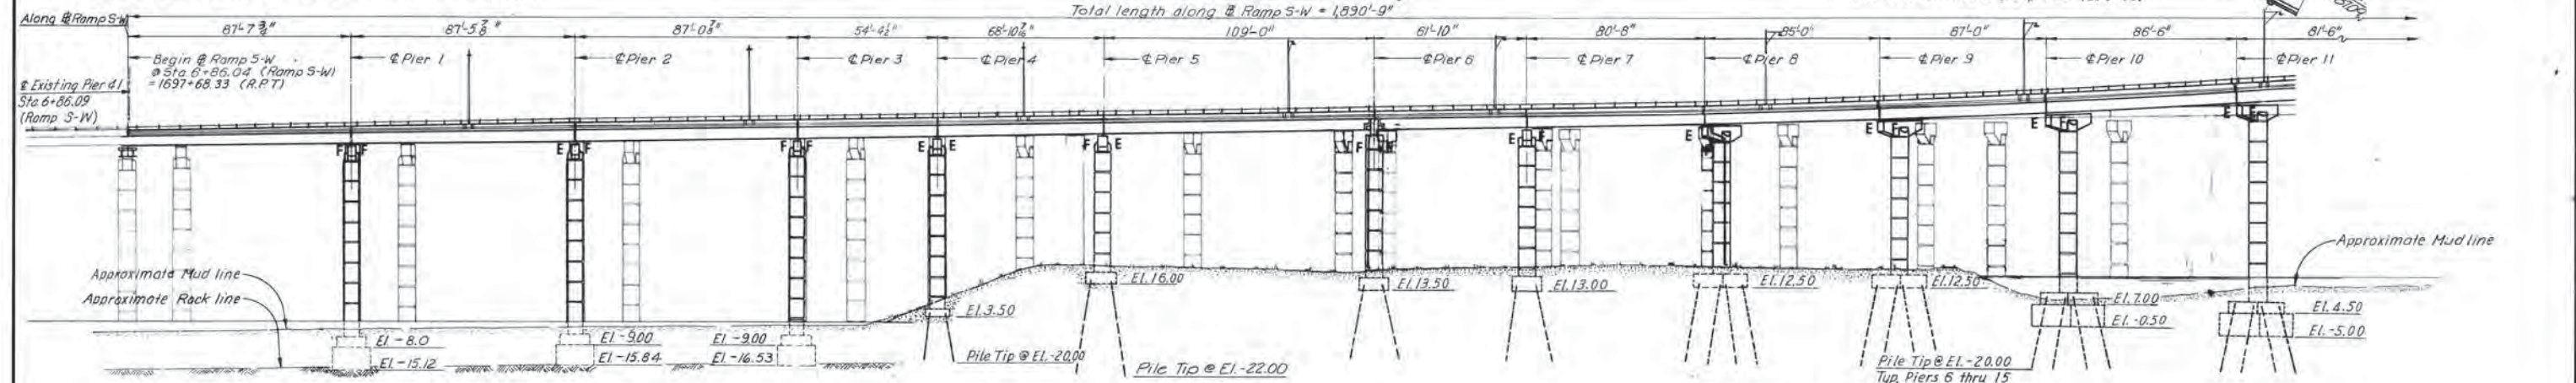

Notes:
 For General Plan and Elevation Units 12 thru 20 see Sheet 2.
 For Layout of Ramp S-W, see Sheets 3 and 4.
 For Estimated Quantities, see Sheet 4.
 For Boring Logs, see Sheets 36 thru 38.
 For General Notes, see Sheet 4.

NO.	REVISION	BY	DATE
1	Sheet 20a Added	TEM	9-9-75
2	Profile Ramp W-S	TEM	9-8-75
3	Limit of pavement removal & R.P.T.	B-25-75	
4	Sheet 17A added		

Substructure Note: Footings for Piers 1, 2 and 3 shall be founded on concrete seals socketed 1'-0" into solid rock.

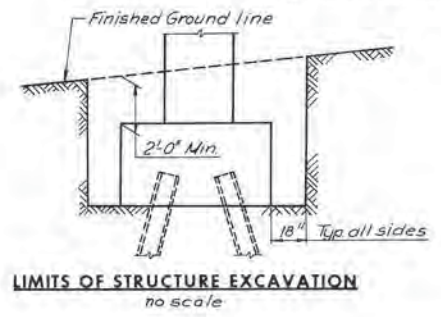

AS BUILT



RICHMOND METROPOLITAN AUTHORITY
RICHMOND EXPRESSWAY SYSTEM
DOWNTOWN EXPRESSWAY

BRIDGE NO. 65
RAMP S-W CONNECTION FROM
RICHMOND-PETERSBURG TURNPIKE
GENERAL PLAN AND ELEVATION

HOWARD, NEEDLES, TAMMEN & BERGENDOFF
 consulting engineers
 NEW YORK ALEXANDRIA KANSAS CITY

SCALE: 1"=30'-0"
 CONTRACT NO. 11
 SHEET NO. 1 OF 38

RICHMOND EXPRESSWAY SYSTEM			
SECTION	PROJECT	SHEET NO.	TOTAL SHEETS
11	DOWNTOWN EXPRESSWAY	27	97

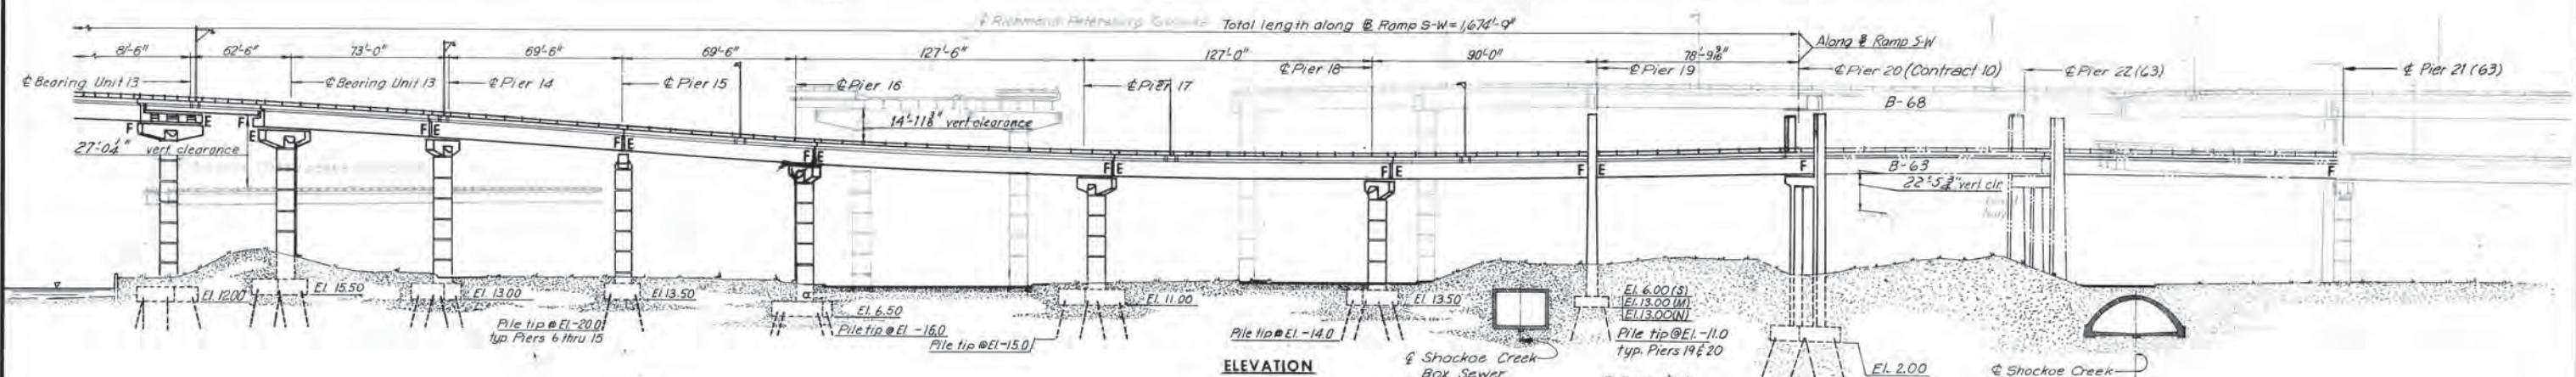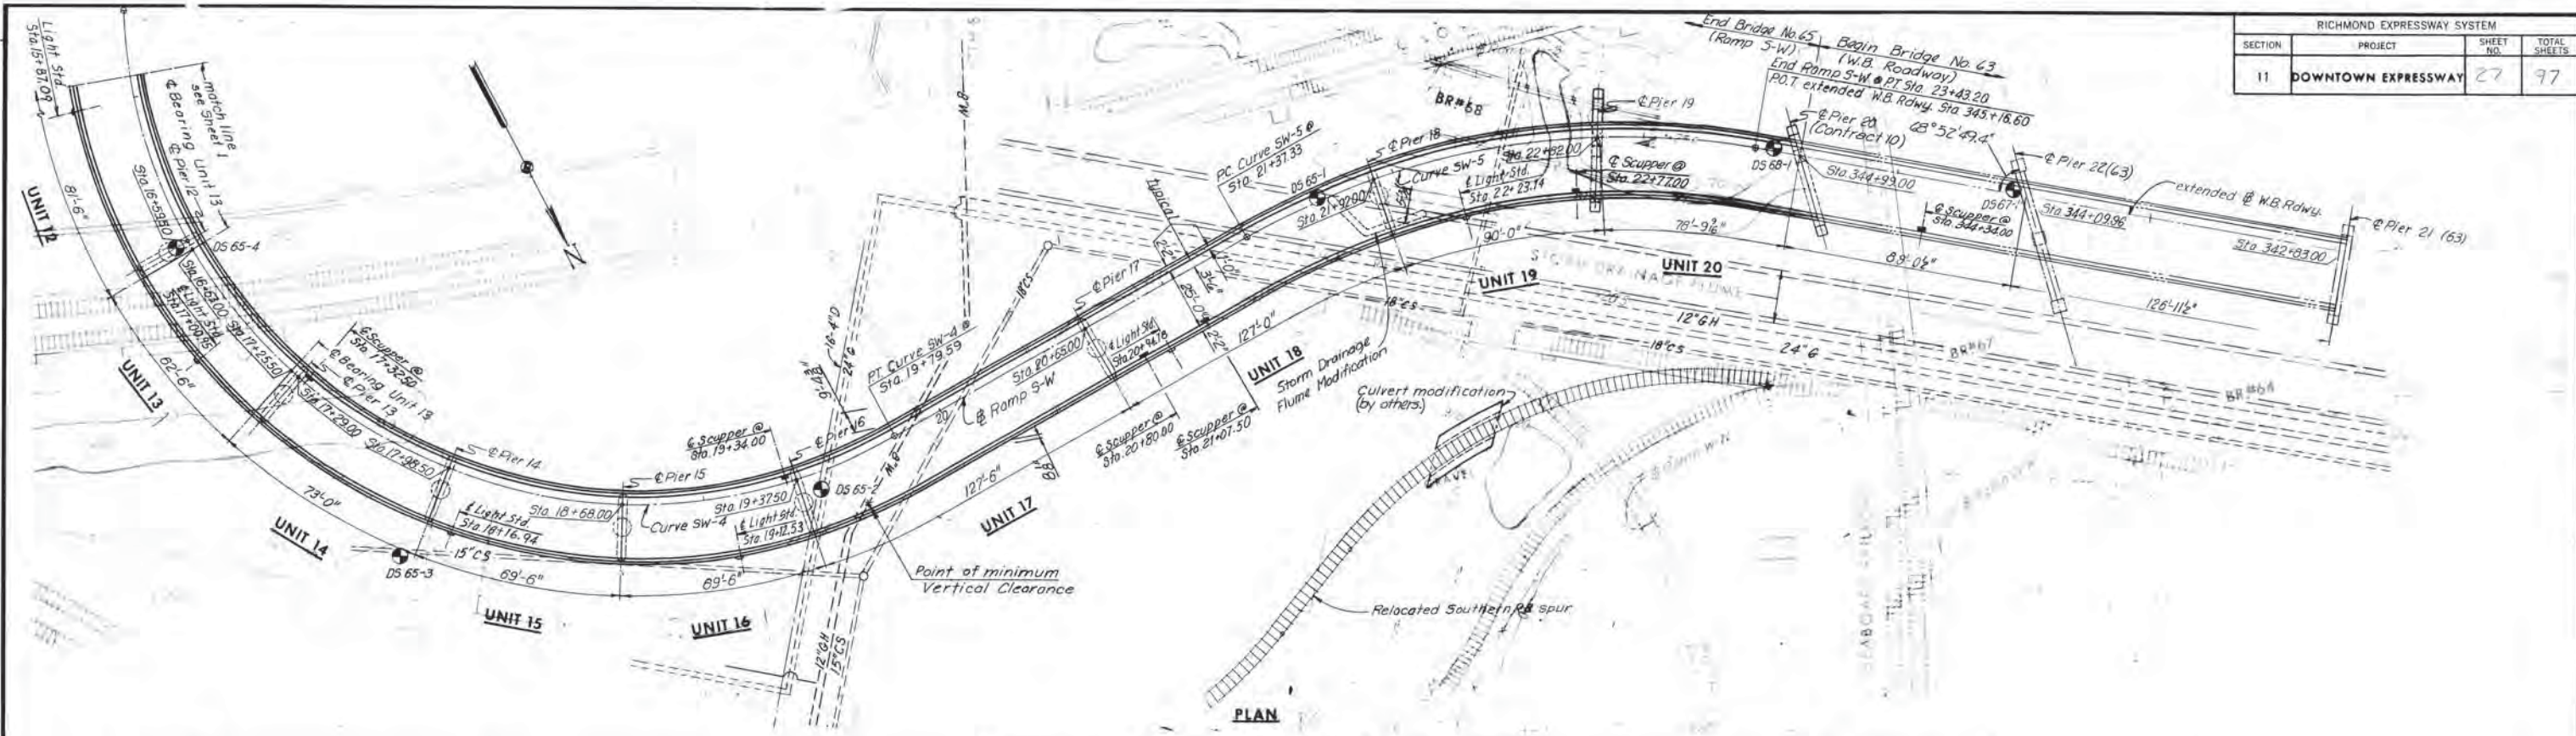

ELEVATION

<p>Curve: SW-1</p> <p>P. I. = Sta. 7+73.58</p> <p>Δ = 1°45'02"</p> <p>D = 1°00'</p> <p>T = 87.53'</p> <p>L = 175.05'</p> <p>R = 5,729.58'</p>	<p>Curve: SW-2</p> <p>P. I. = Sta. 9+80.19</p> <p>Δ = 2°24'12"</p> <p>D = 1°00'33"</p> <p>T = 119.09'</p> <p>L = 238.14'</p> <p>R = 5,677.58'</p>	<p>Curve: SW-3</p> <p>P. I. = Sta. 12+36.15</p> <p>Δ = 32°00'00"</p> <p>D = 12°00'</p> <p>T = 136.97'</p> <p>L = 266.67'</p> <p>R = 477.47'</p>
---	---	---

<p>Curve: SW-4</p> <p>P. I. = Sta. 18+95.05</p> <p>Δ = 116°25'03"</p> <p>D = 28°21'51"</p> <p>T = 325.90'</p> <p>L = 410.44'</p> <p>R = 202.00'</p>	<p>Curve: SW-5</p> <p>P. I. = Sta. 22+44.51</p> <p>Δ = 39°19'04"</p> <p>D = 19°05'55"</p> <p>T = 107.17'</p> <p>L = 205.87'</p> <p>R = 300.00'</p>
---	--

<p>Richmond-Petersburg Turnpike</p> <p>Curve: R.P.T.-1</p> <p>P. I. = Sta. 1704+68.83</p> <p>Δ = 15°03'56"</p> <p>D = 1°00'</p> <p>T = 757.65'</p> <p>L = 1,506.56'</p> <p>R = 5,729.58'</p>	<p>Curve: R.P.T.-2</p> <p>P. I. = Sta. 1723+07.01</p> <p>Δ = 33°27'07"</p> <p>D = 4°00'</p> <p>T = 430.45'</p> <p>L = 836.30'</p> <p>R = 1,432.39'</p>
--	--

HORIZONTAL CURVE DATA

Notes:
 For General Plan and Elevation Units 1 thru 11, see Sheet 1.
 For Layout of Ramp S-W, see Sheets 3 and 4.
 For Estimated Quantities, see Sheet 4.
 For Boring Logs, see Sheets 36 thru 38.
 For General Notes, see Sheet 4.

BY	DATE				
MADE	J.V.	4-8-69			
CHECKED	K.C.P.	5-28-69			
IN CHARGE			NO.	REVISION	BY DATE

AS BUILT

RICHMOND METROPOLITAN AUTHORITY
RICHMOND EXPRESSWAY SYSTEM
DOWNTOWN EXPRESSWAY

BRIDGE NO. 65
RAMP S-W CONNECTION FROM
RICHMOND-PETERSBURG TURNPIKE
GENERAL PLAN AND ELEVATION


HOWARD, NEEDLES, TAMMEN & BERGENDOFF
 consulting engineers
 NEW YORK ALEXANDRIA KANSAS CITY

SCALE: 1"=30'-0"


CONTRACT NO. 11

SHEET NO. 2 OF 38


RICHMOND EXPRESSWAY SYSTEM			
SECTION	PROJECT	SHEET NO.	TOTAL SHEETS
11	DOWNTOWN EXPRESSWAY	30	97

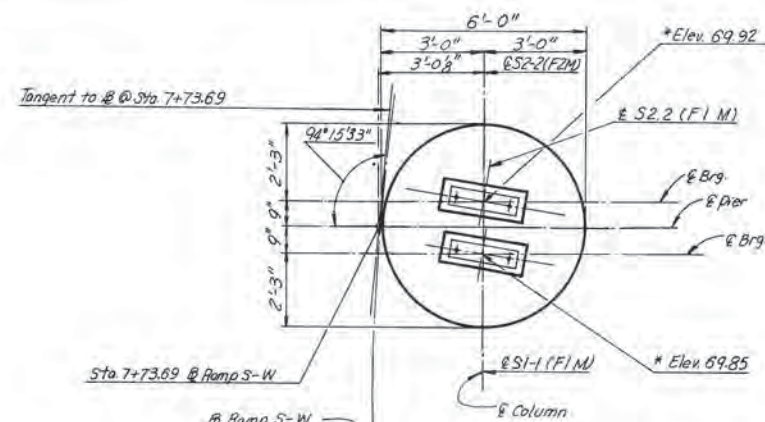


VIEW A-A
Scale: 3/8" = 1'-0"
* Denotes top elevations of pad.

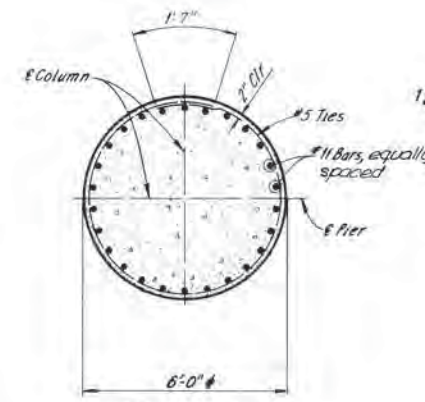


SECTION C-C
Scale: 3/8" = 1'-0"

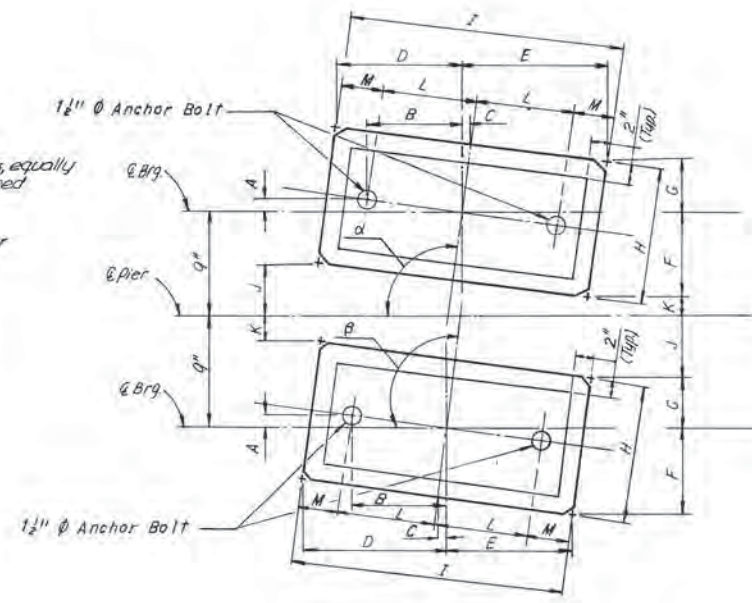


PAD AND ANCHOR BOLT SETTING PLAN
No Scale

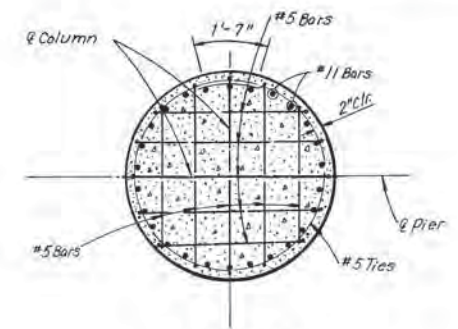


SECTION D-D
Scale: 3/8" = 1'-0"

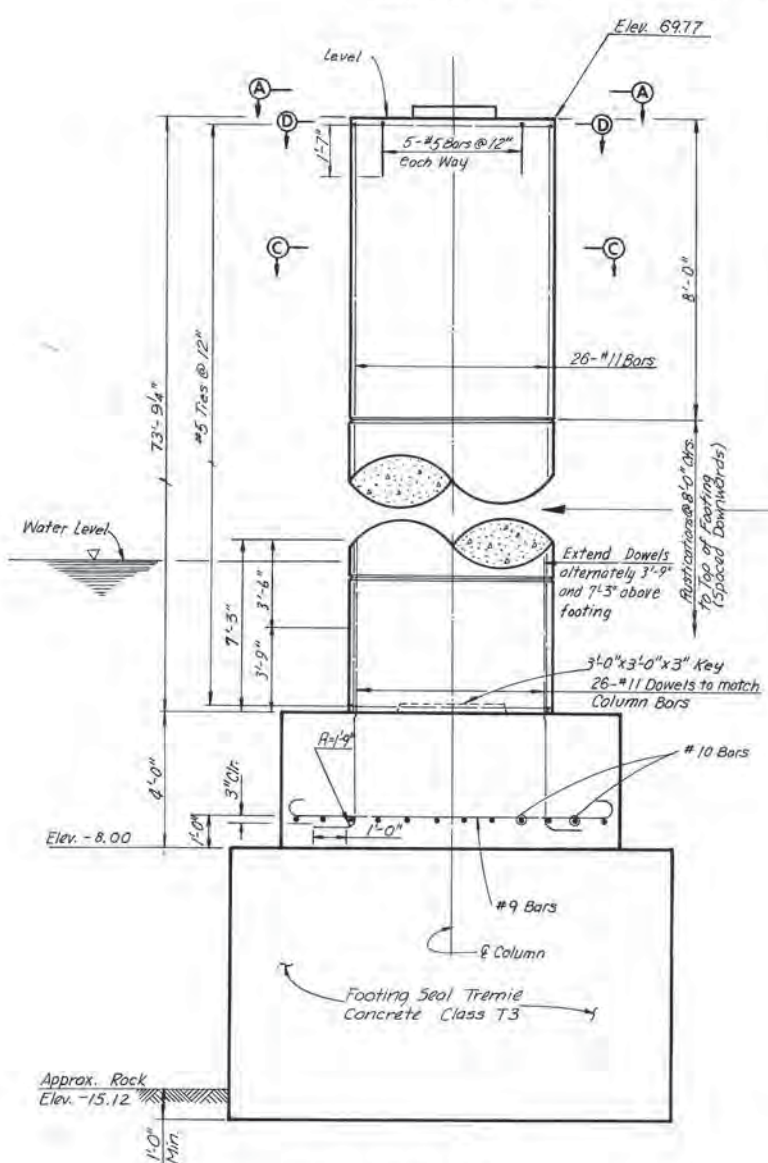

ELEVATION PLAN
Scale: 3/8" = 1'-0"

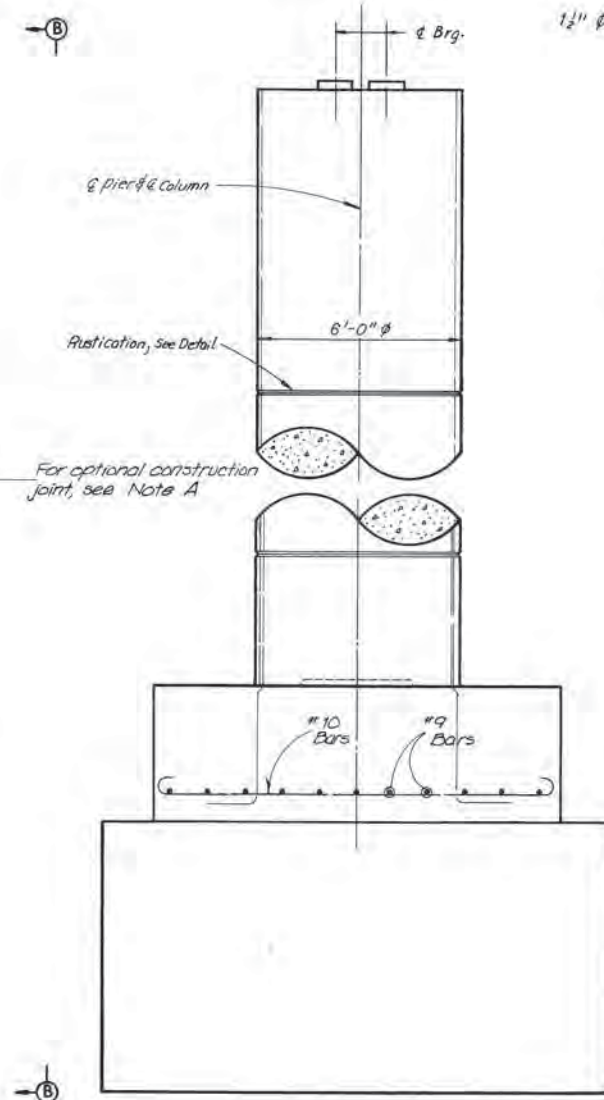


VIEW B-B
Scale: 3/8" = 1'-0"

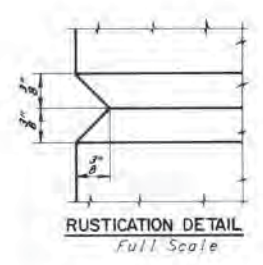

RUSTICATION DETAIL
Full Scale

DIMENSIONS FOR PAD ANCHOR BOLT SETTING PLAN															
Stringer	α	β	A	B	C	D	E	F	G	H	I	J	K	L	M
S1-1	—	92° 00' 58"	5 1/16"	8"	3 1/16"	12 1/16"	12 3/16"	6 3/16"	5 3/16"	11 1/2"	2'-1 1/2"	3 1/16"	2 3/16"	8"	4 1/2"
S2-2	94° 41' 20"	—	5 1/16"	8"	1 1/2"	12"	12 3/16"	6 3/16"	4 1/16"	11 1/2"	2'-1 1/2"	4 5/16"	2 1/2"	8"	4 1/2"

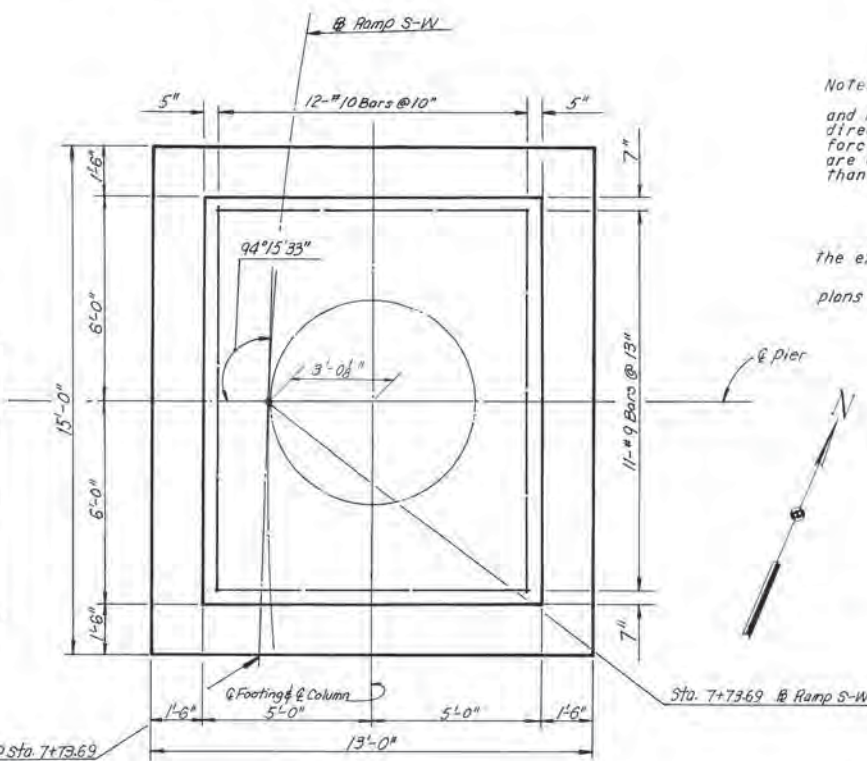

FOOTING PLAN
Scale: 3/8" = 1'-0"

Notes:
Footing elevations are approximate only and may be varied to suit field conditions as directed by the Engineer. Vertical shaft reinforcing shall not be cut until these elevations are established. Where elevations change more than 2 ft., redesign will be required.
For Standard Shoe Details, see Sheet S1 & S2.
For Framing Plan, see Framing Plan Sheets 10.
For Quantities of Steel and Concrete, see Sheet 4.
Overexcavation will not be permitted between the existing pier and new pier.
Pier 1 is to match existing Pier 43. Station shown on plans shall be verified by the Contractor in the field.

NOTE A
A construction joint will be permitted at a rustication near mid-height of the column. The column reinforcement may be lap spliced near the construction joint. The lap at the splice shall be a minimum of 3'-6". Splices shall be staggered at least 3'-3" between adjacent bars.

BY	DATE	NO.	REVISION	BY	DATE
MADE	G.N. 2-10-89		Pad Elev Shoe type & Anchor Bolt set. Dim.	T.E.M.	9-76
CHECKED	J.L.K. 6-25-75		Pad Elev, Str. no. & column height	T.E.M.	9-5-75
IN CHARGE	K.L.F. 2-18-89				

AS BUILT





RICHMOND METROPOLITAN AUTHORITY
RICHMOND EXPRESSWAY SYSTEM
DOWNTOWN EXPRESSWAY

BRIDGE NO. 65
RAMP S-W CONNECTION FROM
RICHMOND-PETERSBURG TURNPIKE
PIER 1






HOWARD, NEEDLES, TAMMEN & BERGENDOFF
consulting engineers
NEW YORK ALEXANDRIA KANSAS CITY

SCALE: *As Noted*
CONTRACT NO. 11
SHEET NO. 5 OF 38

RICHMOND EXPRESSWAY SYSTEM			
SECTION	PROJECT	SHEET NO.	TOTAL SHEETS
11	DOWNTOWN EXPRESSWAY	31	97

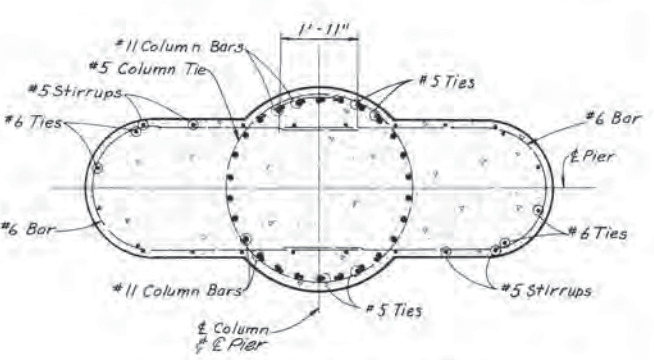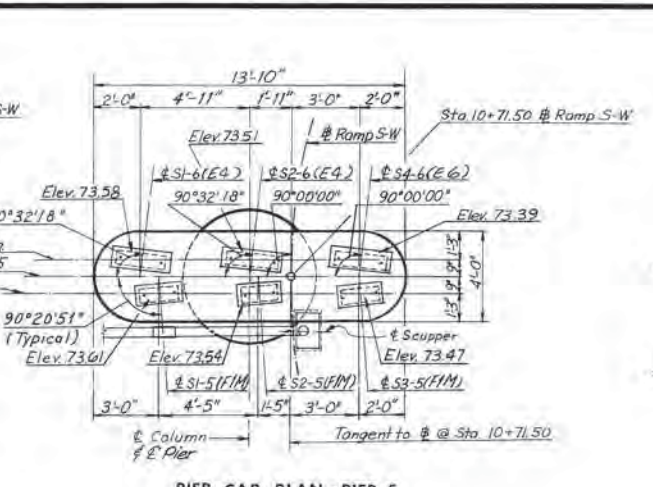
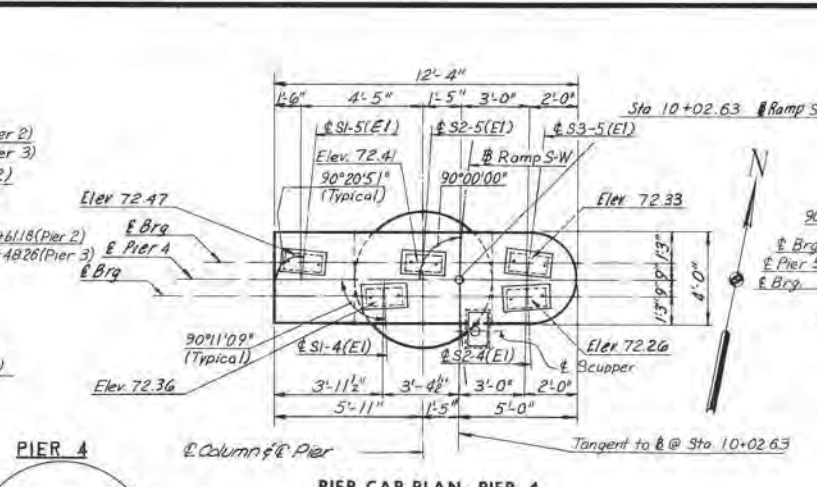
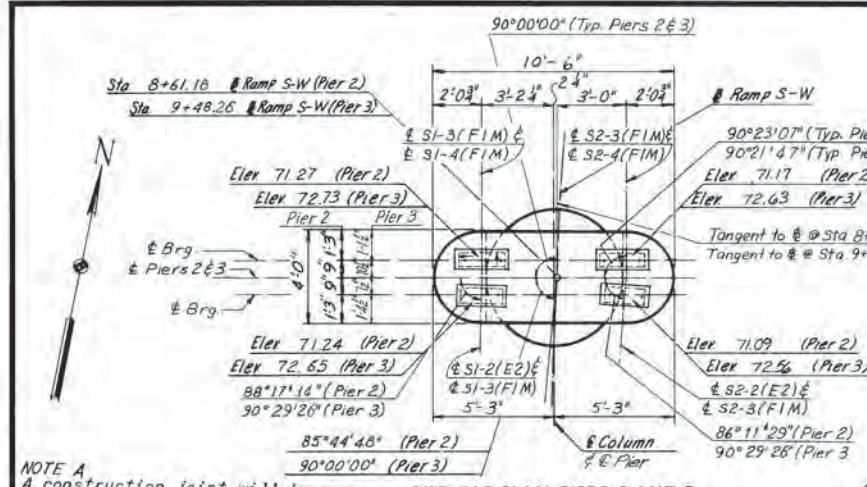


NOTE A
A construction joint will be permitted at a rustication near mid-height of the column. The column reinforcement may be lap spliced near the construction joint. The lap at the splice shall be a minimum of 3'-6". Splices shall be staggered at least 3'-3" between adjacent bars.

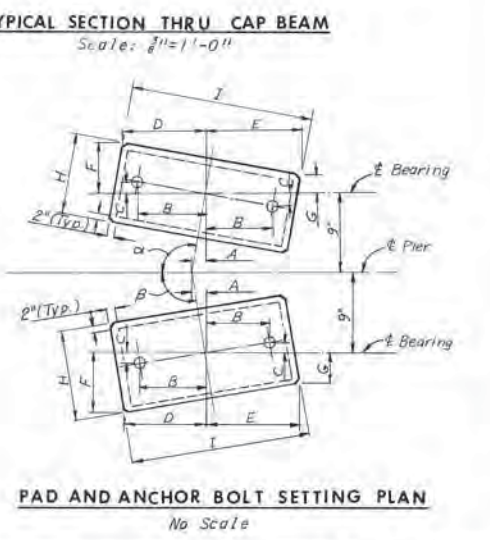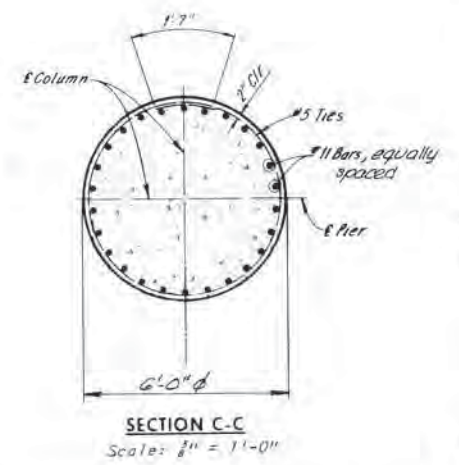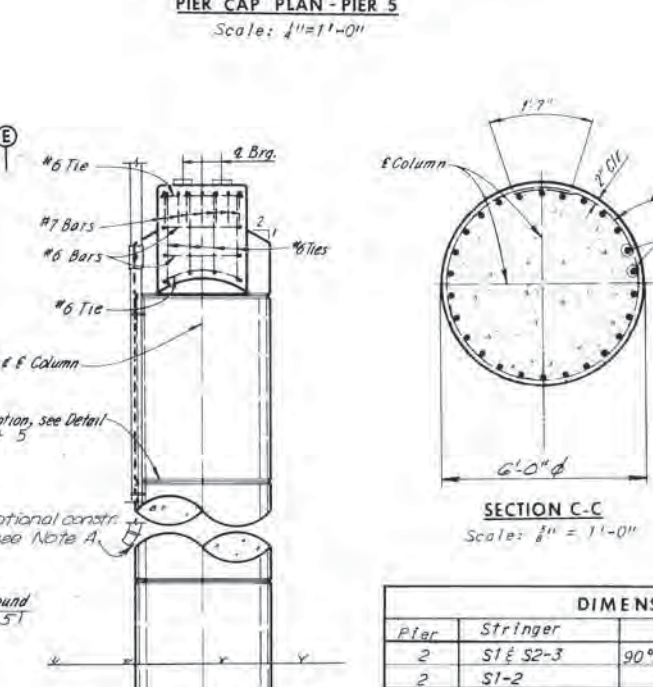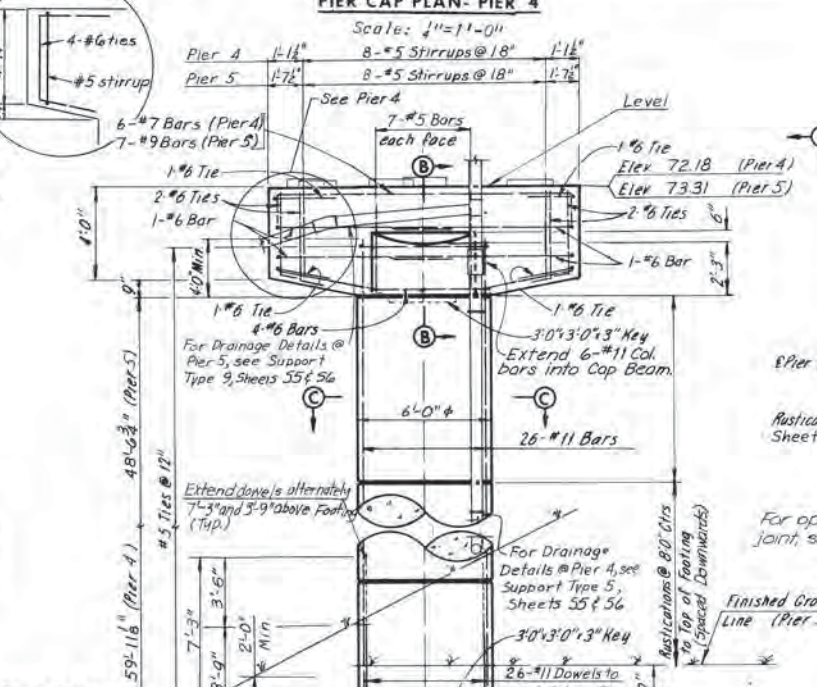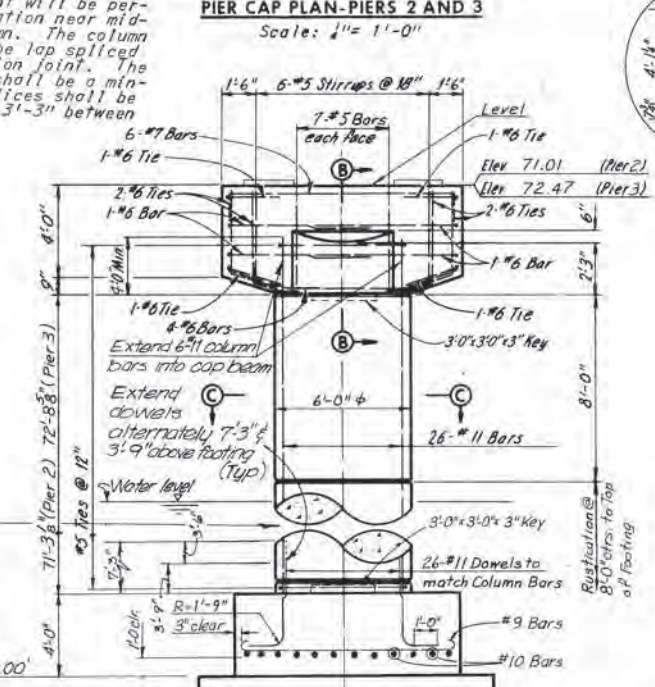

Pier	Stringer	α	B	A	B	C	D	E	F	G	H	I
2	S1 & S2-3	90°29'20"	-	8"	8"	12 1/2"	12 1/2"	5 1/2"	5 1/2"	1 1/2"	2'-1 1/2"	2'-1 1/2"
2	S1-2	-	88°17'14"	4"	8 1/2"	4"	12 1/2"	11 1/2"	6 1/2"	7 1/2"	1'-1"	2'-0 1/2"
2	S2-2	-	86°11'29"	3"	8 1/2"	3"	12 3/4"	11 1/2"	5 1/2"	7 1/2"	1'-1"	2'-0 1/2"
3	S1 & S2-4	90°21'47"	-	8"	8"	12 3/4"	12 3/4"	5 1/2"	5 1/2"	1 1/2"	2'-1 1/2"	2'-1 1/2"
3	S1 & S2-3	-	90°29'26"	4"	8"	4"	12 1/2"	12 1/2"	5 1/2"	5 1/2"	1 1/2"	2'-1 1/2"
4	S1, S2 & S3-5	90°20'51"	-	16"	8 1/2"	16"	12 1/2"	12 1/2"	6 1/2"	5 1/2"	1'-0 1/2"	2'-0 1/2"
4	S1 & S2-4	-	90°11'09"	4"	8 1/2"	4"	12 1/2"	12 1/2"	6 1/2"	5 1/2"	1'-0 1/2"	2'-0 1/2"
5	S1 & S2-6	90°32'18"	-	16"	10 1/2"	16"	14 1/2"	14 1/2"	6 1/2"	6 1/2"	1'-0 1/2"	2'-5"
5	S4-6	90°00'00"	-	0"	11 1/2"	0"	15 1/2"	15 1/2"	6 1/2"	6 1/2"	1'-0 1/2"	2'-6 1/2"
5	S1, S2 & S3-5	-	90°20'51"	16"	8"	16"	12 1/2"	12 1/2"	5 1/2"	5 1/2"	1 1/2"	2'-1"

Notes:
Overexcavation will not be permitted between existing piers and new piers.
Piers 2, 3 and 4 are to match existing Piers 45, 47 and 49 respectively. Stations shown on the plans shall be verified by the Contractor in the field.
All piles shall be 10BP42 Steel Piles (Design Capacity = 45 tons).
For Forming Plans, see Sheets 18 & 19.
Estimated pile tip elevation = 20.0'.
Pier 4 and -22.0' Pier 5.
Batter piles 3" per foot where shown.
For Rustication Detail, see Sheet 10.
For Pile Detail, see Sheet 9.
For Quantities of Steel and Concrete, see Sheet 4.

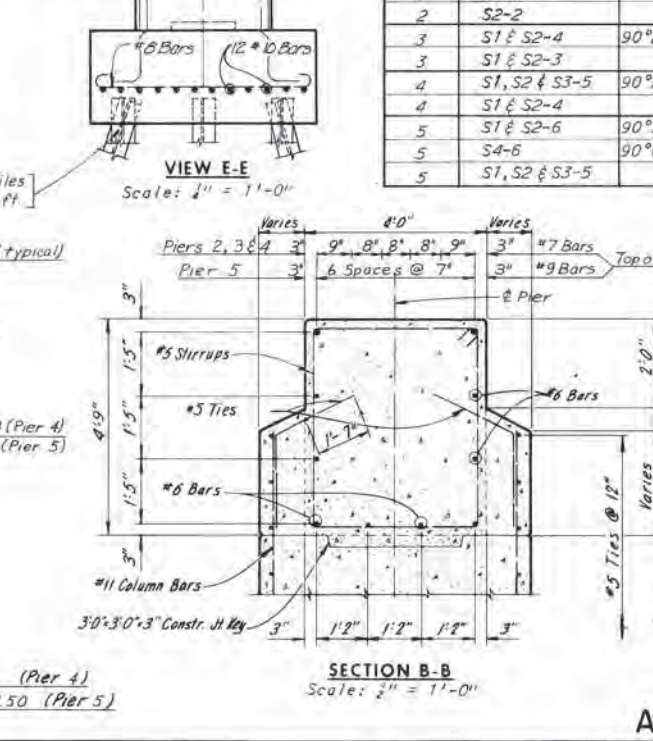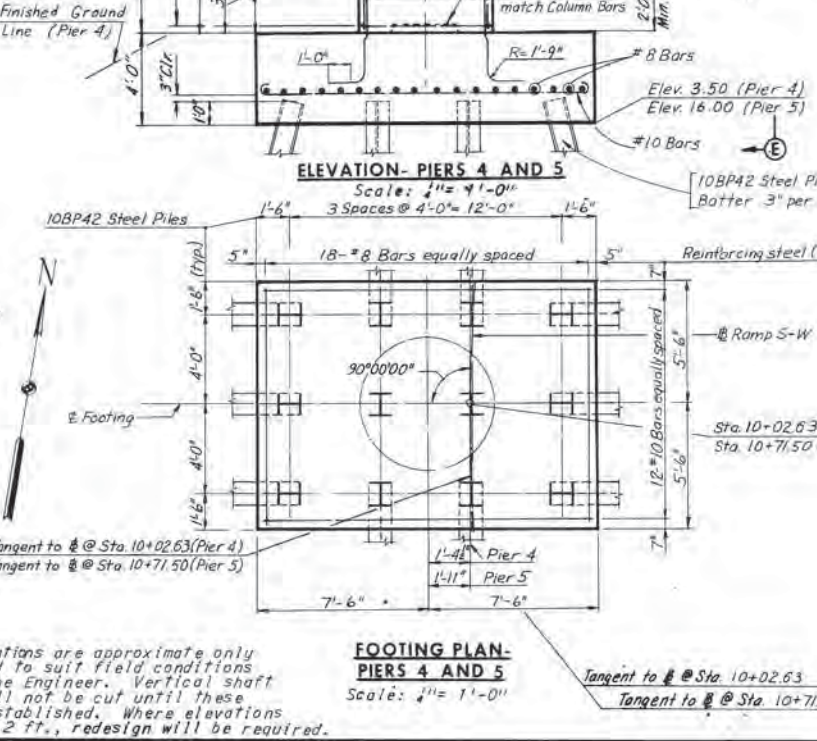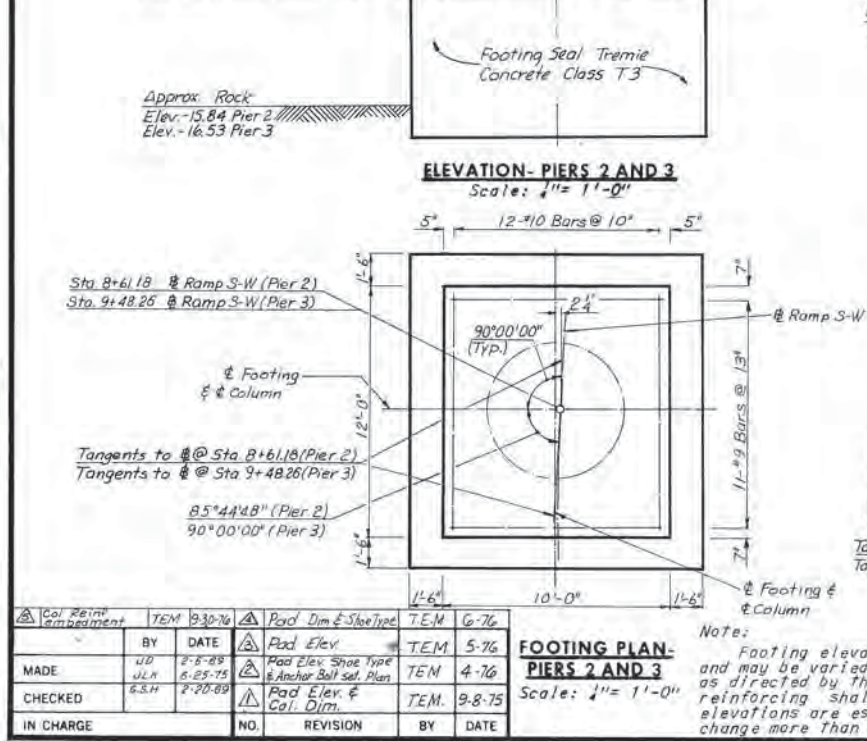

Col. Reinf. Placement	TEM	9-30-76	Pad Dim. & Steel Type	TEM	6-76
BY	DATE	Pad Elev.	Pad Elev. Shoe Type	TEM	5-76
MADE	U.D.	6-25-75	& Anchor Bolt Set Plan	TEM	4-76
CHECKED	G.S.H.	2-20-89	Pad Elev. & Col. Dim.	TEM	9-8-75
IN CHARGE	NO.	REVISION	BY	DATE	

FOOTING PLAN-PIERS 2 AND 3
Scale: 1/4" = 1'-0"
Note: Footing elevations are approximate only and may be varied to suit field conditions as directed by the Engineer. Vertical shaft reinforcing shall not be cut until these elevations are established. Where elevations change more than 2 ft., redesign will be required.

FOOTING PLAN-PIERS 4 AND 5
Scale: 1/4" = 1'-0"
Note: Footing elevations are approximate only and may be varied to suit field conditions as directed by the Engineer. Vertical shaft reinforcing shall not be cut until these elevations are established. Where elevations change more than 2 ft., redesign will be required.

RICHMOND METROPOLITAN AUTHORITY
RICHMOND EXPRESSWAY SYSTEM
DOWNTOWN EXPRESSWAY









BRIDGE NO. 65
RAMP S-W CONNECTION FROM
RICHMOND-PETERSBURG TURNPIKE
PIERS 2, 3, 4 AND 5

HOWARD, NEEDLES, TAMMEN & BERGENDOFF
CONSULTING ENGINEERS
NEW YORK ALEXANDRIA KANSAS CITY

SCALE: As Noted
CONTRACT NO. 11
SHEET NO. 6 OF 38

AS BUILT

RICHMOND EXPRESSWAY SYSTEM			
SECTION	PROJECT	SHEET NO.	TOTAL SHEETS
11	DOWNTOWN EXPRESSWAY	32	97

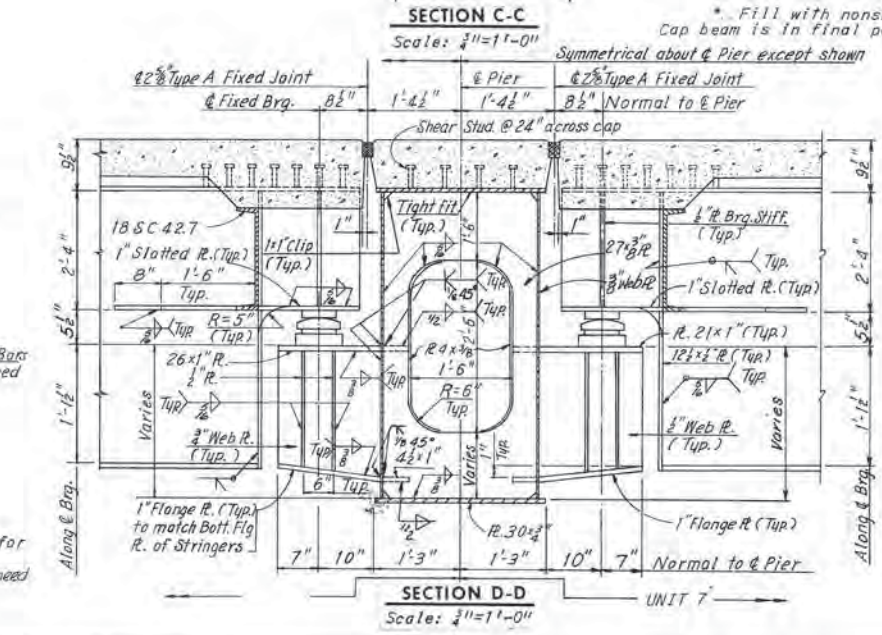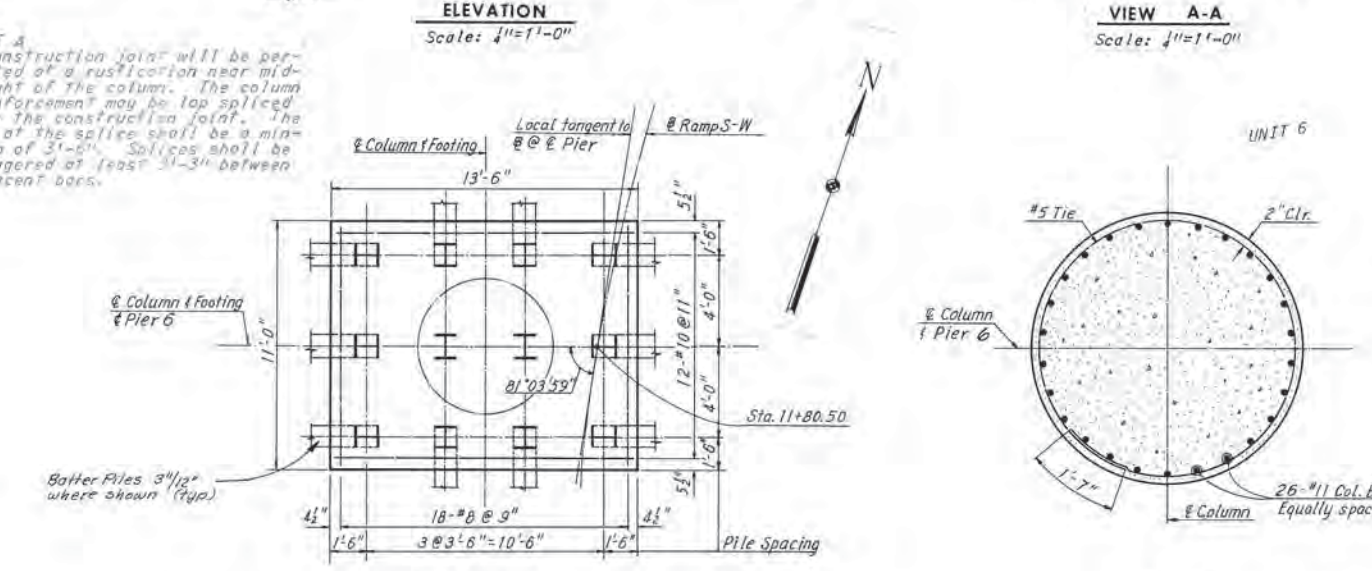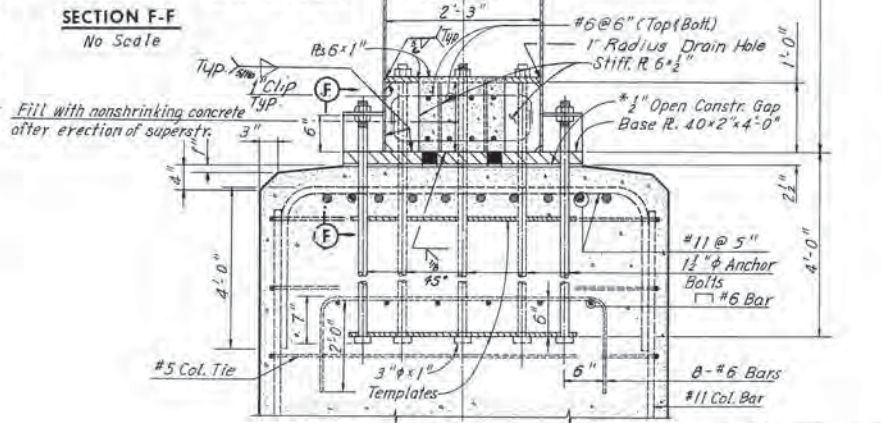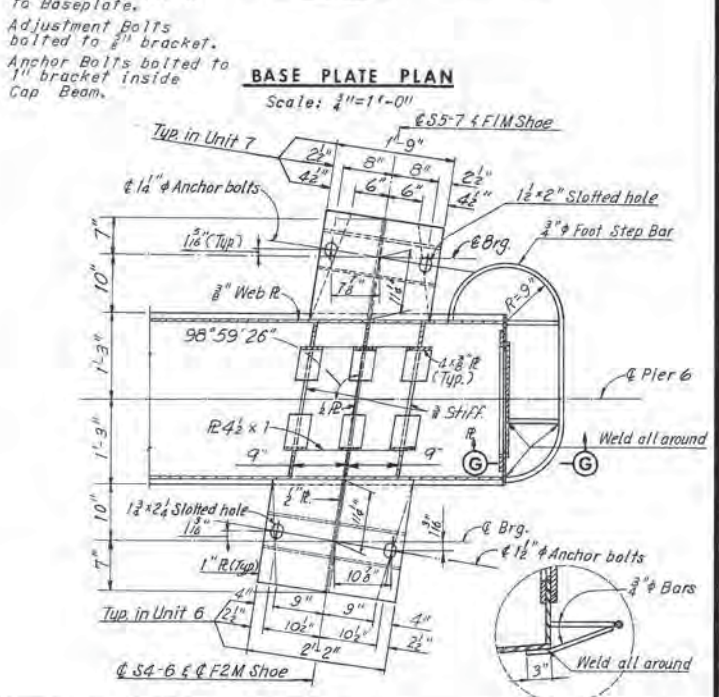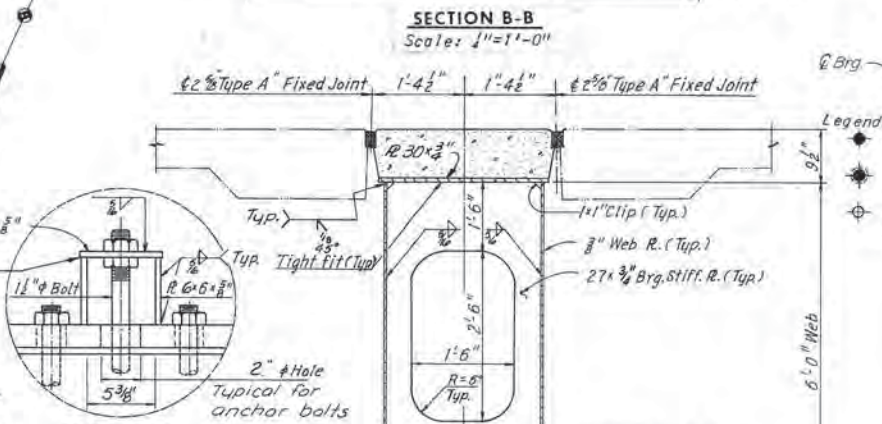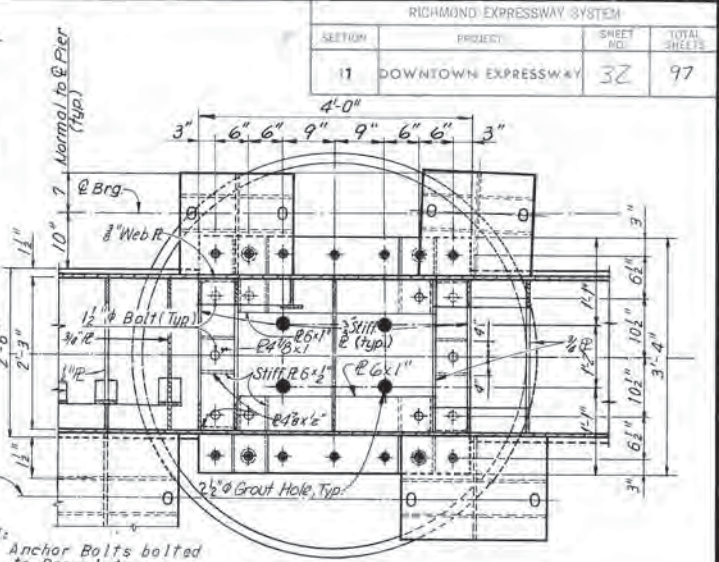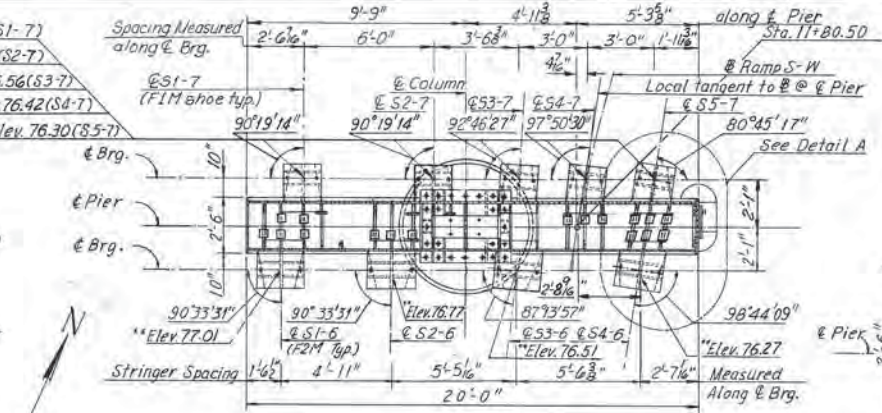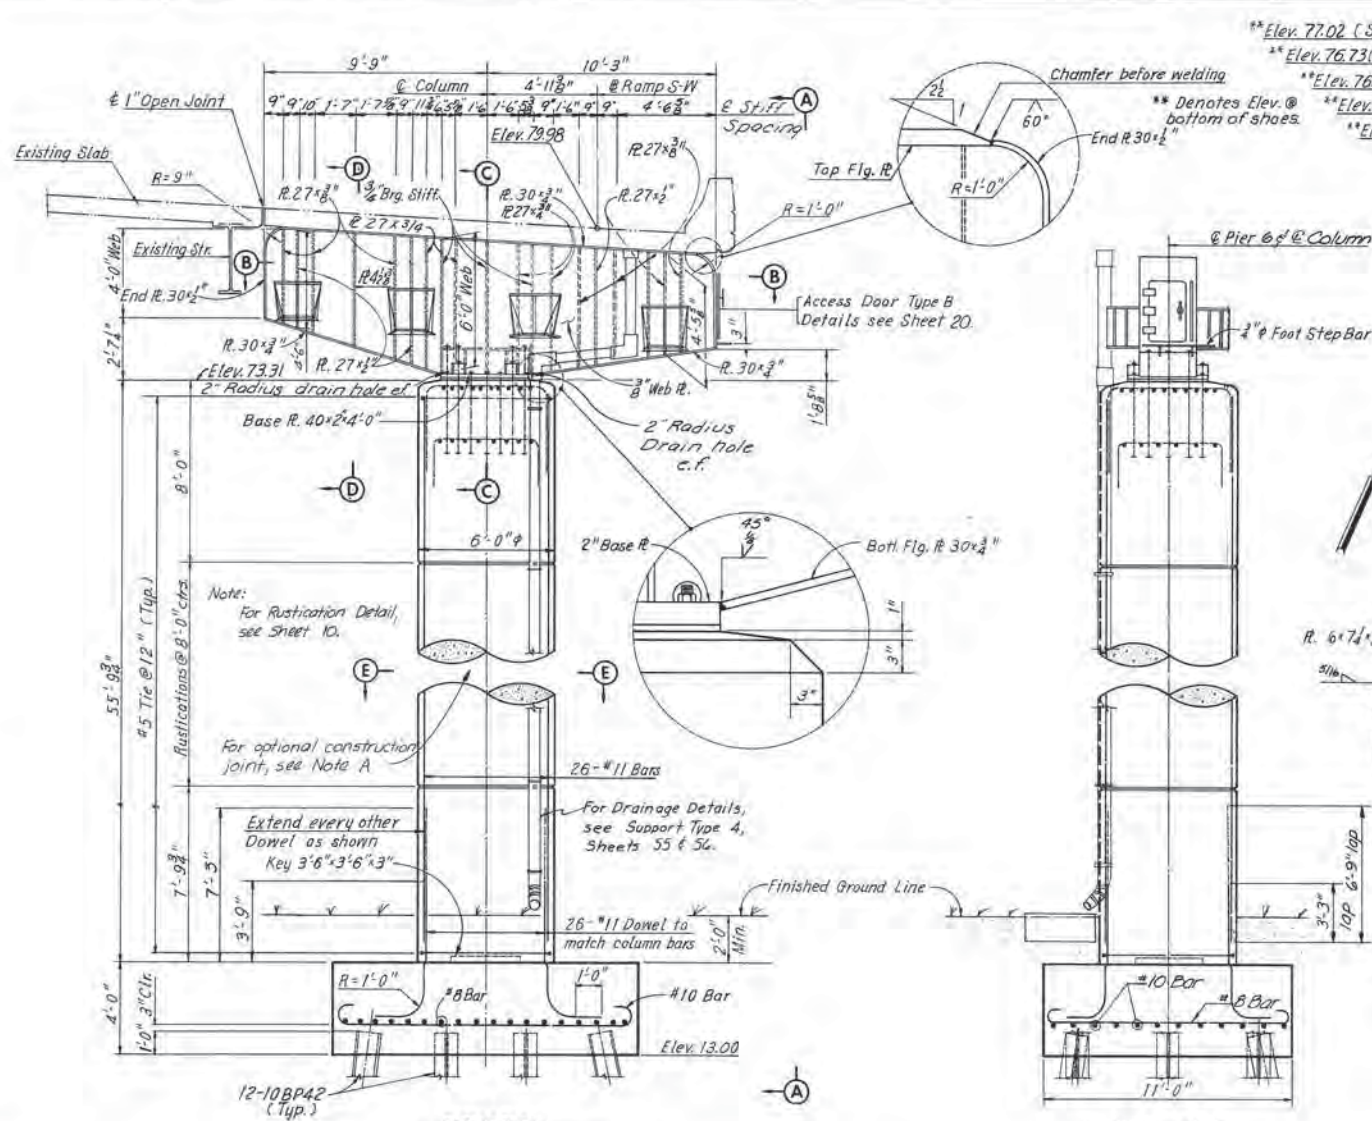

AS BUILT

RICHMOND METROPOLITAN AUTHORITY
RICHMOND EXPRESSWAY SYSTEM
DOWNTOWN EXPRESSWAY

BRIDGE NO. 65
RAMP S-W CONNECTION FROM
RICHMOND-PETERSBURG TURNPIKE

PIER 6

REVISIONS:

NO.	REVISION	BY	DATE
1	Shoe Plate Dim. in Detail A	T.E.M.	8-76
2	Pier Cap Dim.	T.E.M.	3-76
3	Pier Elev. & Col. Dim.	T.E.M.	9-8-75

DATE: 2-19-77
BY: J.L.R.
CHECKED: S.C.C.
IN CHARGE: H.C.


REVISIONS:

NO.	REVISION	BY	DATE
1	As Noted		


CONTRACT NO. 11
SHEET NO. 7 OF 38

NO.	REVISION	BY	DATE
1	As Noted		


RICHMOND EXPRESSWAY SYSTEM			
SECTION	PROJECT	SHEET NO.	TOTAL SHEETS
11	DOWNTOWN EXPRESSWAY	33	97

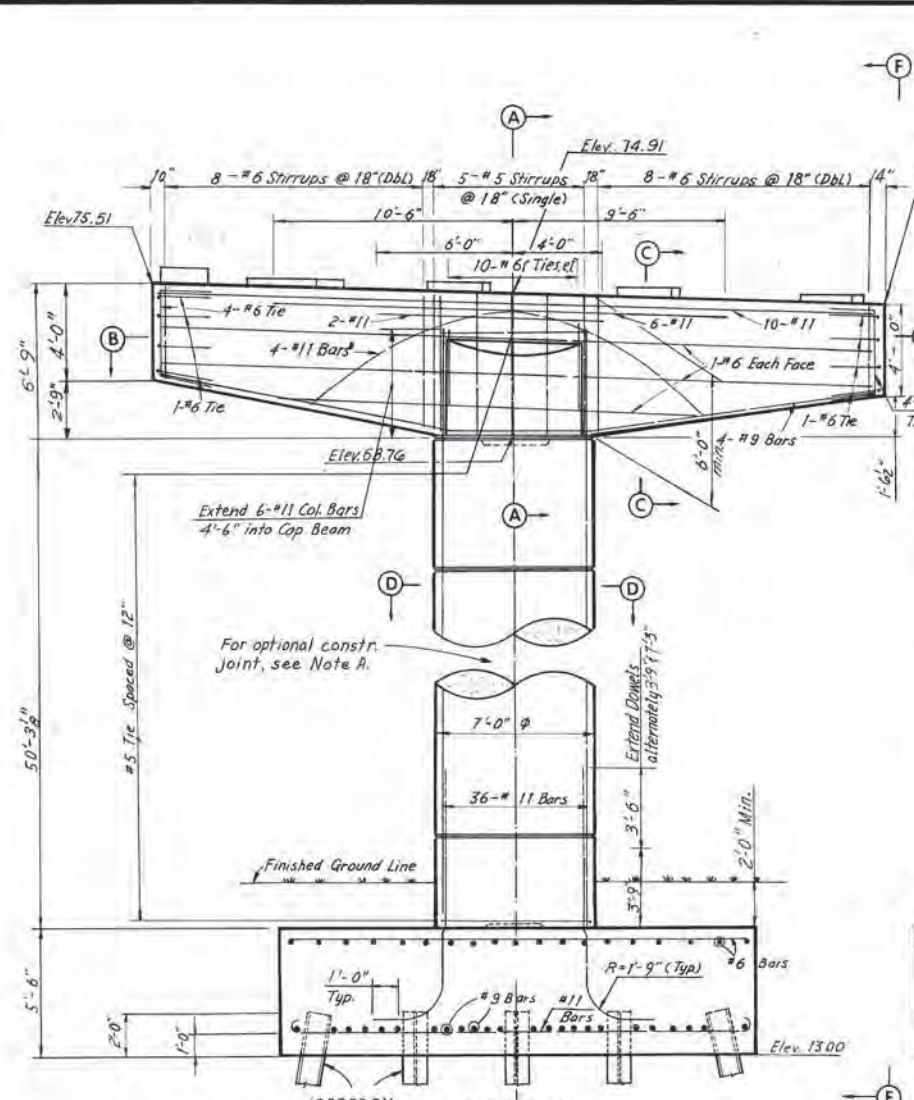


ELEVATION
Scale: 1/4"=1'-0"

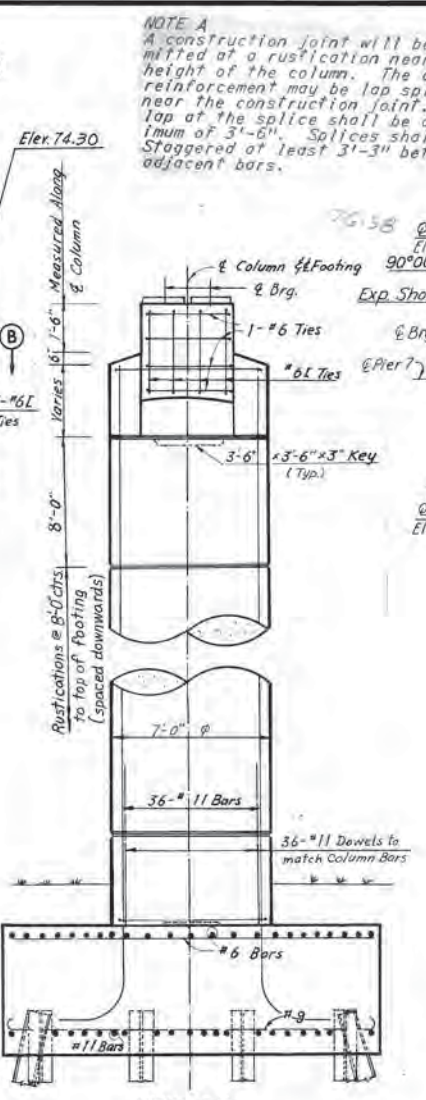


VIEW F-F
Scale: 1/4"=1'-0"

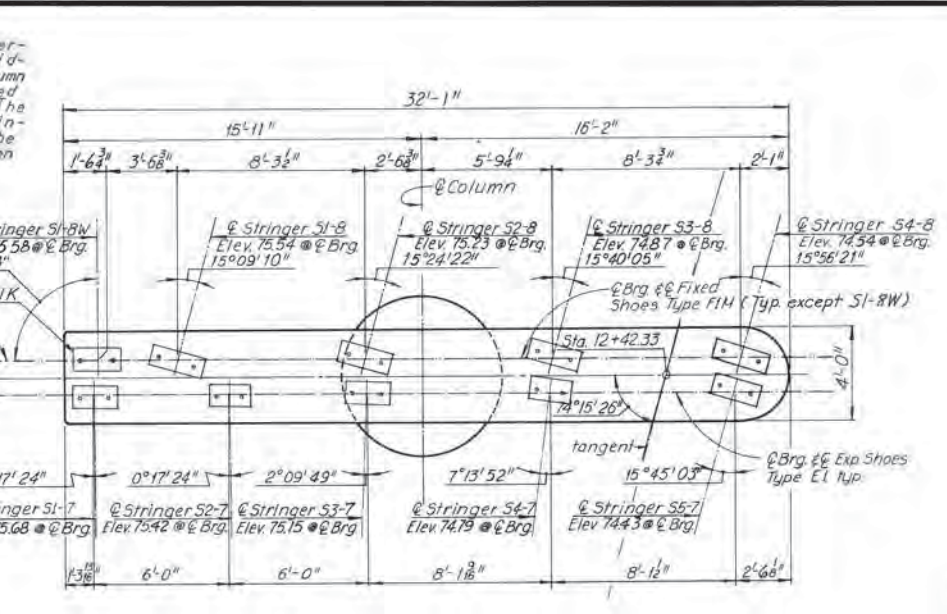

PIER CAP PLAN
Scale: 1/4"=1'-0"

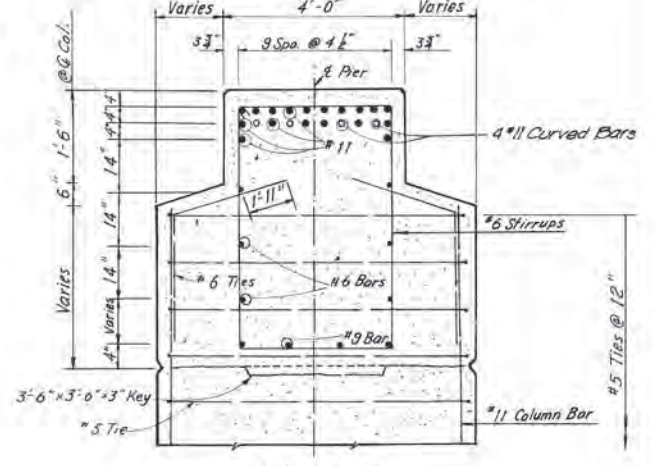


SECTION A-A
Scale: 1/2"=1'-0"

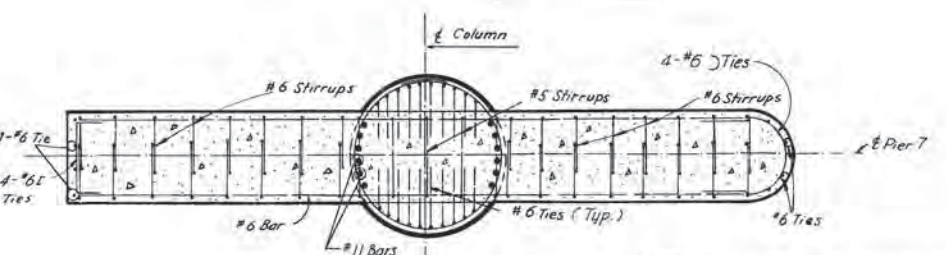

SECTION B-B
Scale: 1/2"=1'-0"


Note: Pier 7 is to match existing Pier 55. Station shown shall be verified by the Contractor in the field.

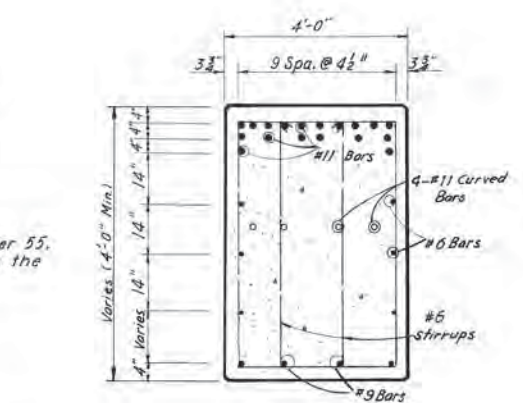


SECTION C-C
Scale: 1/2"=1'-0"

Note: Footing elevations are approximate only and may be varied to suit field conditions as directed by the Engineer. Vertical shaft reinforcing shall not be cut until these elevations are established. Where elevations change more than 2 ft., redesign will be required.

Note: All piles shall be 12BP53 steel piles (Design Capacity = 57 tons). Batter all piles 3" per foot where shown. For Standard Shoe Details, see Sheet S1 & S2. For Framing Plan, see Sheet 19 & 20. Estimated Pile Tip Elevation is 20.0. For Rustication Details, see Sheet 10. For 12BP53 Steel Pile Details, see Sheet 9.

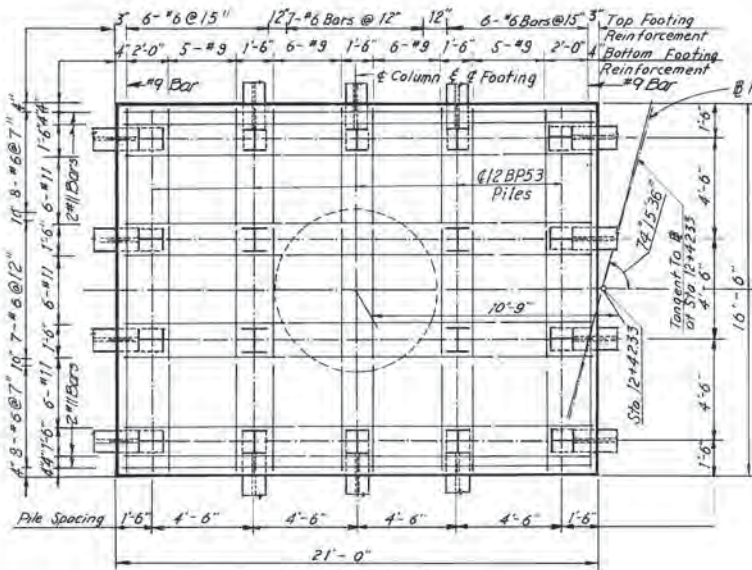


FOOTING PLAN
Scale: 1/4"=1'-0"

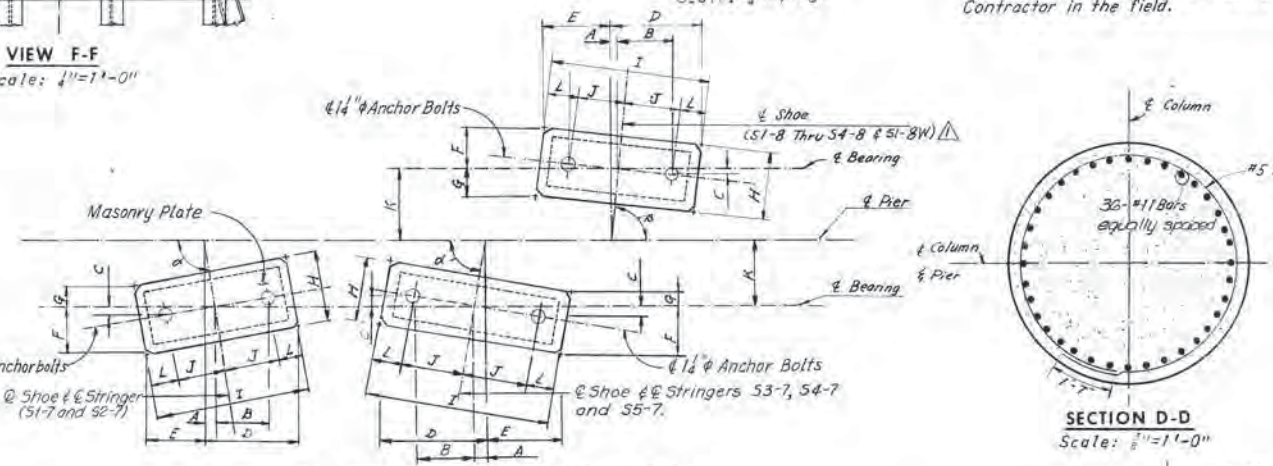

PAD AND ANCHOR BOLT SETTING PLAN
No Scale

Stringer	DIMENSIONS OF ANCHOR BOLT SETTING PLAN													
	a	b	A	B	C	D	E	F	G	H	I	J	K	L
S1-7	90°17'24"	--	1 1/2"	8 1/2"	1 1/2"	1'-0 3/8"	1'-0 3/8"	6 1/2"	5 3/8"	1'-0"	2'-0 1/2"	8 1/2"	9"	4"
S2-7	90°17'24"	--	1 1/2"	8 1/2"	1 1/2"	1'-0 3/8"	1'-0 3/8"	6 1/2"	5 3/8"	1'-0"	2'-0 1/2"	8 1/2"	9"	4"
S3-7	87°50'11"	--	1 1/2"	8 1/2"	1 1/2"	1'-0 3/8"	1'-0 3/8"	6 1/2"	5 3/8"	1'-0"	2'-0 1/2"	8 1/2"	9"	4"
S4-7	82°46'08"	--	1 1/2"	8 1/2"	1 1/2"	1'-2 1/8"	1'-2 1/8"	10 1/2"	7 1/2"	4 1/8"	1'-0"	2'-0 1/2"	8 1/2"	4"
S5-7	74°14'57"	--	2 3/8"	7 7/8"	2 3/8"	1'-3 7/8"	1'-3 7/8"	9 1/2"	2 3/8"	1'-0"	2'-0 1/2"	8 1/2"	9"	4"
S1-8	--	74°50'50"	2 3/8"	10 1/2"	2 3/8"	1'-6 3/8"	1'-6 3/8"	9 1/2"	1 3/8"	11"	2'-1 5/8"	10 1/2"	9"	4 1/2"
S2-8	--	74°50'50"	2 3/8"	10 1/2"	2 3/8"	1'-6 3/8"	1'-6 3/8"	9 1/2"	1 3/8"	11"	2'-1 5/8"	10 1/2"	9"	4 1/2"
S3-8	--	74°19'55"	2 3/8"	10 1/2"	2 3/8"	1'-6 3/8"	1'-6 3/8"	9 1/2"	1 3/8"	11"	2'-1 5/8"	10 1/2"	9"	4 1/2"
S4-8	--	74°03'39"	2 3/8"	10 1/2"	2 3/8"	1'-6 3/8"	1'-6 3/8"	9 1/2"	1 3/8"	11"	2'-1 5/8"	10 1/2"	9"	4 1/2"
S1-8W	--	89°59'57"	--	8 1/2"	--	1'-0 3/8"	1'-0 3/8"	6"	6"	1'-0"	2'-0 1/2"	8 1/2"	9"	4"

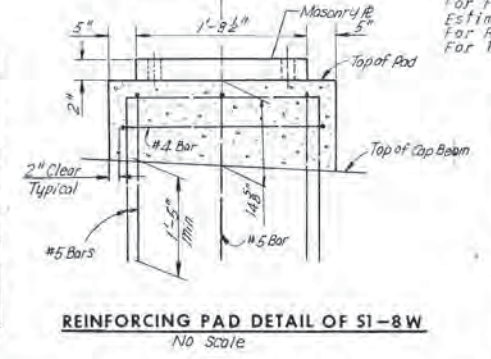

REINFORCING PAD DETAIL OF S1-8W
No Scale

BY	DATE	Cap Dimensions	PRY	10-76
MADE	4-E 2-17-89	Pad Elev. Col. Dim.	TEM	9-8-75
CHECKED	ULF 6-28-75	S1-8W Angle & Pad. Dim.	TEM	9-2-75
IN CHARGE	YCR 5-3-89			
NO.	REVISION	BY	DATE	

AS BUILT



RICHMOND METROPOLITAN AUTHORITY
RICHMOND EXPRESSWAY SYSTEM
DOWNTOWN EXPRESSWAY

BRIDGE NO. 65
RAMP S-W CONNECTION FROM
RICHMOND-PETERSBURG TURNPIKE
PIER 7

HOWARD, NEEDLES, TAMMEN & BERGENDOFF
consulting engineers
NEW YORK ALEXANDRIA KANSAS CITY


SCALE: As Noted
CONTRACT NO. 11
SHEET NO. 8 OF 38

RICHMOND EXPRESSWAY SYSTEM			
SECTION	PROJECT	SHEET NO.	TOTAL SHEETS
11	DOWNTOWN EXPRESSWAY	34	97

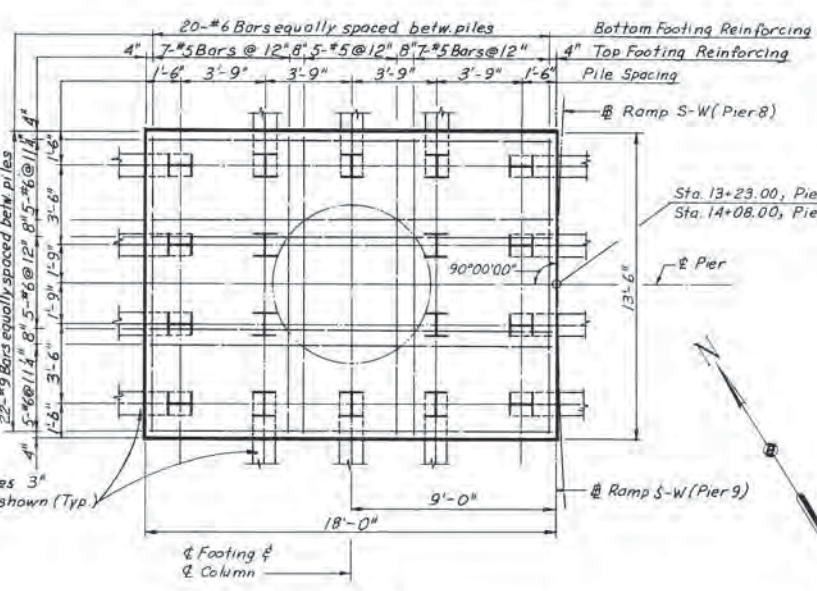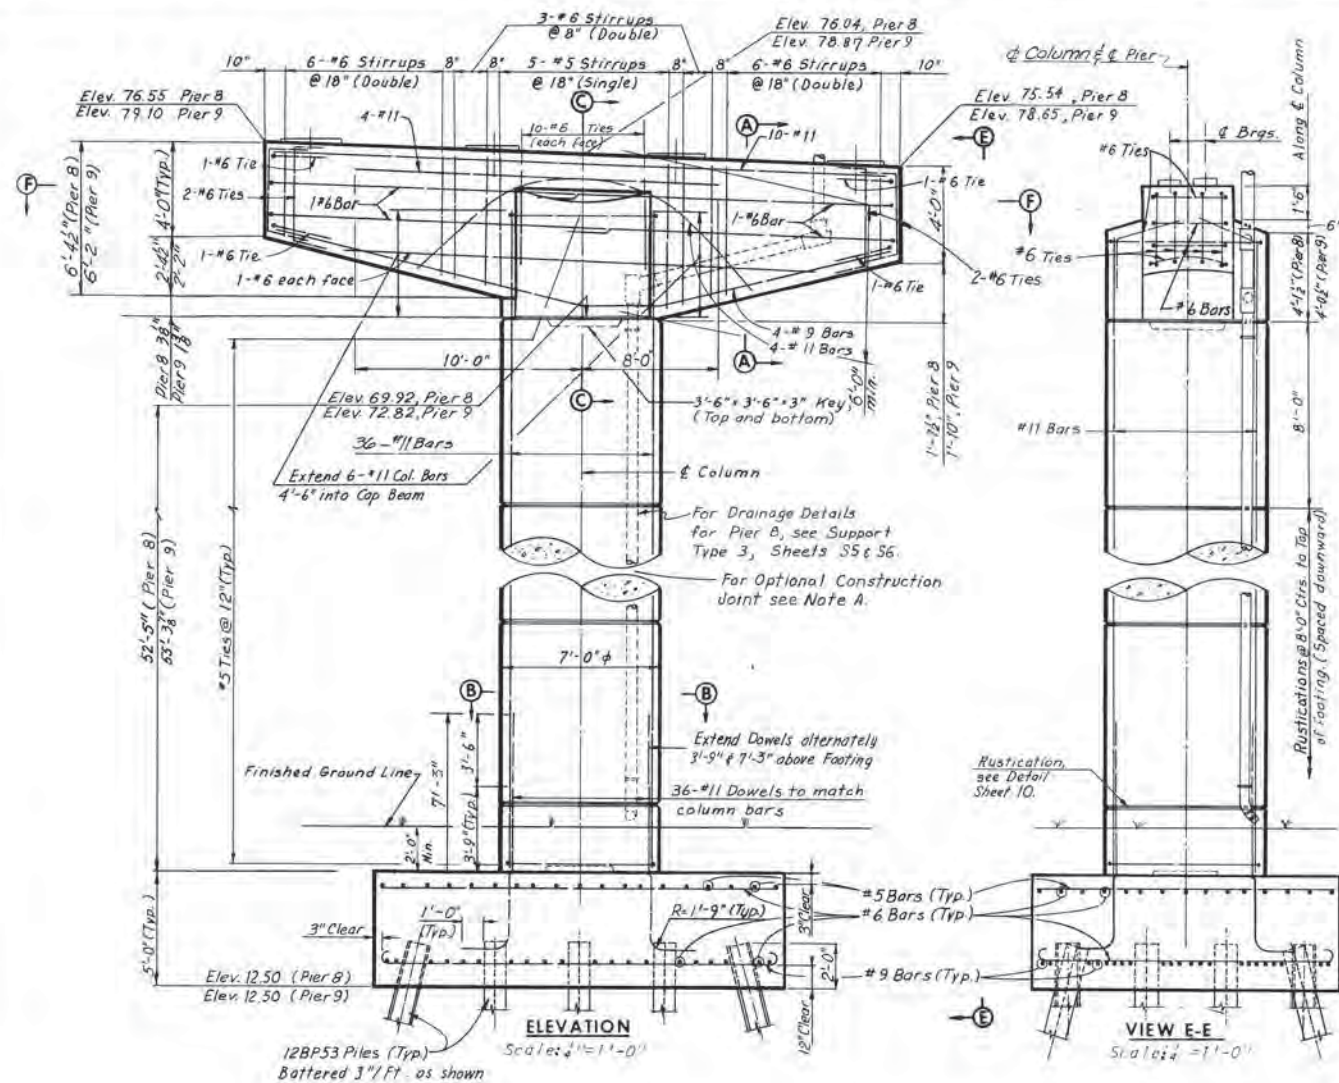


FOOTING PLAN
Scale: 1/4" = 1'-0"

Note: Footing elevations are approximate only and may be varied to suit field conditions as directed by the Engineer. Vertical shaft reinforcement shall not be cut until these elevations are established. Where elevations change more than 2 ft., redesign will be required.

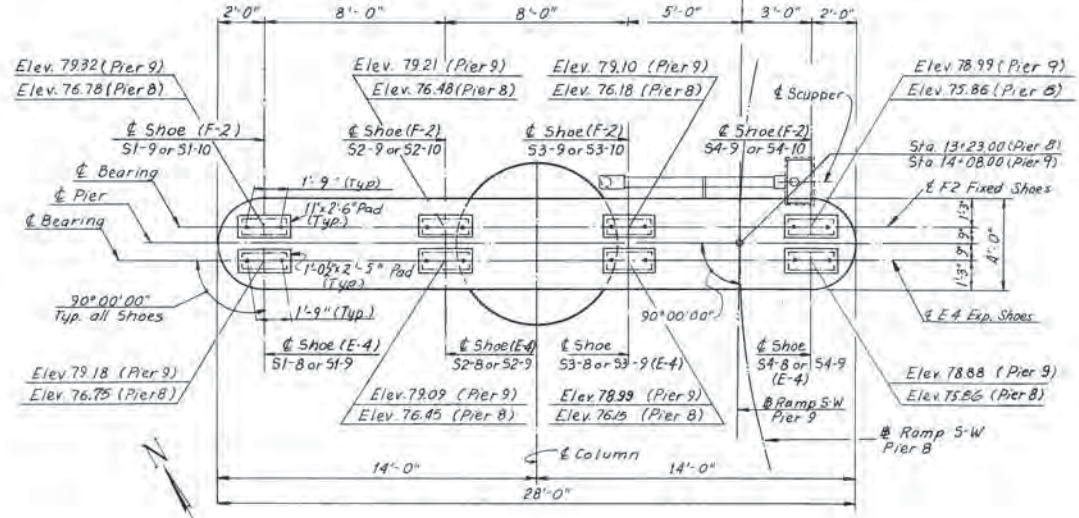


PLAN
Scale: 1/4" = 1'-0"


NOTE A
A construction joint will be permitted at a rustication near mid-height of the column. The column reinforcement may be lap spliced near the construction joint. The lap of the splice shall be a minimum of 3'-6". Splices shall be staggered at least 3'-3" between adjacent bars.

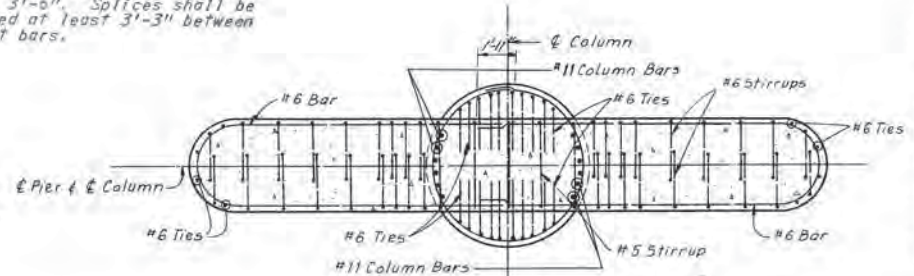


SECTION F-F
Scale: 1/4" = 1'-0"

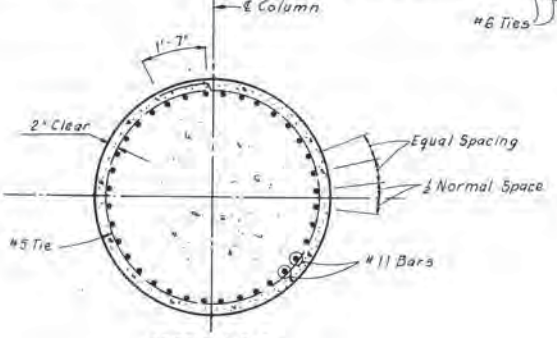


SECTION B-B
Scale: 3/8" = 1'-0"

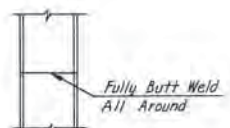

STEEL PILE SPICE DETAIL
No. Scale

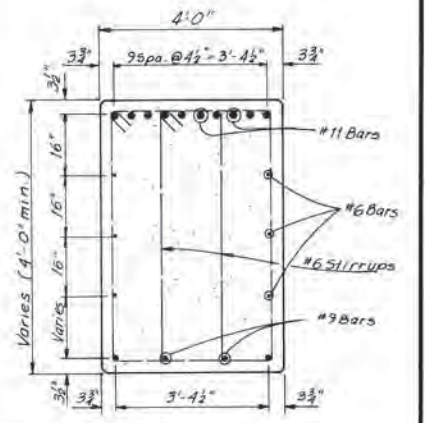

SECTION A-A
Scale: 1/2" = 1'-0"

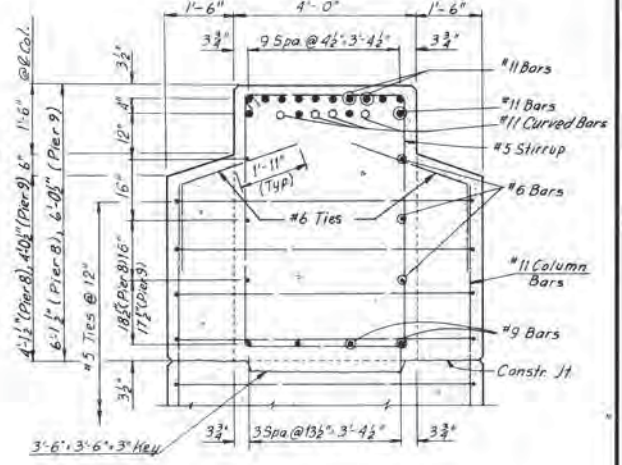

SECTION C-C
Scale: 1/2" = 1'-0"

Notes:
All piles shall be 12BP53 Steel Piles (Design capacity = 57 tons).
Batter piles 3" per ft. as shown.
For Standard Shoe Details see Sheet ST452.
For Framing Plans see Sheet 20.
Estimated Pile Tip elevation -20.0









AS BUILT
RICHMOND METROPOLITAN AUTHORITY
RICHMOND EXPRESSWAY SYSTEM
DOWNTOWN EXPRESSWAY

BRIDGE NO. 65
RAMP S-W CONNECTION FROM
RICHMOND-PETERSBURG TURNPIKE
PIERS 8 AND 9

HOWARD, NEEDLES, TAMMEN & BERGENDOFF
consulting engineers
NEW YORK ALEXANDRIA KANSAS CITY
SCALE: As Noted
CONTRACT NO. 11
SHEET NO. 9 OF 38

IN CHARGE	NO.	REVISION	BY	DATE
MADE	CEB/AD			12-17-68
CHECKED	PTA			11-07-69

RICHMOND EXPRESSWAY SYSTEM			
SECTION	PROJECT	SHEET NO.	TOTAL SHEETS
11	DOWNTOWN EXPRESSWAY	35	97

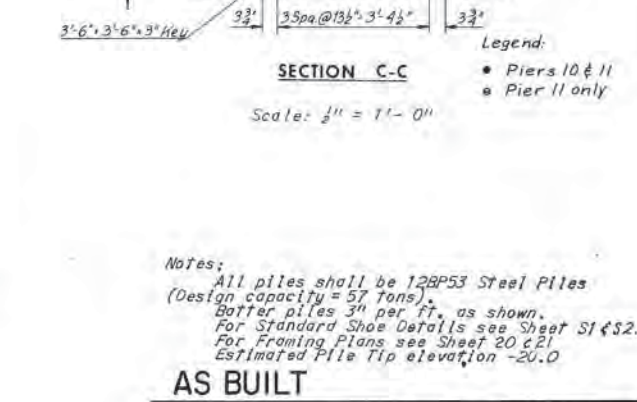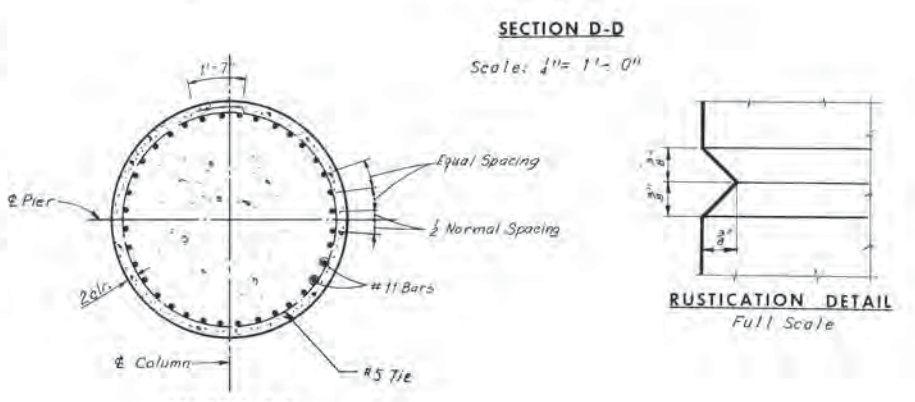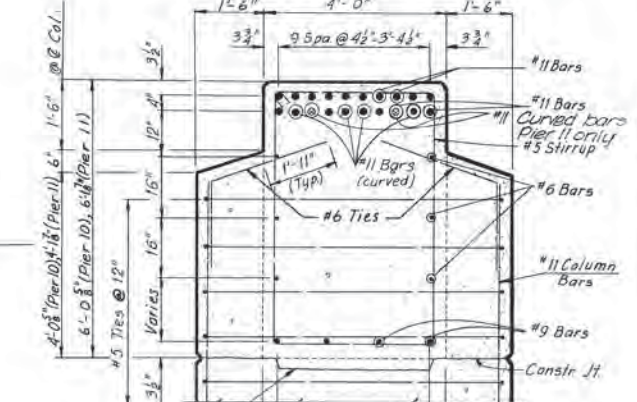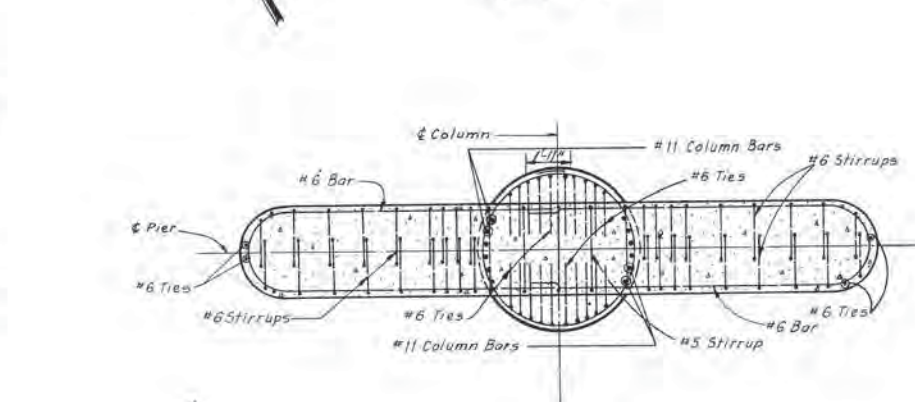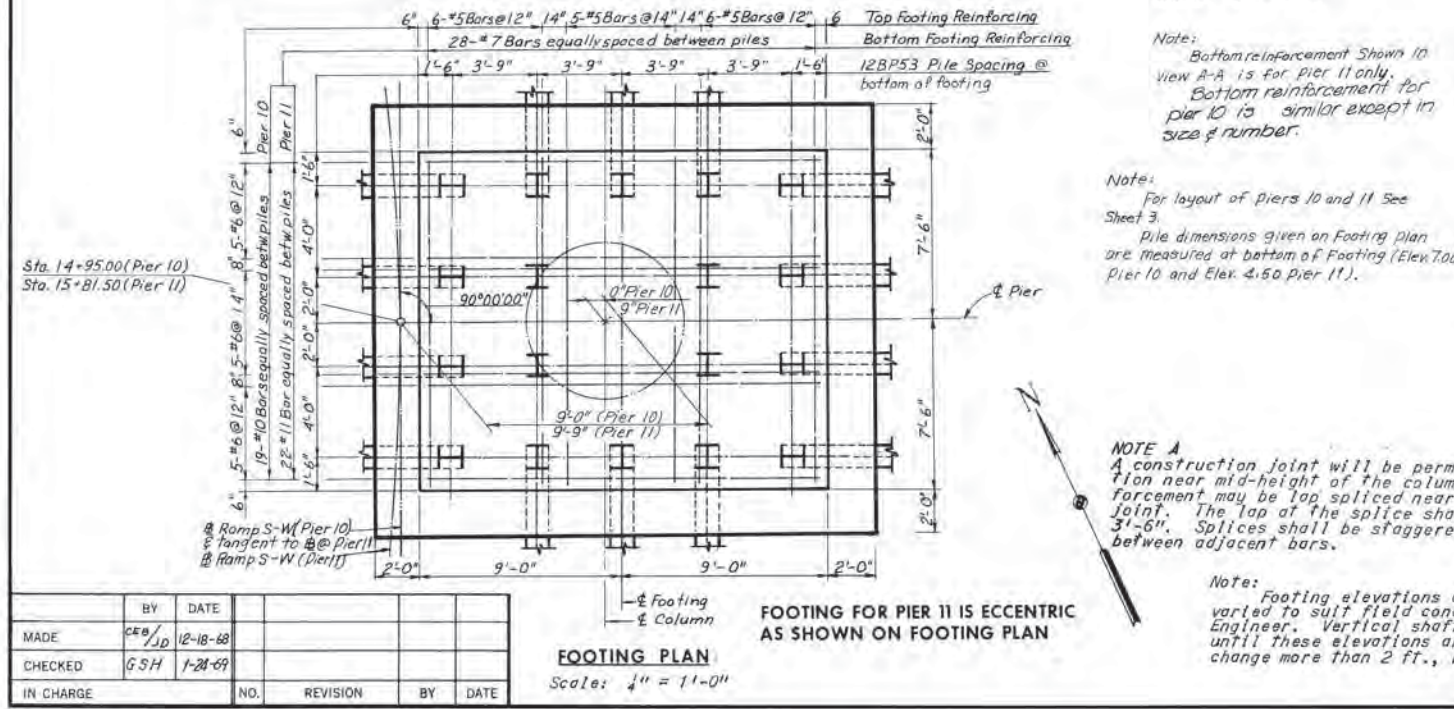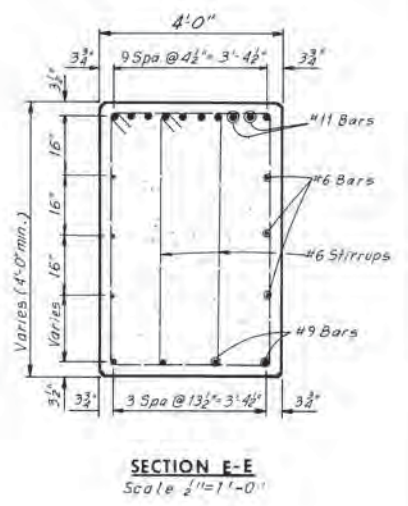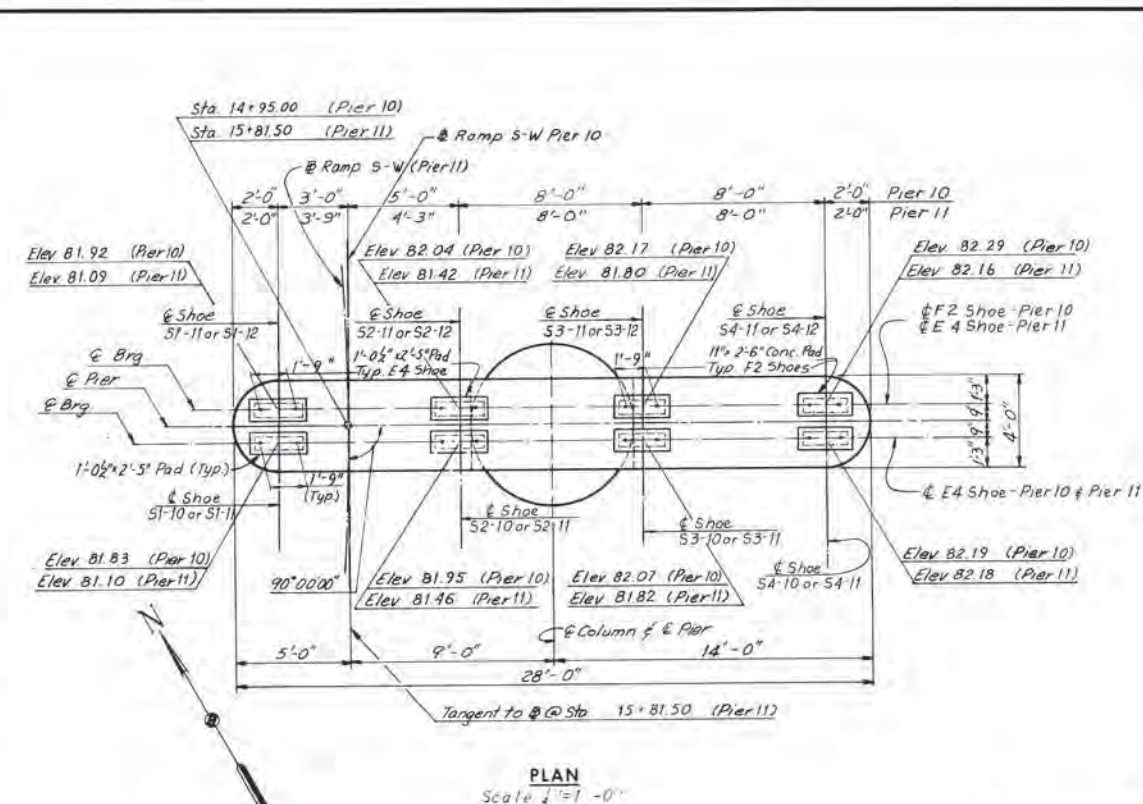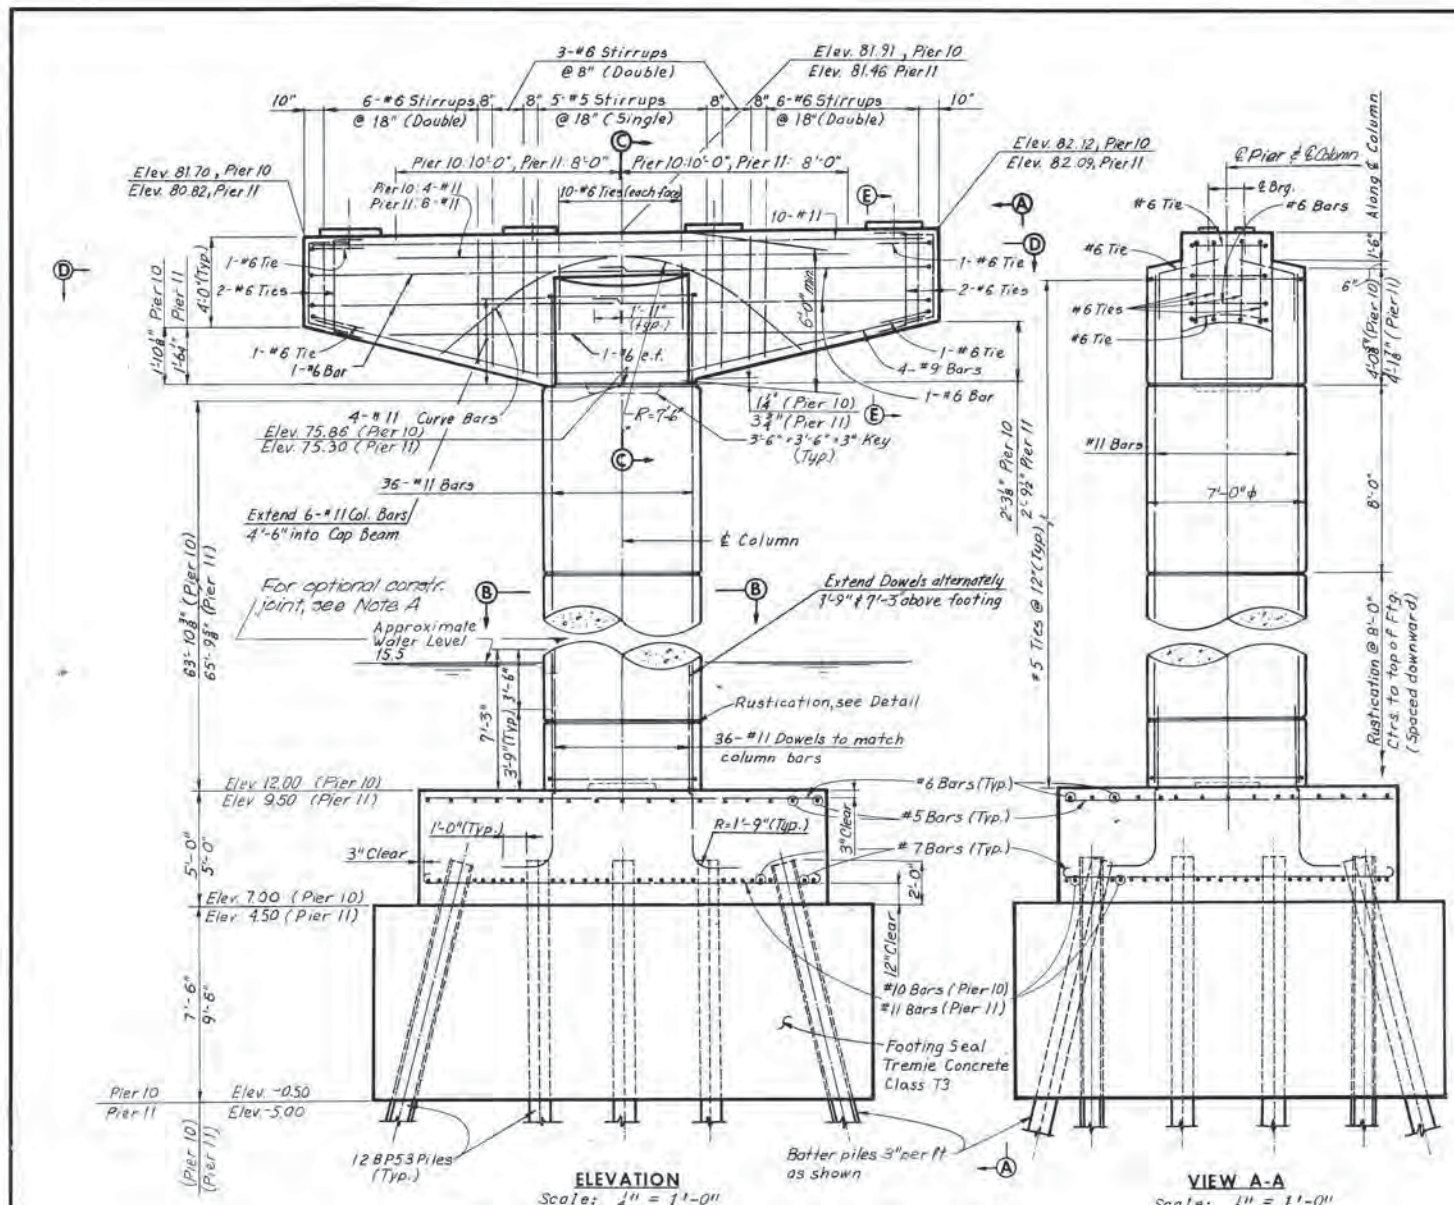

Note:
Bottom reinforcement shown in View A-A is for Pier 11 only. Bottom reinforcement for Pier 10 is similar except in size & number.

Note:
For layout of piers 10 and 11 see Sheet 3.
Pile dimensions given on Footing Plan are measured at bottom of footing (Elev. 7.00 Pier 10 and Elev. 4.50 Pier 11).

NOTE A
A construction joint will be permitted at a rustication near mid-height of the column. The column reinforcement may be lap spliced near the construction joint. The top of the splice shall be a minimum of 3'-6". Splices shall be staggered at least 3'-3" between adjacent bars.

Note:
Footing elevations are approximate only and may be varied to suit field conditions as directed by the Engineer. Vertical shaft reinforcement shall not be cut until these elevations are established. Where elevations change more than 2 ft., redesign will be required.

Legend:
• Piers 10 & 11
• Pier 11 only

Notes:
All piles shall be 12BP53 Steel Piles (Design capacity = 57 tons).
Batter piles 3" per ft., as shown.
For Standard Shoe Details see Sheet S1 & S2.
For Framing Plans see Sheet 20 & 21.
Estimated Pile Tip Elevation -20.0

AS BUILT

RICHMOND METROPOLITAN AUTHORITY
RICHMOND EXPRESSWAY SYSTEM
DOWNTOWN EXPRESSWAY




BRIDGE NO. 65
RAMP S-W CONNECTION FROM
RICHMOND-PETERSBURG TURNPIKE
PIERS 10 AND 11

HOWARD, NEEDLES, TAMMEN & BERGENDOFF
consulting engineers
NEW YORK ALEXANDRIA KANSAS CITY

SCALE: As Noted
CONTRACT NO. 11
SHEET NO. 10 OF 38






BY	DATE	NO.	REVISION	BY	DATE
MADE	CEB/AD				12-18-68
CHECKED	GSH				1-28-69
IN CHARGE					

RICHMOND EXPRESSWAY SYSTEM			
SECTION	PROJECT	SHEET NO.	TOTAL SHEETS
11	DOWNTOWN EXPRESSWAY	36	97

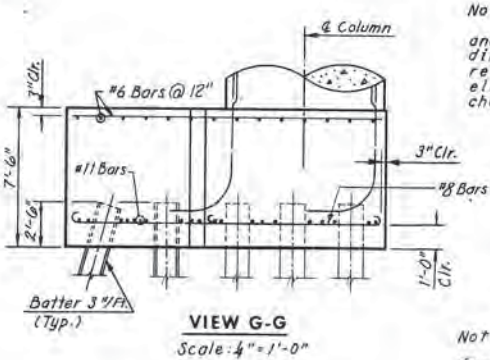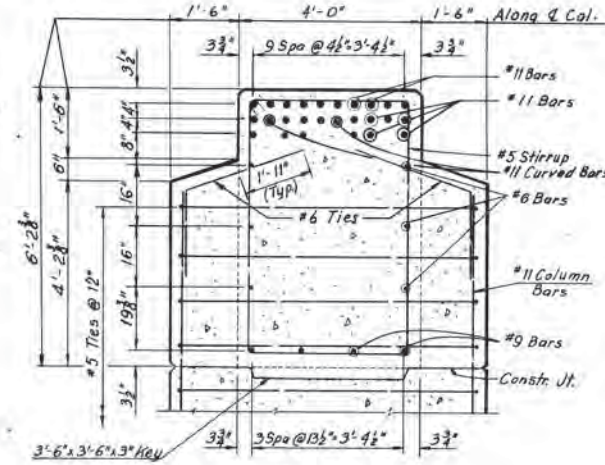
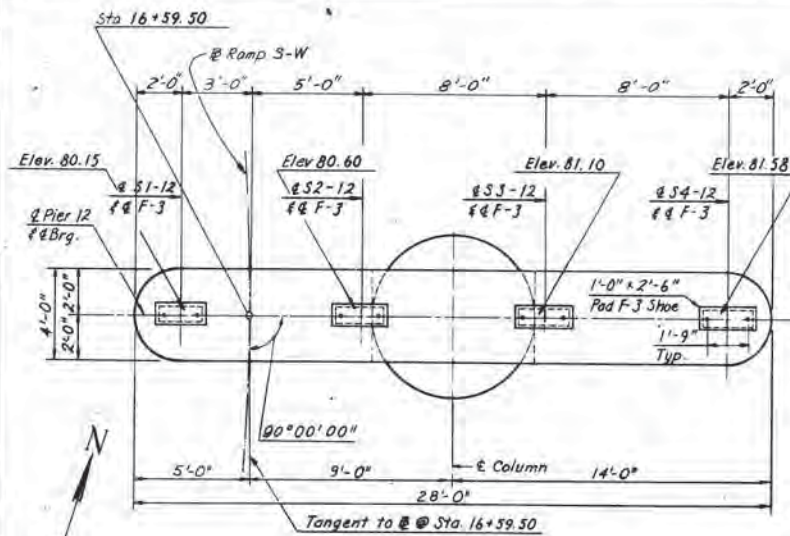


Note: Footing elevations are approximate only and may be varied to suit field conditions as directed by the Engineer. Vertical shaft reinforcing shall not be cut until these elevations are established. Where elevations change more than 2 ft., redesign will be required.

Notes: All piles shall be 12BP53 steel piles (Design Capacity= 67 tons) Batter all piles 3" per foot where shown. For Standard Shoe Details, see Sheets S1 & S2 For Framing Plan, see Sheet 21. Estimated Pile Tip Elevation is -20.0. For Rustication Details, see Sheet 5. For 12BP53 Steel Pile Details, see Sheet 9. For Sections A-B and D-D, see Sheet 12.

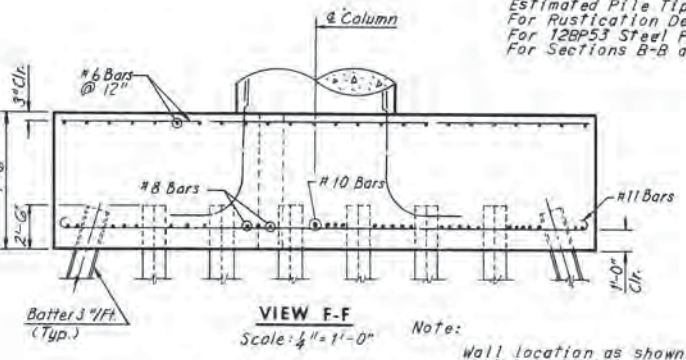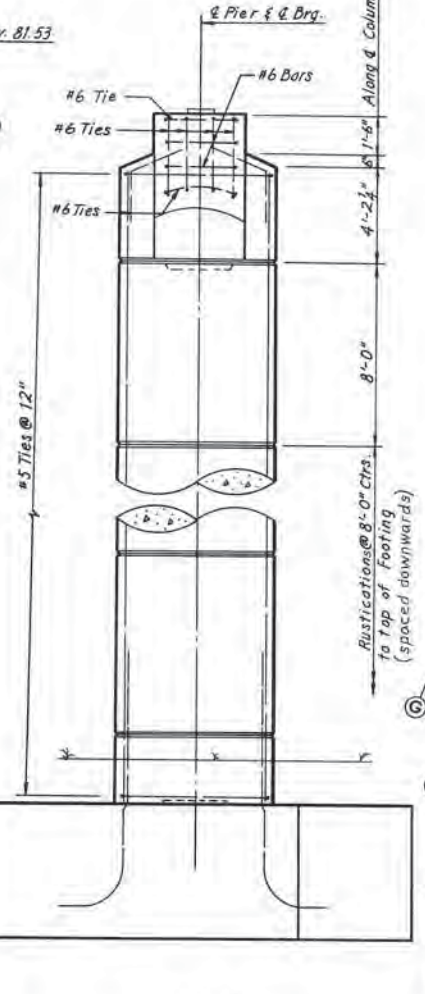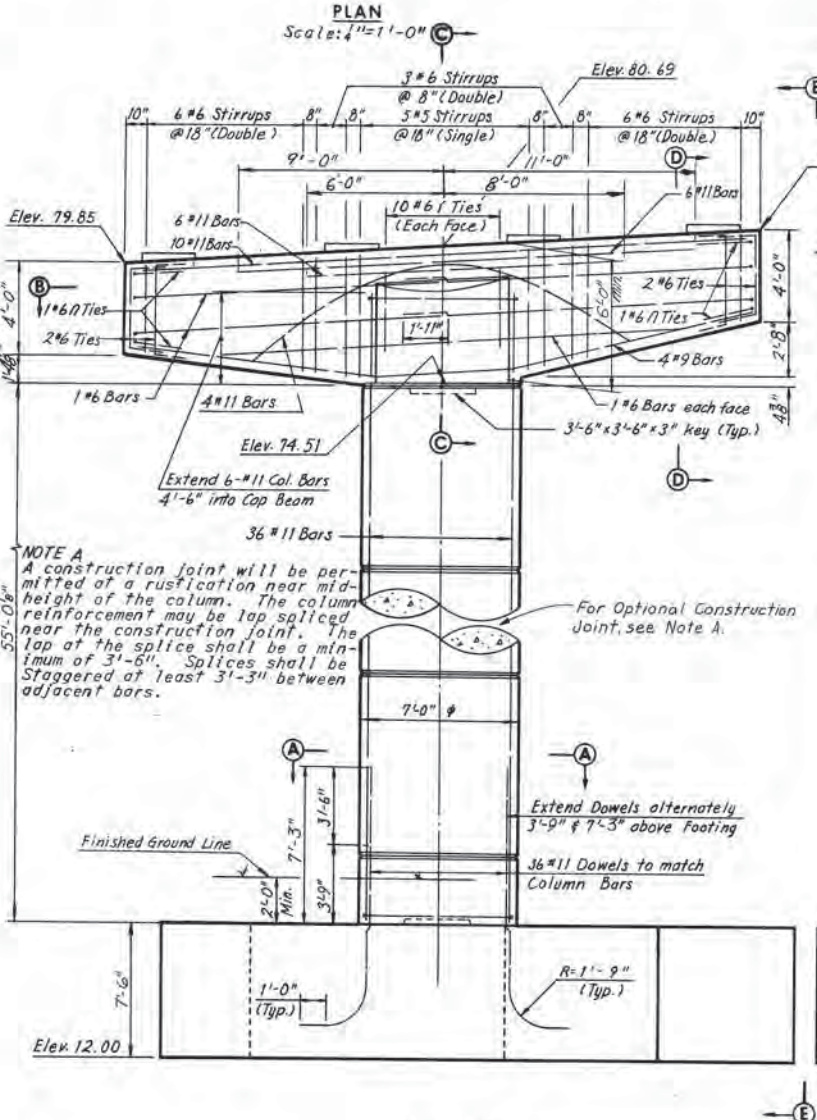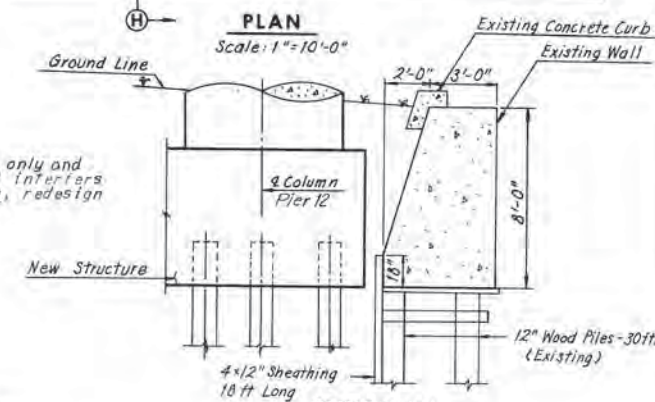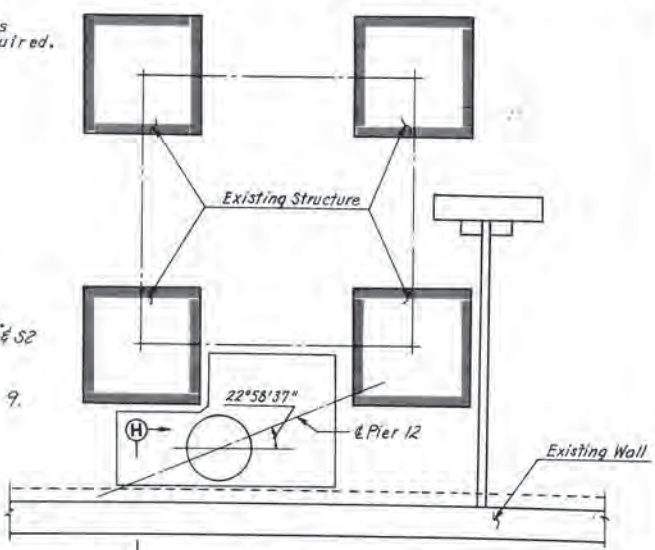

Note: Wall location as shown on Plan is approximate only and shall be verified in field. If existing wall interferes with the piling or parts of the new footing, redesign of footing will be required.

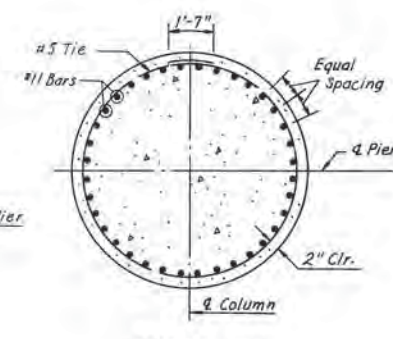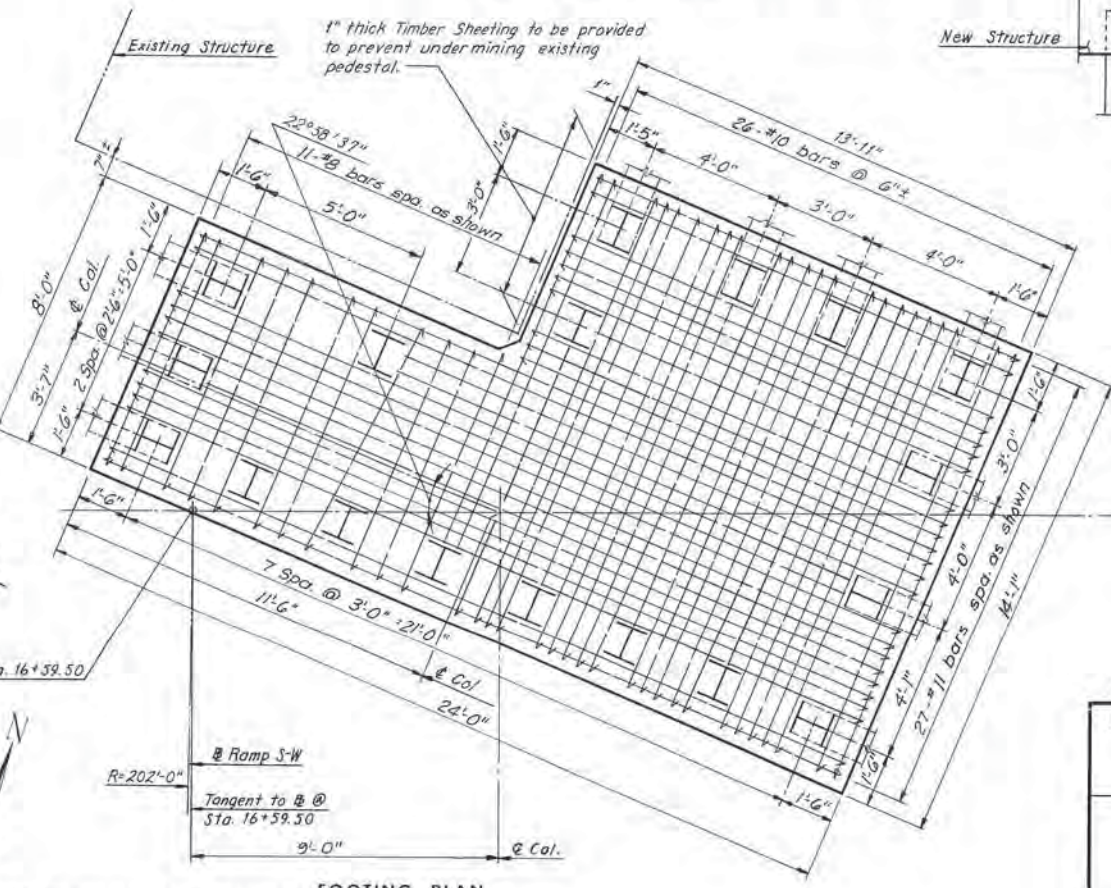

NOTE A
A construction joint will be permitted at a rustication near mid-height of the column. The column reinforcement may be lap spliced near the construction joint. The lap at the splice shall be a minimum of 3'-6". Splices shall be staggered at least 3'-3" between adjacent bars.

For Optional Construction Joint, see Note A.

Extend Dowels alternately 3'-9" & 7'-3" above Footing
36 #11 Dowels to match Column Bars

FOOTING FOR PIER 12 IS ECCENTRIC AS SHOWN ON FOOTING PLAN (Showing Bottom Reinforcing)

Note: 12 BP 53 Bearing Piles and Footing Reinforcing Steel in "ELEVATION" or "VIEW E-E" are not shown.

AS BUILT
RICHMOND METROPOLITAN AUTHORITY
RICHMOND EXPRESSWAY SYSTEM


BRIDGE NO. 65
RAMP S-W CONNECTION FROM
RICHMOND-PETERSBURG TURNPIKE
PIER 12

HOWARD, NEEDLES, TAMMEN & BERGENDOFF
 CONSULTING ENGINEERS
 NEW YORK ALEXANDRIA KANSAS CITY

SCALE: As Noted
 CONTRACT NO. 11
 SHEET NO. 11 OF 38

BY	DATE				
MADE	Y.C.P	3-29-69			
CHECKED	K.C.T	5-6-69			
IN CHARGE					


RICHMOND EXPRESSWAY SYSTEM			
SECTION	PROJECT	SHEET NO.	TOTAL SHEETS
11	DOWNTOWN EXPRESSWAY	37	97

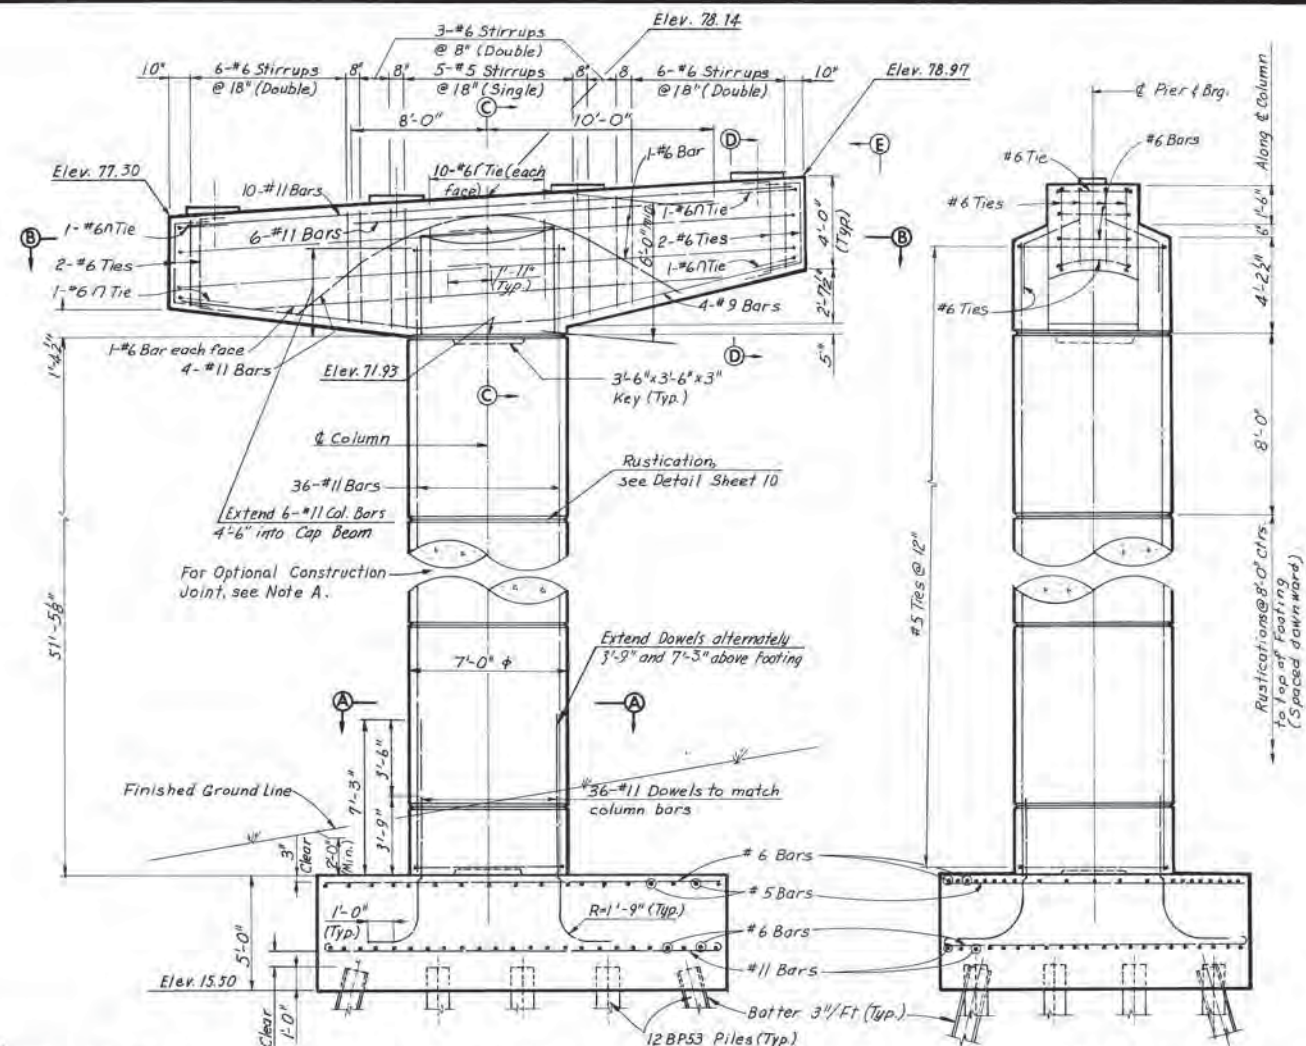


ELEVATION
Scale: 1/4" = 1'-0"

VIEW E-E
Scale: 1/4" = 1'-0"


NOTE A
A construction joint will be permitted at a rustication near mid-height of the column. The column reinforcement may be lap spliced near the construction joint. The lap of the splice shall be a minimum of 3'-6". Splices shall be staggered at least 3'-3" between adjacent bars.

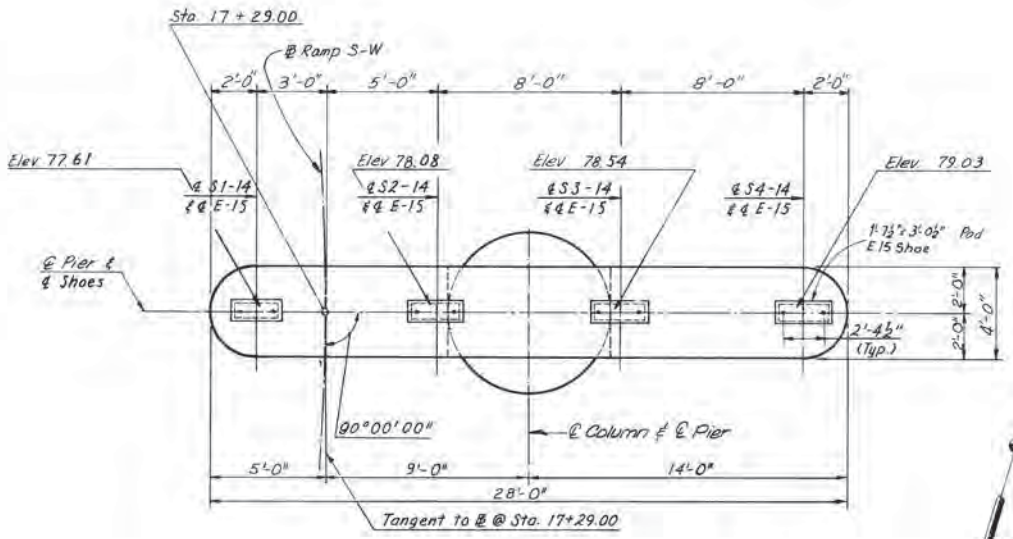


PLAN
Scale: 1/4" = 1'-0"

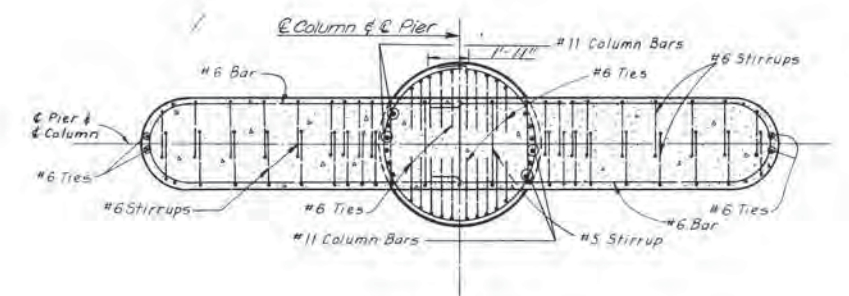


SECTION B-B
Scale: 1/4" = 1'-0"

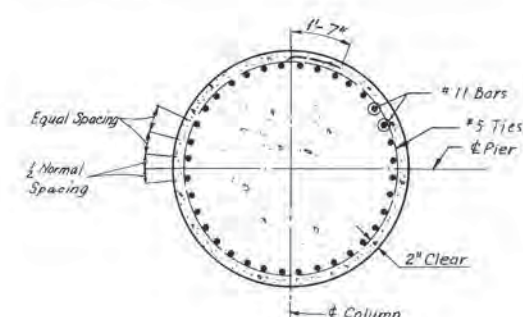

SECTION A-A
Scale: 1/4" = 1'-0"

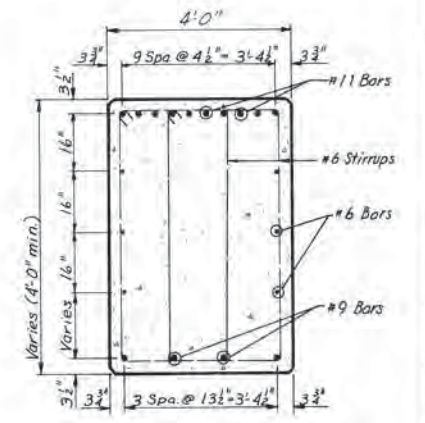

SECTION D-D
Scale: 1/2" = 1'-0"

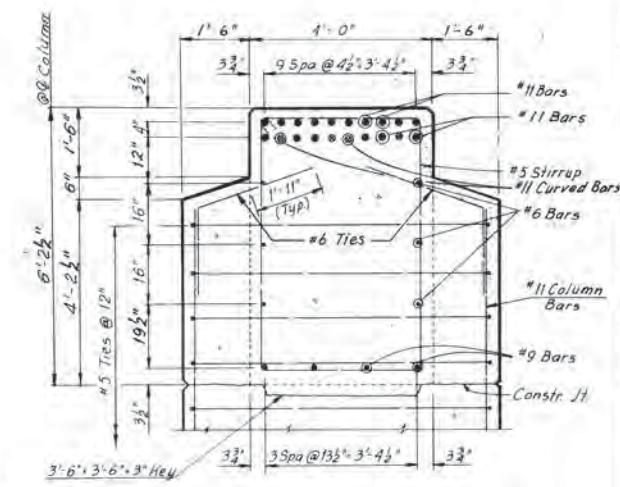


SECTION C-C
Scale: 1/2" = 1'-0"

Notes:
Footing elevations are approximate only and may be varied to suit field conditions as directed by the Engineer. Vertical shaft reinforcing shall not be cut until these elevations are established. Where elevations change more than 2 ft., redesign will be required.

Notes:
All piles shall be 12BP53 steel piles (Design Capacity = 57 ton)
Batter all piles 3" per foot where shown.
For Standard Shop Details, see Sheets S1 & S2.
For Framing Plan, see Sheet 22.
Estimated Pile Tip Elevation is -20.0.
For Rustication Details, see Sheet 10.
For 12BP53 Steel Pile Details, see Sheet 9.

Note:
Existing Flood-protection dike is to be restored to original contour upon completion of Pier construction.

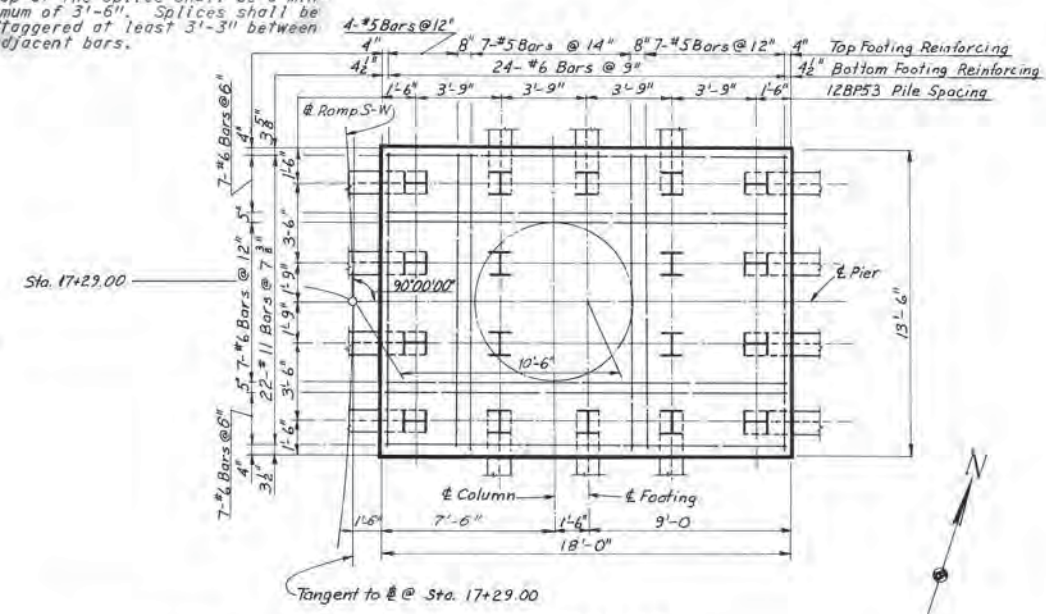

FOOTING PLAN
Scale: 1/4" = 1'-0"

FOOTING FOR PIER 13 IS ECCENTRIC AS SHOWN ON FOOTING PLAN

MADE	BY	DATE			
CHECKED	GS	1-20-69			
IN CHARGE			NO.	REVISION	BY DATE

AS BUILT






RICHMOND METROPOLITAN AUTHORITY
RICHMOND EXPRESSWAY SYSTEM
DOWNTOWN EXPRESSWAY

BRIDGE NO. 65
RAMP S-W CONNECTION FROM
RICHMOND-PETERSBURG TURNPIKE
PIER 13

HOWARD, NEEDLES, TAMMEN & BERGENDOFF
consulting engineers
NEW YORK ALEXANDRIA KANSAS CITY

SCALE: As Noted
CONTRACT NO. 11
SHEET NO. 12 OF 38

RICHMOND EXPRESSWAY SYSTEM			
SECTION	PROJECT	SHEET NO.	TOTAL SHEETS
11	DOWNTOWN EXPRESSWAY	38	97

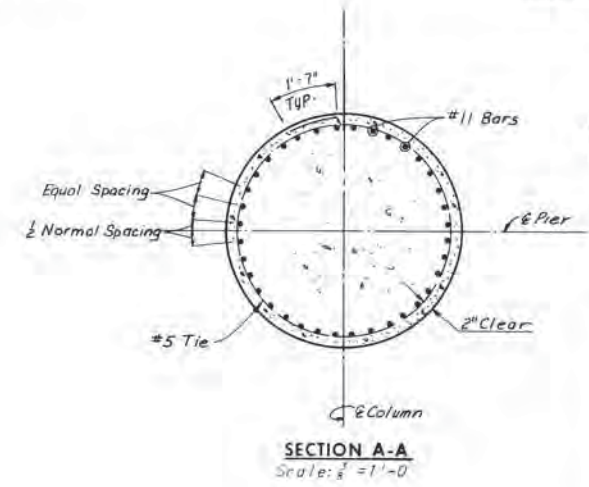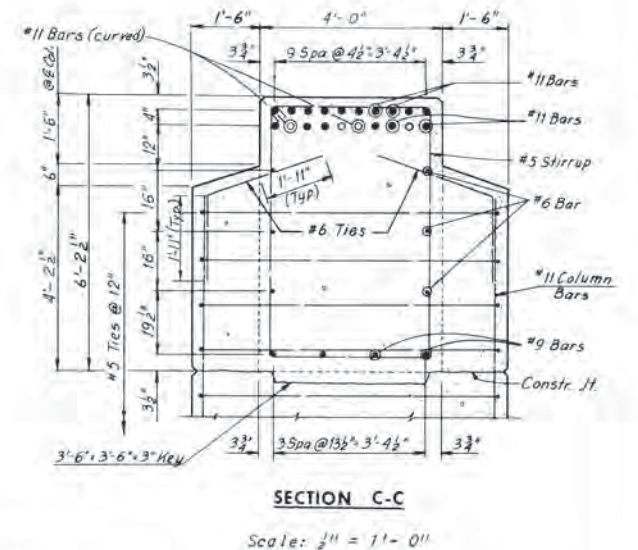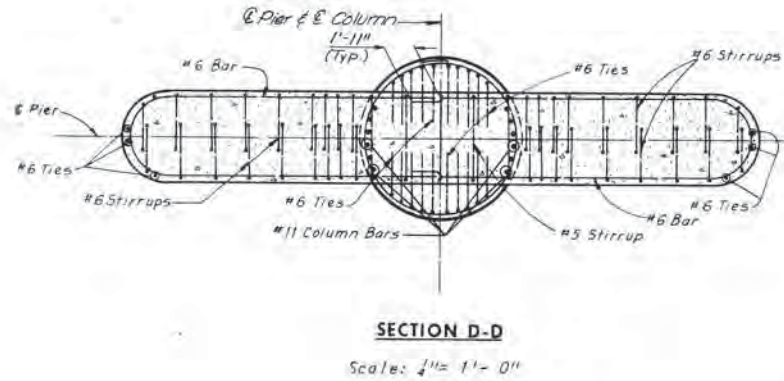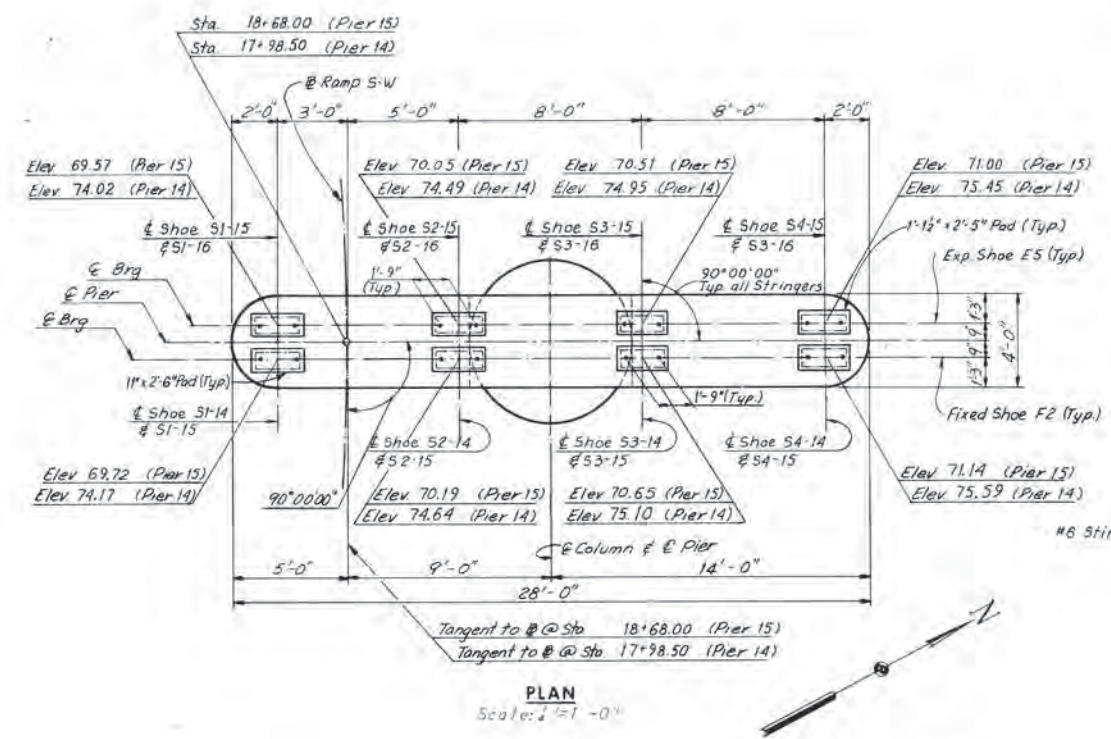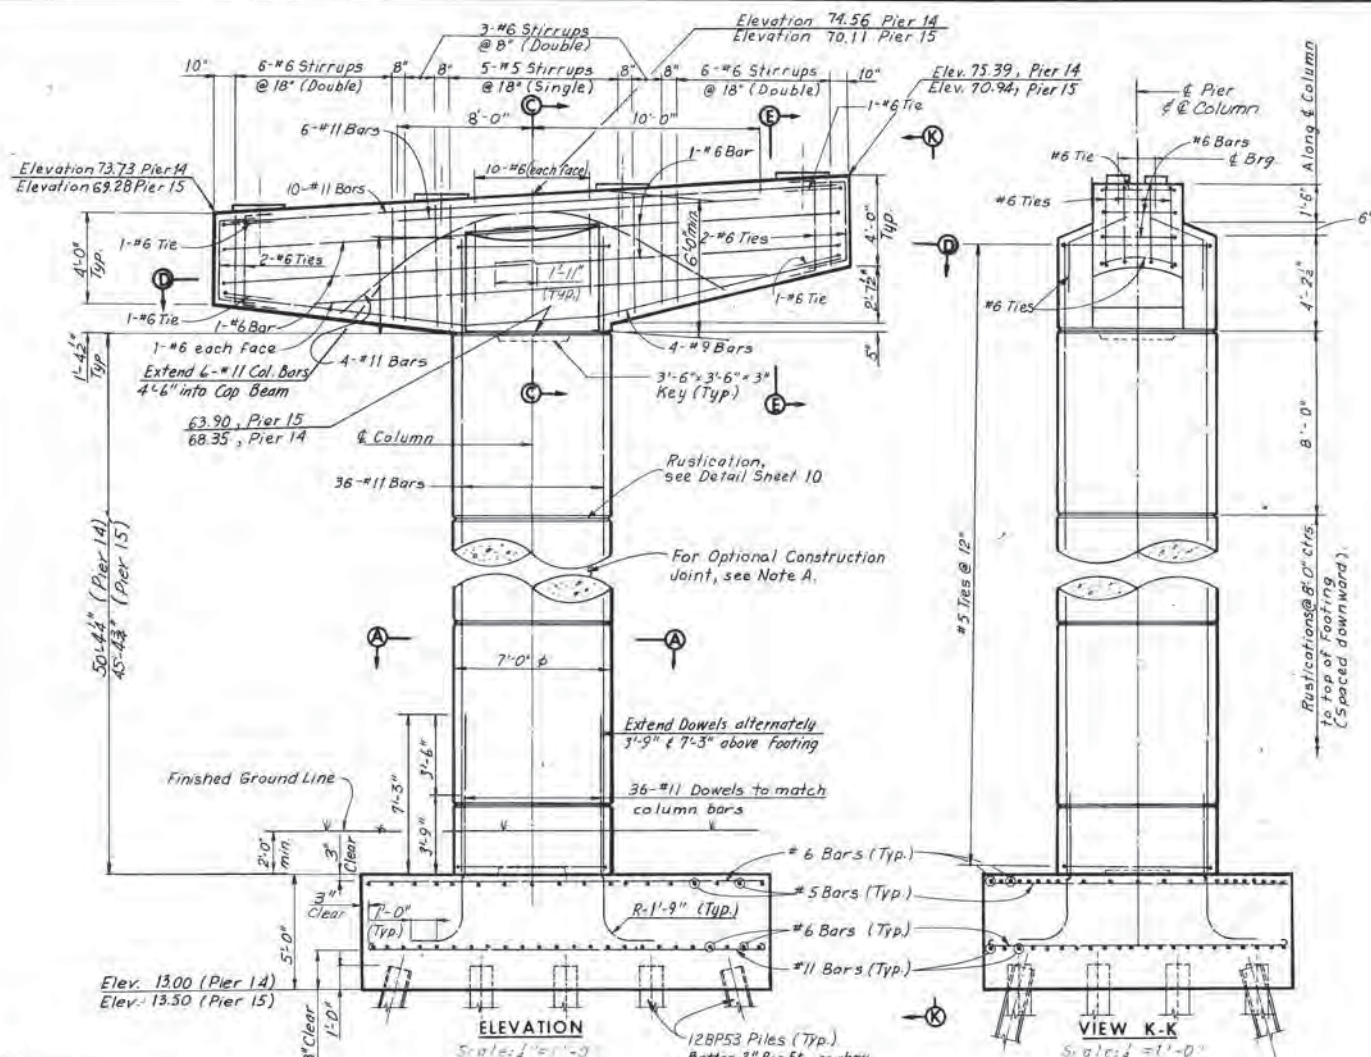

NOTE A
A construction joint will be permitted at a rustication near mid-height of the column. The column reinforcement may be lap spliced near the construction joint. The top of the splice shall be a minimum of 3'-6". Splices shall be staggered at least 3'-3" between adjacent bars.

Note: Existing Flood-protection dike is to be restored to original contour upon completion of Pier construction.
Note: For layout of Piers 14 and 15 See Sheet 3.

FOOTINGS FOR PIERS 14 AND 15 ARE ECCENTRIC AS SHOWN ON FOOTING PLAN

Note: Dimensions given in Footing Plan are measured at bottom of Footing.

Note: Footing elevations are approximate only and may be varied to suit field conditions as directed by the Engineer. Vertical shaft reinforcement shall not be cut until these elevations are established. Where elevations change more than 2 ft., redesign will be required.

Notes:
 All piles shall be 12BPS3 Steel Piles (Design capacity = 57 tons).
 Batter piles 3" per ft. as shown.
 For Shoe Details see Sheet 31 & 52.
 For Steel Pile Details see Sheet 9.
 For Framing Plans see Sheet 22.
 Estimated Pile Tip elevations -20.0.











AS BUILT
 RICHMOND METROPOLITAN AUTHORITY
 RICHMOND EXPRESSWAY SYSTEM
 DOWNTOWN EXPRESSWAY
 BRIDGE NO. 65
 RAMP S-W CONNECTION FROM
 RICHMOND-PETERSBURG TURNPIKE
 PIERS 14 AND 15

BY	DATE	NO.	REVISION	BY	DATE
MADE	CEB/DP	12-19-68			
CHECKED	RC	1.20.69			
IN CHARGE					

FOOTING PLAN
Scale: 1/4" = 1'-0"

RICHMOND EXPRESSWAY SYSTEM			
SECTION	PROJECT	SHEET NO.	TOTAL SHEETS
11	DOWNTOWN EXPRESSWAY	39	97

NOTE A
A construction joint will be permitted at a rustication near mid-height of the column. The column reinforcement may be lap spliced near the construction joint. The lap at the splice shall be a minimum of 3'-6". Splices shall be staggered at least 3'-3" between adjacent bars.

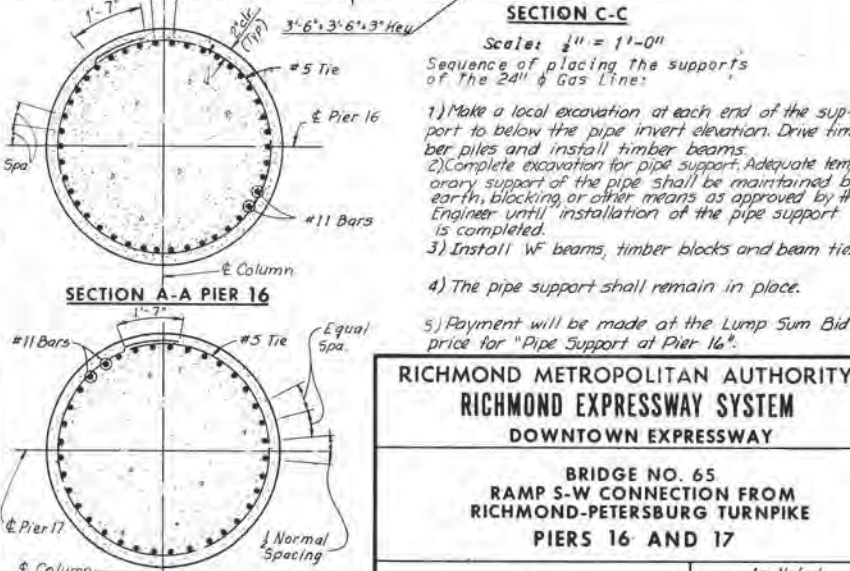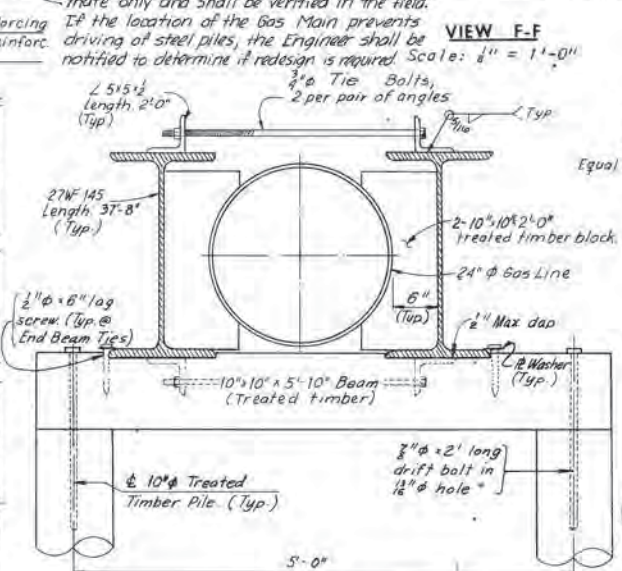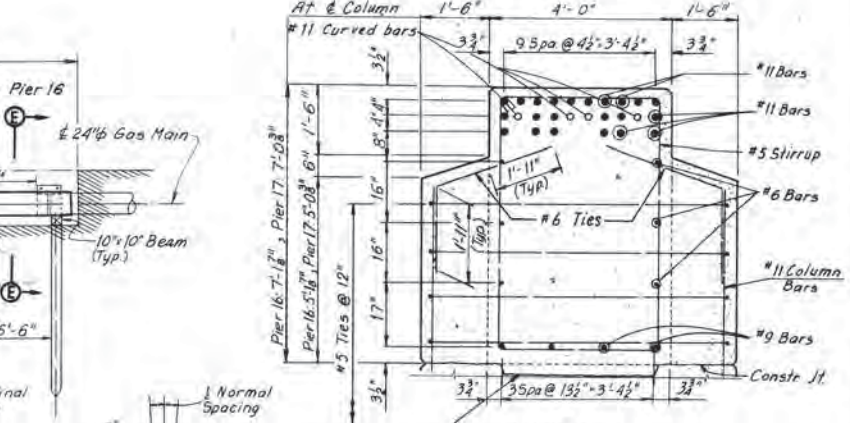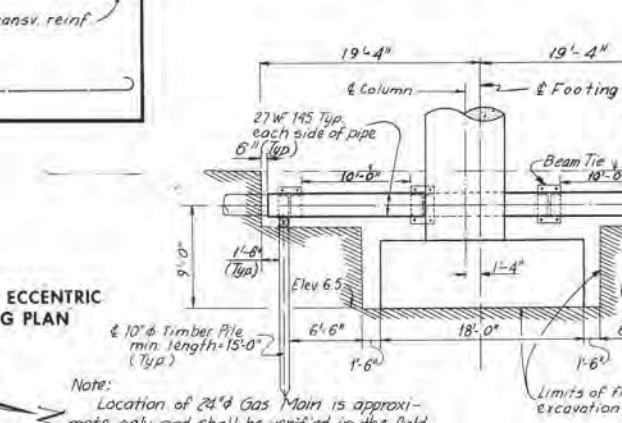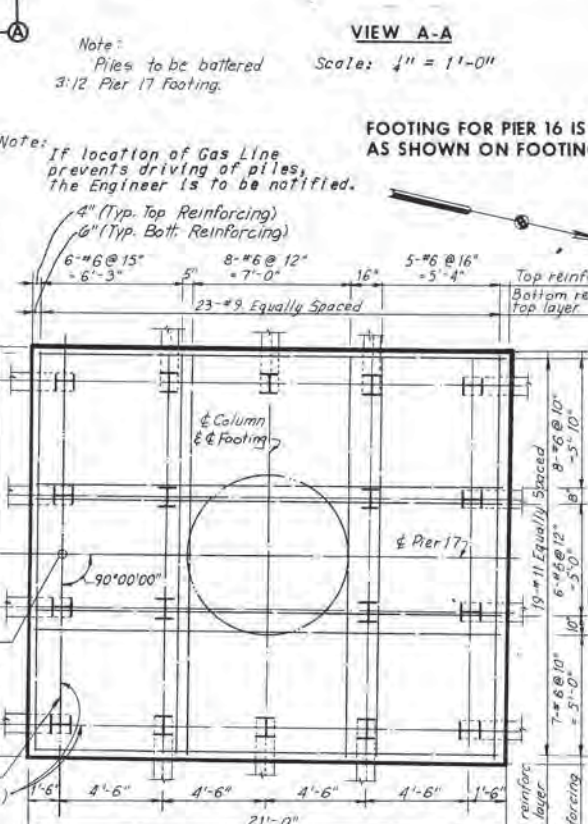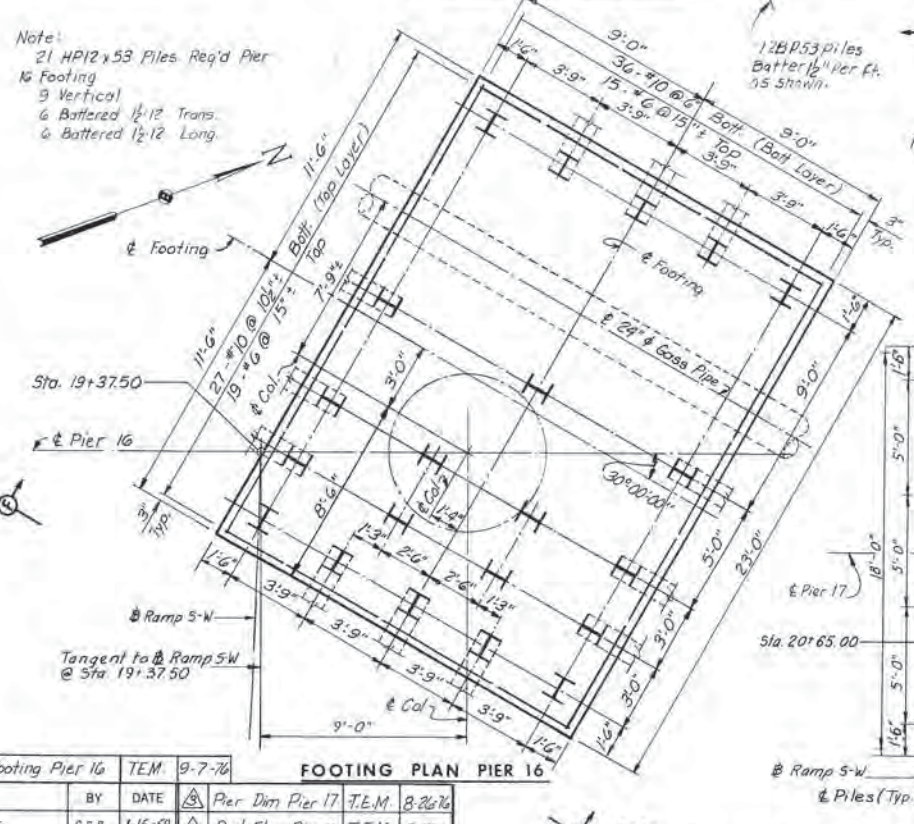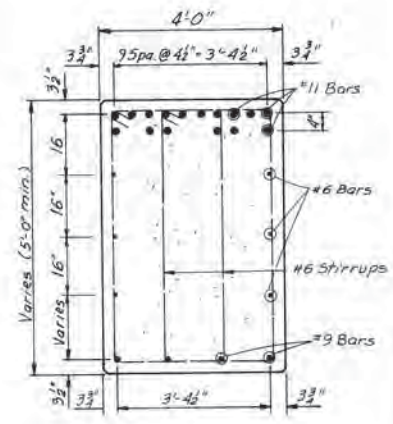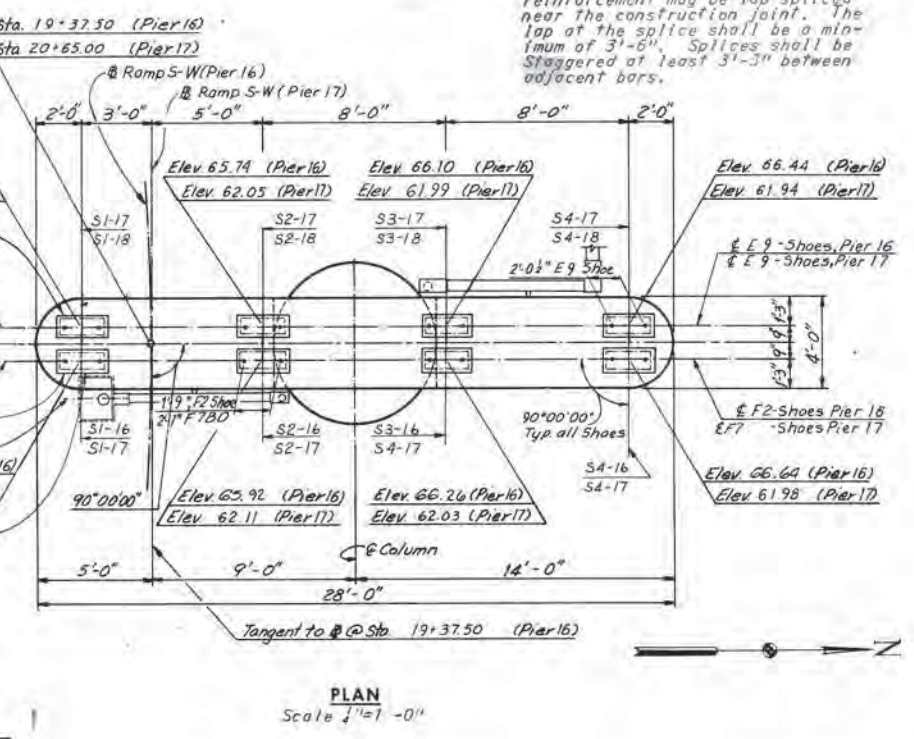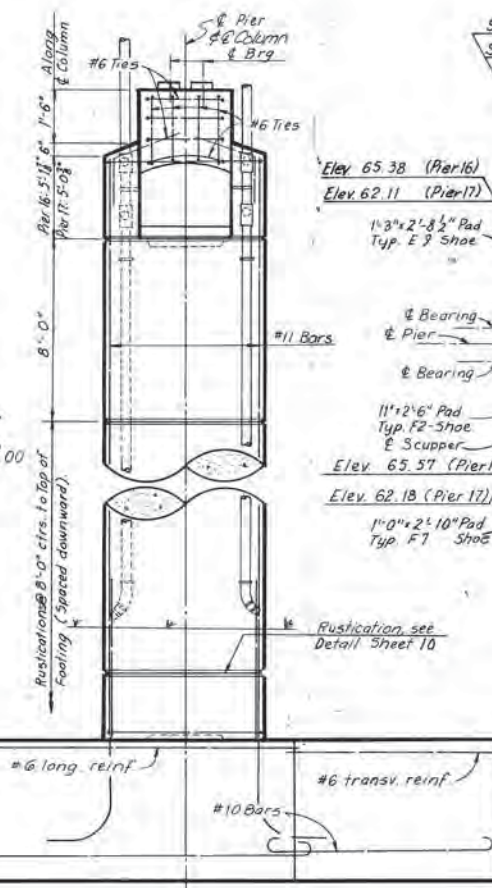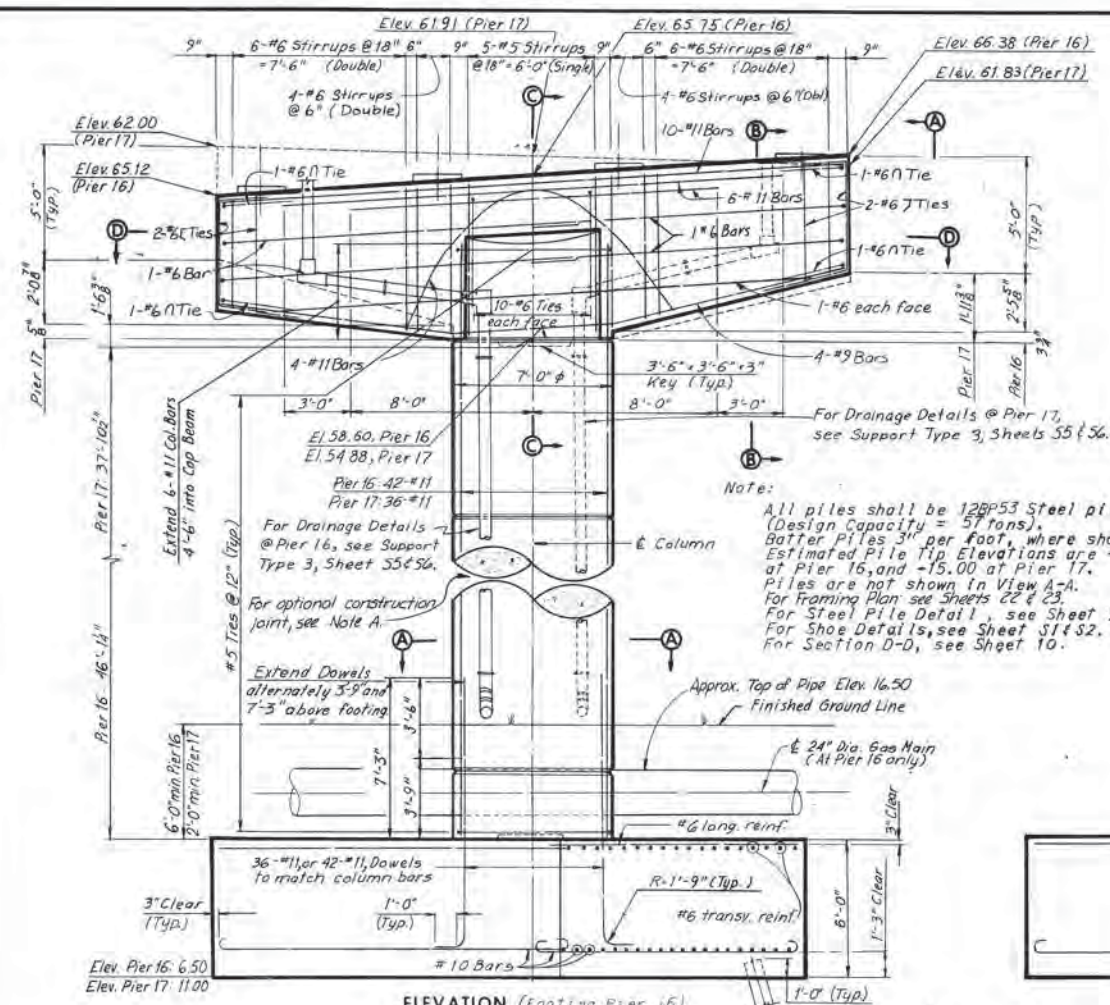

- Sequence of placing the supports of the 24" Gas Line:
- 1) Make a local excavation at each end of the support to below the pipe invert elevation. Drive timber piles and install timber beams.
 - 2) Complete excavation for pipe support. Adequate temporary support of the pipe shall be maintained by earth, blocking, or other means as approved by the Engineer until installation of the pipe support is completed.
 - 3) Install W beams, timber blocks and beam ties.
 - 4) The pipe support shall remain in place.
 - 5) Payment will be made at the Lump Sum Bid price for "Pipe Support at Pier 16".

RICHMOND METROPOLITAN AUTHORITY
RICHMOND EXPRESSWAY SYSTEM
DOWNTOWN EXPRESSWAY

BRIDGE NO. 65
RAMP S-W CONNECTION FROM
RICHMOND-PETERSBURG TURNPIKE
PIERS 16 AND 17

HOWARD, NEEDLES, TAMMEN & BERGENDOFF
consulting engineers
NEW YORK ALEXANDRIA KANSAS CITY



SCALE: As Noted
CONTRACT NO. 11
SHEET NO. 14 OF 38

NO.	REVISION	BY	DATE
1	Per Dim Pier 17	T.E.M.	8-26-76
2	Pod Elev Pier 16	T.E.M.	5-76
3	Shoe Type revised	CBP	8-25-75

Note: Dimensions given in Footing Plan are measured at bottom of footing.

AS BUILT

RICHMOND EXPRESSWAY SYSTEM			
SECTION	PROJECT	SHEET NO.	TOTAL SHEETS
11	DOWNTOWN EXPRESSWAY	40	97

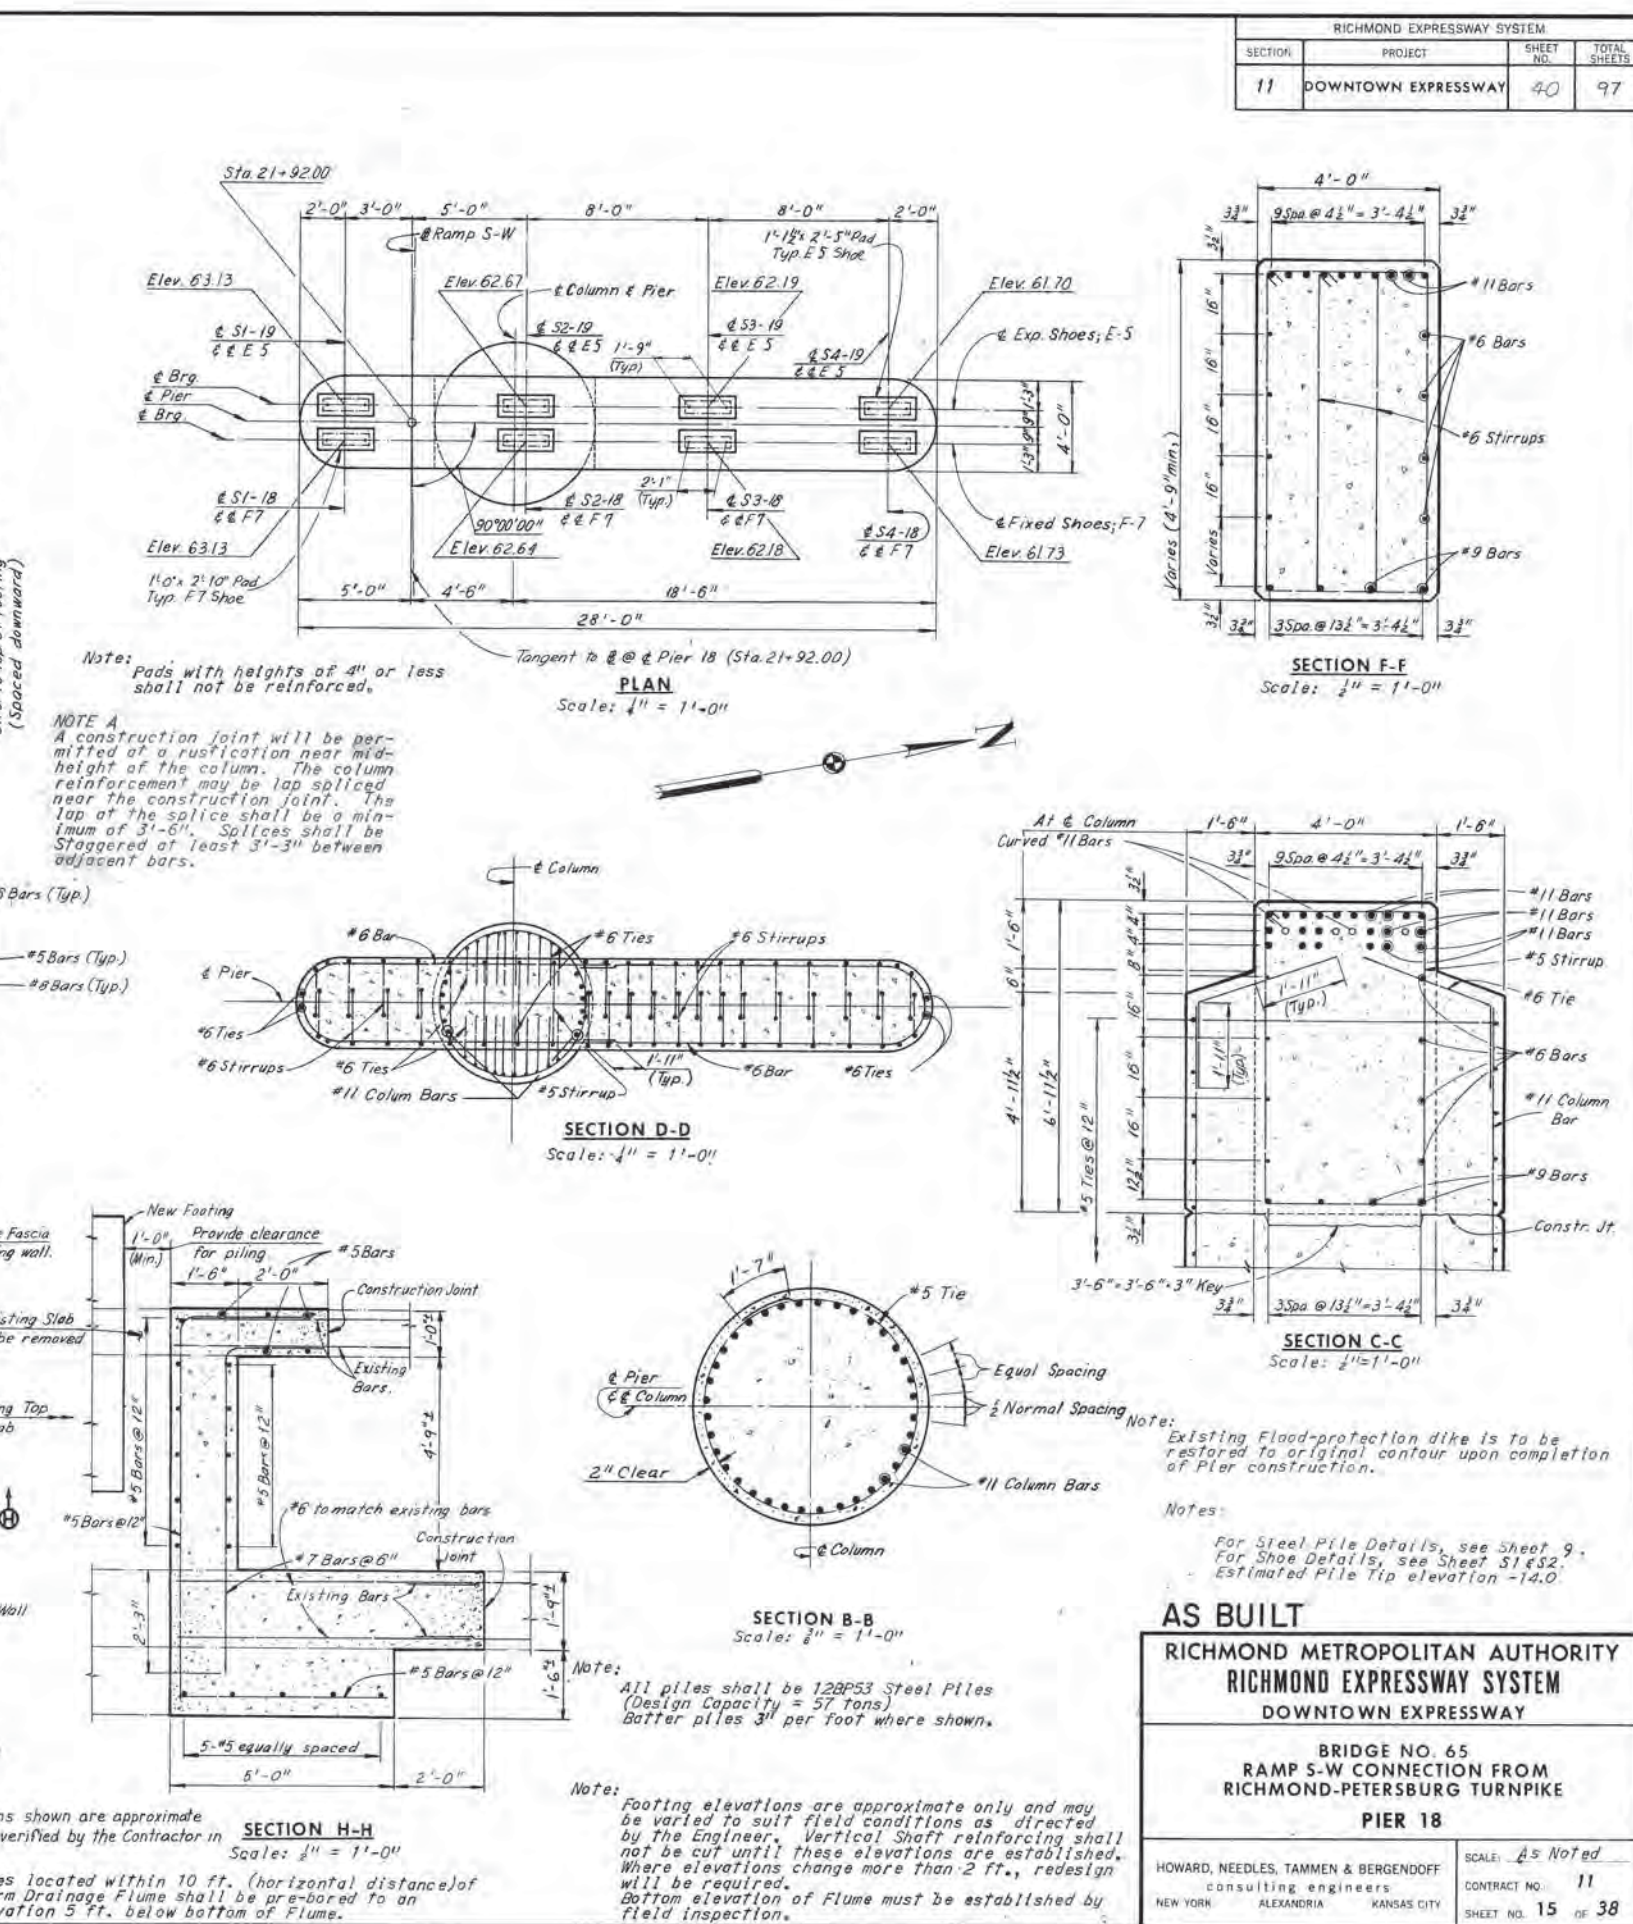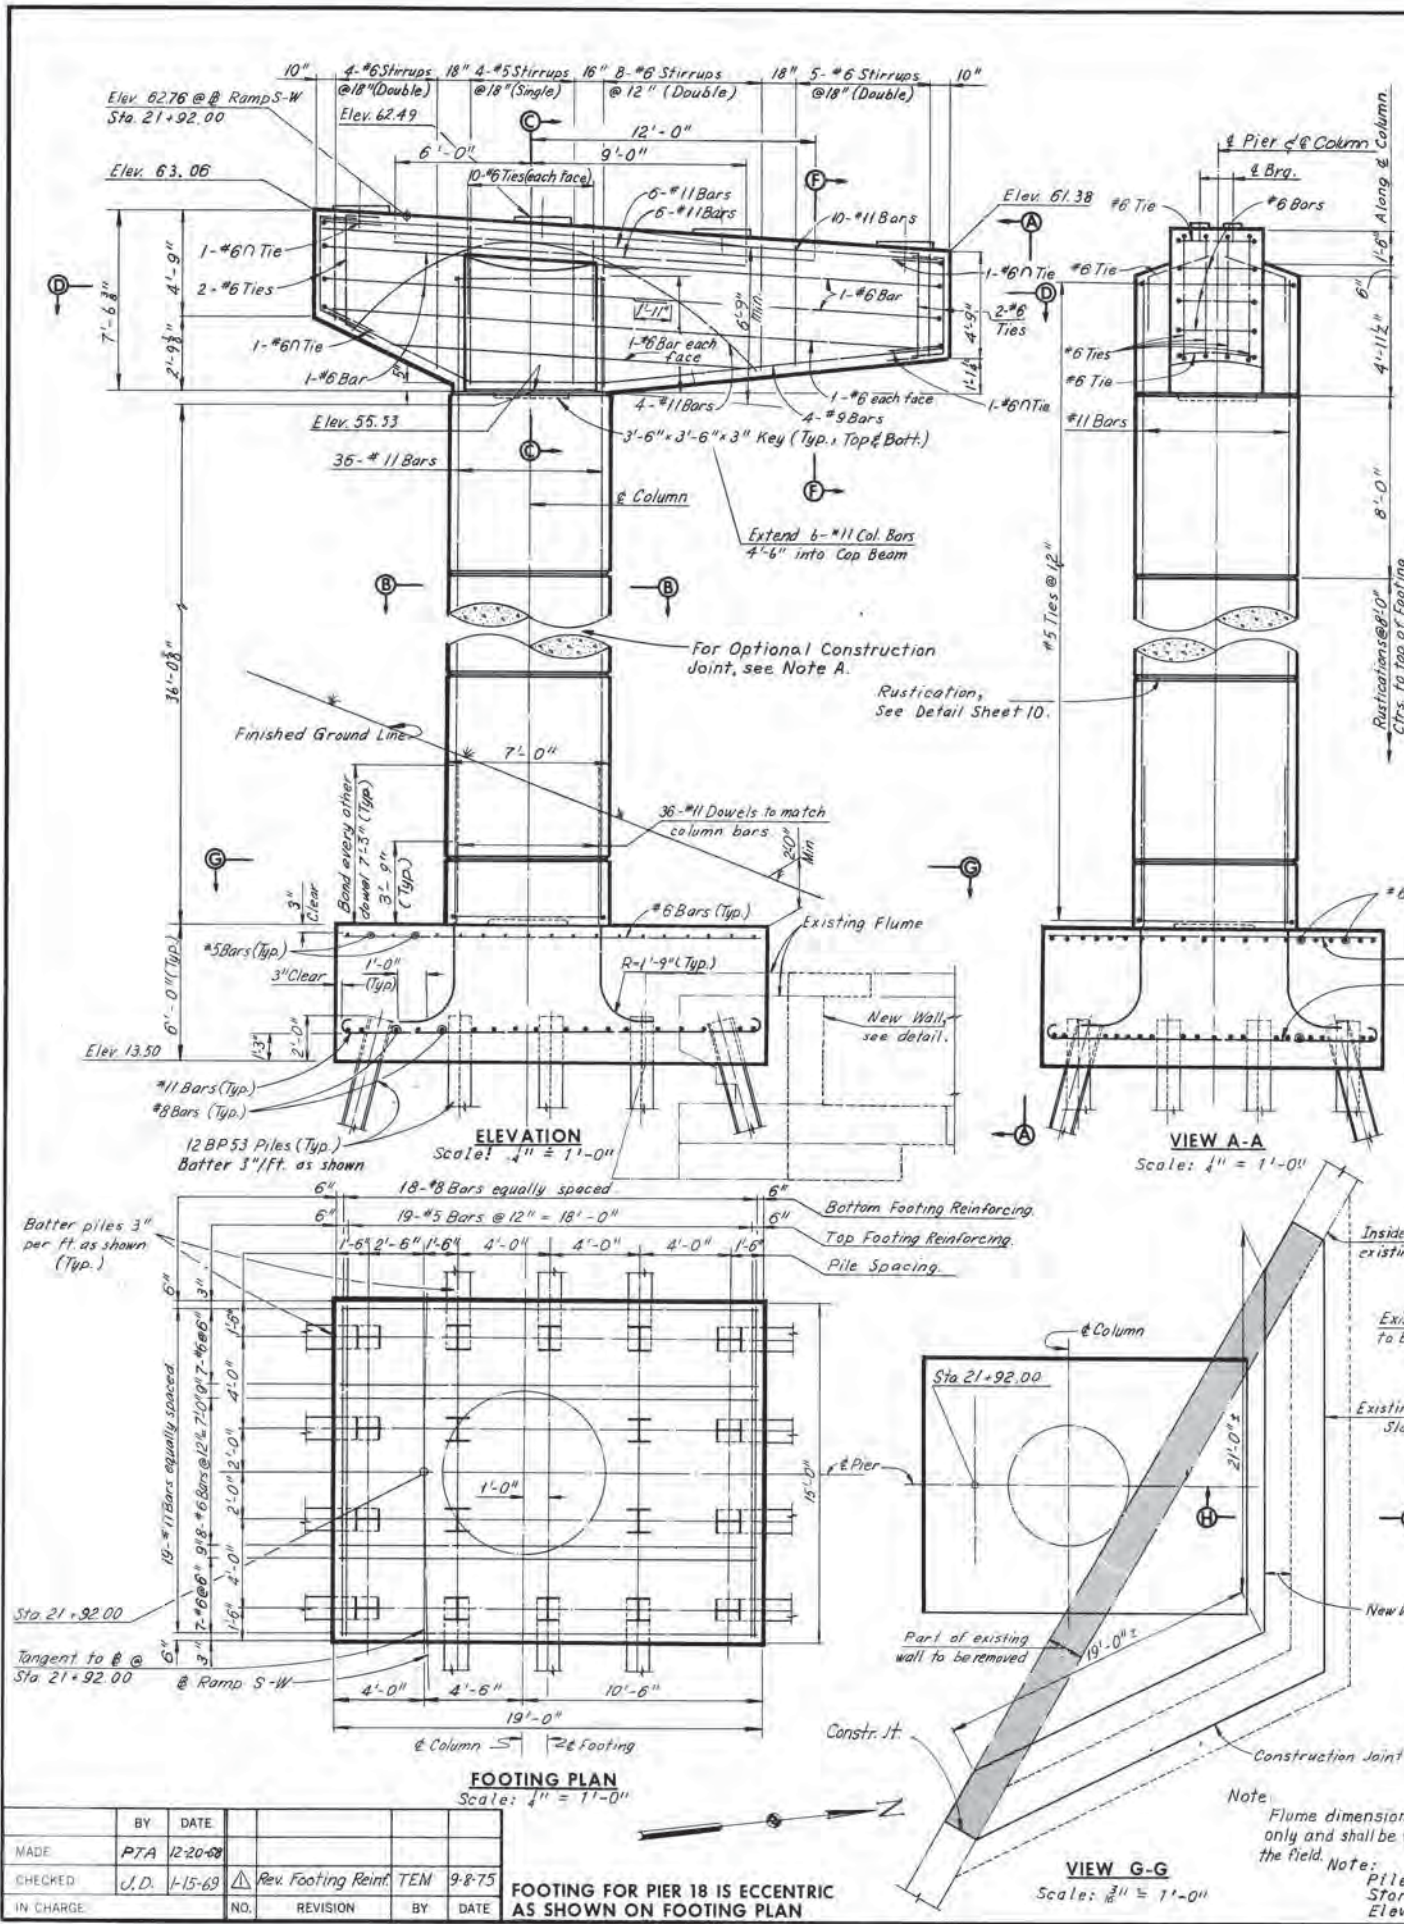

NOTE A
A construction joint will be permitted at a rustication near mid-height of the column. The column reinforcement may be lap spliced near the construction joint. The lap of the splice shall be a minimum of 3'-6". Splices shall be staggered at least 3'-3" between adjacent bars.

Notes:
Existing Flood-protection dike is to be restored to original contour upon completion of Pier construction.

Note:
All piles shall be 12BP53 Steel Piles (Design Capacity = 57 tons). Batter piles 3' per foot where shown.

Note:
Footing elevations are approximate only and may be varied to suit field conditions as directed by the Engineer. Vertical shaft reinforcing shall not be cut until these elevations are established. Where elevations change more than 2 ft., redesign will be required. Bottom elevation of Flume must be established by field inspection.

BY	DATE	REVISION	BY	DATE
MADE	PTA	12-20-09		
CHECKED	J.D.	1-15-09	Rev. Footing Reint.	TEM 9-8-75
IN CHARGE				

FOOTING FOR PIER 18 IS ECCENTRIC AS SHOWN ON FOOTING PLAN

AS BUILT

RICHMOND METROPOLITAN AUTHORITY
RICHMOND EXPRESSWAY SYSTEM
DOWNTOWN EXPRESSWAY











BRIDGE NO. 65
RAMP S-W CONNECTION FROM
RICHMOND-PETERSBURG TURNPIKE

PIER 18

HOWARD, NEEDLES, TAMMEN & BERGENDOFF
consulting engineers
NEW YORK ALEXANDRIA KANSAS CITY

SCALE: AS NOTED
CONTRACT NO. 11
SHEET NO. 15 OF 38

RICHMOND EXPRESSWAY SYSTEM			
SECTION	PROJECT	SHEET NO.	TOTAL SHEETS
11	DOWNTOWN EXPRESSWAY	41	97

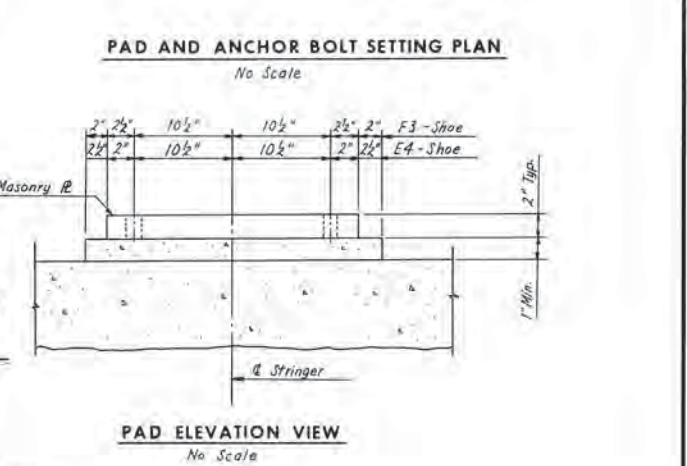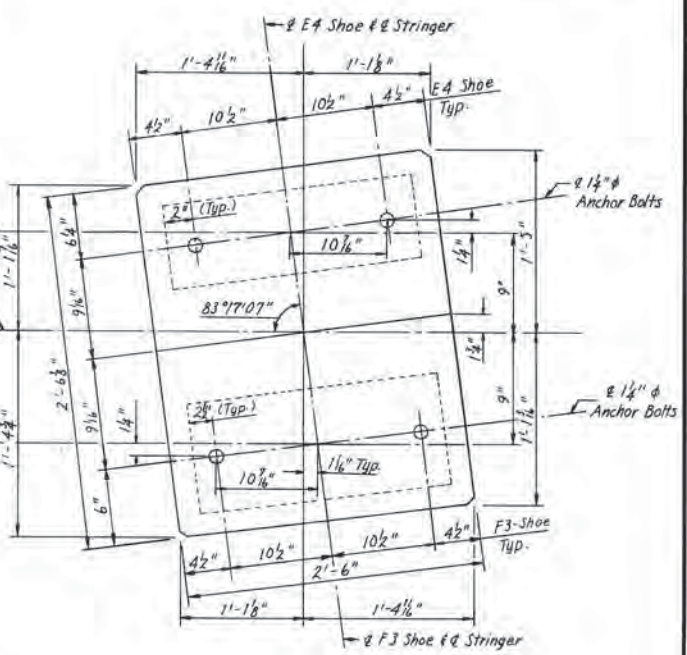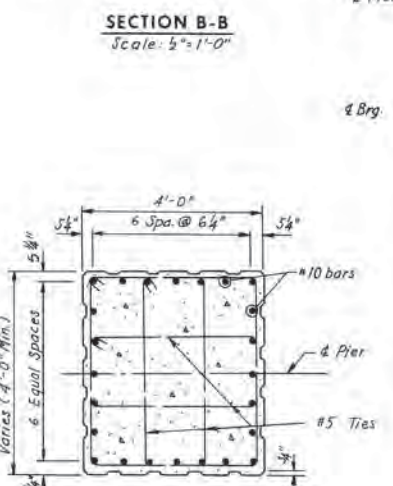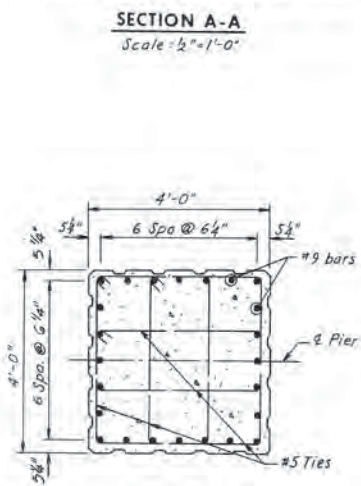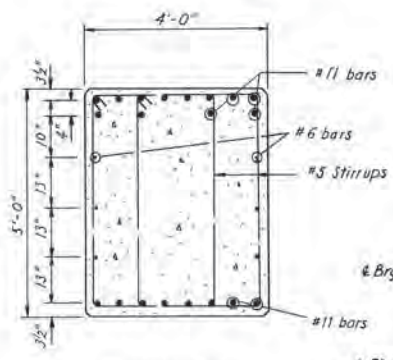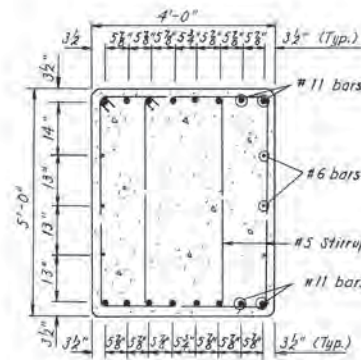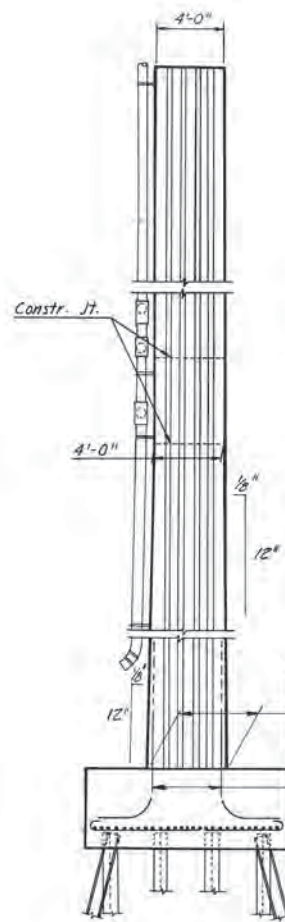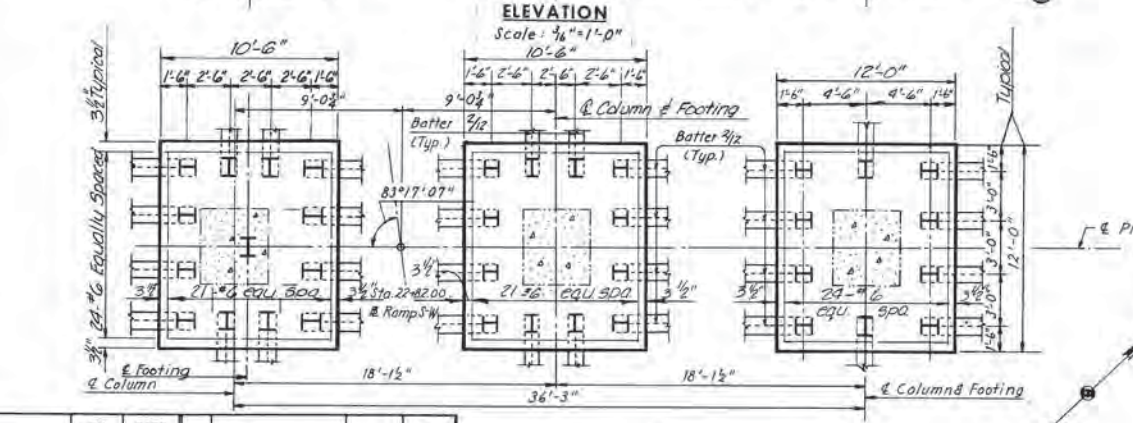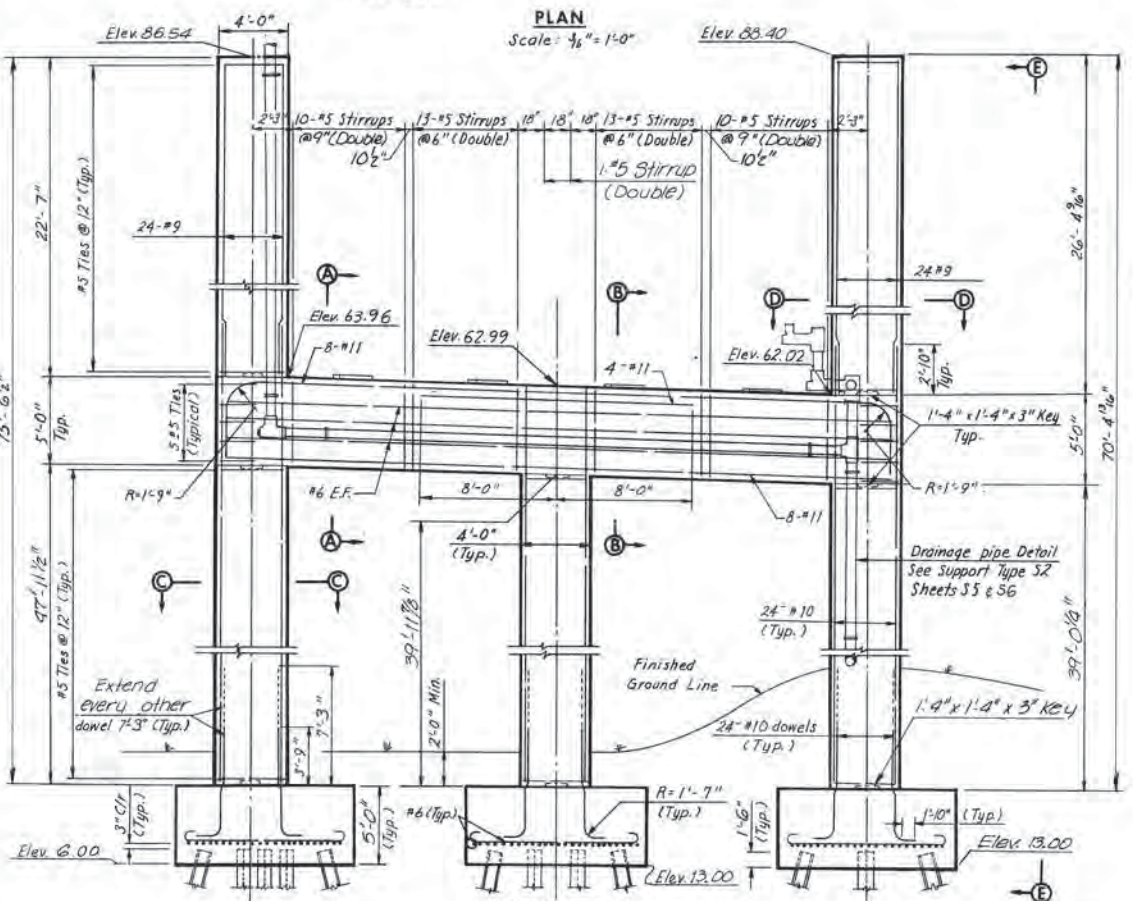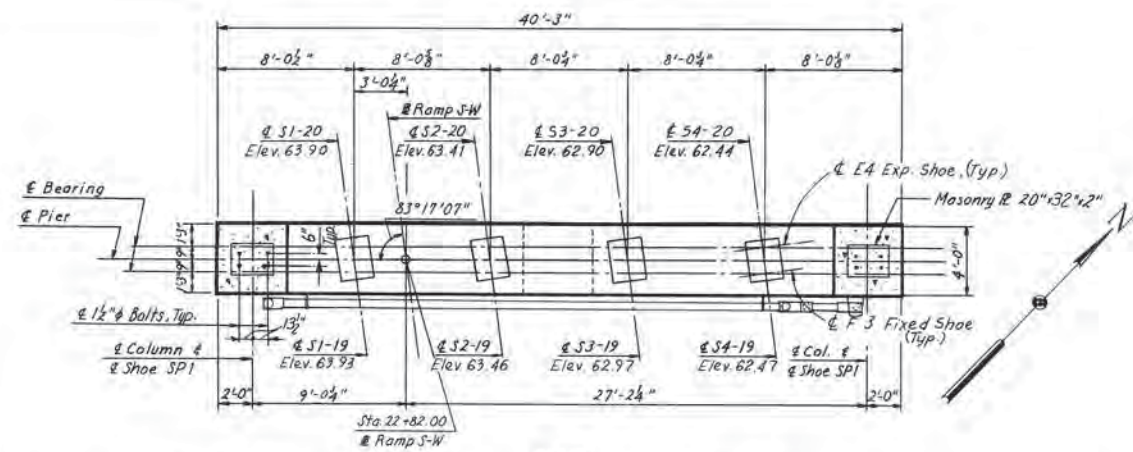

Notes:
 For Shoe Details, see Sheet S1 and S2.
 Batter Piles 2'/ft where shown.
 For Steel Pile Details, see Sheet S.
 For Framing Plan see Sheet 24.
 Estimated Pile Tip Elevation = -11.0
 All piles shall be 12BP53 steel piles
 (Design capacity = 57 tons)

Note:
 Existing Flood-protection dike is to be restored to original contour upon completion of Pier construction.

Note:
 Footing elevations are approximate only and may be varied to suit field conditions as directed by the Engineer. Vertical shaft reinforcement shall not be cut until these elevations are established. Where elevations change more than 2 ft., redesign will be required.

Note:
 Rustications on pier shaft shall extend a minimum of 2'-0" below the finished ground line except that when the top of footing is within 5'-0" of the finished ground line the rustications shall extend to the top of footing.

AS BUILT
 RICHMOND METROPOLITAN AUTHORITY
 RICHMOND EXPRESSWAY SYSTEM
 DOWNTOWN EXPRESSWAY


BRIDGE NO. 65
 RAMP S-W CONNECTION FROM
 RICHMOND-PETERSBURG TURNPIKE
 PIER 19

SCALE: As Noted
 HOWARD, NEEDLES, TAMMEN & BERGENDOFF
 consulting engineers
 NEW YORK ALEXANDRIA KANSAS CITY
 CONTRACT NO. 11
 SHEET NO. 16 OF 38


BY	DATE	NO.	REVISION	BY	DATE
MADE	Y.C.P.	12-26-68	Shoe SPI	TEM	3-76
CHECKED	J.D.	1-22-69	Rev Elevations	SSS	12-75
IN CHARGE					

FOOTING PLAN
 Scale: 1/8" = 1'-0"

RICHMOND EXPRESSWAY SYSTEM			
SECTION	PROJECT	SHEET NO.	TOTAL SHEETS
11	DOWNTOWN EXPRESSWAY	17A	97

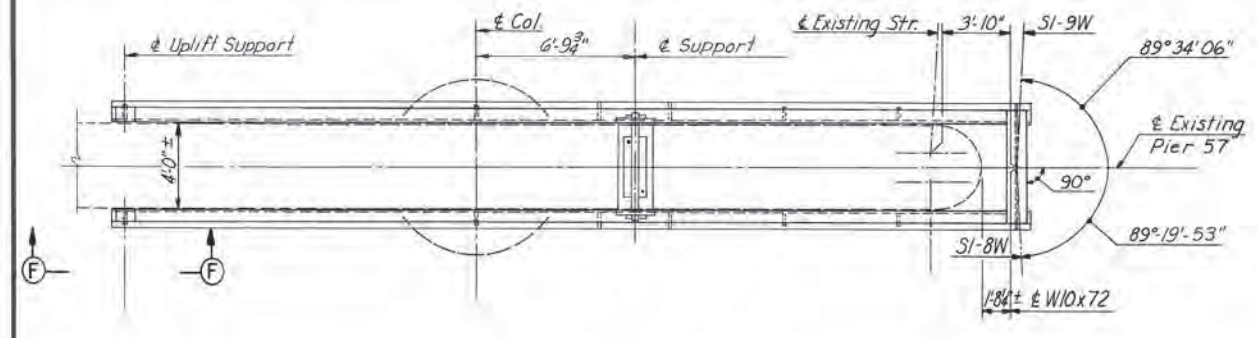


PLAN OF EXISTING PIER 57
Scale: 1/4"=1'-0"

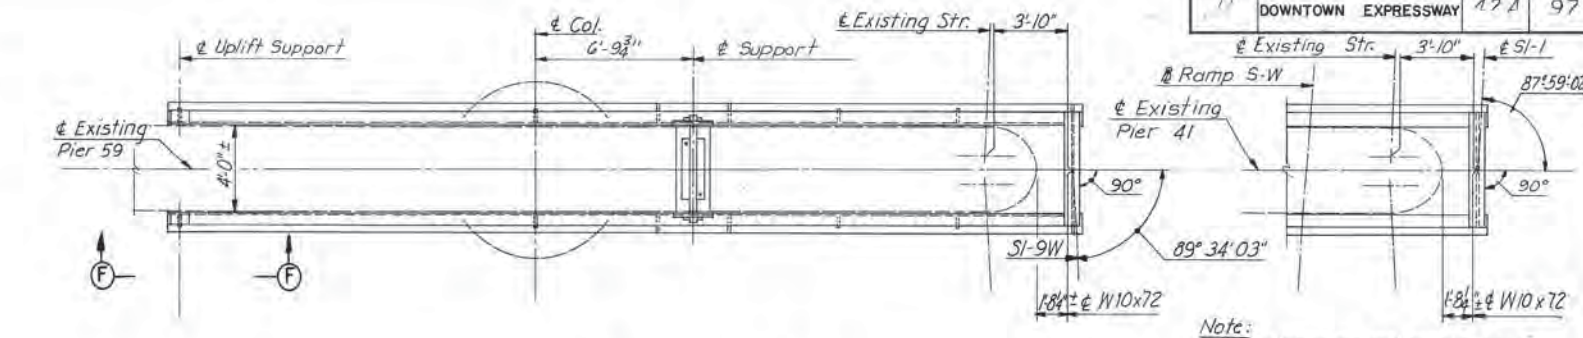


PLAN OF EXISTING PIER 59
Scale: 1/4"=1'-0"

PARTIAL PLAN OF EXISTING PIER 41
Scale: 1/4"=1'-0"


Note:
For dimensions not shown, see Plan of Pier 59.

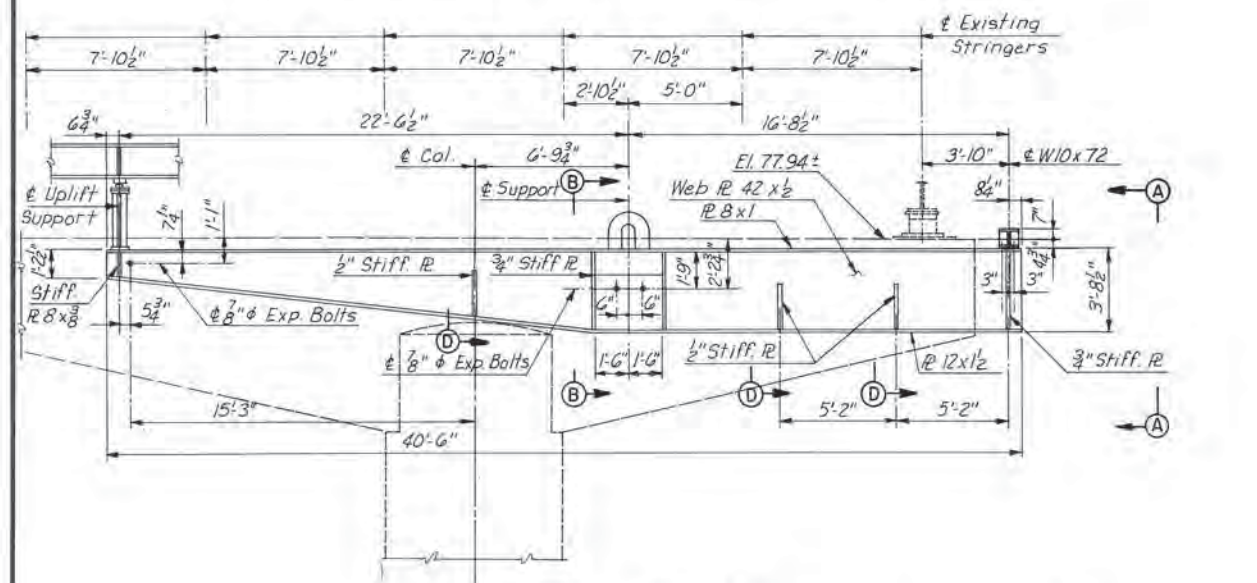


ELEVATION OF EXISTING PIER 57
Scale: 1/4"=1'-0"

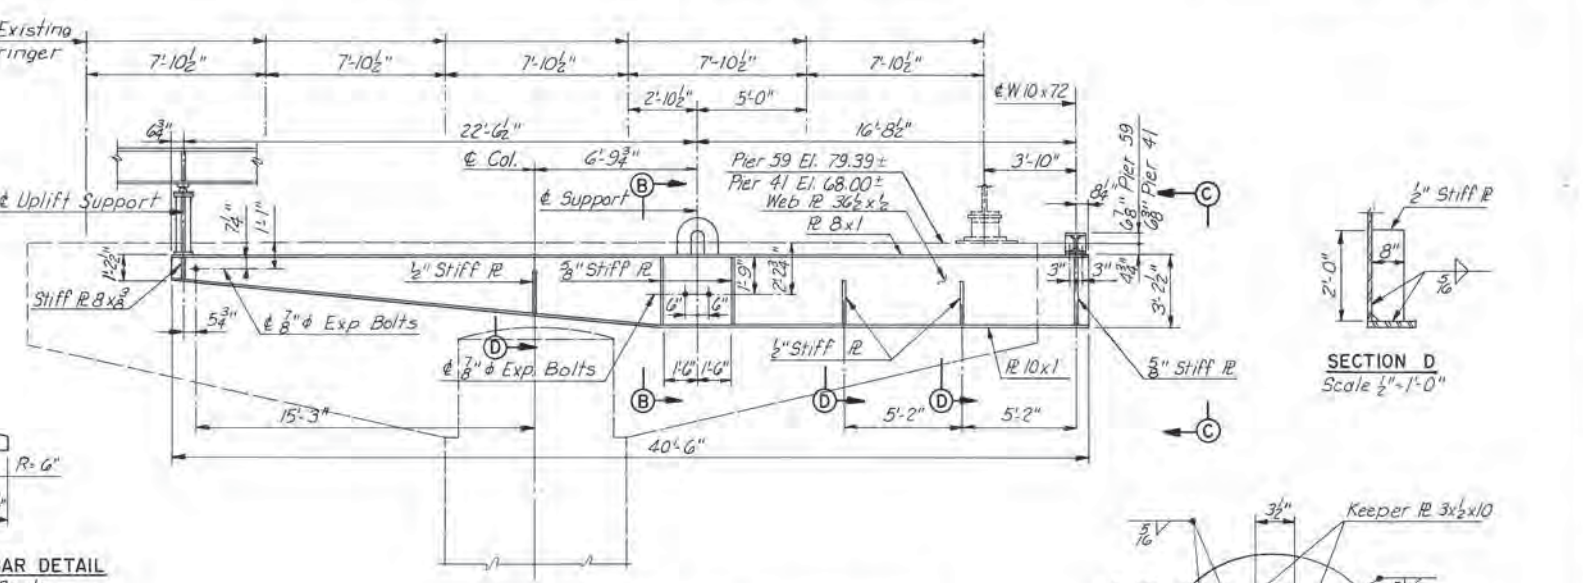


ELEVATION OF EXISTING PIERS 59 & 41
Scale: 1/4"=1'-0"

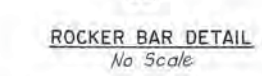


ROCKER BAR DETAIL
No Scale

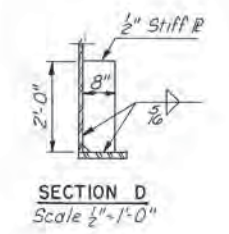


SECTION D
Scale: 1/2"=1'-0"

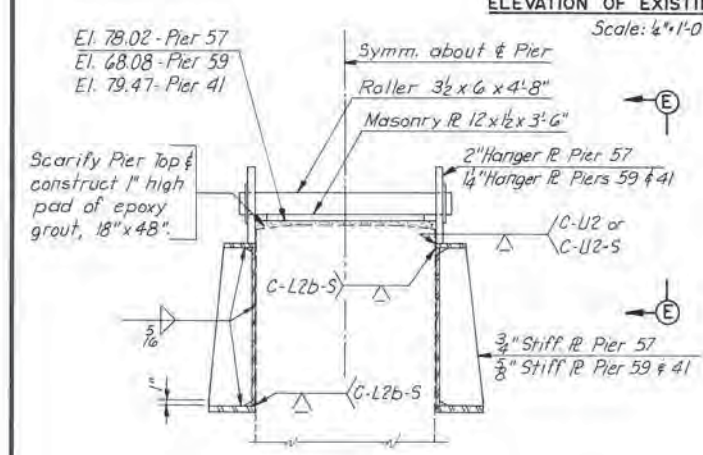


SECTION B-B
Scale: 1/2"=1'-0"

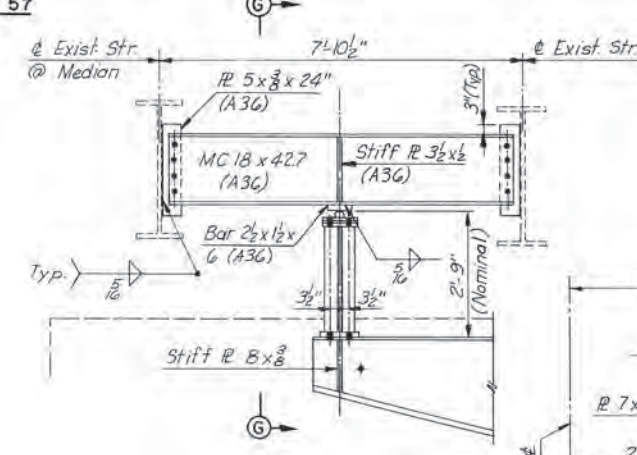


VIEW F-F
Scale: 1/2"=1'-0"

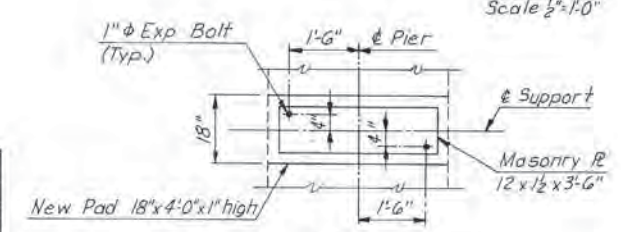


PAD PLAN
Scale: 1/2"=1'-0"

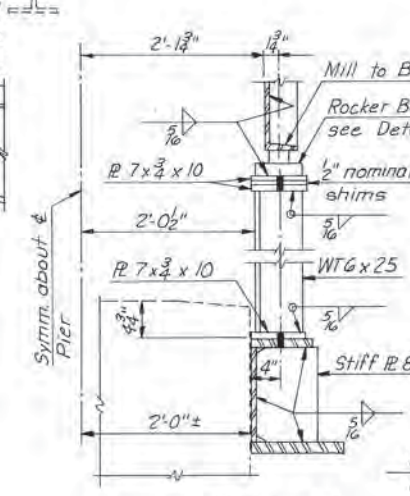

SECTION G-G
Scale: 1"=1'-0"

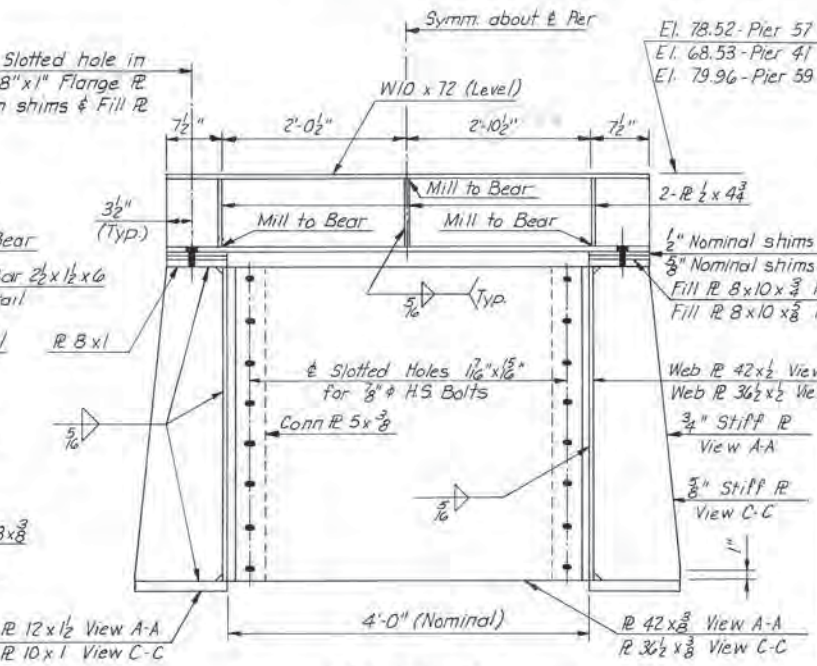

VIEW A-A & C-C
Scale: 1"=1'-0"

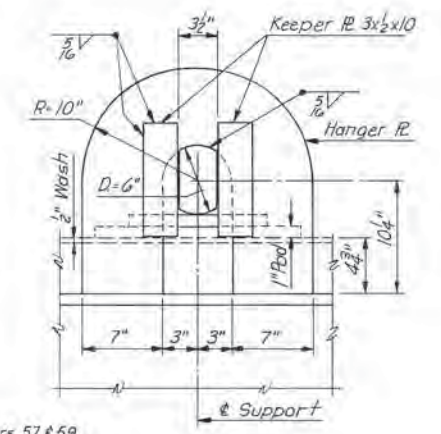

VIEW E-E
Scale: 1/2"=1'-0"

NOTE:
Structural steel shall be A588 except as noted.

RICHMOND METROPOLITAN AUTHORITY
RICHMOND EXPRESSWAY SYSTEM
DOWNTOWN EXPRESSWAY

BRIDGE NO. 65
RAMP S-W CONNECTION TO
RICHMOND-PETERSBURG TURNPIKE
EXISTING PIERS 41, 57 & 59 MODIFICATIONS


SCALE As Noted SHEET 17A OF 38

HOWARD, NEEDLES, TAMMEN & BERGENDOFF
CONSULTING ENGINEERS
Alexandria, Virginia **HNTB**



DESIGNED	DATE	BY	REVISION	DATE
EJM/BJP	8-11-75	BJP	Entire Sheet	TEM 10-76
PRY	10-14-76	BJP	Elev. and Dim.	TEM 9-875
PRY	10-14-76	BJP	New Sheet added	d, B.P. 8-25-75
IN CHARGE P.R.Y.	NO.	REVISION	BY	DATE

42A

RICHMOND EXPRESSWAY SYSTEM			
SECTION	PROJECT	SHEET NO.	TOTAL SHEETS
10	DOWNTOWN EXPRESSWAY	127	265

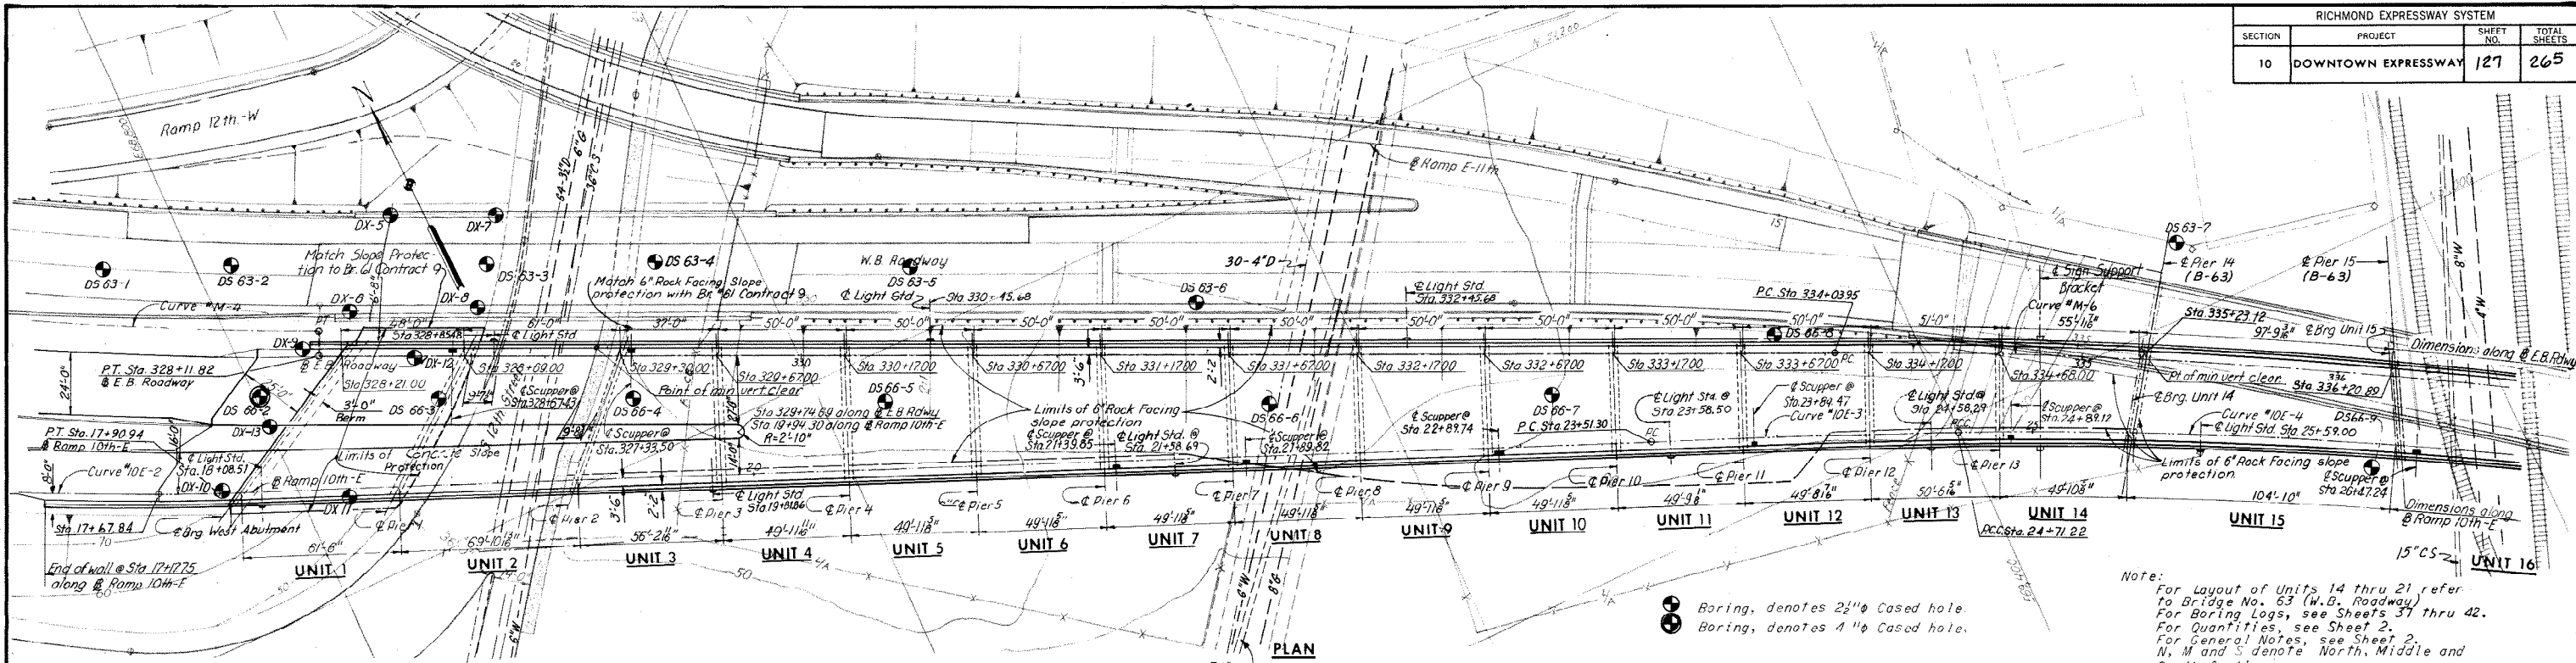


Note:
 For Layout of Units 14 thru 21 refer to Bridge No. 63 (W.B. Roadway)
 For Boring Logs, see Sheets 37 thru 42.
 For Quantities, see Sheet 2.
 For General Notes, see Sheet 2.
 N, M and S denote North, Middle and South footing.

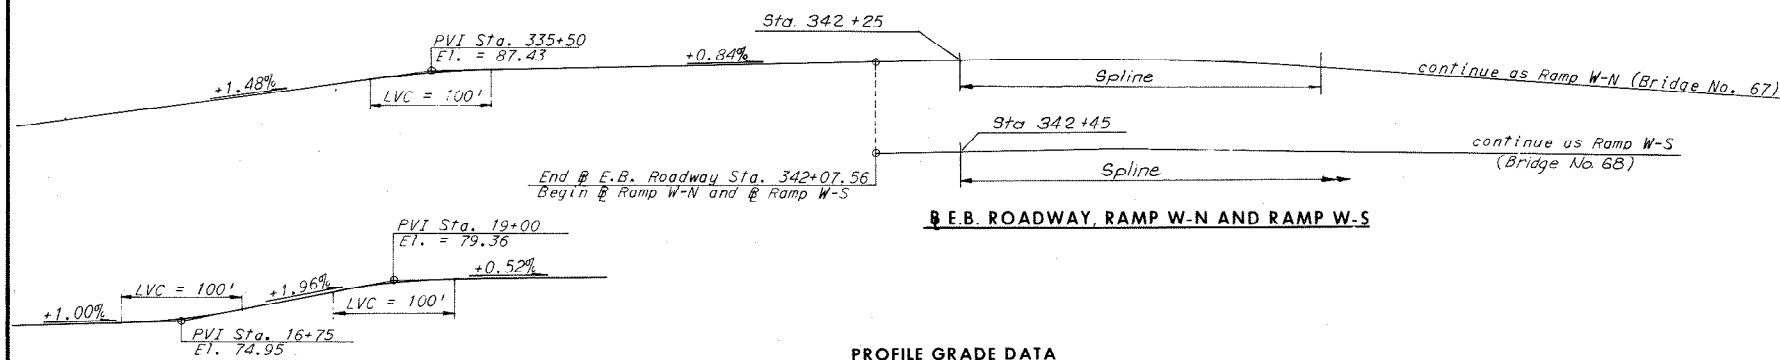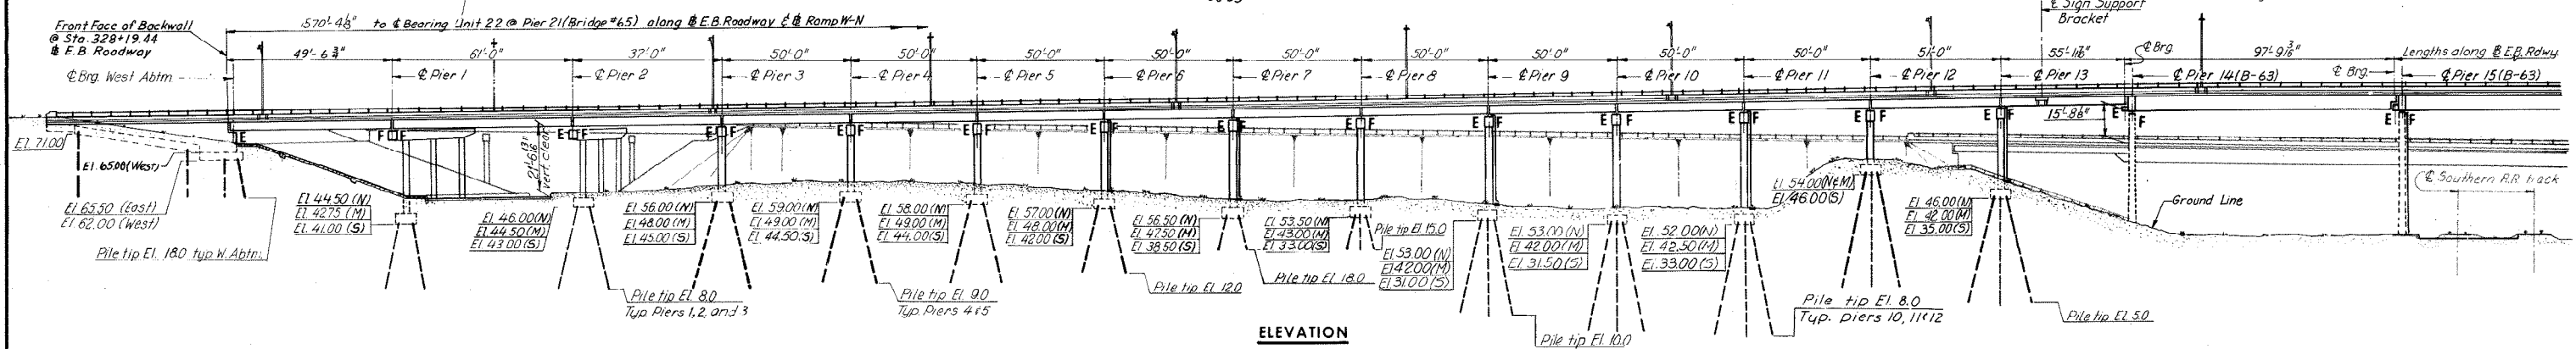

RAMP 10TH-E			
NO.	REVISION	BY	DATE
3	As Built	TEM	8-76
	Sign Support Bracket & Sta. 16A & 20A added	R.B.H.	9-74
	Footing elev. & piles, Piers 8 & 9, 10, 11, 12 & 13	R.B.H.	8-74

HORIZONTAL CURVE DATA		
Curve	P.I.	Curve
Downtown Expressway Curve M-4	P.I. = 326+57.21 Δ = 12°25'03" D = 4'00" T = 155.83' L = 310.44' R = 1,432.40'	E.B. Roadway Curve M-6 P.I. = 336+40.09 Δ = 11°45'56" D = 2'30" T = 236.14' L = 470.62' R = 2,291.83'
Ramp 10th-E Curve 10E-2	P.I. = 17+35.87 Δ = 6°29'42" D = 6'00" T = 54.18' L = 108.25' R = 954.93'	Ramp W-N Curve WN-1 P.I. = 345+25.47 Δ = 64°53'49" D = 11°27'33" T = 317.90' L = 566.33' R = 500.00'
	Ramp W-S Curve 10E-3 P.I. = 24+11.27 Δ = 1°11'57" D = 1'00" T = 59.97' L = 119.93' R = 5,729.58'	

INDEX	SHEET
GENERAL PLAN AND ELEVATION	1
GENERAL PLAN AND ELEVATION	2
WEST ABUTMENT	3
WEST ABUTMENT DETAILS	4
WEST ABUTMENT RETAINING WALL	5
PIER 1	6
PIER 2	7
PIERS 3 AND 4	8
PIERS 5 AND 6	9
PIERS 7 AND 8	10
PIERS 9 AND 10	11
PIERS 11 AND 12	12
PIER 13	13
FRAMING PLAN UNITS 1, 2, 3 AND 4	14
FRAMING PLAN UNITS 5, 6, 7, 8 AND 9	15
FRAMING PLAN UNITS 10, 11, 12, 13 AND 14	16
FRAMING PLAN UNITS 15 AND 16	17
FRAMING PLAN UNITS 17 AND 18	18
FRAMING PLAN UNITS 19 AND 20	19
FRAMING PLAN UNITS 21 AND 22	20
FRAMING PLAN UNIT 23	21
FRAMING DETAILS PIERS 14, 15 AND 16	22
FRAMING DETAILS PIERS 17, 18, 19 AND 20	23
FRAMING DETAILS PIER 21	24
FRAMING DETAILS PIER 22 (BR 63)	25
FRAMING DETAILS UNITS 21 AND 22	26
FRAMING DETAILS UNITS 18, 21 AND 22	27
DECK PLAN UNITS 1, 2, 3 AND 4	28
DECK PLAN UNITS 5, 6, 7, 8 AND 9	29
DECK PLAN UNITS 10, 11, 12, 13 AND 14	30
DECK PLAN UNITS 15 AND 16	31
DECK PLAN UNITS 17 AND 18	32
DECK PLAN UNITS 19 AND 20	33
DECK PLAN UNITS 21 AND 22	34
DECK PLAN UNIT 23	35
SUBSTRUCTURE DETAILS	36
JOINT DETAILS	37 AND 38
APPROACH SLAB AND ROCK FACING SLOPE PROTECTION	39
CONCRETE SLAB SLOPE PROTECTION DETAILS	40
BORING LOGS	41 THRU 46
STANDARD DETAILS	51 THRU 57

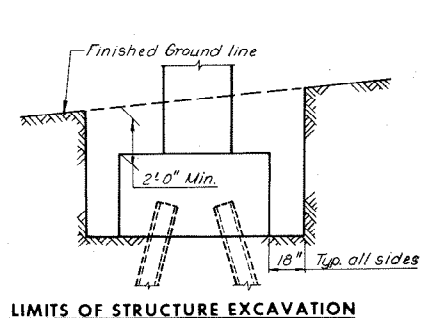


RICHMOND METROPOLITAN AUTHORITY
RICHMOND EXPRESSWAY SYSTEM
DOWNTOWN EXPRESSWAY

BRIDGE NO. 66
EASTBOUND ROADWAY OVER
12TH ST. - R.R. TRACKS AND 16TH ST.
GENERAL PLAN AND ELEVATION

HOWARD, NEEDLES, TAMMEN & BERGENDOFF
 consulting engineers
 NEW YORK ALEXANDRIA KANSAS CITY

SCALE: 1"=30'
 CONTRACT NO: 10
 SHEET NO: 1 OF 46

RICHMOND EXPRESSWAY SYSTEM			
SECTION	PROJECT	SHEET NO.	TOTAL SHEETS
10	DOWNTOWN EXPRESSWAY	128	265

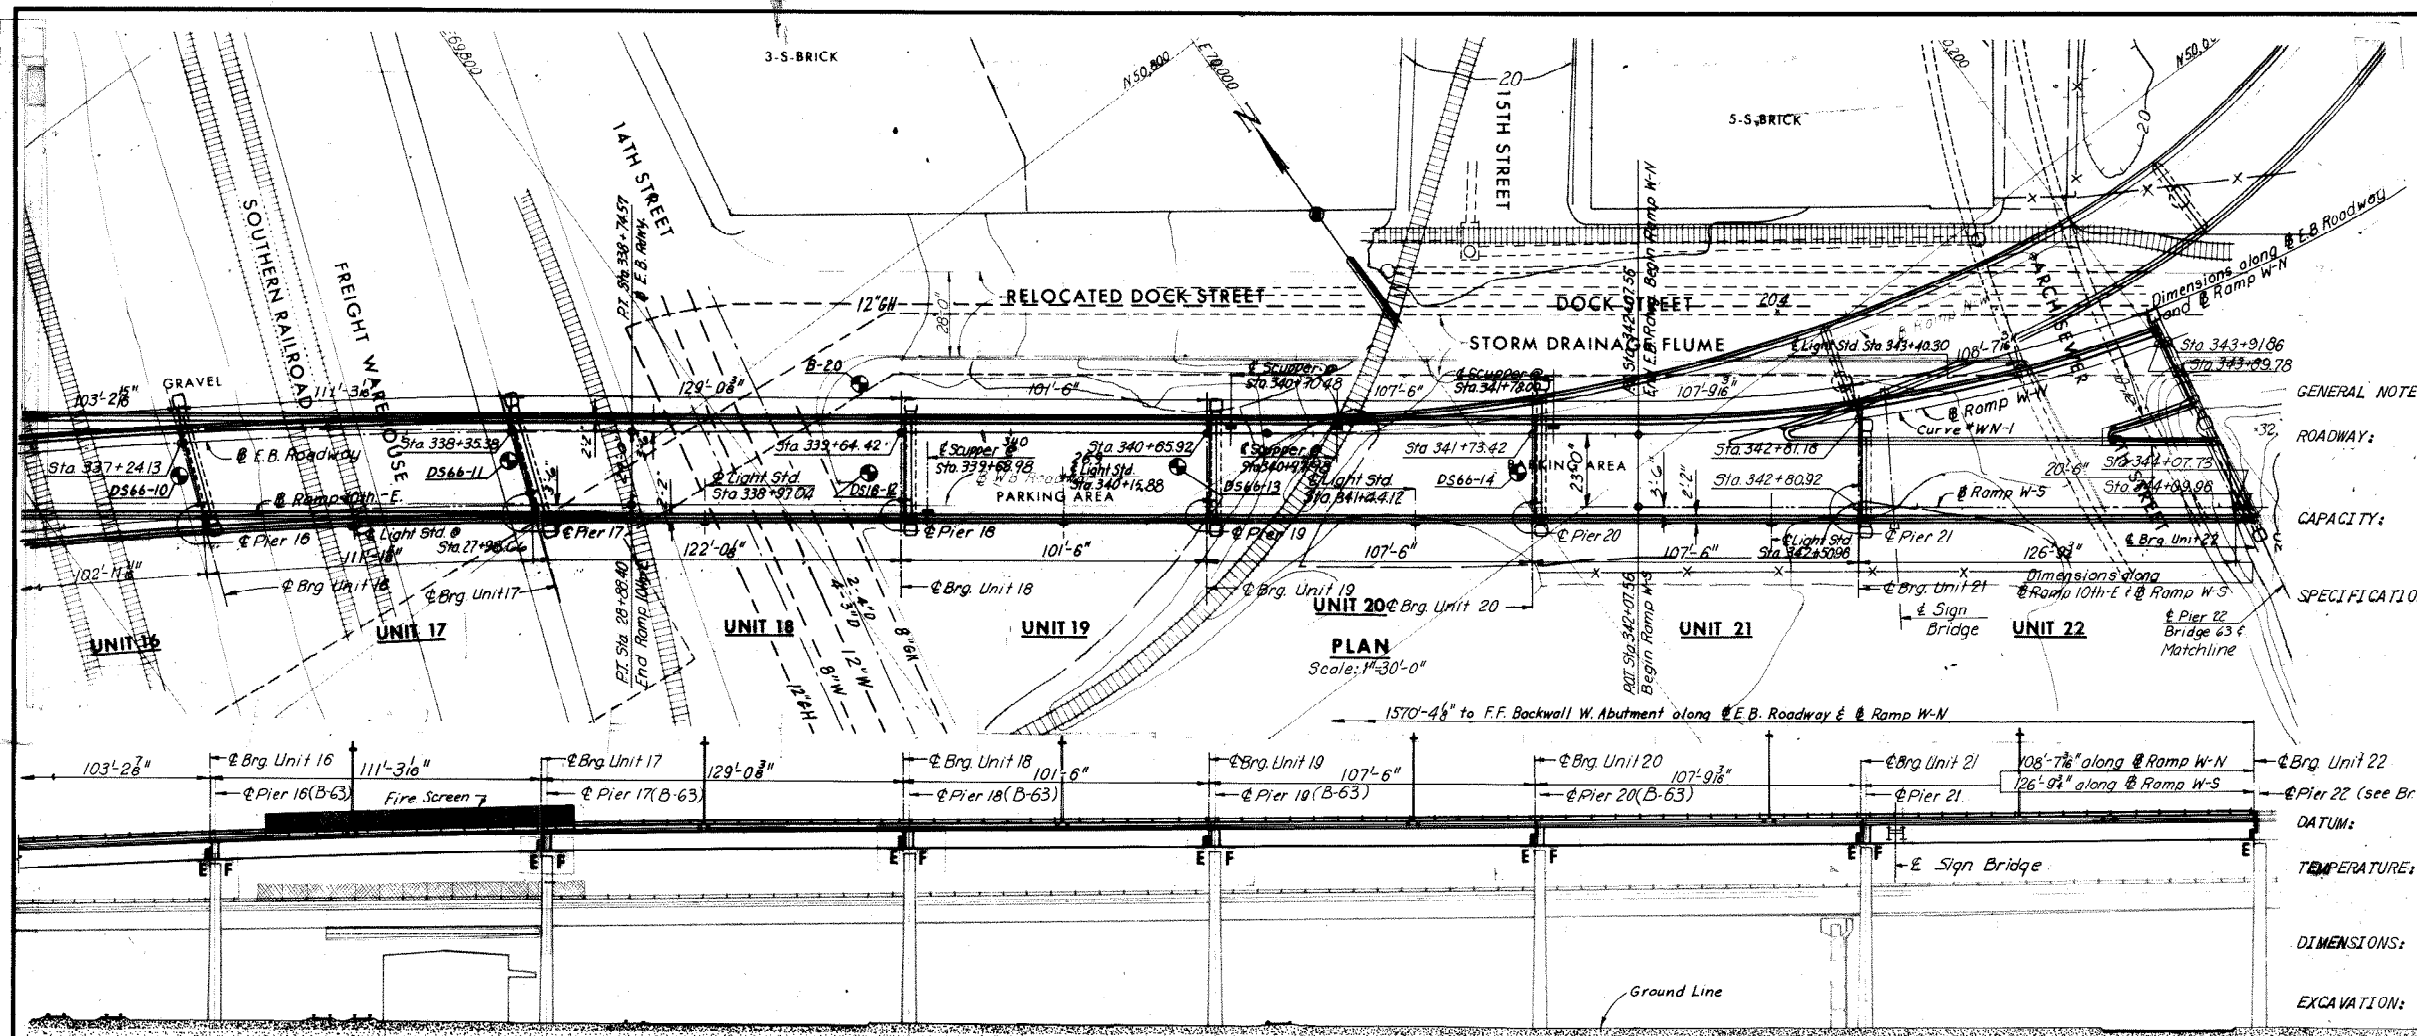

GENERAL NOTES:

ROADWAY: One variable width roadway transitioning from E.B. Roadway Downtown Expressway and Ramp 10th-E into Ramps W-N and W-S (Bridges No. 67 and 68)

CAPACITY: Dead load includes 15 Lbs. per sq. ft. for future wearing surface. Live load, HS 20-44 loading and alternate military loading.

SPECIFICATIONS:

GENERAL: Virginia Department of Highway Road and Bridge Specifications 1970

DESIGN: A.A.S.H.O. Standard Specifications for Highway Bridges 1975 modified by Special Design provisions.

WELDING: 1942 Structural Welding Code of the American Welding Society

CONTRACT SPECIAL PROVISIONS Specifications and Contract Special Provisions referred to above are necessary to make these plans complete

DATUM: City of Richmond

TEMPERATURE: The normal temperature referred to in the plans is 60°F. The temperature range for movement is 0°F to 120°F.

DIMENSIONS: All dimensions are measured horizontally and vertically unless otherwise noted.


EXCAVATION: Excavation below subgrade and cut slope template shall be classified as Structure Excavation. All excavation above these limits shall be classified as Regular Excavation and is not included in the Structural Quantities.

FOUNDATIONS: Footings shall rest on firm material. Foundation material shall be dry and special attention is called to Section 401.05 of General Specifications and to the Contract Special Provisions, concerning preparation of foundations for footings.

CONCRETE NOTES: Concrete in superstructure shall be Class A-4. All other concrete shall be Class A-3. All exposed edges and corners shall have a 3" chamfer or fillet unless otherwise noted. Care in the method of vibration, the use of low-slump concrete, and or other means shall be employed to prevent downgrade movement of newly placed slab concrete. Finishing Concrete Surfaces: See Standard Architectural Detail Sheets and the Contract Special Provisions for types and details. All reinforcing steel shall be deformed bars conforming to ASTM A615 Grade 40. All reinforcing bar dimensions on the detailed drawings are to centers of bars unless otherwise noted. Clear distance between reinforcing steel and face of concrete shall be as noted on the plans. All bar laps shall be 30 diameters of the smaller diameter bar unless otherwise noted.

STEEL NOTES: Structural steel shall conform to A.S.T.M. Designations A36, A572 - Grade 50 and A588 as noted. See Special Provisions. All field connections shall be made with high strength bolts. High strength bolts shall be 8" diameter unless otherwise noted and shall conform to A.S.T.M. Specification A-325.

ELEVATION
Scale: 1"=30'-0"

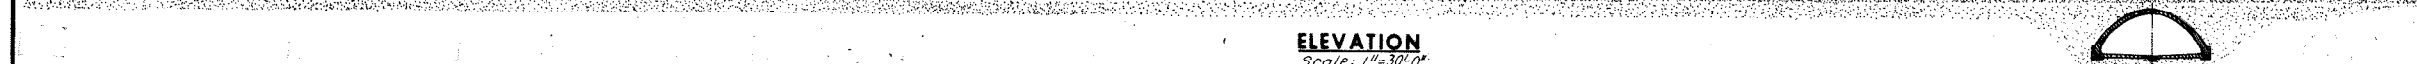



Notes:
For Vertical and Horizontal Curve Data see Sheet 1.
For Layout of Units 14 thru 22 refer to Bridge No. 63 (Westbound Roadway).

ESTIMATED QUANTITIES

	Structure Excavation	Concrete (#)	Reinforcing Steel	Str. Steel Mild Carbon	Str. Steel High Strength	Aluminum Railing (1-Rail)	Porous Backfill	Underdrain	Steel Piles
	Cu. Yds.	Cu. Yds.	Lbs.	Lbs.	Lbs.	Lin. Ft.	Cu. Yds.	Lin. Ft.	Lin. Ft.
Superstructure	--	2,237.6	530,860	1,564,700	567,800	3,241	--	--	---
Substructure	1,835	1,256.6	155,030	---	---	84	34	150	9,410
Total	1,835	3,494.2 †	685,890	1,564,700	567,800	3,325	34	150	9,410

	Asphalt Damp-proofing	Approach Slab Concrete (#)	Fire Screen	Approach Slab Reinforcing Steel	Metal Conduit	Concrete Slope Protection	Bridge Drainage Metal Work	Rock Facing Slope Prot.	Energy Attenuator B-Unit
	Sq. Yds.	Cu. Yds.	Lin. Ft.	(Lbs.)	Lin. Ft.	Sq. Yds.	Lbs.	Sq. Yds.	Each
Superstructure	--	--	210	---	2,214	--	11,870	--	1
Substructure	105	91.5	---	23,870	92	559	--	3,320	---
Total	105	91.5 †	210	23,870	2,306	559	11,870	3,320	1

† All Concrete for Superstructure shall be Class A4 and for Substructure Class A3.

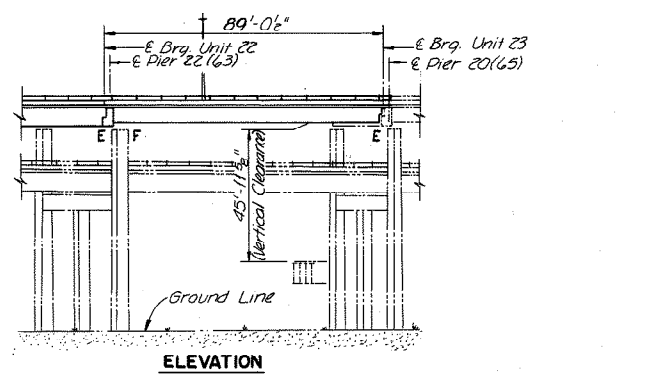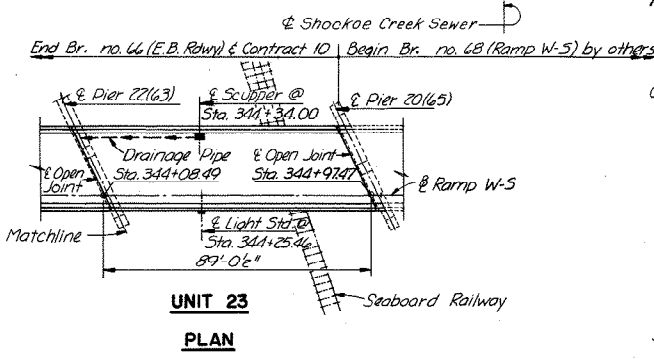

BY	DATE	REVISION	BY	DATE
MADE	J.V. 1-9-69	As Built	PRMS	4-19-74
CHECKED	G.C.C. 5-26-69	As Built	TEM	8-74
IN CHARGE				







RICHMOND METROPOLITAN AUTHORITY
RICHMOND EXPRESSWAY SYSTEM
DOWNTOWN EXPRESSWAY

BRIDGE NO. 66
EASTBOUND ROADWAY OVER
12TH ST. - R.R. TRACKS AND 16TH ST.
GENERAL PLAN AND ELEVATION

HOWARD, NEEDLES, TAMMEN & BERGENDOFF
consulting engineers
NEW YORK ALEXANDRIA KANSAS CITY

SCALE: As Noted
CONTRACT NO: 10
SHEET NO. 2 OF 46



AS BUILT

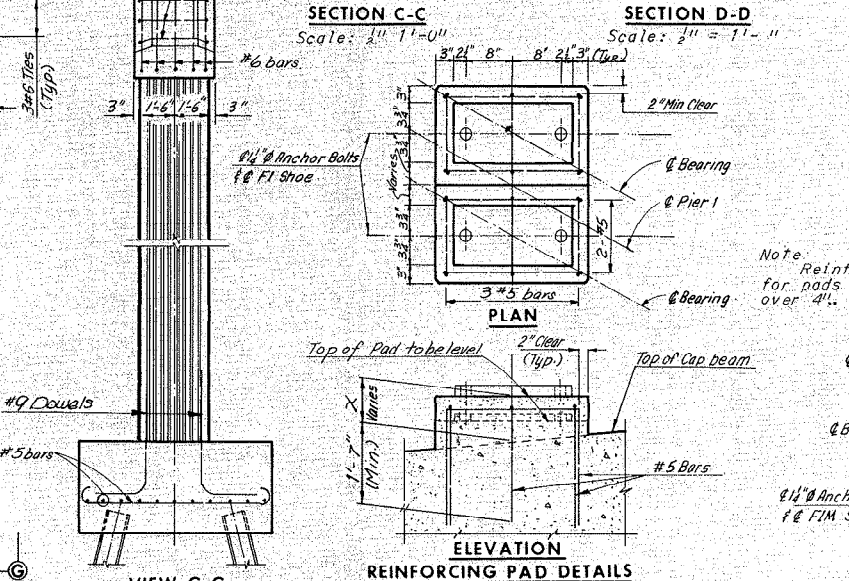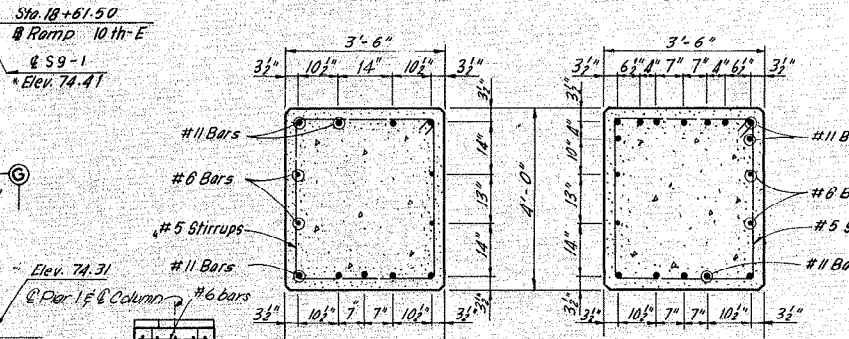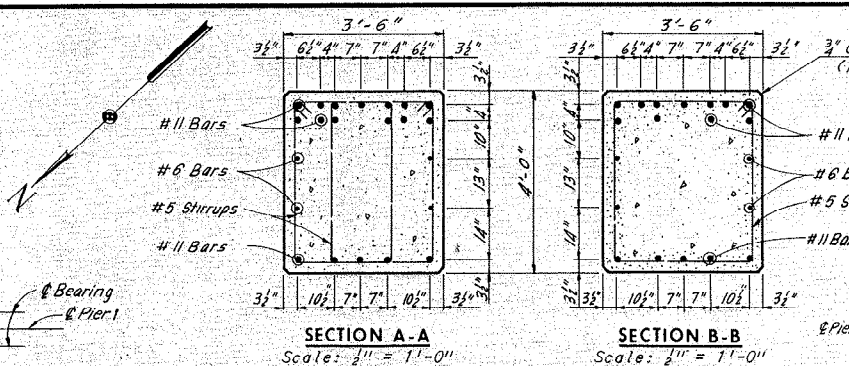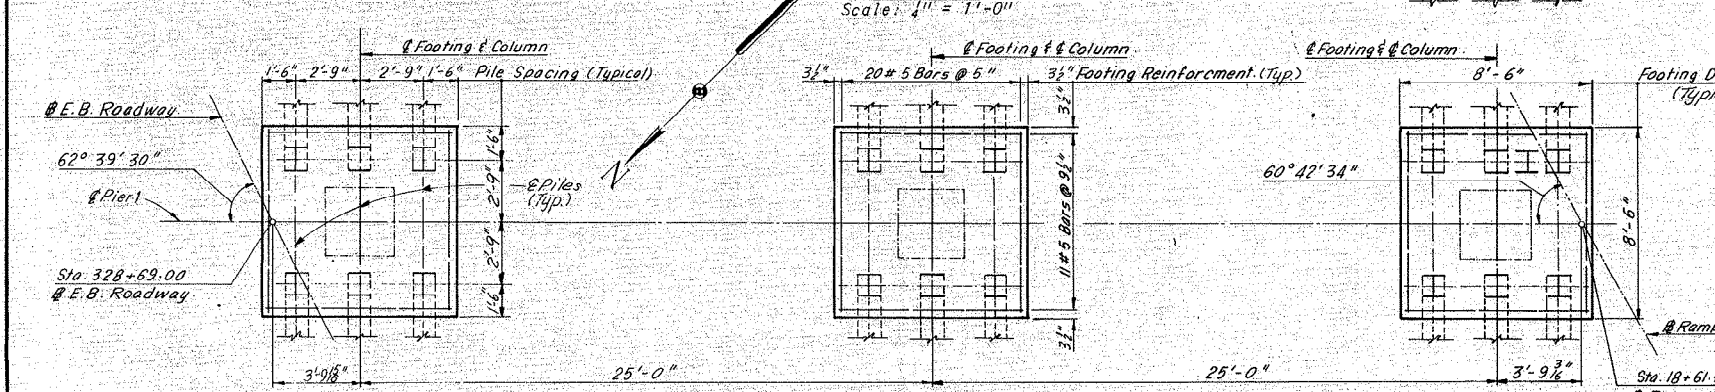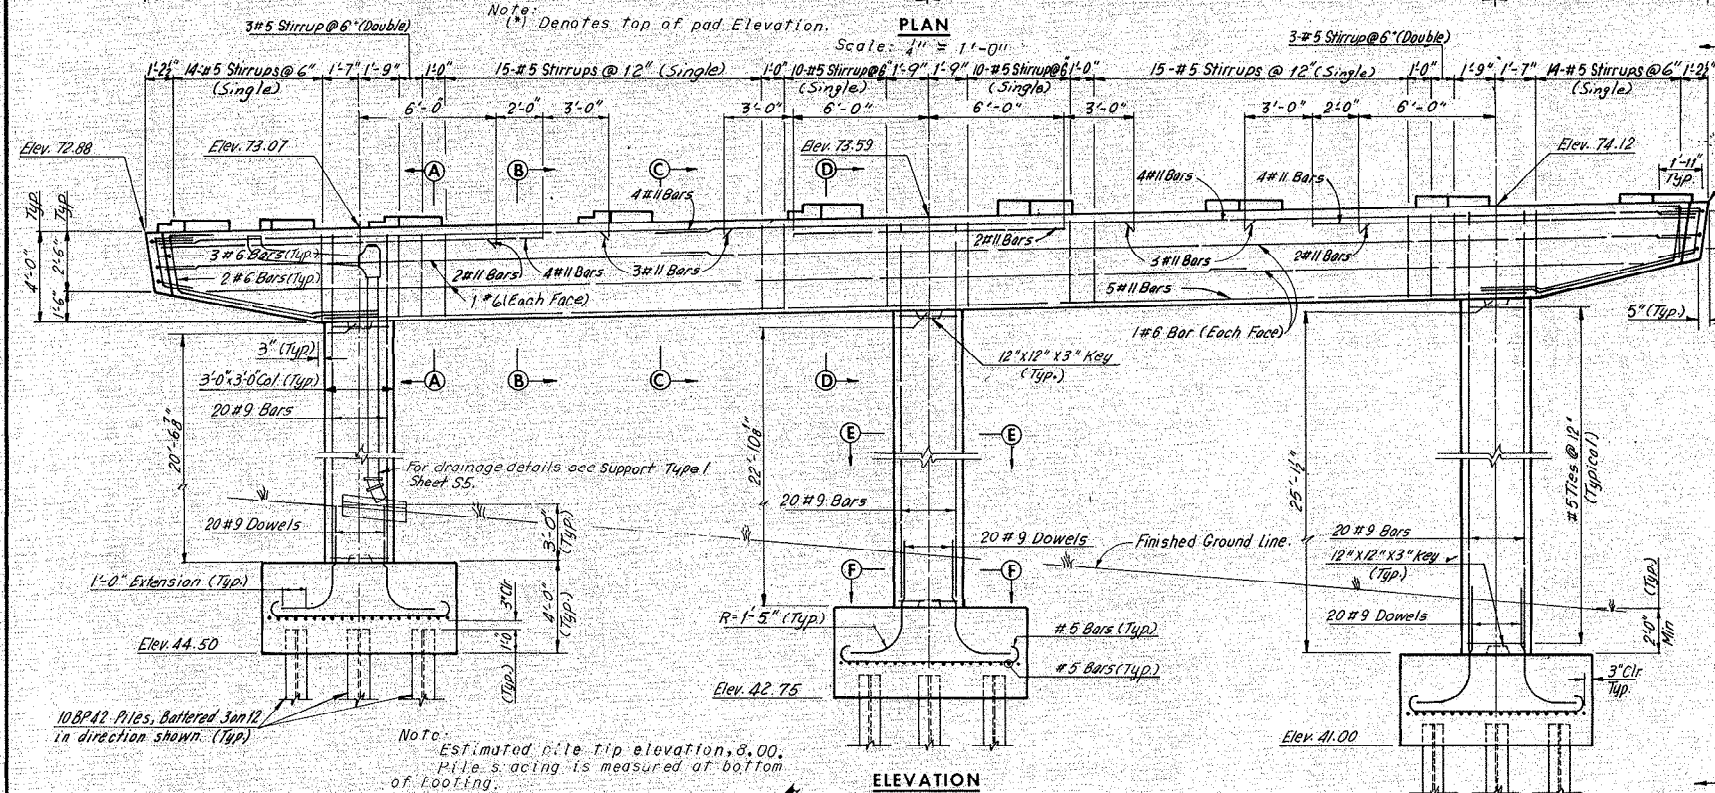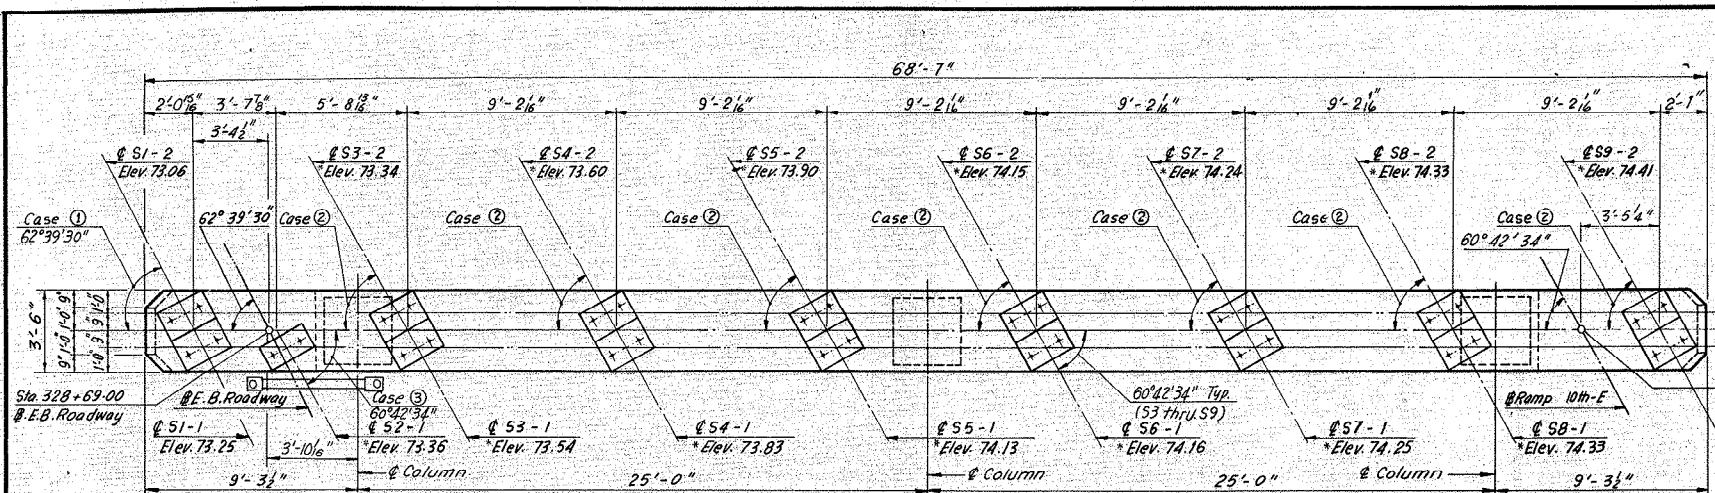

ANCHOR BOLT SETTING PLAN DIMENSIONS

Case	Angle W	A	B	C	D	E	F	G	H	I	J	K	L	M
1	62° 39' 30"	19 1/2	12	4 1/2	4 1/2	11 1/2	2 1/2	6 1/2	5 1/2	12 1/2	8 1/2	21 1/2	6 1/2	33 1/2
2	60° 42' 34"	20 1/2	11 1/2	5 1/2	3 1/2	12 1/2	1 1/2	6 1/2	5 1/2	12 1/2	8 1/2	21 1/2	6 1/2	34 1/2

Dimensions are in inches.

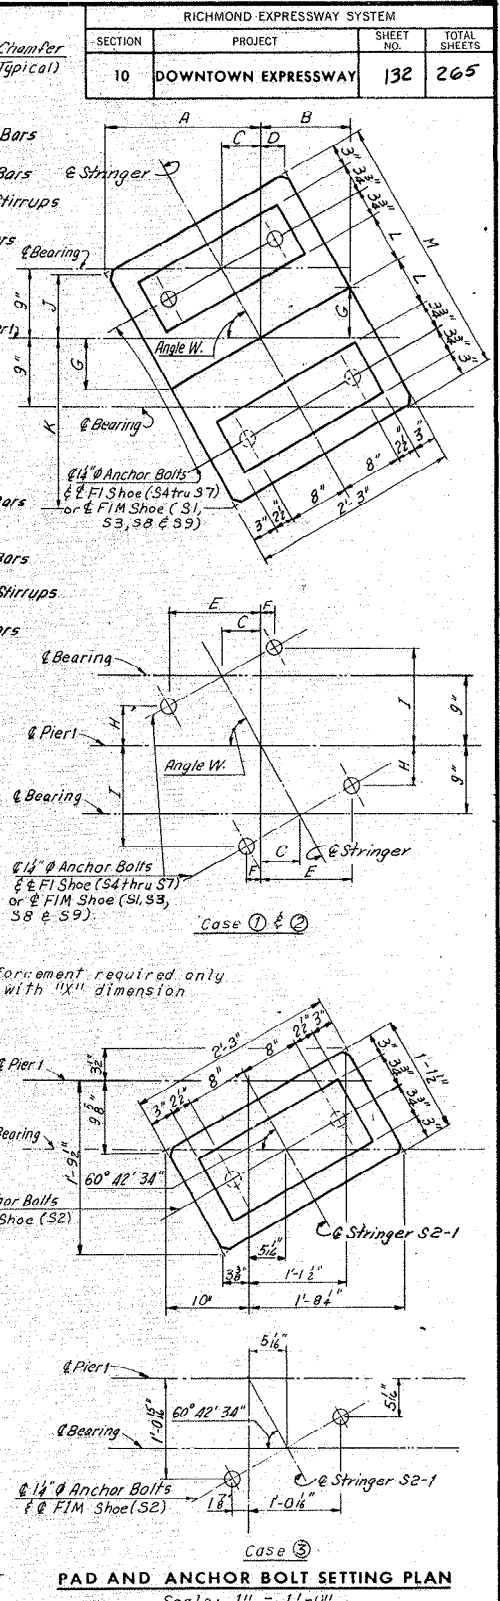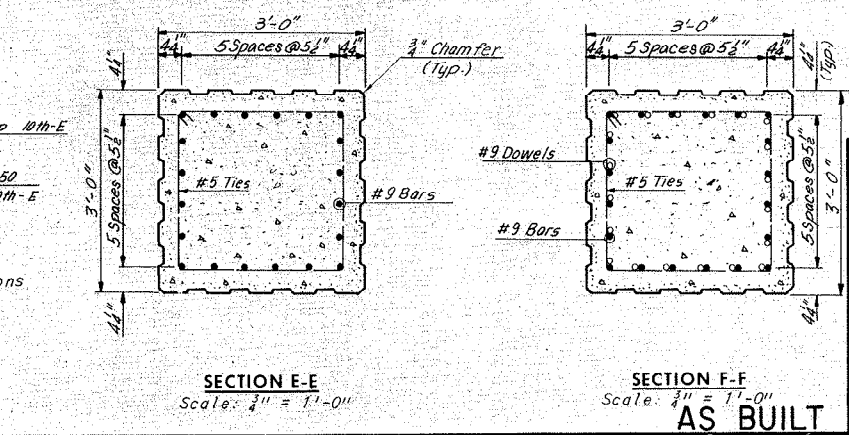

Note: Footing elevations are approximate only and may be varied to suit field conditions as directed by the Engineer. Vertical shaft reinforcing shall not be cut until these elevations are established. Where elevations change more than 2 ft., redesign will be required.

Note: All piles shall be 10BP42 Steel Piles (Design capacity = 45 tons). Buffer all piles 3" per foot where shown. For Standard Shoe details, see Sheet 9 S1 and S2. For Framing Plan, see Sheet 14. For Steel Pile Details, See Sheet 11.

RICHMOND METROPOLITAN AUTHORITY
 RICHMOND EXPRESSWAY SYSTEM
 DOWNTOWN EXPRESSWAY




BRIDGE NO. 66
 EASTBOUND ROADWAY OVER
 12TH ST. - R.R. TRACKS AND 16TH ST.

PIER 1

HOWARD, NEEDLES, TAMMEN & BERGENDOFF
 consulting engineers
 NEW YORK ALEXANDRIA KANSAS CITY

SCALE: As Noted
 CONTRACT NO. 10
 SHEET NO. 6 OF 46


BY	DATE	NO.	REVISION	BY	DATE
MAR	7-31-68	2	As Built	JEM	8-76
CHECKED	RLM	8-15-68	Dimensions	RWZ	10-74
IN CHARGE					

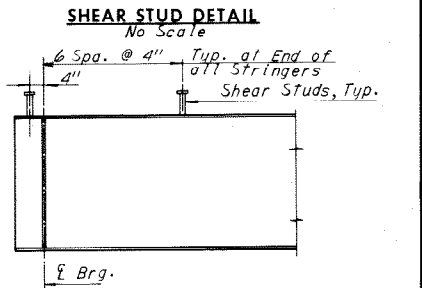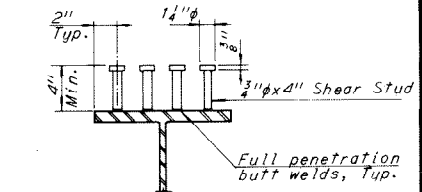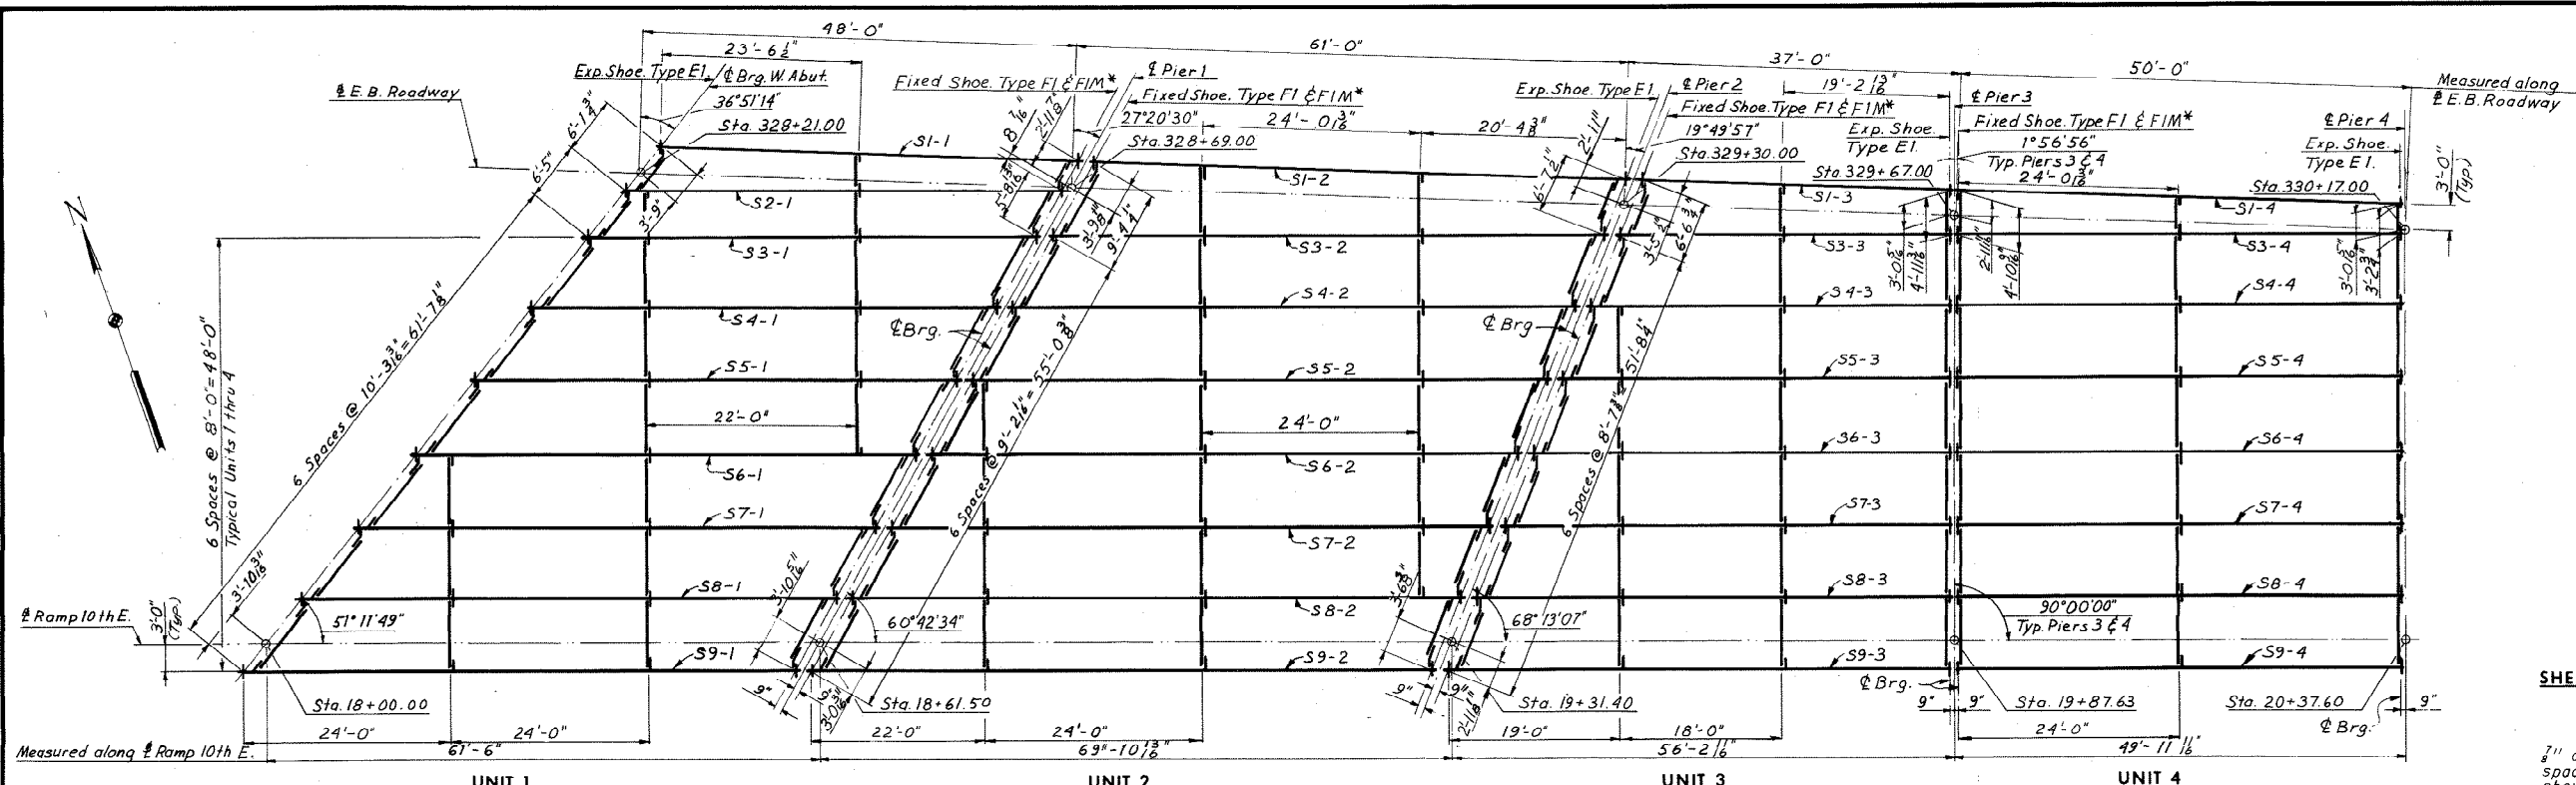

SHEAR STUD NOTE
 Capacity = 3,400 lbs. per stud.
 Contractor may, if he elects, use three 3/4" diameter studs at the same longitudinal spacing in lieu of the four 3/4" diameter studs shown.
 Stud rows shall be placed parallel to the main deck reinforcement.


FRAMING PLAN
 Scale: 1" = 10'-0"

UNIT	STRINGER	STRINGER SIZE	STRINGER SCHEDULE						DEAD LOAD DEFLECTION SCHEDULE					CAMBER SCHEDULE					
			Dim. "A"	LENGTH	Dim. "B"	Dim. "C"	Dim. "D"	PL. "D"	MAX. SHEAR STUD SPACING					1/4L	1/2L	3/4L			
									0.0L-0.1L	0.1L-0.2L	0.2L-0.3L	0.3L-0.4L	0.4L-0.5L						
1	S1-1	33 WF 118	48'-6 1/2"	46'-5 1/2"	1'-4 1/2"	9"	0	0	13"	14 1/2"	17"	20 1/2"	24"	4"	3"	4"	5"	6"	5"
	S2-1	33 WF 118	50'-6 1/2"	48'-5 1/2"	1'-4 1/2"	8"	0	0	12 1/2"	13 1/2"	16"	19"	23 1/2"	3"	2"	3"	4"	5"	4"
	S3-1	33 WF 118	51'-9 1/2"	49'-8 3/4"	1'-4 1/2"	8"	0	0	9"	10"	11 1/2"	13 1/2"	16 1/2"	3"	2"	3"	4"	5"	4"
	S4-1	33 WF 118	53'-8 1/2"	51'-7 1/2"	1'-4 1/2"	8"	19'-0"	10x2 1/2"	7 1/2"	8"	10"	11 1/2"	14"	3"	2"	3"	4"	5"	4"
	S5-1	33 WF 118	55'-7 1/2"	53'-7 1/2"	1'-4 1/2"	8"	21'-0"	10x2 1/2"	7 1/2"	8"	10"	11 1/2"	14"	3"	2"	3"	4"	5"	4"
	S6-1	36 WF 135	57'-7 1/2"	55'-6 1/2"	1'-4 1/2"	8"	21'-0"	10 1/2 x 8"	8"	8 1/2"	10 1/2"	12 1/2"	15"	3"	2"	3"	4"	5"	4"
	S7-1	36 WF 135	59'-6 1/2"	57'-5 1/2"	1'-4 1/2"	8"	21'-6"	10 1/2 x 8"	8"	8 1/2"	10 1/2"	12 1/2"	15"	3"	2"	3"	4"	5"	4"
	S8-1	36 WF 135	61'-5 1/2"	59'-5 1/2"	1'-4 1/2"	8"	22'-6"	10 1/2 x 8"	8"	8 1/2"	10 1/2"	12 1/2"	15"	3"	2"	3"	4"	5"	4"
	S9-1	36 WF 135	63'-6 1/2"	61'-4 1/2"	1'-4 1/2"	9 3/8"	22'-0"	10 1/2 x 8"	7 1/2"	8 1/2"	9 1/2"	11 1/2"	14 1/2"	3"	2"	3"	4"	5"	4"
2	S1-2	36 WF 135	60'-4 1/2"	58'-10 1/2"	9"	8 1/2"	22'-0"	10 1/2 x 8"	8"	9 1/2"	11 1/2"	13 1/2"	17"	3"	2"	3"	4"	5"	4"
	S3-2	36 WF 135	62'-3 1/2"	60'-11 1/2"	9"	7 3/8"	22'-6"	10 1/2 x 8"	8 1/2"	9 1/2"	11 1/2"	13 1/2"	16 1/2"	3"	2"	3"	4"	5"	4"
	S4-2	36 WF 150	63'-6 1/2"	62'-3 1/2"	8"	7 3/8"	23'-3"	10 1/2 x 8"	8"	8 1/2"	11"	12 1/2"	15 1/2"	3"	2"	3"	4"	5"	4"
	S5-2	36 WF 150	64'-10 1/2"	63'-6 1/2"	8"	7 3/8"	24'-0"	10 1/2 x 8"	8"	8 1/2"	11"	12 1/2"	15 1/2"	3"	2"	3"	4"	5"	4"
	S6-2	36 WF 150	66'-1 1/2"	64'-10 1/2"	8"	7 3/8"	25'-0"	10 1/2 x 8"	8"	8 1/2"	10 1/2"	12 1/2"	15 1/2"	3"	2"	3"	4"	5"	4"
	S7-2	36 WF 150	67'-5 1/2"	66'-1 1/2"	8"	7 3/8"	25'-9"	10 1/2 x 8"	8"	8 1/2"	11"	12 1/2"	15 1/2"	3"	2"	3"	4"	5"	4"
	S8-2	36 WF 150	68'-8 1/2"	67'-5 1/2"	8"	7 3/8"	26'-6"	10 1/2 x 8"	8"	8 1/2"	11"	12 1/2"	15 1/2"	3"	2"	3"	4"	5"	4"
	S9-2	36 WF 150	70'-2 1/2"	68'-8 1/2"	9 3/8"	8 5/8"	27'-0"	10 1/2 x 8"	7 1/2"	8 1/2"	11"	12 1/2"	16 1/2"	3"	2"	3"	4"	5"	4"
	3	S1-3	30 WF 99	35'-7 1/2"	34'-3 1/2"	8 1/2"	8"	0	0	11"	12"	14"	16 1/2"	20 1/2"	3"	2"	3"	4"	5"
S3-3		30 WF 99	37'-1 1/2"	36'-8 1/2"	7 3/8"	7"	0	0	9"	10"	11 1/2"	13 1/2"	16"	3"	2"	3"	4"	5"	4"
S4-3		30 WF 108	41'-1 1/2"	39'-10 3/4"	7 3/8"	7"	0	0	7 1/2"	8"	9"	10 1/2"	13"	3"	2"	3"	4"	5"	4"
S5-3		30 WF 108	44'-3 1/2"	43'-0 1/2"	7 3/8"	7"	15'-0"	9x2 1/2"	7"	7 1/2"	9 1/2"	11"	13"	3"	2"	3"	4"	5"	4"
S6-3		30 WF 108	47'-5 1/2"	46'-3 1/2"	7 3/8"	7"	17'-0"	9x2 1/2"	7"	7 1/2"	9"	11"	13"	3"	2"	3"	4"	5"	4"
S7-3		30 WF 108	50'-8 1/2"	49'-5 1/2"	7 3/8"	7"	19'-3"	9x2 1/2"	7"	7 1/2"	9 1/2"	11"	13"	3"	2"	3"	4"	5"	4"
S8-3		30 WF 108	53'-10 3/8"	52'-8"	7 3/8"	7"	21'-6"	9x1 1/2"	7"	7 1/2"	9 1/2"	11"	13"	3"	2"	3"	4"	5"	4"
S9-3		30 WF 108	57'-3"	55'-10 3/8"	8 3/8"	8"	23'-3"	9x1 1/2"	7"	7 1/2"	9 1/2"	11 1/2"	14"	3"	2"	3"	4"	5"	4"
4		S1-4	30 WF 108	49'-10"	48'-6"	8"	8"	0	0	10 1/2"	11 1/2"	13 1/2"	16 1/2"	20 1/2"	3"	2"	3"	4"	5"
	S3-4	30 WF 99	49'-7 1/2"	48'-5 1/2"	7"	7"	18'-0"	9x2 1/2"	8 1/2"	9 1/2"	11 1/2"	13 1/2"	16"	3"	2"	3"	4"	5"	4"
	S4-4	30 WF 108	49'-7 1/2"	48'-5 1/2"	7"	7"	18'-6"	9x2 1/2"	7"	7 1/2"	9 1/2"	11"	13"	3"	2"	3"	4"	5"	4"
	S5-4	30 WF 108	49'-7 1/2"	48'-5 1/2"	7"	7"	18'-6"	9x2 1/2"	7"	7 1/2"	9 1/2"	11"	13"	3"	2"	3"	4"	5"	4"
	S6-4	30 WF 108	49'-7 1/2"	48'-5 1/2"	7"	7"	18'-6"	9x2 1/2"	7"	7 1/2"	9 1/2"	11"	13"	3"	2"	3"	4"	5"	4"
	S7-4	30 WF 108	49'-7 1/2"	48'-5 1/2"	7"	7"	18'-6"	9x2 1/2"	7"	7 1/2"	9 1/2"	11"	13"	3"	2"	3"	4"	5"	4"
	S8-4	30 WF 108	49'-7 1/2"	48'-5 1/2"	7"	7"	18'-6"	9x2 1/2"	7"	7 1/2"	9 1/2"	11"	13"	3"	2"	3"	4"	5"	4"
	S9-4	30 WF 108	49'-9 1/2"	48'-5 1/2"	8"	8"	19'-0"	9x2 1/2"	7"	8"	9 1/2"	11 1/2"	14"	3"	2"	3"	4"	5"	4"

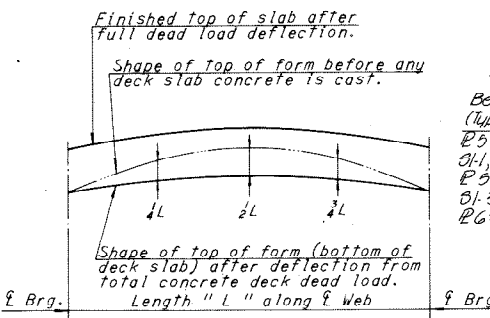


DEAD LOAD DEFLECTION DIAGRAM
 No Scale

NOTE TO CONTRACTOR
 Deflections given are those anticipated to occur in the stringer upon placement of the total concrete deck dead load.
 In practice, the stringers in place are not likely to have the exact camber to compensate for these deflections during construction. The residual amounts shall be provided by adjusting forms to vary the thickness of the concrete haunch between the bottom of the slab and the top of stringer without altering the slab thickness.

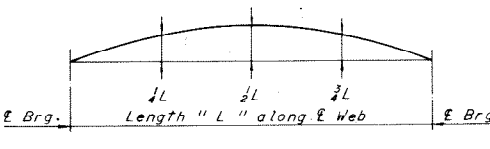


CAMBER DIAGRAM
 No Scale

NOTE TO FABRICATOR
 The stringers shall be fabricated with an upward camber amounting to the tabulated value.
 This will provide approximate compensation for deflection under full dead load and for conformity with finished grade.
 Dimensions are in inches.

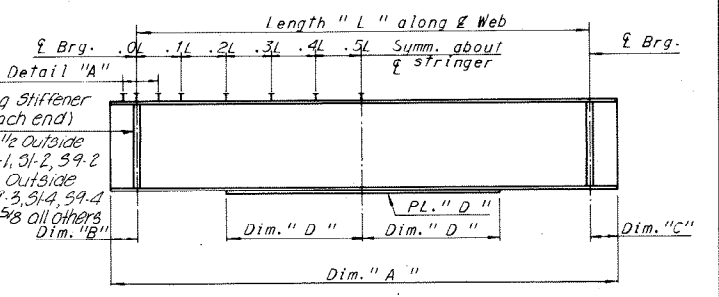

STRINGER ELEVATION
 No Scale

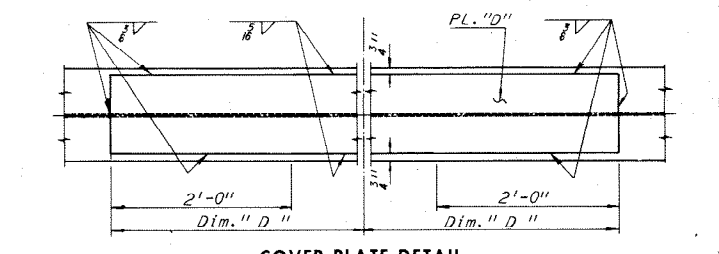

COVER PLATE DETAIL
 No Scale

Note:
 Stringers having a total camber of less than 1" are not required to be shop cambered, but should be turned so that any mill tolerance deviation from straightness will be in the direction shown by the Camber Diagram.
 If stringers are not cambered, distance top of stringers to top of slab will vary along the stringer in accordance with the offset dimensions shown in the Camber Diagram, and with minimum distance as shown in cross-section on Sheet 28.

* Spacing begins at termination of 6 spaces @ 4".
 Note: All steel shall be A36 unless otherwise denoted.

Notes:
 For Diaphragm and Connection Details, see Sheet 26.
 For Joint Details, see Sheet 37.
 For Shoe Details, see Sheets S1 and S2.
 For angles between & Piers and Stringers, see Sheets 3, 6, 7 & 8.
 For Superstructure steel quantities, see Sheet 2.

SHOE SCHEDULE			
EXPANSION SHOES		FIXED SHOES	
TYPE	NO. REQD.	TYPE	NO. REQD.
E1	33	F1	16
		F1M	17

RICHMOND METROPOLITAN AUTHORITY
RICHMOND EXPRESSWAY SYSTEM
DOWNTOWN EXPRESSWAY

BRIDGE NO. 66
EASTBOUND ROADWAY OVER
12TH ST. - R.R. TRACKS AND 16TH ST.


FRAMING PLAN - UNITS 1, 2, 3 AND 4

HOWARD, NEEDLES, TAMMEN & BERGENDOFF
 consulting engineers
 NEW YORK ALEXANDRIA KANSAS CITY

SCALE: 1"=10' Unless as shown
 CONTRACT NO. 10
 SHEET NO. 14 OF 46

BY	DATE	REVISION	BY	DATE
J.D.	8-6-68	2 As Built	TEM	8-7-68
J.Y.	10-22-68	1 Pier 1 & 2 Dim. Change	LBP	10-16-68


AS BUILT

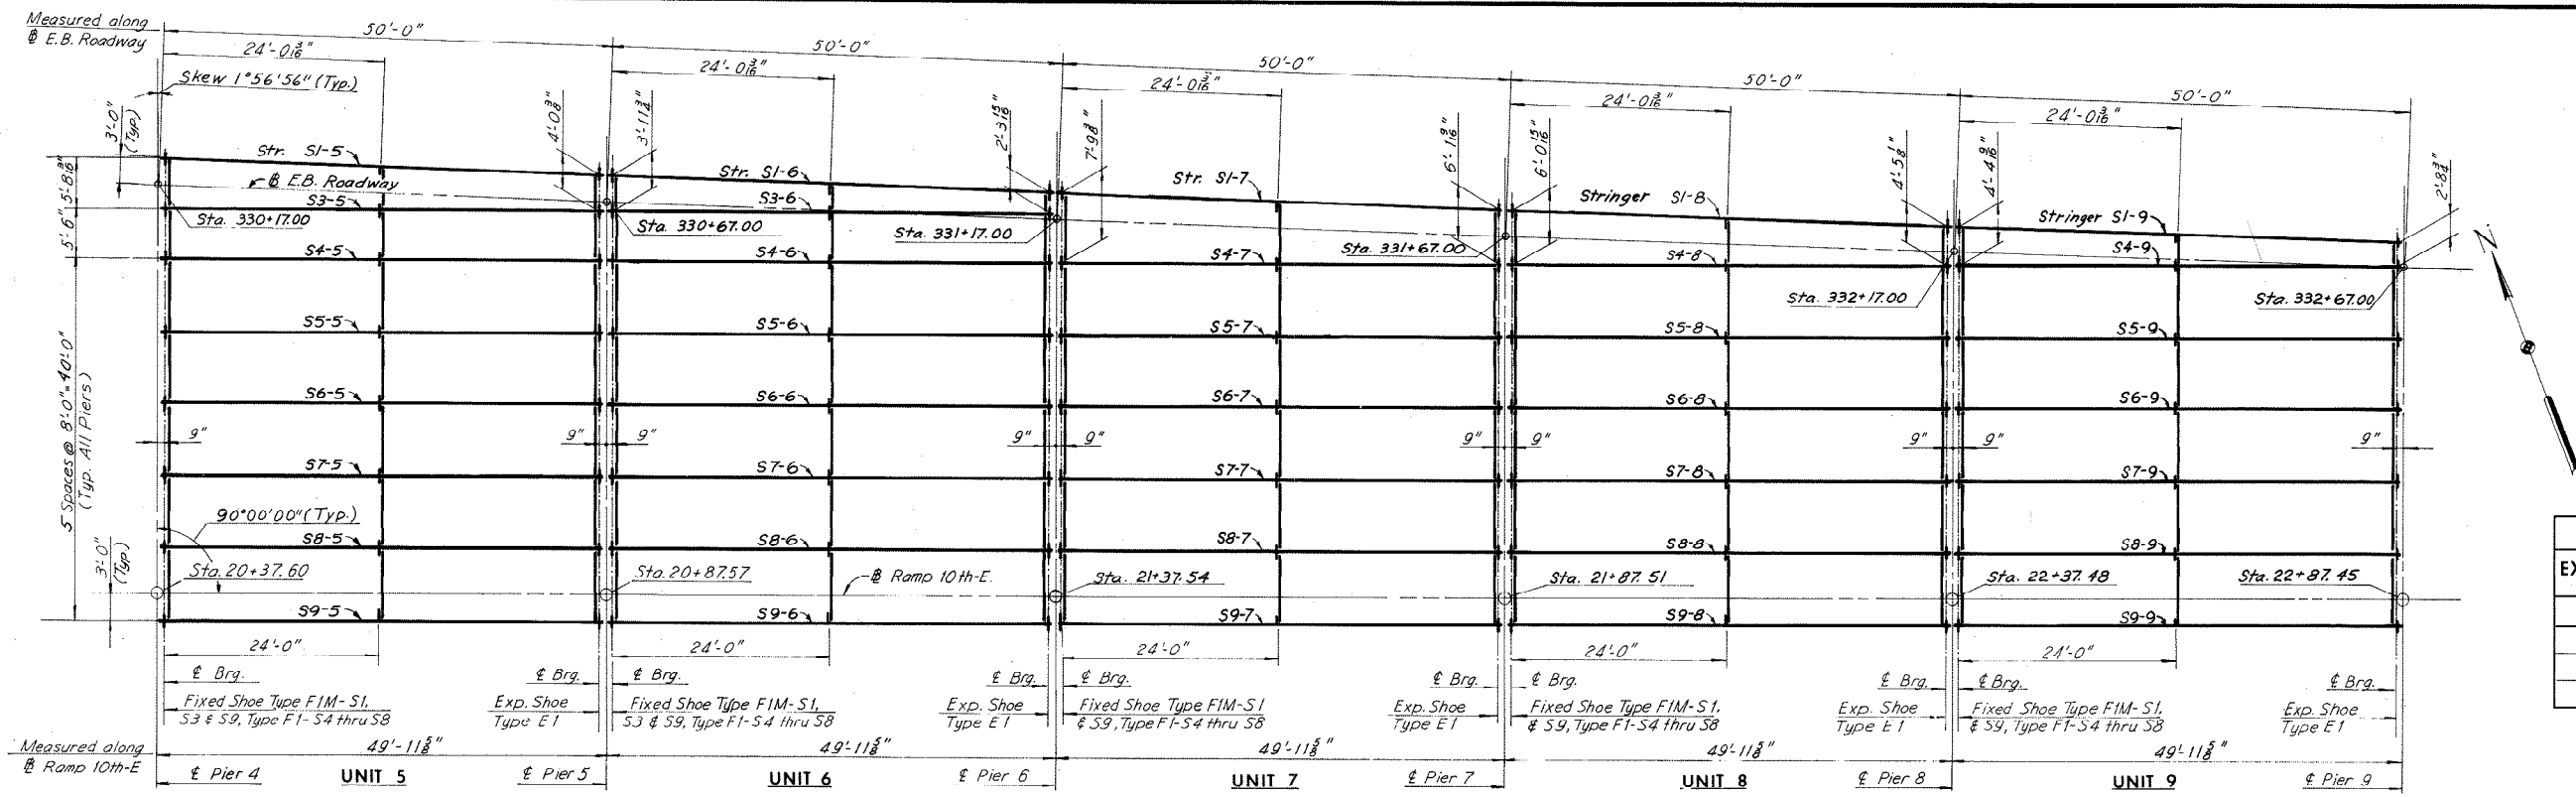


FRAMING PLAN
Scale: 1" = 10'-0"

SHOE SCHEDULE			
EXPANSION SHOES		FIXED SHOES	
TYPE	NO. REQD.	TYPE	NO. REQD.
F1	31	F1	25
		F1M	12



UNIT	STRINGER	STRINGER SIZE	STRINGER SCHEDULE					DEAD LOAD DEFLECTION SCHEDULE					CAMBER SCHEDULE			
			Dim. "A"	LENGTH	Dim. "B"	Dim. "C"	Dim. "D"	PL. "D"	MAX. SHEAR STUD SPACING					1/4L	1/2L	3/4L
				"						0.0L-0.1L	0.1L-0.2L	0.2L-0.3L	0.3L-0.4L	0.4L-0.5L		
5	S1-5	30 W 108	49'-10"	48'-6"	8"	8"	0	0	11"	11 1/2"	13 1/2"	16 1/2"	20 1/2"	1/8"	3/8"	1/2"
	S3-5	30 W 108	49'-7 3/8"	48'-5 5/8"	7"	7"	0	0	10"	11 1/2"	13"	15 1/2"	19"	1/8"	3/8"	1/2"
	S4-5	30 W 99	49'-7 3/8"	48'-5 5/8"	7"	7"	18'-0"	9x3/8"	8"	9"	11"	12 1/2"	15"	1/8"	3/8"	1/2"
	S5-5	30 W 108	49'-7 3/8"	48'-5 5/8"	7"	7"	18'-6"	9x3/8"	7"	7 1/2"	9 1/2"	11"	13"	1/8"	3/8"	1/2"
	S6-5	30 W 108	49'-7 3/8"	48'-5 5/8"	7"	7"	18'-6"	9x3/8"	7"	7 1/2"	9 1/2"	11"	13"	1/8"	3/8"	1/2"
	S7-5	30 W 108	49'-7 3/8"	48'-5 5/8"	7"	7"	18'-6"	9x3/8"	7"	7 1/2"	9 1/2"	11"	13"	1/8"	3/8"	1/2"
	S8-5	30 W 108	49'-7 3/8"	48'-5 5/8"	7"	7"	18'-6"	9x3/8"	7"	7 1/2"	9 1/2"	11"	13"	1/8"	3/8"	1/2"
	S9-5	30 W 108	49'-9 3/8"	48'-5 5/8"	8"	8"	19'-0"	9x3/8"	7 1/2"	8"	9 1/2"	11 1/2"	14"	1/8"	3/8"	1/2"
	S1-6	30 W 99	49'-10"	48'-6"	8"	8"	0	0	13 1/2"	15"	18"	22"	21"	1/8"	3/8"	1/2"
6	S3-6	30 W 99	49'-7 3/8"	48'-5 5/8"	7"	7"	0	0	11 1/2"	12 1/2"	14 1/2"	17 1/2"	21 1/2"	1/8"	3/8"	1/2"
	S4-6	30 W 99	49'-7 3/8"	48'-5 5/8"	7"	7"	18'-0"	9x3/8"	8"	9"	11"	12 1/2"	15"	1/8"	3/8"	1/2"
	S5-6	30 W 108	49'-7 3/8"	48'-5 5/8"	7"	7"	18'-6"	9x3/8"	7"	7 1/2"	9 1/2"	11"	13"	1/8"	3/8"	1/2"
	S6-6	30 W 108	49'-7 3/8"	48'-5 5/8"	7"	7"	18'-6"	9x3/8"	7"	7 1/2"	9 1/2"	11"	13"	1/8"	3/8"	1/2"
	S7-6	30 W 108	49'-7 3/8"	48'-5 5/8"	7"	7"	18'-6"	9x3/8"	7"	7 1/2"	9 1/2"	11"	13"	1/8"	3/8"	1/2"
	S5-9	30 W 108	49'-7 3/8"	48'-5 5/8"	7"	7"	18'-6"	9x3/8"	7"	7 1/2"	9 1/2"	11"	13"	1/8"	3/8"	1/2"
	S6-9	30 W 108	49'-7 3/8"	48'-5 5/8"	7"	7"	18'-6"	9x3/8"	7"	7 1/2"	9 1/2"	11"	13"	1/8"	3/8"	1/2"
	S7-9	30 W 108	49'-7 3/8"	48'-5 5/8"	7"	7"	18'-6"	9x3/8"	7"	7 1/2"	9 1/2"	11"	13"	1/8"	3/8"	1/2"
	S8-9	30 W 108	49'-7 3/8"	48'-5 5/8"	7"	7"	18'-6"	9x3/8"	7"	7 1/2"	9 1/2"	11"	13"	1/8"	3/8"	1/2"
9	S9-9	30 W 108	49'-9 3/8"	48'-5 5/8"	8"	8"	19'-0"	9x3/8"	7 1/2"	8"	9 1/2"	11 1/2"	14"	1/8"	3/8"	1/2"

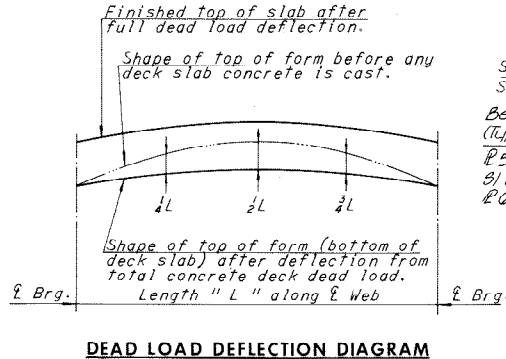

NOTE TO CONTRACTOR
Deflections given are those anticipated to occur in the stringer upon placement of the total concrete deck dead load. In practice, the stringers in place are not likely to have the exact camber to compensate for these deflections during construction. The residual amounts shall be provided by adjusting forms to vary the thickness of the concrete haunch between the bottom of the slab and the top of stringer without altering the slab thickness.

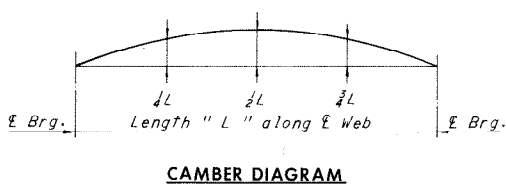

NOTE TO FABRICATOR
The stringers shall be fabricated with an upward camber amounting to the tabulated value. This will provide approximate compensation for deflection under full dead load and for conformity with finished grade. Dimensions are in inches.

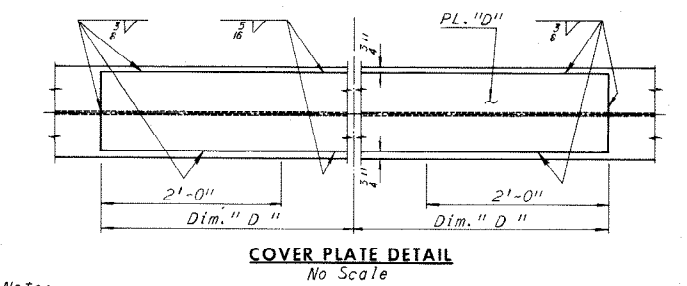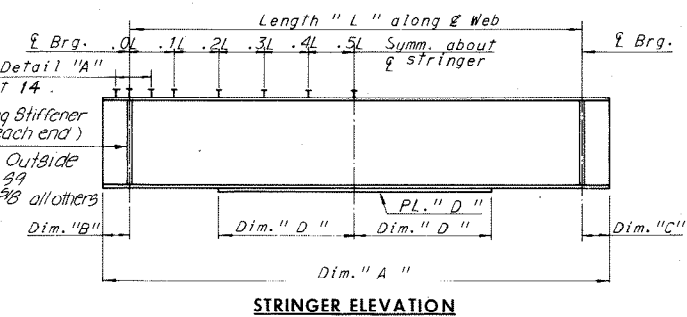

Note: Stringers having a total camber of less than 1" are not required to be shop cambered, but should be turned so that any mill tolerance deviation from straightness will be in the direction shown by the Camber Diagram. If stringers are not cambered, distance top of stringers to top of slab will vary along the stringer in accordance with the offset dimensions shown in the Camber Diagram, and with minimum distance as shown in cross-section on Sheet 29.

* Spacing begins at termination of 6 spaces @ 4".
Note: All steel shall be A36 unless denoted otherwise.

Notes:
For Diaphragm and Connection Details, see Sheet 29.
For Joint Details, see Sheet 37.
For Shoe Details, see Sheets 51 and 52.
For Shear Stud Details, see Sheet 14.
For angles between Piers and Stringers, see Sheets 8, 9, 10 & 11.
For Superstructure steel quantities, see Sheet 2.

BY	DATE				
MADE	SHS	8-2-68			
CHECKED	JD	10-2-68	1	As Built	TEM 8-7
IN CHARGE					

RICHMOND METROPOLITAN AUTHORITY
RICHMOND EXPRESSWAY SYSTEM
DOWNTOWN EXPRESSWAY


BRIDGE NO. 66
EASTBOUND ROADWAY OVER
12TH ST. - R.R. TRACKS AND 16TH ST.
FRAMING PLAN-UNITS 5,6,7,8, AND 9

HOWARD, NEEDLES, TAMMEN & BERGENDOFF
consulting engineers
NEW YORK ALEXANDRIA KANSAS CITY

SCALE: 1"=10' Unless as shown
CONTRACT NO.: 10
SHEET NO.: 15 OF 46

AS BUILT

Note: Dimensions shown at piers are between extended centerlines of stringers.

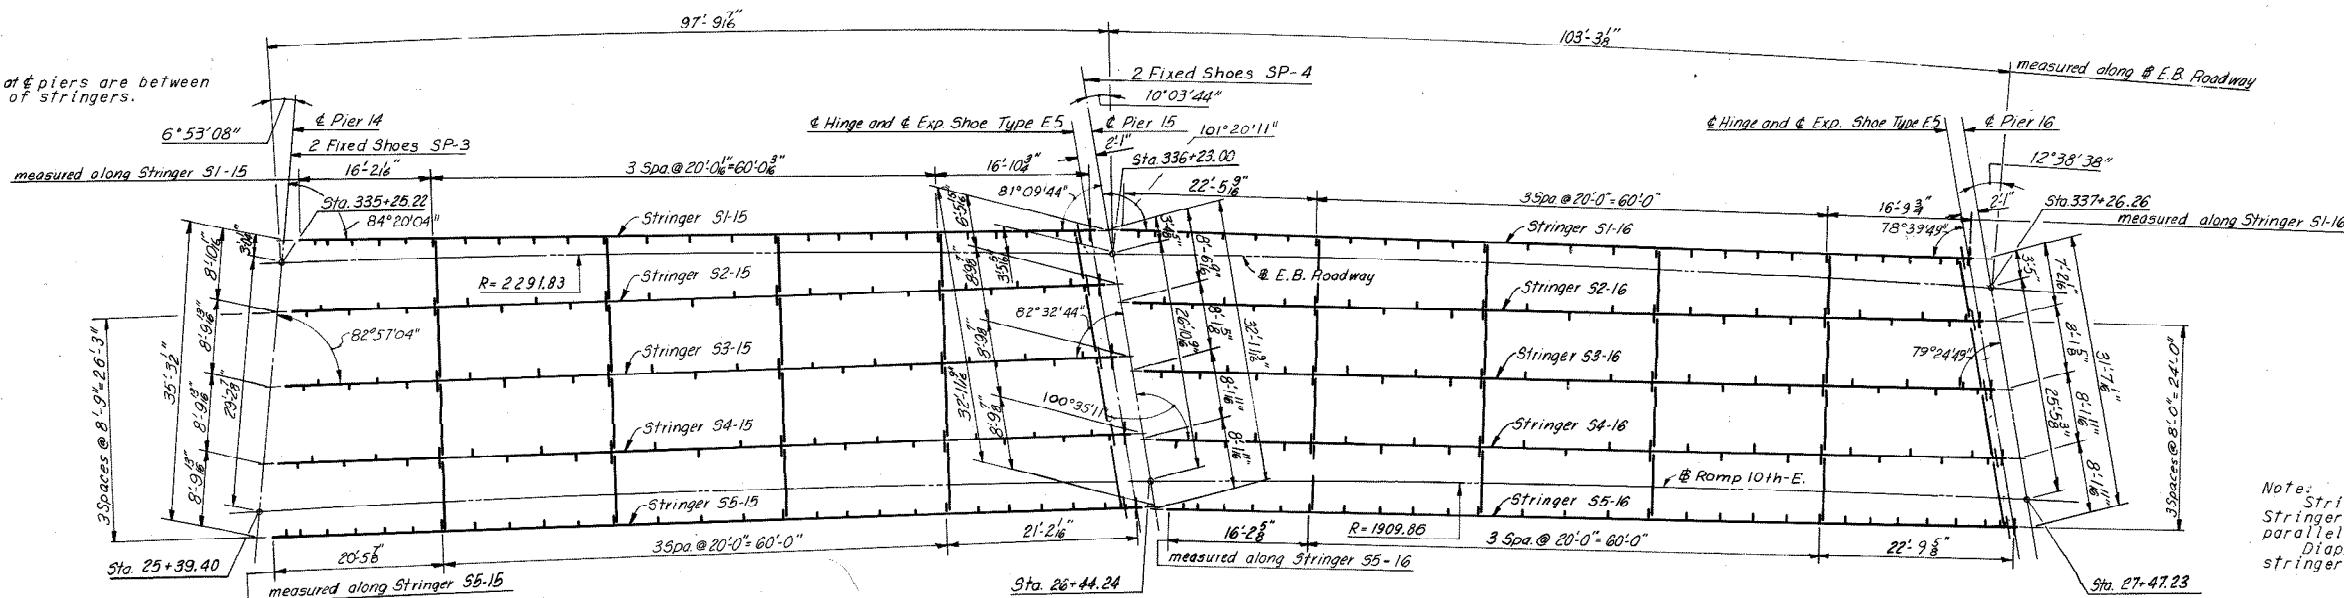


Note: Stringers S2-15 thru S5-15 and Stringers S2-16 thru S5-16 are parallel. Diaphragm spacing is shown along stringer length "L".

UNIT 15

UNIT 16


FRAMING PLAN

Scale: 1/32" = 1'-0"

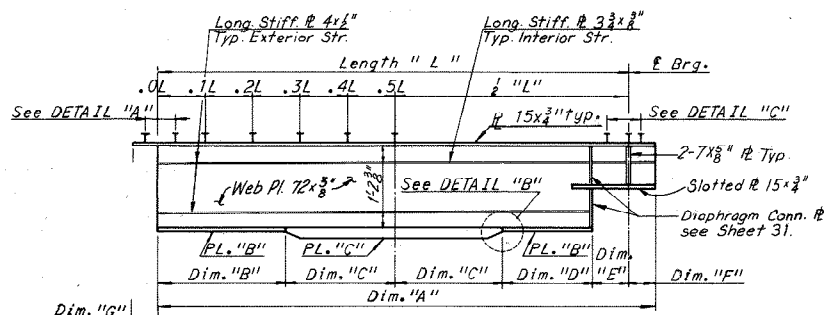


STRINGER ELEVATION

No Scale

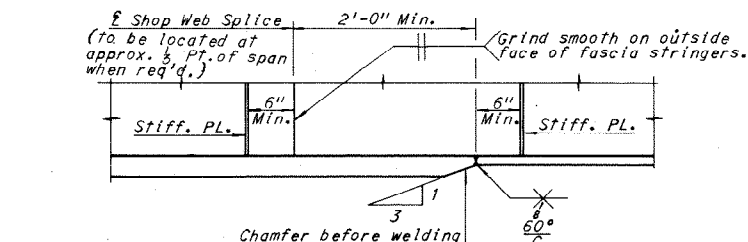

DETAIL "B"


No Scale

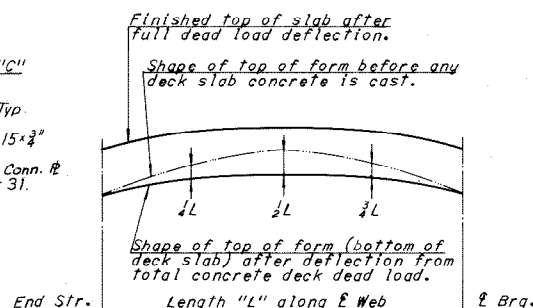

DEAD LOAD DEFLECTION DIAGRAM

NOTE TO CONTRACTOR


Deflections given are those anticipated to occur in the stringer upon placement of the total concrete deck dead load. In practice, the stringers in place are not likely to have the exact camber to compensate for these deflections during construction. The residual amounts shall be provided by adjusting forms to vary the thickness of the concrete haunch between the bottom of the slab and the top of stringer without altering the slab thickness.

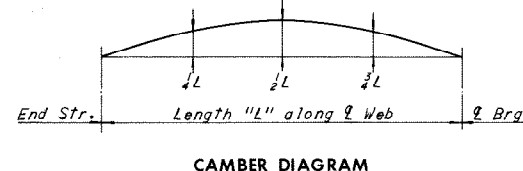

CAMBER DIAGRAM

NOTE TO FABRICATOR

The stringers shall be fabricated with an upward camber amounting to the tabulated value. This will provide approximate compensation for deflection under full dead load and for conformity with finished grade. Dimensions are in inches. Stringers having a total camber of less than 1" are not required to be shop cambered, but should be turned so that any mill tolerance deviation from straightness will be in the direction shown by the Camber Diagram. If stringers are not cambered, distance top of stringers to top of slab will vary along the stringer in accordance with the offset dimensions shown in the Camber Diagram, and with minimum distance as shown in cross-section on Sheet 31.

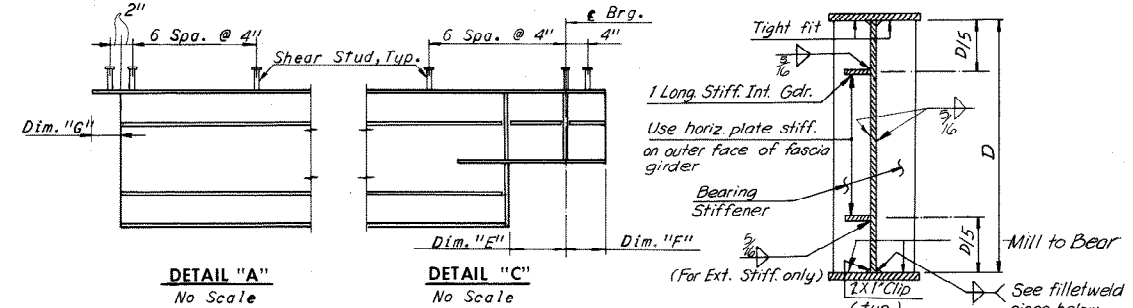

DETAIL "A"

No Scale

DETAIL "C"

No Scale

SHOE SCHEDULE			
FIXED SHOES		EXPANSION SHOES	
TYPE	NO. REQD.	TYPE	NO. REQD.
SP-3	2	E5	10
SP-4	2		

WEB TO FLANGE WELDS AND LONGITUDINAL STIFFENER WELD DETAILS

Note: Web to flange weld size shall be determined by flange thickness as follows:
 To 1/2" 3/8" weld
 over 1/2" to 2 1/2" 1/2" weld

Notes:
 For Superstructure steel quantities, see Sheet 2.
 For Joint Details, see Sheet 38.
 For Shoe Details, see Sheets 31 and 32.
 For Diaphragm Details, see Sheet 31.
 For Framing Details, see Sheet 22.
 For Shear Stud Details, see Sheet 14.
 For Angles between Piers and Stringers see Sheet 22.

UNIT	STRINGER	Dim. "A"	LENGTH	Dim. "B"	Dim. "C"	Dim. "D"	Dim. "E"	Dim. "F"	Dim. "G"	PL. "B"	PL. "C"	MAX. SHEAR STUD SPACING					DEAD LOAD DEFLECTION SCHEDULE			CAMBER SCHEDULE							
												0.0L-0.1L	0.1L-0.2L	0.2L-0.3L	0.3L-0.4L	0.4L-0.5L	1/4L	1/2L	3/4L	1/4L	1/2L	3/4L					
												1/4L	1/2L	3/4L	1/4L	1/2L	3/4L										
15	S1-15	93'-8 1/2"	93'-1"	23'-3 1/2"	23'-3"	22'-5 3/4"	10 1/2"	7 1/2"	6 3/4"	15x2 1/2"	15x1 1/2"	13 1/2"	15 1/2"	19"	24"	24"	1 1/8"	1 1/8"	1 1/8"	1 1/8"	1 1/8"	1 1/8"	1 1/8"	1 1/8"	1 1/8"	1 1/8"	
	S2-15	95'-6 3/4"	94'-11 1/2"	24'-5 1/2"	23'-0"	23'-7 1/2"	10 1/2"	7 1/2"	6 3/4"	15x2 1/2"	15x1 1/2"	14"	16"	18 1/2"	21 1/2"	23 1/2"	1 1/8"	1 1/8"	1 1/8"	1 1/8"	1 1/8"	1 1/8"	1 1/8"	1 1/8"	1 1/8"	1 1/8"	
	S3-15	97'-9 3/4"	97'-2 1/2"	22'-1 1/2"	26'-6"	21'-3 3/4"	10 1/2"	7 1/2"	6 3/4"	15x2 1/2"	15x1 1/2"	14"	16"	19"	21"	22 1/2"	1 1/8"	1 1/8"	1 1/8"	1 1/8"	1 1/8"	1 1/8"	1 1/8"	1 1/8"	1 1/8"	1 1/8"	1 1/8"
	S4-15	100'-0 3/4"	99'-5 1/2"	24'-2 3/4"	25'-6"	23'-4 3/4"	10 1/2"	7 1/2"	6 3/4"	15x2 1/2"	15x1 1/2"	14"	16"	18 1/2"	21"	23"	1 1/8"	1 1/8"	1 1/8"	1 1/8"	1 1/8"	1 1/8"	1 1/8"	1 1/8"	1 1/8"	1 1/8"	1 1/8"
	S5-15	102'-3"	101'-7 1/2"	24'-4"	26'-6"	23'-5 1/2"	10 1/2"	7 1/2"	6 3/4"	15x2 1/2"	15x1 1/2"	13 1/2"	15 1/2"	18 1/2"	23"	24"	1 1/8"	1 1/8"	1 1/8"	1 1/8"	1 1/8"	1 1/8"	1 1/8"	1 1/8"	1 1/8"	1 1/8"	1 1/8"
16	S1-16	99'-10 3/4"	99'-3 3/4"	23'-7 3/4"	26'-0"	22'-9 1/2"	10 1/2"	7 1/2"	6 3/4"	15x2 1/2"	15x1 1/2"	14"	16"	19"	24"	24"	1 1/8"	1 1/8"	1 1/8"	1 1/8"	1 1/8"	1 1/8"	1 1/8"	1 1/8"	1 1/8"	1 1/8"	1 1/8"
	S2-16	99'-7 3/4"	99'-0 1/2"	24'-6 1/2"	25'-0"	23'-7 3/4"	10 1/2"	7 1/2"	6 3/4"	15x2 1/2"	15x1 1/2"	15"	17"	19 1/2"	22 1/2"	24"	1 1/8"	1 1/8"	1 1/8"	1 1/8"	1 1/8"	1 1/8"	1 1/8"	1 1/8"	1 1/8"	1 1/8"	1 1/8"
	S3-16	99'-7 3/4"	99'-0 1/2"	24'-0 1/2"	25'-6"	23'-1 3/4"	10 1/2"	7 1/2"	6 3/4"	15x2 1/2"	15x1 1/2"	15"	17"	19 1/2"	22 1/2"	24"	1 1/8"	1 1/8"	1 1/8"	1 1/8"	1 1/8"	1 1/8"	1 1/8"	1 1/8"	1 1/8"	1 1/8"	1 1/8"
	S4-16	99'-7 3/4"	99'-0 1/2"	24'-0 1/2"	25'-6"	23'-1 3/4"	10 1/2"	7 1/2"	6 3/4"	15x2 1/2"	15x1 1/2"	15"	17"	19 1/2"	22 1/2"	24"	1 1/8"	1 1/8"	1 1/8"	1 1/8"	1 1/8"	1 1/8"	1 1/8"	1 1/8"	1 1/8"	1 1/8"	1 1/8"
	S5-16	99'-7 3/4"	99'-0 1/2"	24'-0 1/2"	25'-6"	23'-1 3/4"	10 1/2"	7 1/2"	6 3/4"	15x2 1/2"	15x1 1/2"	14"	16 1/2"	19 1/2"	24"	24"	1 1/8"	1 1/8"	1 1/8"	1 1/8"	1 1/8"	1 1/8"	1 1/8"	1 1/8"	1 1/8"	1 1/8"	1 1/8"

Note All structural steel in Units 15 and 16 is A36.

* Spacing begins at termination of 6 spaces @ 4"

Longitudinal stiffeners shall be located on the exterior face of the exterior Stringers.

Intermediate stiffener Pls. 1/2 x 3/8" shall be equally spaced between diaphragms as shown. The first two stiffener spaces at the ends of stringers shall be one-half the normal spacing within the panel.

BY	DATE				
MADE	RLM	7-31-68			
CHECKED	PTA	11-4-68	As Built	TEM	8-76
IN CHARGE					

AS BUILT

RICHMOND METROPOLITAN AUTHORITY
RICHMOND EXPRESSWAY SYSTEM
DOWNTOWN EXPRESSWAY


BRIDGE NO. 66
 EASTBOUND ROADWAY OVER
 12TH ST. - R.R. TRACKS AND 16TH ST.
FRAMING PLAN - UNITS 15 AND 16

HOWARD, NEEDLES, TAMMEN & BERGENDOFF
 consulting engineers
 NEW YORK ALEXANDRIA KANSAS CITY
 SCALE: As Noted
 CONTRACT NO.: 10
 SHEET NO.: 17 OF 46

RICHMOND EXPRESSWAY SYSTEM			
SECTION	PROJECT	SHEET NO.	TOTAL SHEETS
10	DOWNTOWN EXPRESSWAY	144	265

Note: Stringers S2-17 thru S5-17 and Stringers S1-18 thru S5-18 are parallel. Diaphragm spacing is shown along stringer length "L".

Dimensions shown at Piers are between extended center lines of stringers.

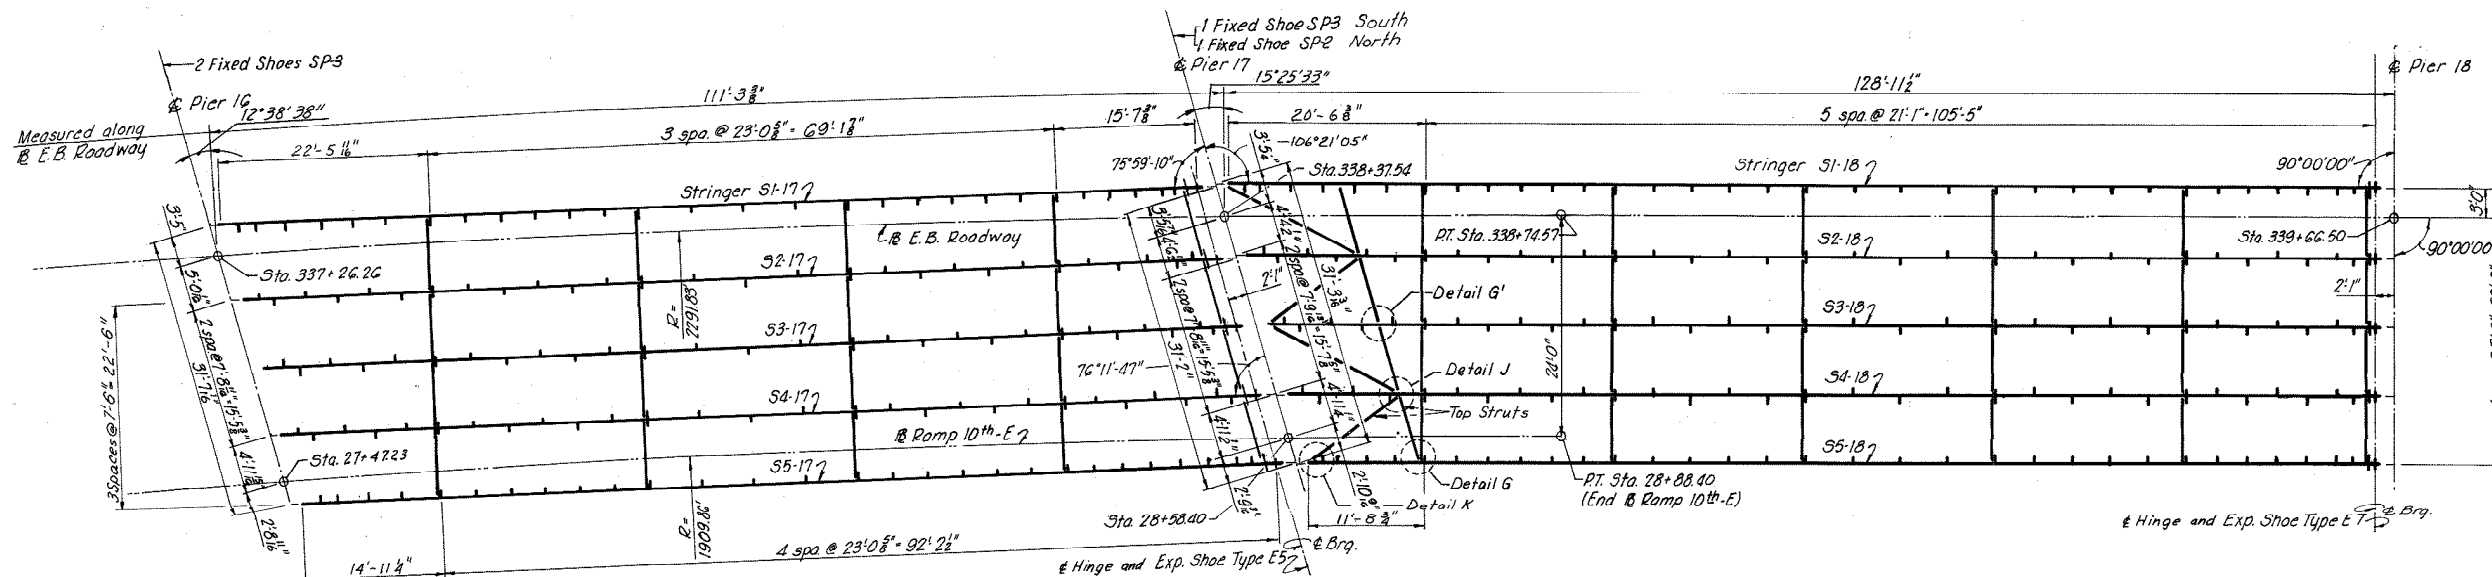


UNIT 17

UNIT 18


FRAMING PLAN

Scale: 1"=10'-0"


Note: For web to flange weld sizes and longitudinal stiffener plate details see Sheet 17.

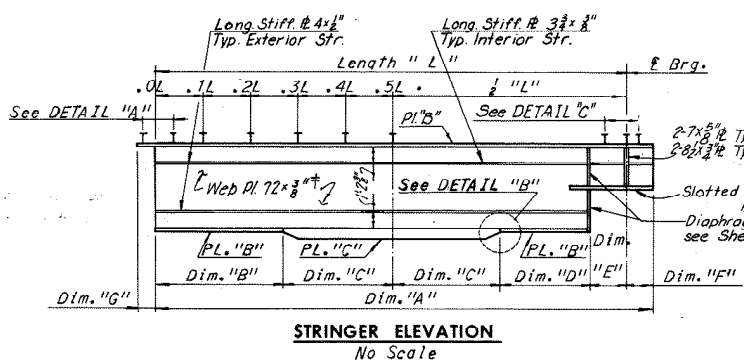

STRINGER ELEVATION
No Scale

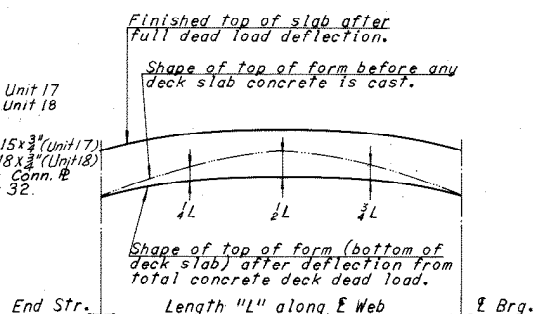

DEAD LOAD DEFLECTION DIAGRAM

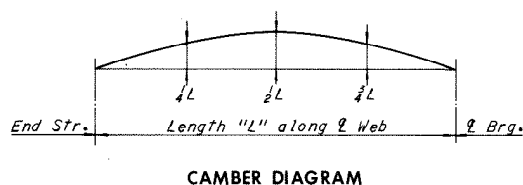


CAMBER DIAGRAM

NOTE TO FABRICATOR

The stringers shall be fabricated with an upward camber amounting to the tabulated value. This will provide approximate compensation for deflection under full dead load and for conformity with finished grade. Dimensions are in inches. Stringers having a total camber of less than 1" are not required to be shop cambered, but should be turned so that any mill tolerance deviation from straightness will be in the direction shown by the Camber Diagram. If stringers are not cambered, distance top of stringer to top of slab will vary along the stringer in accordance with the offset dimensions shown in the Camber Diagram, and with minimum distance as shown in cross-section on Sheet 32.

NOTE TO CONTRACTOR

Deflections given are those anticipated to occur in the stringer upon placement of the total concrete deck dead load. In practice, the stringers in place are not likely to have the exact camber to compensate for these deflections during construction. The residual amounts shall be provided by adjusting forms to vary the thickness of the concrete haunch between the bottom of the slab and the top of stringer without altering the slab thickness.

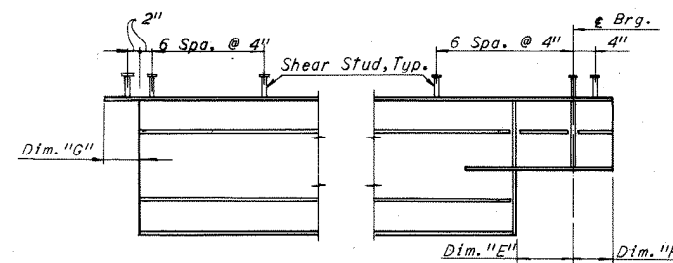

DETAIL "A"
No Scale

DETAIL "C"
No Scale

SHOE SCHEDULE

EXPANSION SHOES		FIXED SHOES	
TYPE	NO. REQD.	TYPE	NO. REQD.
E5	5	SP-2	1
E7	5	SP-3	3

Note: Longitudinal stiffeners shall be located on the exterior face of the exterior stringers. Intermediate stiffener Pls. 4x3" shall be equally spaced between diaphragms as shown. The first two stiffener spaces at the ends of stringers shall be one-half the normal spacing within the panel. All steel shall be A36 unless otherwise noted.

Notes: For Framing Details, see Sheet 22 and 23. For Joint Details, see Sheet 38. For Shoe Details, see Sheets 51, 52. For Diaphragm Details, see Sheet 32. For Superstructure steel quantities, see Sheet 2. For Details G, G', J and K, see Sheet 27. For Shear Stud Details, see Sheet 14. For Angles between Piers and Stringers, see Sheets 22 & 23.

UNIT	STRINGER	STRINGER SCHEDULE										DEAD LOAD DEFLECTION SCHEDULE					CAMBER SCHEDULE					
		Dim. "A"	LENGTH "L"	Dim. "B"	Dim. "C"	Dim. "D"	Dim. "E"	Dim. "F"	Dim. "G"	PL. "B"	PL. "C"	0.0L-0.1L	0.1L-0.2L	0.2L-0.3L	0.3L-0.4L	0.4L-0.5L	1/4L	1/2L	3/4L			
		107'-10 3/4"	107'-2 3/4"	26'-7 1/2"	27'-0"	25'-9 1/4"	10 3/4"	7 1/4"	6 3/4"	* 15x3 1/2"	* 15x1 1/4"											
17	S1-17	107'-10 3/4"	107'-2 3/4"	26'-7 1/2"	27'-0"	25'-9 1/4"	10 3/4"	7 1/4"	6 3/4"	* 15x3 1/2"	* 15x1 1/4"	13 1/2"	15 1/2"	18 1/2"	23"	24"	1 3/8"	2 1/4"	1 3/8"	2"	2 3/8"	2 1/4"
	S2-17	107'-9"	107'-1 1/4"	28'-6 3/4"	25'-0"	27'-8 3/4"	10 3/4"	7 1/4"	6 3/4"	* 15x3 1/2"	* 15x1 1/4"	14 1/2"	17"	19 1/2"	22"	24"	1 3/8"	2 1/4"	1 3/8"	1 1/8"	2 3/8"	1 3/8"
	S3-17	107'-9"	107'-1 1/4"	28'-6 3/4"	25'-0"	27'-8 3/4"	10 3/4"	7 1/4"	6 3/4"	* 15x3 1/2"	* 15x1 1/4"	14 1/2"	17"	19 1/2"	22"	24"	1 3/8"	2 1/4"	1 3/8"	1 1/2"	2 1/4"	1 3/8"
	S4-17	107'-9"	107'-1 1/4"	28'-6 3/4"	25'-0"	27'-8 3/4"	10 3/4"	7 1/4"	6 3/4"	* 15x3 1/2"	* 15x1 1/4"	14 1/2"	17"	19 1/2"	22"	24"	1 3/8"	2 1/4"	1 3/8"	1 5/8"	1 5/8"	1 1/2"
	S5-17	107'-9"	107'-1 1/4"	28'-0 3/4"	25'-6"	27'-2 3/4"	10 3/4"	7 1/4"	6 3/4"	* 15x3 1/2"	* 15x1 1/4"	14"	16"	19"	24"	24"	1 3/8"	2 3/8"	1 3/8"	1"	1 1/8"	3/4"
18	S1-18	126'-6 3/4"	125'-11 1/2"	30'-11 1/2"	32'-0"	30'-1 1/2"	10"	7"	6 3/4"	* 18x3 1/2"	* 18x1 1/4"	14"	16 1/2"	19 1/2"	24"	24"	2 1/8"	3 3/8"	2 1/8"	2 3/8"	4 1/8"	2 3/8"
	S2-18	124'-4"	123'-9"	34'-10 1/2"	27'-0"	34'-0 1/2"	10"	7"	6 3/4"	* 18x3 1/2"	* 18x1 1/4"	16"	18 1/2"	21 1/2"	24"	24"	2 1/8"	2 3/8"	2 1/8"	2 1/8"	3 3/8"	2 3/8"
	S3-18	122'-1 9/16"	121'-6 3/8"	36'-3 3/8"	24'-6"	35'-5 1/4"	10"	7"	6 3/4"	* 18x3 1/2"	* 18x1 1/4"	16"	18 1/2"	21 1/2"	23 1/2"	24"	2"	2 1/4"	2"	2 3/8"	3 3/8"	2 3/8"
	S4-18	119'-11 3/4"	119'-4 3/4"	37'-0 3/4"	21'-6"	36'-2 3/4"	10"	7"	6 3/4"	* 18x3 1/2"	* 18x1 1/4"	16"	18 1/2"	21 1/2"	23 1/2"	24"	1 3/8"	2 3/8"	1 3/8"	2 3/8"	3 3/8"	2 3/8"
	S5-18	117'-8 1/2"	117'-1 1/2"	37'-0 3/4"	21'-6"	36'-2 3/4"	10"	7"	6 3/4"	* 18x3 1/2"	* 18x1 1/4"	14 1/2"	17"	20"	24"	24"	1 3/8"	2 3/8"	1 3/8"	2 1/4"	3 3/8"	2 3/8"

*Spacing begins at termination of 6 spaces @ 4".

† Denotes A572-Grade 50 steel for thickness of 3/4" and under and A500 steel for thickness over 3/4".

MADE	FKD	8-20-68	2	As Built	TEM	8-76
CHECKED	PTA	4-25-69	1	Pier 17 Shoes	DWS	11-14-74
IN CHARGE						


AS BUILT

RICHMOND METROPOLITAN AUTHORITY
RICHMOND EXPRESSWAY SYSTEM
DOWNTOWN EXPRESSWAY

BRIDGE NO. 66
 EASTBOUND ROADWAY OVER
 12TH ST. - R.R. TRACKS AND 16TH ST.
FRAMING PLAN - UNITS 17 AND 18

SCALE: As Noted
 HOWARD, NEEDLES, TAMMEN & BERGENDOFF
 consulting engineers
 NEW YORK ALEXANDRIA KANSAS CITY
 CONTRACT NO. 10
 SHEET NO. 18 OF 46


RICHMOND EXPRESSWAY SYSTEM			
SECTION	PROJECT	SHEET NO.	TOTAL SHEETS
10	DOWNTOWN EXPRESSWAY	145	265

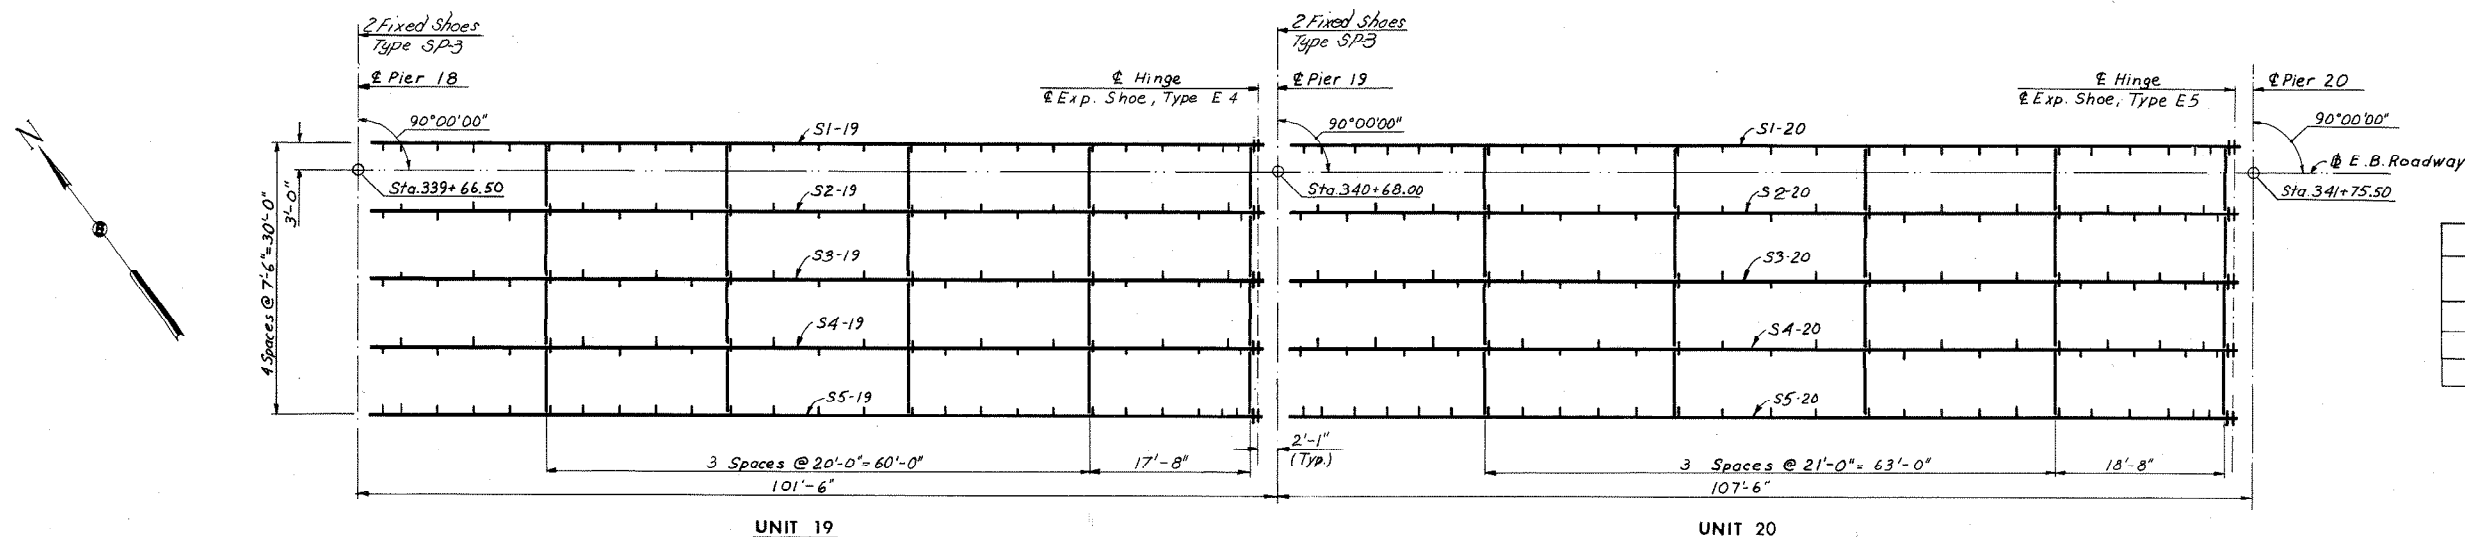


SHOE SCHEDULE			
EXPANSION SHOES		FIXED SHOES	
TYPE	NO. REQD.	TYPE	NO. REQD.
E4	5	SP-3	4
E5	5		

FRAMING PLAN
Scale: 1"=10'-0"

Note: For web to flange weld sizes and Longitudinal Stiffener Plate details see Sheet 17.

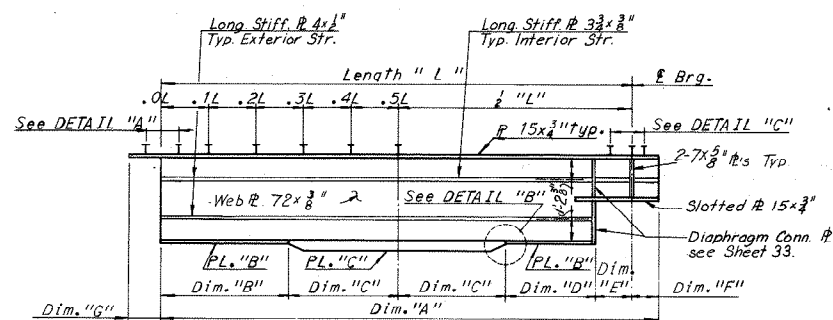


STRINGER ELEVATION
No Scale

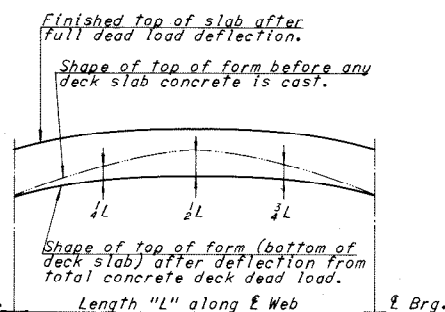

DEAD LOAD DEFLECTION DIAGRAM

NOTE TO CONTRACTOR


Deflections given are those anticipated to occur in the stringer upon placement of the total concrete deck dead load. In practice, the stringers in place are not likely to have the exact camber to compensate for these deflections during construction. The residual amounts shall be provided by adjusting forms to vary the thickness of the concrete haunch between the bottom of the slab and the top of stringer without altering the slab thickness.

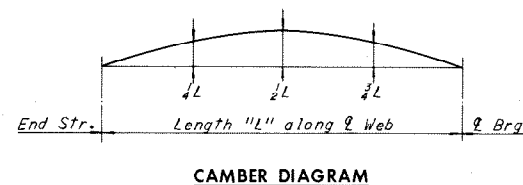

CAMBER DIAGRAM

NOTE TO FABRICATOR


The stringers shall be fabricated with an upward camber amounting to the Tabulated value. This will provide approximate compensation for deflection under full dead load and for conformity with finished grade. Dimensions are in inches. Stringers having a total camber of less than 1" are not required to be shop cambered, but should be turned so that any mill tolerance deviation from straightness will be in the direction shown by the Camber Diagram. If stringers are not cambered, distance top of stringers to top of slab will vary along the stringer in accordance with the offset dimensions shown in the Camber Diagram, and with minimum distance as shown in cross-section on Sheet 33.

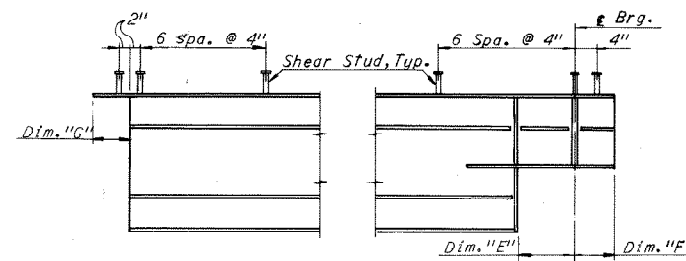

DETAIL "A"
No Scale

DETAIL "C"
No Scale

Note: Longitudinal stiffeners shall be located on the exterior face of the exterior Stringers. Intermediate stiffener Pls. 4 1/2 x 3/8 shall be equally spaced between diaphragms as shown. The first two stiffener spaces at the end of stringers shall be one-half the normal spacing within the panel.

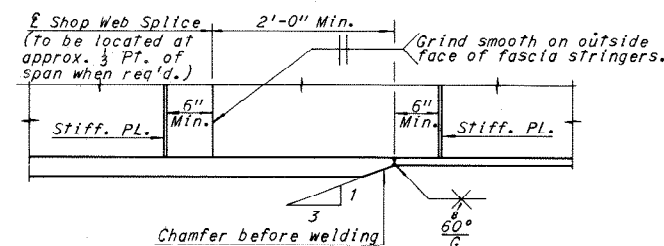

DETAIL "B"
No Scale

Notes: For Superstructure steel quantities, see Sheet 2. For Diaphragm Details, see Sheet 33. For Shoe Details, see Sheets S1/S2. For Joint Details, see Sheet 38. For Framing Details, see Sheet 23. For Shear Stud Details, see Sheet 14. For Angles between Piers and Stringers, see Sheet 23.

UNIT	STRINGER	Dim. "A"	LENGTH "L"	Dim. "B"	Dim. "C"	Dim. "D"	Dim. "E"	Dim. "F"	Dim. "G"	PL. "B"	PL. "C"	MAX. SHEAR STUD SPACING					DEAD LOAD DEFLECTION SCHEDULE			CAMBER SCHEDULE		
												0.0L-0.1L	0.1L-0.2L	0.2L-0.3L	0.3L-0.4L	0.4L-0.5L	1/4L	1/2L	3/4L	1/4L	1/2L	3/4L
												14 1/2"	17"	20"	24"	24"	1"	1 1/2"	1"	1 1/4"	1 1/2"	1 3/4"
19	S1-19	98'-2 1/2"	97'-7 1/4"	23'-9 5/8"	25'-0"	22'-11 1/2"	10"	7"	6 1/2"	15x8 1/2"	15x1 1/4"	14 1/2"	17"	20"	24"	24"	1"	1 1/2"	1"	1 1/4"	1 1/2"	1 3/4"
	S2-19	98'-2 1/2"	97'-7 1/4"	24'-9 5/8"	24'-0"	23'-11 1/2"	10"	7"	6 1/2"	15x8 1/2"	15x1 1/4"	16"	18"	21"	24"	24"	1"	1 1/2"	1"	1 1/4"	1 1/2"	1 3/4"
	S3-19	98'-2 1/2"	97'-7 1/4"	24'-9 5/8"	24'-0"	23'-11 1/2"	10"	7"	6 1/2"	15x8 1/2"	15x1 1/4"	16"	18"	21"	24"	24"	1"	1 1/2"	1"	1 1/4"	1 1/2"	1 3/4"
	S4-19	98'-2 1/2"	97'-7 1/4"	24'-9 5/8"	24'-0"	23'-11 1/2"	10"	7"	6 1/2"	15x8 1/2"	15x1 1/4"	16"	18"	21"	24"	24"	1"	1 1/2"	1"	1 1/4"	1 1/2"	1 3/4"
	S5-19	98'-2 1/2"	97'-7 1/4"	23'-9 5/8"	25'-0"	22'-11 1/2"	10"	7"	6 1/2"	15x8 1/2"	15x1 1/4"	14 1/2"	17"	20"	24"	24"	1"	1 1/2"	1"	1 1/4"	1 1/2"	1 3/4"
* Spacing begins at termination of 6 spaces @ 4"

Note: All structural steel in Units 19 and 20 is A36.

MADE	J.D.	8-6-68			
CHECKED	PTA	11-4-68	As Built	TEM	8-76
IN CHARGE					


RICHMOND METROPOLITAN AUTHORITY
RICHMOND EXPRESSWAY SYSTEM
DOWNTOWN EXPRESSWAY

BRIDGE NO. 66
EASTBOUND ROADWAY OVER
12TH ST. - R.R. TRACKS AND 16TH ST.
FRAMING PLAN - UNITS 19 AND 20


HOWARD, NEEDLES, TAMMEN & BERGENDOFF consulting engineers NEW YORK ALEXANDRIA KANSAS CITY	SCALE: As Noted
CONTRACT NO. 10	SHEET NO. 19 OF 46

AS BUILT


RICHMOND EXPRESSWAY SYSTEM			
SECTION	PROJECT	SHEET NO.	TOTAL SHEETS
10	DOWNTOWN EXPRESSWAY	148	265

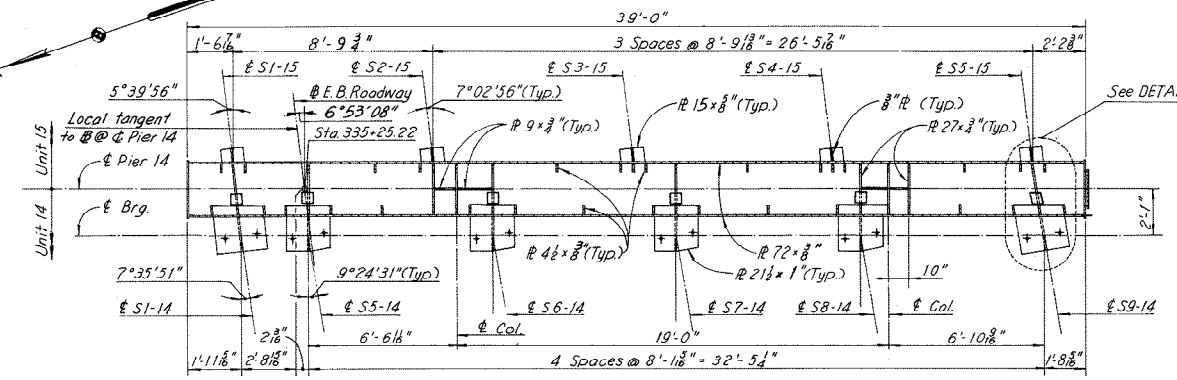


SECTION A-A
Scale: 1/4" = 1'-0"

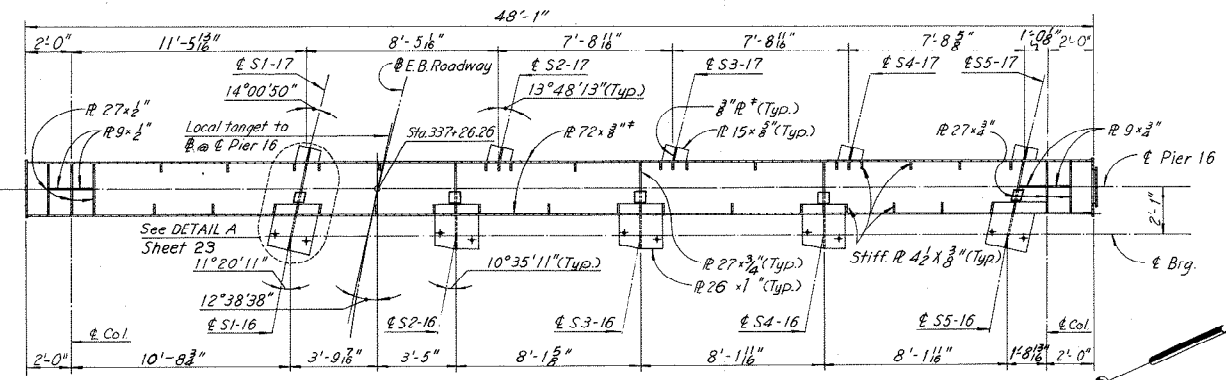


SECTION C-C
Scale: 1/4" = 1'-0"

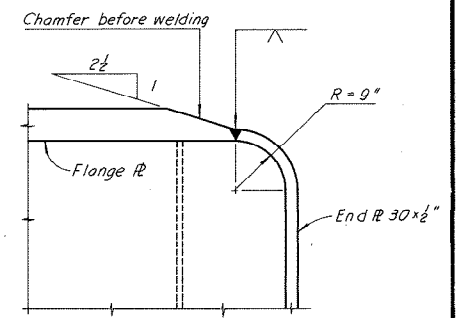


DETAIL A
No Scale

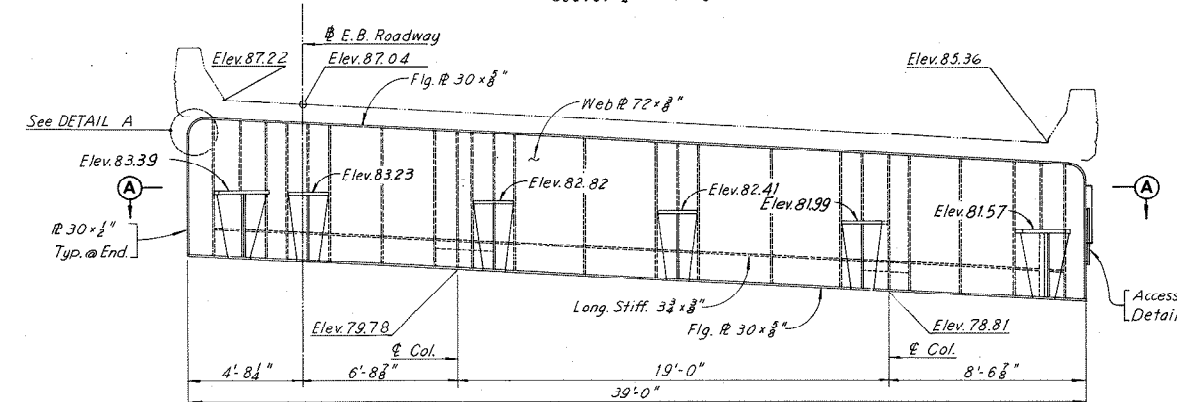


CAP BEAM ELEVATION - PIER 14
Scale: 1/4" = 1'-0"

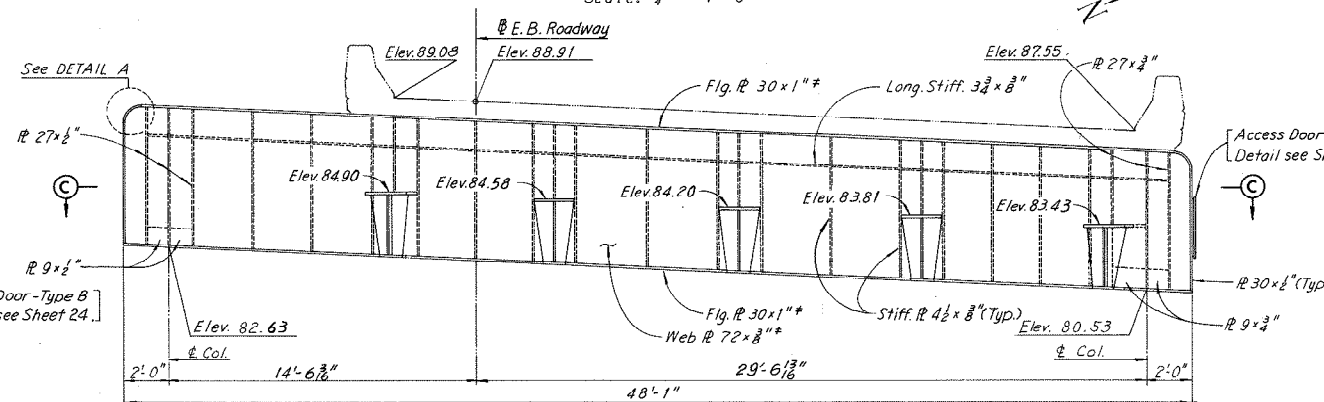


CAP BEAM ELEVATION - PIER 16
Scale: 1/4" = 1'-0"

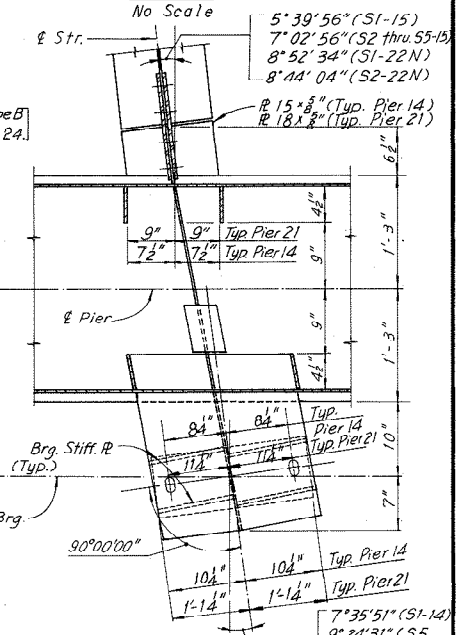


DETAIL B
No Scale

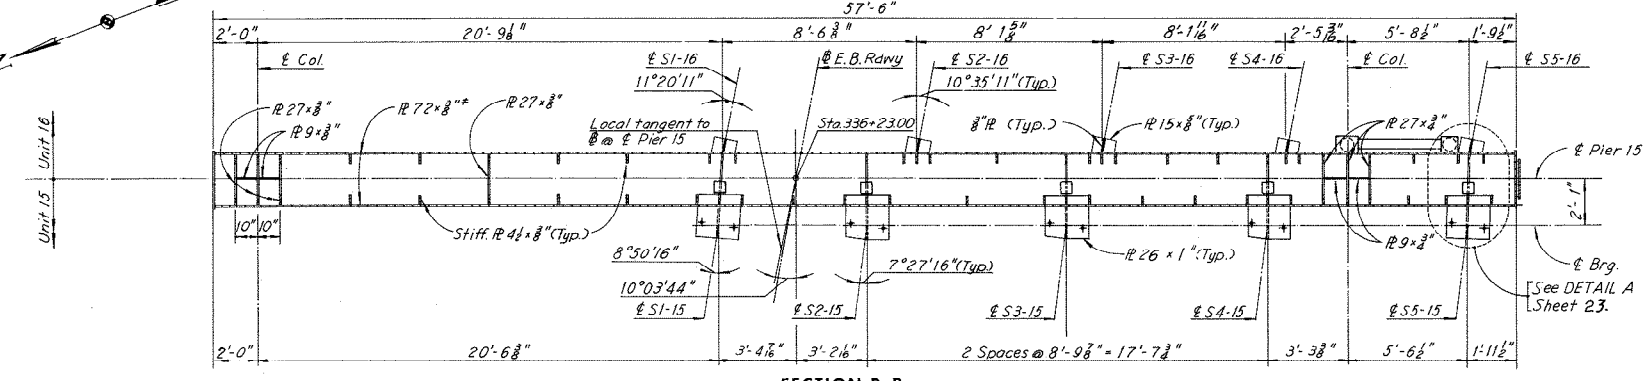

SECTION B-B
Scale: 1/4" = 1'-0"

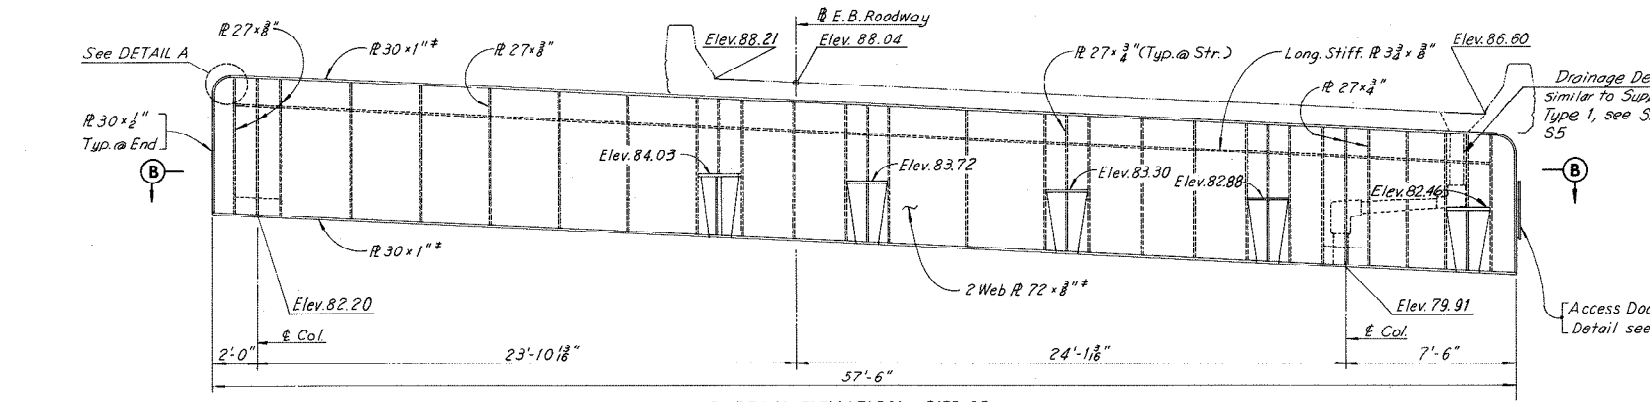

CAP BEAM ELEVATION - PIER 15
Scale: 1/4" = 1'-0"

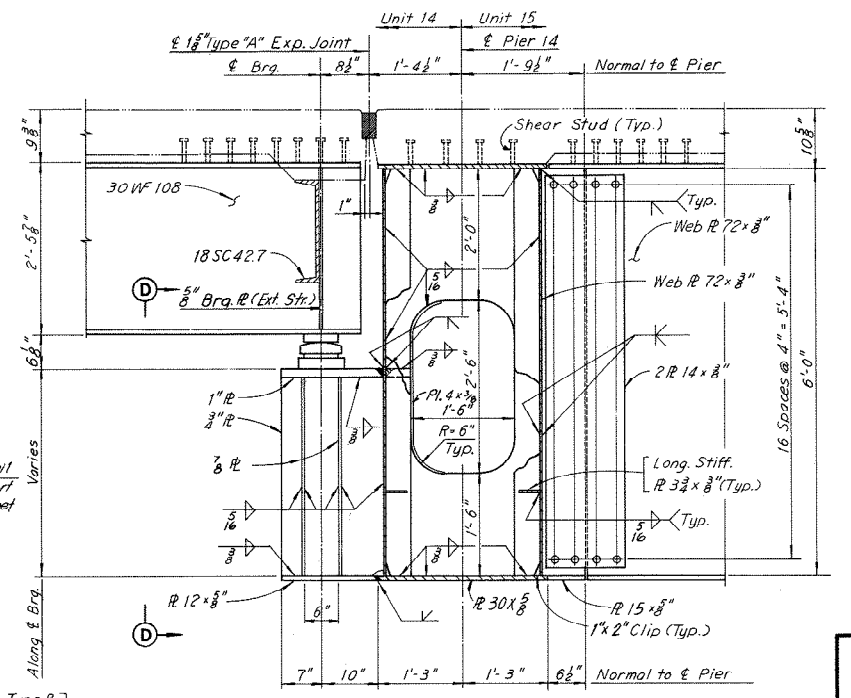

TYPICAL SECTION - PIER 14
Scale: 3/8" = 1'-0"

Note: TYPICAL SECTION for Piers 15 and 16, see TYPICAL SECTION, Sheet 23.

Note: Shear studs are placed in rows, with four shear studs in each row. Rows are spaced at 2d" centers within limits of concrete deck.

RICHMOND METROPOLITAN AUTHORITY
RICHMOND EXPRESSWAY SYSTEM
DOWNTOWN EXPRESSWAY
BRIDGE NO. 66
EASTBOUND ROADWAY OVER
12TH ST. - R.R. TRACKS AND 16TH ST.
FRAMING DETAILS
PIERS 14, 15 AND 16


HOWARD, NEEDLES, TAMMEN & BERGENDOFF
consulting engineers
NEW YORK ALEXANDRIA KANSAS CITY
SCALE: As Noted
CONTRACT NO. 10
SHEET NO. 22 OF 46

AS BUILT


BY	DATE	Note changed	PRMS	4-19-74
MADE	M.H.H.V2-7-68	As Built	TEM	8-74
CHECKED	J.D.	1-29-69		
IN CHARGE	NO.	REVISION	BY	DATE

Note: All steel shall be A36 unless denoted otherwise.
+ Denotes A572-Grade 50 steel for thickness of 3/4" and under and A588 steel for thickness over 3/4".
Provide Drain Holes at lower end of cap beam.
All elevations shown are final elevations.


RICHMOND EXPRESSWAY SYSTEM			
SECTION	PROJECT	SHEET NO.	TOTAL SHEETS
10	DOWNTOWN EXPRESSWAY	149	265

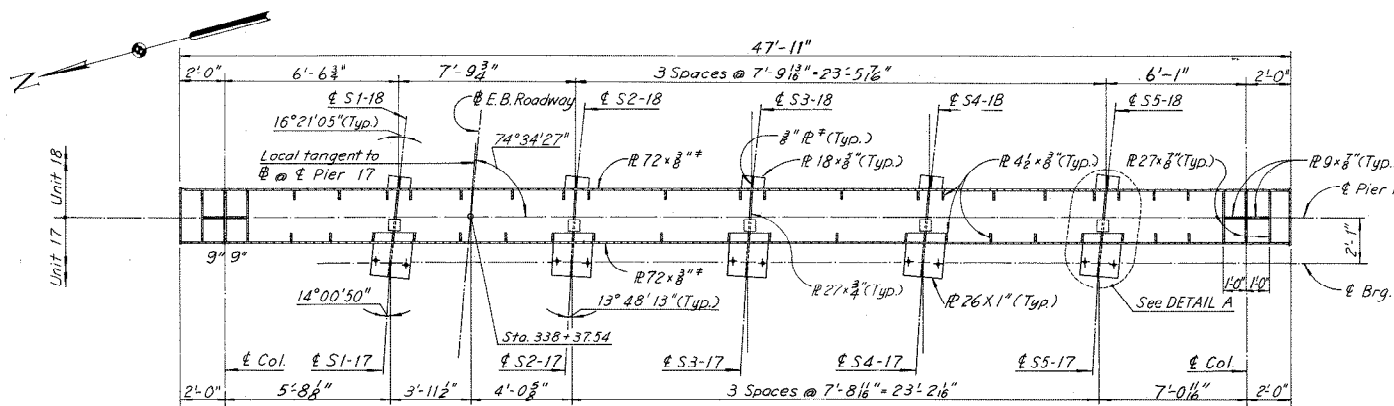


SECTION A-A
Scale: 1/4" = 1'-0"

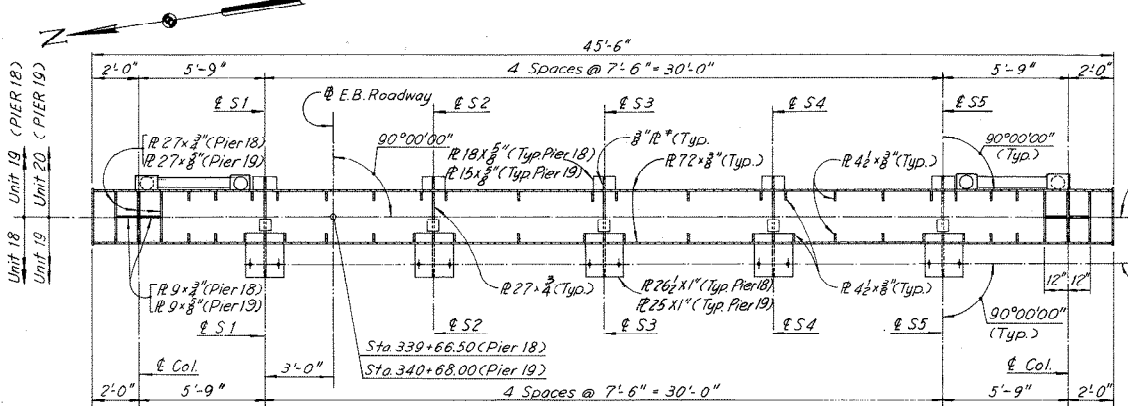


SECTION B-B
Scale: 1/4" = 1'-0"

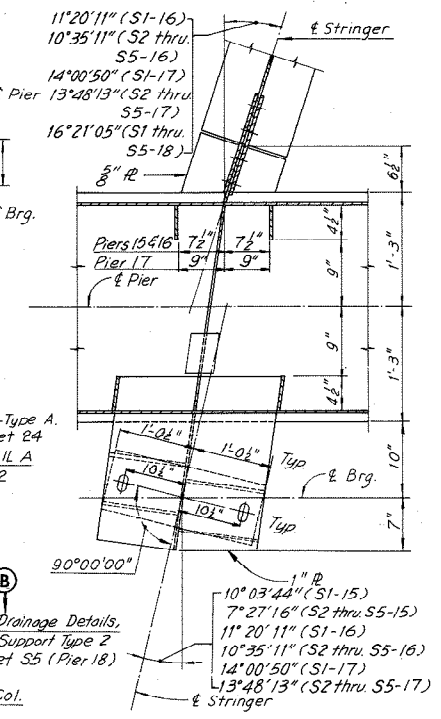


DETAIL A
No Scale

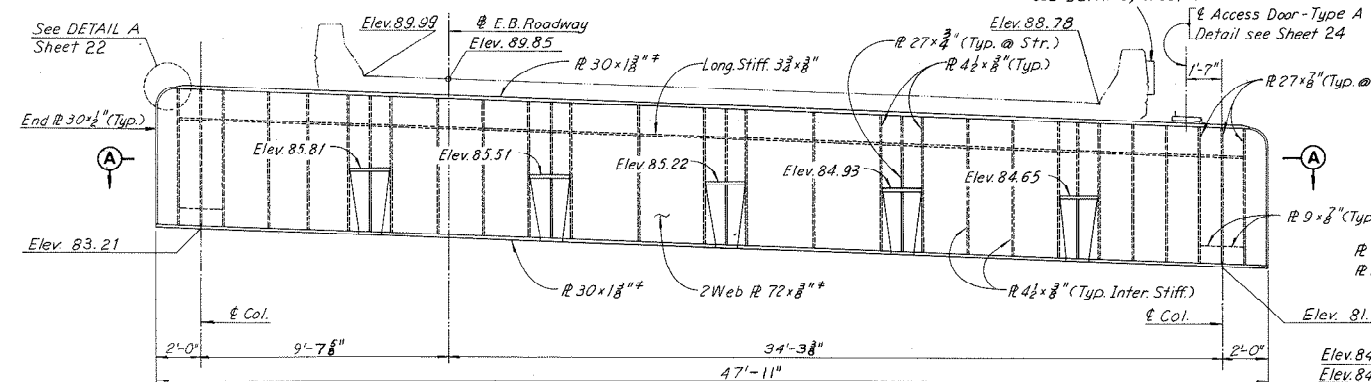


CAP BEAM ELEVATION - PIER 17
Scale: 1/4" = 1'-0"

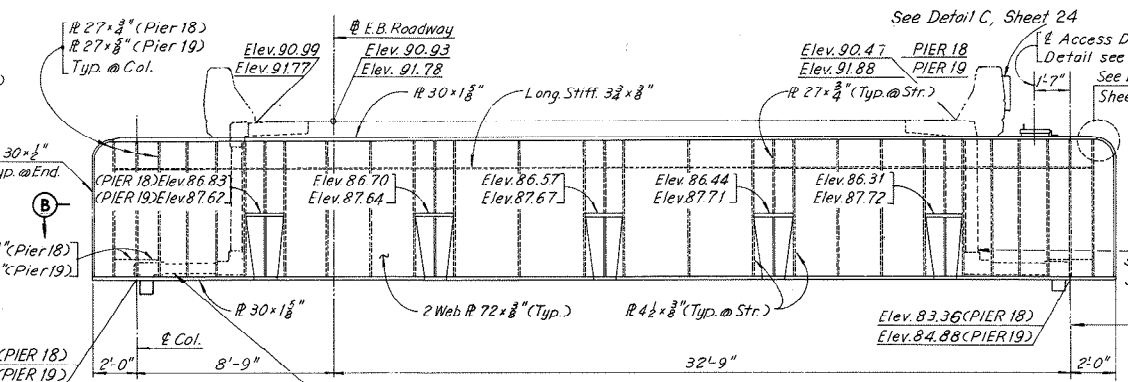


CAP BEAM ELEVATION - PIERS 18 AND 19
Scale: 1/4" = 1'-0"

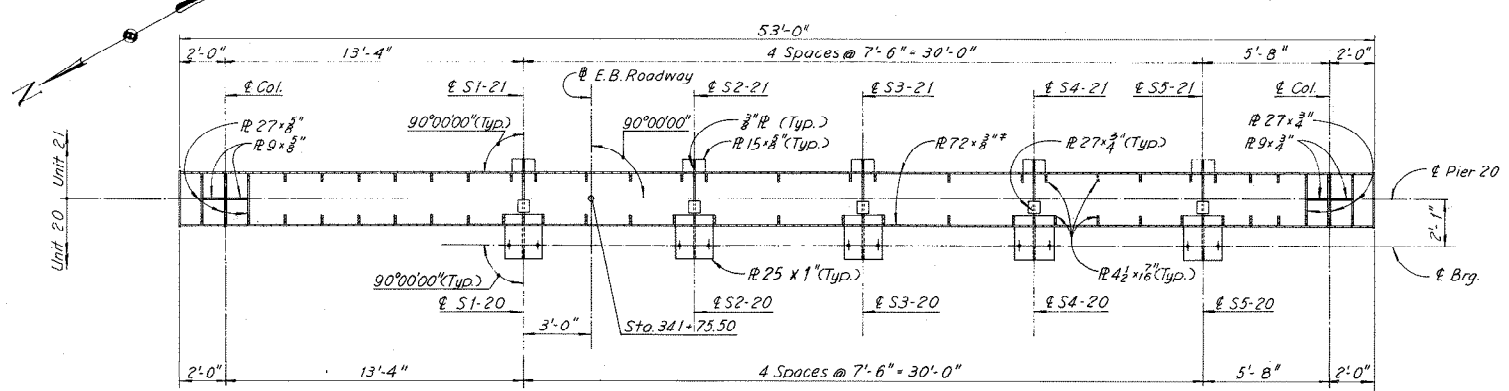

SECTION C-C
Scale: 1/4" = 1'-0"

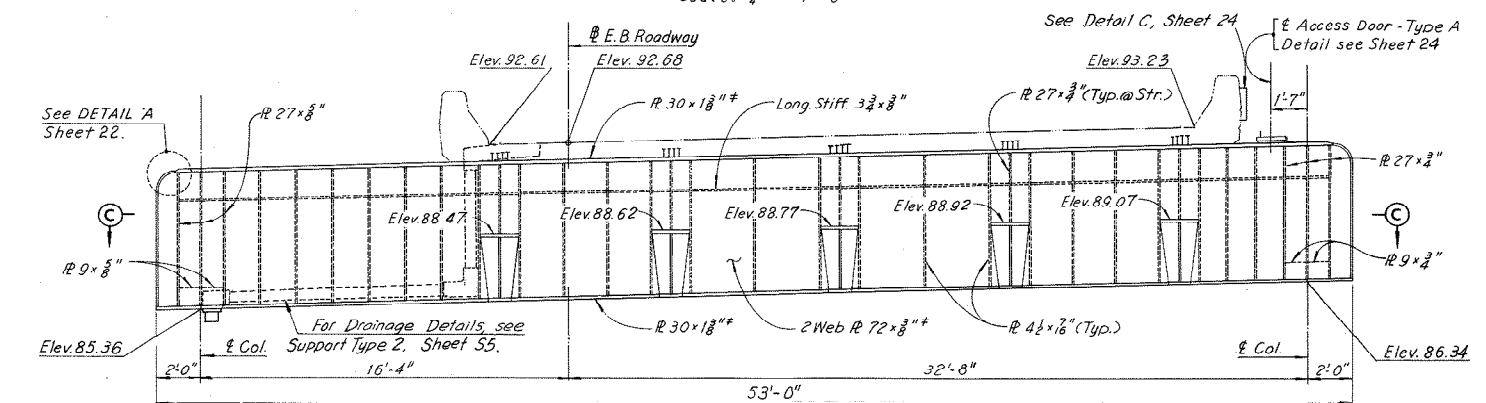


CAP BEAM ELEVATION - PIER 20
Scale: 1/4" = 1'-0"

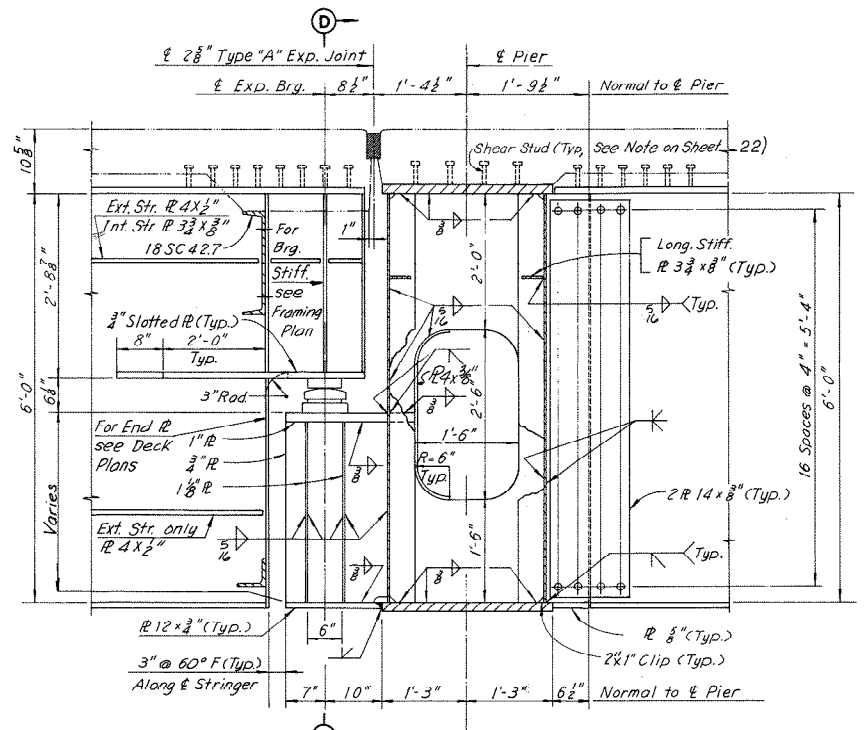

TYPICAL SECTION
Scale: 3/8" = 1'-0"

Notes:
For Framing Plans see:
Sheet 18 for Units 17 & 18.
Sheet 19 for Units 19 & 20.
Sheet 20 for Units 21 & 22.
For Deck Plans see:
Sheet 32 for Units 17 & 18.
Sheet 33 for Units 19 & 20.
Sheet 34 for Units 21 & 22.

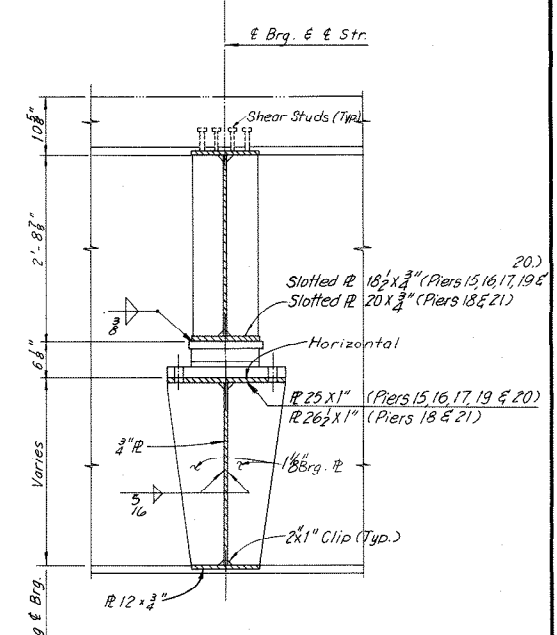

SECTION D-D
Scale: 3/8" = 1'-0"

Note:
All steel shall be A36 unless denoted otherwise.
* Denotes A572-Grade 50 steel for thickness of 3/4" and under and A588 steel for thickness over 3/4".
Provide Drain Holes at lower end of cap beam.
All elevations shown are final elevations.

BY	DATE	REVISION	BY	DATE
MADE	M.H.H. 12-17-68			
CHECKED	J.D. 1-29-69	As Built	TEM	B-7C
IN CHARGE				





















RICHMOND METROPOLITAN AUTHORITY
RICHMOND EXPRESSWAY SYSTEM
DOWNTOWN EXPRESSWAY

BRIDGE NO. 66
EASTBOUND ROADWAY OVER
12TH ST. - R.R. TRACKS AND 16TH ST.
FRAMING DETAILS
PIERS 17, 18, 19 AND 20

HOWARD, NEEDLES, TAMMEN & BERGENDOFF
consulting engineers
NEW YORK ALEXANDRIA KANSAS CITY
SCALE: As Noted
CONTRACT NO. 10
SHEET NO. 23 OF 46

AS BUILT

RICHMOND EXPRESSWAY SYSTEM			
SECTION	PROJECT	SHEET NO.	TOTAL SHEETS
10	DOWNTOWN EXPRESSWAY	153	265

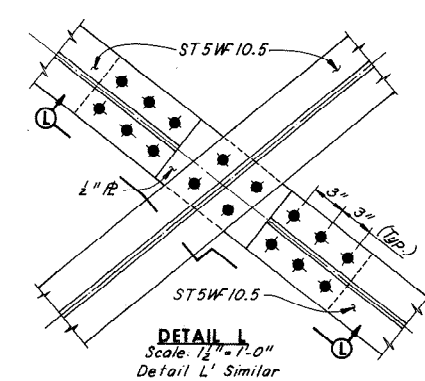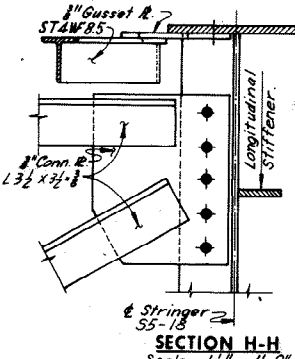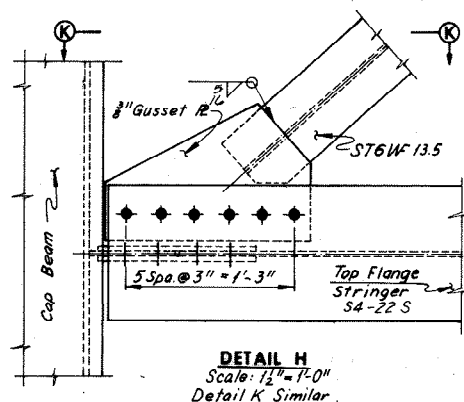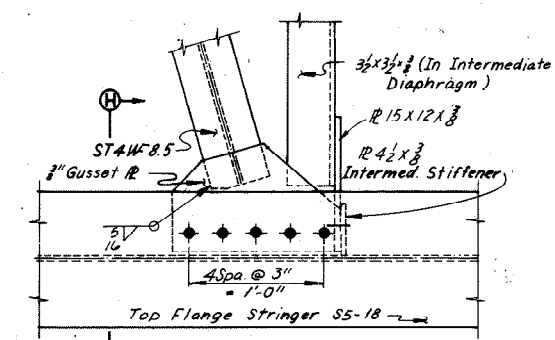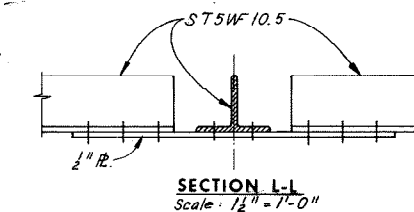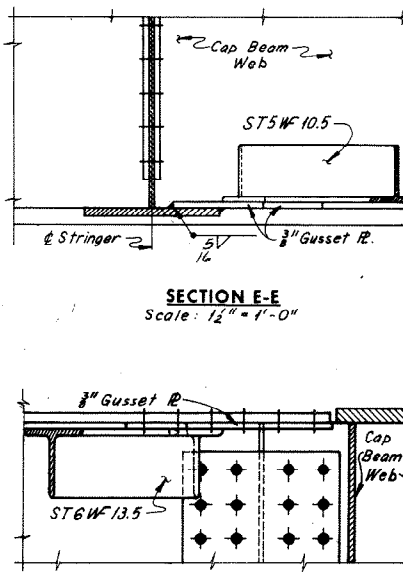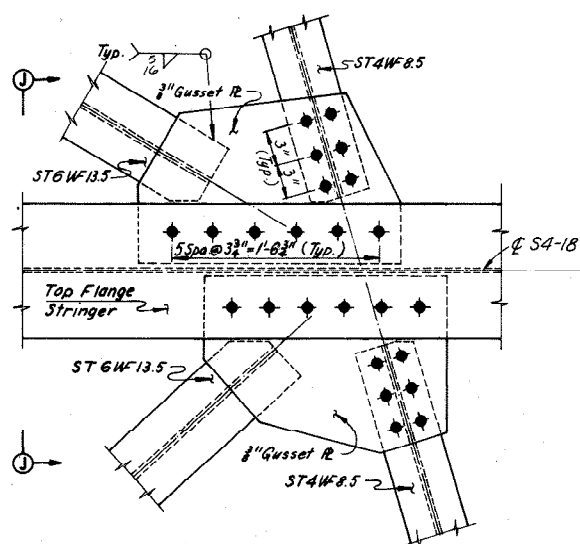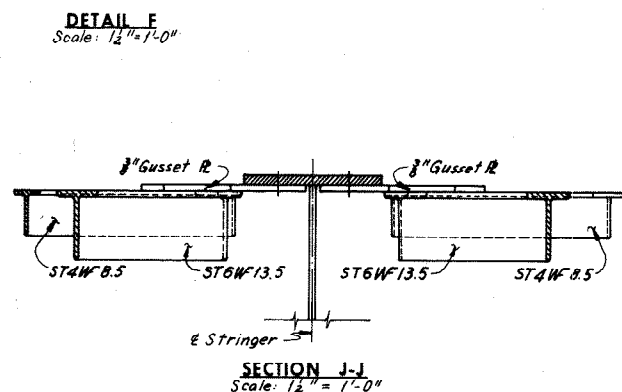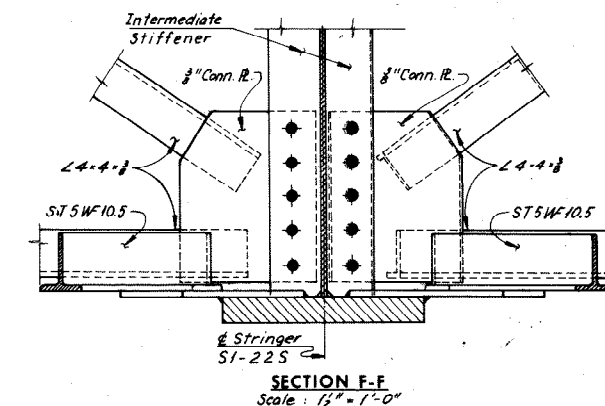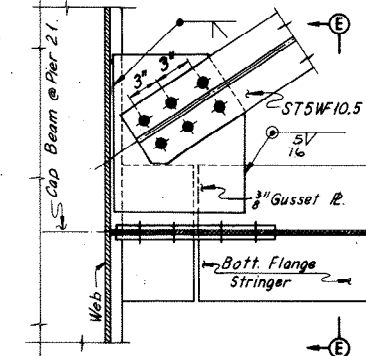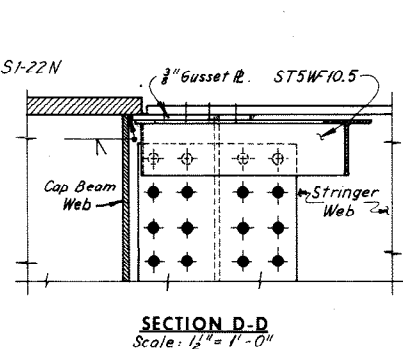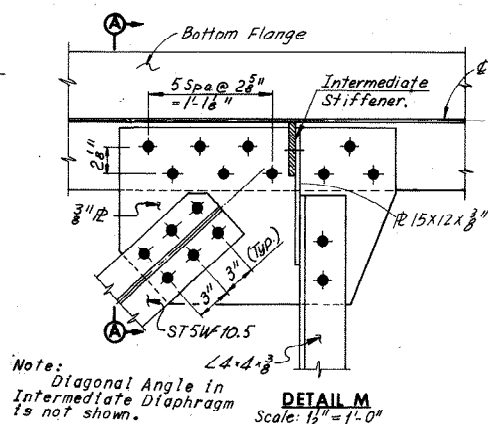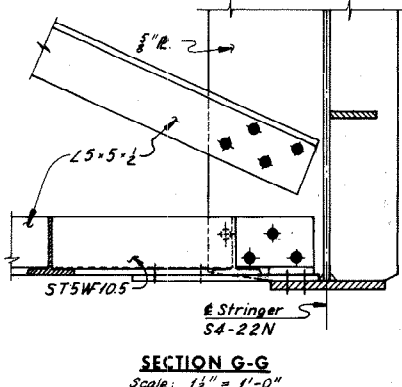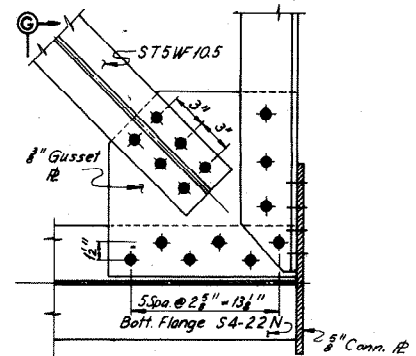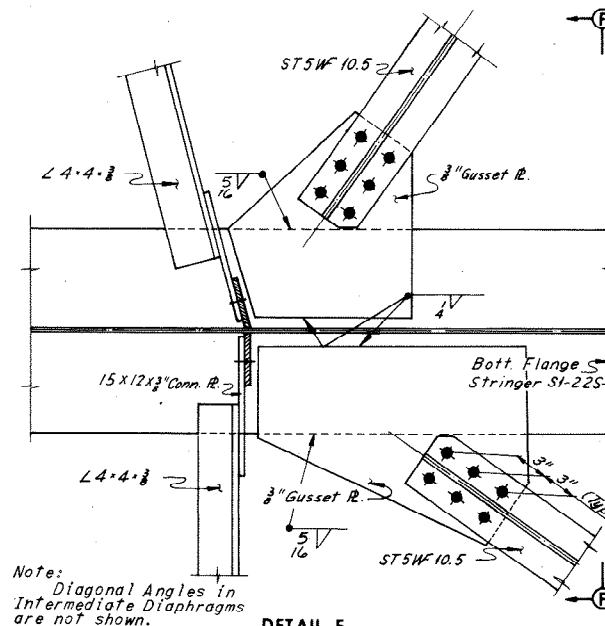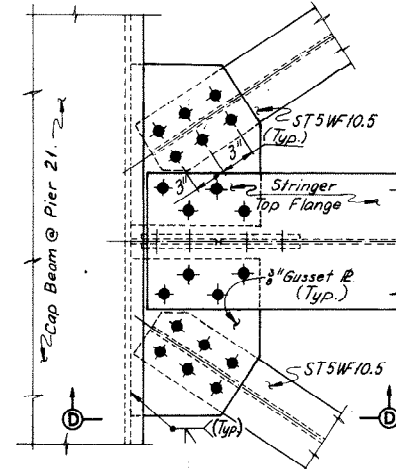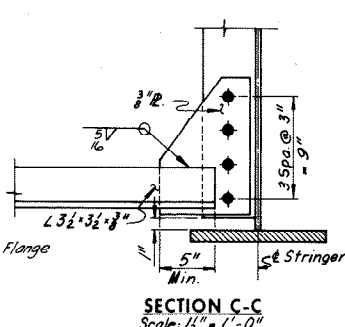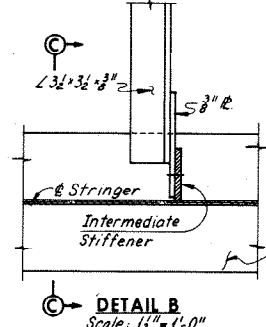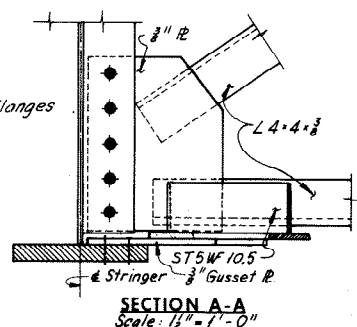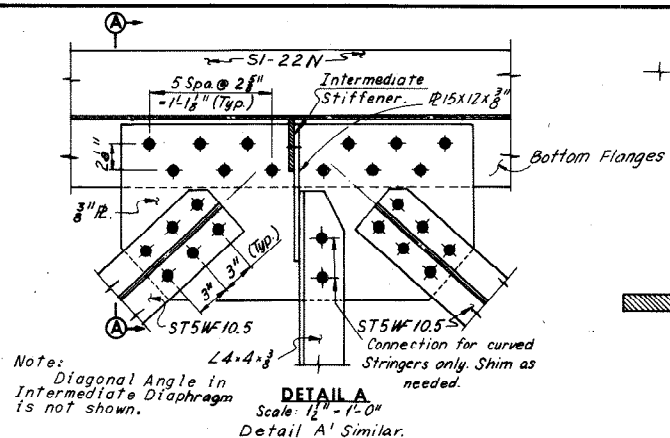

Note: For location of Details A, A', B, C, D, E, F, H, J, L, L' and M, see Sheet 20. For location of Details G, G', J and K, see Sheet 18.

BY	DATE	NO.	REVISION	BY	DATE
MADE	PTA 12-14-68				
CHECKED	AMH 2-10-69	1	As Built	TEM	8-76
IN CHARGE					

RICHMOND METROPOLITAN AUTHORITY
RICHMOND EXPRESSWAY SYSTEM
DOWNTOWN EXPRESSWAY


BRIDGE NO. 66
EASTBOUND ROADWAY OVER
12TH ST., R.R. TRACKS AND 16TH ST.
FRAMING DETAILS
UNITS 18, 21 AND 22

HOWARD, NEEDLES, TAMMEN & BERGENDOFF
consulting engineers
NEW YORK ALEXANDRIA KANSAS CITY



SCALE: As Noted
CONTRACT NO. 10
SHEET NO. 27 OF 46

AS BUILT

RICHMOND EXPRESSWAY SYSTEM			
SECTION	PROJECT	SHEET NO.	TOTAL SHEETS
10	DOWNTOWN EXPRESSWAY	154	265

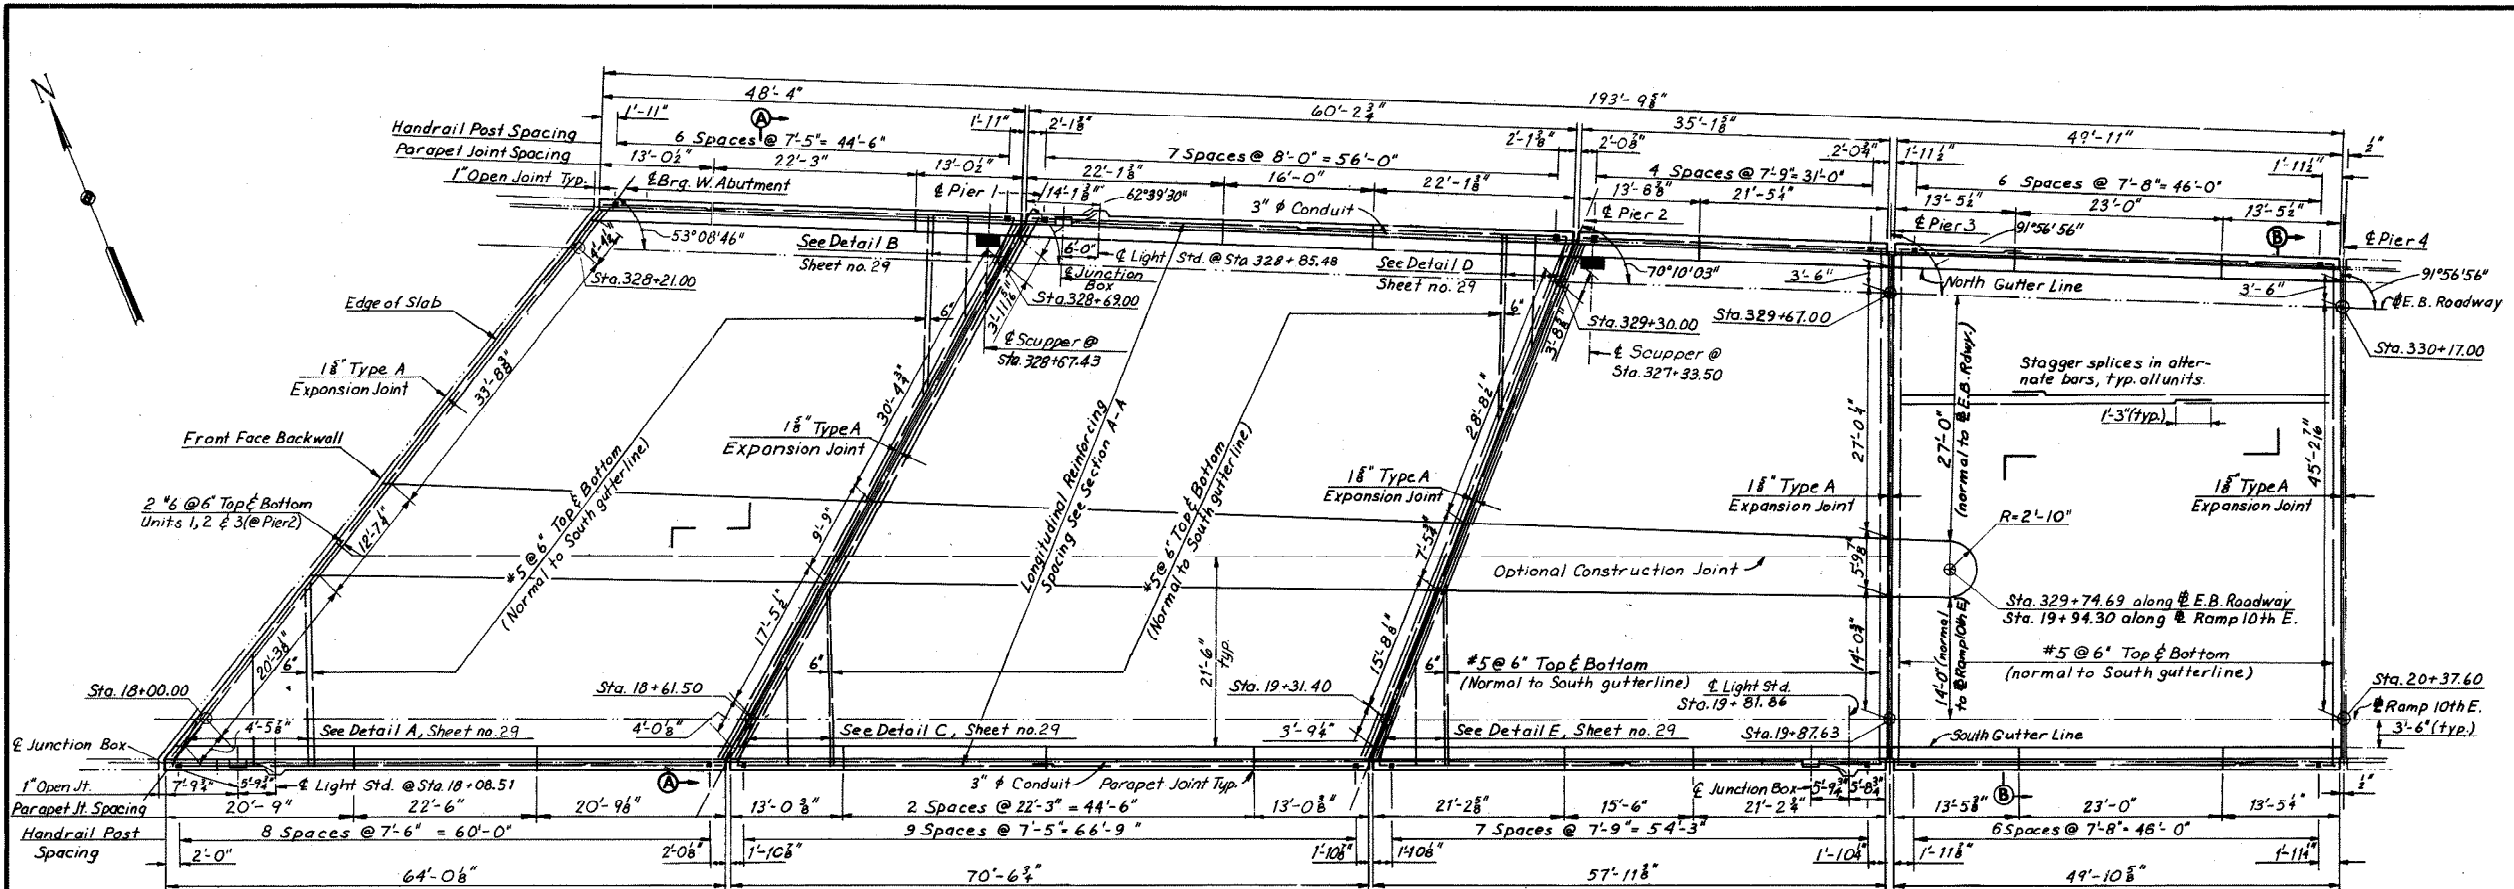

ELEVATION TABLE					
STATION	ELEV. A	ELEV. B	ELEV. C	ELEV. E	ELEV.
328+00.00	76.13	76.33	77.81	—	—
+00.00	—	—	77.81	—	—
+10.00	76.29	76.48	77.91	—	—
+20.00	76.44	76.63	78.00	—	—
+21.00	—	—	76.64	—	—
+23.62	76.50	—	—	—	—
+30.00	76.61	76.77	78.10	—	—
+40.00	76.76	76.92	78.19	—	—
+50.00	76.91	77.07	78.28	—	—
+55.04	—	—	78.33	—	—
+60.00	77.07	77.22	78.38	—	—
+69.00	—	—	77.35	—	—
+70.00	77.22	77.37	78.47	—	—
+70.81	77.25	—	—	—	—
+80.00	77.38	77.51	78.57	—	—
+90.00	77.53	77.66	78.66	—	—
329+00.00	77.68	77.81	78.75	—	—
+10.00	77.84	77.96	78.85	—	—
+20.00	77.99	78.11	78.94	—	—
+20.26	—	—	78.95	—	—
+30.00	78.16	78.25	79.04	—	—
+31.26	78.17	—	—	—	—
+40.00	78.31	78.40	79.13	—	—
+50.00	78.46	78.55	79.22	—	—
+60.00	78.62	78.70	79.32	—	—
+66.88	78.73	—	—	—	—
+67.00	—	—	78.80	—	—
+67.92	—	—	79.39	—	—
+70.00	78.77	78.85	79.41	—	—
+80.00	78.93	78.99	—	79.88	79.94
+90.00	79.08	79.14	—	79.93	79.99
330+00.00	79.23	79.29	—	79.98	80.03
+10.00	79.39	79.44	—	80.03	80.08
+16.88	79.51	—	—	—	—
+17.00	—	—	79.54	—	—
+18.54	—	—	—	—	80.08
+18.64	—	—	—	—	80.12
+20.00	79.54	79.59	—	80.08	80.13

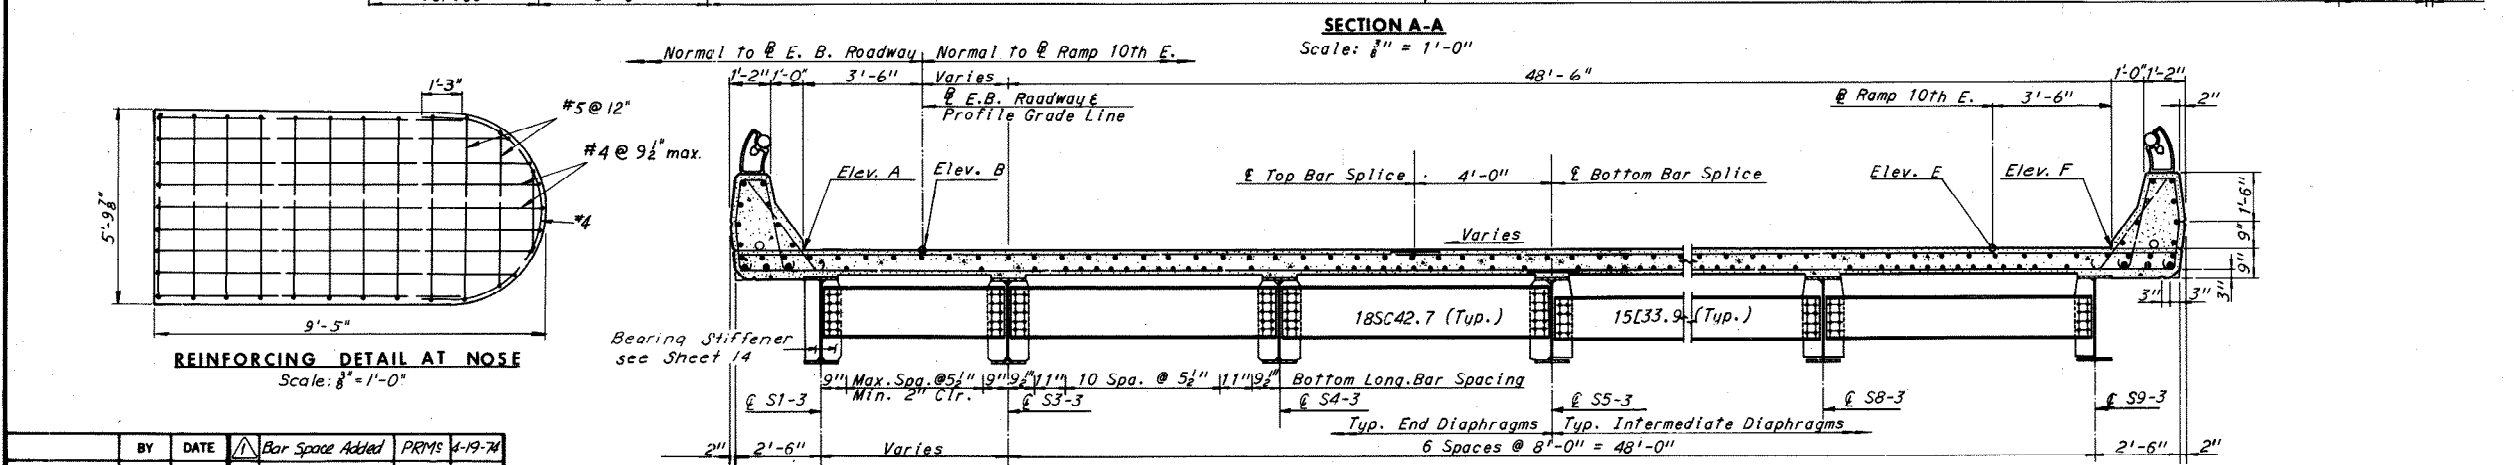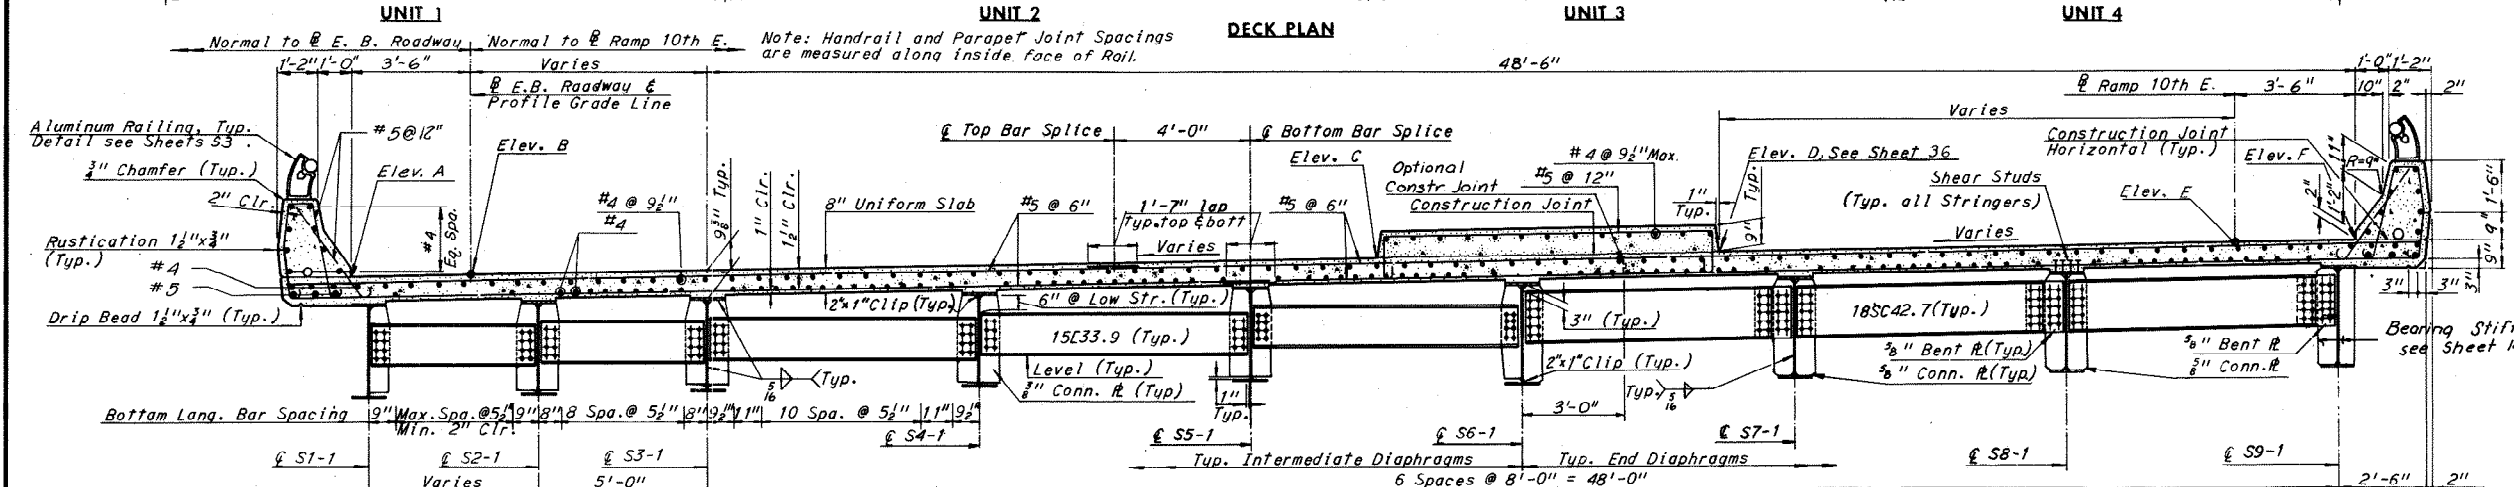

Note: For Elevations along @ Ramp 10th East, see Sheet 33.

Notes:
 For Joint Details, see Sheet 37
 For Framing Plan, see Sheet 14.
 For Handrail Details, see Sheet S3
 For Superstructure quantities, see Sheet 2.
 For Details A, B, C, D and E, see Sheet 29
 For Standard Drainage Details, see Support Type 1, Sheet S5 & S6.

BY	DATE	Bar Space Added	PRMS	4-19-74
MADE	J.D.	8-6-68	2 As Built	T.E.M. 8-76
CHECKED	J.V.	10-23-68		
IN CHARGE				

RICHMOND METROPOLITAN AUTHORITY
RICHMOND EXPRESSWAY SYSTEM
DOWNTOWN EXPRESSWAY


BRIDGE NO. 66
EASTBOUND ROADWAY OVER
12TH ST. - R.R. TRACKS AND 16TH ST.
DECK PLAN - UNITS 1,2,3 AND 4

HOWARD, NEEDLES, TAMMEN & BERGENDOFF
 consulting engineers
 NEW YORK ALEXANDRIA KANSAS CITY



SCALE: 1/2" = 1'-0" Unless shown
 CONTRACT NO. 10
 SHEET NO. 26 OF 46

AS BUILT

RICHMOND EXPRESSWAY SYSTEM			
SECTION	PROJECT	SHEET NO.	TOTAL SHEETS
10	DOWNTOWN EXPRESSWAY	157	265

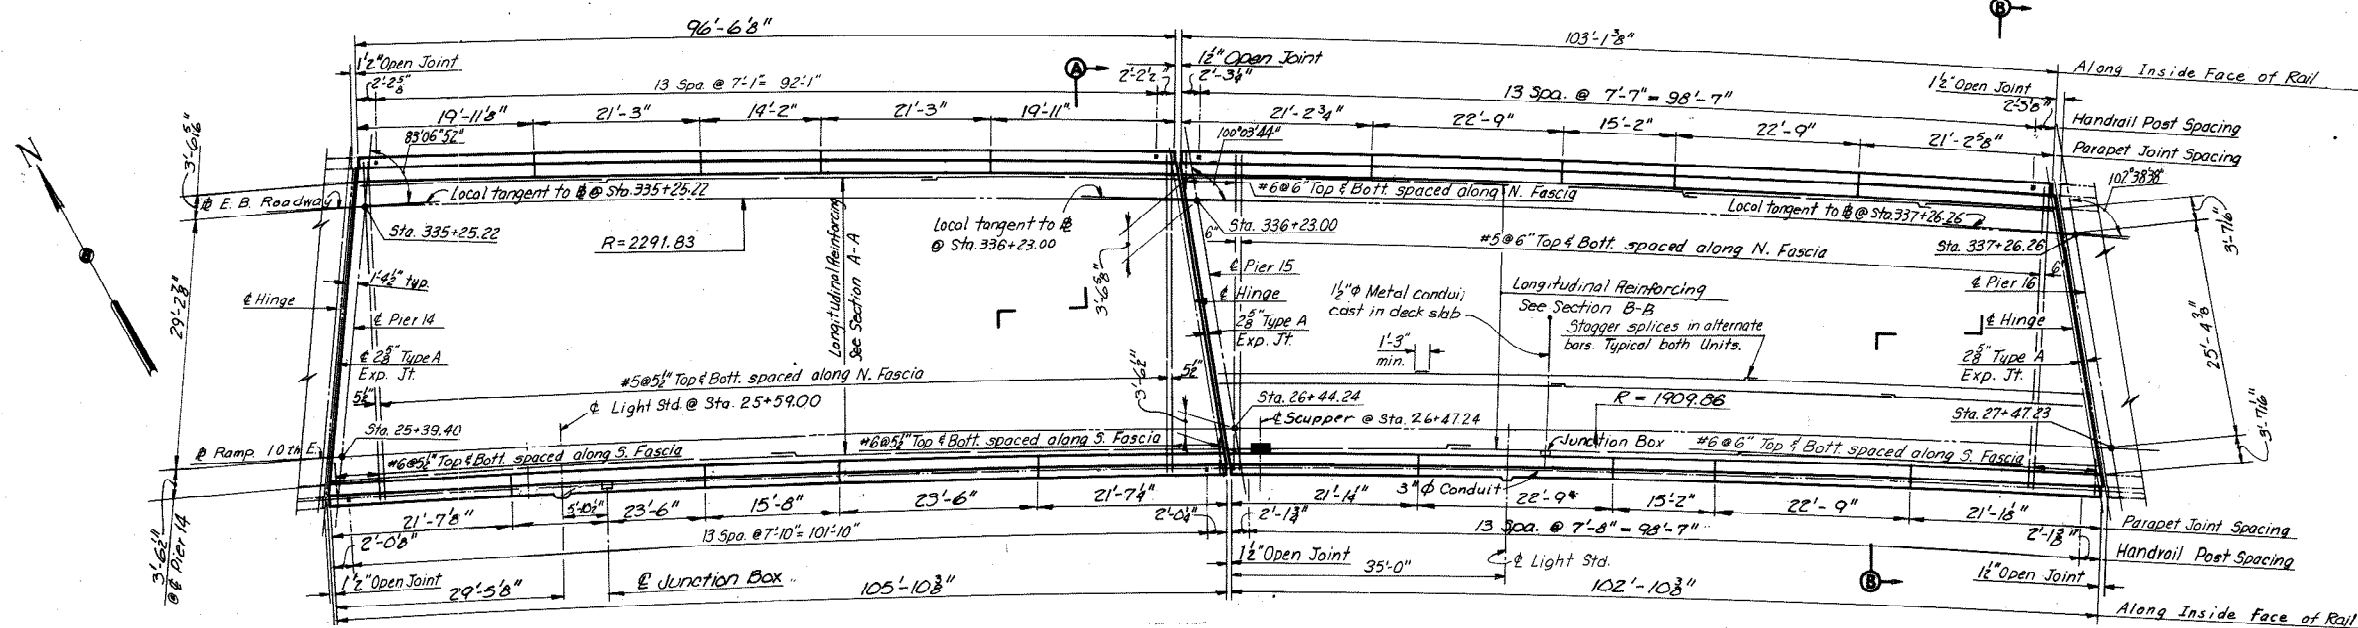

ELEVATION TABLE			
STATION	ELEV. A	ELEV. B	ELEV. C
335+10.00	87.01	86.84	85.20
+20.00	87.15	86.97	85.35
+21.29	—	—	85.36
+25.22	87.22	—	—
+30.00	87.18	87.11	85.50
+40.00	87.40	87.23	85.64
+50.00	87.53	87.35	85.76
+60.00	87.63	87.46	85.89
+70.00	87.74	87.57	86.01
+80.00	87.85	87.67	86.11
+90.00	87.93	87.76	86.23
336+00.00	88.02	87.85	86.33
+10.00	88.10	87.93	86.42
+20.00	88.19	88.02	86.52
+22.38	88.21	—	—
+23.00	—	88.04	—
+28.25	—	—	86.60
+30.00	88.27	88.10	86.61
+40.00	88.36	88.19	86.70
+50.00	88.44	88.27	86.80
+60.00	88.52	88.35	86.89
+70.00	88.61	88.44	86.98
+80.00	88.69	88.52	87.08
+90.00	88.78	88.61	87.17
337+00.00	88.86	88.69	87.26
+10.00	88.94	88.77	87.35
+20.00	89.03	88.86	87.44
+25.48	89.08	—	—
+26.26	—	88.91	—
+30.00	89.11	88.94	87.53
+32.60	—	—	87.55
337+40.00	89.20	89.03	87.62

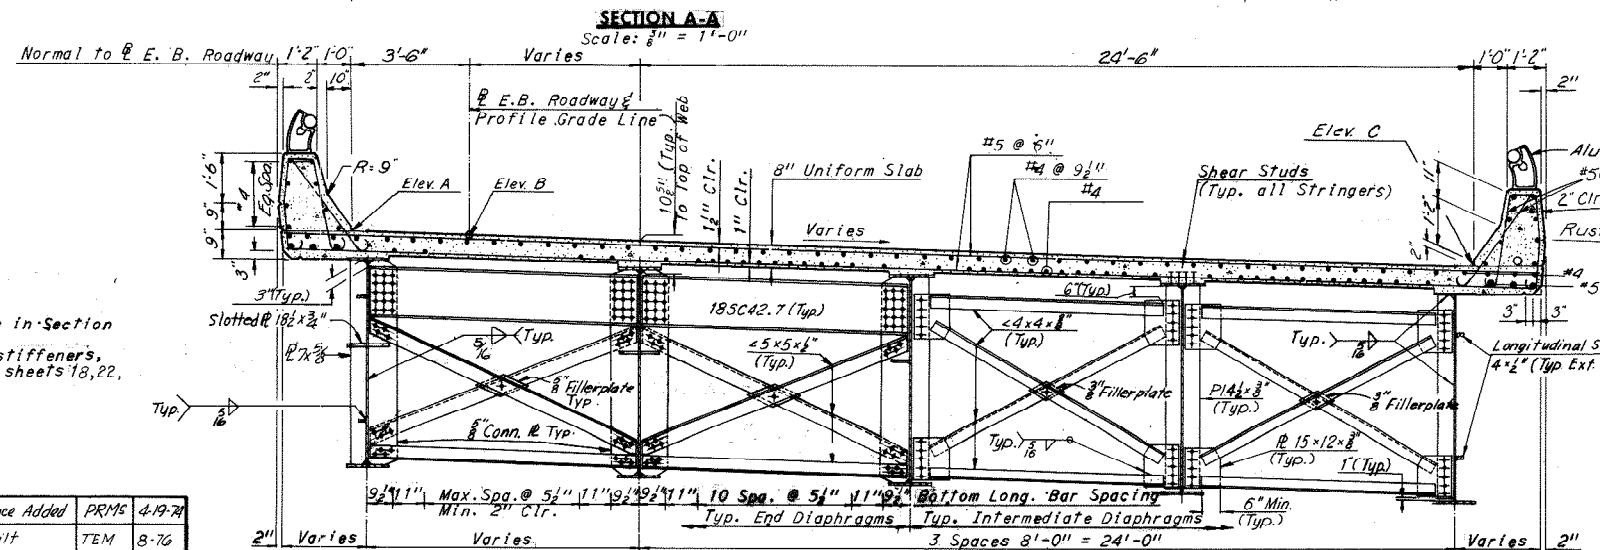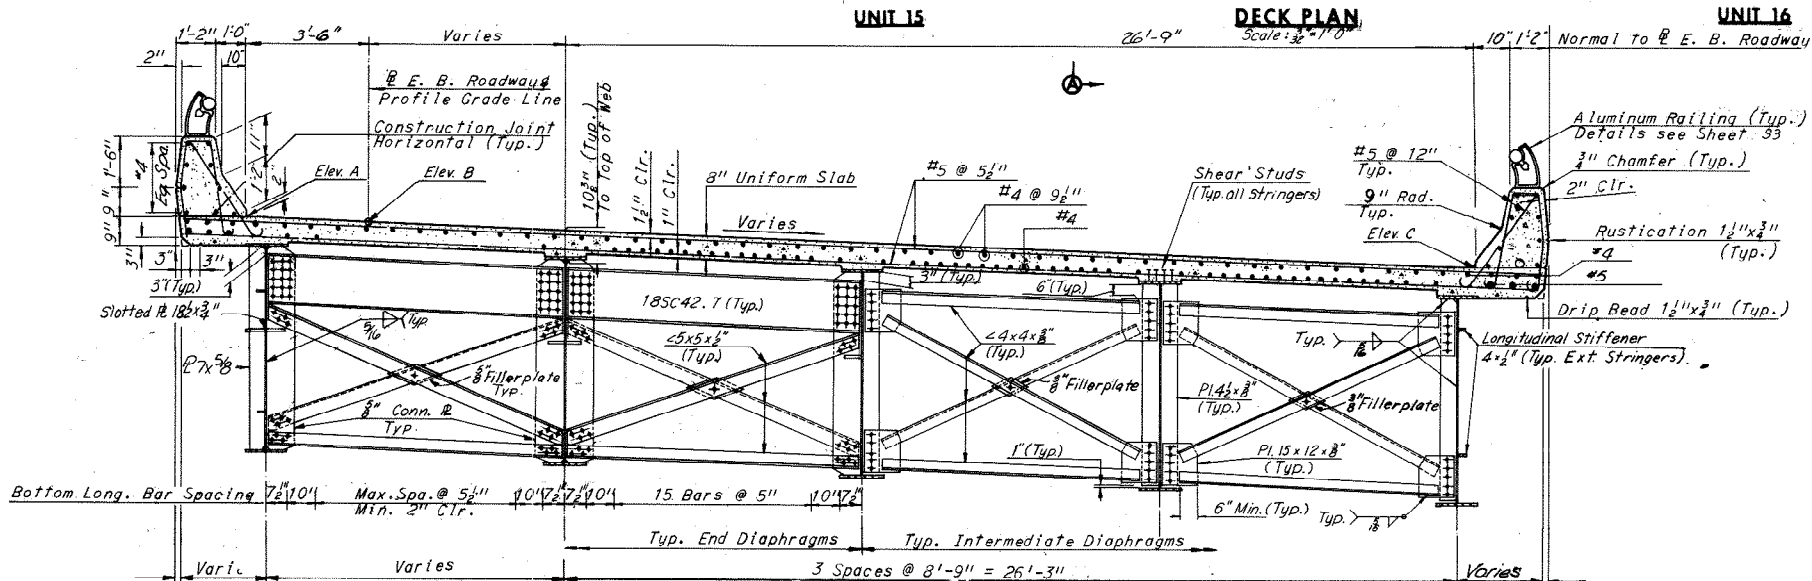

Notes:
 For details not shown in Section B-B, see Section A-A.
 For details of brg. stiffeners, long. stiffeners, see sheets 18, 22, and 23.

Notes:
 For Joint Details, see Sheet 38.
 For Framing Plan, see Sheet 17.
 For Handrail Details, see Sheet 53.
 For Superstructure quantities, see Sheet 2.
 For Standard Drainage Details, see Support Type 2 Sheet 55/56.

BY	DATE	Bar Space Added	PRMS	4-19-74		
MADE	RLM	8-6-68	2	As Built	TEM	8-76
CHECKED	SCC	10-27-68				
IN CHARGE						

RICHMOND METROPOLITAN AUTHORITY
RICHMOND EXPRESSWAY SYSTEM
DOWNTOWN EXPRESSWAY


BRIDGE NO. 66
EASTBOUND ROADWAY OVER
12TH ST. - R.R. TRACKS AND 16TH ST.
DECK PLAN - UNITS 15 AND 16

HOWARD, NEEDLES, TAMMEN & BERGENDOFF
 consulting engineers
 NEW YORK ALEXANDRIA KANSAS CITY



SCALE: As Noted
 CONTRACT NO. 10
 SHEET NO. 31 OF 46

AS BUILT

RICHMOND EXPRESSWAY SYSTEM			
SECTION	PROJECT	SHEET NO.	TOTAL SHEETS
10	DOWNTOWN EXPRESSWAY	158	265

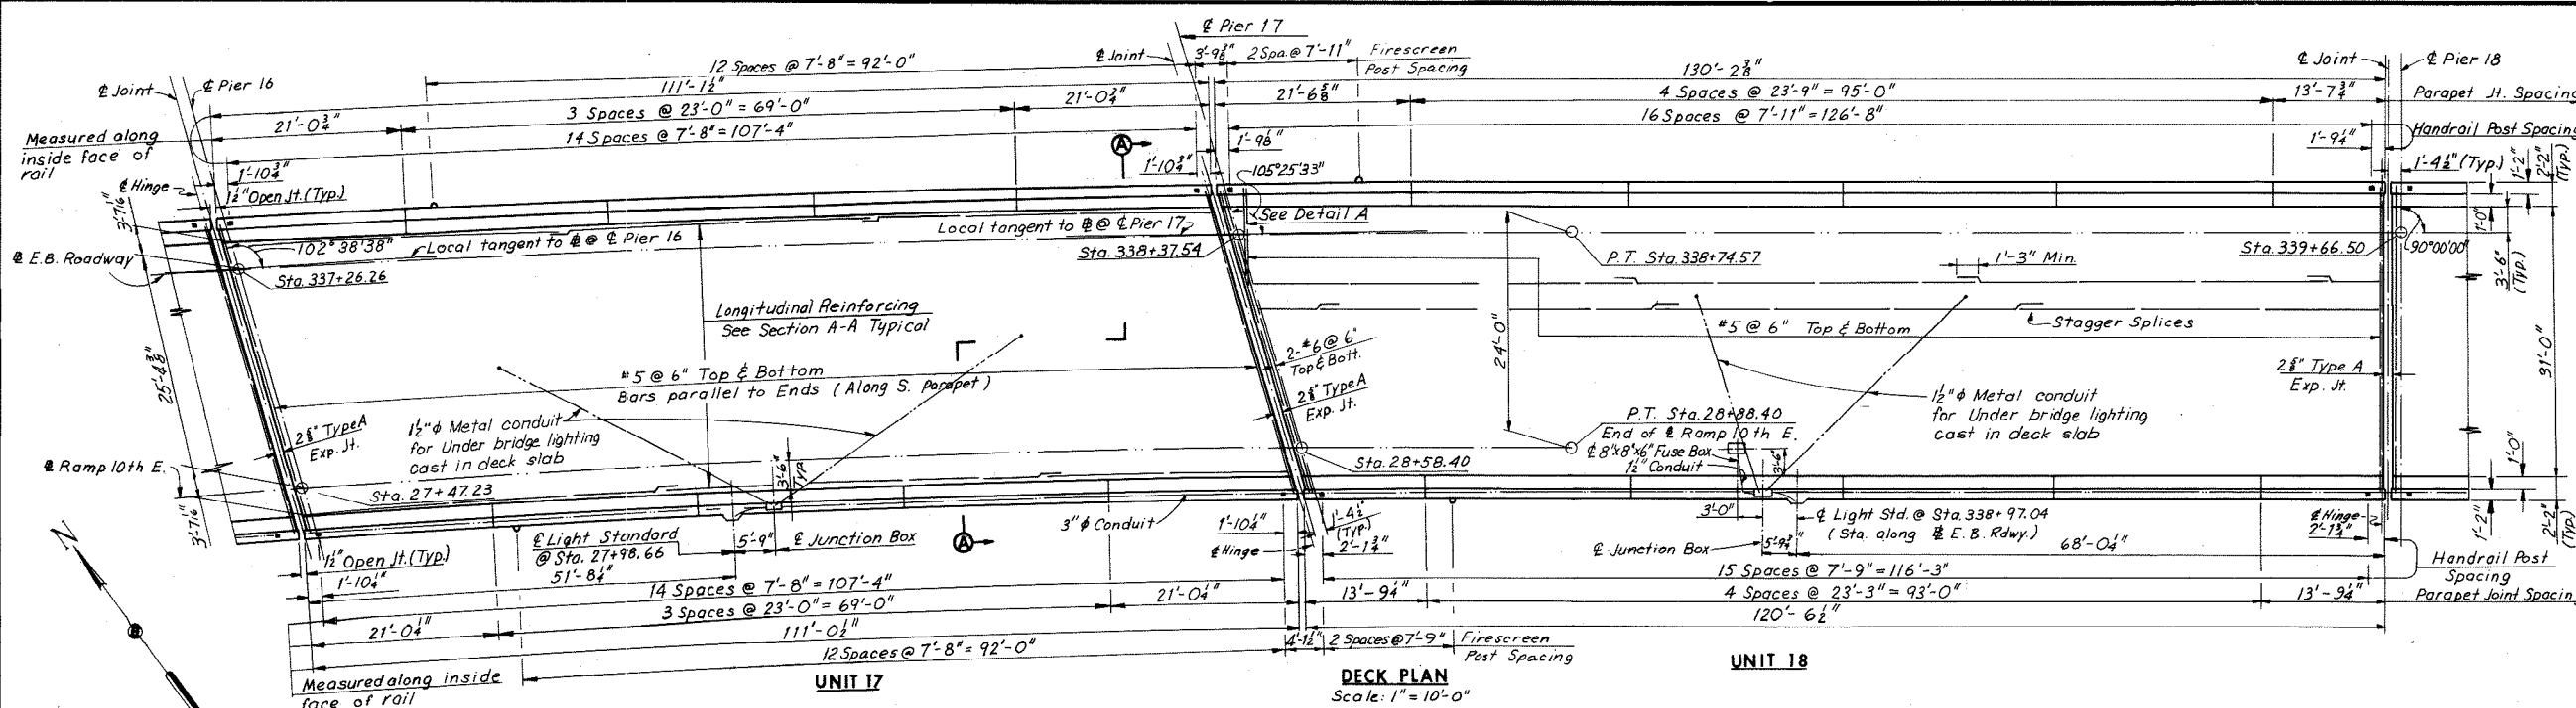

ELEVATION TABLE			
STATION	ELEV. A	ELEV. B	ELEV. C
337+20.00	89.03	88.86	87.44
+25.48	89.08	--	--
+26.26	--	88.91	--
+30.00	89.11	88.94	87.53
+32.60	--	--	87.55
+40.00	89.20	89.03	87.62
+50.00	89.28	89.11	87.71
+60.00	89.36	89.19	87.80
+70.00	89.45	89.28	87.89
+80.00	89.53	89.36	87.98
+90.00	89.62	89.45	88.07
338+00.00	89.70	89.53	88.18
+10.00	89.78	89.61	88.30
+20.00	89.86	89.70	88.43
+30.00	89.93	89.78	88.51
+36.58	89.99	--	--
+37.54	--	89.85	--
+40.00	90.01	89.87	88.71
+45.13	--	--	88.78
+50.00	90.09	89.95	88.85
+60.00	90.17	90.03	88.99
+70.00	90.25	90.12	89.13
+80.00	90.32	90.20	89.26
+90.00	90.40	90.29	89.40
339+00.00	90.48	90.37	89.54
+10.00	90.55	90.45	89.69
+20.00	90.63	90.54	89.83
+30.00	90.70	90.62	89.96
+40.00	90.78	90.71	90.10
+50.00	90.86	90.79	90.24
+60.00	90.94	90.87	90.38
+66.50	90.99	90.93	90.47
+70.00	91.02	90.96	90.52

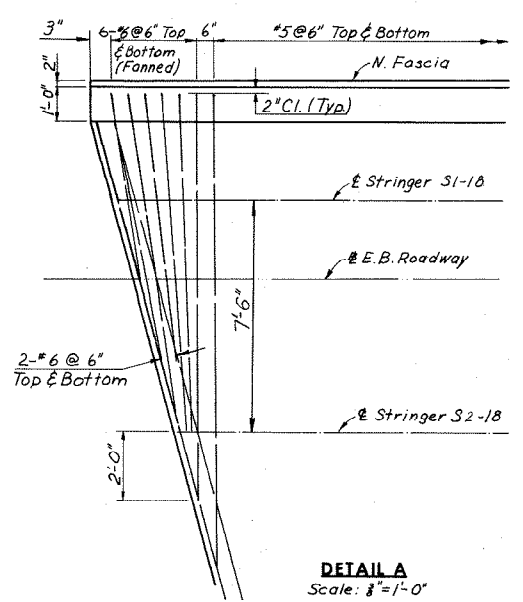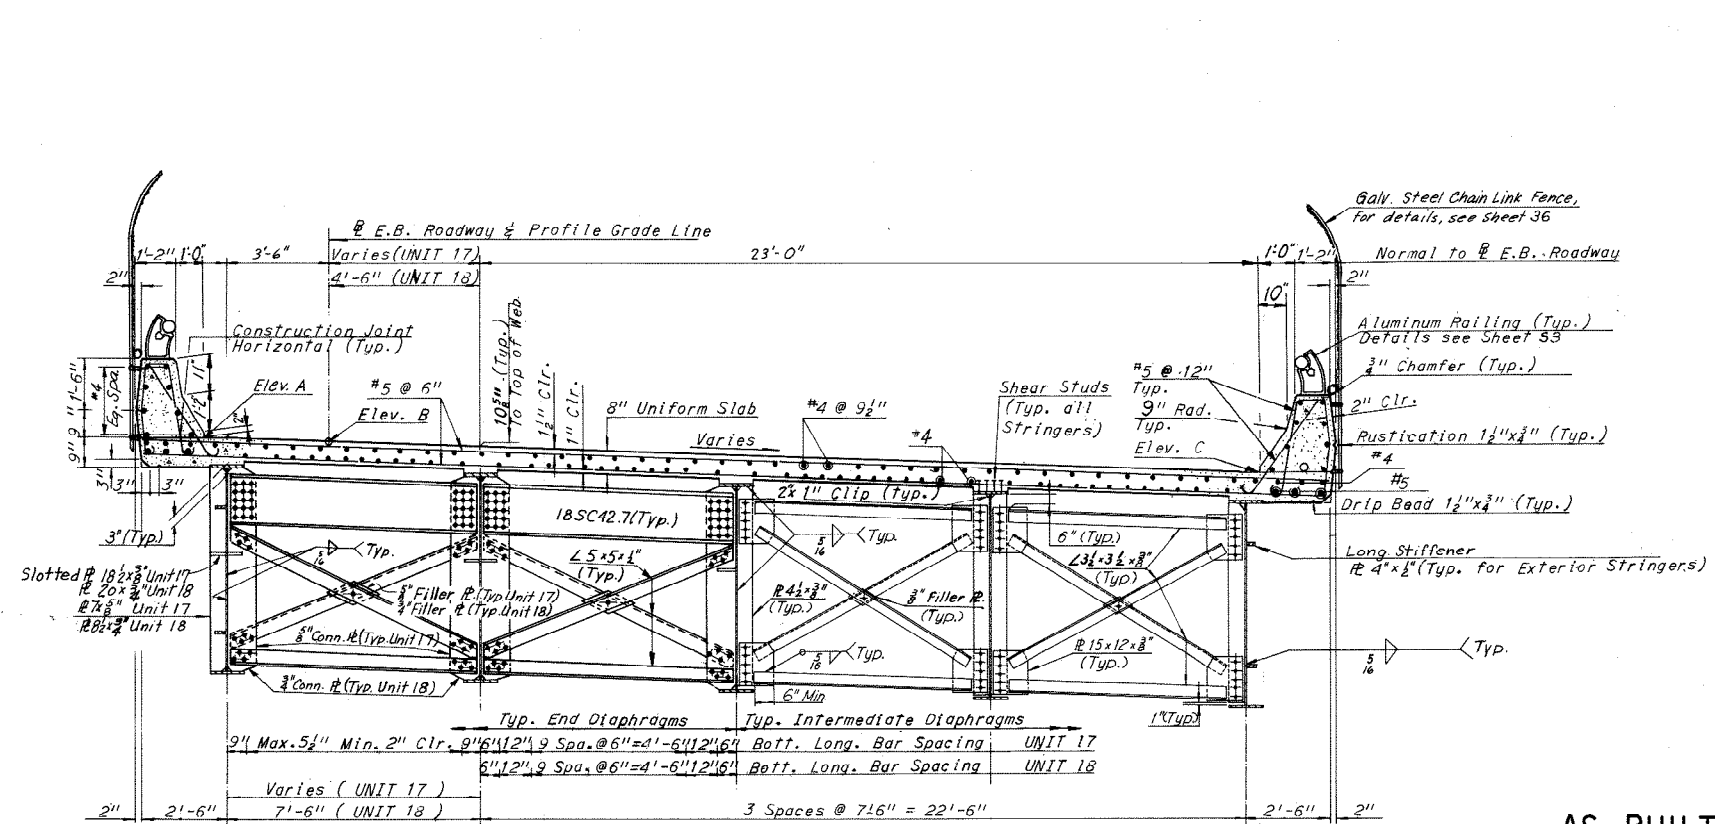

BY	DATE				
MADE	J.D.	8-9-68			
CHECKED	R.C.	10-18-68	As Built	TEM	8-70
IN CHARGE					

AS BUILT

Notes:
For Joint Details, see Sheet 38.
For Framing Plan, see Sheet 18.
For Handrail Details, see Sheet 53.
For Superstructure quantities, see Sheet 2.

RICHMOND METROPOLITAN AUTHORITY
RICHMOND EXPRESSWAY SYSTEM
DOWNTOWN EXPRESSWAY


BRIDGE NO. 66
EASTBOUND ROADWAY OVER
12TH ST. - R.R. TRACKS AND 16TH ST.
DECK PLAN - UNITS 17 AND 18

HOWARD, NEEDLES, TAMMEN & BERGENDOFF
consulting engineers
NEW YORK ALEXANDRIA KANSAS CITY

SCALE:
CONTRACT NO. 10
SHEET NO. 32 OF 46

RICHMOND EXPRESSWAY SYSTEM			
SECTION	PROJECT	SHEET NO.	TOTAL SHEETS
10	DOWNTOWN EXPRESSWAY	159	265


ELEVATION TABLE			
STATION	ELEV. A	ELEV. B	ELEV. C
339+60.00	90.94	90.87	90.38
+66.50	90.99	90.93	90.47
+70.00	91.02	90.96	90.52
+80.00	91.09	91.04	90.65
+90.00	91.17	91.13	90.79
340+00.00	91.24	91.21	90.94
+10.00	91.32	91.29	91.08
+20.00	91.40	91.38	91.22
+30.00	91.47	91.46	91.35
+40.00	91.55	91.55	91.49
+50.00	91.63	91.63	91.63
+60.00	91.71	91.71	91.77
+68.00	91.77	91.78	91.88
+70.00	91.79	91.80	91.91
+80.00	91.86	91.88	92.04
+90.00	91.94	91.97	92.18
341+00.00	92.02	92.05	92.32
+10.00	92.09	92.13	92.47
+20.00	92.17	92.22	92.61
+30.00	92.24	92.30	92.74
+40.00	92.32	92.39	92.87
+50.00	92.40	92.47	92.99
+60.00	92.49	92.55	93.09
+70.00	92.57	92.64	93.19
+75.50	92.61	92.68	93.23
+80.00	92.65	92.72	93.27

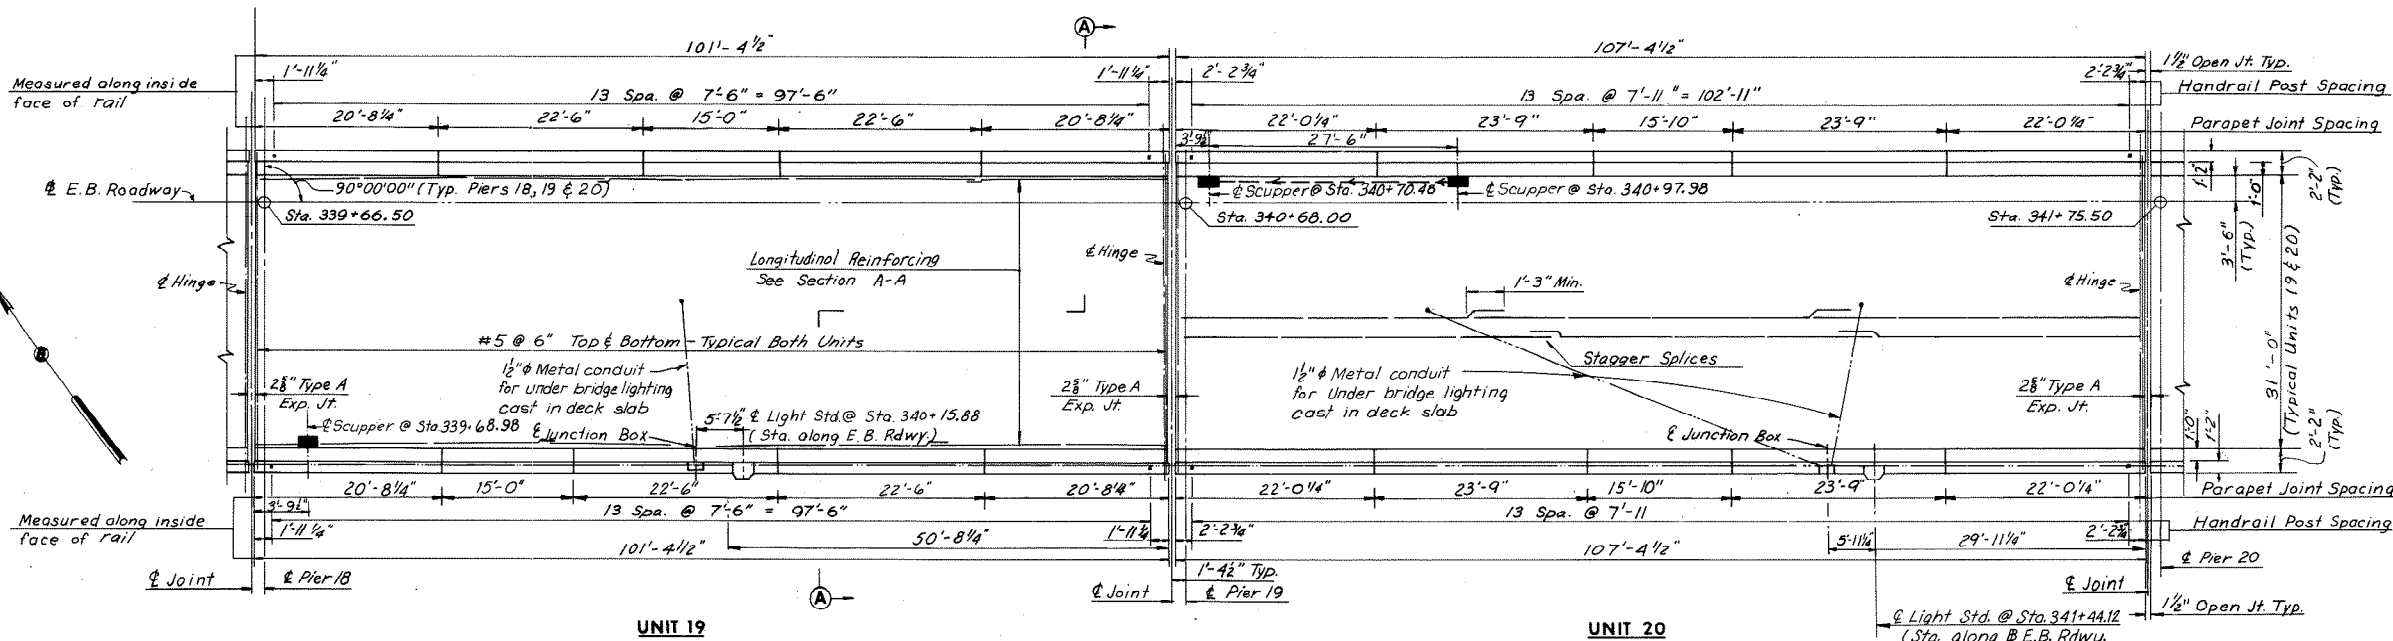


UNIT 19

UNIT 20


Note: For Standard Drainage details for Unit 19 See Support Type 2 Sheet 55 and for Unit 20 Support Type 7 Sheet 56.

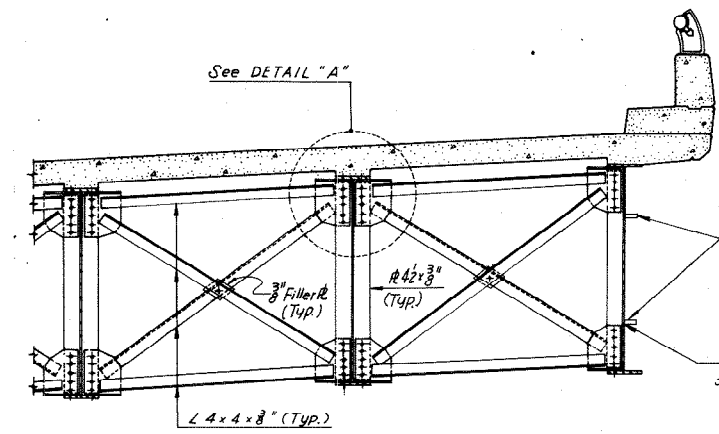


INTERMEDIATE DIAPHRAGM
Scale: 3/8" = 1'-0"

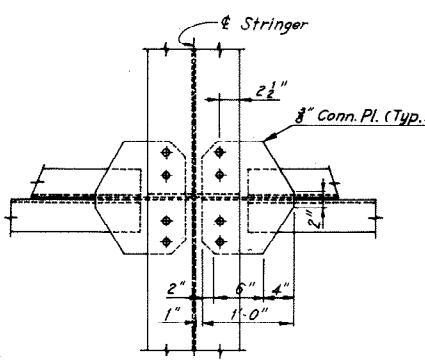

VIEW B-B
Scale: 1" = 1'-0"

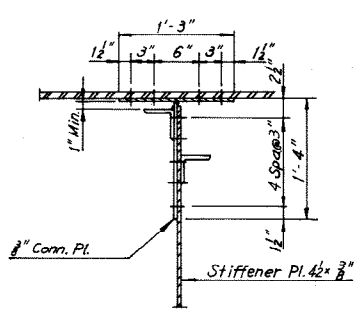


SECTION D-D
Scale: -

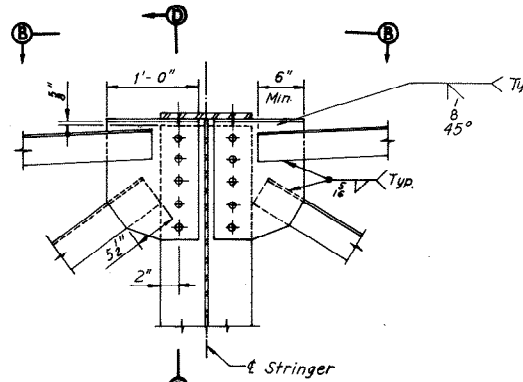

DETAIL A
Scale: 1" = 1'-0"

Note: Intermediate Diaphragm Details belong to Units 21 and 22, see Sheet 34

Note: For details of brg. stiffeners, see sheets 19 & 23

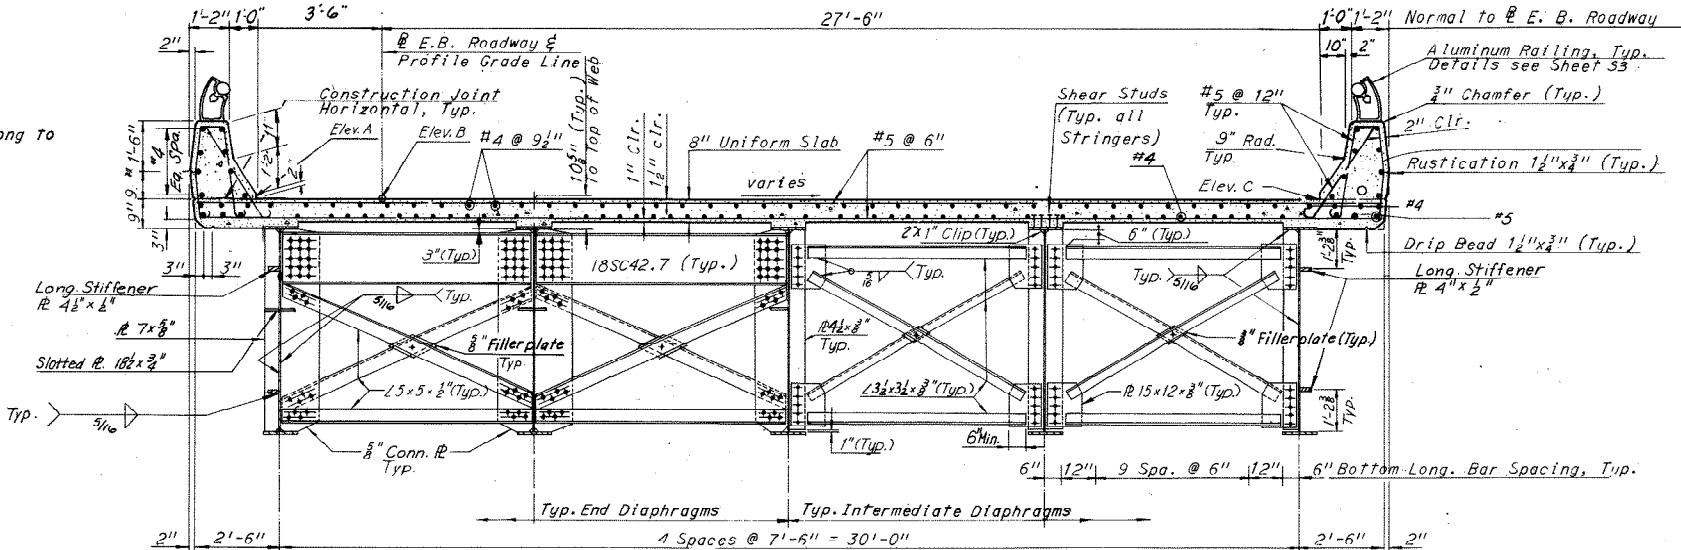

SECTION A-A
Scale: 3/8" = 1'-0"

Notes: For Joint Details, see Sheet 38
For Framing Plan, see Sheet 19
For Handrail Details, see Sheet 53
For Superstructure quantities, see Sheet 2.

RICHMOND METROPOLITAN AUTHORITY
RICHMOND EXPRESSWAY SYSTEM
DOWNTOWN EXPRESSWAY

BRIDGE NO. 66
EASTBOUND ROADWAY OVER
12TH ST. - R.R. TRACKS AND 16TH ST.
DECK PLAN-UNITS 19 AND 20








HOWARD, NEEDLES, TAMMEN & BERGENDOFF
consulting engineers
NEW YORK ALEXANDRIA KANSAS CITY

SCALE: As Noted
CONTRACT NO.: 10
SHEET NO. 33 OF 46

MADE	BY	DATE	NO.	REVISION	BY	DATE
	SHS	8-2-68				
CHECKED	R. C.	10-18-68	1	As Built	TEM	8-76
IN CHARGE						

AS BUILT

RICHMOND EXPRESSWAY SYSTEM			
SECTION	PROJECT	SHEET NO.	TOTAL SHEETS
10	DOWNTOWN EXPRESSWAY	163	265

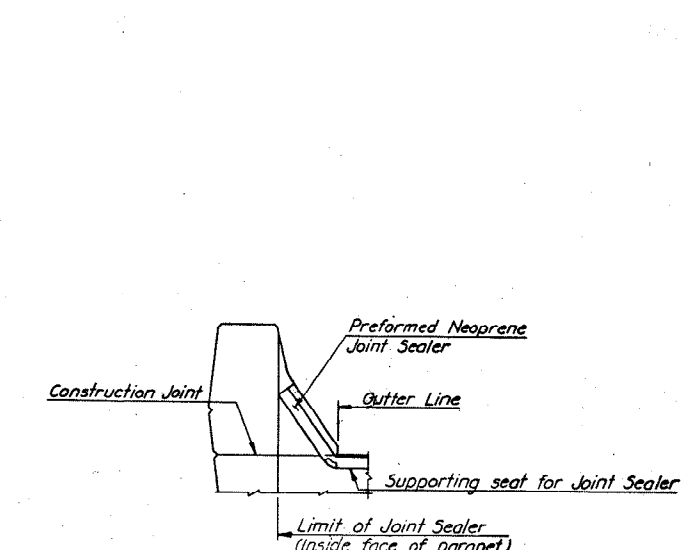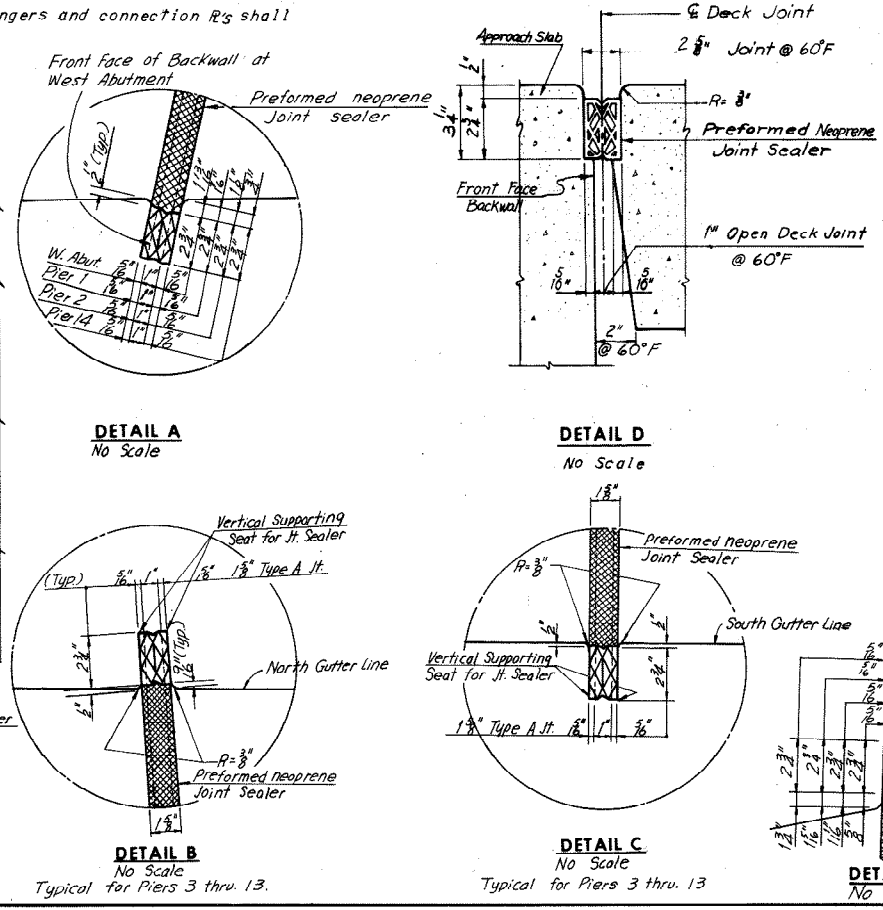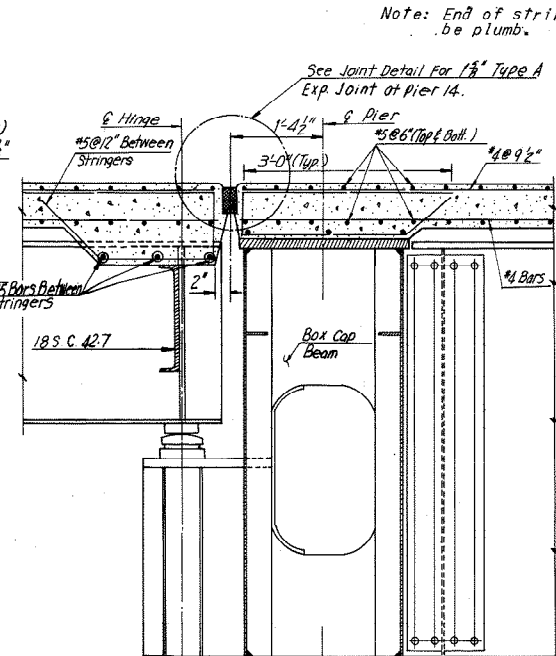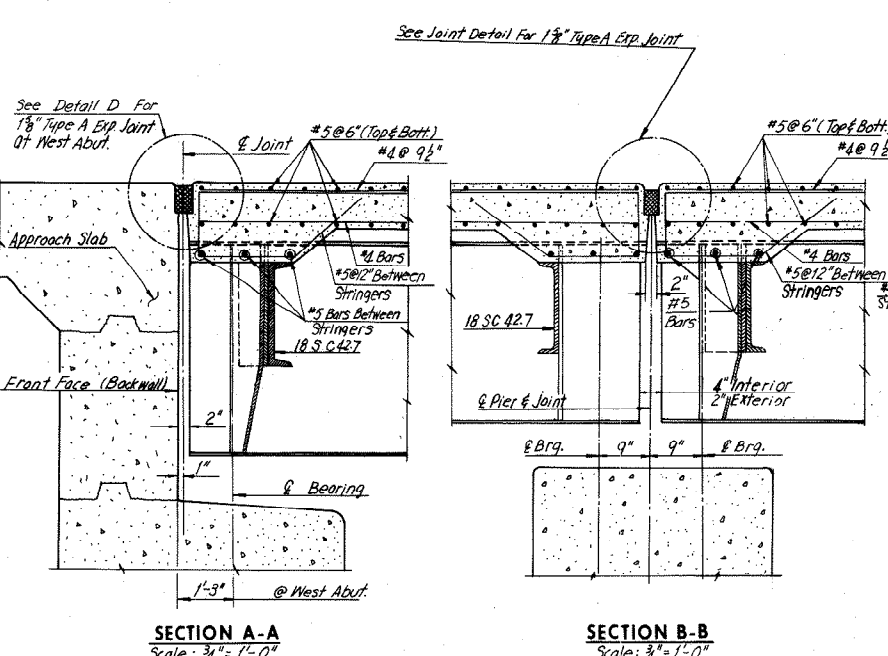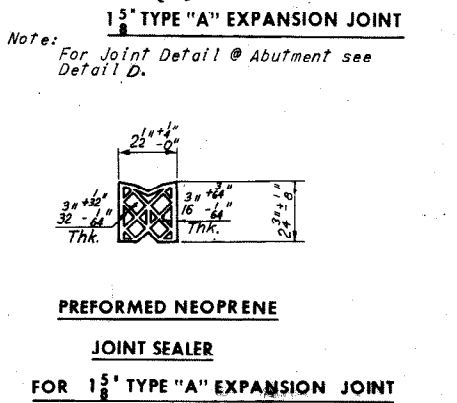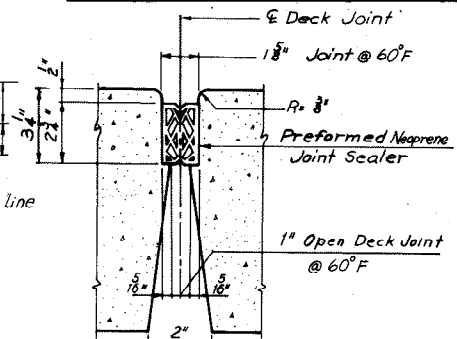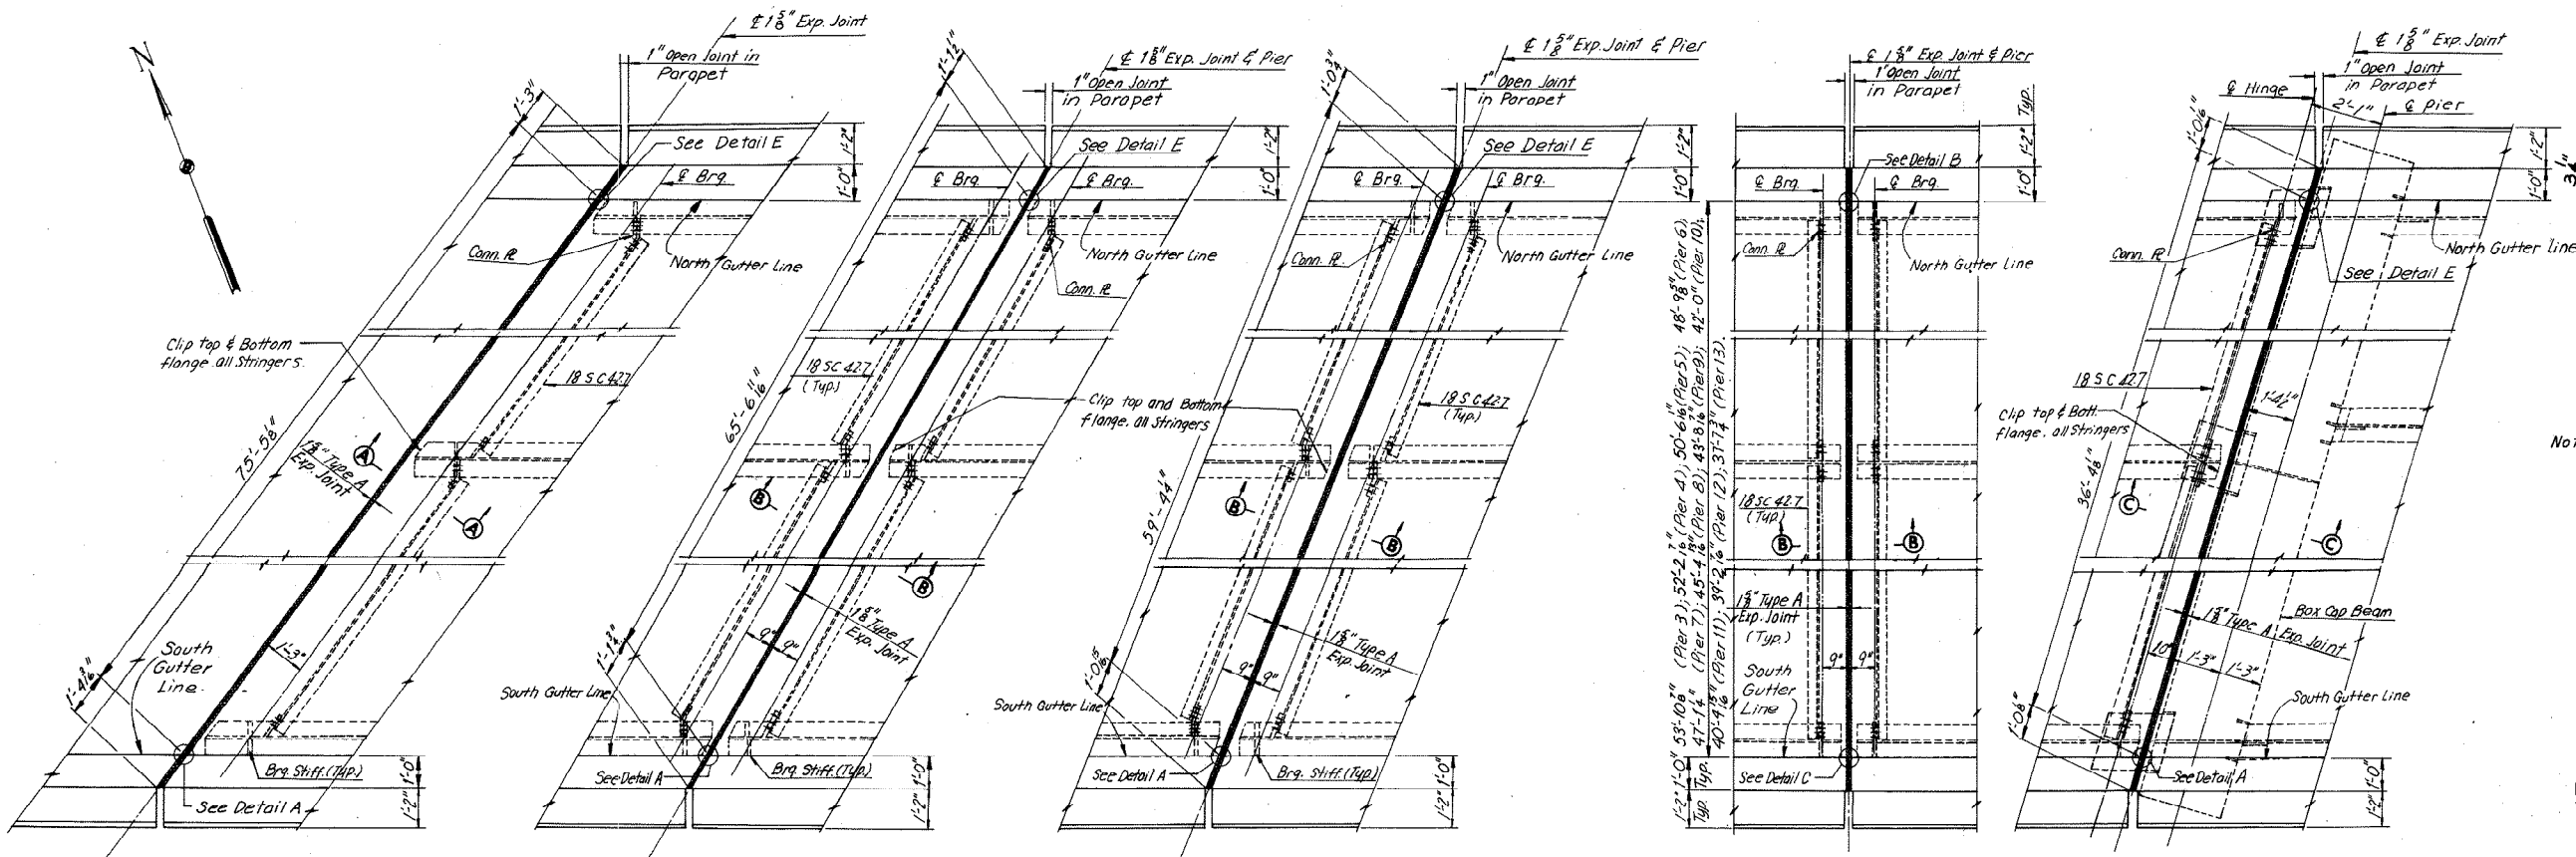

Note: All horizontal dimensions of Sections shown above are normal to \perp joint and pier.

Note: For details of bearing stiffeners, see Deck Plan Sheets 28, 29, & 30.

Note: It is absolutely essential that the openings for the preformed neoprene joint sealers be accurately formed and constructed to smooth, straight lines. The size of opening shall be adjusted to allow for anticipated dead load rotation of the ends of the slab and for the temperature at the time of construction.

BY	DATE	NO.	REVISION	BY	DATE
MADE	G.S.H. 10/10/69				
CHECKED	C.F.B. 2-5-69	1	As Built	TEM	8-76
IN CHARGE					

RICHMOND METROPOLITAN AUTHORITY
RICHMOND EXPRESSWAY SYSTEM
DOWNTOWN EXPRESSWAY


BRIDGE NO. 66
 EASTBOUND ROADWAY ON
 12TH ST. - R.R. TRACKS AND 161

JOINT DETAILS


HOWARD, NEEDLES, TAMMEN & BERGENDOFF
 consulting engineers
 NEW YORK ALEXANDRIA KANSAS CITY

SCALE: As Noted
 CONTRACT NO. 10
 SHEET NO. 37 OF 46


RICHMOND EXPRESSWAY SYSTEM			
SECTION	PROJECT	SHEET NO.	TOTAL SHEETS
10	DOWNTOWN EXPRESSWAY	164	265

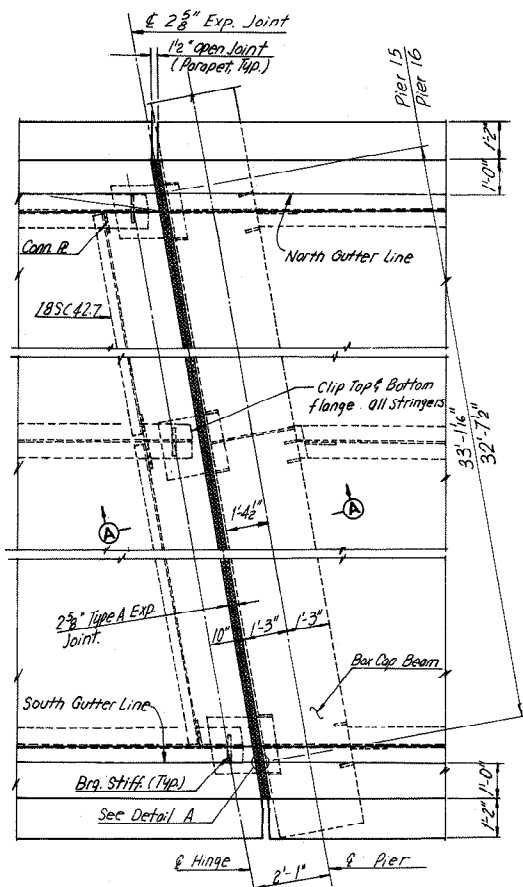


PLAN — JOINT AT PIERS 15 AND 16
Scale 3/8" = 1'-0"

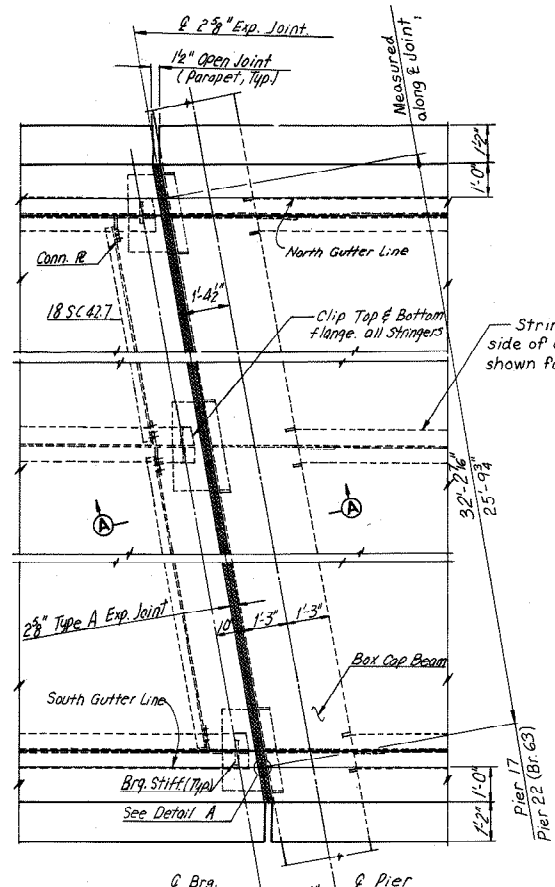


PLAN — JOINT AT PIER 17 AND PIER 22 (BR. 63)
Scale 3/8" = 1'-0"

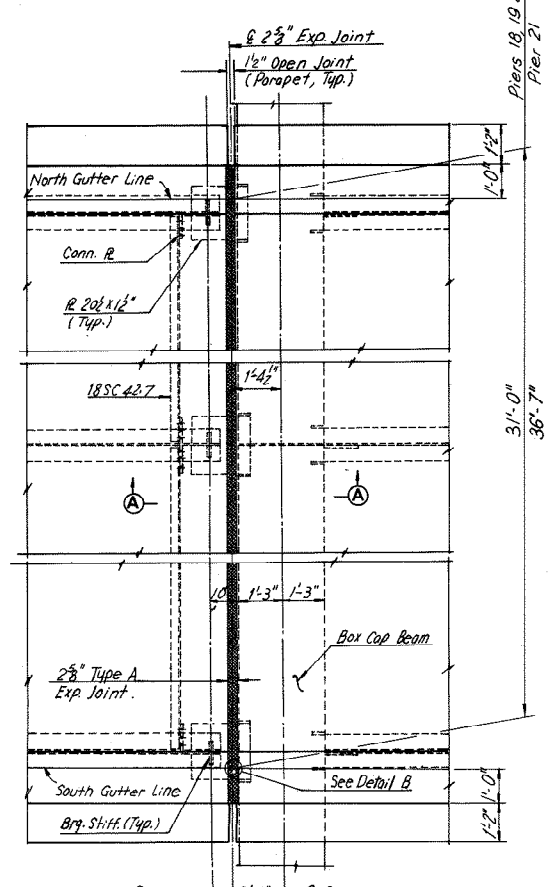

PLAN — JOINT AT PIERS 18, 19, 20 AND 21 (BRIDGE 63)
Scale 3/8" = 1'-0"

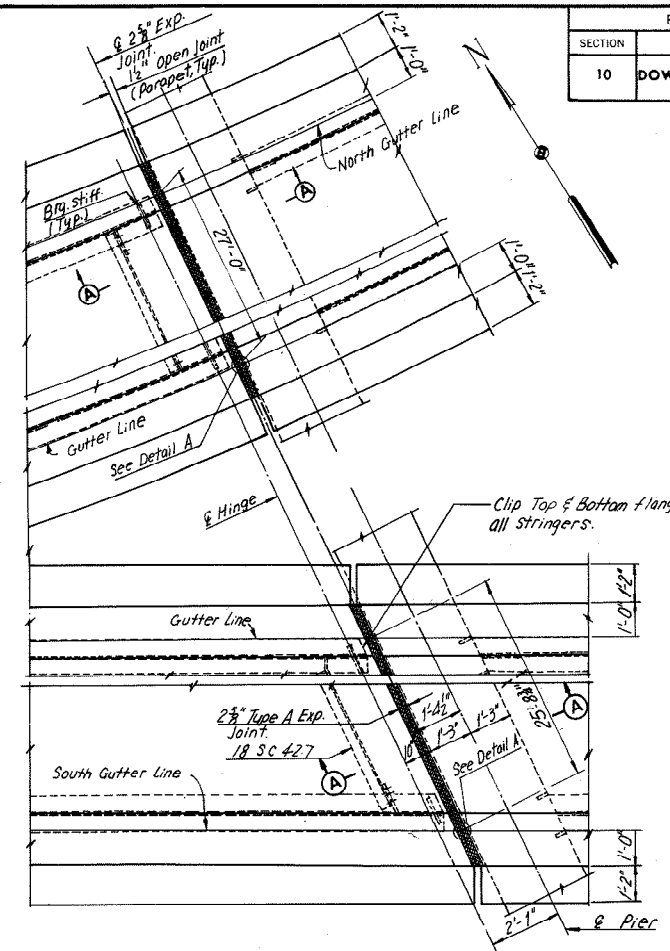


PLAN — JOINT AT PIER 22 (BRIDGE 63)
Scale 3/8" = 1'-0"

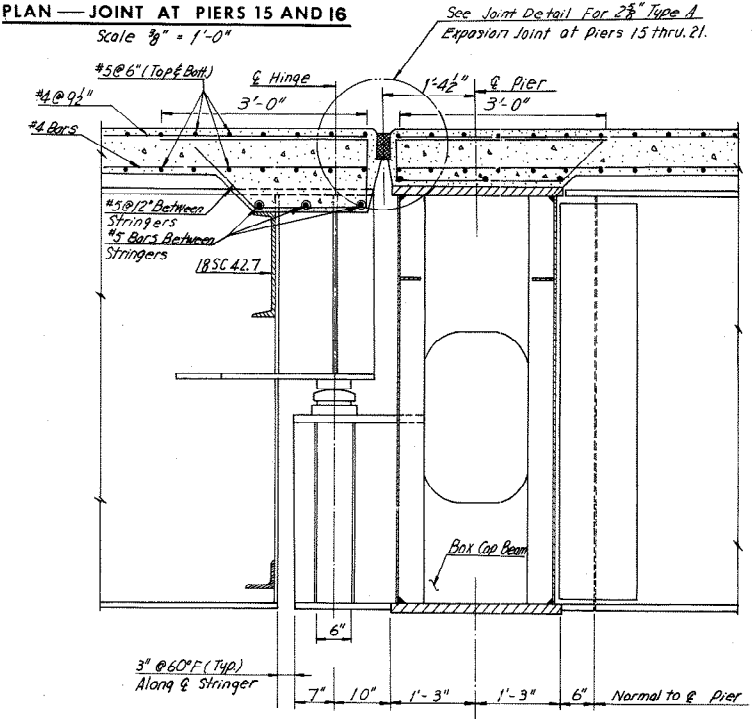

SECTION A-A
Scale 3/4" = 1'-0"


Note: All horizontal dimensions of Section shown above are normal to ϕ joint and pier.

Note: End of stringers and connection R's shall be plumb.

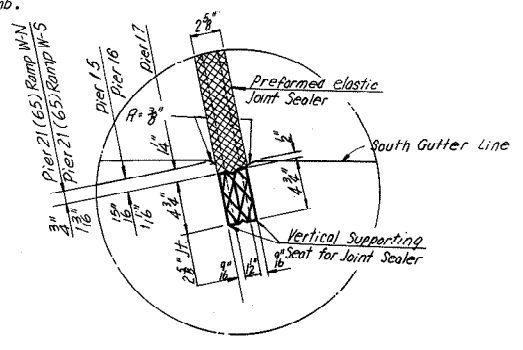


DETAIL A
No Scale

Typical for Piers 15 thru 17 & Pier 21 (Br. 63)

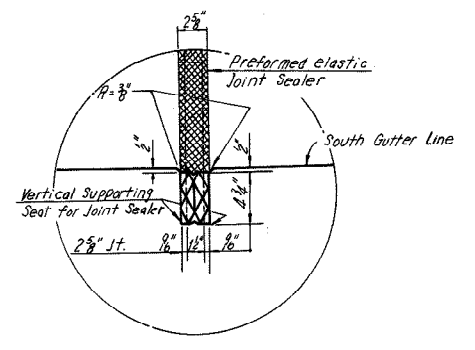


DETAIL B
No Scale

Typical for Piers 18 thru 20 & Pier 21 (Br. 63)

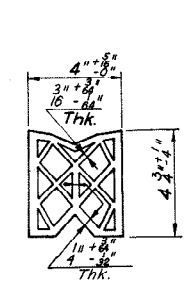

PREFORMED NEOPRENE JOINT SEALER
FOR 2 1/2" TYPE "A" EXPANSION JOINT
No Scale

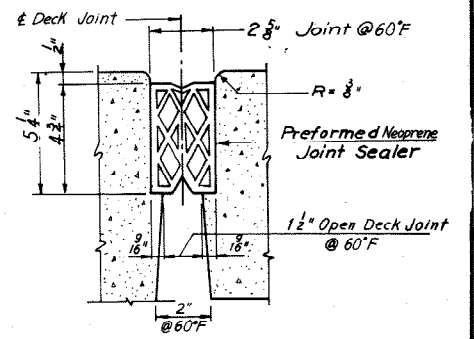


2 1/2" TYPE "A" EXPANSION JOINT
No Scale

Note: All horizontal dimensions shown above are normal to ϕ joint.

Note: For details of bearing stiffeners, see Framing Plan Sheets 17 thru 21.

Note: It is absolutely essential that the openings for the preformed neoprene joint sealers be accurately formed and constructed to smooth, straight lines. The size of opening shall be adjusted to allow for anticipated dead load rotation of ends of the slab and for the temperature at the time of construction.

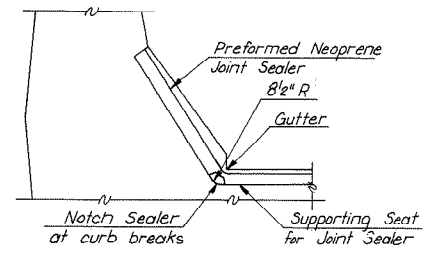

TREATMENT OF TYPE "A" JOINT AT CURB
No Scale

BY	DATE				
MADE	G.S.H.	10-5-68			
CHECKED	C.F.B.	2-5-69	1	As Built	TEM 8-76
IN CHARGE			NO.	REVISION	BY DATE


RICHMOND METROPOLITAN AUTHORITY
RICHMOND EXPRESSWAY SYSTEM
DOWNTOWN EXPRESSWAY

BRIDGE NO. 66
EASTBOUND ROADWAY OVER
12TH ST. - R.R. TRACKS AND 16TH ST.
JOINT DETAILS

SCALE: As Noted
HOWARD, NEEDLES, TAMMEN & BERGENDOFF
consulting engineers
NEW YORK ALEXANDRIA KANSAS CITY
CONTRACT NO. 10
SHEET NO. 38 OF 46


AS BUILT

RICHMOND EXPRESSWAY SYSTEM			
SECTION	PROJECT	SHEET NO.	TOTAL SHEETS
10	DOWNTOWN EXPRESSWAY	173	265

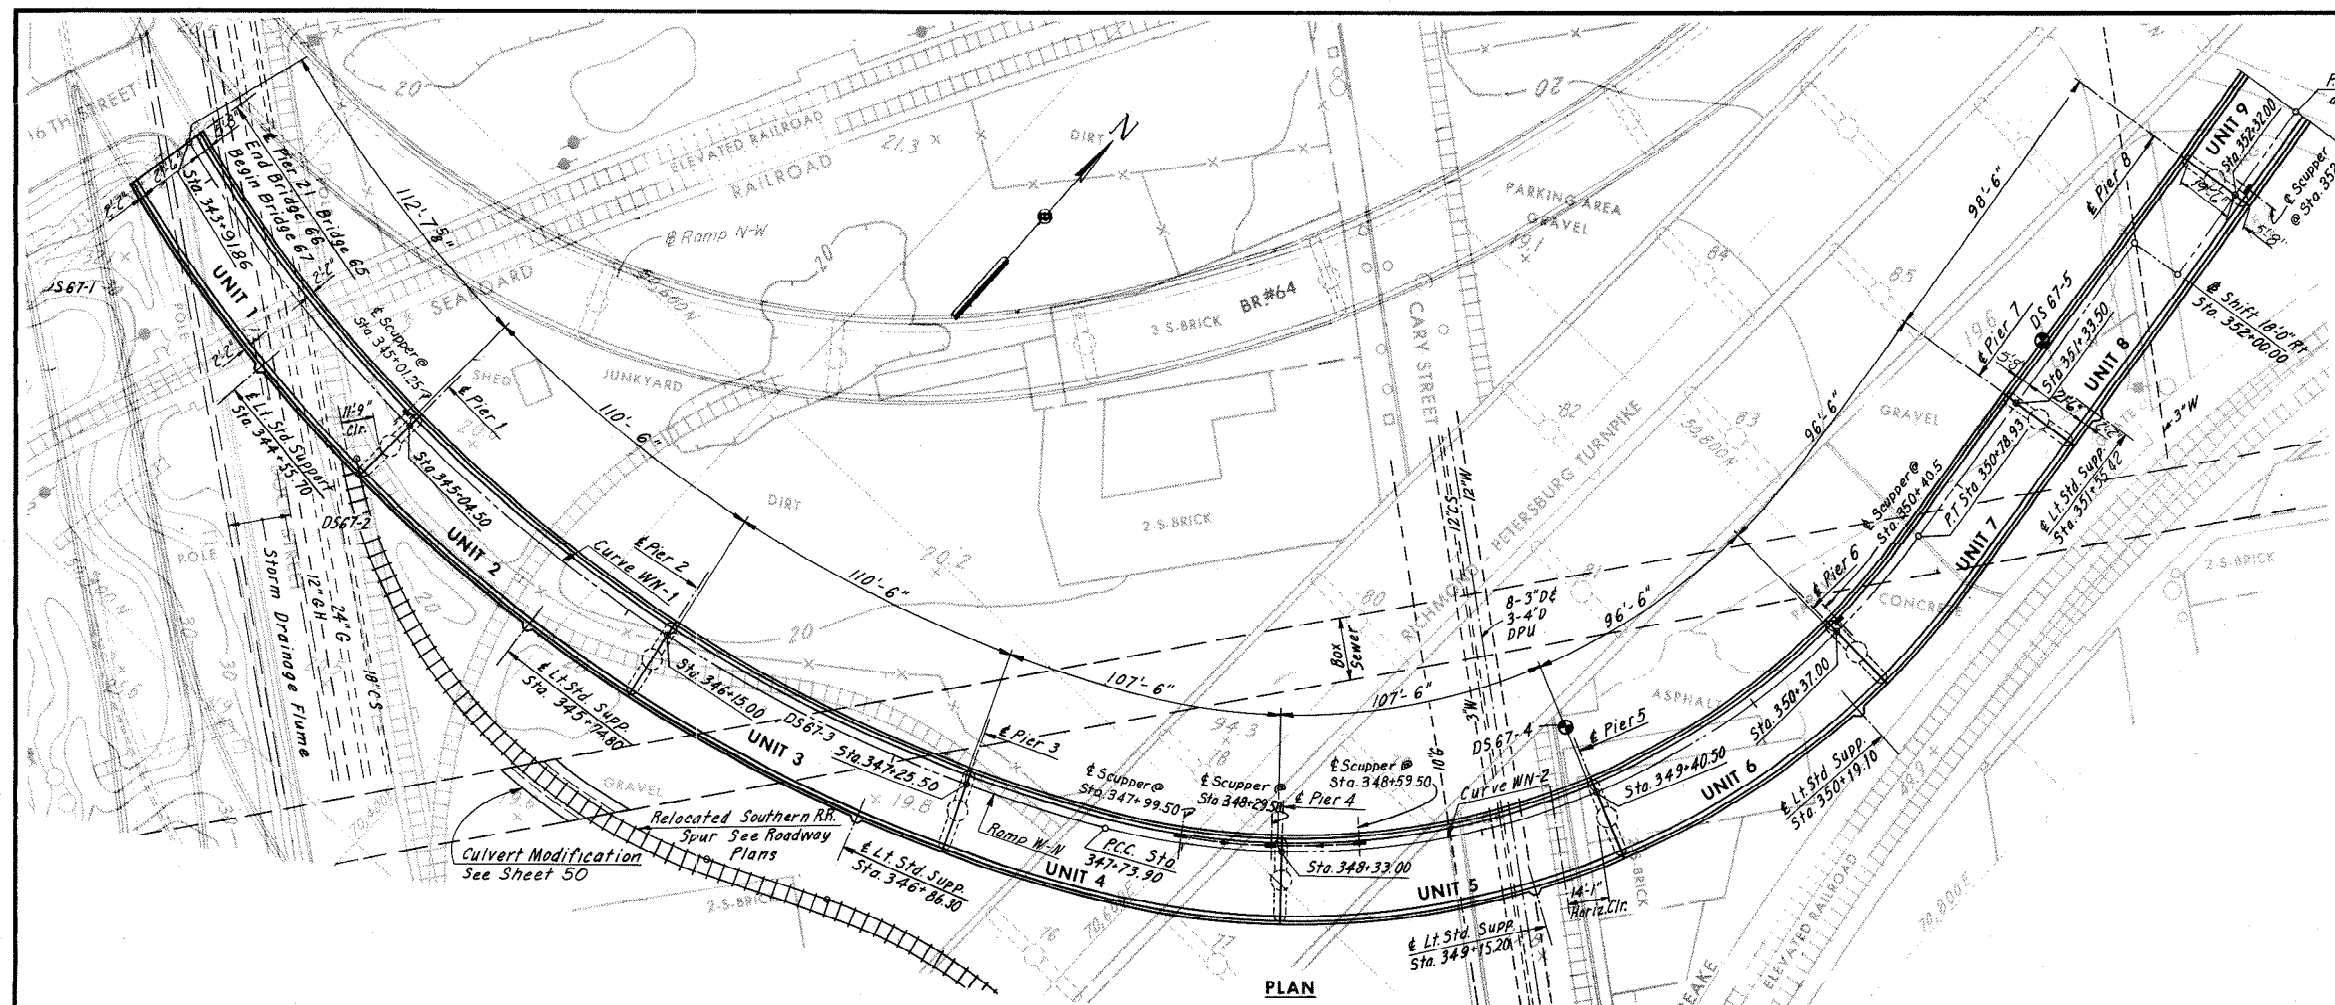

INDEX


GENERAL PLAN AND ELEVATION	1
GENERAL PLAN AND ELEVATION LAYOUT	2
LAYOUT	3
PIERS 1 AND 2	4
PIER 3	5
PIERS 4 AND 5	6
PIER 6	7
PIER 7	8
PIERS 8 AND 9	9
PIER 10	10
PIERS 11 AND 12E	11
PIER 13E	12
PIERS 10A AND 12W	13
PIERS 13W AND 14	14
NORTH ABUTMENT	15
NORTH ABUTMENT DETAILS	16
NORTH ABUTMENT RETAINING WALL MODIFICATION	17
FRAMING PLAN - UNITS 1 AND 2	18
FRAMING PLAN - UNITS 3 AND 4	19
FRAMING PLAN - UNITS 5 AND 6	20
FRAMING PLAN - UNITS 7 AND 8	21
FRAMING PLAN - UNIT 9 AND FRAMING DETAILS	22
FRAMING PLAN - UNIT 10	23
GIRDER ELEVATIONS - UNIT 10	24
FRAMING PLAN - UNITS 11, 12, 13, 14 AND 15	25
FRAMING PLAN - UNITS 11, 12, 13, 14 AND 15	26
FLOORBEAM 16 AND STEEL COLUMNS	27
DECK PLAN - UNITS 1 AND 2	28
DECK PLAN - UNITS 3 AND 4	29
DECK PLAN - UNITS 5 AND 6	30
DECK PLAN - UNITS 7 AND 8	31
DECK PLAN - UNIT 9 - AND SUPERSTRUCTURE DETAILS	32
DECK PLAN - UNIT 10	33
DECK PLAN - UNITS 11, 12, 13, 14 AND 15	34
STRESS SHEET TRUSS SPAN	35
TOP LATERAL SYSTEM	36
BOTTOM LATERAL SYSTEM	37
TRUSS DETAILS P.P. 0 TO P.P. 6	38
TRUSS DETAILS P.P. 7 TO P.P. 10	39
TRUSS DETAILS P.P. 11 TO P.P. 12	40
FLOORBEAM 0 AND JOINT DETAILS	41
INTERMEDIATE FLOOR BEAMS	42
MISCELLANEOUS DETAILS	43
FLOORBEAM 12 AND JOINT DETAILS	44
DECK PLAN - TRUSS SPAN	45
SHOE DETAILS AND DECK ELEVATIONS	46
JOINT DETAILS	47
SLOPE PROTECTION DETAILS	48 THRU 49
BORING LOGS	50
STANDARD DETAILS	51 THRU 54

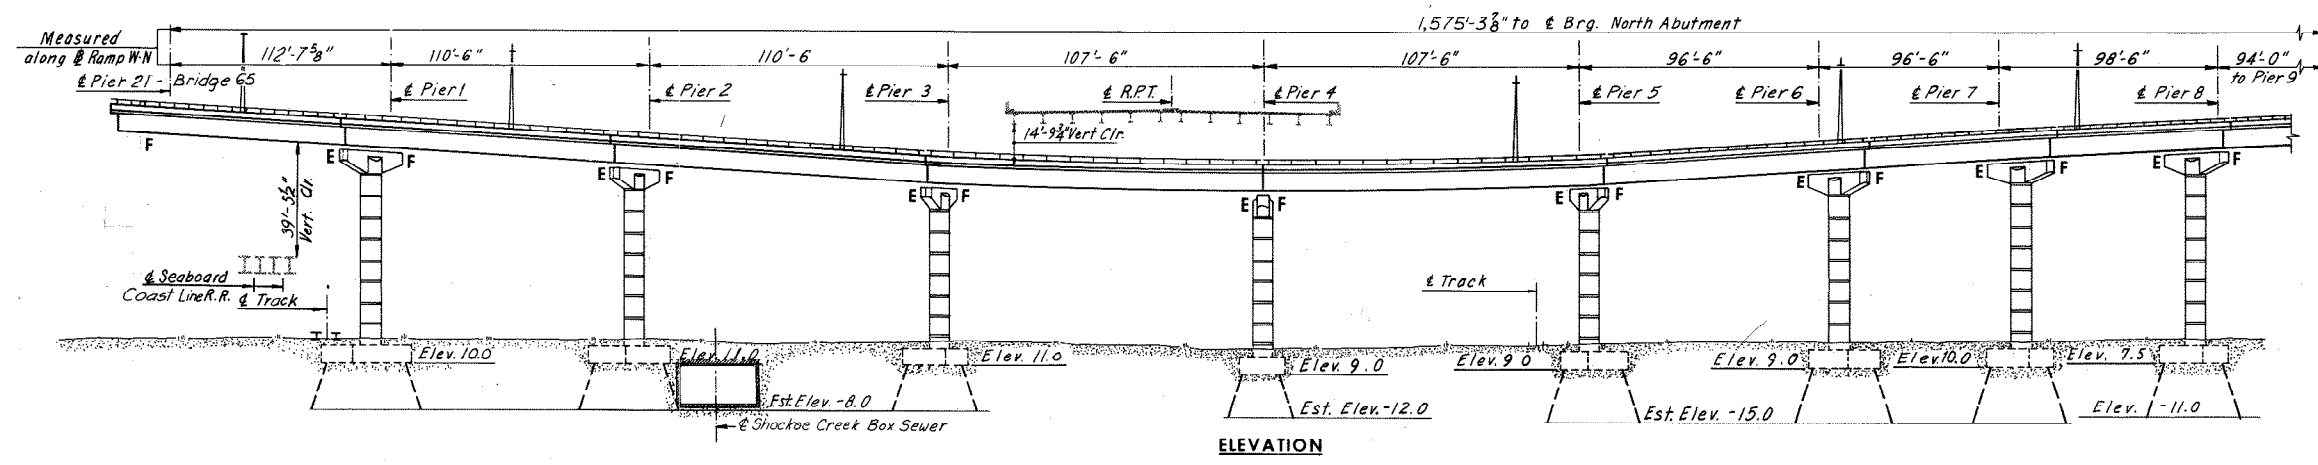

Note:
For General Notes, see Sheet 4.
For Quantity Table, see Sheet 3

CURVE DATA

@ R.P.T.		@ Ramp W-N		@ Ramp N-W	
Curve: R.P.T.-1	Curve: R.P.T.-2	Curve: WN-1	Curve: WN-2	Curve: WN-3	Curve: WN-4
P.I. = Sta. 1704+68.83	P.I. = Sta. 1723+07.01	P.I. = Sta. 345+25.47	P.I. = Sta. 349+47.64	P.I. = Sta. 353+19.15	P.I. = Sta. 13+42.50
A = 15°03'56"	A = 33°27'10"	A = 64°53'49"	A = 68°32'15"	A = 6°23'54"	A = 32°01'34"
D = 1°00'	D = 4°06'	D = 11°27'33"	D = 12°28'08"	D = 6°00'	D = 4°09'36"
T = 757.65'	T = 430.45'	T = 317.90'	T = 173.75'	T = 53.38'	T = 426.01'
L = 1,506.56'	L = 836.30'	L = 305.63'	L = 106.64'	L = 106.64'	L = 829.72'
R = 5,729.58'	R = 1,432.39'	R = 500.00'	R = 255.00'	R = 954.93'	R = 1,484.39'
		Curve: WN-4	Curve: WN-5	Curve: WN-6	
		P.I. = Sta. 355+39.85	P.I. = Sta. 358+17.39	P.I. = Sta. 361+67.68	
		A = 5°01'11"	A = 13°10'51"	A = 19°35'06"	
		D = 1°30'	D = 6°00'	D = 4°09'03"	
		T = 167.43'	T = 110.33'	T = 238.25'	
		L = 334.65'	L = 219.68'	L = 471.85'	
		R = 3,819.72'	R = 954.93'	R = 1,380.39'	

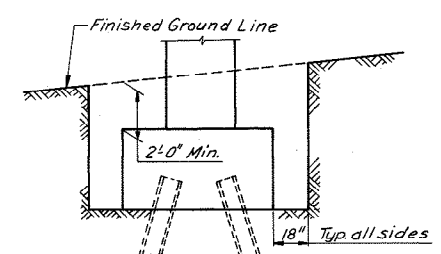

LIMITS OF STRUCTURE EXCAVATION
No Scale

RICHMOND METROPOLITAN AUTHORITY
RICHMOND EXPRESSWAY SYSTEM
DOWNTOWN EXPRESSWAY

BRIDGE NO. 67
RAMP W-N CONNECTION TO
RICHMOND-PETERSBURG TURNPIKE
GENERAL PLAN AND ELEVATION


HOWARD, NEEDLES, TAMMEN & BERGENDOFF
consulting engineers
NEW YORK ALEXANDRIA KANSAS CITY

SCALE: 1" = 30'-0"
CONTRACT NO.: 10
SHEET NO. 1 OF 54


AS BUILT

BY	DATE	3	As Built	TEM	6-77
MADE	AMH 3-5-69	Ⓢ	Light Site Location Unit 9	JLK	6-6-75
CHECKED	KCT 5-12-69	Ⓢ	Sheets 42 & 45 added	L.B.P.	3-5-75
IN CHARGE		NO.	REVISION	BY	DATE


RICHMOND EXPRESSWAY SYSTEM			
SECTION	PROJECT	SHEET NO.	TOTAL SHEETS
10	DOWNTOWN EXPRESSWAY	174	265

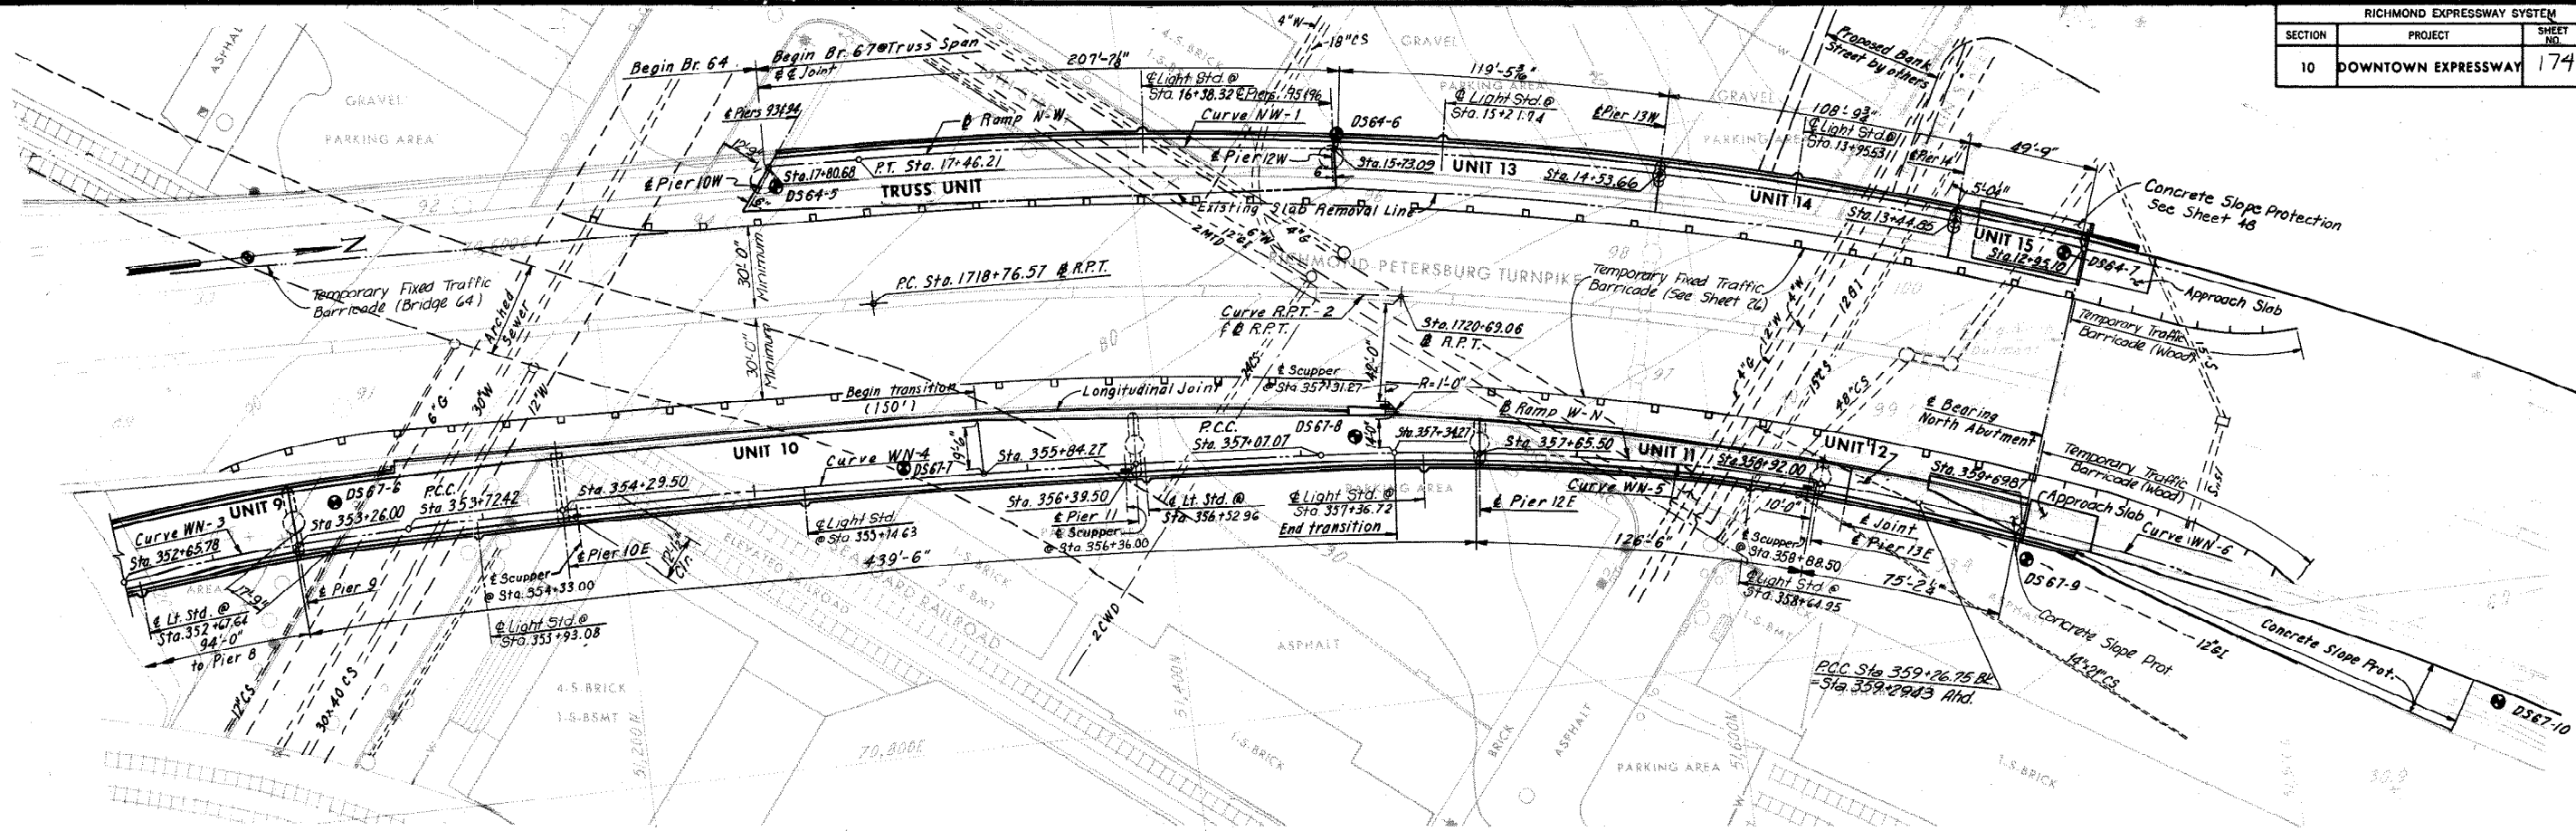


PLAN
Scale: 1" = 30'-0"

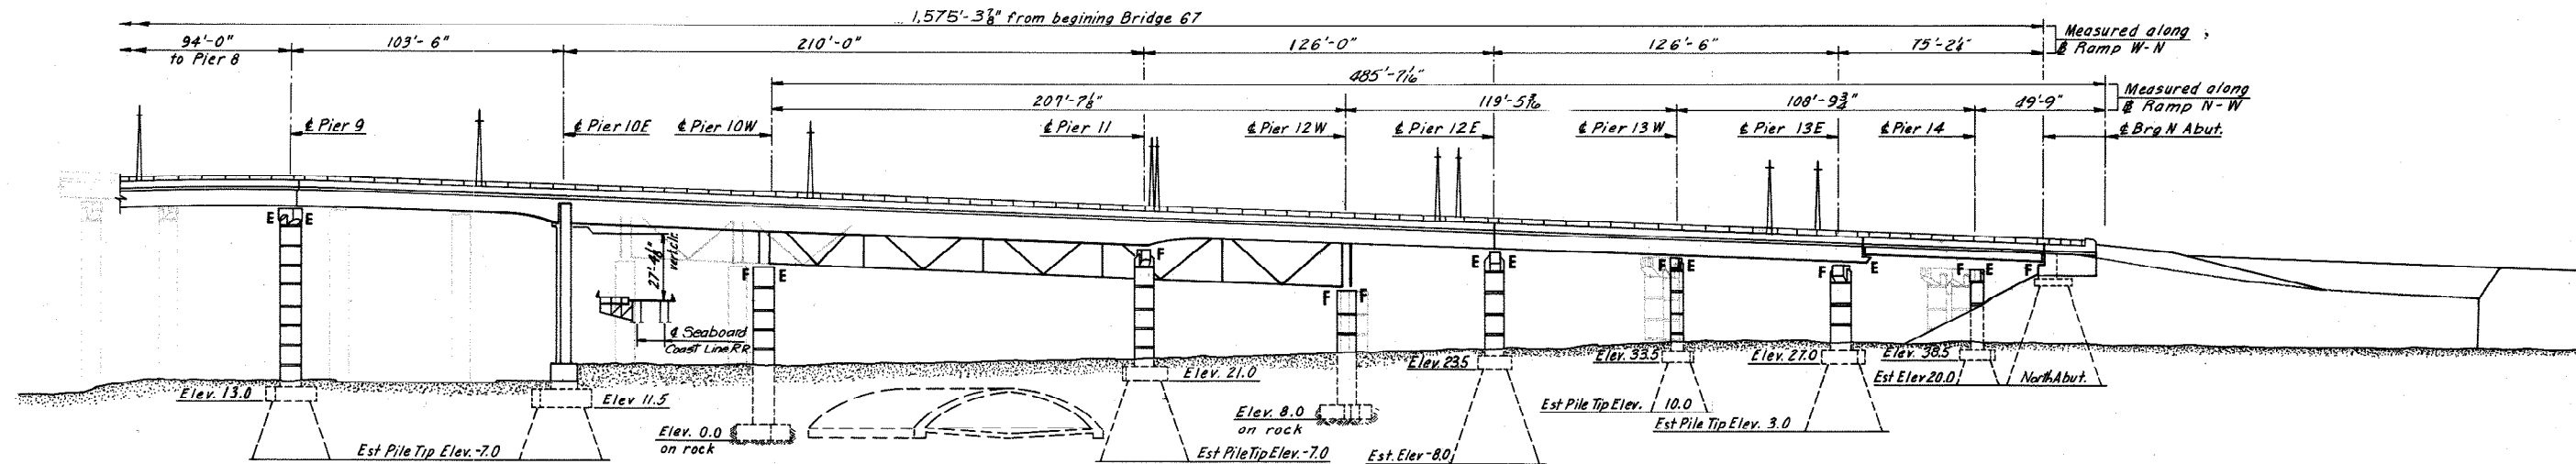

ELEVATION
Scale: 1" = 30'-0"

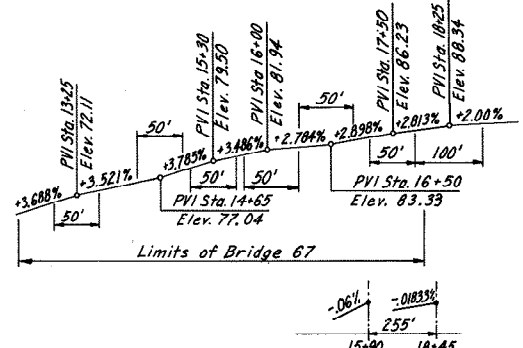

PROFILE GRADE CROSS SLOPE - RAMP N-W

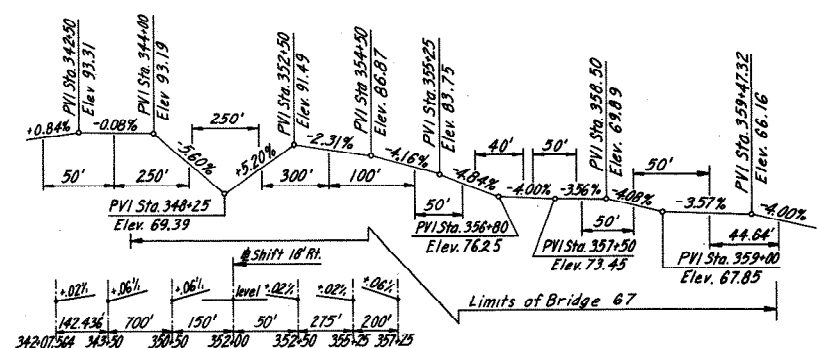

PROFILE GRADE AND CROSS SLOPE - RAMP W-N

AS BUILT

BY	DATE	REVISION	BY	DATE
AMH	12-30-68	2	JEM	6-77
KCT	5-12-69	1	DWB	1-28-75
NO.				

RICHMOND METROPOLITAN AUTHORITY
RICHMOND EXPRESSWAY SYSTEM
DOWNTOWN EXPRESSWAY


BRIDGE NO. 67
RAMP W-N CONNECTION TO
RICHMOND-PETERSBURG TURNPIKE
GENERAL PLAN AND ELEVATION

HOWARD, NEEDLES, TAMMEN & BERGENDOFF
 consulting engineers
 NEW YORK ALEXANDRIA KANSAS CITY








SCALE: As Noted
 CONTRACT NO. 10
 SHEET NO. 2 OF 54

RICHMOND EXPRESSWAY SYSTEM			
SECTION	PROJECT	SHEET NO.	TOTAL SHEETS
10	DOWNTOWN EXPRESSWAY	183	265

Note: All Steel shall be A36 except otherwise shown.
 Pile Tip Elev. -7.00
 Batter exterior piles 2" per foot in direction shown.
 All piles shall be 12BP53 Steel Piles (Design Cap.=57 Tons).

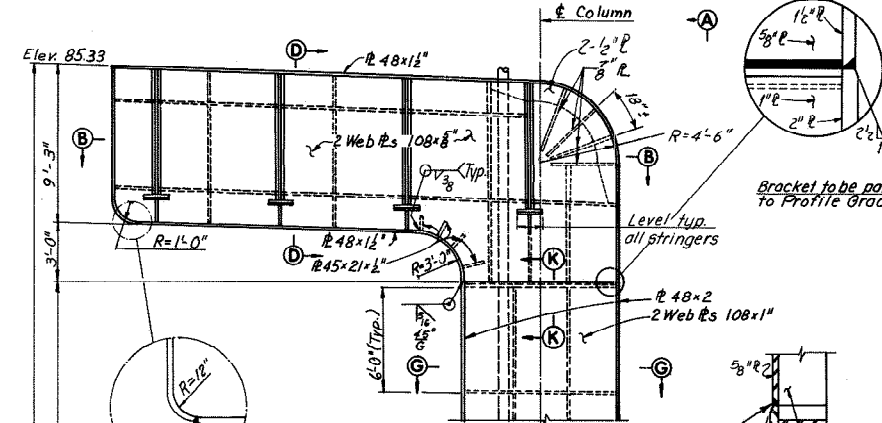





Note: Concrete under column. Base plate shall be prepared as given in standard shoe details. Base plate shall be set on a thin layer of dry cement powder to provide a uniform bearing.

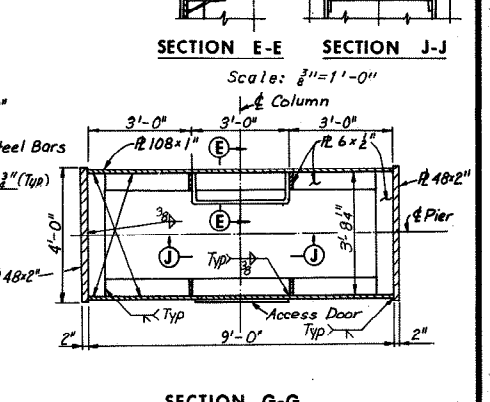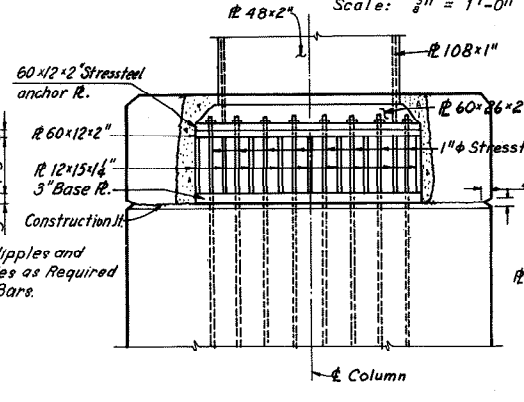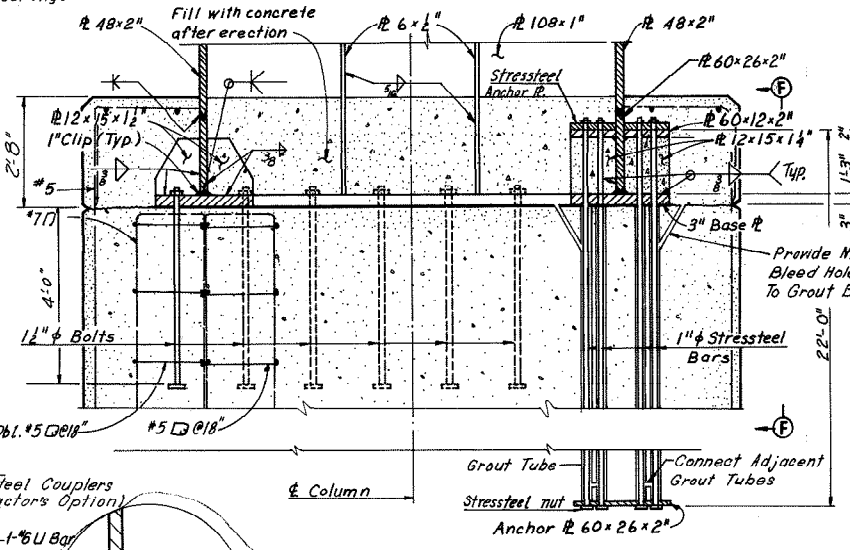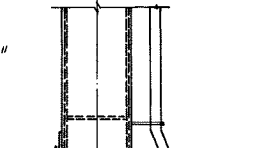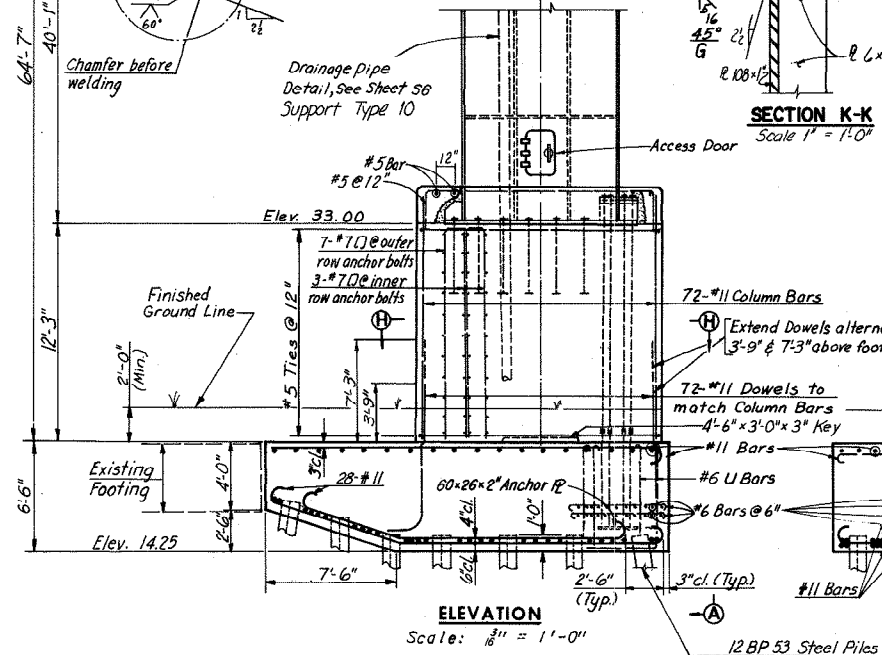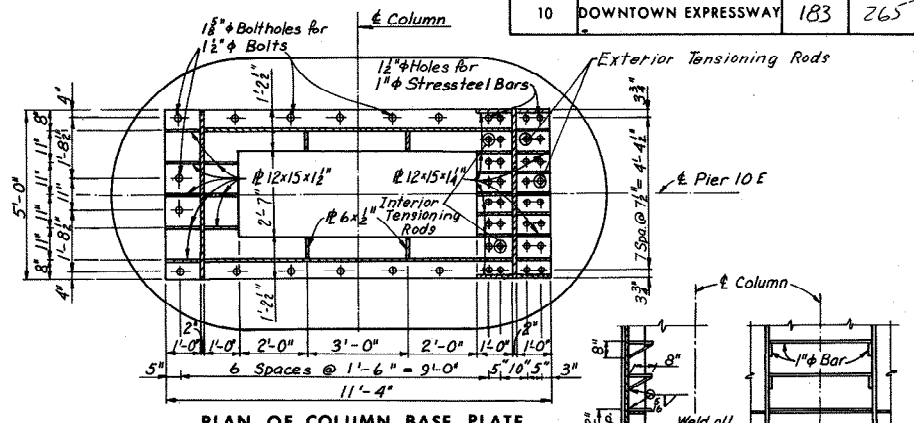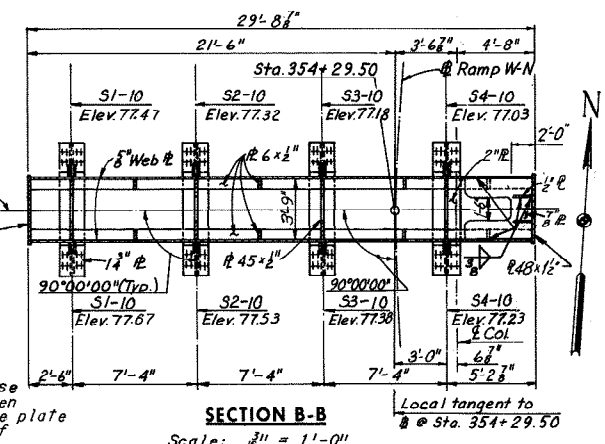

Note: Stressteel rods shall be 1" Special Grade, 160 ksi. min. ult. Strength, 32 rods red'd. Rods to be grouted after tensioning. Initial Jacking Force Required = 884,000 lbs for seating wedge.
 Rods shall be tensioned as outlined in the construction sequence. Rods need not be tensioned in pairs, however, tensioning shall proceed outward from the centerline of Pier 10.
 Rods of the first group shall be checked in the same sequence as initial tensioning, checking shall continue until two successive 1" rods checked have a tension of at least 80%.

The contractor is cautioned against nicking the stress rods and he shall follow the manufacturers recommended handling procedures. The contractor shall provide adequate safety measures. The contractor shall submit his proposed construction procedures to the engineer for approval.



- GENERAL CONSTRUCTION SEQUENCE:
1. Construct footing and pedestal including 32-1/4" stressteel bars.
 2. Erect column and capbeam. Tighten down nuts on 1/2" anchor bolts. Stress 12 interior tensioning rods.
 3. Erect structural steel superstructure in such a manner that load eccentricity on the column is kept at a minimum.
 4. Stress 12 exterior tensioning rods.
 5. Place concrete deck.
 6. Stress remaining 8 tensioning rods.
 7. Check tension on initial group of rods.
 8. Cutoff rod extension. Fill column base with concrete, grout and encase base and anchorage with concrete.

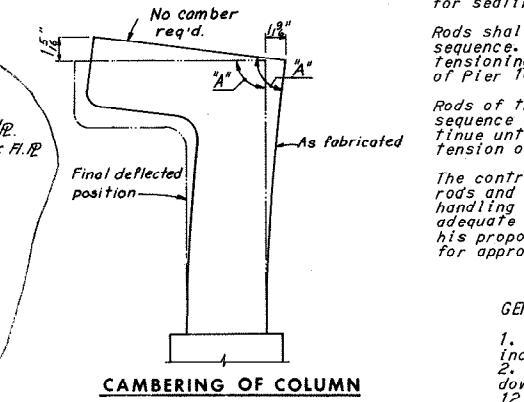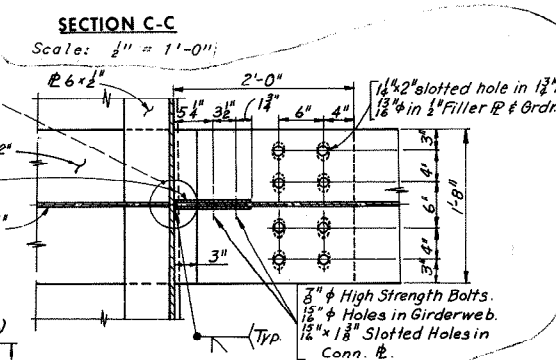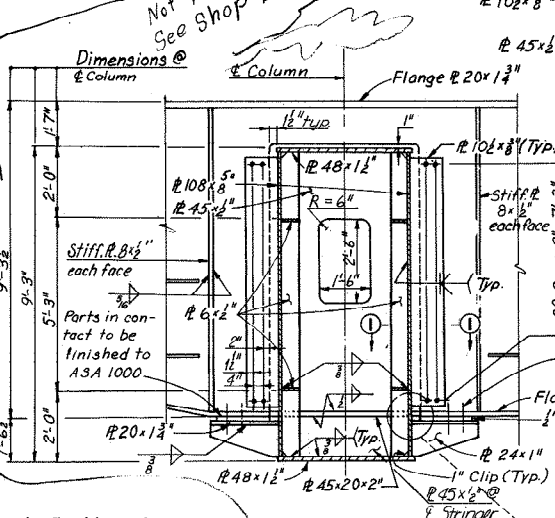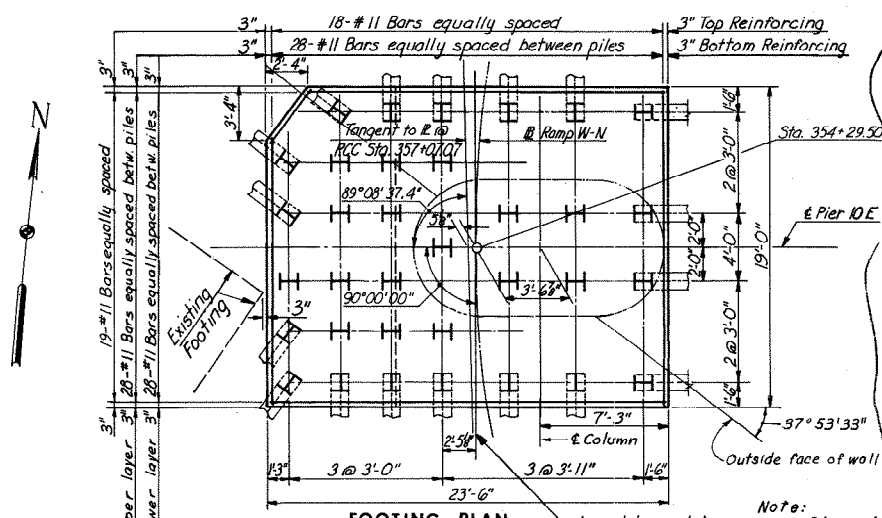

FOOTING FOR PIER 10E IS ECCENTRIC AS SHOWN ON FOOTING PLAN

NO.	REVISION	BY	DATE
3	As Built	TEM	6-77
2	Fig. Plan & Elev. changed	d.B.P.	7-23-75
1	Changed Dim. Section	REJ	1-24-75

Note: Dimensions in Footing Plan are measured at bottom of Footing.
 Note: Footing elevations are approximate only and may be varied to suit field conditions as directed by the Engineer. Vertical shaft reinforcing shall not be cut until these elevations are established. Where elevations change more than 2 ft., redesign will be required.

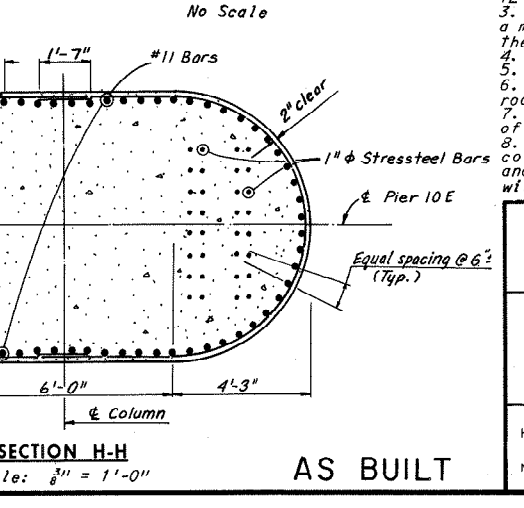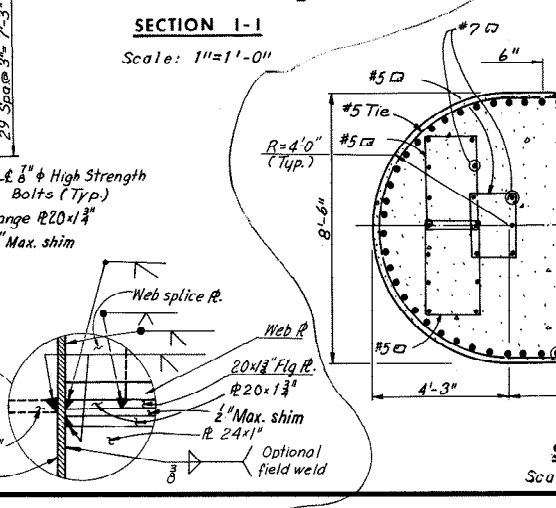













RICHMOND METROPOLITAN AUTHORITY
 RICHMOND EXPRESSWAY SYSTEM
 DOWNTOWN EXPRESSWAY

BRIDGE NO. 67
 RAMP W-N CONNECTION TO
 RICHMOND-PETERSBURG TURNPIKE
 PIER 10E

HOWARD, NEEDLES, TAMMEN & BERGENDOFF
 consulting engineers
 NEW YORK ALEXANDRIA KANSAS CITY

SCALE: As Noted
 CONTRACT NO.: 10
 SHEET NO. 11 OF 54


RICHMOND EXPRESSWAY SYSTEM			
SECTION	PROJECT	SHEET NO.	TOTAL SHEETS
10	DOWNTOWN EXPRESSWAY	184	265

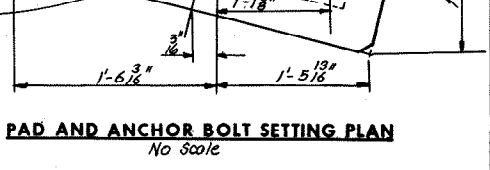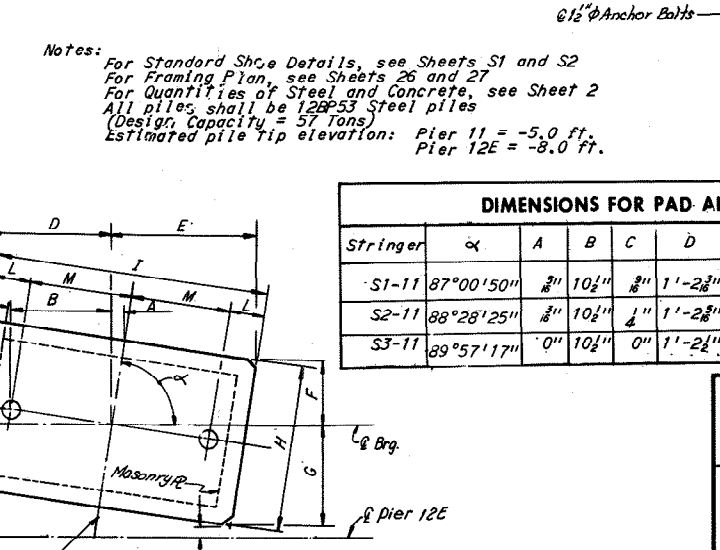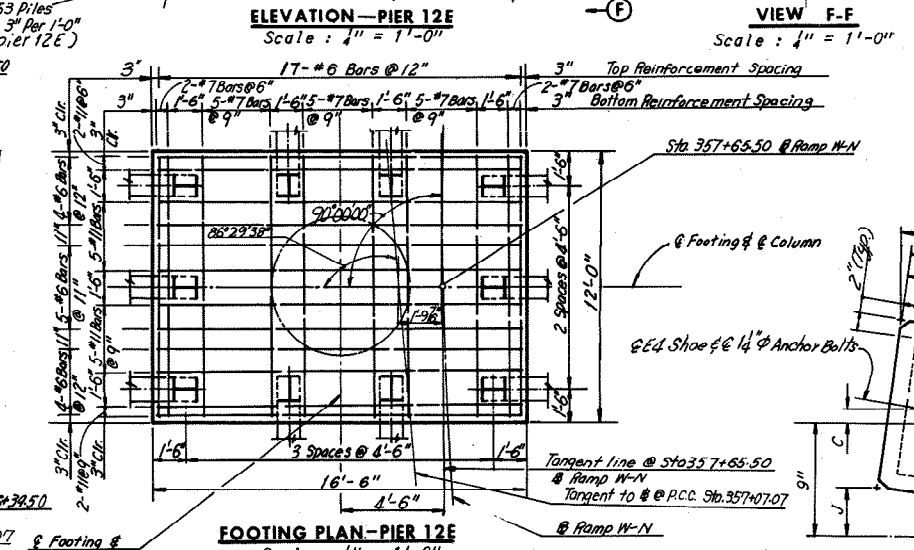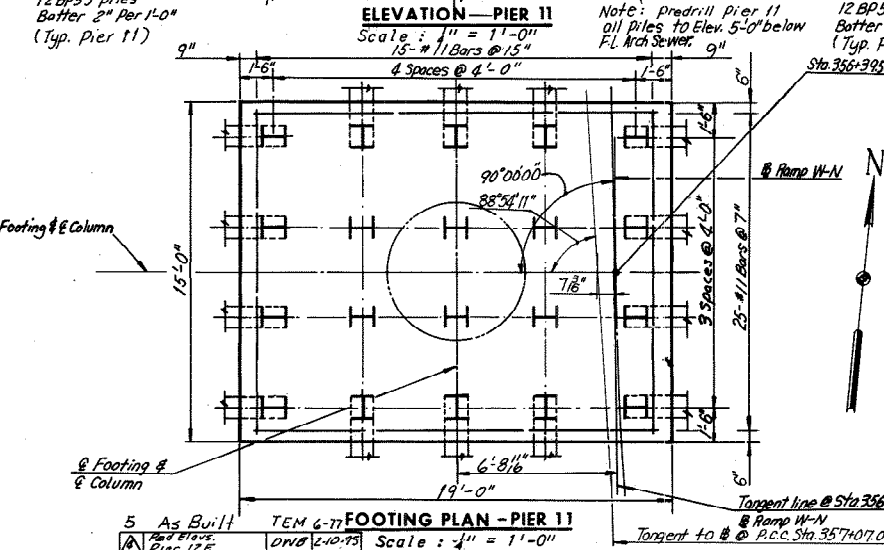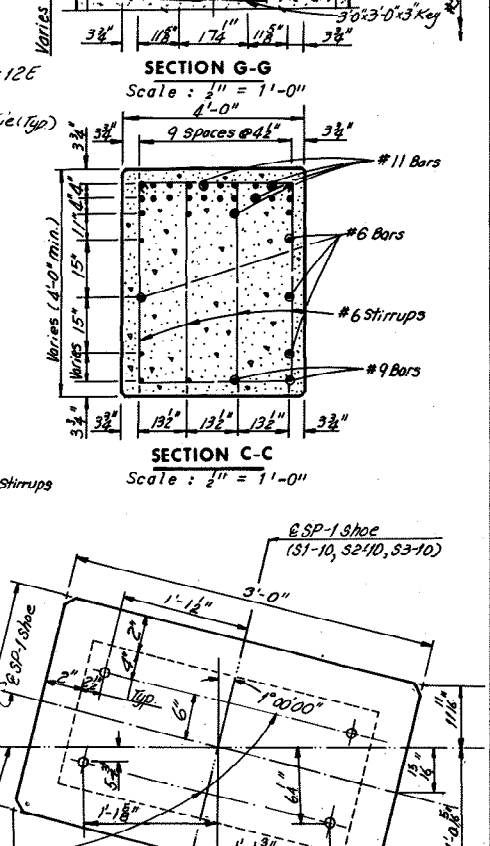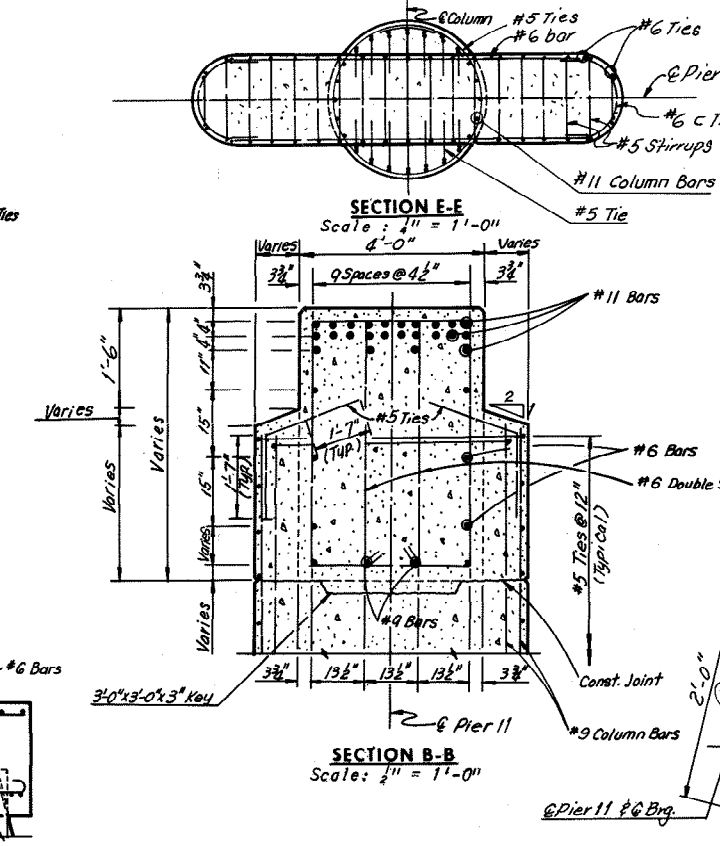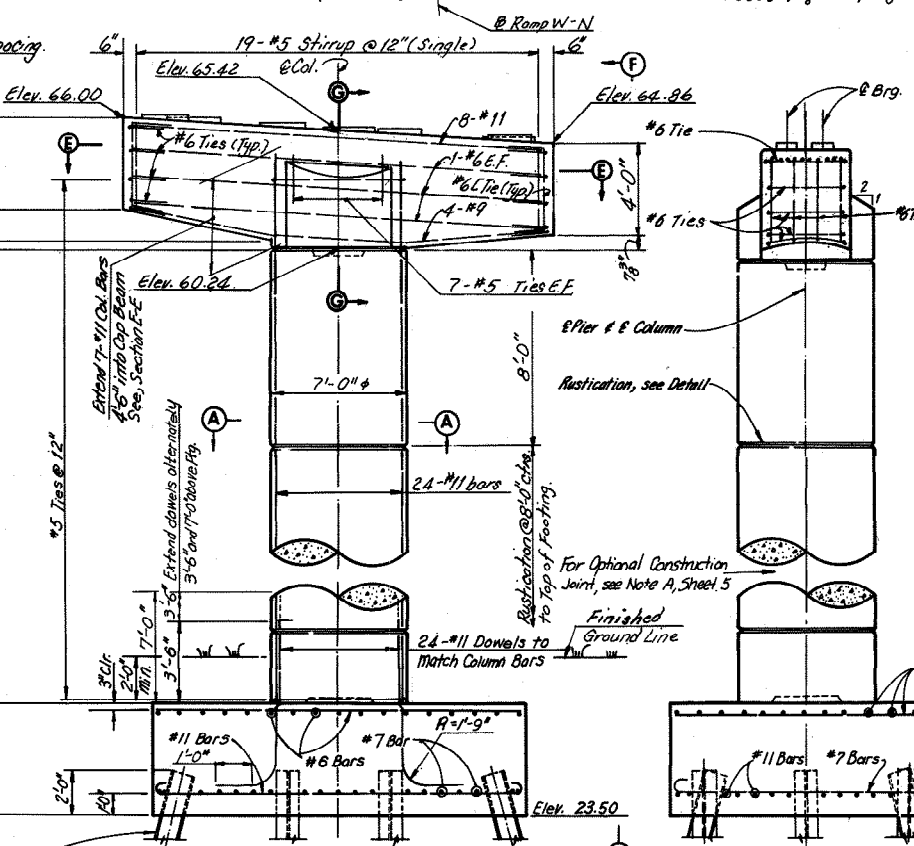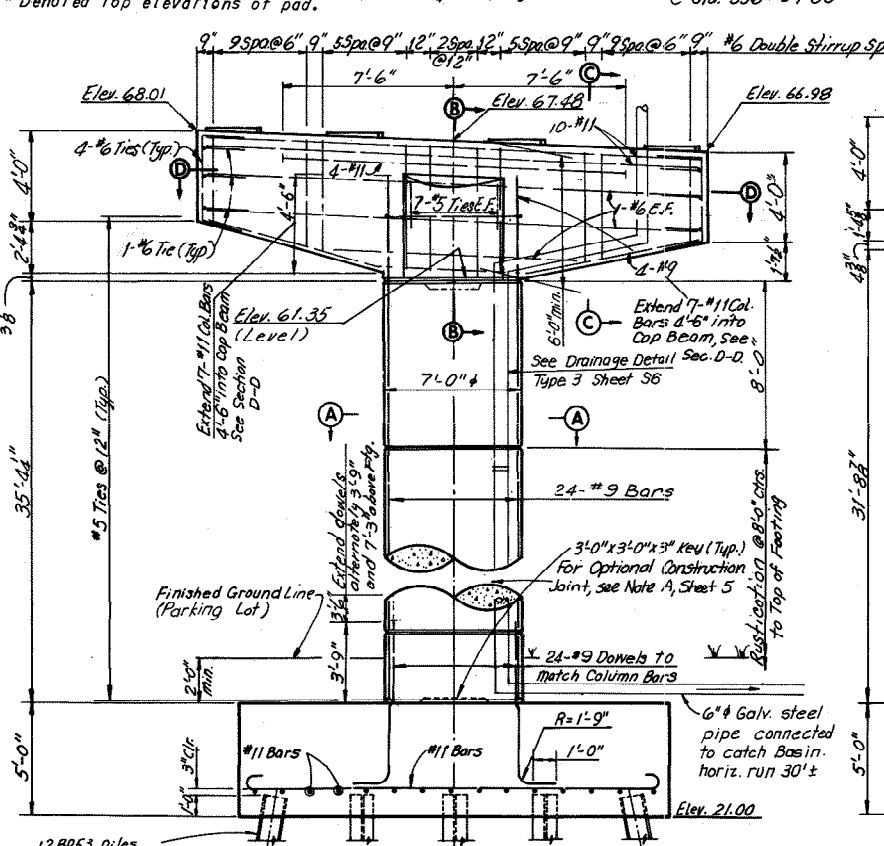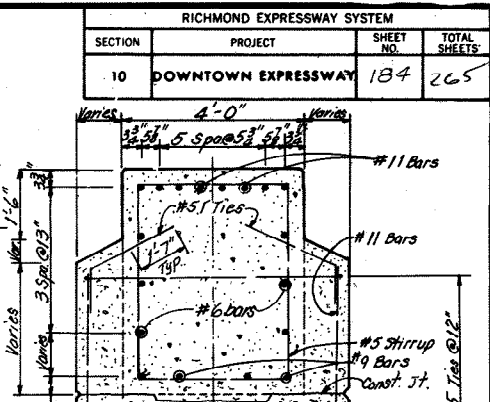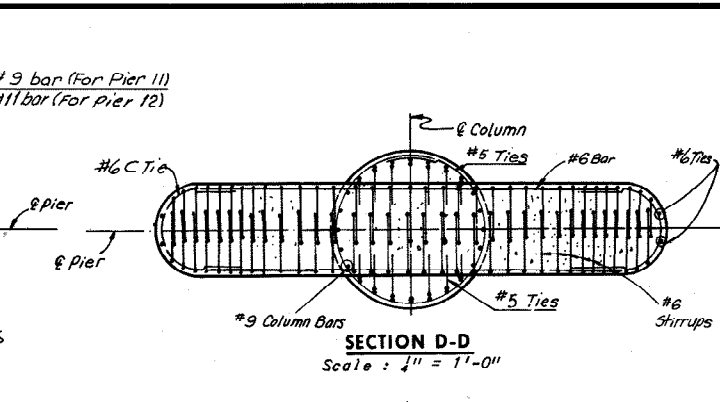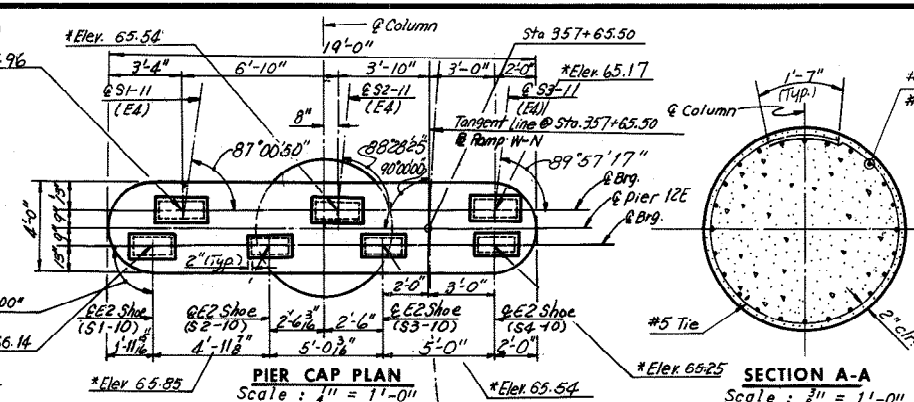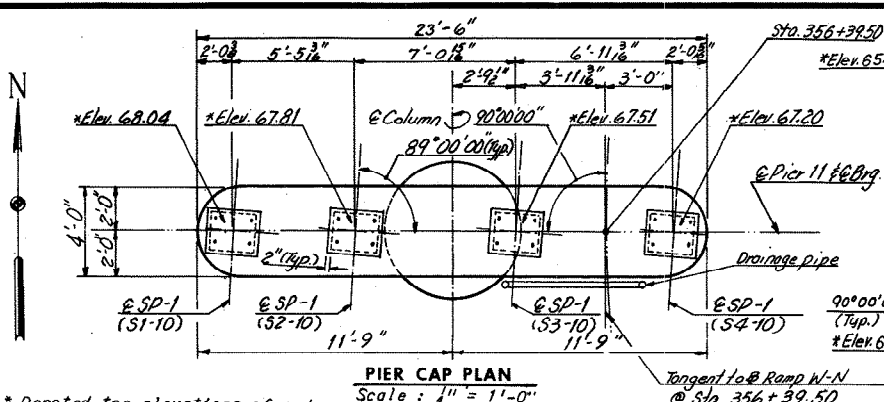

Stringer	α	A	B	C	D	E	F	G	H	I	J	K	L	M
S1-11	87°00'50"	3 1/2"	10 1/2"	3 1/2"	1'-2 3/4"	1'-2 3/4"	5 1/2"	7"	1'-0 1/2"	2'-5"	3 1/2"	2"	4"	10 1/2"
S2-11	88°28'25"	3 1/2"	10 1/2"	3 1/2"	1'-2 3/4"	1'-2 3/4"	5 1/2"	6 1/2"	1'-0 1/2"	2'-5"	3 1/2"	2 3/4"	4"	10 1/2"
S3-11	89°57'17"	0"	10 1/2"	0"	1'-2 3/4"	1'-2 3/4"	6 1/2"	6 1/2"	1'-0 1/2"	2'-5"	2 3/4"	2 3/4"	4"	10 1/2"

BY	DATE	Notes Added	LRH	4-19-74	
MADE	G.S.H.	3-14-69	Column size	T.E.M.	9-10-74
CHECKED	PTA	5-7-69	SP-1 size chg.	R.P.	11-13-74
IN CHARGE			Pier cap dim. chg.		

Note: Footing elevations are approximate only and may be varied to suit field conditions as directed by the Engineer. Vertical shaft reinforcing shall not be cut until these elevations are established. Where elevations change more than 2 ft., redesign will be required.

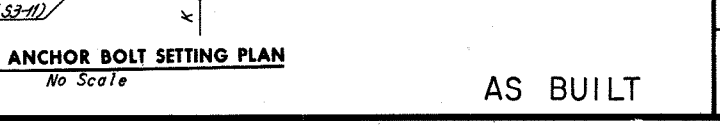

RICHMOND METROPOLITAN AUTHORITY
RICHMOND EXPRESSWAY SYSTEM
DOWNTOWN EXPRESSWAY


BRIDGE NO. 67
RAMP W-N CONNECTION TO
RICHMOND-PETERSBURG TURNPIKE
PIERS 11 AND 12E

HOWARD, NEEDLES, TAMMEN & BERGENDOFF
consulting engineers
NEW YORK ALEXANDRIA KANSAS CITY


SCALE: *As Noted*
CONTRACT NO.: 10
SHEET NO. 12 of 54

AS BUILT


RICHMOND EXPRESSWAY SYSTEM			
SECTION	PROJECT	SHEET NO.	TOTAL SHEETS
10	DOWNTOWN EXPRESSWAY	185	265

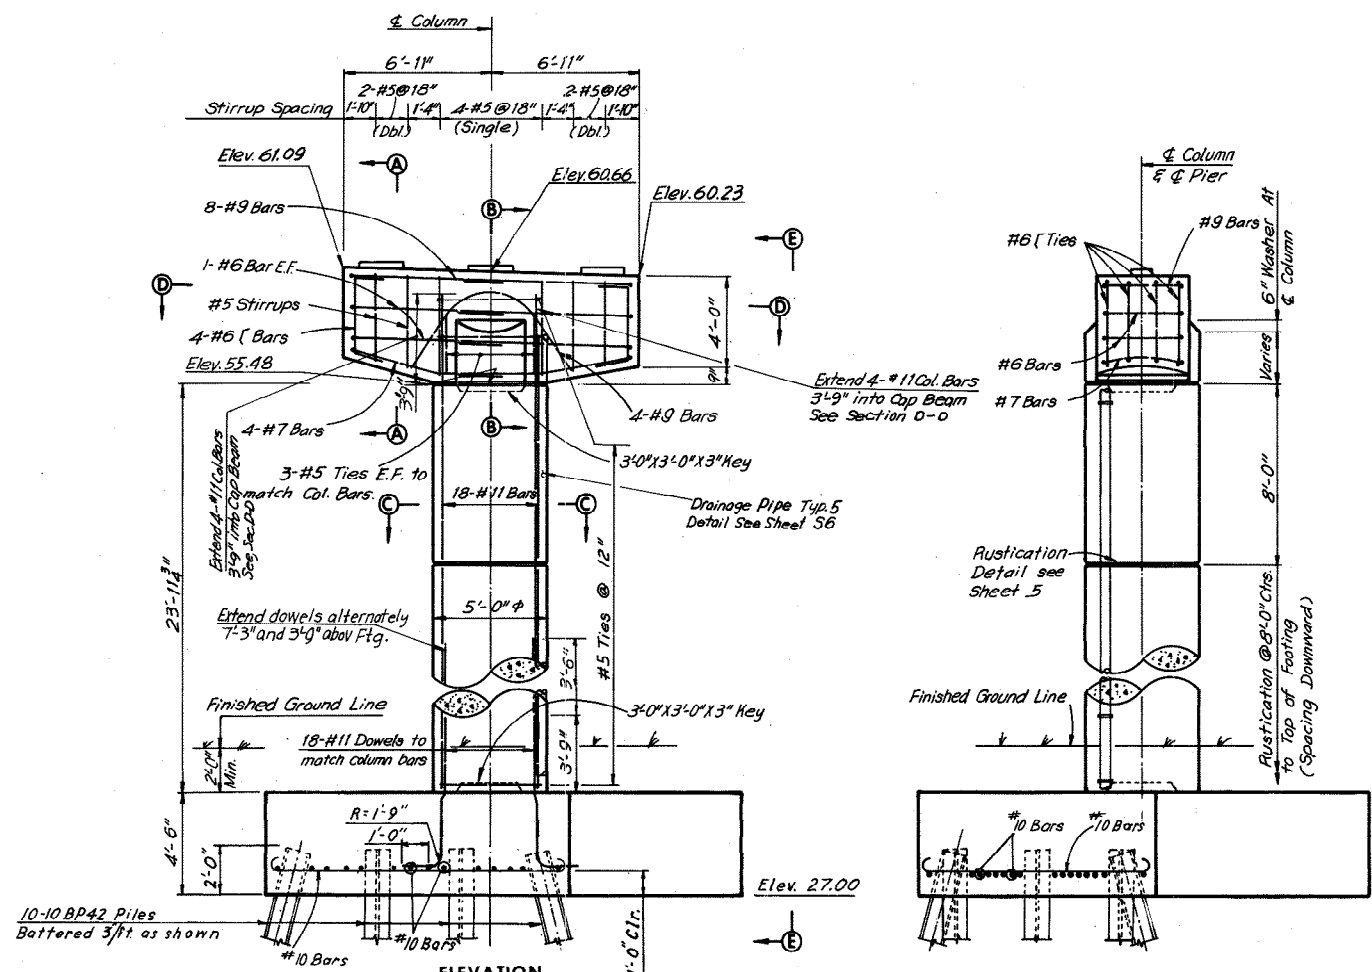


ELEVATION
Scale: 1/4"=1'-0"

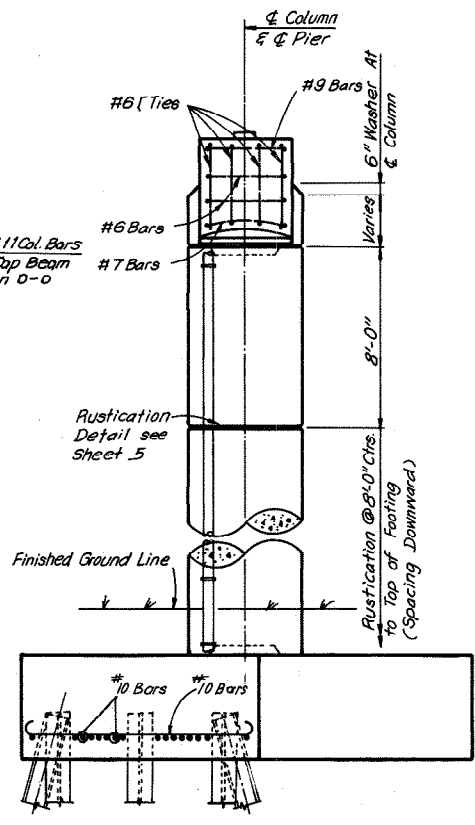


VIEW E-E
Scale: 1/4"=1'-0"

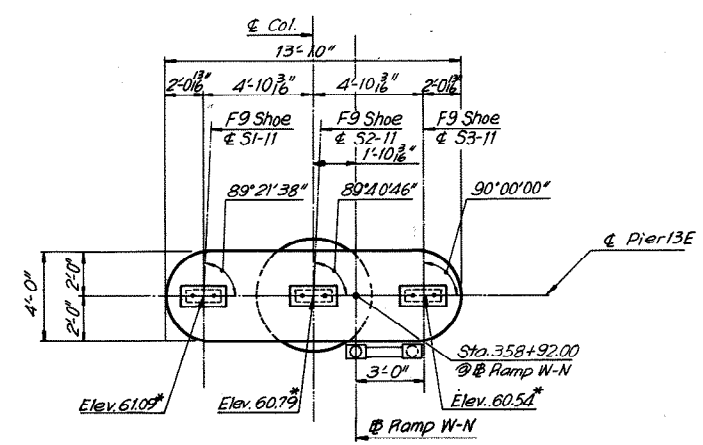



PLAN
Scale: 1/4"=1'-0"
* Denotes Elevations of Top Pad.

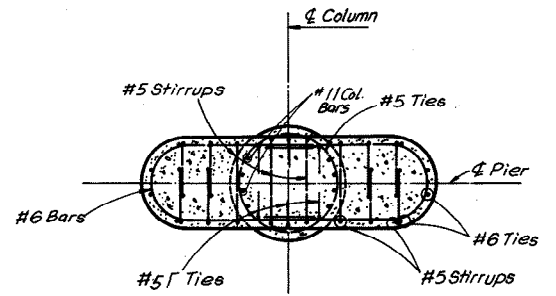


SECTION D-D
Scale: 1/4"=1'-0"

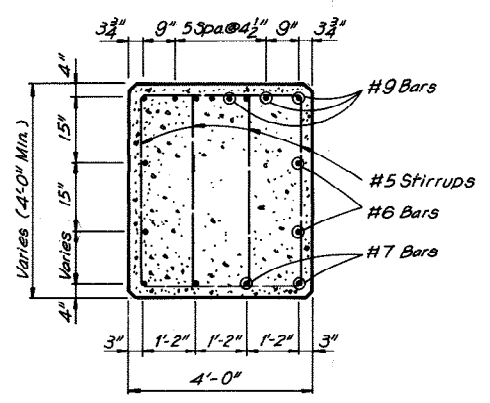


SECTION A-A
Scale: 1/2"=1'-0"

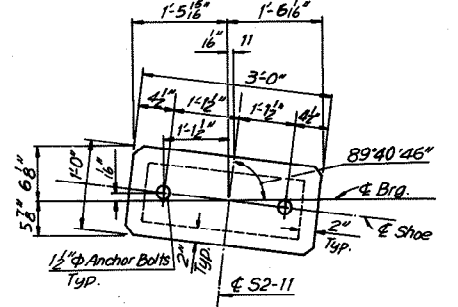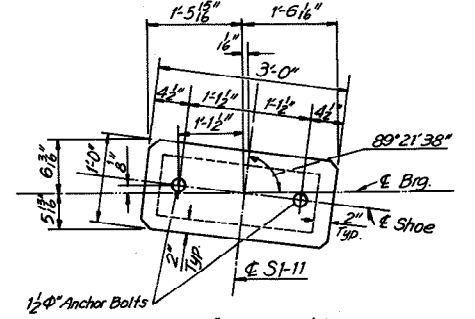


PAD AND ANCHOR BOLT SETTING PLAN
No Scale

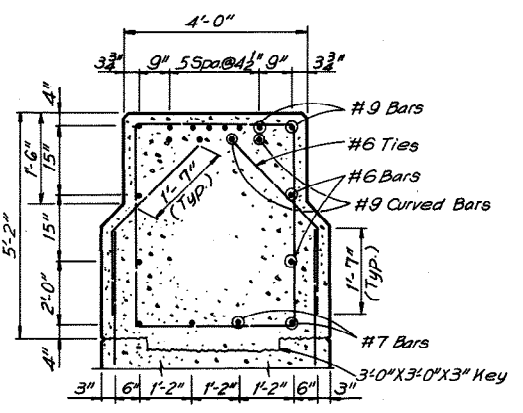

SECTION B-B
Scale: 1/4"=1'-0"

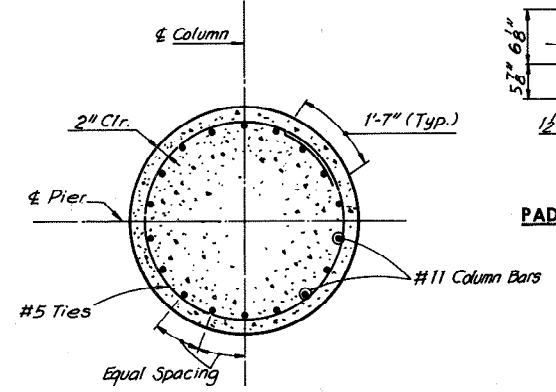

SECTION C-C
Scale: 1/2"=1'-0"

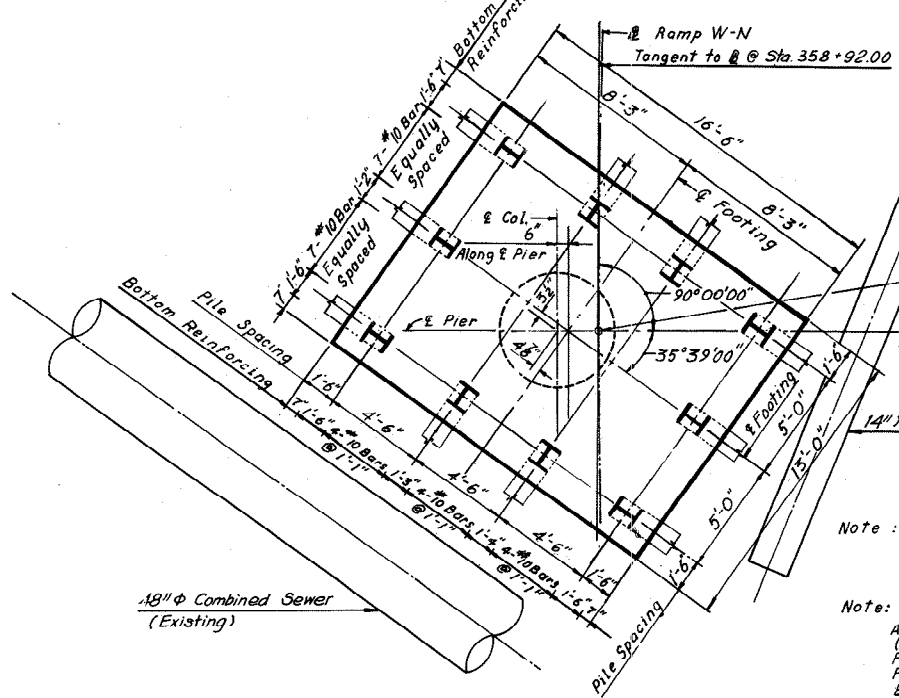

FOOTING FOR PIER 13E IS ECCENTRIC AS SHOWN ON FOOTING PLAN

Note: Be careful to avoid interference of battered piles and footing excavations with the two existing combined sewers.

Note: All piles shall be 10BP42 Steel Piles (Design capacity = 45 Tons.) For Standard Shoe Details, see Sheet For Framing Plans, see Sheets 26 & 27. Estimated Pile Tip Elevation: 3.0 For 10BP42 Steel Piles details, see Sheet 5.

Note: Footing elevations are approximate only and may be varied to suit field conditions as directed by the Engineer. Vertical shaft reinforcing shall not be cut until these elevations are established. Where elevations change more than 2 ft. redesign will be required.

FOOTING PLAN
Scale: 1/4"=1'-0"

BY	DATE	NO.	REVISION	BY	DATE
MADE	SCC 2/19/69	2	As Built	TEM	6-77
CHECKED	GSH 4/19/69		Pad Elevations	DWB	2/10/75
IN CHARGE					

RICHMOND METROPOLITAN AUTHORITY
RICHMOND EXPRESSWAY SYSTEM
DOWNTOWN EXPRESSWAY

BRIDGE NO. 67
RAMP W-N CONNECTION TO
RICHMOND-PETERSBURG TURNPIKE
PIER 13E







HOWARD, NEEDLES, TAMMEN & BERGENDOFF
consulting engineers
NEW YORK ALEXANDRIA KANSAS CITY

SCALE: As Noted
CONTRACT NO.: 10
SHEET NO. 13 OF 54

AS BUILT

SHOE SCHEDULE			
EXP. SHOE TYPE	FIXED SHOE TYPE	NO.	NO.
E2	SP-1	8	4

RICHMOND EXPRESSWAY SYSTEM			
SECTION	PROJECT	SHEET NO.	TOTAL SHEETS
10	DOWNTOWN EXPRESSWAY	196	265

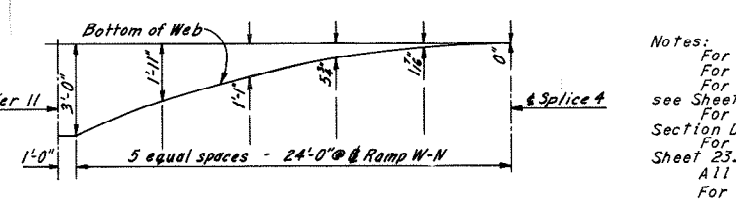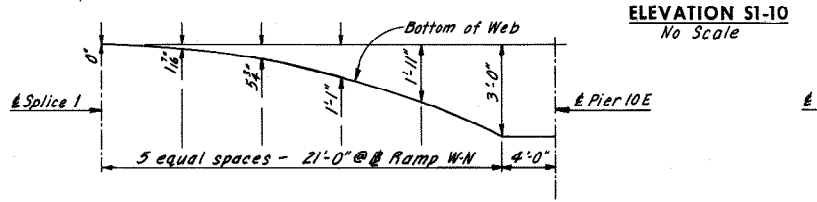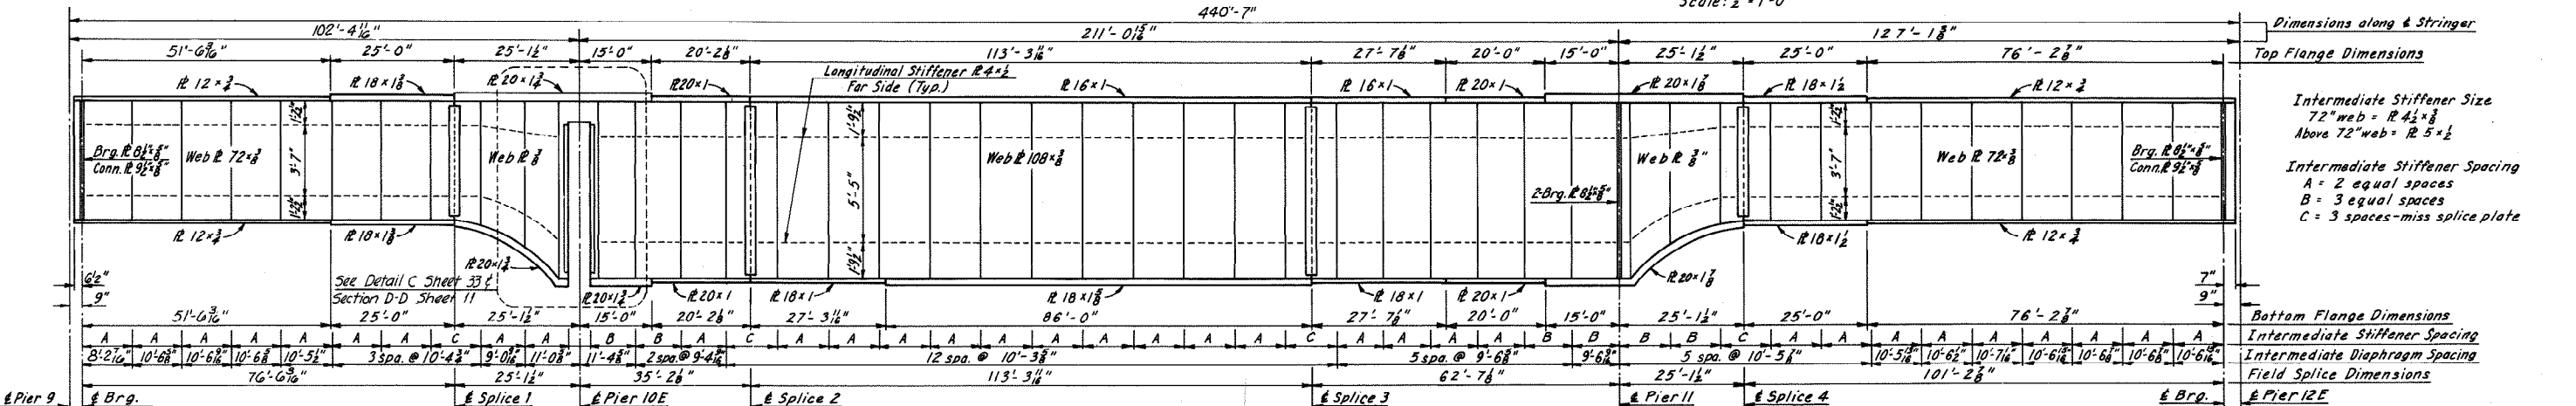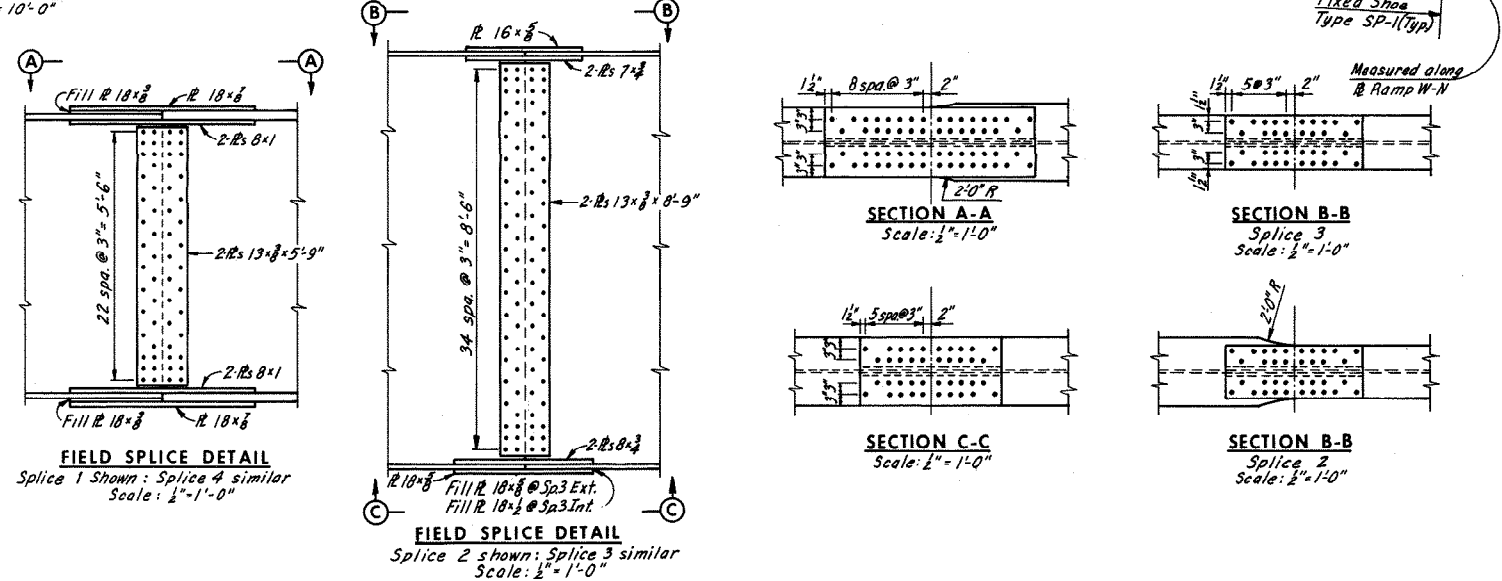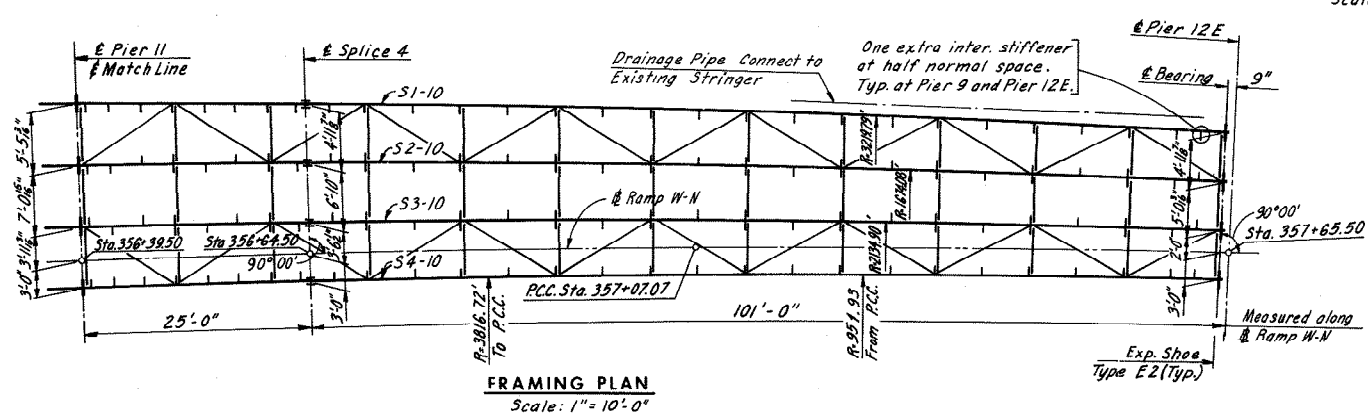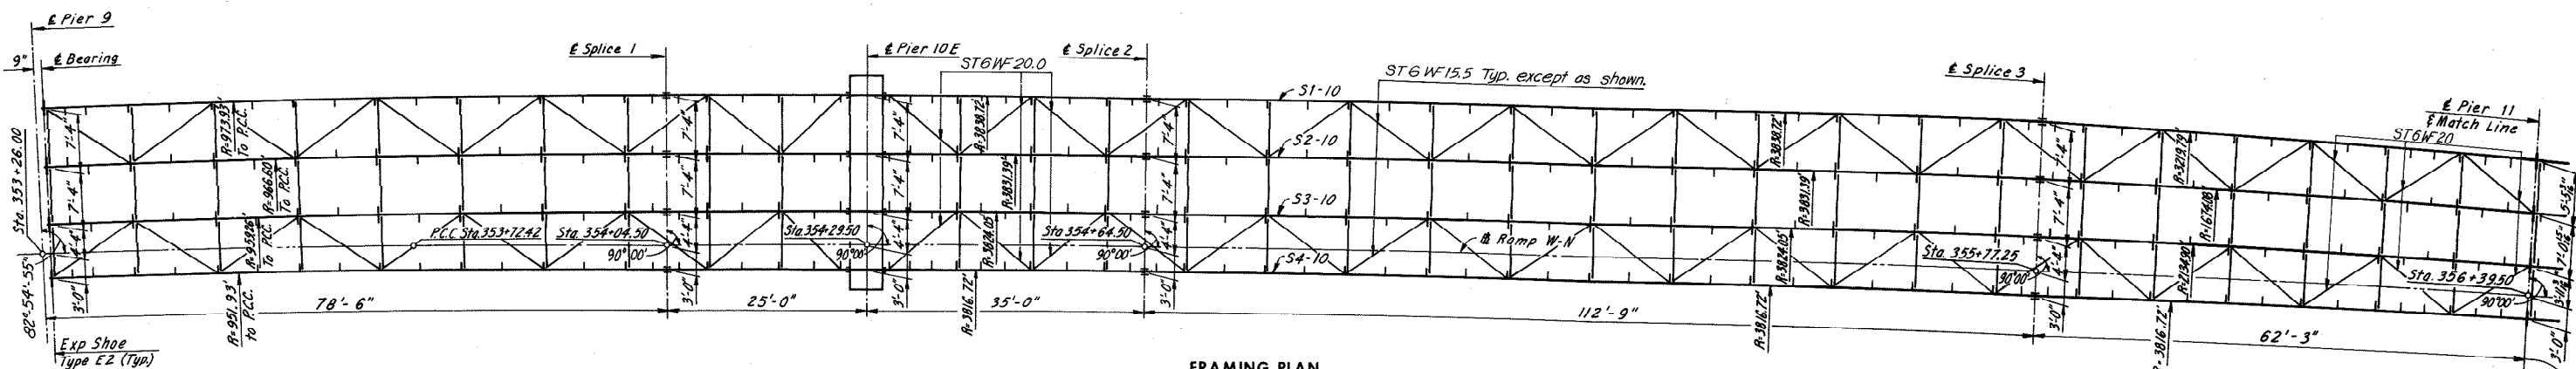

Notes:
 For Deck Plan, see Sheet 34.
 For Shoe Details, see Sheet S2.
 For Details of Intermediate Diaphragms, see Sheet 23.
 For Details of End Diaphragms, see Section D-D Sheet 33.
 For Details of Lateral Bracing, see Sheet 23.
 All steel is A36 unless otherwise noted.
 For Joint Details, see Sheet 49.
 For Web to Flange Weld, see Note, Sheet 20.


RICHMOND METROPOLITAN AUTHORITY
 RICHMOND EXPRESSWAY SYSTEM
 DOWNTOWN EXPRESSWAY
 BRIDGE NO. 67
 RAMP W-N CONNECTION TO
 RICHMOND-PETERSBURG TURNPIKE
 FRAMING PLAN - UNIT 10

BY	DATE	Note Added	LRH	4-19-74	
MADE	AMH	2-28-69	2 As Built	TEM	G-77
CHECKED	JD	4-26-69			
IN CHARGE					

SCALE:	As Noted
CONTRACT NO.:	10
SHEET NO.:	24 OF 54
HOWARD, NEEDLES, TAMMEN & BERGENDOFF consulting engineers NEW YORK ALEXANDRIA KANSAS CITY	

AS BUILT

RICHMOND EXPRESSWAY SYSTEM			
SECTION	PROJECT	SHEET NO.	TOTAL SHEETS
10	DOWNTOWN EXPRESSWAY	197	265

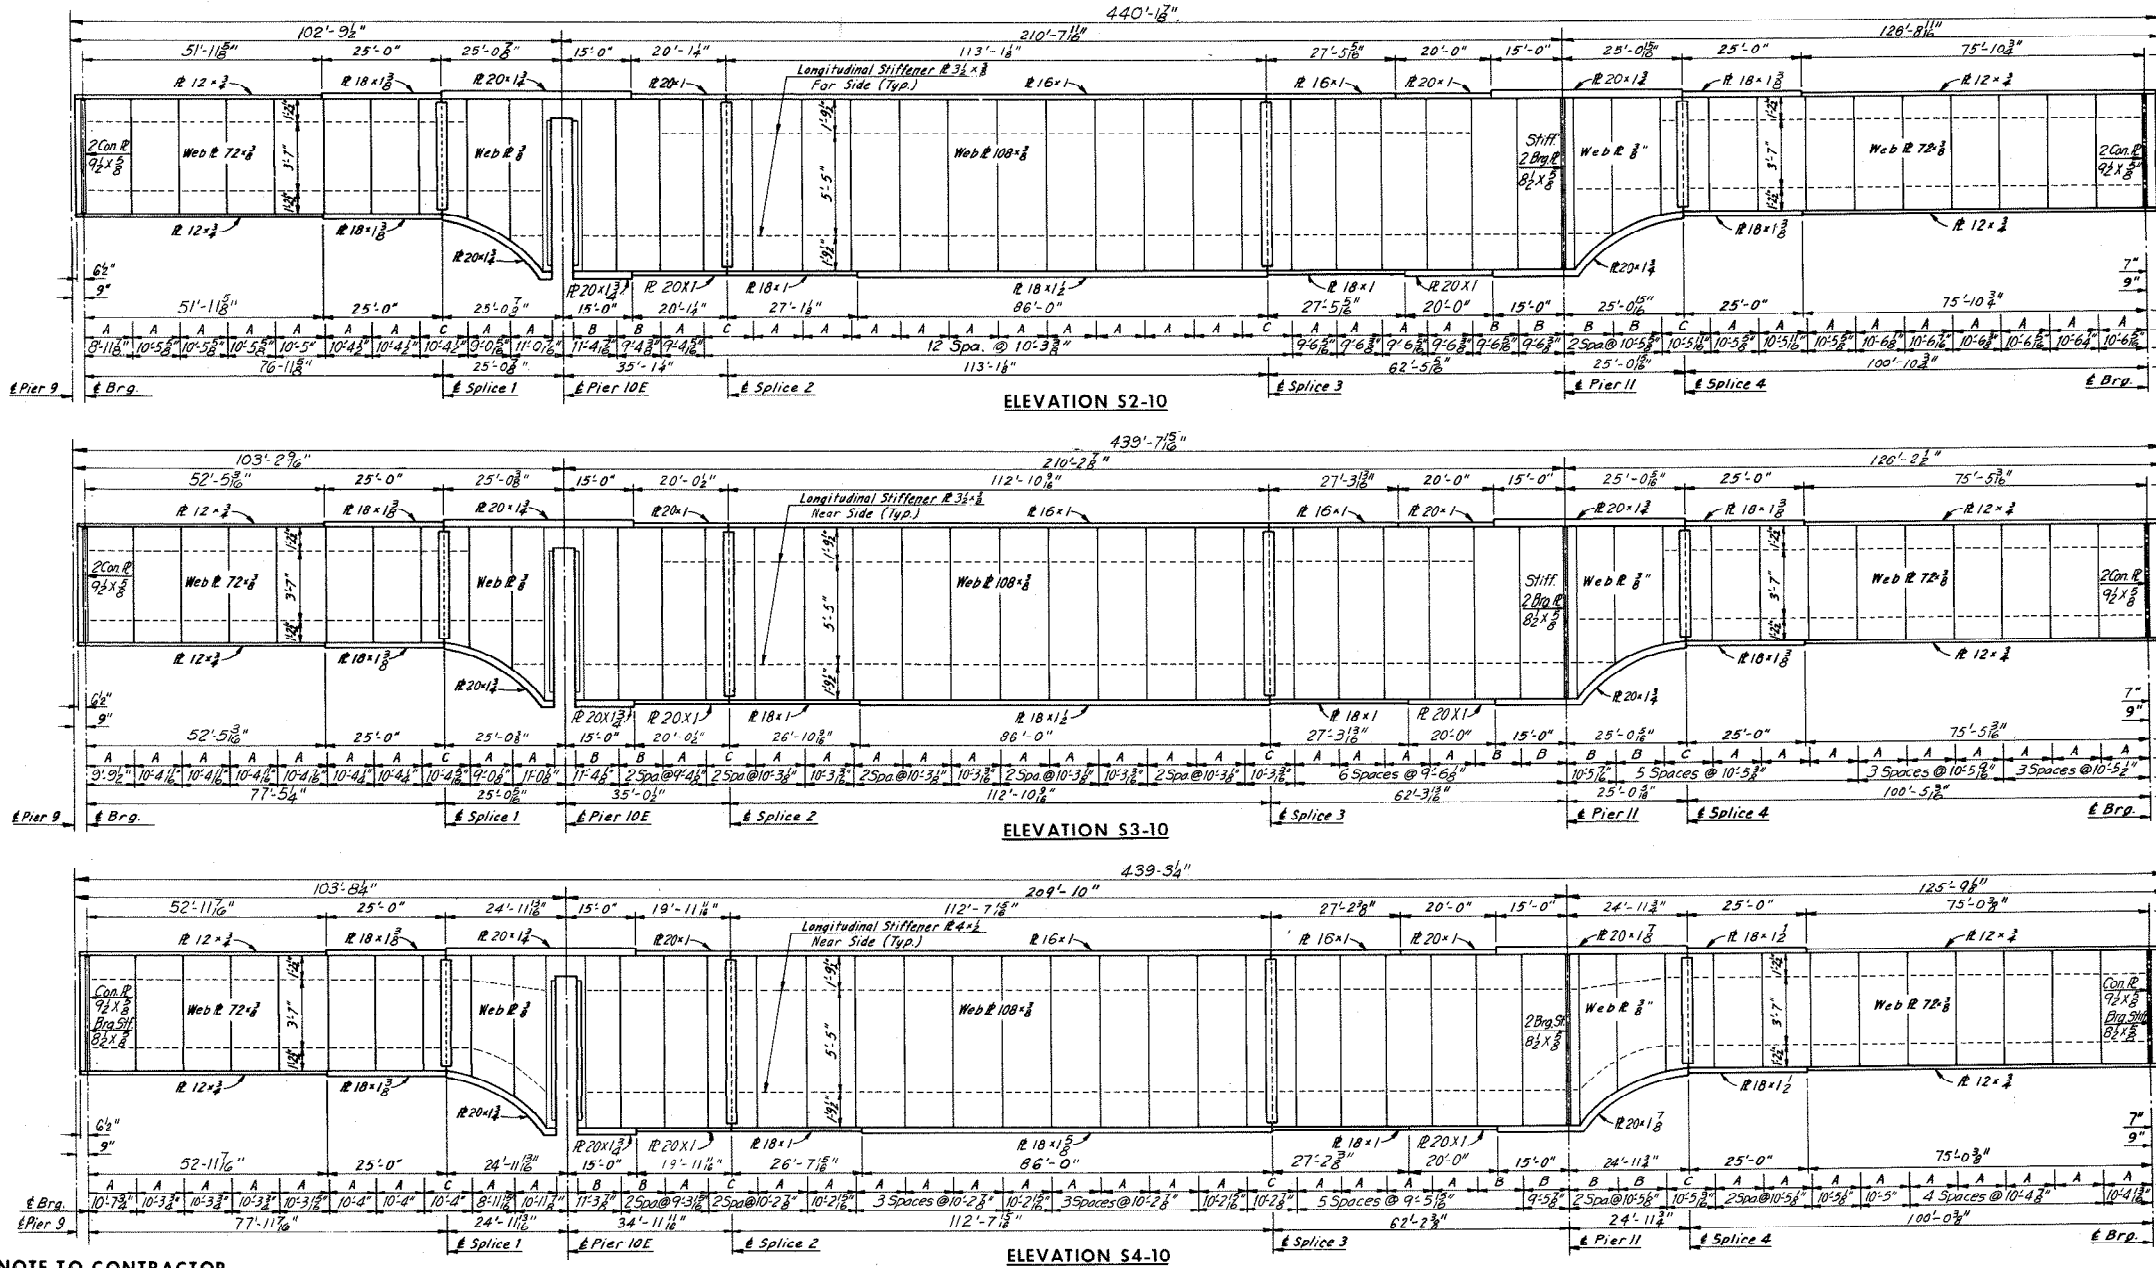

Dimensions along & Stringer
Top Flange Dimensions
Bottom Flange Dimensions
Intermediate Stiffener Spacing
Intermediate Diaphragm Spacing
Field Splice Dimensions

Intermediate Stiffener Size
72" web - R 4 1/2 x 3/8
Above 72" web - R 5 x 1/2

Intermediate Stiffener Spacing
A - 2 equal spaces
B - 3 equal spaces
C - 3 spaces - miss splice plate

STRINGER	ELEV. A	ELEV. B	ELEV. C	ELEV. D	ELEV. E	ELEV. F
S1-10	88.50	87.37	85.60	80.87	76.81	72.72
S2-10	88.35	87.23	85.46	80.65	76.57	72.42
S3-10	88.21	87.08	85.31	80.43	76.24	72.12
S4-10	88.06	86.93	85.16	80.20	75.93	71.82

NOTE TO CONTRACTOR

Deflections given are those anticipated to occur in the stringer upon placement of the total concrete deck dead load. In practice, the stringers in place are not likely to have the exact camber to compensate for these deflections during construction. The residual amounts shall be provided by adjusting forms to vary the thickness of the concrete haunch between the bottom of the slab and the top of stringer without altering the slab thickness.

NOTE TO FABRICATOR

The stringers shall be fabricated with an upward camber amounting to the tabulated value. This will provide approximate compensation for deflection under full dead load and for conformity with finished grade.

CAMBER
Stringers having a total camber of less than 1" are not required to be shop cambered, but should be turned so that any mill tolerance deviation from straightness will be in the direction shown by the Camber Diagram.


If stringers are not cambered distance top of stringers to top of slab will vary along the stringer in accordance with the offset dimensions shown in the Camber Diagram, and with minimum distance as shown in Cross-Section on Sheet

DEAD LOAD

DEFLECTION

DIAGRAM

Exterior Stringer S1-10
Interior Stringer S2-10
Exterior Stringer S4-10

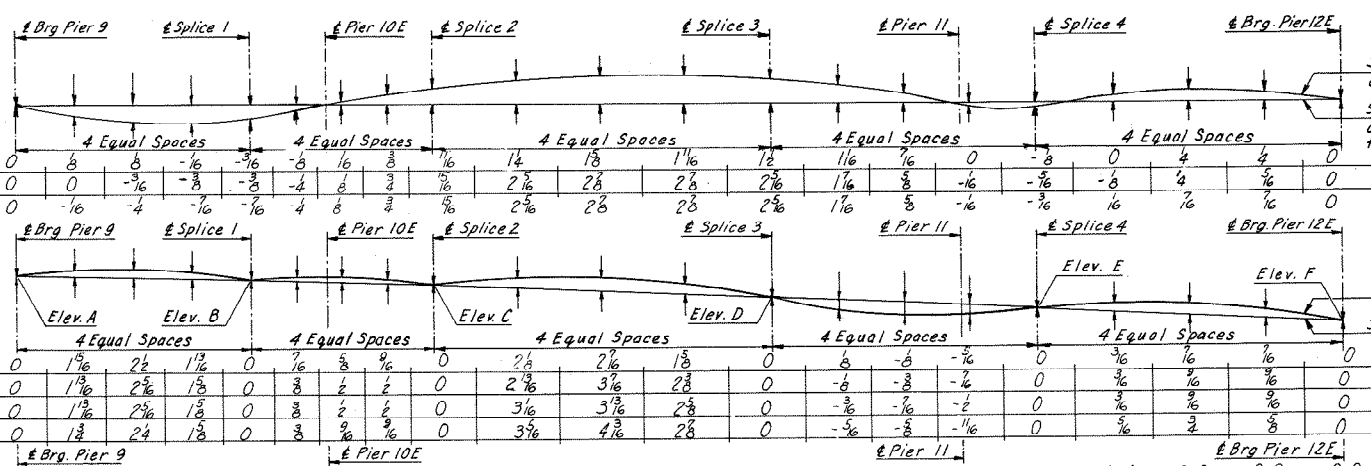

Shape of top of form before any deck slab concrete is cast
Shape of top of form (bottom of deck slab) after deflection from total concrete deck dead load.
Straight line btwn. splices

Notes:
For Deck Plan, see Sheet 34.
All Steel shall be A36 unless otherwise noted.
For Details not shown, see Section D-D, sheet 11, and Detail C, sheet 33.
For Web to Flange Weld size, see Note, sheet 20.

Notes:
Deflections, camber, and stud spacings are in inches.

BY	DATE	Note Added	LRH	4-19-76
MADE	AMH	22869	Z	As Built
CHECKED	JD	4-24-69		TEM
IN CHARGE			NO.	REVISION
			BY	DATE

MAX. SHEAR STUD SPACING

Exterior Stringers
Interior Stringers

0.0	0.2	0.4	0.6	0.8	0.0	0.2	0.4	0.6	0.8	0.0	0.2	0.4	0.6	0.8	0.0	
21	24	24	24	24	24	24	24	24	24	22	24	24	24	24	24	24
21	24	24	24	24	24	24	24	24	24	24	24	24	24	24	24	20


RICHMOND METROPOLITAN AUTHORITY
RICHMOND EXPRESSWAY SYSTEM
DOWNTOWN EXPRESSWAY

BRIDGE NO. 67
RAMP W-N CONNECTION TO
RICHMOND-PETERSBURG TURNPIKE
GIRDER ELEVATIONS-UNIT 10

SCALE:	NO Scale
CONTRACT NO.:	10
SHEET NO.:	25 OF 54

AS BUILT


RICHMOND EXPRESSWAY SYSTEM			
SECTION	PROJECT	SHEET NO.	TOTAL SHEETS
10	DOWNTOWN EXPRESSWAY	198	265

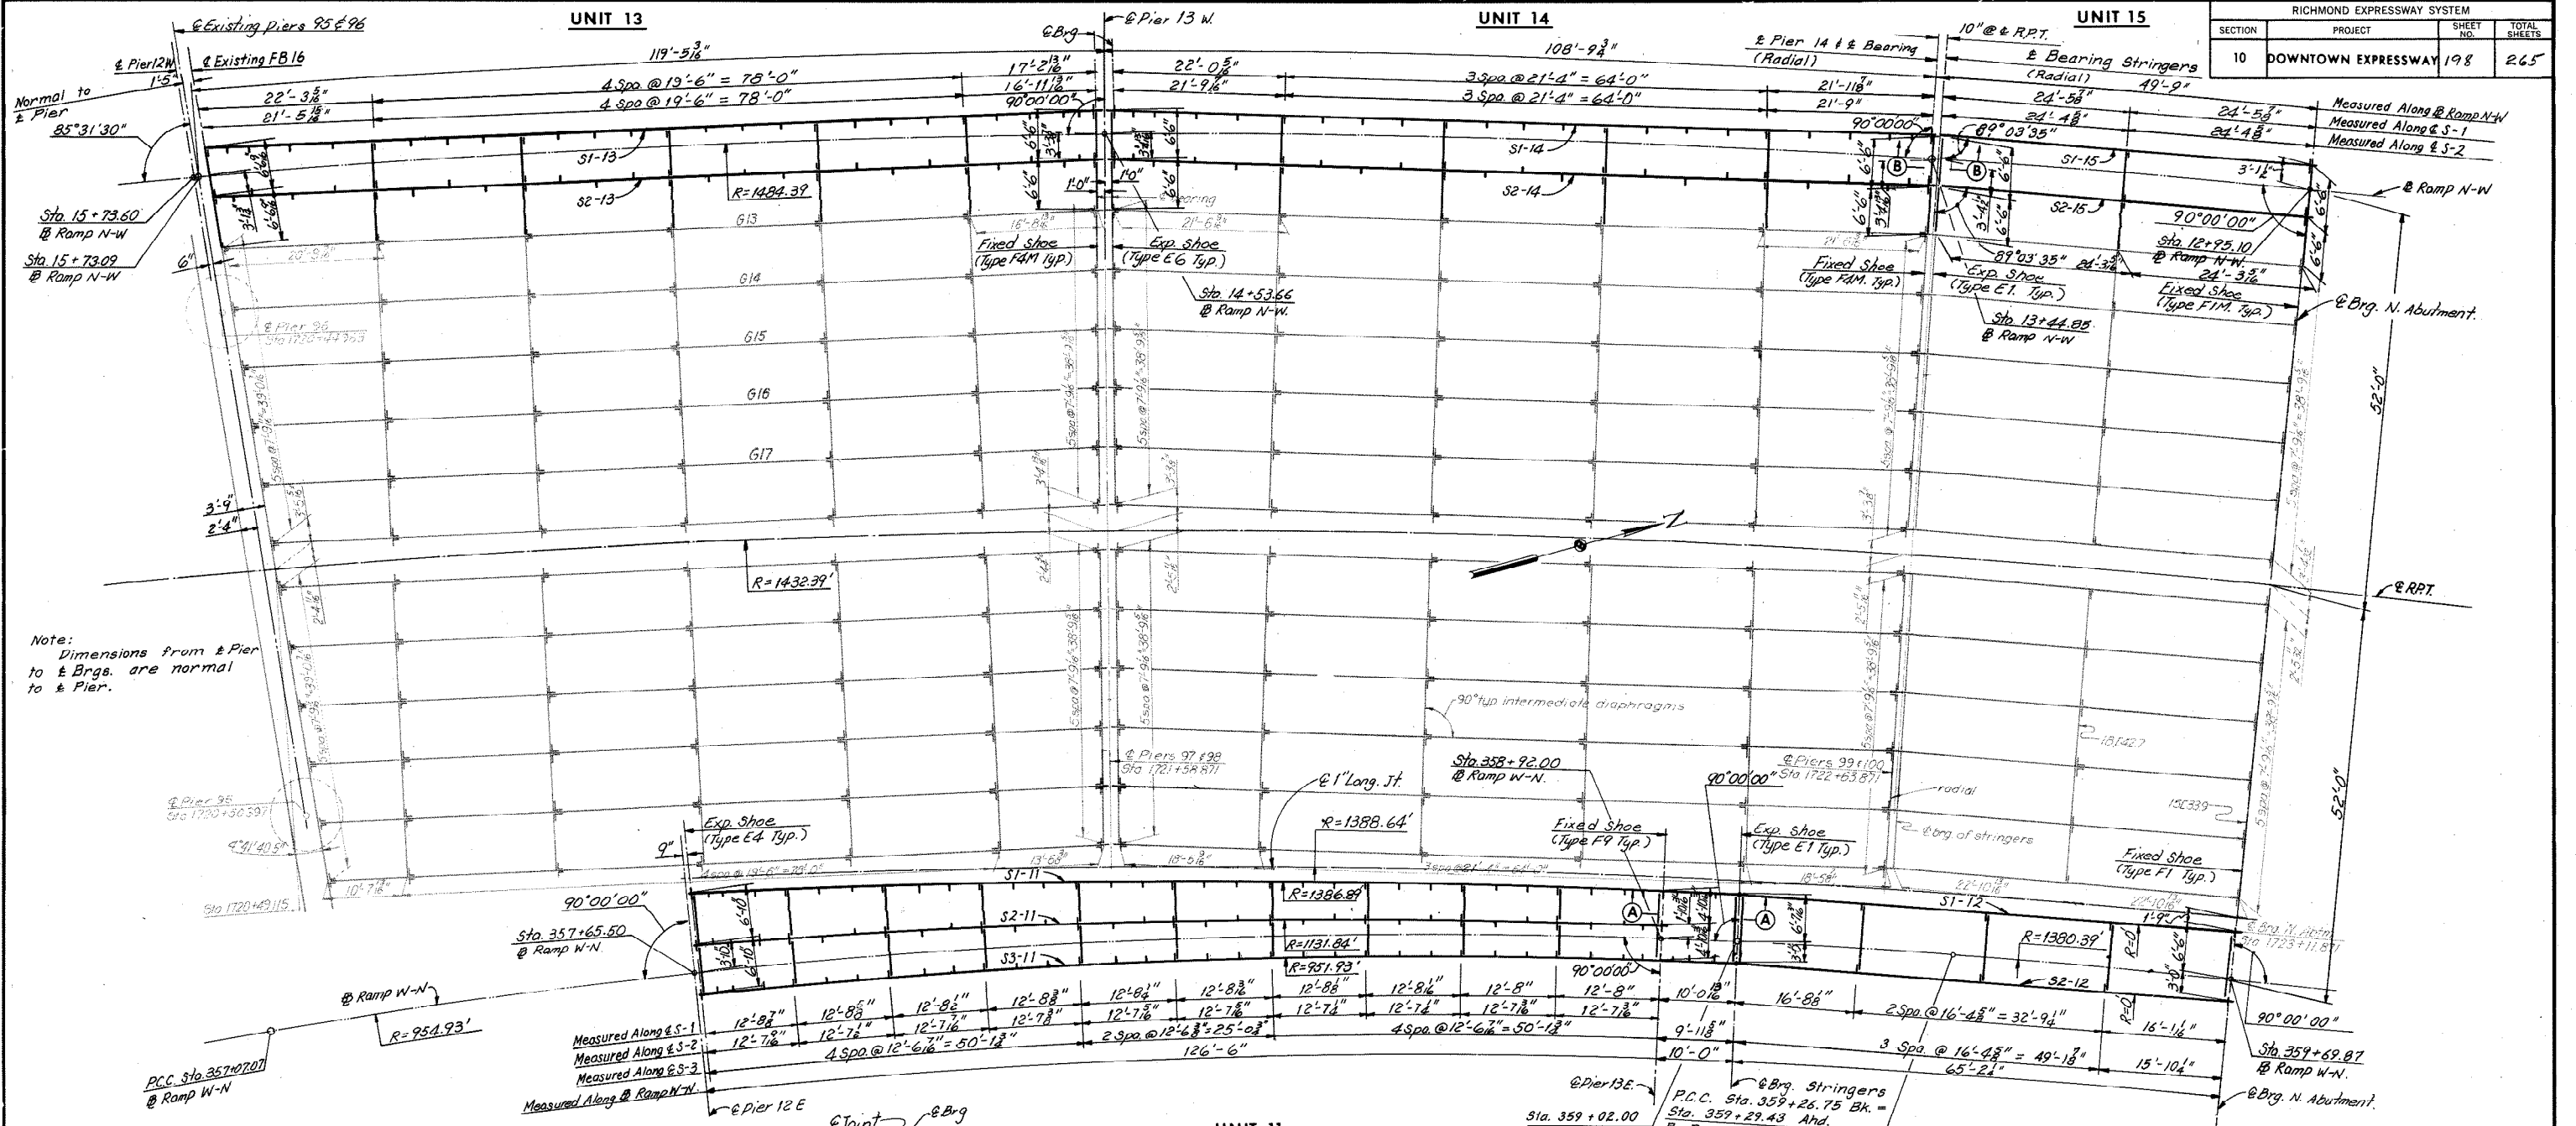

Note:
Dimensions from & Pier
to & Brgs. are normal
to & Pier.


Note:
For Stringer Elevation, see Sheet 27.
For Stringer Schedule, see Sheet 27.
For Camber Schedule, see Sheet 27.
For FB 16 Details, see Sheet 28.
For Deck Plan, see Sheet 33.
For Shoe Details, see Sheets S1&S2.

Note:
Dimensions shown on the plans for existing structural metalwork are in accordance with drawings prepared for the original construction. The Contractor shall verify all necessary dimensions of existing structural metalwork prior to fabrication of new metalwork.
New Diaphragms are to match Existing Diaphragms, in Units 13, 14 and 15.

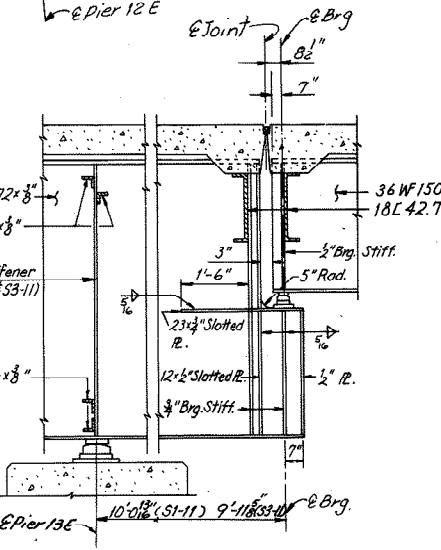

SECTION A-A
Scale: 1/2\"/>

FRAMING PLAN
Scale: 1\"/>

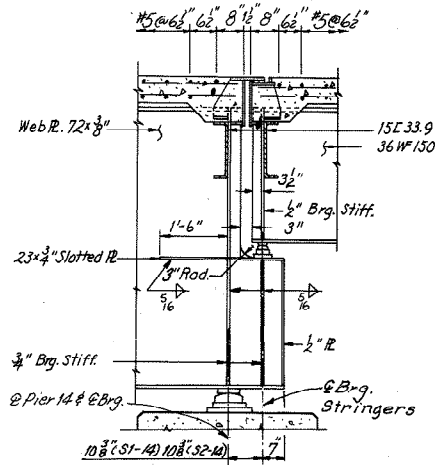

SECTION B-B
Scale: 1/2\"/>

Note:
Intermediate stiffener Pls. 4x3\"/>

SHOE SCHEDULE			
FIXED SHOES		EXPANSION SHOES	
TYPE	NO. REQD.	TYPE	NO. REQD.
F1	2	E1	4
F1M	2	E4	3
F4M	4	E6	2
F9	3	-	-

RICHMOND METROPOLITAN AUTHORITY
RICHMOND EXPRESSWAY SYSTEM
DOWNTOWN EXPRESSWAY

BRIDGE NO. 67
RAMP W-N CONNECTION TO
RICHMOND-PETERSBURG TURNPIKE
FRAMING PLAN - UNITS 11, 12, 13, 14 AND 15


HOWARD, NEEDLES, TAMMEN & BERGENDOFF
consulting engineers
NEW YORK ALEXANDRIA KANSAS CITY

SCALE: As Noted
CONTRACT NO. 10
SHEET NO. 26 OF 54


BY	DATE	REVISION	BY	DATE
K.C.T.	2-24-69	As Built	TEM	6-77
MADE	K.C.T.	2-24-69	REVISION	BY
CHECKED	K.C.T.	4-20-69	BY	DATE
IN CHARGE	NO.	REVISION	BY	DATE

AS BUILT

RICHMOND EXPRESSWAY SYSTEM			
SECTION	PROJECT	SHEET NO.	TOTAL SHEETS
10	DOWNTOWN EXPRESSWAY	199	265

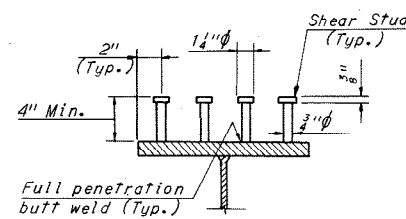

SHEAR STUD DETAIL
No Scale

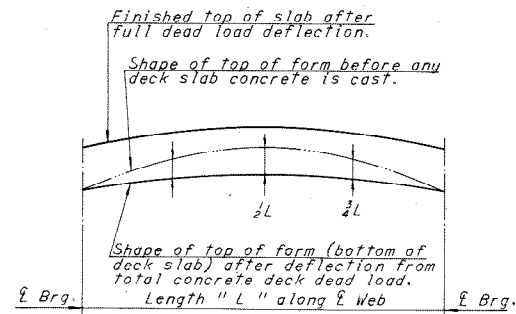


DEAD LOAD DEFLECTION DIAGRAM

NOTE TO CONTRACTOR

Deflections given are those anticipated to occur in the stringer upon placement of the total concrete deck dead load. In practice, the stringers in place are not likely to have the exact camber to compensate for these deflections during construction. The residual amounts shall be provided by adjusting forms to vary the thickness of the concrete haunch between the bottom of the slab and the top of stringer without altering the slab thickness.

SHEAR STUD NOTE

Capacity = 3,400 lbs. per stud. The Contractor may, if he elects, use three 1/2 inch diameter studs at the same longitudinal spacing in lieu of the four 3/4 inch diameter studs shown. Stud rows shall be placed parallel to the main deck reinforcing. Shear stud spacing shown is maximum spacing.

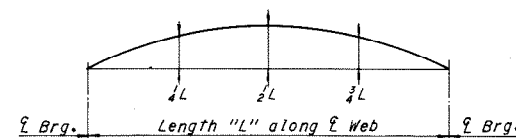


CAMBER DIAGRAM


NOTE TO FABRICATOR

The stringers shall be fabricated with an upward camber amounting to the tabulated value. This will provide approximate compensation for deflection under full dead load and for conformity with finished grade.


Note: Stringers having a total camber of less than 1 inch are not required to be shop cambered, but should be turned so that any mill tolerance deviation from straightness will be in the direction shown by the Camber Diagram. If stringers are not cambered, distance top of stringers to top of slab will vary along the stringer in accordance with the offset dimensions shown in the Camber Diagram, and with minimum distance as shown in Cross-Section on Sheet 35.

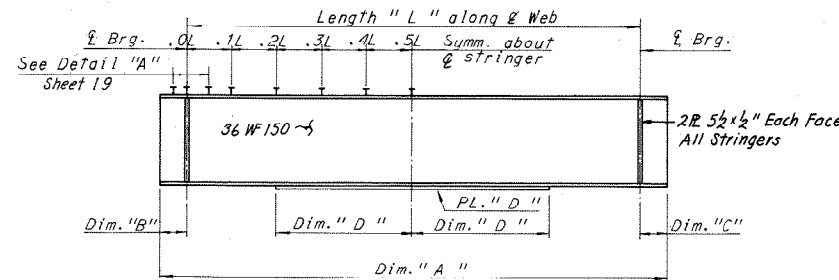


STRINGER ELEVATION
No Scale
(Unit 12 & 15)

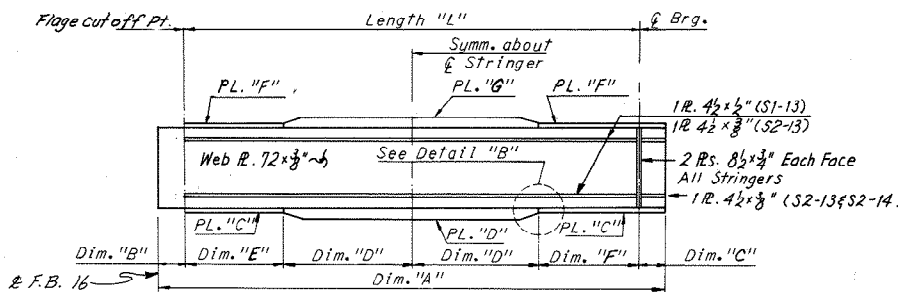


STRINGER ELEVATION
No Scale
(Unit 13)

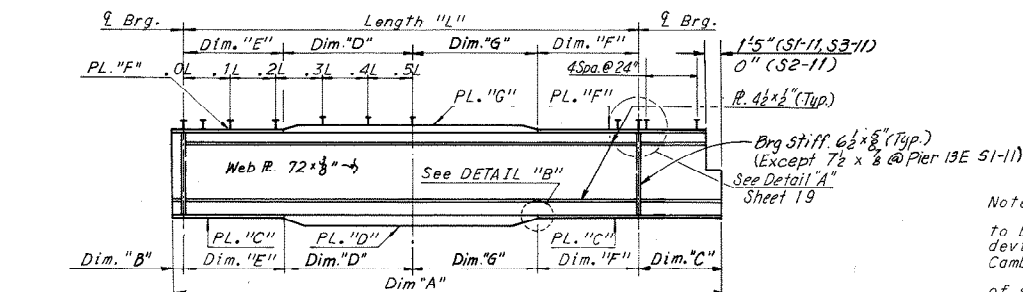

STRINGER ELEVATION
No Scale
(Unit 11)

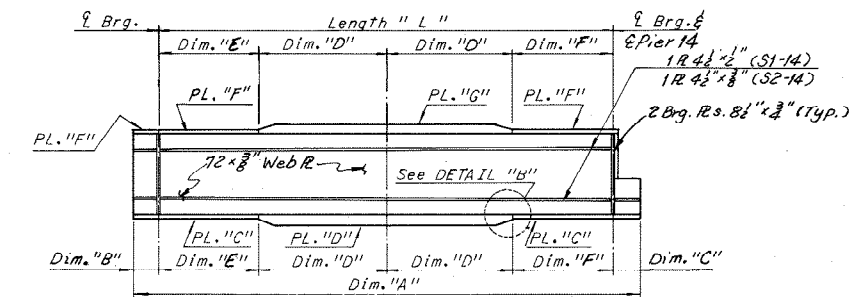


STRINGER ELEVATION
No Scale
(Unit 14)

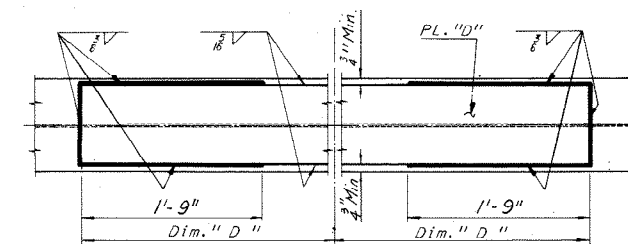

COVER PLATE DETAIL
No Scale

Note: Stringers having a total camber of less than 1 inch are not required to be shop cambered, but should be turned so that any mill tolerance deviation from straightness will be in the direction shown by the Camber Diagram. If stringers are not cambered, distance top of stringers to top of slab will vary along the stringer in accordance with the offset dimensions shown in the Camber Diagram, and with minimum distance as shown in cross-section on Sheet 35.

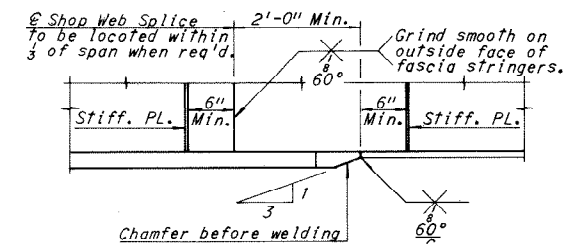

DETAIL "B"
No Scale
NOTE: Web to flange weld size see sheet 20.

UNIT	STRINGER	Dim. "A"	LENGTH	Dim. "B"	Dim. "C"	Dim. "D"	Dim. "E"	Dim. "F"	Dim. "G"	PL. "C"	PL. "D"	PL. "F"	PL. "G"	MAX. SHEAR STUD SPACING					DEAD LOAD DEFLECTION SCHEDULE			CAMBER SCHEDULE			
														0.0L-0.1L*	0.1L-0.2L	0.2L-0.3L	0.3L-0.4L	0.4L-0.5L	1/4L	1/2L	3/4L	1/4L	1/2L	3/4L	
11	S1-11	133'-1 1/2"	126'-11"	7"	10'-7 1/2"	38'-0"	25'-5 1/2"	25'-5 1/2"	38'-0"	16'-1 1/2"	18 x 2"	12 x 1"	16 x 1"	17"	19"	24"	24"	24"	24"	1 1/2"	1 1/2"	1 1/2"	2 3/8"	3 3/8"	2 3/8"
	S2-11	127'-3 3/8"	126'-1 3/8"	7"	7"	31'-6"	31'-6 1/8"	31'-6 1/8"	31'-6"	14 x 1 1/2"	16 x 2"	12 x 1"	12 x 1"	18"	20 1/2"	24"	24"	24"	24"	1 1/2"	2 3/8"	1 1/2"	2 3/8"	4"	3 3/8"
	S3-11	136'-5 1/2"	125'-4 1/2"	7"	10'-6 5/8"	37'-8"	25'-0 1/2"	18'-6 1/2"	44'-2"	14 x 1"	14 x 2"	12 x 1 1/2"	12 x 1 1/2"	22"	24"	24"	24"	24"	24"	1 3/4"	2 1/2"	1 1/2"	2 3/8"	4"	2 3/8"
12	S1-12	66'-9 1/2"	65'-6 1/2"	7"	8"	24'-0"	-	-	-	36 W 150	10 1/2 x 1 1/2"	-	-	8"	9"	11"	12 1/2"	15"	15"	1 3/4"	1 1/2"	1 1/2"	1 1/2"	1 1/2"	1 1/2"
	S3-12	66'-5 1/2"	65'-0 1/2"	7"	10"	23'-9"	-	-	-	36 W 150	10 1/2 x 1 1/2"	-	-	10"	11"	14 1/2"	17 1/2"	24"	24"	1 3/4"	1 1/2"	1 1/2"	1 1/2"	1 1/2"	1 1/2"
13	S1-13	118'-4 1/2"	116'-2 1/2"	11"	10 1/2"	37'-0"	21'-3 3/8"	21'-3 3/8"	-	18 x 1"	18 x 1 1/2"	18 x 1"	18 x 1 1/2"	-	-	-	-	-	-	1 3/4"	1 3/8"	1 3/4"	1 3/4"	2 3/8"	1 3/4"
	S2-13	117'-4 1/2"	115'-6 3/8"	11"	10 1/2"	36'-0"	21'-9 3/8"	21'-9 3/8"	-	18 x 1"	18 x 1 1/2"	18 x 1"	18 x 1 1/2"	-	-	-	-	-	-	1 3/4"	1 3/8"	1 3/4"	1 3/4"	2 3/8"	1 3/4"
14	S1-14	110'-4 1/2"	108'-0 3/8"	10 1/2"	11'-5 3/8"	35'-0"	19'-0 1/2"	19'-0 1/2"	-	18 x 1"	18 x 1 1/2"	18 x 1"	18 x 1 1/2"	-	-	-	-	-	-	1 1/2"	1 3/8"	1 1/2"	1 3/8"	1 3/4"	1 1/2"
	S2-14	109'-10 3/8"	107'-6 1/2"	10 1/2"	11'-5 3/8"	35'-0"	18'-9 1/2"	18'-9 1/2"	-	18 x 1"	18 x 1 1/2"	18 x 1"	18 x 1 1/2"	-	-	-	-	-	-	1 1/2"	1 3/8"	1 1/2"	1 3/8"	1 3/4"	1 1/2"
15	S1-15	50'-1 1/2"	48'-11 3/4"	3 1/2"	10"	-	-	-	-	36 W 150	-	-	-	-	-	-	-	-	-	1 1/2"	1 1/2"	1 1/2"	1 1/2"	1 1/2"	1 1/2"
	S2-15	49'-8 1/2"	48'-9 3/8"	3 1/2"	8"	-	-	-	-	36 W 150	-	-	-	-	-	-	-	-	-	1 1/2"	1 1/2"	1 1/2"	1 1/2"	1 1/2"	1 1/2"

* Spacing begins at termination of 6 spaces @ 4".

NOTE: All steel shall be A36 unless otherwise shown. Longitudinal stiffeners of exterior stringer shall be located on the exterior face of the stringer.

BY	DATE	REVISION	BY	DATE
MADE	K.C.P. 2-26-69	2 As Built	TEM	6-77
CHECKED	K.C.T. 4-28-69			
IN CHARGE				

RICHMOND METROPOLITAN AUTHORITY
RICHMOND EXPRESSWAY SYSTEM
DOWNTOWN EXPRESSWAY

BRIDGE NO. 67
RAMP W-N CONNECTION TO
RICHMOND-PETERSBURG TURNPIKE
FRAMING PLAN - UNITS 11,12,13,14 AND 15


SCALE: No Scale
HOWARD, NEEDLES, TAMMEN & BERGENDOFF
consulting engineers
NEW YORK ALEXANDRIA KANSAS CITY
CONTRACT NO. 10
SHEET NO. 27 OF 54

AS BUILT



RICHMOND EXPRESSWAY SYSTEM			
SECTION	PROJECT	SHEET NO.	TOTAL SHEETS
10	DOWNTOWN EXPRESSWAY	205	265

ELEVATION TABLE			
STATION	ELEV A	ELEV B	ELEV C
352+30.00	88.57	88.33	88.29
32.00	88.63	88.37	88.33
40.00	88.83	88.52	88.46
50.00	89.06	88.67	88.60
60.00	89.20	88.81	88.74
70.00	89.30	88.91	88.84
80.00	89.39	89.00	88.93
90.00	89.44	89.05	88.98
353+00.00	89.47	89.08	89.01
10.00	89.48	89.09	89.02
20.00	89.46	89.07	89.00
26.00	89.44	89.05	88.98
30.00	89.42	89.03	88.96


Note: Connect Lighting Conduit in existing structure with Junction Box at nose of new part of structure.

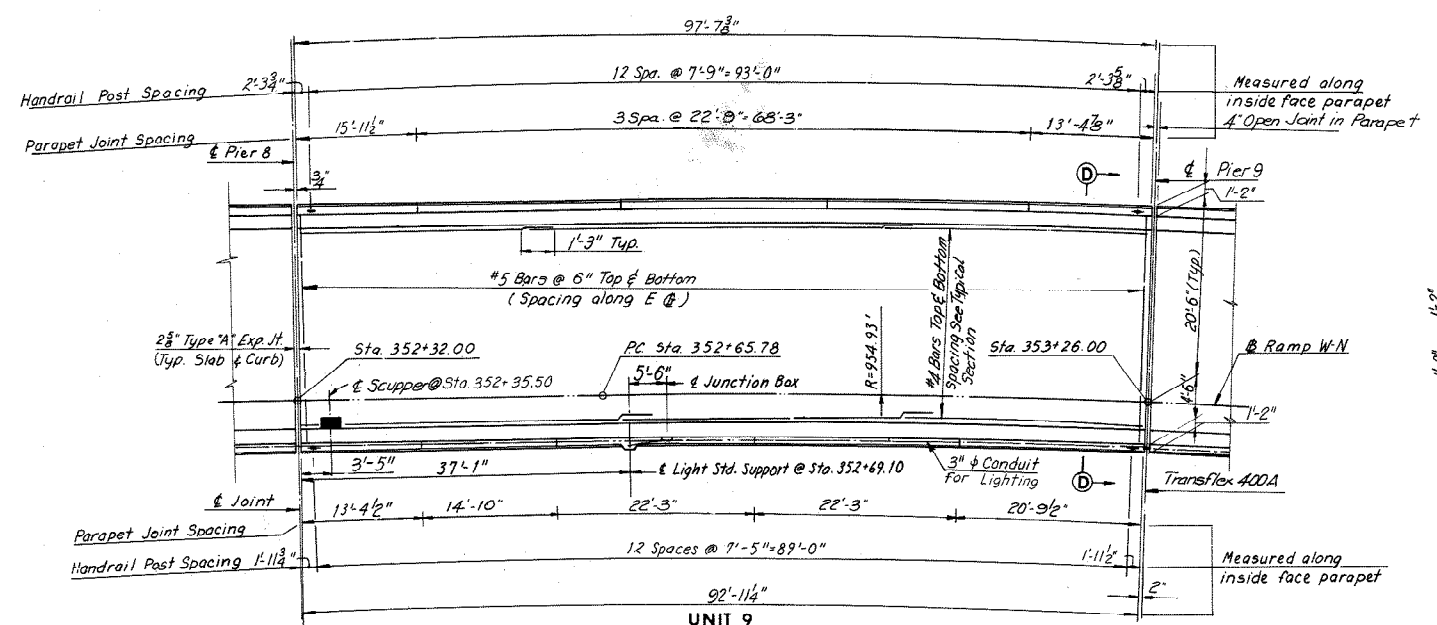


UNIT 9
DECK PLAN
Scale: 1" = 10'-0"

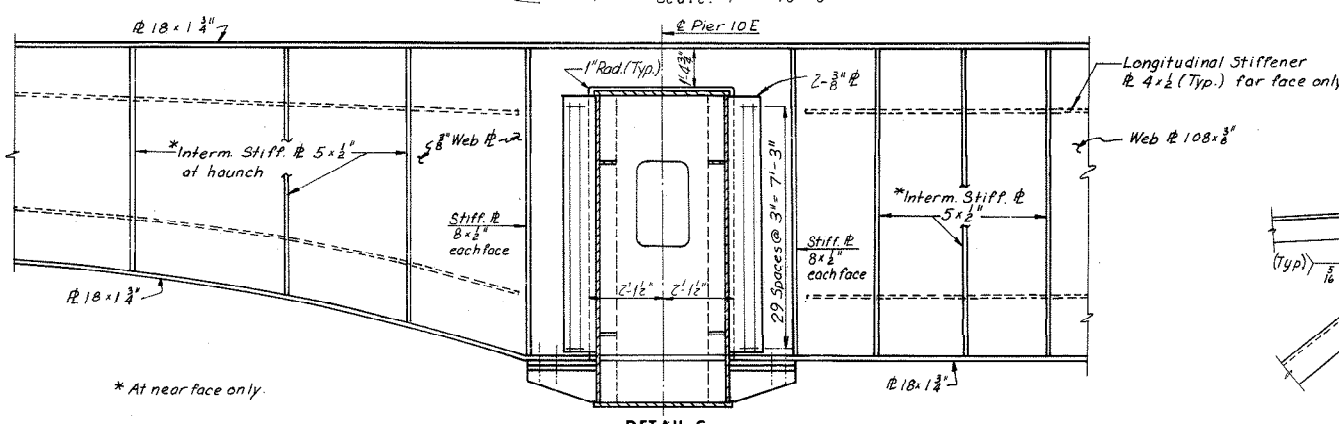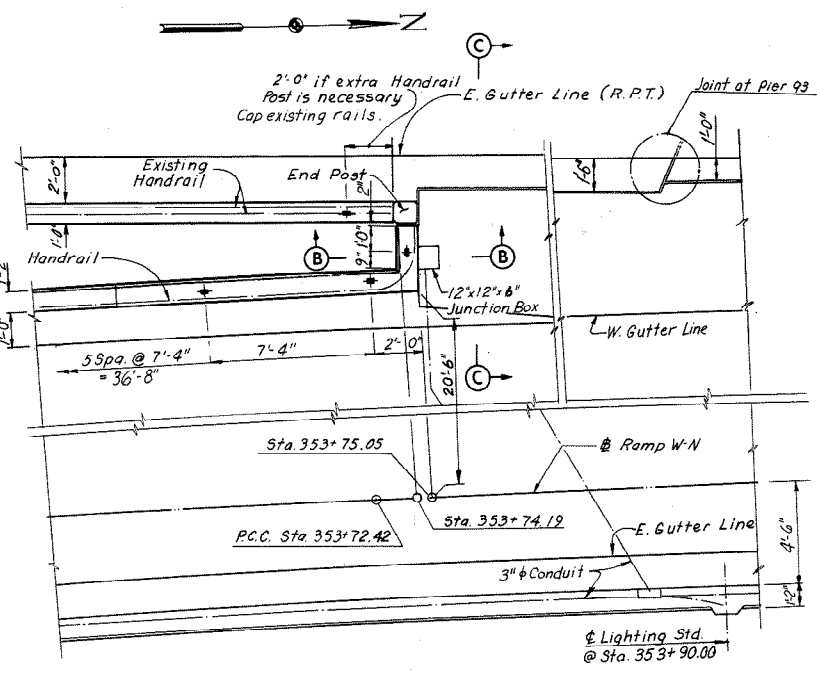


DETAIL C
Scale: 3/8" = 1'-0"

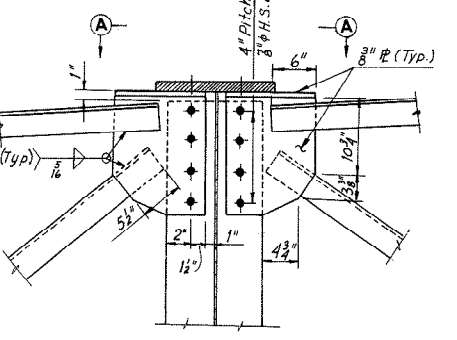


DETAIL A
Scale: 1" = 1'-0"

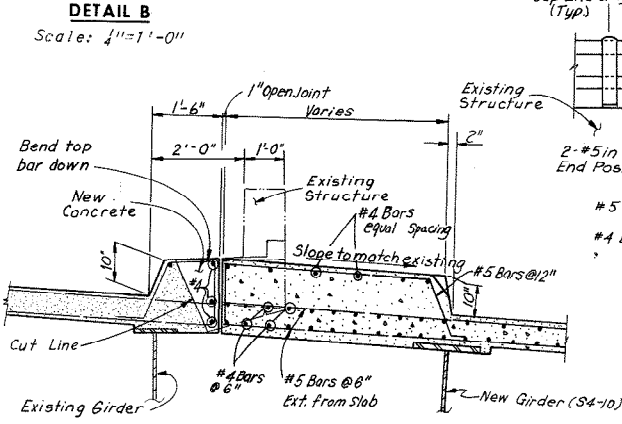


SECTION C-C
Scale: 1/2" = 1'-0"

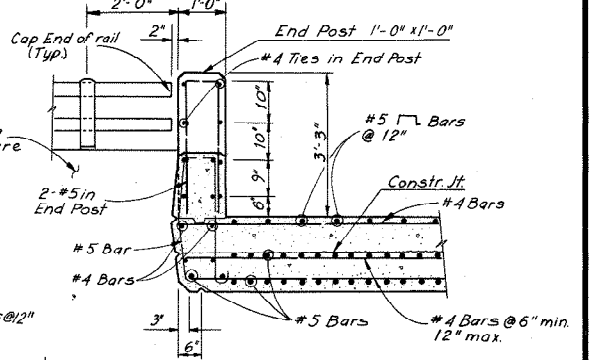


SECTION B-B
Scale: 1/2" = 1'-0"

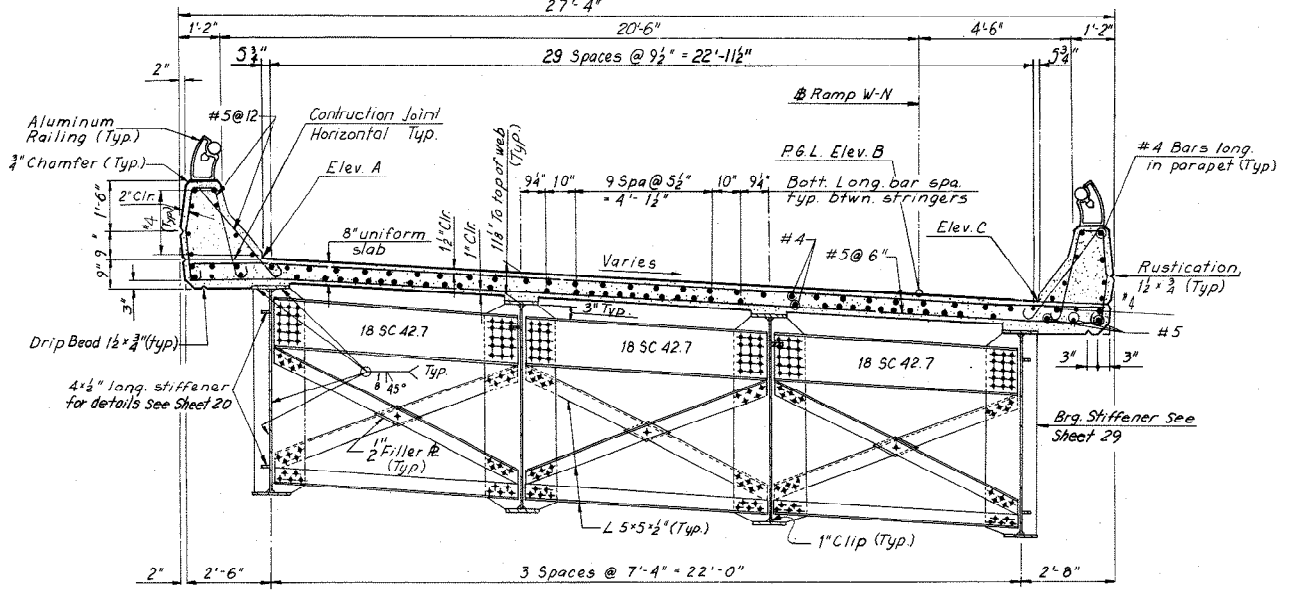

SECTION D-D - END DIAPHRAGM
Scale: 3/8" = 1'-0"

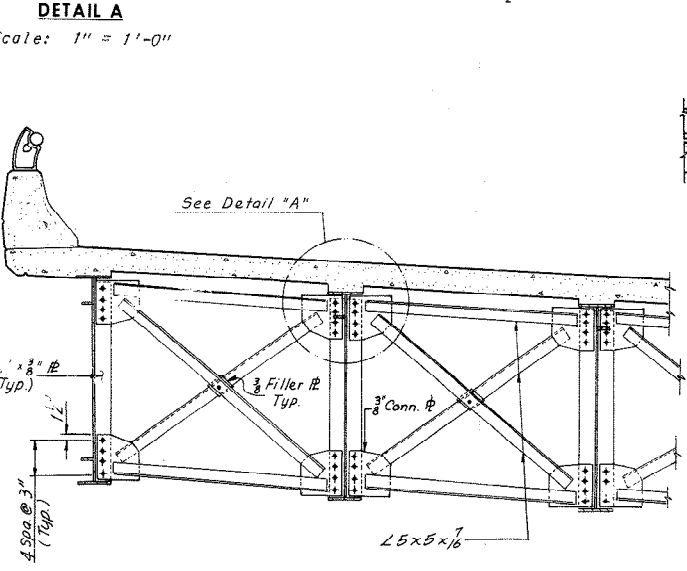

INTERMEDIATE DIAPHRAGM-UNIT 9
Scale: 3/8" = 1'-0"

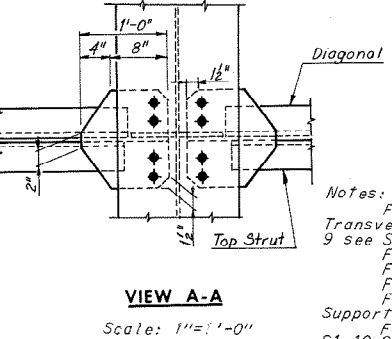

VIEW A-A
Scale: 1" = 1'-0"

Notes:
For Intermediate Diaphragm and Transverse Stiffener Spacing for Unit 9 see Sheet 23.
For Handrail Details see Sheet S3.
For Lighting Details see Sheet S4.
For Location of Detail B see Sheet 34.
For Standard Drainage Details see Support Type 3 Sheet S6.
For Location of Detail C see Stringer S1-10 Sheet 24.
For Typical Parapet Detail, see Sheet 29.

**RICHMOND METROPOLITAN AUTHORITY
RICHMOND EXPRESSWAY SYSTEM
DOWNTOWN EXPRESSWAY**

**BRIDGE NO. 67
RAMP W-N CONNECTION TO
RICHMOND-PETERSBURG TURNPIKE
DECK PLAN AND SUPERSTRUCTURE DETAILS
UNIT 9**

HOWARD, NEEDLES, TAMMEN & BERGENDOFF
consulting engineers
NEW YORK ALEXANDRIA KANSAS CITY

BY	DATE	REVISION	BY	DATE
MADE	C.E.B. 3-7-69	2 As Built	TEM	G-77
CHECKED	A.M.H. 4-21-69	1 Revised 2 size, Intermediate Post Wall	RFJ	1-24-75
IN CHARGE				




Unit 9 shown, Unit 10, Diaphragm similar

AS BUILT



SCALE: As Noted
CONTRACT NO.: 10
SHEET NO. 33 OF 54

RICHMOND EXPRESSWAY SYSTEM			
SECTION	PROJECT	SHEET NO.	TOTAL SHEETS
10	DOWNTOWN EXPRESSWAY	206	265

ELEVATION TABLE			
STATION	ELEV. A	ELEV. B	ELEV. C
353+26.00	88.98	89.05	89.43
+30.00	88.96	89.03	89.41
+40.00	88.89	88.96	89.34
+50.00	88.80	88.87	89.25
+60.00	88.68	88.75	89.13
+70.00	88.54	88.61	88.99
+80.00	88.37	88.44	88.82
+90.00	88.17	88.24	88.62
354+00.00	87.90	88.03	88.41
+10.00	87.72	87.79	88.17
+20.00	87.46	87.53	87.91
+29.50	87.19	87.26	87.64
+30.00	87.17	87.24	87.62
+40.00	86.88	86.95	87.33
+50.00	86.57	86.64	87.02
+60.00	86.24	86.31	86.69
+70.00	85.89	85.96	86.34
+80.00	85.52	85.59	85.97
+90.00	85.13	85.20	85.58
355+00.00	84.72	84.79	85.17
+10.00	84.30	84.37	84.75
+20.00	83.86	83.93	84.33
+30.00	83.41	83.48	83.90
+40.00	82.94	83.02	83.46
+50.00	82.45	82.54	83.02
+60.00	81.97	82.06	82.57
+70.00	81.48	81.57	82.12
+80.00	80.99	81.09	81.68
+90.00	80.49	80.61	81.23
356+00.00	80.00	80.12	80.77
+10.00	79.51	79.64	80.31
+20.00	79.02	79.15	79.85
+30.00	78.53	78.67	79.39
+39.50	78.06	78.21	78.95
+40.00	78.04	78.19	78.92
+50.00	77.55	77.70	78.46
+60.00	77.06	77.22	77.99
+70.00	76.58	76.74	77.53
+80.00	76.11	76.29	77.10
+90.00	75.67	75.86	76.68
357+00.00	75.25	75.45	76.28
+10.00	74.85	75.05	75.88
+20.00	74.44	74.65	75.48
+30.00	74.04	74.25	75.09
+40.00	73.65	73.86	—
+50.00	73.27	73.48	—
+60.00	72.89	73.10	—
+65.50	72.69	72.90	—

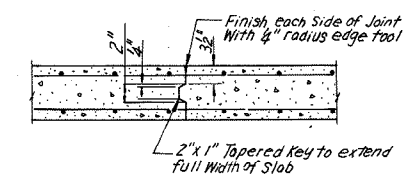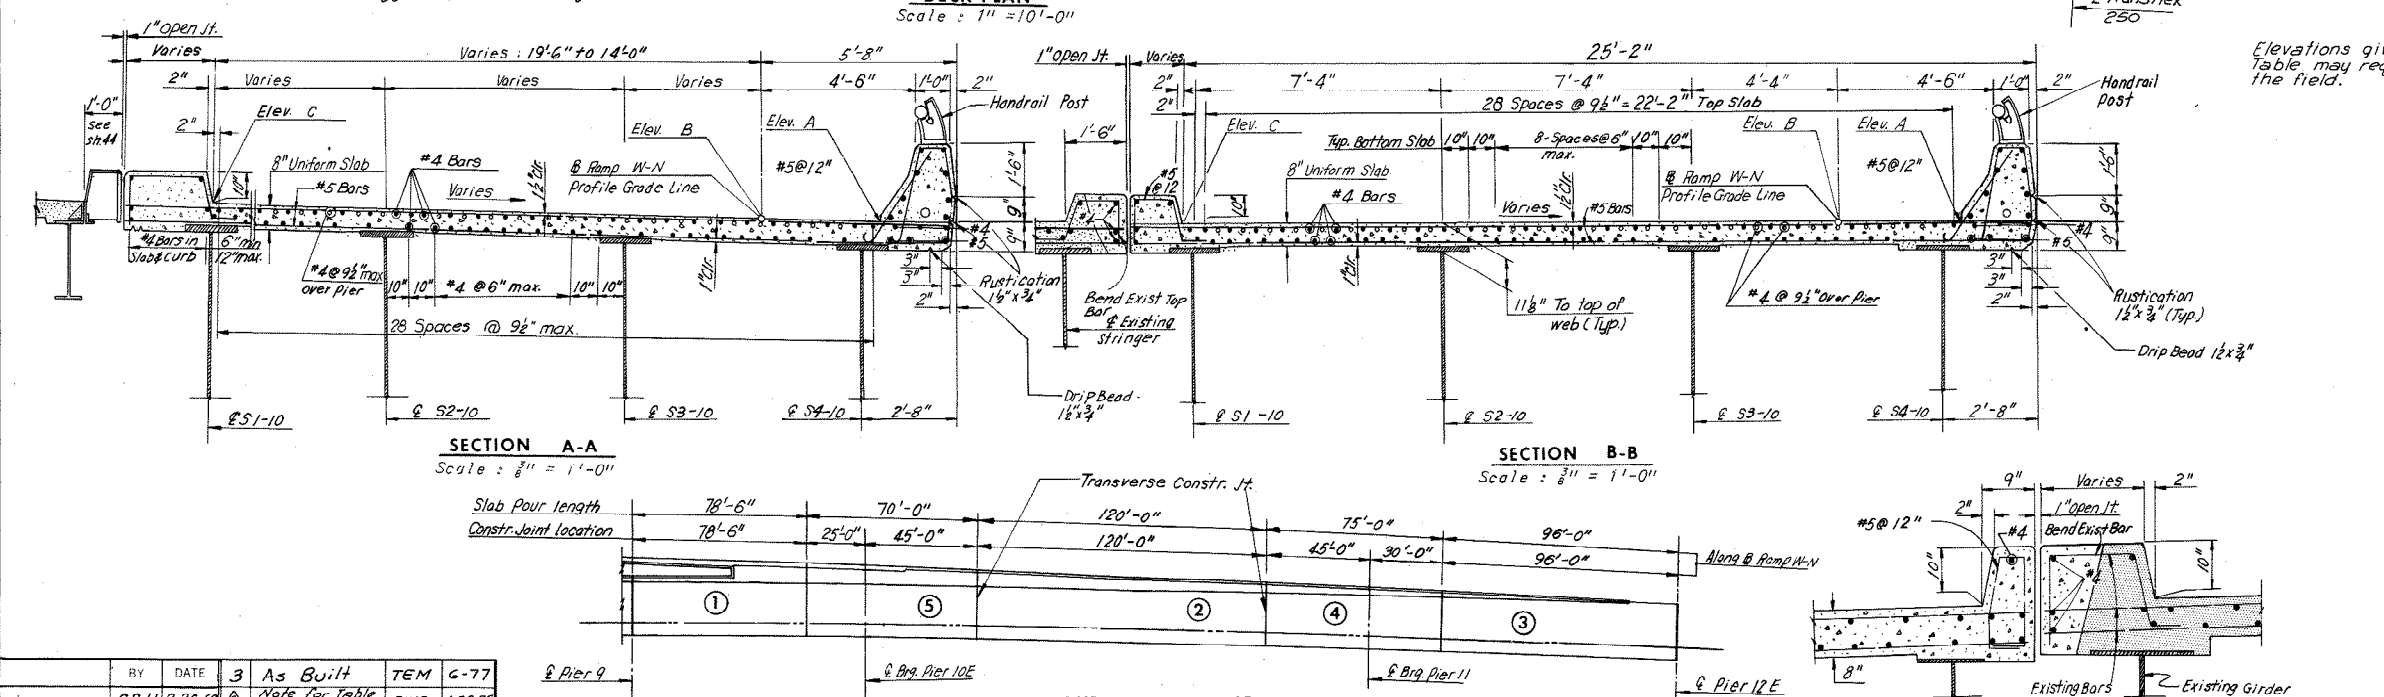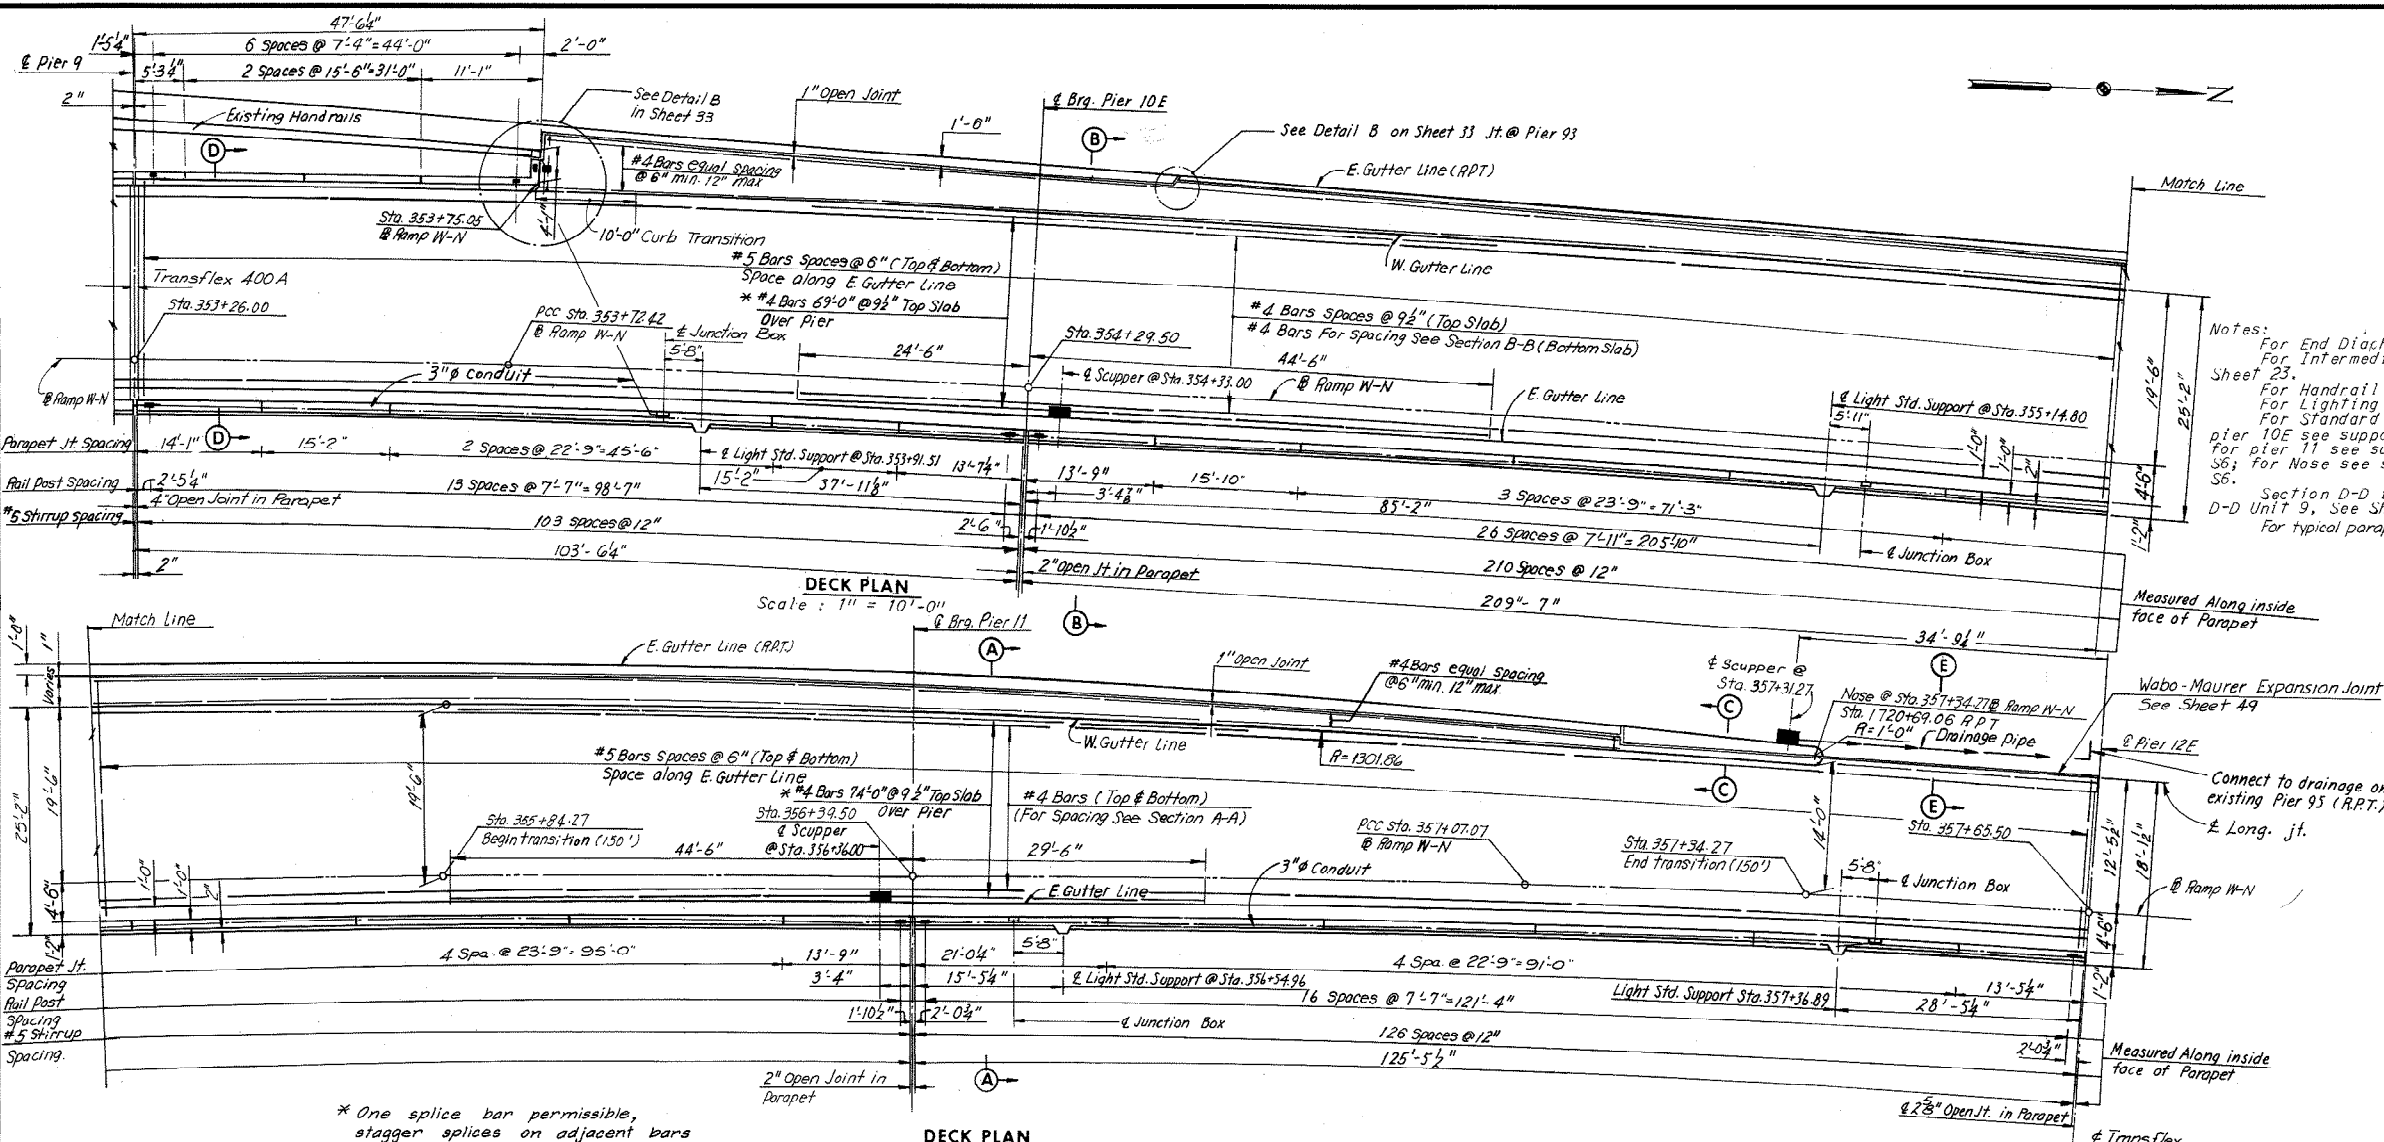

RY	DATE	3	As Built	TEM	G-77
MADE	G.S.H. 2-26-69	1	Note for table of elevations	DWB	1-28-75
CHECKED	AMH 4-23-69	1	Rev. length of bars	NJ	1-24-75
IN CHARGE			Rev. Road width		

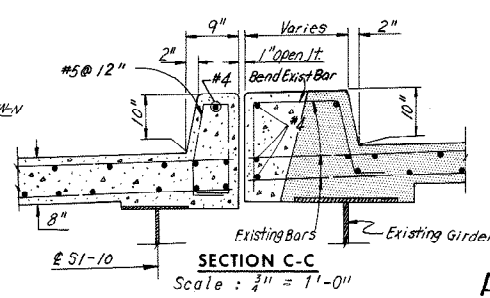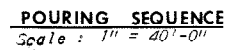

AS BUILT

RICHMOND METROPOLITAN AUTHORITY
RICHMOND EXPRESSWAY SYSTEM
DOWNTOWN EXPRESSWAY


BRIDGE NO. 67
RAMP W-N CONNECTION TO
RICHMOND-PETERSBURG TURNPIKE

DECK PLAN — UNIT 10

HOWARD, NEEDLES, TAMMEN & BERGENDOFF
consulting engineers
NEW YORK ALEXANDRIA KANSAS CITY

SCALE: As Noted
CONTRACT NO.: 10
SHEET NO. 34 OF 54



RICHMOND EXPRESSWAY SYSTEM			
SECTION	PROJECT	SHEET NO.	TOTAL SHEETS
10	DOWNTOWN EXPRESSWAY	207	265

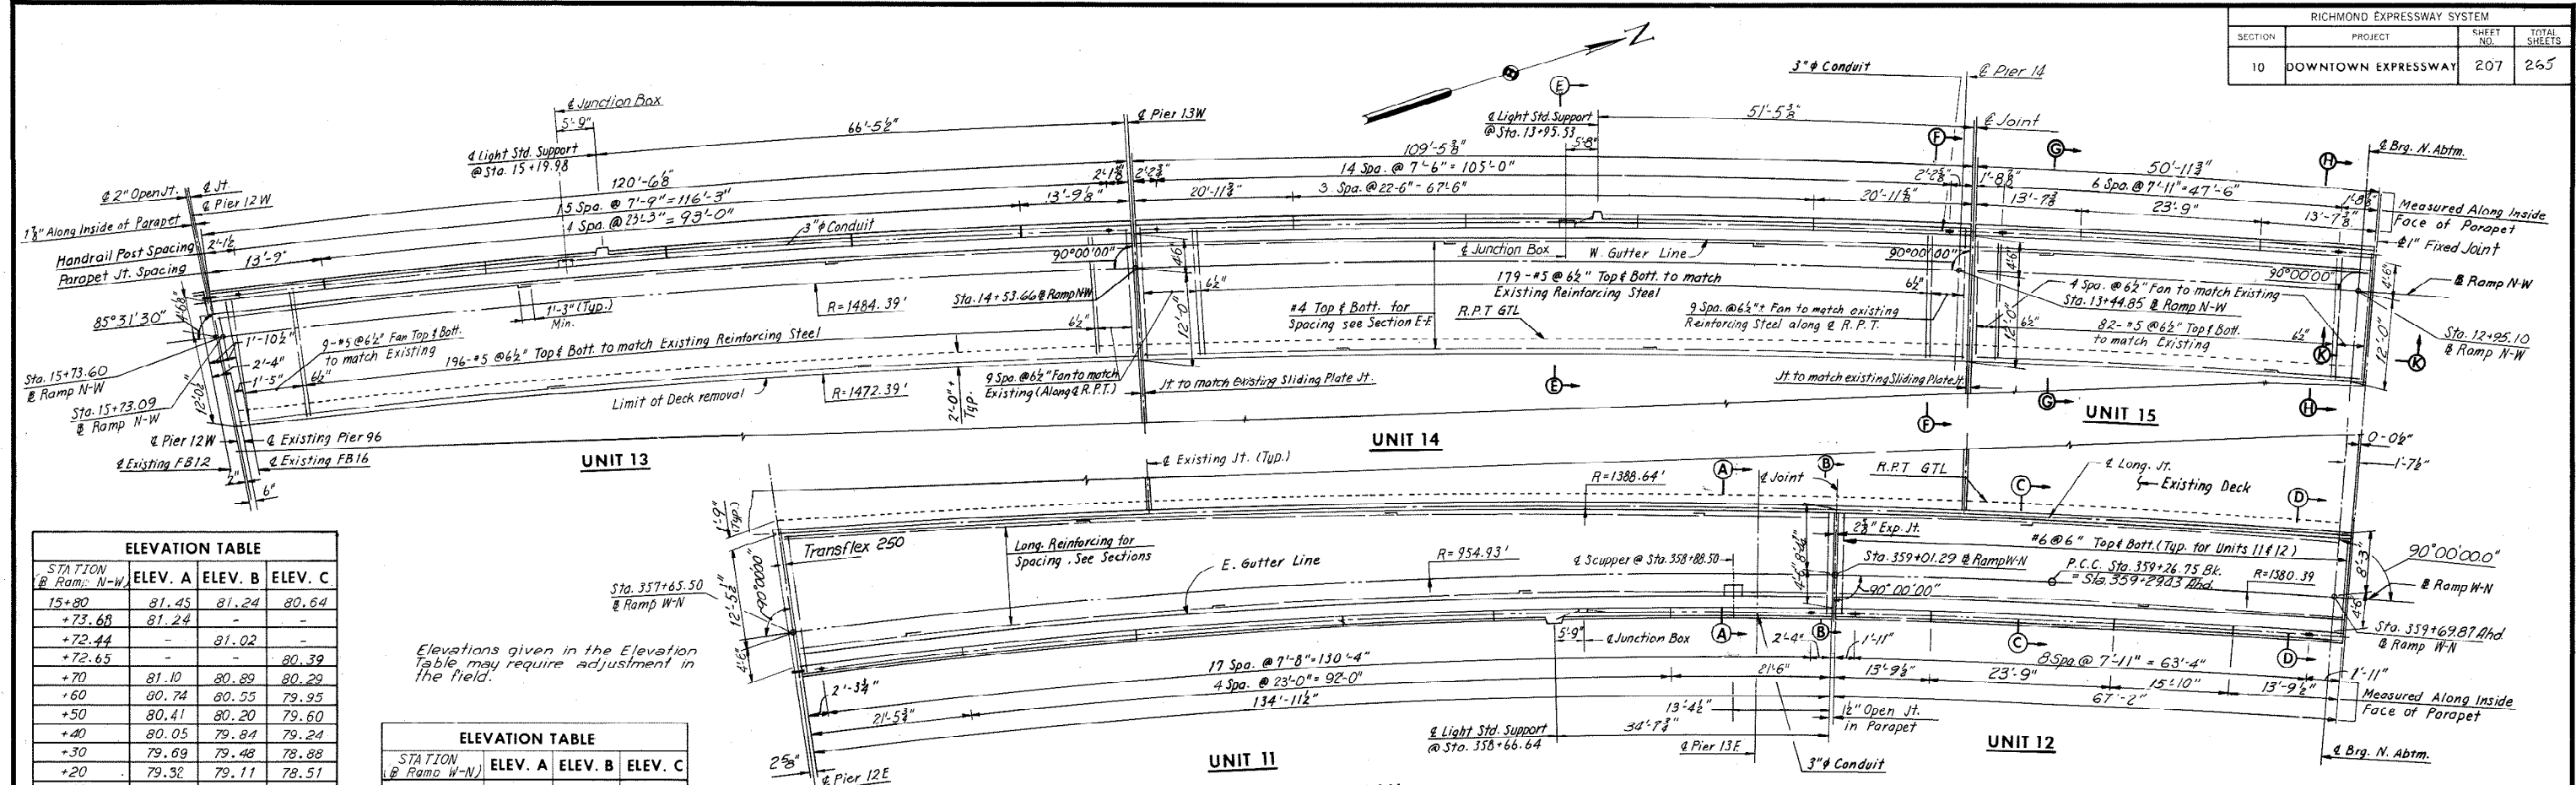

ELEVATION TABLE			
STATION @ Ramp N-W	ELEV. A	ELEV. B	ELEV. C
15+80	81.45	81.24	80.64
+73.68			
+72.44		81.02	
+72.65			80.39
+70	81.10	80.89	80.29
+60	80.74	80.55	79.95
+50	80.41	80.20	79.60
+40	80.05	79.84	79.24
+30	79.69	79.48	78.88
+20	79.32	79.11	78.51
+10	78.95	78.74	78.14
15+00	78.57	78.36	77.76
14+90	78.20	77.99	77.39
+80	77.82	77.61	77.01
+70	77.45	77.24	76.64
+60	77.08	76.87	76.27
+53.40	76.85	76.64	76.04
+50	76.72	76.51	75.91
+40	76.37	76.15	75.56
+30	76.02	75.81	75.21
+20	75.67	75.46	74.86
+10	75.31	75.10	74.50
14+00	74.96	74.75	74.15
13+90	74.61	74.40	73.80
+80	74.26	74.05	73.45
+70	73.91	73.70	73.10
+60	73.55	73.34	72.74
+50	73.20	72.99	72.39
+44.61	73.01	72.80	72.20
+40	72.85	72.64	72.04
+30	72.49	72.28	71.68
+20	72.13	71.92	71.32
+10	71.77	71.56	70.96
13+00	71.40	71.19	70.59
12+92.81	71.12	70.91	70.31

ELEVATION TABLE			
STATION @ Ramp W-N	ELEV. A	ELEV. B	ELEV. C
357+60	72.89	73.10	74.28
+65.50	72.69	72.90	73.65
+70	72.53	72.74	73.48
+80	72.17	72.38	73.09
+90	71.82	72.03	72.70
358+00	71.46	71.67	72.32
+10	71.10	71.31	71.94
+20	70.75	70.96	71.56
+30	70.39	70.60	71.19
+40	70.02	70.23	70.80
+50	69.65	69.86	70.41
+60	69.26	69.47	70.01
+70	68.86	69.07	69.60
+80	68.46	68.67	69.18
+90	68.06	68.27	68.78
+92	67.98	68.19	68.70
359+00	67.67	67.88	68.38
+02.00	67.60	67.81	68.31
+10	67.24	67.50	68.00
+20	66.93	67.14	67.63
+30	66.57	66.78	67.27
+40	66.20	66.41	66.91
+50	65.82	66.03	66.53
+60	65.44	65.65	66.14
+69.39	65.06	65.27	65.78
+70	65.04	65.25	65.75

Elevations given in the Elevation Table may require adjustment in the field.

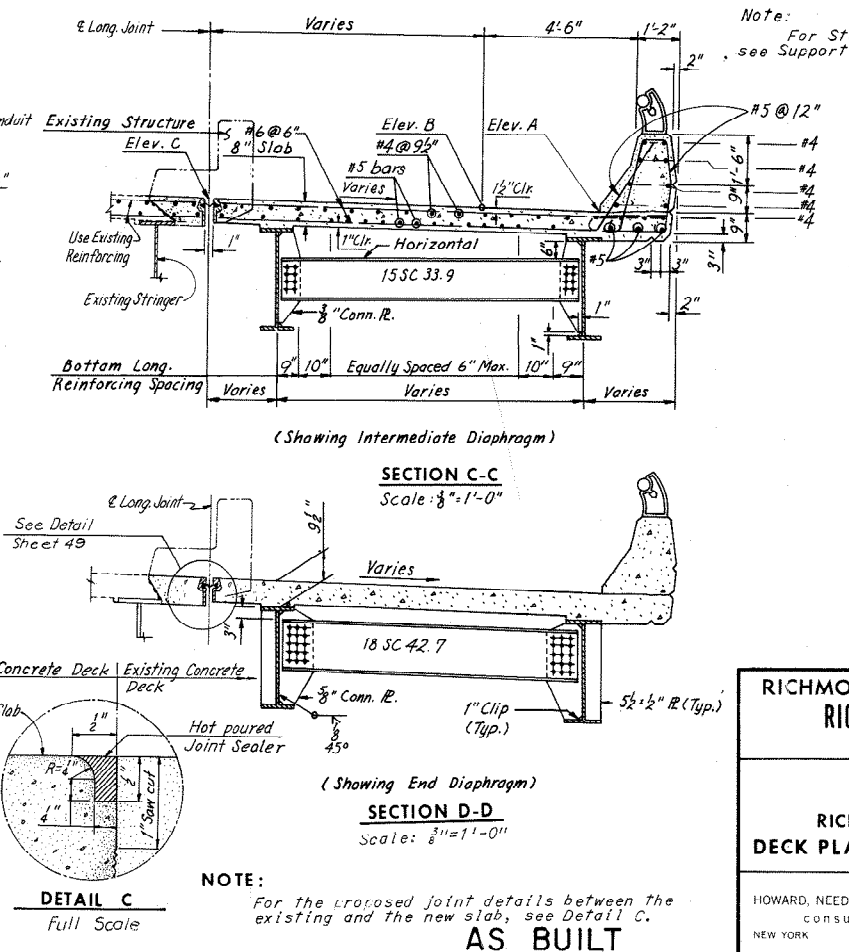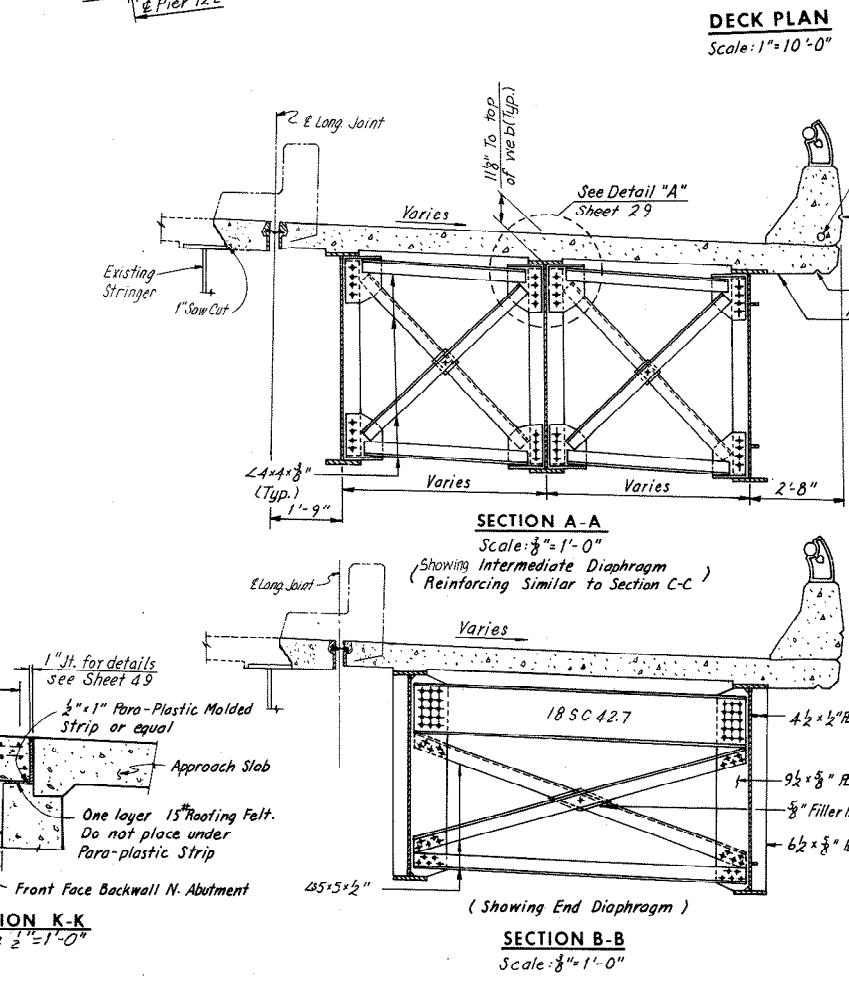

Note:
For Sections E-E, F-F, G-G and H-H, see Sheet 47.
For Framing Plan, see Sheet 26.
For Joint Details, see Sheet 48 and 49.
Elevation C is to be confirmed by Contractor.
For Handrail Details, see Sheet 33.
For Typical Parapet Details, see Sheet 23.

BY	DATE	3	As Built	TEM	G-77
MADE	Y.C.P.	2-27-69	Note For Table of Elevations	DWB	1-28-75
CHECKED	K.C.T.	5-1-69	Piers & Abutment Sta. Change	DWB	1-17-75
IN CHARGE					

NOTE:
For the proposed joint details between the existing and the new slab, see Detail C.

RICHMOND METROPOLITAN AUTHORITY
RICHMOND EXPRESSWAY SYSTEM
 DOWNTOWN EXPRESSWAY


BRIDGE NO. 67
 RAMP W-N CONNECTION TO
 RICHMOND-PETERSBURG TURNPIKE
 DECK PLAN-UNITS 11, 12, 13, 14 AND 15

HOWARD, NEEDLES, TAMMEN & BERGENDOFF
 consulting engineers
 NEW YORK ALEXANDRIA KANSAS CITY

SCALE: As Noted
 CONTRACT NO.: 10
 SHEET NO. 35 OF 54


AS BUILT

RICHMOND EXPRESSWAY SYSTEM			
SECTION	PROJECT	SHEET NO.	TOTAL SHEETS
10	DOWNTOWN EXPRESSWAY	214	265

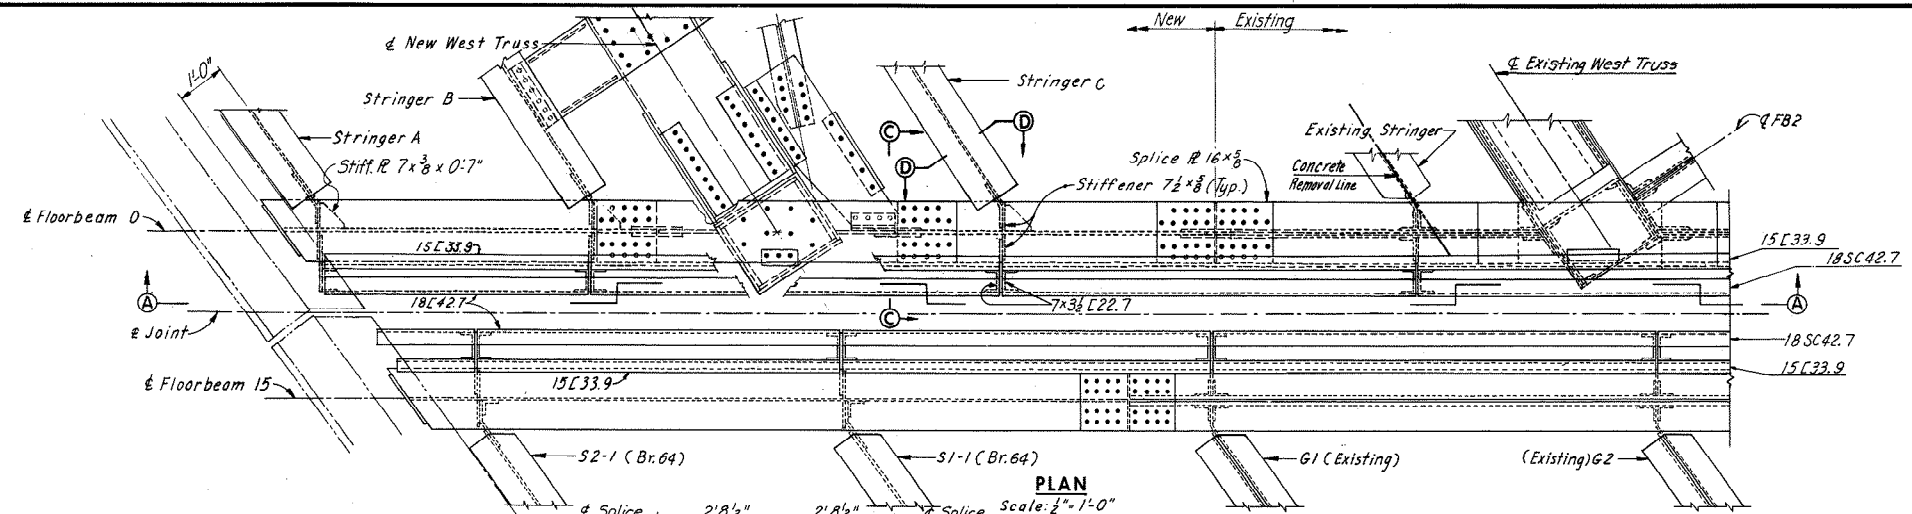


PLAN
Scale: 1/2" = 1'-0"

Note: Expansion plates and curb plates are omitted from Plan. For Elevation of Floorbeam 15, see Bridge 64 Sheet 18.

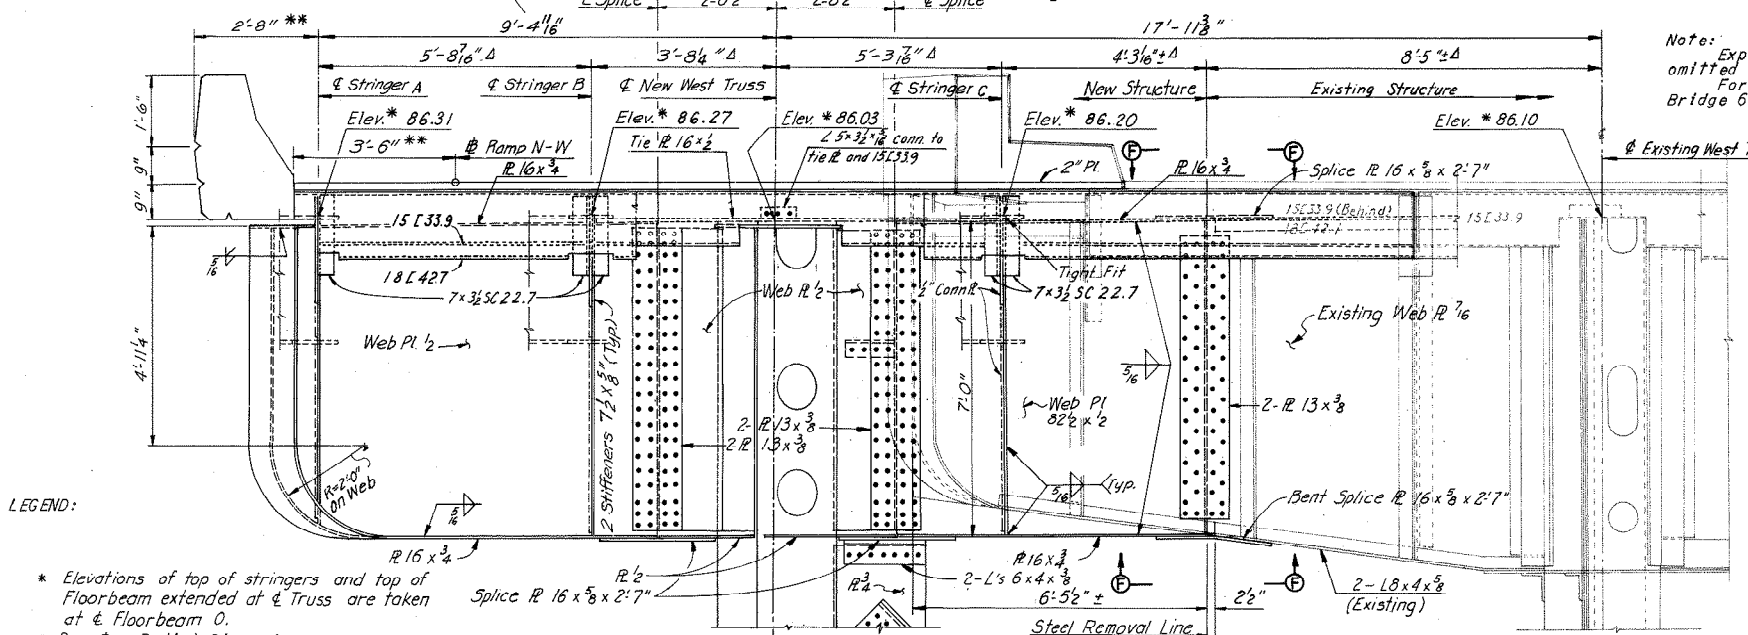


SECTION A-A
ELEVATION-FLOORBEAM 0
Scale: 1/2" = 1'-0"


LEGEND:
* Elevations of top of stringers and top of floorbeam extended at & Truss are taken at & Floorbeam 0.
** Denotes Radial Dimension
Δ Dimensions are to projected & Stringer at & Floorbeam. Connection - Stiffener Plate shall be located by the Fabricator.

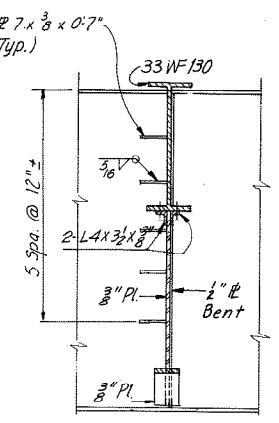

SECTION D-D
Scale: 1/2" = 1'-0"

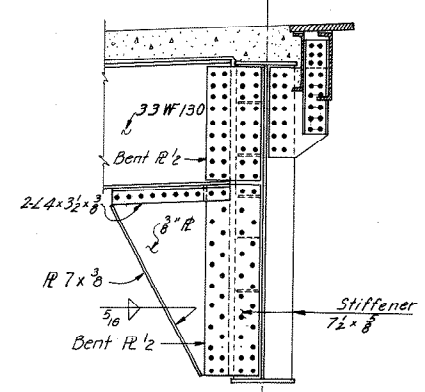


SECTION C-C
Scale: 1/2" = 1'-0"

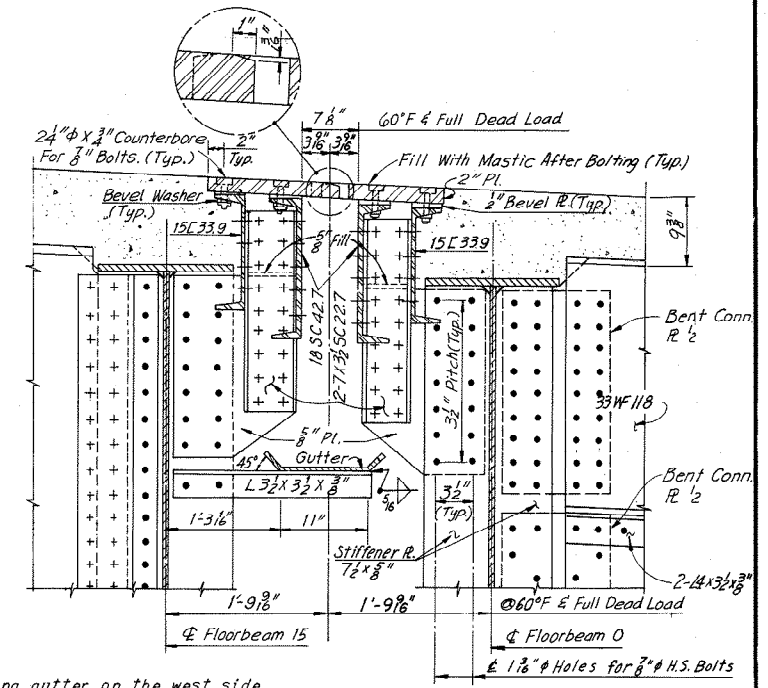


SECTION B-B
Scale: 1/2" = 1'-0"


Note: Cut existing gutter on the west side of the existing stringer and set the new gutter into the existing gutter. Bolt the two together with existing bolts. Provide an 8" lap.

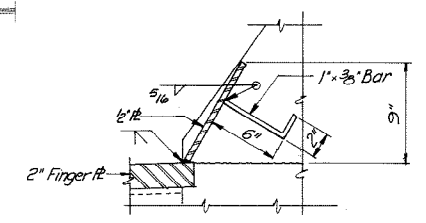

SECTION E-E
Scale: 1/2" = 1'-0"

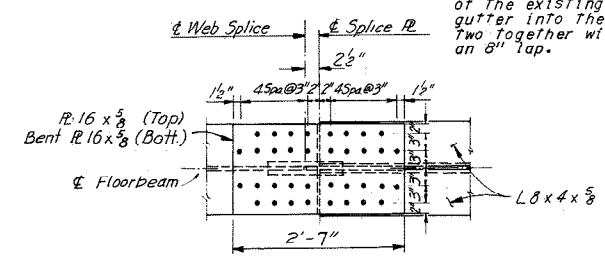

VIEW F-F
Scale: 3/4" = 1'-0"
bottom Splice Similar

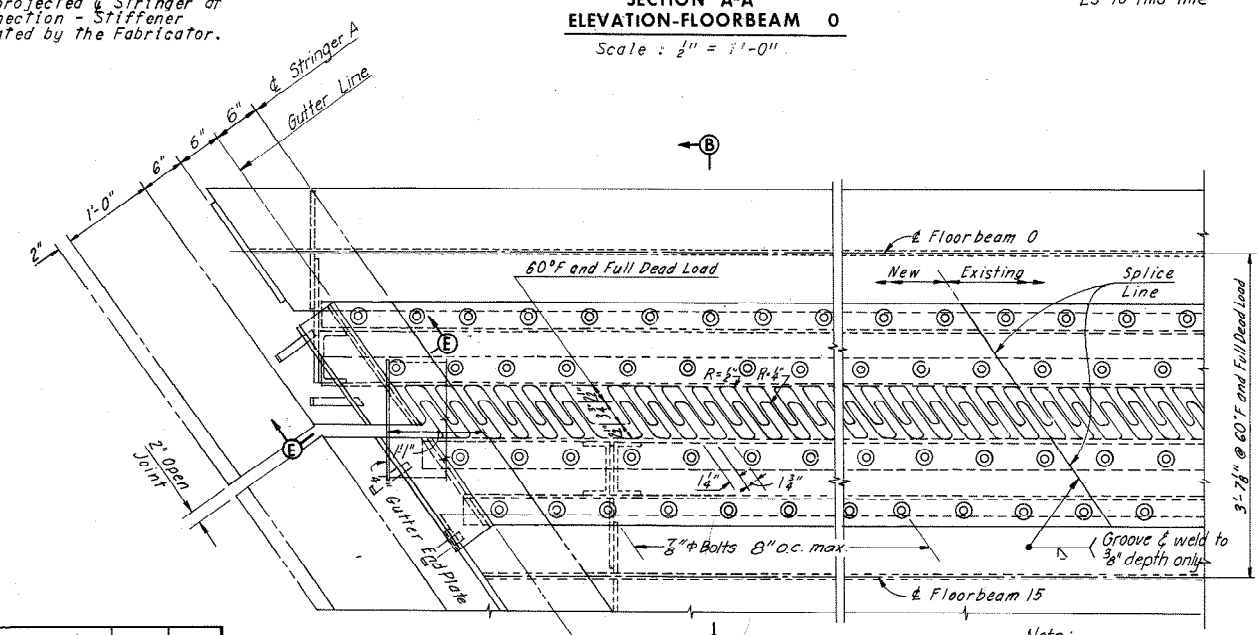

PART PLAN OF EXPANSION DEVICE
Scale: 1" = 1'-0"

Note: Cut existing finger plate as close to the existing gutter line as possible. New plate shall be provided long & cut to exact length after existing plate is cut.

BY	DATE	REVISION	BY	DATE
MADE	A.B.P. 1-75	2 As Built	TEM	6-77
CHECKED		Δ New sheet added	A.B.P.	2-7-75
IN CHARGE				

RICHMOND METROPOLITAN AUTHORITY
RICHMOND EXPRESSWAY SYSTEM

BRIDGE NO. 67
RAMP W-N CONNECTION TO
RICHMOND-PETERSBURG TURNPIKE
FLOORBEAM 0 AND JOINT DETAILS


HOWARD, NEEDLES, TAMMEN & BERGENDOFF
consulting engineers
NEW YORK ALEXANDRIA KANSAS CITY
SCALE: As Noted
CONTRACT NO. 10
SHEET NO. 42 OF 54

AS BUILT

RICHMOND EXPRESSWAY SYSTEM			
SECTION	PROJECT	SHEET NO.	TOTAL SHEETS
11	DOWNTOWN EXPRESSWAY	64	97

INDEX

	SHEET
GENERAL PLAN AND ELEVATION	1
GENERAL PLAN AND ELEVATION	2
LAYOUT	3
PIERS 1 AND 2	4 AND 4A
PIER 3	5
PIER 4	6
PIER 5	7
PIERS 6 AND 7	8
PIERS 8, 9 AND 10	9
PIERS 11 AND 12	10
PIERS 13 AND 14	11
FRAMING PLAN UNITS 2 AND 3	12
FRAMING PLAN UNITS 4, 5 AND 6	13
FRAMING PLAN UNITS 7, 8, AND 9	14
FRAMING PLAN UNITS 10, 11 AND 12	15
FRAMING PLAN UNITS 13 THRU 18	16 AND 16A
FRAMING DETAILS	17
DECK PLAN UNITS 2 AND 3	18
DECK PLAN UNITS 4, 5 AND 6	19
DECK PLAN UNITS 7, 8 AND 9	20
DECK PLAN UNITS 10, 11 AND 12	21
DECK PLAN UNITS 13 THRU 18	22
SUPERSTRUCTURE DETAILS	23
JOINT DETAILS	24
BORING LOGS	25 AND 26
STANDARD SHEETS	27 AND 28
EXISTING PIERS 42-44 MODIFICATIONS	51 THRU 58

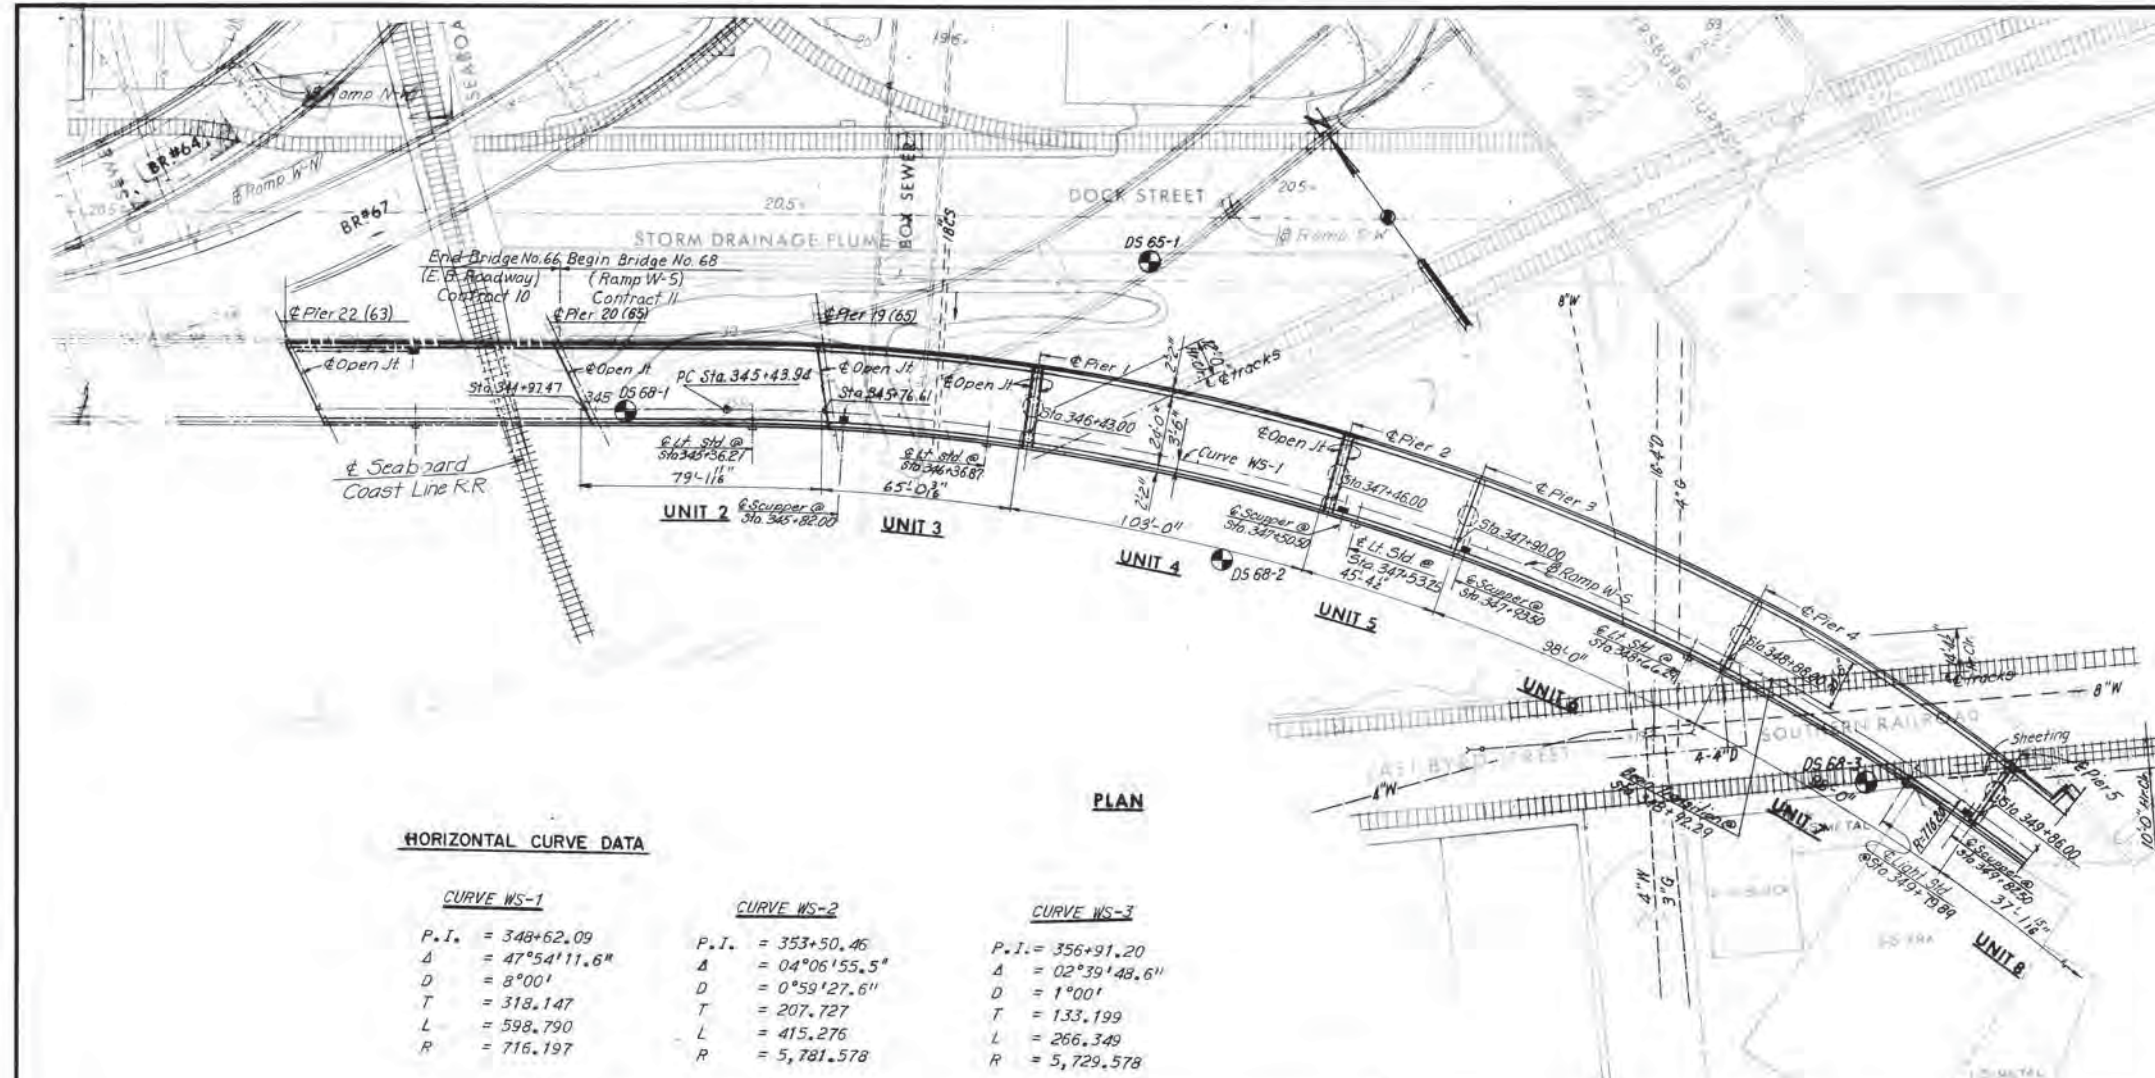


HORIZONTAL CURVE DATA

CURVE WS-1	CURVE WS-2	CURVE WS-3
P.I. = 348+62.09	P.I. = 353+50.46	P.I. = 356+91.20
Δ = 47°54'11.6"	Δ = 04°06'55.5"	Δ = 02°39'48.6"
D = 8°00'	D = 0°59'27.6"	D = 1°00'
T = 318.147	T = 207.727	T = 133.199
L = 598.790	L = 415.276	L = 266.349
R = 716.197	R = 5,781.578	R = 5,729.578


PLAN

GENERAL NOTES

- ROADWAY:** One 24'-0" clear roadway transitioning into a 13'-6" widening of existing Richmond-Petersburg Turnpike.
- CAPACITY:** Dead load includes 15lbs. per sq.ft. for future wearing surface. Live load HS 20-44 loading and alternate military loading.
- SPECIFICATIONS:**
 - GENERAL:** Virginia Department of Highway Road and Bridge Specifications 1970.
 - DESIGN:** A.A.S.H.O. Standard Specifications for Highway Bridges 1973, modified by Special Design provisions.
 - WELDING:** 1972 Structural Welding Code of the American Welding Society.
- CONTRACT SPECIAL PROVISIONS:** Specifications and Contract Special Provisions referred to above are necessary to make these plans complete.
- DATUM:** City of Richmond.
- TEMPERATURE:** The normal temperature referred to in the plans is 60°F. The temperature range for movement is 0°F to 120°F.
- DIMENSIONS:** All dimensions are measured horizontally and vertically unless otherwise noted.
- EXCAVATION:** Excavation below subgrade and cut slope template shall be classified as Regular Excavation. All excavation above these limits shall be classified as Regular Excavation and is not included in the Structural Quantities.
- FOUNDATIONS:** Footings shall rest on firm material. Foundation material shall be dry and special attention is called to Section 401.05 of General Specifications and to the Contract Special Provisions, concerning preparation of foundations for footings.
- CONCRETE NOTES:** Concrete in superstructure shall be Class A-4. All other concrete shall be Class A-3. All exposed edges and corners shall have a 1/4" chamfer or fillet unless otherwise noted. Care in the method of vibration, the use of low-slump concrete, and/or other means shall be employed to prevent downgrade movement of newly placed slab concrete. Finishing Concrete Surfaces: See Standard Architectural Detail Sheets and the Contract Special Provisions for types and details. All reinforcing steel shall be deformed bars conforming to ASTM A615 Grade 40. All reinforcing bar dimensions on the detailed drawings are to centers of bars unless otherwise noted. Clear distance between reinforcing steel and face of concrete shall be as noted on the plans. All bar laps shall be 30 diameters of the smaller diameter bar unless otherwise noted.
- STEEL NOTES:** Structural steel shall conform to A.S.T.M. Designations A36, A572-Grade 50 and A588 as noted. See Special Provisions. All field connections shall be made with high strength bolts. High strength bolts shall be 1" diameter unless otherwise noted and shall conform to A.S.T.M. Specification A-325.

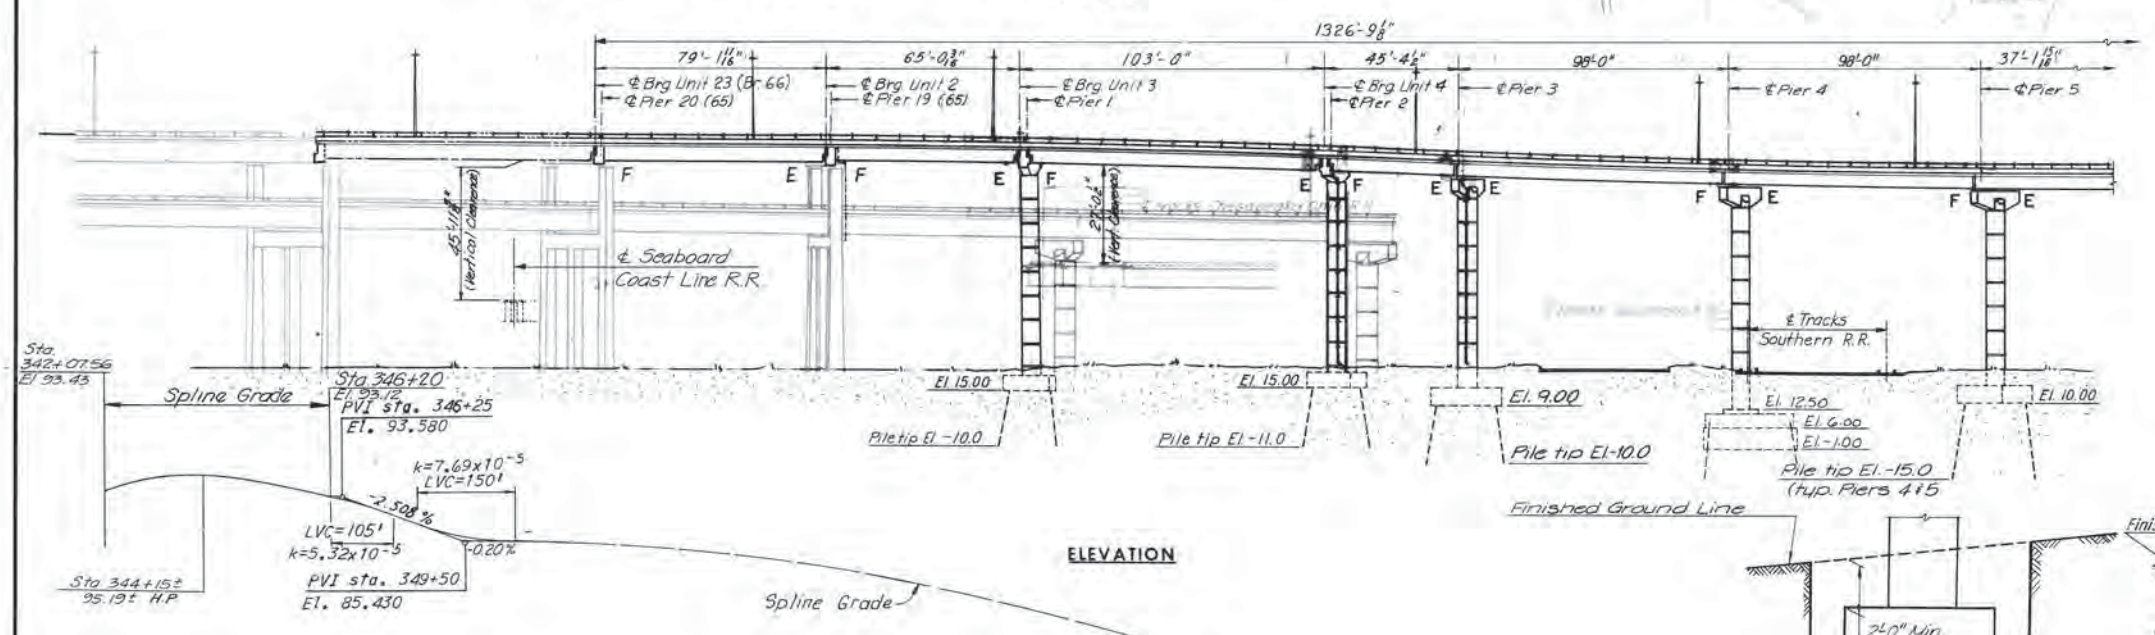

ELEVATION

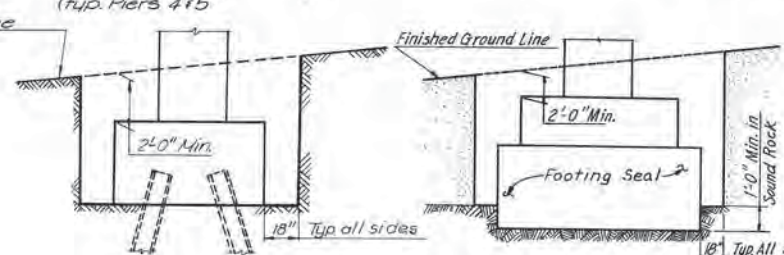

LIMITS OF STRUCTURE EXCAVATION
No Scale

BY	DATE	REVISION	BY	DATE
Rev. Profile Grade & Ramp W-S	555	12-75		
MADE	J.V. 4-2-69	Profile Grade W-S, Index	TEM	8-26-75
CHECKED	G.S.H. 7-16-69	Seaboard Coast Line Added	TEM	6-74
IN CHARGE				

▲ PROFILE GRADE & RAMP W-S

AS BUILT


RICHMOND METROPOLITAN AUTHORITY
RICHMOND EXPRESSWAY SYSTEM
DOWNTOWN EXPRESSWAY

BRIDGE NO. 68
RAMP W-S CONNECTION TO
RICHMOND-PETERSBURG TURNPIKE
GENERAL PLAN AND ELEVATION


HOWARD, NEEDLES, TAMMEN & BERGENDOFF
consulting engineers
NEW YORK ALEXANDRIA KANSAS CITY

SCALE: 1"=30'
CONTRACT NO. 11
SHEET NO. 1 OF 28

RICHMOND EXPRESSWAY SYSTEM			
SECTION	PROJECT	SHEET NO.	TOTAL SHEETS
11	DOWNTOWN EXPRESSWAY	65	97

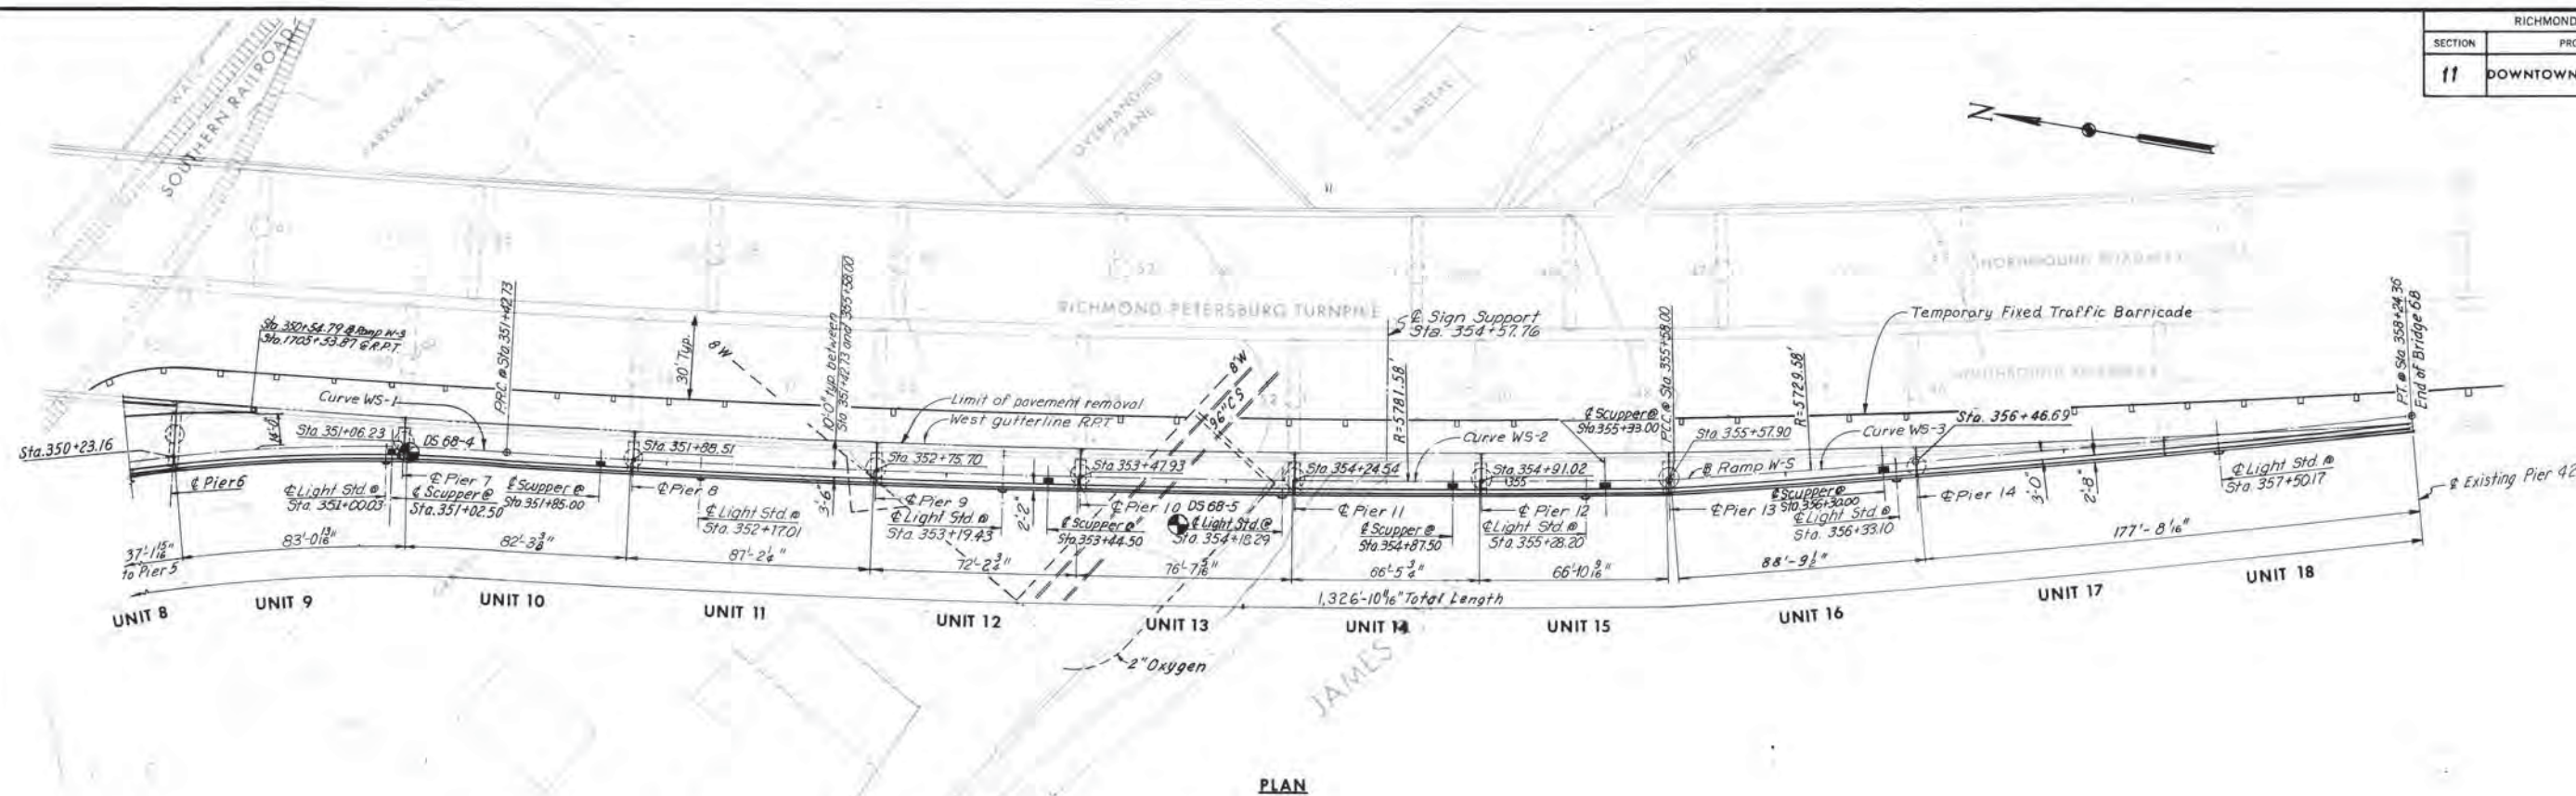

PLAN

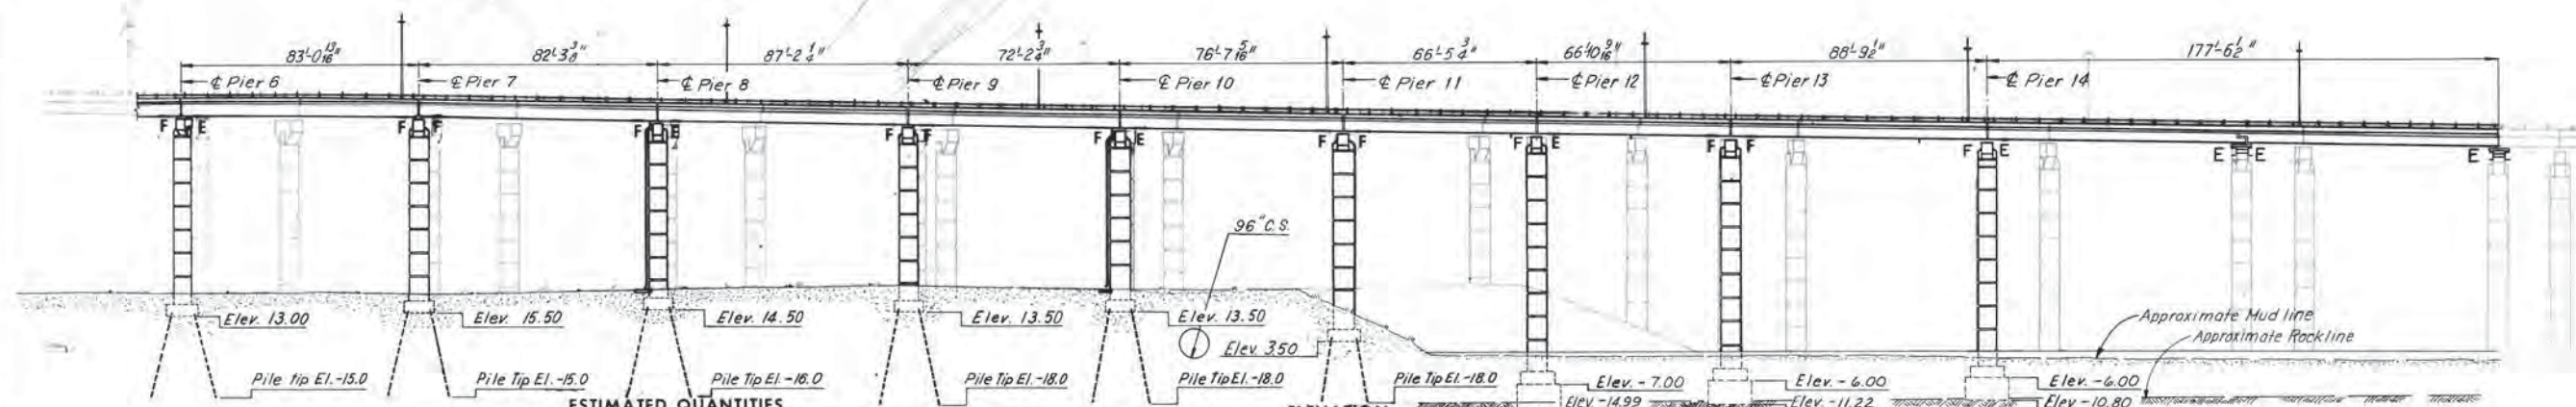

ELEVATION

ESTIMATED QUANTITIES

	Structure Excavation	Concrete (#)	Reinforcing Steel	Str. Steel Mild carbon	Str. Steel High Strength	Aluminum Railing (1-rail) Lin. Ft.	Steel Piles 10BP42
	Cu. Yds.	Cu. Yds.	Lbs.	Lbs.	Lbs.	Lin. Ft.	Lin. Ft.
Superstructure	---	888.7	215,200	600,400	255,600	1,849	---
Substructure	1,415*	1,751.0	245,300	31,600	8,400	---	2,630
Total	1,415*	2,639.7	460,500	632,000	264,000	1,849	2,630

	Steel Piles 12BP53 Lin. Ft.	Tremie Concrete Class T3 Cu. Yds.	Sheeting Pier 5 Lump Sum	Metal Conduit Lin. Ft.	Bridge Drainage Metal work Lbs.	Modifications to R.P. Turnpike Bridge Lump Sum	Modifications to Existing Retaining Wall Cu. Yds.	Temporary Barricade Lin. Ft.
Superstructure	---	---	---	1,310	11,450	1	50	---
Substructure	1,412	173.3	1	---	---	---	---	---
Total	1,412	173.3	1	1,310	11,450	1	50	990

*Including 365 Cu. Yds. of "Underwater" Excavation for Piers 12, 13 and 14.
 *All concrete for Superstructure shall be Class A4 and for Substructure Class A3. Concrete for Footing Seals shall be Tremie Concrete, Class T3 and is listed separately.

MADE	BY	DATE	NO.	REVISION	BY	DATE
	J.V.	4-3-69				
	G.S.H.	7-16-69		At Pier 44 & 42	T.E.M.	8-26-75
				Struct. Steel Quant.		

AS BUILT




RICHMOND METROPOLITAN AUTHORITY
RICHMOND EXPRESSWAY SYSTEM
DOWNTOWN EXPRESSWAY

BRIDGE NO. 68
RAMP W-S CONNECTION TO
RICHMOND-PETERSBURG TURNPIKE
GENERAL PLAN AND ELEVATION

HOWARD, NEEDLES, TAMMEN & BERGENDOFF
 consulting engineers
 NEW YORK ALEXANDRIA KANSAS CITY

SCALE: 1"=30'
 CONTRACT NO. 11
 SHEET NO. 2 OF 28

RICHMOND EXPRESSWAY SYSTEM			
SECTION	PROJECT	SHEET NO.	TOTAL SHEETS
11	DOWNTOWN EXPRESSWAY	67	97

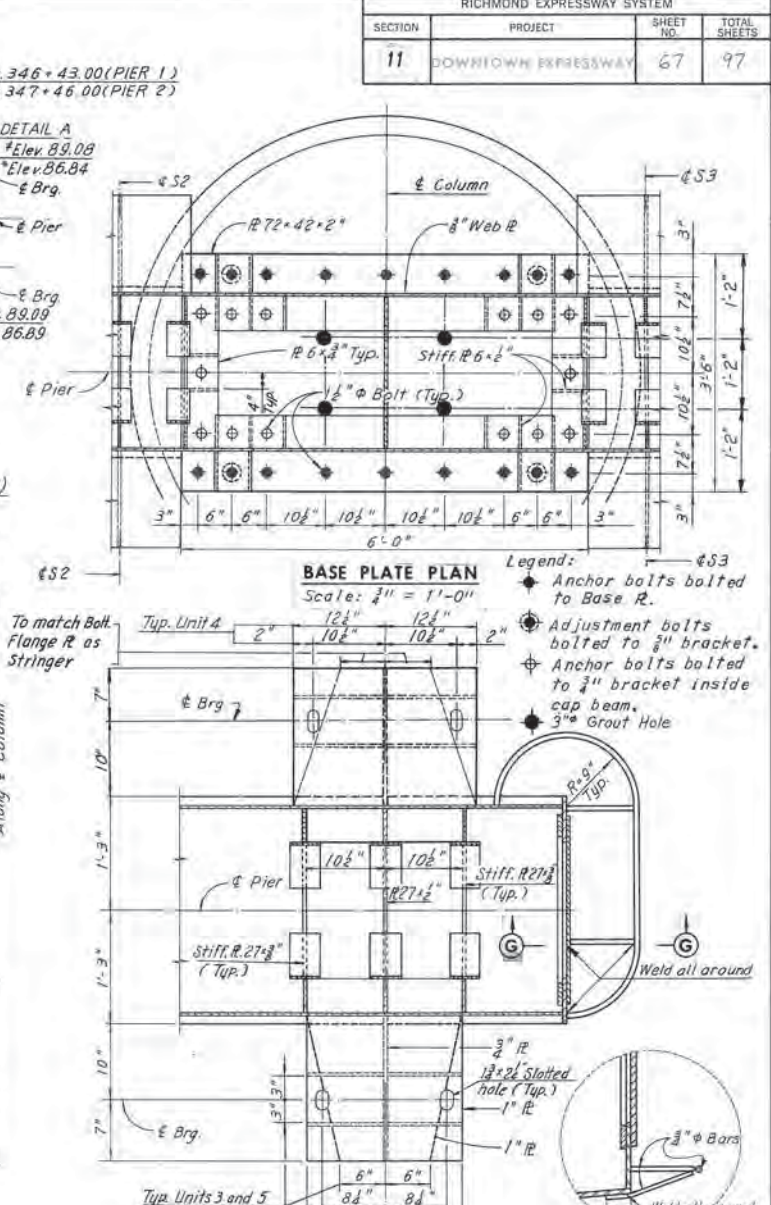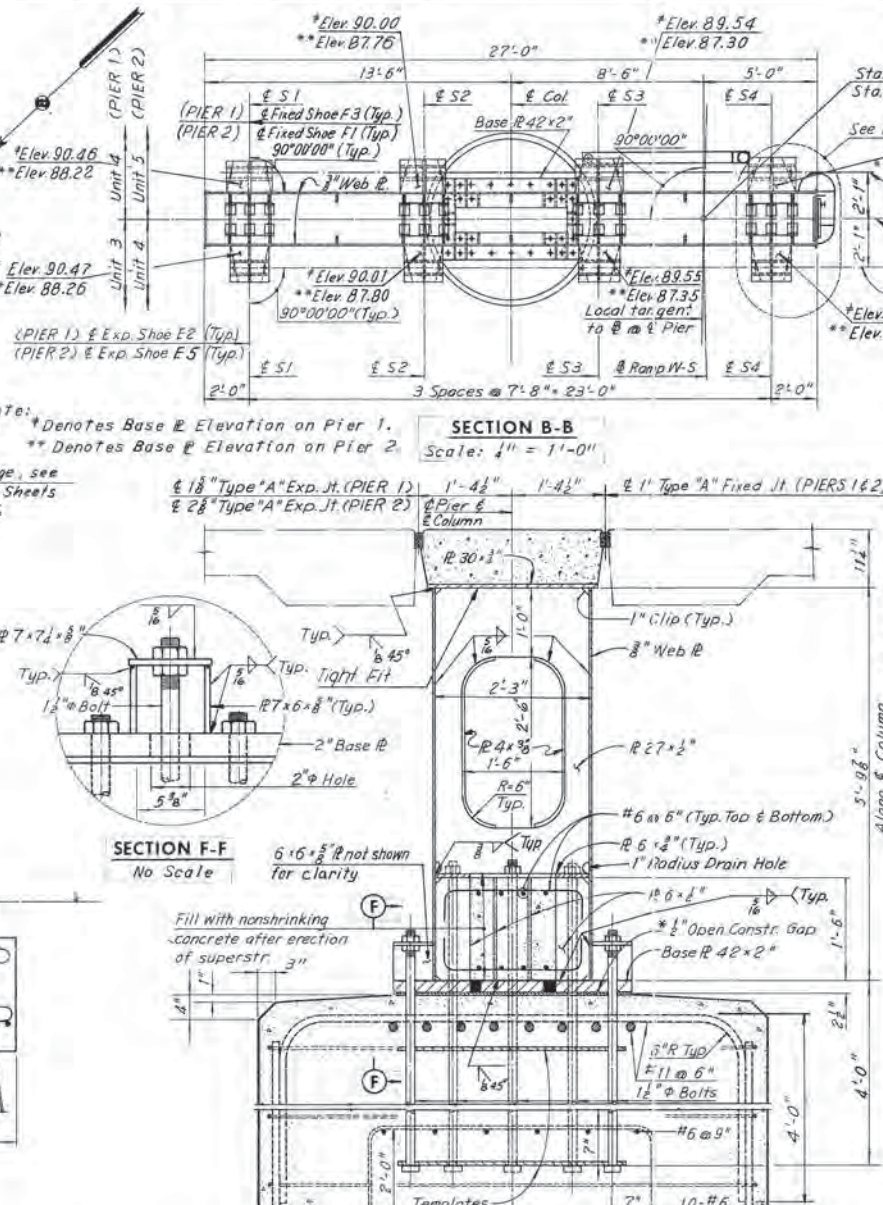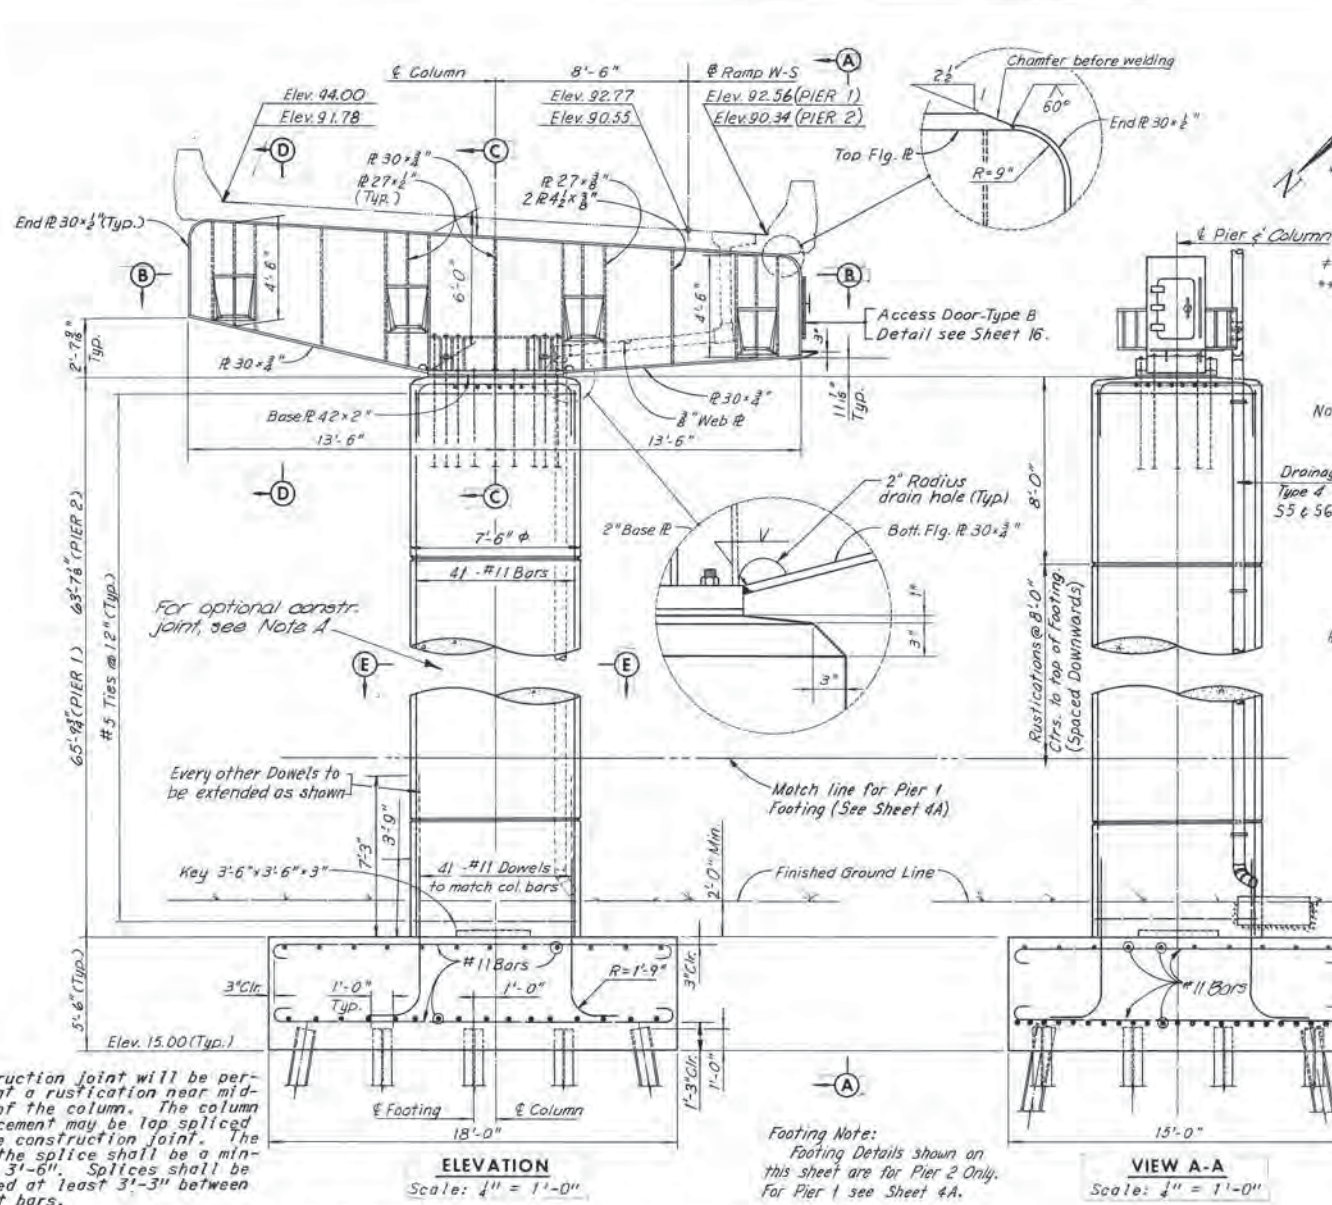


NOTE A
A construction joint will be permitted at a rustication near mid-height of the column. The column reinforcement may be lap spliced near the construction joint. The top of the splice shall be a minimum of 3'-6". Splices shall be staggered at least 3'-3" between adjacent bars.

ELEVATION
Scale: 1/4" = 1'-0"


Footing Note:
Footing Details shown on this sheet are for Pier 2 Only. For Pier 1 see Sheet 4A.

VIEW A-A
Scale: 1/4" = 1'-0"

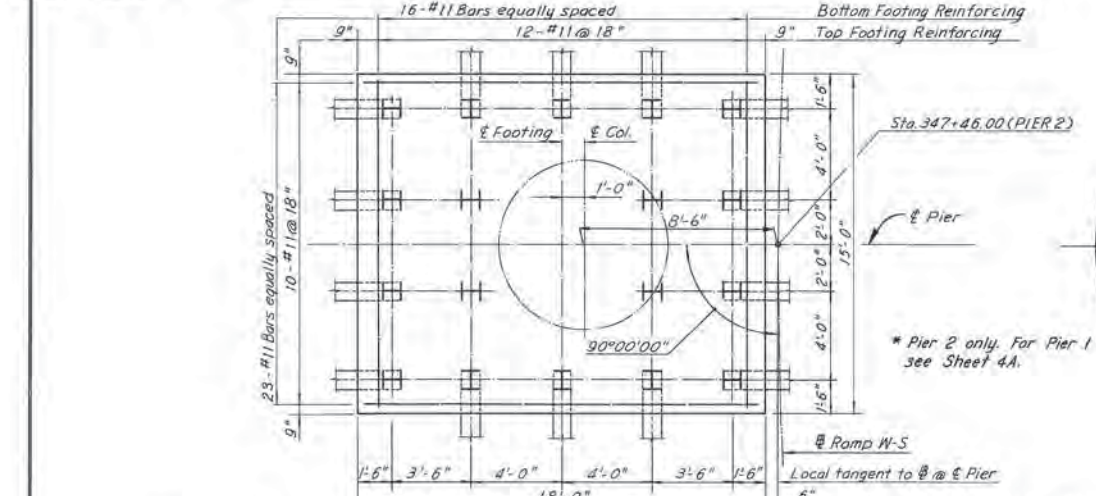

FOOTING PLAN
Scale: 1/4" = 1'-0"

FOOTINGS FOR PIERS 1 AND 2 ARE ECCENTRIC AS SHOWN ON FOOTING PLAN

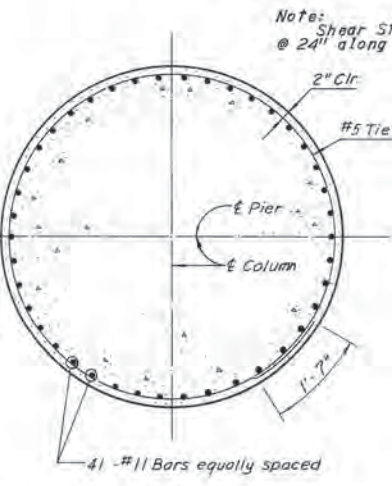


SECTION E-E
Scale: 1/4" = 1'-0"

BY	DATE	REVISION	BY	DATE
MADE	MHH 1-17-69	2	TEM	8-76
CHECKED	JD 2-13-69	1	MSD	3-13-75
IN CHARGE				

Note: Footing elevations are approximate only and may be varied to suit field conditions as directed by the Engineer. Vertical shaft reinforcement shall not be cut until these elevations are established. Where elevations change more than 2 ft., redesign will be required.

Note: All Structural Steel for Piers 1 and 2 shall be A36. Steel Cap Beams need not be cambered.

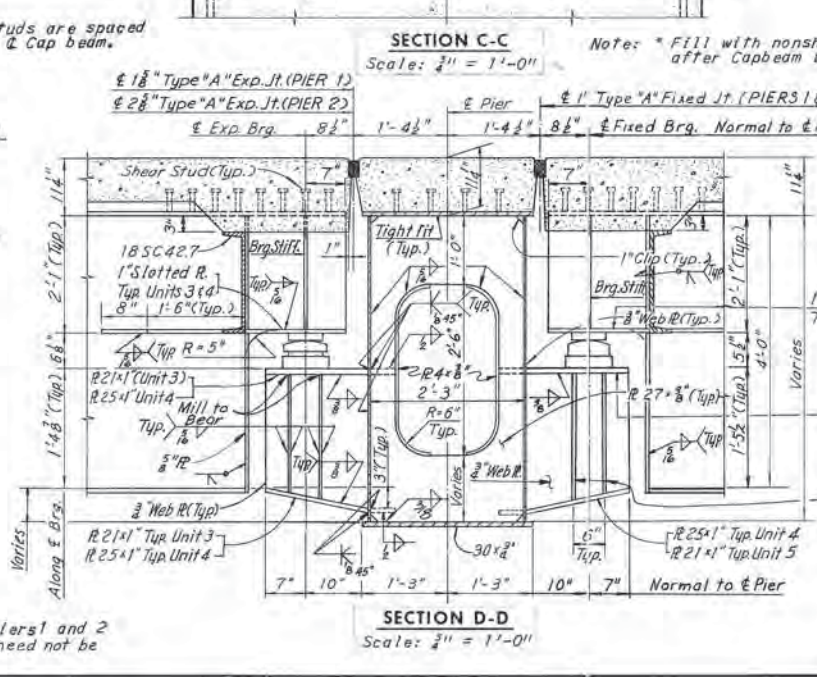

SECTION D-D
Scale: 1/4" = 1'-0"

SECTION C-C
Scale: 1/4" = 1'-0"

DETAIL A
Scale: 1" = 1'-0"

SECTION G-G
Scale: 1" = 1'-0"

Notes:
All holes in base R and bracket R's for 1/2" dia. anchor bolts shall be 2" in dia.
For Framing Plan, see Sheet 13.
For Joint Details, see Sheet 25.
For Shear Stud Details, see Sheet 12.
For Shoe Details, see Sheets S1 and S2.
For Bearing pile Details, see Sheet 9.
Estimated pile tip elevation -10.00 for Pier 1 and -11.00 for Pier 2.
All anchor bolts connecting cap beam to column shall be 1/2" dia., and each nut shall have washer (not shown on details).
For Rustication Detail, see Sheet 5.

RICHMOND METROPOLITAN AUTHORITY
RICHMOND EXPRESSWAY SYSTEM
DOWNTOWN EXPRESSWAY

BRIDGE NO. 68
RAMP W-3 CONNECTION TO
RICHMOND-PETERSBURG TURNPIKE
PIERS 1 AND 2

SCALE: AS NOTED




HOWARD, NEEDLES, TAMMEN & BERGENDOFF
consulting engineers
NEW YORK ALEXANDRIA KANSAS CITY

CONTRACT NO. 11
SHEET NO. 4 OF 28







AS BUILT

RICHMOND EXPRESSWAY SYSTEM			
SECTION	PROJECT	SHEET NO.	TOTAL SHEETS
11	DOWNTOWN EXPRESSWAY	68	97

NOTE: A
 A construction joint will be permitted at a rustication near mid-height of the column. The column reinforcement may be lap spliced near the construction joint. The lap of the splice shall be a minimum of 3'-6". Splices shall be staggered at least 3'-3" between adjacent bars.

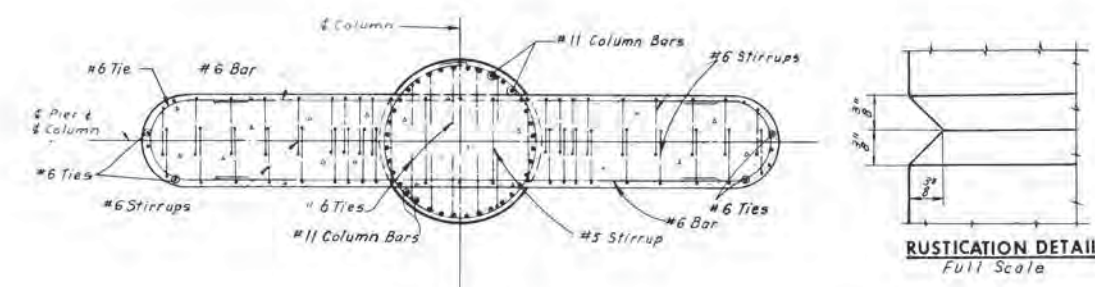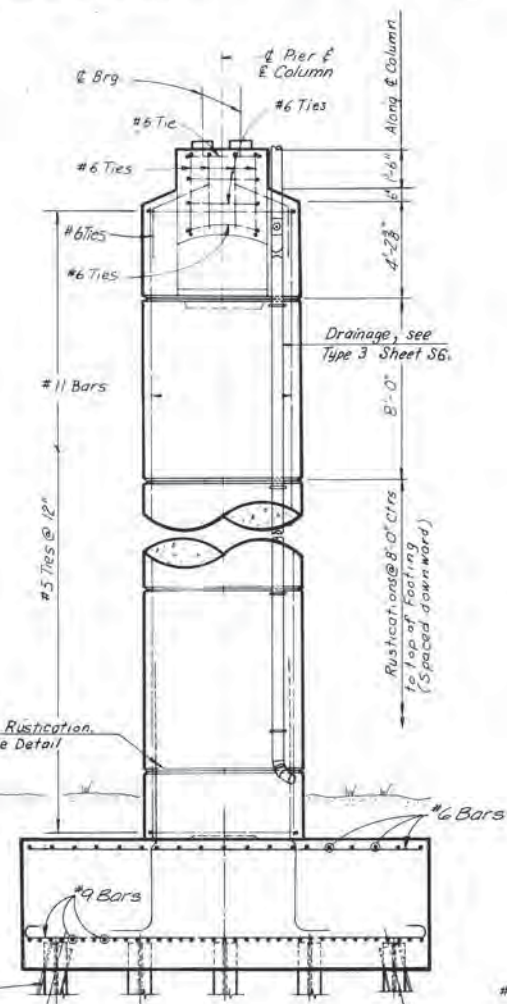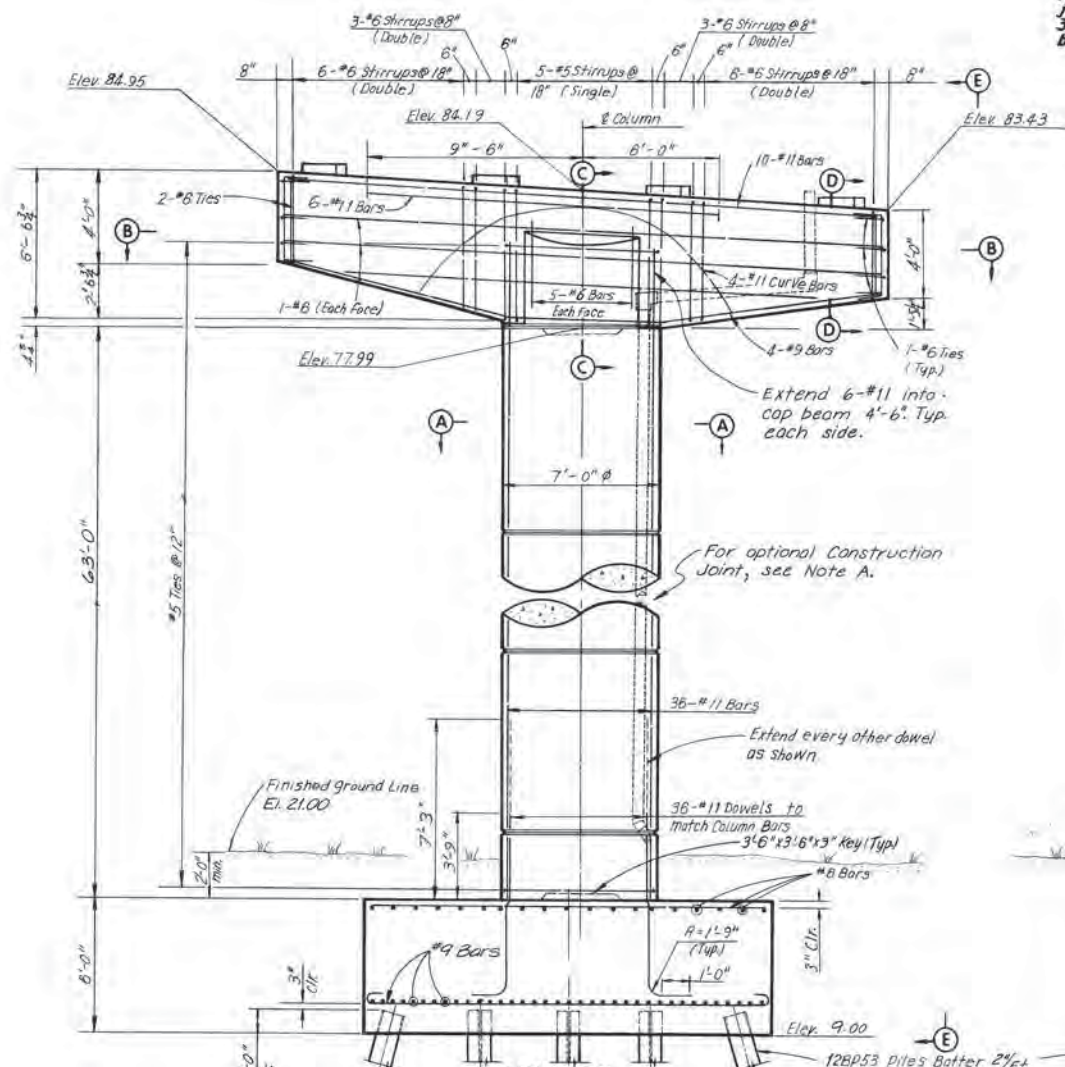

Note:
 Typical dimensions of concrete pad for E1 shoe is 2'-0" x 1'-0" and for E5 shoe is 2'-5" x 1'-1 1/2".

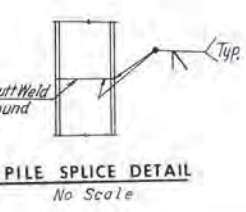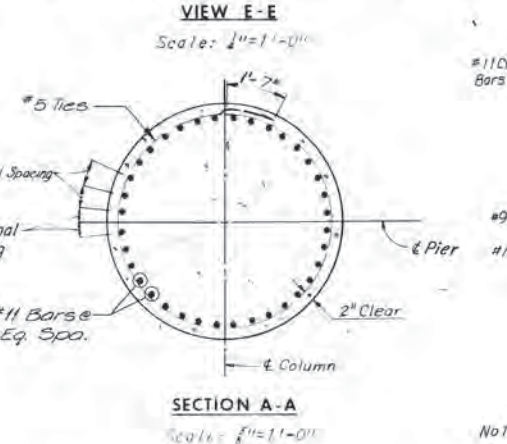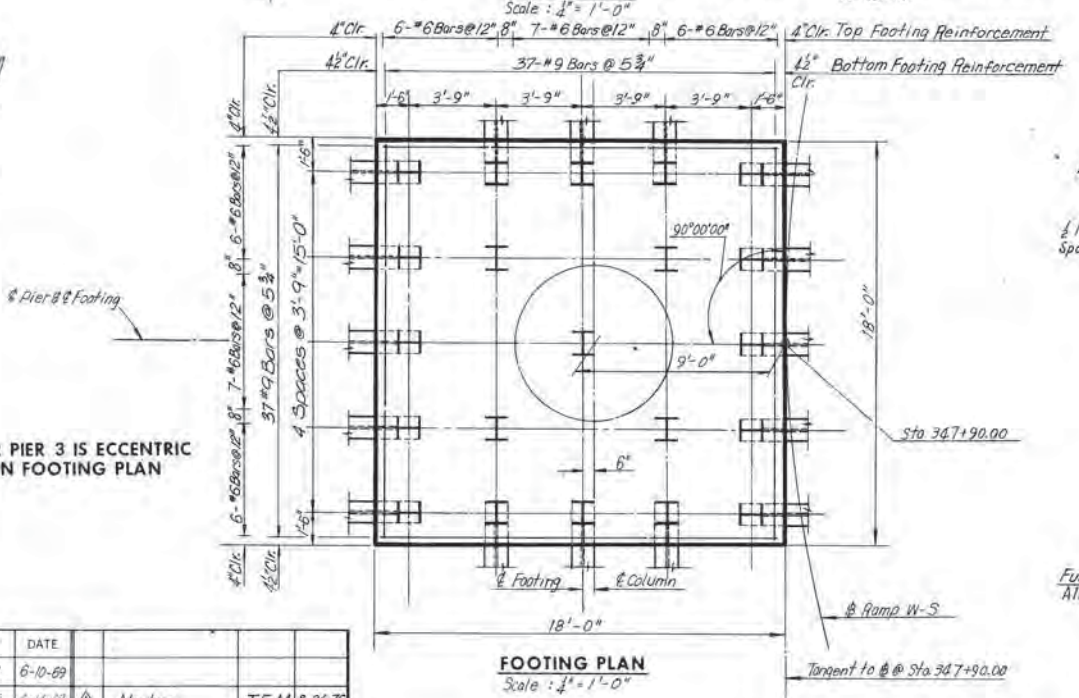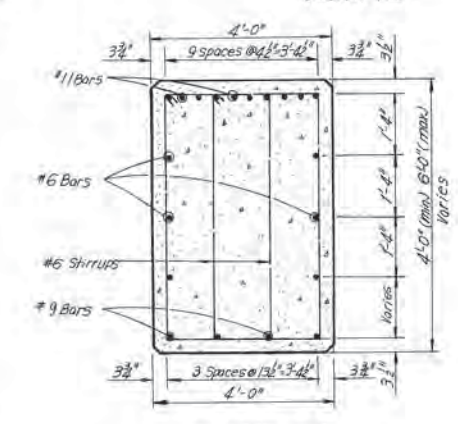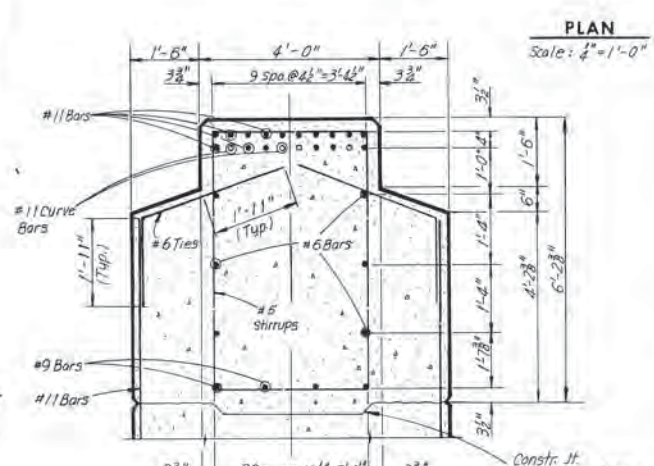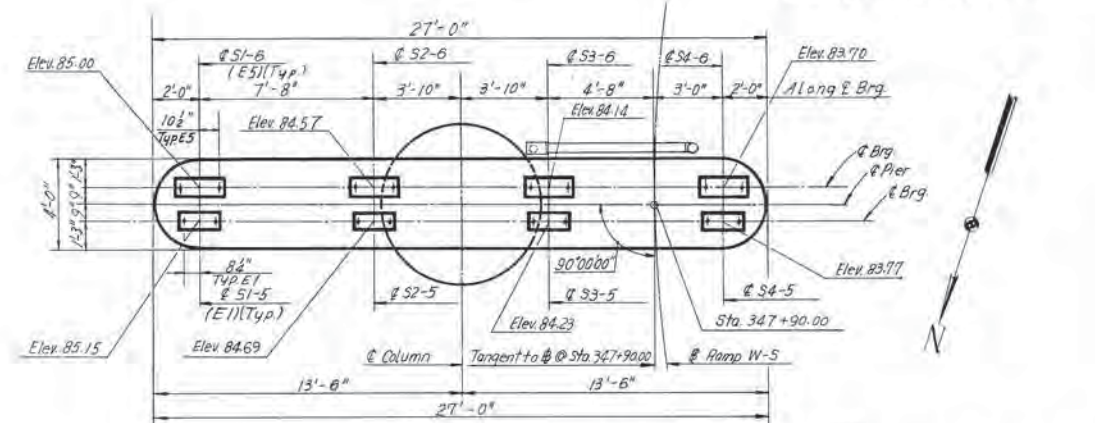

Note:
 Footing Elevations are approximate only and maybe varied to suit field conditions as directed by the Engineer. Vertical shaft reinforcing shall not be cut until these elevations are established. Where elevations change more than 2ft., redesign will be required.

Notes:
 All piles shall be 12BP53 Steel Piles (design capacity = 57 tons)
 For Standard shoe Detail, see sheets S1 and S2.
 For Framing Plan, see Sheet 13.
 For Quantities of concrete and Steel see Sheet 2.
 Estimated pile tip elevation is -10.0.

MADE	BY	DATE	NO.	REVISION	BY	DATE
GSH	GSH	6-10-89				
	VCP	6-14-89		Notes	T.E.M.	8-26-75

AS BUILT


RICHMOND METROPOLITAN AUTHORITY
RICHMOND EXPRESSWAY SYSTEM
DOWNTOWN EXPRESSWAY

BRIDGE NO. 68
RAMP W-S CONNECTION TO
RICHMOND-PETERSBURG TURNPIKE
PIER 3




HOWARD, NEEDLES, TAMMEN & BERGENDOFF
 consulting engineers
 NEW YORK, ALEXANDRIA, KANSAS CITY

SCALE: As Noted
 CONTRACT NO.: 11
 SHEET NO. 5 OF 28

RICHMOND EXPRESSWAY SYSTEM			
SECTION	PROJECT	SHEET NO.	TOTAL SHEETS
11	DOWNTOWN EXPRESSWAY	69	97


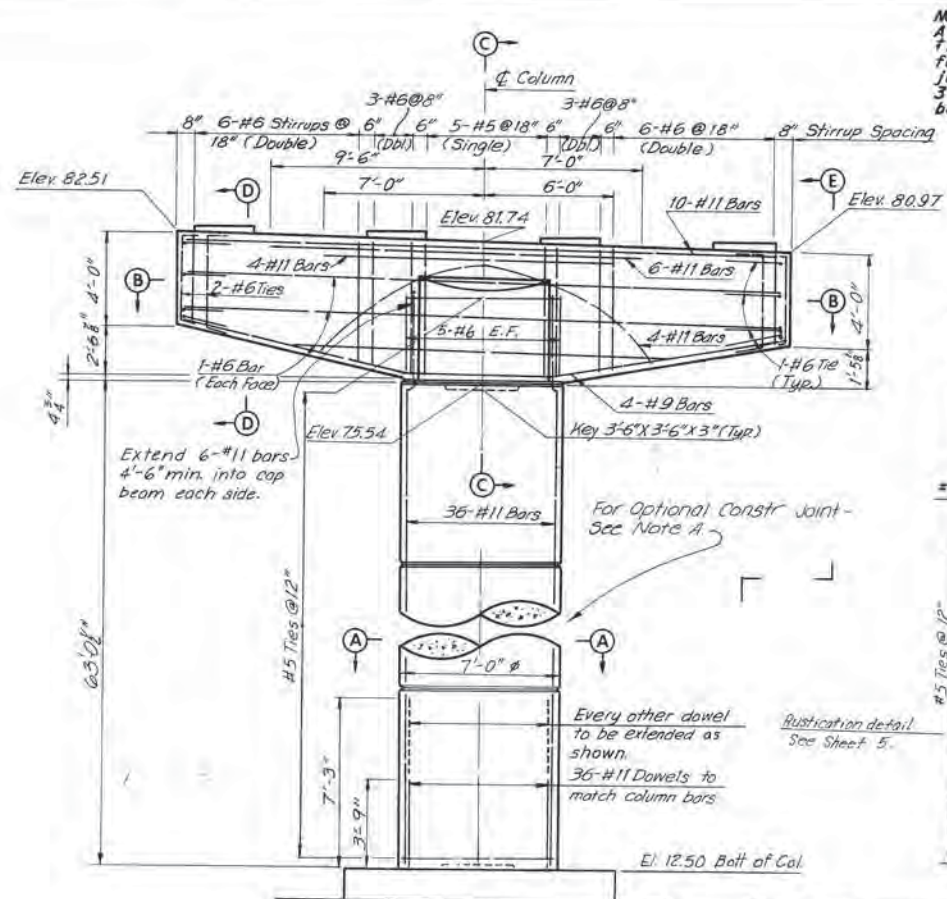


NOTE A
A construction joint will be permitted at a rustication near mid-height of the column. The column reinforcement may be lap spliced near the construction joint. The top of the splice shall be a minimum of 3'-6". Splices shall be staggered at least 3'-3" between adjacent bars.

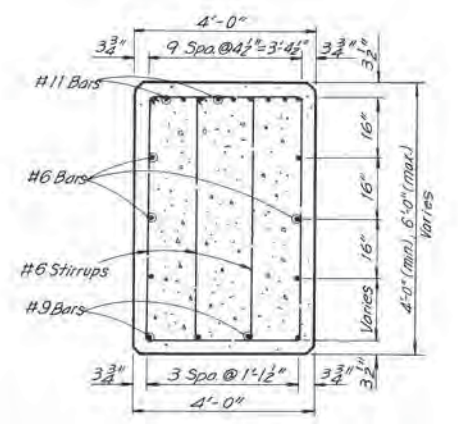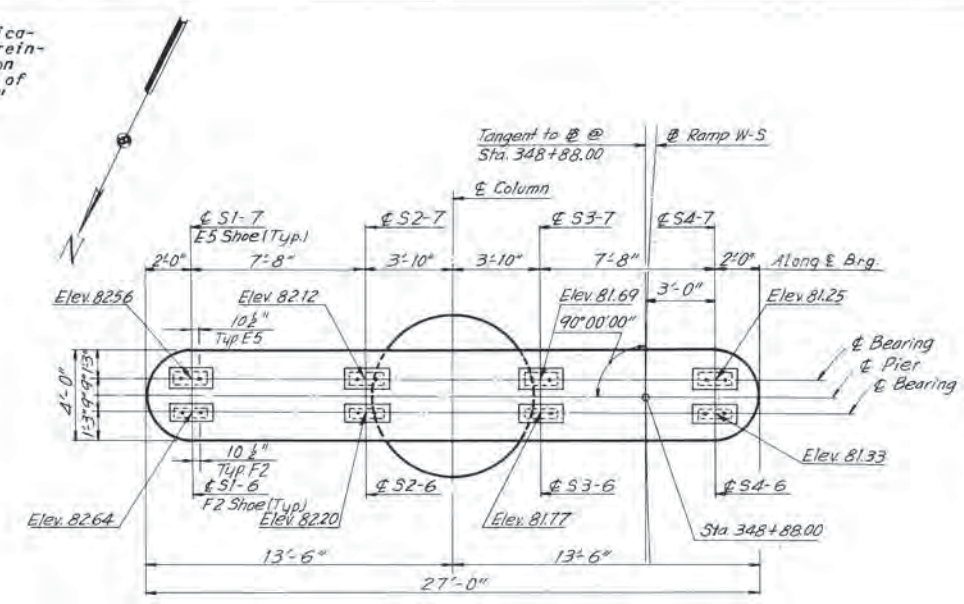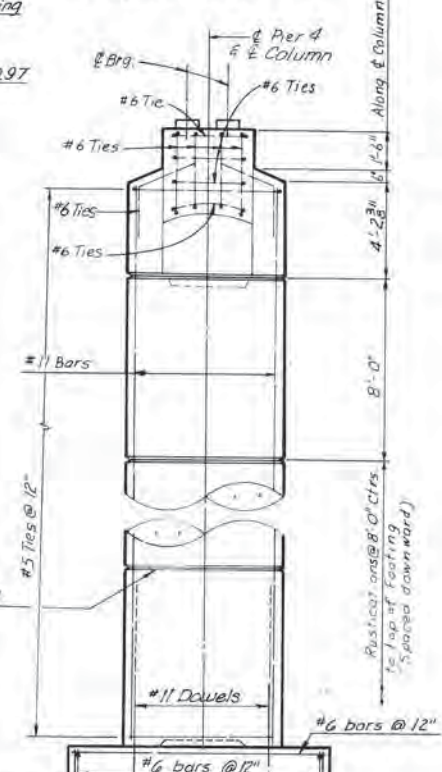


Note: Typical dimensions of concrete pad for E5 shoe is 2'-5" x 1'-1 1/2" and for F2 shoe is 2'-6" x 1'11".

Note: All elevations are @ top of Concrete pad at Bearing.

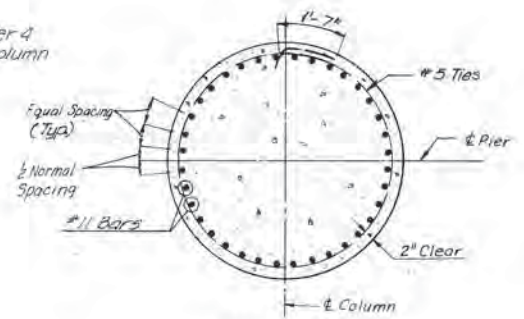
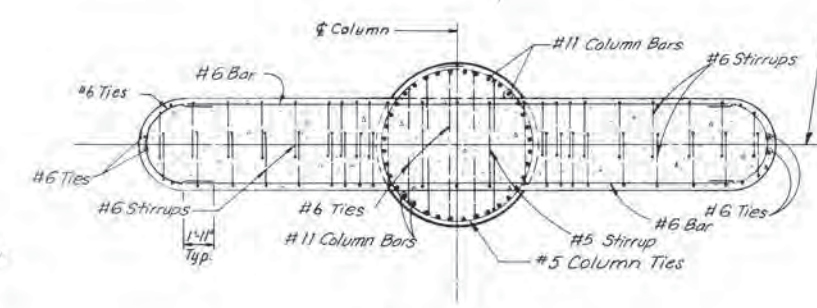


Note: Footing elevations are approximate only and may be varied to suit field conditions as directed by the Engineer. Vertical shaft reinforcing shall not be cut until these elevations are established. Where elevations change more than 2 ft., redesign will be required.

Notes: All piles shall be 12AP53 steel piles (Design Capacity = 57 Tons). Batter piles 1' per foot where shown. For Standard Shoe Detail, see Sheets S1 and S2. For Framing Plan, see Sheets 13 and 14. For Rustication Detail, see Sheet 5. For 12AP53 Steel Pile Details, see Sheet 5. For Quantities of concrete and steel, see Sheet 2. Estimated pile Tip Elevation is - 15.0.

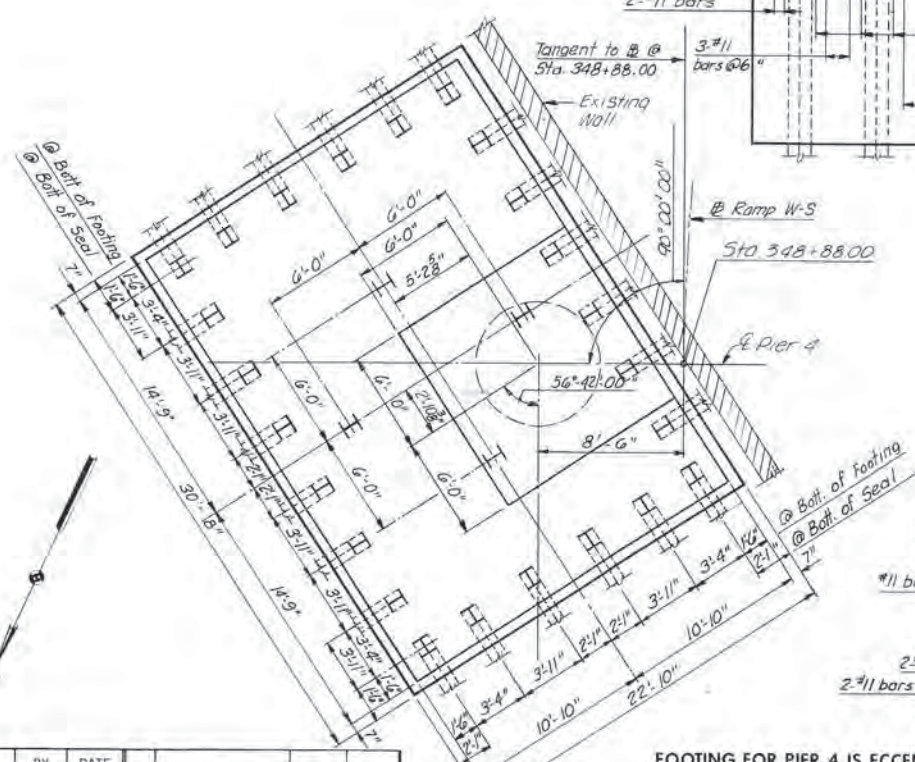

FOOTING FOR PIER 4 IS ECCENTRIC AS SHOWN ON FOOTING PLAN

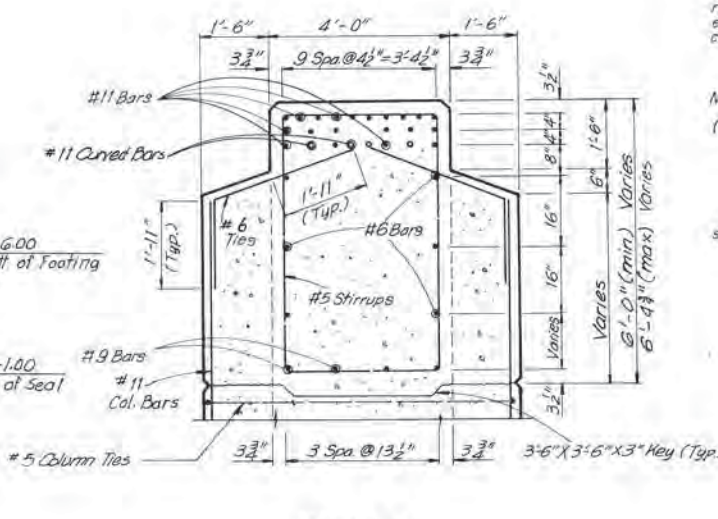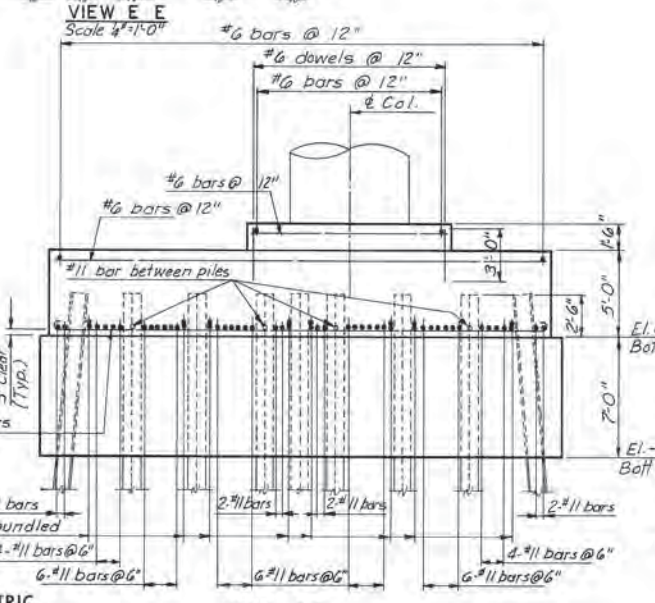

VIEW F-F
Scale: 1/8" = 1'-0"







BY	DATE			
MADE	SCC	6-10-69		
CHECKED	G.S.H.	6-14-69	Note deleted	T.E.M. 8-26-75
IN CHARGE				

AS BUILT

RICHMOND METROPOLITAN AUTHORITY
RICHMOND EXPRESSWAY SYSTEM
DOWNTOWN EXPRESSWAY

BRIDGE NO. 68
RAMP W-S CONNECTION TO
RICHMOND-PETERSBURG TURNPIKE
PIER 4

HOWARD, NEEDLES, TAMMEN & BERGENDOFF consulting engineers NEW YORK ALEXANDRIA KANSAS CITY	SCALE: As Noted CONTRACT NO. 11 SHEET NO. 6 OF 28
---	---

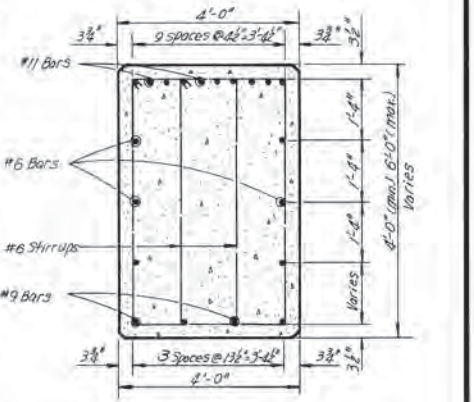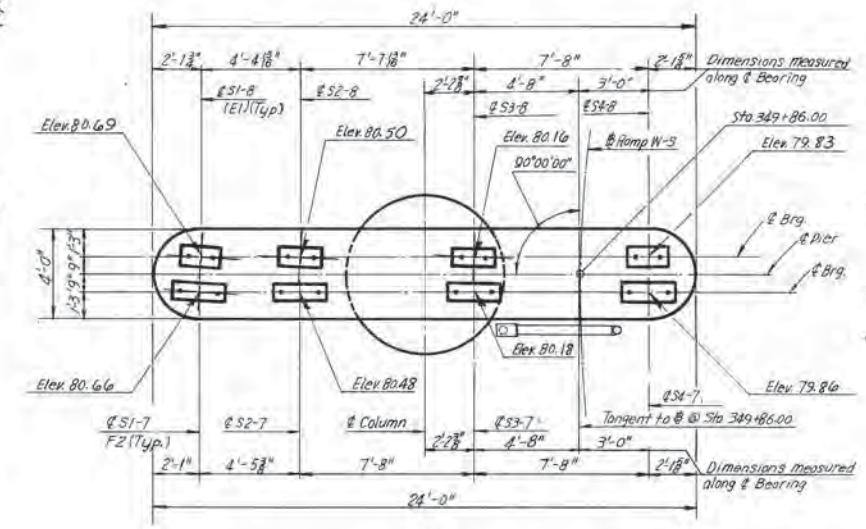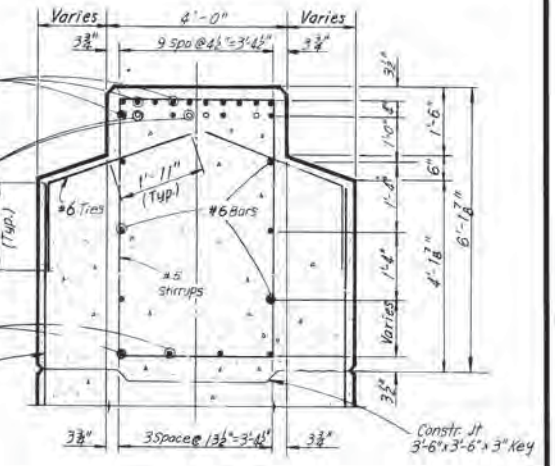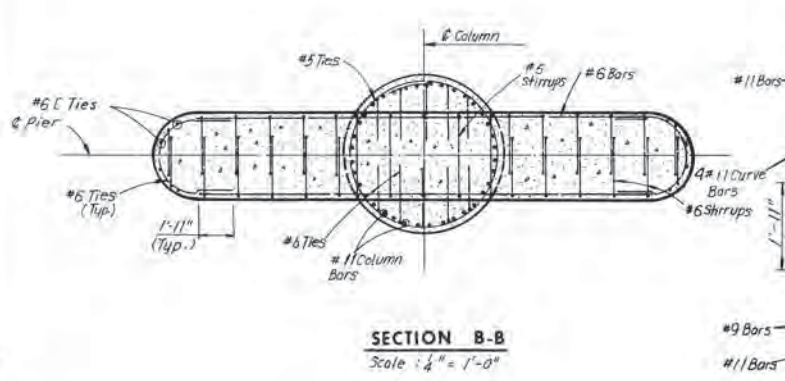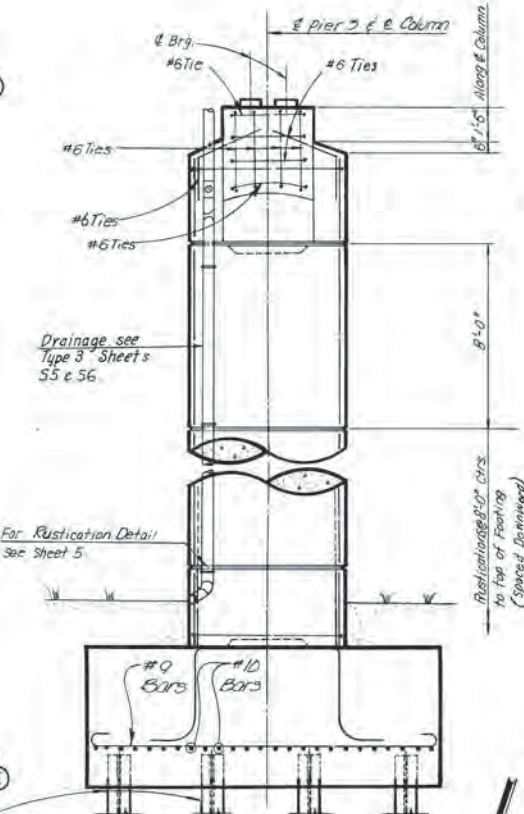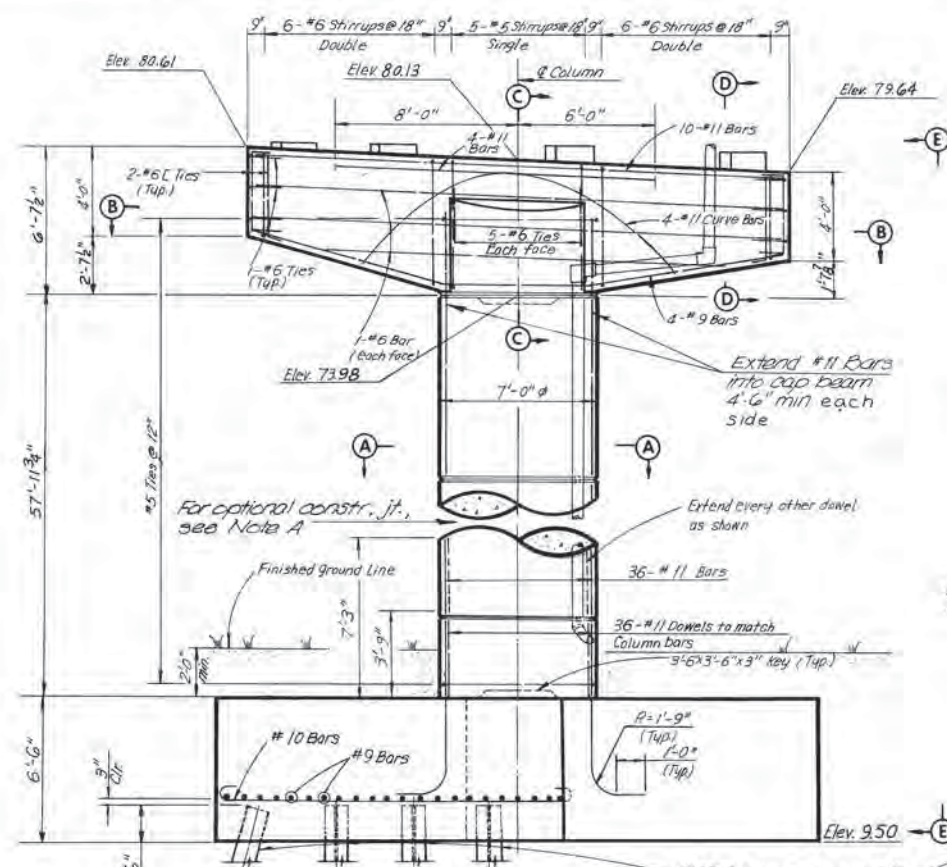


NOTE A:
A construction joint will be permitted at a rustication near mid-height of the column. The column reinforcement may be lap spliced near the construction joint. The lap of the splice shall be a minimum of 3'-6". Splices shall be staggered at least 3'-3" between adjacent bars.

ELEVATION
Scale: 1/4" = 1'-0"


VIEW E-E
Scale: 1/4" = 1'-0"

PLAN
Scale: 1/4" = 1'-0"


SECTION D-D
Scale: 1/4" = 1'-0"

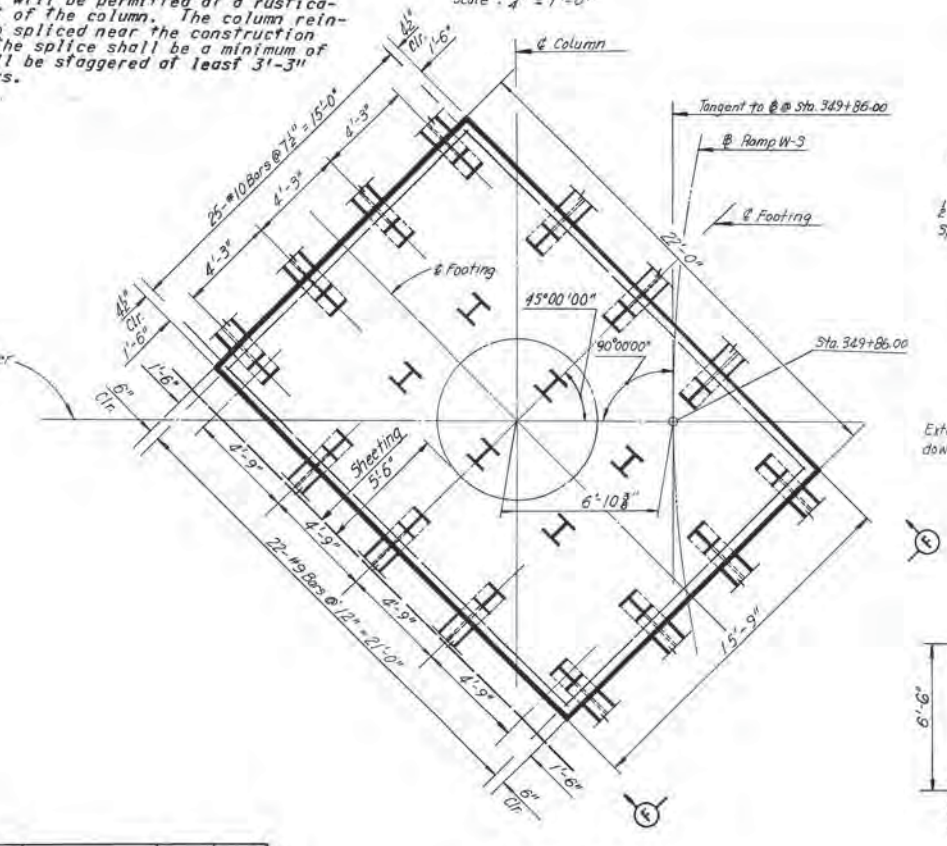

FOOTING PLAN
Scale: 1/4" = 1'-0"

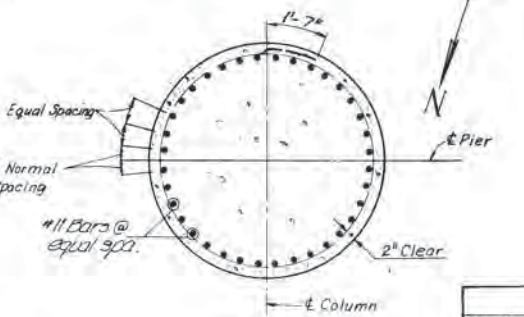


SECTION A-A
Scale: 1/2" = 1'-0"

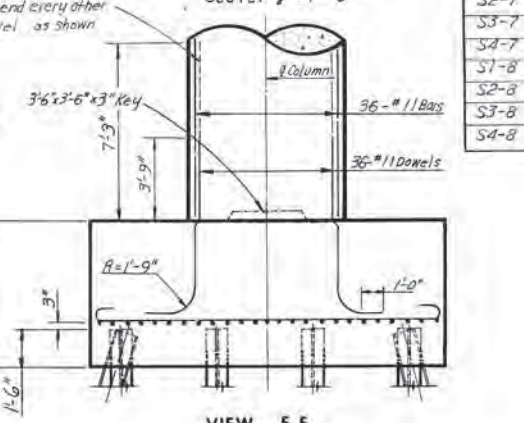

VIEW F-F
Scale: 1/4" = 1'-0"

Stringers	a	b	A	B	C	D	E	F	G	H	I	J	K
S1-7	-	87°45'28"	5 1/2"	10 1/2"	5 1/2"	15 3/4"	14 1/2"	6 1/2"	4 1/2"	11"	2'-6"	10 1/2"	2 1/2"
S2-7	-	90°00'00"	0"	10 1/2"	0"	15"	15"	5 1/2"	5 1/2"	11"	2'-6"	10 1/2"	2 1/2"
S3-7	-	90°00'00"	0"	10 1/2"	0"	15"	15"	5 1/2"	5 1/2"	11"	2'-6"	10 1/2"	2 1/2"
S4-7	-	90°00'00"	0"	10 1/2"	0"	15"	15"	5 1/2"	5 1/2"	11"	2'-6"	10 1/2"	2 1/2"
S1-8	93°50'24"	-	5 1/2"	8 1/2"	5 1/2"	12 3/4"	11 3/4"	6 1/2"	5 1/2"	1'-0"	2'-0 1/2"	8 1/2"	2 1/2"
S2-8	92°38'34"	-	5 1/2"	8 1/2"	5 1/2"	12 3/4"	12"	6 1/2"	5 1/2"	1'-0"	2'-0 1/2"	8 1/2"	2 1/2"
S3-8	91°27'44"	-	5 1/2"	8 1/2"	5 1/2"	12 3/4"	12 1/2"	6 1/2"	5 1/2"	1'-0"	2'-0 1/2"	8 1/2"	2 1/2"
S4-8	91°27'44"	-	5 1/2"	8 1/2"	5 1/2"	12 3/4"	12 1/2"	6 1/2"	5 1/2"	1'-0"	2'-0 1/2"	8 1/2"	2 1/2"

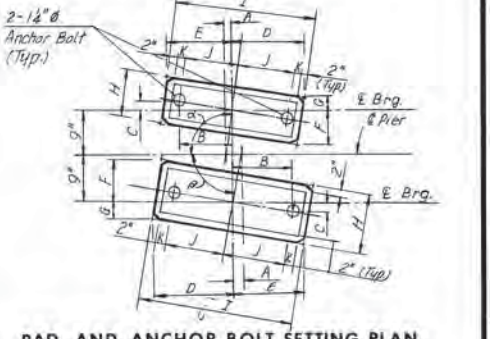

PAD AND ANCHOR BOLT SETTING PLAN
No Scale

Note: Footing Elevations are approximate only and maybe varied to suit field conditions as directed by the Engineer. Vertical shaft reinforcing shall not be cut until these elevations are established. Where elevations change more than 2 ft., redesign will be required.

Notes:
All piles shall be 12BP53 steel piles (Design Capacity = 57 tons).
Batter all piles 3" per foot where shown.
For Standard Shoe Detail, see Sheets S1 and S2.
For Framing Plan, see Sheet 14.
For Rustication Detail, see Sheet 5.
For 12BP53 Steel Pile Detail, see Sheet 5.
For Quantities of concrete and steel, see Sheet 2.
Estimated Pile tip elevations are -15.0

MADE	BY	DATE			
CHECKED	BY	DATE	Pad Elevations	TEM	8-26-75
IN CHARGE	NO.	REVISION	BY	DATE	

AS BUILT

RICHMOND METROPOLITAN AUTHORITY
RICHMOND EXPRESSWAY SYSTEM
DOWNTOWN EXPRESSWAY

BRIDGE NO. 68
RAMP W-3 CONNECTION TO
RICHMOND-PETERSBURG TURNPIKE
PIER 5


HOWARD, NEEDLES, TAMMEN & BERGENDOFF
consulting engineers
NEW YORK ALEXANDRIA KANSAS CITY

SCALE: As Noted
CONTRACT NO.: 11
SHEET NO. 7 OF 28


DIMENSIONS FOR PAD AND ANCHOR BOLT SETTING PLAN

Stringer	α	A	B	C	D	E	F	G	H	I	J	K	L
*S1-9	88°31'17"	8 1/2	7 1/2	13 1/2	12 1/2	15	2'-2 1/2"	8 1/2	5	10	↓		
*S2-9	85°33'46"	9	6 1/2	8 1/2	13 1/2	15	2'-2 1/2"	8 1/2	5	10	↓		
*S3-9	79°16'37"	10 1/2	4 1/2	9 1/2	16 1/2	15	2'-2 1/2"	8 1/2	5	10	↓		
S1-10	89°35'33"	8 1/2	5 1/2	12 1/2	12 1/2	11 1/2	2'-1"	8	4 1/2	9	↓		
S2-10	88°51'44"	8 1/2	5 1/2	12 1/2	12 1/2	11 1/2	2'-1"	8	4 1/2	9	↓		
S1-8	80°07'28"	9 1/2	4 1/2	8 1/2	15 1/2	13 1/2	2'-3"	8	5 1/2	8	↓		
S2-8	78°55'37"	9 1/2	4 1/2	8 1/2	16 1/2	13 1/2	2'-3"	8	5 1/2	8	↓		
S3, 4-8	77°44'47"	9 1/2	4 1/2	8 1/2	16 1/2	10 1/2	2'-3"	8	5 1/2	8	↓		
** S1-9	89°20'16"	8 1/2	5 1/2	12 1/2	12 1/2	11 1/2	2'-1"	8	4 1/2	9	↓		
** S2-9	86°22'45"	8 1/2	5 1/2	12 1/2	12 1/2	11 1/2	2'-1"	8	4 1/2	9	↓		
** S3-9	86°38'50"	8 1/2	5 1/2	12 1/2	12 1/2	11 1/2	2'-1"	8	4 1/2	9	↓		


NOTE: Dimensions are in inches unless shown otherwise. Stringers denoted with * are at Pier 6 and with ** are at Pier 7.

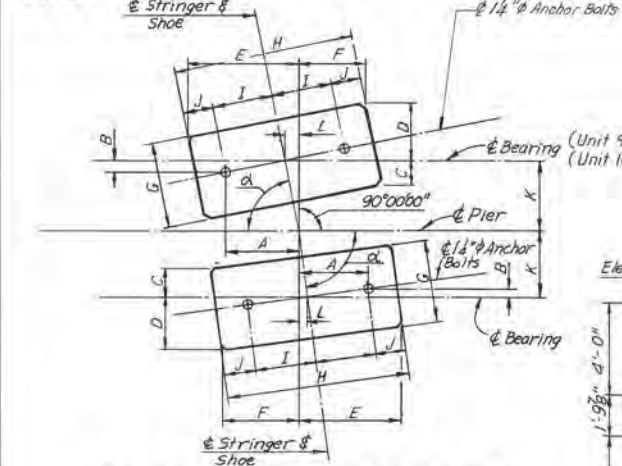

PAD AND ANCHOR BOLT SETTING PLAN
 No Scale

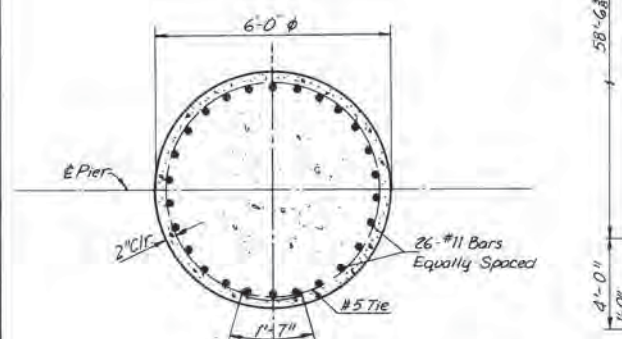


SECTION G-G
 No Scale

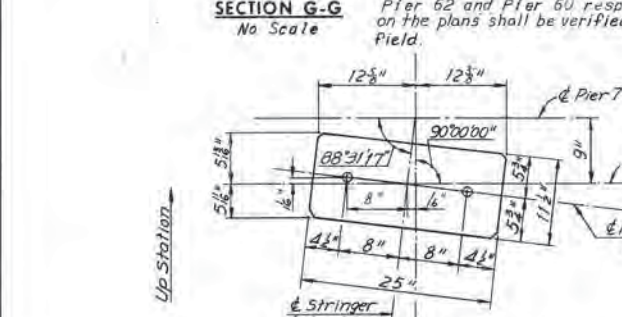


PAD AND ANCHOR BOLT SETTING PLAN
 No Scale (S2-9 Only)


BY	DATE	REVISION	BY	DATE
MADE	AHH 01-27-68	Footings Detail Pier 7	TEM	08-26-75
CHECKED	YCP 2-5-69	Pad Elevations	TEM	08-26-75
IN CHARGE				

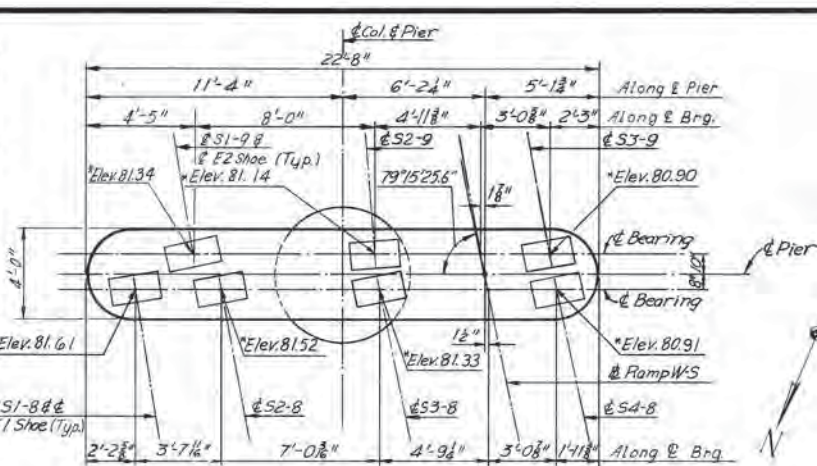


PLAN-PIER 6
 Scale: 1/4" = 1'-0"

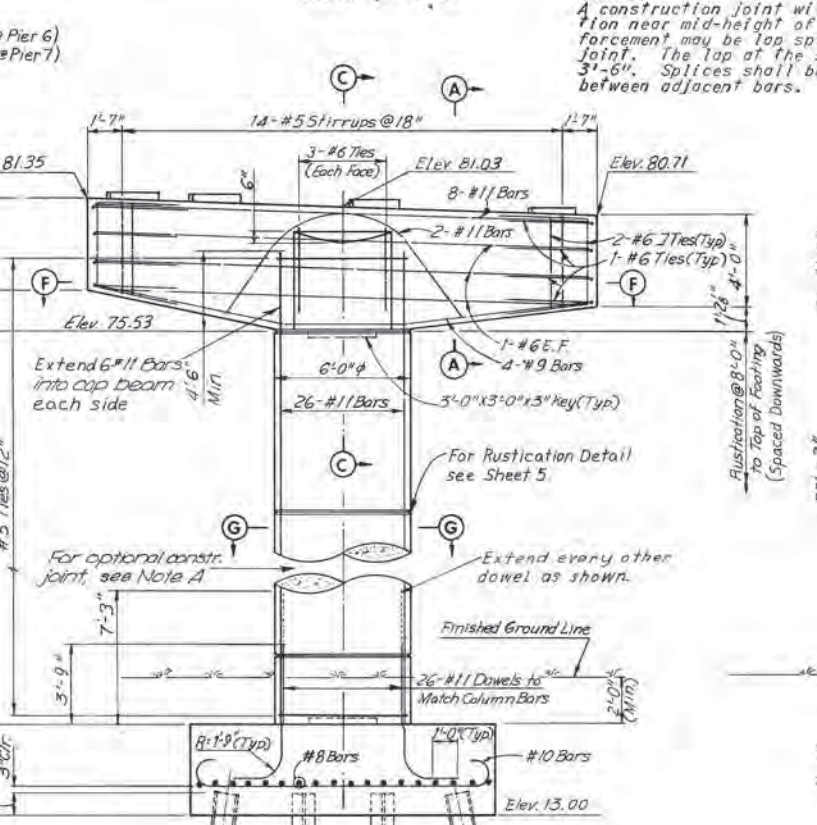


ELEVATION-PIER 6
 Scale: 1/4" = 1'-0"

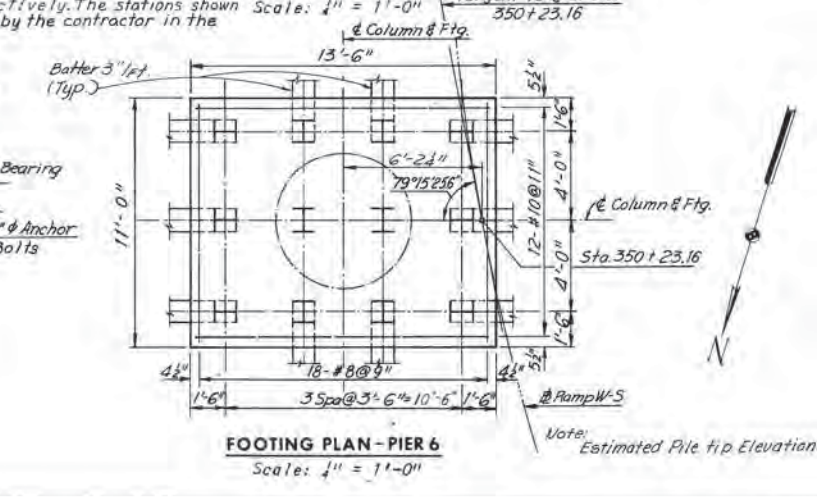


FOOTING PLAN-PIER 6
 Scale: 1/4" = 1'-0"

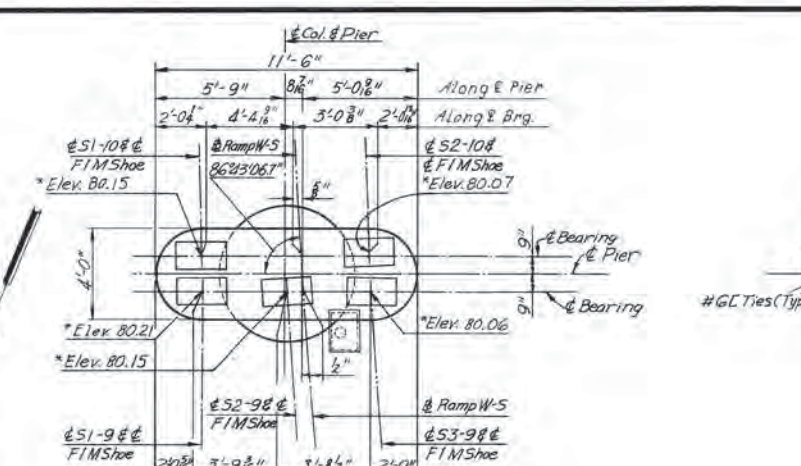


PLAN-PIER 7
 Scale: 1/4" = 1'-0"

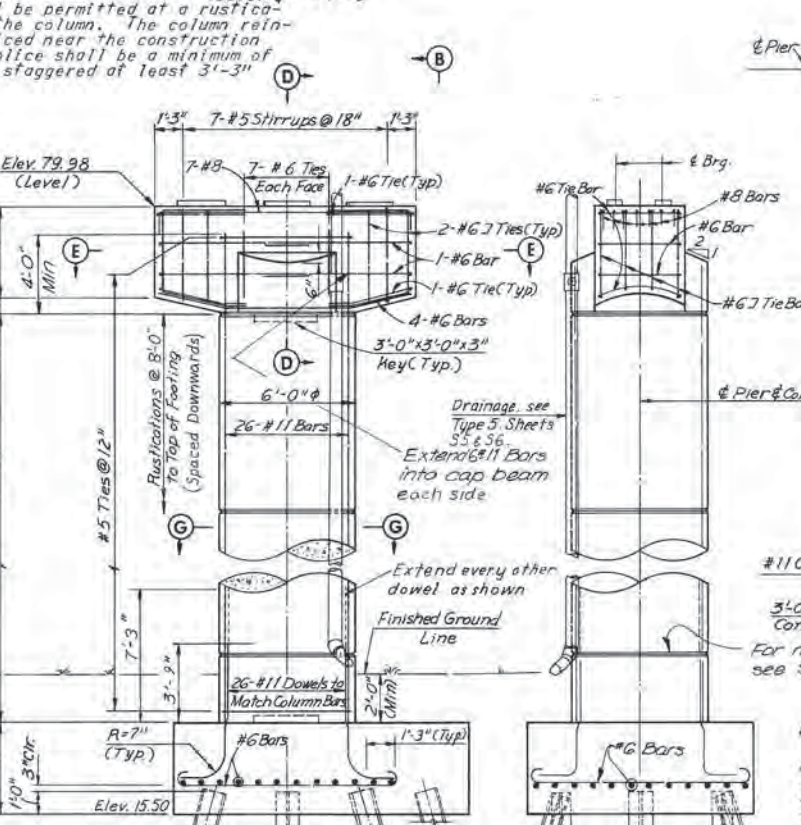


ELEVATION-PIER 7
 Scale: 1/4" = 1'-0"

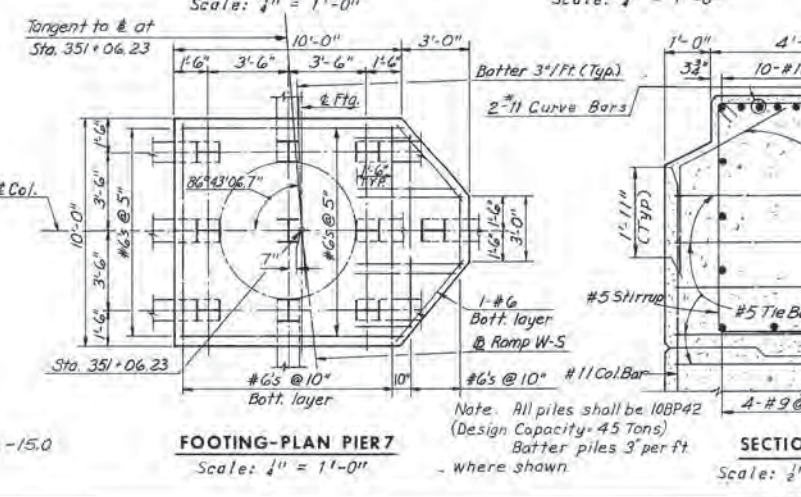


FOOTING PLAN-PIER 7
 Scale: 1/4" = 1'-0"

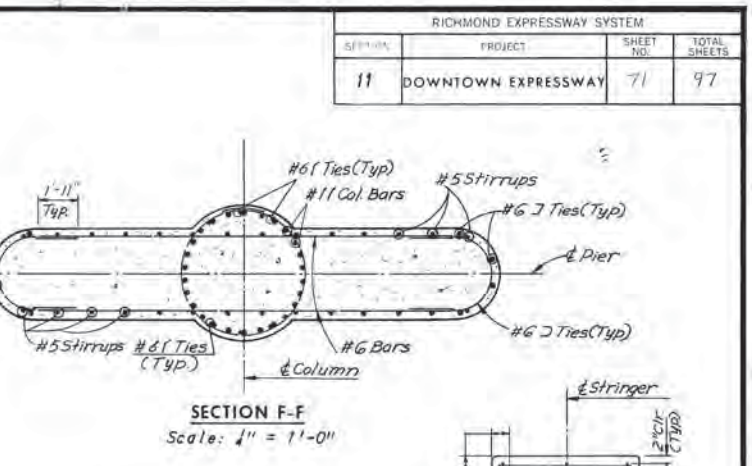


SECTION F-F
 Scale: 1/4" = 1'-0"

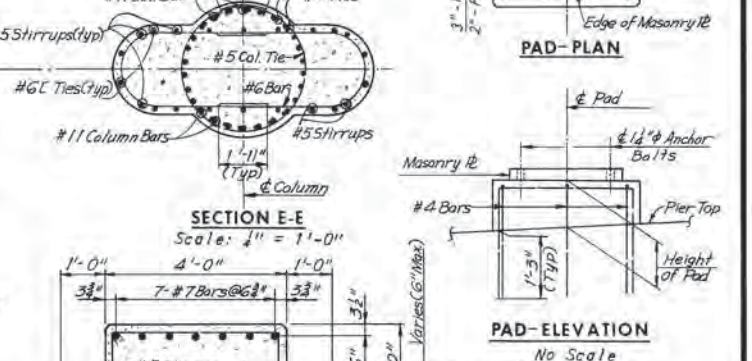

SECTION E-E
 Scale: 1/4" = 1'-0"

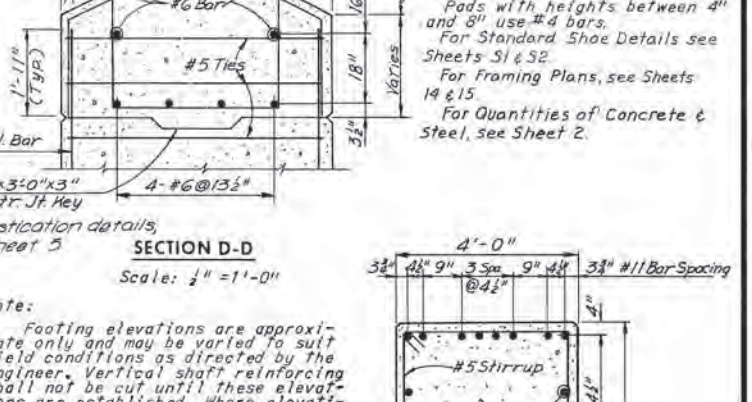

SECTION D-D
 Scale: 1/4" = 1'-0"

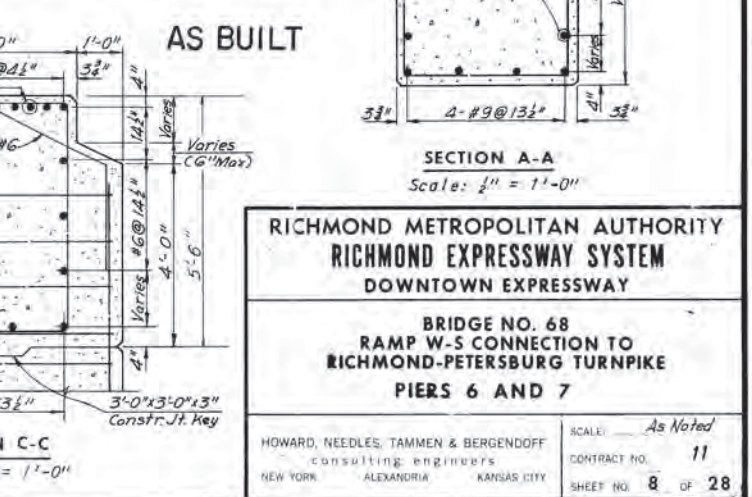

SECTION A-A
 Scale: 1/4" = 1'-0"

NOTE A
 A construction joint will be permitted at a rustication near mid-height of the column. The column reinforcement may be lap spliced near the construction joint. The lap of the splice shall be a minimum of 3'-6". Splices shall be staggered at least 3'-3" between adjacent bars.

Notes:
 Pads with heights of 4" or less shall not be reinforced. Pads with heights between 4" and 8" use #4 bars. For Standard Shoe Details see Sheets S1 & S2. For Framing Plans, see Sheets 14 & 15. For Quantities of Concrete & Steel, see Sheet 2.








Note:
 Footing elevations are approximate only and may be varied to suit field conditions as directed by the Engineer. Vertical shaft reinforcement shall not be cut until these elevations are established. Where elevations change more than 2 ft., redesign will be required.

RICHMOND METROPOLITAN AUTHORITY
 RICHMOND EXPRESSWAY SYSTEM
 DOWNTOWN EXPRESSWAY





BRIDGE NO. 68
 RAMP W-5 CONNECTION TO
 RICHMOND-PETERSBURG TURNPIKE
 PIERS 6 AND 7

HOWARD, NEEDLES, TAMMEN & BERGENDOFF
 CONSULTING ENGINEERS
 NEW YORK ALEXANDRIA KANSAS CITY

SCALE: As Noted
 CONTRACT NO. 11
 SHEET NO. 8 OF 28

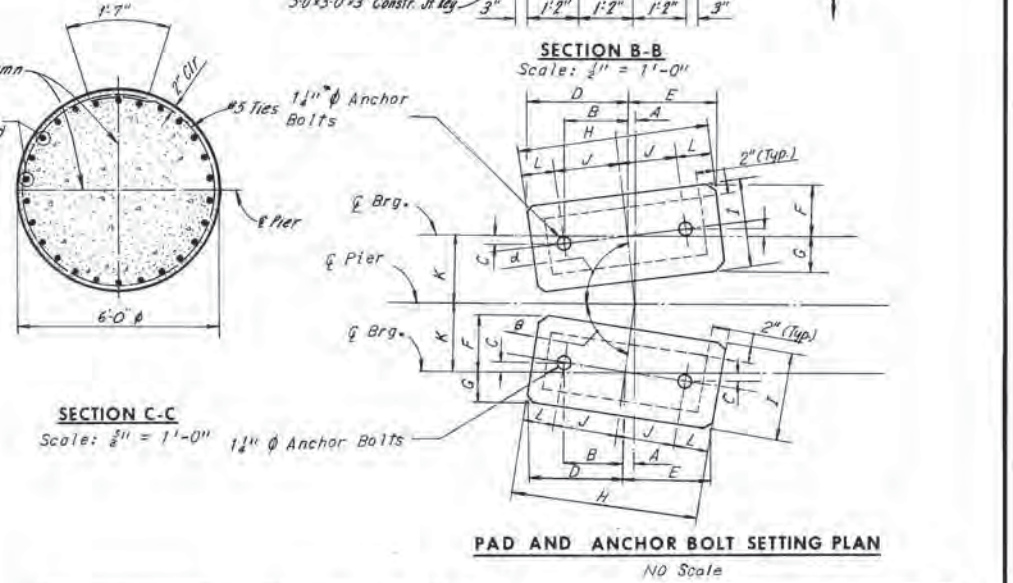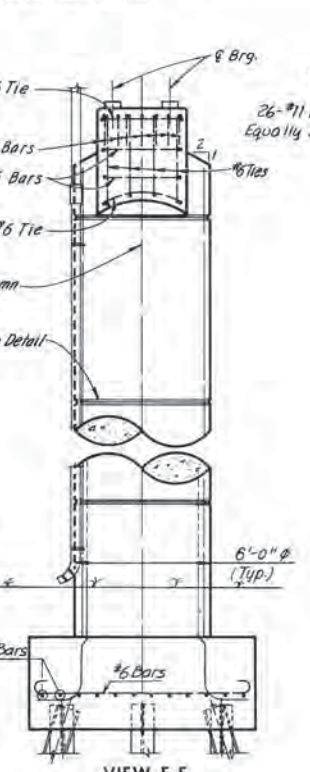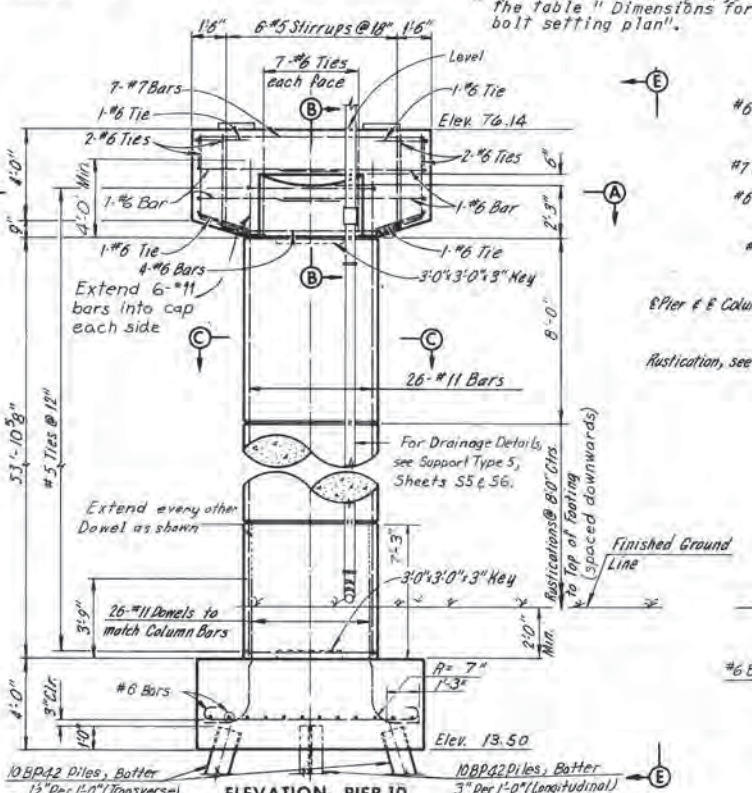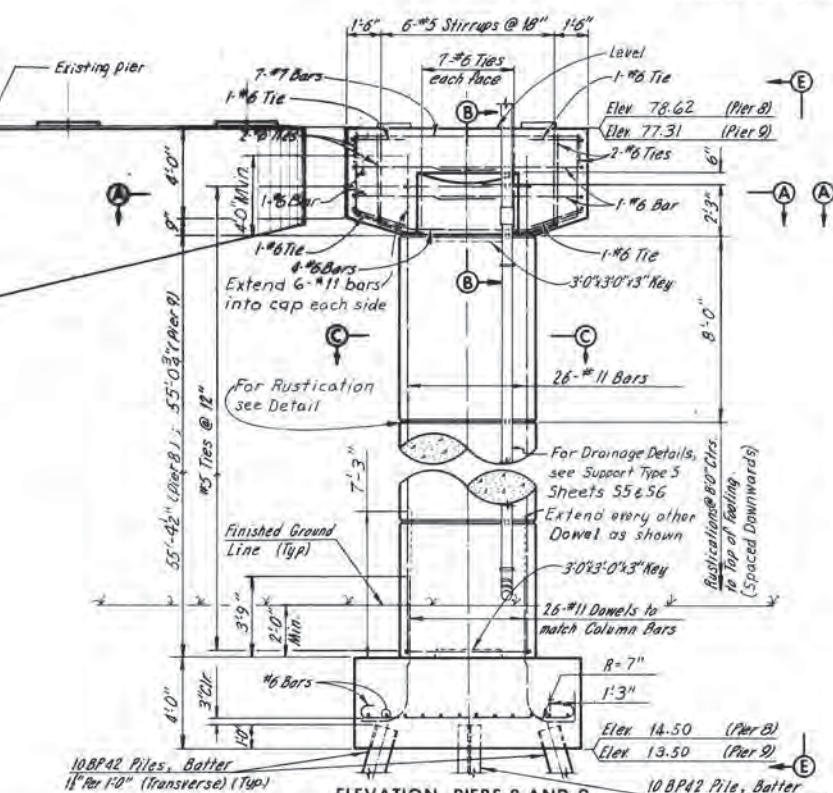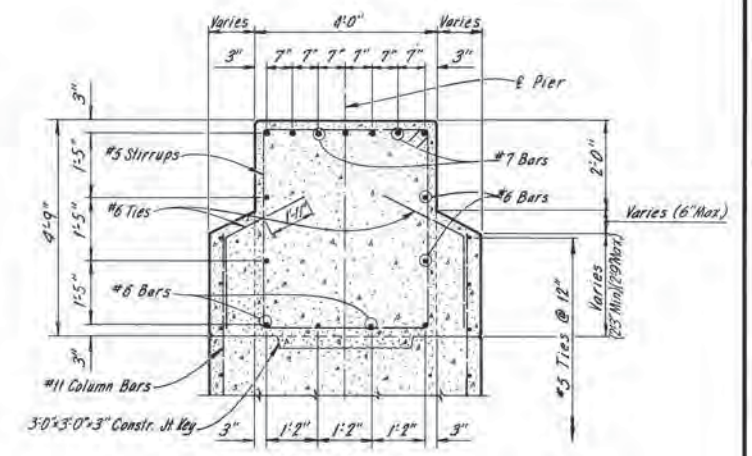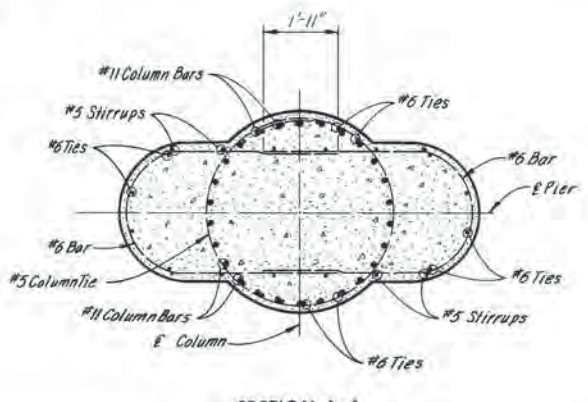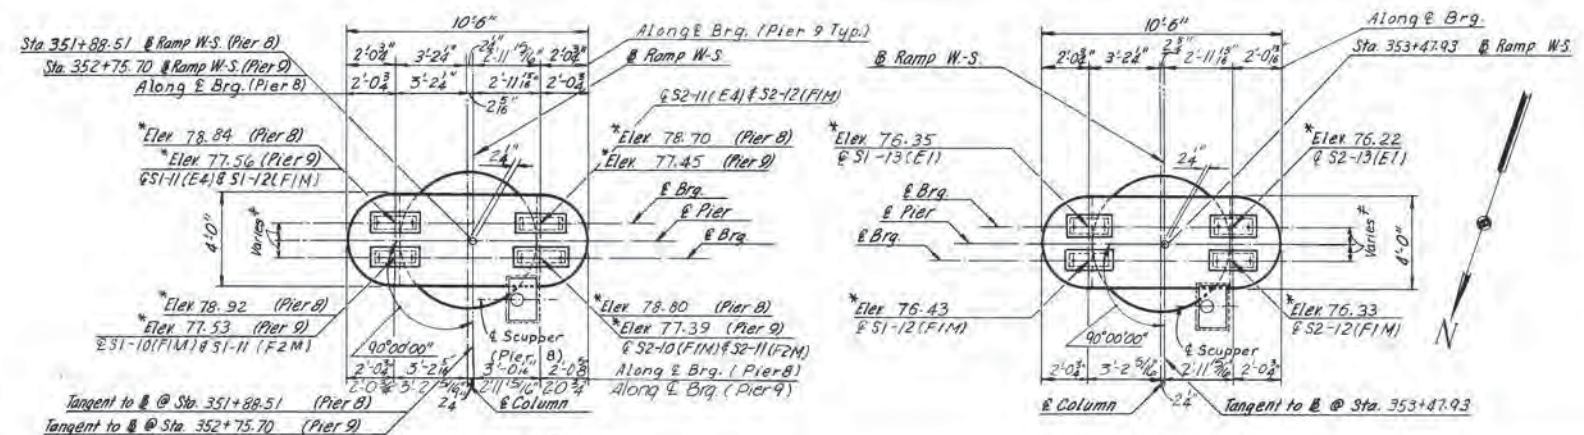

Pier	Stringer	α	β	A	B	C	D	E	F	G	H	I	J	K	L
8	S1-10	-	89°36'33"	11"	8"	11"	11'-0"	11'-0"	5 1/2"	5 1/2"	21'-11"	11 1/2"	8"	9"	4 1/2"
	S2-10	-	90°19'22"	11"	8"	11"	11'-0"	11'-0"	5 1/2"	5 1/2"	21'-11"	11 1/2"	8"	9"	4 1/2"
	S1-11	90°25'55"	-	11"	10 1/2"	11"	11'-2"	11'-2"	5 1/2"	5 1/2"	21'-5"	11'-0"	10 1/2"	9"	4"
9	S1-11	-	89°34'05"	11"	10 1/2"	11"	11'-3"	11'-3"	5 1/2"	5 1/2"	21'-6"	11"	10 1/2"	8"	4 1/2"
	S2-11	-	89°34'05"	11"	10 1/2"	11"	11'-3"	11'-3"	5 1/2"	5 1/2"	21'-6"	11"	10 1/2"	8"	4 1/2"
	S1-12	90°21'29"	-	11"	8"	11"	11'-0"	11'-0"	5 1/2"	5 1/2"	21'-11"	11 1/2"	8"	10"	4 1/2"
10	S2-12	-	90°21'29"	11"	8"	11"	11'-0"	11'-0"	5 1/2"	5 1/2"	21'-11"	11 1/2"	8"	10"	4 1/2"
	S1-13	89°38'13"	-	11"	8 1/4"	11"	11'-0"	11'-0"	5 1/2"	5 1/2"	21'-0 1/2"	11'-0"	8 1/4"	9"	4"
	S2-13	89°38'13"	-	11"	8 1/4"	11"	11'-0"	11'-0"	5 1/2"	5 1/2"	21'-0 1/2"	11'-0"	8 1/4"	9"	4"

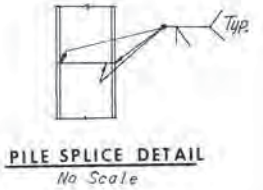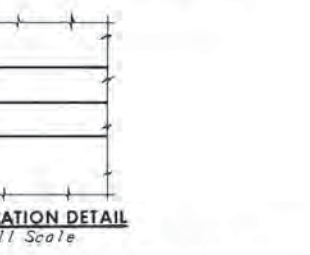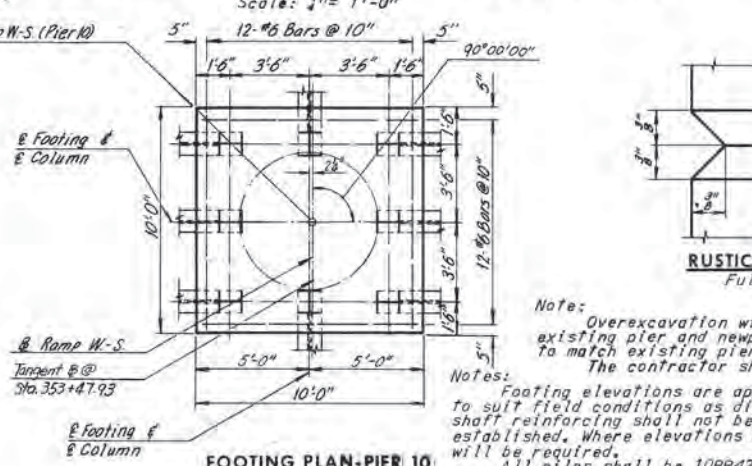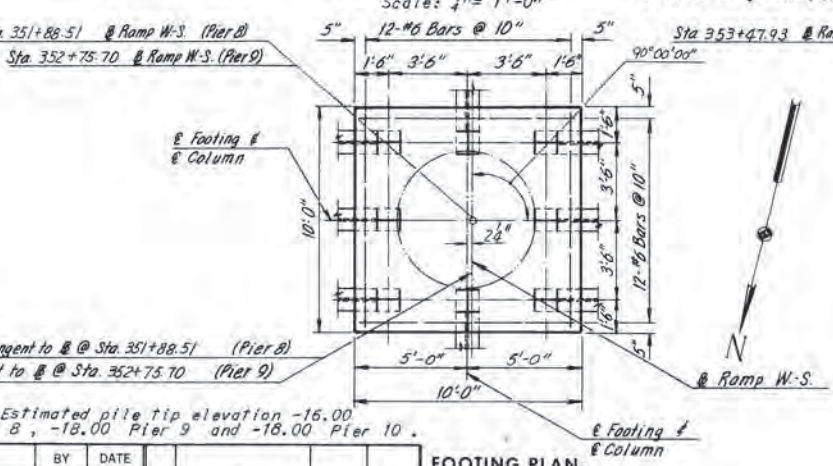

Note: Overexcavation will not be permitted between existing pier and new pier. Piers 8, 9 and 10 are to match existing piers 58, 56 and 54 respectively. The contractor shall verify the stations in the field.

Notes: Footing elevations are approximate only and may be varied to suit field conditions as directed by Engineer. Vertical shaft reinforcing shall not be cut until these elevations are established. Where elevations change more than 2 ft. redesign will be required.

All piles shall be 10BP42 Steel Piles. (Design capacity = 45 Tons.)

For Standard Shoe Details, see Sheets S1 & S2.

For Framing Plans, see Sheets 15 and 16.

For quantities of concrete and steel, see Sheet 2.

BY	DATE	NO.	REVISION	BY	DATE
MADE	DES G.S.H	1-28-69	Footing Dowels	TEM	8-26-76
CHECKED	K.C.T	2-4-69	Pad Elevations	TEM	8-26-75
IN CHARGE					

AS BUILT


RICHMOND METROPOLITAN AUTHORITY
RICHMOND EXPRESSWAY SYSTEM
DOWNTOWN EXPRESSWAY

BRIDGE NO. 68
RAMP W-S CONNECTION TO
RICHMOND-PETERSBURG JURNPIKE
PIERS 8, 9 AND 10


HOWARD, NEEDLES, TAMMEN & BERGENDOFF
consulting engineers
NEW YORK ALEXANDRIA KANSAS CITY

SCALE: As Noted
CONTRACT NO. 11
SHEET NO. 9 of 28

RICHMOND EXPRESSWAY SYSTEM			
SECTION	PROJECT	SHEET NO.	TOTAL SHEETS
11	DOWNTOWN EXPRESSWAY	73	97

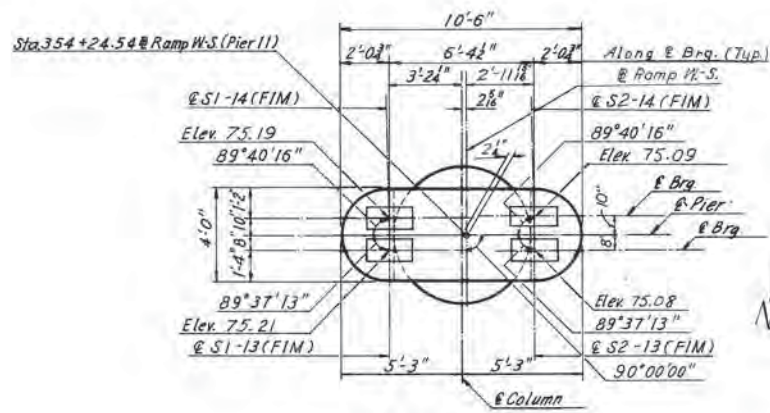


PIER CAP PLAN-PIER 11
Scale: 1/4" = 1'-0"

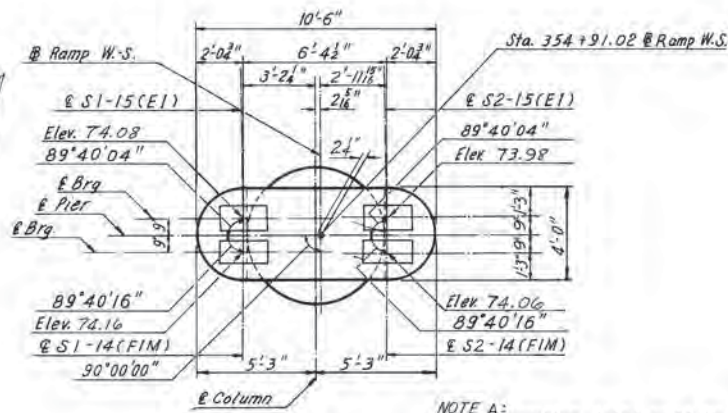


PIER CAP PLAN-PIER 12
Scale: 1/4" = 1'-0"


NOTE A:
A construction joint will be permitted at a rustication near mid-height of the column. The column reinforcement may be lap spliced near the construction joint. The lap at the splice shall be a minimum of 3'-6". Splices shall be staggered at least 3'-3" between adjacent bars.

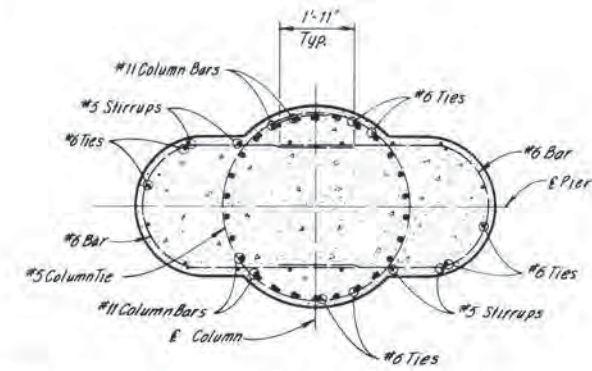


SECTION A-A
Scale: 1/2" = 1'-0"

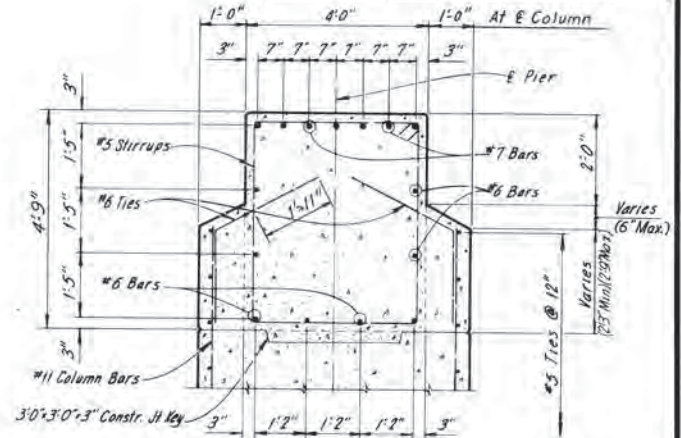

SECTION B-B
Scale: 1/2" = 1'-0"

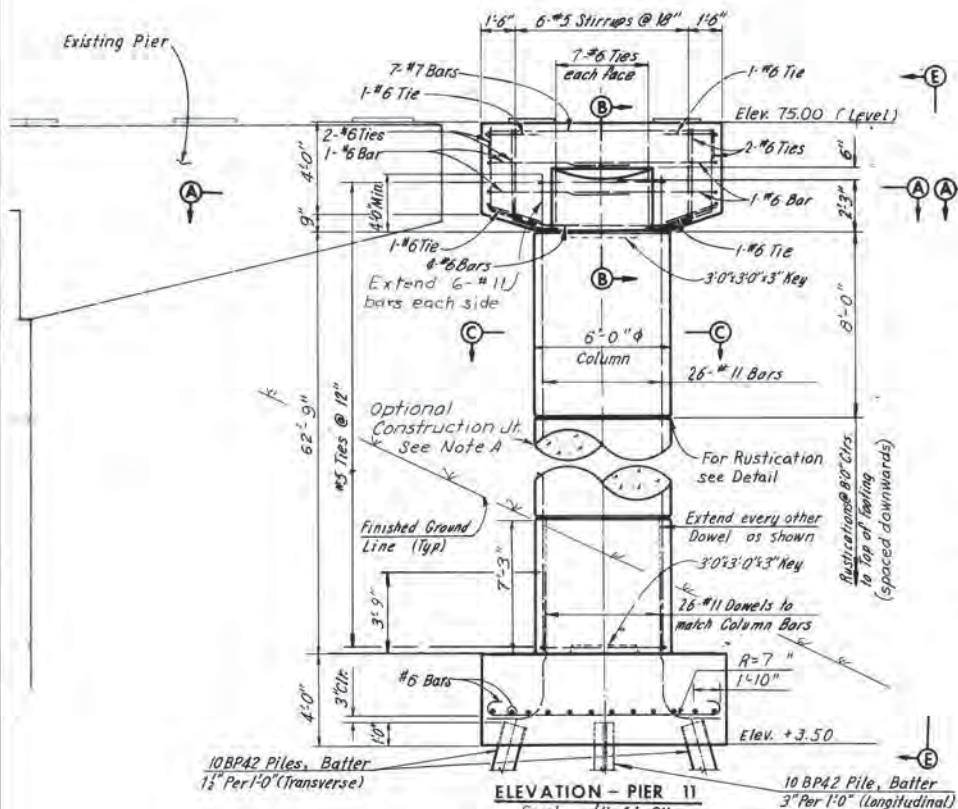


ELEVATION - PIER 11
Scale: 1/4" = 1'-0"

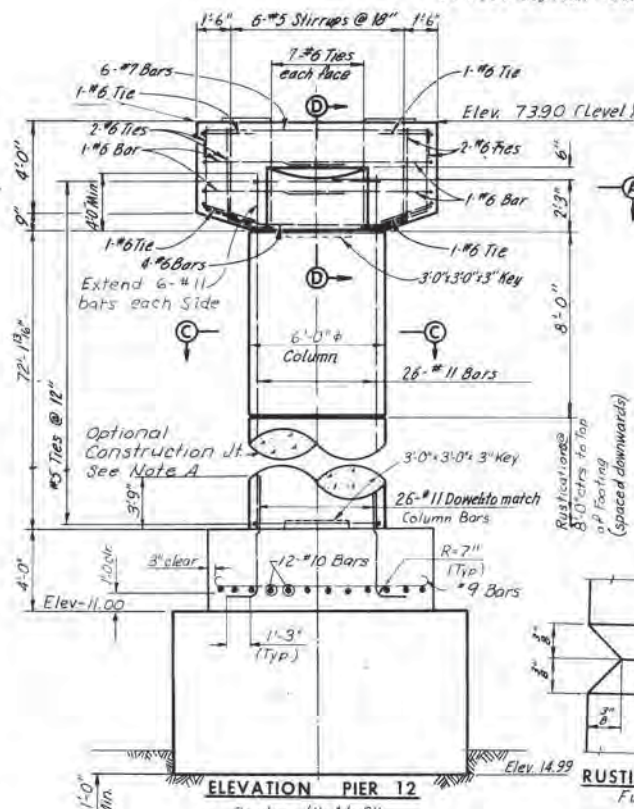


ELEVATION PIER 12
Scale: 1/4" = 1'-0"


RUSTICATION DETAIL
Full Scale

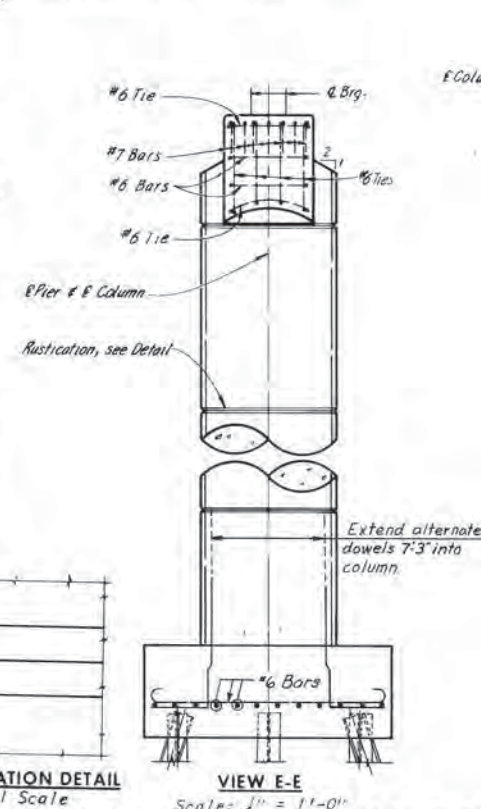

VIEW E-E
Scale: 1/4" = 1'-0"

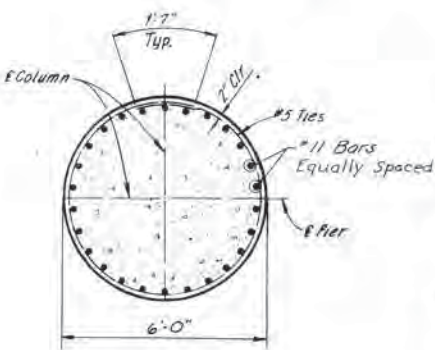

SECTION C-C
Scale: 1/2" = 1'-0"

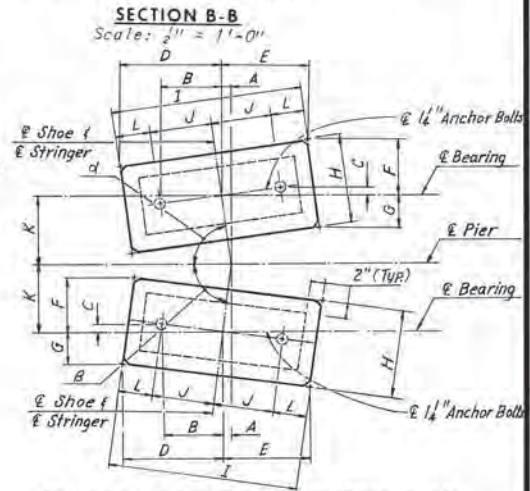

PAD AND ANCHOR BOLT SETTING PLAN
No Scale

DIMENSIONS FOR PAD AND ANCHOR BOLT SETTING PLAN															
Pier	Stringer	d	B	A	B	C	D	E	F	G	H	I	J	K	L
11	S1-13	—	89° 37' 13"	8"	8"	12 1/2"	12 1/2"	5 1/2"	5 1/2"	11 1/2"	21'-1"	8"	8"	4 1/2"	4 1/2"
	S2-13	—	89° 37' 13"	8"	8"	12 1/2"	12 1/2"	5 1/2"	5 1/2"	11 1/2"	21'-1"	8"	8"	4 1/2"	4 1/2"
	S1-14	89° 40' 16"	—	8"	8"	12 1/2"	12 1/2"	5 1/2"	5 1/2"	11 1/2"	21'-1"	8"	10"	4 1/2"	4 1/2"
	S2-14	89° 40' 16"	—	8"	8"	12 1/2"	12 1/2"	5 1/2"	5 1/2"	11 1/2"	21'-1"	8"	10"	4 1/2"	4 1/2"
12	S1-14	—	89° 40' 16"	8"	8"	12 1/2"	12 1/2"	5 1/2"	5 1/2"	11 1/2"	21'-1"	8"	9"	4 1/2"	4 1/2"
	S2-14	—	89° 40' 16"	8"	8"	12 1/2"	12 1/2"	5 1/2"	5 1/2"	11 1/2"	21'-1"	8"	9"	4 1/2"	4 1/2"
	S1-15	89° 40' 04"	—	8"	8 1/2"	12 1/2"	12 1/2"	6 1/2"	5 1/2"	12"	21'-0 1/2"	8 1/2"	9"	4 1/2"	4 1/2"
	S2-15	89° 40' 04"	—	8"	8 1/2"	12 1/2"	12 1/2"	6 1/2"	5 1/2"	12"	21'-0 1/2"	8 1/2"	9"	4 1/2"	4 1/2"


Note:
Footing elevations are approximate only and may be varied to suit field conditions as directed by the Engineer. Vertical shaft reinforcing shall not be cut until these elevations are established. Where elevations change more than 2 ft., redesign will be required.

Overexcavation will not be permitted between existing pier and new pier.


Pier 11 and pier 12 are to match existing pier S2 and pier S3 respectively. The Contractor shall verify the stations in the field.

All piles shall be 10BP42 Steel Piles. (Design capacity = 45 Tons.)


For Steel and Concrete quantities, see Sheet 2.

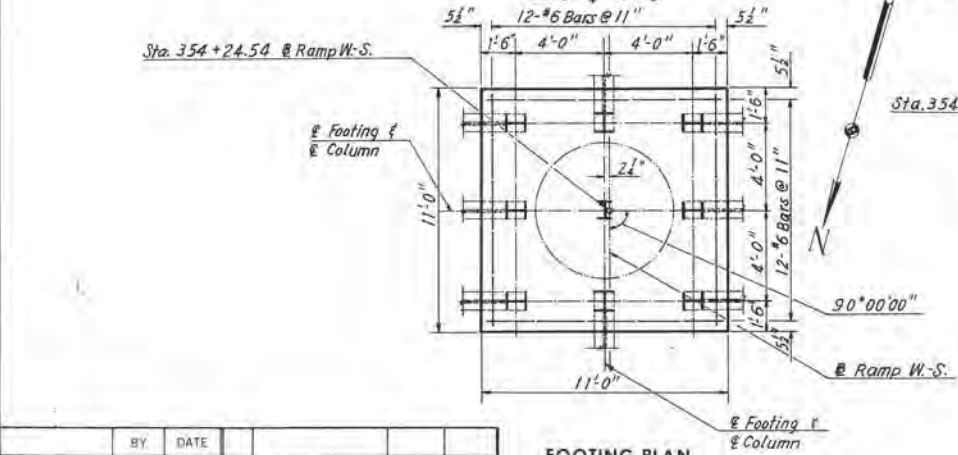

FOOTING PLAN - PIER 11
Scale: 1/4" = 1'-0"

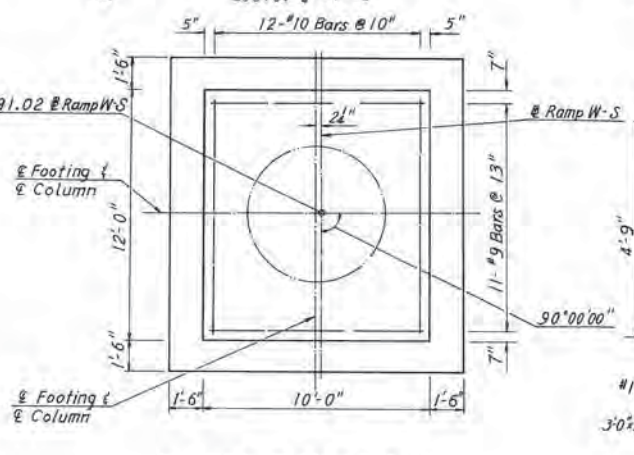

FOOTING PLAN - PIER 12
Scale: 1/4" = 1'-0"

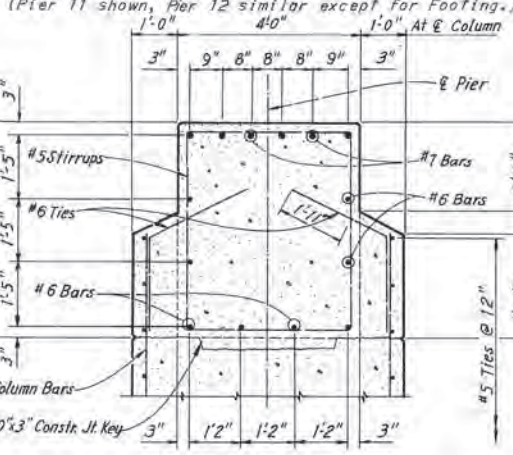

SECTION D-D
Scale: 1/2" = 1'-0"

Note:
For Standard Shoe Details see Sheets S1 and S2
For Framing Plans see Sheet 16.
Estimated Pile Tip Elevation -18.00 for Pier 11.

AS BUILT


BY	DATE				
MADE	KCT 1-22-69	Footing Dowels	TEM	8-26-76	
CHECKED	R C 2-1-69	Pad Elevations	TEM	8-26-75	
IN CHARGE					

RICHMOND METROPOLITAN AUTHORITY
RICHMOND EXPRESSWAY SYSTEM
DOWNTOWN EXPRESSWAY


BRIDGE NO. 68
RAMP W-S CONNECTION TO
RICHMOND-PETERSBURG TURNPIKE
PIERS 11 AND 12

HOWARD, NEEDLES, TAMMEN & BERGENDOFF	SCALE	As Noted
CONSULTING ENGINEERS	CONTRACT NO.	11
NEW YORK ALEXANDRIA KANSAS CITY	SHEET NO.	10 OF 28


RICHMOND EXPRESSWAY SYSTEM			
SECTION	PROJECT	SHEET NO.	TOTAL SHEETS
11	DOWNTOWN EXPRESSWAY	74	97

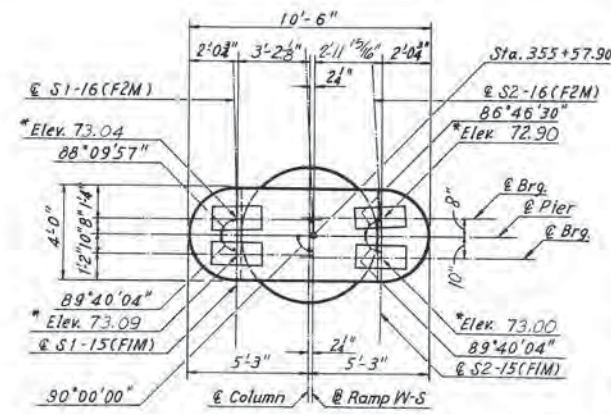


PIER CAP PLAN - PIER 13
Scale: 1/4" = 1'-0"

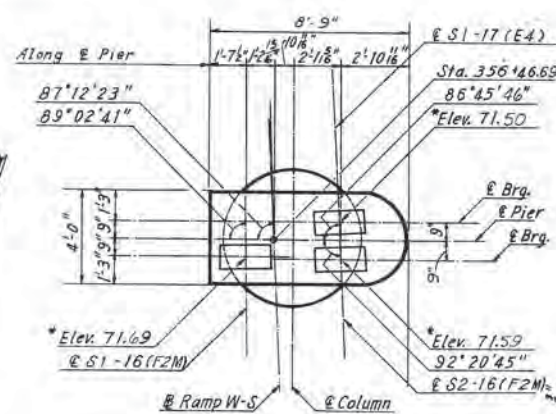

PIER CAP PLAN - PIER 14
Scale: 1/4" = 1'-0"


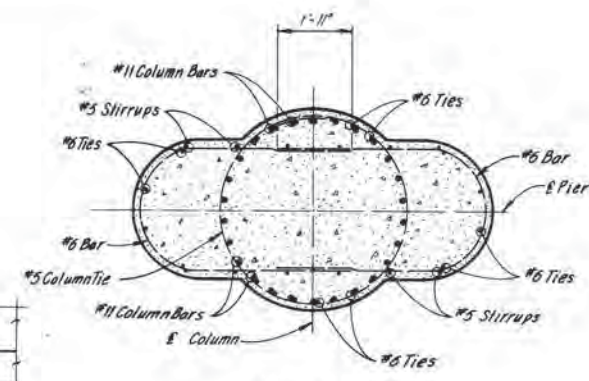


SECTION A-A
Scale: 3/8" = 1'-0"

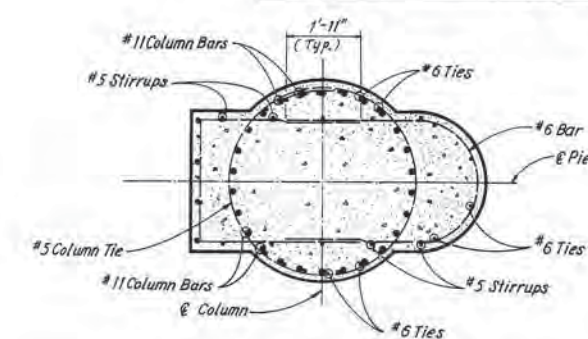


SECTION D-D
Scale: 3/8" = 1'-0"

RUSTICATION DETAIL
Full Scale

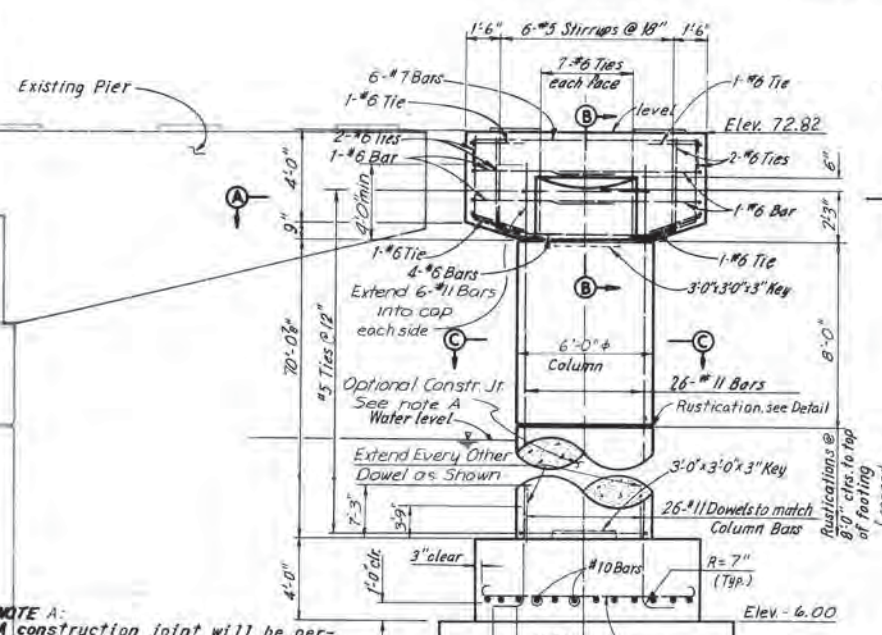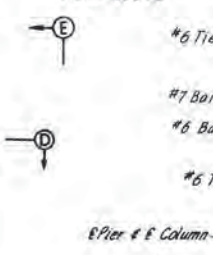


ELEVATION - PIER 13
Scale: 1/4" = 1'-0"

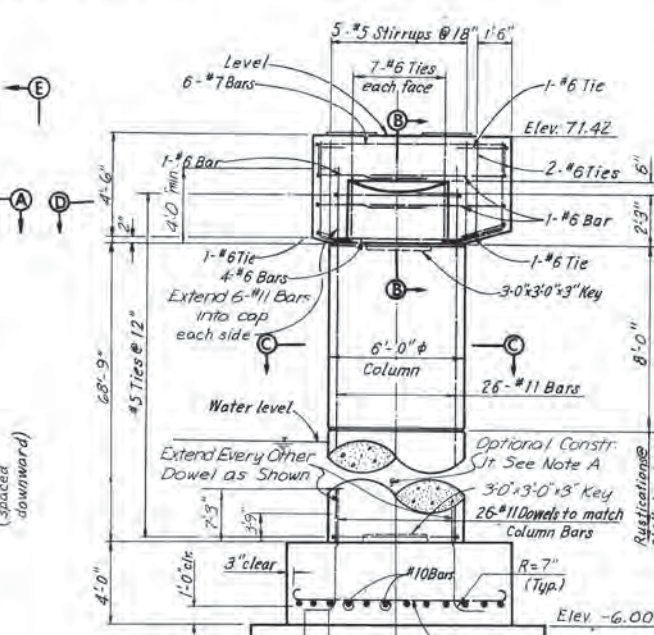

ELEVATION PIER 14
Scale: 1/4" = 1'-0"

VIEW E-E
Scale: 1/4" = 1'-0"

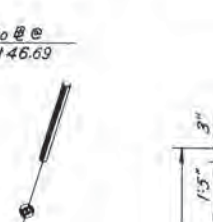

NOTE A:
A construction joint will be permitted at a rustication near mid-height of the column. The column reinforcement may be lap spliced near the construction joint. The lap at the splice shall be a minimum of 3'-6". Splices shall be staggered at least 3'-3" between adjacent bars.

SECTION C-C
Scale: 3/8" = 1'-0"


SECTION B-B
Scale: 1/2" = 1'-0"

PAD AND ANCHOR BOLT SETTING PLAN
NO Scale


Pier	Stringer	d	B	A	B	C	D	E	F	G	H	I	J	K	L
13	S1-15	—	89'40"04"	8 1/2"	8 1/2"	1 1/2"	12 1/2"	12 1/2"	5 1/2"	5 1/2"	11 1/2"	2 1/2"	8"	10"	4 1/2"
	S2-15	—	89'40"04"	1 1/2"	8 1/2"	1 1/2"	12 1/2"	12 1/2"	5 1/2"	5 1/2"	11 1/2"	2 1/2"	8"	10"	4 1/2"
	S1-16	88'09"57"	—	4 1/2"	10 1/2"	3 1/2"	15 1/2"	14 1/2"	6 1/2"	5 1/2"	11"	2 1/2"	10 1/2"	8"	4 1/2"
14	S1-16	—	90'57"19"	1 1/2"	10 1/2"	3 1/2"	15 1/2"	14 1/2"	5 1/2"	5 1/2"	11"	2 1/2"	10 1/2"	9"	4 1/2"
	S2-16	—	92'20"45"	1 1/2"	10 1/2"	3 1/2"	15 1/2"	14 1/2"	6 1/2"	4 1/2"	11"	2 1/2"	10 1/2"	9"	4 1/2"
	S1-17	86'45"29"	—	1 1/2"	10 1/2"	3 1/2"	15 1/2"	13 1/2"	7"	5 1/2"	12 1/2"	2 1/2"	10 1/2"	9"	4 1/2"

Note:
Footings elevations are approximate only and may be varied to suit field conditions as directed by the Engineer. Vertical shaft reinforcing shall not be cut until these elevations are established. Where elevations change more than 2 ft. redesign will be required.
Overexcavation will not be permitted between existing pier and new pier.
Pier 13 and pier 14 are to match existing pier 48 and pier 46 respectively. The Contractor shall verify the stations in the field.

For Standard Shoe Details, see Sheets S1 and S2.
For Framing Plans, see Sheet 16.
For Steel and Concrete quantities, see Sheet 2.

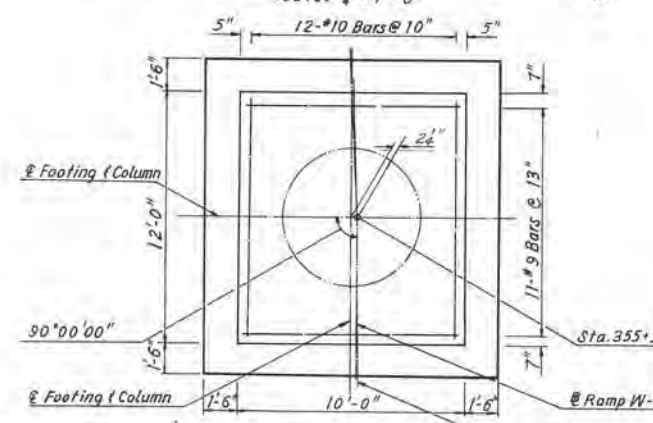

FOOTING PLAN PIER 13
Scale: 1/4" = 1'-0"

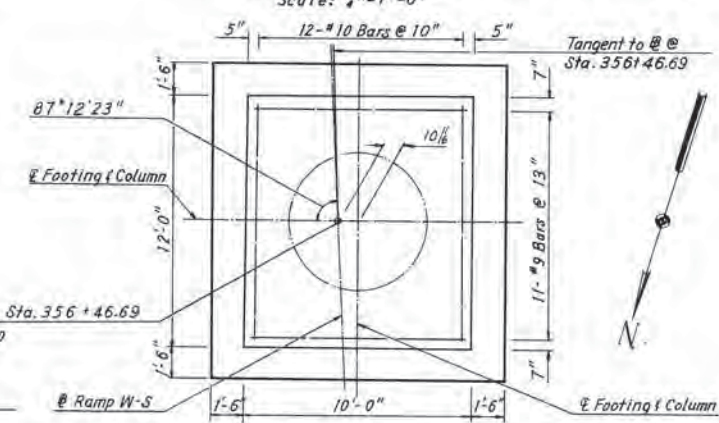

FOOTING PLAN PIER 14
Scale: 1/4" = 1'-0"

NO.	REVISION	BY	DATE

RICHMOND METROPOLITAN AUTHORITY
RICHMOND EXPRESSWAY SYSTEM
DOWNTOWN EXPRESSWAY






BRIDGE NO. 68
RAMP W-5 CONNECTION TO
RICHMOND-PETERSBURG TURNPIKE
PIERS - 13 AND 14

HOWARD, NEEDLES, TAMMEN & BERGENDOFF
consulting engineers
NEW YORK ALEXANDRIA KANSAS CITY

SCALE: As Noted
CONTRACT NO. 11
SHEET NO. 11 OF 28

AS BUILT

RICHMOND EXPRESSWAY SYSTEM			
SECTION	PROJECT	SHEET NO	TOTAL SHEETS
11	DOWNTOWN EXPRESSWAY	74 A	97

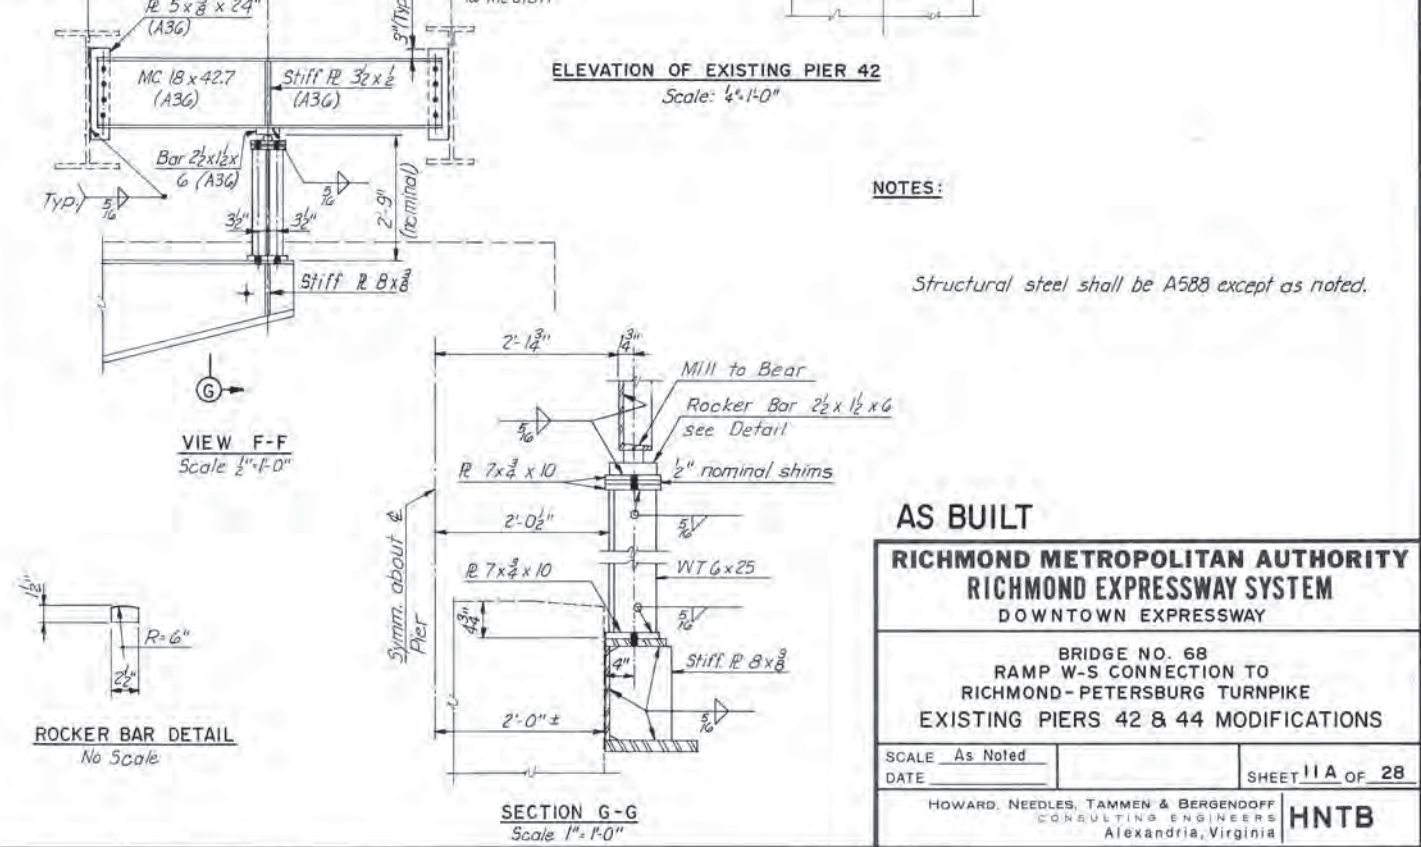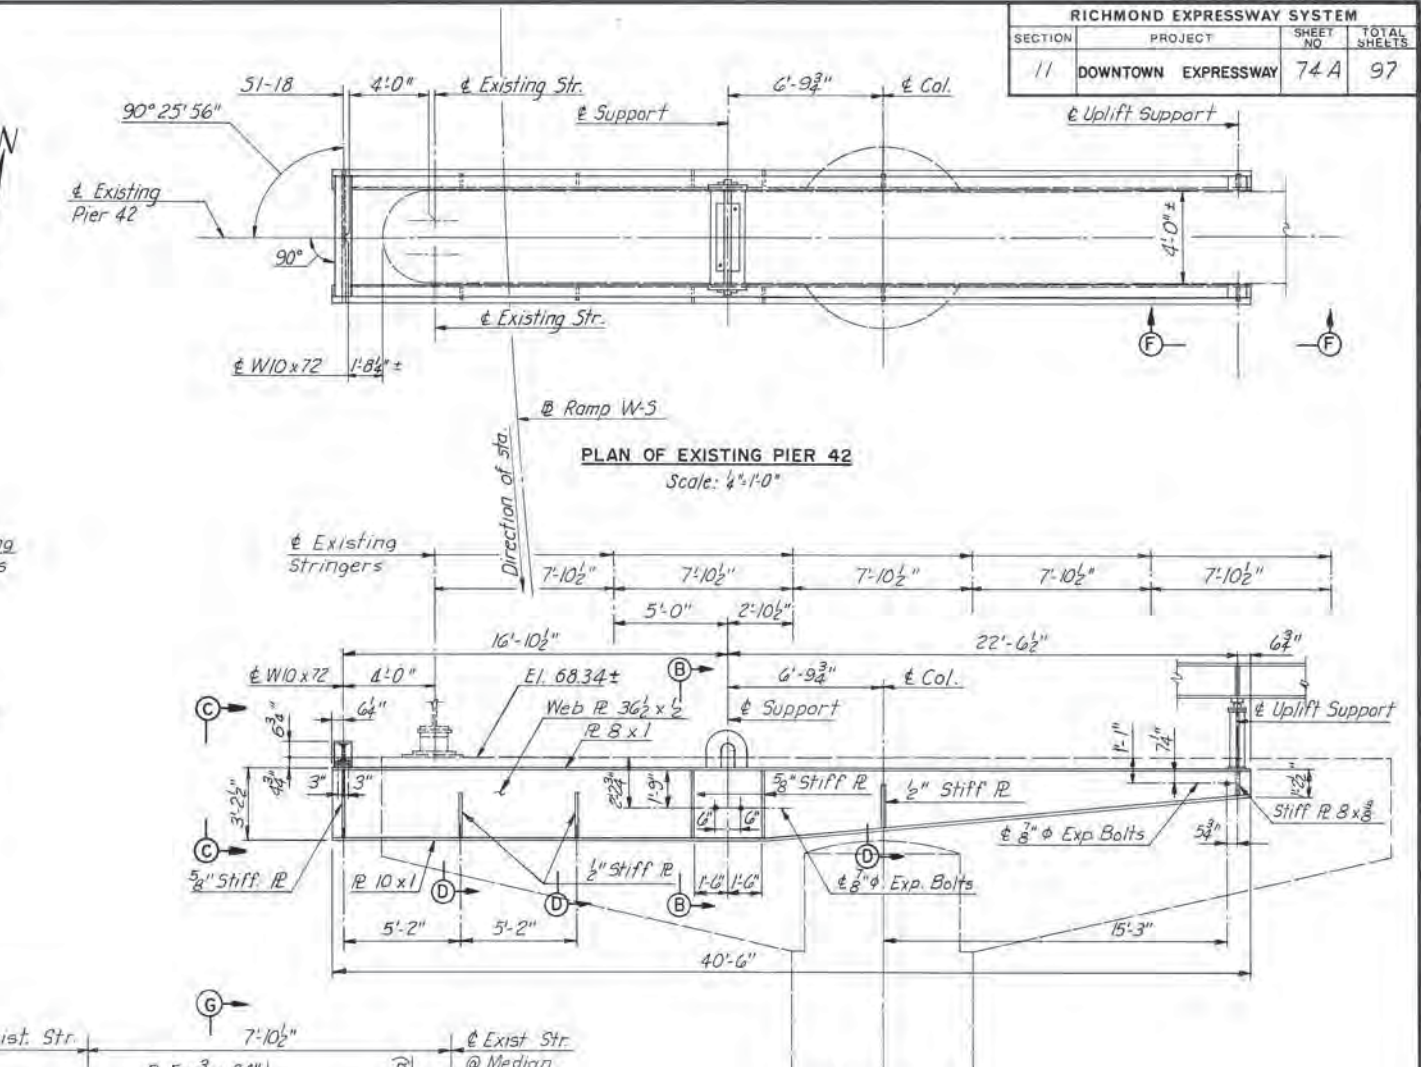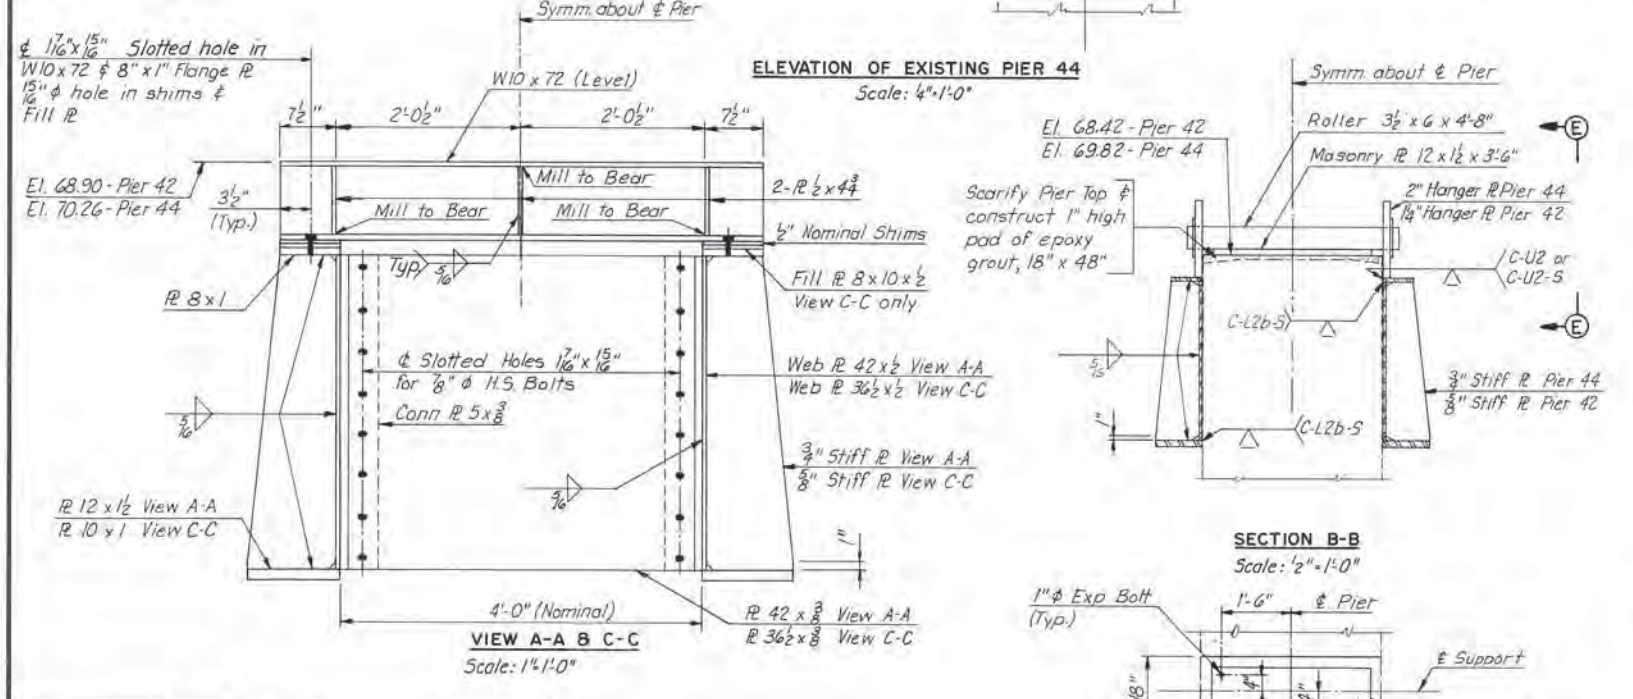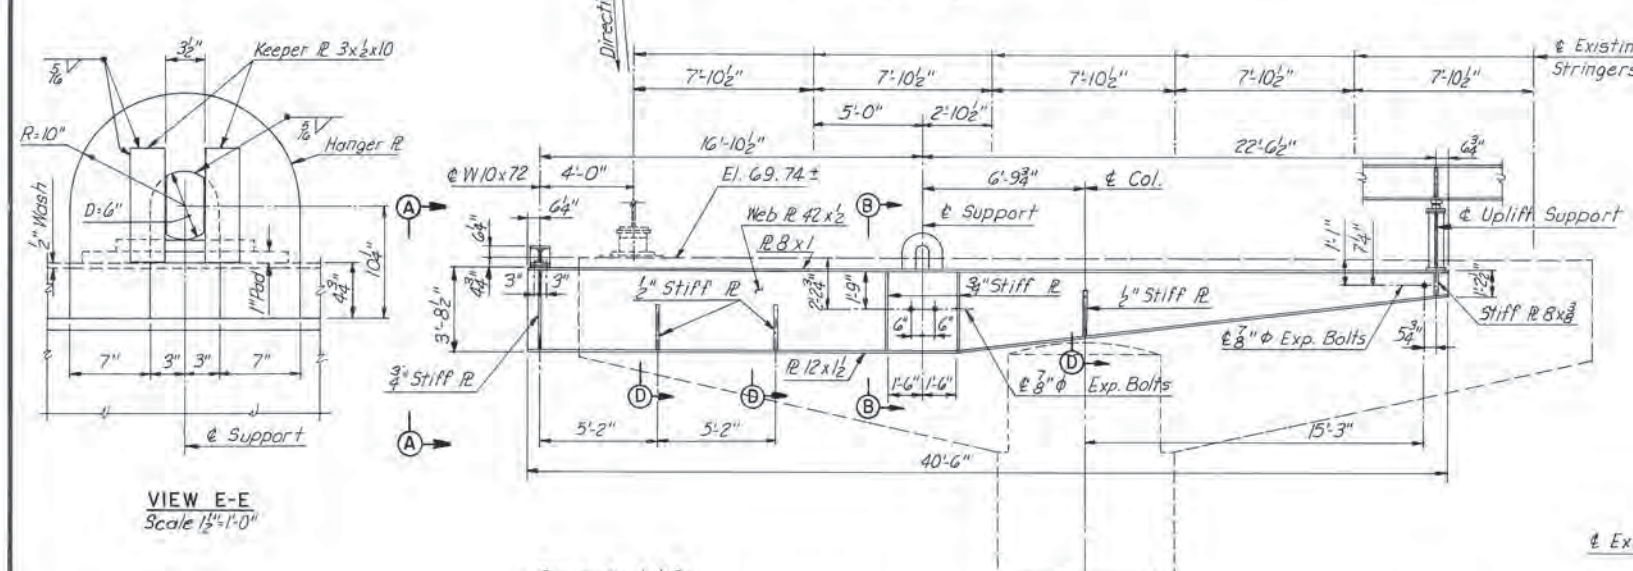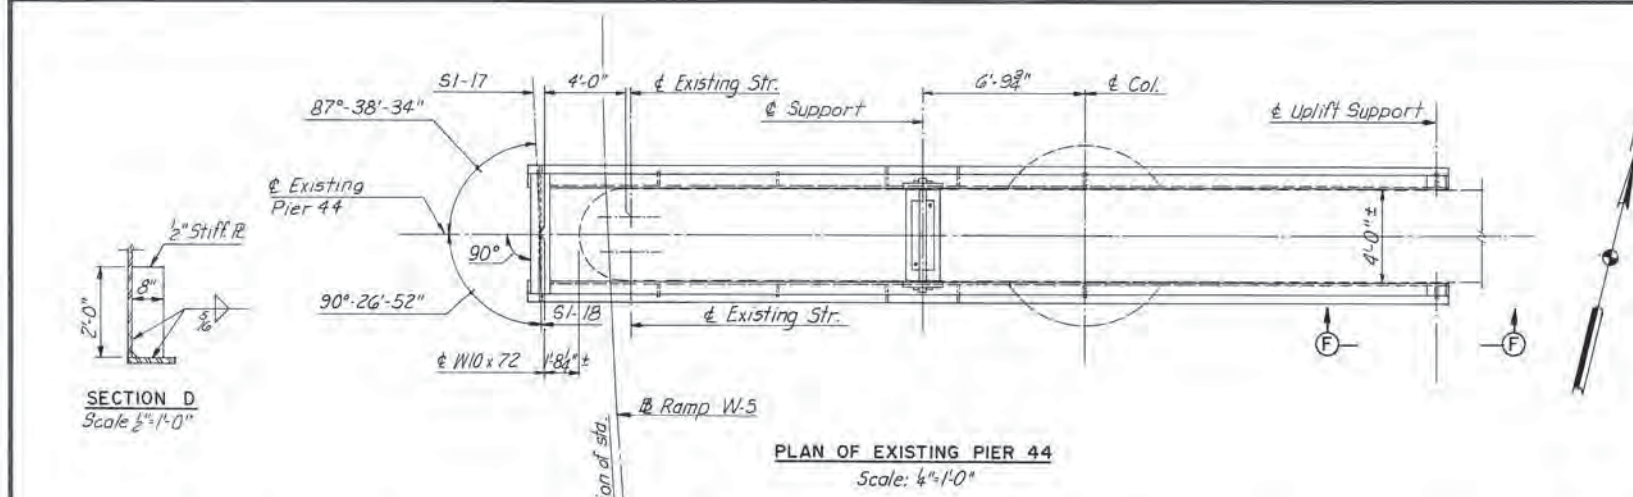

NOTES:
Structural steel shall be A588 except as noted.

DESIGNED	DATE	BY	REVISION
TEM/ABP	8-11-75	TEM	Entire Sheet
PRY	10-15-76	C.B.P.	New Sheet added

AS BUILT

RICHMOND METROPOLITAN AUTHORITY
RICHMOND EXPRESSWAY SYSTEM
DOWNTOWN EXPRESSWAY


BRIDGE NO. 68
RAMP W-S CONNECTION TO
RICHMOND-PETERSBURG TURNPIKE
EXISTING PIERS 42 & 44 MODIFICATIONS

SCALE As Noted
DATE
SHEET 11A OF 28


HOWARD, NEEDLES, TAMMEN & BERGENDOFF
CONSULTING ENGINEERS
Alexandria, Virginia

HNTB


RICHMOND EXPRESSWAY SYSTEM			
SECTION	PROJECT	SHEET NO.	TOTAL SHEETS
II	DOWNTOWN EXPRESSWAY	96	97

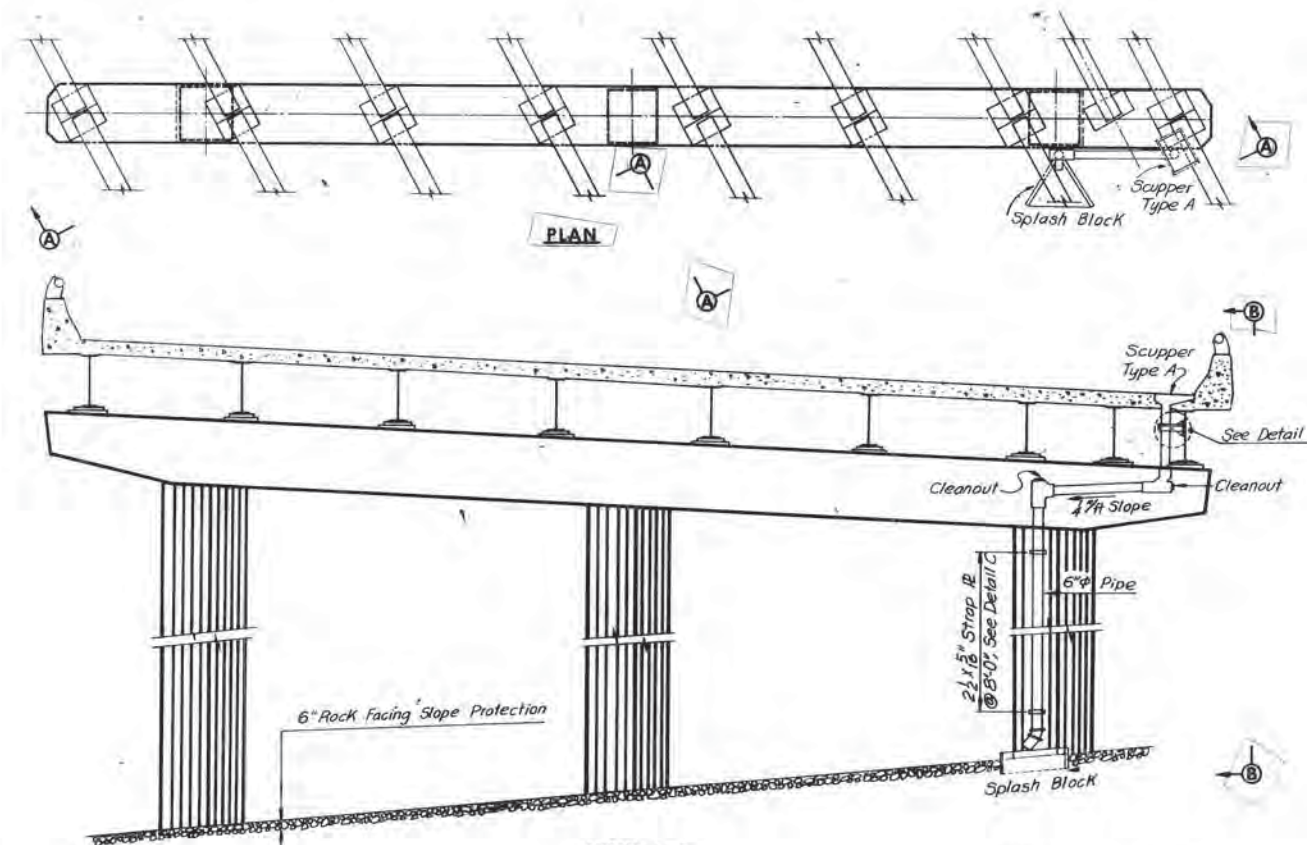


VIEW A-A ELEVATION SUPPORT TYPE 1
Scale: 1/8" = 1'-0"

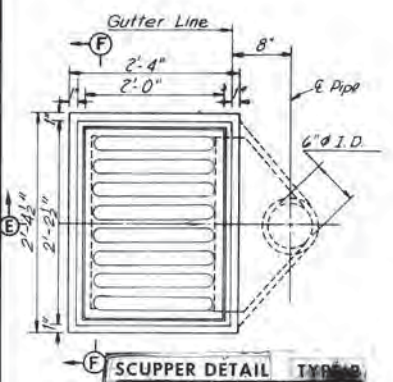


SCUPPER DETAIL TYPE B
Scale: 1" = 1'-0"
Note: For dimensions not given, see Scupper Detail, Type A.

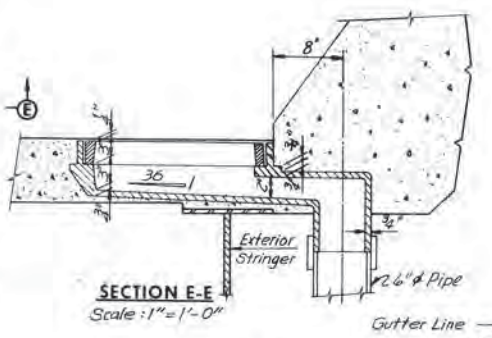


SECTION E-E
Scale: 1" = 1'-0"

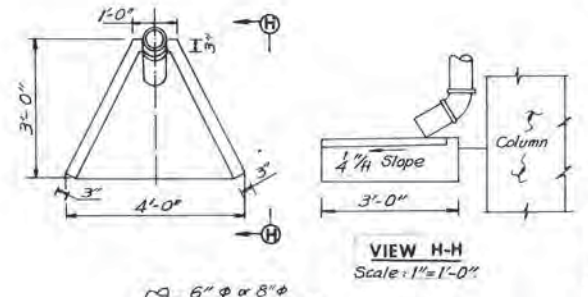


VIEW H-H
Scale: 1" = 1'-0"

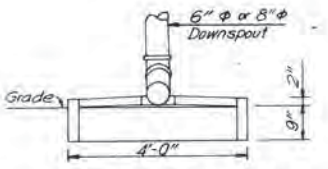


SPASH BLOCK DETAIL
Scale: 1" = 1'-0"

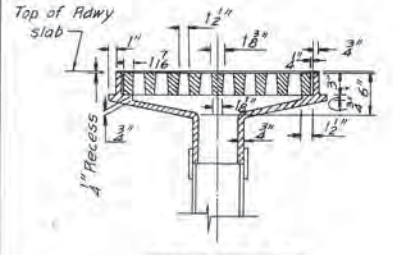


SECTION D-D
Scale: 1" = 1'-0"

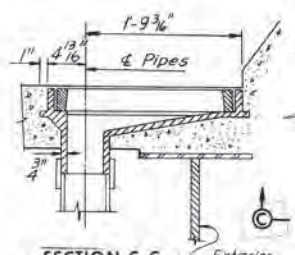


SECTION C-C
Scale: 1" = 1'-0"

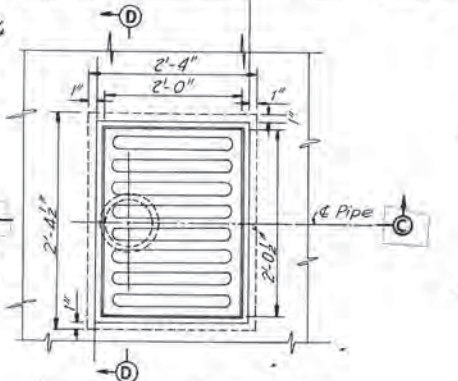


SCUPPER DETAIL TYPE A
Scale: 1" = 1'-0"

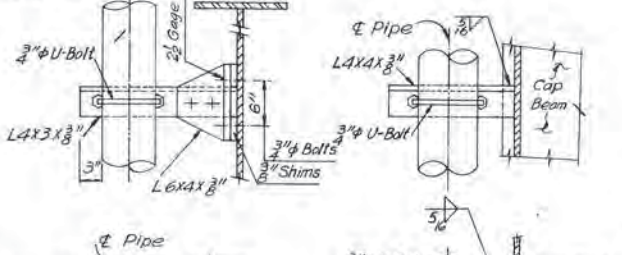


DETAIL A
Scale: 1" = 1'-0"

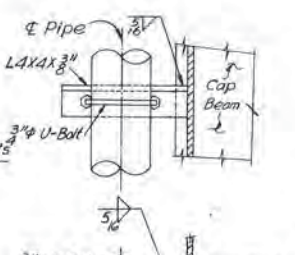


DETAIL B
Scale: 1" = 1'-0"

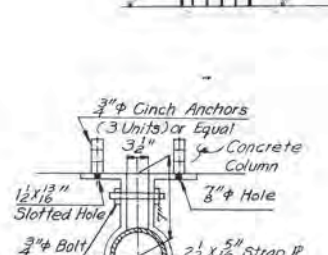

DETAIL C
Scale: 1" = 1'-0"

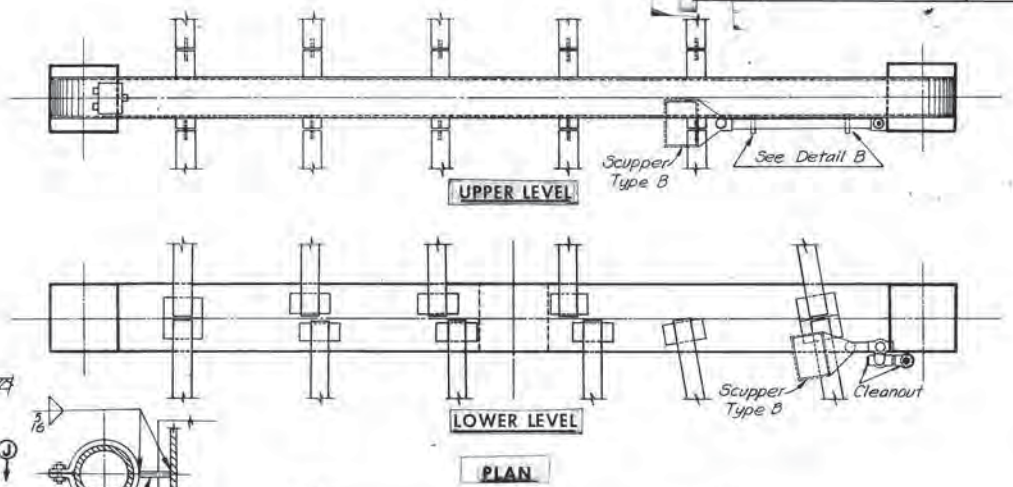

Note: Remove existing scuppers at widening portions. Also remove enough concrete around these scuppers to provide required bond length (about 2'-0").

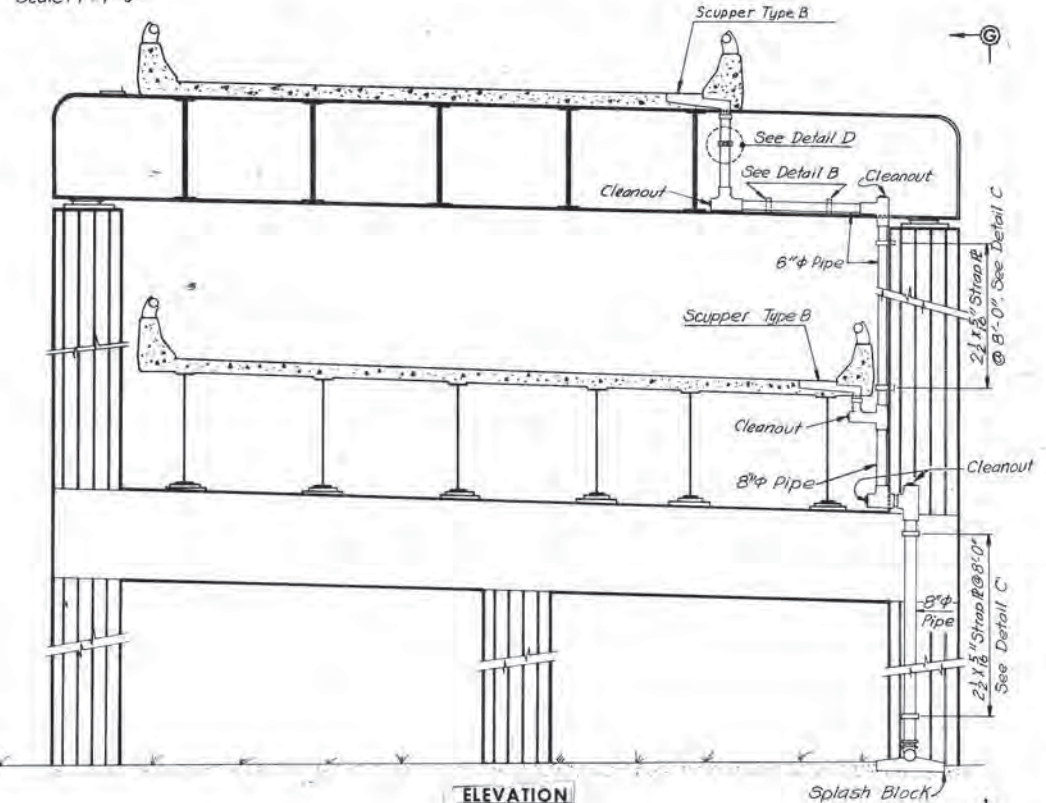

ELEVATION SUPPORT TYPE 2
Scale: 3/16" = 1'-0"

MADE	CHECKED	IN CHARGE	BY	DATE	REVISION
				10-10-69	

RICHMOND METROPOLITAN AUTHORITY
RICHMOND EXPRESSWAY SYSTEM
DOWNTOWN EXPRESSWAY




















STANDARD DRAINAGE DETAILS

HOWARD, NEEDLES, TAMMEN & BERGENDOFF
consulting engineers
NEW YORK ALEXANDRIA KANSAS CITY

SCALE: As Noted
CONTRACT NO. 11
SHEET NO. 55 of 6

Note: Where existing scuppers are to be removed, concrete shall be removed 2'-0" minimum from the edges of scuppers.

RICHMOND EXPRESSWAY SYSTEM			
SECTION	PROJECT	SHEET NO.	TOTAL SHEETS
II	DOWNTOWN EXPRESSWAY	97	97

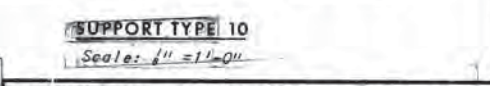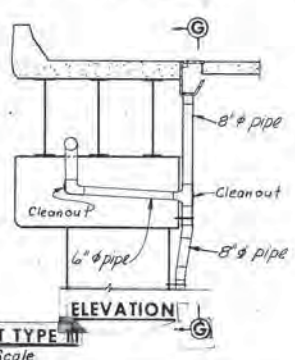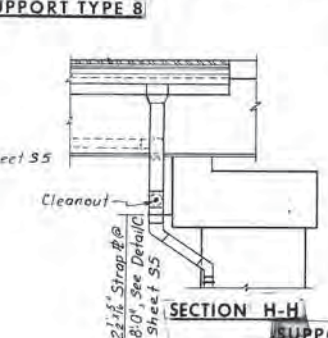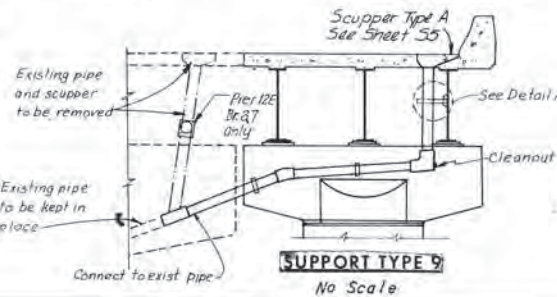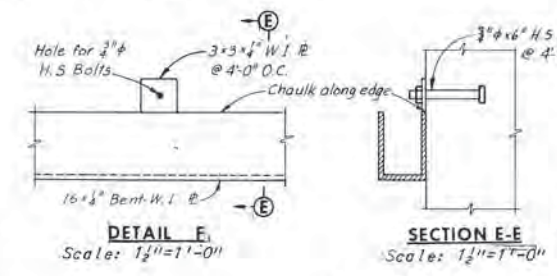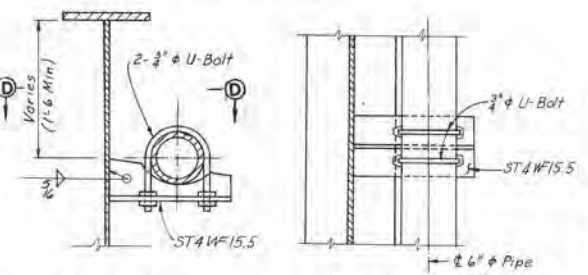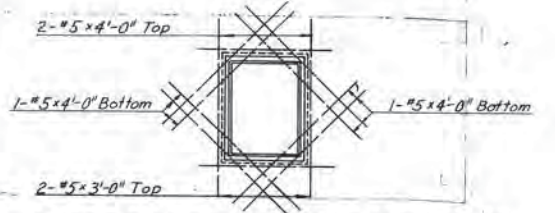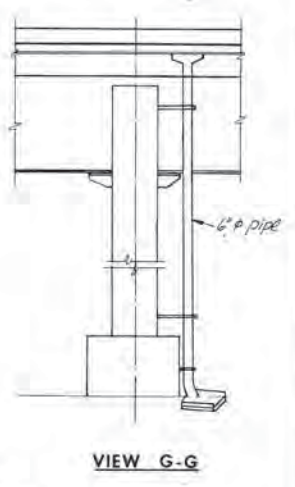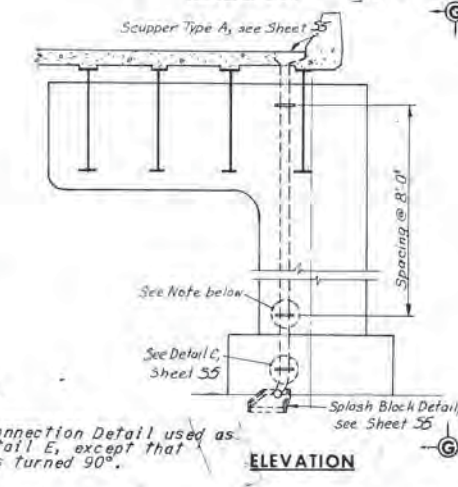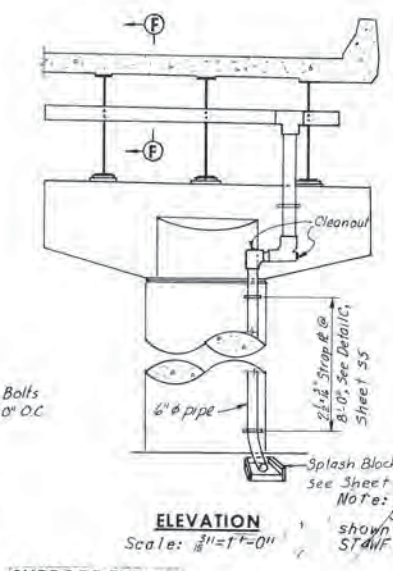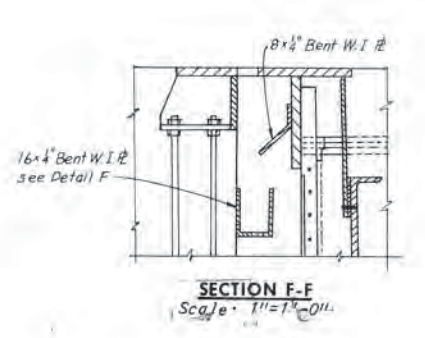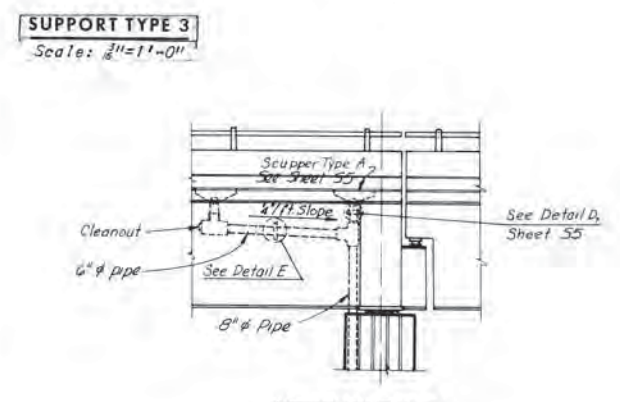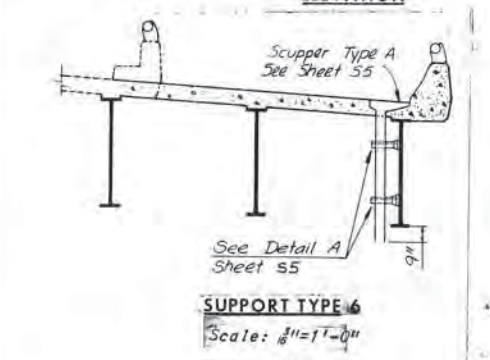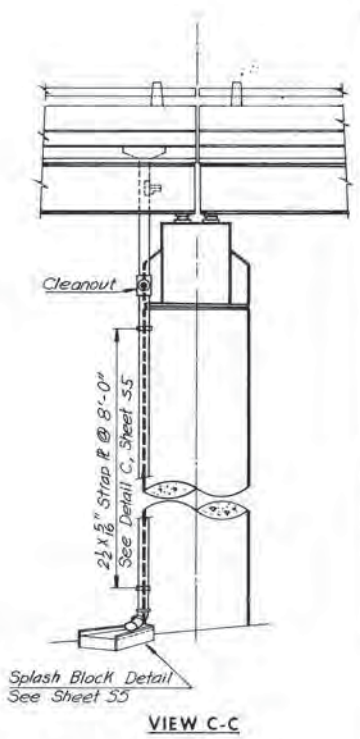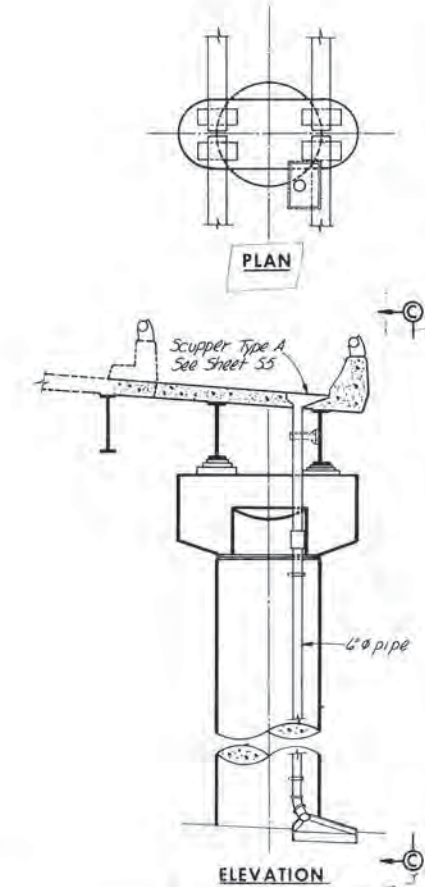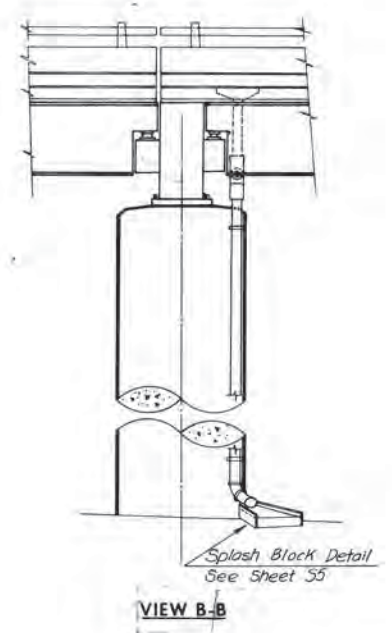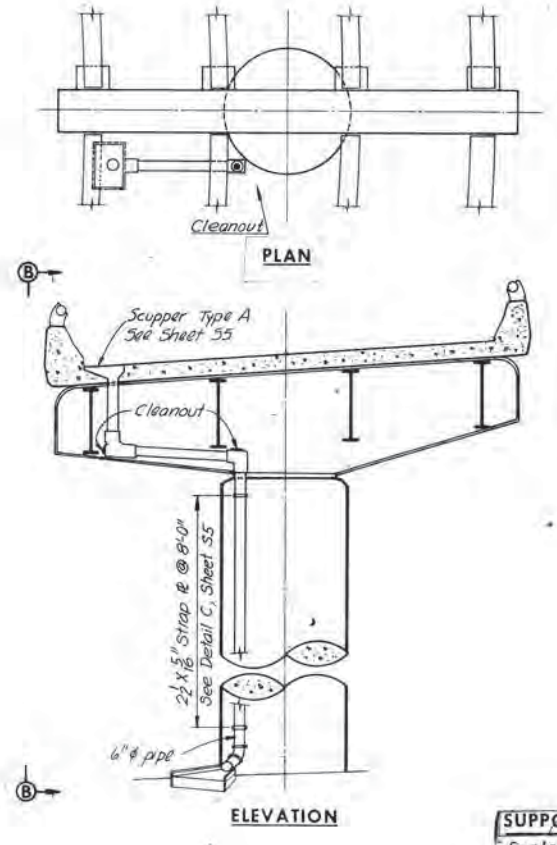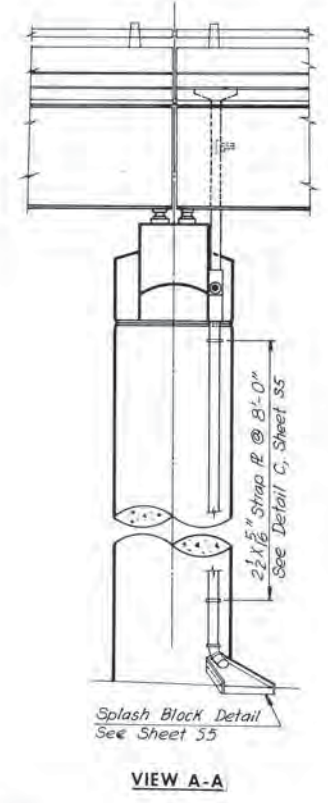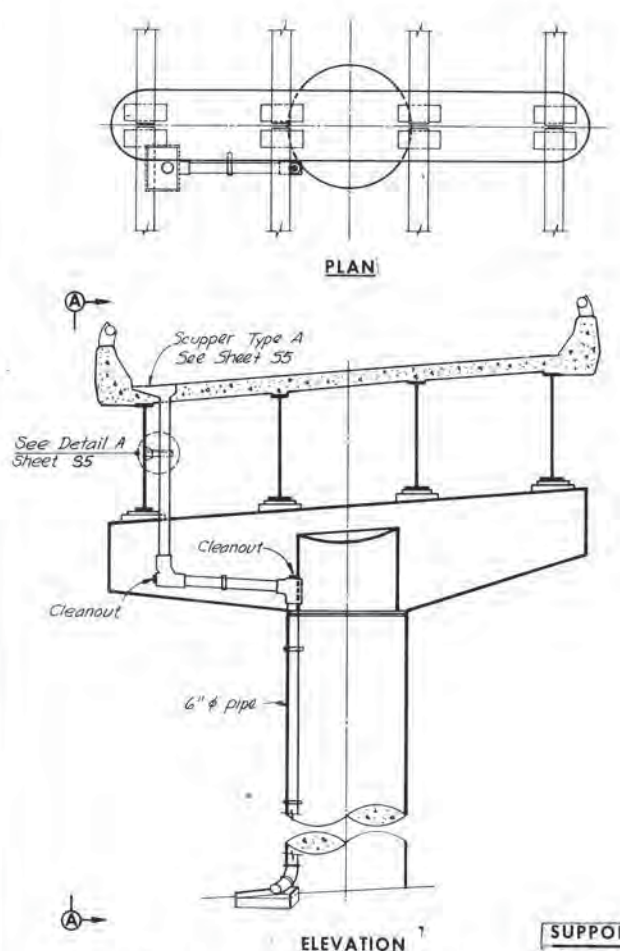

Note: Bend bottom and top slab bars at Cast Scuppers where interference occurs.
Weight of Reinforcing Bars at Scupper: 48 lbs.

BY	DATE	Parapet Changed	PR/ME	4-19-74
MADE	SCC	129.69		
CHECKED	G.S.H.	243-69		
IN CHARGE				
NO.	REVISION	BY	DATE	

RICHMOND METROPOLITAN AUTHORITY
RICHMOND EXPRESSWAY SYSTEM
DOWNTOWN EXPRESSWAY

STANDARD DRAINAGE DETAILS

HOWARD, NEEDLES, TAMMEN & BERGENDOFF
consulting engineers
NEW YORK ALEXANDRIA KANSAS CITY

SCALE: As Noted
CONTRACT NO. 11
SHEET NO. 56 OF 60